


NB 18+50.00

NB 18+00.00



SCALE IN FEET

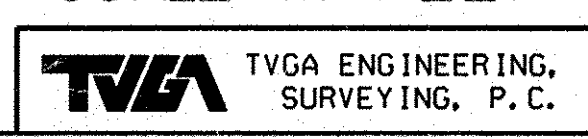

STATE OF VERMONT AGENCY OF TRANSPORTATION		Designed By	Drawn By
		Checked By	Date
Town Of	Bridge No.	PROJECT	
Highway No.	Log Sta.	Guilford	PROJECT NO.
	Surv. Sta.	TVGA CAD Drawing No.	ACIM 091-1(33)
		Bridge Sheet No.	Date
			Sheet 1 of 17

12' FT
0.15
TYP.

contrib
-09.69

MLL
2/16/10
Jed
09/2/16/10
MLL
2/10/10

12.43