


1" = 25'  
Constant = 0.0969

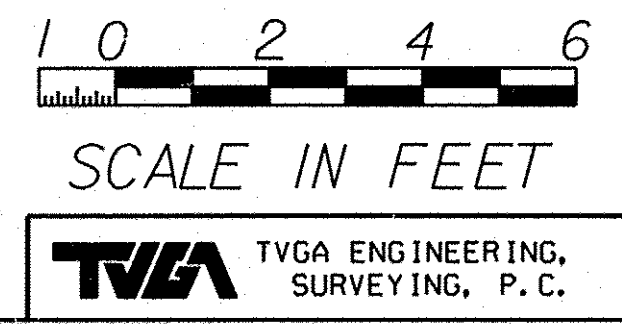

STATE OF VERMONT AGENCY OF TRANSPORTATION		Designed By	Drawn By
		Checked By	Bridge Design Supervisor
Town Of	Bridge No.	PROJECT	PROJECT NO.
Highway No.	Log Sta.	Guilford	ACT091-1(33)
	Surv. Sta.	TVGA CAD Drawing No.	Date
		Bridge Sheet No.	Sheet 4 of 17