


MATCHLINE (THIS DWG.)

SAND BORROW	DENSE GRAVEL
32.69 410.11	31.92 410.63
10 410.54	12 411.04
10 411.04	12 413.04
31.92 410.63	24 412.79
32.69 410.11	28.92 412.58
	28.92 413.62
	32 413.49
	33.66 410.38
	31.39 412.48
	31.39 410.98
	31.92 410.63
10.19 SF	42.29 SF

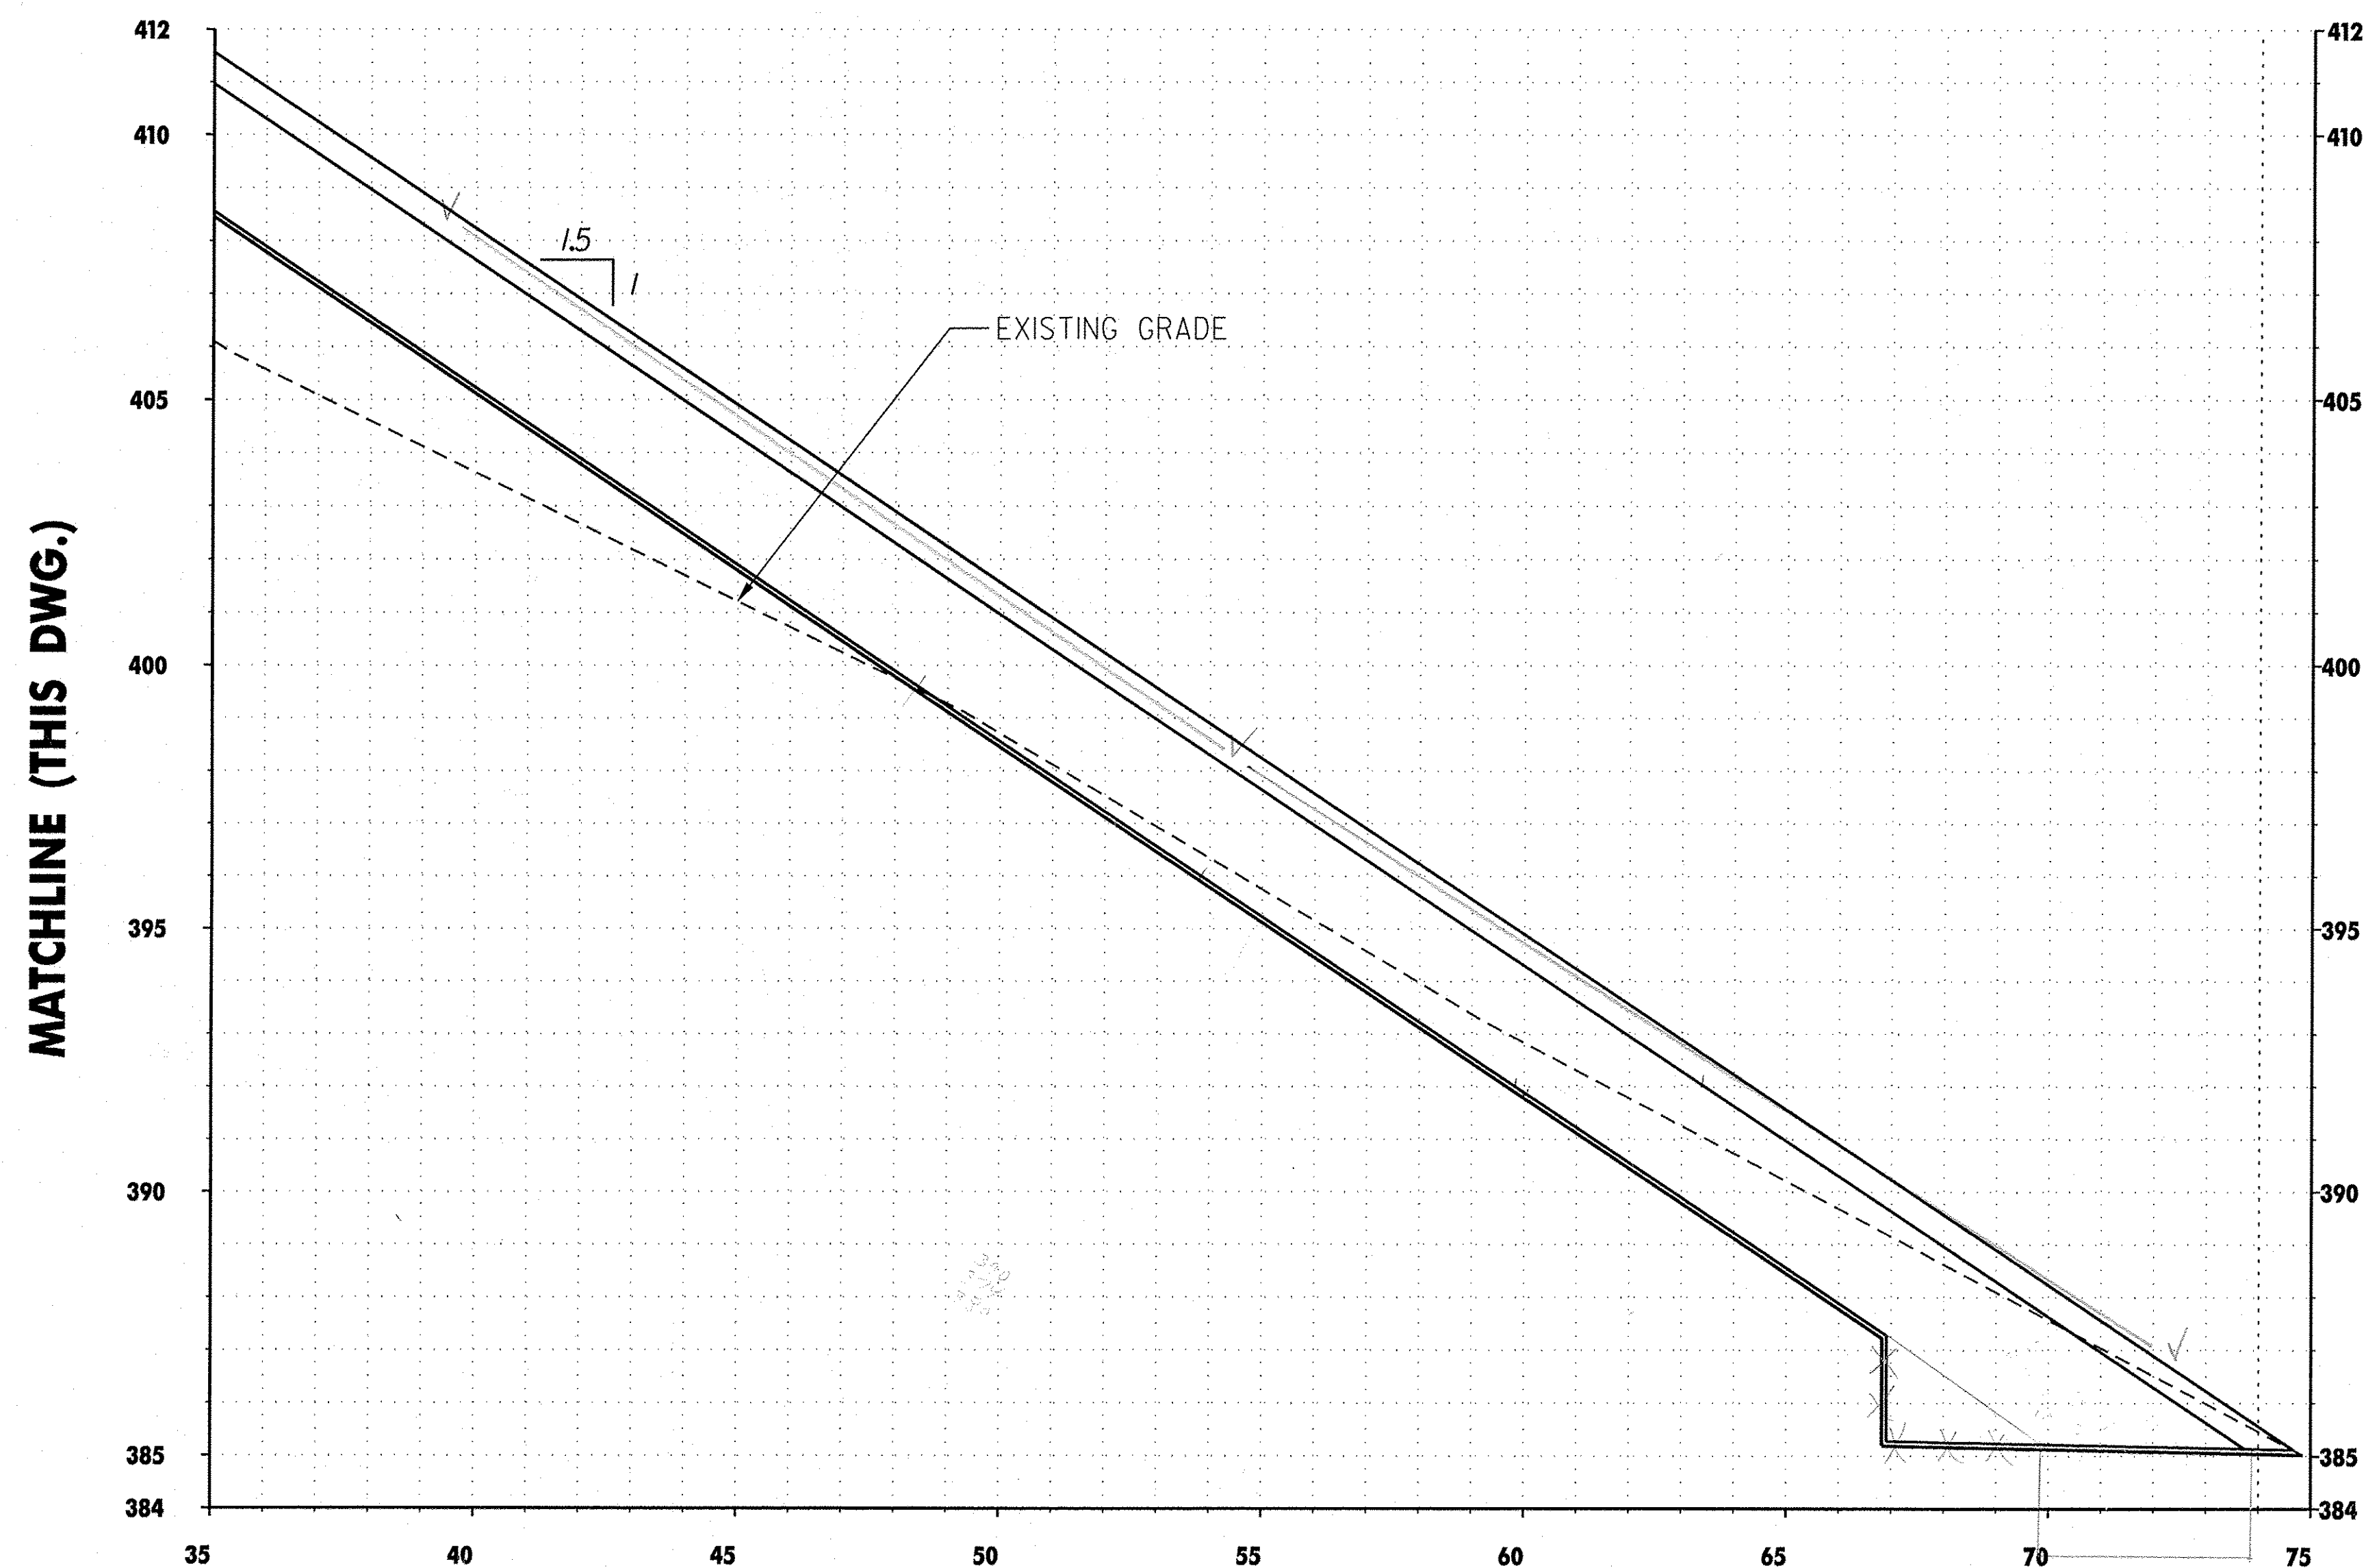

MATCHLINE (THIS DWG.)


COMMON EXCAVATION  
START @ 31.25 R.T.

34  
38  
37

Stone Fill, Type II M.W.H. 2/10/10

MTL  
2/10/10

MTL  
2/10/10

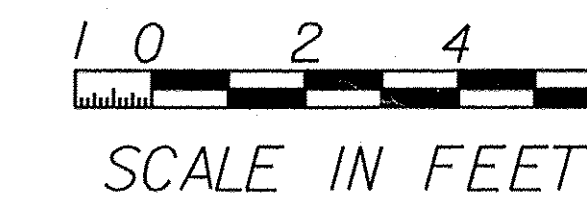

STATE OF VERMONT  
AGENCY OF TRANSPORTATION

Designed By	Drawn By
Checked By	Bridge Design Supervisor
Date	Date

Town Of	Bridge No.	PROJECT	PROJECT NO.
Highway No.	Log Sta.	GULLFORD	AC10091-1(33)
	Surv. Sta.	TVGA CAD Drawing No.	Date
		Bridge Sheet No.	Sheet 6 of 17

TVGA ENGINEERING, SURVEYING, P. C.