


SAND BORROW	DENSE GRADED
32.69 417.83	31.92 418.35
12 418.26	12 418.76
12 418.76	12 420.76
31.92 418.35	24 420.51
32.69 417.83	28.92 420.36
	28.92 421.24
	32 421.21
	33.66 420.1
	31.39 420.20
	31.39 418.70
	31.92 418.35
	42.29 SF

This section was re-sectioned and re-plotted due to the original section not matching the existing old ground.

Type II Stone M.W.H. 2/18/10

MTL 2/10/10

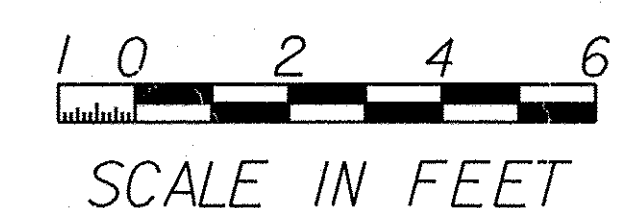

SCALE IN FEET

<b>STATE OF VERMONT</b> <b>AGENCY OF TRANSPORTATION</b>		Designed By	Drawn By
		Checked By	Date
Town Of	Bridge No.	PROJECT	PROJECT NO.
Highway No.	Log Sta.	TVGA CAD Drawing No.	Date
	Surv. Sta.	Bridge Sheet No.	Sheet 7 of 17