


COMMON EXCAVATION = 883.33' ✓ M.W.H. 2/23/10

TYPE II STONE = 54.65 SF

REFLECTIVE UNDER STONE FILL = 33.2' ✓ M.W.H. 2/23/10

SAND BORROW		DENSE GRAVEL	
-32.69	419.19	-31.92	419.70
-12	419.83	-12	420.13
-12	420.12	-12	420.12
-31.92	419.70	-24	421.89
-32.61	419.19	-28.92	421.66
		-28.10	422.57
		-31.38	422.57
		-32.82	421.57
		-31.39	421.56
		-31.39	420.66
		-31.92	419.70
			41.35 SF

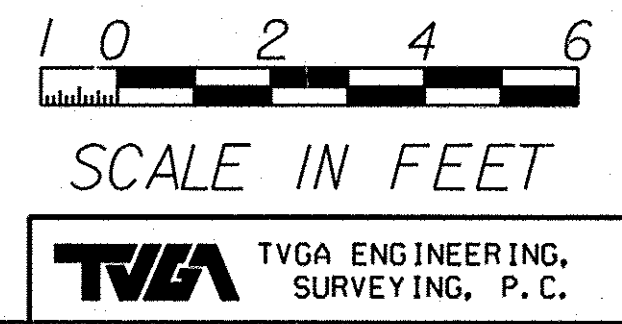

STATE OF VERMONT
AGENCY OF TRANSPORTATION

Designed By _____
Checked By _____ Date _____
Town Of _____ Bridge No. _____
Highway No. _____ Log Sta. _____
Surv. Sta. _____

Drawn By _____
Bridge Design Supervisor _____
Date _____
PROJECT _____
PROJECT NO. _____
TVGA CAD Drawing No. _____
Date _____
Bridge Sheet No. _____
Sheet 8 of 17