
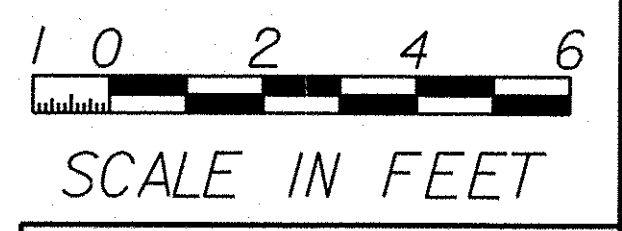


729  
733  
734  
733.67 \* .0769 = 71.0 SF

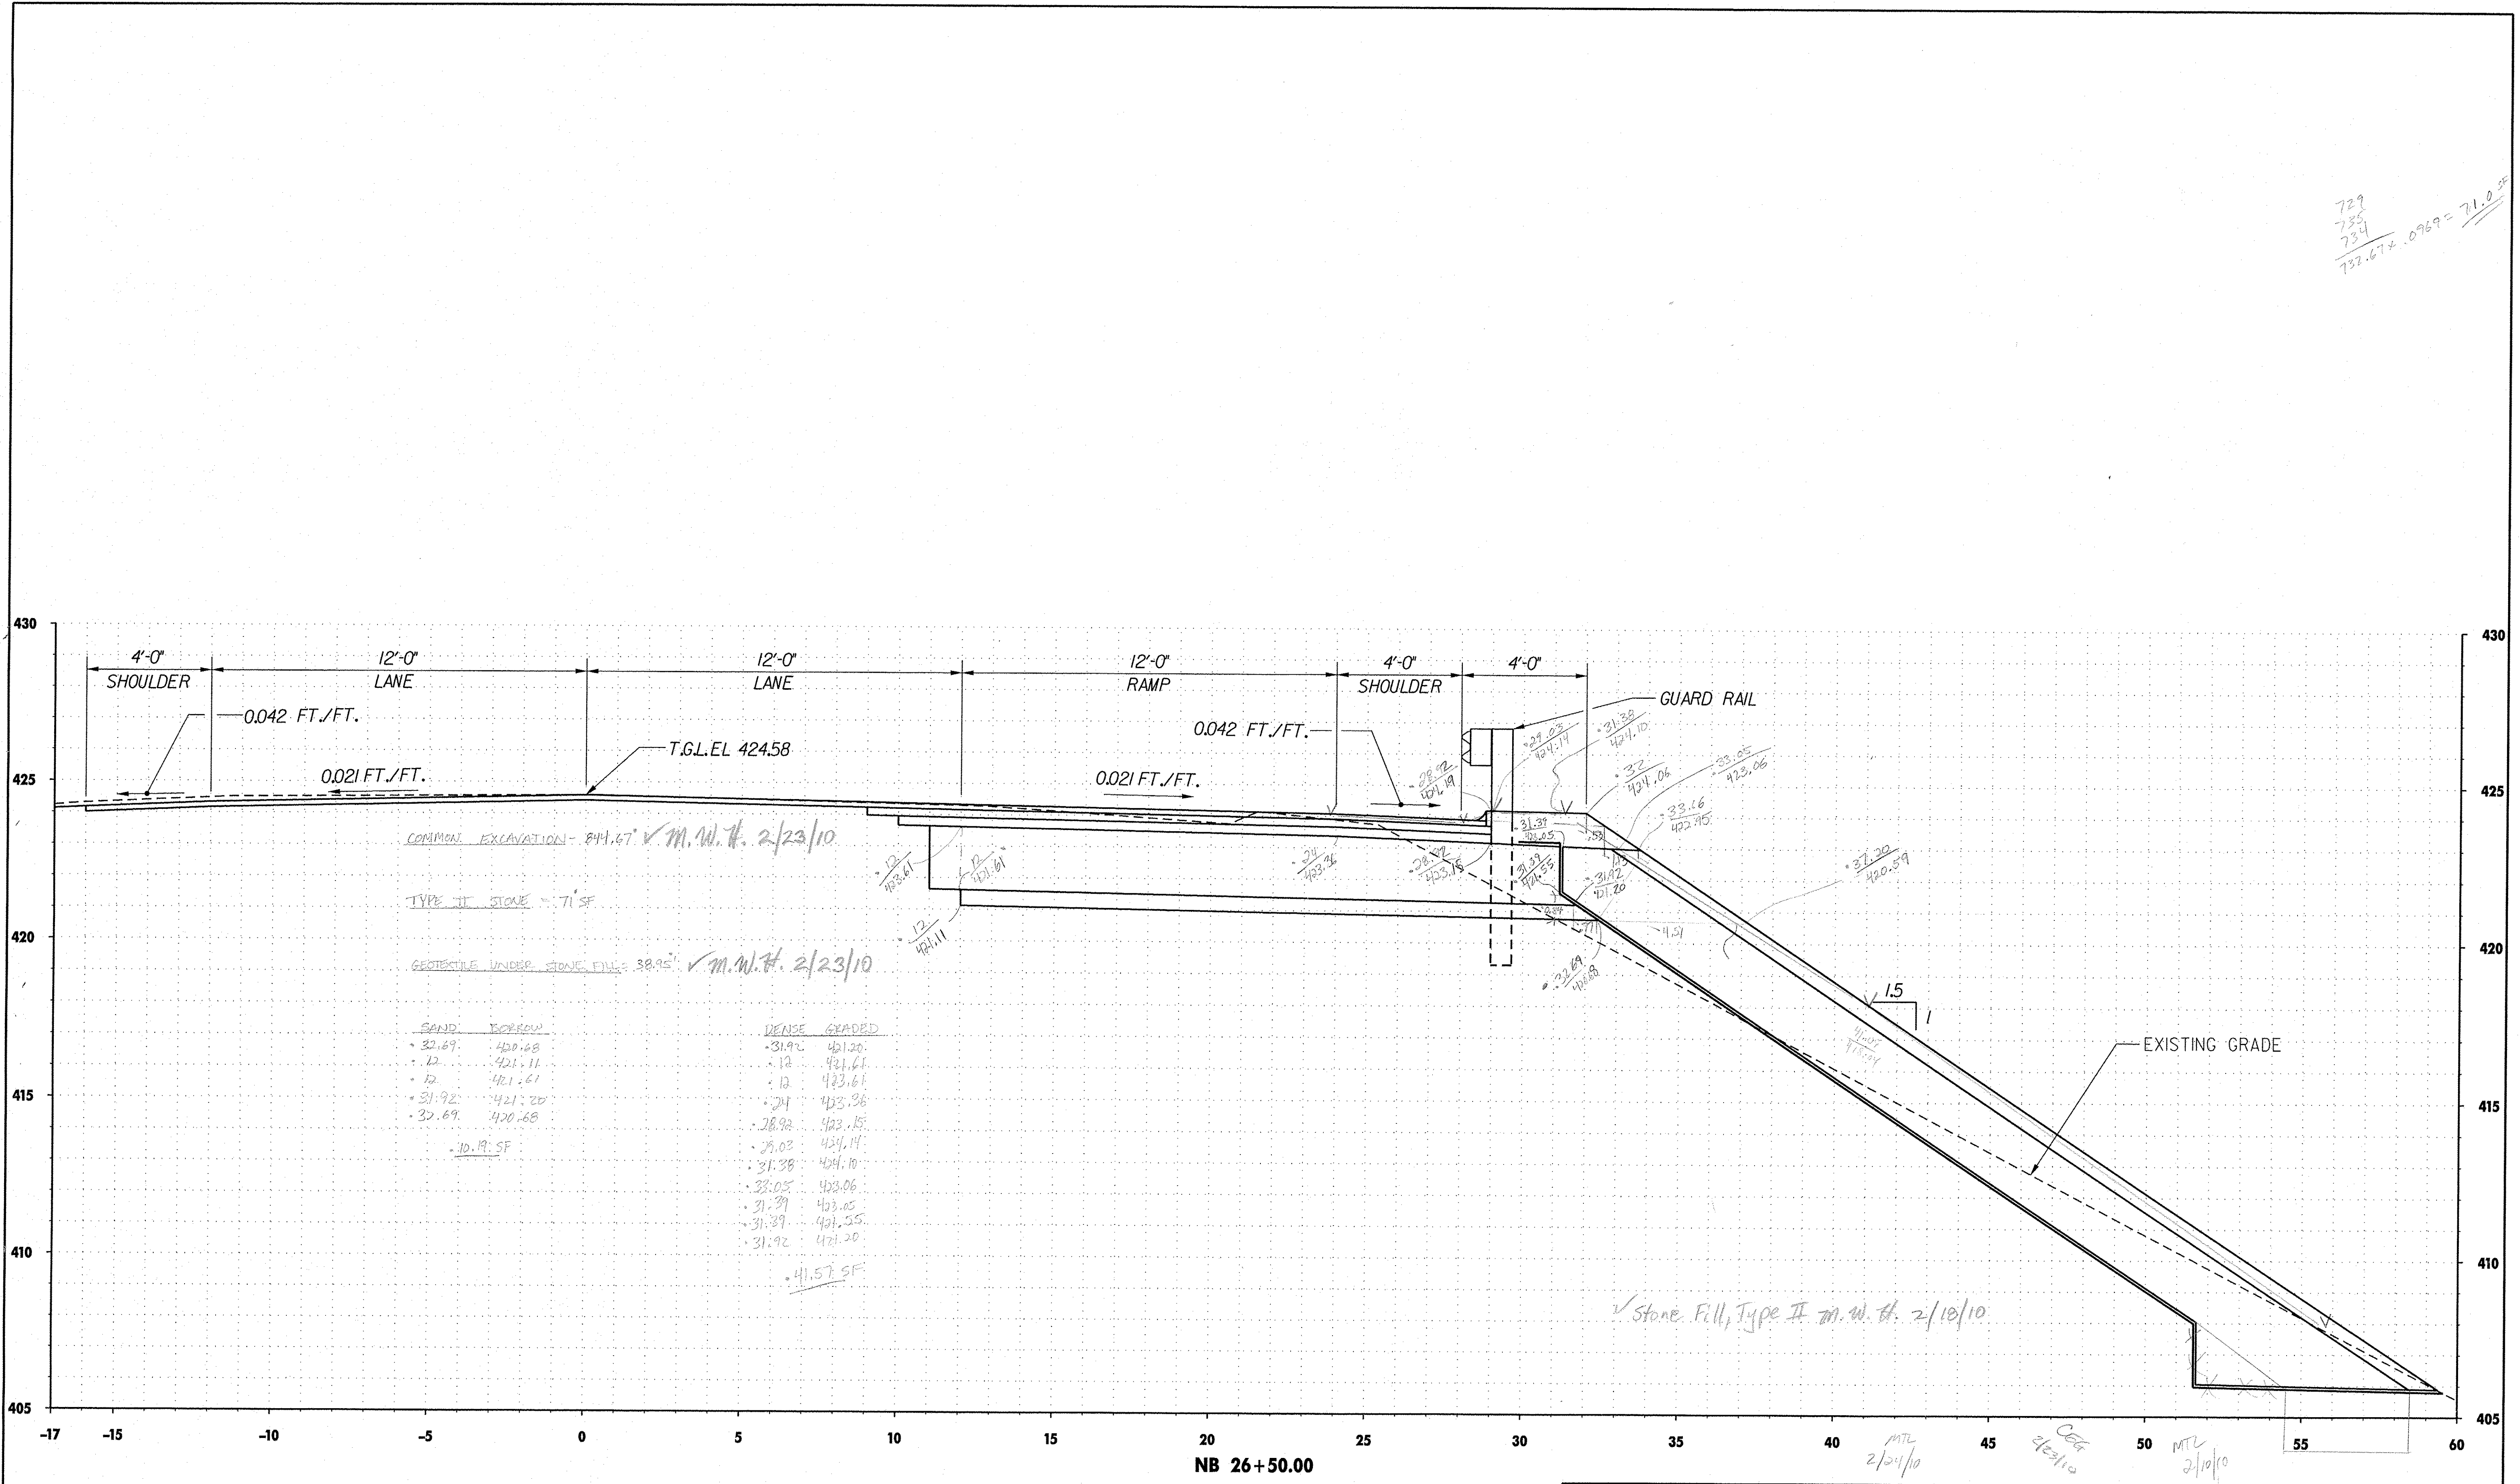

TVGA ENGINEERING, SURVEYING, P. C.

<b>STATE OF VERMONT</b> <b>AGENCY OF TRANSPORTATION</b>		Designed By	Drawn By
		Checked By	Bridge-Design Supervisor
Town Of	Bridge No.	PROJECT	PROJECT NO.
Highway No.	Log Sta.	GUILFORD	ACZM091-1(33)
	Surv. Sta.	TVGA CAD Drawing No.	Date
		Bridge Sheet No.	Sheet 9 of 17