



653
650
653
652 x .0969
63.18 SF

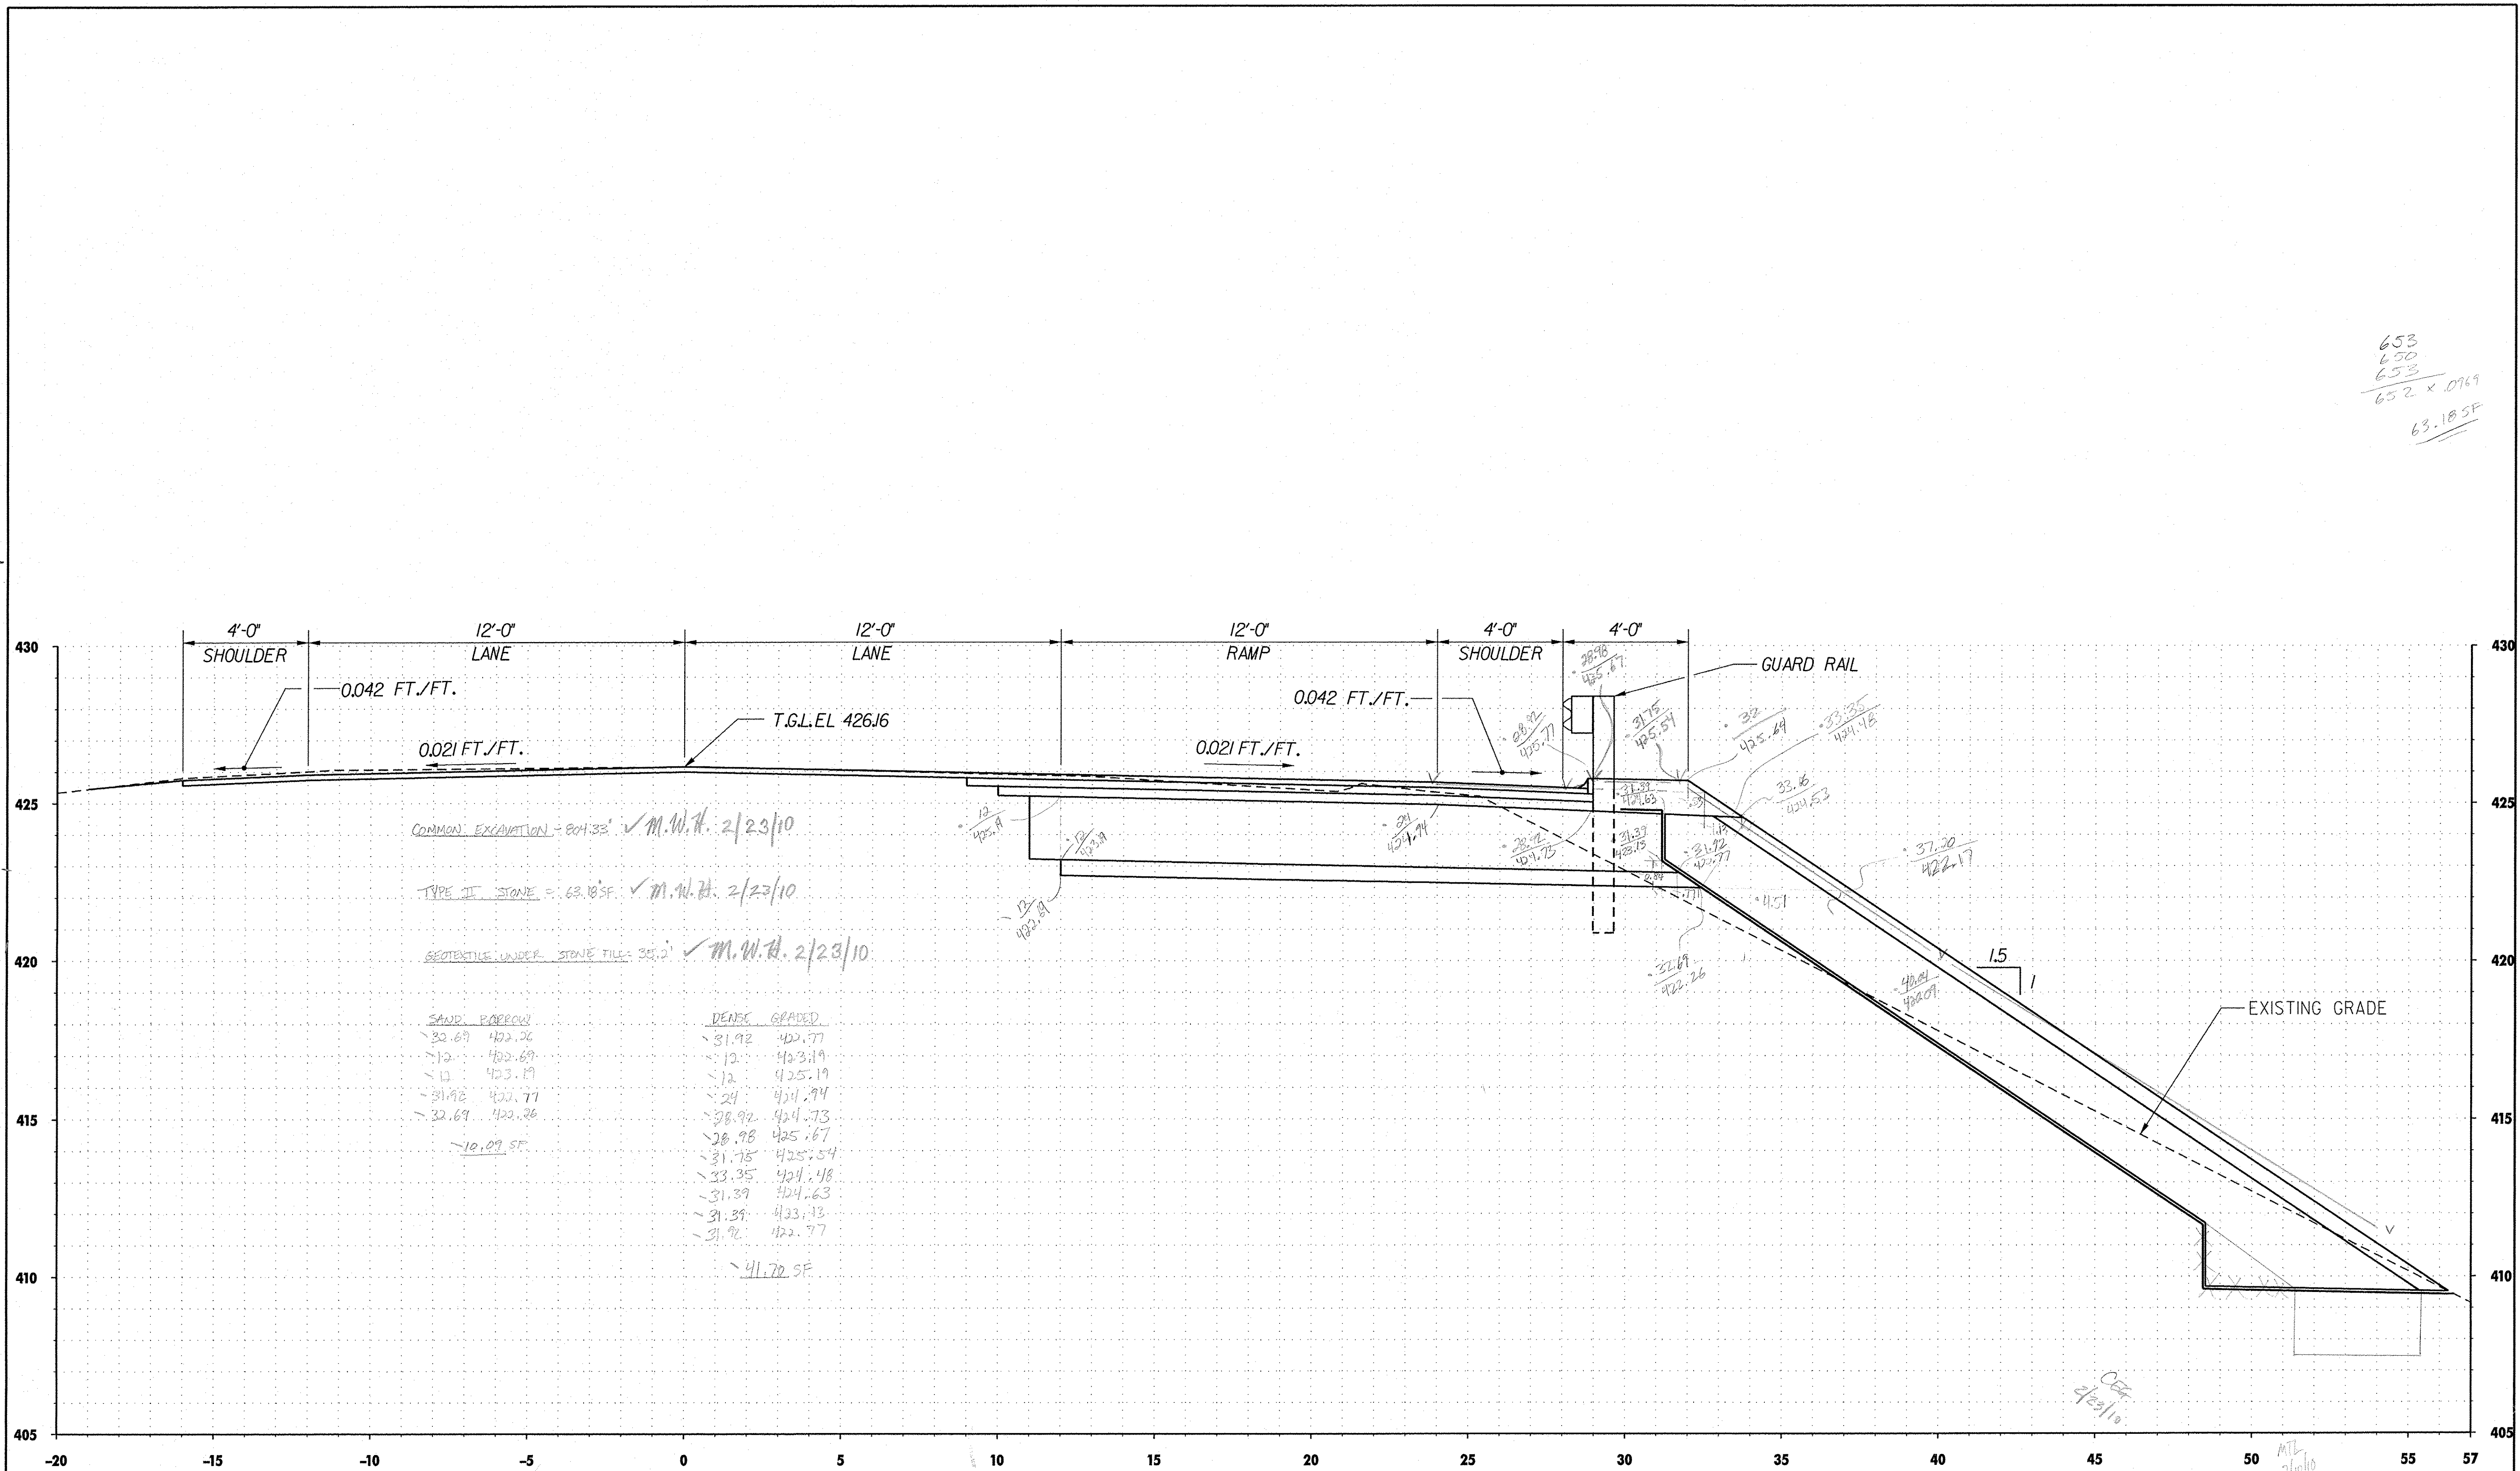

NB 27+00.00

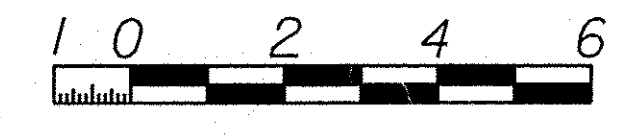

TVGA ENGINEERING, SURVEYING, P.C.

| STATE OF VERMONT AGENCY OF TRANSPORTATION | | | |
|--|------------|----------------------|--------------------------|
| Designed By | Date | Drawn By | Bridge Design Supervisor |
| Checked By | Date | | Date |
| Town Of | Bridge No. | PROJECT | PROJECT NO. |
| Highway No. | Log Sta. | (77116 FOR D) | ACEND91-1(93) |
| | Surv. Sta. | TVGA CAD Drawing No. | Date |
| | | Bridge Sheet No. | Sheet 10 of 17 |