



642
645
649
646.53 x .02%
6253 SF

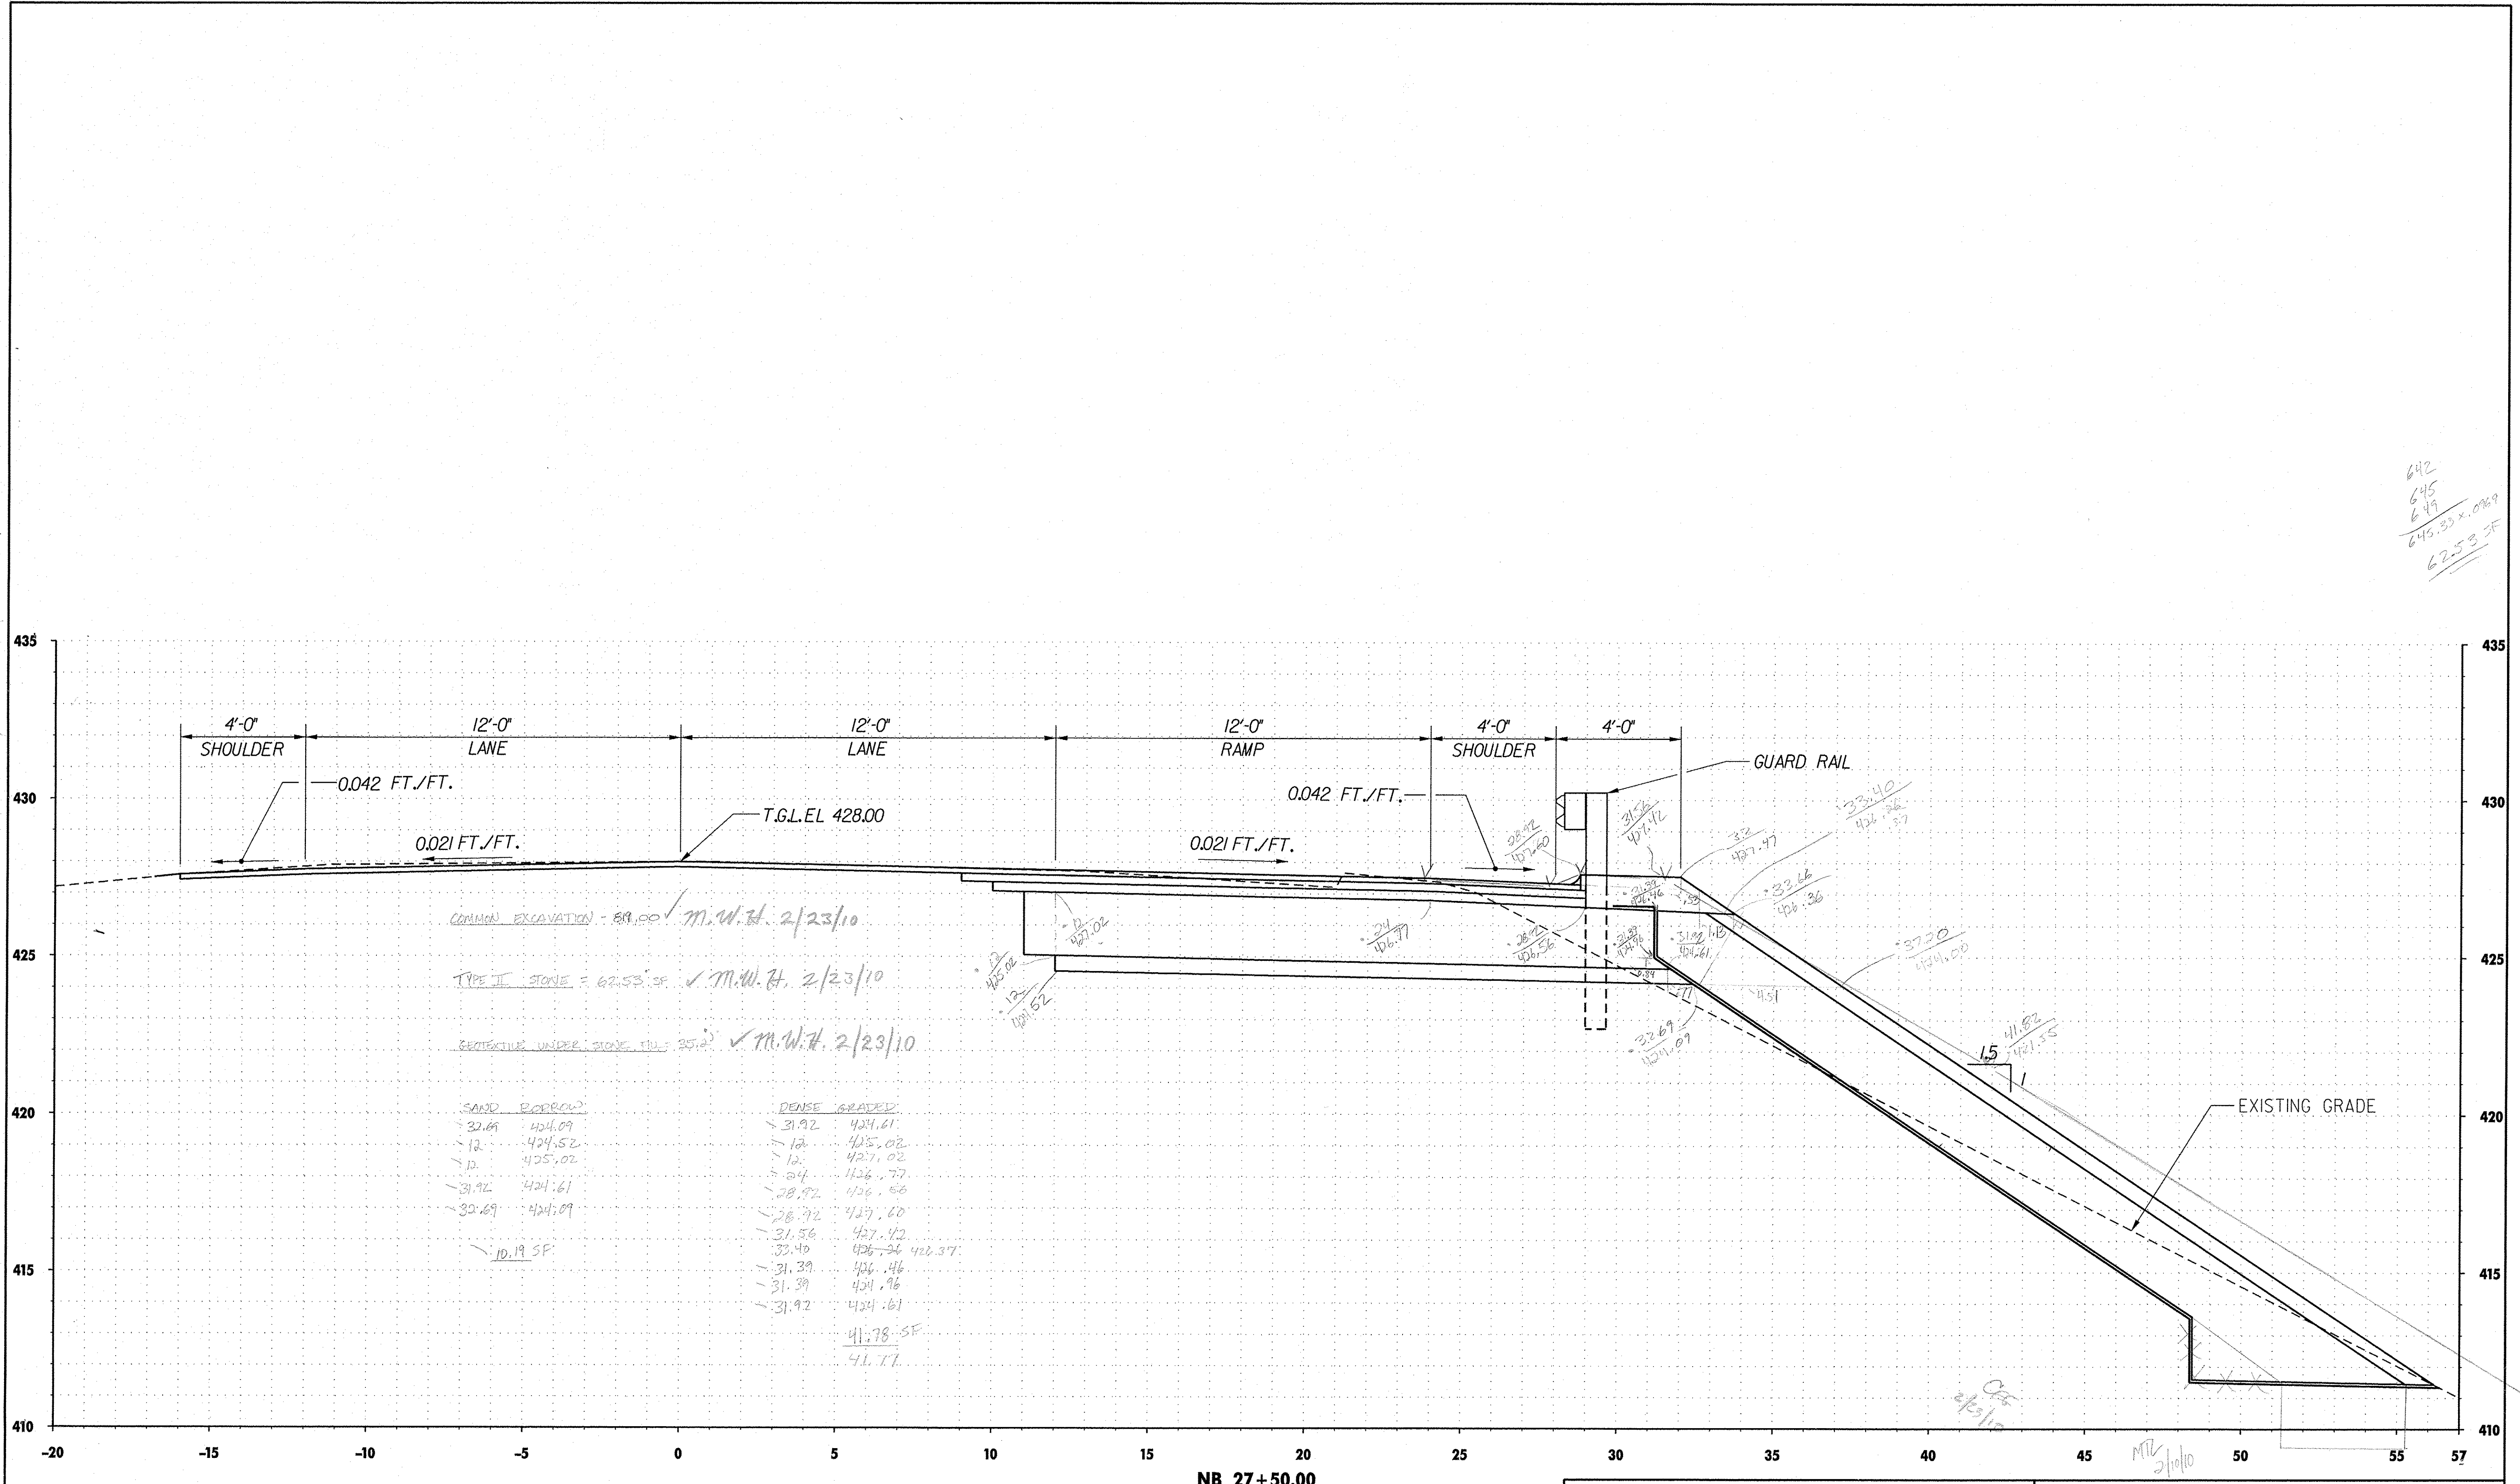


COMMON EXCAVATION = 89.00' M.W.H. 2/23/10
 TYPE II STONE = 62.53 SF ✓ M.W.H. 2/23/10
 GEOTEXTILE UNDER STONE 35.2' ✓ M.W.H. 2/23/10

SAND ROBBED		DENSE GRAVEL	
32.69	424.09	31.92	424.61
12	424.52	12	425.02
12	425.02	12	427.02
31.92	424.61	20.92	426.77
30.69	424.09	28.92	426.60
		28.92	427.60
		31.56	427.42
		32.40	426.24 422.37
		31.39	426.46
		31.39	424.96
		31.92	424.61
			41.78 SF
			41.17

NB 27+50.00

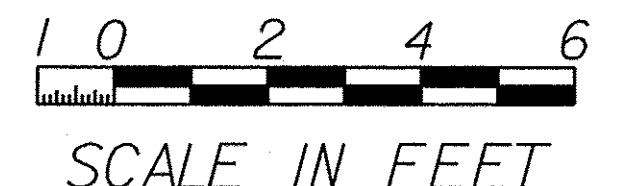

SCALE IN FEET

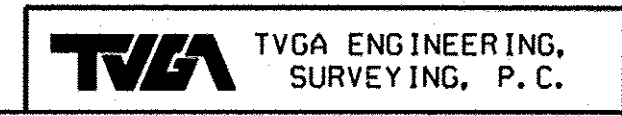

STATE OF VERMONT AGENCY OF TRANSPORTATION			
Designed By	Date	Drawn By	Bridge Design Supervisor
Checked By	Date		Date
Town Of	Bridge No.	PROJECT	PROJECT NO.
Highway No.	Log Sta.	Guilford	AC 20091-133
	Surv. Sta.	TVGA CAD Drawing No.	Date
		Bridge Sheet No.	Sheet 11 of 17