


634  
626  
632  
630.67 x 0.069 =  
41.11 SF

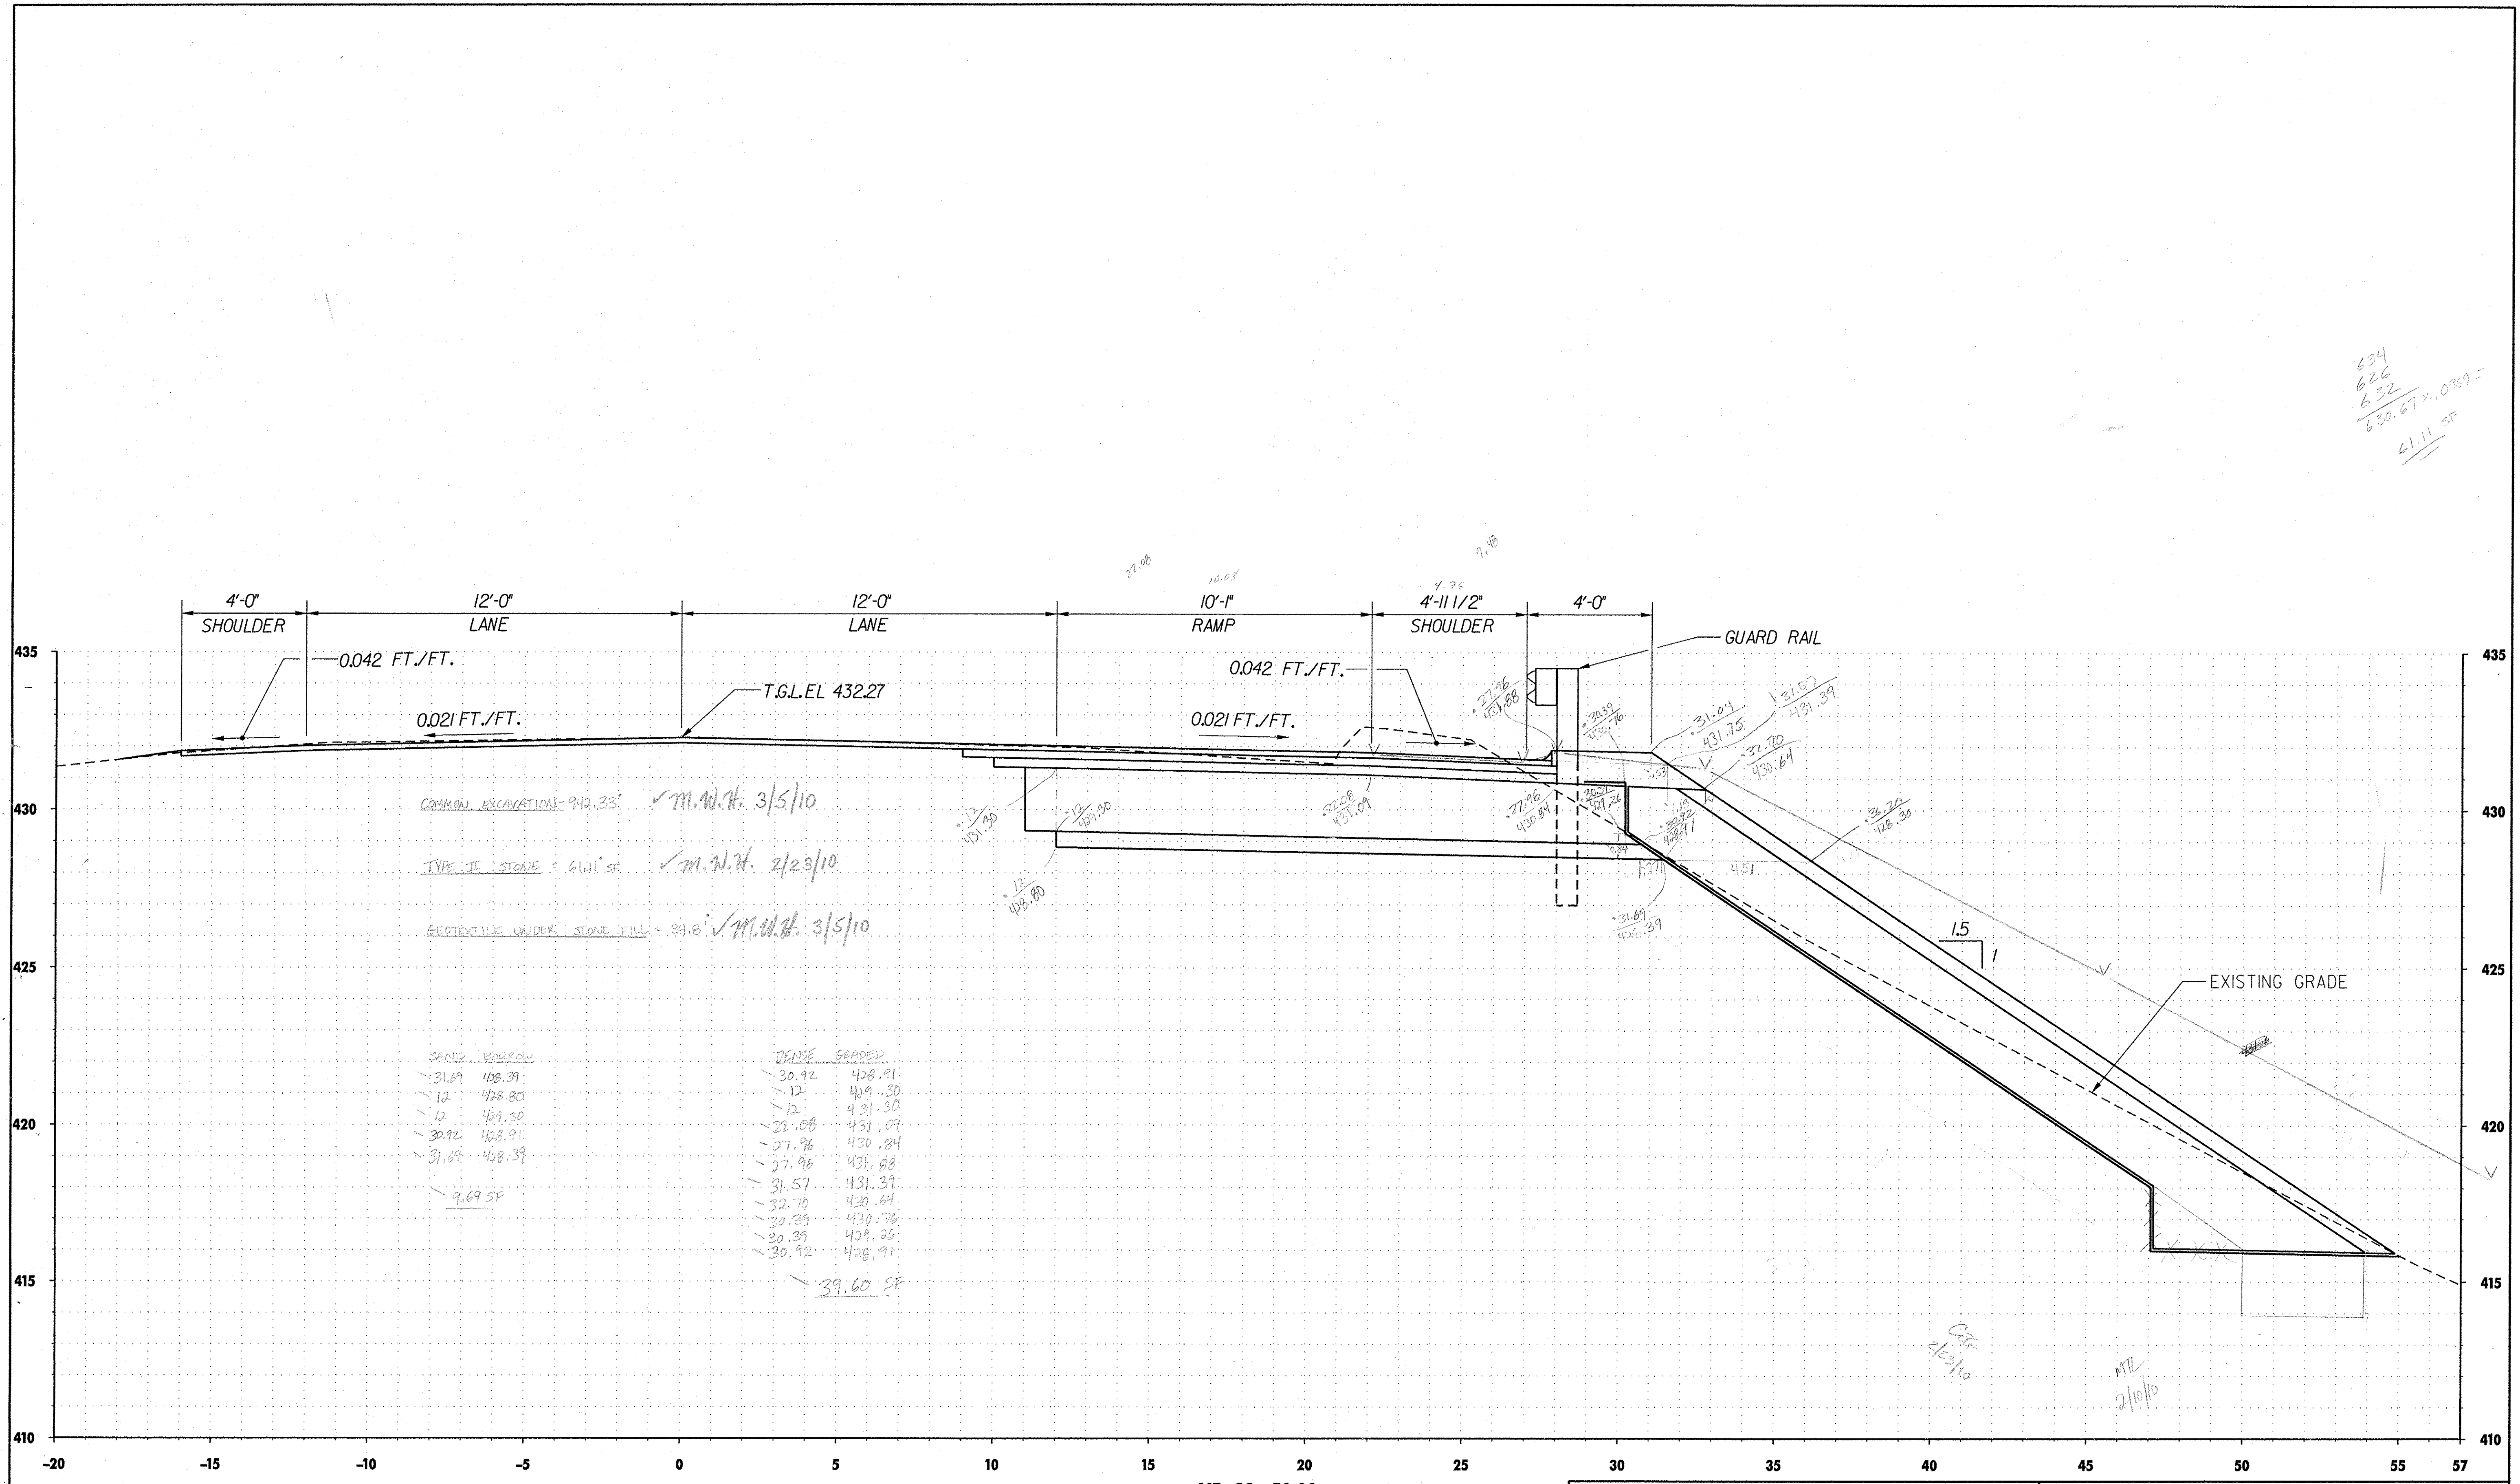

COMMON EXCAVATION = 942.33' ✓ M.W.H. 3/5/10  
 TYPE III STONE = 6411 SF ✓ M.W.H. 2/23/10  
 GEOTEXTILE UNDER STONE FILL = 29.8 ✓ M.W.H. 3/5/10

SAND BEDROCK		DENSE GRAVEL	
31.69	428.39	30.92	428.91
12	428.80	12	429.30
12	429.30	12	431.30
30.92	428.91	27.96	431.09
31.69	428.39	27.96	430.84
		27.96	431.08
		31.57	431.37
		32.70	430.64
		30.39	430.76
		30.39	429.26
		30.92	428.91
			39.60 SF

NB 28+50.00



TVGA ENGINEERING, SURVEYING, P. C.

<b>STATE OF VERMONT</b> <b>AGENCY OF TRANSPORTATION</b>		Designed By	Drawn By
		Checked By	Bridge Design Supervisor
Town Of	Bridge No.	PROJECT	PROJECT NO.
Highway No.	Log Sta.	Guilford	ACT 2009-1 (33)
	Surv. Sta.	TVGA CAD Drawing No.	Date
		Bridge Sheet No.	Sheet 13 of 17