


530
530
531
530.33 x 0.021 =
51.395F

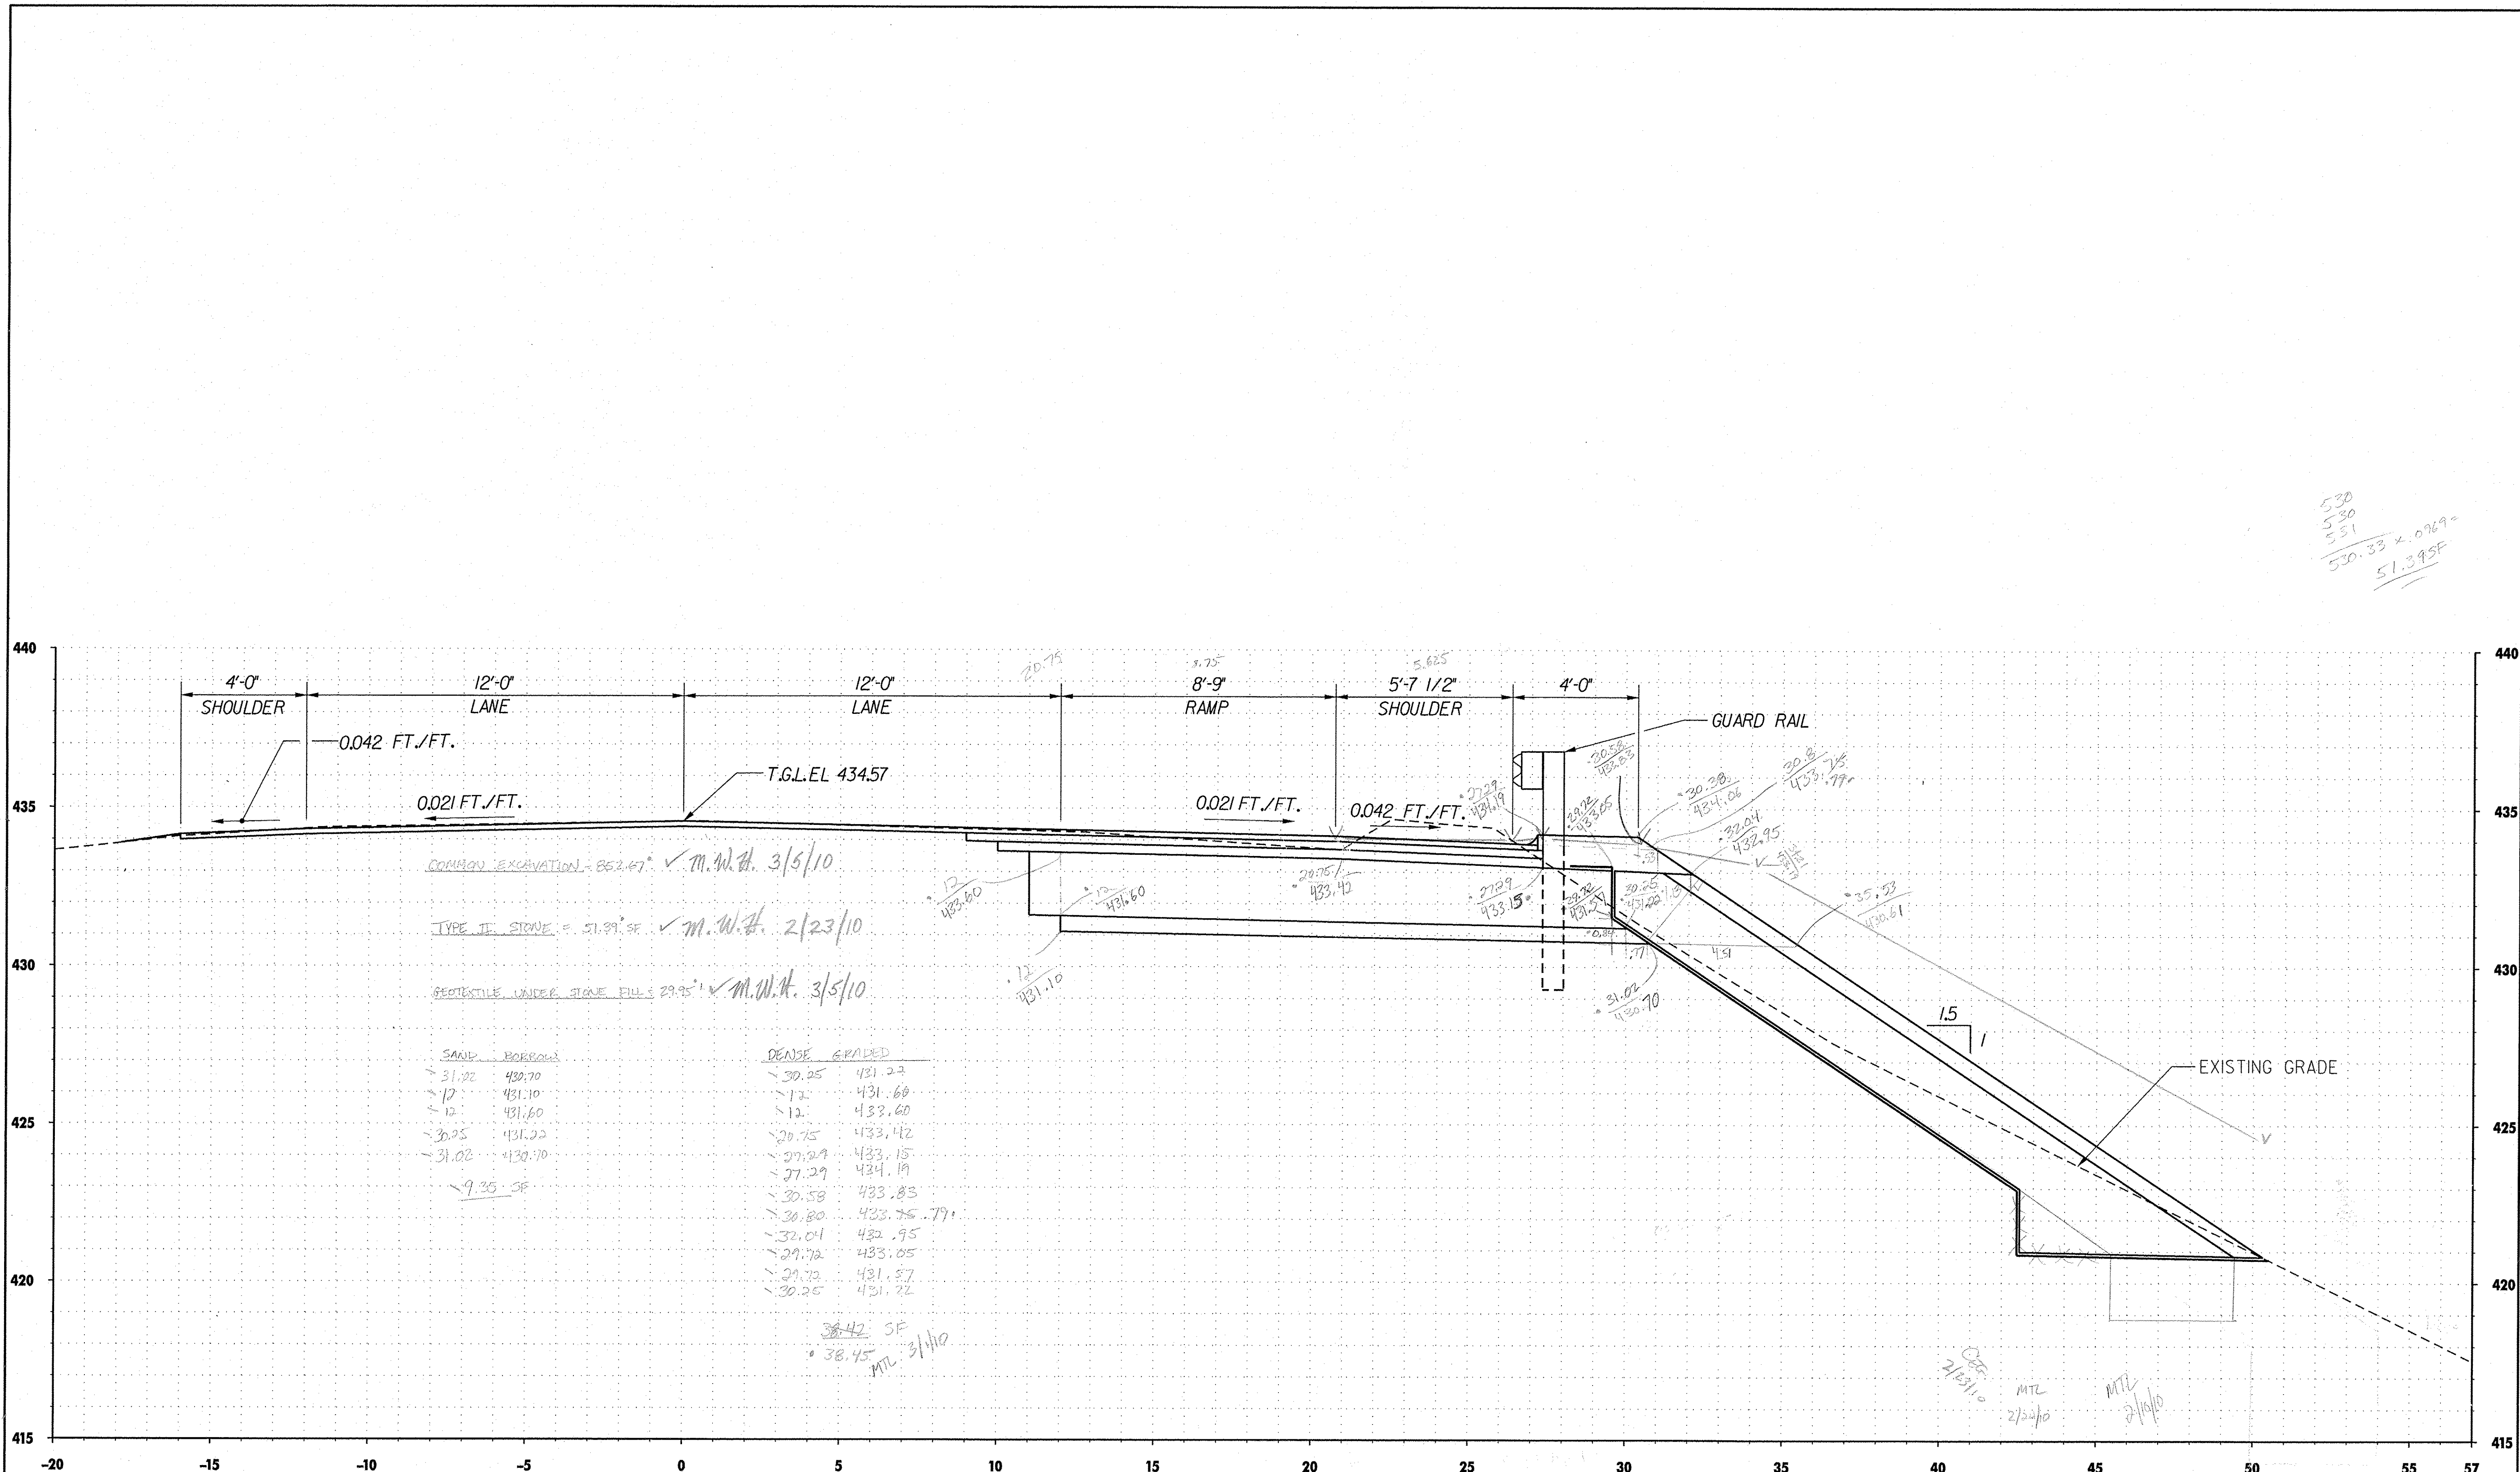


COMMON EXCAVATION - 862.47' ✓ M.W.H. 3/5/10
 TYPE II STONE = 51.99' SF ✓ M.W.H. 2/23/10
 GEOTEXTILE UNDER STONE FILL 23.95' ✓ M.W.H. 3/5/10

SAND BORINGS	DENSE GRAVEL
31.92 430.70	30.25 431.27
17 431.10	12 431.69
10 431.60	12 432.60
30.95 431.22	20.75 433.42
31.02 430.70	29.29 433.15
	27.29 434.19
9.35 SF	30.58 433.83
	30.80 433.75 .79
	32.04 432.95
	29.72 433.05
	29.73 431.57
	30.25 431.22

38.42 SF
 38.45 MTL 3/1/10

OFF: 2/15/10
 MTL 2/24/10
 MTL 2/10/10

NB 29+00.00

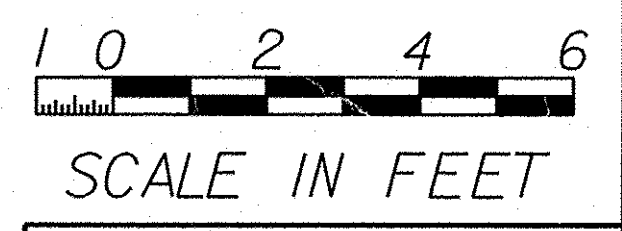

TVA TVGA ENGINEERING, SURVEYING, P. C.

STATE OF VERMONT AGENCY OF TRANSPORTATION		Designed By	Drawn By
		Checked By	Bridge Design Supervisor
Town Of	Bridge No.	PROJECT	PROJECT NO.
Highway No.	Log Sta.	GRANFORD	AC24091-(33)
	Surv. Sta.	TVGA CAD Drawing No.	Date
		Bridge Sheet No.	Sheet 14 of 17