


NO. 1  
 DATE: 1/1/88  
 DRAWN BY: J. W. BROWN  
 CHECKED BY: J. W. BROWN  
 PROJECT: GULFEND JN 091-1/88

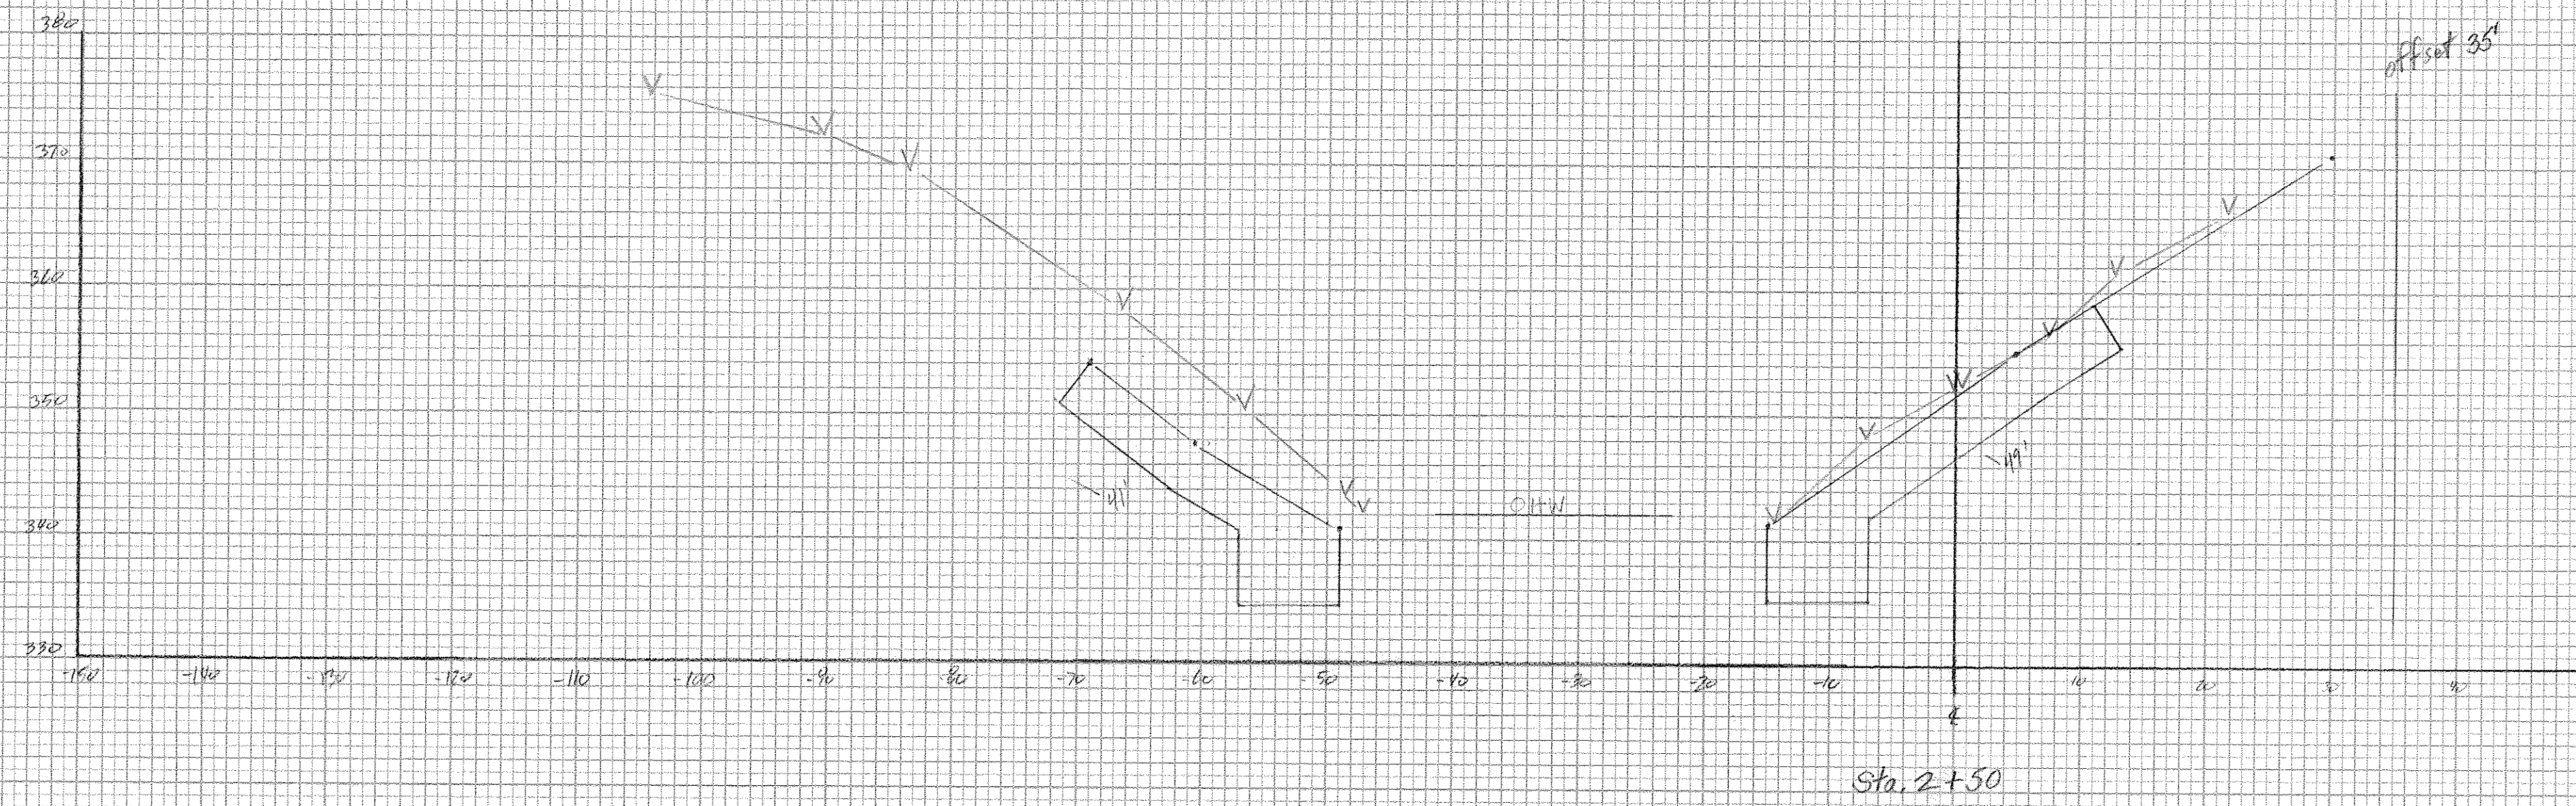


$\begin{matrix} 89 \\ 85 \\ 89 \\ \hline 172.89 \text{ SF} \end{matrix}$ 
 $\begin{matrix} 111 \\ 108 \\ 105 \\ \hline 167.4 \text{ SF} \end{matrix}$

UNCLASSIFIED CHANNEL - 303.28 SF To Calc. Folder Page 203.27-1  
 TYPE II STONE - 303.28 SF To Calc. Folder, Page 613.13-1  
 GEOTEXTILE UNDER STONE FILL - 70'

Sta. 2+50

NO. 2  
 DATE: 1/1/88  
 DRAWN BY: J. W. BROWN  
 CHECKED BY: J. W. BROWN  
 PROJECT: GULFEND JN 091-1/88

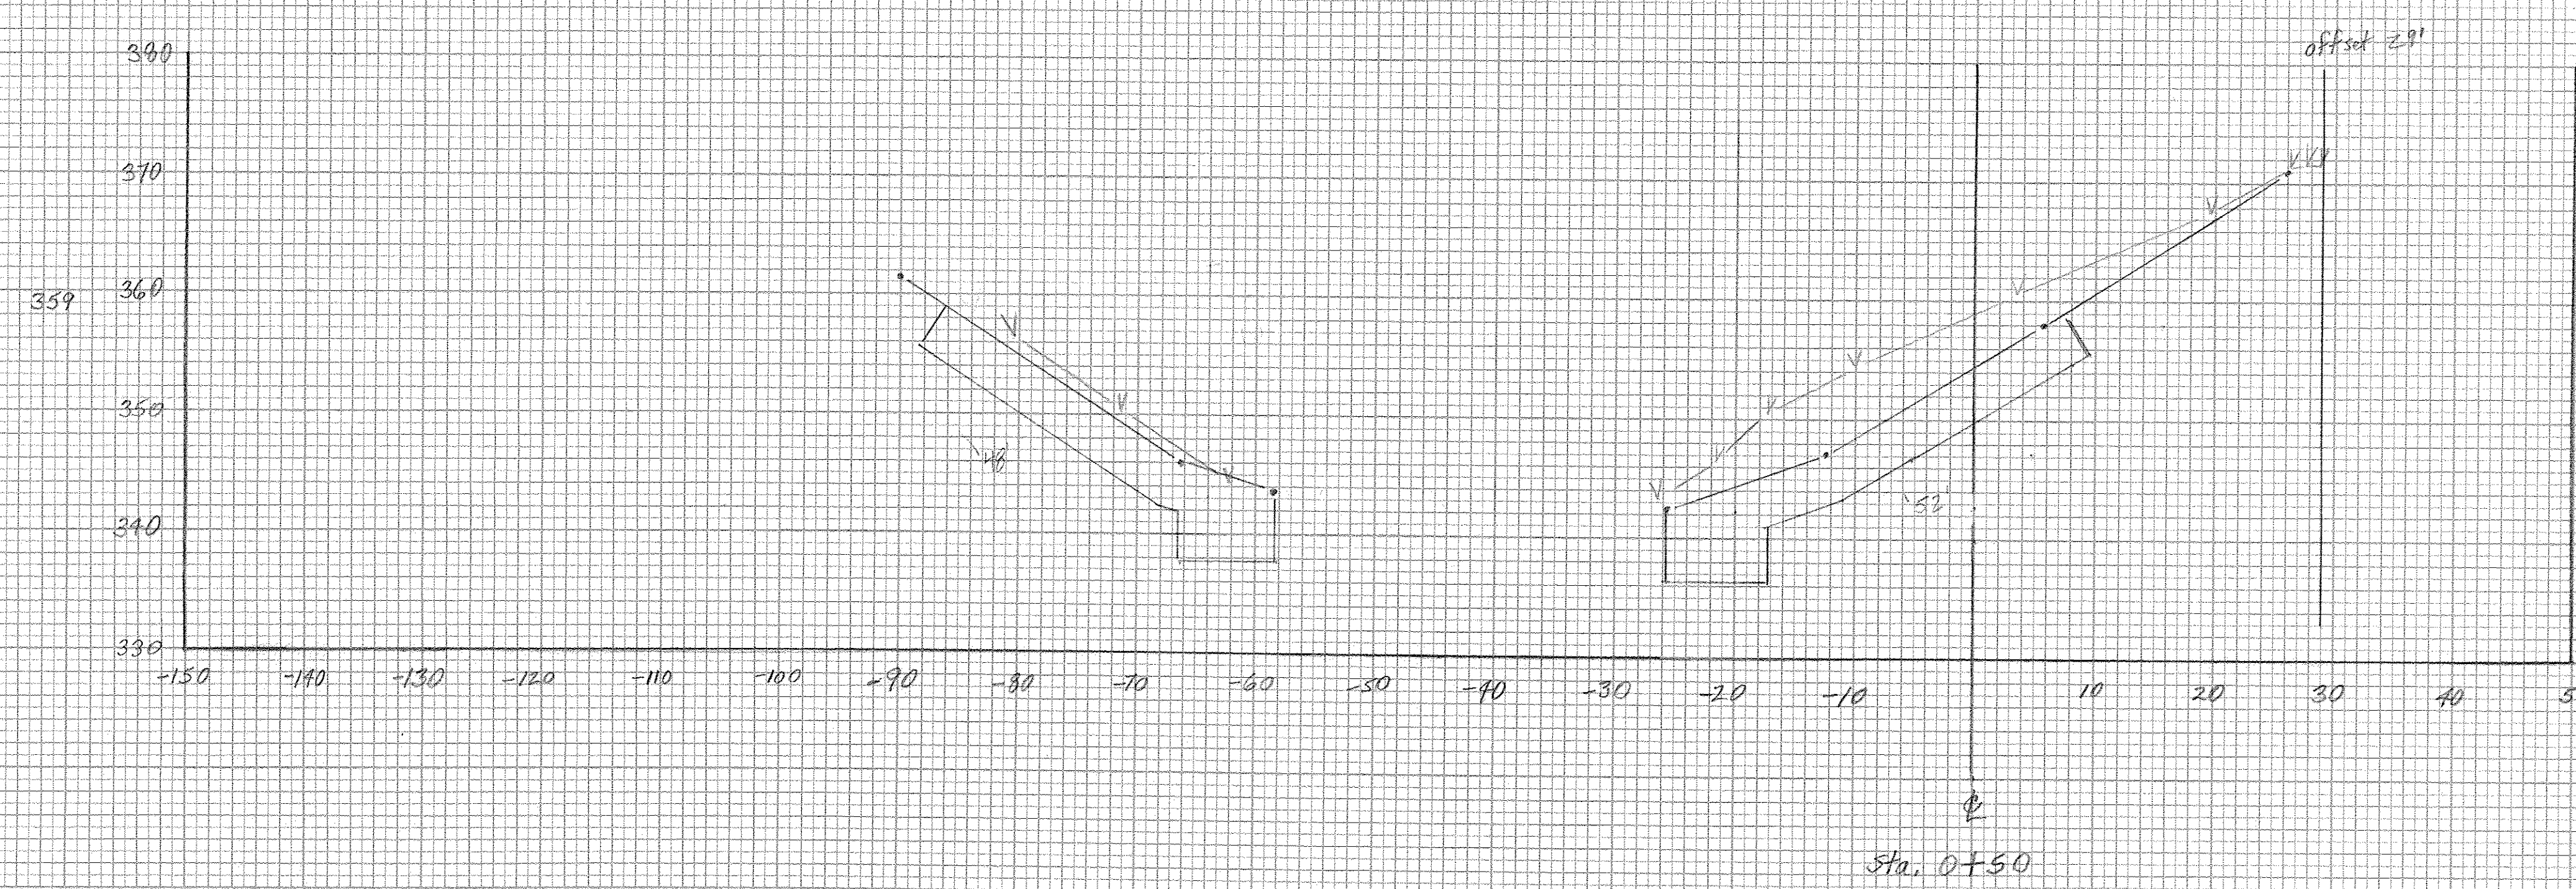

$\begin{matrix} 114 \\ 115 \\ 118 \\ \hline 179.28 \text{ SF} \end{matrix}$ 
 $\begin{matrix} 100 \\ 102 \\ 109 \\ \hline 162.68 \text{ SF} \end{matrix}$

UNCLASSIFIED CHANNEL - 339.96 SF To Calc. Folder Page 203.27-1  
 TYPE II STONE - 339.96 SF To Calc. Folder, Page 613.13-1  
 GEOTEXTILE UNDER STONE FILL - 100'

Sta. 0+50