

FINGER PLATE LAYOUT


BILL OF MATERIALS				
QTY	MARK	SHAPE	LENGTH	REMARKS
1	6F1	FINGER		
1	6p1	Plate 2 1/4 x 24"	16'-0"	
64		7/8" Hexhead Bolts x 3 1/2" lg with nut		
1	6F2	FINGER		
1	6p2	Plate 2 1/4 x 24"	8'-4"	
32		7/8" Hexhead Bolts x 3 1/2" lg with nut		
1	6F3	FINGER		
1	6p3	Plate 2 1/4 x 24"	19'-8"	
78		7/8" Hexhead Bolts x 3 1/2" lg with nut		

TVGA CONSULTANTS


NO EXCEPTIONS TAKEN     REJECTED  
 FURNISH AS CORRECTED  
 REVISE AND RESUBMIT

ENGINEER has reviewed Shop Drawings and Samples and other data which Contractor is required to submit, only for conformance with the information given in the Contract Documents and compatibility with the design concept of the completed Project as a functioning whole as indicated in the Contract Documents. Such reviews do not extend to means, methods, techniques, sequences or procedures of construction or to safety precautions and programs incident thereto. Such reviews do not extend to any LEED certification or accreditation. Contractor is responsible for dimensions to be confirmed and correlated at the job site; for information that pertains solely to the fabrication processes or to techniques of construction; and for coordination of the work of...

BY: *[Signature]*  
DATE: 8/31/2009

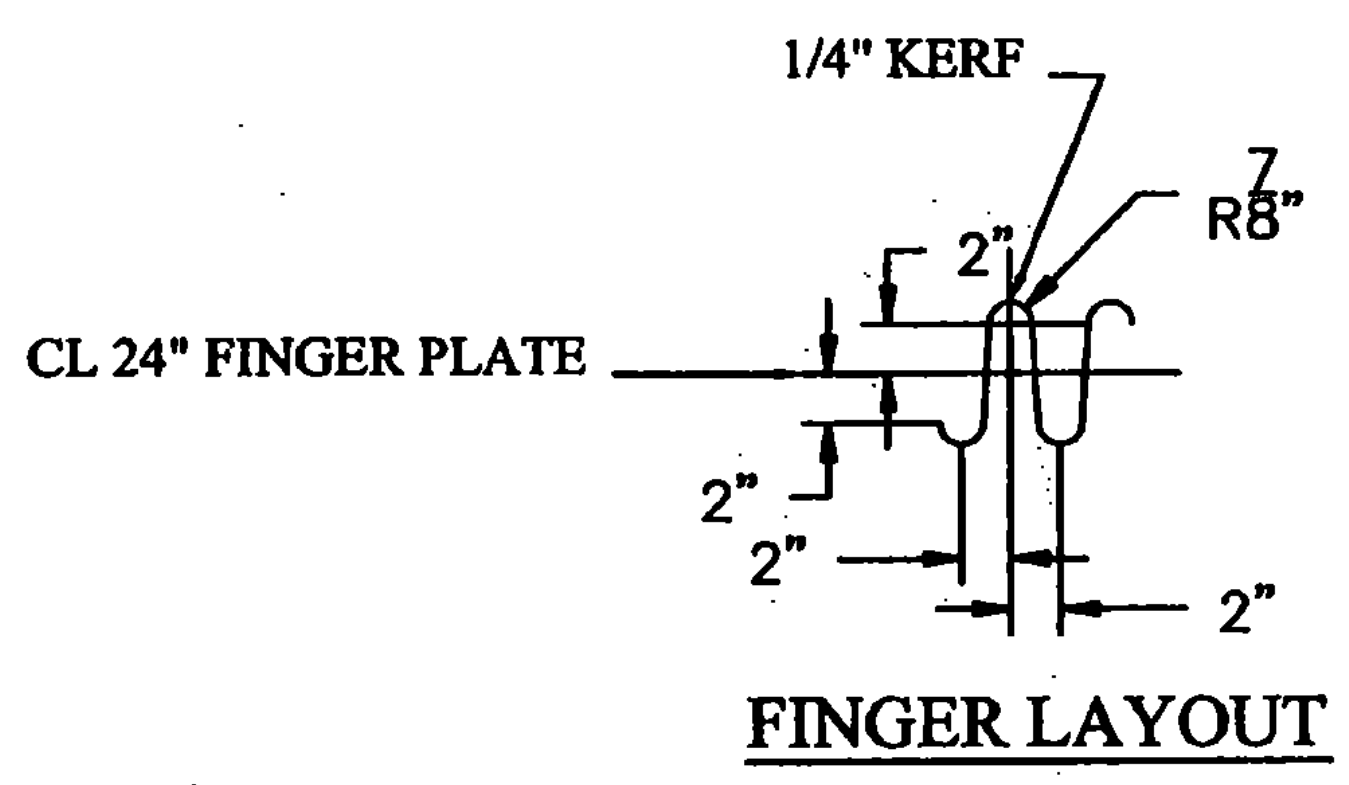

FINGER LAYOUT

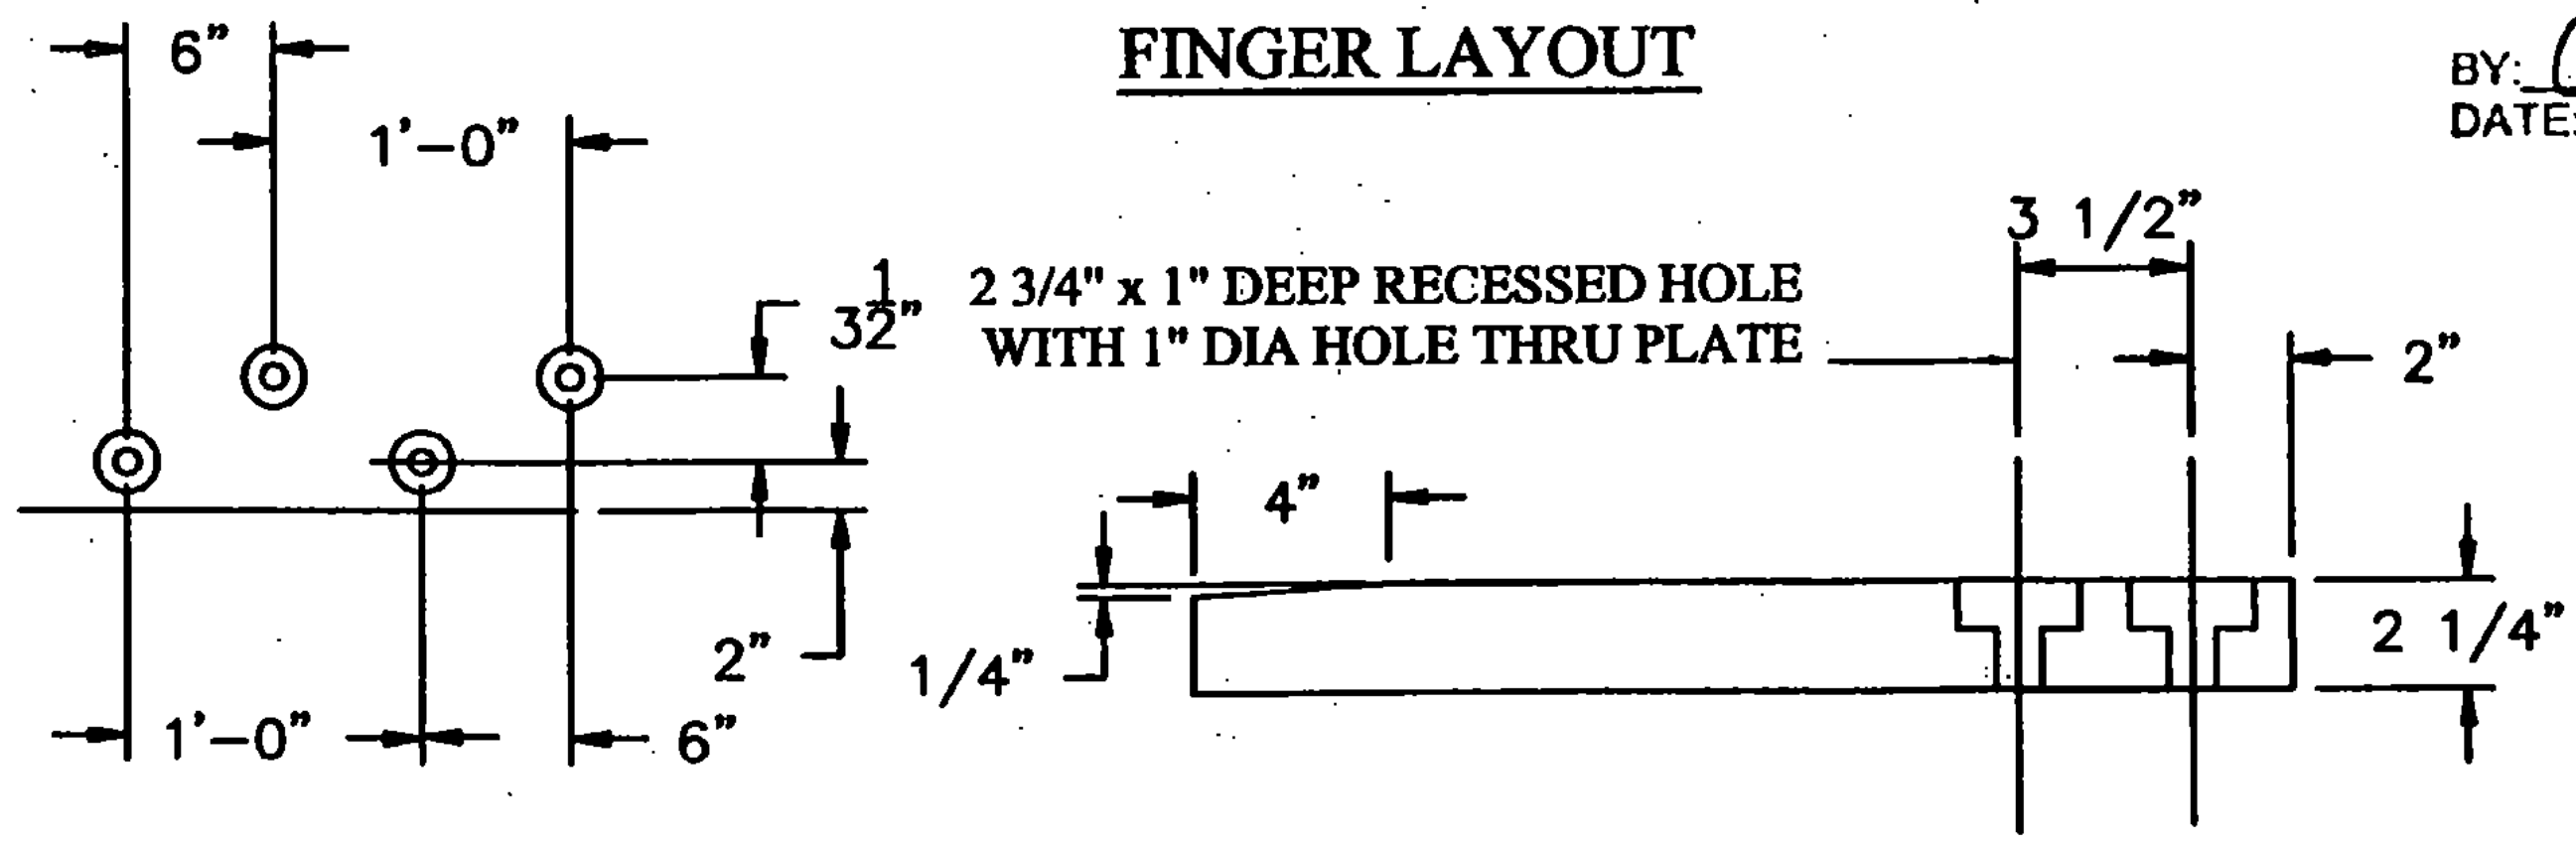

HOLE LAYOUT

DETAIL FINGERS

DRAWING COVERS	
<b>FINGERS DETAIL (3N)</b>	
PROJECT	GULFORD IN 091-1(33)
LOCATION	I-91 OVER BROAD BROOK & BROAD BROOK ROAD
ENGINEER	VERMONT AGENCY OF TRANSPORTATION
CUSTOMER	J.A. McDONALD

REV NO.	DATE	DESCRIPTION
1	3-23-2009	REVISED PER APPROVAL COMMENTS
0	11-24-2008	SUBMITTED FOR APPROVAL

HOLES AS NOTED  
MATERIAL: AASHTO M 270 GRADE 50 GALV.

**MERRIMACK SHEET METAL**

119 HALL STREET  
CONCORD NH 03301

Tel. 603.224.7766  
Fax 603.224.7925

DRAWN BY: RL  
CHECKED BY: JD  
JOB NO: #2353  
DWG: F6