



TYP. "ABUT 2" DIAPHRAGM
 BAY 1 (SHOWN) LOOKING AHEAD STATION
 OTHER BAYS (SIMILAR)


TVGA CONSULTANTS
 NO EXCEPTIONS TAKEN
 FURNISH AS CORRECTED
 REVISE AND RESUBMIT
 ENGINEER has reviewed Shop Drawings and Samples and other data which Contractor is required to furnish, only for conformance with the information given in the Contract Documents and compliance with the design concept of the Contract Documents. Such review is not intended to insure, in whole or in part, the safety, propriety or procedure of methods, techniques, sequences or procedures of construction or to certify the contractor or any subcontractor or any other person. Contractor is responsible for obtaining all necessary permits and for coordination of the work of all trades.
 BY: *[Signature]*
 DATE: 2/24/2009

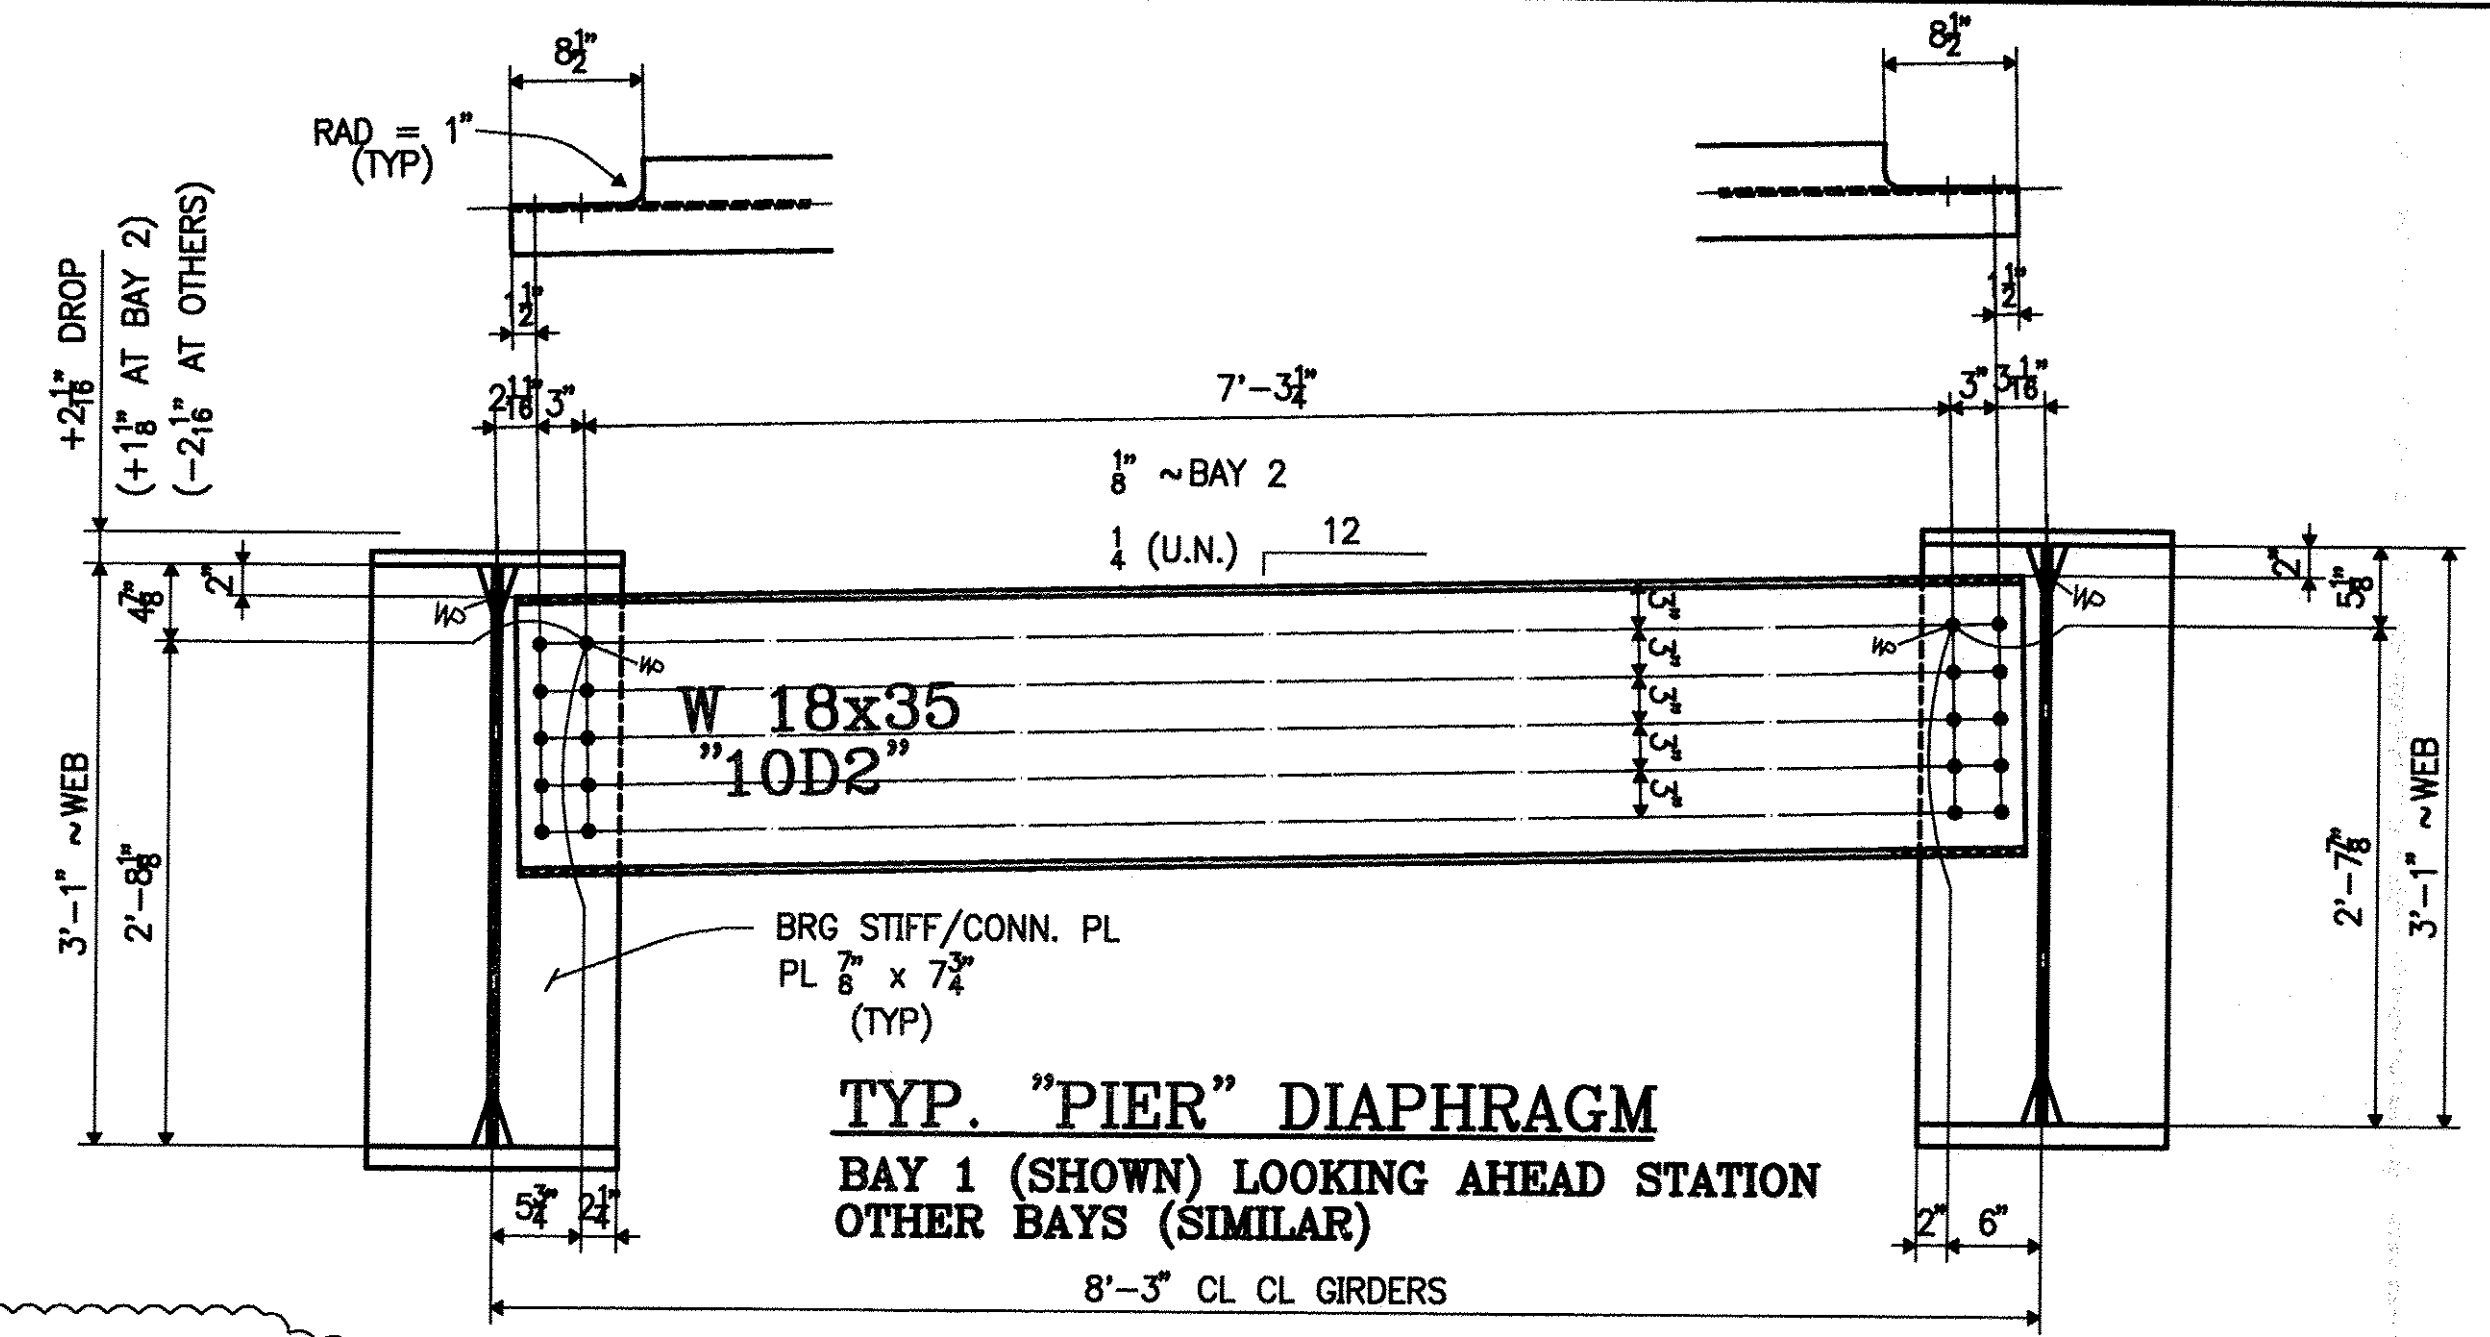

TYP. "PIER" DIAPHRAGM
 BAY 1 (SHOWN) LOOKING AHEAD STATION
 OTHER BAYS (SIMILAR)

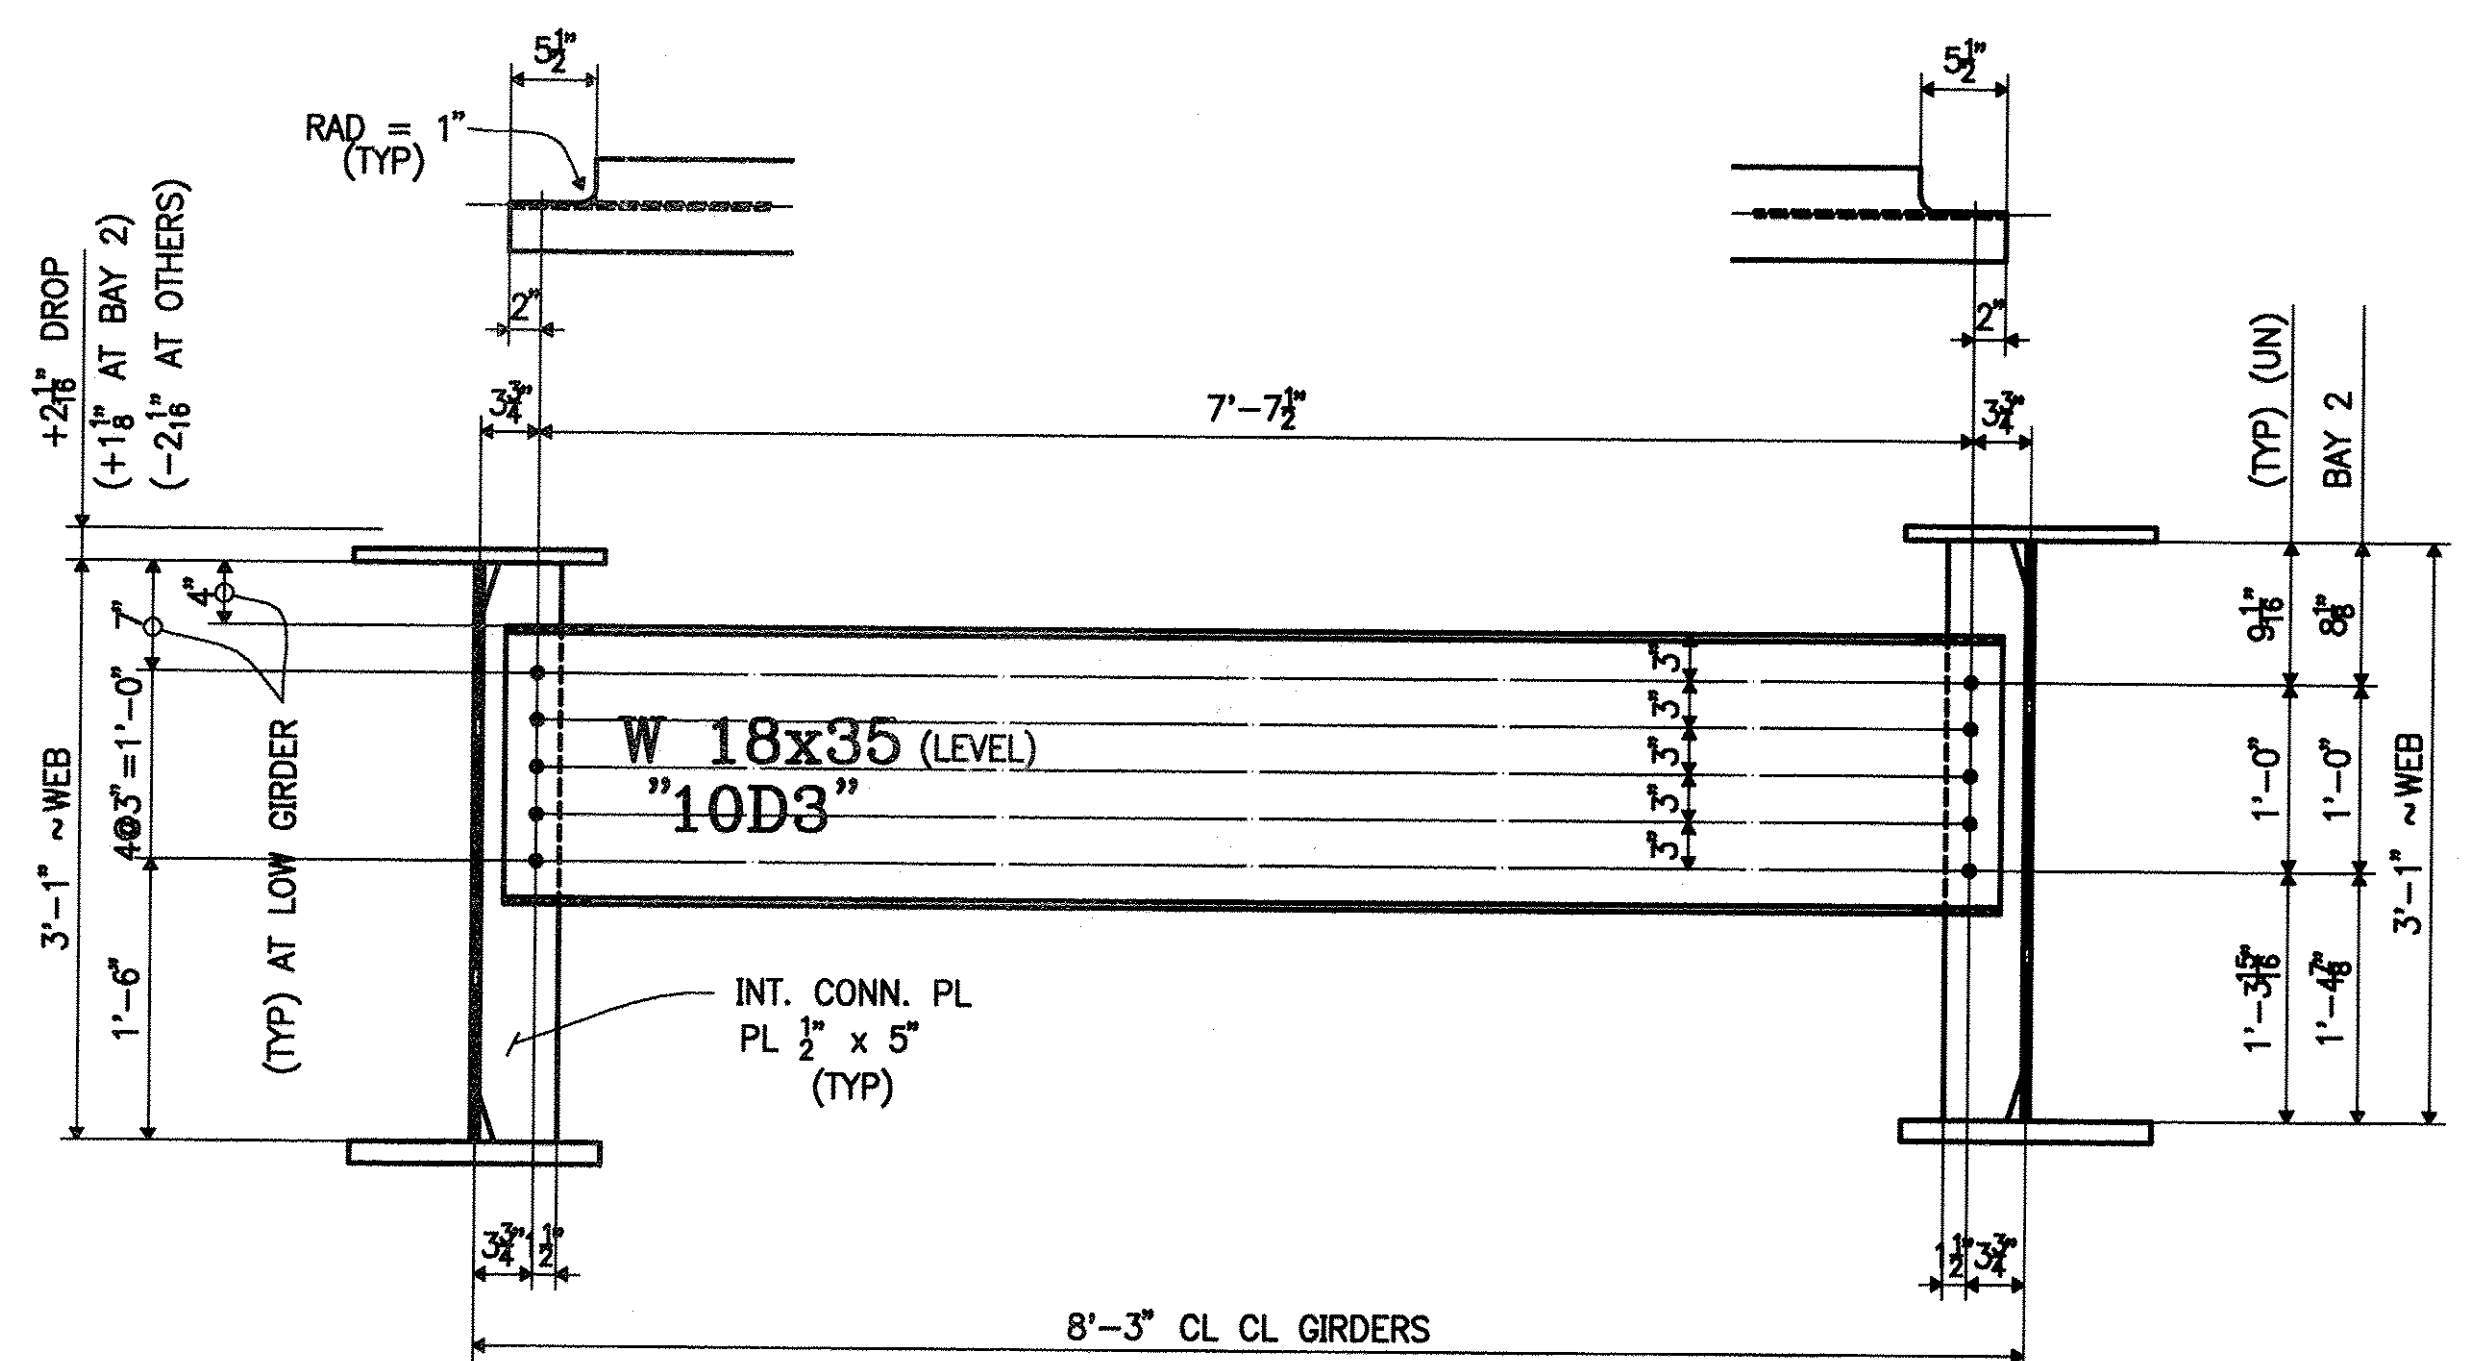

TYP. "INT." DIAPHRAGM
 BAY 1 (SHOWN) LOOKING AHEAD STATION
 OTHER BAYS (SIMILAR)

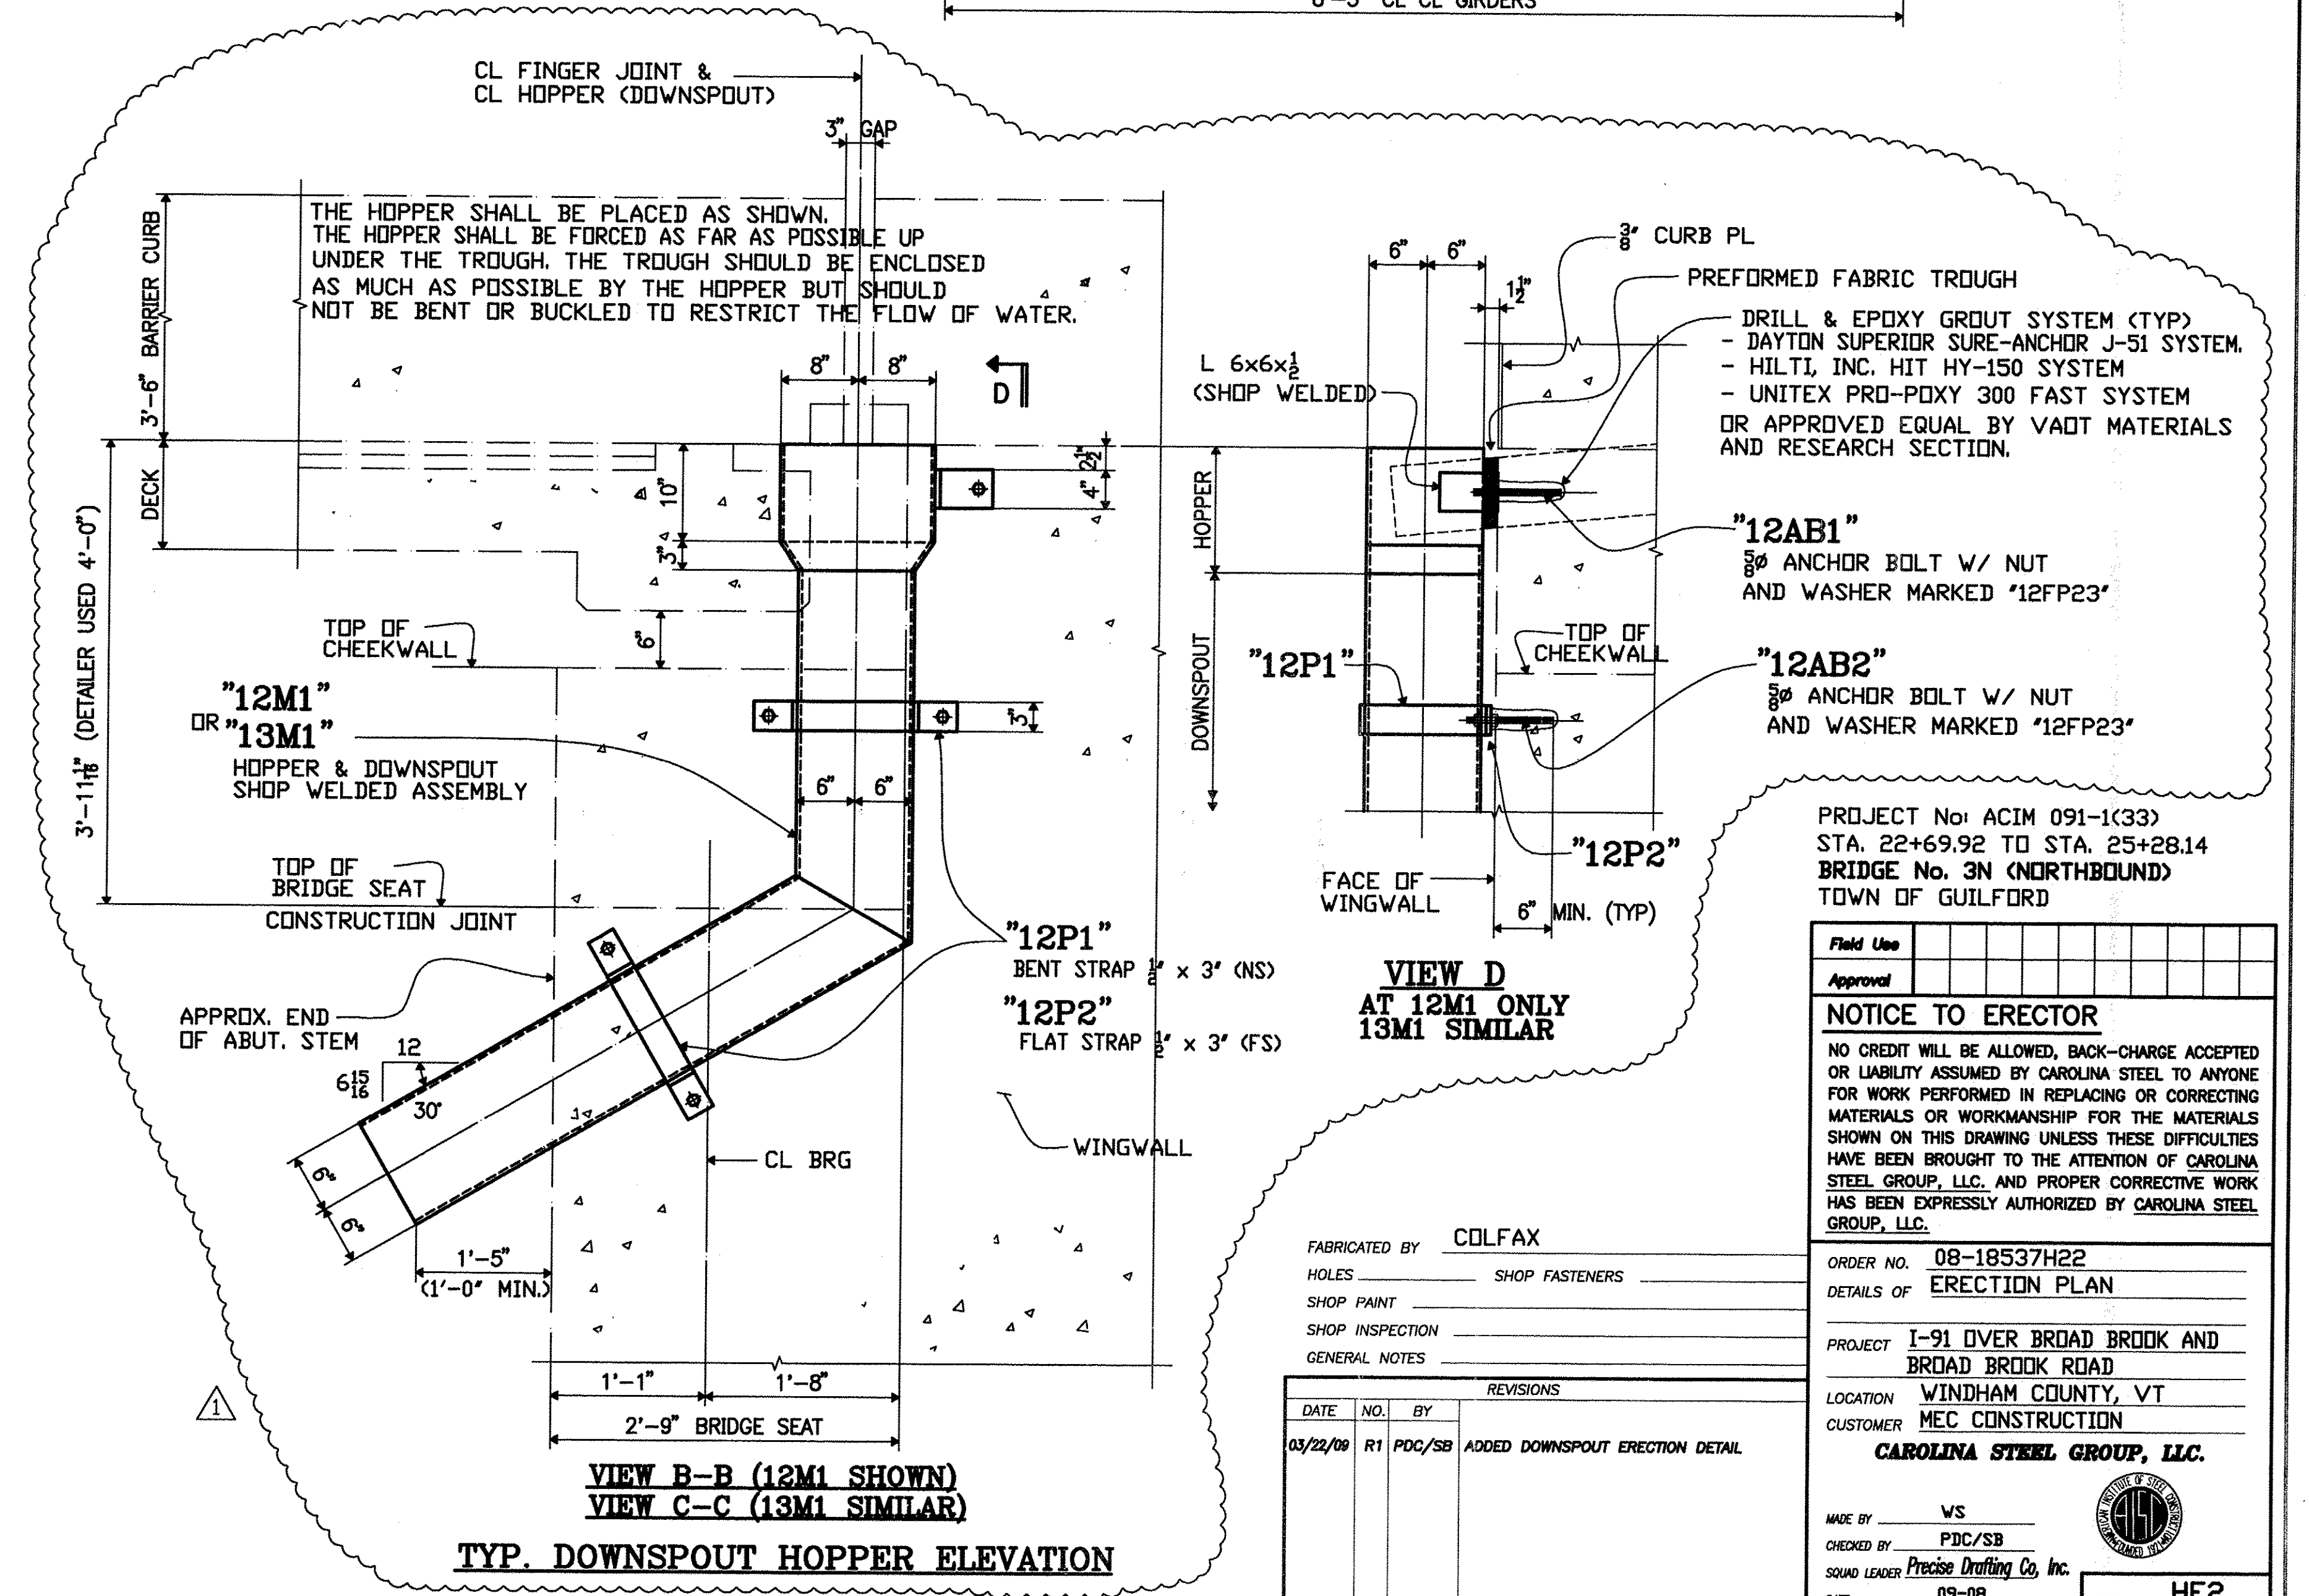

TYP. DOWNSPOUT HOPPER ELEVATION
 VIEW B-B (12M1 SHOWN)
 VIEW C-C (13M1 SIMILAR)

FABRICATED BY COLFAX
 HOLES SHOP FASTENERS
 SHOP PAINT
 SHOP INSPECTION
 GENERAL NOTES

REVISIONS			
DATE	NO.	BY	DESCRIPTION
03/22/09	R1	PDC/SB	ADDED DOWNSPOUT ERECTION DETAIL

PROJECT No: ACIM 091-1(33)
 STA. 22+69.92 TO STA. 25+28.14
 BRIDGE No. 3N (NORTHBOUND)
 TOWN OF GUILFORD

Field Use	Approval
NOTICE TO ERECTOR	
NO CREDIT WILL BE ALLOWED, BACK-CHARGE ACCEPTED OR LIABILITY ASSUMED BY CAROLINA STEEL TO ANYONE FOR WORK PERFORMED IN REPLACING OR CORRECTING MATERIALS OR WORKMANSHIP FOR THE MATERIALS SHOWN ON THIS DRAWING UNLESS THESE DIFFICULTIES HAVE BEEN BROUGHT TO THE ATTENTION OF CAROLINA STEEL GROUP, LLC, AND PROPER CORRECTIVE WORK HAS BEEN EXPRESSLY AUTHORIZED BY CAROLINA STEEL GROUP, LLC.	
ORDER NO.	08-18537H22
DETAILS OF	ERECTION PLAN
PROJECT	I-91 OVER BROAD BROOK AND BROAD BROOK ROAD
LOCATION	WINDHAM COUNTY, VT
CUSTOMER	MEC CONSTRUCTION
CAROLINA STEEL GROUP, LLC.	
MADE BY	WS
CHECKED BY	PDC/SB
SOUND LEADER	Precise Drafting Co, Inc.
DATE	09-08
SHEET	HE2