
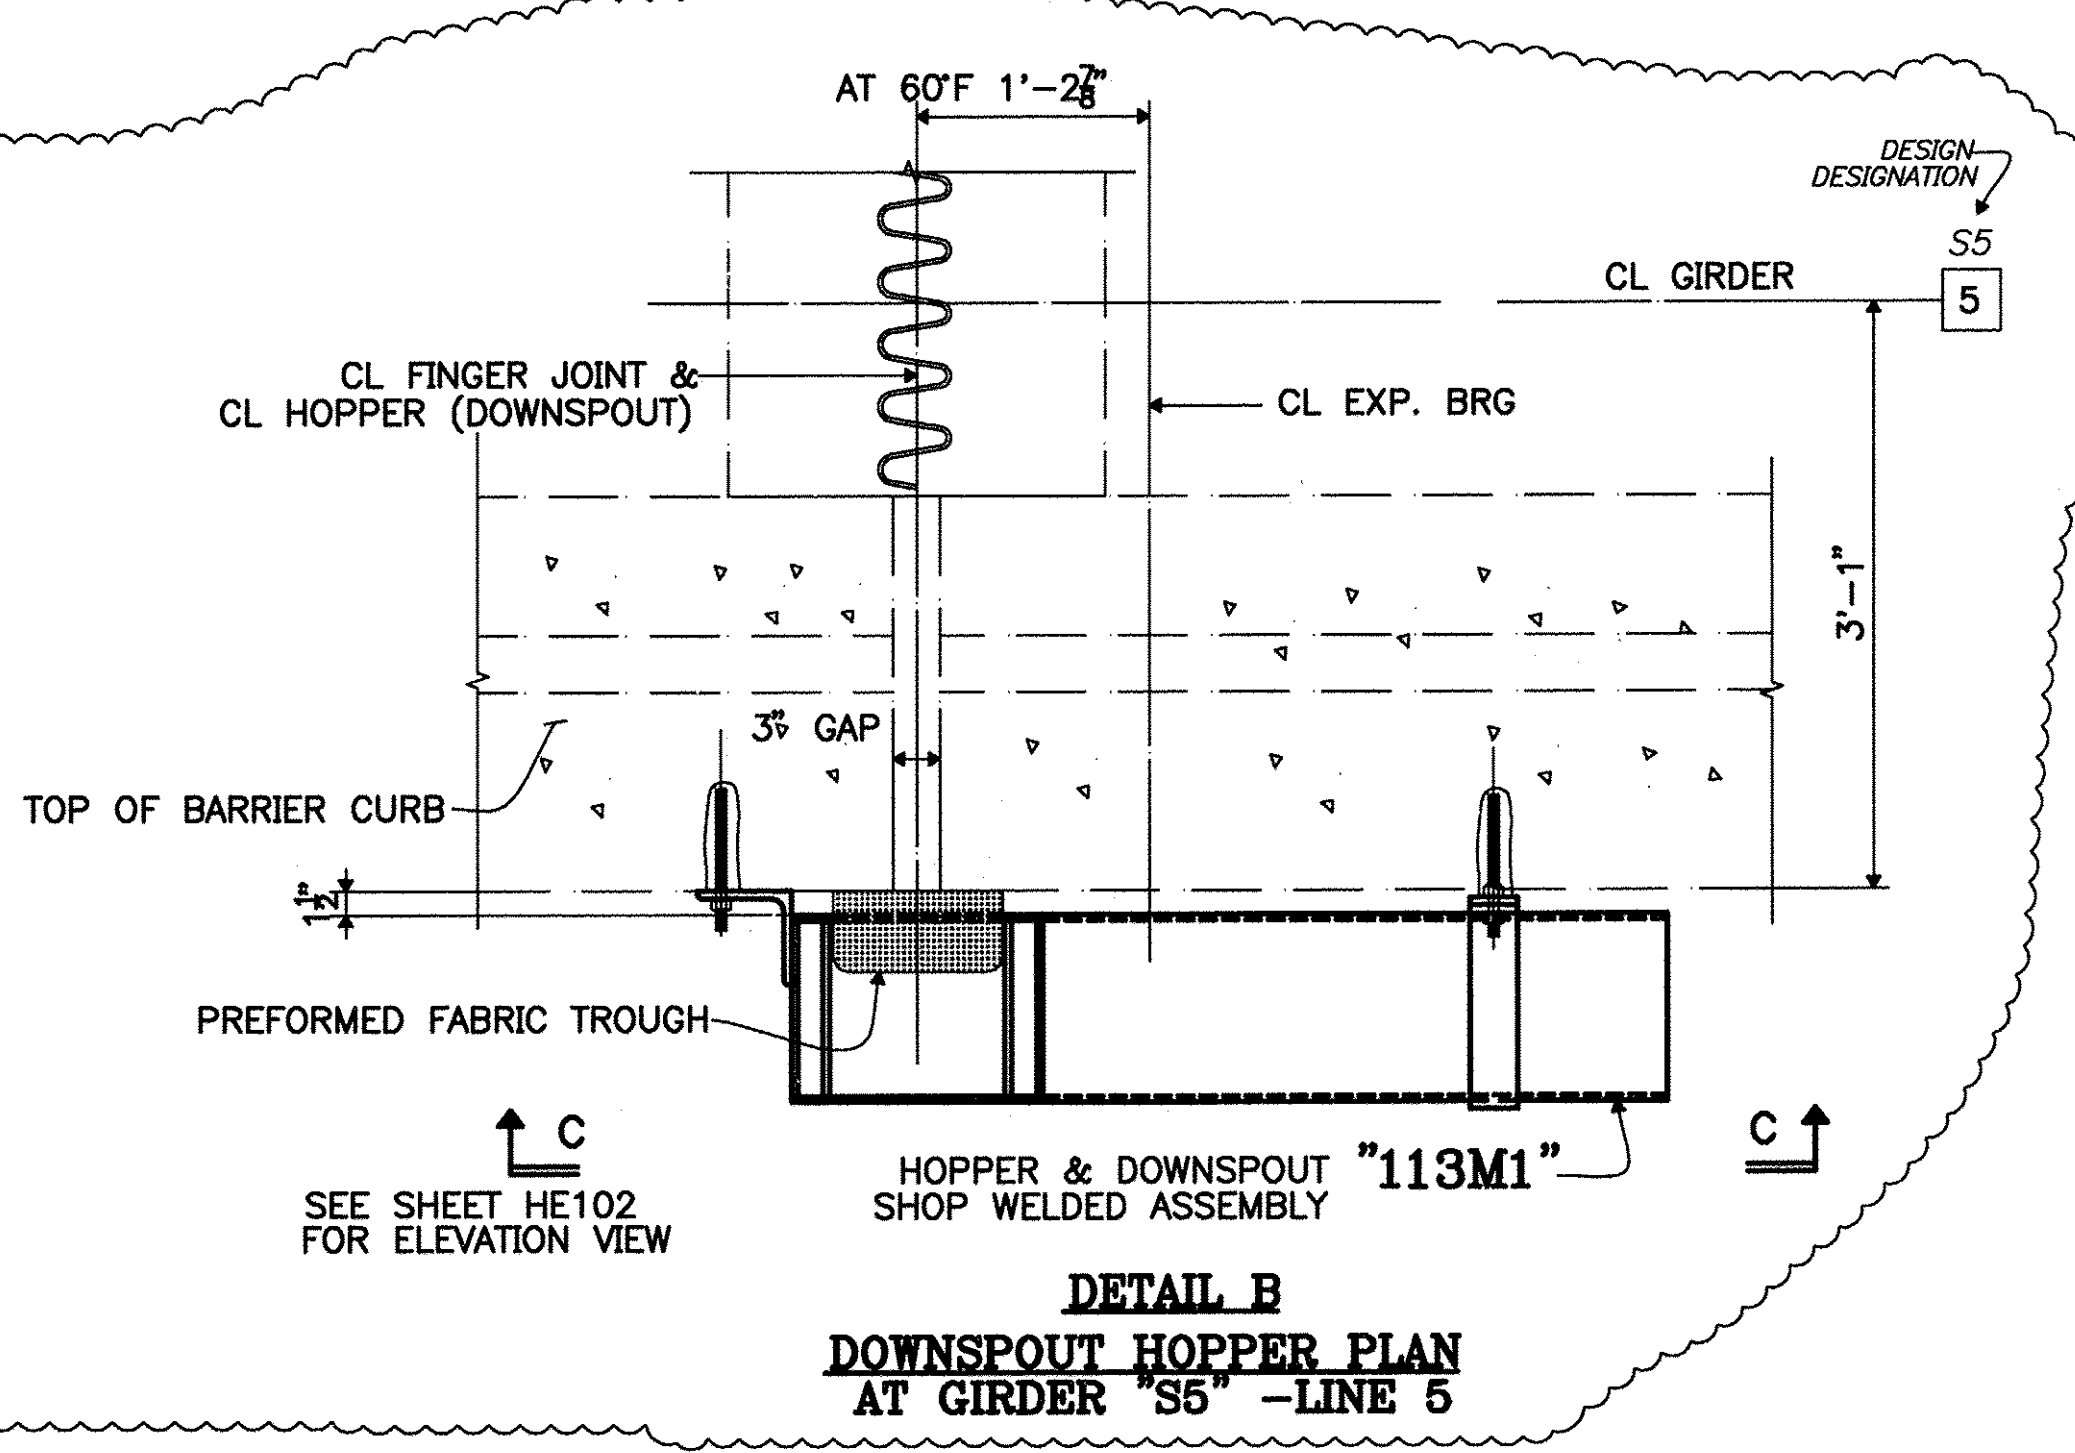


STEEL ERECTION PLAN ~ BRIDGE 3S
 ((BEARING & ANCHOR BOLT DETAILS BY OTHERS))

- ALL GIRDERS ARE 37" WEB DEPTH WELDED PL GIRDERS (U.N.)
- WEB DEPTH VARIES AT ABUTS, (33" AT ABUT. 1 & 31" AT ABUT. 2)
- SEE SHEET "HE102" FOR TYPICAL ELEVATION AT DIAPHRAGMS.
- SEE SHEET "HE103" FOR GRADE & CAMBER DIAGRAMS.
- SEE SHEET "HW101" FOR PROGRESSIVE CAMBER DIAGRAM.
- SEE SHEET "HN101" FOR GENERAL NOTES.

TVGA CONSULTANTS

NO EXCEPTIONS TAKEN REJECTED
 FURNISH AS CORRECTED
 REVISE AND RESUBMIT
 ENGINEER has reviewed Shop Drawings and Samples and other data which Contractor is required to submit, and for compliance with the information given in the Contract Documents and compliance with the design concept of the Consultant. Such review does not extend to means, methods, techniques, sequences or procedures of construction or to safety precautions and programs inherent thereto. Such review does not extend to any LEED certification or accreditation. Contractor is responsible for dimensions to be confirmed and corrected at the job site, for information that pertains solely to the fabrication process or to techniques of construction, and for coordination of the work of all trades.
 BY: *Ad. Col.*
 DATE: 7/6/2008

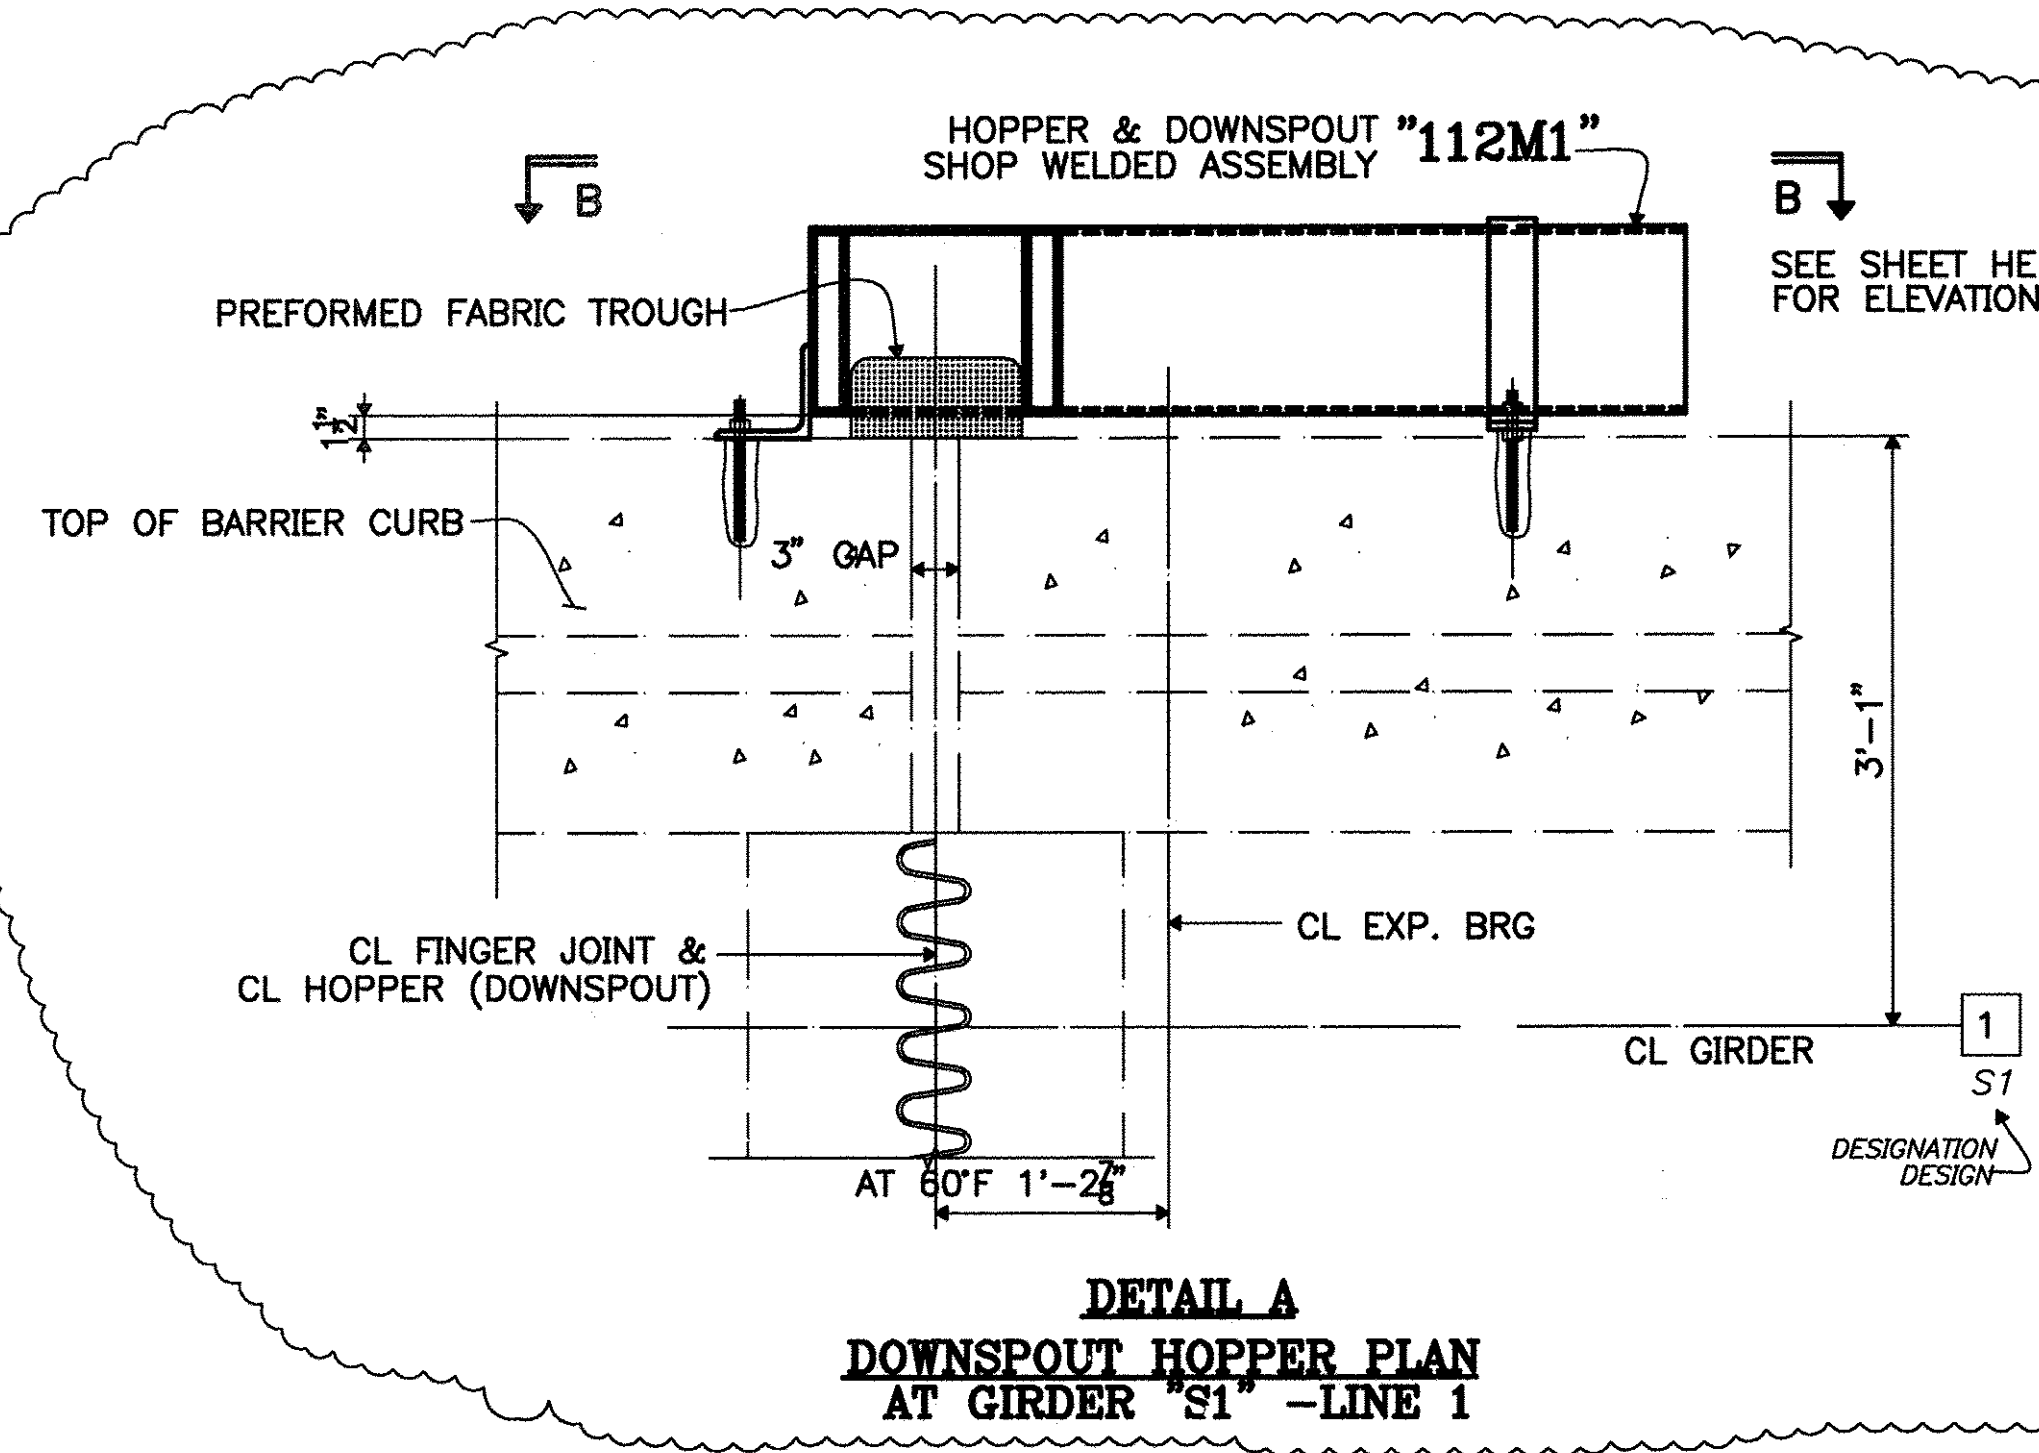

FABRICATED BY: NASH

HOLES: SHOP FASTENERS

SHOP PAINT: _____

SHOP INSPECTION: _____

GENERAL NOTES: _____

DATE	NO.	BY	REVISIONS
03/22/09	R1	PDC/SB	ADDED DOWNSPOUT LOCATION & PLAN

PROJECT No: ACIM 091-1(33)
 STA. 22+47.71 TO STA. 25+05.93
 BRIDGE No. 3S (SOUTHBOUND)
 TOWN OF GUILFORD

Field Use	
Approval	
NOTICE TO ERECTOR	
NO CREDIT WILL BE ALLOWED, BACK-CHARGE ACCEPTED OR LIABILITY ASSUMED BY CAROLINA STEEL TO ANYONE FOR WORK PERFORMED IN REPLACING OR CORRECTING MATERIALS OR WORKMANSHIP FOR THE MATERIALS SHOWN ON THIS DRAWING UNLESS THESE DIFFICULTIES HAVE BEEN BROUGHT TO THE ATTENTION OF CAROLINA STEEL GROUP, LLC. AND PROPER CORRECTIVE WORK HAS BEEN EXPRESSLY AUTHORIZED BY CAROLINA STEEL GROUP, LLC.	
ORDER NO.	08-18537H32
DETAILS OF	ERECTION PLAN
PROJECT	I-91 OVER BROAD BROOK AND BROAD BROOK ROAD
LOCATION	WINDHAM COUNTY, VT
CUSTOMER	MEC CONSTRUCTION
	CAROLINA STEEL GROUP, LLC.
MADE BY	WS
CHECKED BY	PDC/SB
SOUND LEADER	Precise Drafting Co., Inc.
DATE	08-08
SHEET	HE101