

**PAINT NOTE "A"**  
 (MIST COAT OF PRIMER ONLY -1.5 MILS DFT)

**SECTION Y**  
 AT 7'-0" PAINTED AREA

3'-1" -WEB  
 9 SPA @ 3 1/2" = 2'-7 1/2"  
 DOR (TYP)

**WT 10.0 TONS**  
 (allowing weight rounded up to the nearest 1/2 ton)

8BC2  
 8BC3  
 8BC4  
 8BC5

**TVGA CONSULTANTS**


- NO EXCEPTIONS TAKEN
  - FURNISH AS CORRECTED
  - REVISE AND RESUBMIT
- ENGINEER has reviewed Shop Drawings and Samples and other data which Contractor is required to submit, only for conformance with the information given in the Contract Documents and compatibility with the design concept of the completed Project as a functioning whole as indicated in the Contract Documents. Such review does not extend to means, methods, techniques, sequences or procedures of construction or to safety precautions and programs, incident thereto. Such review is not evidence of any LEED certification or accreditation. Contractor is responsible for dimensions to be confirmed and coordinated at the job site for information that pertains solely to the fabrication procedures or to techniques of construction and for coordination of the work of all trades.
- BY: *[Signature]*  
 DATE: 7/27/09

PROJECT No: ACIM 091-1(33)  
 STA. 22+69.92 TO STA. 25+28.14  
 BRIDGE No. 3N (NORTHBOUND)  
 TOWN OF GUILFORD

FABRICATED BY COLFAX  
 HOLES - 15/16" SHOP FASTENERS  
 SHOP PAINT PARTIAL PAINT PER HMI & AS NOTED  
 SHOP INSPECTION WORK THIS SHEET w/HF8B  
 GENERAL NOTES

REVISIONS			
DATE	NO.	BY	REVISIONS
07/06/09	R1	PDC/SB	REMOVED HATCHED AREA & ADDED NOTES

ORDER NO.	08-18537H22
DETAILS OF	PL GIRDER - SPAN BC
	LINES 2, 3, 4 & 5
PROJECT	I-91 OVER BROAD BROOK AND BROAD BROOK ROAD
LOCATION	WINDHAM COUNTY, VT
CUSTOMER	MEC CONSTRUCTION
	<b>CAROLINA STEEL GROUP, LLC.</b>
MADE BY	GM
CHECKED BY	PDC/SB
SOUND LEADER	Precise Drafting Co. Inc.
DATE	09-08
SHEET	HF8A

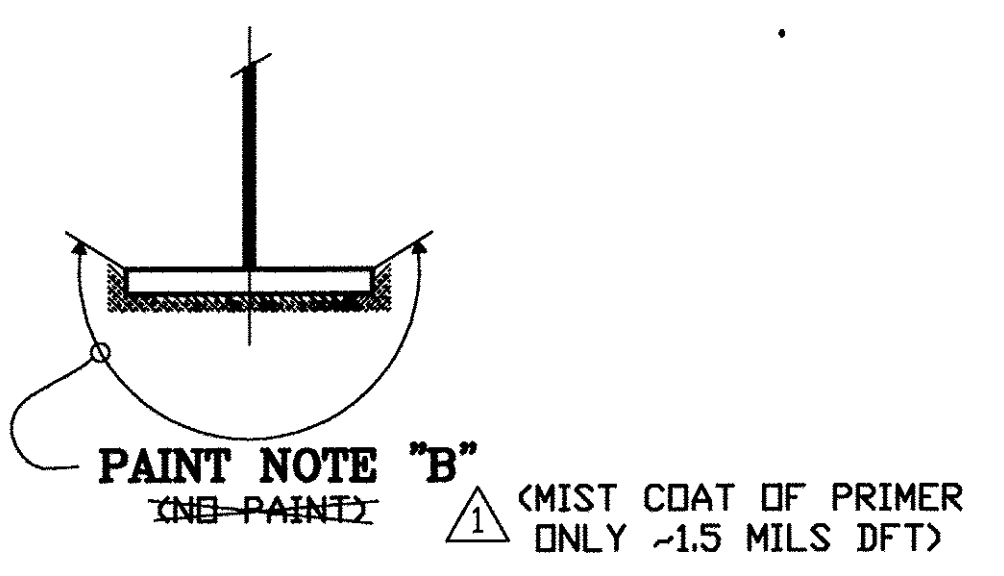

DOR - DENTICES  
 DIRECTION OF ROLLING