

TVGA CONSULTANTS

NO EXCEPTIONS TAKEN REJECTED
 FURNISH AS CORRECTED
 REVISE AND RESUBMIT

ENGINEER HAS REVIEWED SHOP DRAWINGS AND SAMPLES AND ENDORSER HAS REVIEWED SHOP DRAWINGS AND SAMPLES FOR OTHER DATA WHICH CONTRACTOR IS REQUIRED TO SUBMIT FOR PERFORMANCE WITH THE INFORMATION GIVEN IN THE CONTRACT DOCUMENTS AND COMPATIBILITY WITH THE DESIGN CONCEPT OF THE CONTRACT DOCUMENTS. SUCH REVIEWS DO NOT EXTEND TO ANY LEAD CERTIFICATION OR TO VERIFY PROCEDURES AND PROGRAMS INDIFFERENT METHODS, TECHNIQUES, MATERIALS OR PROCEDURES OF CONSTRUCTION. SUCH REVIEWS DO NOT EXTEND TO ANY LEAD CERTIFICATION OR TO VERIFY PROCEDURES AND PROGRAMS INDIFFERENT METHODS, TECHNIQUES, MATERIALS OR PROCEDURES OF CONSTRUCTION. SUCH REVIEWS DO NOT EXTEND TO ANY LEAD CERTIFICATION OR TO VERIFY PROCEDURES AND PROGRAMS INDIFFERENT METHODS, TECHNIQUES, MATERIALS OR PROCEDURES OF CONSTRUCTION.

BY: *Orin*
 DATE: 7/27/2009

PROJECT No: ACIM 091-1(33)
 STA. 22+69.92 TO STA. 25+28.14
 BRIDGE No. 3N (NORTHBOUND)
 TOWN OF GUILFORD

FABRICATED BY: CDLFAX

Holes: 15/16" SHOP FASTENERS


SHOP PAINT: PARTIAL PAINT PER HMI & AS NOTED

SHOP INSPECTION: WORK THIS SHEET w/HF9B

GENERAL NOTES: WORK THIS SHEET w/HF9B

DATE	NO.	BY	REVISIONS
07/06/09	R1	PDC/SB	REMOVED HATCHED AREA & ADDED NOTES

ORDER NO.	08-18537H22
DETAILS OF	PL GIRDER - SPAN BC
	LINE 6
PROJECT	I-91 OVER BROAD BROOK AND BROAD BROOK ROAD
LOCATION	WINDHAM COUNTY, VT
CUSTOMER	MEC CONSTRUCTION
	CAROLINA STEEL GROUP, LLC.
MADE BY	GM
CHECKED BY	PDC/SB
SOUND LEADER	Precise Printing Co. Inc.
DATE	09-08
SHEET	HF9A

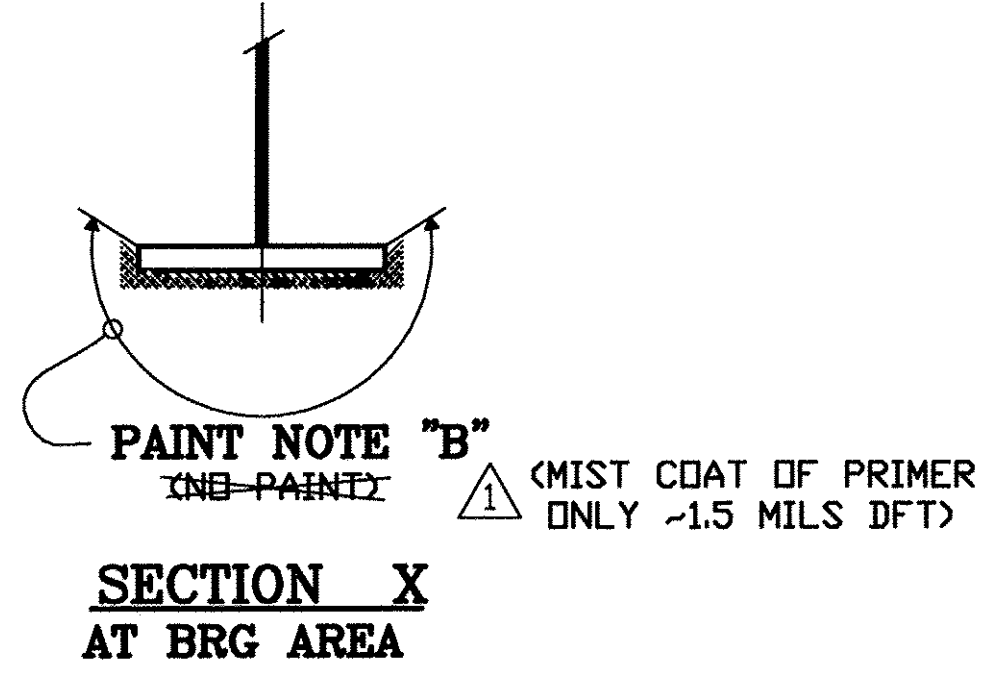

DOR - DENOTES DIRECTION OF ROLLING