


**BRIDGE DECK PLAN**

**BRIDGE 3S**  
SCALE: 3/32" = 1'-0"

**TVGA CONSULTANTS**  
 NO EXCEPTIONS TAKEN  
 REVISED AND RECONSTRUCTED  
 REJECTED  
 This plan has been approved by TVGA Consultants and the contractor is required to submit only for information and compliance with the design except of the contract documents. Such revision shall be indicated in the drawings, schedules, specifications and proposals. Such revision shall be indicated to maintain compliance with the contract documents. The contractor is responsible for any LEED certification or accreditation. Contractor is responsible for any and all work to be performed at the job site for information and for construction and for organization of the work of all trades.  
 BY: *John J. J...*  
 DATE: 4/18/2009

**WARNING:**  
EACH BRIDGE DECK FORM SHEET MUST BE FASTENED IMMEDIATELY UPON PLACEMENT TO AVOID HAZARD THAT CAN RESULT FROM LATERAL MOVEMENT OR SUDDEN UPLIFT.

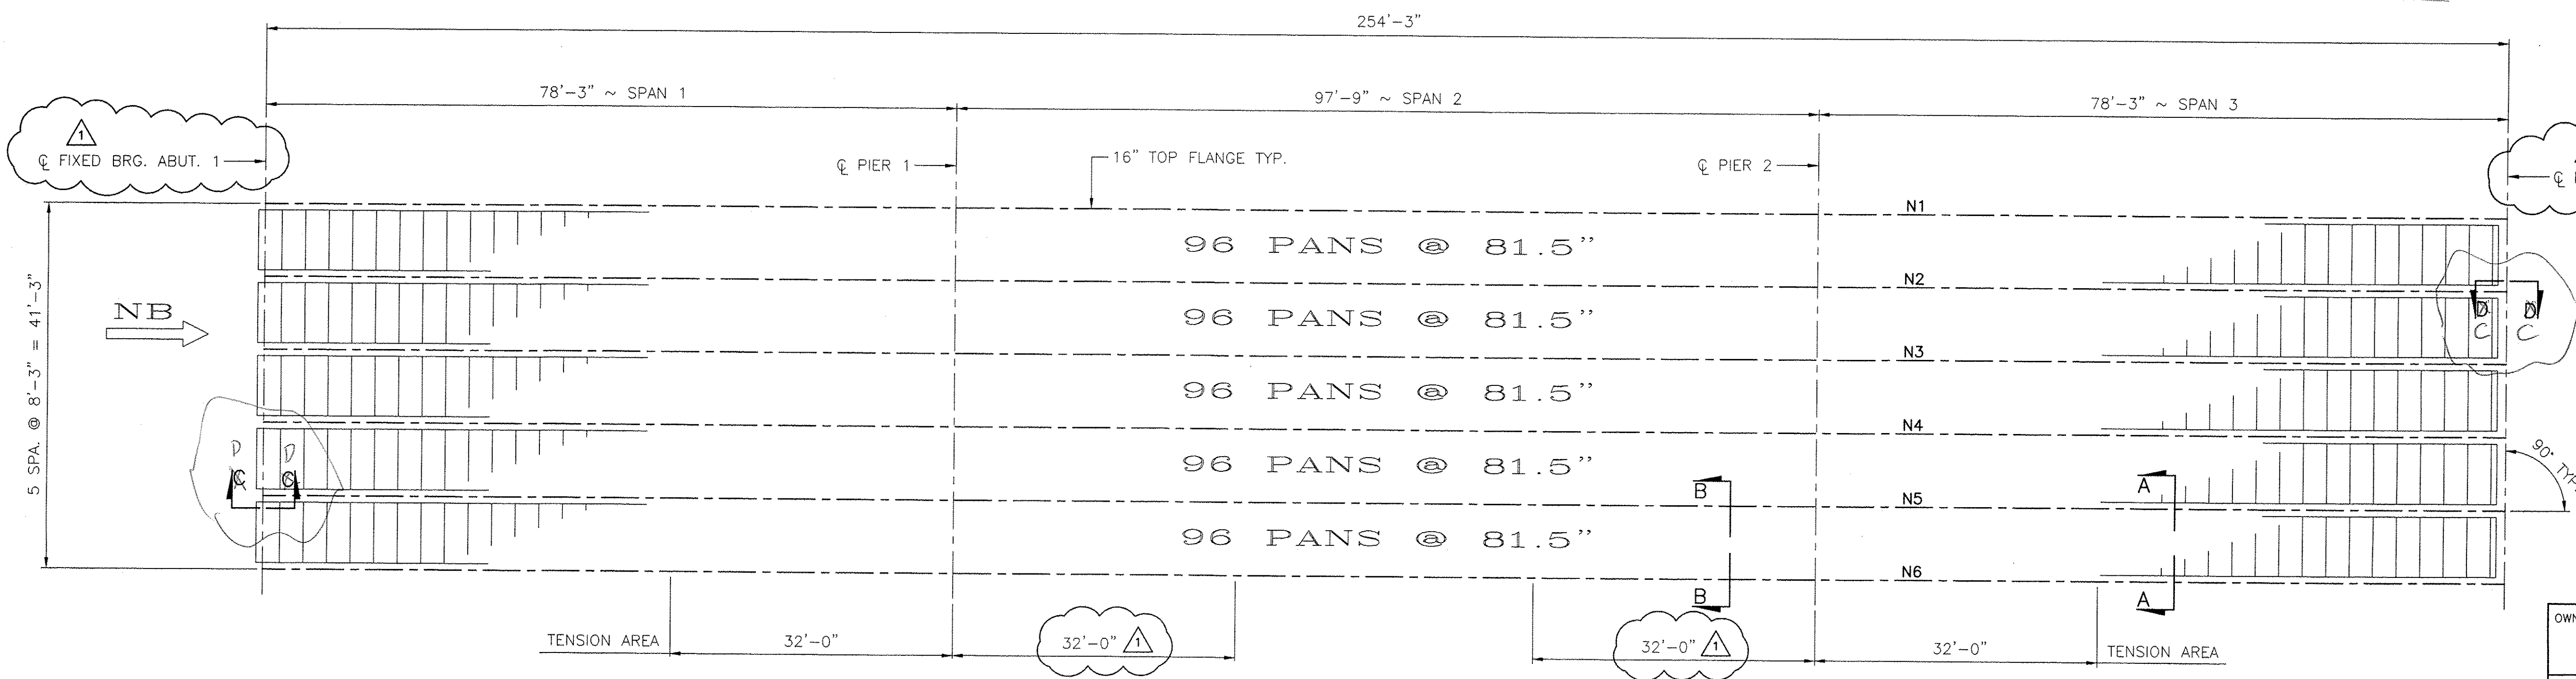

**BRIDGE DECK PLAN**

**BRIDGE 3N**  
SCALE: 3/32" = 1'-0"

TRANSMITTAL RECORD		
NO.	DATE	SENT FOR
2	3/25/09	APPROVAL
1	2/20/09	APPROVAL


**OWNER:** STATE OF VERMONT  
AGENCY OF TRANSPORTATION

**CONTRACTOR:** J.A. McDONALD, INC.

**PROJECT:** I-91 OVER BROAD BROOK & BROAD BROOK ROAD BRIDGE NO. 3N&S

**LOCATION:** GUILFORD, VERMONT

**J & B WELDING, INC.**  
229 N. MAIN ST.  
COOPERSBURG, PA 18036  
(610) 282-3461  
FAX: (610) 282-3014

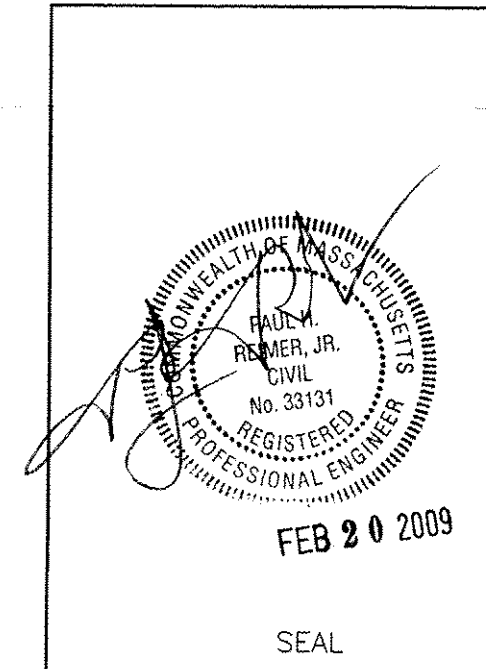

RECORD OF REVISIONS		
REV.	DATE	DESCRIPTION
△	3/25/09	ENGINEER'S REVISIONS

**DATE:** 2/13/09  
**APPROVED BY:** [Signature]  
**CHECKED BY:** [Signature]  
**DRAWN BY:** JJJ

**SCALE:** 3/32" = 1'-0"  
**J&B PROJECT No:** 920

**PG. 1 OF 2**  
**PROJECT No:** IM 091-1(33)