


STATION
PROFILE - BR 43N
 RAISED FINISH GRADE 1/4"

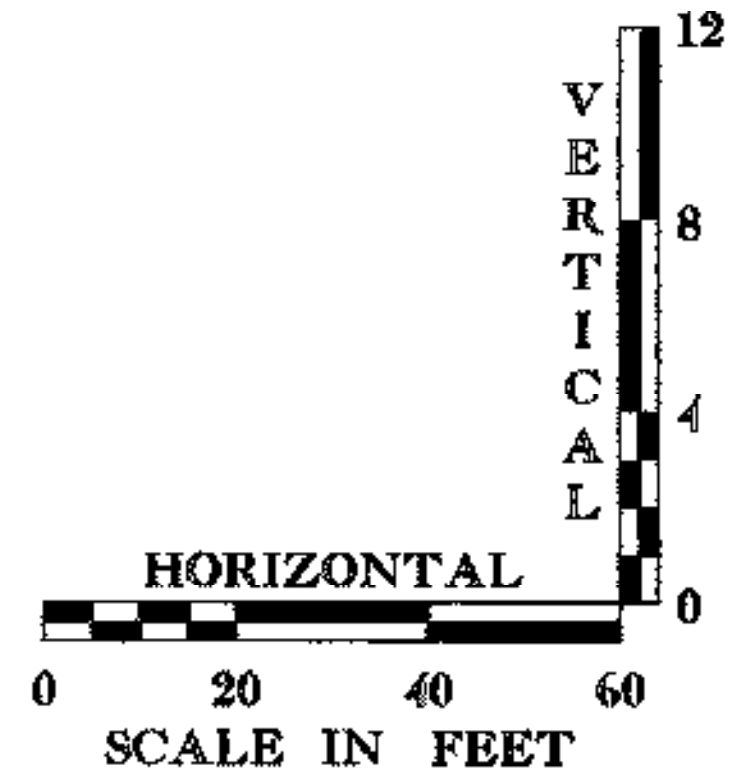

STATE OF VERMONT AGENCY OF TRANSPORTATION	
Town Of MIDDLESEX-BOLTON	Bridge No. 43N
Highway No. I-89	Log Sta. Surv. Sta.
I-89 NB OVER U.S. ROUTE 2	
PROFILE (43N)	
Designed By P.W. SZUSTAK	Drawn By R.A. BOTZENHART
Checked By J.P. HALSTEAD	Bridge Design Supervisor Date 10/99
PROJECT MIDDLESEX-BOLTON	PROJECT NO. IM-089-2(26)
TVGA CAD Drawing No. 43pro1f	Date 10/99
Bridge Sheet No. BR43-2	Sheet 48 of 307