



NOTE: RAISED BRIDGE 49N FINISHED GRADE 1/2"

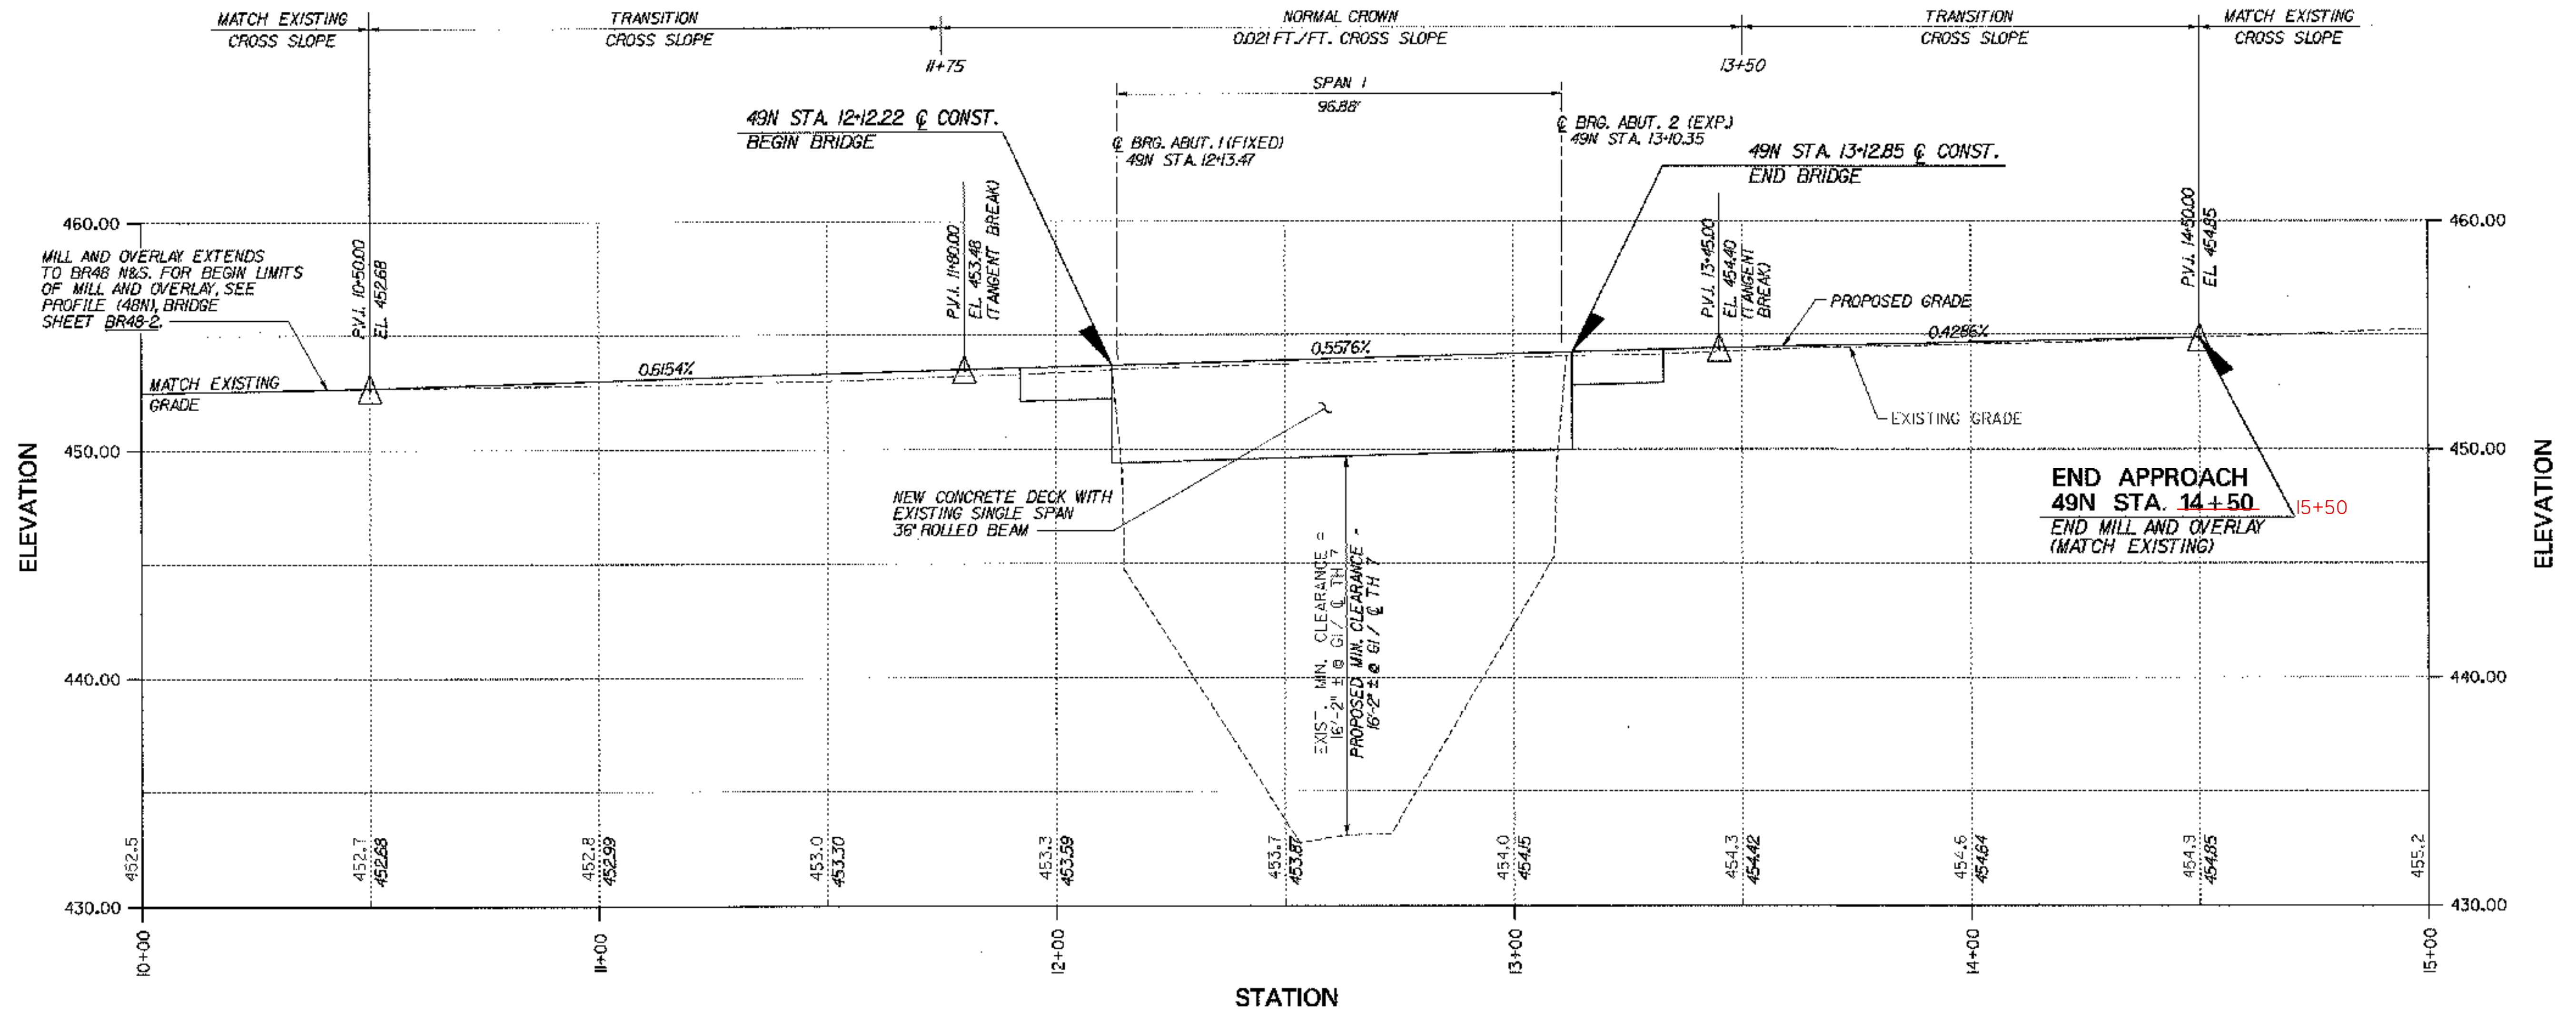

STATION  
PROFILE - BR 49N

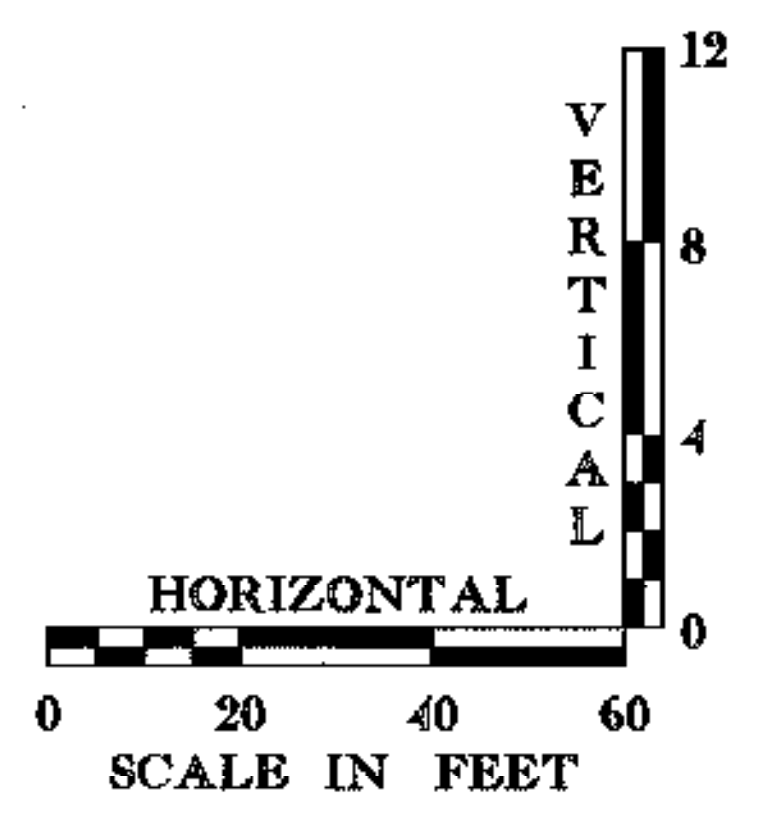

<b>STATE OF VERMONT AGENCY OF TRANSPORTATION</b>			
Town Of	MIDDLESEX-BOLTON	Bridge No.	<b>49N</b>
Highway No.	I-89	Log Sta.	
		Surv. Sta.	
I-89 NB OVER TH 7			
<b>PROFILE (49N)</b>			
Designed By	P.W. SZUSTAK	Drawn By	R.A. BOTZENHART
Checked By	Date	Bridge Design Supervisor	
J.P. HALSTEAD	10/99	J.P. HALSTEAD	Date 10/99
PROJECT	MIDDLESEX-BOLTON	PROJECT NO.	IM-089-2(26)
TVGA CAD Drawing No.	49nprof	Date	10/99
Bridge Sheet No.	<b>BR49-2</b>	Sheet	76 of 307

