



NOTE: RAISED BRIDGE 49S FINISH GRADE 5/8"

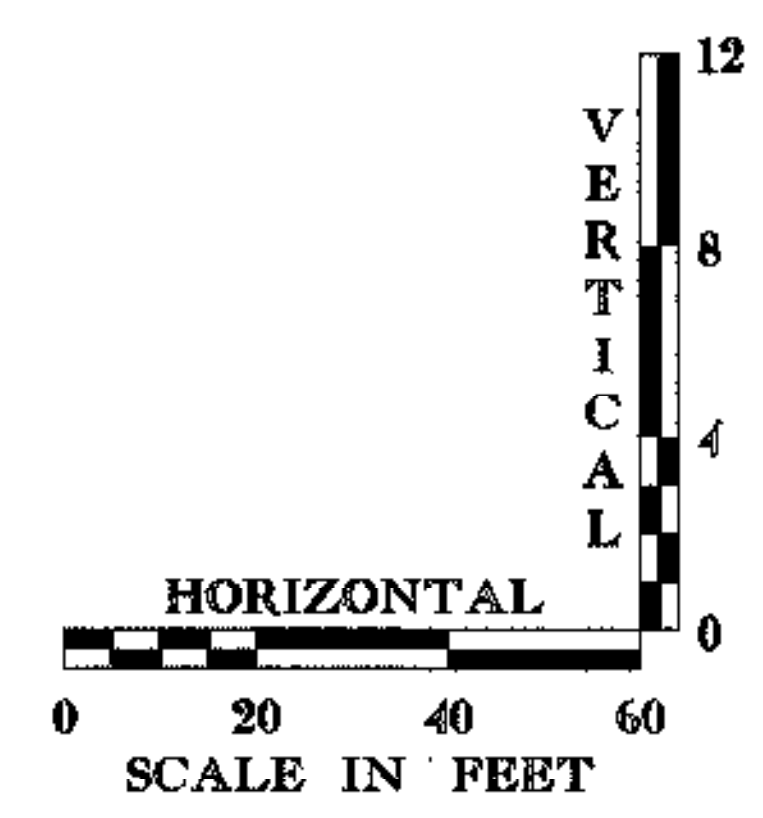

<b>STATE OF VERMONT AGENCY OF TRANSPORTATION</b>	
Town Of <b>MIDDLESEX-BOLTON</b>	Bridge No. <b>49S</b>
Highway No. <b>I-89</b>	Log Sta. <b>Surv. Sta.</b>
<b>I-89 SB OVER TH 7</b>	
<b>PROFILE (49S)</b>	
Designed By <b>P.W. SZUSTAK</b>	Drawn By <b>R.A. BOTZENHART</b>
Checked By <b>J.P. HALSTEAD</b>	Bridge Design Supervisor <b>J.P. HALSTEAD</b>
Date <b>10/99</b>	Date <b>10/99</b>
PROJECT <b>MIDDLESEX-BOLTON</b>	PROJECT NO. <b>IM-089-2(26)</b>
TVGA CAD Drawing No. <b>49sprof</b>	Date <b>10/99</b>
Bridge Sheet No. <b>BR49-3</b>	Sheet <b>77</b> of <b>307</b>

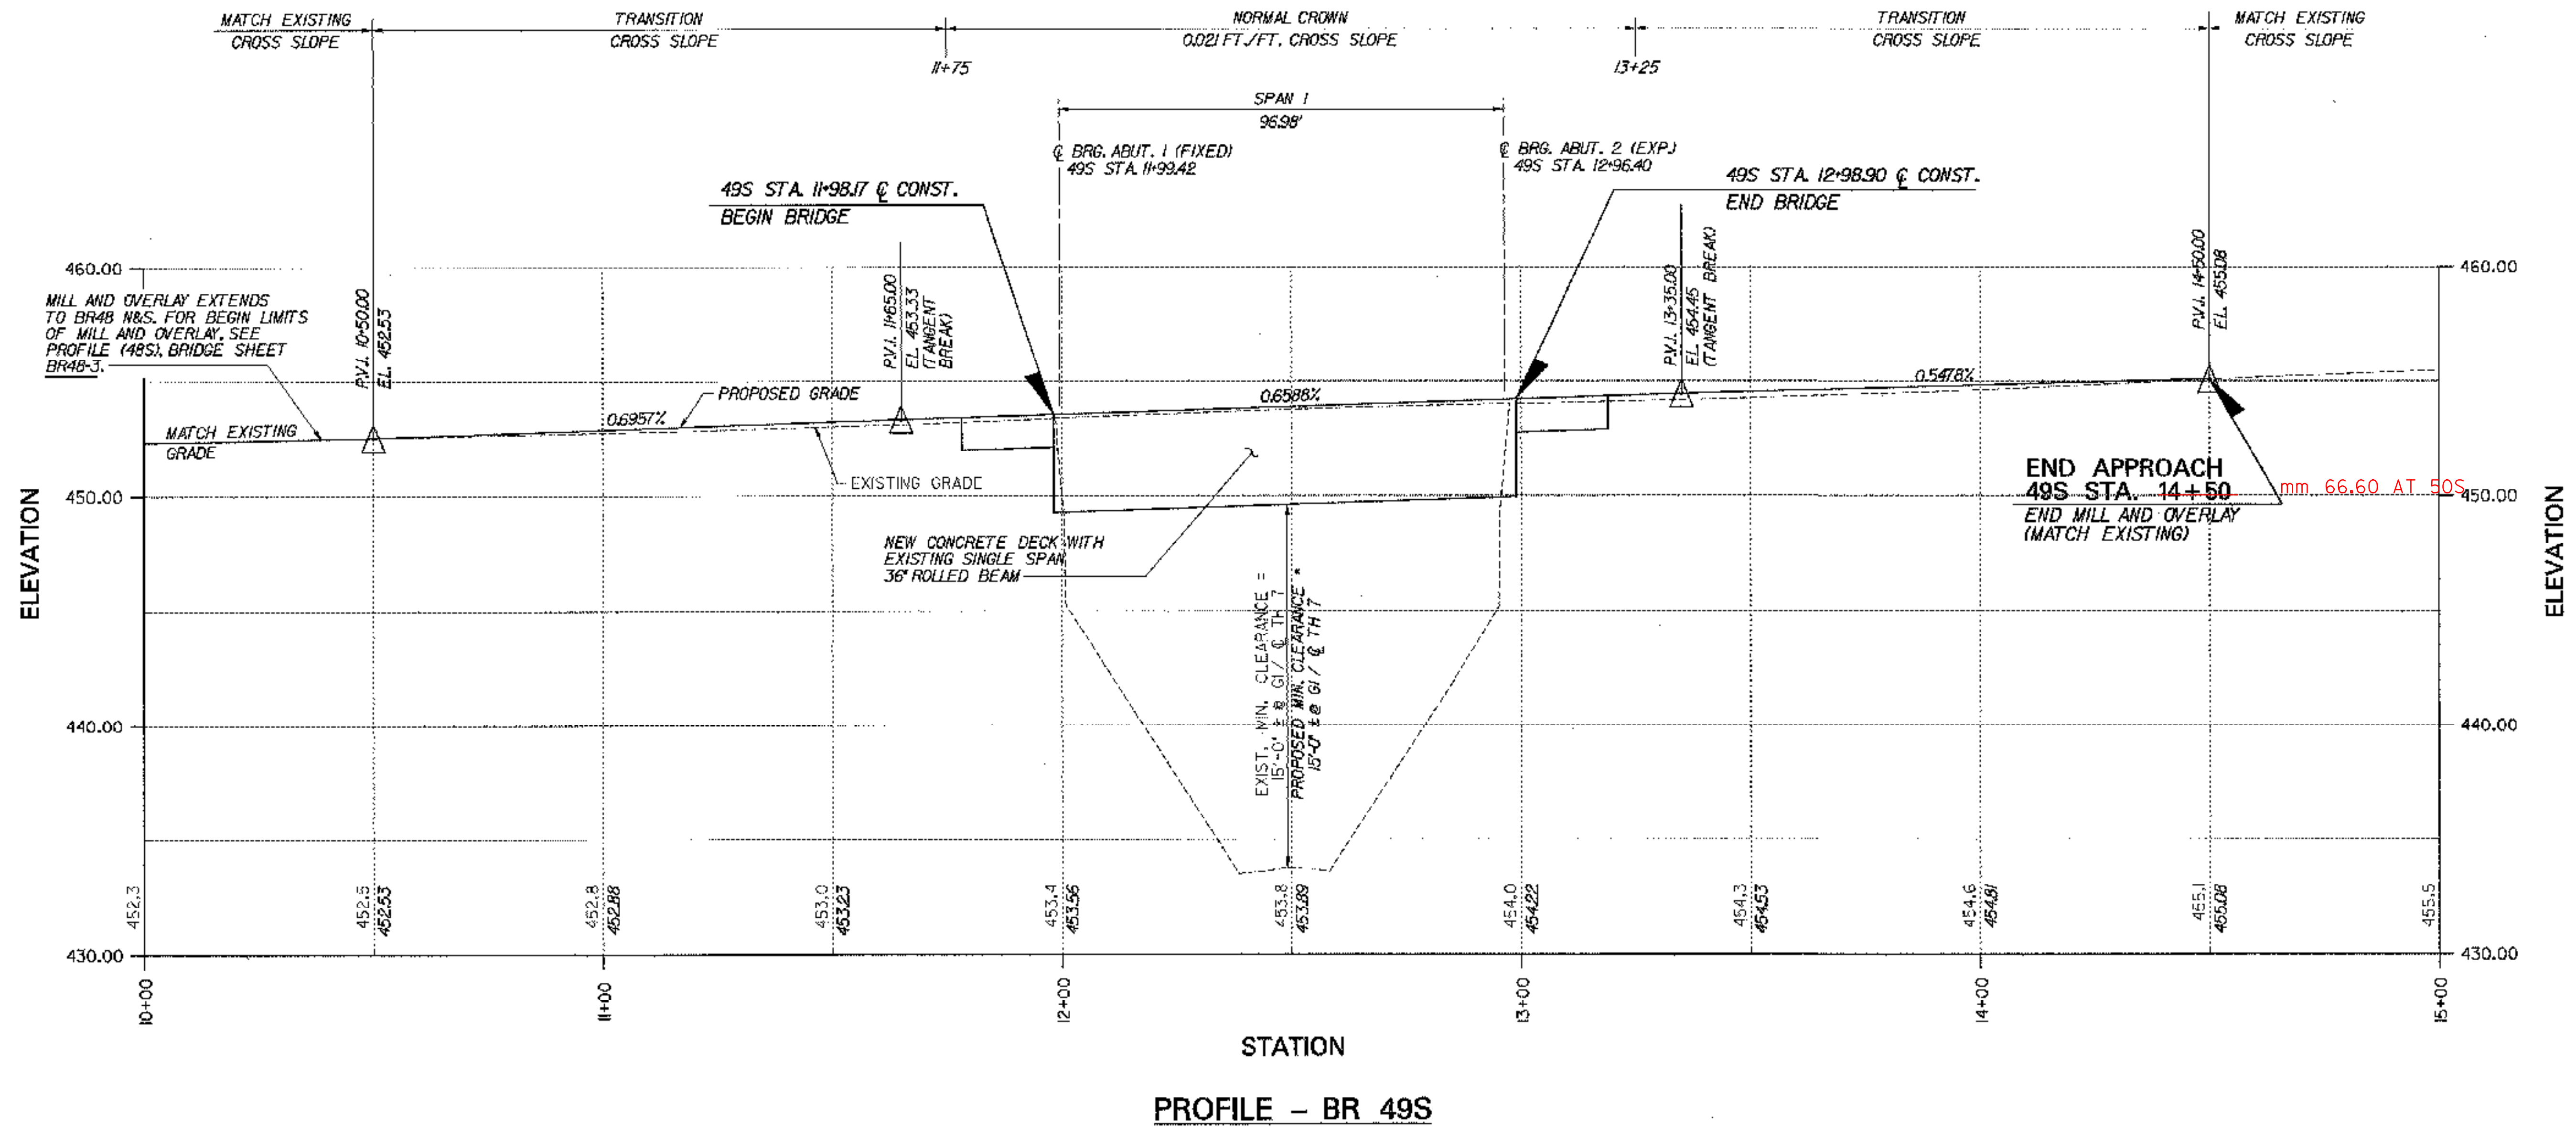