



RAISED BRIDGE 50N FINISH GRADE 1/4"

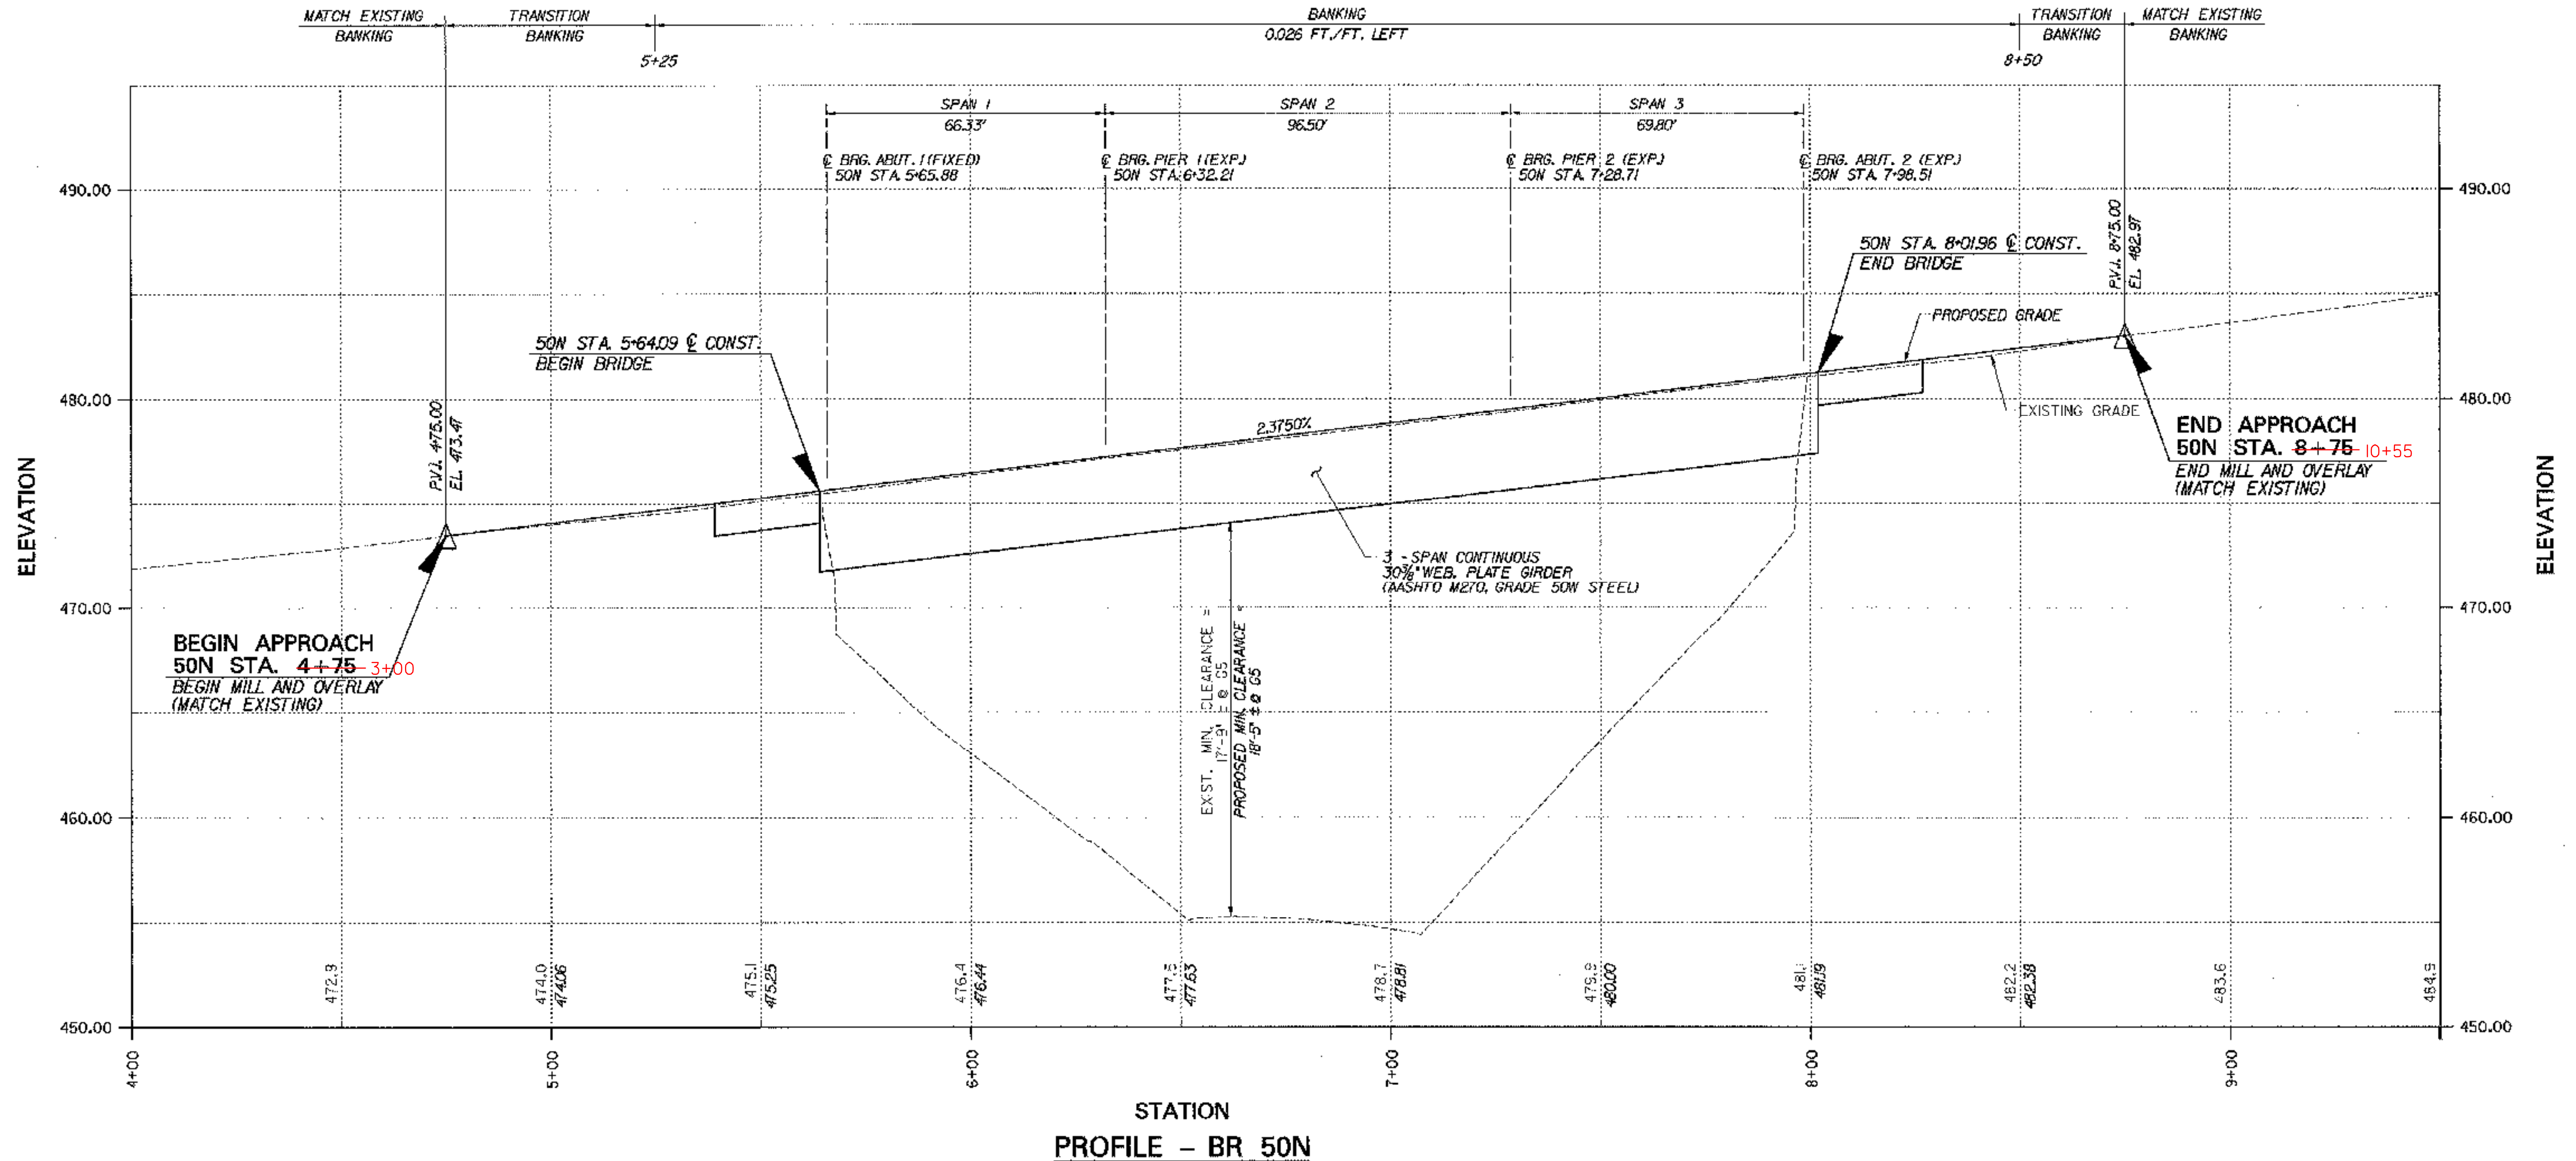

STATION  
PROFILE - BR 50N

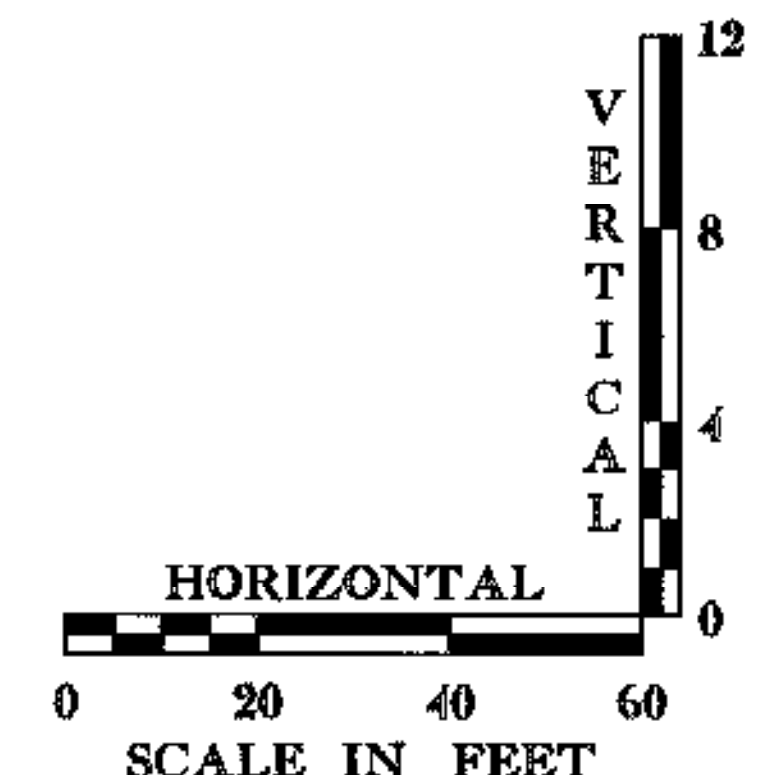

<b>STATE OF VERMONT AGENCY OF TRANSPORTATION</b>	
Town Of <b>MIDDLESEX-BOLTON</b>	Bridge No. <b>50N</b>
Highway No. <b>I-89</b>	Log Sta. Surv. Sta.
<b>I-89 NB OVER U.S. ROUTE 2</b>	
<b>PROFILE (50N)</b>	
Designed By <b>P.W. SZUSTAK</b>	Drawn By <b>R.A. BOTZENHART</b>
Checked By <b>J.P. HALSTEAD</b>	Bridge Design Supervisor
Date <b>10/99</b>	Date <b>10/99</b>
PROJECT <b>MIDDLESEX-BOLTON</b>	PROJECT NO. <b>IM-089-2(26)</b>
TVGA CAD Drawing No. <b>50nprof</b>	Date <b>10/99</b>
Bridge Sheet No. <b>BR50-2</b>	Sheet <b>86</b> of <b>307</b>

**TVGA** TVGA ENGINEERING,  
SURVEYING, P. C.