




**LEGEND**


- CONCRETE BARRIER
- ➔ DIRECTION OF TRAFFIC FLOW WITH DETOUR IN PLACE
- CROSSOVER ALIGNMENT
- ▨ BRIDGE WORK AREA
- ⬭ LEDGE OUTCROPPING
- ⊞ GUARDRAIL
- ⊞ EXISTING DROP INLET
- ⊞ PORTABLE ARROW BOARD
- TYPE I DELINEATOR (YELLOW)
- TYPE I DELINEATOR (WHITE)
- REFLECTORIZED PLASTIC DRUM
- 4" TEMPORARY PAVEMENT MARKINGS
- ⊞ TYPE III BARRICADE
- ⊞ TYPE III (MOD) BARRICADE
- APPROXIMATE CULVERT LOCATION

• NOT ALL SOUTH BOUND REST AREA SIGNS THAT NEEDED TO BE COVERED WERE INDICATED ON THE PLANS ON SHEETS 206 AND 207.

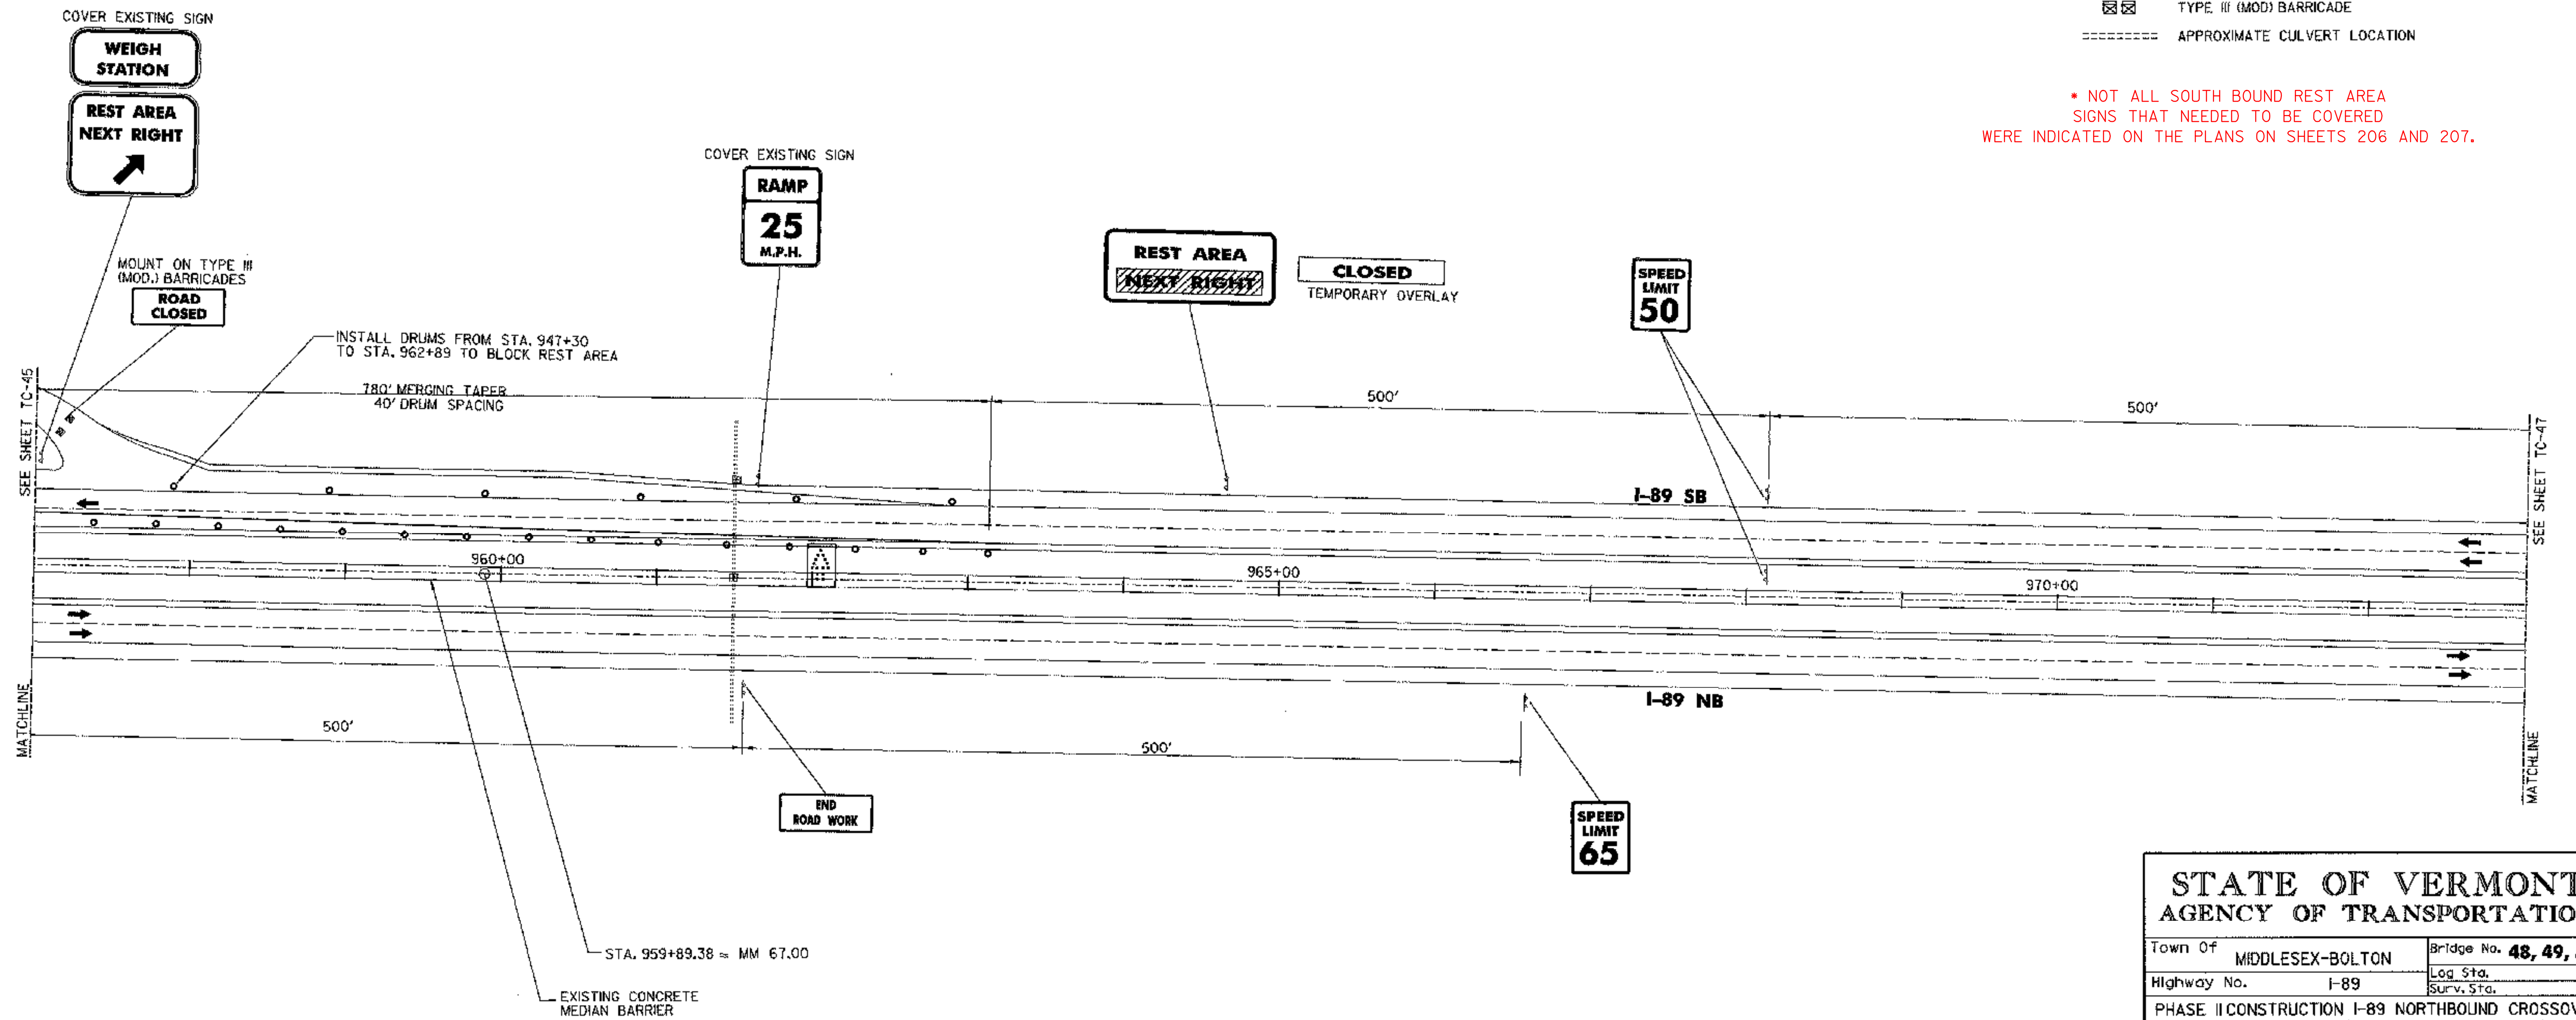

SEE SHEET TC-45  
MATCHLINE

SEE SHEET TC-47  
MATCHLINE

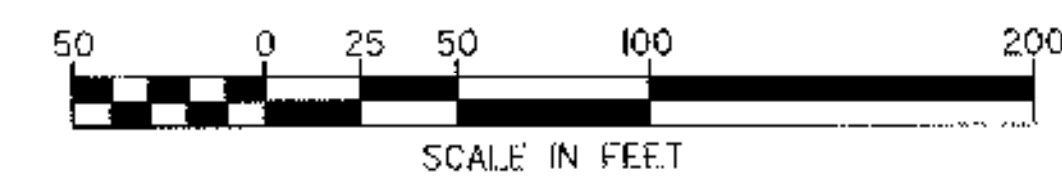

**STATE OF VERMONT  
AGENCY OF TRANSPORTATION**

Town Of	MIDDLESEX-BOLTON	Bridge No.	48, 49, 50
Highway No.	I-89	Log Sta.	
		Surv. Sta.	
PHASE II CONSTRUCTION I-89 NORTHBOUND CROSSOVER			
<b>BRIDGES 48, 49, 50</b>			
Designed By	J.M.SMYRSKI/K.S.MARSHIA	Drawn By	S.E.SCHMITT
Checked By	J.W.TUCKER	Date	10/99
		Bridge Design Supervisor	J.P.HALSTEAD
		Date	10/99
PROJECT	MIDDLESEX-BOLTON	PROJECT NO.	IM-089-2(26)
Drawing No.	...48-49-50-nb.dgn	Date	OCT 1999
Bridge Sheet No.	TC-46	Sheet	206 of 307

