




B. P. R. DIV. NO.	STATE	PROJECT NO.	SHEET NO.	TOTAL SHEETS
1	VT.	I-89-2 (7)		

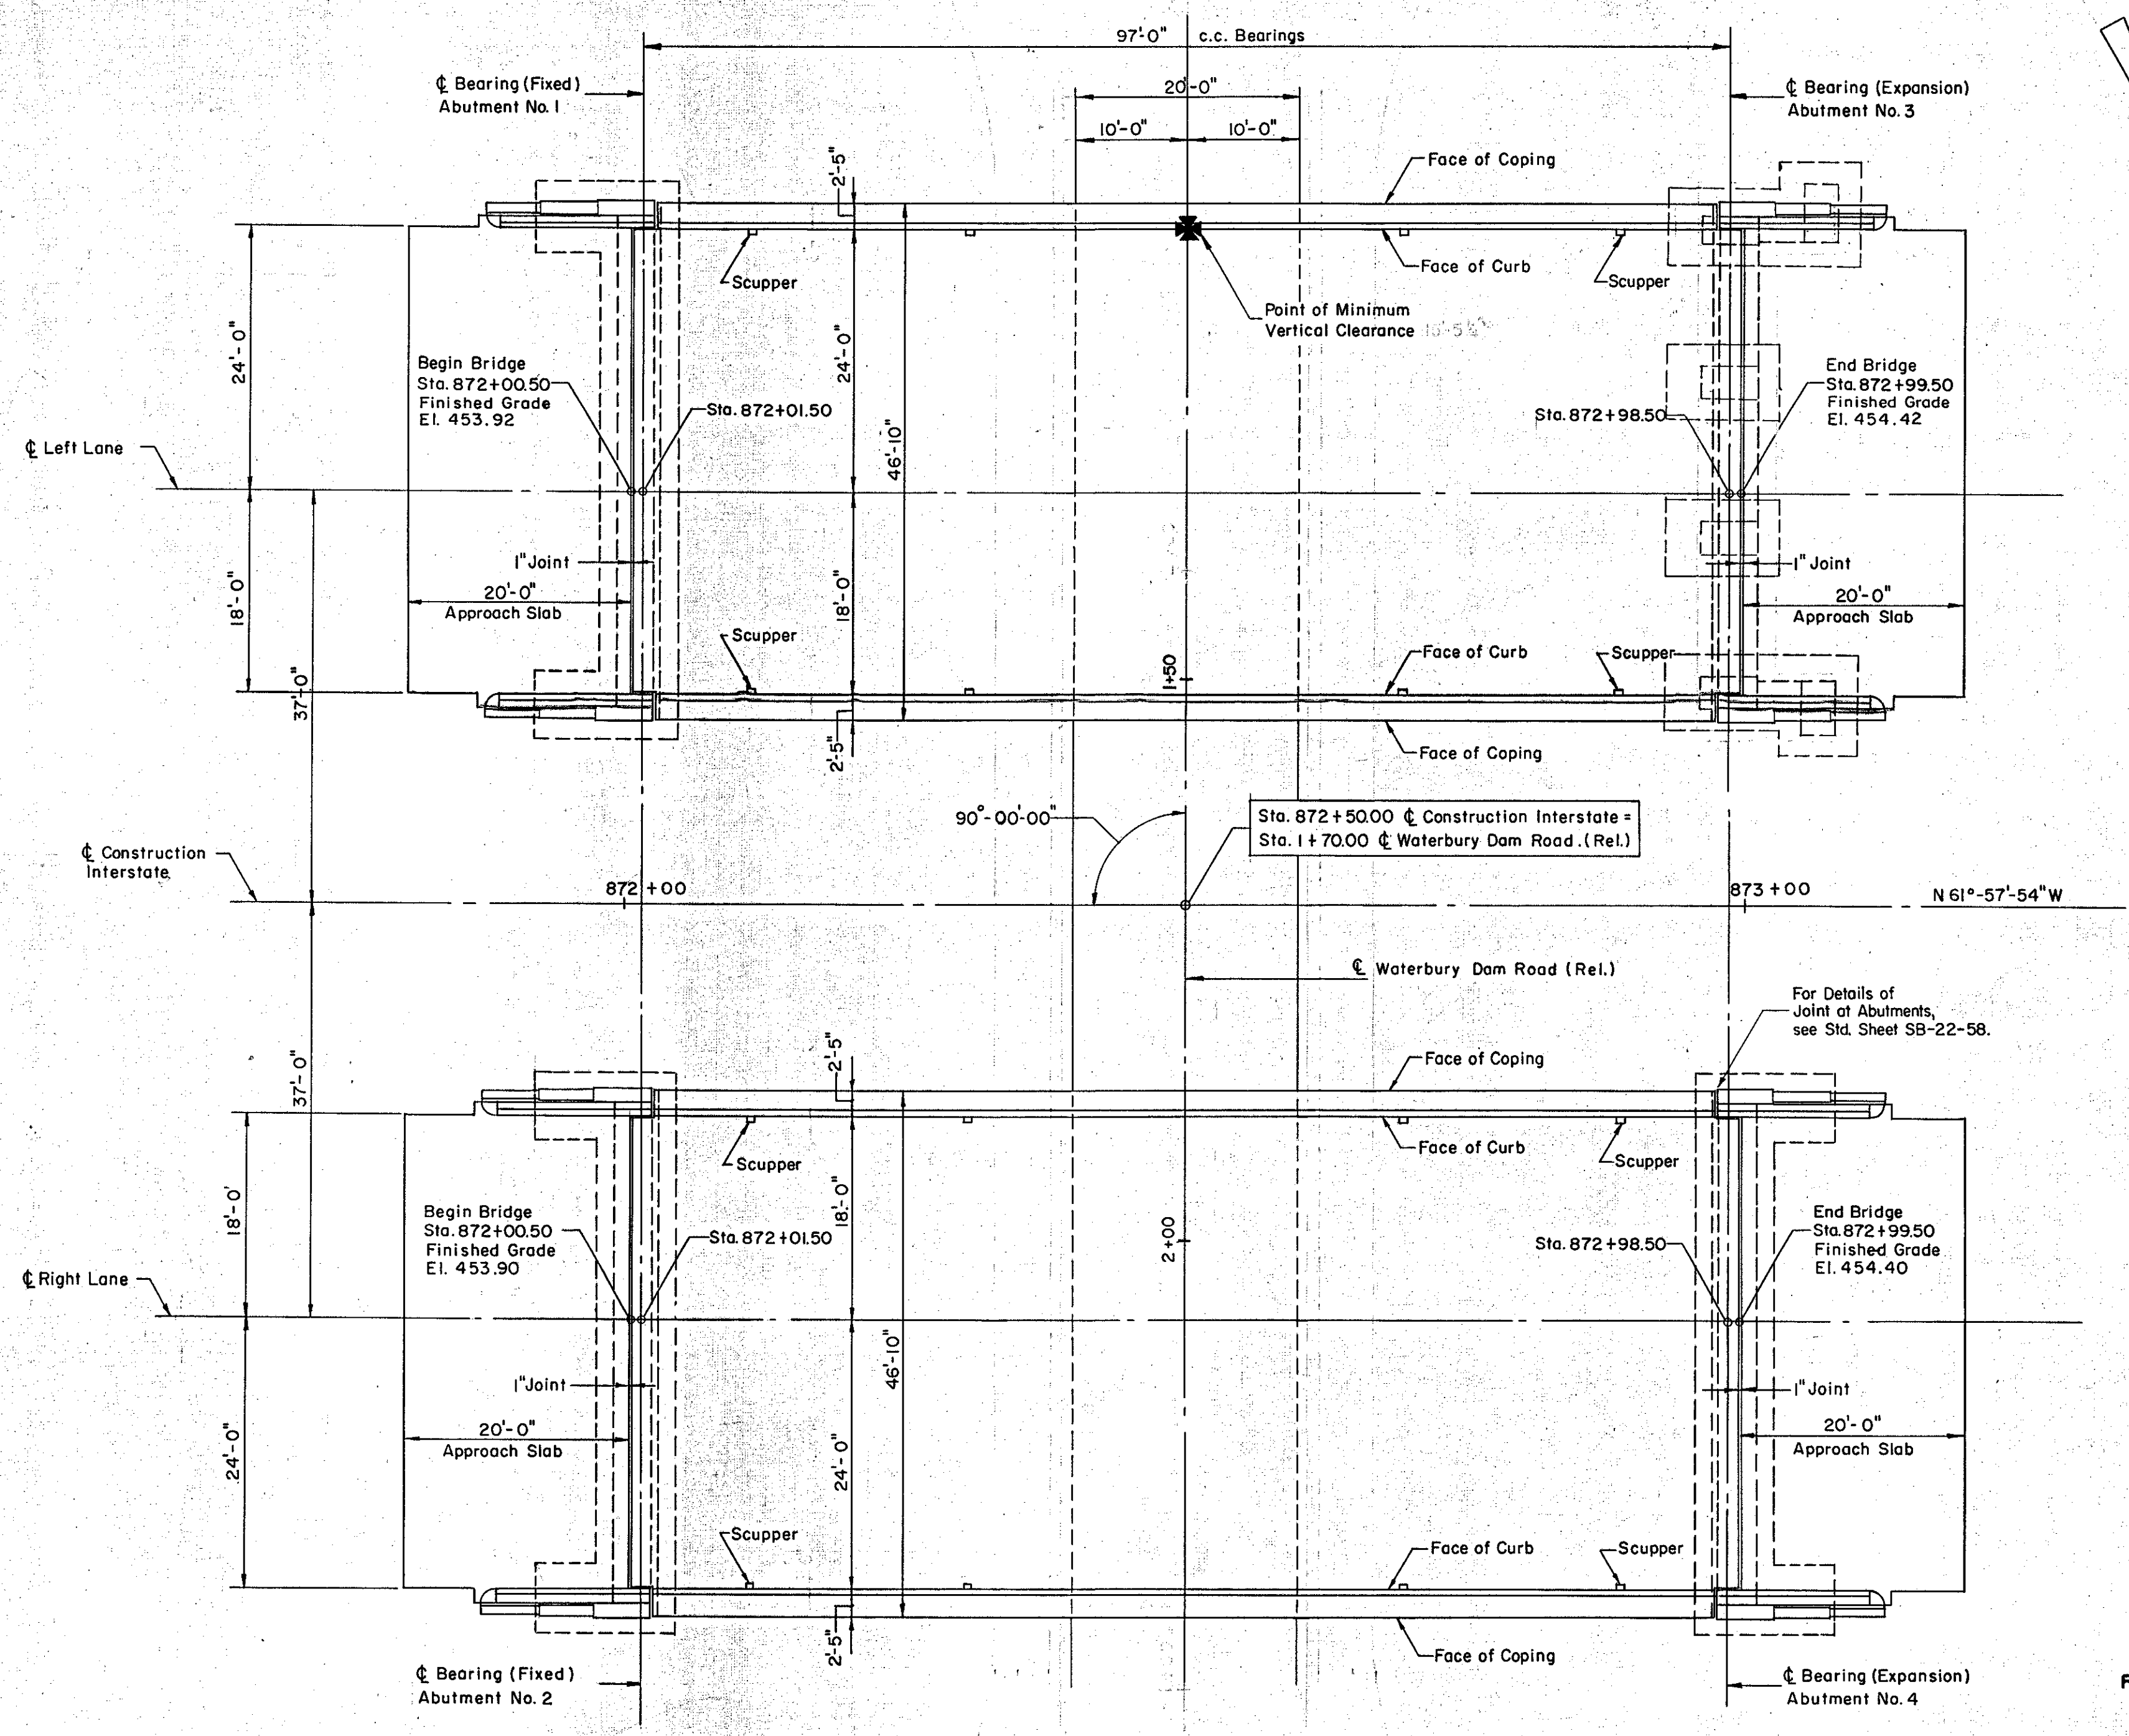

PLAN
Scale: 3/32" = 1'-0"

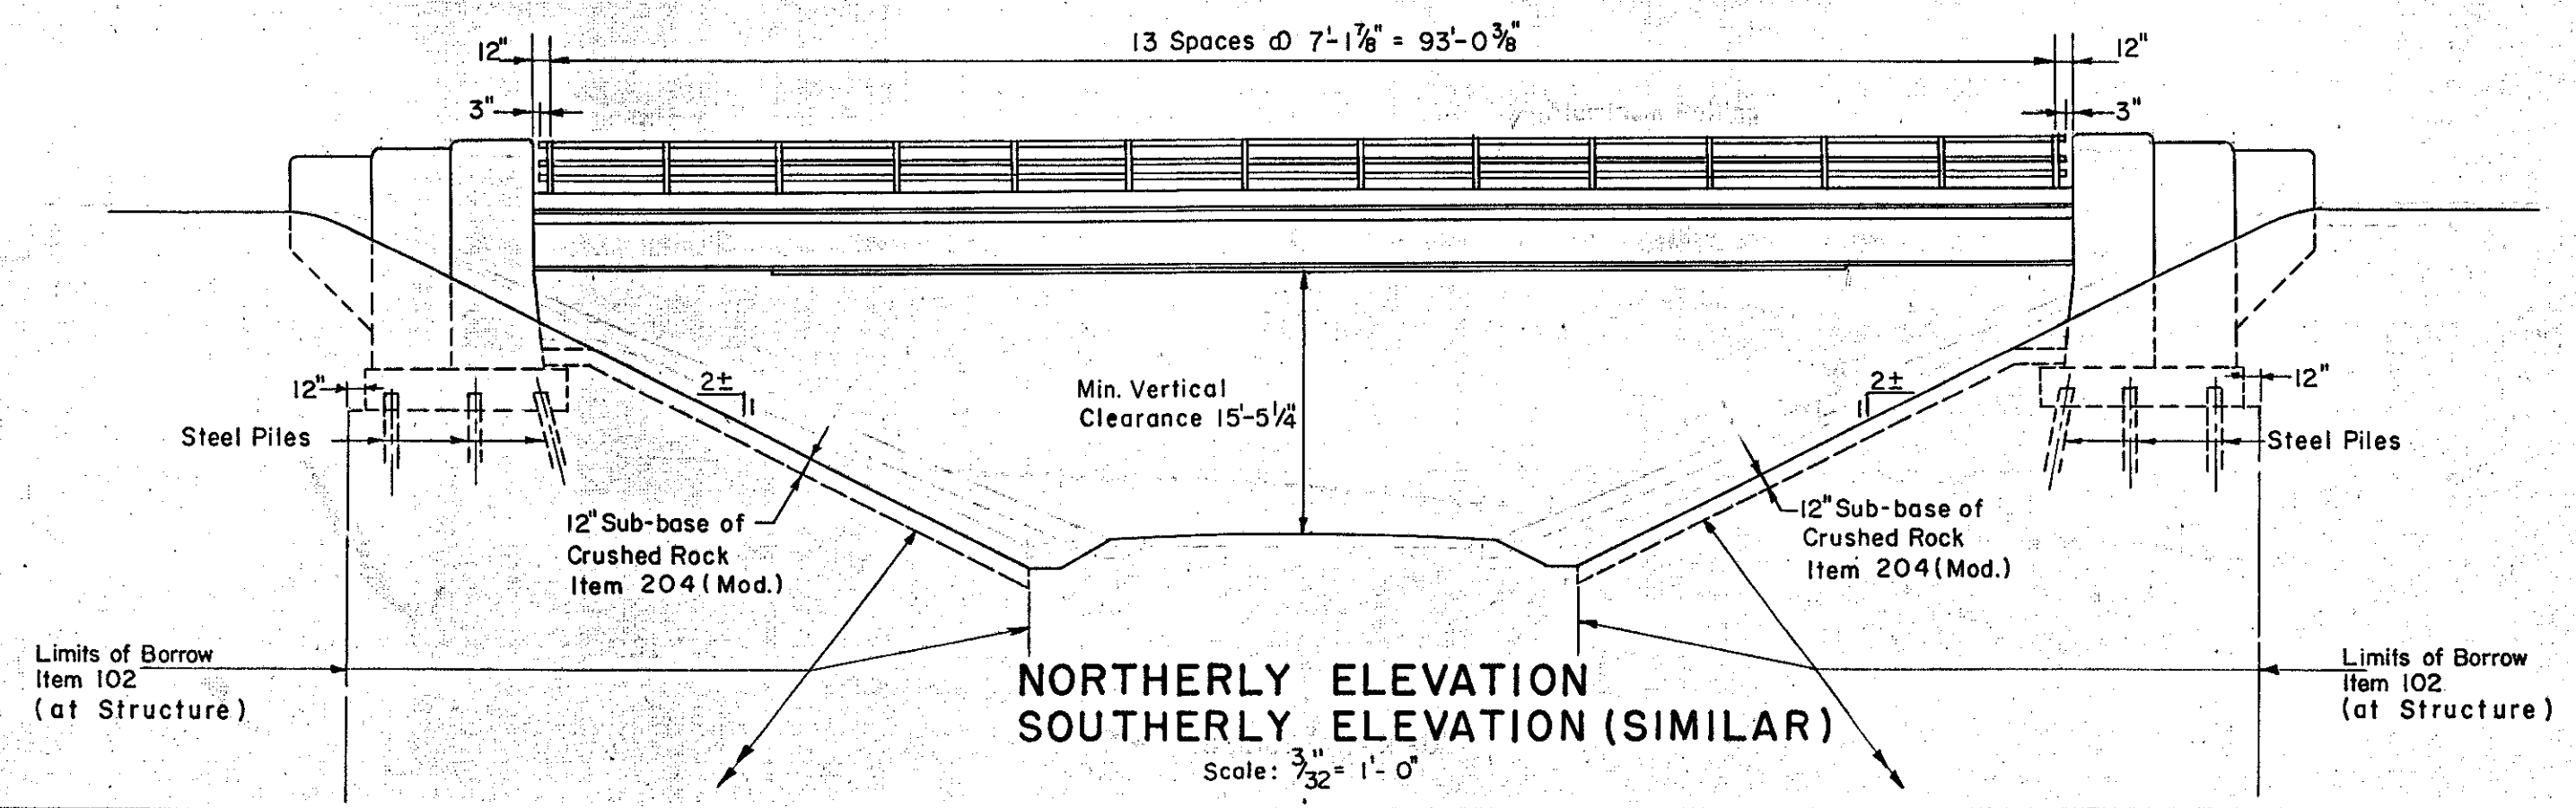

NORTHERLY ELEVATION
SOUTHERLY ELEVATION (SIMILAR)
Scale: 3/32" = 1'-0"

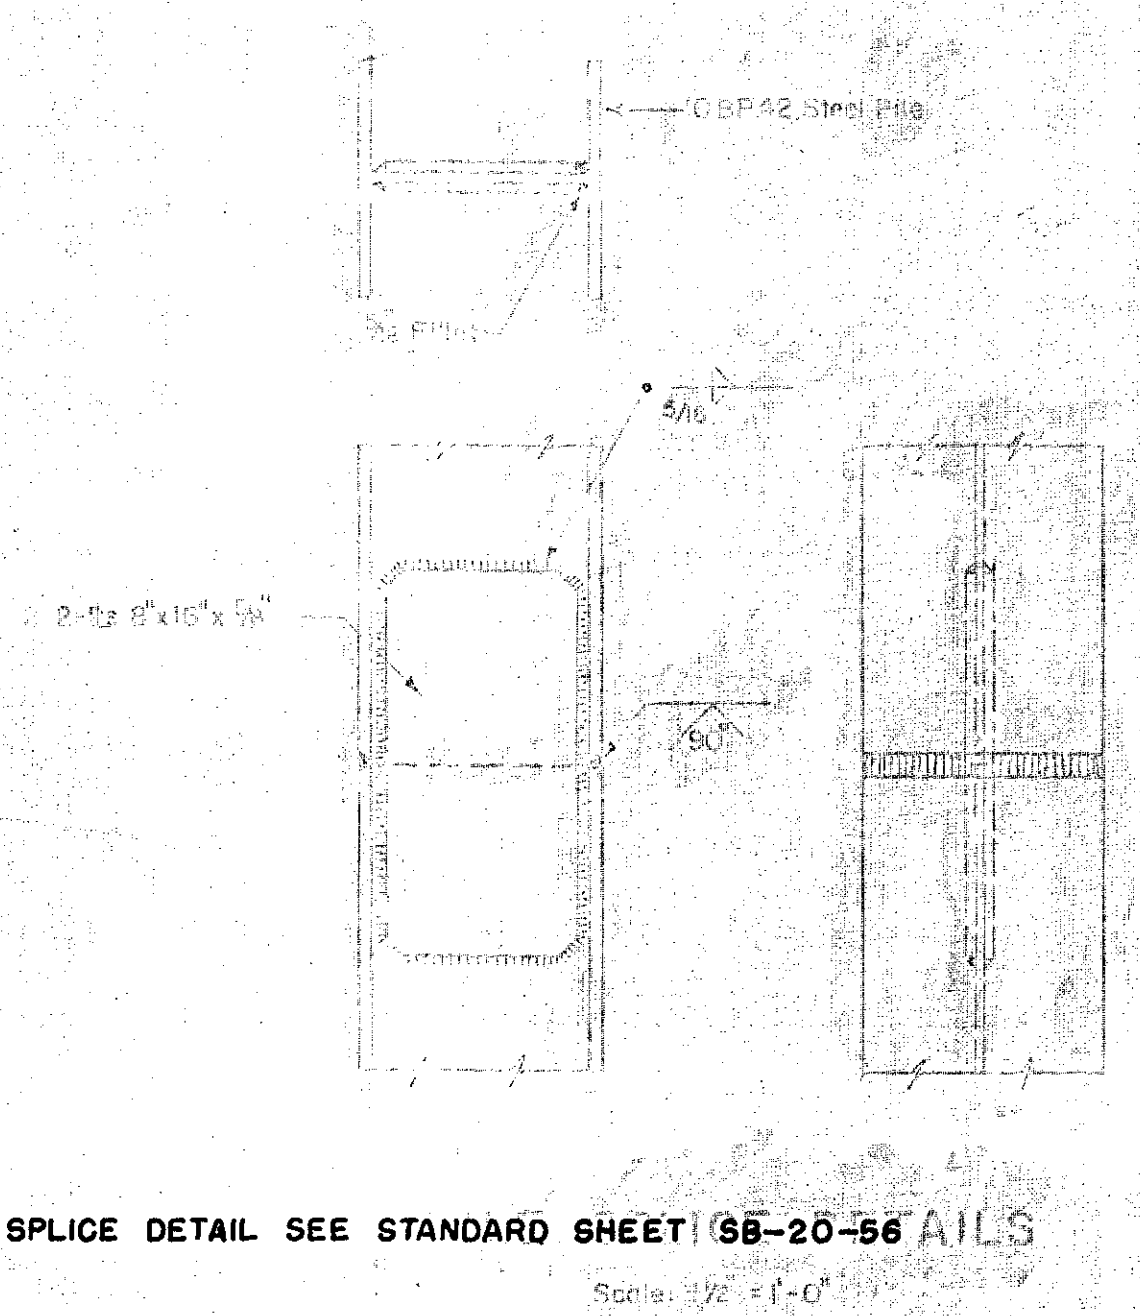

FOR PILE SPLICE DETAIL SEE STANDARD SHEET SB-20-56 PILES
Scale: 1/2" = 1'-0"

- Notes:
1. Railing Posts to be set normal to grade.
 2. For Scupper layout see Framing Plan Sheet No. 7
 3. All dimensions are horizontal dimensions.
 4. For Bridge Marker see Dwg. SB-20-56 (Detail "A")

ESTIMATED QUANTITIES

ITEM NO.	DESCRIPTION	UNIT	QUANTITIES			
			NET	OVER-RUN	TOTAL	FINAL
102	Borrow	C.Y.	10,500	±,050	±1,550	10,500
556-C	Granite Bridge Curb (Type 1)	L.F.	500	-	500	500
572	Bridge Railing	L.F.	378	-	378	378

IM 089-2(26)
This sheet for information only
BR 49 N & S

CONTRACT NO. 1

PLAN AND ELEVATION
STATE OF VERMONT
DEPARTMENT OF HIGHWAYS
INTERSTATE PROJECT in the town of
WATERBURY
INTERSTATE OVER STA. 872+50
WATERBURY DAM RD. (REL.) STA. 1+70
THE CLARKESON ENGINEERING CO., INC.
CONSULTING ENGINEERS MASSACHUSETTS
BOSTON
SURVEYED BY: DRAWN BY H.B.C. CHECKED BY G.B. B.D.S. IN CHARGE J.V.B. SCALE: AS NOTED DATE 6-19-58
PROJECT NO. I-89-2(7) SHEET 239 OF 307