



STATE OF VERMONT  
AGENCY OF TRANSPORTATION



PROPOSED IMPROVEMENT  
TOWNS OF MIDDLESEX, WATERBURY AND BOLTON  
COUNTIES OF CHITTENDEN AND WASHINGTON  
PROJECT AC IM-089-2(26)

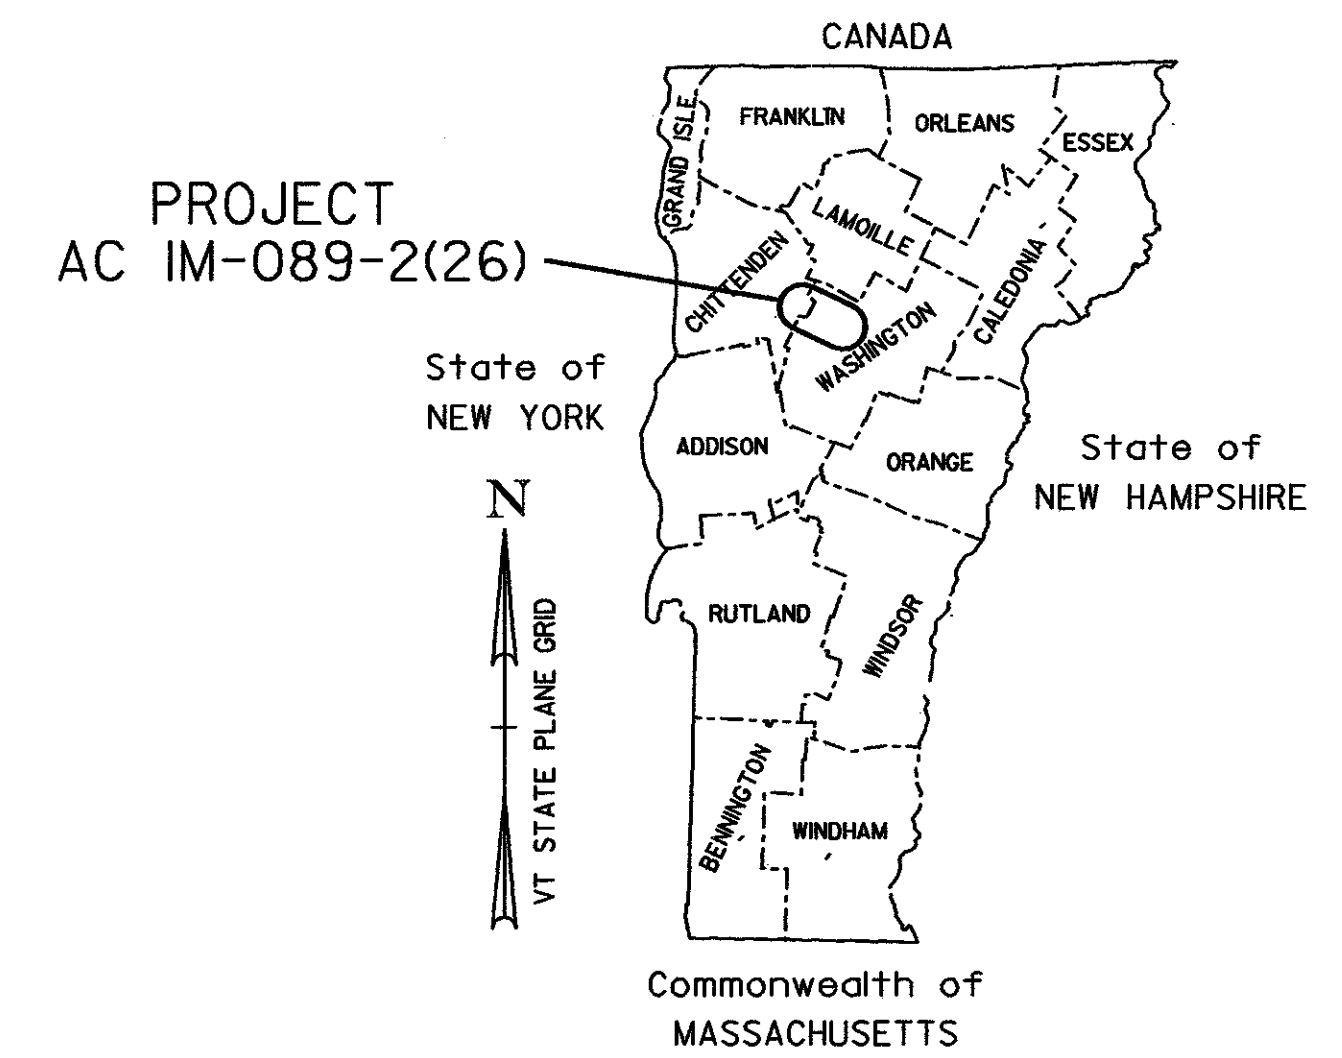


ROUTE NO.:	I-89	PROJECT DESCRIPTION:	INSTALL TRAFFIC CONTROL, REHABILITATE STRUCTURES, REMOVE TRAFFIC CONTROL			
BRIDGE NO.:	43N&S, 48N&S, 49N&S, 50N&S	LENGTH OF STRUCTURES:	BR 43N	175.11'	BR 43S	205.29'
PROJECT LOCATION:	BR 43N&S OVER U.S. ROUTE 2 (MM 54.8)		BR 48N	299.70'	BR 48S	300.70'
	BR 48N&S OVER LITTLE RIVER (MM 65.2)		BR 49N	100.63'	BR 49S	100.73'
	BR 49N&S OVER TH 7 - LITTLE RIVER ROAD (MM 65.4)		BR 50N	237.87'	BR 50S	224.73'
	BR 50N&S OVER U.S. ROUTE 2 (MM 66.6)	TOTAL LENGTH OF STRUCTURES:	1644.76'			

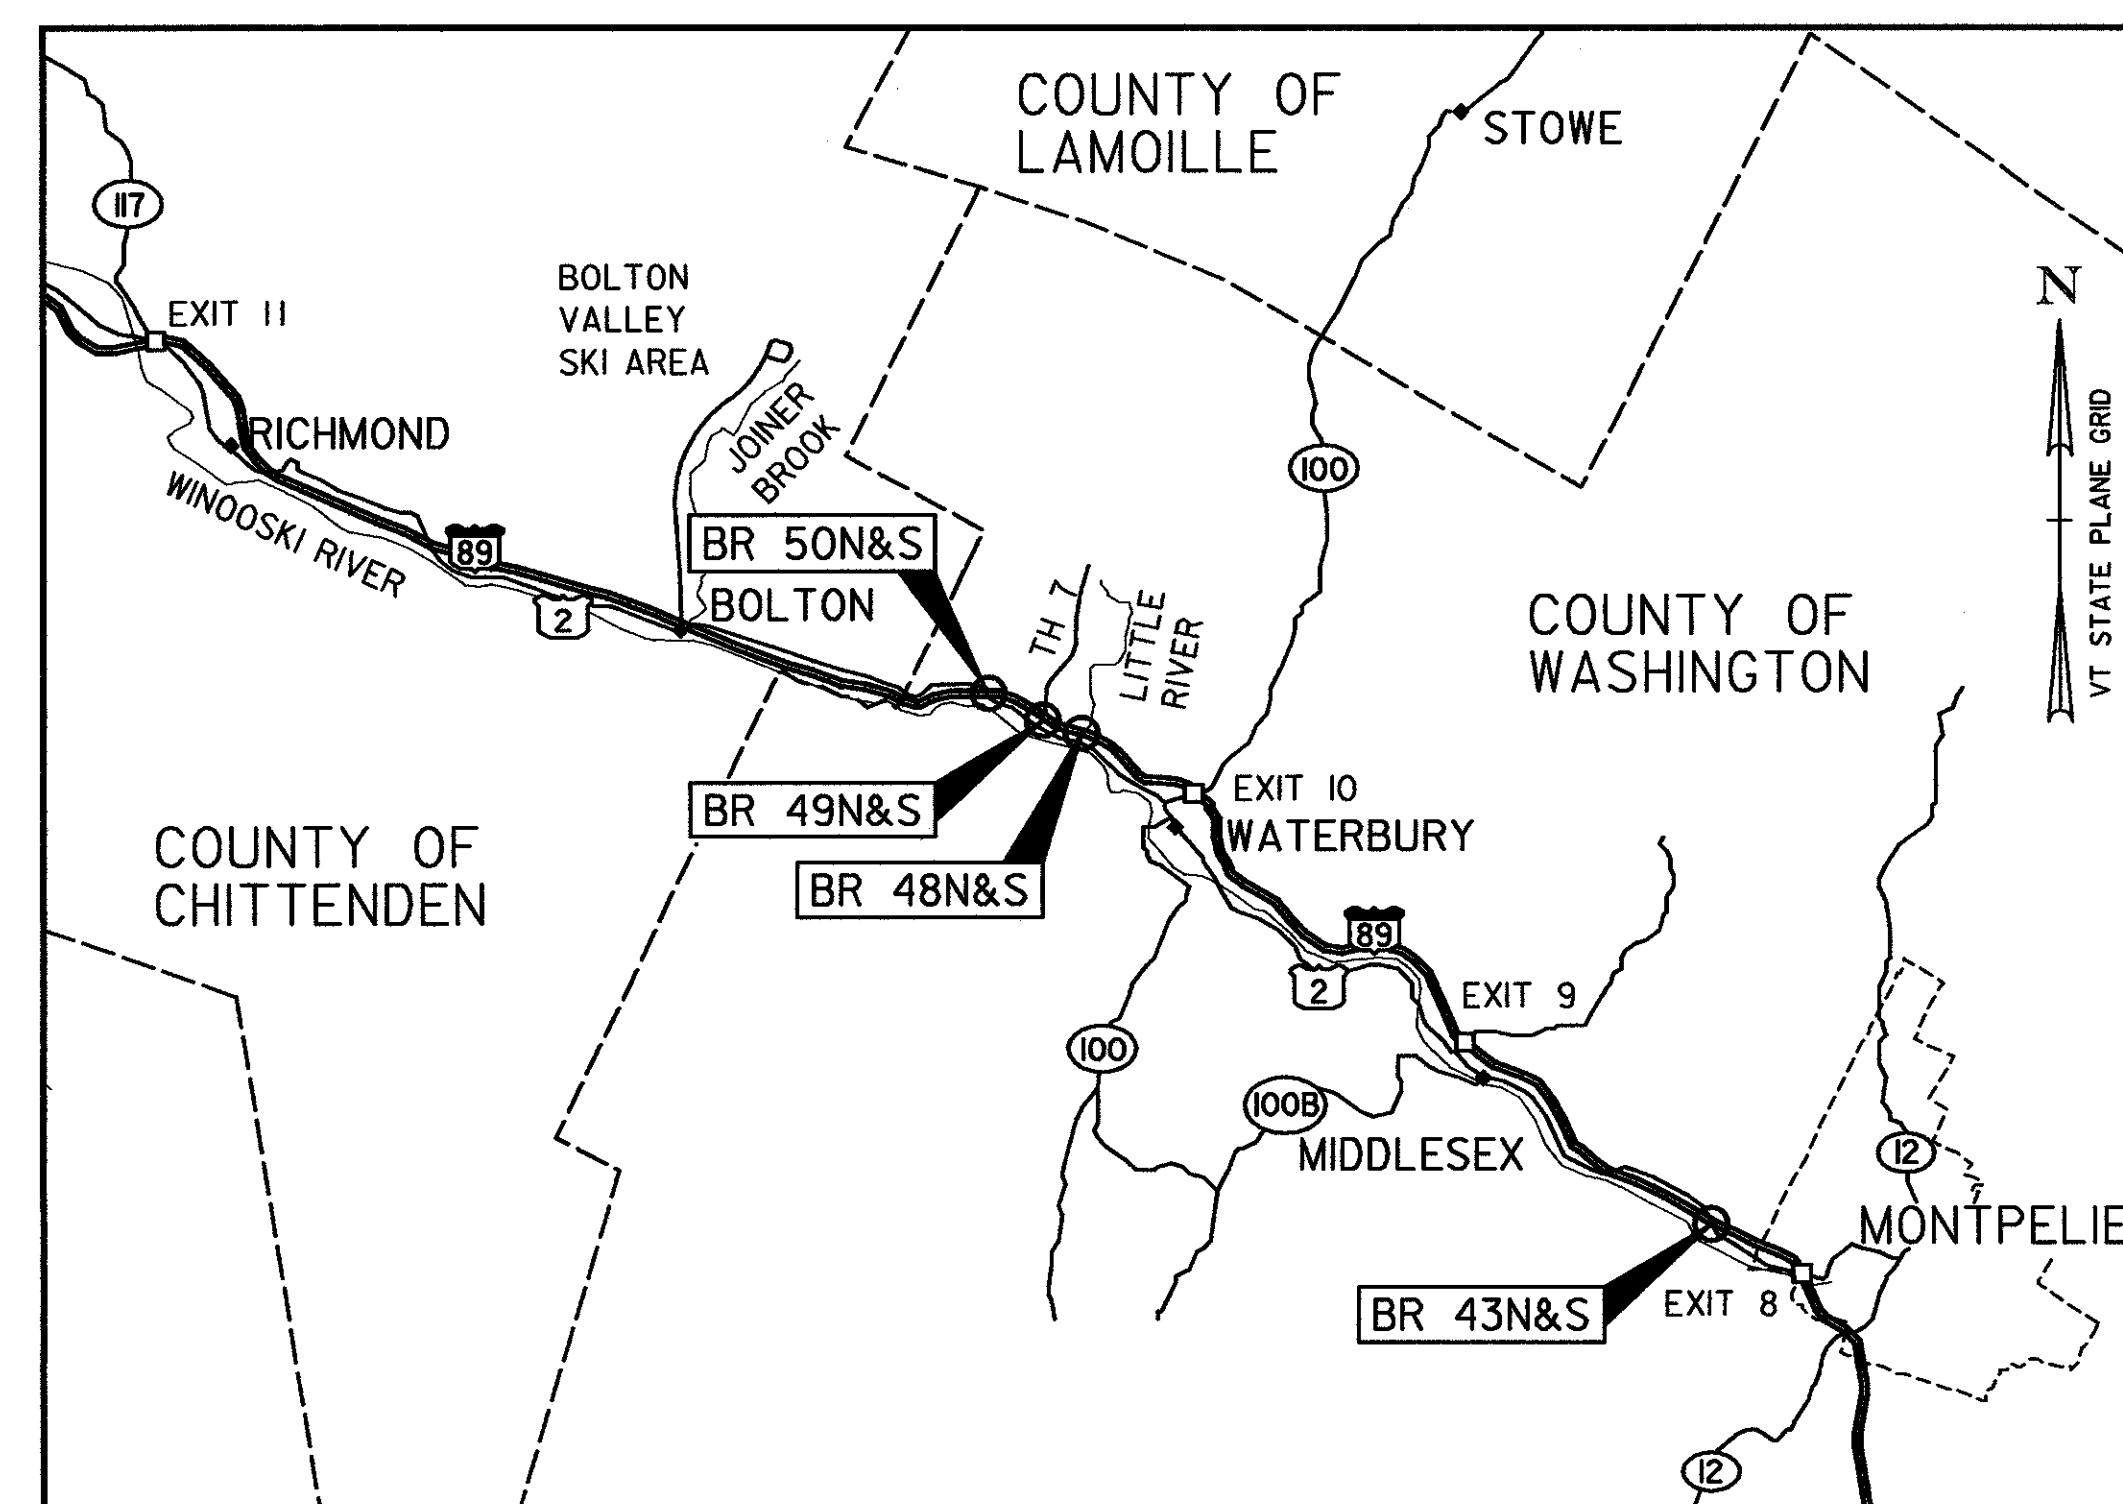

CONVENTIONAL SIGNS

COUNTY LINE	---
TOWN LINE	- - - -
LIMITS OF ACCESS	o-o-o-o
POINT OF ACCESS	X
FENCE LINE	-x-x-
STONE WALL	o-o-o-o-o-o
TRAVELED WAY	- - - - -
GUARD RAIL	o-o-o-o
RAILROAD	
SURVEY LINE	+
CULVERT	- - - - -
POWER POLE	+
TELEPHONE POLE	+
TREES	⊗
CONTROL OF ACCESS	///
PROPERTY LINE	---
R.O.W. TAKING LINE	SR
SLOPE RIGHTS	SR
TOP OF CUT	△
TOE OF SLOPE	○

DATUM  
VERTICAL NAVD 88  
HORIZONTAL NAD 83/92

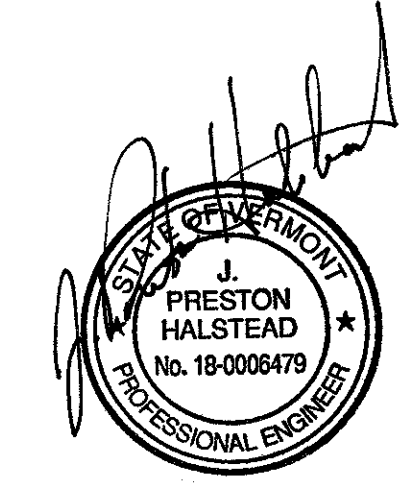

THESE PLANS ARE SUBJECT TO SUCH ENGINEERING CHANGES AS MAY BE REQUIRED BY THE FEDERAL HIGHWAY ADMINISTRATION OR THE CHIEF ENGINEER. CONSTRUCTION IS TO BE CARRIED ON IN ACCORDANCE WITH THESE PLANS AND THE STANDARD SPECIFICATIONS FOR CONSTRUCTION DATED 1990, AS APPROVED BY THE FEDERAL HIGHWAY ADMINISTRATION ON MARCH 15, 1990 FOR USE ON THIS PROJECT, INCLUDING ALL SUBSEQUENT REVISIONS AND SUCH REVISED SPECIFICATIONS AND SPECIAL PROVISIONS AS ARE INCORPORATED IN THESE PLANS.

APPROVED	DATE 4/4/99
DIRECTOR OF PROJECT DEVELOPMENT	
DEPARTMENT OF TRANSPORTATION FEDERAL HIGHWAY ADMINISTRATION	
APPROVED	DATE 8-30-00
DIVISION ADMINISTRATOR	
PROJECT	
SHEET 1 OF 307 SHEETS	




# INDEX OF SHEETS

SHEET	BRIDGE SHEET	COMMON SHEETS	SHEET	BRIDGE SHEET	BRIDGE 48N&S SHEETS	SHEET	BRIDGE SHEET	TRAFFIC CONTROL SHEETS	STANDARD SHEETS
1	C-1	TITLE SHEET	61	BR48-1	GENERAL PLAN (48N&S)	160	TC-1A	TRAFFIC CONTROL NOTES	B-17 02/23/95
2	C-2	INDEX OF SHEETS	62	BR48-2	PROFILE (48N)	161	TC-1B	TRAFFIC CONTROL NOTES	BRI-97 06/05/98
3	C-3	COMPOSITE QUANTITIES	63	BR48-3	PROFILE (48S)	162	TC-2	PHASE I SOUTHBOUND CROSSOVER BRIDGE 43	BR3-97 06/23/98
4	C-4	QUANTITIES (1 OF 3)	64	BR48-4	TRANSVERSE SECTION (48N&S)	163	TC-3	PHASE I SOUTHBOUND CROSSOVER BRIDGE 43	C-1 06/01/99
5	C-5	QUANTITIES (2 OF 3)	65	BR48-5	DECK REINFORCEMENT PLANS (48N&S)	164	TC-4	PHASE I SOUTHBOUND CROSSOVER BRIDGE 43	E-100 01/06/97
6	C-6	QUANTITIES (3 OF 3)	66	BR48-6	APPROACH SLAB DETAILS (48N&S)	165	TC-5	PHASE I SOUTHBOUND CROSSOVER BRIDGE 43	E-100A 01/06/97
7	C-7	GENERAL NOTES (1 OF 2)	67	BR48-7	CURB AND RAIL LAYOUT PLANS (48N&S)	166	TC-6	PHASE I SOUTHBOUND CROSSOVER BRIDGE 43	E-101 03/10/97
8	C-8	GENERAL NOTES (2 OF 2)	68	BR48-8	FRAMING PLAN (48N)	167	TC-7	PHASE I SOUTHBOUND CROSSOVER BRIDGE 43	E-102 08/08/95
9	C-9	BRIDGE INFORMATION SUMMARY	69	BR48-9	FRAMING PLAN (48S)	168	TC-8	PHASE I SOUTHBOUND CROSSOVER BRIDGE 43	E-102A 08/08/95
10	C-10	CONTROL POINT TIES (43N&S)	70	BR48-10	STRINGER ELEVATION (48N&S)	169	TC-9	PHASE I SOUTHBOUND CROSSOVER BRIDGE 43	E-103 09/23/98
11	C-11	CONTROL POINT TIES (48N&S AND 49N&S)	71	BR48-11	ABUTMENT MASONRY (48N)	170	TC-10	PHASE I SOUTHBOUND CROSSOVER BRIDGE 43	E-104 02/03/99
12	C-12	CONTROL POINT TIES (50N&S)	72	BR48-12	ABUTMENT MASONRY (48S)	171	TC-11	PHASE I SOUTHBOUND CROSSOVER BRIDGE 48, 49, & 50	E-104A 12/27/96
13		SHEET NOT USED	73	BR48-13	PIER CAP MASONRY (48N&S)	172	TC-12	PHASE I SOUTHBOUND CROSSOVER BRIDGE 48, 49, & 50	E-105 04/01/99
14	C-14	TRANSVERSE SECTIONS FOR TRAFFIC CONTROL	74	BR48-14	REINFORCING STEEL SCHEDULE (48N&S)	173	TC-13	PHASE I SOUTHBOUND CROSSOVER BRIDGE 48, 49, & 50	E-106 08/08/95
15	C-15	TYPICAL END OF DECK SLAB DETAILS				174	TC-14	PHASE I SOUTHBOUND CROSSOVER BRIDGE 48, 49, & 50	E-107 08/08/95
16	C-16	TYPICAL ROLLED BEAM DETAILS				175	TC-15	PHASE I SOUTHBOUND CROSSOVER BRIDGE 48, 49, & 50	E-107A 08/08/95
17	C-17	TYPICAL PLATE GIRDER DETAILS (1 OF 2)	75	BR49-1	GENERAL PLAN (49N&S)	176	TC-16	PHASE I SOUTHBOUND CROSSOVER BRIDGE 48, 49, & 50	E-108 08/18/95
18	C-18	TYPICAL PLATE GIRDER DETAILS (2 OF 2)	76	BR49-2	PROFILE (49N)	177	TC-17	PHASE I SOUTHBOUND CROSSOVER BRIDGE 48, 49, & 50	E-109 08/08/95
19	C-19	TYPICAL ROLLED BEAM SPLICE DETAILS	77	BR49-3	PROFILE (49S)	178	TC-18	PHASE I SOUTHBOUND CROSSOVER BRIDGE 48, 49, & 50	E-119 08/08/95
20	C-20	TYPICAL GIRDER SPLICE DETAILS	78	BR49-4	TRANSVERSE SECTION (49N&S)	179	TC-19	PHASE I SOUTHBOUND CROSSOVER BRIDGE 48, 49, & 50	E-120 08/08/95
21	C-21	FIXED BEARING DETAILS	79	BR49-5	DECK REINFORCEMENT PLANS (49N&S)	180	TC-20	PHASE I SOUTHBOUND CROSSOVER BRIDGE 48, 49, & 50	E-154 08/08/95
22	C-22	BEARING NOTES & FIXED BRG. TABLES	80	BR49-6	APPROACH SLAB DETAILS (49N&S)	181	TC-21	PHASE I SOUTHBOUND CROSSOVER BRIDGE 48, 49, & 50	E-160 08/18/95
23	C-23	EXPANSION BEARING DETAILS	81	BR49-7	CURB AND RAIL LAYOUT PLANS (49N&S)	182-187		SHEETS NOT USED	E-162 08/18/95
24	C-24	EXPANSION BEARING TABLES	82	BR49-8	ABUTMENT MASONRY (49N)	188	TC-28	PHASE II NORTHBOUND CROSSOVER BRIDGE 43	E-164 05/20/99
25	C-25	SOLE & MASONRY PLATE DETAILS	83	BR49-9	ABUTMENT MASONRY (49S)	189	TC-29	PHASE II NORTHBOUND CROSSOVER BRIDGE 43	E-198 04/14/97
26	C-26	BR 49 FIXED BEARINGS - REPLACE IN KIND	84	BR49-10	REINFORCING STEEL SCHEDULE (49N&S)	190	TC-30	PHASE II NORTHBOUND CROSSOVER BRIDGE 43	E-199 08/18/95
27	C-27	TYPICAL TYPE "H" ABUTMENT JOINT PLAN				191	TC-31	PHASE II NORTHBOUND CROSSOVER BRIDGE 43	G-18 06/01/94
28	C-28	TYPE "H" ABUTMENT JOINT DETAILS (1 OF 3)				192	TC-32	PHASE II NORTHBOUND CROSSOVER BRIDGE 43	G-19 10/21/98
29	C-29	TYPE "H" ABUTMENT JOINT DETAILS (2 OF 3)	85	BR50-1	GENERAL PLAN (50N&S)	193	TC-33	PHASE II NORTHBOUND CROSSOVER BRIDGE 43	T-1 06/01/94
30	C-30	TYPE "H" ABUTMENT JOINT DETAILS (3 OF 3)	86	BR50-2	PROFILE (50N)	194	TC-34	PHASE II NORTHBOUND CROSSOVER BRIDGE 43	T-2 06/01/94
31-34		SHEETS NOT USED	87	BR50-3	PROFILE (50S)	195	TC-35	PHASE II NORTHBOUND CROSSOVER BRIDGE 43	
35	C-35	TYPICAL FINGER JOINT PLAN (BR 48N&S)	88	BR50-4	TRANSVERSE SECTION (50N&S)	196	TC-36	PHASE II NORTHBOUND CROSSOVER BRIDGE 43	
36	C-36	FINGER JOINT DETAILS (1 OF 3)	89	BR50-5	DECK REINFORCEMENT PLANS (50N&S)	197	TC-37	PHASE II NORTHBOUND CROSSOVER BRIDGE 48, 49, & 50	
37	C-37	FINGER JOINT DETAILS (2 OF 3)	90	BR50-6	APPROACH SLAB DETAILS (50N&S)	198	TC-38	PHASE II NORTHBOUND CROSSOVER BRIDGE 48, 49, & 50	
38	C-38	FINGER JOINT DETAILS (3 OF 3)	91	BR50-7	CURB AND RAIL LAYOUT PLANS (50N&S)	199	TC-39	PHASE II NORTHBOUND CROSSOVER BRIDGE 48, 49, & 50	
39	C-39	TYPICAL SCUPPER DETAILS	92	BR50-8	FRAMING PLAN (50N)	200	TC-40	PHASE II NORTHBOUND CROSSOVER BRIDGE 48, 49, & 50	
40	C-40	TYPICAL EXPANSION ABUTMENT REINFORCEMENT	93	BR50-9	FRAMING PLAN (50S)	201	TC-41	PHASE II NORTHBOUND CROSSOVER BRIDGE 48, 49, & 50	
41	C-41	TYPICAL FIXED ABUTMENT REINFORCEMENT	94	BR50-10	STRINGER ELEVATION (50N&S)	202	TC-42	PHASE II NORTHBOUND CROSSOVER BRIDGE 48, 49, & 50	
42	C-42	TYPICAL CURTAINWALL DETAILS	95	BR50-11	ABUTMENT MASONRY (50N)	203	TC-43	PHASE II NORTHBOUND CROSSOVER BRIDGE 48, 49, & 50	
43	C-43	TYPICAL WINGWALL DETAILS (1 OF 2)	96	BR50-12	ABUTMENT MASONRY (50S)	204	TC-44	PHASE II NORTHBOUND CROSSOVER BRIDGE 48, 49, & 50	
44	C-44	TYPICAL WINGWALL DETAILS (2 OF 2)	97	BR50-13	PIER CAP MASONRY AND REINF. (50N&S)	205	TC-45	PHASE II NORTHBOUND CROSSOVER BRIDGE 48, 49, & 50	
45	C-45	SUBSTRUCTURE REPAIR DETAILS AND NOTES	98	BR50-14	REINFORCING STEEL SCHEDULE (50N&S)	206	TC-46	PHASE II NORTHBOUND CROSSOVER BRIDGE 48, 49, & 50	
46	C-46	TYPICAL BRIDGE DETAILS	99-134			207	TC-47	PHASE II NORTHBOUND CROSSOVER BRIDGE 48, 49, & 50	
46A	C-46A	GUARD RAIL APPR. SECTION, NETC 2 RAIL (1 OF 2)				208-214		SHEETS NOT USED	
46B	C-46B	GUARD RAIL APPR. SECTION, NETC 2 RAIL (2 OF 2)							
46C	C-46C	RUMBLE STRIPS	135	SC-1	EXIST. SUBSTR. CONDITION (43N) (1 OF 2)	215-223		REFERENCE SHEETS	
			136	SC-2	EXIST. SUBSTR. CONDITION (43N) (2 OF 2)	224-236		BRIDGE 43N&S REFERENCE SHEETS	
			137	SC-3	EXIST. SUBSTR. CONDITION (43S) (1 OF 2)	237-244		BRIDGE 48N&S REFERENCE SHEETS	
			138	SC-4	EXIST. SUBSTR. CONDITION (43S) (2 OF 2)	245-259		BRIDGE 49N&S REFERENCE SHEETS	
			139	SC-5	EXIST. SUBSTR. CONDITION (48N) (1 OF 3)	260-307		BRIDGE 50N&S REFERENCE SHEETS	
			140	SC-6	EXIST. SUBSTR. CONDITION (48N) (2 OF 3)			SHEETS NOT USED	
			141	SC-7	EXIST. SUBSTR. CONDITION (48N) (3 OF 3)				
			142	SC-8	EXIST. SUBSTR. CONDITION (48S) (1 OF 3)				
			143	SC-9	EXIST. SUBSTR. CONDITION (48S) (2 OF 3)				
			144	SC-10	EXIST. SUBSTR. CONDITION (48S) (3 OF 3)				
			145	SC-11	EXIST. SUBSTR. CONDITION (49N)				
			146	SC-12	EXIST. SUBSTR. CONDITION (49S)				
			147	SC-13	EXIST. SUBSTR. CONDITION (50N) (1 OF 2)				
			148	SC-14	EXIST. SUBSTR. CONDITION (50N) (2 OF 2)				
			149	SC-15	EXIST. SUBSTR. CONDITION (50S) (1 OF 2)				
			150	SC-16	EXIST. SUBSTR. CONDITION (50S) (2 OF 2)				
			151-159		SHEETS NOT USED				

ANY REFERENCE IN THE PLANS OR SPECIFICATIONS TO VAOT OR AOT SHALL BE UNDERSTOOD AS REFERRING TO VTRANS.

NOTE: THIS PROJECT ORIGINALLY INCLUDED BRIDGES 51N&S, WHICH HAVE BEEN SUBSEQUENTLY REMOVED TO FORM A NEW CONSTRUCTION CONTRACT FOR BRIDGES 43N&S, 48N&S, 49N&S, AND 50N&S ONLY. ANY REFERENCE IN THESE PLANS OR IN THE SPECIFICATIONS TO BRIDGES 51N&S SHALL BE IGNORED.

<b>STATE OF VERMONT AGENCY OF TRANSPORTATION</b>	
Town Of	MIDDLESEX-BOLTON
Highway No.	I-89
Bridge No.	
Log Sta.	
Surv. Sta.	
<b>INDEX OF SHEETS</b>	
Designed By	P.W. SZUSTAK
Checked By	J.P. HALSTEAD
Date	10/99
Drawn By	R.A. BOTZENHART
Bridge Design Supervisor	J.P. HALSTEAD
Date	10/99
PROJECT	MIDDLESEX-BOLTON
PROJECT NO.	IM-089-2(26)
TVGA CAD Drawing No.	Istosht
Date	08/00
Bridge Sheet No.	C-2
Sheet	2 of 307

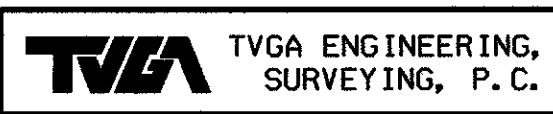

**COMPOSITE QUANTITIES**

ITEM NO.	ITEM DESCRIPTION	UNIT	TOTAL
203.99	SHOULDER BERM REMOVAL	LF	1600
204.20	TRENCH EXCAVATION OF EARTH	CY	60
204.25	STRUCTURE EXCAVATION	CY	720
204.30	GRANULAR BACKFILL FOR STRUCTURES	CY	340
210.10	COLD PLANING-BIT.PAVEMENT	SY	8970
213.10	MILLED RUMBLE STRIPS	LF	8850
301.35	SUBBASE OF DENSE GRADED CRUSHED STONE	CY	100
404.65	EMULSIFIED ASPHALT	CWT	28
406.25	BITUMINOUS CONCRETE PAVEMENT (PG 58-34)	TON	2640
501.221	CONCRETE, CLASS A QC/QA	CY	1840
501.25	CONCRETE, CLASS B	CY	1238
501.60	SILICA-FUME CONCRETE	CY	247
506.50	STRUCTURAL STEEL (ROLLED BEAM)	LB	310070
506.55	STRUCTURAL STEEL(PLATE GIRDER)	LB	1078330
506.60	STRUCTURAL STEEL	LB	4300
507.16	DRILLING AND GROUTING DOWELS	LF	1910
507.17	EPOXY COATED REINFORCING STEEL	LB	692200
507.19	MECHANICAL BAR CONNECTOR	EACH	40
508.15	SHEAR CONNECTORS (2280 - 7/8" x 7" LONG - BR 43N)	LS	1
508.15	SHEAR CONNECTORS (2760 - 7/8" x 7" LONG - BR 43S)	LS	1
508.15	SHEAR CONNECTORS (3140 - 7/8" x 7" LONG - BR 48N)	LS	1
508.15	SHEAR CONNECTORS (3140 - 7/8" x 7" LONG - BR 48S)	LS	1
508.15	SHEAR CONNECTORS (1190 - 7/8" x 7" LONG - BR 49N)	LS	1
508.15	SHEAR CONNECTORS (1190 - 7/8" x 7" LONG - BR 49S)	LS	1
508.15	SHEAR CONNECTORS (2720 - 7/8" x 7" LONG - BR 50N)	LS	1
508.15	SHEAR CONNECTORS (2980 - 7/8" x 7" LONG - BR 50S)	LS	1
513.25	STRUCTURAL PAINTING,SHOP APPLIED (BR 43N - 4 TONS)	LS	1
513.25	STRUCTURAL PAINTING,SHOP APPLIED (BR 43S - 4 TONS)	LS	1
513.25	STRUCTURAL PAINTING,SHOP APPLIED (BR 48N - 6 TONS)	LS	1
513.25	STRUCTURAL PAINTING,SHOP APPLIED (BR 48S - 6 TONS)	LS	1
513.25	STRUCTURAL PAINTING,SHOP APPLIED (BR 50N - 5 TONS)	LS	1
513.25	STRUCTURAL PAINTING,SHOP APPLIED (BR 50S - 5 TONS)	LS	1
513.30	STRUCTURAL PAINTING,FIELD APPLIED (BR 49N - 132 TONS)	LS	1
513.30	STRUCTURAL PAINTING,FIELD APPLIED (BR 49S - 132 TONS)	LS	1
513.35	CONTAINMENT & ENVIRONMENTAL PROTECTION,SHOP (BR 43N - 4 TONS)	LS	1
513.35	CONTAINMENT & ENVIRONMENTAL PROTECTION,SHOP (BR 43S - 4 TONS)	LS	1
513.35	CONTAINMENT & ENVIRONMENTAL PROTECTION,SHOP (BR 48N - 6 TONS)	LS	1
513.35	CONTAINMENT & ENVIRONMENTAL PROTECTION,SHOP (BR 48S - 6 TONS)	LS	1
513.35	CONTAINMENT & ENVIRONMENTAL PROTECTION,SHOP (BR 50N - 5 TONS)	LS	1
513.35	CONTAINMENT & ENVIRONMENTAL PROTECTION,SHOP (BR 50S - 5 TONS)	LS	1
513.36	CONTAINMENT & ENVIRONMENTAL PROTECTION,FIELD (BR 49N - 132 TONS)	LS	1
513.36	CONTAINMENT & ENVIRONMENTAL PROTECTION,FIELD (BR 49S - 132 TONS)	LS	1
513.40	SURFACE PREPARATION,SHOP (BR 43N - 4 TONS)	LS	1
513.40	SURFACE PREPARATION,SHOP (BR 43S - 4 TONS)	LS	1
513.40	SURFACE PREPARATION,SHOP (BR 48N - 6 TONS)	LS	1
513.40	SURFACE PREPARATION,SHOP (BR 48S - 6 TONS)	LS	1
513.40	SURFACE PREPARATION,SHOP (BR 50N - 5 TONS)	LS	1
513.40	SURFACE PREPARATION,SHOP (BR 50S - 5 TONS)	LS	1
513.41	SURFACE PREPARATION, FIELD (BR 49N - 132 TONS)	LS	1
513.41	SURFACE PREPARATION, FIELD (BR 49S - 132 TONS)	LS	1
514.10	WATER REPELLENT	GAL	160
516.10	BRIDGE EXPANSION JOINT (ARMORED JOINT)	LF	302
516.10	BRIDGE EXPANSION JOINT (FINGER JOINT)	LF	81
519.20	SHEET MEMBRANE WATERPROOFING (MOD. - TORCH APPLIED)	SY	7600
524.21	JOINT SEALER, POLYURETHANE	LF	900
525.10	REMOVAL OF EXISTING RAILING (MOD. - SALVAGE)	LF	4690
525.33	BRIDGE RAILING - NETC 2 RAIL	LF	3730
527.11	TRAFFIC PROTECTION FOR BRIDGE PROJECT (BR 43N)	LS	1
527.11	TRAFFIC PROTECTION FOR BRIDGE PROJECT (BR 43S)	LS	1
527.11	TRAFFIC PROTECTION FOR BRIDGE PROJECT (BR 48N)	LS	1
527.11	TRAFFIC PROTECTION FOR BRIDGE PROJECT (BR 48S)	LS	1
527.11	TRAFFIC PROTECTION FOR BRIDGE PROJECT (BR 49N)	LS	1
527.11	TRAFFIC PROTECTION FOR BRIDGE PROJECT (BR 49S)	LS	1
527.11	TRAFFIC PROTECTION FOR BRIDGE PROJECT (BR 50N)	LS	1
527.11	TRAFFIC PROTECTION FOR BRIDGE PROJECT (BR 50S)	LS	1

ITEM NO.	ITEM DESCRIPTION	UNIT	TOTAL
529.10	REMOVAL OF BRIDGE PAVEMENT	SY	7090
529.20	PARTIAL REMOVAL OF STRUCTURE (BR 43N)	EACH	1
529.20	PARTIAL REMOVAL OF STRUCTURE (BR 43S)	EACH	1
529.20	PARTIAL REMOVAL OF STRUCTURE (BR 48N)	EACH	1
529.20	PARTIAL REMOVAL OF STRUCTURE (BR 48S)	EACH	1
529.20	PARTIAL REMOVAL OF STRUCTURE (BR 49N)	EACH	1
529.20	PARTIAL REMOVAL OF STRUCTURE (BR 49S)	EACH	1
529.20	PARTIAL REMOVAL OF STRUCTURE (BR 50N)	EACH	1
529.20	PARTIAL REMOVAL OF STRUCTURE (BR 50S)	EACH	1
529.20	PARTIAL REMOVAL OF STRUCTURE (MOD. - EXISTING STEEL BEAMS - BR 43N)	EACH	1
529.20	PARTIAL REMOVAL OF STRUCTURE (MOD. - EXISTING STEEL BEAMS - BR 43S)	EACH	1
529.20	PARTIAL REMOVAL OF STRUCTURE (MOD. - EXISTING STEEL BEAMS - BR 48N)	EACH	1
529.20	PARTIAL REMOVAL OF STRUCTURE (MOD. - EXISTING STEEL BEAMS - BR 48S)	EACH	1
529.20	PARTIAL REMOVAL OF STRUCTURE (MOD. - EXISTING STEEL BEAMS - BR 50N)	EACH	1
529.20	PARTIAL REMOVAL OF STRUCTURE (MOD. - EXISTING STEEL BEAMS - BR 50S)	EACH	1
531.10	BEARING DEVICE ASSEMBLY (STEEL PLT. FIXED BEARINGS)	EACH	4
531.10	BEARING DEVICE ASSEMBLY (ELASTOMERIC TFE EXP. BEARINGS)	EACH	104
531.10	BEARING DEVICE ASSEMBLY (ELASTOMERIC FIXED BEARINGS)	EACH	30
580.13	REPAIR OF CONCRETE SUBSTRUCTURE SURFACE CLASS I	SY	51
580.14	REPAIR OF CONCRETE SUBSTRUCTURE SURFACE CLASS II	SY	273
580.15	REPAIR OF CONCRETE SUBSTRUCTURE SURFACE CLASS III	CY	8
580.40	FIBER REINFORCED POLYMER WRAP	SY	203
613.10	STONE FILL, TYPE I	CY	80
613.11	STONE FILL, TYPE II	CY	30
613.13	STONE FILL, TYPE IV	CY	50
616.28	CAST-IN PLACE CEMENT CONCRETE CURB, TYPE B	LF	1280
620.25	WOVEN WIRE FENCE W/STEEL POSTS	LF	800
620.55	REMOVAL OF EXISTING FENCE	LF	800
620.75	SNOW BARRIER - GALVANIZED	LF	860
621.20	STEEL BEAM GUARD RAIL	LF	300
621.505	MANUFACTURED TERMINAL SECTION	EACH	16
621.57	ENERGY ABSORPTION ATTENUATOR	EACH	2
621.72	GUARD RAIL APPR. SECTION,NETC 2 RAIL (MOD.)	EACH	32
621.75	REMOVING AND RESET GUARD RAIL	LF	290
621.80	REMOVL AND DISP OF GUARD RAIL	LF	1100
621.90	TEMPORARY TRAFFIC BARRIER	LF	34350
630.10	UNIFORMED TRAFFIC OFFICERS	HR	2700
630.15	FLAGGERS	HR	1750
631.10	FIELD OFFICE-ENGINEERS	LS	1
631.16	TESTING EQUIPMENT - CONCRETE	LS	1
631.17	TESTING EQUIPMENT - BITUMINOUS	LS	1
631.18	TESTING EQUIPMENT - PROTECTIVE COATINGS	LS	1
631.25	FIELD OFFICE - TELEPHONE (N.A.B.I.)	LU	1
634.10	EMPLOYEE TRAINEESHIP	HR	2080
635.10	MOBILIZATION	LS	1
641.10	TRAFFIC CONTROL (BR 43N&S)	LS	1
641.10	TRAFFIC CONTROL (BR 48N&S, 49N&S, 50N&S)	LS	1
641.10	TRAFFIC CONTROL (MOD. - PUBLIC RELATIONS OFFICER)	LS	1
641.15	PORTABLE CHANGEABLE MESSAGE SIGN	EACH	6
641.16	PORTABLE ARROW BOARD	EACH	8
646.414	DURABLE 6" WHITE LINE	LF	5270
646.415	DURABLE 6" YELLOW LINE	LF	4220
646.60	TEMPORARY 4" WHITE LINE	LF	3900
646.60	TEMPORARY 4" WHITE LINE (TAPE, TYPE II)	LF	68850
646.61	TEMPORARY 4" YELLOW LINE	LF	3650
646.61	TEMPORARY 4" YELLOW LINE (TAPE, TYPE II)	LF	79500
646.81	RAISED PAVEMENT MARKERS TYPE II	EACH	8100
646.86	BLACK PAVEMENT MARKING MASKING TAPE	SF	26050
649.31	GEOTEXTILE UNDER STONE FILL	SY	40
649.51	GEOTEXTILE FOR SILT FENCE	SY	2000
651.26	HAY BALES FOR EROSION CONTROL	EACH	320
654.10	EROSION MATTING	SY	800
675.20	TRAFFIC SIGNS, TYPE A (MOD.)	SF	80

**STATE OF VERMONT  
AGENCY OF TRANSPORTATION**

Town Of	MIDDLESEX-BOLTON	Bridge No.	
Highway No.	I-89	Log Sta.	
		Surv. Sta.	

COMPOSITE QUANTITIES			
Designed By	P.W. SZUSTAK	Drawn By	R.A. BOTZENHART
Checked By	Date	Bridge Design Supervisor	
J.P. HALSTEAD	10/99	J.P. HALSTEAD	Date 10/99
PROJECT	MIDDLESEX-BOLTON	PROJECT NO.	IM-089-2(26)
TVGA CAD Drawing No.	quantities	Date	08/00
Bridge Sheet No.	C-3	Sheet	3 of 307



**QUANTITIES**

ITEM NO.	ITEM DESCRIPTION	UNIT	IM 089-2(26)										TOTAL	
			43N	43S	48N	48S	49N	49S	50N	50S	TRAINING	FULL C&E		
203.99	SHOULDER BERM REMOVAL	LF	200	200	200	200	200	200	200	200	200			1600
204.20	TRENCH EXCAVATION OF EARTH	CY	10	10			10	10	10	10				60
204.25	STRUCTURE EXCAVATION	CY	120	120	80	80	70	70	90	90				720
204.30	GRANULAR BACKFILL FOR STRUCTURES	CY	70	60	30	40	30	30	30	50				340
210.10	COLD PLANING-BIT.PAVEMENT	SY	1030	1060	1490	1100	1630	1610	400	650				8970
213.10	MILLED RUMBLE STRIPS	LF	1600	1750	1050	950	1050	1100	600	750				8850
301.35	SUBBASE OF DENSE GRADED CRUSHED STONE	CY	20	20	10	10			20	20				100
404.85	EMULSIFIED ASPHALT	CWT	3	3	4	4	4	4	3	3				28
406.25	BITUMINOUS CONCRETE PAVEMENT (PG 58-34)	TON	400	410	350	330	300	300	270	280				2640
501.221	CONCRETE, CLASS A QC/QA	CY	190	222	315	316	149	149	256	243				1840
501.25	CONCRETE, CLASS B	CY	186	185	124	124	131	132	186	170				1238
501.60	SILICA-FUME CONCRETE	CY	26	30	44	44	17	17	36	33				247
506.50	STRUCTURAL STEEL (ROLLED BEAM)	LB	133520	170950			2800	2800						310070
506.55	STRUCTURAL STEEL(PLATE GIRDER)	LB			327970	328850			219780	201730				1078330
506.60	STRUCTURAL STEEL	LB	400	400	550	550	800	800	400	400				4300
507.16	DRILLING AND GROUTING DOWELS	LF	280	280	230	230	160	170	280	280				1910
507.17	EPOXY COATED REINFORCING STEEL	LB	82430	90240	107340	107140	54380	54370	101060	95240				692200
507.19	MECHANICAL BAR CONNECTOR	EACH	20	20										40
508.15	SHEAR CONNECTORS (2280 - 7/8" x 7" LONG - BR 43N)	LS	1											1
508.15	SHEAR CONNECTORS (2760 - 7/8" x 7" LONG - BR 43S)	LS		1										1
508.15	SHEAR CONNECTORS (3140 - 7/8" x 7" LONG - BR 48N)	LS			1									1
508.15	SHEAR CONNECTORS (3140 - 7/8" x 7" LONG - BR 48S)	LS				1								1
508.15	SHEAR CONNECTORS (1190 - 7/8" x 7" LONG - BR 49N)	LS					1							1
508.15	SHEAR CONNECTORS (1190 - 7/8" x 7" LONG - BR 49S)	LS						1						1
508.15	SHEAR CONNECTORS (2720 - 7/8" x 7" LONG - BR 50N)	LS							1					1
508.15	SHEAR CONNECTORS (2980 - 7/8" x 7" LONG - BR 50S)	LS								1				1
513.25	STRUCTURAL PAINTING,SHOP APPLIED (BR 43N - 4 TONS)	LS	1											1
513.25	STRUCTURAL PAINTING,SHOP APPLIED (BR 43S - 4 TONS)	LS		1										1
513.25	STRUCTURAL PAINTING,SHOP APPLIED (BR 48N - 6 TONS)	LS			1									1
513.25	STRUCTURAL PAINTING,SHOP APPLIED (BR 48S - 6 TONS)	LS				1								1
513.25	STRUCTURAL PAINTING,SHOP APPLIED (BR 50N - 5 TONS)	LS							1					1
513.25	STRUCTURAL PAINTING,SHOP APPLIED (BR 50S - 5 TONS)	LS								1				1
513.30	STRUCTURAL PAINTING,FIELD APPLIED (BR 49N - 132 TONS)	LS					1							1
513.30	STRUCTURAL PAINTING,FIELD APPLIED (BR 49S - 132 TONS)	LS						1						1
513.35	CONTAINMENT & ENVIRONMENTAL PROTECTION,SHOP (BR 43N - 4 TONS)	LS	1											1
513.35	CONTAINMENT & ENVIRONMENTAL PROTECTION,SHOP (BR 43S - 4 TONS)	LS		1										1
513.35	CONTAINMENT & ENVIRONMENTAL PROTECTION,SHOP (BR 48N - 6 TONS)	LS			1									1
513.35	CONTAINMENT & ENVIRONMENTAL PROTECTION,SHOP (BR 48S - 6 TONS)	LS				1								1
513.35	CONTAINMENT & ENVIRONMENTAL PROTECTION,SHOP (BR 50N - 5 TONS)	LS							1					1
513.35	CONTAINMENT & ENVIRONMENTAL PROTECTION,SHOP (BR 50S - 5 TONS)	LS								1				1
513.36	CONTAINMENT & ENVIRONMENTAL PROTECTION,FIELD (BR 49N - 132 TONS)	LS					1							1
513.36	CONTAINMENT & ENVIRONMENTAL PROTECTION,FIELD (BR 49S - 132 TONS)	LS						1						1
513.40	SURFACE PREPARATION,SHOP (BR 43N - 4 TONS)	LS	1											1


**STATE OF VERMONT  
AGENCY OF TRANSPORTATION**

Town Of	MIDDLESEX-BOLTON	Bridge No.	
Highway No.	I-89	Log Sta.	
		Surv. Sta.	

**QUANTITIES (1 OF 3)**

Designed By	P.W. SZUSTAK	Drawn By	R.A. BOTZENHART
Checked By	Date	Bridge Design Supervisor	
J.P. HALSTEAD	10/99	J.P. HALSTEAD	Date 10/99

PROJECT	MIDDLESEX-BOLTON	PROJECT NO.	IM-089-2(26)
---------	------------------	-------------	--------------

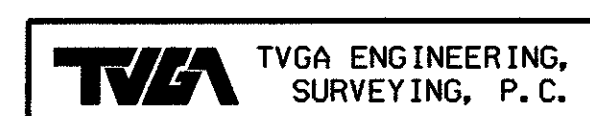

TVGA CAD Drawing No.	quantities	Date	08/00
Bridge Sheet No.	C-4	Sheet	4 of 307

**QUANTITIES**

ITEM NO.	ITEM DESCRIPTION	UNIT	IM 089-2(26)										TOTAL		
			43N	43S	48N	48S	49N	49S	50N	50S	TRAINING	FULL C&E			
513.40	SURFACE PREPARATION,SHOP (BR 43S - 4 TONS)	LS		1											1
513.40	SURFACE PREPARATION,SHOP (BR 48N - 6 TONS)	LS			1										1
513.40	SURFACE PREPARATION,SHOP (BR 48S - 6 TONS)	LS				1									1
513.40	SURFACE PREPARATION,SHOP (BR 50N - 5 TONS)	LS								1					1
513.40	SURFACE PREPARATION,SHOP (BR 50S - 5 TONS)	LS									1				1
513.41	SURFACE PREPARATION, FIELD (BR 49N - 132 TONS)	LS						1							1
513.41	SURFACE PREPARATION, FIELD (BR 49S - 132 TONS)	LS							1						1
514.10	WATER REPELLENT	GAL	20	20	30	30	10	10	20	20					160
516.10	BRIDGE EXPANSION JOINT (ARMORED JOINT)	LF	52	51			48	48	53	50					302
516.10	BRIDGE EXPANSION JOINT (FINGER JOINT)	LF			41	40									81
519.20	SHEET MEMBRANE WATERPROOFING (MOD. - TORCH APPLIED)	SY	810	920	1220	1220	700	700	1040	990					7600
524.21	JOINT SEALER, POLYURETHANE	LF	100	110	160	160	60	60	130	120					900
525.10	REMOVAL OF EXISTING RAILING (MOD. - SALVAGE)	LF	510	580	780	780	380	380	660	620					4690
525.33	BRIDGE RAILING - NETC 2 RAIL	LF	390	460	660	660	260	260	540	500					3730
527.11	TRAFFIC PROTECTION FOR BRIDGE PROJECT (BR 43N)	LS	1												1
527.11	TRAFFIC PROTECTION FOR BRIDGE PROJECT (BR 43S)	LS		1											1
527.11	TRAFFIC PROTECTION FOR BRIDGE PROJECT (BR 48N)	LS			1										1
527.11	TRAFFIC PROTECTION FOR BRIDGE PROJECT (BR 48S)	LS				1									1
527.11	TRAFFIC PROTECTION FOR BRIDGE PROJECT (BR 49N)	LS					1								1
527.11	TRAFFIC PROTECTION FOR BRIDGE PROJECT (BR 49S)	LS						1							1
527.11	TRAFFIC PROTECTION FOR BRIDGE PROJECT (BR 50N)	LS							1						1
527.11	TRAFFIC PROTECTION FOR BRIDGE PROJECT (BR 50S)	LS								1					1
529.10	REMOVAL OF BRIDGE PAVEMENT	SY	750	850	1150	1150	650	650	960	930					7090
529.20	PARTIAL REMOVAL OF STRUCTURE (BR 43N)	EACH	1												1
529.20	PARTIAL REMOVAL OF STRUCTURE (BR 43S)	EACH		1											1
529.20	PARTIAL REMOVAL OF STRUCTURE (BR 48N)	EACH			1										1
529.20	PARTIAL REMOVAL OF STRUCTURE (BR 48S)	EACH				1									1
529.20	PARTIAL REMOVAL OF STRUCTURE (BR 49N)	EACH					1								1
529.20	PARTIAL REMOVAL OF STRUCTURE (BR 49S)	EACH						1							1
529.20	PARTIAL REMOVAL OF STRUCTURE (BR 50N)	EACH							1						1
529.20	PARTIAL REMOVAL OF STRUCTURE (BR 50S)	EACH								1					1
529.20	PARTIAL REMOVAL OF STRUCTURE (MOD. - EXISTING STEEL BEAMS - BR 43N)	EACH	1												1
529.20	PARTIAL REMOVAL OF STRUCTURE (MOD. - EXISTING STEEL BEAMS - BR 43S)	EACH		1											1
529.20	PARTIAL REMOVAL OF STRUCTURE (MOD. - EXISTING STEEL BEAMS - BR 48N)	EACH			1										1
529.20	PARTIAL REMOVAL OF STRUCTURE (MOD. - EXISTING STEEL BEAMS - BR 48S)	EACH				1									1
529.20	PARTIAL REMOVAL OF STRUCTURE (MOD. - EXISTING STEEL BEAMS - BR 50N)	EACH							1						1
529.20	PARTIAL REMOVAL OF STRUCTURE (MOD. - EXISTING STEEL BEAMS - BR 50S)	EACH								1					1
531.10	BEARING DEVICE ASSEMBLY (STEEL PLT. FIXED BEARINGS)	EACH					2	2							4
531.10	BEARING DEVICE ASSEMBLY (ELASTOMERIC TFE EXP. BEARINGS)	EACH	15	15	15	15	7	7	15	15					104
531.10	BEARING DEVICE ASSEMBLY (ELASTOMERIC FIXED BEARINGS)	EACH	5	5	5	5			5	5					30
580.13	REPAIR OF CONCRETE SUBSTRUCTURE SURFACE CLASS I	SY	1	3	23	20	1	1	1	1					51

**STATE OF VERMONT  
AGENCY OF TRANSPORTATION**

Town Of	MIDDLESEX-BOLTON	Bridge No.	
Highway No.	I-89	Log Sta.	
		Surv. Sta.	


**QUANTITIES (2 OF 3)**

Designed By	P.W. SZUSTAK	Drawn By	R.A. BOTZENHART
Checked By	Date	Bridge Design Supervisor	
J.P. HALSTEAD	10/99	J.P. HALSTEAD	Date 10/99
PROJECT	MIDDLESEX-BOLTON	PROJECT NO.	IM-089-2(26)
TVGA CAD Drawing No.	quantities	Date	10/99
Bridge Sheet No.	C-5	Sheet	5 of 307

**QUANTITIES**

ITEM NO.	ITEM DESCRIPTION	UNIT	IM 089-2(26)										TOTAL
			43N	43S	48N	48S	49N	49S	50N	50S	TRAINING	FULL C&E	
580.14	REPAIR OF CONCRETE SUBSTRUCTURE SURFACE CLASS II	SY	11	17	129	110	1	1	3	1			273
580.15	REPAIR OF CONCRETE SUBSTRUCTURE SURFACE CLASS III	CY	1	1	1	1	1	1	1	1			8
580.40	FIBER REINFORCED POLYMER WRAP	SY	104	99									203
613.10	STONE FILL, TYPE I	CY	10	10	10	10	10	10	10	10			80
613.11	STONE FILL, TYPE II	CY	10			10				10			30
613.13	STONE FILL, TYPE IV	CY			25	25							50
616.28	CAST-IN PLACE CEMENT CONCRETE CURB, TYPE B	LF	160	160	160	160	160	160	160	160			1280
620.25	WOVEN WIRE FENCE W/STEEL POSTS	LF	100	100	100	100	100	100	100	100			800
620.55	REMOVAL OF EXISTING FENCE	LF	100	100	100	100	100	100	100	100			800
620.75	SNOW BARRIER - GALVANIZED	LF	150	160			110	110	170	160			860
621.20	STEEL BEAM GUARD RAIL	LF	300										300
621.505	MANUFACTURED TERMINAL SECTION	EACH	4	4	2	2			2	2			16
621.57	ENERGY ABSORPTION ATTENUATOR	EACH	1							1			2
621.72	GUARD RAIL APPR. SECTION,NETC 2 RAIL (MOD.)	EACH	4	4	4	4	4	4	4	4			32
621.75	REMOVING AND RESET GUARD RAIL	LF		30	30	30	90	40	30	40			290
621.80	REMOVL AND DISP OF GUARD RAIL	LF	400	100	100	100	100	100	100	100			1100
621.90	TEMPORARY TRAFFIC BARRIER	LF	5600	5500	3850	3900	3850	3900	3850	3900			34350
630.10	UNIFORMED TRAFFIC OFFICERS	HR	675	675	225	225	225	225	225	225			2700
630.15	FLAGGERS	HR	425	425	150	150	150	150	150	150			1750
631.10	FIELD OFFICE-ENGINEERS	LS									1		1
631.16	TESTING EQUIPMENT - CONCRETE	LS									1		1
631.17	TESTING EQUIPMENT - BITUMINOUS	LS									1		1
631.18	TESTING EQUIPMENT - PROTECTIVE COATINGS	LS									1		1
631.25	FIELD OFFICE - TELEPHONE (N.A.B.I.)	LU									1		1
634.10	EMPLOYEE TRAINEESHIP	HR								2080			2080
635.10	MOBILIZATION	LS	0.125	0.125	0.125	0.125	0.125	0.125	0.125	0.125			1
641.10	TRAFFIC CONTROL (BR 43N&S)	LS	0.5	0.5									1
641.10	TRAFFIC CONTROL (BR 48N&S, 49N&S, 50N&S)	LS			0.2	0.2	0.15	0.15	0.15	0.15			1
641.10	TRAFFIC CONTROL (MOD. - PUBLIC RELATIONS OFFICER)	LS	0.125	0.125	0.125	0.125	0.125	0.125	0.125	0.125			1
641.15	PORTABLE CHANGEABLE MESSAGE SIGN	EACH	2	2	1					1			6
641.16	PORTABLE ARROW BOARD	EACH	2	2	1	1			1	1			8
646.414	DURABLE 6" WHITE LINE	LF	630	680	890	770	620	610	500	570			5270
646.415	DURABLE 6" YELLOW LINE	LF	500	540	710	620	490	500	400	460			4220
646.60	TEMPORARY 4" WHITE LINE	LF	900	1050	300	350	300	350	300	350			3900
646.60	TEMPORARY 4" WHITE LINE (TAPE, TYPE II)	LF	10250	11500	7750	7950	7750	7950	7750	7950			68850
646.61	TEMPORARY 4" YELLOW LINE	LF	950	900	300	300	300	300	300	300			3650
646.61	TEMPORARY 4" YELLOW LINE (TAPE, TYPE II)	LF	12450	16500	8350	8500	8350	8500	8350	8500			79500
646.81	RAISED PAVEMENT MARKERS TYPE II	EACH	1350	1650	850	850	850	850	850	850			8100
646.86	BLACK PAVEMENT MARKING MASKING TAPE	SF	4450	4500	2750	2950	2750	2950	2750	2950			26050
649.31	GEOTEXTILE UNDER STONE FILL	SY	20			10				10			40
649.51	GEOTEXTILE FOR SILT FENCE	SY	400	400	200	200	200	200	200	200			2000
651.26	HAY BALES FOR EROSION CONTROL	EACH	40	40	40	40	40	40	40	40			320
654.10	EROSION MATTING	SY	100	100	100	100	100	100	100	100			800
675.20	TRAFFIC SIGNS, TYPE A (MOD.)	SF	10	10	10	10	10	10	10	10			80

<b>STATE OF VERMONT AGENCY OF TRANSPORTATION</b>			
Town Of	MIDDLESEX-BOLTON	Bridge No.	
Highway No.	I-89	Log Sta.	
		Surv. Sta.	
<b>QUANTITIES (3 OF 3)</b>			
Designed By	P.W. SZUSTAK	Drawn By	R.A. BOTZENHART
Checked By	Date	Bridge Design Supervisor	
J.P. HALSTEAD	10/99	J.P. HALSTEAD	Date 10/99
PROJECT	MIDDLESEX-BOLTON	PROJECT NO.	IM-089-2(26)
TVGA CAD Drawing No.	quantities	Date	08/00
Bridge Sheet No.	C-6	Sheet	6 of 307

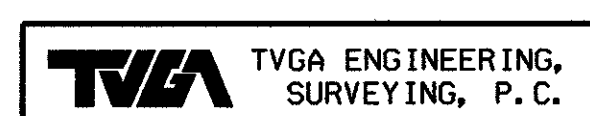

**GENERAL NOTES:**

1. A FIELD SURVEY WAS CONDUCTED BY VAOT, IN WHICH THE FACES OF ABUTMENTS AND PIER SURFACES OF THE EXISTING BRIDGES WERE LOCATED. THIS INFORMATION WAS THEN USED, IN COMBINATION WITH ORIGINAL BRIDGE DESIGN PLANS, TO DEVELOP THE APPROXIMATE EXISTING STRUCTURE INFORMATION SHOWN IN THESE PLANS. THE ORIGINAL BRIDGE DESIGN PLANS ARE INCLUDED IN THIS PLAN SET, AND ARE FOR INFORMATION ONLY. TRAFFIC CONTROL PLANS WERE DEVELOPED BASED SOLELY ON ORIGINAL HIGHWAY DESIGN PLANS. THE CONTRACTOR IS RESPONSIBLE FOR CHECKING ANY AND ALL DIMENSIONS APPLICABLE TO THIS PROJECT.
2. ALL MATERIALS AND CONSTRUCTION SHALL CONFORM TO STATE OF VERMONT AGENCY OF TRANSPORTATION "STANDARD SPECIFICATIONS FOR CONSTRUCTION" (1990) AND ITS LATEST REVISIONS, AND AASHTO "STANDARD SPECIFICATIONS FOR HIGHWAY BRIDGES" (1996) AND ITS LATEST REVISIONS.
3. DESIGN IS FOR HS-25 LOADING APPLIED IN ACCORDANCE WITH THE PROVISIONS OF AASHTO STANDARD SPECIFICATIONS.
4. ALL DIMENSIONS ARE HORIZONTAL OR VERTICAL AND ARE GIVEN AT 68°F, UNLESS SHOWN OTHERWISE.
5. ANY REFERENCE TO "LEFT" AND/OR "RIGHT" ON THE PLANS OR IN THE NOTES REFERS TO THE DIRECTION OF STATIONING AND NOT THE DIRECTION OF TRAFFIC.
6. ALL STRUCTURAL STEEL SHALL CONFORM TO AASHTO DESIGNATION M270, GRADE 50W, EXCEPT AS NOTED IN THE PLANS.
7. THE FOLLOWING TABLE OF DESIGN STRENGTHS APPLIES TO THESE PLANS FOR DESIGN PURPOSES:  
 CONCRETE:  $f'_c = 4,000$  PSI (BRIDGE DECKS)  
 $f'_c = 3,500$  PSI (PIERS AND ABUTMENTS)  
 EXISTING STRUCTURAL STEEL (BR 49N&S): AASHO M165  
 $F_y = 33,000$  PSI  
 NEW STRUCTURAL STEEL: AASHTO M270, GR50W  
 $F_y = 50,000$  PSI  
 EXISTING REINFORCING STEEL:  
 $F_y = 40,000$  PSI (GRADE 40)  
 NEW REINFORCING STEEL:  
 $F_y = 60,000$  PSI (GRADE 60)  
 NEW STEEL PIPE PILES: ASTM 252 GRADE 2  
 $F_y = 35,000$  PSI
8. ALL CONNECTIONS OF UNPAINTED MEMBERS SHALL BE MADE WITH 7/8" DIAMETER AASHTO M-164, TYPE 3 BOLTS IN 15/16" DIAMETER HOLES, EXCEPT AS NOTED IN THE PLANS. ALL CONNECTIONS OF PAINTED OR GALVANIZED MEMBERS SHALL BE MADE WITH AASHTO M-164 TYPE 1 GALVANIZED BOLTS. NEW OR EXISTING BOLTS THAT HAVE BEEN FULLY TIGHTENED SHALL NOT BE RE-USED.
9. WHERE CONNECTIONS ARE NOT DETAILED ON THE PLANS, THEY SHALL BE DETAILED BY THE FABRICATOR AND SUBMITTED TO THE STRUCTURES ENGINEER FOR APPROVAL.
10. ALL WELDING AND DIMENSIONAL TOLERANCES OF WELDED MEMBERS SHALL CONFORM TO THE LATEST ANSI / AASHTO / AWS BRIDGE WELDING CODE AND ITS LATEST REVISIONS.
11. WHERE GALVANIZING HAS BEEN REMOVED BY ANY MEANS FROM ANY BRIDGE COMPONENTS, INCLUDING DOWNSPOUTS AND ASSOCIATED HARDWARE, IT SHALL BE REPAIRED IN ACCORDANCE WITH SECTION 513 OF THE SPECIFICATIONS. COSTS FOR THIS WORK SHALL BE SUBSIDIARY TO THE ITEM UNDER WHICH THE GALVANIZED COMPONENT IS PROVIDED.
12. ANY FORM BRACKET HOLES (IF REQUIRED) IN FASCIA STRINGERS OR STRINGER WEBS SHALL BE FILLED WITH BUTTONHEAD OR HEX-HEAD BOLTS, TYPE 3. FORM BRACKETS SHALL BE DESIGNED BY THE CONTRACTOR - MAXIMUM SPACING SHALL NOT EXCEED 4'-0" (TYP.).
13. ALL REINFORCING STEEL SHALL BE DETAILED AND FABRICATED USING PROCEDURES IN ACCORDANCE WITH APPLICABLE PUBLICATIONS OF THE CONCRETE REINFORCING STEEL INSTITUTE.
14. REINFORCEMENT PLACING TOLERANCES SHALL BE:  
 SPACING +/- 1"  
 CLEARANCE +/- 1/4"
15. MINIMUM COVER FOR REINFORCING STEEL (EXCEPT IN THE DECK) SHALL BE 2" IN BACK FACES OF SUBSTRUCTURES AGAINST EARTH, 4" IN PIER COLUMNS AND CAP BEAMS, AND 3" ELSEWHERE, UNLESS OTHERWISE SHOWN.
16. FLAME CUTTING OF EPOXY COATED REINFORCING STEEL SHALL NOT BE PERMITTED.
17. ALL DECK SLAB, CURTAINWALL, AND EXPANSION JOINT HEADER CONCRETE SHALL BE ITEM 501.221, "CONCRETE, CLASS A QC/QA", IN ACCORDANCE WITH THE SPECIAL PROVISIONS. ALL BRUSH CURB CONCRETE SHALL BE ITEM 501.60, "SILICA-FUME CONCRETE". ALL SUBSTRUCTURE CONCRETE SHALL BE ITEM 501.25, "CONCRETE, CLASS B", EXCEPT AS SHOWN IN THE PLANS.
18. ALL EXPOSED EDGES OF CONCRETE IN THE SUBSTRUCTURE AND THE SUPERSTRUCTURE SHALL BE CHAMFERED 1" X 1", UNLESS OTHERWISE SHOWN.
19. ABUTMENT CONCRETE ABOVE THE ADJACENT BRIDGE SEAT ELEVATIONS SHALL NOT BE PLACED UNTIL GIRDERS HAVE BEEN ERECTED, BEAM PROFILES HAVE BEEN TAKEN, AND FINAL FINISH GRADE OF DECK IS ESTABLISHED BY THE ENGINEER.
20. BRIDGE SEATS SHALL BE SLOPED 1/2" PER FOOT EXCEPT UNDER BEARING PLATES WHERE THE SURFACE SHALL BE LEVEL WITH A CONSTRUCTION TOLERANCE OF 0.005 RADIANS, UNLESS OTHERWISE SHOWN IN THE PLANS. THE ENTIRE BRIDGE SEAT SHALL BE SMOOTH STEEL TROWEL FINISHED.
21. IN ALL HORIZONTAL AND VERTICAL CONSTRUCTION JOINTS, SHEAR KEYS SHALL BE FORMED AS SHOWN IN THE TYPICAL BRIDGE DETAILS, BRIDGE SHEET C-46, AND THEY SHALL BE CONTINUOUS UP TO 3" FROM EACH END OF THE JOINT. THE UPWARD KEY SHALL BE PLACED INTEGRALLY WITH THE CONCRETE BELOW THE JOINT.
22. POLYURETHANE JOINT SEALER SHALL BE USED IN CURB CONSTRUCTION JOINTS OR AT FIXED END CURB JOINTS AS DIRECTED BY THE ENGINEER, IN ACCORDANCE WITH THE CURB JOINT DETAILS SHOWN IN THE TYPICAL BRIDGE DETAILS, BRIDGE SHEET C-46.
23. THE COST OF INSTALLING PVC WATERSTOPS, AS SHOWN IN THE PLANS, SHALL BE SUBSIDIARY TO ITEM 501.25, "CONCRETE CLASS B". THE TYPE OF PVC WATERSTOP TO BE USED SHALL BE SUBMITTED BY THE CONTRACTOR TO THE ENGINEER FOR APPROVAL.
24. NOT USED.

<b>STATE OF VERMONT AGENCY OF TRANSPORTATION</b>			
Town Of	MIDDLESEX-BOLTON	Bridge No.	
Highway No.	I-89	Log Sta.	
		Surv. Sta.	
<b>GENERAL NOTES (1 OF 2)</b>			
Designed By	P.W. SZUSTAK	Drawn By	R.A. BOTZENHART
Checked By	Date	Bridge Design Supervisor	
J.P. HALSTEAD	10/99	J.P. HALSTEAD	Date 10/99
PROJECT	MIDDLESEX-BOLTON	PROJECT NO.	IM-089-2(26)
TVGA CAD Drawing No.	genotes	Date	10/99
Bridge Sheet No.	C-7	Sheet	7 of 307



**GENERAL NOTES (CONTINUED):**

25. ITEM 514.10, "WATER REPELLENT" SHALL BE APPLIED TO ALL EXPOSED CONCRETE ON THE SUPERSTRUCTURE, EXCEPT THE BOTTOM OF THE DECK BETWEEN THE DRIP BEADS. IT SHALL ALSO BE APPLIED TO ALL EXPOSED SUBSTRUCTURES, EXCEPT AS NOTED IN NOTE 26.

26. WATER REPELLENT SHALL NOT BE APPLIED TO SURFACES THAT ARE TO BE COVERED BY FIBER REINFORCED POLYMER WRAP. IN ADDITION, THESE SURFACES SHALL BE PROTECTED FROM OVER-SPRAY OF WATER REPELLENT.

27. ABUTMENT AND PIER CONCRETE REPAIRS SHALL BE PERFORMED AS SHOWN IN THE SUBSTRUCTURE REPAIR DETAILS AND NOTES, BRIDGE SHEET C-46. THE SUBSTRUCTURE CONDITION SHEETS, BRIDGE SHEETS SC-1 THROUGH SC-23, WERE DEVELOPED FROM NOTES OF AN OCTOBER 1996 PRELIMINARY INSPECTION, AND SHALL BE USED ONLY AS AN INDICATION OF THE GENERAL CONDITION OF THE SUBSTRUCTURE. A THOROUGH INSPECTION BY THE RESIDENT ENGINEER WILL BE MADE OF ALL SUBSTRUCTURE AREAS AT THE TIME OF CONSTRUCTION, AND THOSE AREAS FOUND TO HAVE SPALLED, DELAMINATED OR OTHERWISE UNSOUND CONCRETE WILL BE REPAIRED. THE CONTRACTOR SHALL SUPPLY ANY STAGING AND LADDERS REQUIRED FOR THIS INSPECTION, THE COST FOR WHICH SHALL BE SUBSIDIARY TO ITEM 635.10, "MOBILIZATION".

28. ALL FABRIC TROUGHS AND DOWNSPOUTS SHALL BE THOROUGHLY FLUSHED BY THE CONTRACTOR AFTER ALL PAVING IS COMPLETED. ALL COSTS ASSOCIATED WITH THIS WORK SHALL BE SUBSIDIARY TO ITEM 408.25, "BITUMINOUS CONCRETE PAVEMENT". FOLLOWING PAVING, ANY BITUMINOUS CONCRETE PAVEMENT THAT IS LODGED IN THE EXPANSION JOINTS, OR THAT ENTERS DRAIN TROUGHS, SCUPPERS, HOPPERS OR DOWNSPOUTS, SHALL BE REMOVED BY THE CONTRACTOR AT NO COST TO THE STATE.

29. SNOW FENCE SHALL BE INSTALLED ON BRIDGE RAIL OVER ALL ROADWAYS AS SHOWN ON STANDARD SHEET BR3-97, AND PAID FOR UNDER ITEM 620.75, "SNOW BARRIER - GALVANIZED".

~~30. ALL NEW PILING AT PIER 2 (BR 51N) AND PIER 3 (BR 51S) SHALL BE CAST-IN-PLACE CONCRETE PILING, WITH A MAXIMUM DESIGN LOAD OF 200 KIPS. METAL SHELLS FOR THE CAST-IN-PLACE CONCRETE PILES SHALL BE CLOSED END PP 12 1/2" WITH A MINIMUM WALL THICKNESS OF 3/8" CONFORMING TO ASTM 252 GRADE 2. A 1" THICK FLAT STEEL PLATE CONFORMING TO AASHTO M270 GRADE 36 SHALL BE WELDED TO THE END OF THE SHELLS AS SHOWN IN THE TYPICAL BRIDGE DETAILS, BRIDGE SHEET C-46. THE FIRST PILE DRIVEN AT EACH PIER SHALL BE DYNAMICALLY TESTED IN ACCORDANCE WITH THE SPECIAL PROVISIONS. PILES SHALL BE DRIVEN TO AN ULTIMATE LOAD CAPACITY OF 450 KIPS. ALL COSTS TO BE INCLUDED UNDER ITEM 505.25, "CAST-IN-PLACE CONCRETE PILING".~~

BRIDGE 51N AND 51S WERE NOT PART OF THIS PROJECT.

31. COSTS FOR ALL WORK REQUIRED FOR REMOVAL OF EXISTING CONCRETE BRUSH CURBS, CONCRETE DECK, CURTAINWALLS, EXPANSION JOINT HARDWARE, BEARINGS, WINGWALLS, ABUTMENT AND PIER CONCRETE, ACCORDING TO THE LIMITS OF WORK DEFINED IN THE PLANS, SHALL BE INCLUDED UNDER ITEM 529.20, "PARTIAL REMOVAL OF STRUCTURE (BRXXX)". PAYMENT FOR THIS ITEM SHALL INCLUDE ALL INCIDENTAL EXCAVATION NECESSARY TO PERFORM THE REQUIRED STRUCTURE REMOVAL WORK UNLESS OTHERWISE SHOWN IN THE PLANS. PAYMENT FOR BACKFILL AROUND ABUTMENTS AND PIERS FOLLOWING PLACEMENT OF NEW CONCRETE SHALL BE MADE UNDER ITEM 204.30, "GRANULAR BACKFILL FOR STRUCTURES".

32. PAYMENT FOR REMOVAL OF EXISTING BRIDGE PAVEMENT SHALL BE MADE UNDER ITEM 529.10, "REMOVAL OF BRIDGE PAVEMENT". PAYMENT FOR REMOVAL OF EXISTING APPROACH SLABS, AND EXCAVATION REQUIRED FOR NEW APPROACH SLAB CONSTRUCTION SHALL BE MADE UNDER ITEM 204.25, "STRUCTURE EXCAVATION".

33. EXISTING STEEL BEAMS TO BE REMOVED SHALL BE DELIVERED AND UNLOADED BY THE CONTRACTOR TO THE VAOT DISTRICT 6 MIDDLESEX MAINTENANCE GARAGE. THE CONTRACTOR IS RESPONSIBLE FOR UNLOADING STRUCTURAL STEEL AT THE GARAGE. CARE SHALL BE TAKEN NOT TO DAMAGE EXISTING BEAMS DURING REMOVAL OR TRANSPORTATION, AND ALL EXISTING CONCRETE SHALL BE REMOVED. THE BEAMS SHALL BE MARKED WITH IDENTIFICATION INFORMATION AS ORDERED BY THE ENGINEER. ALL COSTS ASSOCIATED WITH REMOVAL AND SALVAGE OF EXISTING STEEL BEAMS SHALL BE INCLUDED IN THE BID PRICE FOR ITEM 529.20, "PARTIAL REMOVAL OF STRUCTURES (MOD. - EXISTING STEEL BEAMS - BRXX)" IN ACCORDANCE WITH THE SPECIAL PROVISIONS.

34. ALL EXISTING BRIDGE RAIL SHALL BE SALVAGED AND DELIVERED TO THE VAOT DISTRICT 6 MIDDLESEX MAINTENANCE GARAGE. CARE SHALL BE TAKEN NOT TO DAMAGE THE RAIL DURING REMOVAL OR TRANSPORTATION. THE CONTRACTOR IS RESPONSIBLE FOR UNLOADING THE RAIL AT THE GARAGE. ALL COSTS ASSOCIATED WITH REMOVAL, TRANSPORT AND UNLOADING OF THE BRIDGE RAIL SHALL BE INCLUDED IN THE BID PRICE FOR ITEM 525.10, "REMOVAL OF EXISTING RAILING (MOD. - SALVAGE)" IN ACCORDANCE WITH THE SPECIAL PROVISIONS.

35. REMOVAL OF ALL EXISTING BRIDGE APPROACH RAIL AND GUARD RAIL AT LOCATIONS SHOWN ON THE PLANS SHALL BE PAID FOR UNDER ITEM 621.80, "REMOVAL AND DISPOSAL OF GUARD RAIL".

36. ALL EXISTING GRANITE CURB SHALL BE SALVAGED AND DELIVERED TO THE VAOT DISTRICT 6 MIDDLESEX MAINTENANCE GARAGE. CARE SHALL BE TAKEN NOT TO DAMAGE THE CURB DURING REMOVAL OR TRANSPORTATION. THE CONTRACTOR IS RESPONSIBLE FOR UNLOADING THE CURB AT THE GARAGE. ALL COSTS ASSOCIATED WITH REMOVAL AND SALVAGE OF THE CURB SHALL BE INCLUDED IN THE BID PRICE FOR ITEM 529.20, "PARTIAL REMOVAL OF STRUCTURE (BRXXX)".

37. THE CONTRACTOR SHALL REMOVE VEGETATION AROUND EXISTING SUBSTRUCTURE COMPONENTS AS ORDERED BY THE ENGINEER, INCLUDING THE SMALL TREES UNDER BRIDGE 51N&S. COSTS FOR THIS WORK SHALL BE SUBSIDIARY TO ITEM 529.20, "PARTIAL REMOVAL OF STRUCTURE (BRXXX)".

~~38. A PAD OF CONCRETE (CLASS A) 4' x 4' x 0.5' IN PLACE OF~~  
38. A PAD OF STONE FILL, TYPE II (MINIMUM SIZE 6' x 6' x 2' THICK) SHALL BE CONSTRUCTED UNDER EACH SCUPPER DOWNSPOUT WHERE INADEQUATE PROTECTION AGAINST EROSION EXISTS IN THE OPINION OF THE ENGINEER. STONE FILL, TYPE II SHALL BE PLACED ON SLOPES ADJACENT TO WINGWALLS WHERE, IN THE JUDGEMENT OF THE ENGINEER, RUN-OFF MAY CAUSE POTENTIAL EROSION. IN ADDITION, ABUTMENT SLOPES SHALL BE REPAIRED BY PLACING STONE FILL AND RE-GRADING AS DIRECTED BY THE ENGINEER. STONE FILL SHALL BE PROVIDED UNDER ITEMS 613.10, 613.11, AND 613.13, AS DIRECTED BY THE ENGINEER AT EACH LOCATION. COSTS FOR RE-GRADING SLOPES SHALL BE SUBSIDIARY TO THE APPLICABLE STONE FILL ITEM.


39. TEMPORARY EROSION CONTROL MEASURES SHALL INCLUDE PLACEMENT OF SILT FENCE, HAY BALES AND EROSION CONTROL MATTING AROUND WINGWALLS, ABUTMENTS AND PIERS WHERE EXCAVATION AND BACKFILL IS PERFORMED, AS DIRECTED BY THE ENGINEER.

40. THE CONTRACTOR SHALL CALL "DIG-SAFE" PRIOR TO PERFORMING ANY EXCAVATION, IN ACCORDANCE WITH DIG-SAFE'S RULES OF NOTIFICATION. THE COST OF COORDINATING WITH DIG-SAFE AND THE FOLLOWING UTILITY COMPANIES SHALL BE SUBSIDIARY TO ITEM 635.10, "MOBILIZATION"; BELL ATLANTIC, BOLTON WATERWORKS, GREEN MOUNTAIN POWER CORP., AND NOVA CABLE. THE COST OF ANY EXPLORATORY EXCAVATION BY THE CONTRACTOR TO ASCERTAIN UTILITY LOCATIONS SHALL BE PAID UNDER ITEM 204.20, "TRENCH EXCAVATION OF EARTH" IN ACCORDANCE WITH THE SPECIAL PROVISIONS. ANY DAMAGE TO UTILITIES CAUSED BY THE CONTRACTOR SHALL BE REPAIRED IMMEDIATELY AS DIRECTED BY THE RESPECTIVE UTILITY COMPANY OR THE ENGINEER AT THE CONTRACTOR'S OWN EXPENSE.

41. FOR TRAFFIC CONTROL NOTES, SEE BRIDGE SHEETS TC-1A AND TC-1B.

42. AN ESTIMATED QUANTITY OF ITEM 404.65, "EMULSIFIED ASPHALT" HAS BEEN INCLUDED TO BE USED, AT THE DISCRETION OF THE ENGINEER, AS A TACK COAT BETWEEN THE LIFTS OF ALL PAVEMENT AT AN APPLICATION RATE OF 0.015 GAL/SY.

<b>STATE OF VERMONT AGENCY OF TRANSPORTATION</b>			
Town Of	MIDDLESEX-BOLTON	Bridge No.	
Highway No.	1-89	Log Sta.	
		Surv. Sta.	
<b>GENERAL NOTES (2 OF 2)</b>			
Designed By	P.W. SZUSTAK	Drawn By	R.A. BOTZENHART
Checked By	Date	Bridge Design Supervisor	
	J.P. HALSTEAD 10/99	J.P. HALSTEAD	Date 10/99
PROJECT	MIDDLESEX-BOLTON	PROJECT NO.	IM-089-2(26)
TVGA CAD Drawing No.	gma1es	Date	08/00
Bridge Sheet No.	C-8	Sheet	8 of 307

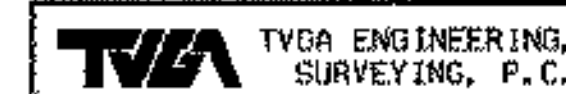

BRIDGE NUMBER	BRIDGE DATA										SCOPE OF WORK						
	SUBSTRUCTURE ELEMENTS			SPAN NUMBER	PROPOSED LENGTH @ CL CONSTRUCTION	EXISTING STEEL BEAMS CONFIGURATION	EXISTING STEEL BEAMS APPROXIMATE WEIGHT (T)		EXISTING UNDERGROUND UTILITIES	PROPOSED DECK TREATMENT	PROPOSED JOINT	PROPOSED STEEL STRINGERS TREATMENT	APPROX. WT.	PROPOSED BEARING TREATMENT	PROPOSED SUBSTRUCTURE TREATMENT	PROPOSED MIN. VERT. CLEARANCE OVER ROADWAY	
	PROPOSED	ORIGINAL	APPROX. SKEW				TO BE REMOVED	TO REMAIN									
43N	ABUTMENT 1	EAST ABUTMENT	45° AHEAD RT.	1	52.95'	33WF130 W/ COVER PL. (INTERIOR) 36WF150 (FASCIA)	84.1 TONS		TEL.	NEW 8 1/2" CONCRETE DECK W/ 2 1/2" WEARING SURFACE AND NEW APPROACH SLABS	FIXED TYPE C	NEW 30" WF CONTINUOUS ROLLED BEAMS AASHTO M270 GR 50W	66.5 TONS	NEW ELASTOMERIC FIXED	SEE NOTE 3	14'-11"	
	PIER 1	PIER 1	45° AHEAD RT.	2	74.14'	36WF170 W/ COVER PL.											
	PIER 2	PIER 2	45° AHEAD RT.	3	42.71'	33WF130 (INTERIOR) 36WF150 (FASCIA)											
43S	ABUTMENT 2	WEST ABUTMENT	45° AHEAD RT.	1	73.12'	36WF170 W/ COVER PL.	123.7 TONS		TEL.	DO.	EXP. TYPE H	NEW 33" WF CONTINUOUS ROLLED BEAMS AASHTO M270 GR 50W	85.5 TONS	NEW ELASTOMERIC EXP.	SEE NOTE 2	14'-4"	
	ABUTMENT 1	EAST ABUTMENT	45° AHEAD RT.	2	84.10'	36WF245 W/ COVER PL.											
	PIER 2	PIER 2	45° AHEAD RT.	3	42.75'	33WF130 (INTERIOR) 36WF150 (FASCIA)											
48N	ABUTMENT 2	WEST ABUTMENT	45° AHEAD RT.	1	98.13'	36WF300 W/ COVER PL'S.	282.4 TONS			DO.	FIXED TYPE C	NEW 32 3/4" WEB CONTINUOUS PLATE GIRDERS AASHTO M270 GR 50W	163.9 TONS	NEW ELASTOMERIC EXP.	LCR	NOT APPLICABLE	
	ABUTMENT 1	ABUTMENT 2	25° AHEAD LT.	2	99.07'	36WF300 W/ COVER PL'S.											
	PIER 1	PIER B	25° AHEAD LT.	3	98.04'	36WF300 W/ COVER PL'S.											
48S	ABUTMENT 2	ABUTMENT 4	25° AHEAD LT.	1	98.51'	36WF300 W/ COVER PL'S.	283.5 TONS			DO.	FINGER JOINT	NEW 32 3/4" WEB CONTINUOUS PLATE GIRDERS AASHTO M270 GR 50W	164.3 TONS	NEW ELASTOMERIC EXP.	LCR	NOT APPLICABLE	
	ABUTMENT 1	ABUTMENT 1	25° AHEAD LT.	2	99.42'	36WF300 W/ COVER PL'S.											
	PIER 1	PIER A	25° AHEAD LT.	3	98.36'	36WF300 W/ COVER PL'S.											
49N	ABUTMENT 2	ABUTMENT 4	0°	1	96.88'	36WF300 W/ COVER PL'S.	131.6 TONS		TEL.	DO.	FIXED TYPE C	N/A	N/A	NEW ELASTOMERIC EXP.	SEE NOTE 2	16'-2"	
	ABUTMENT 1	ABUTMENT 1	0°	2	96.98'	36WF300 W/ COVER PL'S.											
	PIER 1	PIER C	25° AHEAD LT.	3	98.36'	36WF300 W/ COVER PL'S.											
49S	ABUTMENT 2	ABUTMENT 3	0°	1	96.88'	36WF300 W/ COVER PL'S.	131.6 TONS		TEL.	DO.	FIXED TYPE C	N/A	N/A	NEW ELASTOMERIC EXP.	SEE NOTE 2	15'-0"	
	ABUTMENT 1	ABUTMENT 2	45° AHEAD RT.	2	66.33'	36WF150 W/ COVER PL.											
	PIER 1	PIER B	45° AHEAD RT.	3	69.80'	36WF150 W/ COVER PL.											
50N	ABUTMENT 2	ABUTMENT 4	45° AHEAD RT.	1	66.33'	36WF150 W/ COVER PL.	148.1 TONS		TEL.	DO.	FIXED TYPE C	NEW 30 3/4" WEB CONTINUOUS PLATE GIRDERS AASHTO M270 GR 50W	109.9 TONS	NEW ELASTOMERIC EXP.	NPC/LCR	18'-5"	
	ABUTMENT 1	ABUTMENT 1	45° AHEAD RT.	2	96.50'	36WF300 W/ COVER PL.											
	PIER 1	PIER D	45° AHEAD RT.	3	69.80'	36WF150 W/ COVER PL.											
50S	ABUTMENT 2	ABUTMENT 4	45° AHEAD RT.	1	65.36'	36WF150 W/ COVER PL.	139.6 TONS		TEL.	DO.	EXP. TYPE H	NEW 30 3/4" WEB CONTINUOUS PLATE GIRDERS AASHTO M270 GR 50W	100.7 TONS	NEW ELASTOMERIC EXP.	NPC/LCR	16'-3"	
	ABUTMENT 1	ABUTMENT 1	45° AHEAD RT.	2	90.50'	36WF300 W/ COVER PL.											
	PIER 1	PIER A	45° AHEAD RT.	3	63.50'	36WF150 W/ COVER PL.											
51N	ABUTMENT 2	ABUTMENT 2	45° AHEAD RT.	1	38.15'	30WF108 (INTERIOR) 36WF150 (FASCIA)	274.8 TONS			DO.	FIXED TYPE C	NEW 30" WF ROLLED BEAMS AASHTO M270 GR 50W (SPAN D)	182.1 TONS	NEW ELAST. EXP./NEW ELAST. EXP.	NPC / LCR / FWPC	14'-9"	
	ABUTMENT 1	ABUTMENT 2	0°	2	88.95'	36WF300 W/ COVER PL.											
	PIER 1	PIER C	0°	3	84.35'	36WF300 W/ COVER PL. 36WF300 W/ COVER PL. 36WF194 W/ COVER PL.											
51S	ABUTMENT 2	ABUTMENT 4	45° AHEAD LT.	1	98.71'	36WF300 W/ COVER PL'S.	339.9 TONS		CABLE TV	DO.	EXP. TYPE H	NEW 33" WEB CONTINUOUS PLATE GIRDERS AASHTO M270 GR 50W (SPANS 2-5)	213.3 TONS	NEW ELASTOMERIC EXP.	LCR / FWPC (SEE NOTE 5)	16'-4"	
	ABUTMENT 1	ABUTMENT 1	0°	2	88.89'	36WF300 W/ COVER PL.											
	PIER 1	PIER J	45° AHEAD LT.	3	87.46'	36WF300 W/ COVER PL.											
51S	ABUTMENT 2	ABUTMENT 4	45° AHEAD LT.	1	83.82'	36WF300 W/ COVER PL.	339.9 TONS		TEL./WATER	DO.	FIXED TYPE C	NEW 30" WF ROLLED BEAMS AASHTO M270 GR 50W (SPAN D)	213.3 TONS	NEW ELAST. EXP./NEW ELAST. EXP.	NPC / LCR / FWPC	16'-4"	
	ABUTMENT 1	ABUTMENT 1	0°	2	88.89'	36WF300 W/ COVER PL.											
	PIER 1	PIER A	0°	3	87.46'	36WF300 W/ COVER PL.											
51S	ABUTMENT 2	ABUTMENT 4	45° AHEAD LT.	1	83.82'	36WF300 W/ COVER PL.	339.9 TONS		CABLE TV	DO.	EXP. TYPE H	NEW 33" WEB CONTINUOUS PLATE GIRDERS AASHTO M270 GR 50W (SPANS 2-6)	213.3 TONS	NEW ELASTOMERIC EXP.	LCR / FWPC (SEE NOTE 5)	16'-4"	
	ABUTMENT 1	ABUTMENT 1	0°	2	88.89'	36WF300 W/ COVER PL.											
	PIER 1	PIER E	0°	3	87.46'	36WF300 W/ COVER PL.											
51S	ABUTMENT 2	ABUTMENT 4	45° AHEAD LT.	1	52.86'	33WF130 W/ COVER PL. (INTERIOR) 36WF150 (FASCIA)	339.9 TONS		TEL./WATER	DO.	EXP. TYPE H	NEW 30" WF ROLLED BEAMS AASHTO M270 GR 50W (SPAN D)	213.3 TONS	NEW ELAST. EXP./NEW ELAST. EXP.	NPC / LCR / FWPC	16'-4"	
	ABUTMENT 1	ABUTMENT 1	0°	2	88.89'	36WF300 W/ COVER PL.											
	PIER 1	PIER H	45° AHEAD LT.	3	87.46'	36WF300 W/ COVER PL.											
51S	ABUTMENT 2	ABUTMENT 4	45° AHEAD LT.	1	52.86'	33WF130 W/ COVER PL. (INTERIOR) 36WF150 (FASCIA)	339.9 TONS		TEL./WATER	DO.	EXP. TYPE H	NEW 30" WF ROLLED BEAMS AASHTO M270 GR 50W (SPAN D)	213.3 TONS	NEW ELAST. EXP./NEW ELAST. EXP.	NPC / LCR / FWPC	16'-4"	
	ABUTMENT 1	ABUTMENT 1	0°	2	88.89'	36WF300 W/ COVER PL.											
	PIER 1	PIER H	45° AHEAD LT.	3	87.46'	36WF300 W/ COVER PL.											
TOTALS							1680 TONS	270 TONS			1100 TONS						

- ### SEQUENCE OF OPERATIONS:
- PHASE I (FIRST CONSTRUCTION SEASON):**
- CONSTRUCT SOUTHBOUND CROSSOVERS AS SHOWN IN TRAFFIC CONTROL PLANS.
  - SHIFT I-89 SOUTHBOUND TRAFFIC TO I-89 NORTHBOUND SIDE.
  - REHABILITATE BRIDGES 43S, 48S, 49S, 50S, 51S.
  - SHIFT I-89 SOUTHBOUND TRAFFIC BACK TO I-89 SOUTHBOUND SIDE.
- PHASE II (SECOND CONSTRUCTION SEASON):**
- CONSTRUCT NORTHBOUND CROSSOVERS AS SHOWN IN TRAFFIC CONTROL PLANS.
  - SHIFT I-89 NORTHBOUND TRAFFIC TO I-89 SOUTHBOUND SIDE.
  - REHABILITATE BRIDGES 43N, 48N, 49N, 50N, 51N.
  - SHIFT I-89 NORTHBOUND TRAFFIC BACK TO I-89 NORTHBOUND SIDE.

- ### NOTES:
- EXISTING STEEL WEIGHTS ARE APPROXIMATE, USING RATIO OF BRIDGE LENGTH TIMES THE TOTAL RECORD WEIGHT FOR EACH BRIDGE PAIR.
  - EXPANSION ABUTMENT TREATMENT INCLUDES: LOCALIZED CONCRETE REPAIR, REMOVE AND REPLACE WINGWALLS ABOVE BRIDGE SEAT ELEVATION, REMOVE BRIDGE SEAT AND REPLACE TO NEW SEAT ELEVATIONS, REMOVE CURTAINWALL, AND PLACE NEW BACKWALL.
  - FIXED ABUTMENT TREATMENT (EXCEPT BR 49N&S) INCLUDES: LOCALIZED CONCRETE REPAIR, REMOVE AND REPLACE WINGWALLS ABOVE BRIDGE SEAT ELEVATION, REMOVE BRIDGE SEAT AND REPLACE TO NEW SEAT ELEVATIONS, REMOVE CURTAINWALL AND REPLACE WITH NEW CURTAINWALL.
  - FIXED ABUTMENT TREATMENT (BR 49N&S) INCLUDES: LOCALIZED CONCRETE REPAIR, REMOVE AND REPLACE WINGWALLS ABOVE BRIDGE SEAT ELEVATION, REMOVE CURTAINWALL AND REPLACE WITH NEW CURTAINWALL.
  - AT BR 51N&S, FIBER WRAPPING OF THE PIER COLUMNS TO BE APPLIED TO CERTAIN COLUMNS ONLY, AS SHOWN ON SUBSTRUCTURE REPAIR DETAILS AND NOTES, BRIDGE SHEET C-45.

### PIER CODES

LCR LOCALIZED CONCRETE REPAIR  
 NPC NEW PIER CAP  
 FWPC FIBER WRAP PIER COLUMNS

### BEARING CODES

JCPG JACK, CLEAN, PAINT, GREASE EXISTING BEARINGS  
 RIK REPLACE EXISTING BEARINGS IN KIND

<b>STATE OF VERMONT AGENCY OF TRANSPORTATION</b>			
Town Of	MIDDLESEX-BOLTON	Bridge No.	
Highway No.	I-89	Log Sta.	
		Surv. Sta.	
<b>BRIDGE INFORMATION SUMMARY</b>			
Designed By	P.W. SZUSTAK	Drawn By	P.A. MEREWETHER
Checked By	J.P. HALSTEAD	Bridge Design Supervisor	J.P. HALSTEAD
PROJECT	MIDDLESEX-BOLTON	PROJECT NO.	IM-089-2(26)
TVGA Engineering, Surveying, P.C.	TVGA CAD Drawing No.	brgsum	Date 10/99
	Bridge Sheet No. C-9		Sheet 9 of 307

GPS CONTROL POINTS

**TRAV. 1**

**VTGS SURVEY DISK STAMPED  
" BASELINE WEST 1970 "**

N = 42565.15840  
E = 10049.883  
Z = 528.05

**STATION DESCRIPTION**

TO REACH FROM THE INTERSECTION OF US ROUTE 2, STATE STREET, AND BAILEY AVENUE IN MONPIELIER, GO WEST ALONG US ROUTE 2 FOR 1.9 MILES (3.1 KM) TO THE MARK ON THE NORTHEAST SIDE OF ROUTE 2.

THE MARK IS SET IN THE TOP OF A 6 INCH BY 6 INCH CONCRETE MONUMENT FLUSH WITH GROUND SURFACE.

IT IS 60.5 FEET (18.4 M) NORTHEAST OF THE CENTERLINE OF US ROUTE 2, 119 FEET (36.3 M) NORTH NORTHWEST OF A CLUMP APPLE, 50.5 FEET (15.4 M) SOUTHEAST OF A BRACE POST IN THE 189 R.O.W. FENCE, 106 FEET (32.3 M) NORTHWEST OF A 4 INCH BIRCH IN 189 R.O.W. FENCE, 1.8 FEET (0.5 M) SOUTHWEST OF A CARSONITE WITNESS POST IN I-89 R.O.W. FENCE.

**TRAV. 2**

**CGS BENCHMARK DISK STAMPED  
" B 24 1935"**

N = 43272.95550  
E = 8735.81100  
Z = 525.842

**STATION DESCRIPTION**


TO REACH FROM THE JUNCTION OF US ROUTE 2 AND VERMONT 100B IN MIDDLESEX, PROCEED 3.85 MI (6.20 KM) EAST ON ROUTE 2 AND THE MARK ON THE RIGHT.

THE MARK IS SET IN THE TOP OF A 6 INCH BY 6 INCH CONCRETE MONUMENT, PROJECTING 6 INCHES ABOVE GROUND SURFACE.

IT IS 90.0 FEET (27.4 M) SOUTHEAST OF A 20 INCH DIA. CAST IRON CULVERT, 42 FEET (12.8 M) SOUTHWEST OF THE CENTERLINE OF US ROUTE 2, 31.8 FEET (9.7 M) NORTHEAST OF THE CORNER OF A 6 FOOT (1.8 M) CHAINLINK FENCE, 12.6 FEET (3.8 M) SOUTHWEST OF THE SOUTHWEST RAIL, 6.5 FEET (2.0 M) NORTHEAST OF THE RAILROAD R.O.W. FENCE 0.8 FEET (24.4 CM) NORTHEAST OF A FIBERGLASS WITNESS POST. OWNERSHIP IS OF THE CENTRAL VERMONT RAILWAY.

• DESCRIPTIONS PROVIDED BY VTGS

TRAVERSE TIES

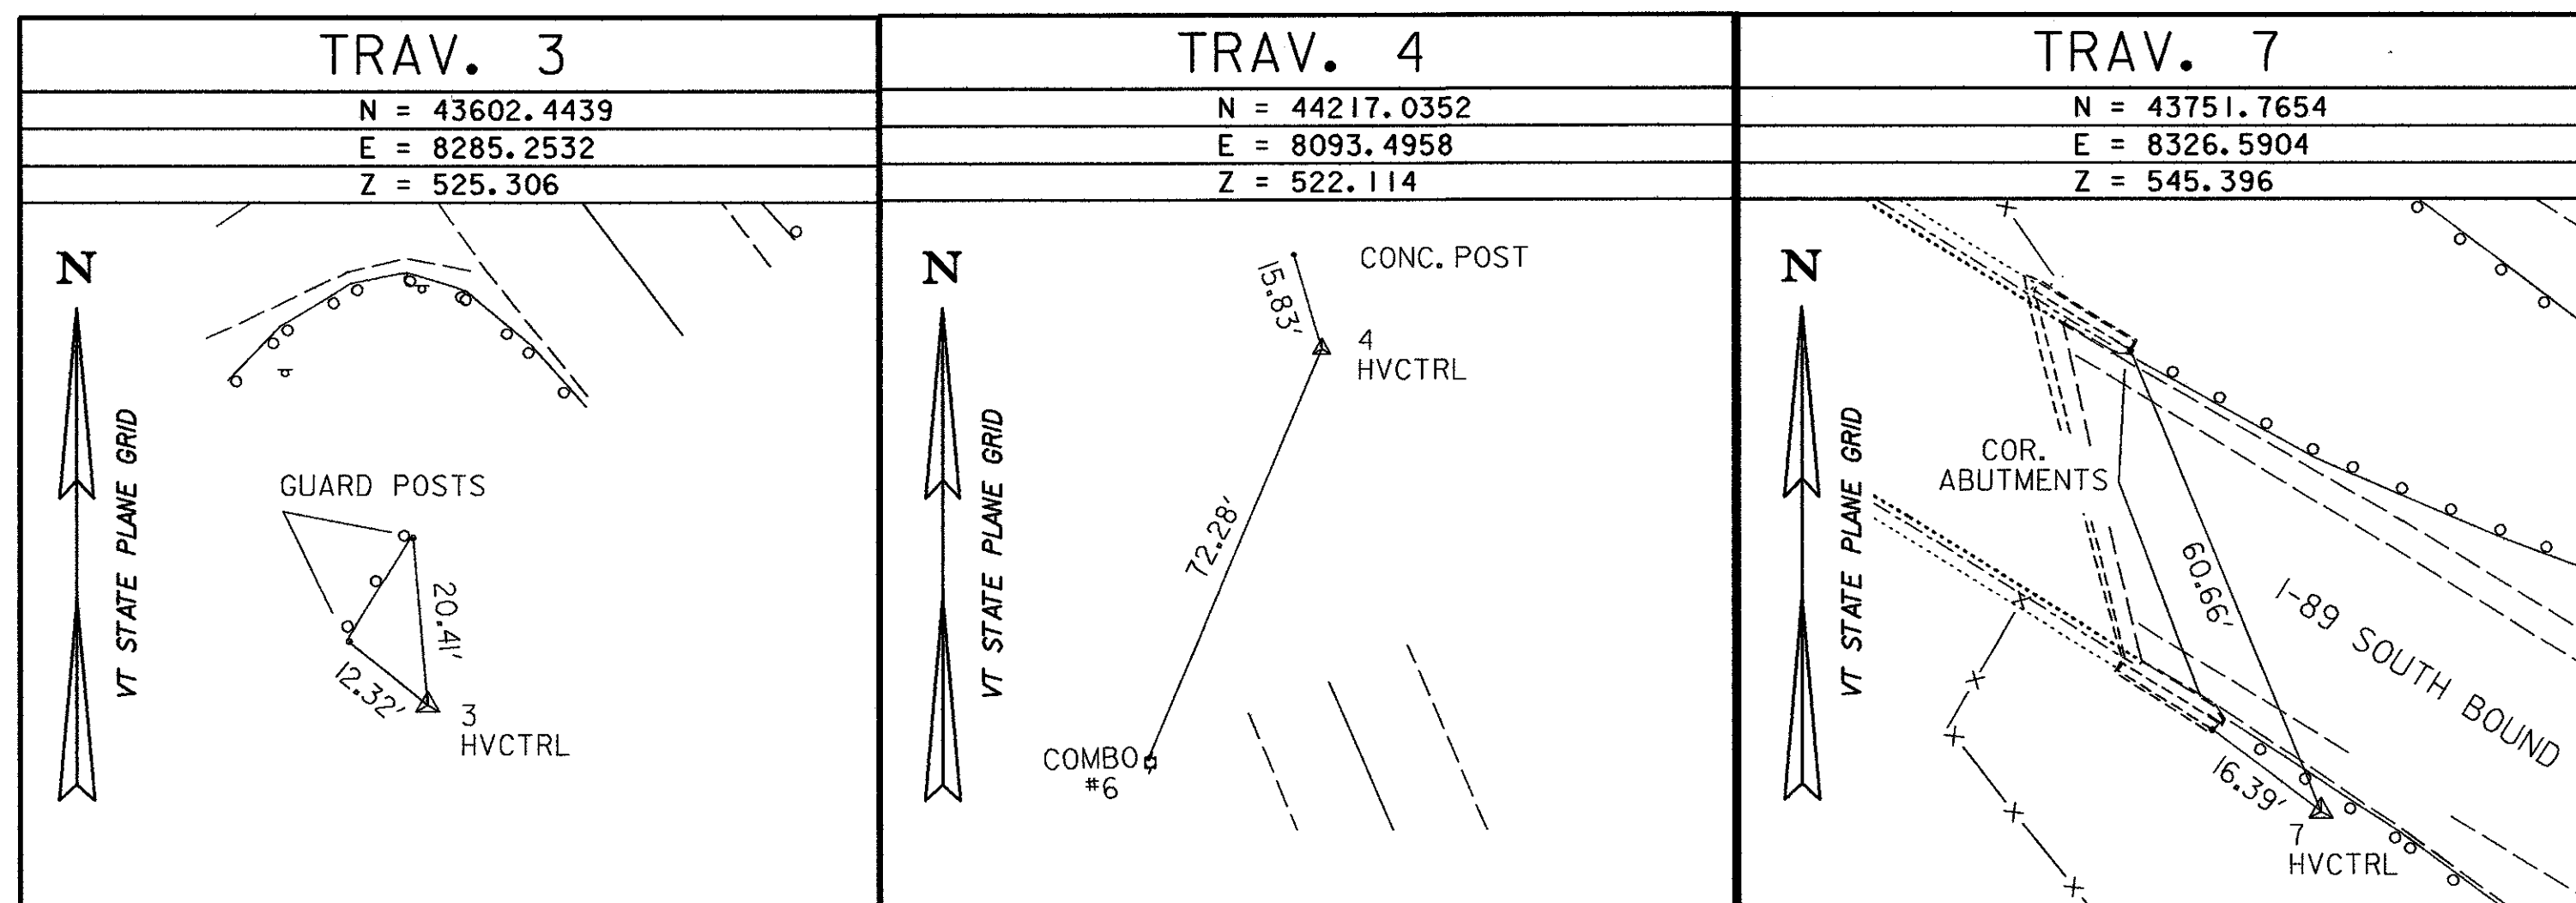

ALIGNMENT TIES

N =	N =	N =	N =	N =
E =	E =	E =	E =	E =

**NOTES:**

I. VAOT TO PROVIDE ALIGNMENT TIES DURING CONSTRUCTION.

**STATE OF VERMONT  
AGENCY OF TRANSPORTATION**

Town Of	MIDDLESEX-BOLTON	Bridge No.	<b>43N&amp;S</b>
Highway No.	I-89	Log Sta.	
		Surv. Sta.	
I-89 OVER US ROUTE 2			
<b>CONTROL POINT TIES (43N&amp;S)</b>			
Designed By	V.A.O.T.	Drawn By	V.A.O.T.
Checked By	Date	Bridge Design Supervisor	Date
V.A.O.T.	10/99	J.P. HALSTEAD	Date 10/99
PROJECT	MIDDLESEX-BOLTON	PROJECT NO.	IM-089-2(26)
TVGA CAD Drawing No.	43ties	Date	10/99
Bridge Sheet No.	<b>C-10</b>	Sheet	10 of 307

<b>DATUM</b>	
VERTICAL	NAVD 88
HORIZONTAL	NAD 83/92

GPS CONTROL POINTS

**TRAV. 1**

**VTGS SURVEY DISK STAMPED  
"PAPPY AZ MK. 1997"**

N = 78677.96340  
E = 60239.82600  
Z = 510.696

**STATION DESCRIPTION**

TO REACH THIS MARK FROM THE VT ROUTE 100 BRIDGE OVER I-89 AT EXIT 10 IN THE TOWN OF WATERBURY, TRAVEL NORTHBOUND ON I-89 FOR 3.1 MI (5.0 KM) TO THE MARK LOCATED ON THE RIGHT IN THE TOP OF A MASSIVE LEDGE OUTCROP. IT IS 0.15 MI (0.24 KM) NORTHWEST OF THE I-89 NORTHBOUND BRIDGE OVER U.S. ROUTE 2 AND 24M (78.7 FT) NORTHWEST OF MILEMARKER 66.80.

THIS MARK IS 7.1M (23.3 FT) NORTHEAST OF AND ABOUT 3 M (9.8 FT) HIGHER THAN THE NORTHEAST EDGE OF PAVEMENT OF I-89 NORTHBOUND. THE MARK IS 15.7 M (51.5 FT) SOUTHWEST OF THE RIGHT-OF-WAY FENCE, 6.3 M (20.7 FT) SOUTH SOUTHWEST OF A 25 CM PINE AND 0.3 M (1.0 FT) SOUTHWEST OF A FIBERGLASS WITNESS POST.

**TRAV. 2**

**VTGS SURVEY DISK STAMPED  
"PAPPY 1997"**


N = 75885.77410  
E = 66219.1800  
Z = 528.577

**STATION DESCRIPTION**

TO REACH THIS MARK FROM THE VT ROUTE 100 BRIDGE OVER I-89 AT EXIT 10 IN THE TOWN OF WATERBURY, TRAVEL NORTHBOUND ON I-89 FOR 1.8 MI (2.9KM) TO THE MARK LOCATED ON THE SOUTHEAST END OF A MASSIVE ROCK CUT. IT IS POSITIONED ON THE RIGHT AT THE TOP OF THIS ROCK CUT, RESTING JUST NORTHWEST OF MILE MARKER 65.50.

THIS MARK IS 5.5 M (18.0 FT) NORTHEAST OF SOUTHWEST FACE OF ROCK CUT, 59.7 M (195.9FT) SOUTHWEST OF RIGHT-OF-WAY FENCE, 47.9 M (157.2 FT) SOUTHWEST OF A 30 CM PINE, 4.38 (14.37 FT) EAST OF A DRILL HOLE WITH CHISELED LINES, 2.35 M (7.71FT) NORTHWEST OF A DRILL HOLE AND 0.3 M (1.0FT) SOUTHWEST OF A FIBERGLASS WITNESS POST.

TRAVERSE TIES

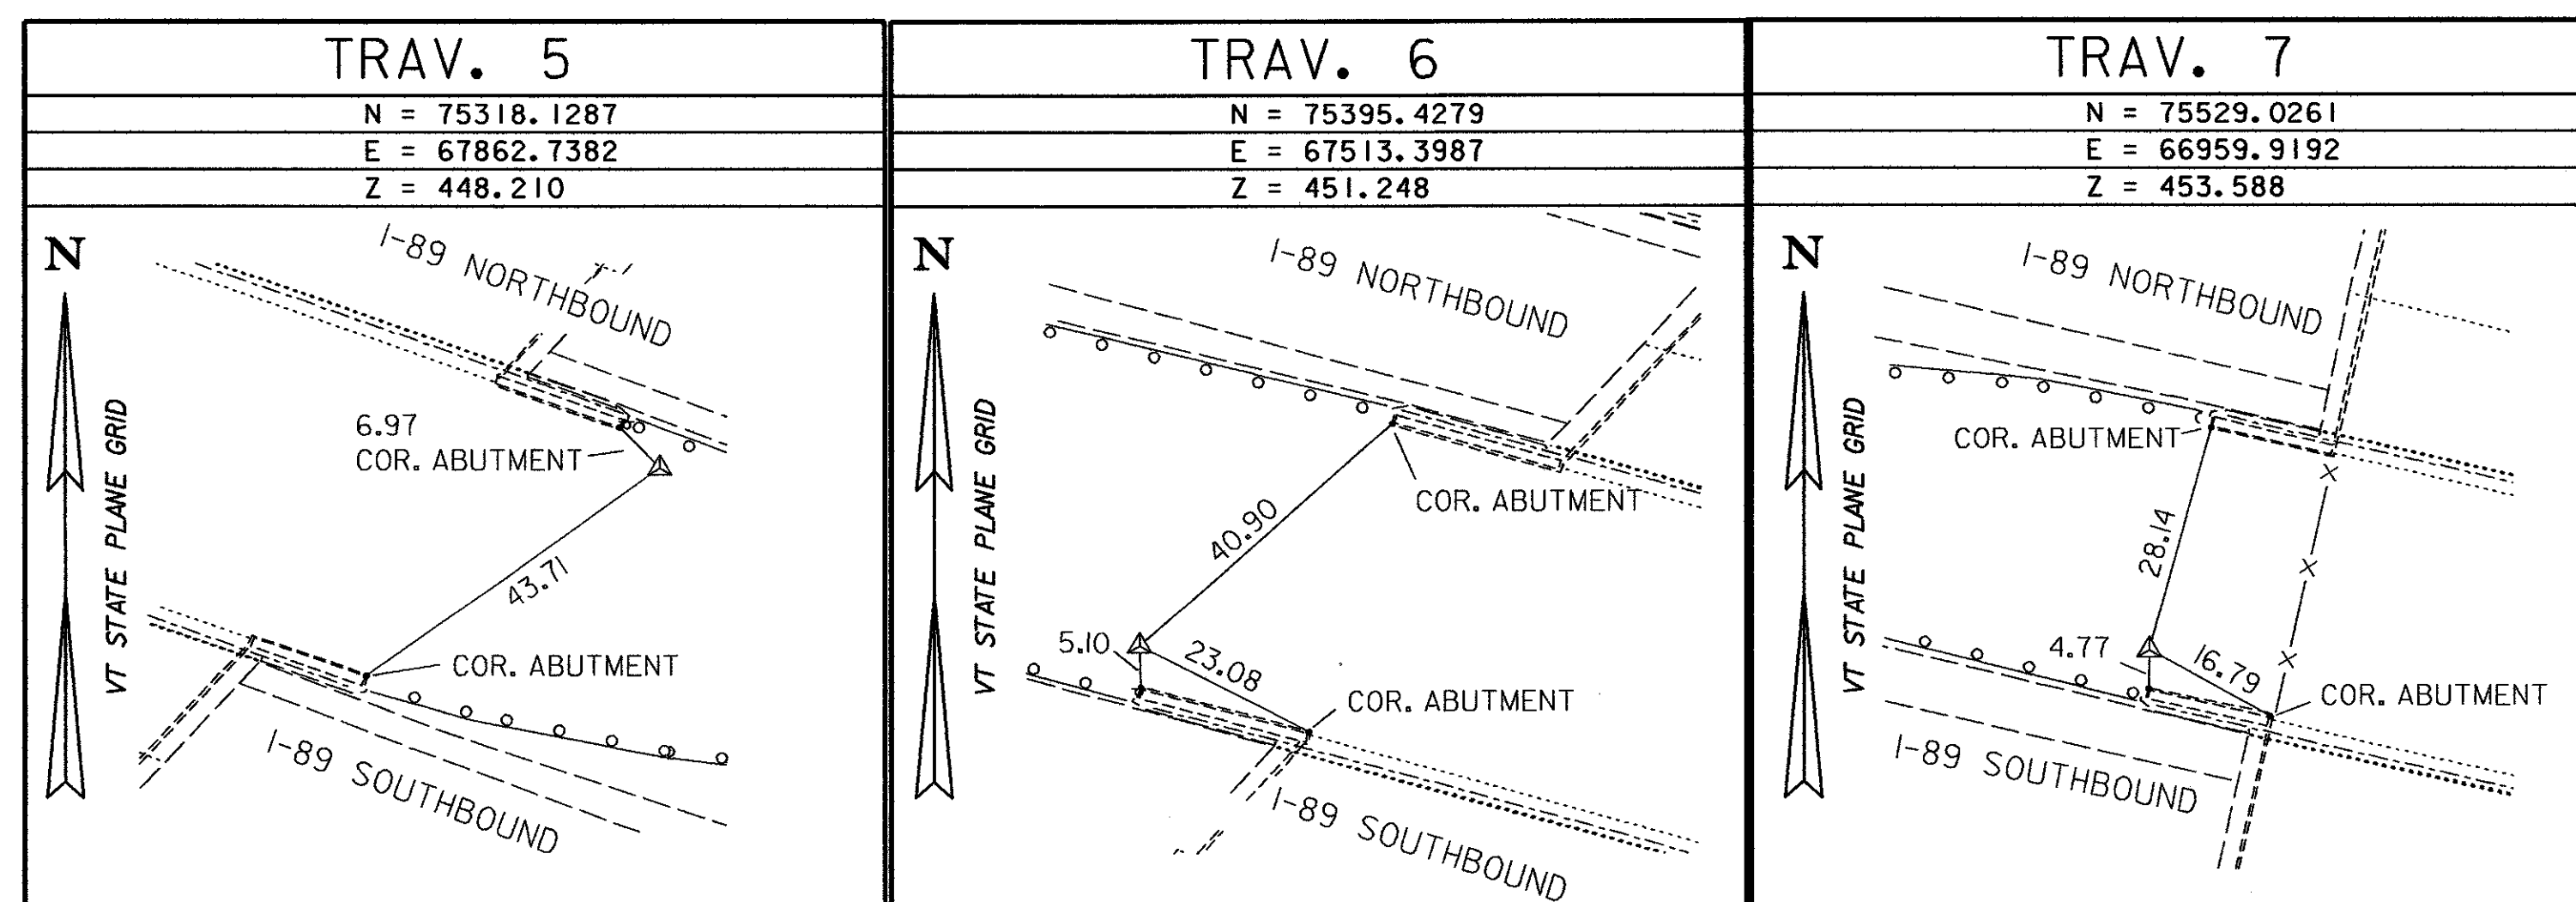

ALIGNMENT TIES


N =	N =	N =	N =	N =
E =	E =	E =	E =	E =

**NOTES:**

I. VAOT TO PROVIDE ALIGNMENT TIES DURING CONSTRUCTION.

<b>DATUM</b>	
VERTICAL	NAVD 88
HORIZONTAL	NAD 83/92

<b>STATE OF VERMONT AGENCY OF TRANSPORTATION</b>	
Town Of <b>MIDDLESEX-BOLTON</b>	Bridge No. <b>48&amp;49</b>
Highway No. <b>I-89</b>	Log Sta. Surv. Sta.
<b>I-89 OVER LITTLE RIVER (48) / I-89 OVER TH 7 (49)</b>	
<b>CONTROL POINT TIES (48N&amp;S AND 49N&amp;S)</b>	
Designed By <b>V.A.O.T.</b>	Drawn By <b>V.A.O.T.</b>
Checked By <b>V.A.O.T.</b>	Bridge Design Supervisor <b>J.P. HALSTEAD</b>
Date <b>10/99</b>	Date <b>10/99</b>
PROJECT <b>MIDDLESEX-BOLTON</b>	PROJECT NO. <b>IM-089-2(26)</b>
TVGA CAD Drawing No. <b>48&amp;49tie</b>	Date <b>10/99</b>
Bridge Sheet No. <b>C-11</b>	Sheet <b>11</b> of <b>307</b>

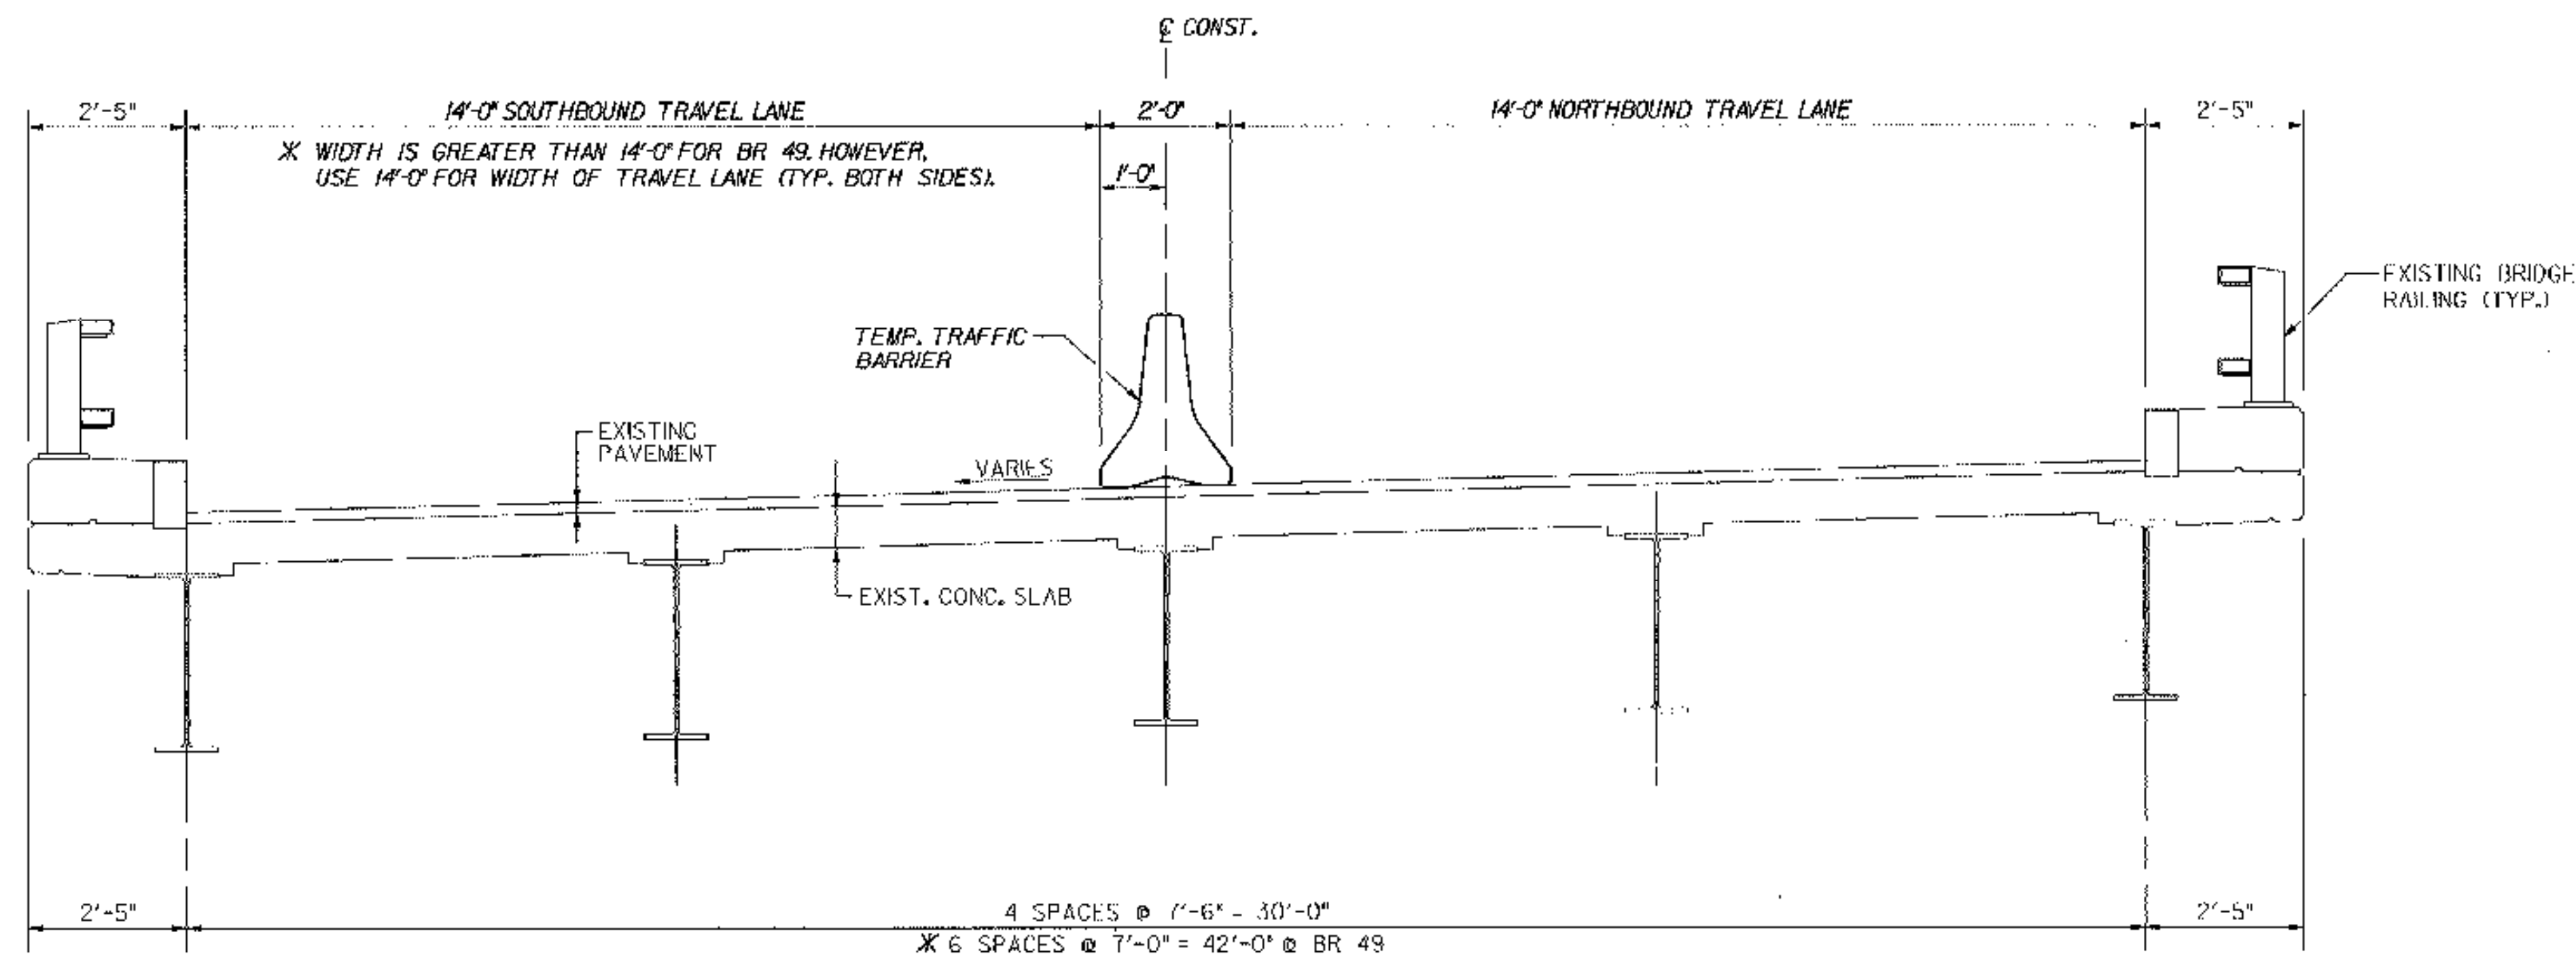


**TYPICAL PHASE I TRAFFIC CONTROL ON EXISTING BRIDGE (NORTHBOUND)**

SCALE: 1/2" = 1'-0"

**NOTE:**


X TRANSVERSE SECTIONS FOR BR 43, 48, 50 AND 51 ARE SHOWN.  
TRANSVERSE SECTION FOR BR 49 IS SIMILAR EXCEPT AS NOTED.

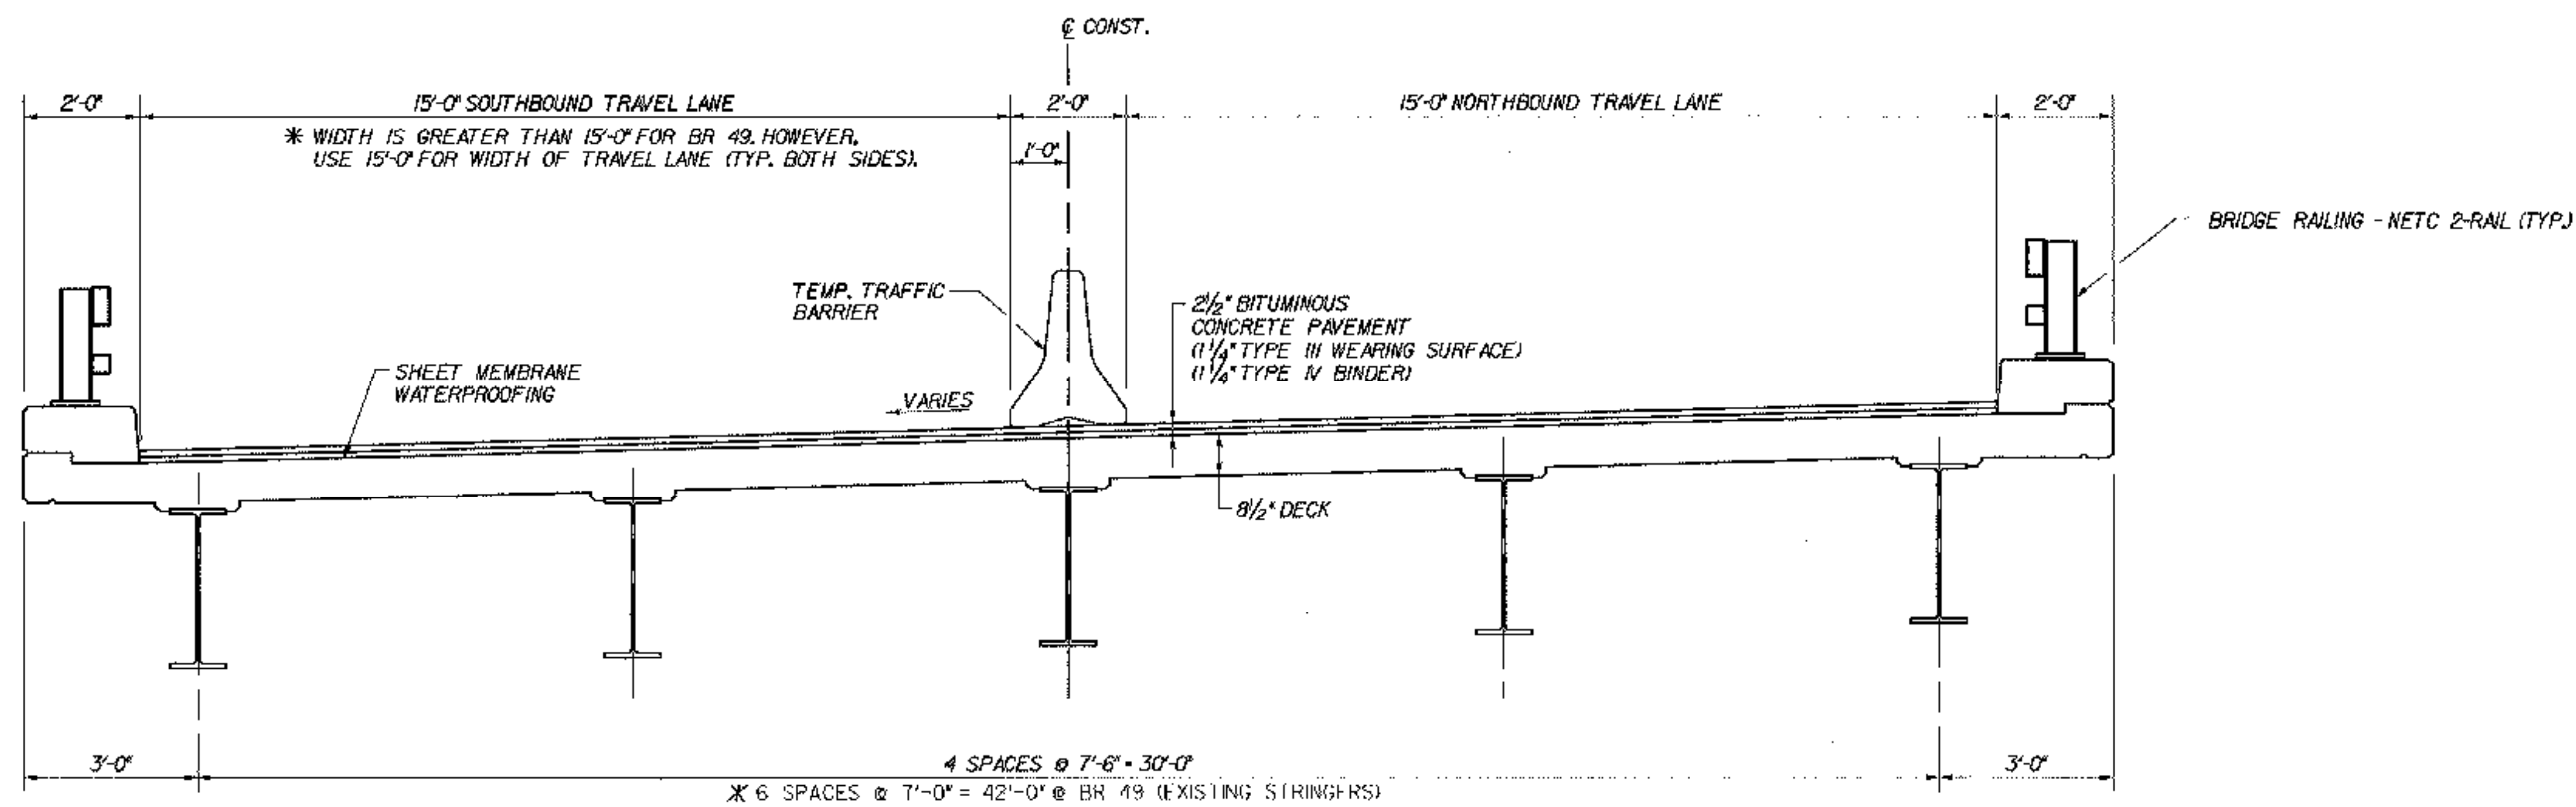


**TYPICAL PHASE II TRAFFIC CONTROL ON NEW BRIDGE (SOUTHBOUND)**

SCALE: 1/2" = 1'-0"


<b>STATE OF VERMONT AGENCY OF TRANSPORTATION</b>			
Town Of	MIDDLESEX-BOLTON	Bridge No.	
Highway No.	I-89	Log Sta.	
		Surv. Sta.	
<b>TRANSVERSE SECTIONS FOR TRAFFIC CONTROL</b>			
Designed By	P.W. SZUSTAK	Drawn By	R.A. BOTZENHART
Checked By	J.P. HALSTEAD	Bridge Design Supervisor	J.P. HALSTEAD
Date	10/99	Date	10/99
PROJECT	MIDDLESEX-BOLTON	PROJECT NO.	IM-089-2(26)
TVGA CAD Drawing No.	tstraf	Date	10/99
Bridge Sheet No.	C-14	Sheet	14 of 307

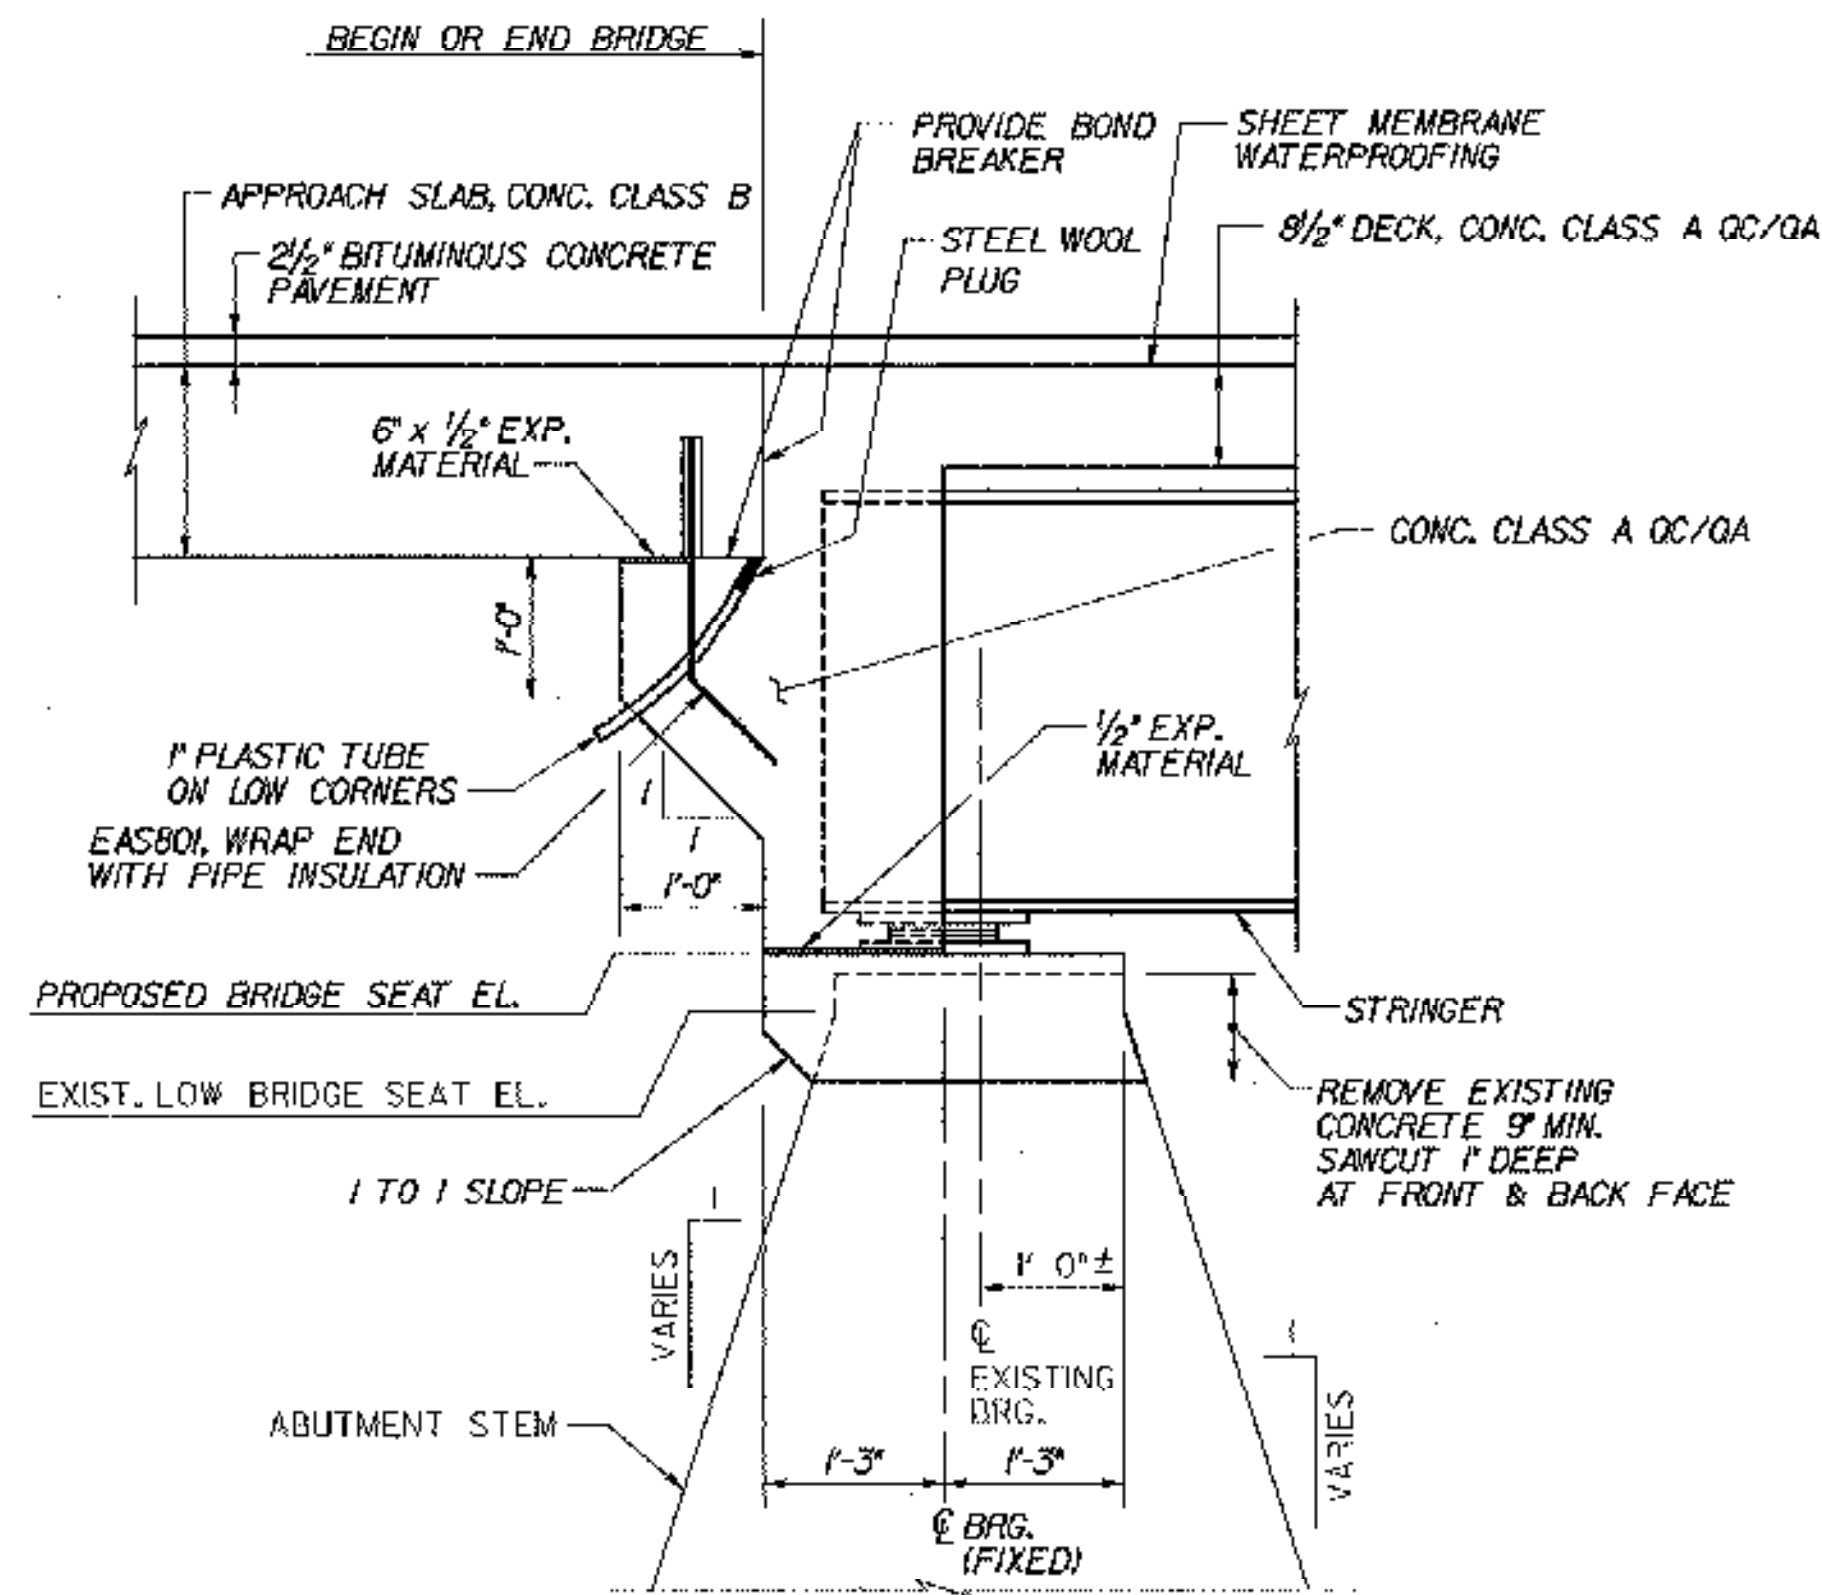


**TYPICAL FIXED ABUT. DETAIL, TYPE "C"**  
(NORMAL TO  $\phi$  BEARING)  
SCALE: 3/4"=1'-0"

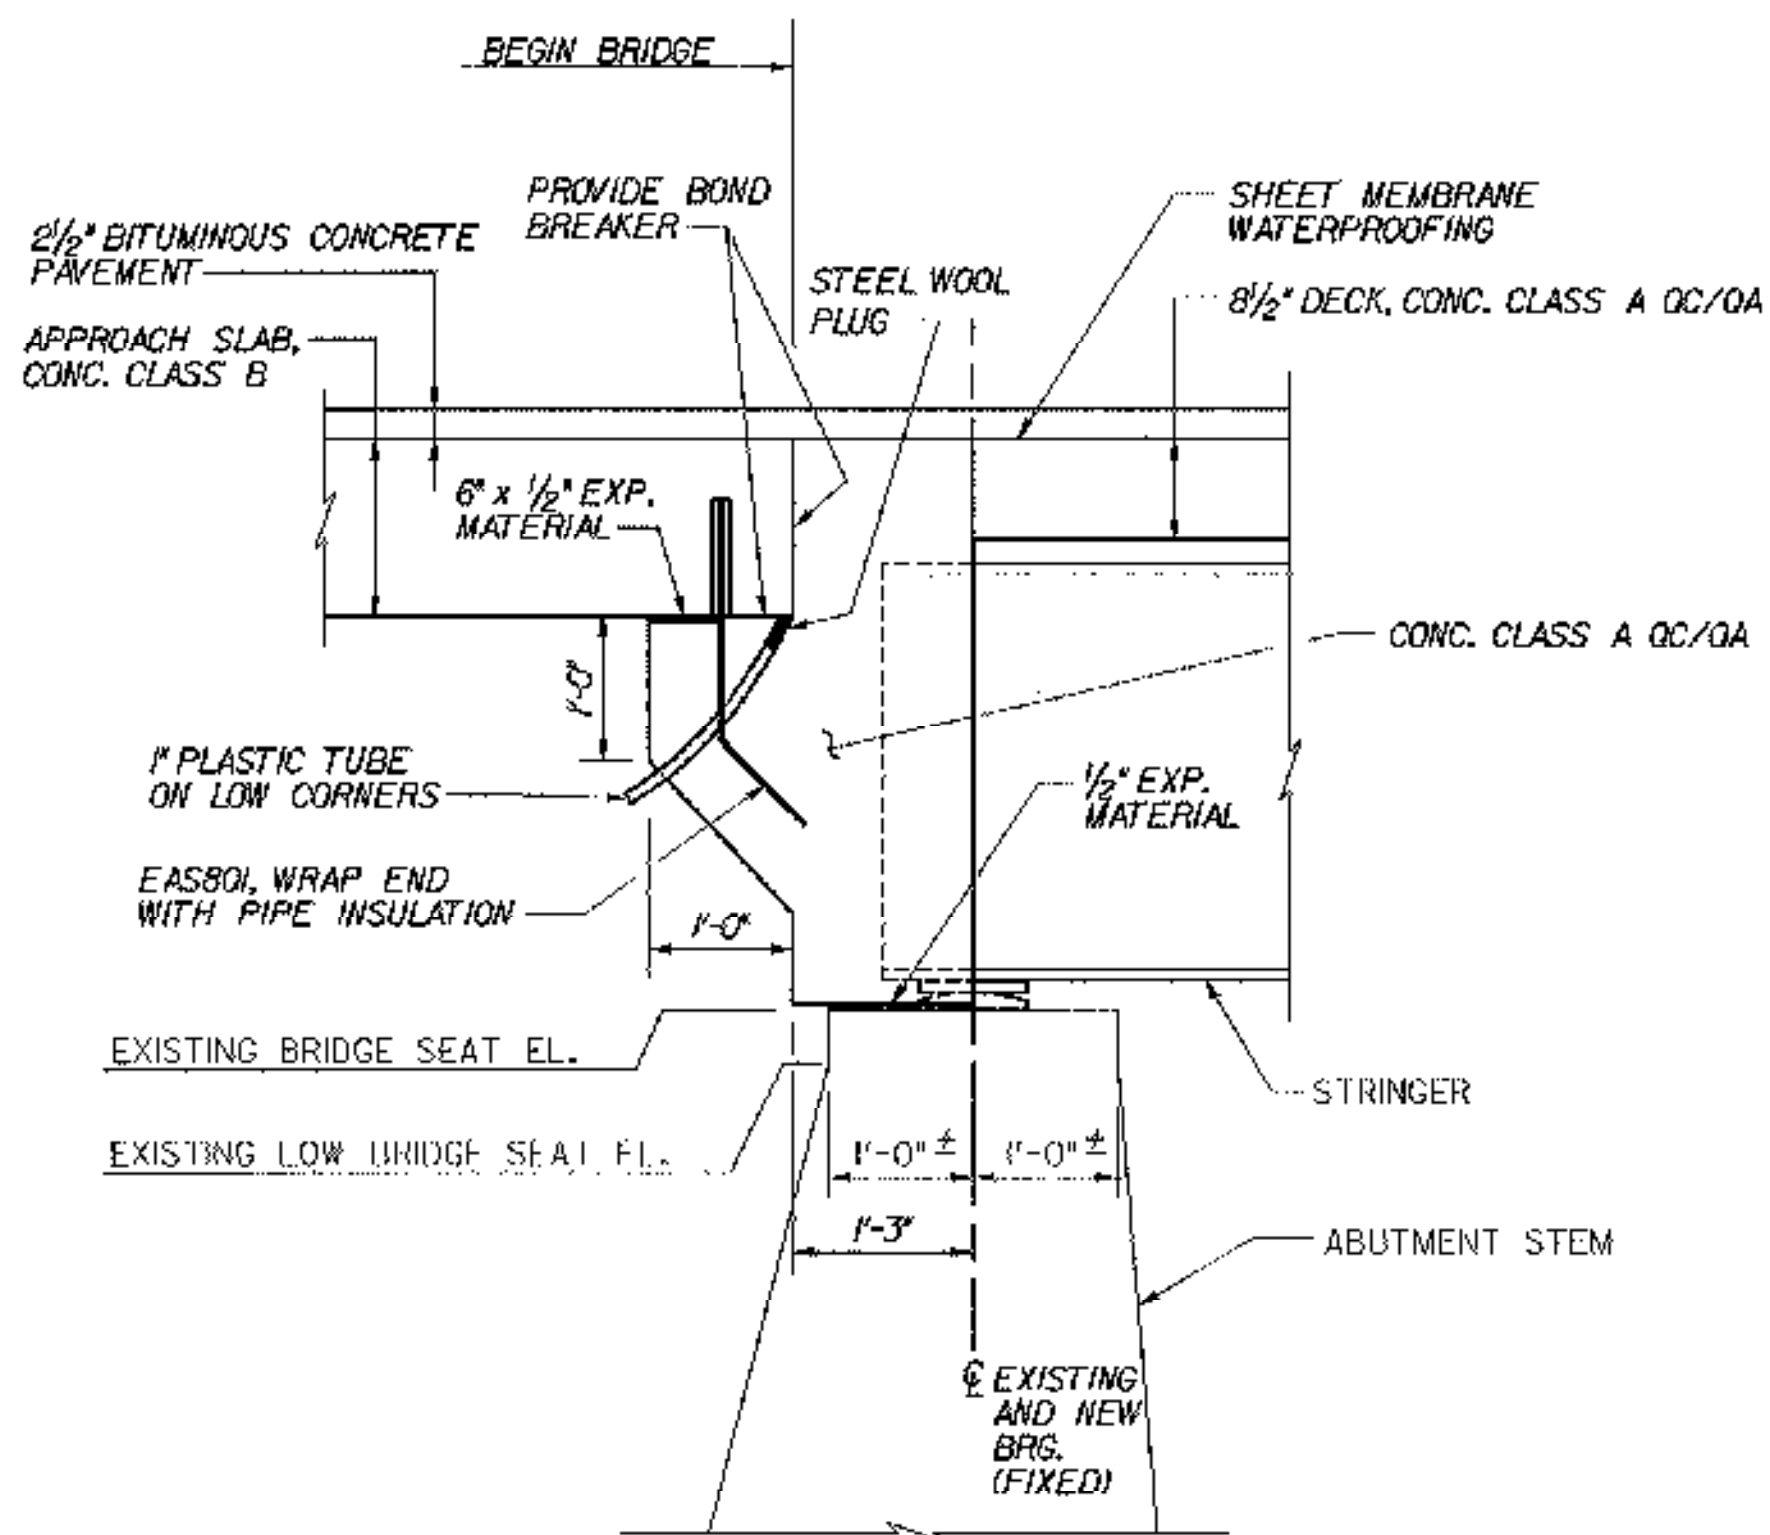


**FIXED ABUT. DETAIL, TYPE "C"**  
(NORMAL TO  $\phi$  BEARING)  
(BR 49N&S ONLY)  
SCALE: 3/4"=1'-0"

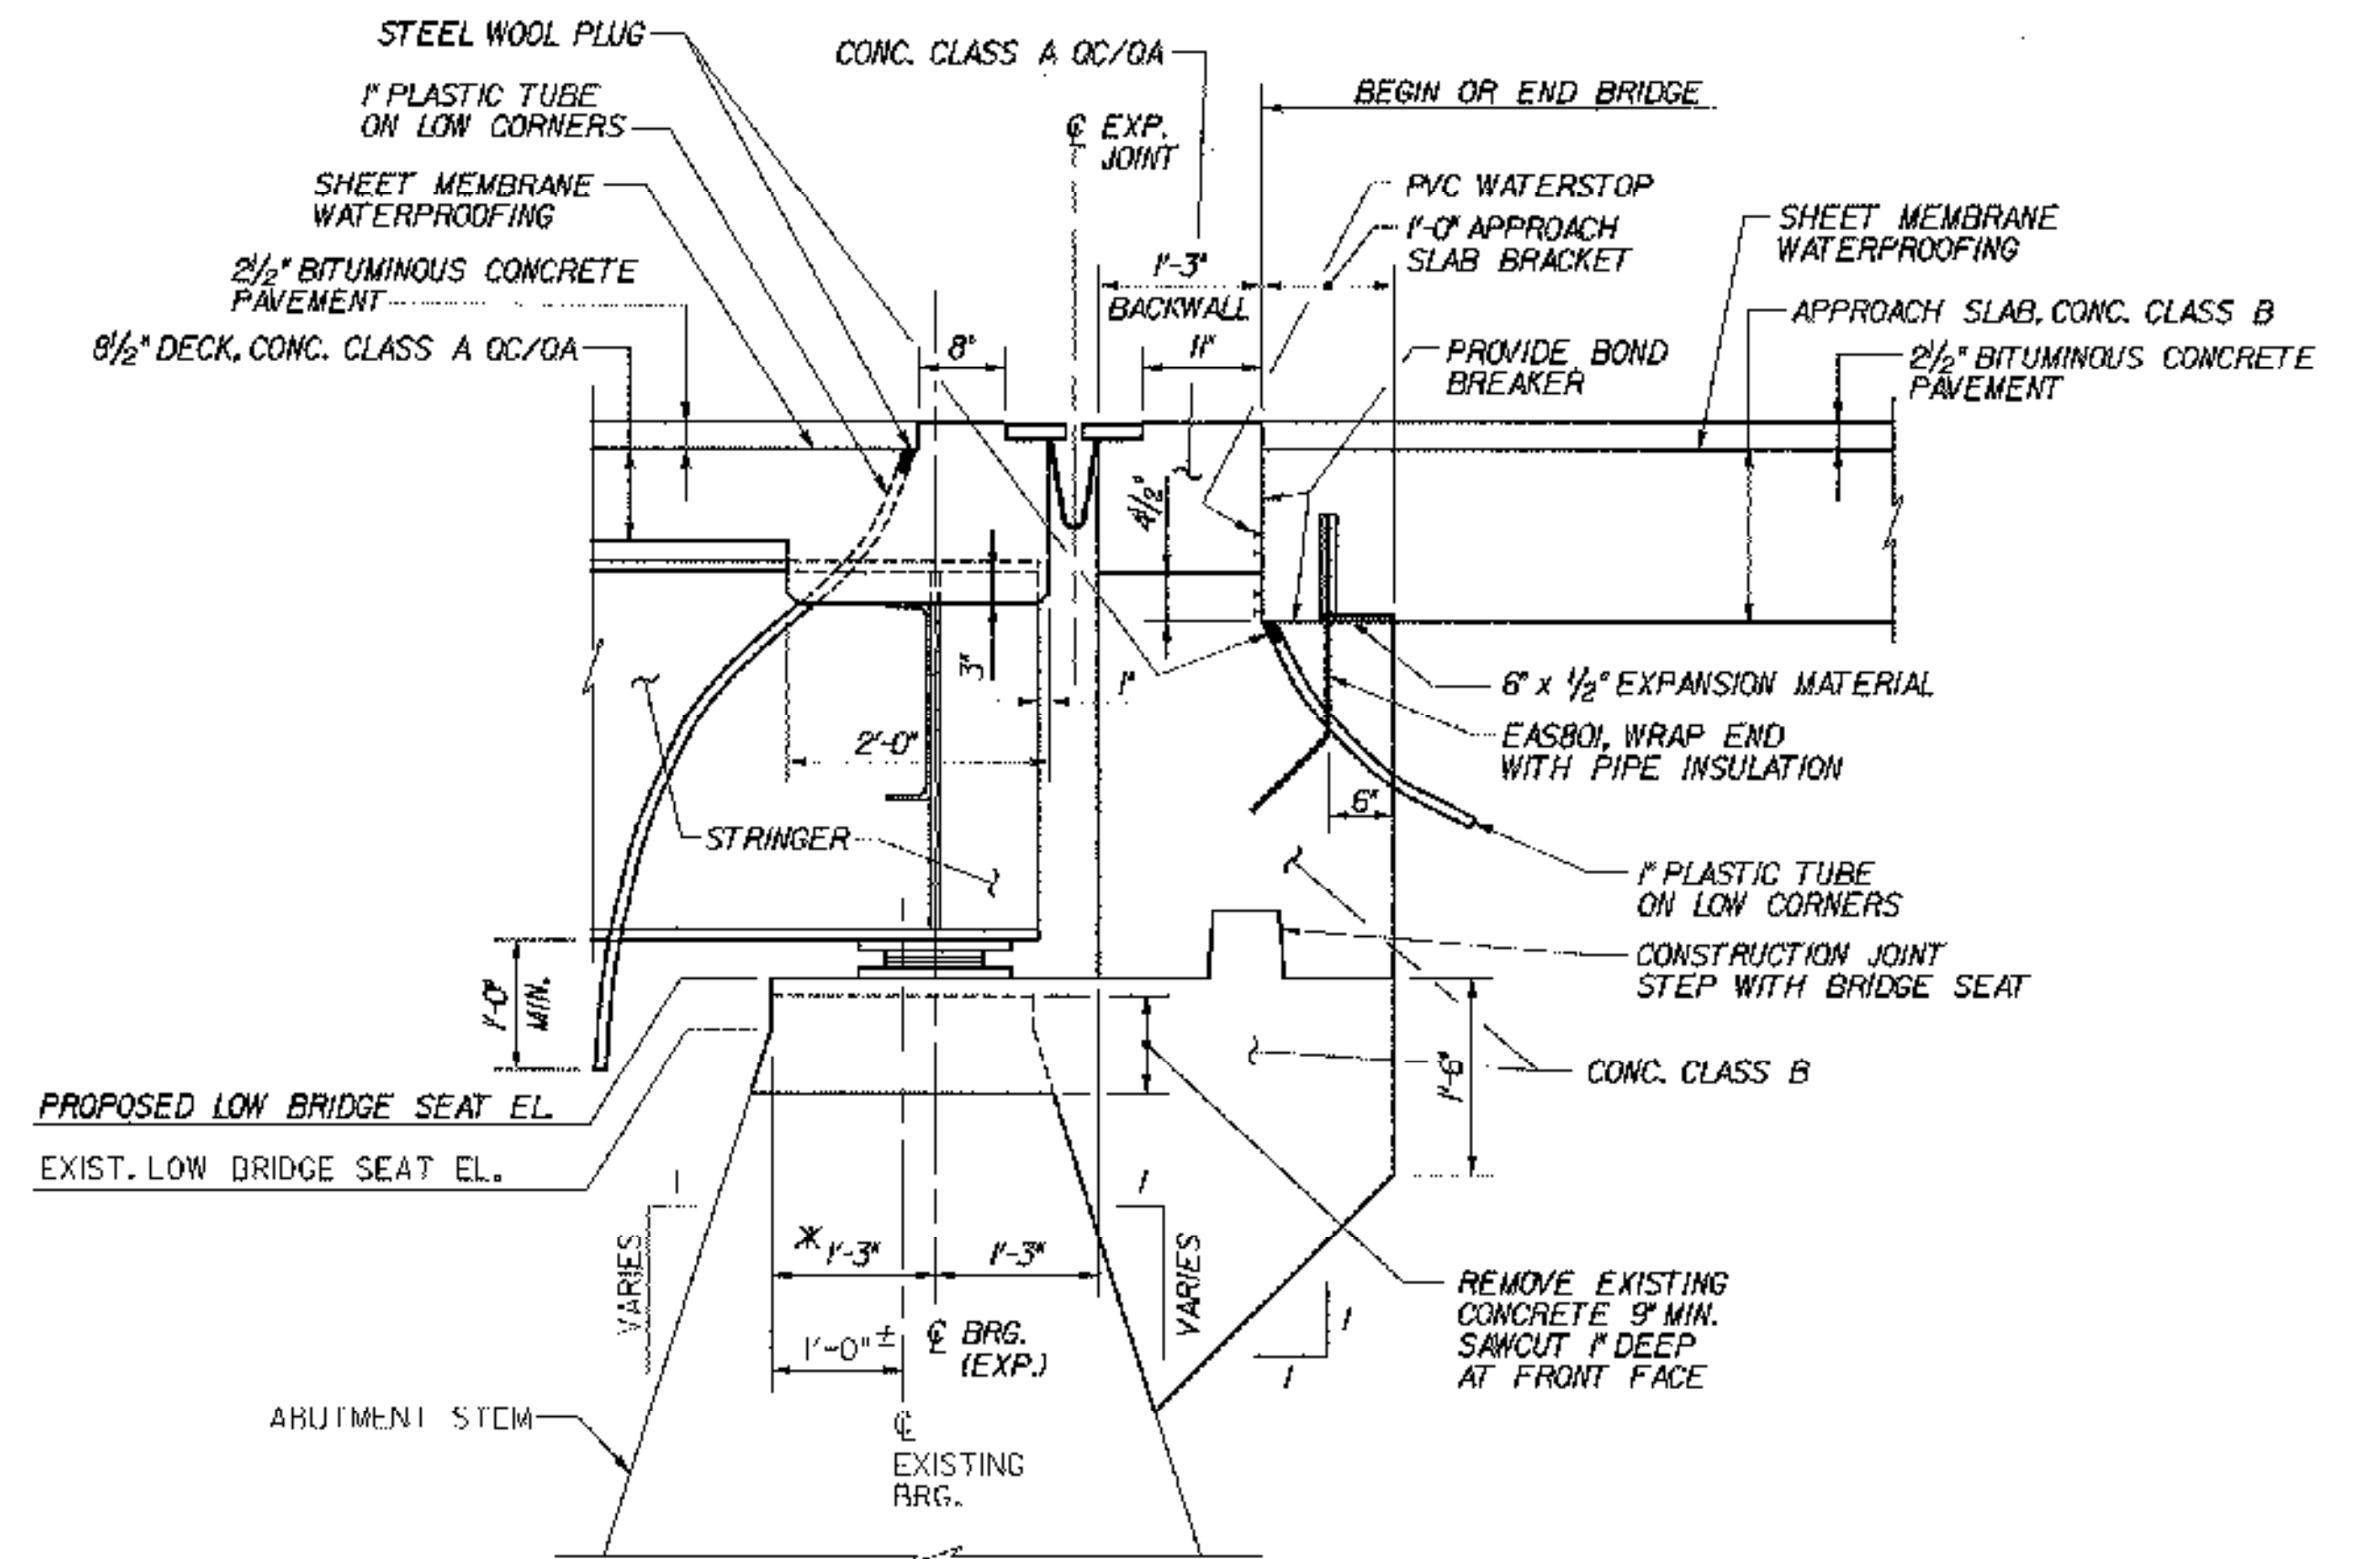

**TYPICAL EXP. ABUT. DETAIL, TYPE "H"**  
(NORMAL TO  $\phi$  BEARING)  
SCALE: 3/4"=1'-0"

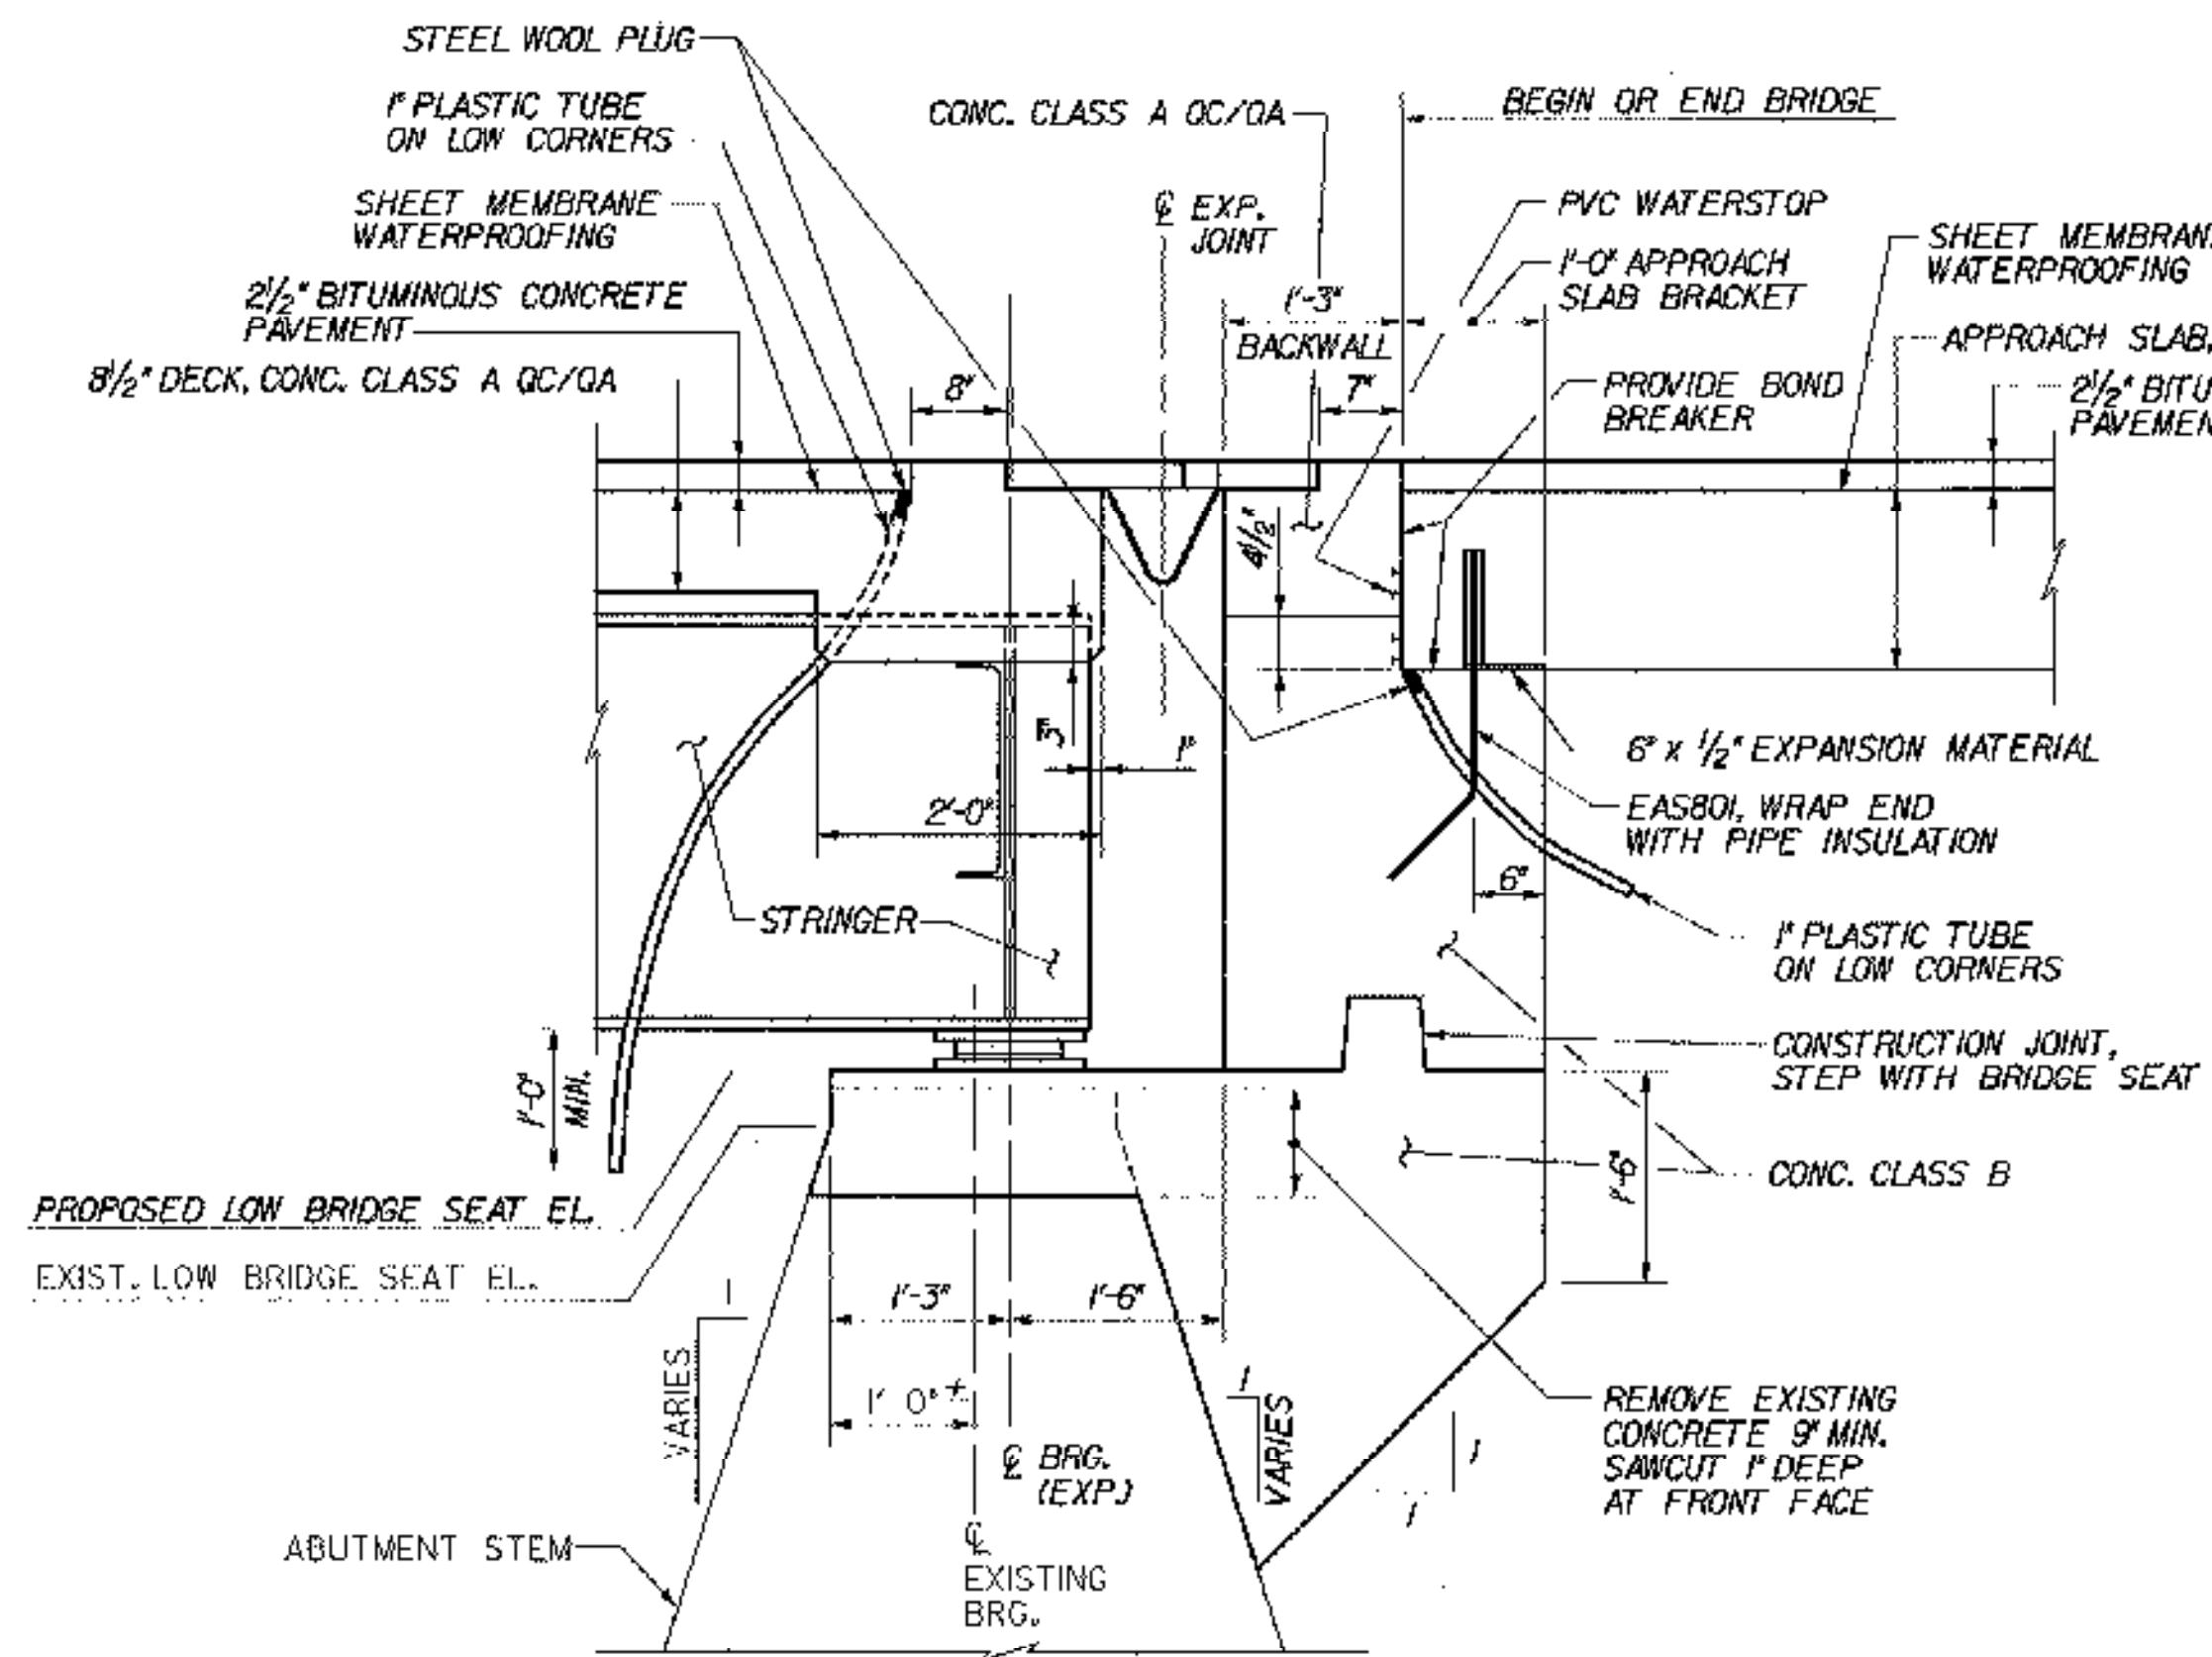

**TYPICAL EXP. ABUT. DETAIL, FINGER JOINT**  
(NORMAL TO  $\phi$  BEARING)  
SCALE: 3/4"=1'-0"

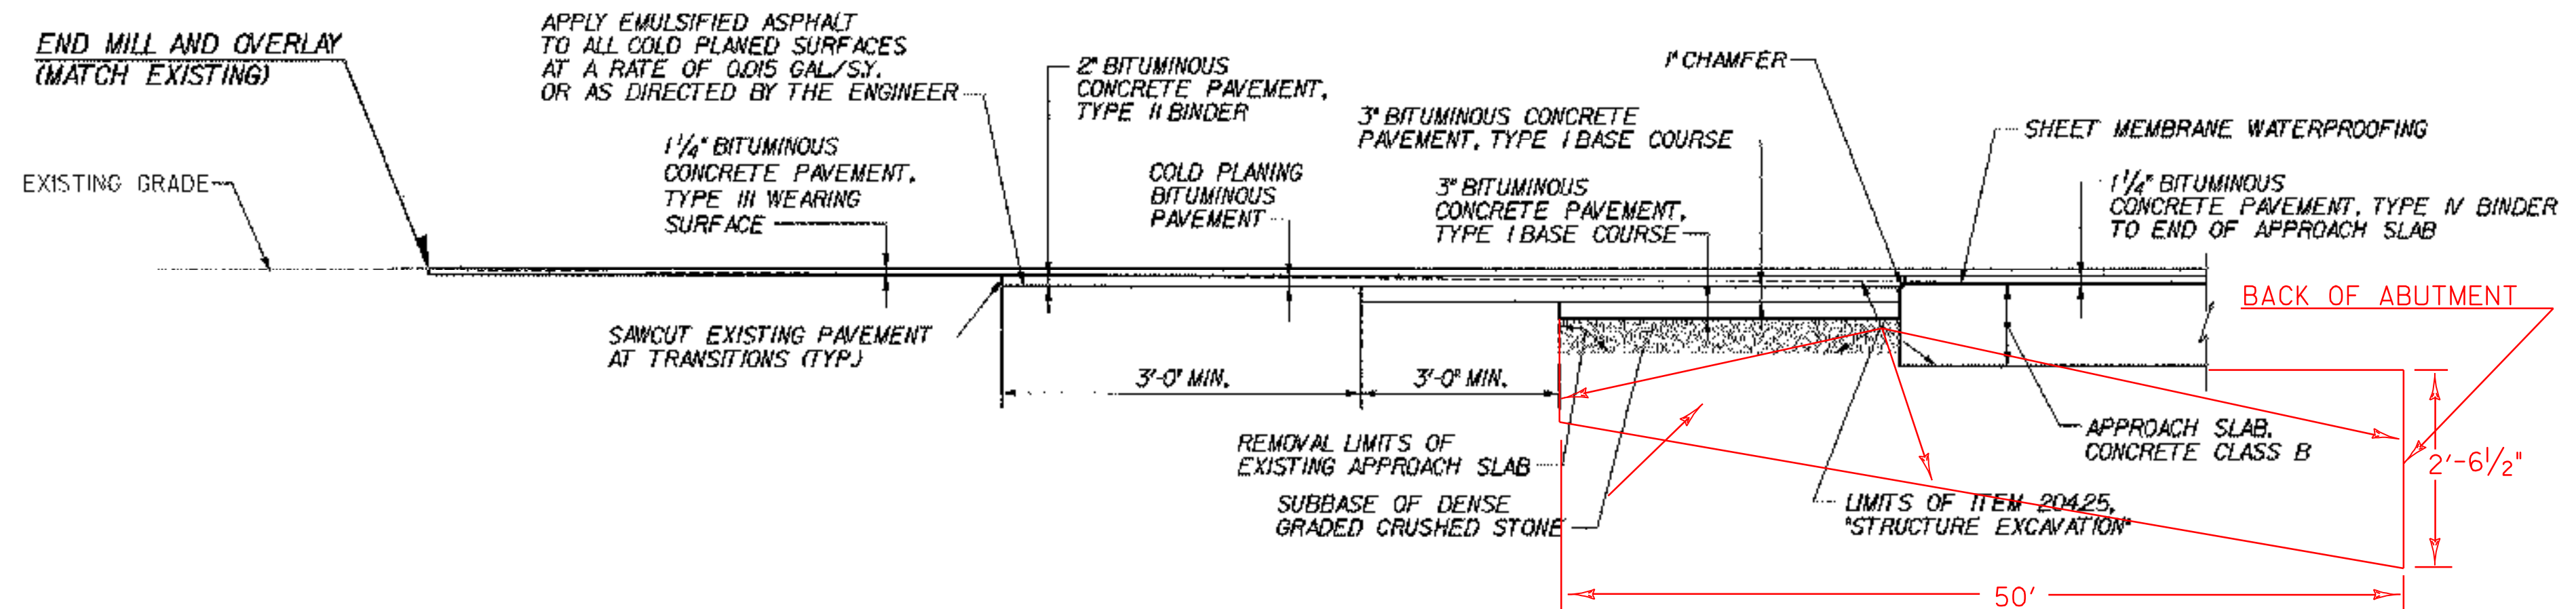

**APPROACH PAVEMENT TRANSITION DETAIL**  
N.T.S.

1. NEW AREA IS ALL DENSE GRADED CRUSHED STONE
2. NEW AREA IS ALSO THE LIMITS OF 204.25 STRUCTURE EXCAVATION
3. TYPICAL FOR ALL BRIDGES

(NOT SHOWN - END OF DECK SLAB AT PIER  
SIMILAR TO END OF DECK SLAB AT TYPICAL  
EXP. ABUT. DETAIL, TYPE "H")

**TYPICAL EXP. PIER DETAIL, TYPE "H"**

**STATE OF VERMONT  
AGENCY OF TRANSPORTATION**


Town Of	MIDDLESEX-BOLTON	Bridge No.	
Highway No.	1-89	Log Sta.	
		Surv. Sta.	

**TYPICAL END OF DECK SLAB DETAILS**


Designed By	P.W. SZUSTAK	Drawn By	R.A. BOTZENHART
Checked By	Date	Bridge Design Supervisor	
J.P. HALSTEAD	10/99	J.P. HALSTEAD	Date 10/99

PROJECT	MIDDLESEX-BOLTON	PROJECT NO.	IM-089-2(26)
---------	------------------	-------------	--------------


TYGA CAD Drawing No.	dsabdet	Date	10/99
Bridge Sheet No.	C-15	Sheet	15 of 307

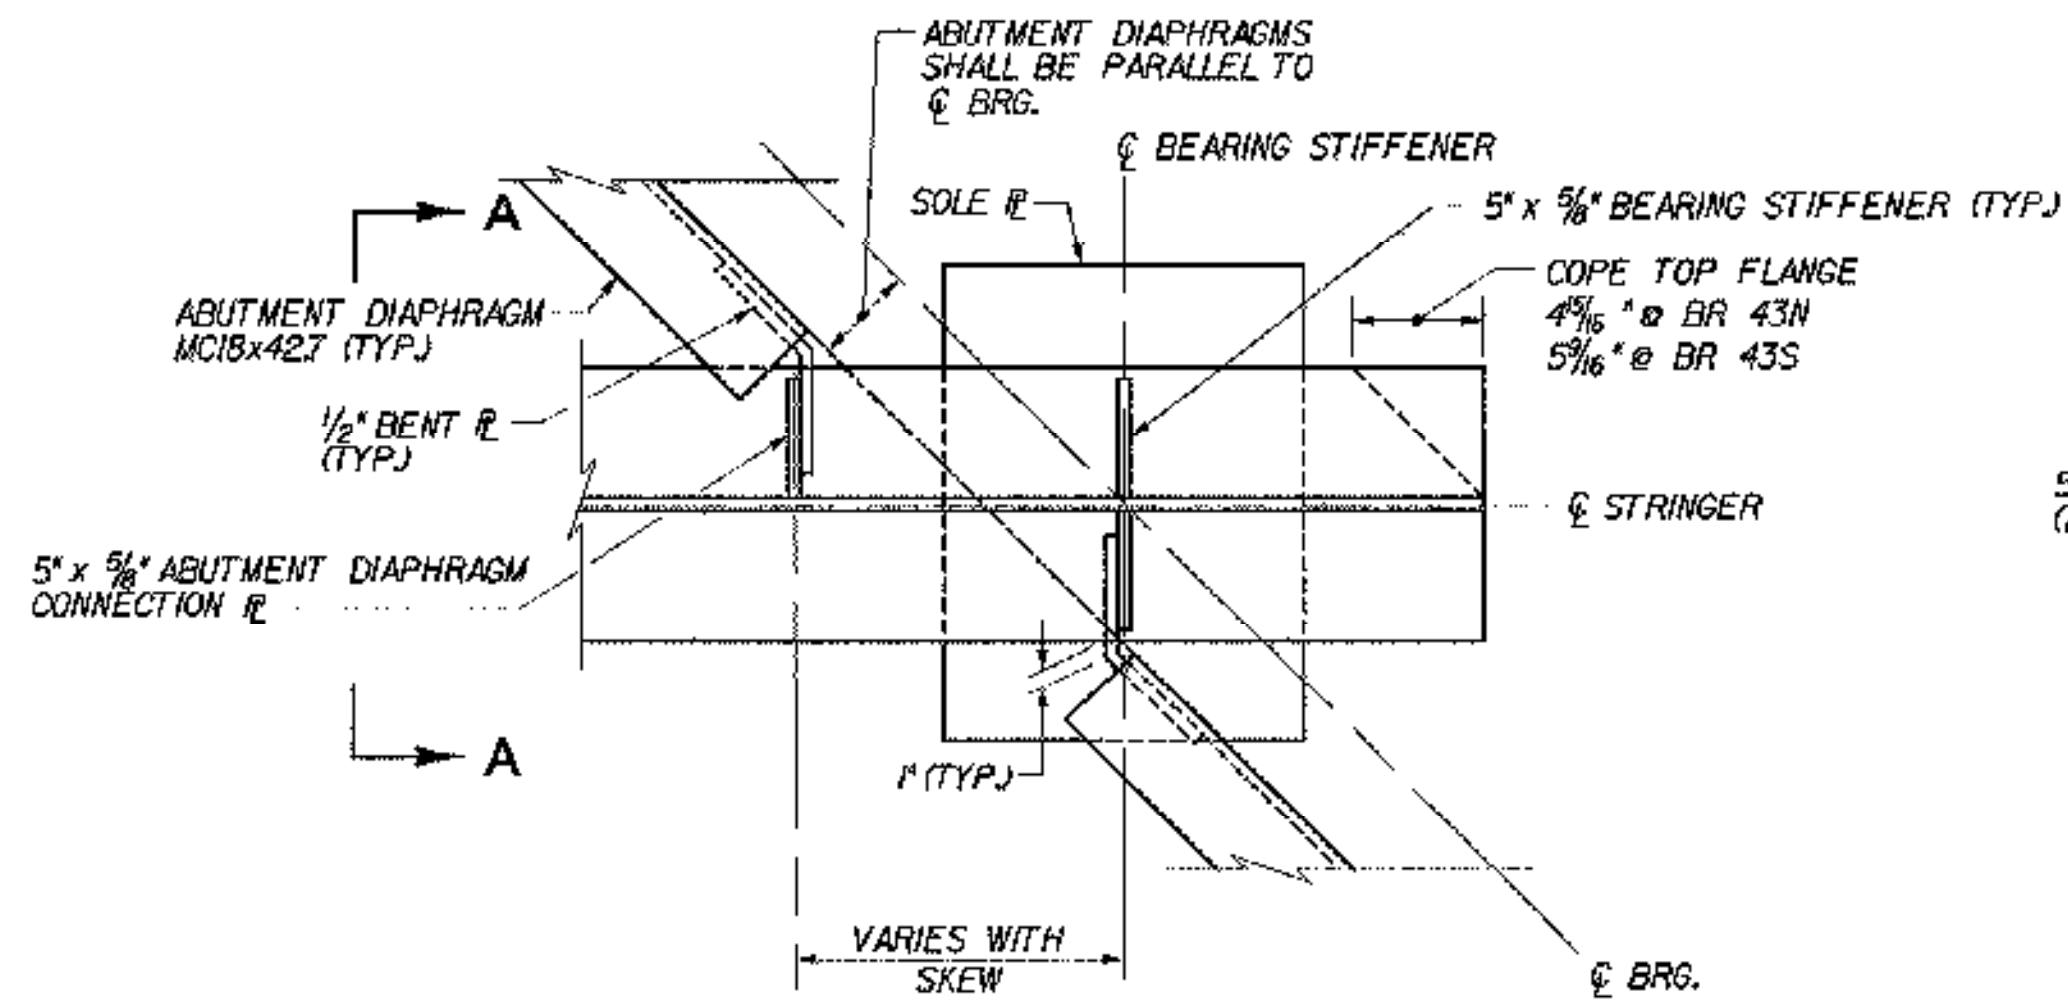

**PLAN AT EXPANSION ABUTMENTS**  
(BR 43N&S)  
N.T.S.

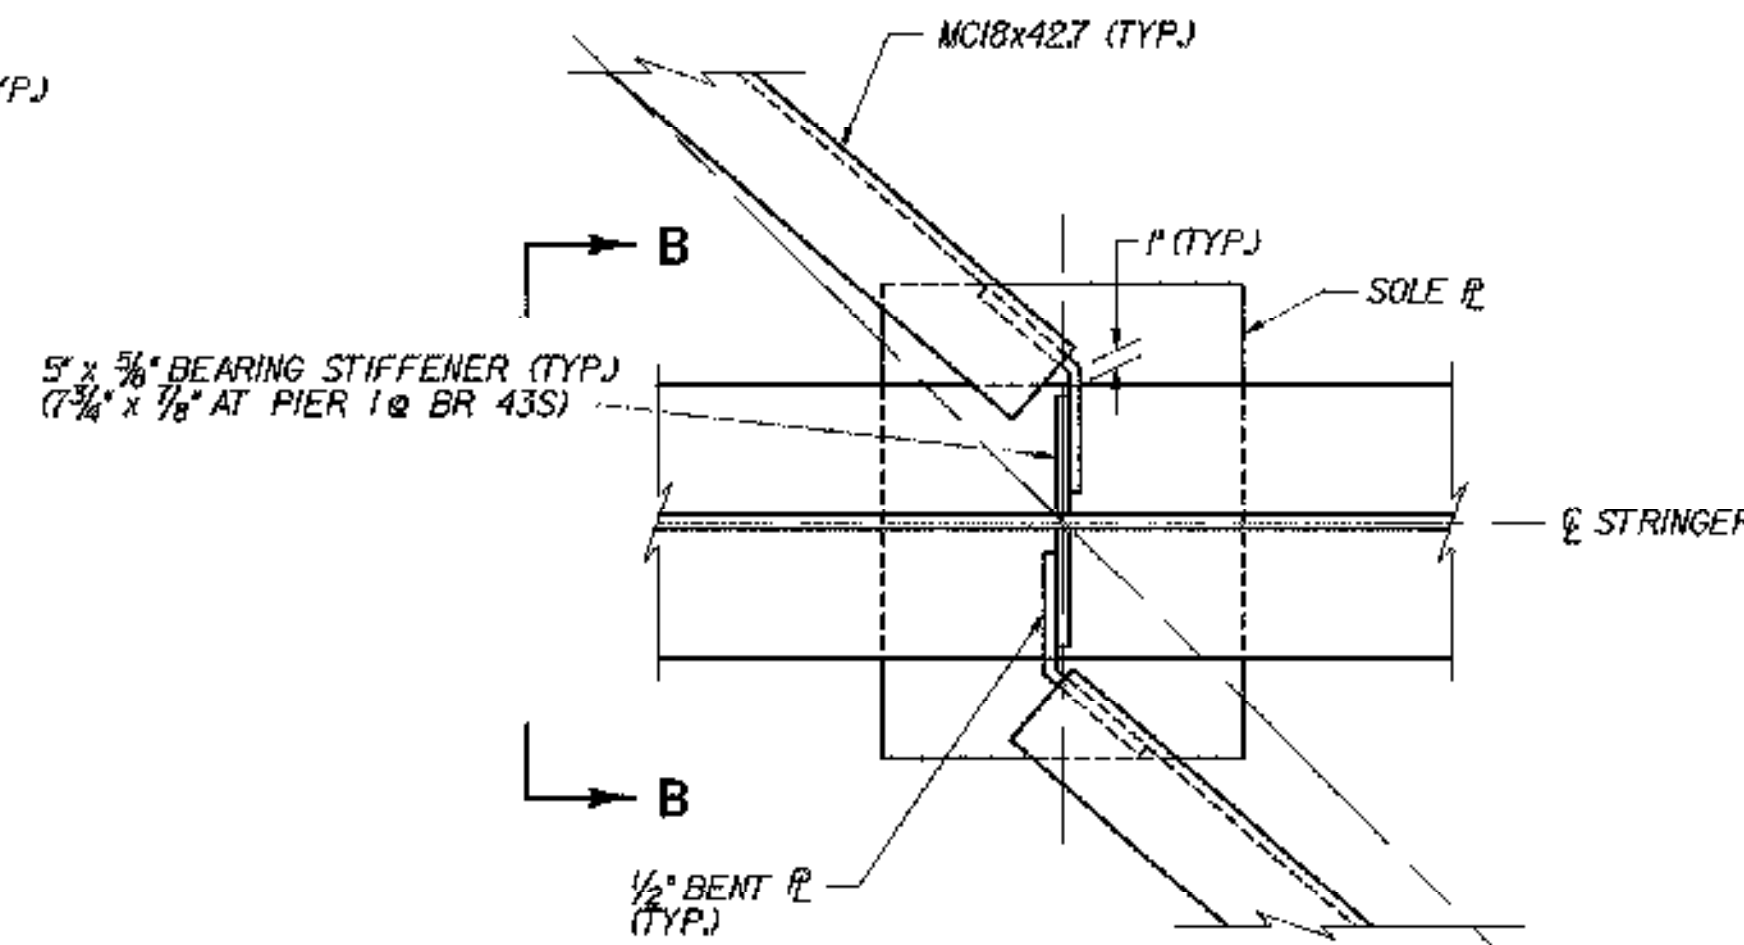


**PLAN AT PIERS**  
(BR 43N&S)  
N.T.S.

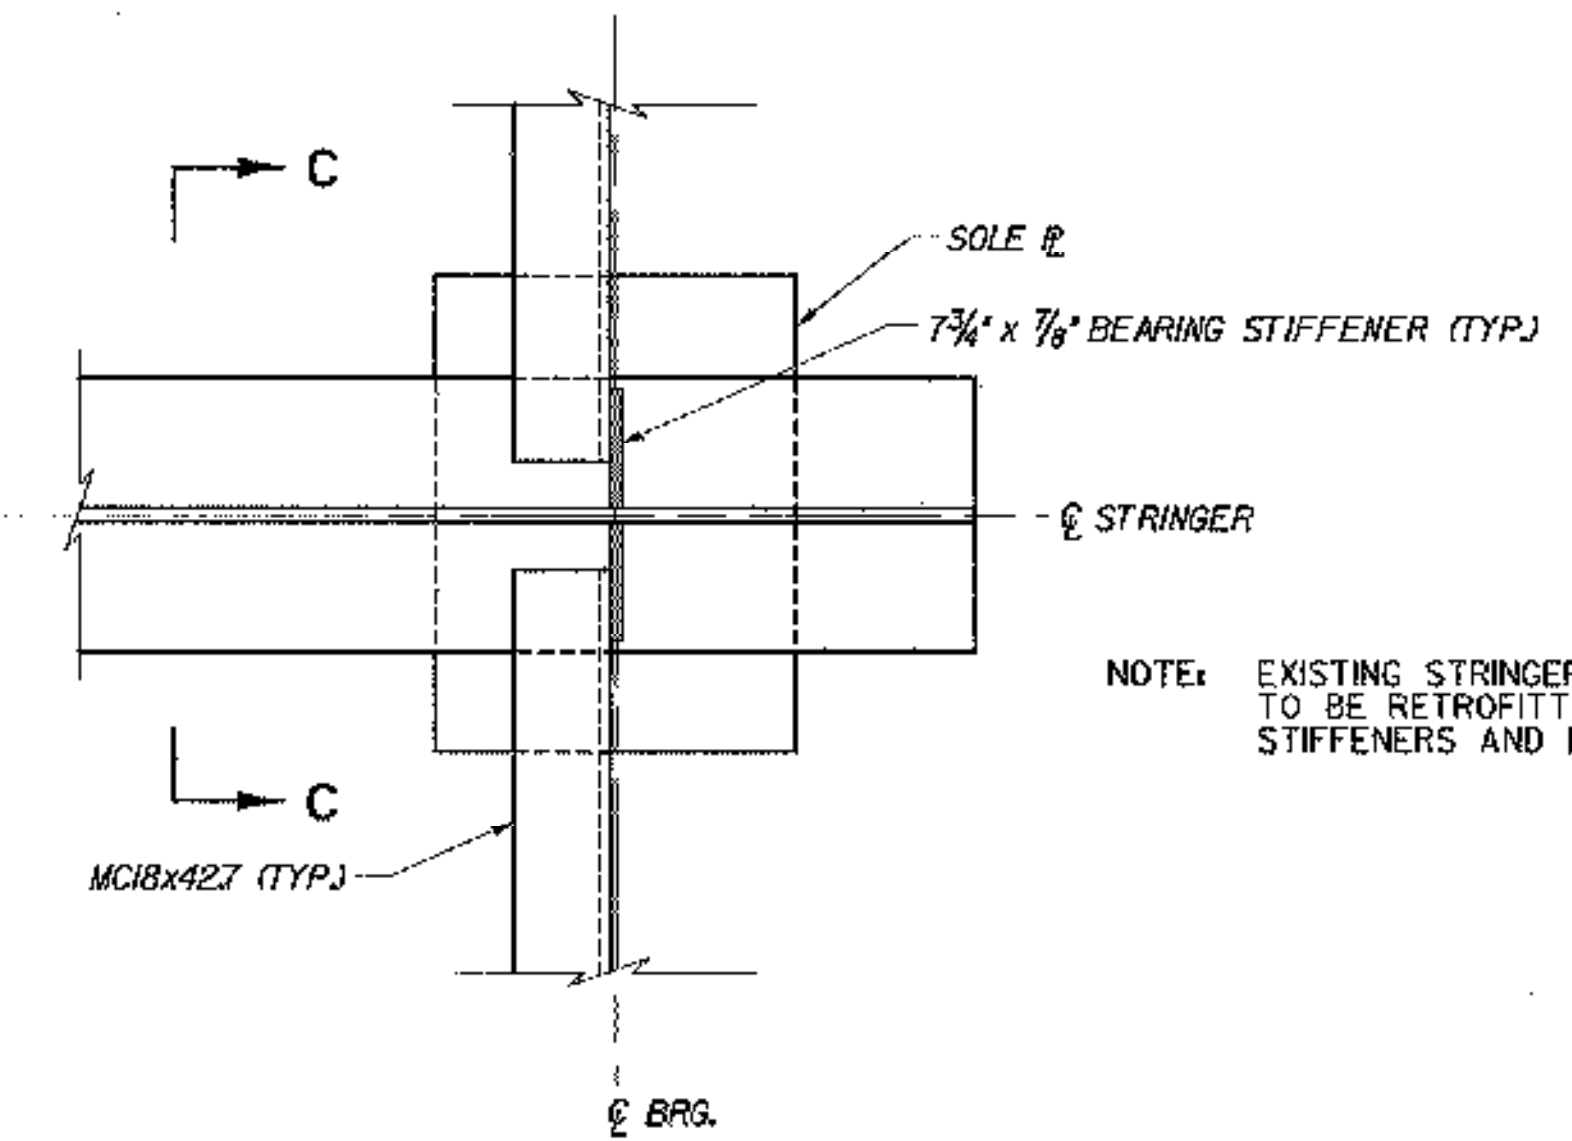


**PLAN AT ABUTMENTS AND PIERS**  
(PIER 1 AT BR 51N&S)  
(ABUTMENT 2 AT BR 49N&S)  
N.T.S.


NOTE: EXISTING STRINGERS AT BR 49N&S ABUT. 2 TO BE RETROFITTED WITH NEW BRG. STIFFENERS AND DIAPHRAGMS.

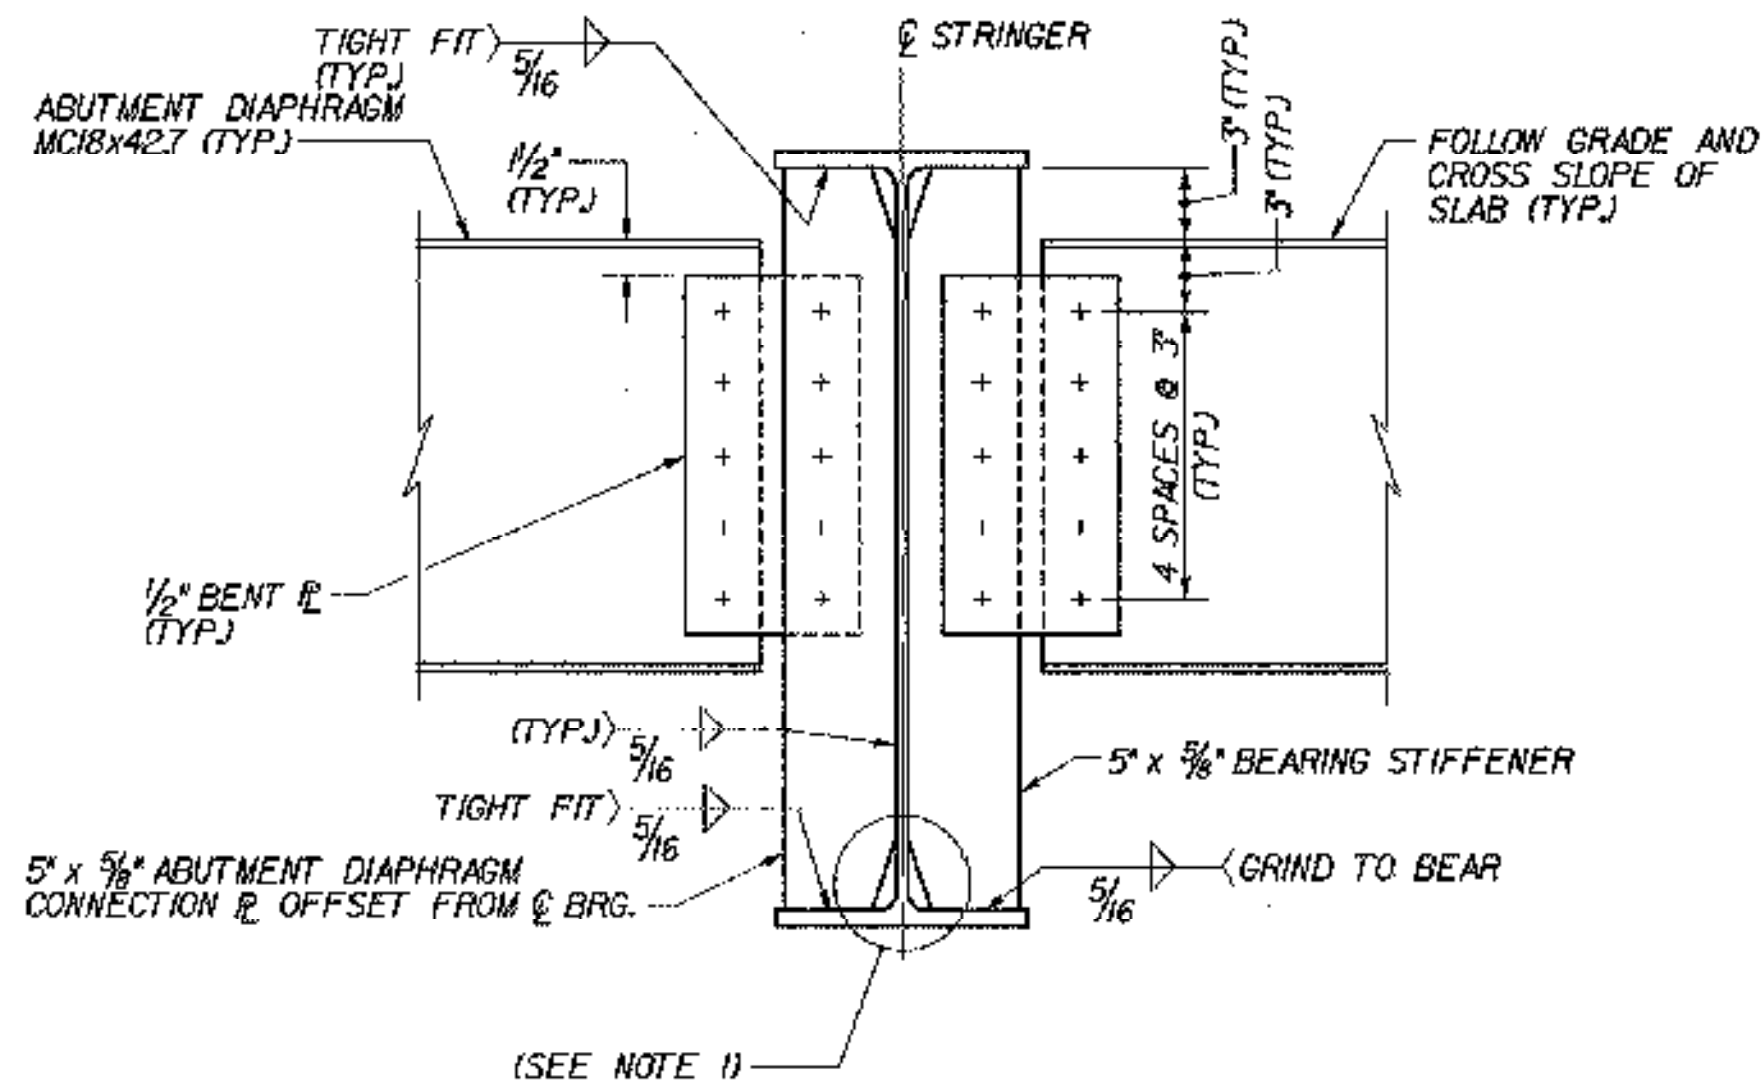


**ELEVATION A-A**  
N.T.S.

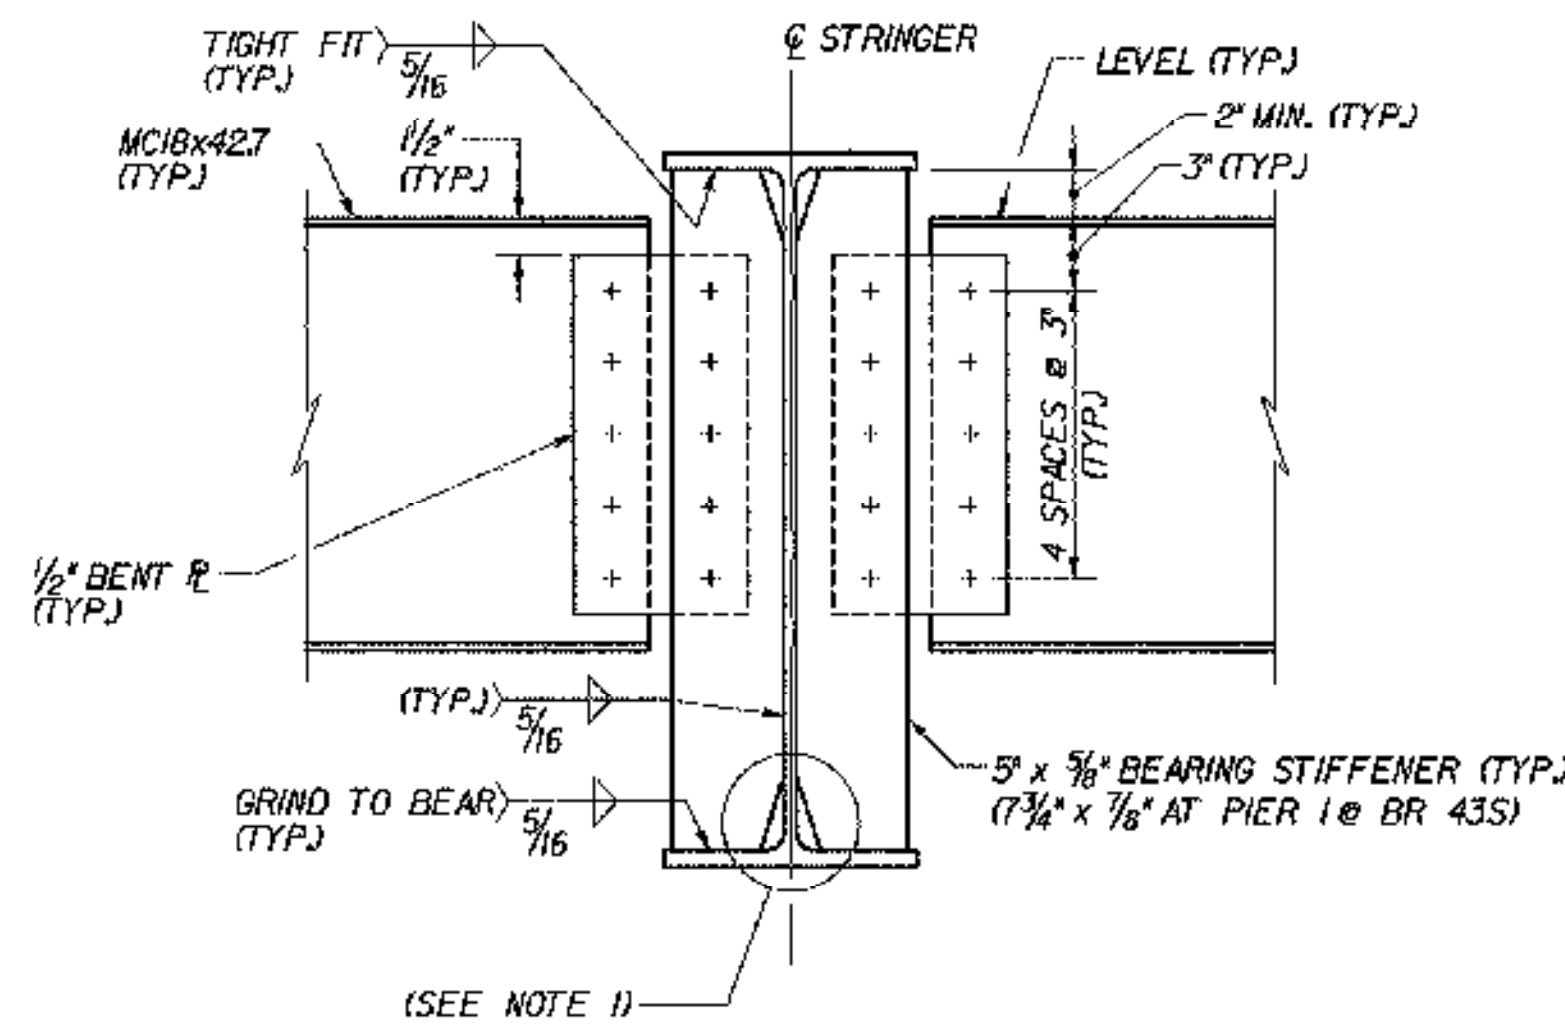


**ELEVATION B-B**  
N.T.S.

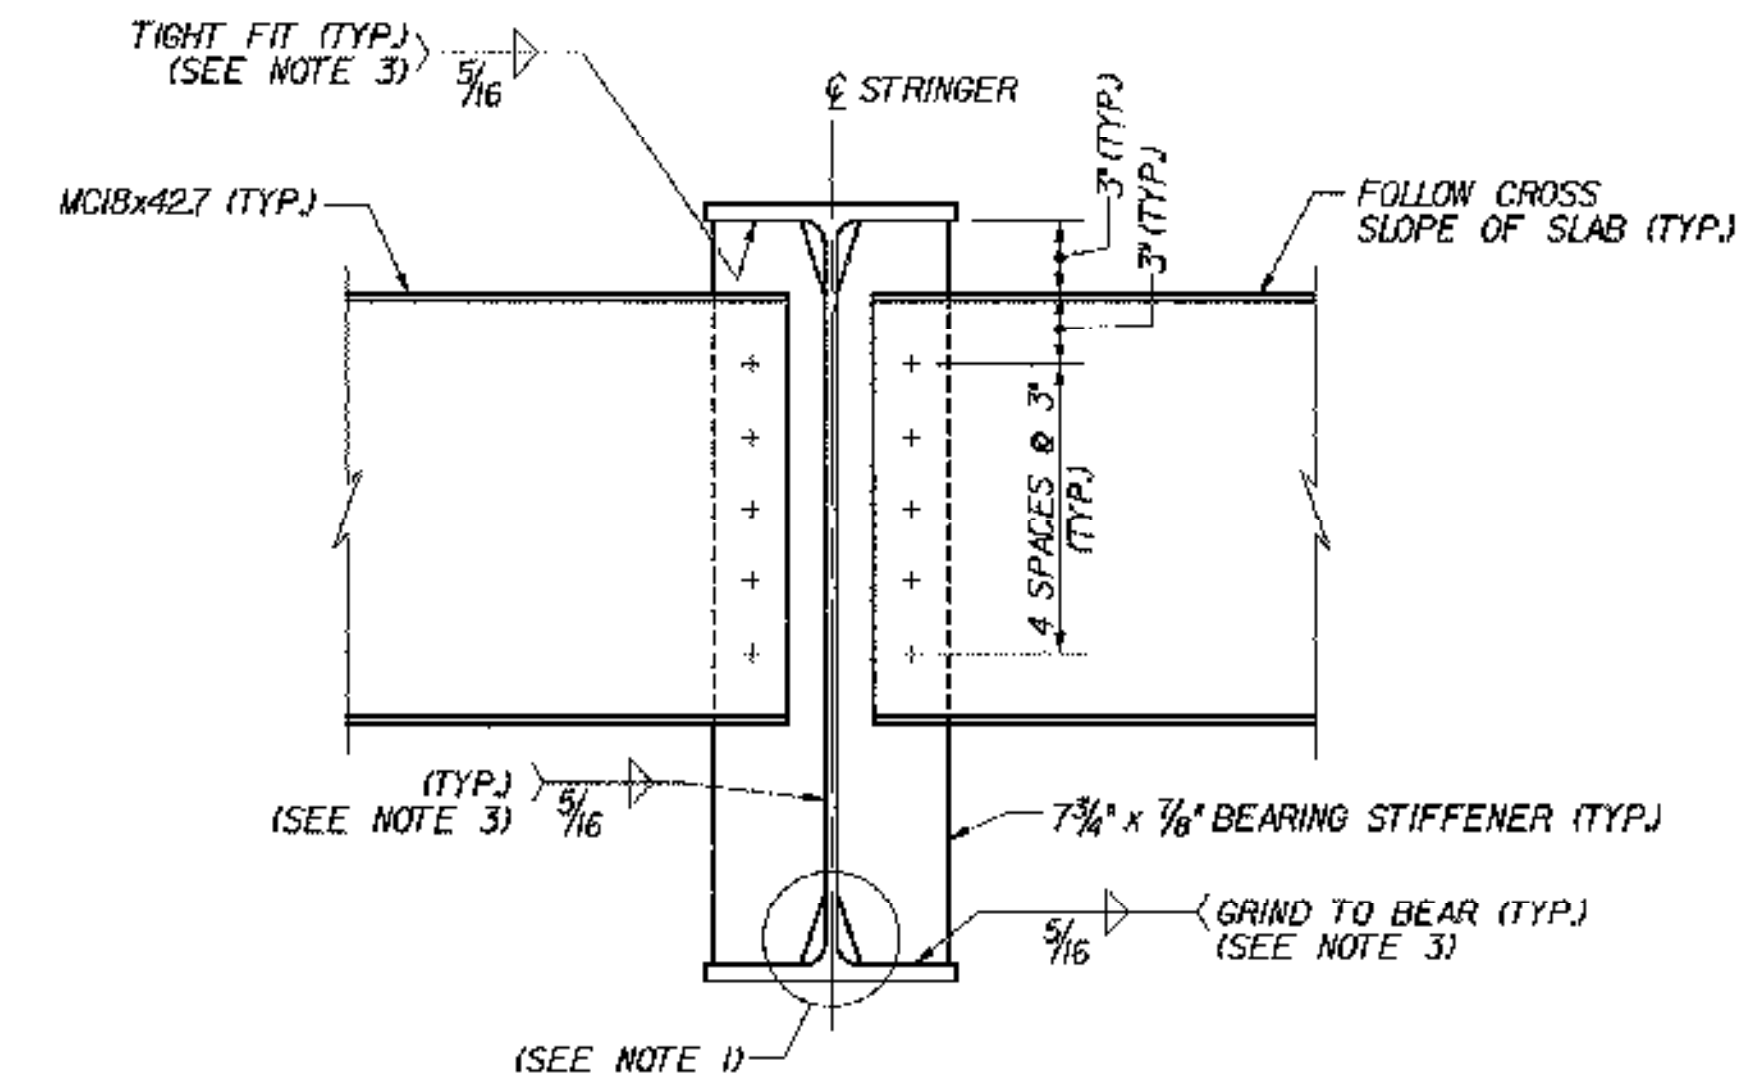

**ELEVATION C-C**  
N.T.S.

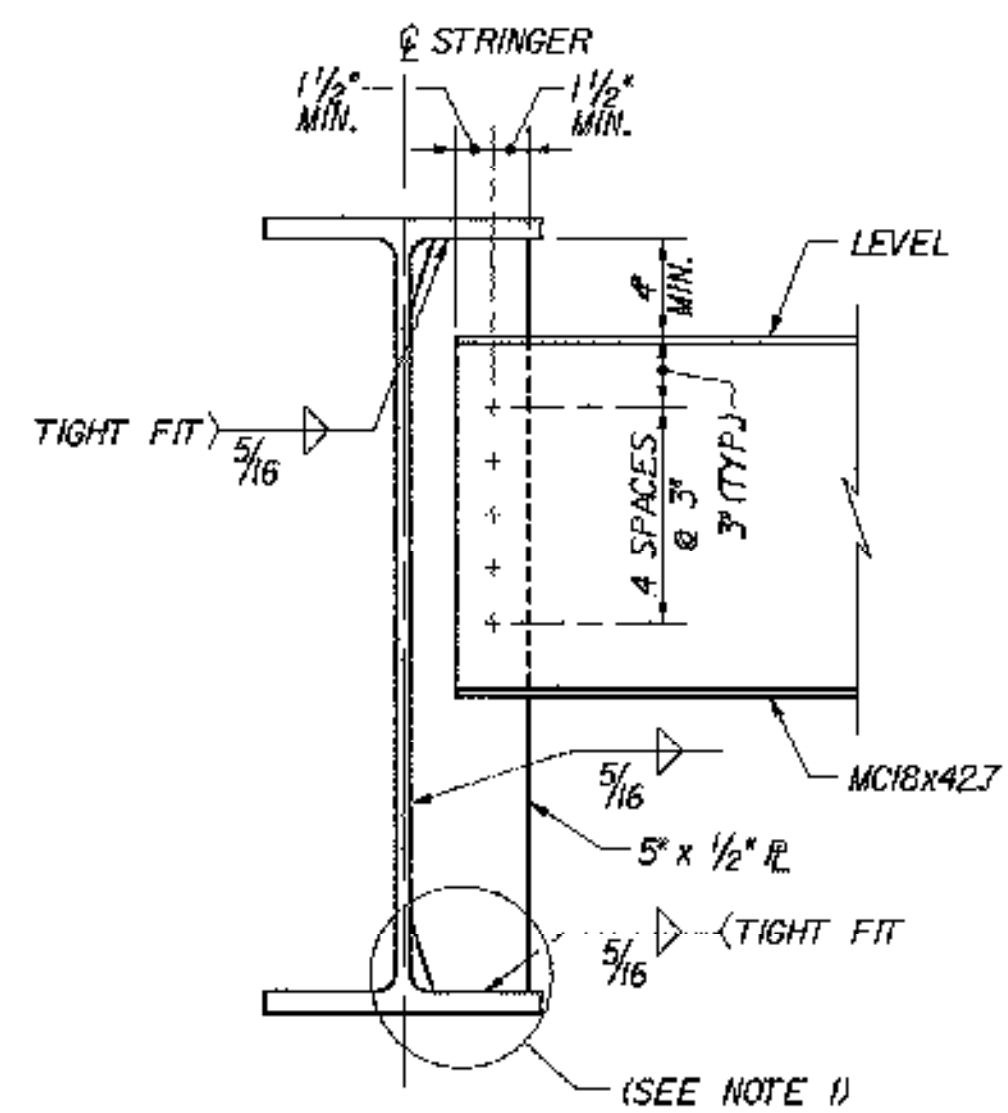

**TYPICAL INTERMEDIATE DIAPHRAGM CONNECTION**  
N.T.S.

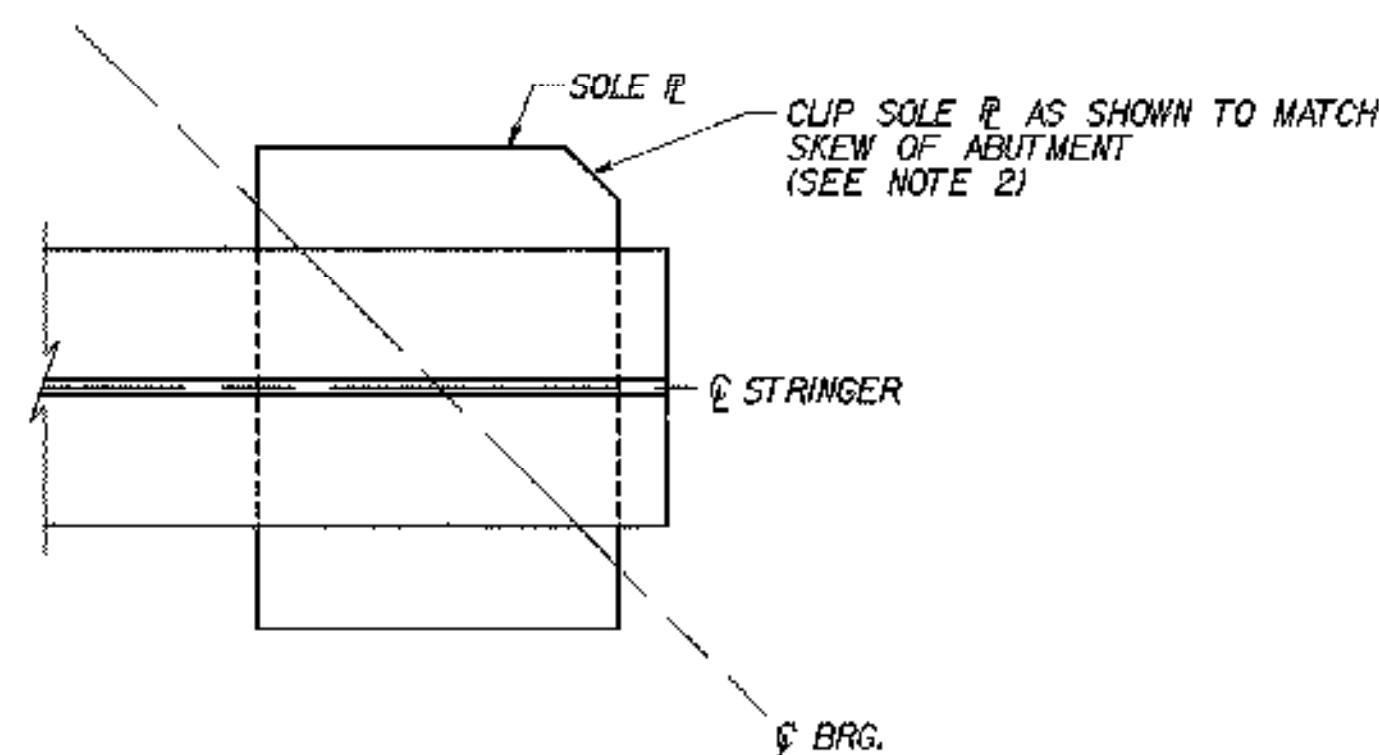

**PLAN AT FIXED ABUTMENTS**  
(BR 43N&S SHOWN, ABUTMENT 1 AT BR 51N&S SIMILAR)  
N.T.S.

**NOTES:**

- FOR TYPICAL WELD TERMINATION AND COPING DETAIL, SEE TYPICAL PLATE GIRDER DETAILS (2 OF 2), BRIDGE SHEET C-18.
- FOR DETAILS AND DIMENSIONS OF SOLE PLATE CLIP, SEE BEARING DETAILS ON BRIDGE SHEETS C-21 THROUGH C-25.
- FIELD WELD AT BR 49N&S.
- FOR DRIP PLATE DETAIL, SEE TYPICAL BRIDGE DETAILS, BRIDGE SHEET C-46.


**STATE OF VERMONT AGENCY OF TRANSPORTATION**

Town Of	MIDDLESEX-BOLTON	Bridge No.	
Highway No.	I-89	Log Sta.	
		Surv. Sta.	


**TYPICAL ROLLED BEAM DETAILS**

Designed By	P.W. SZUSTAK	Drawn By	R.A. BOTZENHART
Checked By	Date	Bridge Design Supervisor	
J.P. HALSTEAD	10/99	J.P. HALSTEAD	Date 10/99
PROJECT	MIDDLESEX-BOLTON	PROJECT NO.	IM-089-2(26)


TVGA CAD Drawing No.	rollbeam	Date	10/99
Bridge Sheet No.	C-16	Sheet	16 of 307

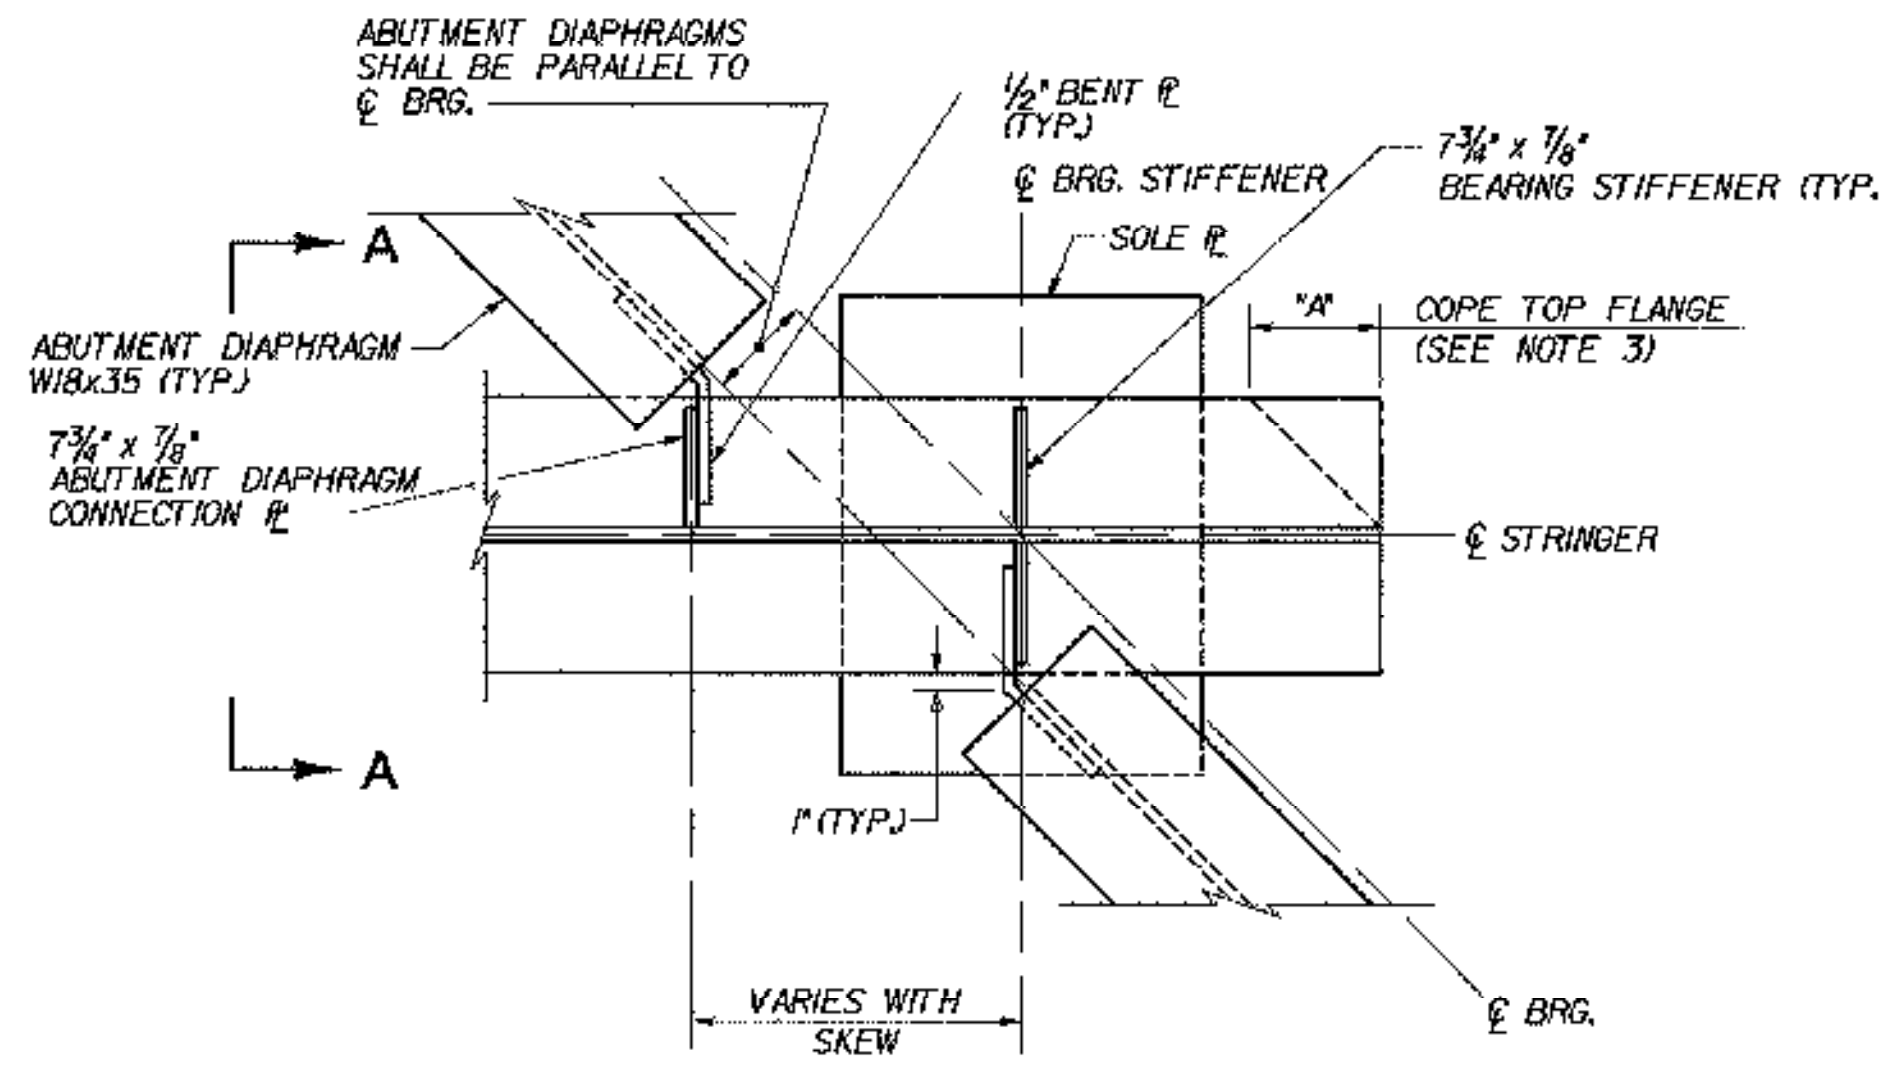


**PLAN AT EXPANSION ABUTMENTS**  
N.T.S.

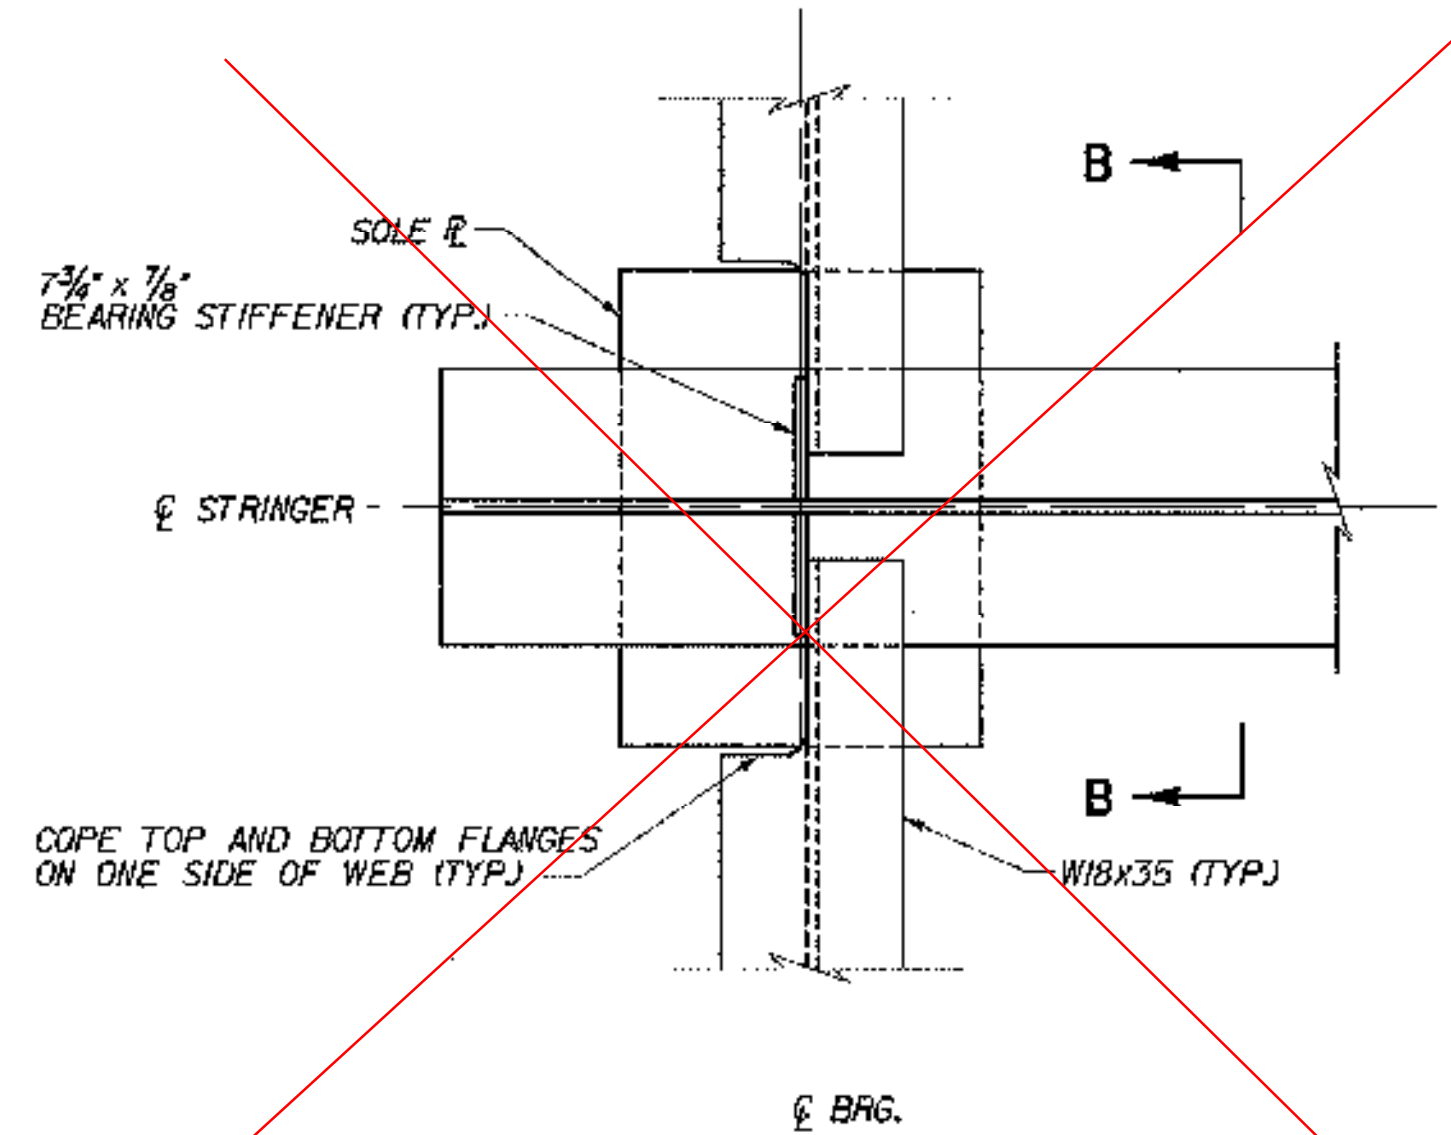


**PLAN AT PIERS WITH EXPANSION JOINTS**  
(PIER 1 AT BR51 N&S)  
N.T.S.

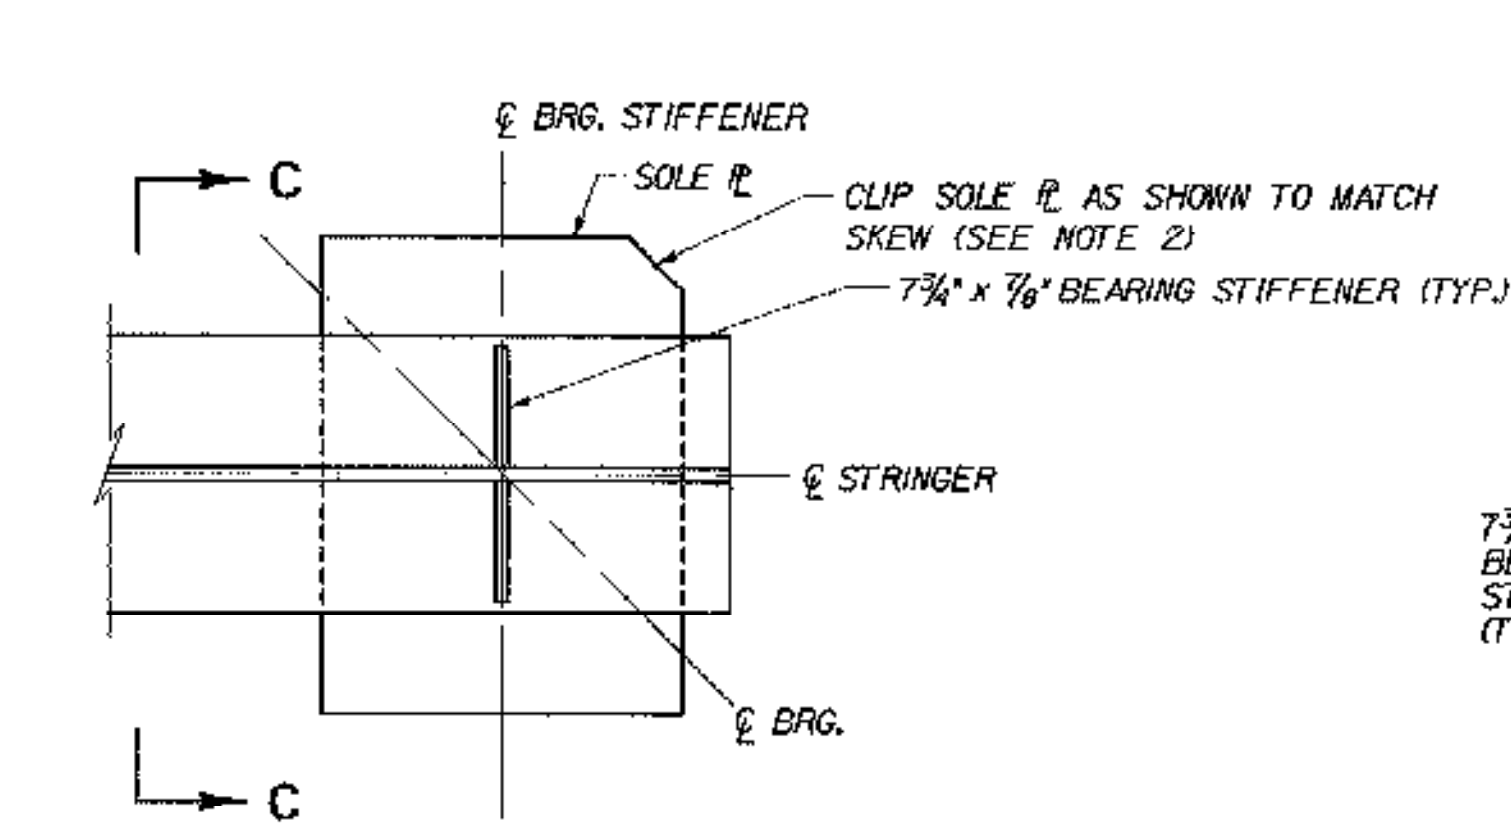


**PLAN AT FIXED ABUTMENTS**  
N.T.S.

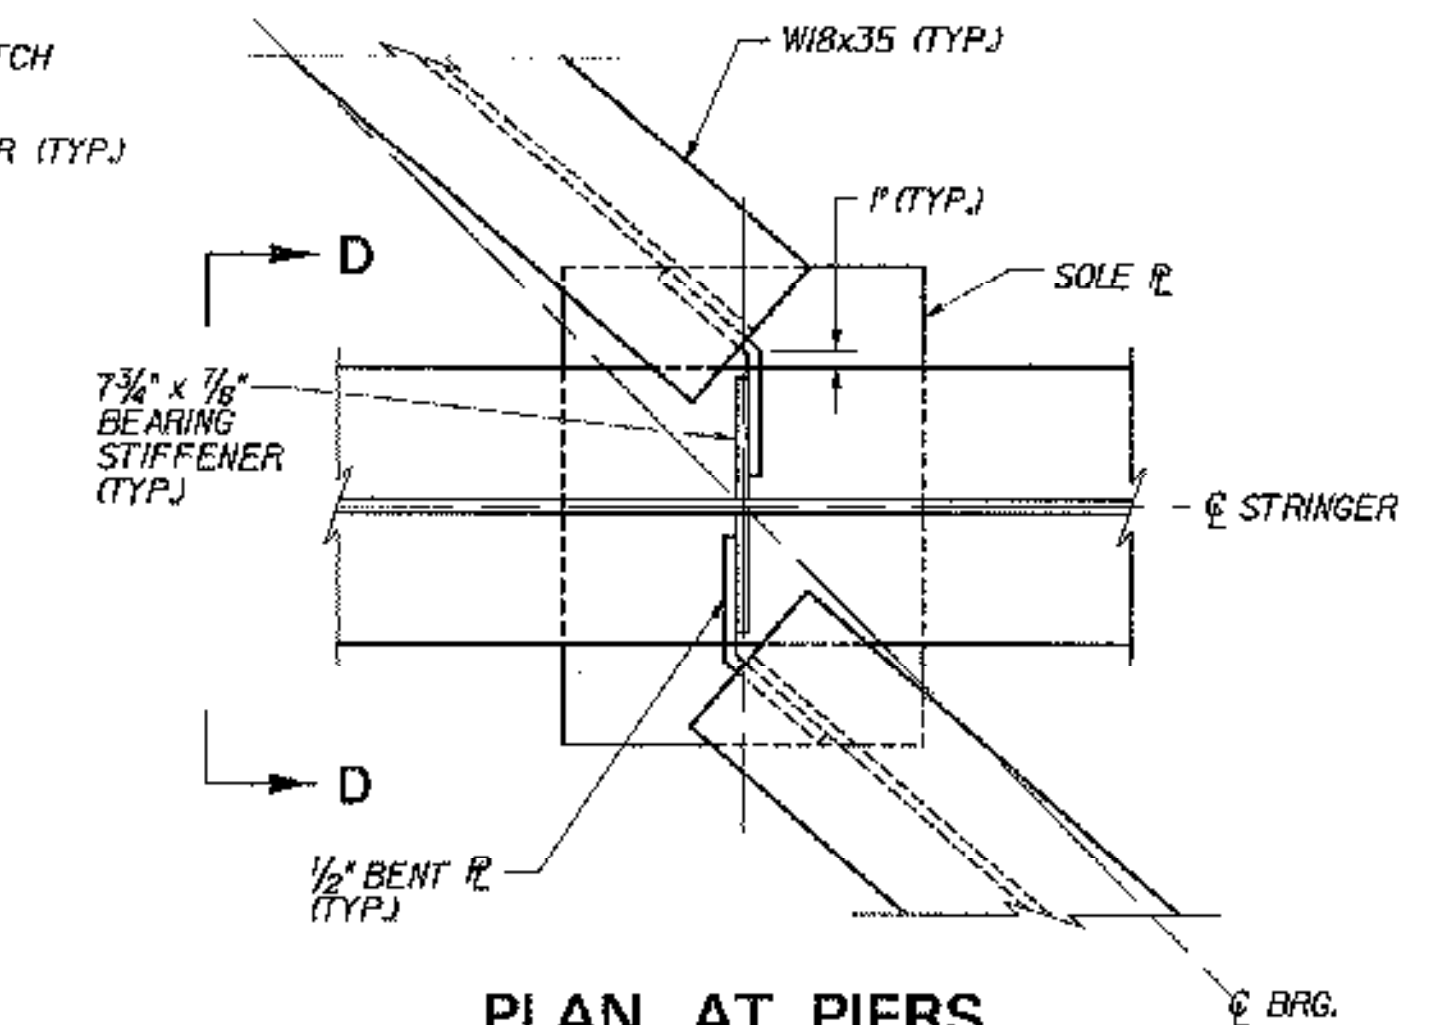


**PLAN AT PIERS**  
N.T.S.

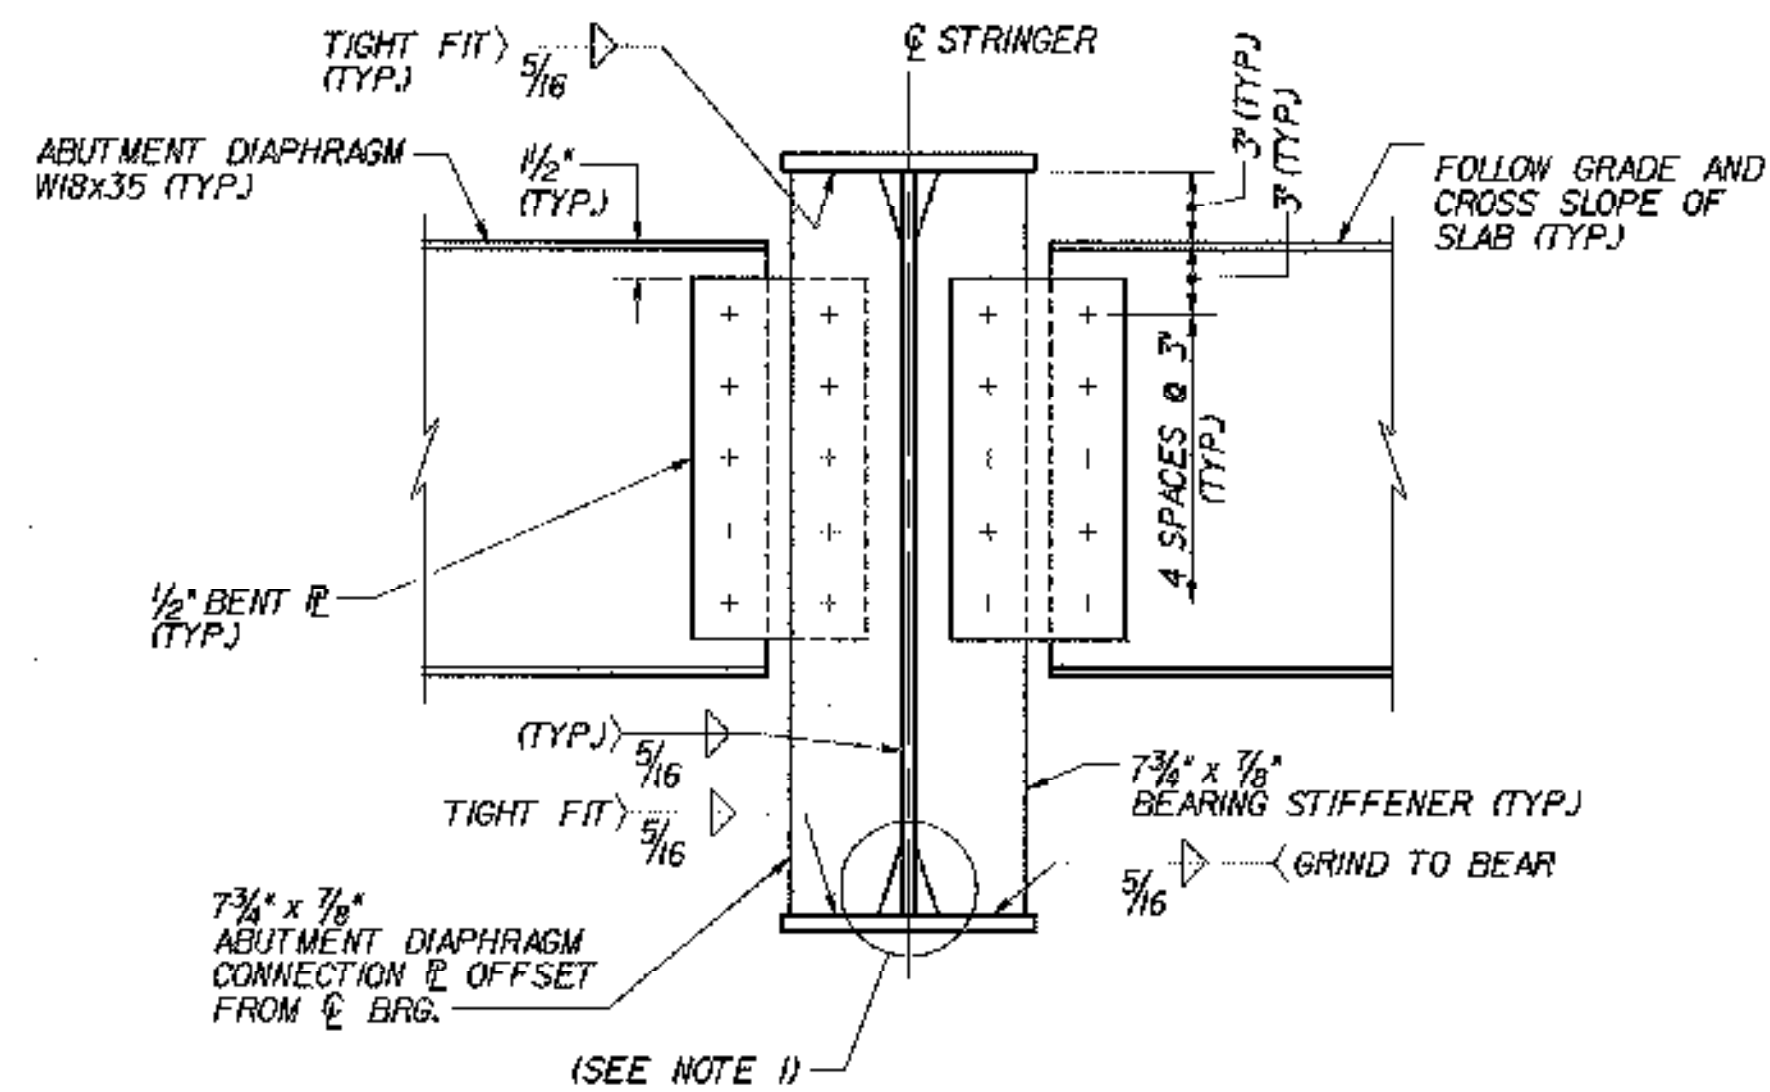


**ELEVATION A-A**  
N.T.S.

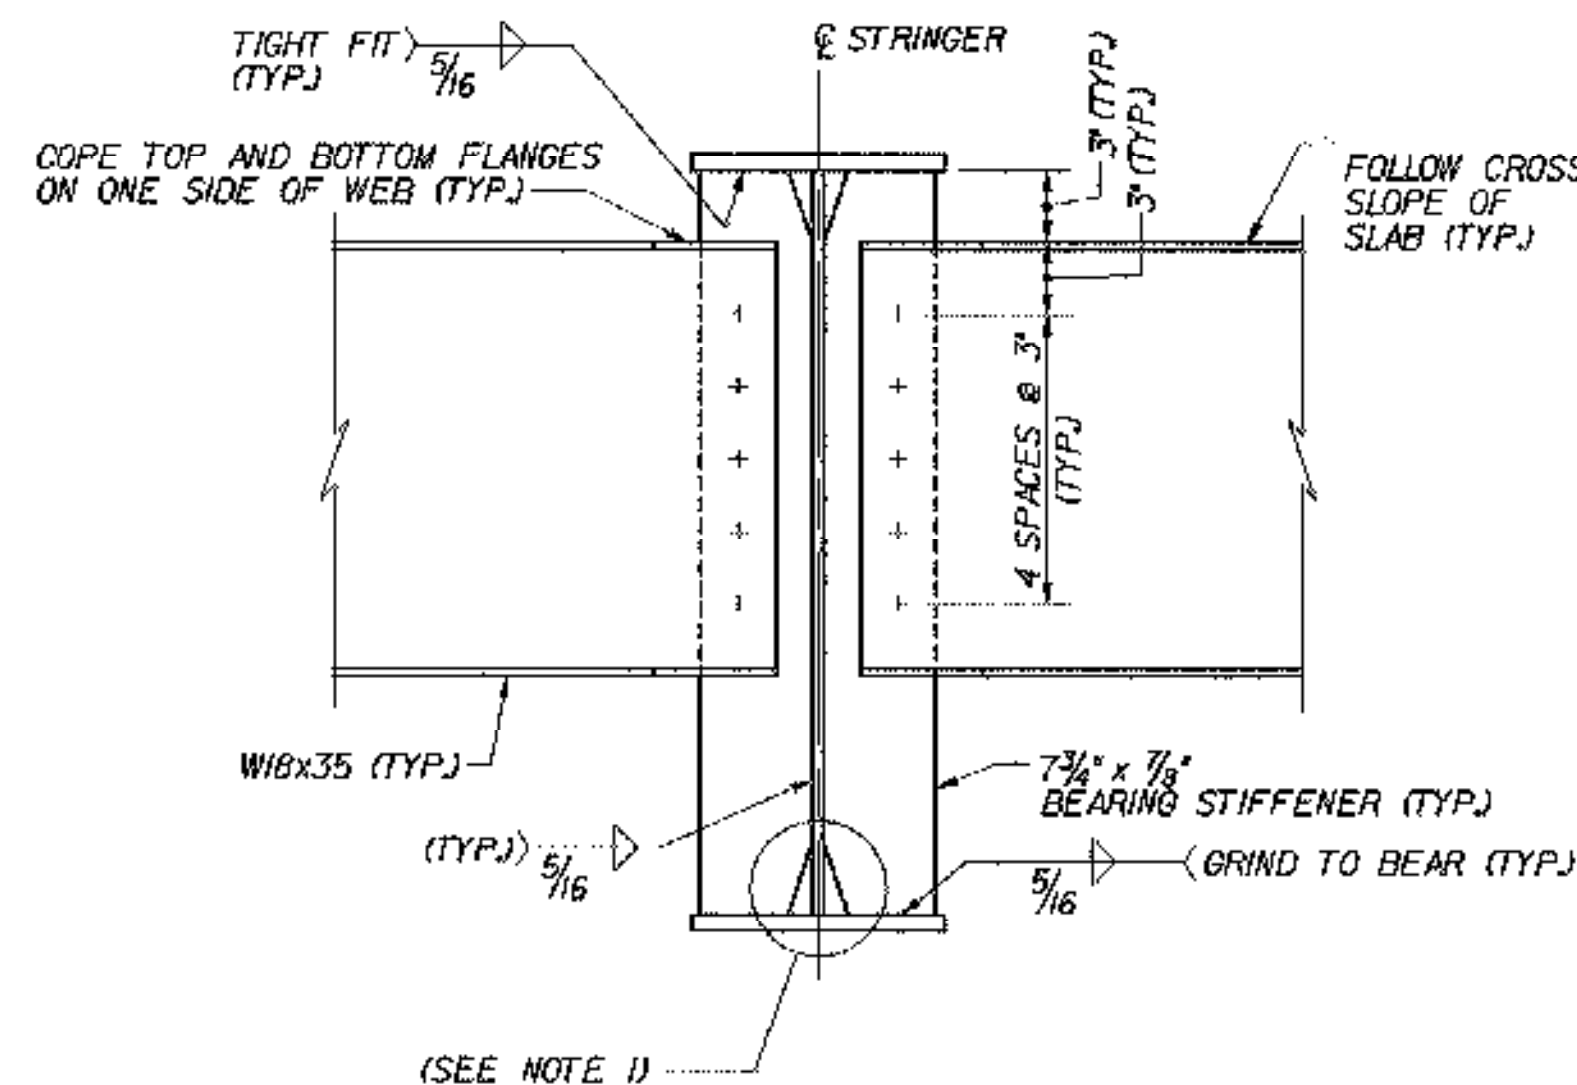

**ELEVATION B-B**  
N.T.S.

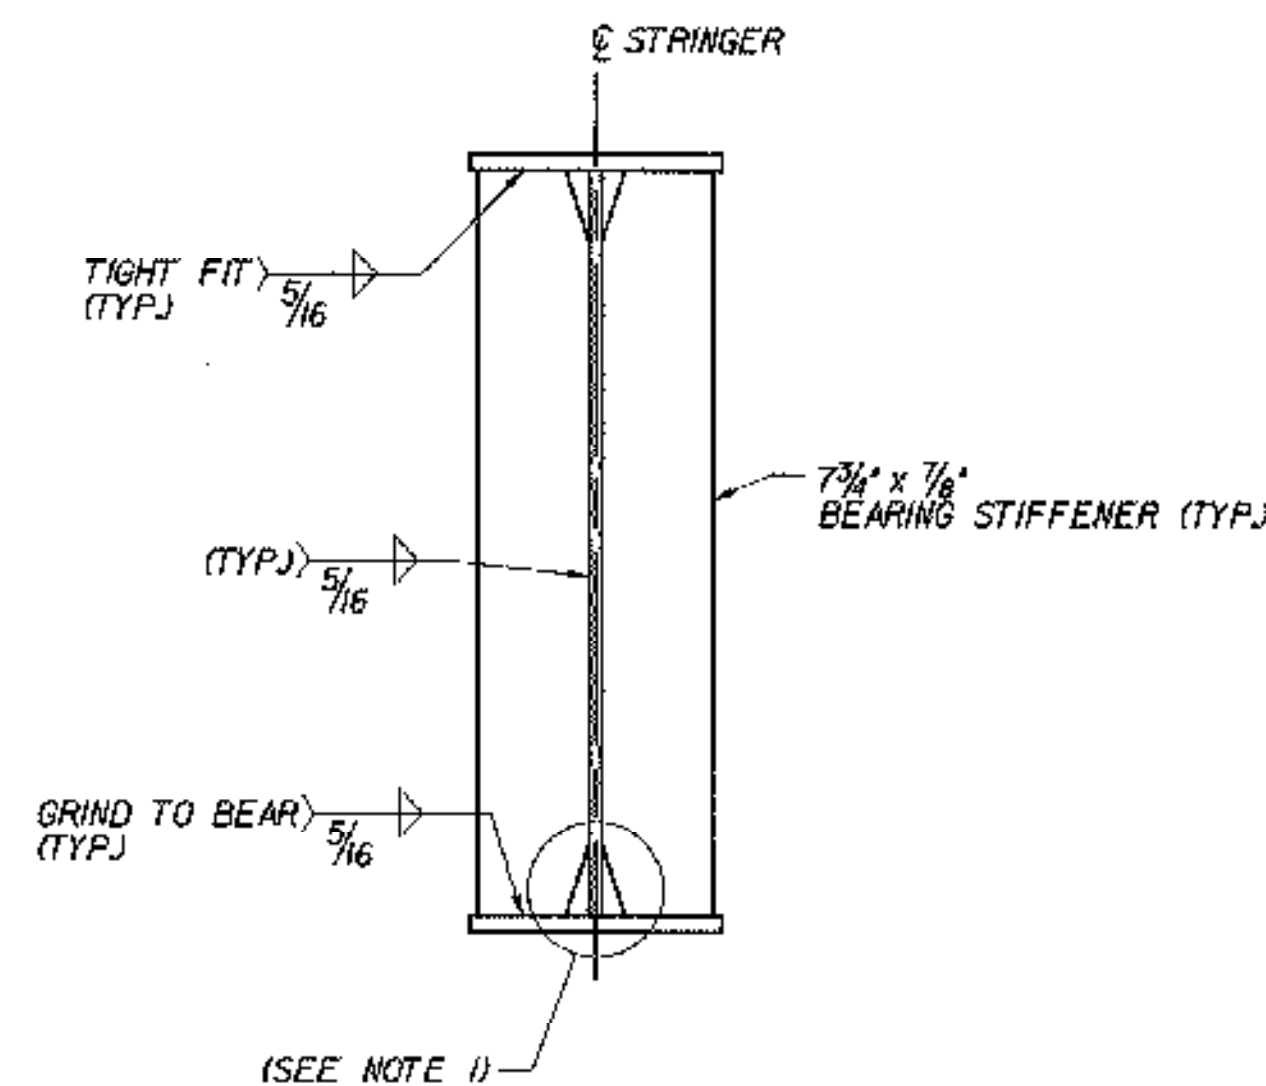

**ELEVATION C-C**  
N.T.S.

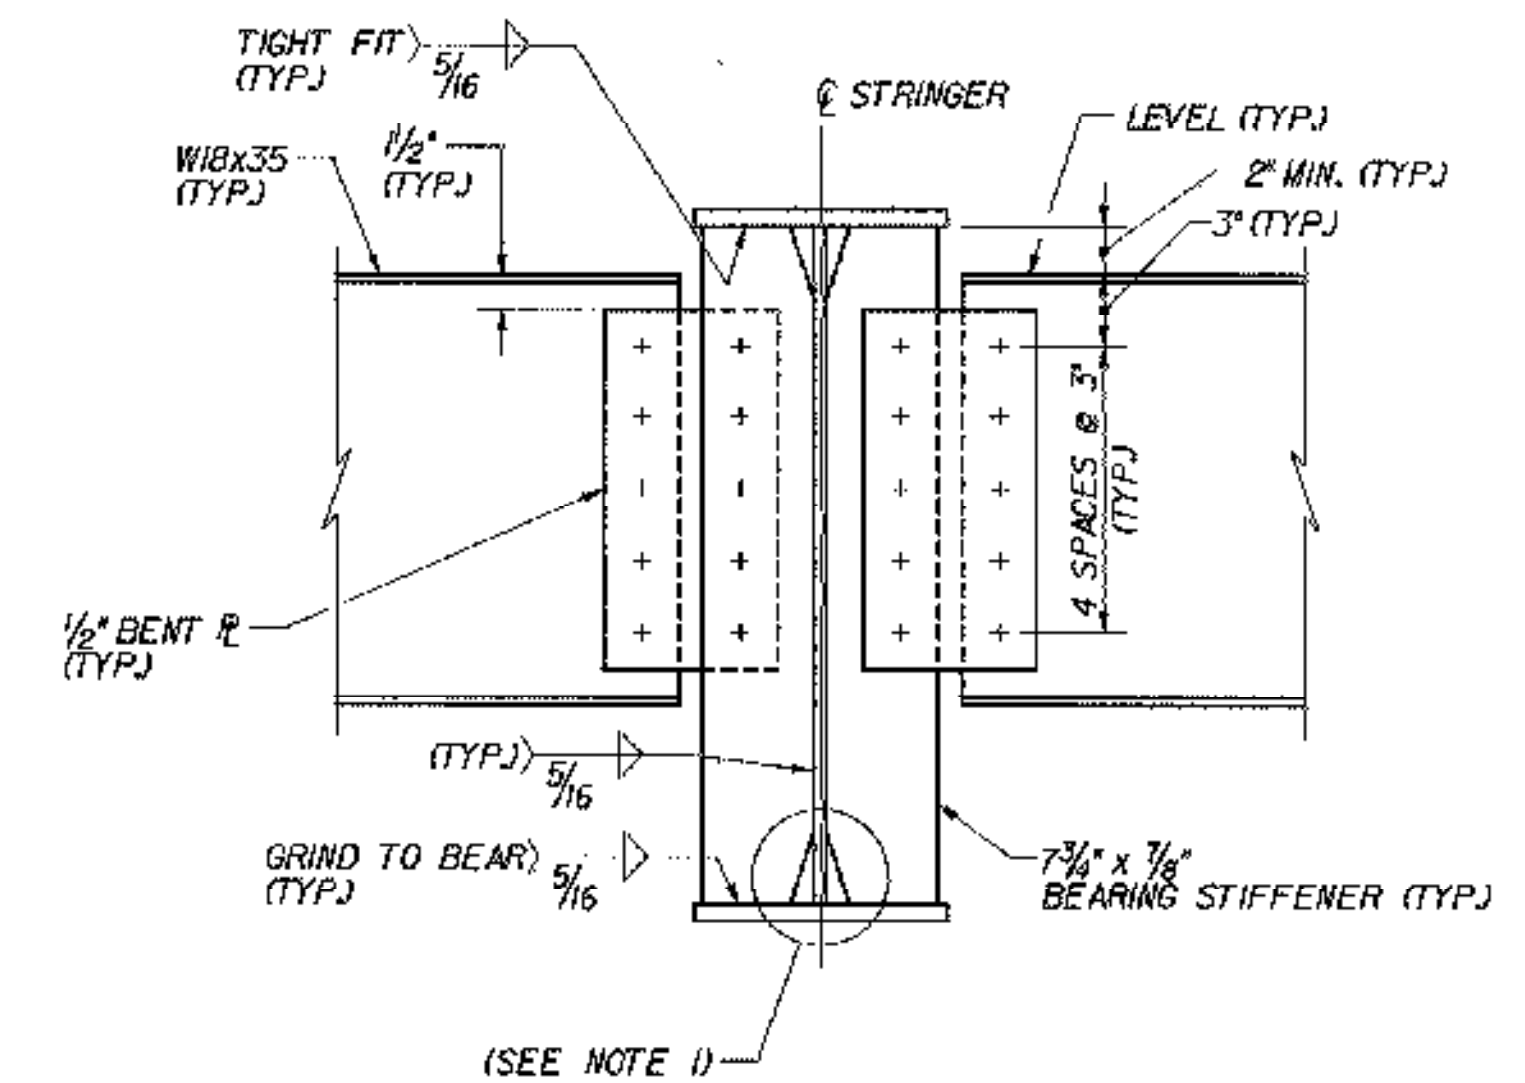

**ELEVATION D-D**  
N.T.S.

**NOTES:**


- FOR TYPICAL WELD TERMINATION AND COPING DETAIL, SEE TYPICAL PLATE GIRDER DETAILS (2 OF 2), BRIDGE SHEET C-18.
- FOR DETAILS AND DIMENSIONS OF SOLE PLATE CLIP, SEE BEARING DETAILS ON BRIDGE SHEETS C-21 THROUGH C-25.
- FOR TABLE OF TOP FLANGE COPE DIMENSION "A", SEE TYPICAL PLATE GIRDER DETAILS (2 OF 2), BRIDGE SHEET C-18.
- THE TOP AND BOTTOM EDGES OF BEARING STIFFENERS SHALL BE CUT AT RIGHT ANGLES TO THE WEB.

**STATE OF VERMONT AGENCY OF TRANSPORTATION**

Town Of	MIDDLESEX-BOLTON	Bridge No.	
Highway No.	I-89	Log Sta.	
		Surv. Sta.	


**TYPICAL PLATE GIRDER DETAILS (1 OF 2)**

Designed By	P.W. SZUSTAK	Drawn By	R.A. BOTZENHART
Checked By	J.P. HALSTEAD	Bridge Design Supervisor	J.P. HALSTEAD
Date	10/99	Date	10/99
PROJECT	MIDDLESEX-BOLTON	PROJECT NO.	IM-089-2(26)
TVGA CAD Drawing No.	g1rardet	Date	10/99
Bridge Sheet No.	C-17	Sheet	17 of 307

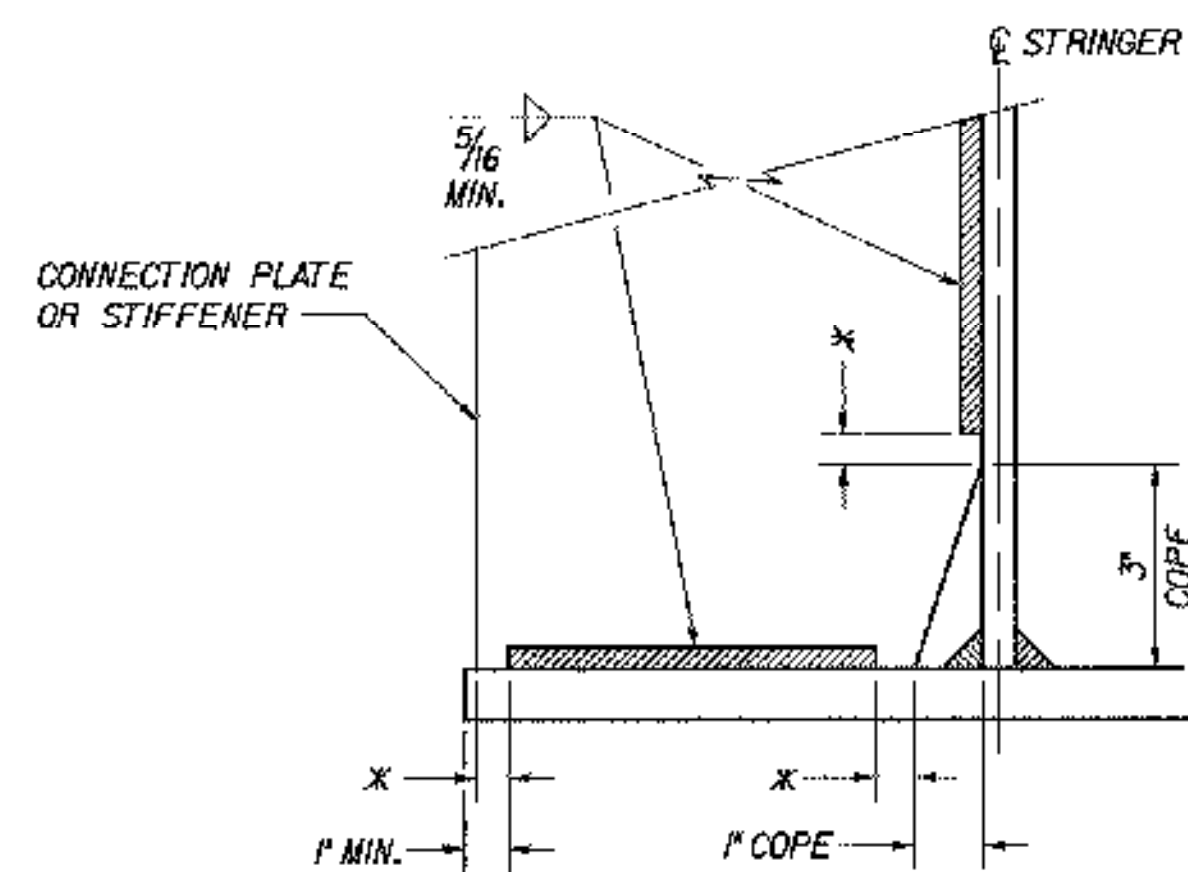


**TYPICAL WELD TERMINATION AND COPING DETAIL**  
 (PLATE GIRDER SHOWN - SIMILAR FOR ROLLED BEAM)  
 N.T.S.

X NO WELD PLACED FOR 1/4" MIN. 1/2" MAX.  
 (EXCEPT MUST MAINTAIN 1" MINIMUM FROM EDGE OF FLANGE)

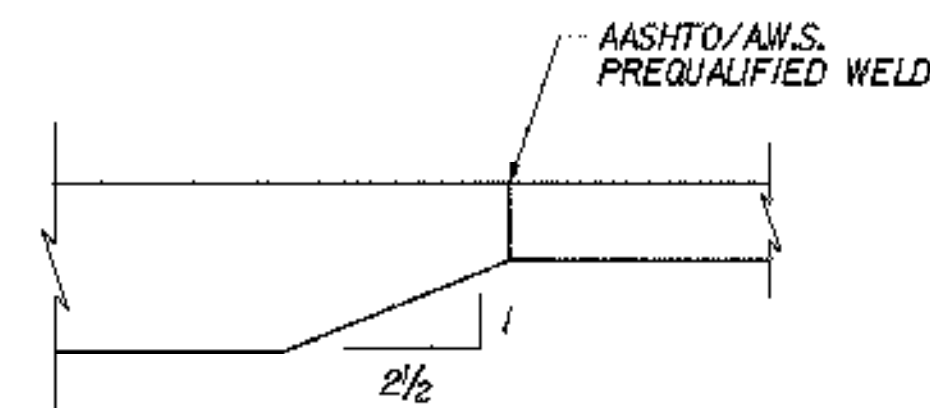

**FLANGE BUTT SPLICE DETAIL**  
 N.T.S.

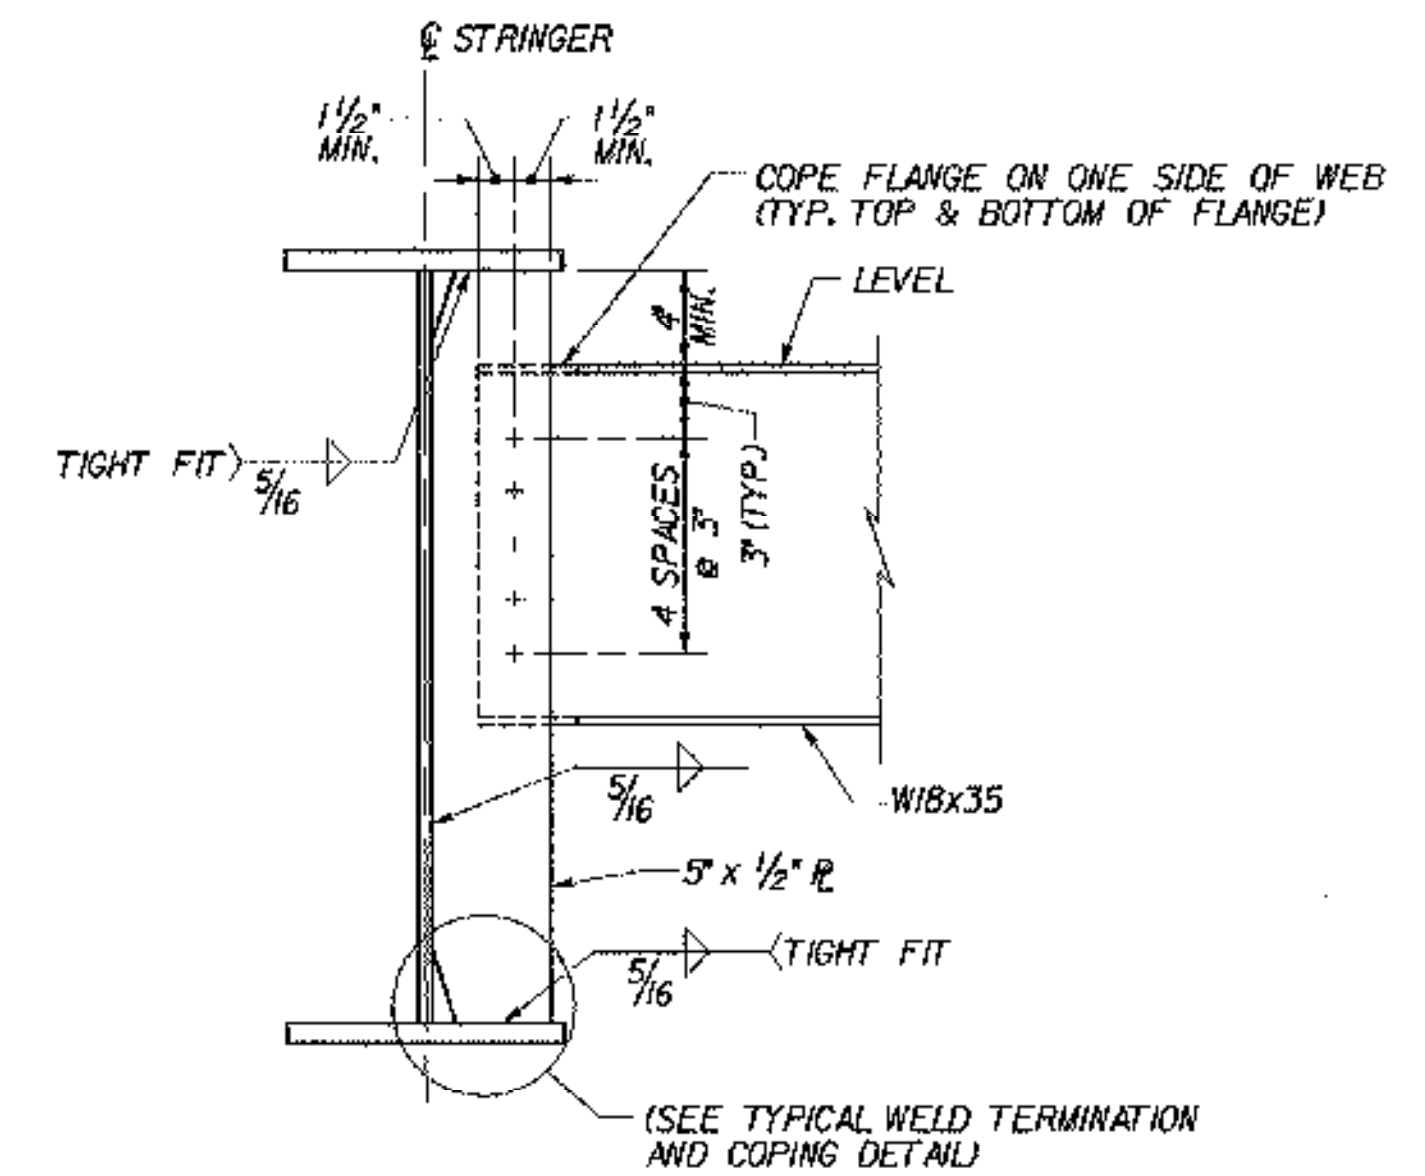

**INTERMEDIATE DIAPHRAGM CONNECTION**  
 N.T.S.

TOP FLANGE COPE		
BRIDGE	LOCATION	"A"
48N	ABUT. 2	4"
48S	ABUT. 1	3 3/8"
50N	ABUT. 2	7 3/8"
50S	ABUT. 1	8 3/16"
51N	ABUT. 2	8 1/8"
51S	ABUT. 1	8 1/4"

(SEE NOTE 1)

**NOTES:**

- FOR LAYOUT OF FLANGE COPE, SEE "PLAN AT EXPANSION ABUTMENTS" DETAIL, ON TYPICAL PLATE GIRDER DETAILS (1 OF 2), BRIDGE SHEET C-17.
- FOR DRIP PLATE DETAIL, SEE TYPICAL BRIDGE DETAILS, BRIDGE SHEET C-46.


**STATE OF VERMONT  
 AGENCY OF TRANSPORTATION**

Town Of	MIDDLESEX-BOLTON	Bridge No.	
Highway No.	I-89	Log Sta.	
		Surv. Sta.	


**TYPICAL PLATE GIRDER DETAILS (2 OF 2)**

Designed By	P.W. SZUSTAK	Drawn By	R.A. BOTZENHART
Checked By	J.P. HALSTEAD	Date	10/99
		Bridge Design Supervisor	J.P. HALSTEAD
		Date	10/99


PROJECT	MIDDLESEX-BOLTON	PROJECT NO.	IM-089-2(26)
---------	------------------	-------------	--------------

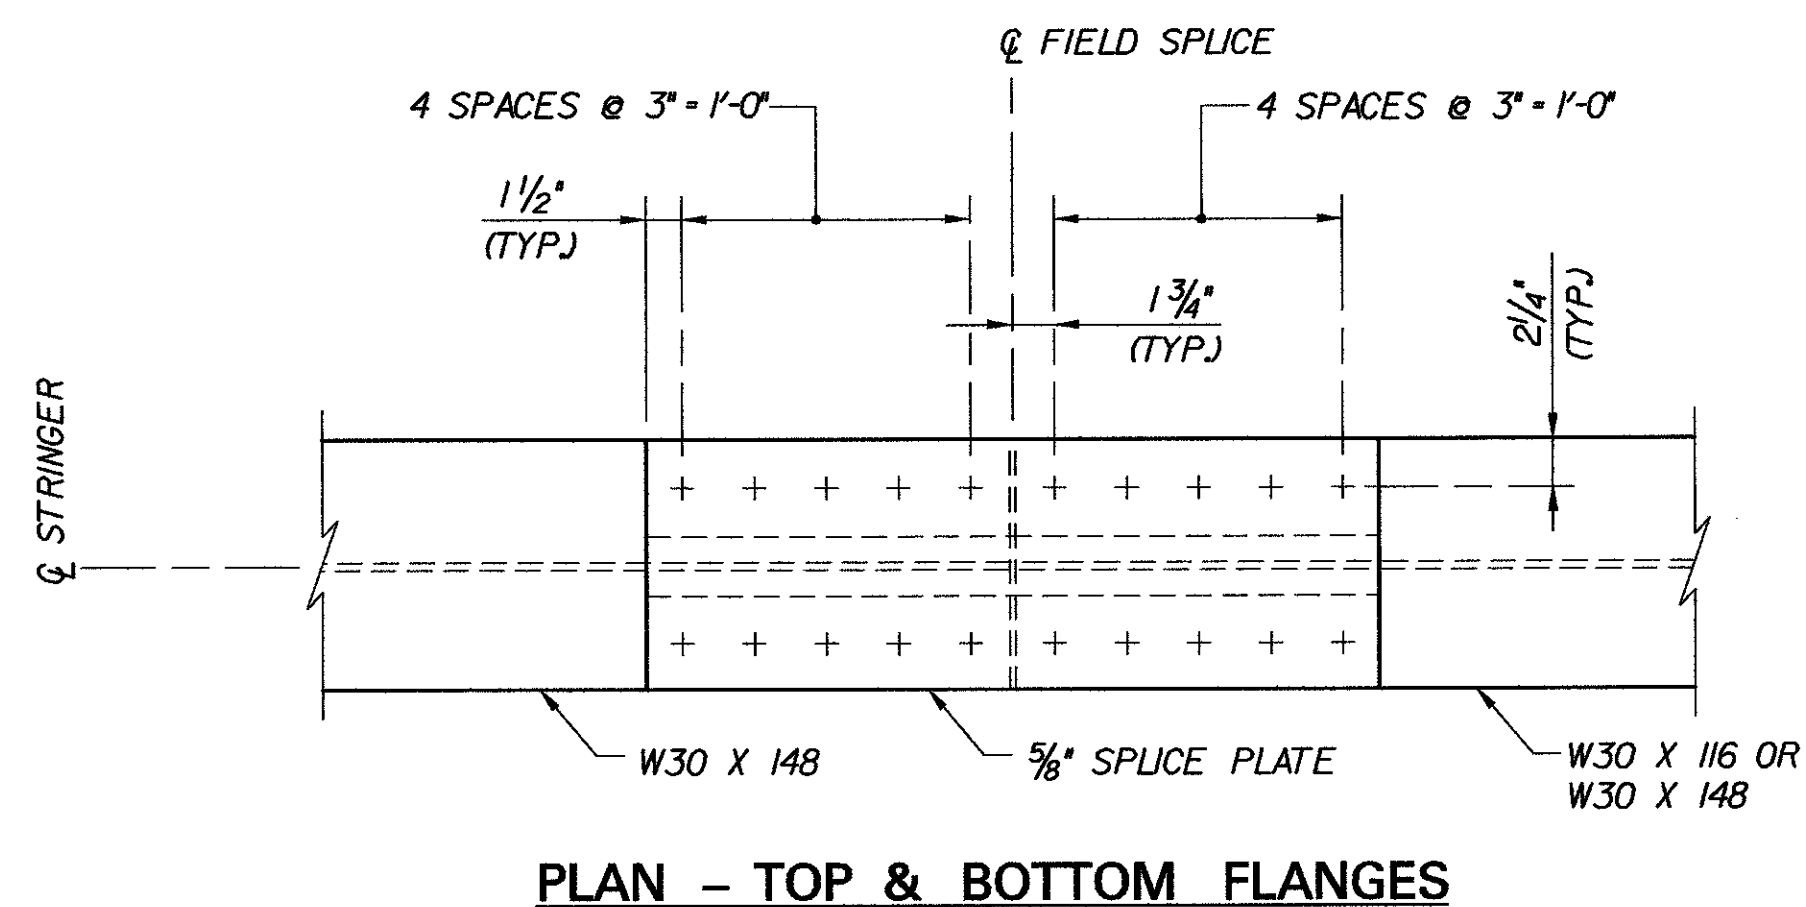


PLAN - TOP & BOTTOM FLANGES

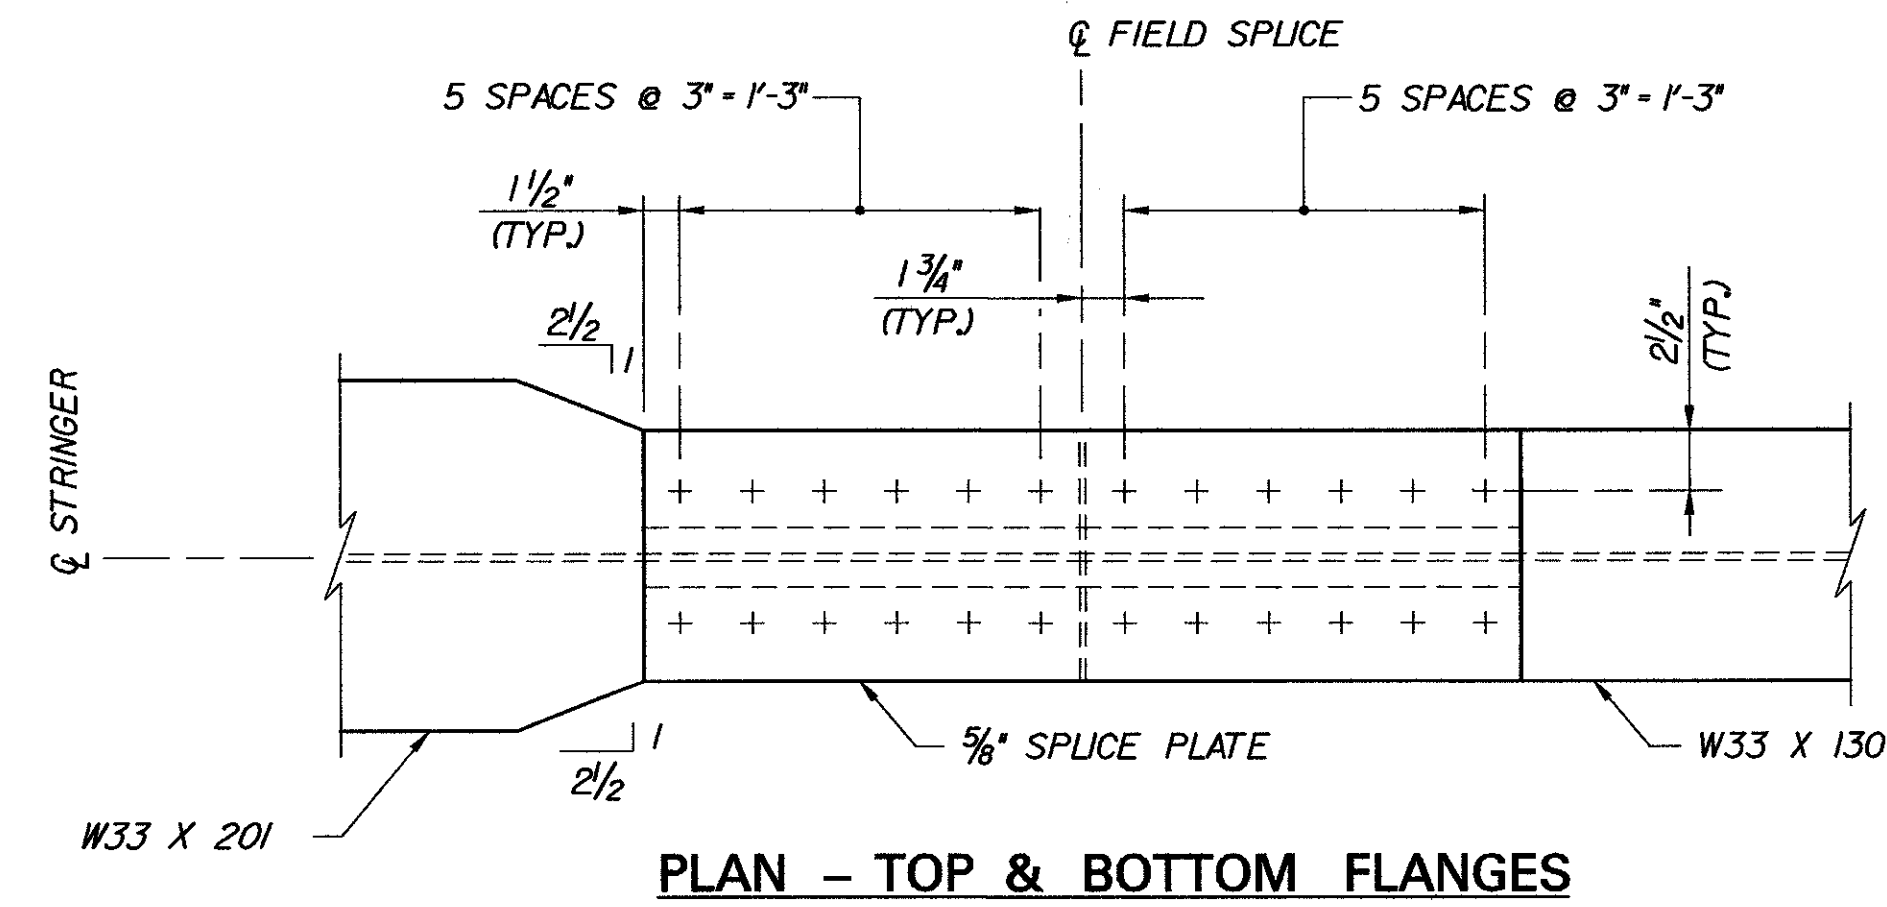


PLAN - TOP & BOTTOM FLANGES

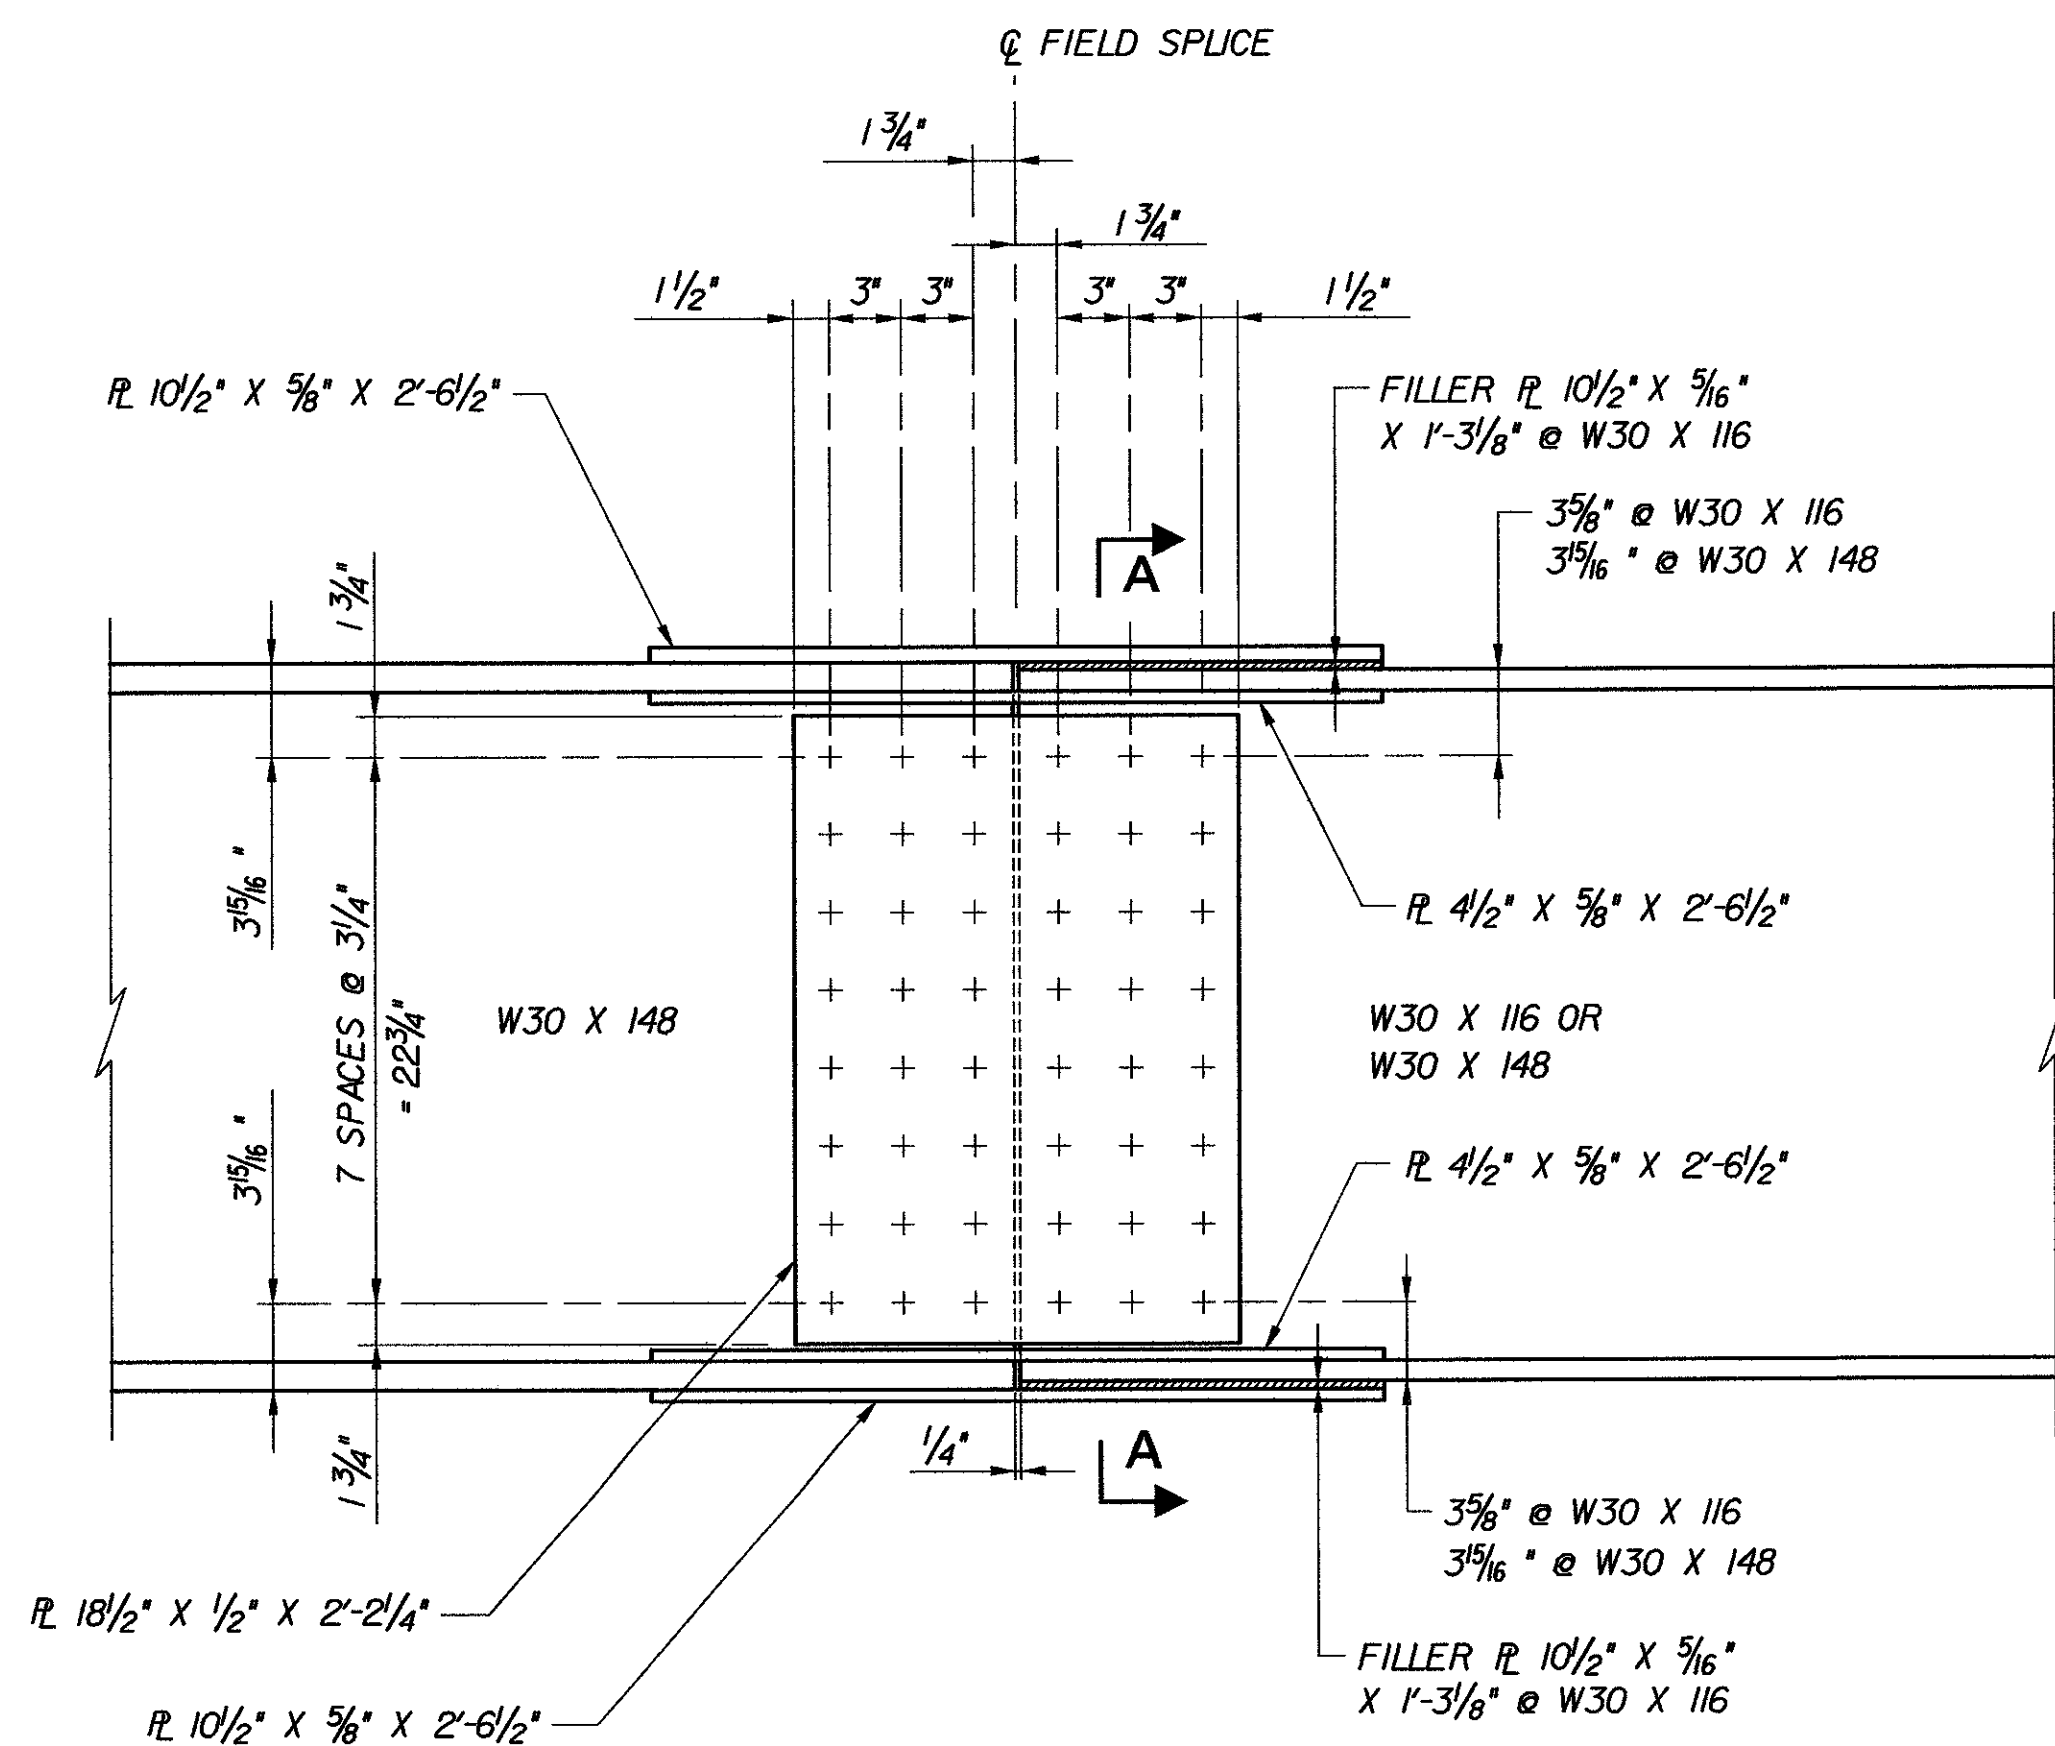


ELEVATION

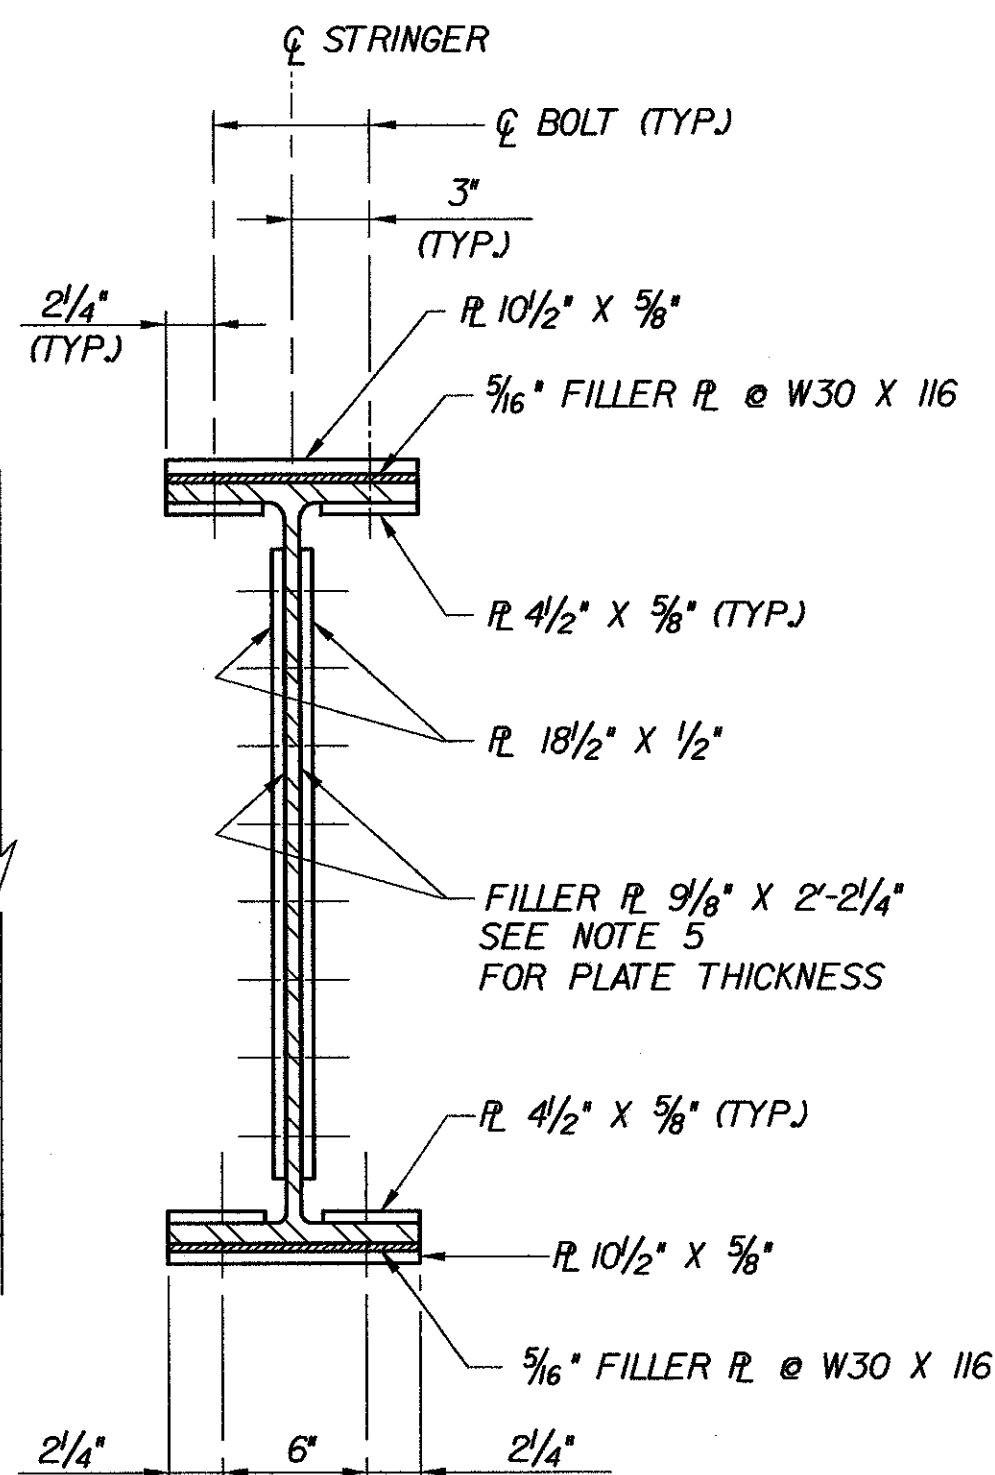

SECTION A-A

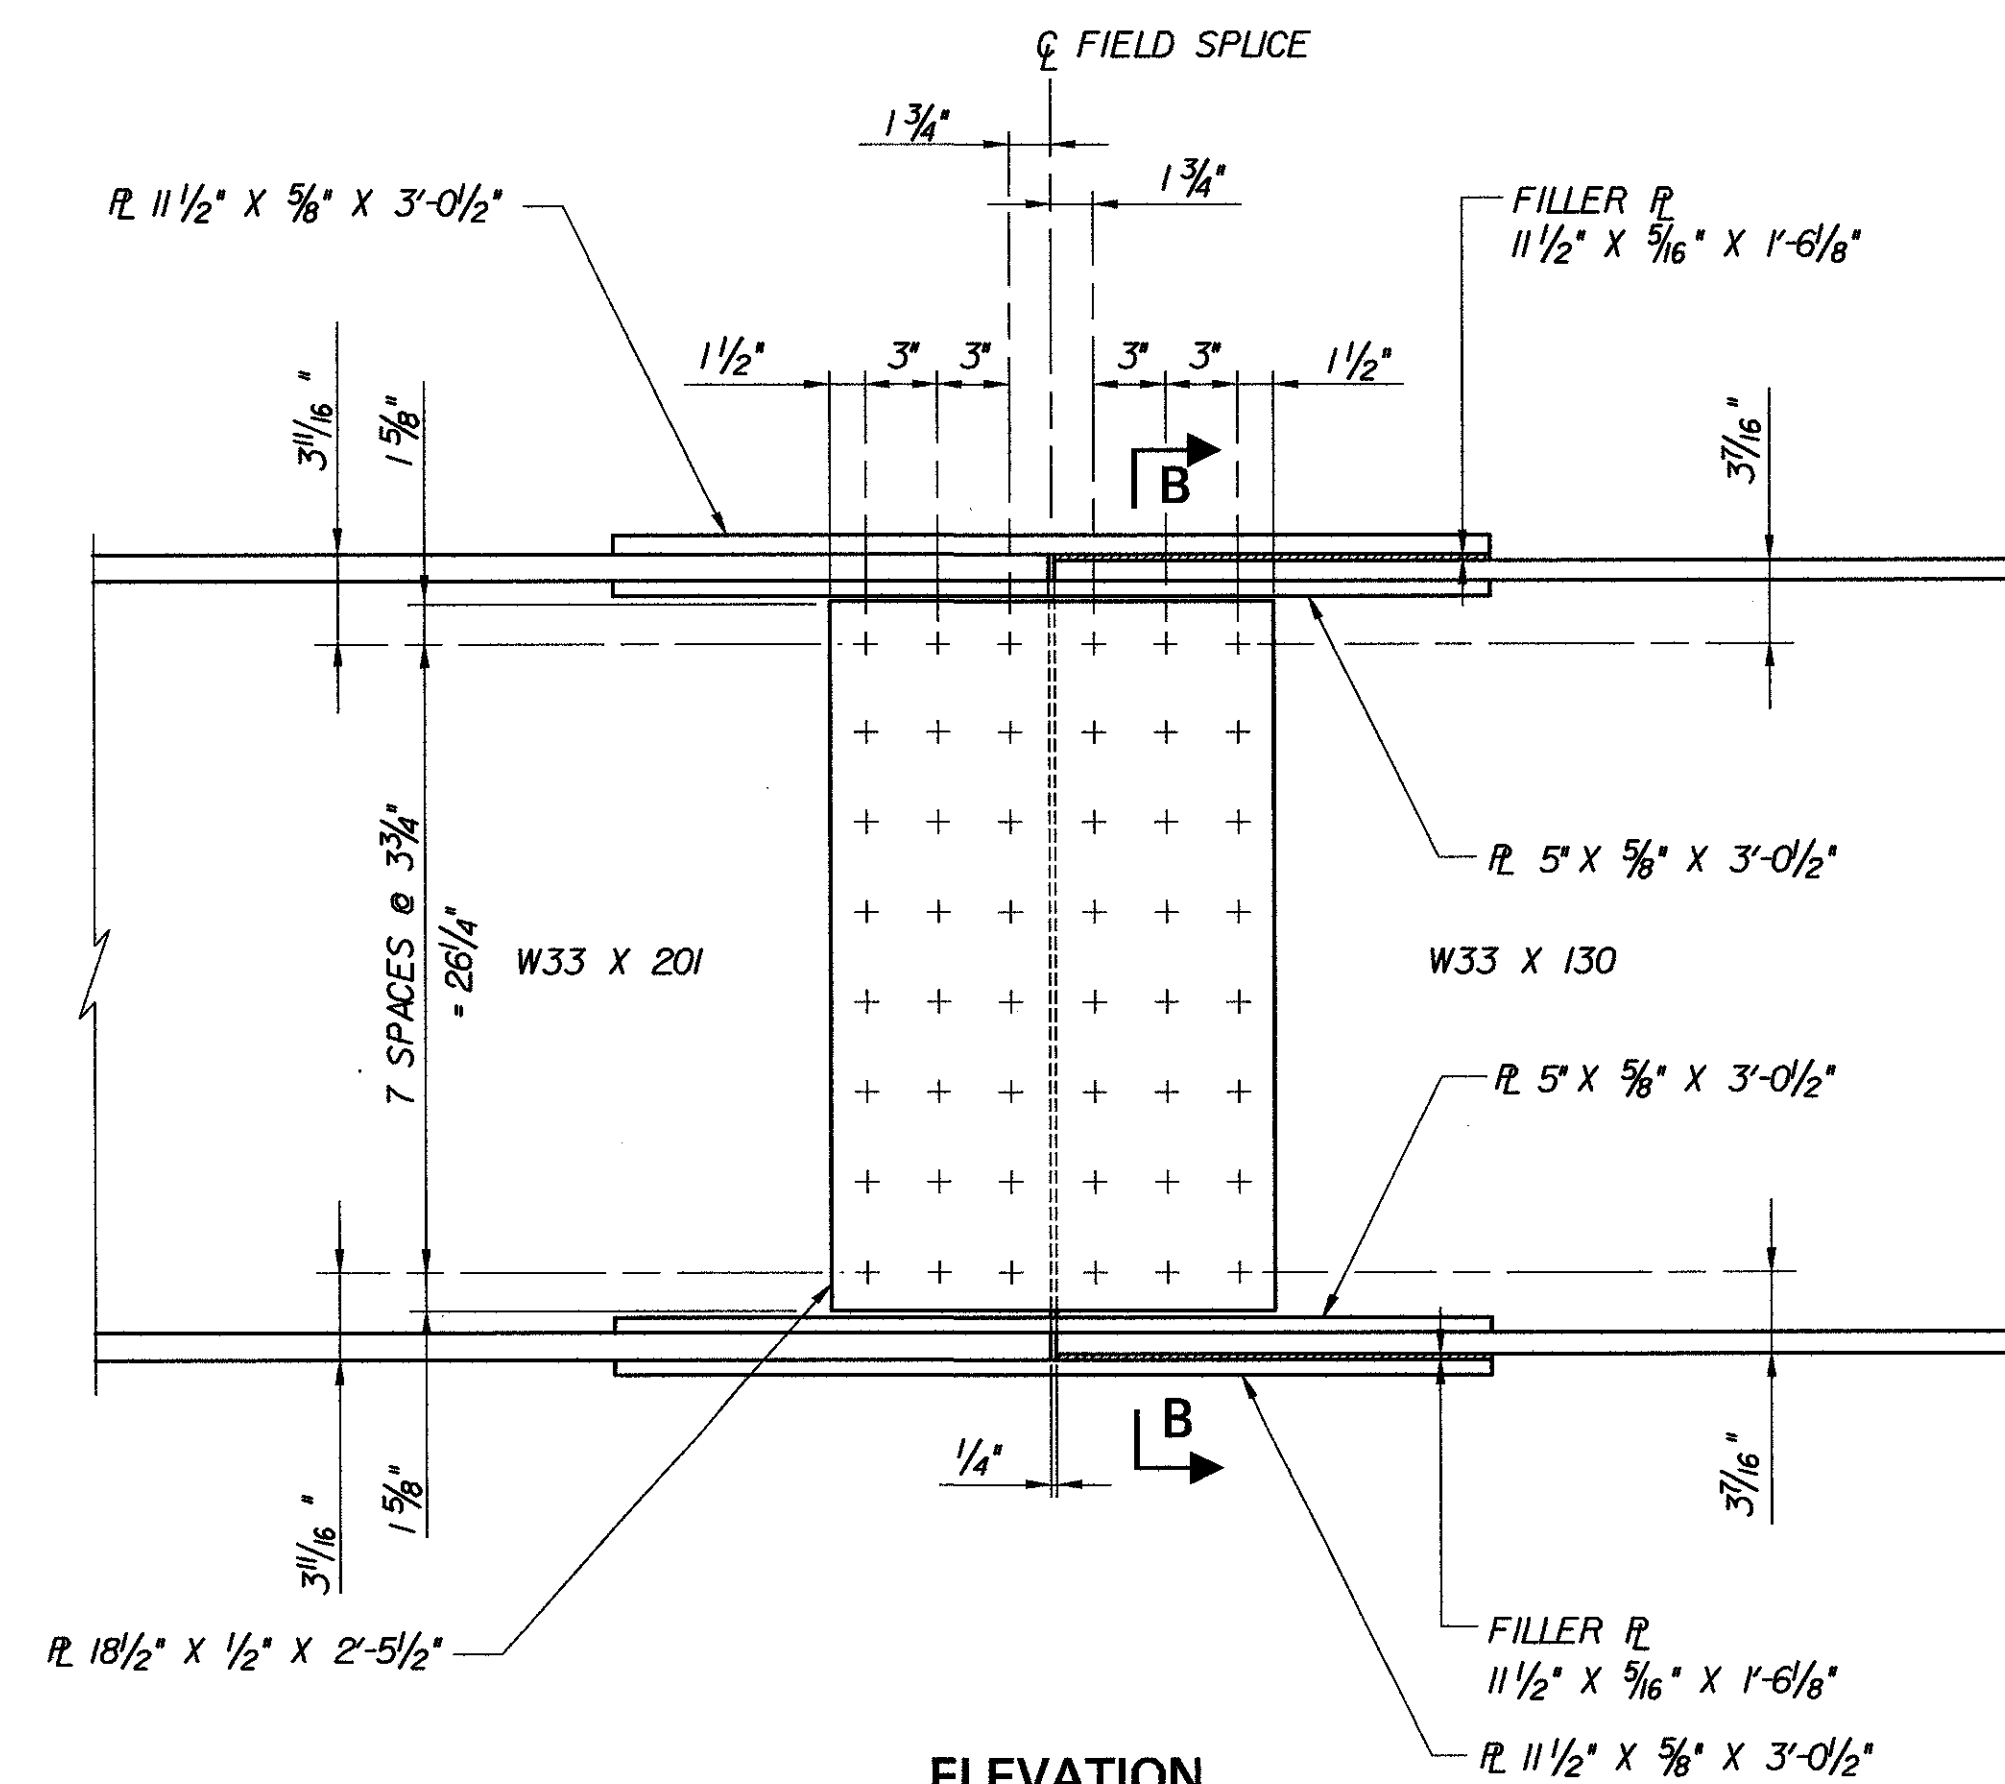

ELEVATION

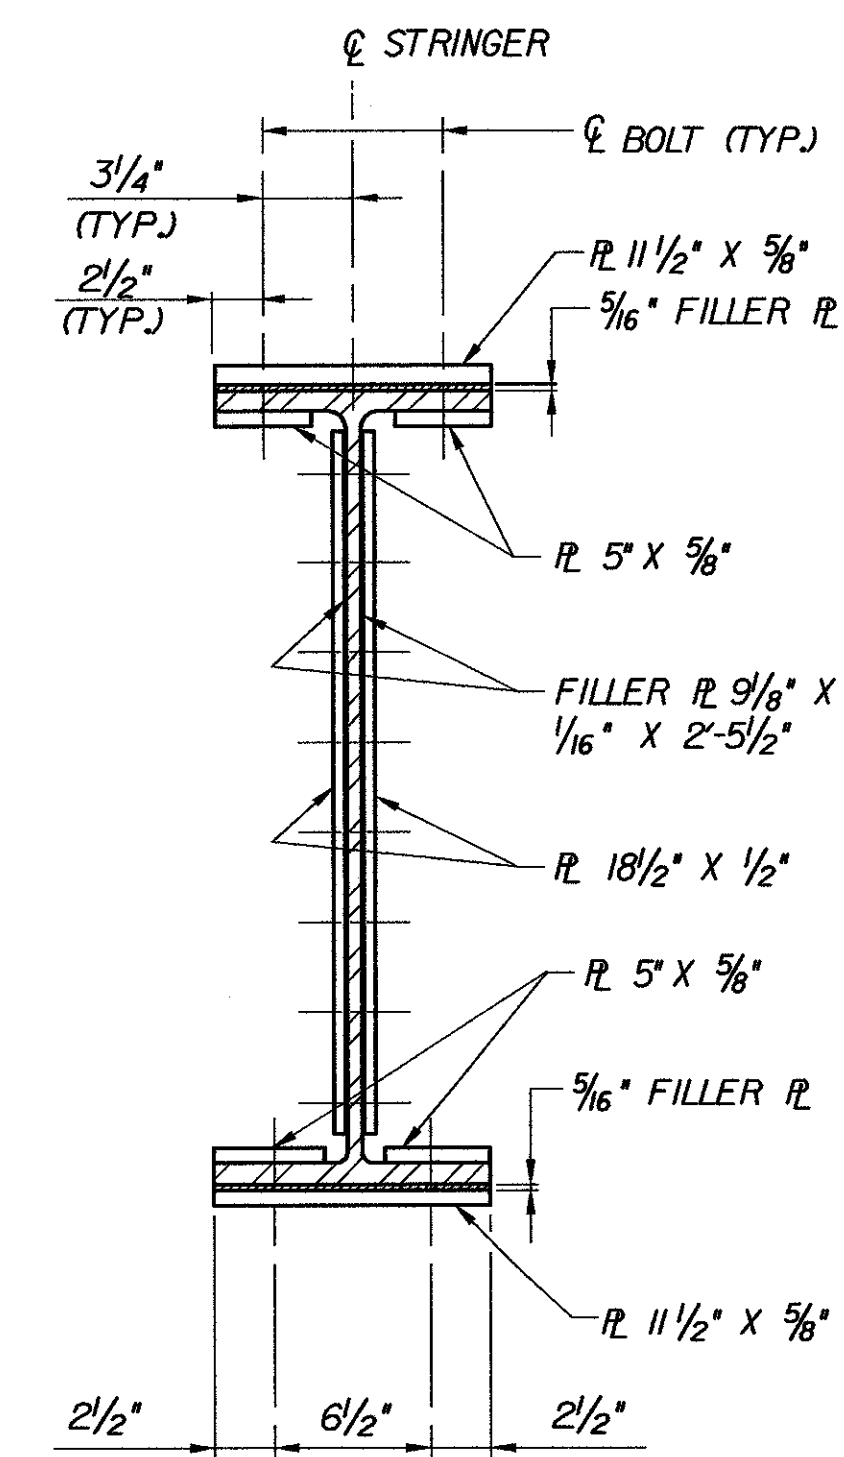

SECTION B-B

FIELD SPLICE @ BR 43N

NOT TO SCALE

FIELD SPLICE @ BR 43S

NOT TO SCALE

NOTES:

- BOLTS SHALL BE 7/8" DIA. AASHTO M164 TYPE 3 HIGH STRENGTH BOLTS IN 1/16" DIA. HOLES. NUTS AND WASHERS SHALL ALSO CONFORM TO AASHTO M164. BOLT LENGTHS SHALL BE SUCH THAT THE BOLT THREADS ARE EXCLUDED FROM THE SHEAR PLANE.
- ALL FIELD SPLICE CONNECTIONS SHALL BE "SLIP CRITICAL" WITH A CLASS B SURFACE (BLAST CLEAN SURFACE) FOR THE CONTACT SURFACES OF BOLTED PARTS.
- STEEL FOR SPLICE & FILLER PLATES SHALL BE AASHTO M270 GRADE 50W (ASTM A709, GRADE 50W).
- HOLES FOR FIELD SPLICES SHALL BE DRILLED IN THE SHOP WHILE STRINGERS ARE ASSEMBLED TO FIT BEARING ELEVATIONS.
- PROVIDE 3/32" THICK PLATE @ EACH SIDE OF W30 X 116 AND 1/16" THICK PLATE @ EACH SIDE OF W30 X 148 FOR SPLICES AT BR 43N SPAN 2.
- ALL FLANGE AND WEB SPLICE PLATES SHALL BE CHARPY V-NOTCH TESTED IN ACCORDANCE WITH SECTION 714.01 OF THE SPECIFICATIONS.

STATE OF VERMONT  
AGENCY OF TRANSPORTATION


Town Of	MIDDLESEX-BOLTON	Bridge No.	
Highway No.	I-89	Log Sta.	
		Surv. Sta.	

TYPICAL ROLLED BEAM SPLICE DETAILS


Designed By	M.H. GALLO	Drawn By	N.J. HOYT
Checked By	Date	Bridge Design Supervisor	
K.L. JAMES	10/99	J.P. HALSTEAD	Date 10/99

PROJECT	MIDDLESEX-BOLTON	PROJECT NO.	IM-089-2(26)
TVGA CAD Drawing No.	127fsl.dgn	Date	10/99
Bridge Sheet No.	C-19	Sheet	19 of 307


**Hayashi Corporation**  
Consulting Engineers

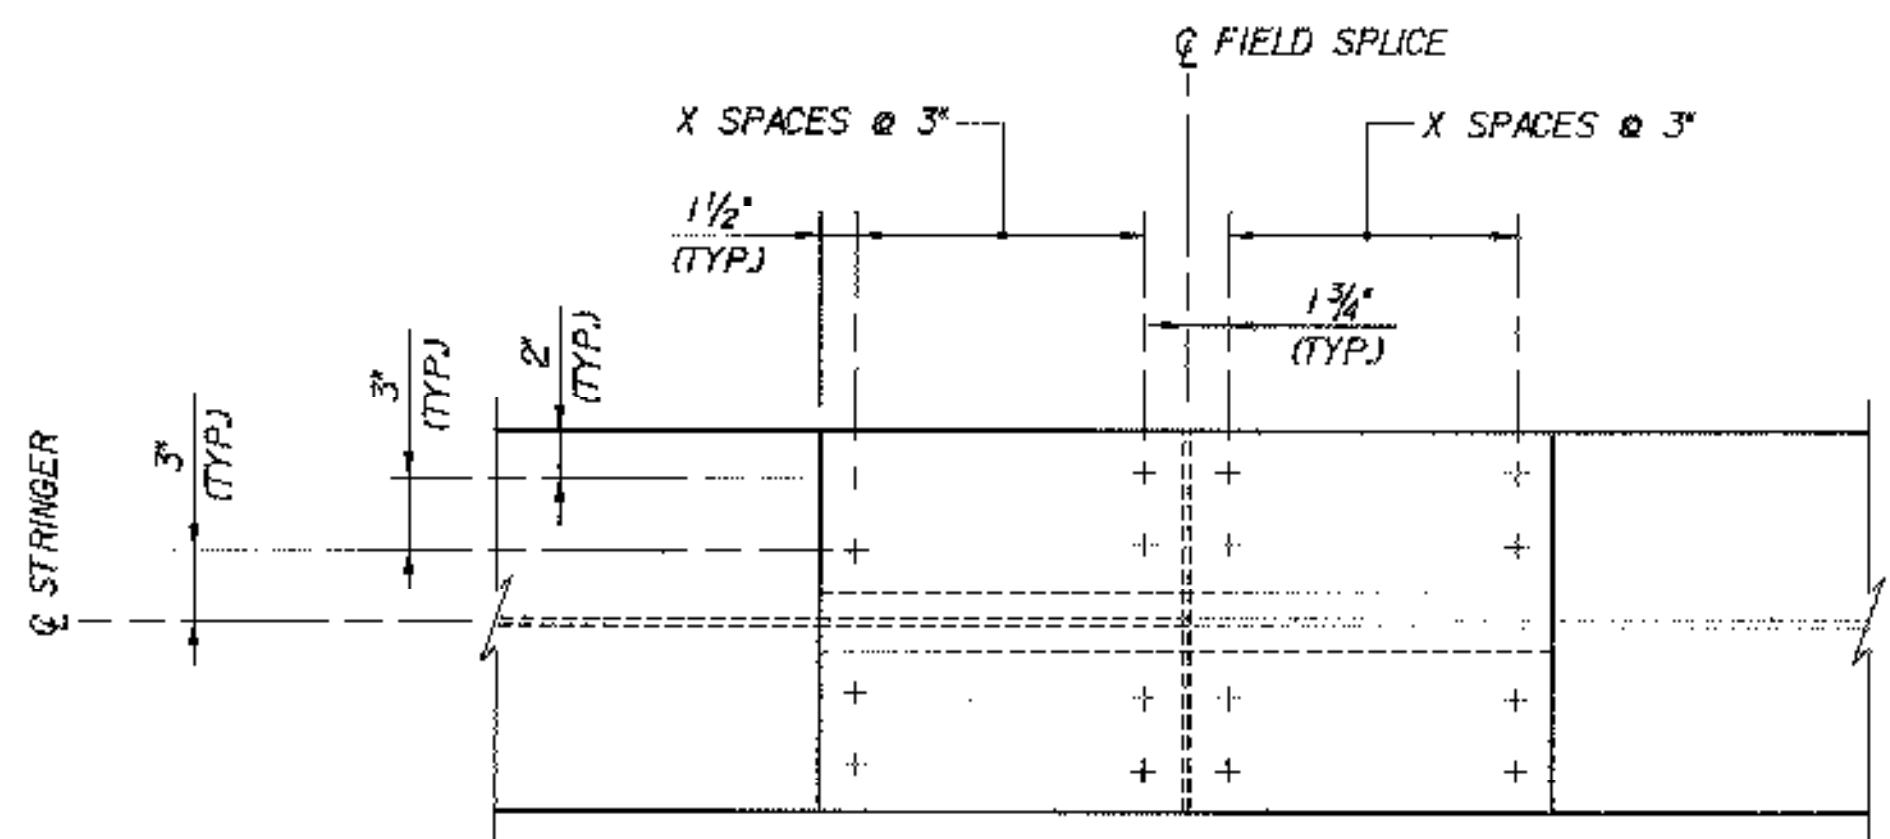

PLAN - TOP & BOTTOM FLANGES

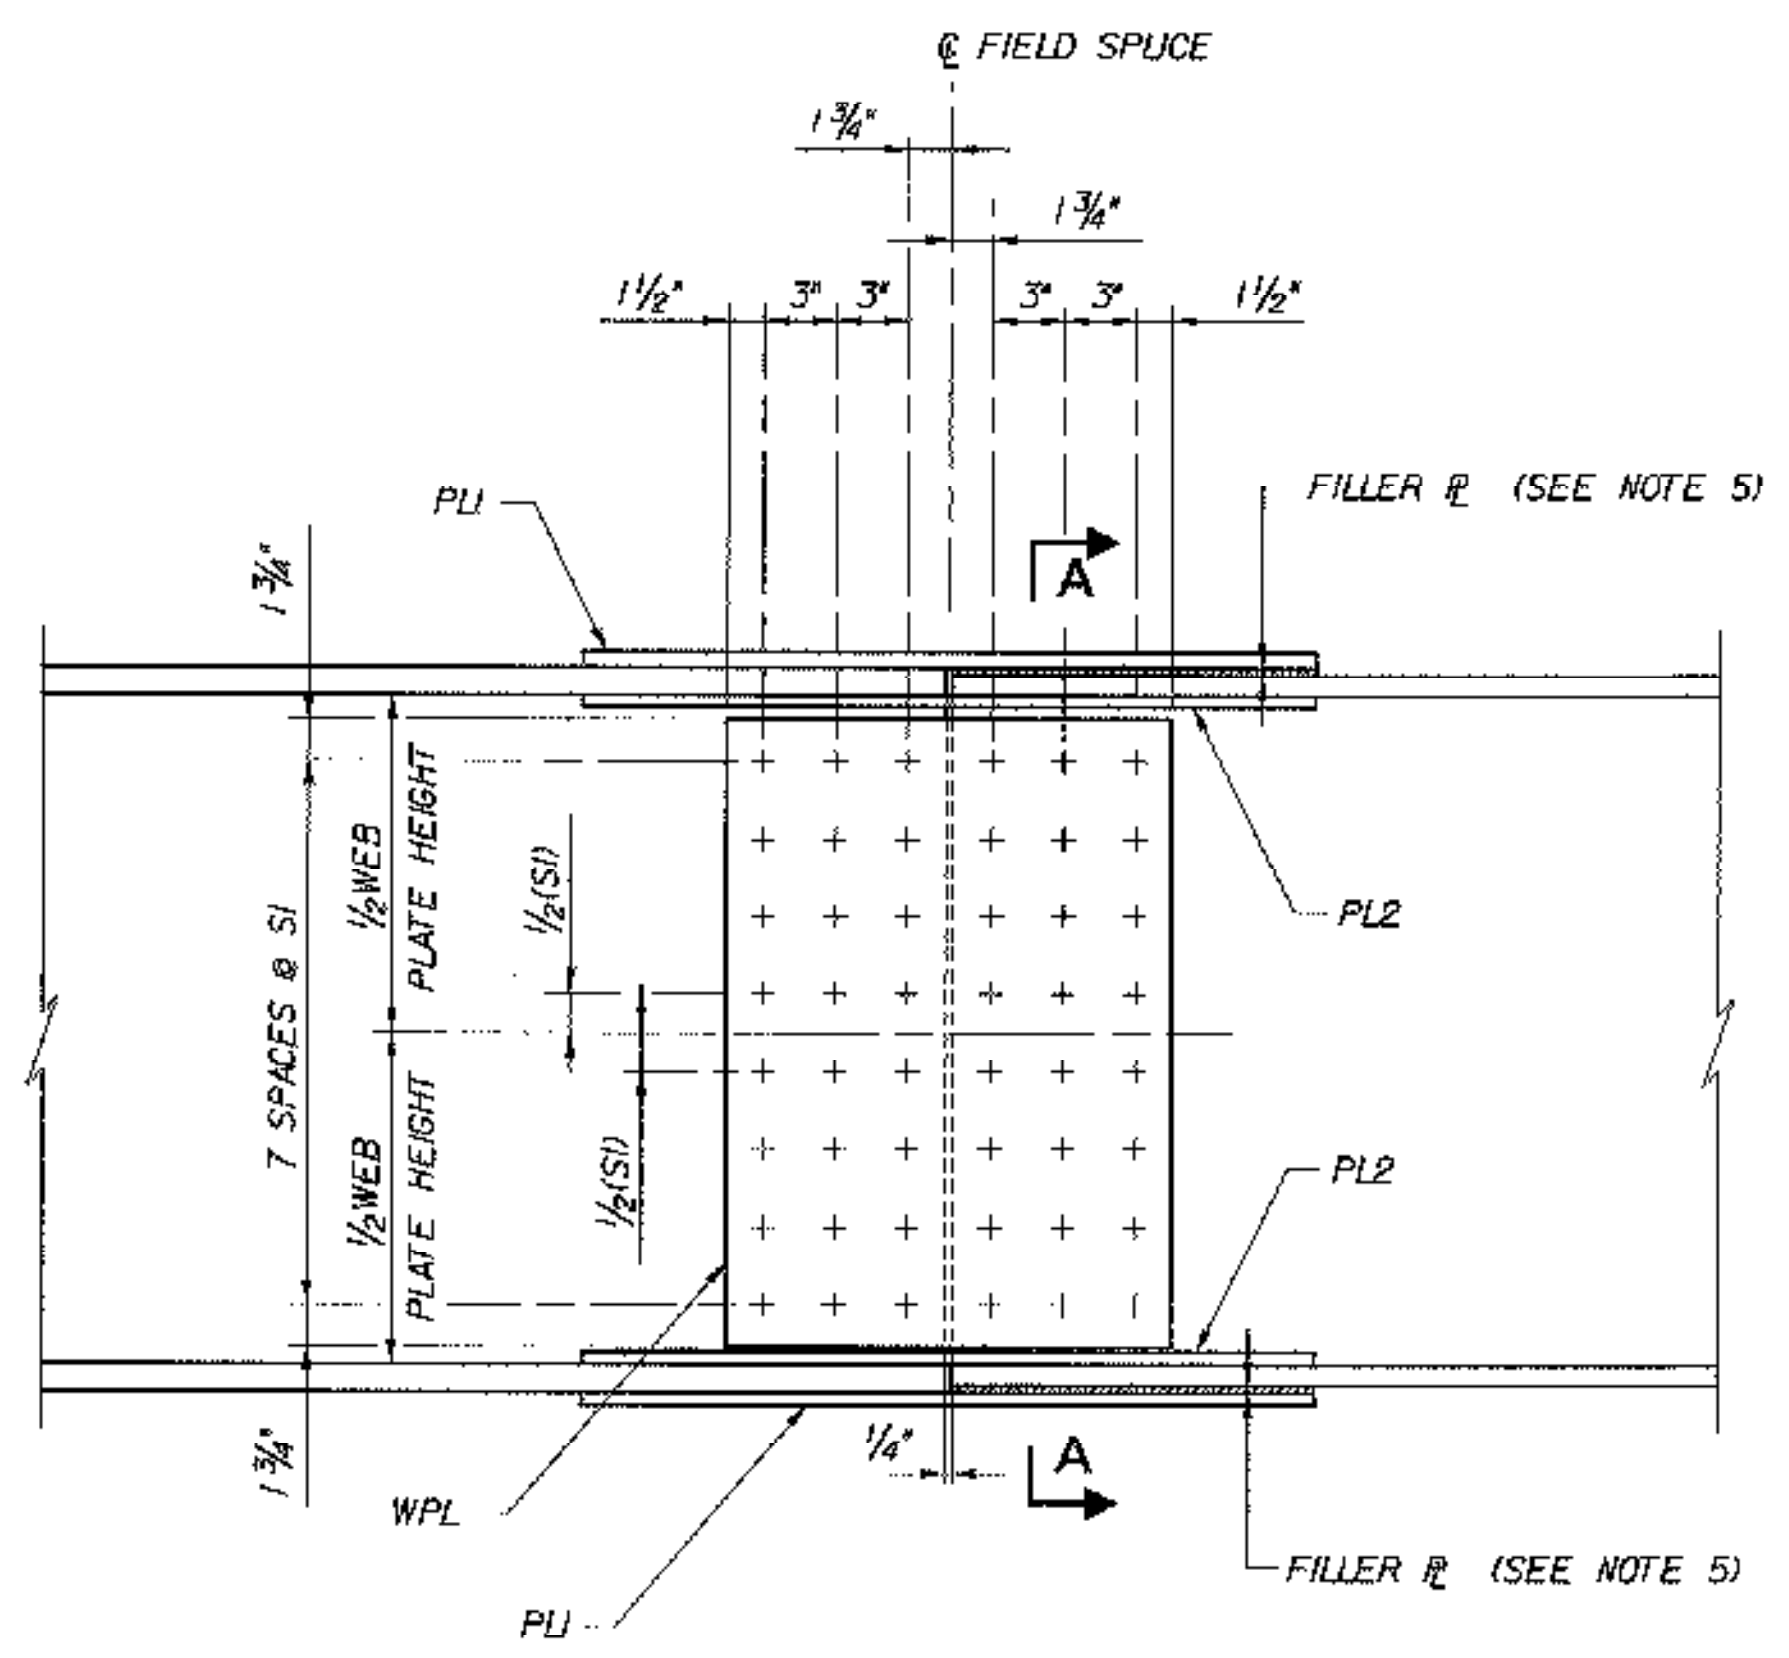

ELEVATION

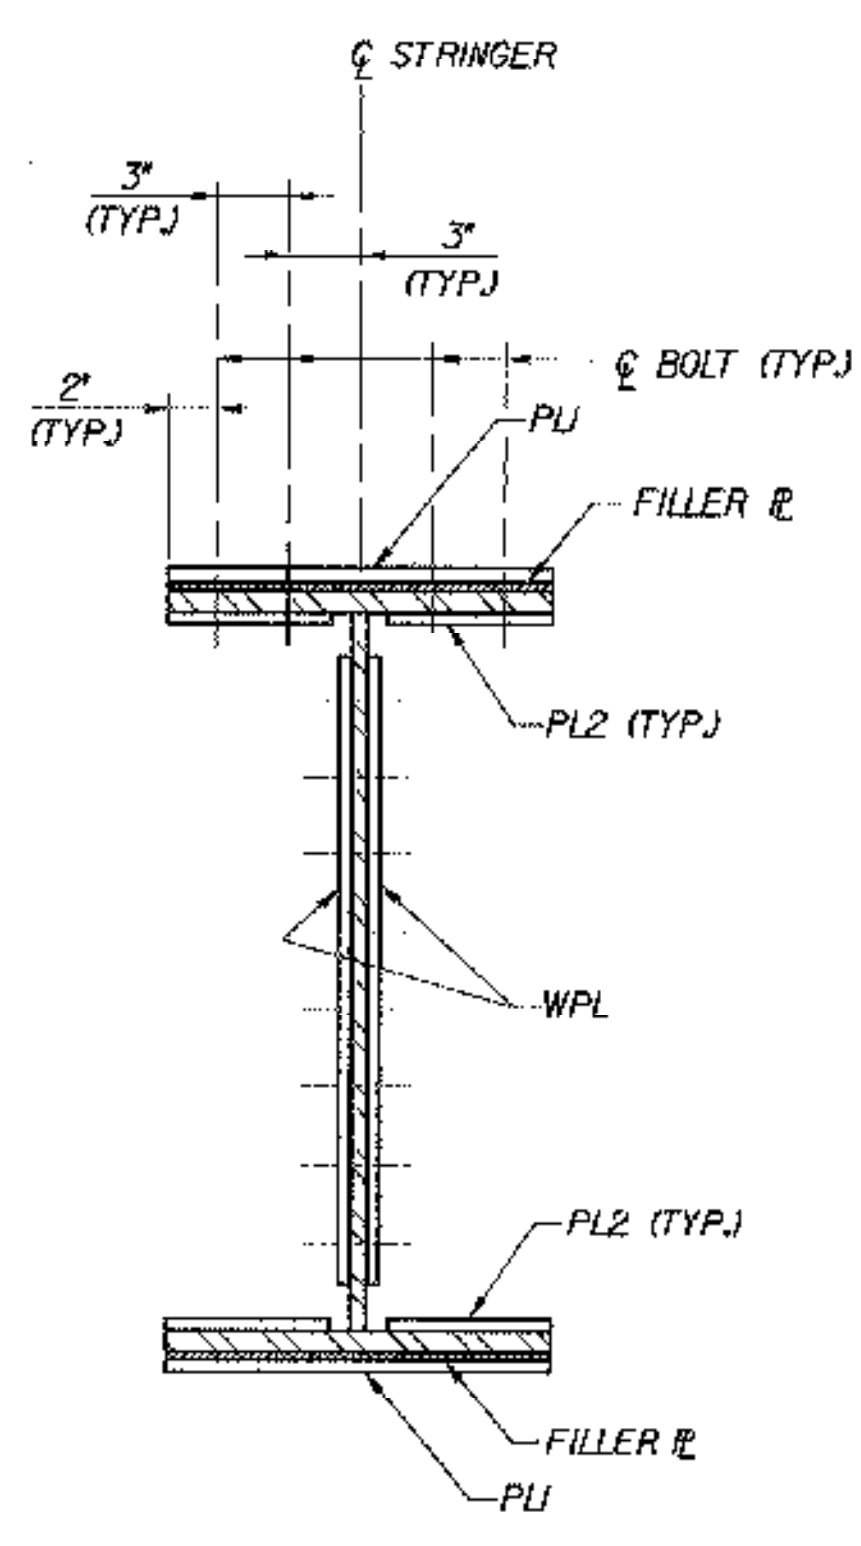

SECTION A-A

FIELD SPLICE @ BR 48, 50 & 51  
NOT TO SCALE

SPLICE PLATE ID	PLATE SIZE
A	18 1/2" X 1/2" X 2'-2 1/4"
B	18 1/2" X 1/2" X 2'-5 3/4"
C	16" X 5/8" X 2'-6 1/2"
D	7" X 5/8" X 2'-6 1/2"
E	16" X 3/4" X 2'-6 1/2"
F	7" X 3/4" X 2'-6 1/2"
G	16" X 1" X 3'-0 1/2"
H	7" X 1" X 3'-0 1/2"

BR. NO.	SPLICE LOCATION	WEB SPLICE		FLANGE SPLICE		
		PLATE SIZE	BOLT SPACING	PL1	PL2	NO. OF BOLT SPACES
48N	ALL	B	3 3/4"	C	D	4
48S	ALL	B	3 3/4"	C	D	4
50N	ALL	A	3 1/4"	C	D	4
50S	ALL	A	3 1/4"	C	D	4
51N	SPANS 2 & 4	B	3 3/4"	E	F	4
	SPAN 3	B	3 3/4"	G	H	5
51S	ALL	B	3 3/4"	E	F	4

NOTES:

- BOLTS SHALL BE 7/8" DIA. AASHTO M164 TYPE 3 HIGH STRENGTH BOLTS IN 1/8" DIA. HOLES. NUTS AND WASHERS SHALL ALSO CONFORM TO AASHTO M164. BOLT LENGTHS SHALL BE SUCH THAT THE BOLT THREADS ARE EXCLUDED FROM THE SHEAR PLANE.
- ALL FIELD SPLICE CONNECTIONS SHALL BE "SLIP CRITICAL" WITH A CLASS B SURFACE (BLAST CLEAN SURFACE) FOR THE CONTACT SURFACES OF BOLTED PARTS.
- STEEL FOR SPLICE & FILLER PLATES SHALL BE AASHTO M270 GRADE 50W (ASTM A709, GRADE 50W).
- HOLES FOR FIELD SPLICES SHALL BE DRILLED IN THE SHOP WHILE STRINGERS ARE ASSEMBLED TO FIT BEARING ELEVATIONS.
- FILLER PLATE SIZE : MIN. THICKNESS = 1/16" WIDTH = 16" LENGTH = (1/2) (PL1) - 1/8"
- ALL FLANGE AND WEB SPLICE PLATES SHALL BE CHARNY V-NOTCH TESTED IN ACCORDANCE WITH SECTION 714.01 OF THE SPECIFICATIONS.


STATE OF VERMONT  
AGENCY OF TRANSPORTATION

Town Of	MIDDLESEX-BOLTON	Bridge No.	
Highway No.	I-89	Log Sta.	
		Surv. Sta.	

TYPICAL GIRDER SPLICE DETAILS


Designed By	M.H. GALLO	Drawn By	N.J. HOYT
Checked By	K.L. JAMES	Bridge Design Supervisor	J.P. HALSTEAD
Date	10/99	Date	10/99
PROJECT	MIDDLESEX-BOLTON	PROJECT NO.	IM-089-2(26)
TVGA CAD Drawing No.	I27fe2.dgn	Date	10/99
Bridge Sheet No.	C-20	Sheet	20 of 307



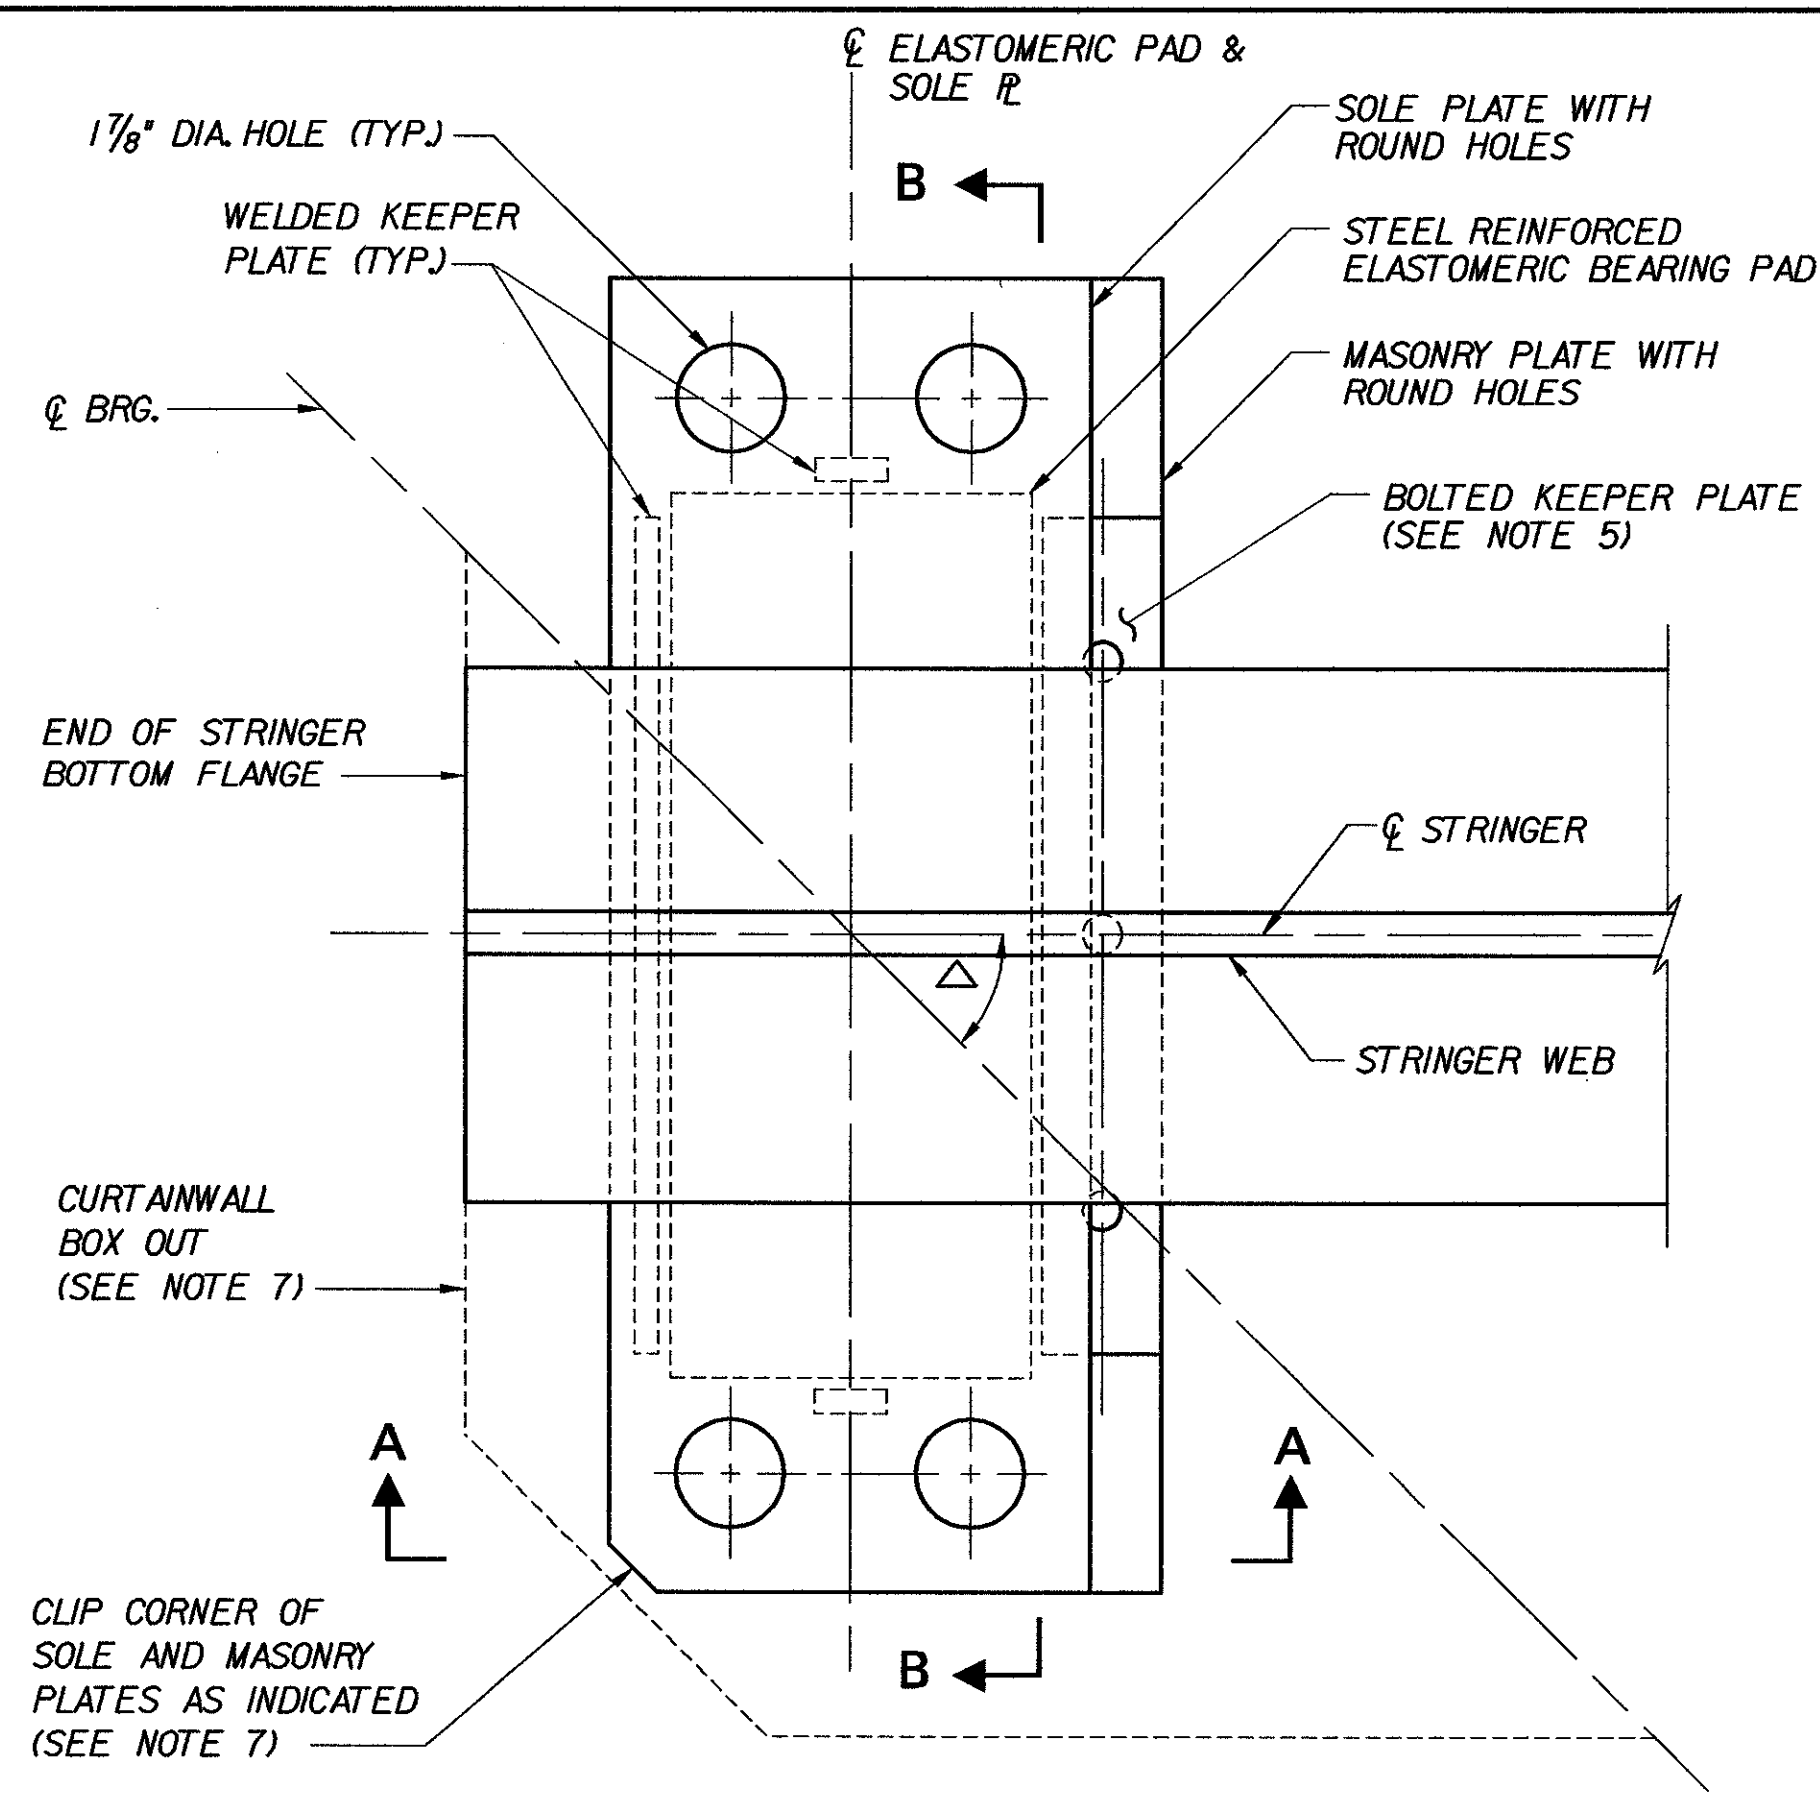


(ANCHOR BOLTS NOT SHOWN FOR CLARITY)

**BEARING PLAN AT ABUTMENT**  
NOT TO SCALE

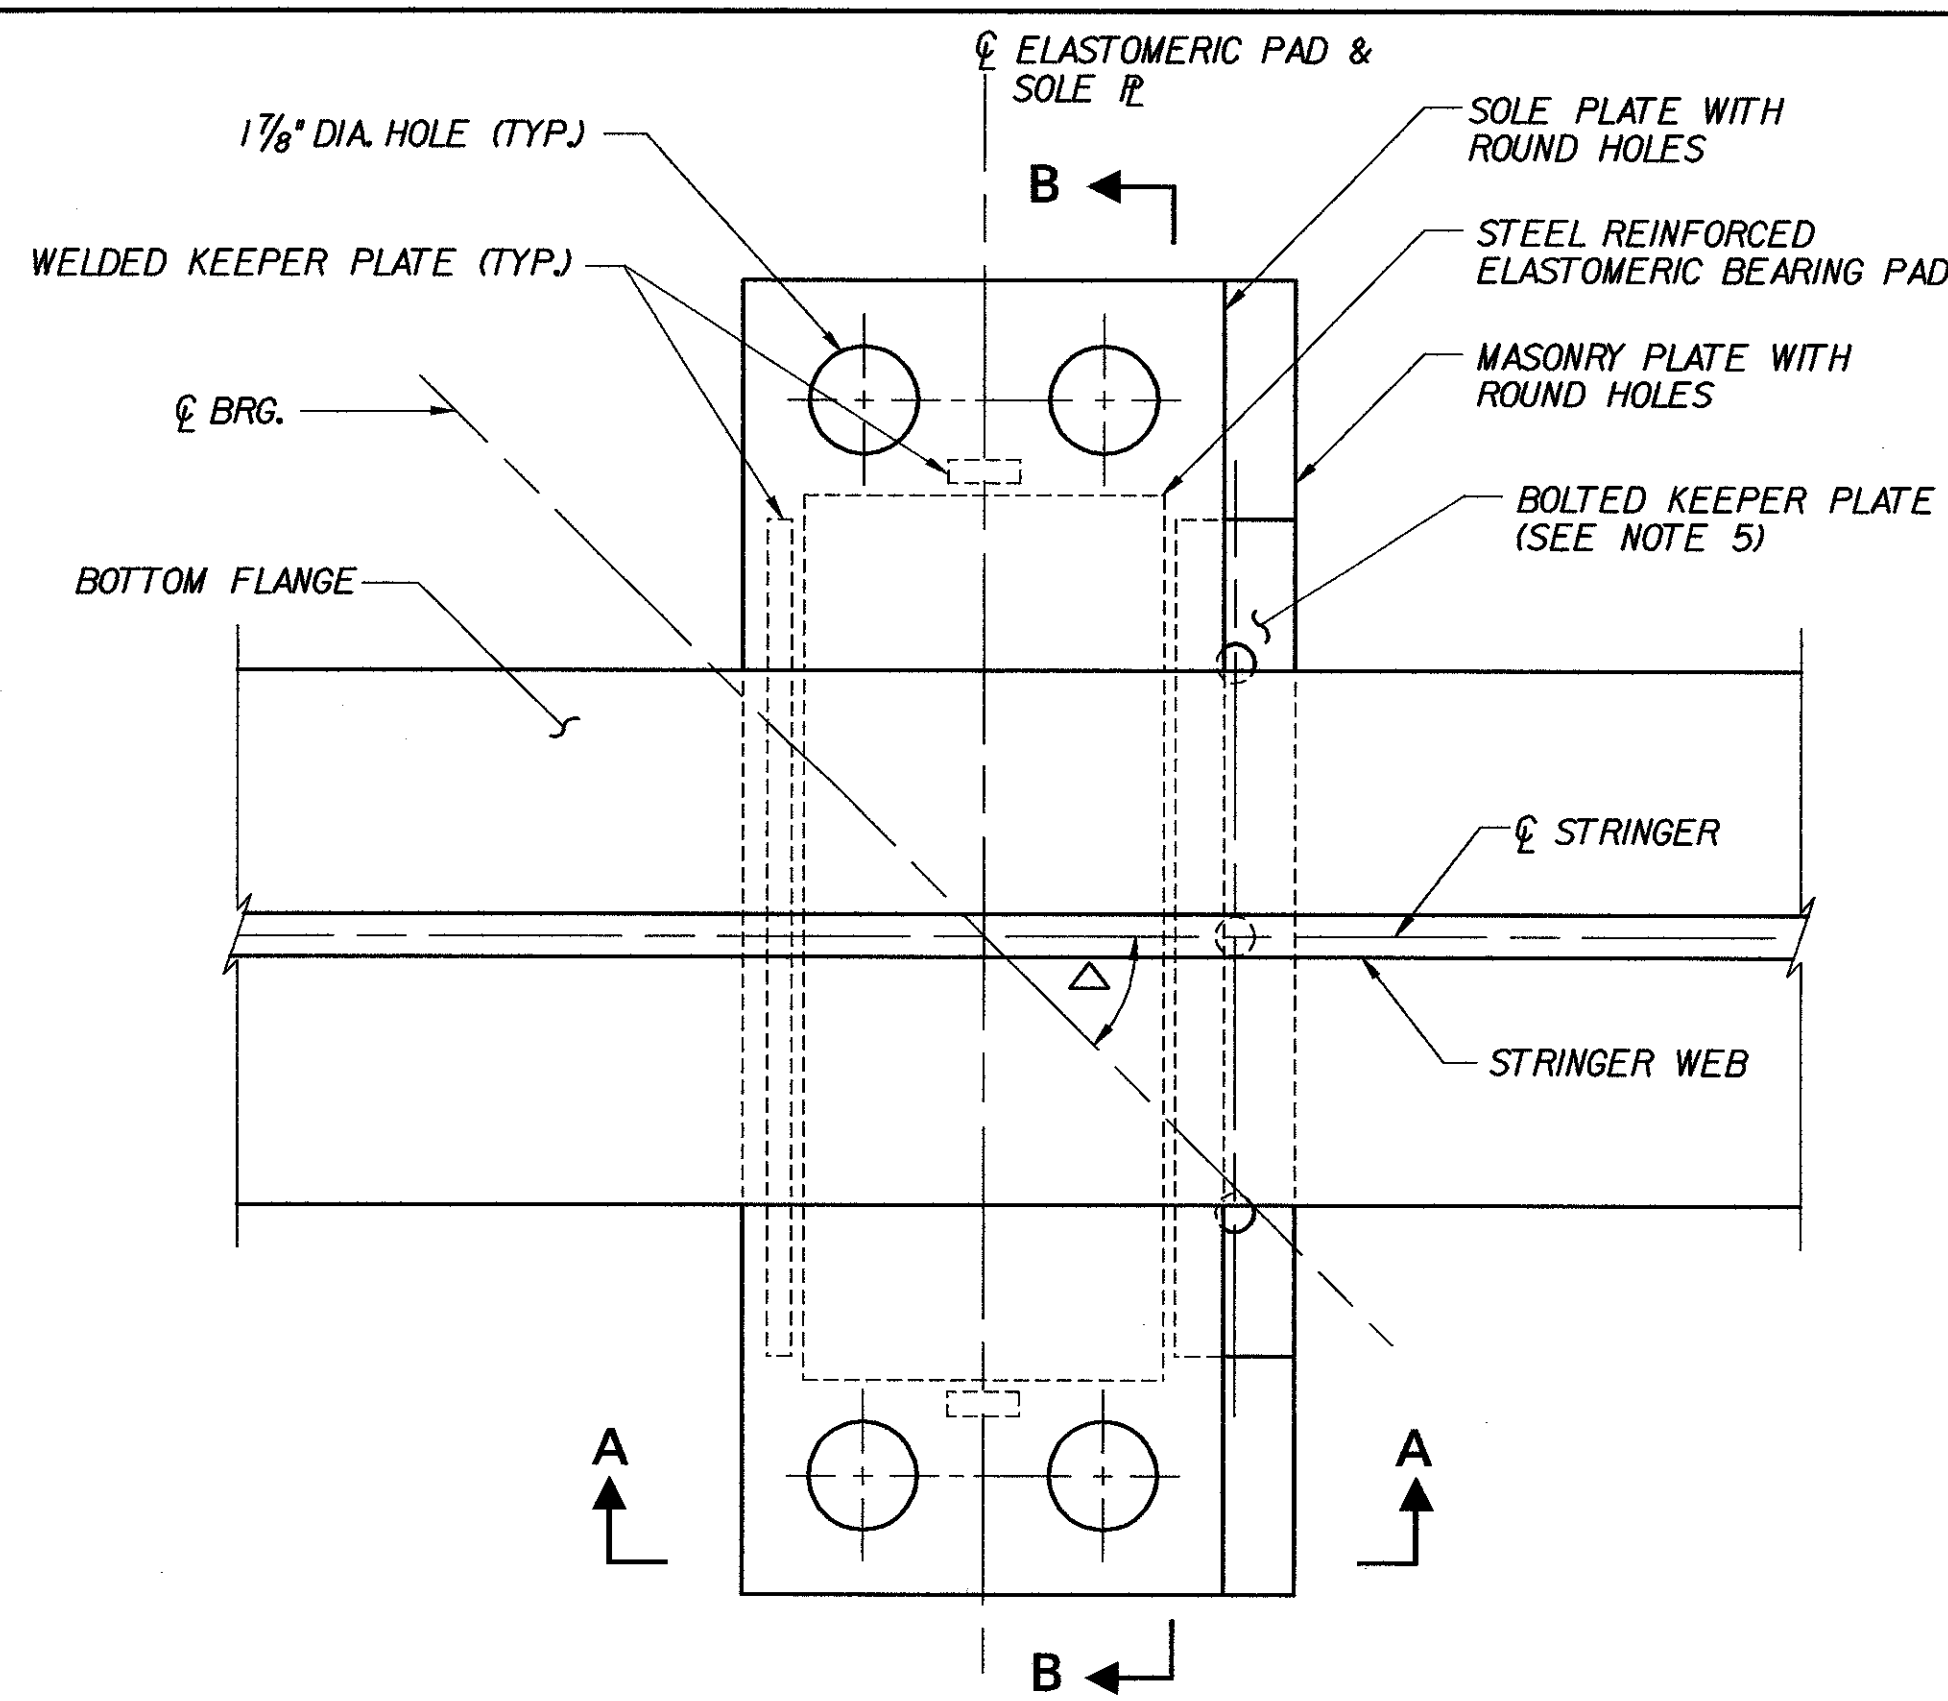


(ANCHOR BOLTS NOT SHOWN FOR CLARITY)

**BEARING PLAN AT PIER**  
NOT TO SCALE

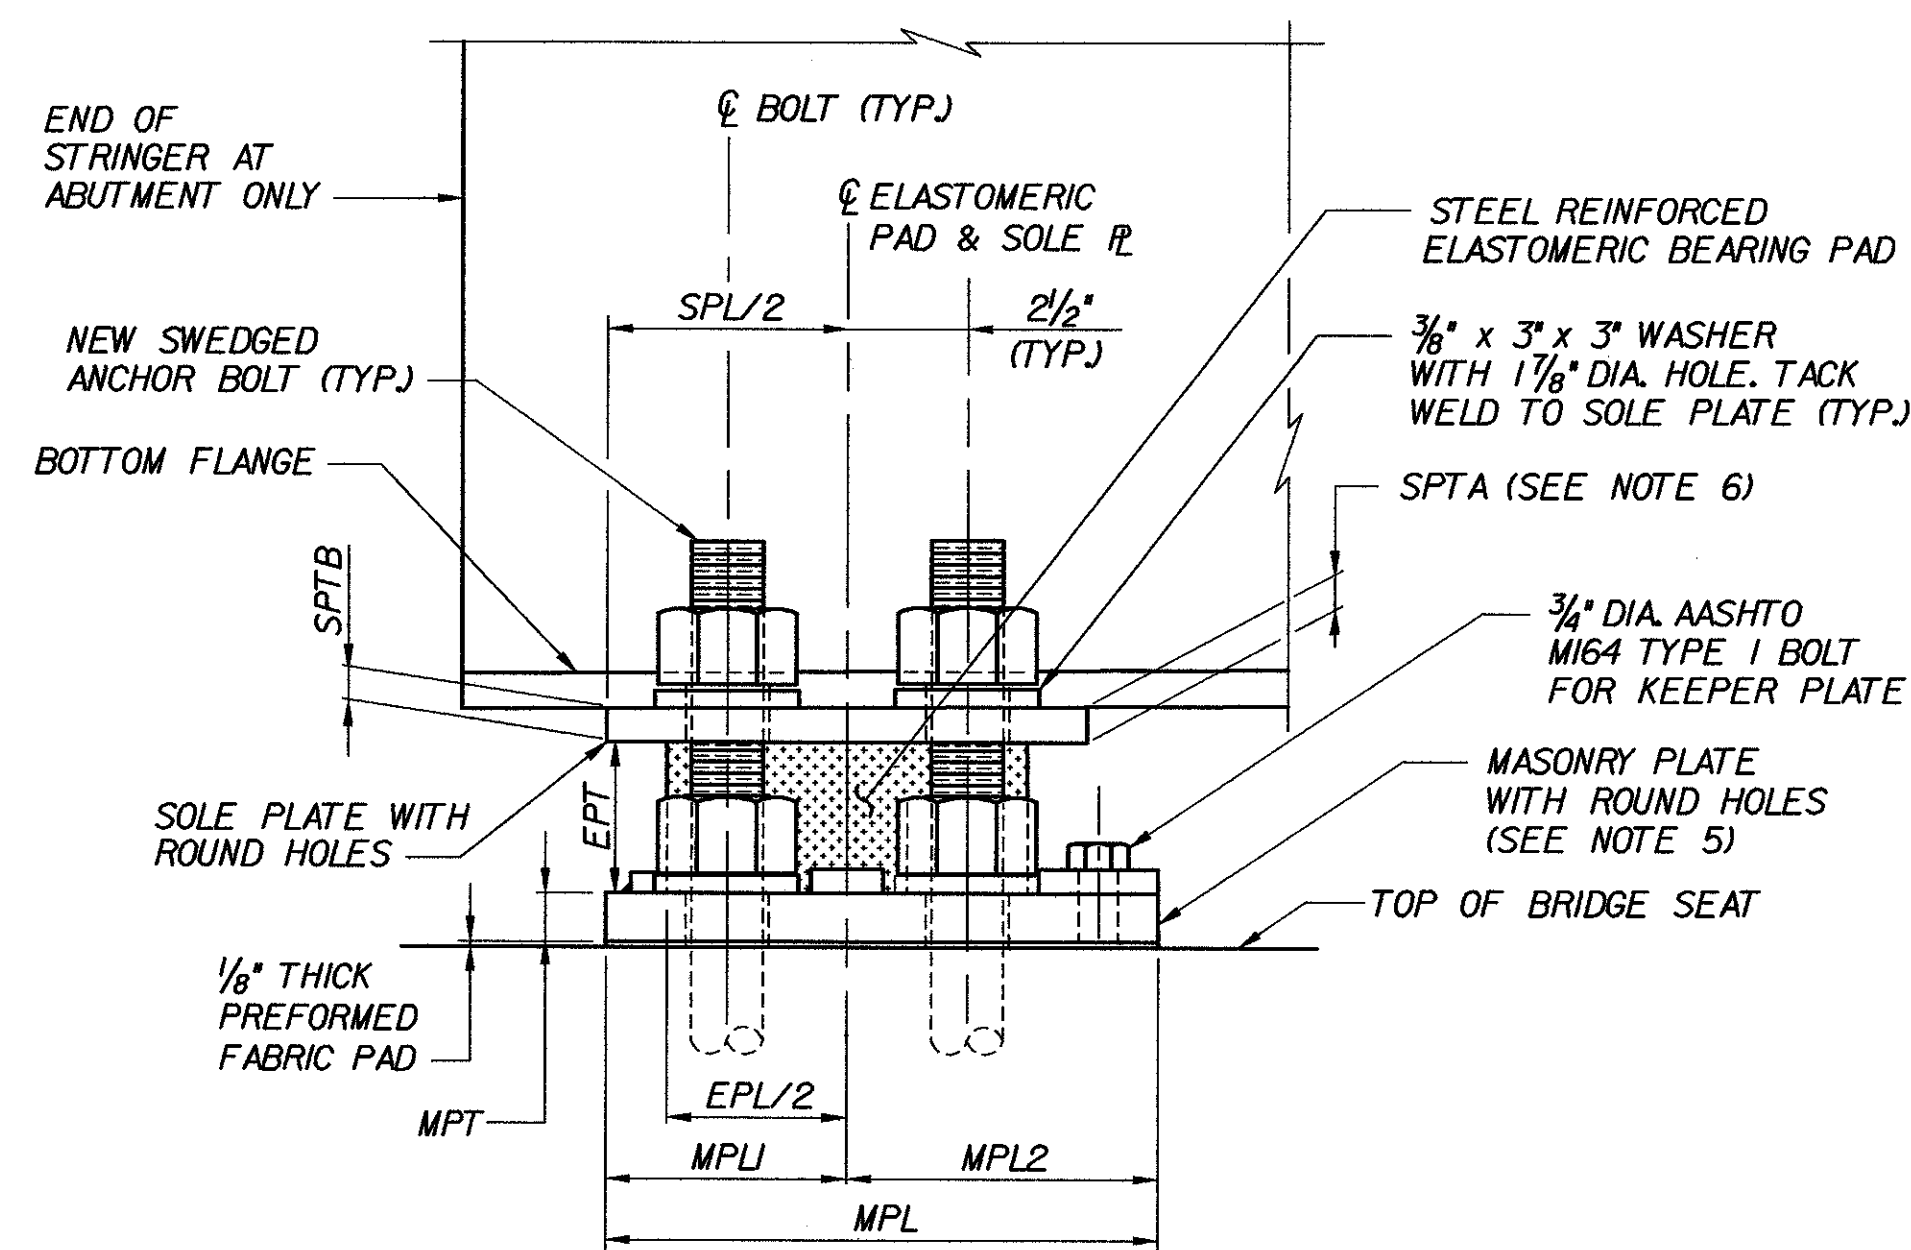


(BEARING AT ABUTMENT SHOWN, BEARING AT PIER SIMILAR)


**SECTION A-A**  
NOT TO SCALE

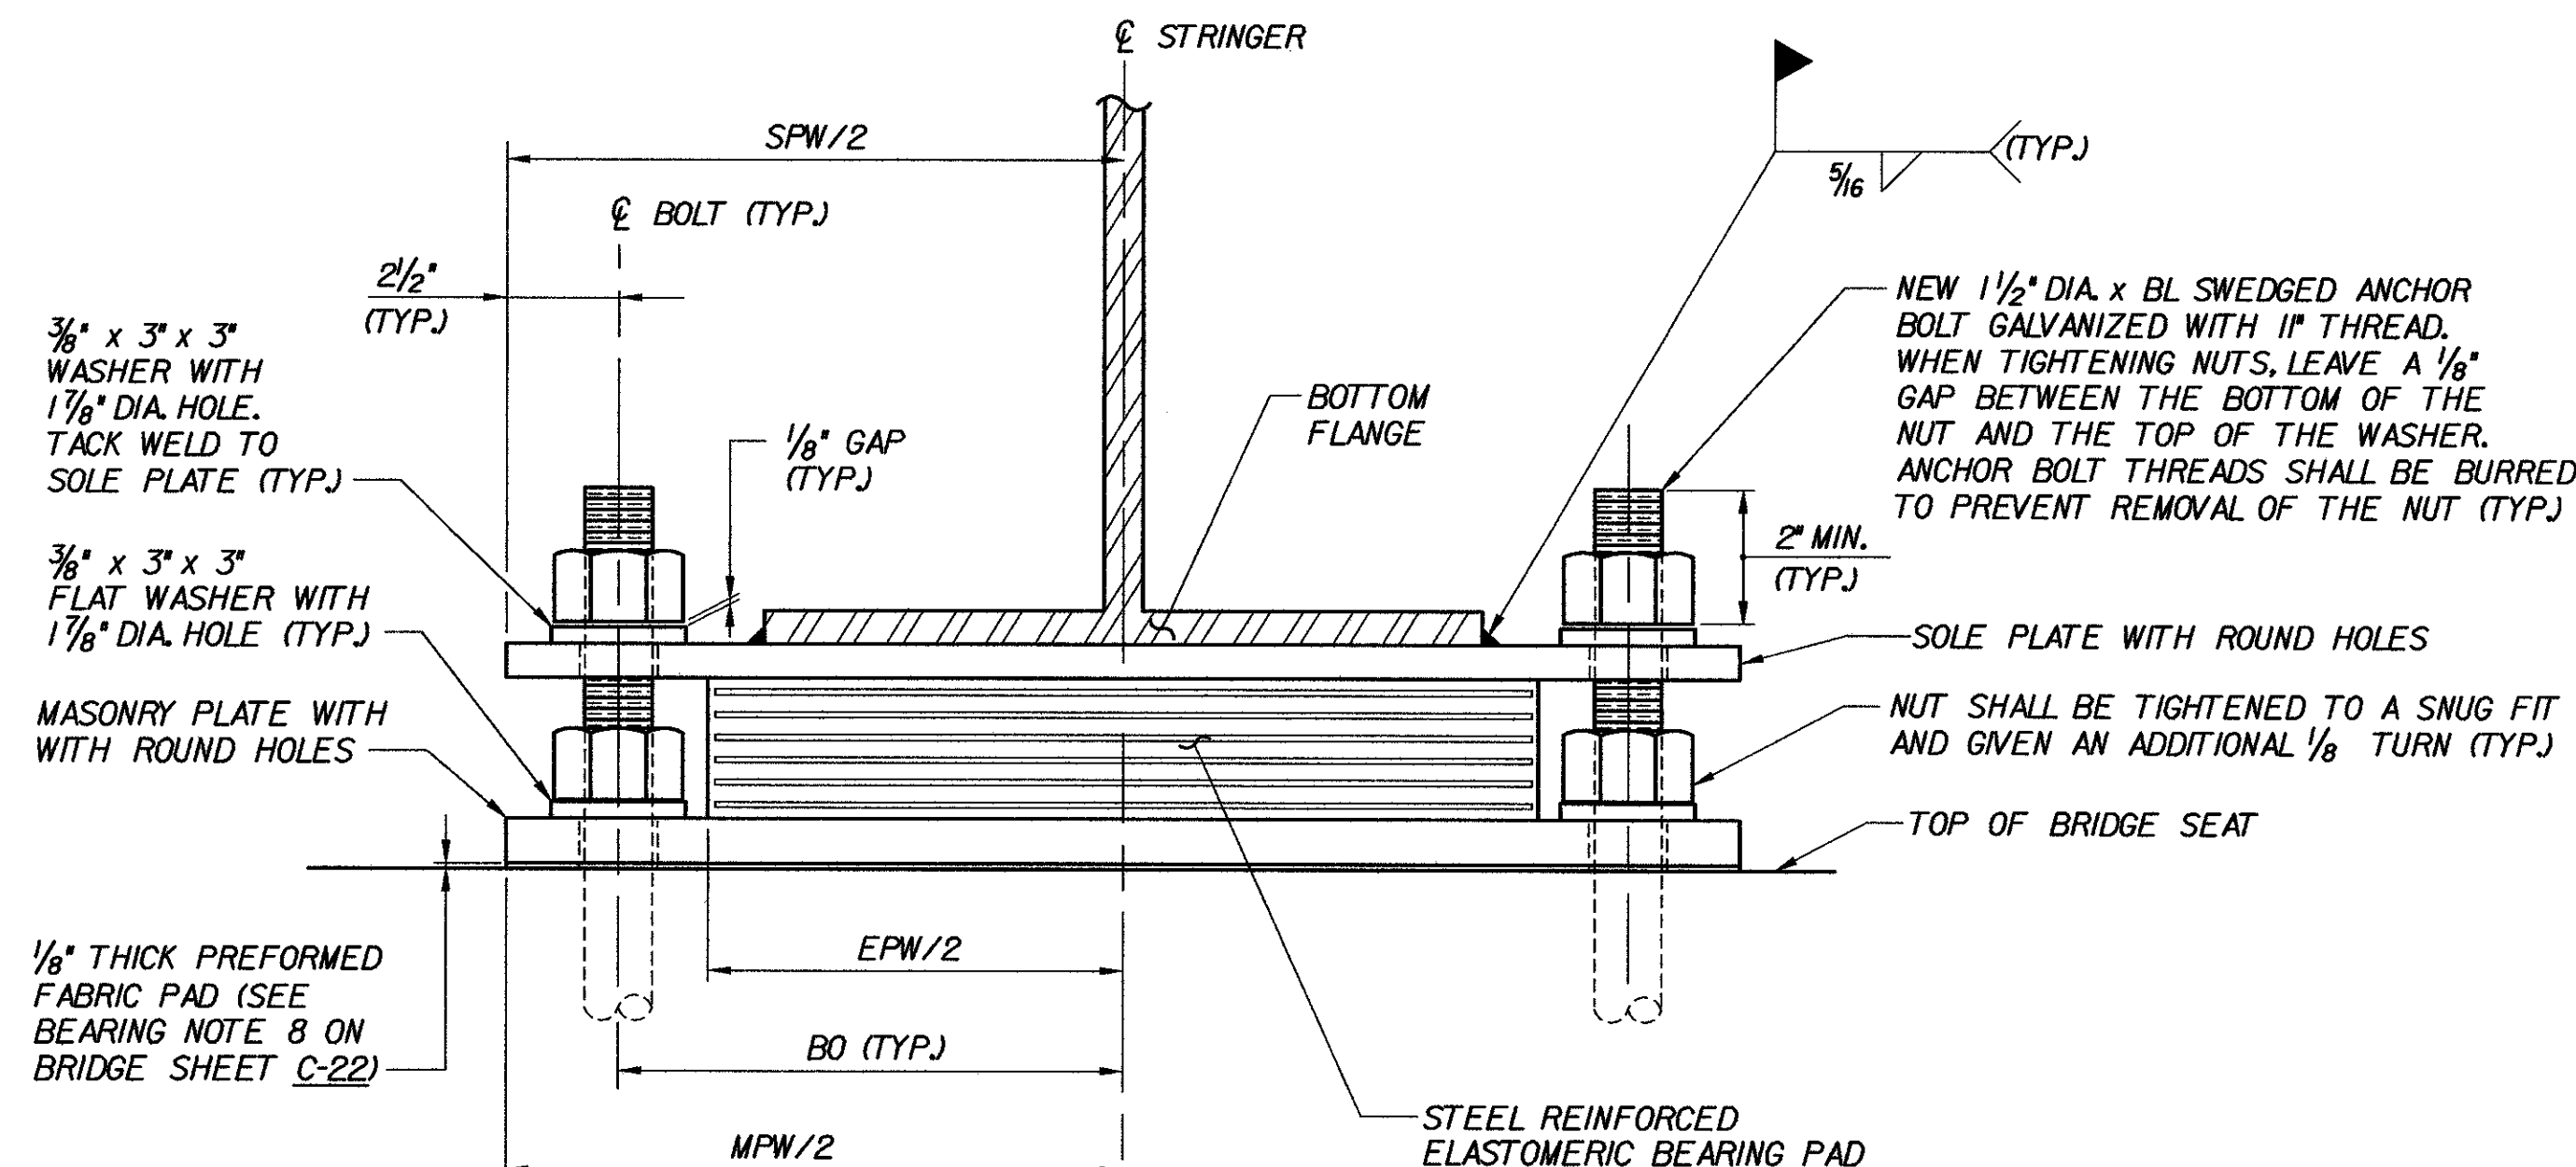

**SECTION B-B**  
NOT TO SCALE

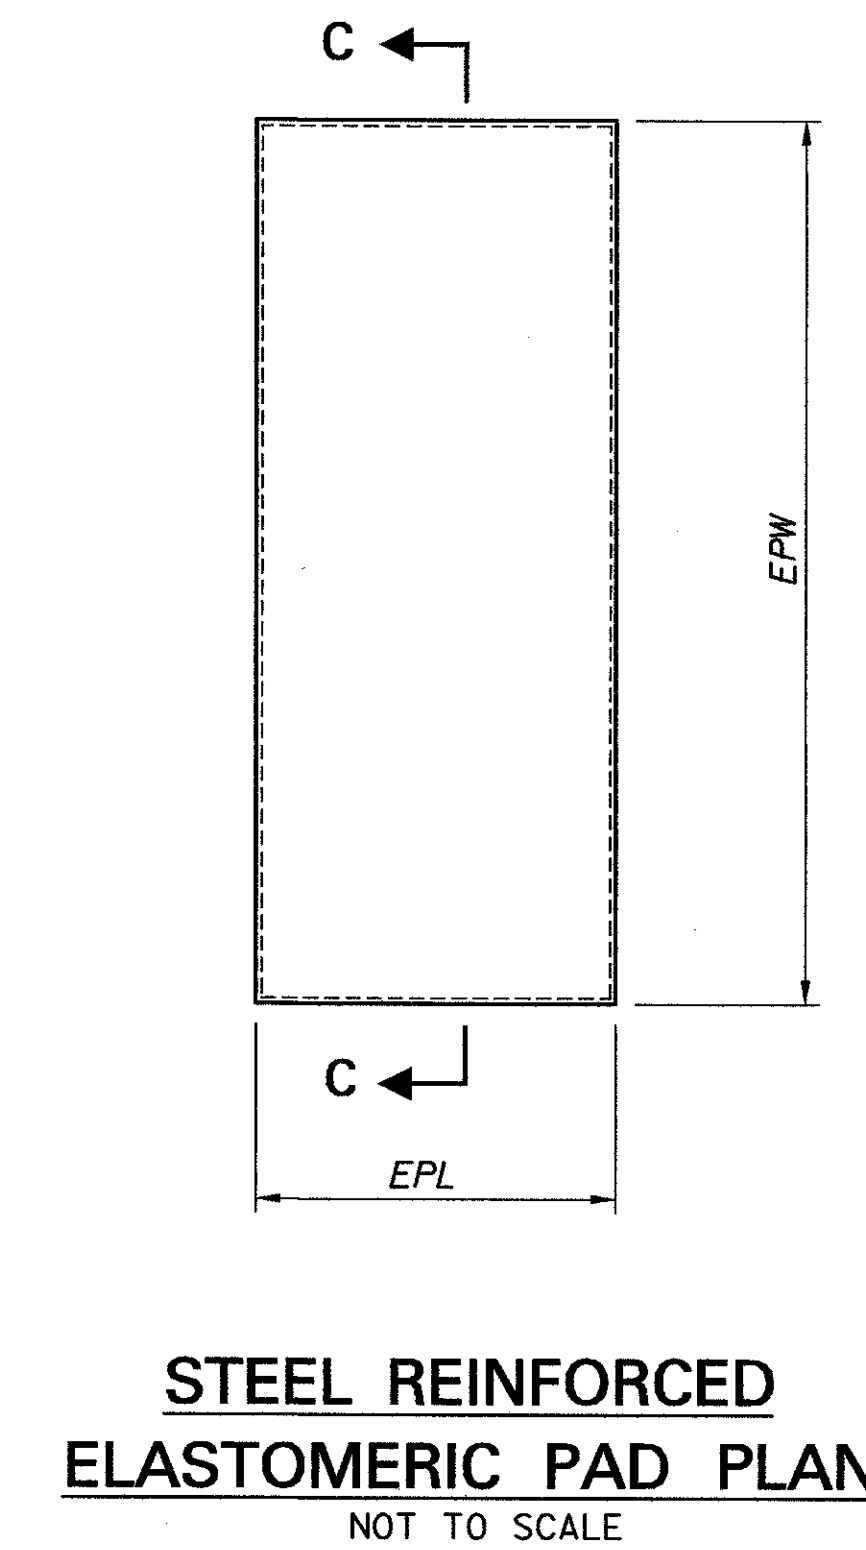

**STEEL REINFORCED ELASTOMERIC PAD PLAN**  
NOT TO SCALE

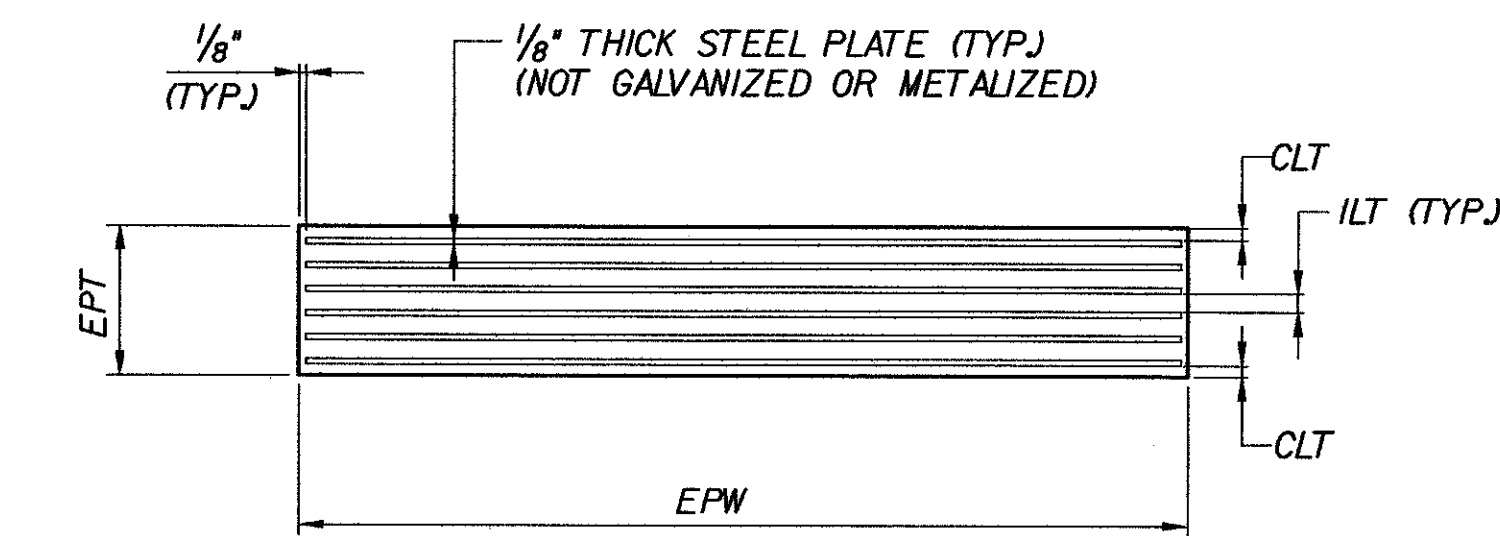

NOTE : NUMBER OF STEEL PLATES VARIES (SEE TABLE ON BRIDGE SHEET C-22)

**SECTION C-C**  
NOT TO SCALE

**NOTES:**

- SEE BRIDGE SHEET C-22 FOR BEARING NOTES & FIXED BEARING TABLES.
- SEE BRIDGE SHEET C-25 FOR SOLE PLATE, MASONRY PLATE AND KEEPER PLATE DETAILS.
- SKUEW DIRECTION SHOWN IS \*AHEAD RIGHT\*.
- BEARING STIFFENERS/DIAPHRAGM CONNECTION PLATES ARE NOT SHOWN FOR CLARITY.
- AT ABUTMENT, MASONRY PLATE SHALL BE ORIENTED SO THAT THE BOLTED KEEPER PLATE IS ACCESSIBLE FROM THE FACE OF THE ABUTMENT TO ACCOMMODATE ELASTOMERIC PAD REMOVAL, IF REQUIRED IN THE FUTURE. AT PIER, THE ENGINEER SHALL DETERMINE THE MASONRY PLATE ORIENTATION.
- \*SPTA\* DIMENSION FOR SOLE PLATE SHALL BE MEASURED AND SET ON THE UPSTATION SIDE OF THE BEARING.
- SOLE & MASONRY PLATES MAY REQUIRE ONE CORNER TO BE CLIPPED TO CLEAR CURTAINWALL AT FIXED ABUTMENTS ONLY. FOR DETAILS AND DIMENSIONS OF THE SOLE AND MASONRY PLATE CLIP, SEE BRIDGE SHEETS C-22 AND C-25. FOR CURTAINWALL DETAILS AND DIMENSIONS, SEE BRIDGE SHEET C-42.

**STATE OF VERMONT AGENCY OF TRANSPORTATION**

Town Of	MIDDLESEX-BOLTON	Bridge No.	
Highway No.	I-89	Log Sta.	
		Surv. Sta.	

**FIXED BEARING DETAILS**

Designed By	K.L. JAMES	Drawn By	N.J. HOYT
Checked By	Date	Bridge Design Supervisor	Date
	M.H. GALLO	J.P. HALSTEAD	10/99

PROJECT	MIDDLESEX-BOLTON	PROJECT NO.	IM-089-2(26)
TVGA CAD Drawing No.	I27fxb2.dgn	Date	10/99
Bridge Sheet No.	C-21	Sheet	21 of 307

**Hayashi Corporation**  
Consulting Engineers

### FIXED BEARING GEOMETRY

BRIDGE NO.	SUB-STRUCTURE NO.	△ ASKEW ANGLE	DIRECTION OF SKEW	FIXED BEARING TYPE *	SOLE PLATE					MASONRY PLATE							ANCHOR BOLT		
					LENGTH (SPL)	WIDTH (SPW)	THICKNESS		CORNER CLIP (SPCLIP)	MPL1	LENGTH		WIDTH (MPW)	THICKNESS (MPT)	CORNER CLIP (MPCLIP)	KEEPER PLATE WIDTH (KPW)	KEEPER PLATE OFFSET (KPO)	OFFSET (BO)	LENGTH (BL)
							SPTA (UPSTATION)	SPTB (DOWNSTATION)			MPL2	MPL							
43N	ABUT. 1	44°42'11"	AHEAD RIGHT	AA	10 1/2"	24 1/2"	1"	1 1/4"	3/4"	5"	5 1/2"	10 1/2"	24 1/2"	7/8"	1/2"	14 1/2"	3"	9 3/4"	1'-11"
43S	ABUT. 2	45°05'18"	AHEAD RIGHT	BB	10"	22"	3/4"	1 1/8"	---	6 3/4"	7 1/4"	13"	22"	3/4"	---	12"	4 3/4"	8 1/2"	1'-11"
48N	ABUT. 1	68°34'38"	AHEAD LEFT	CC	13"	27 1/2"	7/8"	3/4"	---	5"	8 1/2"	11 1/2"	27 1/2"	1"	---	17 1/2"	4"	11 1/4"	1'-11"
48S	ABUT. 2	62°21'08"	AHEAD LEFT	CC	10"	27 1/2"	3/4"	3/4"	---	5"	8 1/2"	11 1/2"	27 1/2"	1"	---	17 1/2"	4"	11 1/4"	1'-11"
50N	ABUT. 1	44°11'07"	AHEAD RIGHT	AA	11"	26"	1 5/16"	1"	1 3/4"	5"	5 1/2"	10 1/2"	26"	1 1/8"	1 1/4"	14 1/2"	3"	10 1/2"	1'-11"
50S	ABUT. 2	45°44'11"	AHEAD RIGHT	AA	10"	26"	1 1/4"	1"	1 1/4"	5"	5 1/2"	10 1/2"	26"	1 1/8"	1 1/4"	14 1/2"	3"	10 1/2"	1'-11"
51N	ABUT. 1	90°00'00"	---	AA	10"	26"	1 1/8"	7/8"	---	5"	5 1/2"	10 1/2"	26"	1"	---	14 1/2"	3"	10 1/2"	1'-11"
51S	ABUT. 1	90°00'00"	---	AA	10 1/2"	28"	1 1/8"	7/8"	---	5"	5 1/2"	10 1/2"	26"	1"	---	14 1/2"	3"	10 1/2"	1'-11"
51N	PIER 2	90°00'00"	---	DD	14"	27 1/2"	1 5/16"	3/4"	---	6 3/4"	8 1/4"	15"	27 1/2"	1 1/8"	---	17 1/2"	5 3/4"	11 1/4"	1'-11"
51S	PIER 3	89°33'39"	AHEAD RIGHT	EE	13"	29 1/2"	1"	7/8"	---	6 1/4"	7 3/4"	14"	29 1/2"	1 1/8"	---	18 1/2"	5 1/4"	12 1/4"	2'-1"

\* SEE TABLE OF "FIXED BEARING TYPE DETAILS" BELOW

BRIDGE 51N AND 51S ARE NOT A PART OF THIS PROJECT.

### BEARING NOTES :

1. THESE NOTES ARE APPLICABLE FOR THE BEARINGS AND THEIR COMPONENTS SHOWN ON BRIDGE SHEETS C-21, C-23, C-24 AND C-25, IN ADDITION TO THIS SHEET.
2. SEE BRIDGE SHEET C-21 FOR FIXED BEARING DETAILS.  
SEE BRIDGE SHEET C-23 FOR EXPANSION BEARING DETAILS.  
SEE BRIDGE SHEET C-24 FOR EXPANSION BEARING TABLES.  
SEE BRIDGE SHEET C-25 FOR SOLE AND MASONRY PLATE DETAILS.
3. BEARING ASSEMBLIES, INCLUDING ELASTOMERIC PADS, ANCHOR BOLTS, INTERNAL STEEL PLATES, PTFE SHEET, STAINLESS STEEL PLATES, SOLE PLATES, MASONRY PLATES, PREFORMED FABRIC PADS, BOLTS, NUTS, WASHERS AND ALL WORK REQUIRED TO FABRICATE AND INSTALL BEARINGS TO BE PAID AS ITEM 531.0, "BEARING DEVICE ASSEMBLY".
4. THE FABRICATION, TESTING AND INSTALLATION OF THE BEARINGS SHALL BE IN ACCORDANCE WITH THE REQUIREMENTS OF THESE CONTRACT PLANS, THE STANDARD SPECIFICATIONS, AND THE AASHTO STANDARD SPECIFICATIONS FOR HIGHWAY BRIDGES DIVISION I- SECTION 14 AND DIVISION II- SECTION 18.
5. STEEL REINFORCED ELASTOMERIC BEARINGS WERE DESIGNED USING METHOD B IN AASHTO DIVISION I- SECTION 14.6.5.
6. ELASTOMER SHALL BE GRADE 4, 60 DUROMETER NEOPRENE CONFORMING TO AASHTO STANDARD SPECIFICATIONS FOR HIGHWAY BRIDGES, DIVISION II, SECTION 18. THE AVERAGE SHEAR MODULUS (G) FOR THE ELASTOMER SHALL BE 150 PSI, WITH AN ALLOWABLE RANGE OF 127.5 PSIT0 172.5 PSI.
7. SOLE, MASONRY AND KEEPER PLATES SHALL CONFORM TO AASHTO M270 GRADE 50. ALL OTHER STEEL SHALL BE AASHTO M270 GRADE 36, EXCEPT AS NOTED OTHERWISE. ANCHOR BOLTS, NUTS AND WASHERS FOR BEARINGS SHALL CONFORM TO SUBSECTION 714.08 OF THE SPECIFICATIONS, UNLESS NOTED OTHERWISE, ALL STEEL PLATES AND ALL STEEL COMPONENTS (ANCHOR BOLTS, HIGH-STRENGTH BOLTS, NUTS, WASHERS, ETC.) SHALL BE GALVANIZED OR METALIZED PER SUBSECTION 506.15 OF THE SPECIFICATIONS.
8. MINIMUM EMBEDMENT OF ALL ANCHOR BOLTS SHALL BE 1'-3".
9. THE 1/8" THICK PREFORMED FABRIC PAD BENEATH THE MASONRY PLATE SHALL HAVE THE SAME SIZE AND ANCHOR BOLT HOLE LAYOUT AS THE CORRESPONDING MASONRY PLATE.
10. IN ADDITION TO THE REQUIREMENTS OF SUBSECTION 531.03 OF THE SPECIFICATIONS, THE FABRICATOR OF BEARINGS FURNISHED UNDER THIS SECTION SHALL SUBMIT VULCANIZING PROCEDURES IN ACCORDANCE WITH SUBSECTIONS 105.03 AND 506.04.
11. THE DESIGN COEFFICIENT OF FRICTION BETWEEN THE PTFE AND THE STAINLESS STEEL SHALL NOT EXCEED 0.06 AT 900 PSICOMPRESSIVE LOADING.
12. BEARING HEIGHTS AND DIMENSIONS SHOWN ARE BEFORE APPLICATION OF LOADS.
13. THE CONTRACTOR SHALL ENSURE THAT THE HEAT FROM WELDING THE SOLE PLATE TO THE STRINGER DOES NOT DAMAGE THE ELASTOMERIC MATERIAL OR ANY PART OF THE BEARING.
14. THE 'A' DISTANCE IS THE SOLE PLATE ADJUSTMENT TO BE USED BEFORE DEAD LOADS ARE ADDED TO THE STRINGERS.

### FIXED BEARING TYPE DETAILS

FIXED BEARING TYPE	STEEL REINFORCED ELASTOMERIC BEARING PAD						
	LENGTH (EPL)	WIDTH (EPW)	THICKNESS (EPT)	COVER LAYER THICKNESS (CLT)	INTERNAL LAYER THICKNESS (ILT)	NO. OF INTERNAL ELASTOMER LAYERS	NO. OF INTERNAL STEEL PLATES
AA	5 1/2"	15 1/2"	2 5/8"	1/4"	3/8"	4	5
BB	9"	13"	3 1/8"	1/4"	1/2"	4	5
CC	7 1/2"	18 1/2"	3 1/8"	1/4"	1/2"	4	5
DD	11"	18 1/2"	2 7/8"	1/4"	5/8"	3	4
EE	10"	20 1/2"	5 1/8"	1/4"	5/8"	6	7

#### CONSTRUCTION NOTE:

CONCRETE SURFACES UNDER ALL BEARINGS SHALL BE LEVEL WITH A CONSTRUCTION TOLERANCE OF 0.005 RADIAN, EXCEPT FOR THE TOP OF THE PIERS AT BR 48N & 48S WHICH SHALL BE SLOPED TO MATCH THE C CONSTRUCTION GRADE WITH A TOLERANCE OF 0.005 RADIAN.

### STATE OF VERMONT AGENCY OF TRANSPORTATION


Town Of	MIDDLESEX-BOLTON	Bridge No.	
Highway No.	I-89	Log Sta.	
		Surv. Sta.	

#### BEARING NOTES & FIXED BRG. TABLES


Designed By	K.L. JAMES	Drawn By	N.J. HOYT
Checked By	Date	Bridge Design Supervisor	
	M.H. GALLO		J.P. HALSTEAD Date 10/99

PROJECT	MIDDLESEX-BOLTON	PROJECT NO.	IM-089-2(26)
TVGA CAD Drawing No.	127tbl.dgn	Date	10/99
Bridge Sheet No.	C-22	Sheet	22 of 307


**Hayashi Corporation**  
*Consulting Engineers*

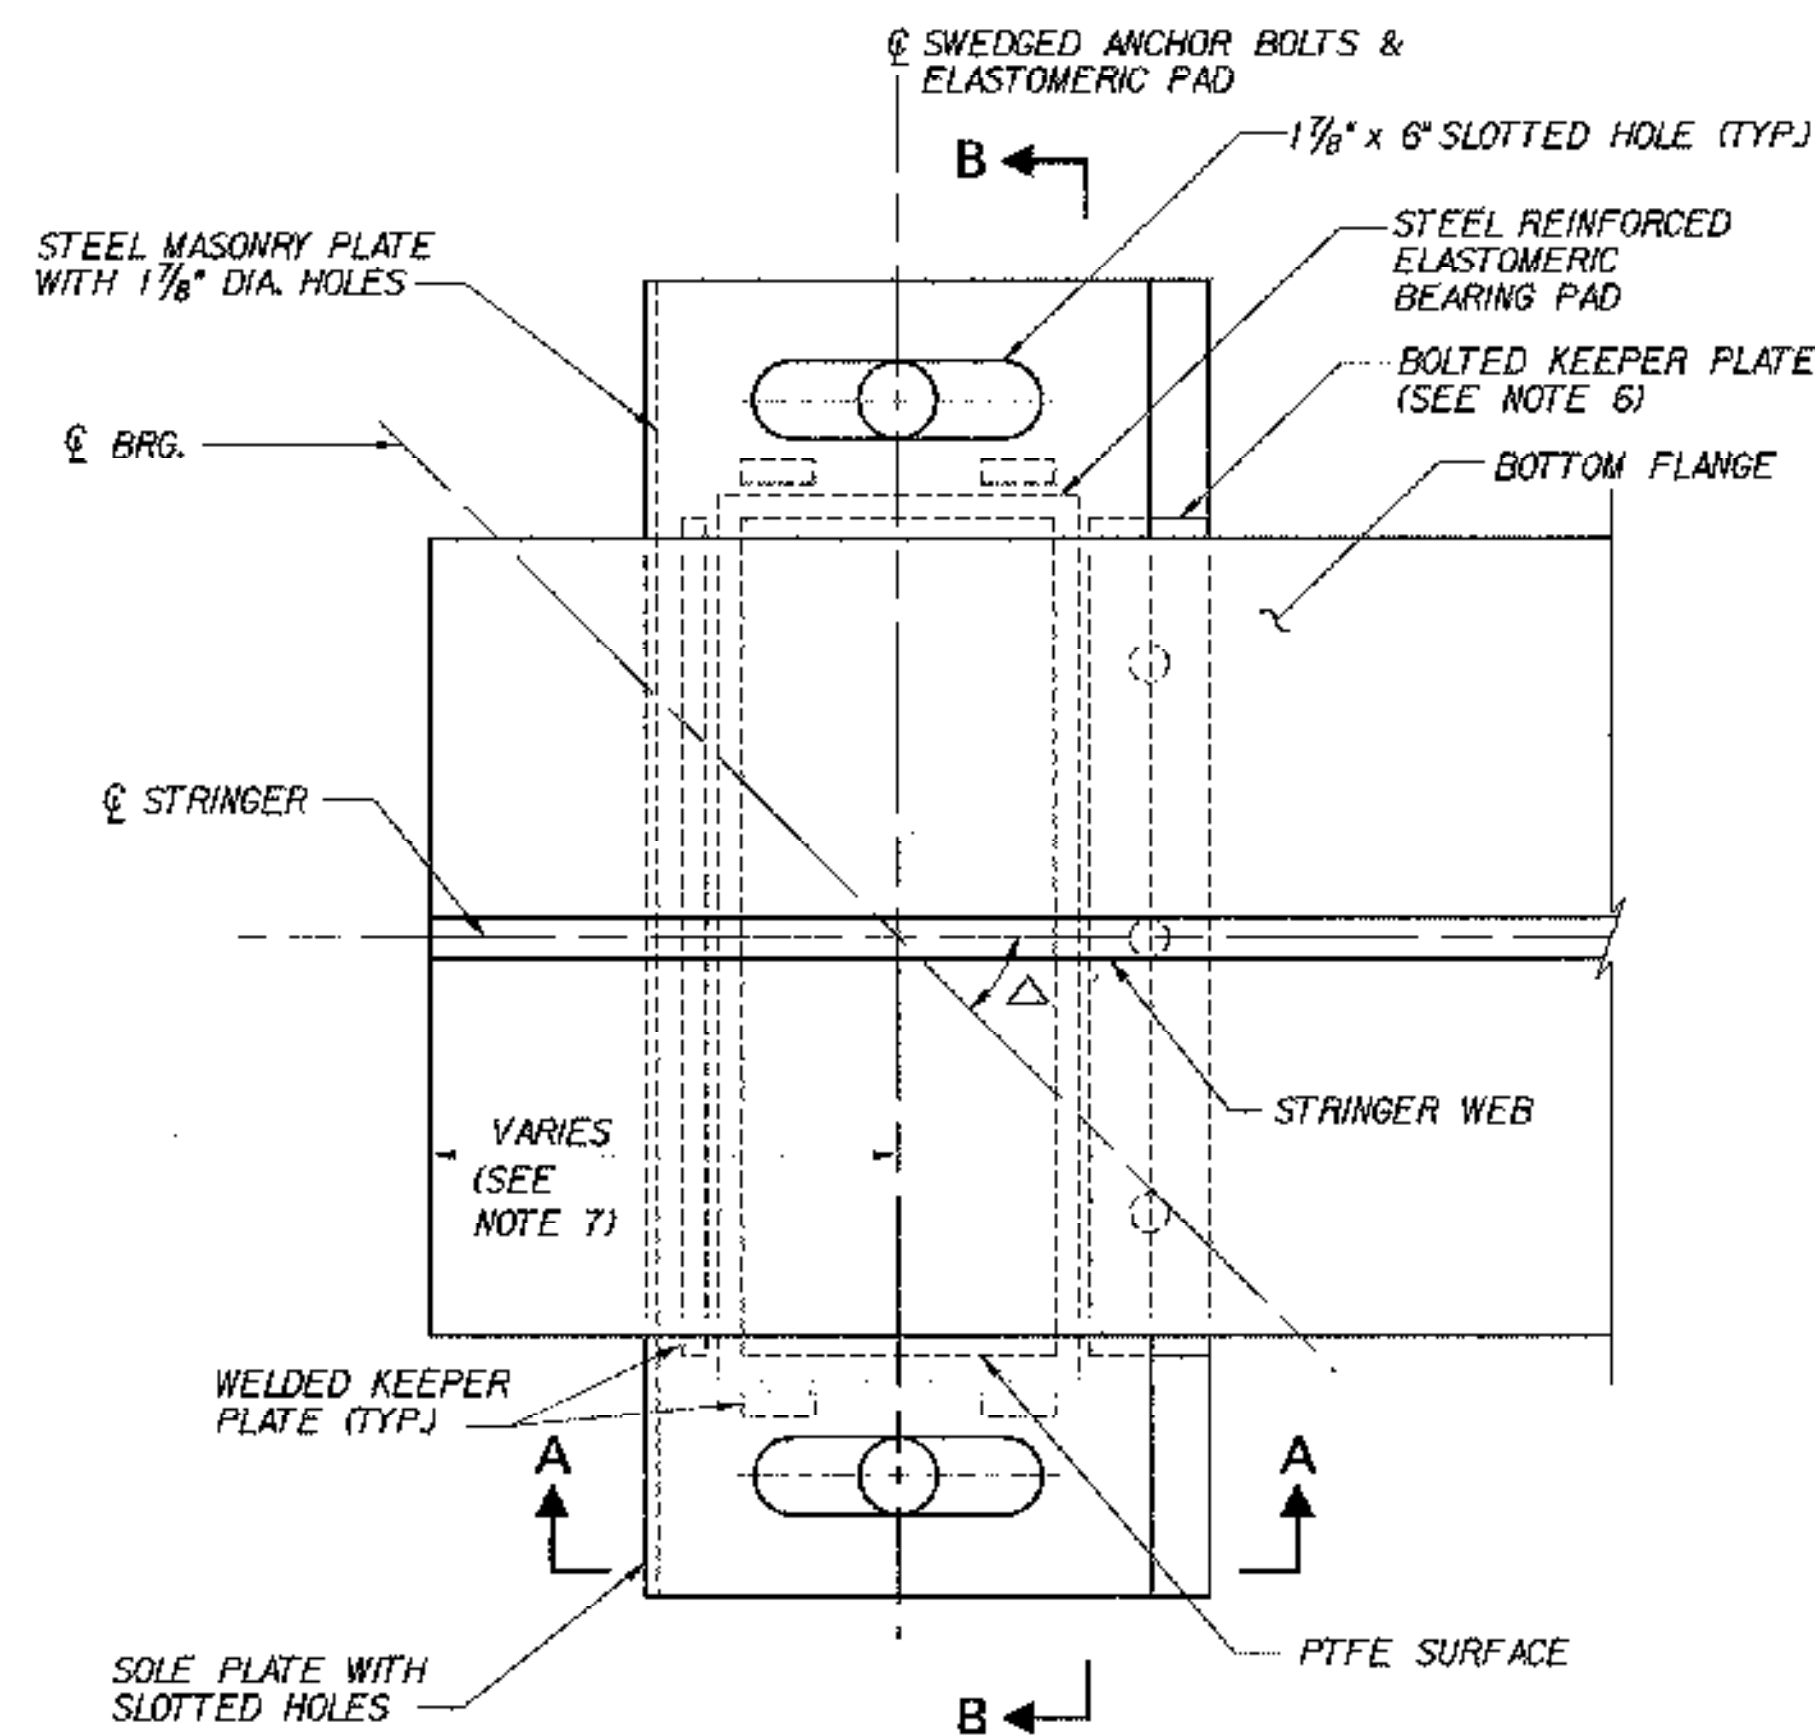


(ANCHOR BOLTS NOT SHOWN FOR CLARITY)  
**BEARING PLAN AT ABUTMENT**  
 NOT TO SCALE

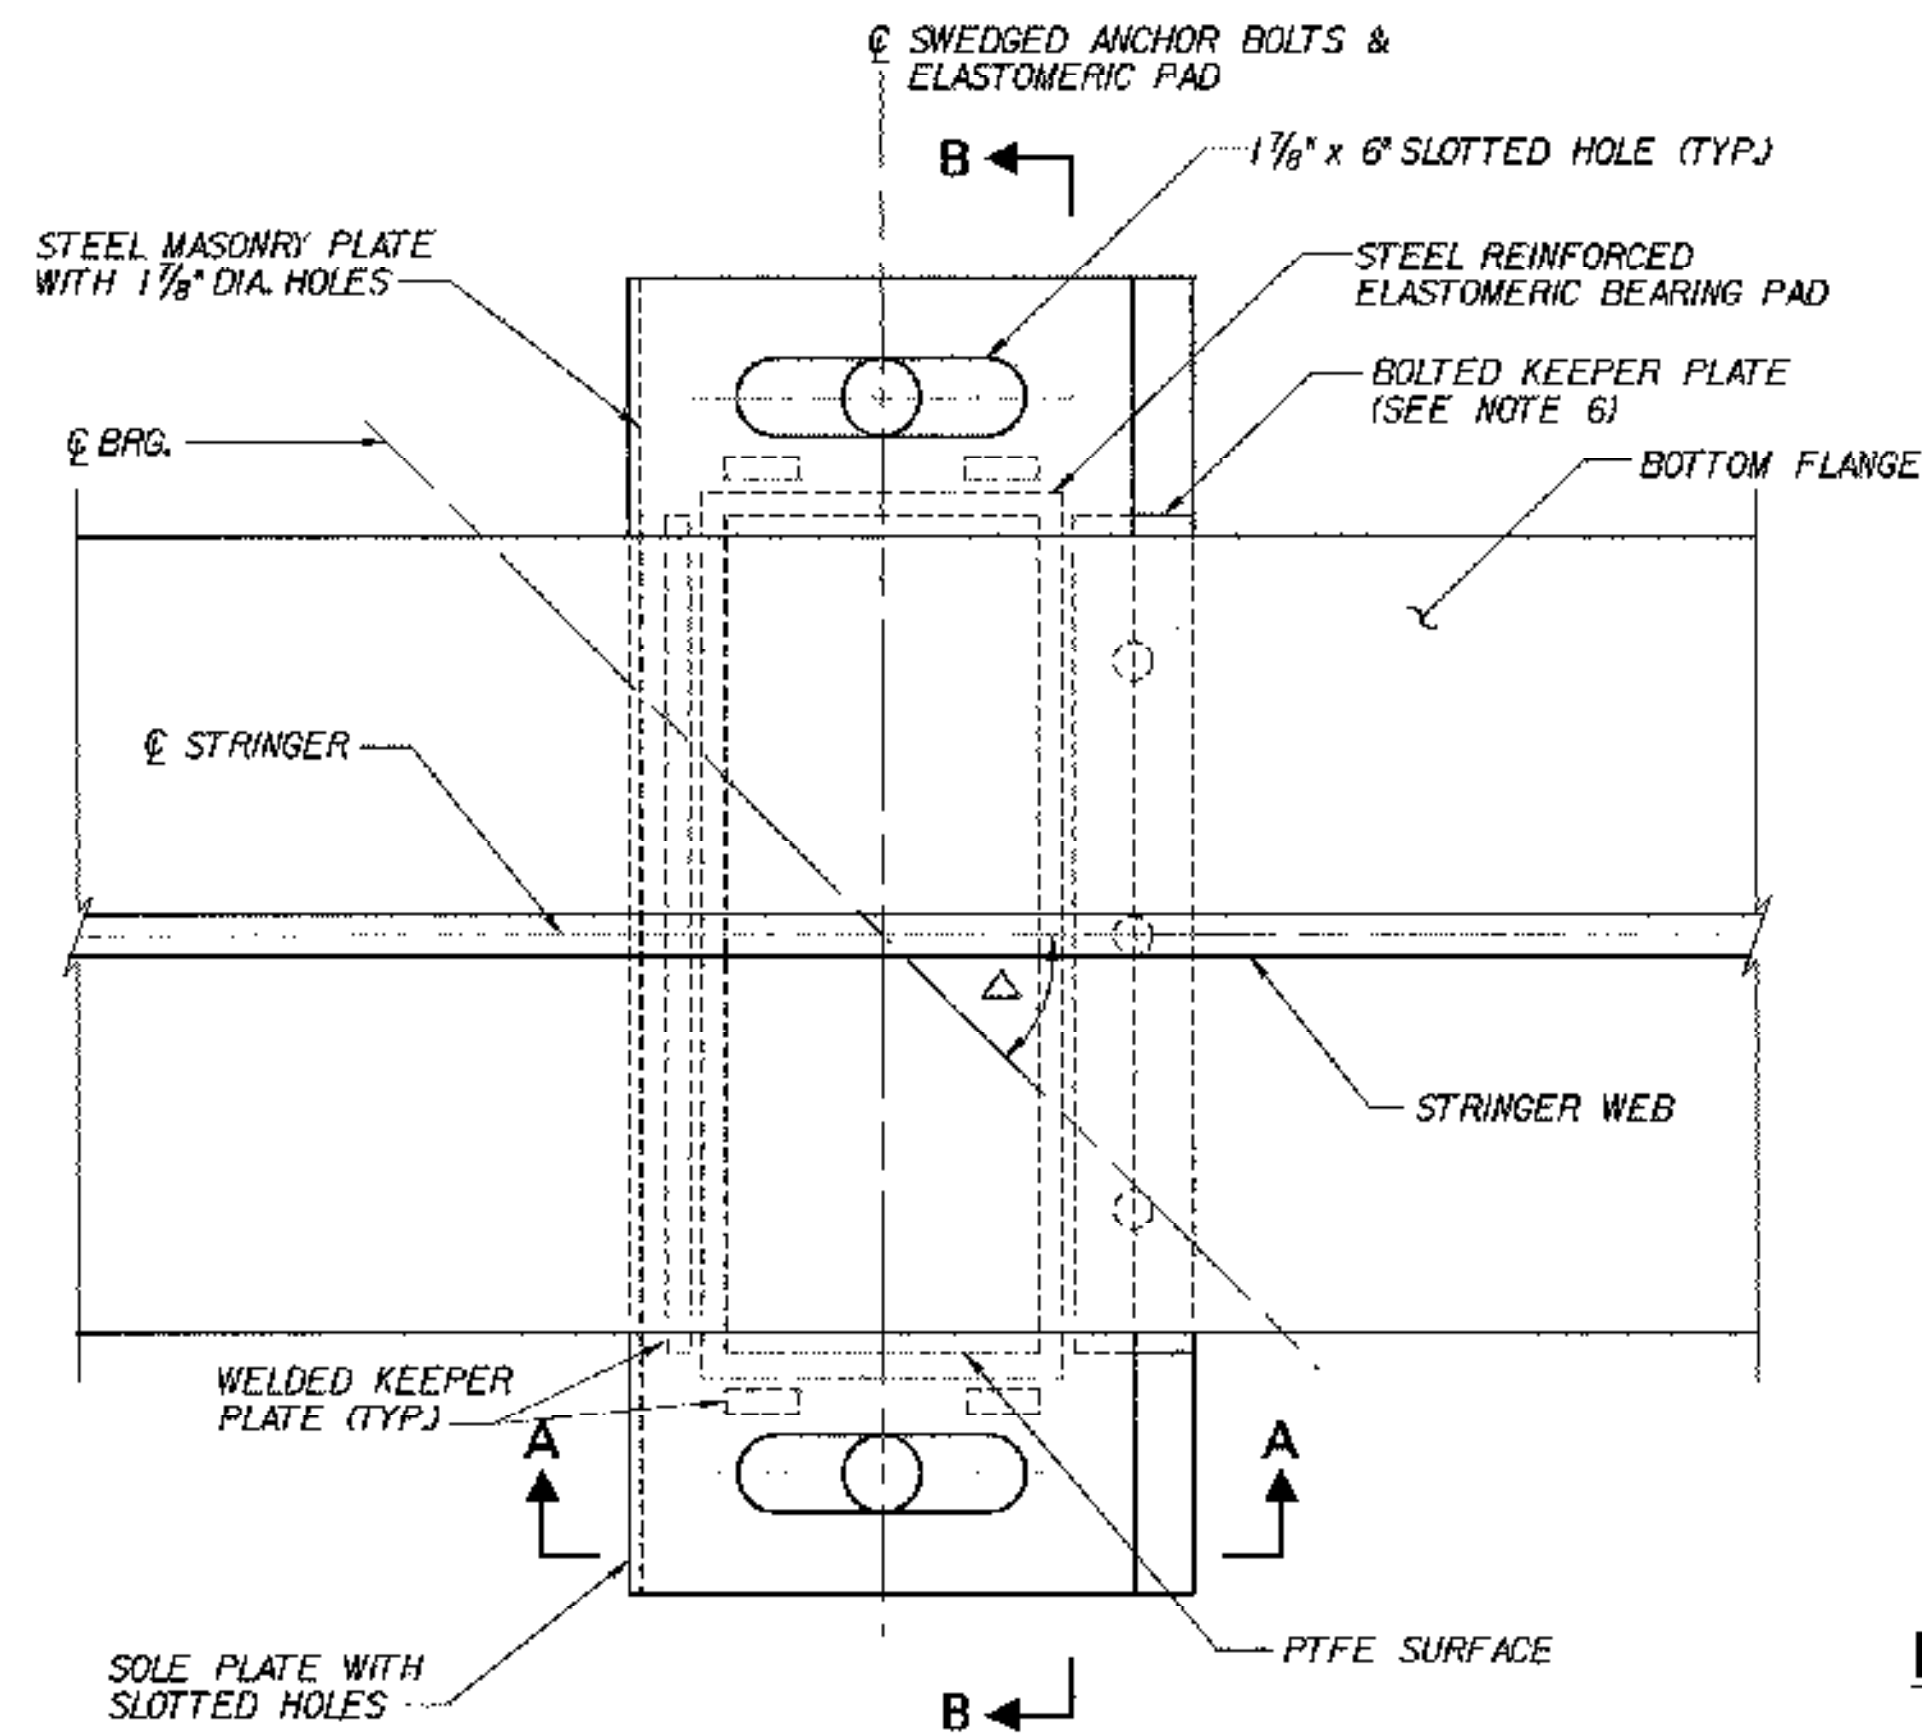

(ANCHOR BOLTS NOT SHOWN FOR CLARITY)  
**BEARING PLAN AT PIER**  
 NOT TO SCALE

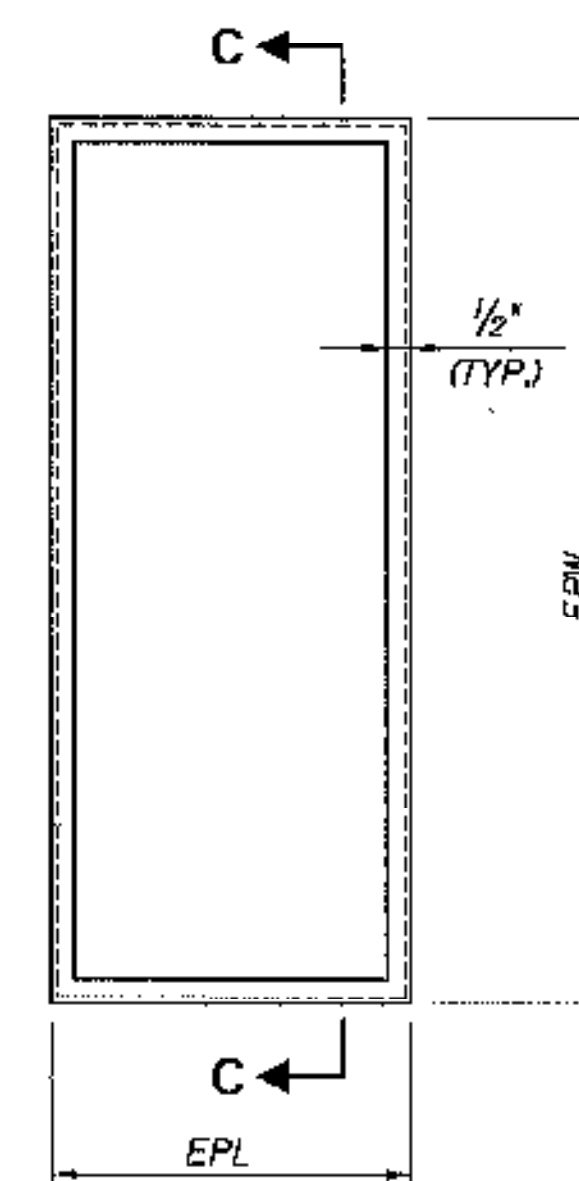

**STEEL REINFORCED ELASTOMERIC PAD PLAN WITH PTFE SURFACE**  
 NOT TO SCALE

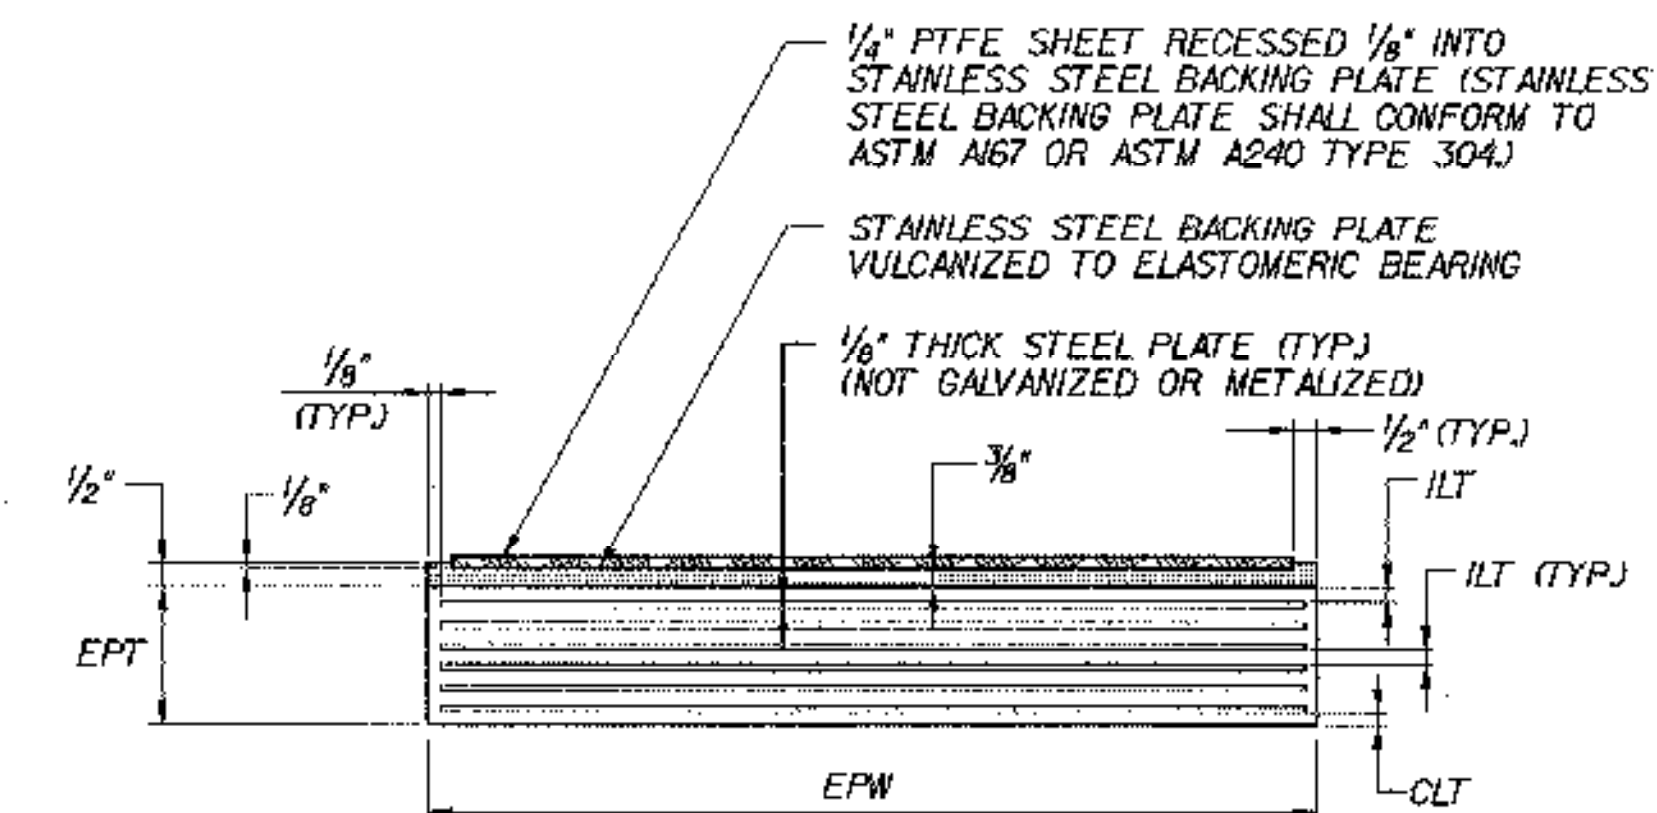


NOTE: NUMBER OF STEEL PLATES VARIES (SEE TABLE ON BRIDGE SHEET C-24)

**SECTION C-C**  
 NOT TO SCALE


**NOTES:**

- SEE BRIDGE SHEET C-22 FOR BEARING NOTES AND C-24 FOR EXPANSION BEARING TABLES.
- SEE BRIDGE SHEET C-25 FOR SOLE PLATE, MASONRY PLATE, AND KEEPER PLATE DETAILS.
- SKEW DIRECTION SHOWN IS "AHEAD RIGHT".
- BEARING STIFFENERS/DIAPHRAGM CONNECTION PLATES ARE NOT SHOWN FOR CLARITY.
- THE "A" DISTANCE, "SPTA" AND "WTA" DIMENSIONS SHALL BE MEASURED AND SET ON THE UPSTATION SIDE OF THE BEARING.
- AT ABUTMENT, MASONRY PLATE SHALL BE ORIENTED SO THAT THE BOLTED KEEPER PLATE IS ACCESSIBLE FROM THE FACE OF THE ABUTMENT TO ACCOMMODATE ELASTOMERIC PAD REMOVAL, IF REQUIRED IN THE FUTURE. AT PIER WITH ONE BEARING LINE, THE ENGINEER SHALL DETERMINE THE MASONRY PLATE ORIENTATION. AT PIER WITH TWO BEARING LINES (BR 51N PIER I AND BR 51S PIER I), THE MASONRY PLATE SHALL BE ORIENTED SO THAT THE BOLTED KEEPER PLATE IS ACCESSIBLE FROM THE PIER FACE NEAREST TO THE BEARING LINE.
- THE DISTANCE FROM C BEARING TO THE END OF THE STRINGER VARIES AT EACH BEARING LOCATION. FOR THIS DIMENSION AT BRIDGES 43, 48, 50 AND 51, SEE THE STRINGER ELEVATION FOR EACH BRIDGE. FOR THIS DIMENSION AT BRIDGE 49, SEE THE TRANSVERSE SECTION, BRIDGE SHEET BR49-4.

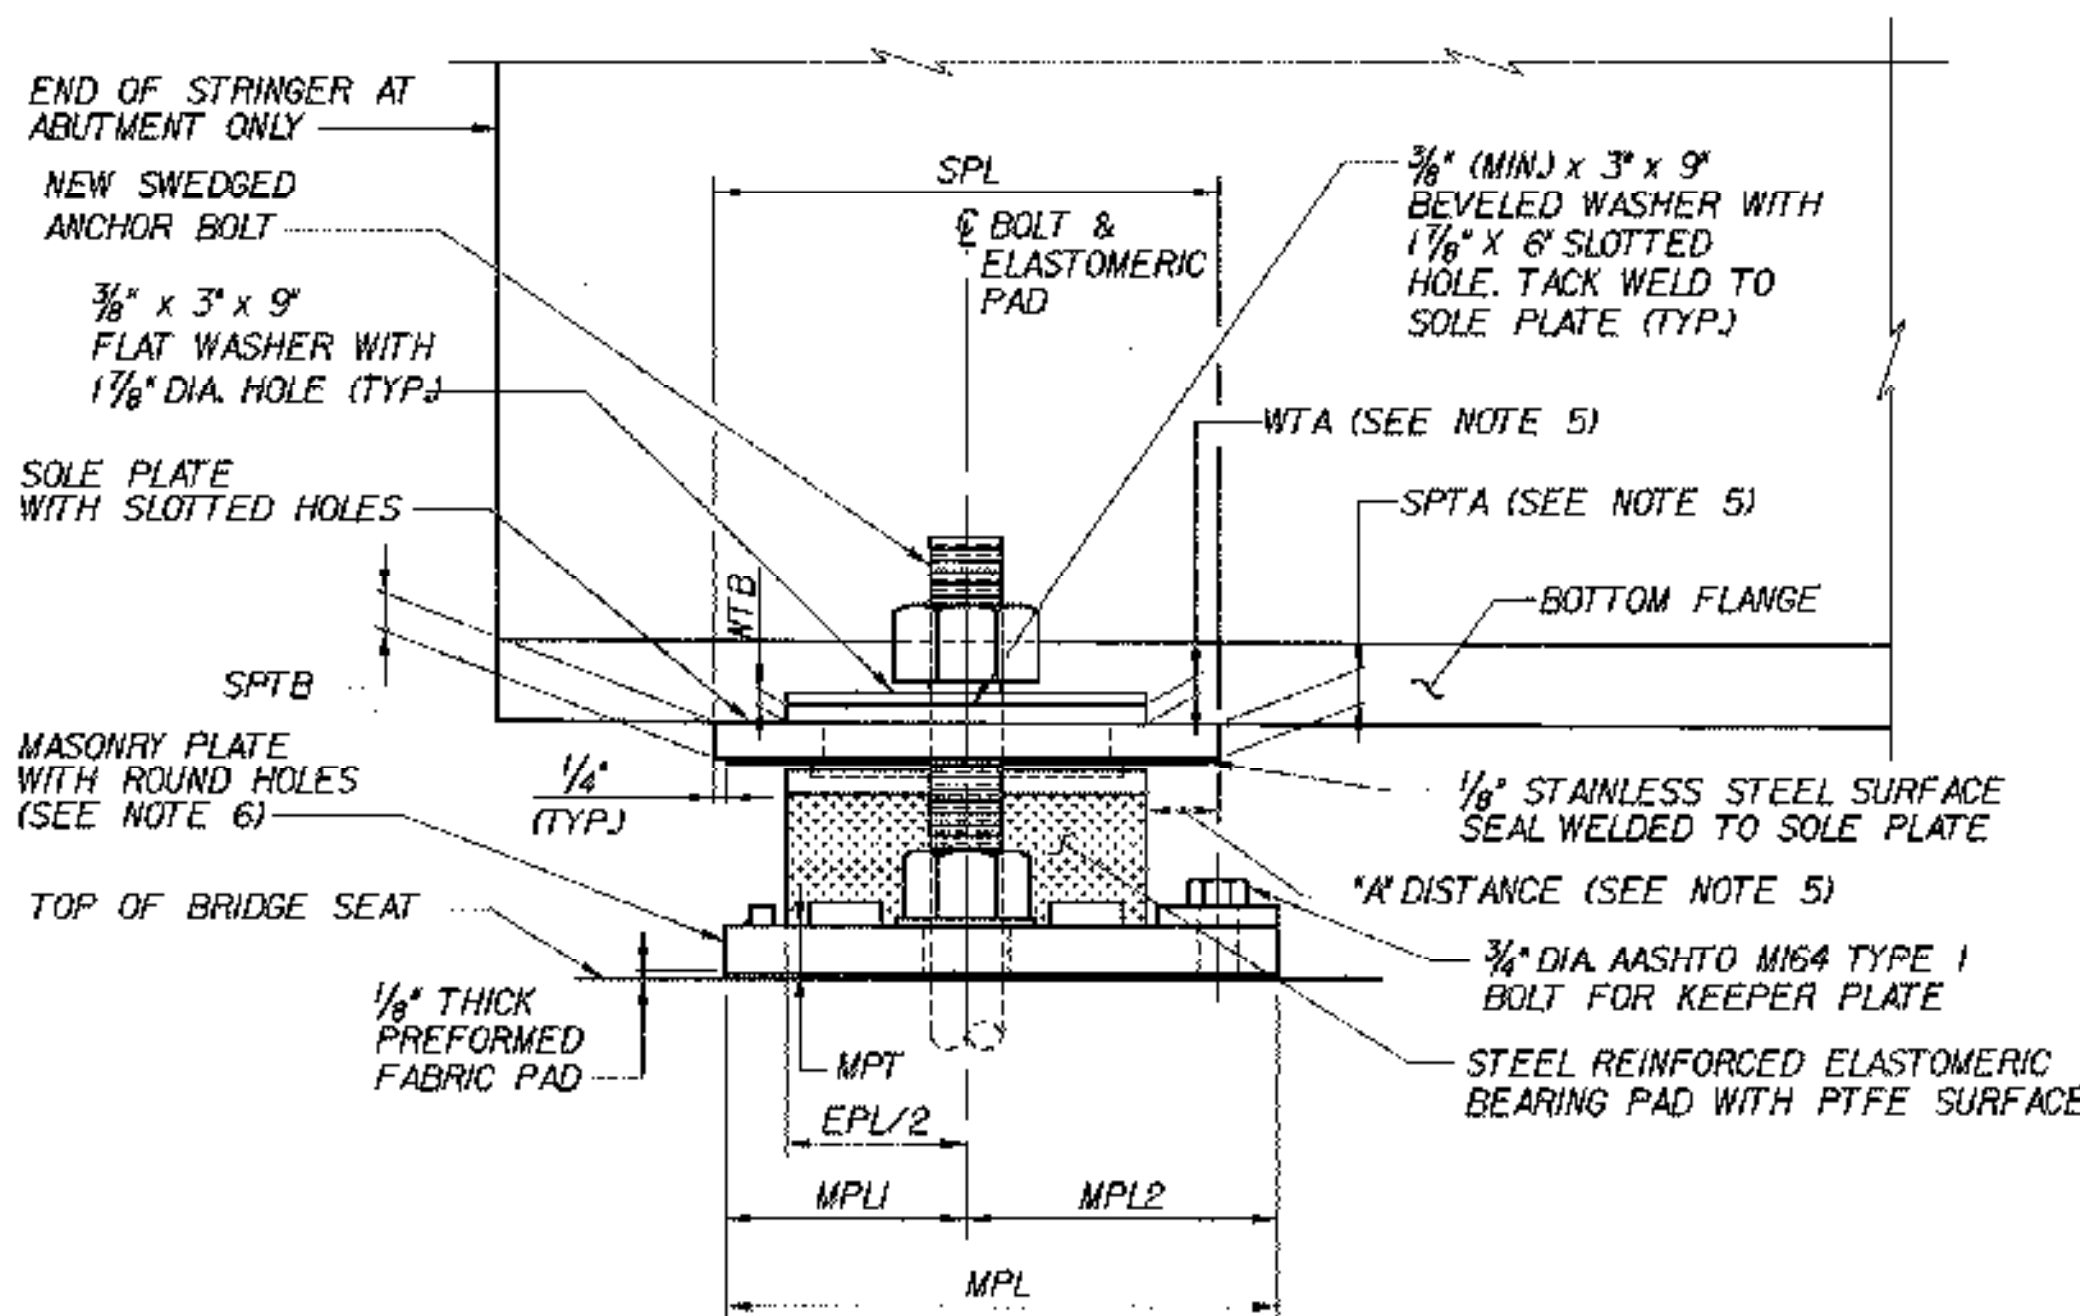

(BEARING AT ABUTMENT SHOWN, BEARING AT PIER SIMILAR)

**SECTION A-A**  
 NOT TO SCALE

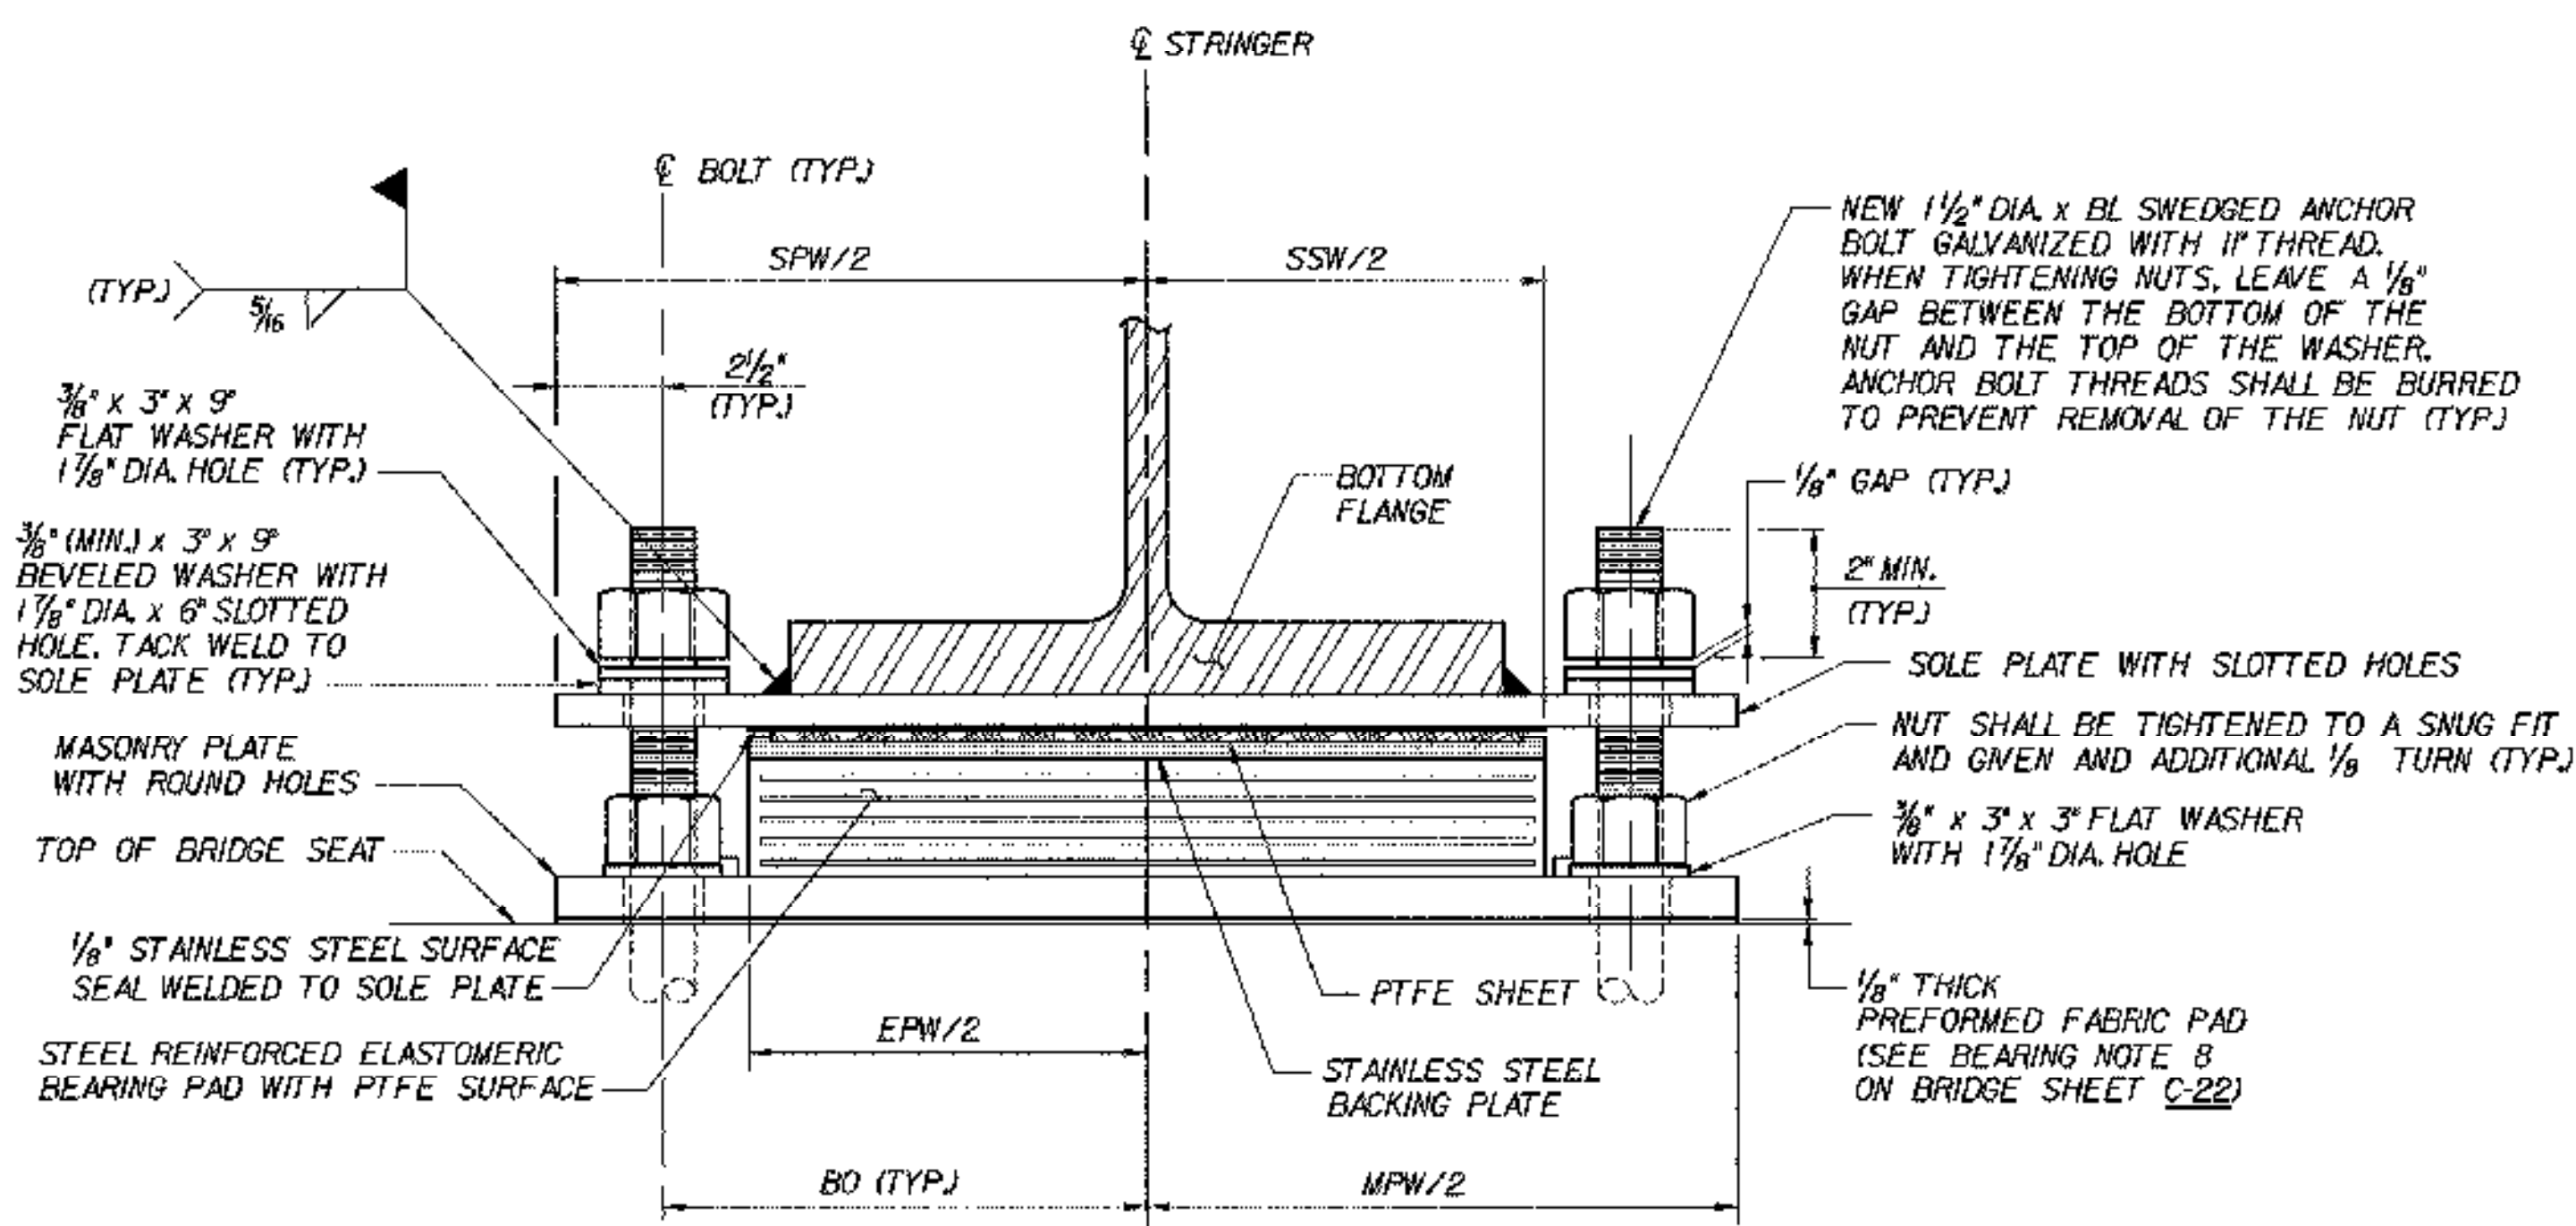

**SECTION B-B**  
 NOT TO SCALE

**Hayashi Corporation**  
 Consulting Engineers

**STATE OF VERMONT AGENCY OF TRANSPORTATION**

Town Of	MIDDLESEX-BOLTON	Bridge No.	
Highway No.	I-89	Log Sta.	
		Surv. Sta.	

**EXPANSION BEARING DETAILS**

Designed By	K.L. JAMES	Drawn By	N.J. HOYT
Checked By	Date	Bridge Design Supervisor	
M.H. GALLO	10/99	J.P. HALSTEAD	Date 10/99

PROJECT	MIDDLESEX-BOLTON	PROJECT NO.	IM-089-2(26)
TVGA CAD Drawing No.	12Texb2.dgn	Date	10/99
Bridge Sheet No.	C-23	Sheet	23 of 307

### EXPANSION BEARING GEOMETRY

BRIDGE NO.	SUB-STRUCTURE NO.	ASKEW ANGLE	DIRECTION OF SKEW	EXPANSION BEARING TYPE *	SOLE PLATE				STAINLESS STEEL		MASONRY PLATE					ANCHOR BOLT		BEVELED WASHER THICKNESS		"A" DISTANCE (UPSTATION SIDE OF BEARING)								
					LENGTH (SPL)	WIDTH (SPW)	THICKNESS		LENGTH (SSL)	WIDTH (SSW)	LENGTH			KEEPER PLATE WIDTH (KPW)	OFFSET (BO)	LENGTH (BL)	WTA (UPSTATION)	WTB (DOWNSTATION)	TEMPERATURE (F)									
							SPTA (UPSTATION)	SPTB (DOWNSTATION)			MPL1	MPL2	MPL						MPW	MPT	0	15	30	45	60	75	90	
<b>ABUTMENT BEARINGS</b>																												
43N	ABUT. 2	45°07'37"	AHEAD RIGHT	A	13 1/2"	22"	3/4"	1 1/4"	13"	13"	5 3/4"	7 1/4"	13"	22"	3/4"	12"	8 1/2"	2'-0"	1 1/16"	3/8"	1 5/8"	1 7/8"	2 1/16"	2 1/4"	2 7/16"	2 5/8"	2 7/8"	
43S	ABUT. 1	44°36'15"	AHEAD RIGHT	B	12"	26"	1"	1 3/16"	11 1/2"	17"	4 1/2"	6"	10 1/2"	26"	7/8"	16"	10 1/2"	2'-1"	1/2"	3/8"	3 7/16"	3 3/16"	3"	2 3/4"	2 1/2"	2 5/16"	2 1/16"	
49N	ABUT. 2	62°40'28"	AHEAD LEFT	C	12 1/2"	27 1/2"	3/4"	3/4"	12"	18 1/2"	5"	6 1/2"	11 1/2"	27 1/2"	1"	17 1/2"	11 1/4"	2'-0"	3/8"	3/8"	1 7/16"	1 13/16"	2 1/8"	2 1/2"	2 7/8"	3 3/16"	3 9/16"	
48S	ABUT. 1	88°20'14"	AHEAD LEFT	C	13"	27 1/2"	7/8"	3/4"	12 1/2"	18 1/2"	5"	6 1/2"	11 1/2"	27 1/2"	1"	17 1/2"	11 1/4"	2'-0"	3/8"	3/8"	3 13/16"	3 7/16"	3 1/8"	2 3/4"	2 3/8"	2 1/16"	1 11/16"	
49N	ABUT. 2	80°00'00"	---	C	10 1/2"	27 1/2"	3/4"	3/4"	10"	18 1/2"	5"	6 1/2"	11 1/2"	27 1/2"	1"	17 1/2"	11 1/4"	2'-0"	3/8"	3/8"	1 3/16"	1 1/4"	1 3/8"	1 1/2"	1 5/8"	1 3/4"	1 13/16"	
49S	ABUT. 2	80°00'00"	---	C	10 1/2"	27 1/2"	3/4"	3/4"	10"	18 1/2"	5"	6 1/2"	11 1/2"	27 1/2"	1"	17 1/2"	11 1/4"	2'-0"	3/8"	3/8"	1 3/16"	1 1/4"	1 3/8"	1 1/2"	1 5/8"	1 3/4"	1 13/16"	
50N	ABUT. 2	46°29'48"	AHEAD RIGHT	B	13"	26"	1 1/4"	1"	12 1/2"	17"	4 1/2"	6"	10 1/2"	26"	7/8"	16"	10 1/2"	2'-1"	3/8"	9/16"	2 7/16"	2 11/16"	3"	3 1/4"	3 1/2"	3 13/16"	4 1/16"	
50S	ABUT. 1	43°31'43"	AHEAD RIGHT	B	12 1/2"	26"	1 7/16"	1"	12"	17"	4 1/2"	6"	10 1/2"	26"	7/8"	16"	10 1/2"	2'-1"	3/8"	11/16"	3 3/4"	3 1/2"	3 1/4"	3"	2 3/4"	2 1/2"	2 1/4"	
<del>51N</del>	<del>ABUT. 2</del>	<del>43°40'33"</del>	<del>AHEAD LEFT</del>	<del>G</del>	<del>11"</del>	<del>26"</del>	<del>3/4"</del>	<del>3/4"</del>	<del>10 1/2"</del>	<del>16 1/2"</del>	<del>4 1/2"</del>	<del>6"</del>	<del>10 1/2"</del>	<del>26"</del>	<del>7/8"</del>	<del>15 1/2"</del>	<del>10 1/2"</del>	<del>1'-11"</del>	<del>3/8"</del>	<del>3/8"</del>	<del>1 3/8"</del>	<del>1 11/16"</del>	<del>1 15/16"</del>	<del>2 1/4"</del>	<del>2 9/16"</del>	<del>2 13/16"</del>	<del>3 1/8"</del>	
<del>51S</del>	<del>ABUT. 2</del>	<del>43°08'46"</del>	<del>AHEAD LEFT</del>	<del>G</del>	<del>11"</del>	<del>26"</del>	<del>3/4"</del>	<del>3/4"</del>	<del>10 1/2"</del>	<del>16 1/2"</del>	<del>4 1/2"</del>	<del>6"</del>	<del>10 1/2"</del>	<del>26"</del>	<del>7/8"</del>	<del>15 1/2"</del>	<del>10 1/2"</del>	<del>1'-11"</del>	<del>3/8"</del>	<del>3/8"</del>	<del>1 3/8"</del>	<del>1 11/16"</del>	<del>1 15/16"</del>	<del>2 1/4"</del>	<del>2 9/16"</del>	<del>2 13/16"</del>	<del>3 1/8"</del>	
<b>PIER BEARINGS</b>																												
43N	PIER 1	44°50'07"	AHEAD RIGHT	D	12 1/2"	23"	3/4"	1 1/8"	12"	14"	8 1/4"	7 3/4"	14"	23"	1 1/8"	13"	9"	2'-0"	5/8"	3/8"	1 1/16"	1 1/8"	1 3/16"	1 1/4"	1 5/16"	1 3/8"	1 7/16"	
43N	PIER 2	45°01'13"	AHEAD RIGHT	D	13"	23"	3/4"	1 1/8"	12 1/2"	14"	8 1/4"	7 3/4"	14"	23"	1 1/8"	13"	9"	2'-0"	5/8"	3/8"	1 1/16"	1 3/16"	1 3/8"	1 1/2"	1 5/8"	1 13/16"	1 15/16"	
43S	PIER 1	44°46'15"	AHEAD RIGHT	E	13 1/2"	27 1/2"	3/4"	1 1/16"	13"	18 1/2"	5 3/4"	7 1/4"	13"	27 1/2"	1 1/4"	17 1/2"	11 1/4"	2'-0"	9/16"	3/8"	2 11/16"	2 9/16"	2 3/8"	2 1/4"	2 1/8"	1 15/16"	1 13/16"	
43S	PIER 2	44°58'53"	AHEAD RIGHT	D	13 1/2"	23"	3/4"	1 1/8"	13"	14"	8 1/4"	7 3/4"	14"	23"	1 1/8"	13"	9"	2'-0"	5/8"	3/8"	1 7/8"	1 7/8"	1 13/16"	1 3/4"	1 11/16"	1 5/8"	1 5/8"	
48N	PIER 1	85°16'48"	AHEAD LEFT	F	14 1/2"	27 1/2"	3/4"	3/4"	14"	18 1/2"	7"	8 1/2"	15 1/2"	27 1/2"	1"	17 1/2"	11 1/4"	1'-11"	3/8"	3/8"	1 1/8"	1 1/4"	1 3/8"	1 1/2"	1 5/8"	1 3/4"	1 7/8"	
48N	PIER 2	63°58'14"	AHEAD LEFT	F	15 1/2"	27 1/2"	3/4"	3/4"	15"	18 1/2"	7"	8 1/2"	15 1/2"	27 1/2"	1"	17 1/2"	11 1/4"	1'-11"	3/8"	3/8"	1 5/16"	1 9/16"	1 3/4"	2"	2 1/4"	2 7/16"	2 11/16"	
48S	PIER 1	85°00'45"	AHEAD LEFT	F	15 1/2"	27 1/2"	3/4"	3/4"	15"	18 1/2"	7"	8 1/2"	15 1/2"	27 1/2"	1"	17 1/2"	11 1/4"	1'-11"	3/8"	3/8"	2 11/16"	2 7/16"	2 1/4"	2"	1 3/4"	1 9/16"	1 5/16"	
48S	PIER 2	63°58'14"	AHEAD LEFT	F	14 1/2"	27 1/2"	3/4"	3/4"	14"	18 1/2"	7"	8 1/2"	15 1/2"	27 1/2"	1"	17 1/2"	11 1/4"	1'-11"	3/8"	3/8"	1 7/8"	1 3/4"	1 5/8"	1 1/2"	1 3/8"	1 1/4"	1 1/8"	
50N	PIER 1	44°50'40"	AHEAD RIGHT	E	13"	27 1/2"	1 1/16"	3/4"	12 1/2"	18 1/2"	5 3/4"	7 1/4"	13"	27 1/2"	1 1/4"	17 1/2"	11 1/4"	2'-0"	3/8"	9/16"	1 3/4"	1 7/8"	1 15/16"	2"	2 1/16"	2 1/8"	2 1/4"	
50N	PIER 2	45°48'12"	AHEAD RIGHT	E	13"	27 1/2"	1 1/16"	3/4"	12 1/2"	18 1/2"	5 3/4"	7 1/4"	13"	27 1/2"	1 1/4"	17 1/2"	11 1/4"	2'-0"	3/8"	9/16"	1 7/16"	1 5/8"	1 13/16"	2"	2 3/16"	2 3/8"	2 9/16"	
50S	PIER 1	44°11'11"	AHEAD RIGHT	E	12 1/2"	27 1/2"	1 1/8"	3/4"	12"	18 1/2"	5 3/4"	7 1/4"	13"	27 1/2"	1 1/4"	17 1/2"	11 1/4"	2'-0"	3/8"	5/8"	2 5/16"	2 1/8"	1 15/16"	1 3/4"	1 9/16"	1 3/8"	1 3/16"	
50S	PIER 2	45°05'50"	AHEAD RIGHT	E	12 1/2"	27 1/2"	1 1/8"	3/4"	12"	18 1/2"	5 3/4"	7 1/4"	13"	27 1/2"	1 1/4"	17 1/2"	11 1/4"	2'-0"	3/8"	5/8"	2"	1 7/8"	1 13/16"	1 3/4"	1 11/16"	1 5/8"	1 1/2"	
<del>51N</del>	<del>PIER 1(S1)</del>	<del>90°00'00"</del>	<del>---</del>	<del>H</del>	<del>9"</del>	<del>26"</del>	<del>3/4"</del>	<del>3/4"</del>	<del>8 1/2"</del>	<del>16"</del>	<del>4 1/2"</del>	<del>6"</del>	<del>10 1/2"</del>	<del>26"</del>	<del>7/8"</del>	<del>15"</del>	<del>10 1/2"</del>	<del>2'-0"</del>	<del>3/8"</del>	<del>3/8"</del>	<del>1 1/8"</del>	<del>1 3/16"</del>	<del>1 3/16"</del>	<del>1 1/4"</del>	<del>1 5/16"</del>	<del>1 5/16"</del>	<del>1 3/8"</del>	
<del>51N</del>	<del>PIER 1(S2)</del>	<del>90°00'00"</del>	<del>---</del>	<del>J</del>	<del>9 1/2"</del>	<del>26"</del>	<del>15/16"</del>	<del>3/4"</del>	<del>9"</del>	<del>20"</del>	<del>4 3/4"</del>	<del>8 1/4"</del>	<del>11"</del>	<del>29"</del>	<del>7/8"</del>	<del>19"</del>	<del>12"</del>	<del>1'-11"</del>	<del>3/8"</del>	<del>3/8"</del>	<del>1 9/16"</del>	<del>1 9/16"</del>	<del>1 7/16"</del>	<del>1 3/8"</del>	<del>1 1/4"</del>	<del>1 1/8"</del>	<del>1 1/16"</del>	<del>0 15/16"</del>
<del>51N</del>	<del>PIER 3</del>	<del>44°34'50"</del>	<del>AHEAD LEFT</del>	<del>K</del>	<del>13 1/2"</del>	<del>27 1/2"</del>	<del>7/8"</del>	<del>3/4"</del>	<del>13"</del>	<del>18 1/2"</del>	<del>6 3/4"</del>	<del>8 1/4"</del>	<del>15"</del>	<del>27 1/2"</del>	<del>1 1/8"</del>	<del>17 1/2"</del>	<del>11 1/4"</del>	<del>2'-0"</del>	<del>3/8"</del>	<del>3/8"</del>	<del>0 7/8"</del>	<del>1"</del>	<del>1 1/8"</del>	<del>1 1/4"</del>	<del>1 3/8"</del>	<del>1 1/2"</del>	<del>1 5/8"</del>	
<del>51N</del>	<del>PIER 4</del>	<del>43°59'35"</del>	<del>AHEAD LEFT</del>	<del>L</del>	<del>14"</del>	<del>29 1/2"</del>	<del>7/8"</del>	<del>7/8"</del>	<del>13 1/2"</del>	<del>20 1/2"</del>	<del>6 1/4"</del>	<del>7 3/4"</del>	<del>14"</del>	<del>29 1/2"</del>	<del>1 1/8"</del>	<del>19 1/2"</del>	<del>12 1/4"</del>	<del>2'-2"</del>	<del>3/8"</del>	<del>3/8"</del>	<del>1 5/16"</del>	<del>1 9/16"</del>	<del>1 3/4"</del>	<del>2"</del>	<del>2 1/4"</del>	<del>2 7/16"</del>	<del>2 11/16"</del>	
<del>51S</del>	<del>PIER 1(S1)</del>	<del>90°00'00"</del>	<del>---</del>	<del>H</del>	<del>9"</del>	<del>26"</del>	<del>3/4"</del>	<del>3/4"</del>	<del>8 1/2"</del>	<del>16"</del>	<del>4 1/2"</del>	<del>6"</del>	<del>10 1/2"</del>	<del>26"</del>	<del>7/8"</del>	<del>15"</del>	<del>10 1/2"</del>	<del>2'-0"</del>	<del>3/8"</del>	<del>3/8"</del>	<del>1 1/8"</del>	<del>1 3/16"</del>	<del>1 3/16"</del>	<del>1 1/4"</del>	<del>1 5/16"</del>	<del>1 5/16"</del>	<del>1 3/8"</del>	
<del>51S</del>	<del>PIER 1(S2)</del>	<del>90°00'00"</del>	<del>---</del>	<del>J</del>	<del>10 1/2"</del>	<del>26"</del>	<del>15/16"</del>	<del>3/4"</del>	<del>10"</del>	<del>20"</del>	<del>4 3/4"</del>	<del>8 1/4"</del>	<del>11"</del>	<del>29"</del>	<del>7/8"</del>	<del>19"</del>	<del>12"</del>	<del>1'-11"</del>	<del>3/8"</del>	<del>3/8"</del>	<del>2 3/8"</del>	<del>2 3/16"</del>	<del>1 15/16"</del>	<del>1 3/4"</del>	<del>1 9/16"</del>	<del>1 5/16"</del>	<del>1 1/8"</del>	
<del>51S</del>	<del>PIER 2</del>	<del>90°00'00"</del>	<del>---</del>	<del>K</del>	<del>14 1/2"</del>	<del>27 1/2"</del>	<del>15/16"</del>	<del>3/4"</del>	<del>14"</del>	<del>18 1/2"</del>	<del>6 3/4"</del>	<del>8 1/4"</del>	<del>15"</del>	<del>27 1/2"</del>	<del>1 1/8"</del>	<del>17 1/2"</del>	<del>11 1/4"</del>	<del>2'-0"</del>	<del>3/8"</del>	<del>1/2"</del>	<del>2 1/16"</del>	<del>1 5/16"</del>	<del>1 7/8"</del>	<del>1 3/4"</del>	<del>1 5/8"</del>	<del>1 9/16"</del>	<del>1 7/16"</del>	
\* SEE TABLE OF "EXPANSION BEARING TYPE DETAILS" BELOW


\*\* THE "A" DISTANCES FOR THESE BEARINGS ARE FOR STRINGER 1 ONLY. SEE "BR 51 SUPPLEMENTARY "A" DISTANCE TABLE" FOR OTHER STRINGERS.

(S1) - SPAN 1  
(S2) - SPAN 2


BRIDGE 51N AND 51S ARE NOT PART OF THIS PROJECT

EXPANSION BEARING TYPE DETAILS							
EXPANSION BEARING TYPE	STEEL REINFORCED ELASTOMERIC PAD WITH PTFE SURFACE						
	LENGTH (EPL)	WIDTH (EPW)	THICKNESS (EPT)	COVER LAYER THICKNESS (CLT)	INTERNAL LAYER THICKNESS (ILT)	NUMBER OF INTERNAL ELASTOMER LAYERS	NUMBER OF INTERNAL STEEL PLATES
A	9"	13"	2 3/4"	1/4"	1/2"	4	4
B	6 1/2"	17"	3 3/4"	1/4"	3/8"	7	7
C	7 1/2"	18 1/2"	2 3/4"	1/4"	1/2"	4	4
D	10"	14"	2 3/4"	1/4"	1/2"	4	4
E	9"	18 1/2"	2 3/4"	1/4"	1/2"	4	4
F	11 1/2"	18 1/2"	2 1/2"	1/4"	5/8"	3	3
G	8 1/2"	16 1/2"	2 1/4"	1/4"	3/8"	4	4
H	8 1/2"	16"	3 1/4"	1/4"	3/8"	6	6
J	7"	20"	2 1/8"	1/4"	1/2"	3	3
K	11"	18 1/2"	2 1/2"	1/4"	5/8"	3	3
L	10"	20 1/2"	4 3/4"	1/4"	5/8"	6	6


BR 51 SUPPLEMENTARY "A" DISTANCE TABLE									
BRIDGE NO.	SUB-STRUCTURE NO.	STRINGER NO.	"A" DISTANCE (UPSTATION SIDE OF BEARING)						
			TEMPERATURE (F)						
			0	15	30	45	60	75	90
51N	ABUT. 2	2	1 3/8"	1 11/16"	1 15/16"	2 1/4"	2 9/16"	2 13/16"	3 1/8"
		3 & 4	1 7/16"	1 11/16"	2"	2 1/4"	2 1/2"	2 13/16"	3 1/16"
		5	1 1/2"	1 3/4"	2"	2 1/4"	2 1/2"	2 3/4"	3"
51S	ABUT. 2	2	1 3/8"	1 11/16"	1 15/16"	2 1/4"	2 9/16"	2 13/16"	3 1/8"
		3 & 4	1 7/16"	1 11/16"	2"	2 1/4"	2 1/2"	2 13/16"	3 1/16"
		5	1 1/2"	1 3/4"	2"	2 1/4"	2 1/2"	2 3/4"	3"
51N	PIER 3	2 & 3	0 15/16"	1 1/16"	1 1/8"	1 1/4"	1 3/8"	1 7/16"	1 9/16"
		4 & 5	1"	1 1/16"	1 3/16"</				

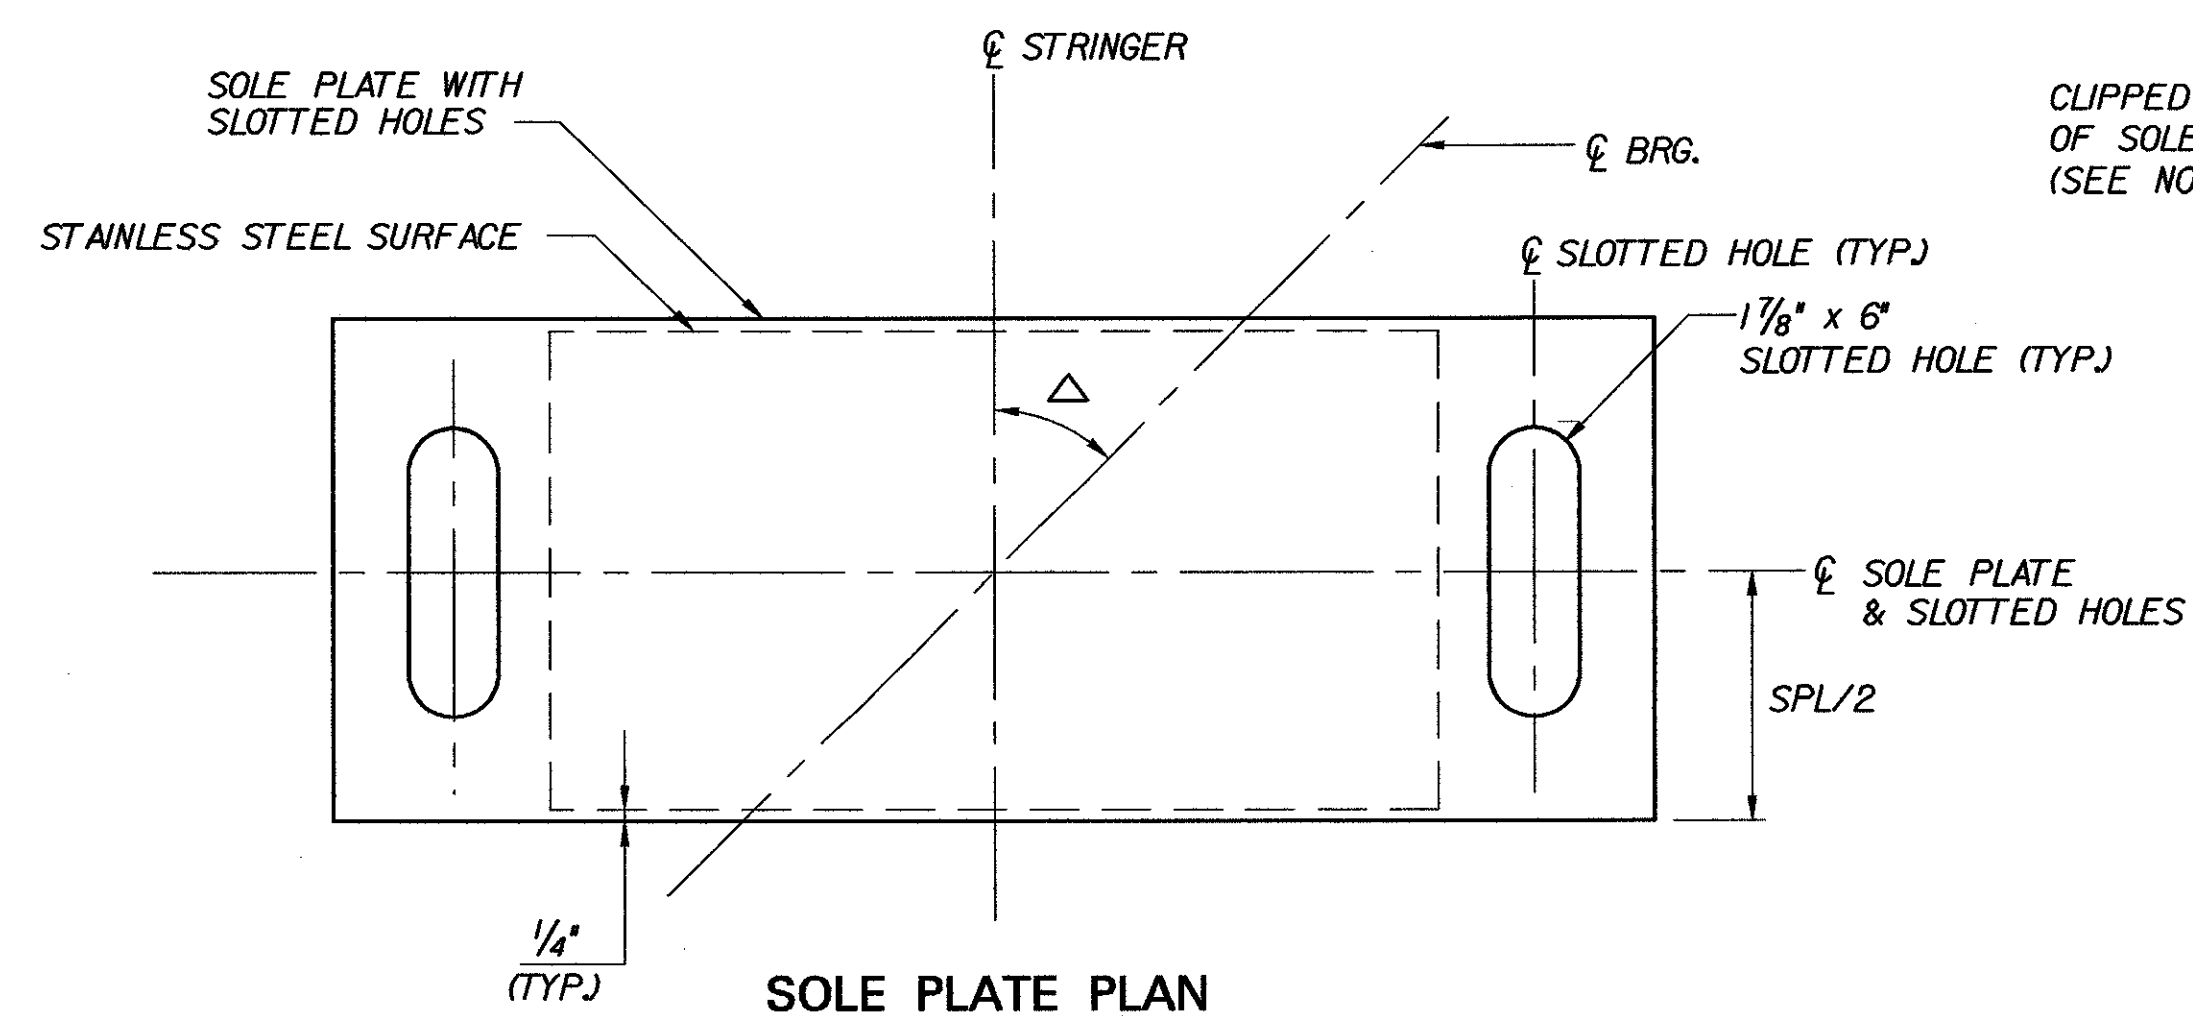


SOLE PLATE PLAN

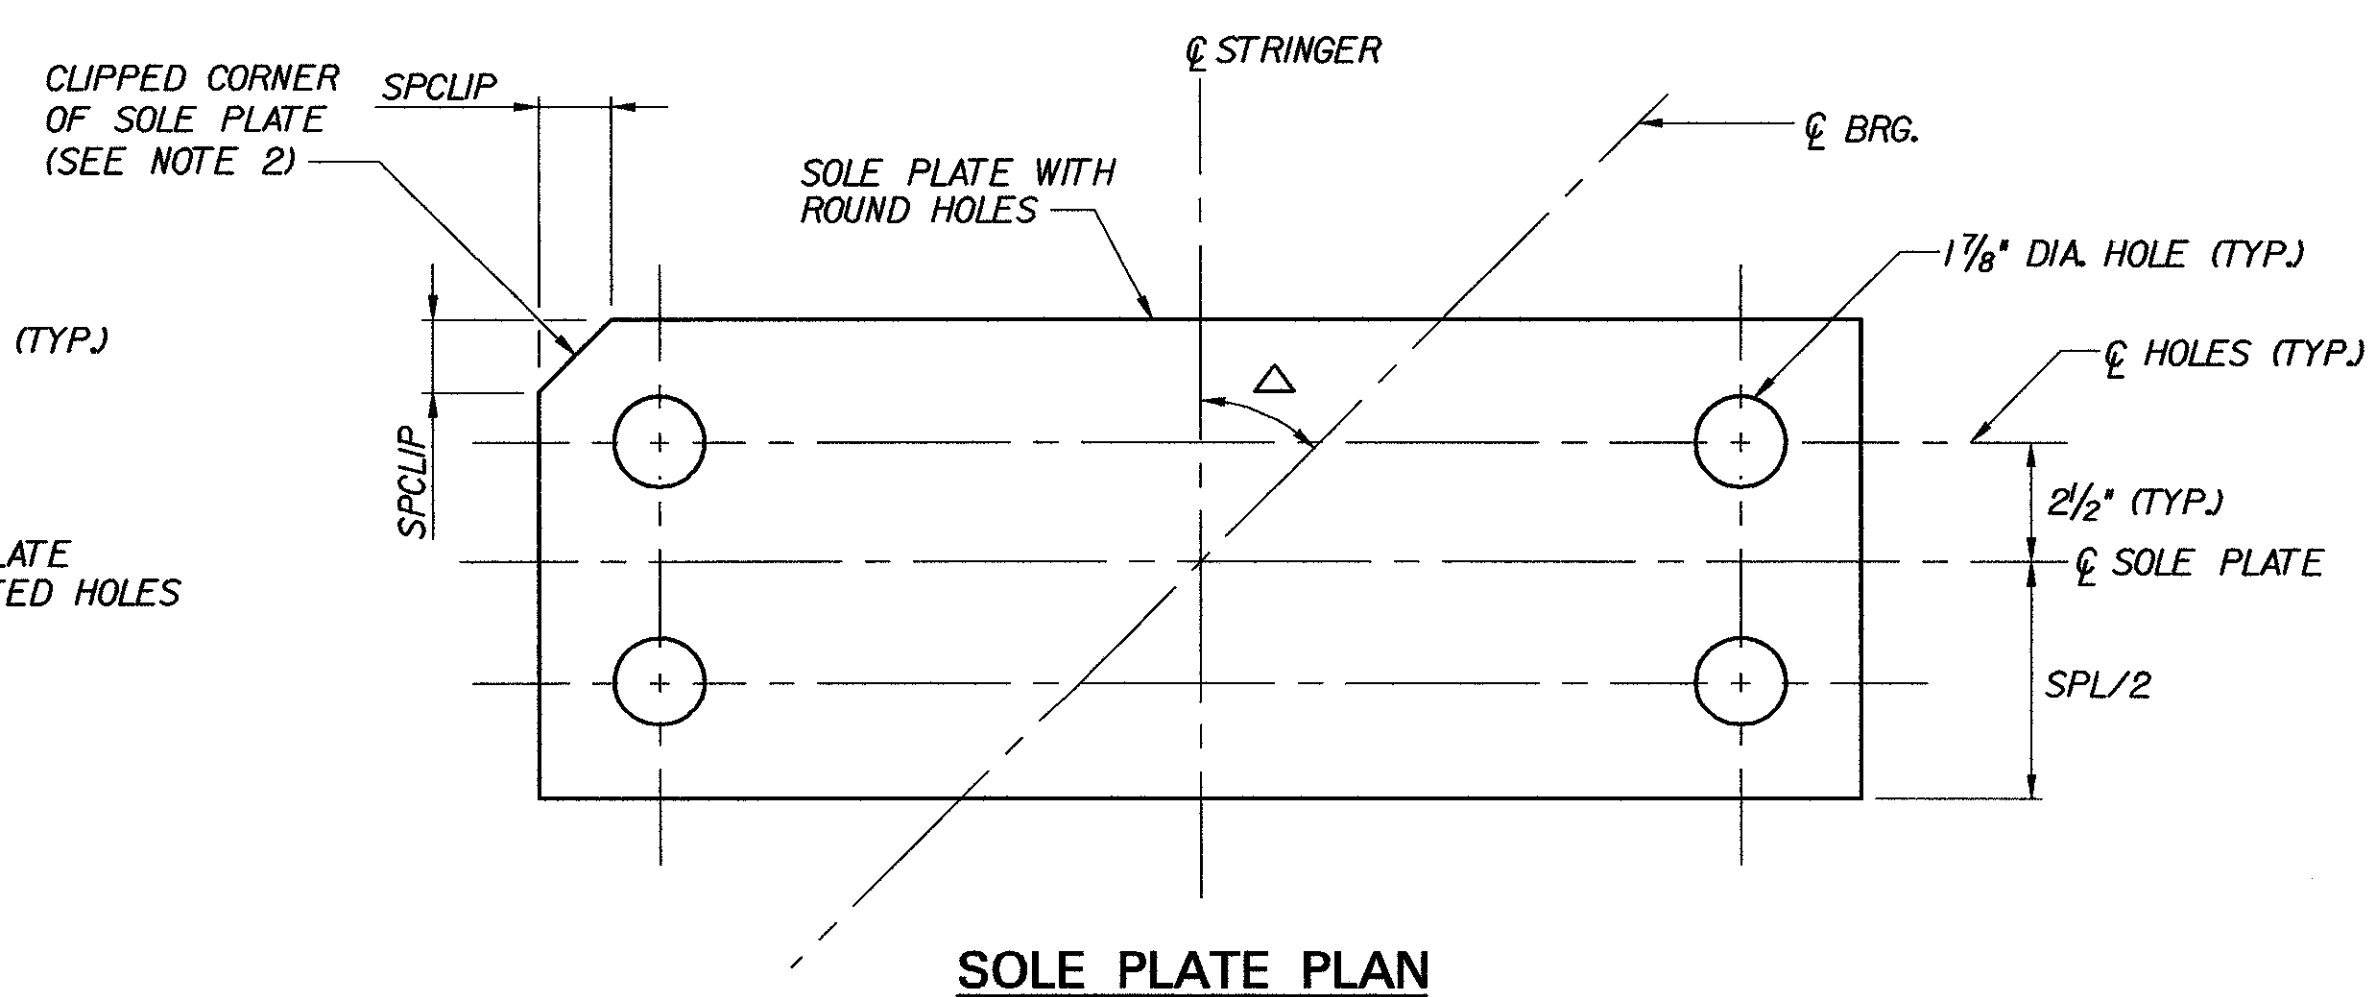


SOLE PLATE PLAN

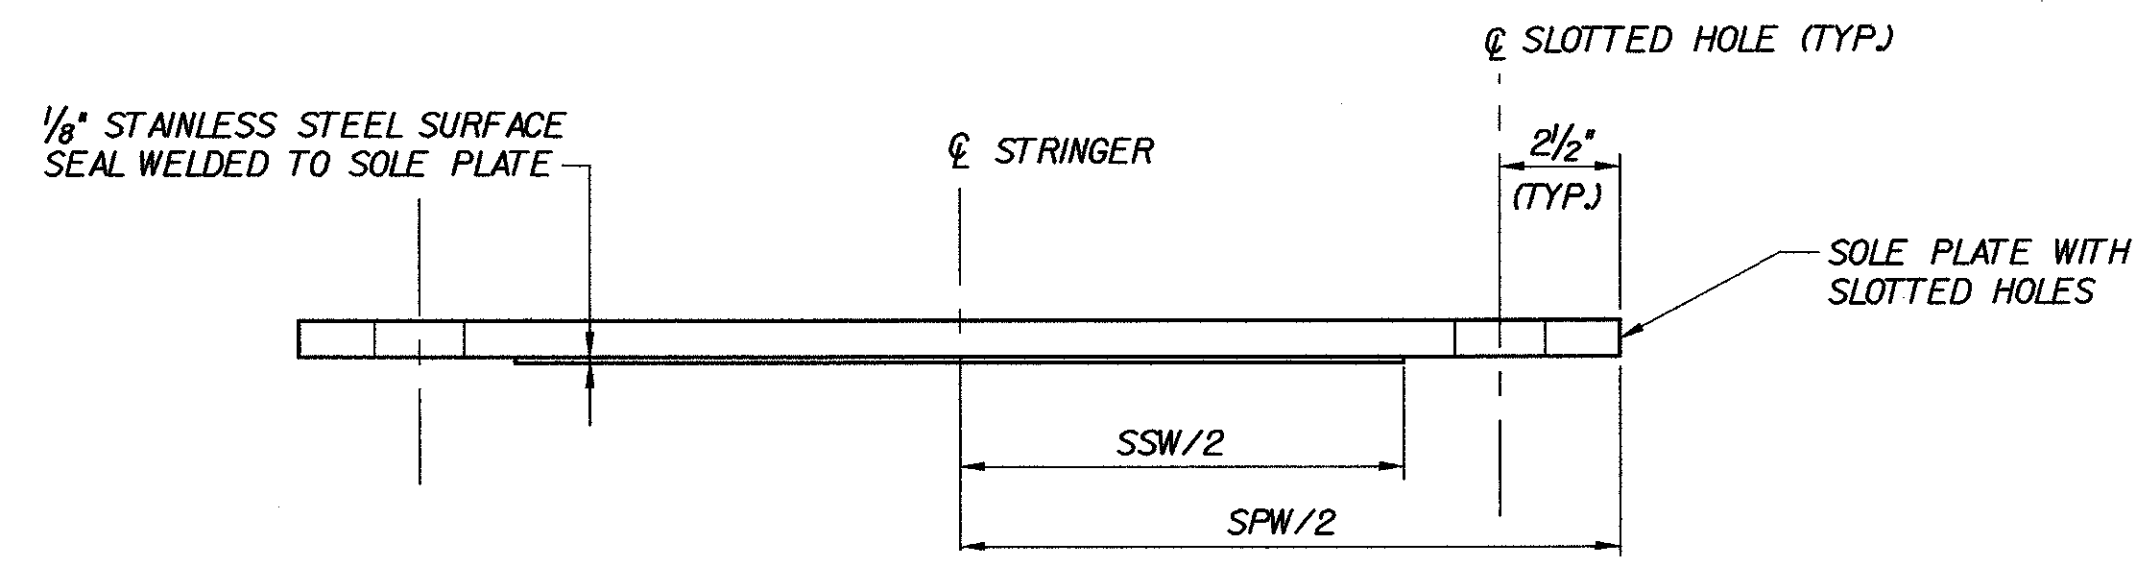


SOLE PLATE ELEVATION

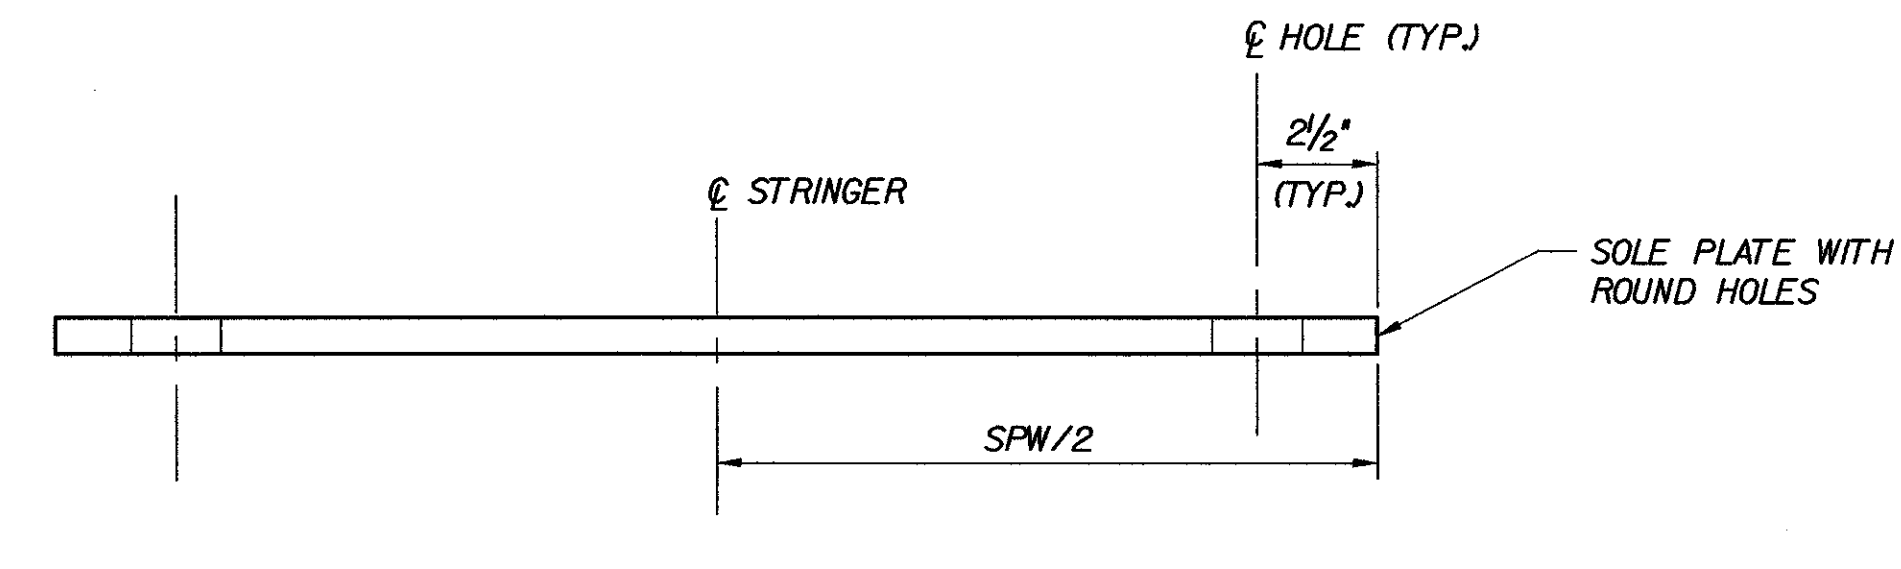


SOLE PLATE ELEVATION

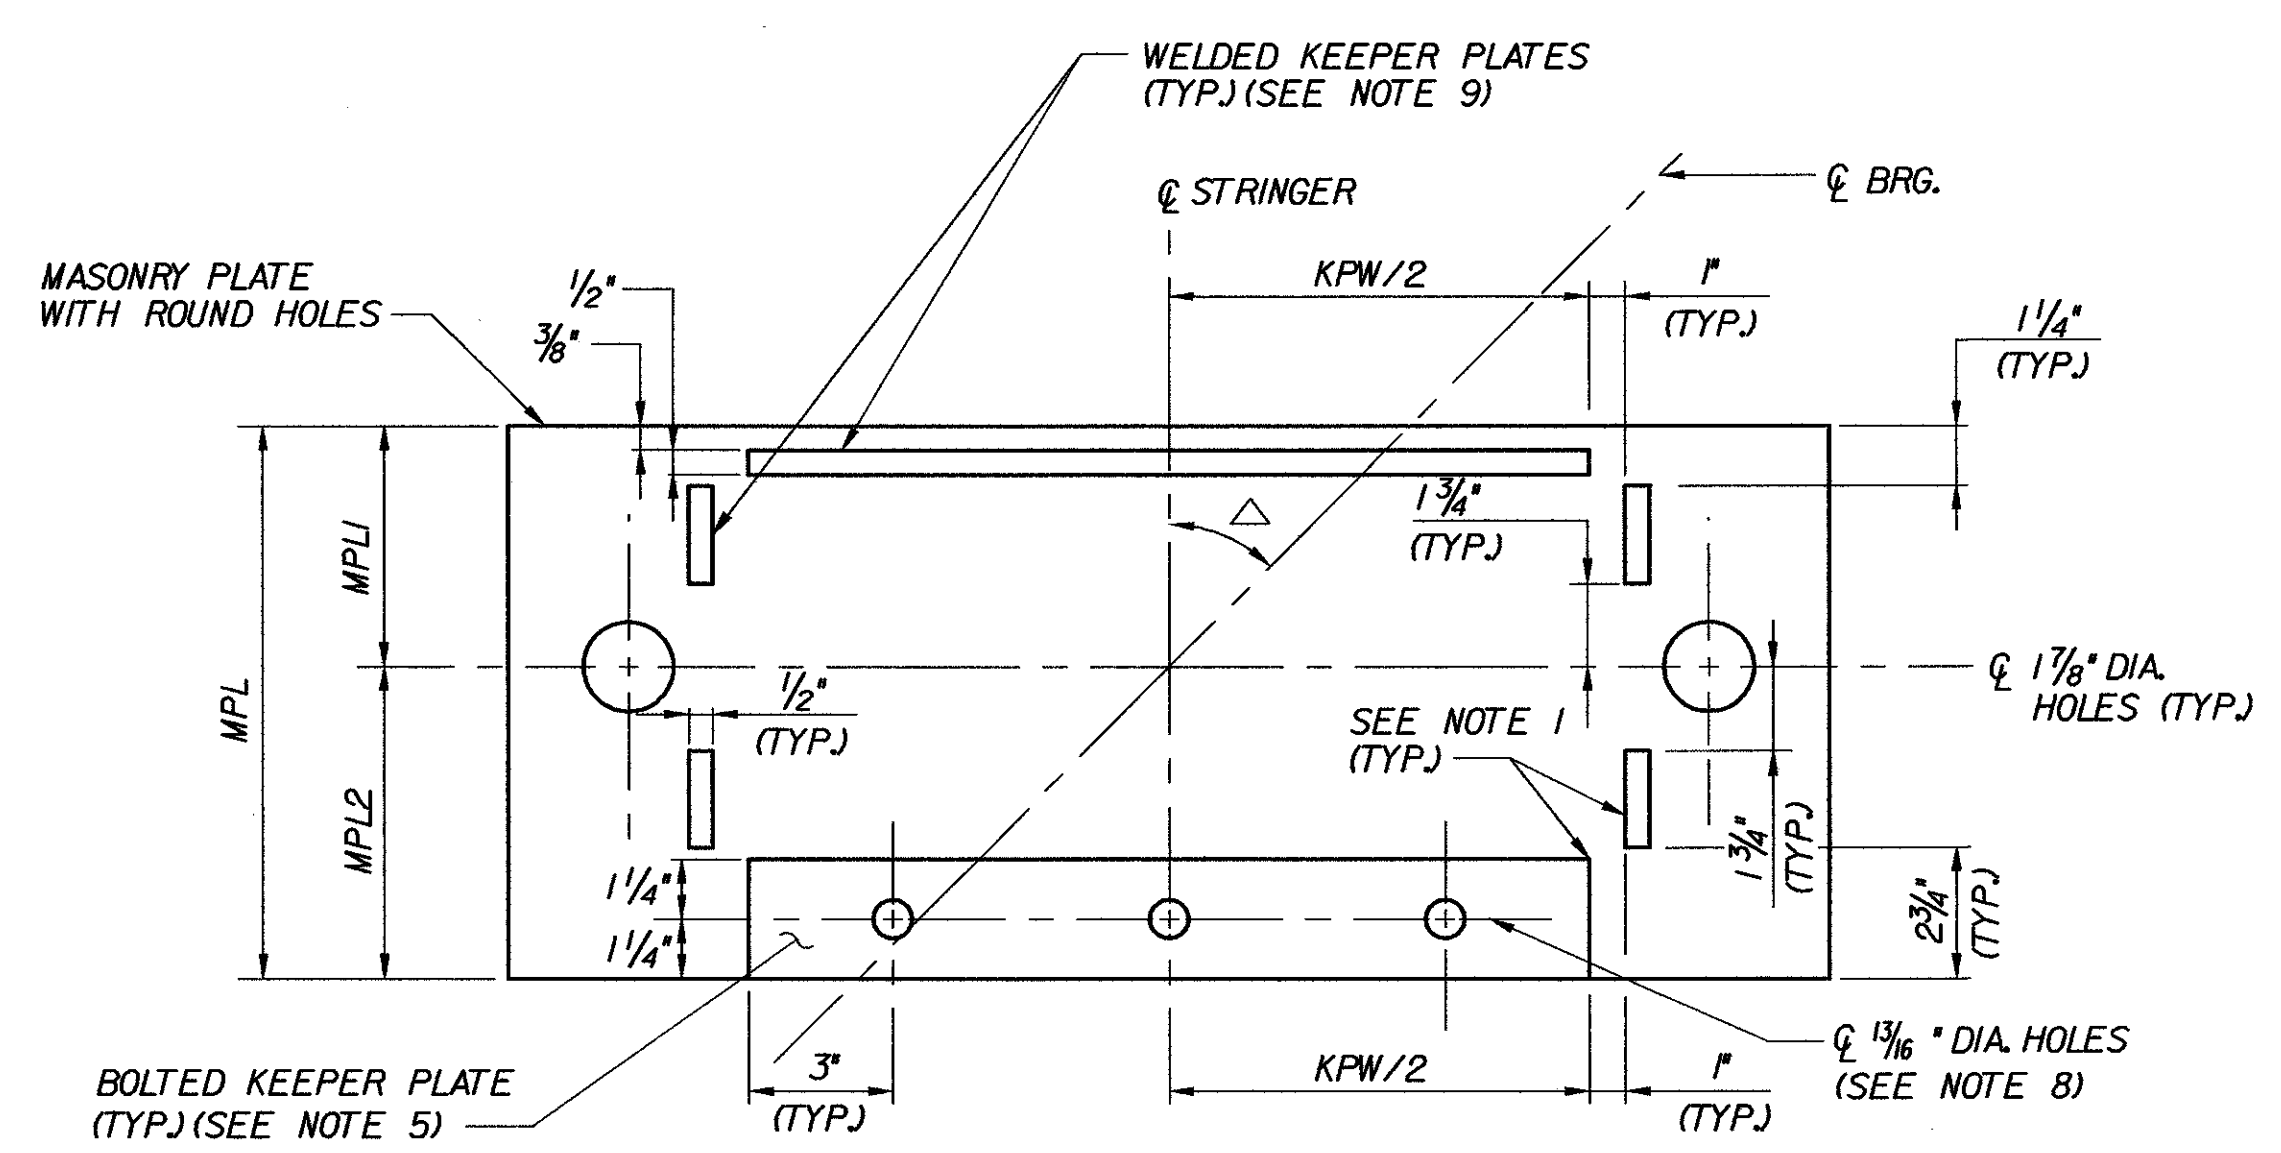

MASONRY PLATE PLAN

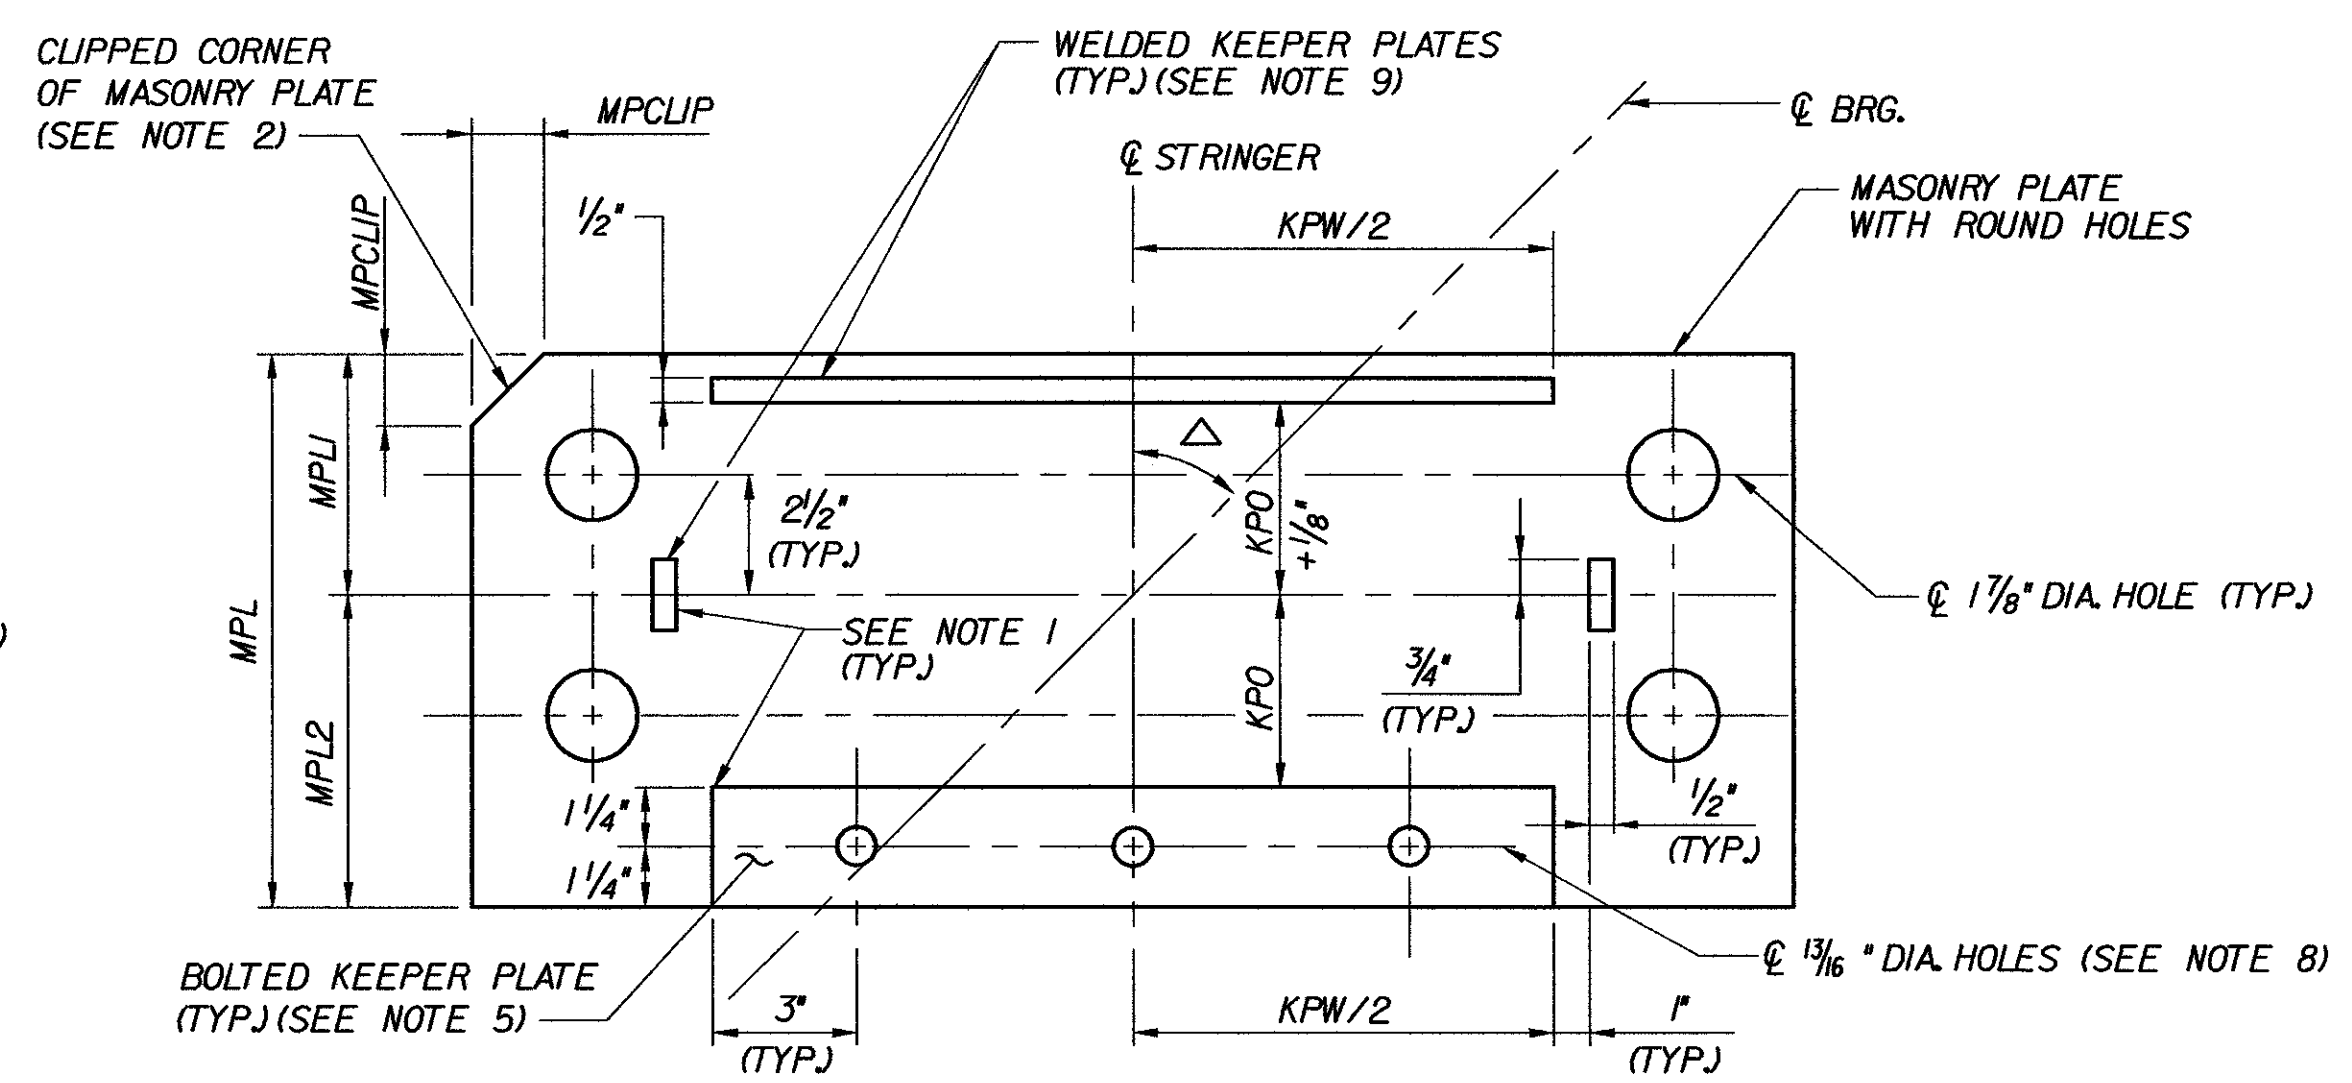


MASONRY PLATE PLAN

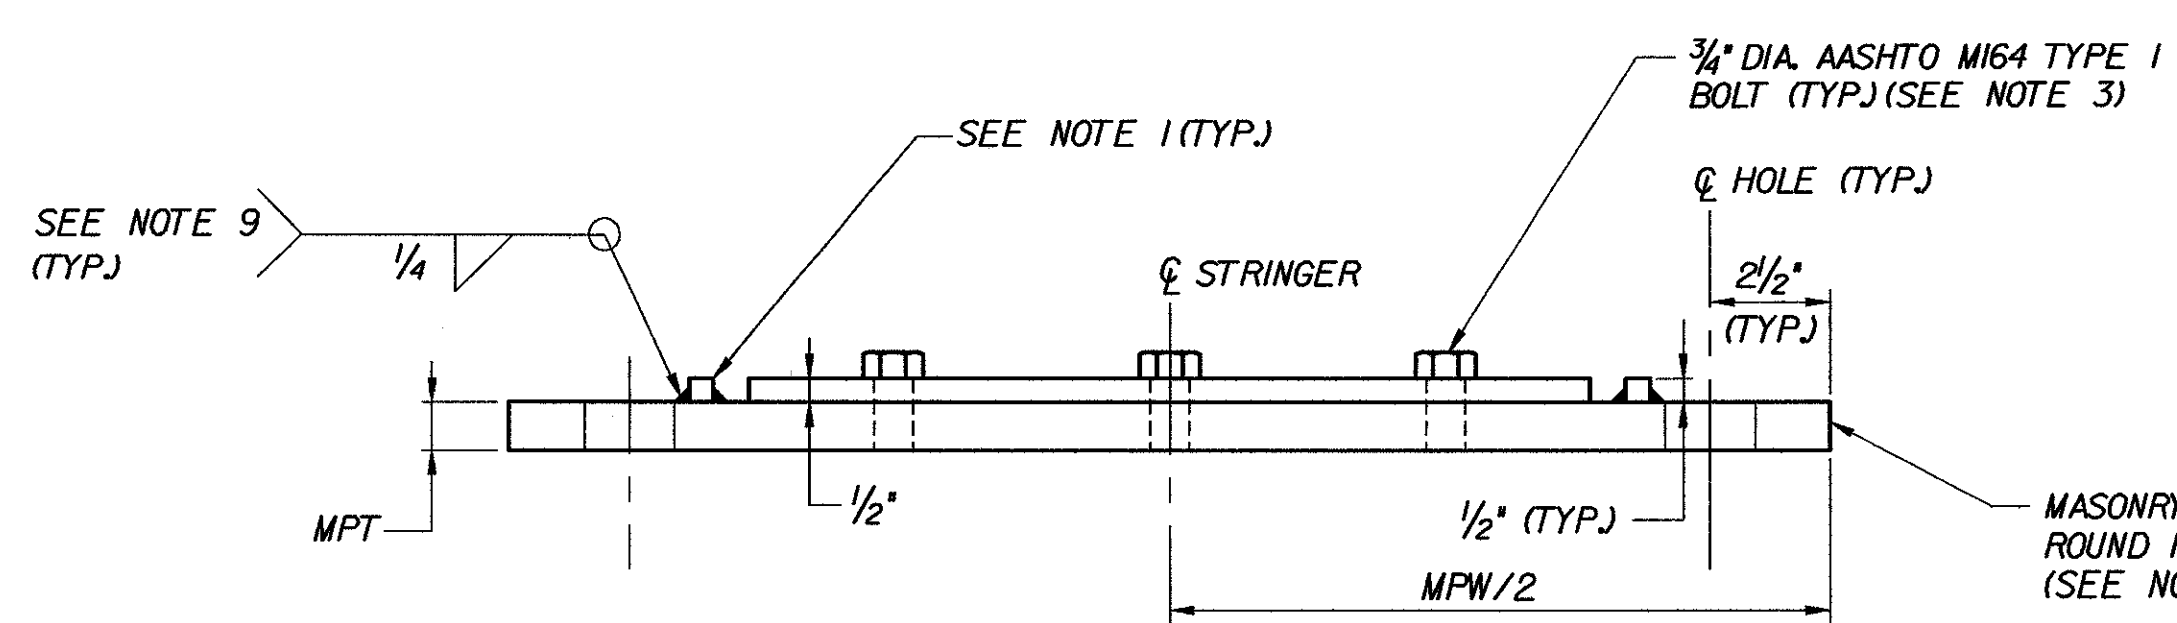

MASONRY PLATE ELEVATION

EXPANSION BEARING DETAILS

NOT TO SCALE

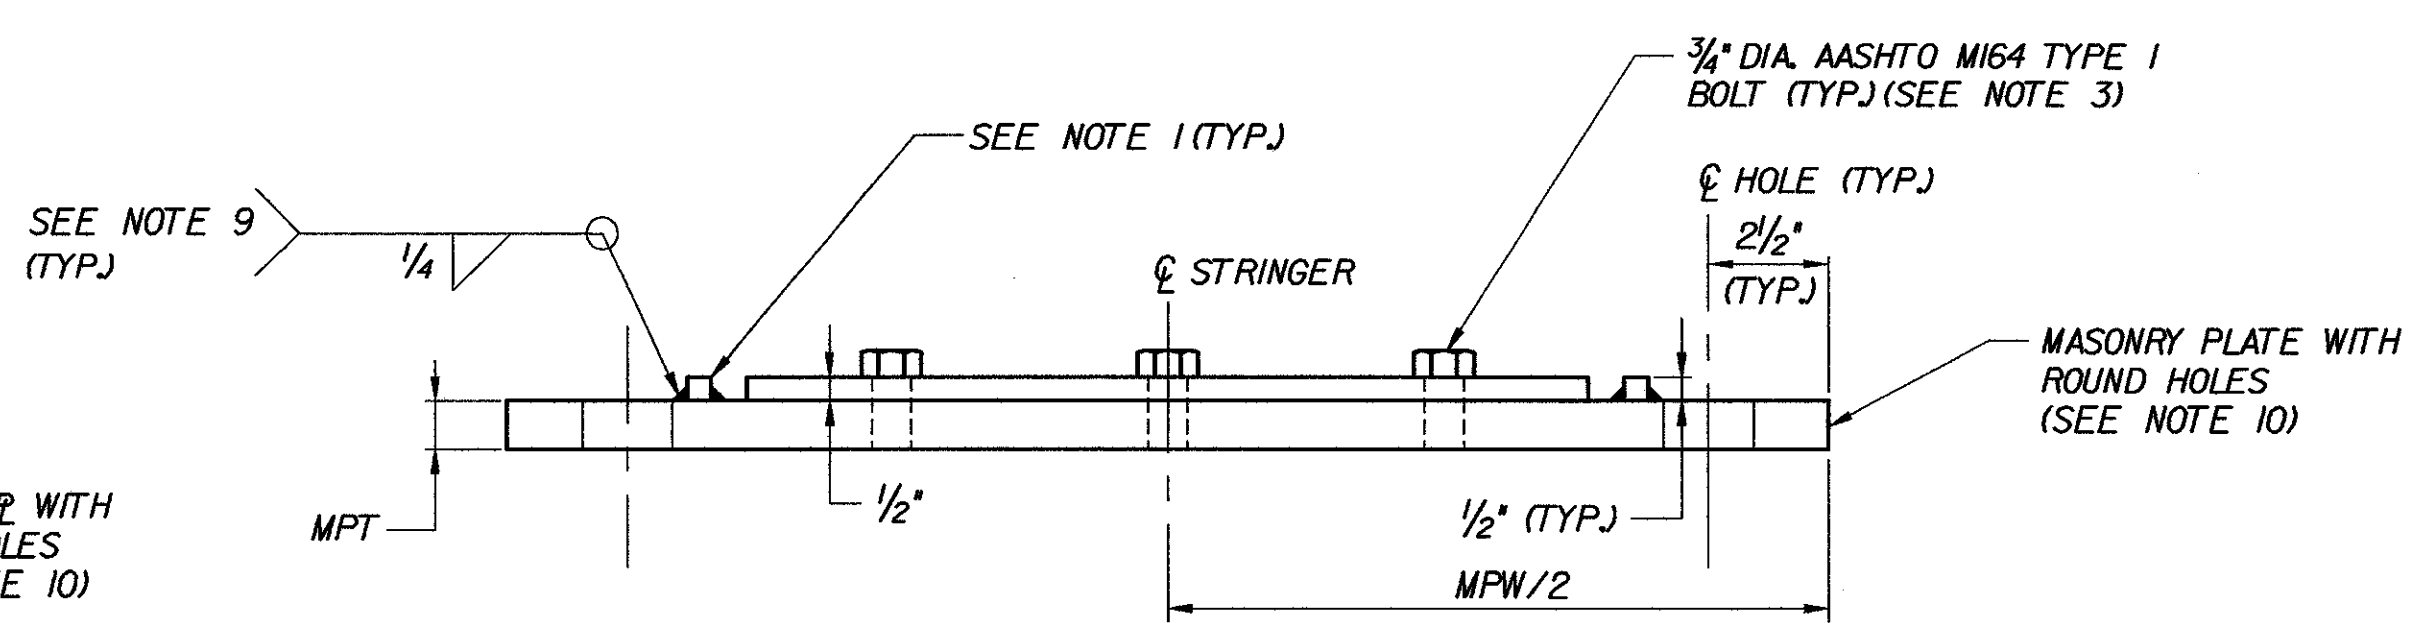

MASONRY PLATE ELEVATION

FIXED BEARING DETAILS

NOT TO SCALE

NOTES:

- SPECIAL CARE SHALL BE TAKEN TO ENSURE THAT THE INSIDE CORNERS OF ALL KEEPER PLATES ARE GROUND PER SUBSECTION 531.04 OF THE SPECIFICATIONS TO REMOVE ALL SHARP EDGES WHICH MIGHT COME INTO CONTACT WITH THE ELASTOMERIC BEARING.
- SOLE AND MASONRY PLATES AT FIXED BEARINGS MAY REQUIRE ONE CORNER TO BE CLIPPED TO CLEAR CURTAINWALL AT ABUTMENTS ONLY. SEE TABLE ON BRIDGE SHEET C-22 FOR CLIP DIMENSIONS.
- KEEPER BOLT LENGTH SHALL BE 1 1/2". COAT KEEPER BOLTS AND HOLES WITH "NEVER SEIZE GREASE". BOLTS SHALL BE FITTED WITH 3/16" THICK WASHERS AND TIGHTENED TO A SNUG FIT. WASHERS SHALL CONFORM TO AASHTO M164.
- SKEW DIRECTION SHOWN IS "AHEAD RIGHT".
- BOLTED KEEPER PLATES ARE REMOVABLE TO ALLOW FOR FUTURE REPLACEMENT OF ELASTOMERIC BEARINGS, IF REQUIRED.
- SEE BRIDGE SHEET C-22 FOR BEARING NOTES.
- SEE BRIDGE SHEET C-21 FOR FIXED BEARING DETAILS. SEE BRIDGE SHEET C-22 FOR FIXED BEARING TABLES. SEE BRIDGE SHEET C-23 FOR EXPANSION BEARING DETAILS. SEE BRIDGE SHEET C-24 FOR EXPANSION BEARING TABLES.
- THE HOLES IN THE MASONRY PLATE FOR THE KEEPER PLATE BOLTS SHALL BE THREADED FOR THE ENTIRE THICKNESS OF THE MASONRY PLATE. THE KEEPER PLATE HOLES SHALL NOT BE THREADED.
- WELDING PROCEDURE SHALL PROVIDE SUFFICIENT PREHEAT TO ENSURE SOUNDNESS OF THE WELD.
- THE MASONRY PLATES SHALL BE COMPLETELY FABRICATED WHEN GALVANIZED OR METALIZED EXCEPT THAT THE BOLTED KEEPER PLATES SHALL BE GALVANIZED OR METALIZED SEPARATELY.

STATE OF VERMONT  
AGENCY OF TRANSPORTATION


Town Of	MIDDLESEX-BOLTON	Bridge No.	
Highway No.	I-89	Log Sta.	
		Surv. Sta.	

SOLE & MASONRY PLATE DETAILS


Designed By	K.L. JAMES	Drawn By	N.J. HOYT
Checked By	M.H. GALLO	Date	10/99
		Bridge Design Supervisor	J.P. HALSTEAD Date 10/99

PROJECT	MIDDLESEX-BOLTON	PROJECT NO.	IM-089-2(26)
TVGA CAD Drawing No.	I27smp1.dgn	Date	10/99
Bridge Sheet No.	C-25	Sheet	25 of 307


**Hayashi Corporation**  
Consulting Engineers

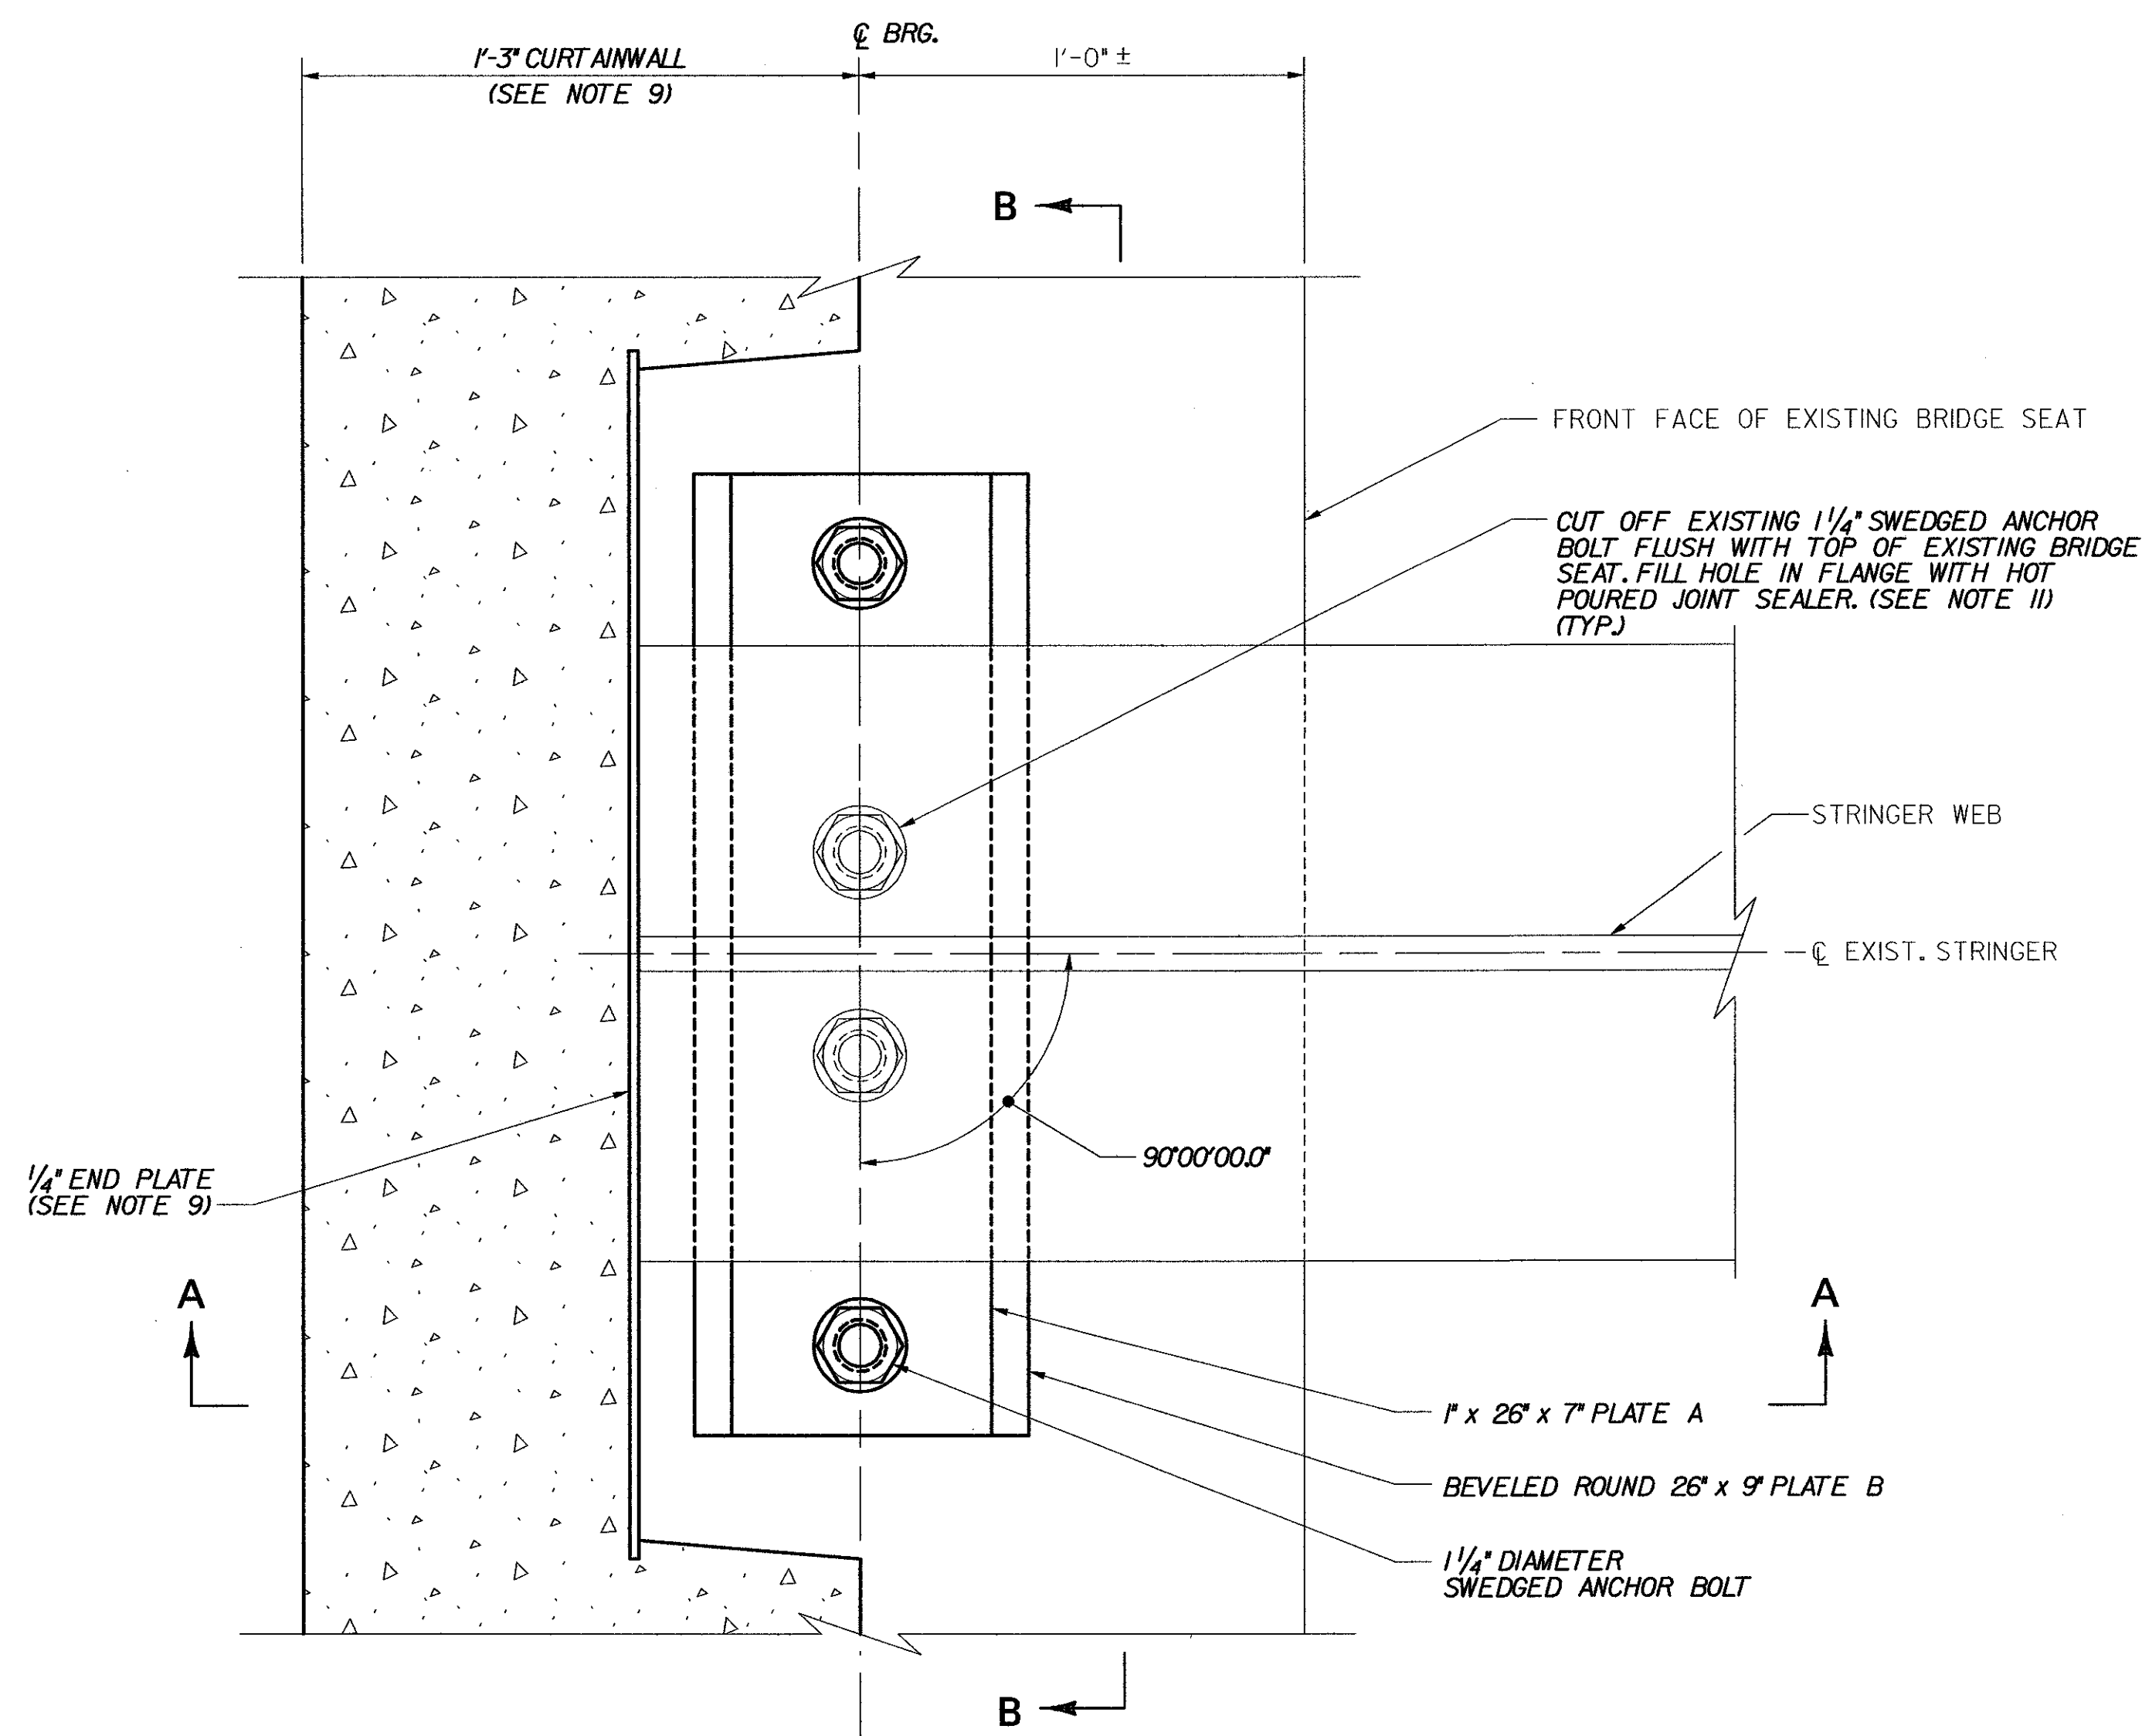

**PLAN VIEW**  
SCALE: 3" = 1'-0"

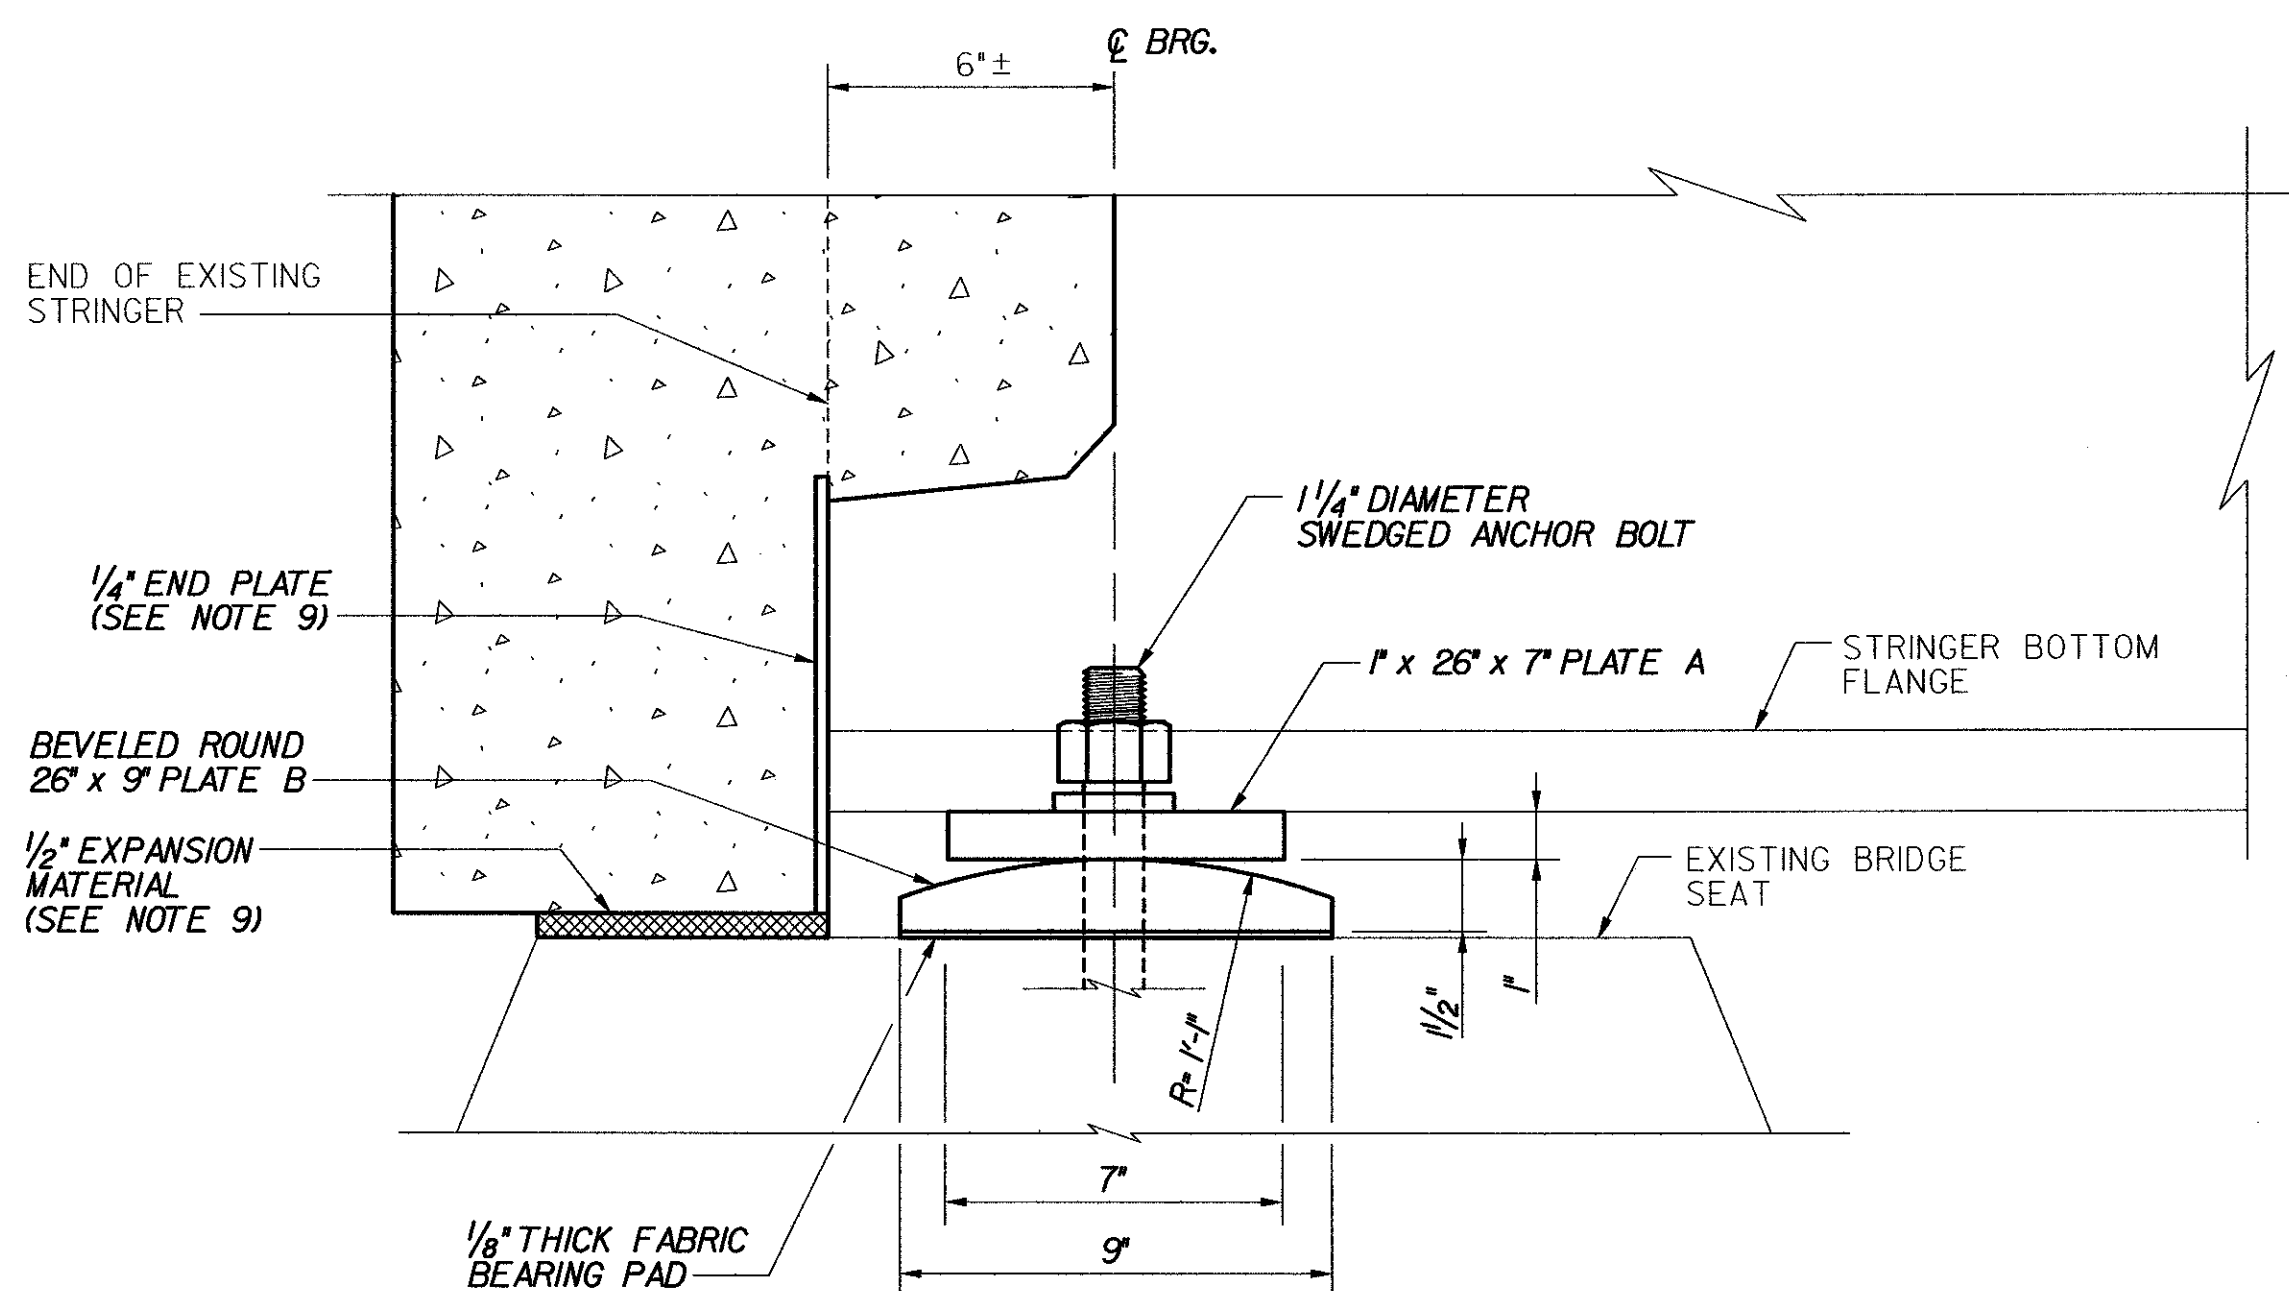

**SECTION A-A**  
SCALE: 3" = 1'-0"

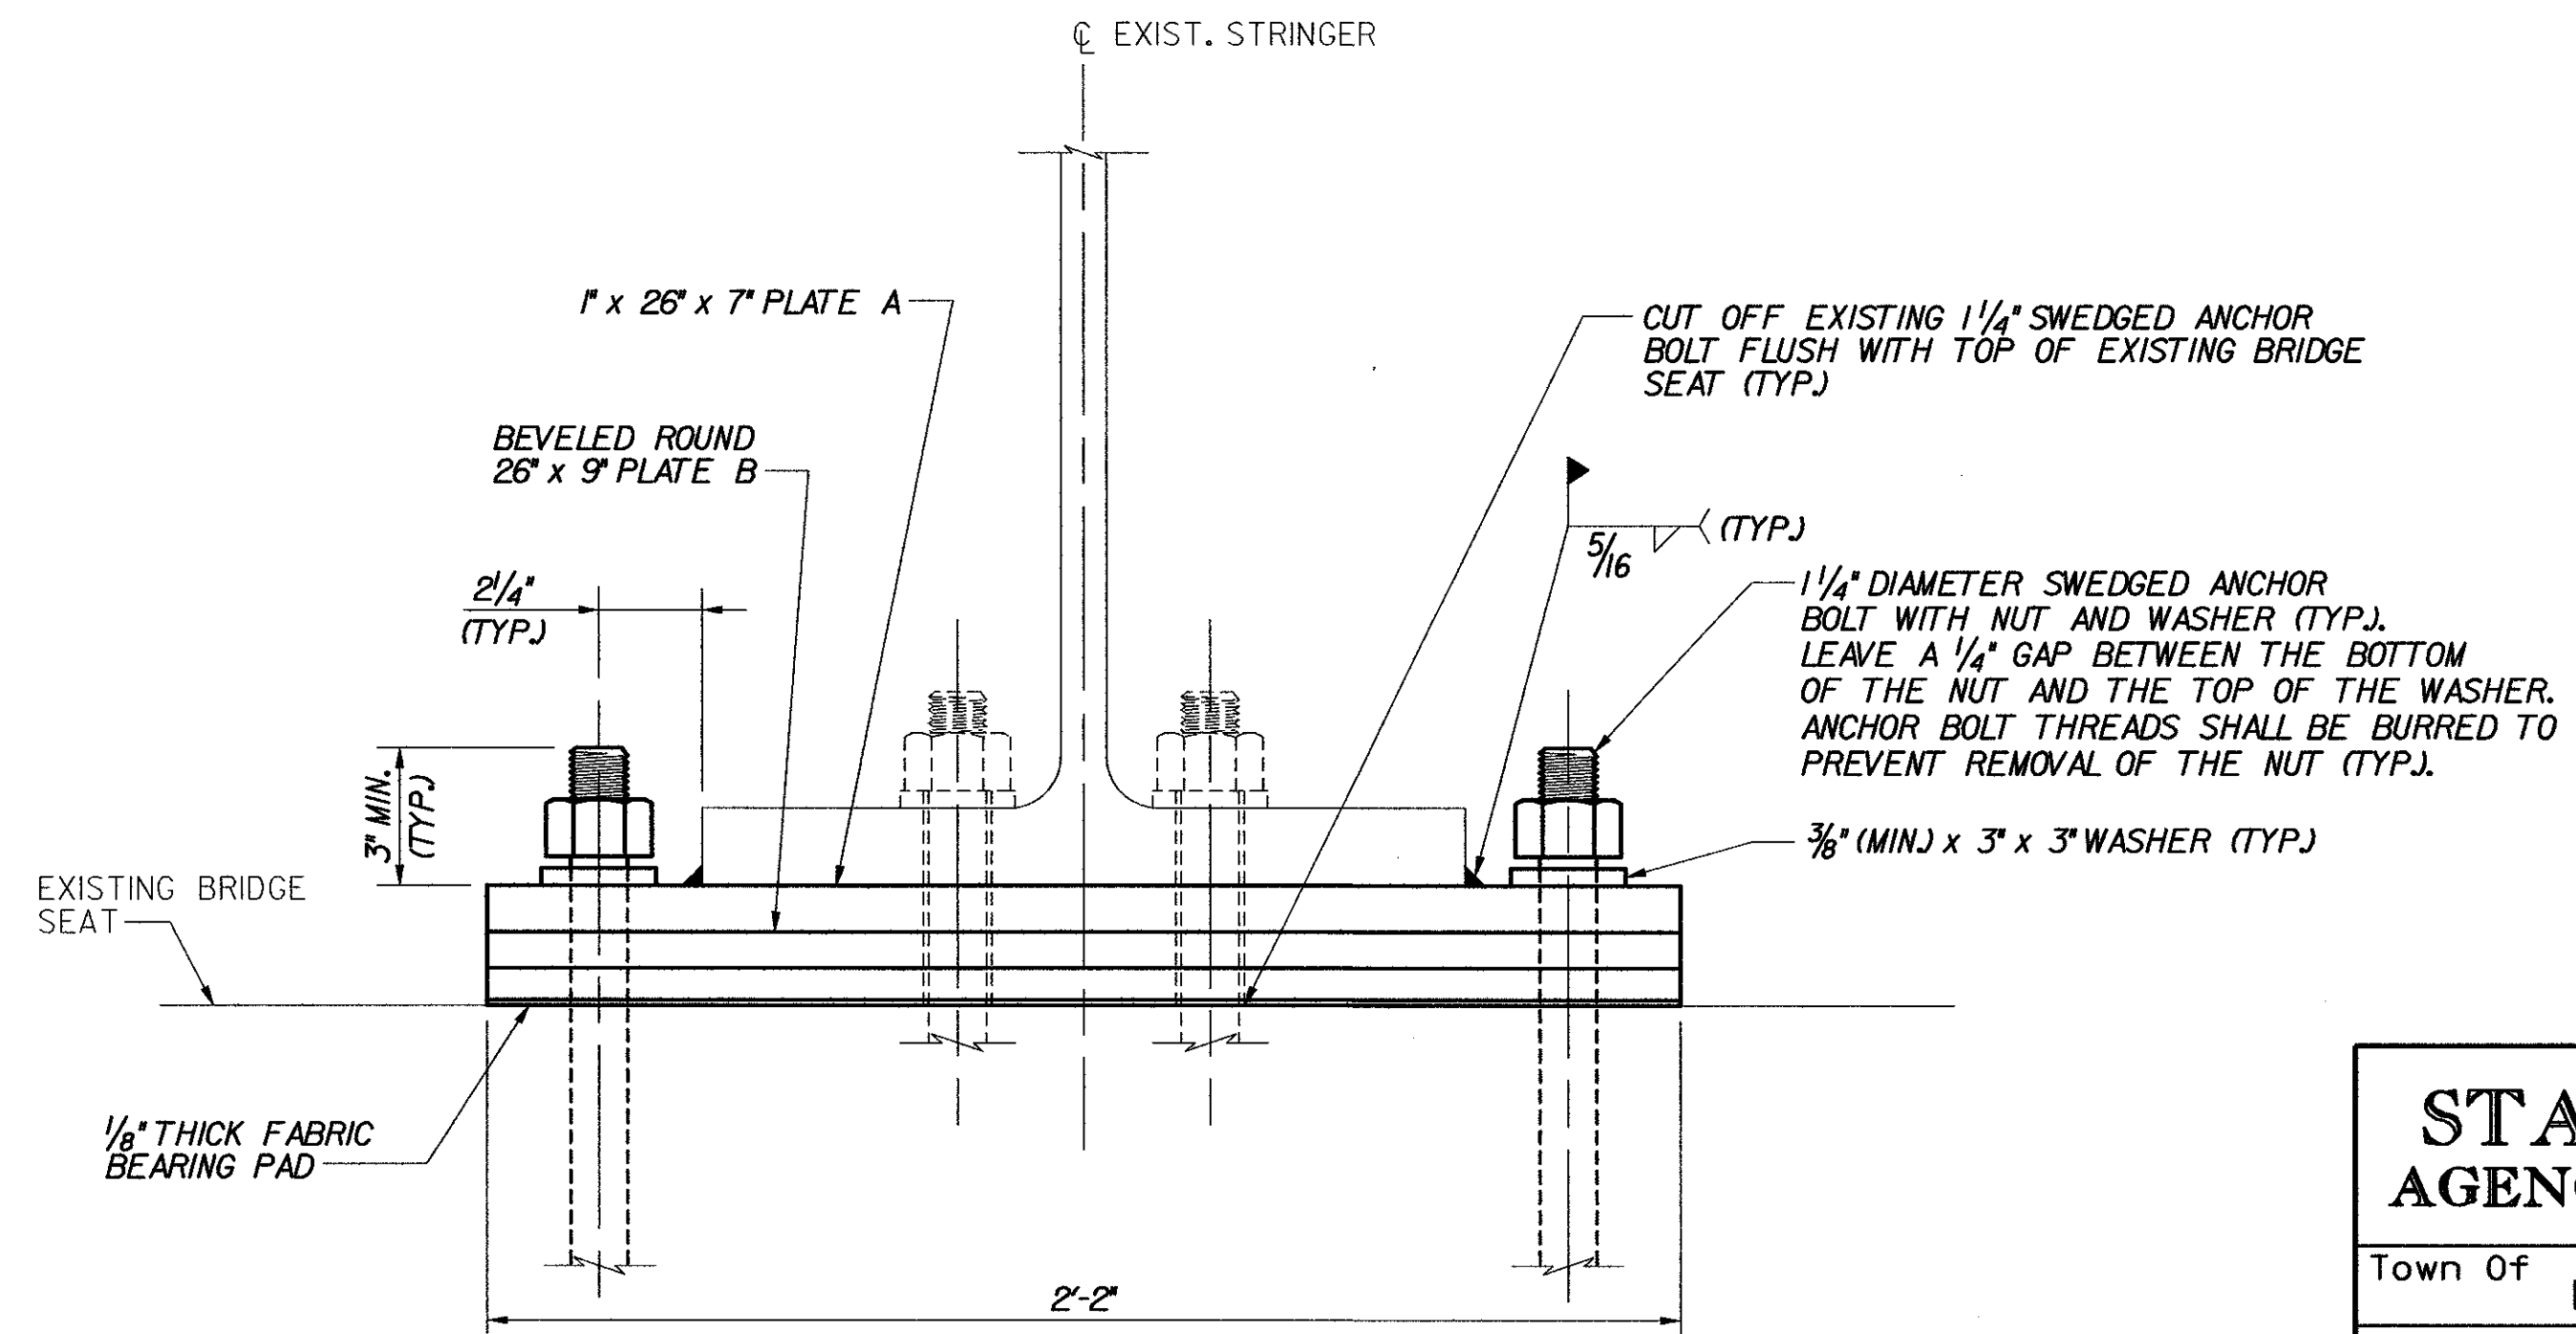

**SECTION B-B**  
SCALE: 3" = 1'-0"

BEARINGS TO BE REPLACED		
BRIDGE	LOCATION	STRINGER
49N	ABUT.1	S1,S7
49S	ABUT.1	S1,S7

**NOTE:** ALL OTHER FIXED BEARINGS AT BR 49N&S TO BE JACKED, CLEANED, PAINTED AND GREASED.

**NOTES:**

1. THE WORK REQUIRED TO CUT EXISTING ANCHOR BOLTS AND TO REMOVE EXISTING BEARINGS, BEARING PLATES AND ANY EXISTING SHIM PLATES IN ORDER TO INSTALL NEW BEARING PLATES SHALL BE SUBSIDIARY TO ITEM 531.10, "BEARING DEVICE ASSEMBLY (STEEL PLT. FIXED BEARINGS)."
2. THE COST FOR THE BEARING PLATES, ANCHOR BOLTS, PREFORMED FABRIC PAD, NUTS, WASHERS AND ALL WORK REQUIRED TO FABRICATE AND INSTALL THE BEARINGS SHALL BE INCLUDED IN THE BID PRICE FOR ITEM 531.10, "BEARING DEVICE ASSEMBLY (STEEL PLT. FIXED BEARINGS)."
3. ALL BRIDGE SEATS SHALL BE CLEANED OF ALL DIRT, DEBRIS AND FOREIGN MATERIAL PRIOR TO THE INSTALLATION OF THE NEW BEARINGS. AFTER REMOVAL OF FOREIGN MATERIAL, THE ABUTMENT STEM AND BRIDGE SEATS SHALL BE REPAIRED AS SHOWN ON THE SUBSTRUCTURE REPAIR DETAILS AND NOTES, BRIDGE SHEET C-45.
4. NEW PLATES REQUIRED FOR BEARINGS BEING REPLACED IN KIND SHALL BE FABRICATED TO MATCH EXACTLY THE DIMENSIONS OF THE PLATES BEING REPLACED, EXCEPT AS NOTED. THE CONTRACTOR SHALL VERIFY THE DIMENSIONS OF THE EXISTING PLATES BEFORE ORDERING ANY NEW BEARING PLATES.
5. ALL COSTS FOR CLEANING AND REPAINTING EXISTING BEAMS SHALL BE SUBSIDIARY TO ITEMS 513.30, 513.36 AND 513.41.
6. NEW 1 1/4" ANCHOR BOLTS SHALL BE GROUTED WITH A MINIMUM EMBEDMENT OF 1'-3".
7. ALL STEEL USED IN THE BEARINGS SHALL BE AASHTO M270 GRADE 36 STEEL. ANCHOR BOLTS, NUTS, AND WASHERS SHALL CONFORM TO SUBSECTION 714.08 OF THE SPECIFICATIONS. ALL COMPONENTS SHALL BE GALVANIZED OR METALIZED PER SUBSECTIONS 531.04 (B) AND 506.15 OF THE SPECIFICATIONS.
8. ANY GALVANIZED AREAS THAT ARE WELDED IN THE FIELD (OR OTHERWISE DAMAGED) SHALL BE REPAIRED IN ACCORDANCE WITH SUBSECTION 513 OF THE SPECIFICATIONS.
9. DETAILS AND DIMENSIONS OF CURTAINWALL AND END PLATE NOT SHOWN FOR CLARITY. SEE TYPICAL CURTAINWALL DETAILS, BRIDGE SHEET C-42.
10. ALL COSTS FOR JACKING, CLEANING, PAINTING AND GREASING THE EXISTING BEARINGS SHALL BE SUBSIDIARY TO ITEMS 513.30, 513.36 AND 513.41.
11. THE EXISTING ANCHOR BOLT HOLES IN THE FLANGES OF THE STRINGER SHALL BE FILLED WITH HOT POURED JOINT SEALER. COSTS FOR THIS WORK SHALL BE SUBSIDIARY TO ITEM 531.10, "BEARING DEVICE ASSEMBLY (STEEL PLT. FIXED BEARINGS)."

**STATE OF VERMONT  
AGENCY OF TRANSPORTATION**


Town Of	MIDDLESEX-BOLTON	Bridge No.	
Highway No.	I-89	Log Sta.	
		Surv. Sta.	

**BR 49 FIXED BEARINGS - REPLACE IN KIND**

Designed By	P.W. SZUSTAK	Drawn By	T.M. LONGO
Checked By	Date	Bridge Design Supervisor	
J.P. HALSTEAD	10/99	J.P. HALSTEAD	Date 10/99

PROJECT	MIDDLESEX-BOLTON	PROJECT NO.	IM-089-2(26)
---------	------------------	-------------	--------------

TVGA CAD Drawing No.	49f-brg	Date	10/99
Bridge Sheet No.	C-26	Sheet	26 of 307

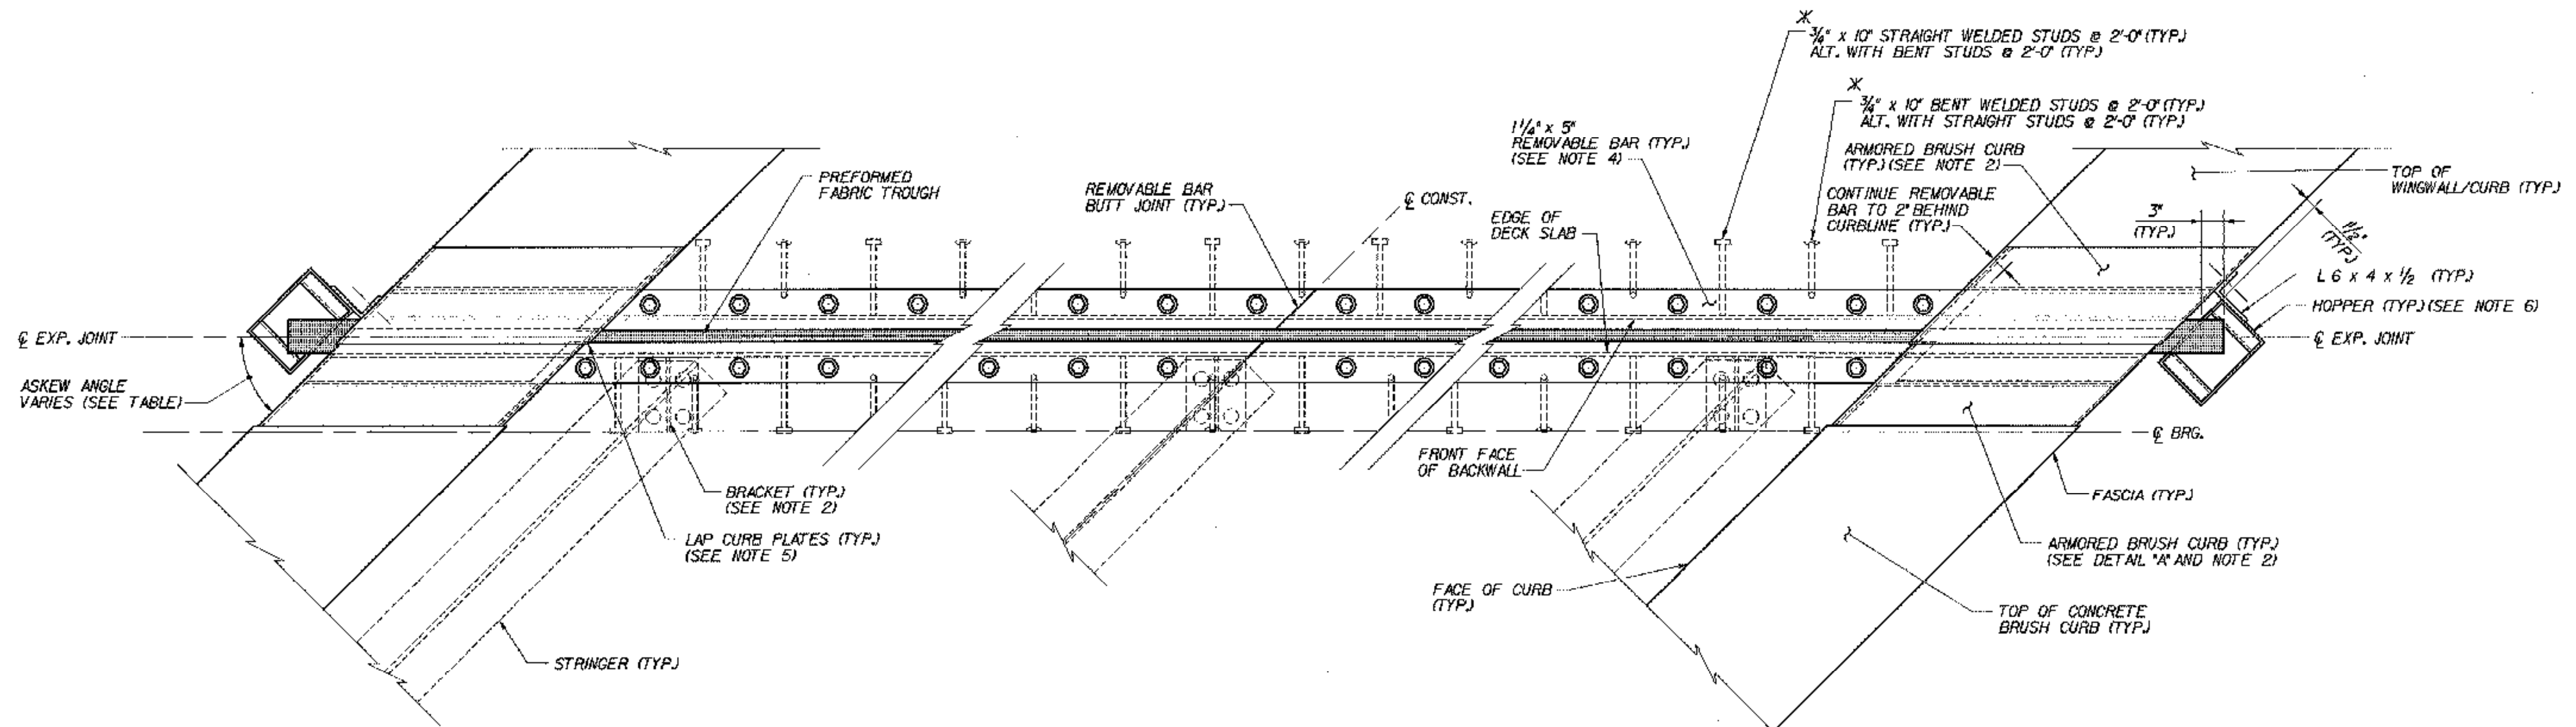

**TYPICAL TYPE "H" EXPANSION ABUTMENT JOINT PLAN**


(AHEAD RT. SHOWN - AHEAD LT. SIMILAR)

SCALE: 1" = 1'-0"

\* NOTE: STUDS NOT SHOWN IN BRUSH CURB FOR CLARITY.

**NOTES:**

1. TOP AND FACE OF BRUSH CURB ARE ATTACHED BY BOLTS AND ARE REMOVABLE TO ALLOW CLEANING AND/OR REPLACEMENT OF FABRIC TROUGH.
2. FOR TYPICAL SECTIONS OF EXPANSION JOINT AND ARMORED BRUSH CURB, SEE TYPE "H" ABUTMENT JOINT DETAILS, BRIDGE SHEETS C-28 AND C-29.
3. FOR VIEW OF FASCIA PLATES, AND LOCATION OF WELDED STUDS ON FASCIA PLATES, SEE TYPE "H" ABUTMENT JOINT DETAILS (3 OF 3), BRIDGE SHEET C-30.
4. BARS IN ROADWAY ARE REMOVABLE TO ALLOW CLEANING AND/OR REPLACEMENT OF FABRIC TROUGH.
5. LAP CURB PLATES IN DIRECTION OF TRAFFIC. SEE TABLE FOR DIRECTION OF LAP AT EACH EXPANSION JOINT LOCATION.
6. WHERE HOPPER IS NOT REQUIRED, PREFORMED FABRIC DRAIN TROUGH SHALL BE TERMINATED 2" INSIDE THE FASCIA.

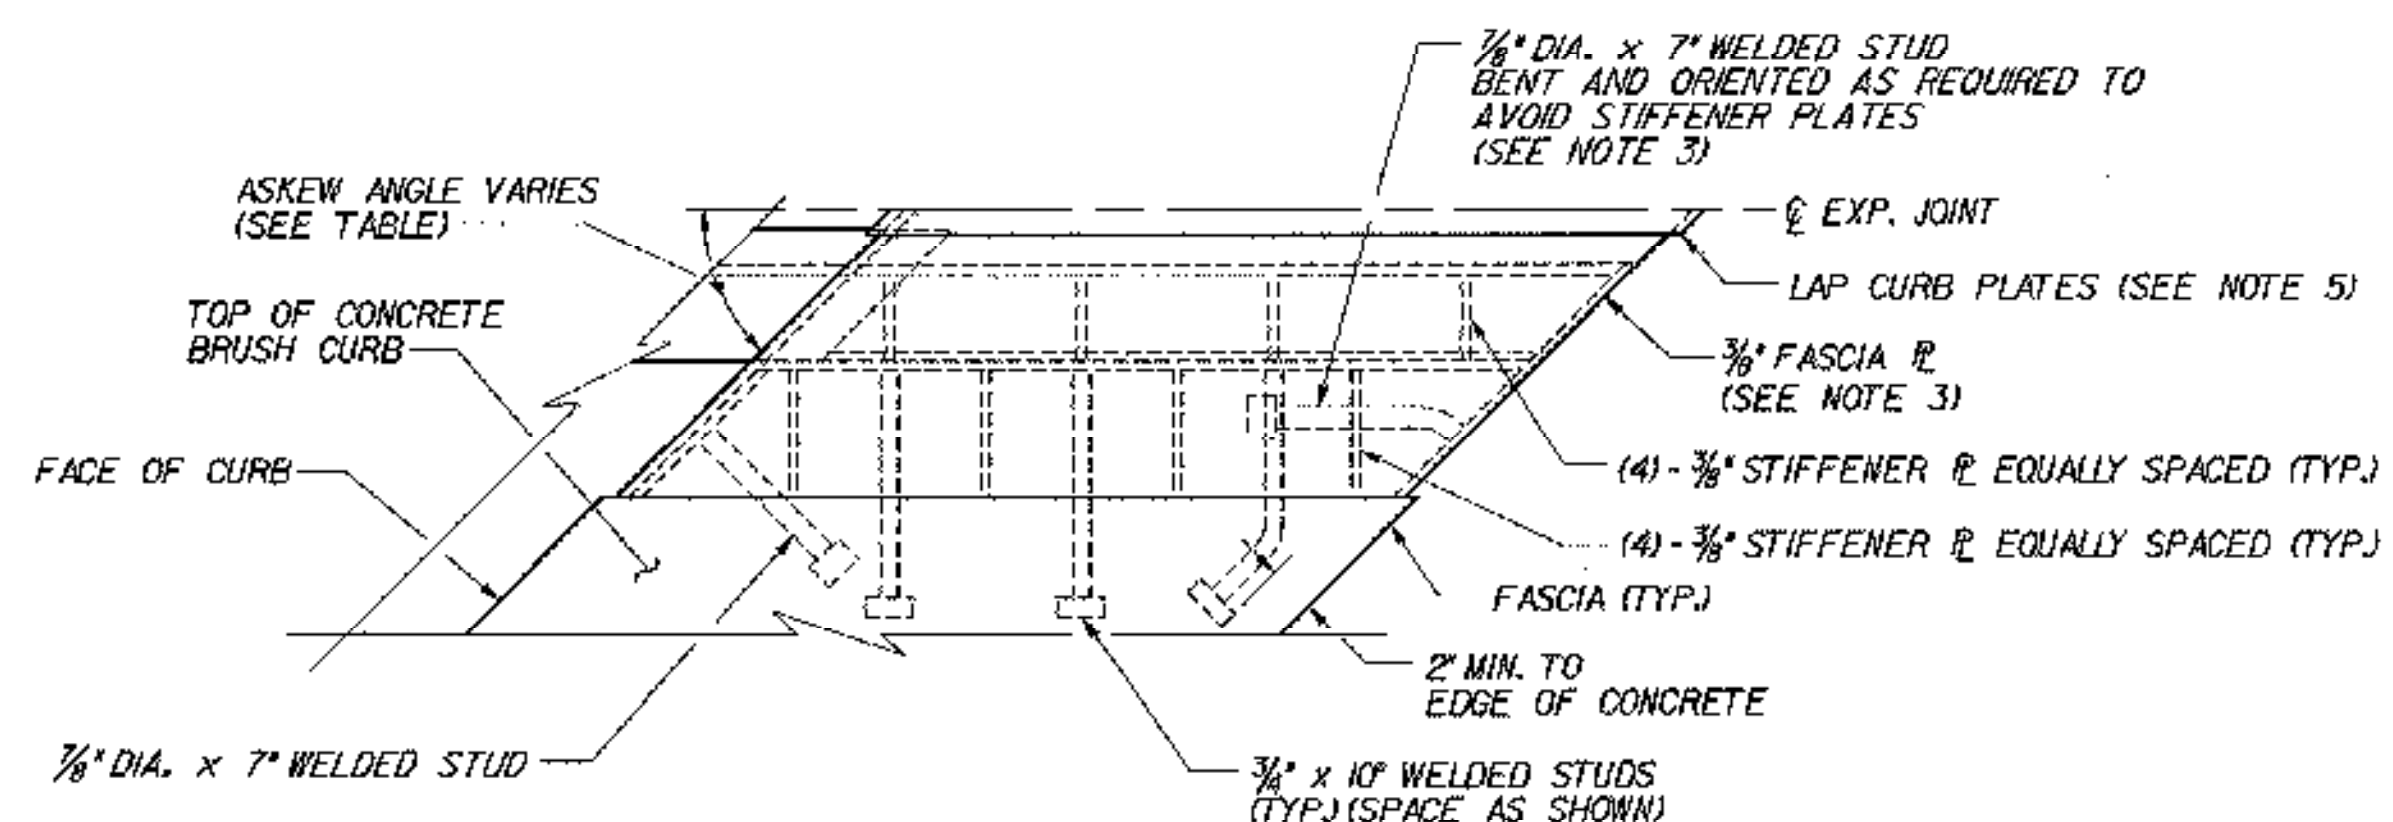

**DETAIL "A"**

(ONE QUADRANT OF ARMORED BRUSH CURB SHOWN - ALL OTHER QUADRANTS SIMILAR)

SCALE: 1/2" = 1'-0"


BRIDGE	EXPANSION JOINT LOCATION	ASKEW ANGLE AT EXPANSION JOINT	DIRECTION OF SKEW	HOPPER LOCATION (SEE NOTE 6)	DIRECTION OF CURB PLATE LAP
43N	ABUT. 2	45° 07' 37"	AHEAD RT.	RT.	REVERSE AS SHOWN
43S	ABUT. 1	44° 35' 15"	AHEAD RT.	RT.	REVERSE AS SHOWN
49N	ABUT. 2	90° 00' 00"		BOTH	REVERSE AS SHOWN
49S	ABUT. 2	90° 00' 00"		BOTH	AS SHOWN
50N	ABUT. 2	46° 29' 48"	AHEAD RT.	LT.	REVERSE AS SHOWN
50S	ABUT. 1	43° 31' 43"	AHEAD RT.	LT.	REVERSE AS SHOWN
51N	ABUT. 2	43° 40' 33"	AHEAD LT.	LT.	REVERSE AS SHOWN
51S	ABUT. 2	43° 08' 46"	AHEAD LT.	LT.	AS SHOWN

**STATE OF VERMONT AGENCY OF TRANSPORTATION**


Town Of **MIDDLESEX-BOLTON** Bridge No. \_\_\_\_\_  
 Highway No. **I-89** Log Sta. \_\_\_\_\_  
 Surv. Sta. \_\_\_\_\_

**TYPICAL TYPE "H" ABUTMENT JOINT PLAN**

Designed By **P.W. SZUSTAK** Drawn By **R.A. BOTZENHART**  
 Checked By **J.P. HALSTEAD** Date **10/99** Bridge Design Supervisor Date **10/99**  
 PROJECT **MIDDLESEX-BOLTON** PROJECT NO. **IM-089-2(26)**  
 TVGA CAD Drawing No. **h-jointp** Date **10/99**  
 Bridge Sheet No. **C-27** Sheet **27** of **307**

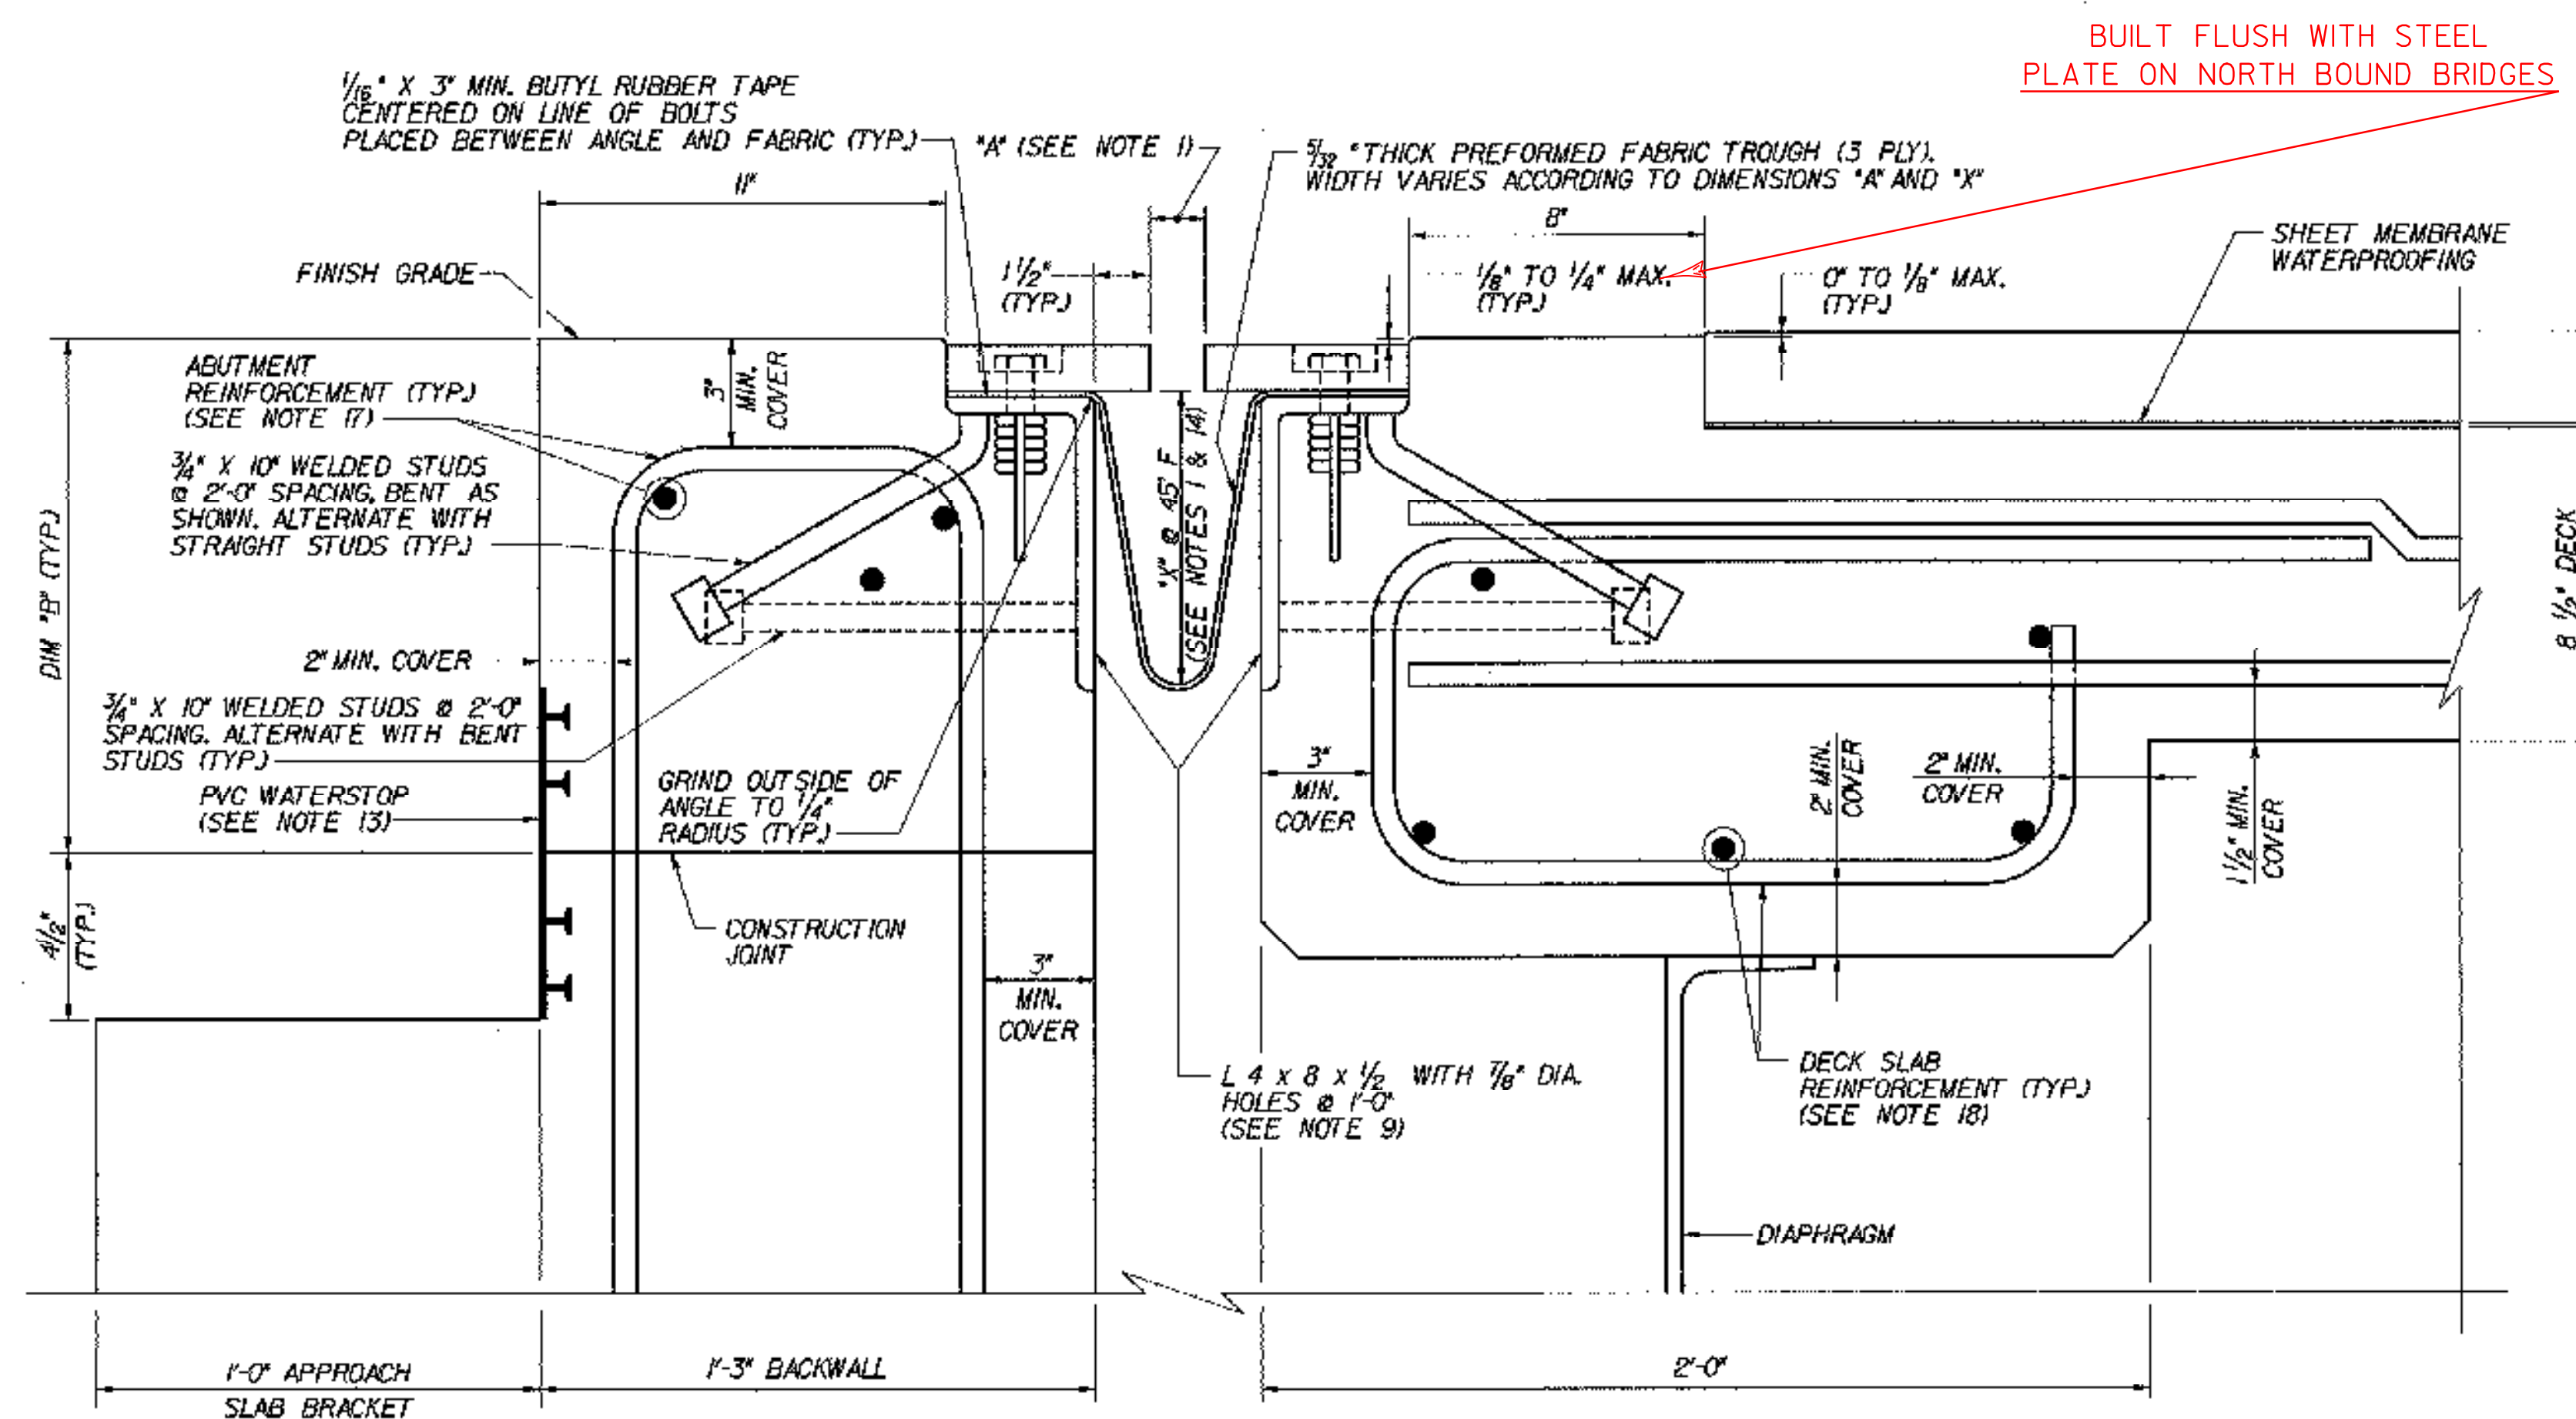

BUILT FLUSH WITH STEEL PLATE ON NORTH BOUND BRIDGES

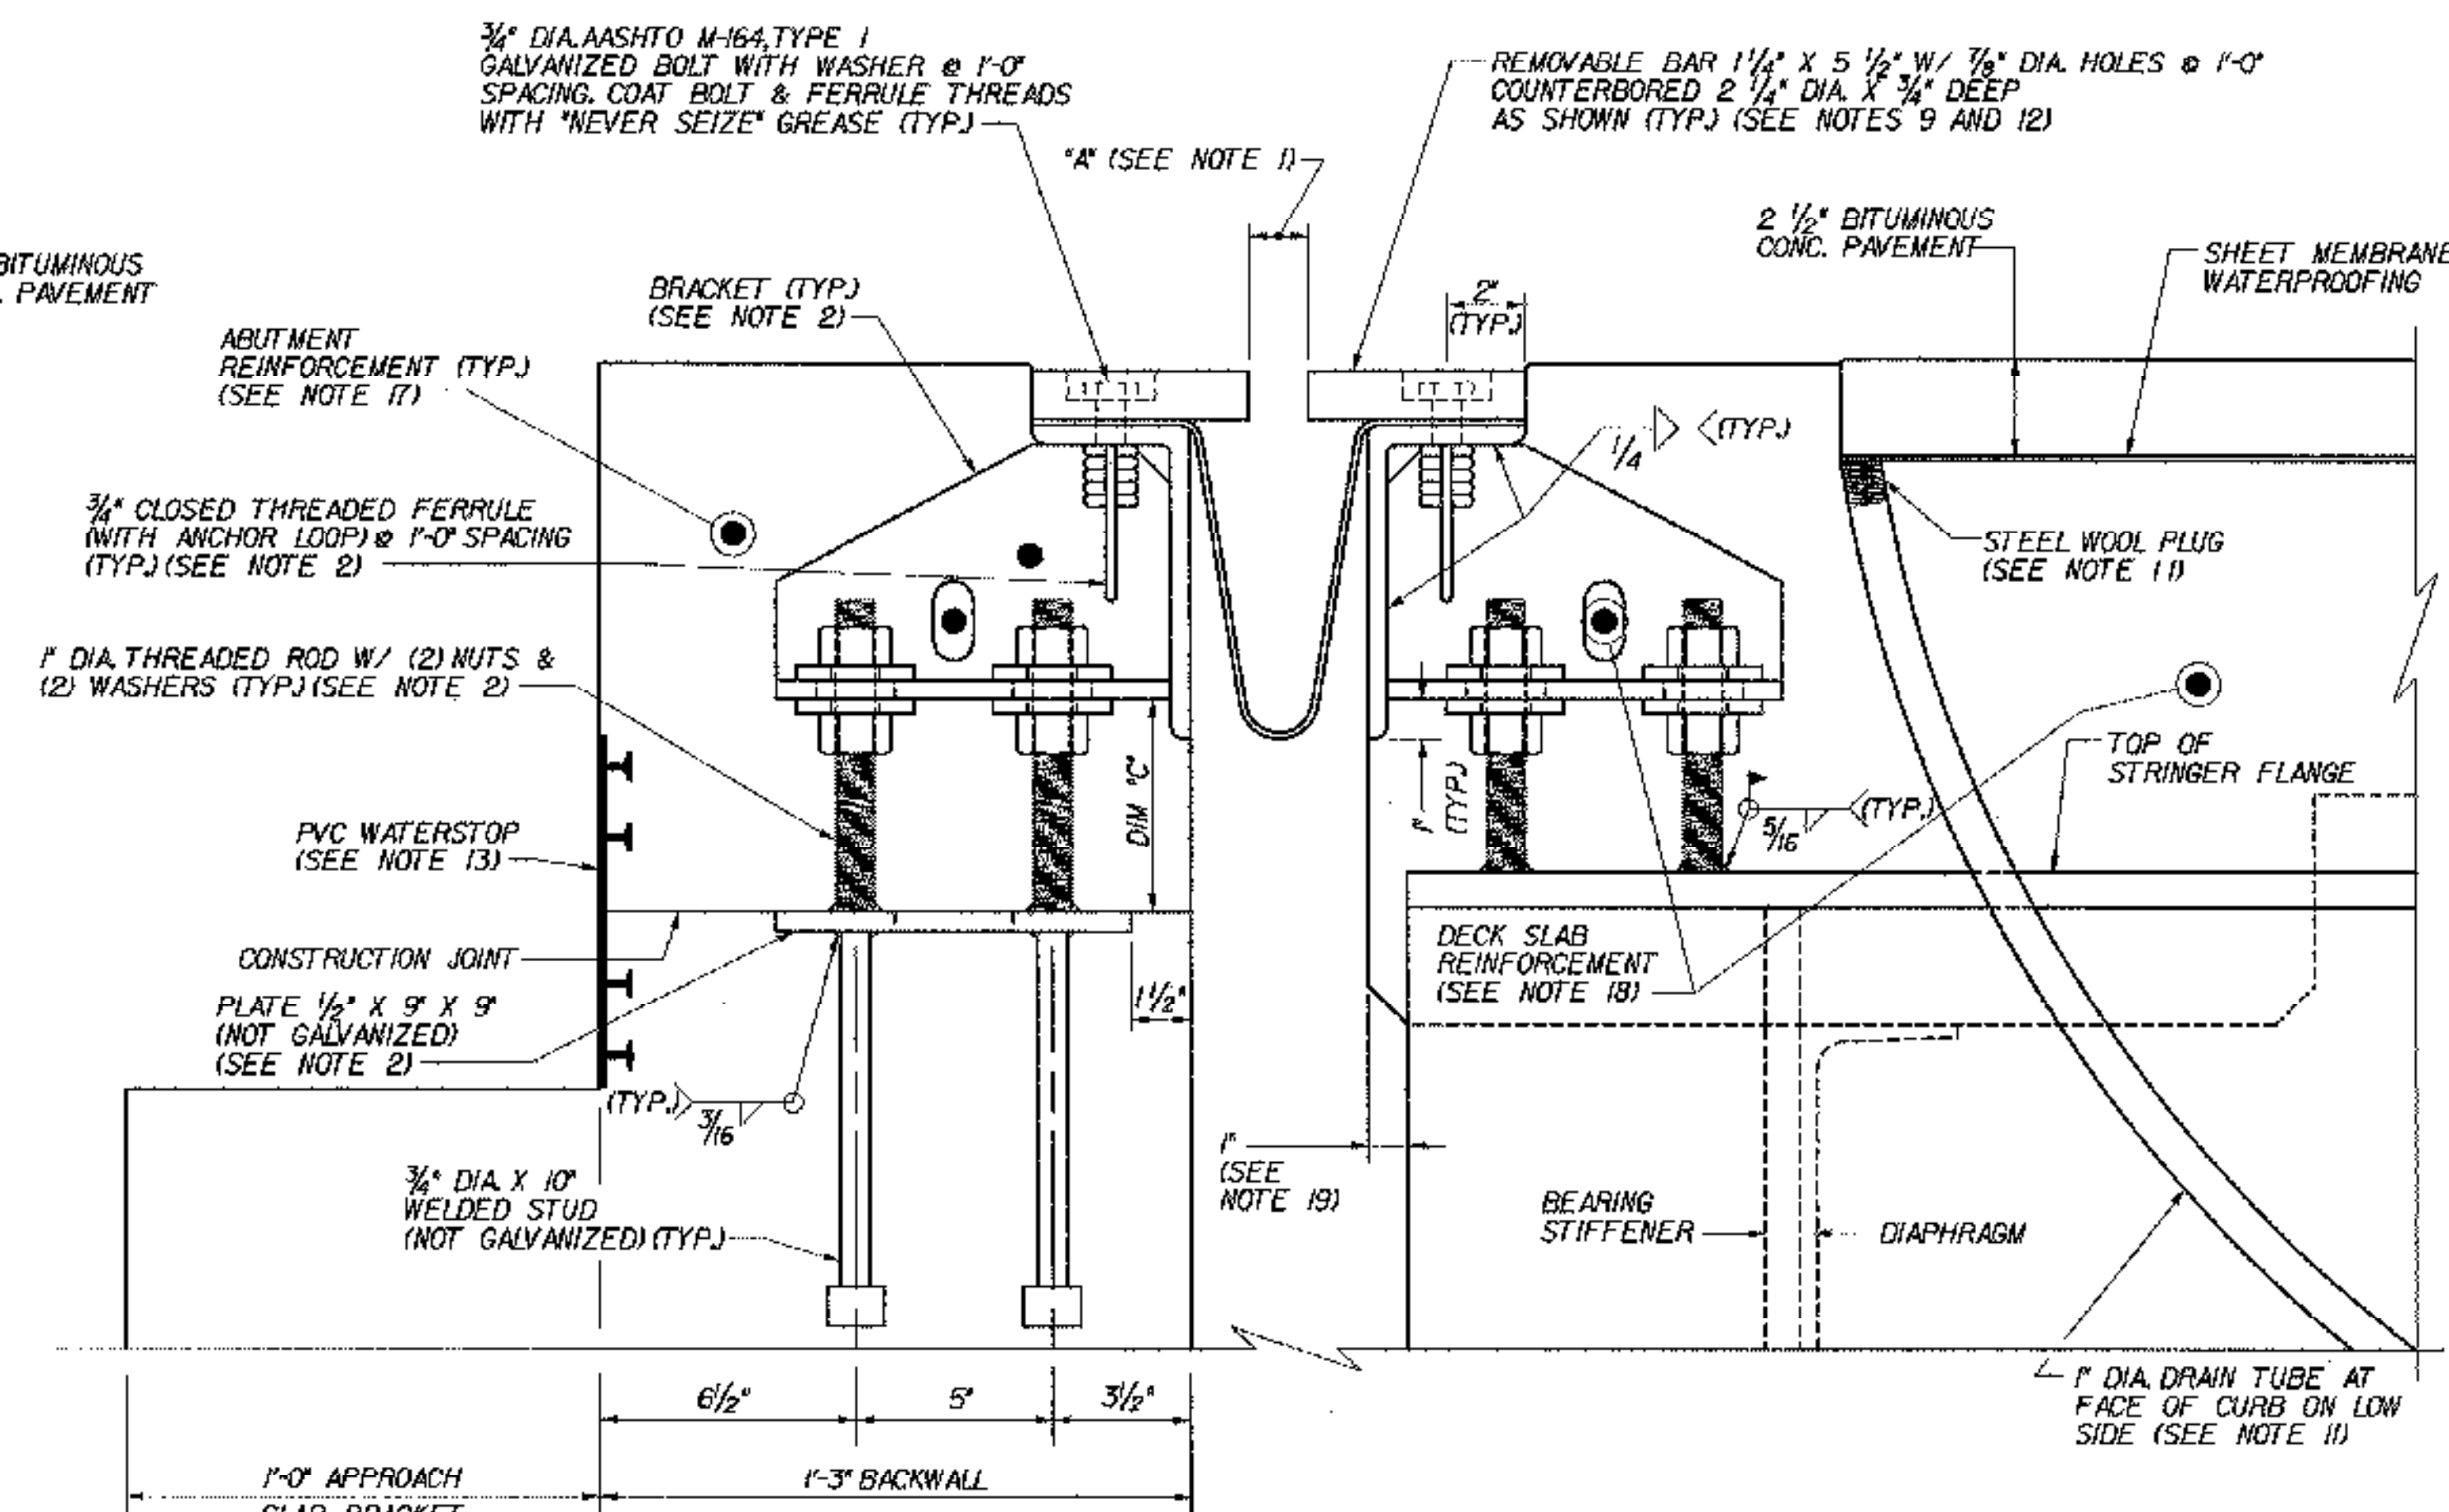

**NOTES:**

- FOR TABLES OF \*A AND \*X DIMENSIONS, SEE TYPE "H" ABUTMENT JOINT DETAILS (2 OF 3), BRIDGE SHEET C-29.
- FOR BRACKET, PLATE, WASHER AND ANCHOR FERRULE DETAILS, SEE TYPE "H" ABUTMENT JOINT DETAILS (2 OF 3), BRIDGE SHEET C-29.
- DETAILS ON THIS SHEET ARE FOR ITEM 516.10, "BRIDGE EXPANSION JOINT".
- PREFORMED FABRIC MATERIAL SHALL BE CONTINUOUS AND SHALL CONFORM TO SUBSECTION 707.07 OF THE SPECIFICATIONS.
- BUTYL RUBBER TAPE SHALL CONFORM TO AASHTO SPECIFICATION M-198, TYPE B.
- THE FINAL FINISH OF THE EXPANSION DEVICE SHALL BE COVERED DURING THE PLACING OF BRIDGE DECK CONCRETE.
- ALL STEEL COMPONENTS SHALL BE AASHTO M270 GRADE 36, UNLESS OTHERWISE SPECIFIED. THREADED ROD AND ASSOCIATED NUTS AND WASHERS SHALL CONFORM TO SUBSECTION 714.08 OF THE SPECIFICATIONS. ALL STEEL COMPONENTS AND HARDWARE SHALL BE GALVANIZED OR METALIZED PER SUBSECTION 506.15 OF THE SPECIFICATIONS, UNLESS OTHERWISE SPECIFIED.
- PAYMENT FOR ITEM 516.10, "BRIDGE EXPANSION JOINT" SHALL INCLUDE THE FABRICATION AND ERECTION OF THE COMPLETE JOINT ASSEMBLY INCLUDING ALL STEEL PLATES, BRACKETS, ANGLES, WELDED STUDS OR RODS, PREFORMED FABRIC DRAIN TROUGH MATERIAL AND PLASTIC DRAIN TUBES, BUTYL RUBBER TAPE AND ANY OTHER MISCELLANEOUS MATERIAL NECESSARY TO INSTALL JOINT.
- THE 4 x 8 x 1/2 ANGLES SHALL BE FURNISHED AS ONE CONTINUOUS PIECE. THE 1 1/4 x 5 1/2 BARS EACH SIDE OF THE JOINT SHALL BE PROVIDED IN TWO EQUAL LENGTHS.

- COAT CONCRETE CONTACT SURFACES WITH EPOXY BONDING COMPOUND MEETING THE REQUIREMENTS OF SUBSECTION 719.02 OF THE SPECIFICATIONS. PAYMENT SHALL BE INCLUDED IN THE UNIT PRICE BID FOR ITEM 516.10, "BRIDGE EXPANSION JOINT".
- A 1" DIAMETER PLASTIC DRAIN TUBE SHALL BE INSTALLED AS SHOWN AT THE FACE OF CURB. THE UPPER END IS TO BE PLUGGED WITH STEEL WOOL AND THE LOWER END IS TO EXTEND BELOW THE BOTTOM OF THE ADJACENT STRINGER. THE DRAIN TUBES SHALL BE FASTENED TO THE STRINGERS USING A METHOD APPROVED BY THE ENGINEER.
- FILL COUNTERBORED HOLES WITH HOT POURED JOINT SEALER AFTER BOLT INSTALLATION. COSTS FOR THE WORK SHALL BE SUBSIDIARY TO ITEM 516.10.
- PAYMENT FOR WATERSTOP SHALL BE SUBSIDIARY TO ITEM 501.25, "CONCRETE CLASS B".
- FABRIC TROUGHS SHALL BE INSTALLED SO THAT MINIMUM SLOPE IS 1/2 FOR POSITIVE DRAINAGE.
- FABRIC TROUGH SHALL BE THOROUGHLY CLEANED AND FLUSHED AFTER PAVING OPERATION.
- EXPANSION JOINTS SHALL BE SHOP ASSEMBLED AND SHIPPED AS ONE UNIT.
- FOR ABUTMENT REINFORCEMENT DETAILS, SEE TYPICAL EXPANSION ABUTMENT REINFORCEMENT, BRIDGE SHEET C-40.
- FOR DECK SLAB REINFORCEMENT, SEE THE TRANSVERSE SECTION AND DECK REINFORCEMENT PLANS FOR EACH BRIDGE.
- THE DIMENSION FROM END OF EXISTING STRINGER TO END OF NEW DECK SLAB SHALL BE 3 1/2" ± AT BR 49N AND 4 3/4" ± AT BR 49S.
- WORK THIS SHEET WITH TYPICAL END OF DECK SLAB DETAILS, BRIDGE SHEET C-15.

BRIDGE	LOCATION	DIM "B"	DIM "C"
43N	ABUT. 2	1'-2"	5'38"
43S	ABUT. 1	1'-2"	5'38"
49N	ABUT. 2	1'-1"	4'38"
49S	ABUT. 2	1'-1"	4'38"
50N	ABUT. 2	1'-2"	5'38"
50S	ABUT. 1	1'-2"	5'38"
51N	ABUT. 2	1'-2"	5'38"
51S	ABUT. 2	1'-2"	5'38"

\* THESE DIMENSIONS ARE THEORETICAL AND MAY CHANGE DEPENDING UPON THE OUTCOME OF THE STRINGER PROFILES.

**STATE OF VERMONT  
AGENCY OF TRANSPORTATION**


Town Of	MIDDLESEX-BOLTON	Bridge No.	
Highway No.	I-89	Log Sta.	
		Surv. Sta.	

**TYPE "H" ABUTMENT JOINT DETAILS (1 OF 3)**


Designed By	P.W. SZUSTAK	Drawn By	R.A. BOYZENHART
Checked By	Date	Bridge Design Supervisor	Date
J.P. HALSTEAD	10/99	J.P. HALSTEAD	10/99

PROJECT	MIDDLESEX-BOLTON	PROJECT NO.	IM-089-2(26)
---------	------------------	-------------	--------------


TVGA CAD Drawing No.	h-jointd	Date	10/99
Bridge Sheet No.	C-28	Sheet	28 of 307

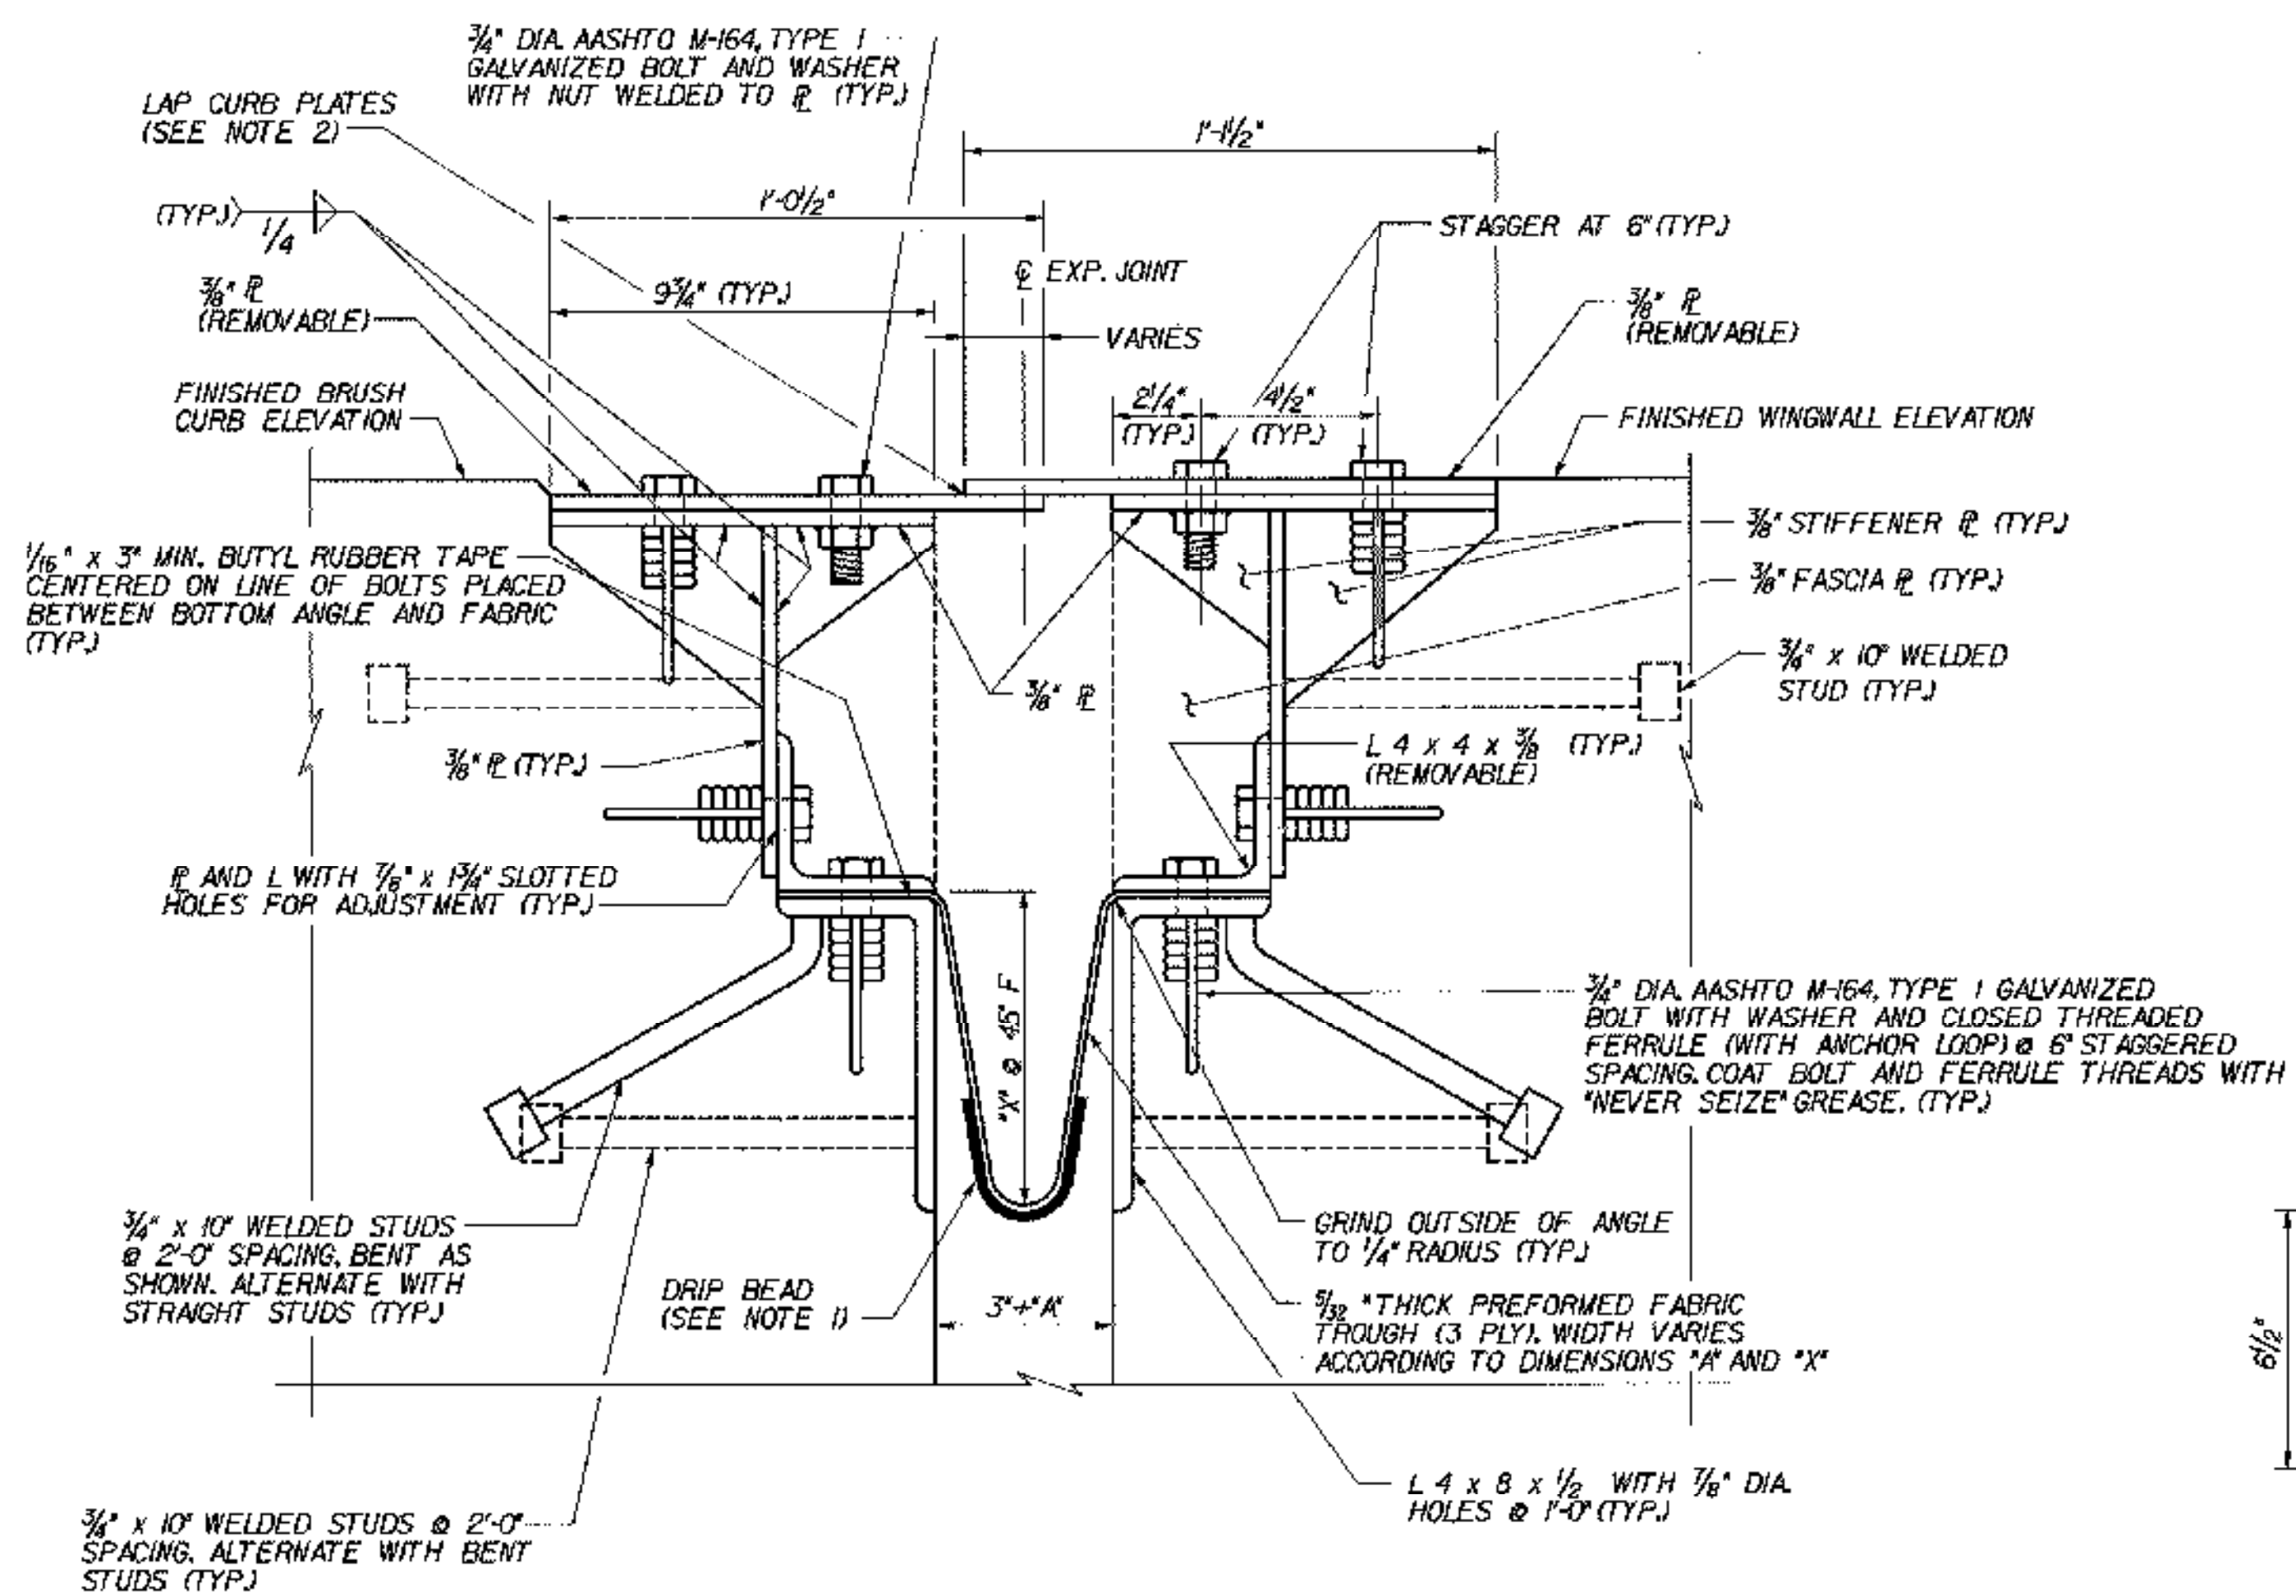

**TYPICAL SECTION AT ARMORED BRUSH CURB**  
(NORMAL TO  $\hat{C}$  BEARING)  
SCALE: 3" = 1'-0"

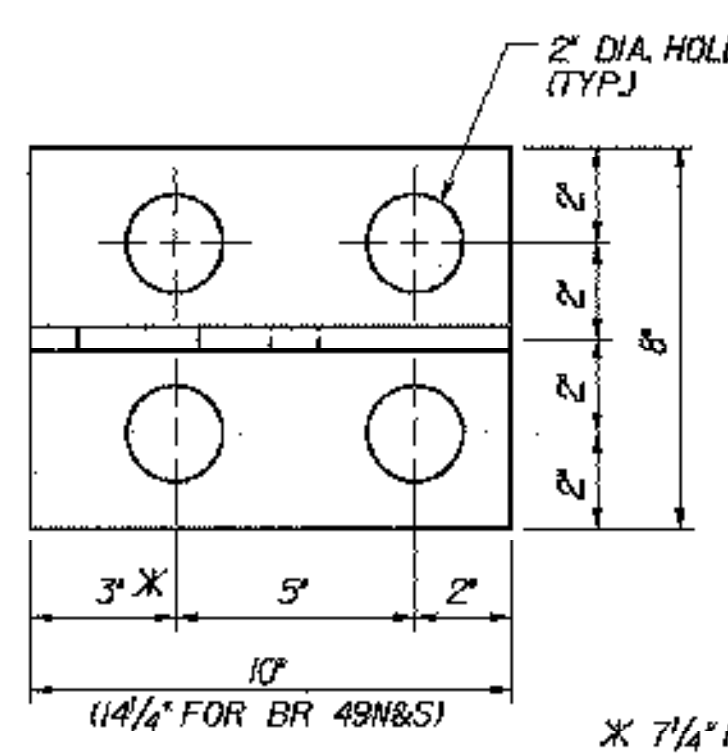


**BRACKET PLAN**  
SCALE: 3" = 1'-0"

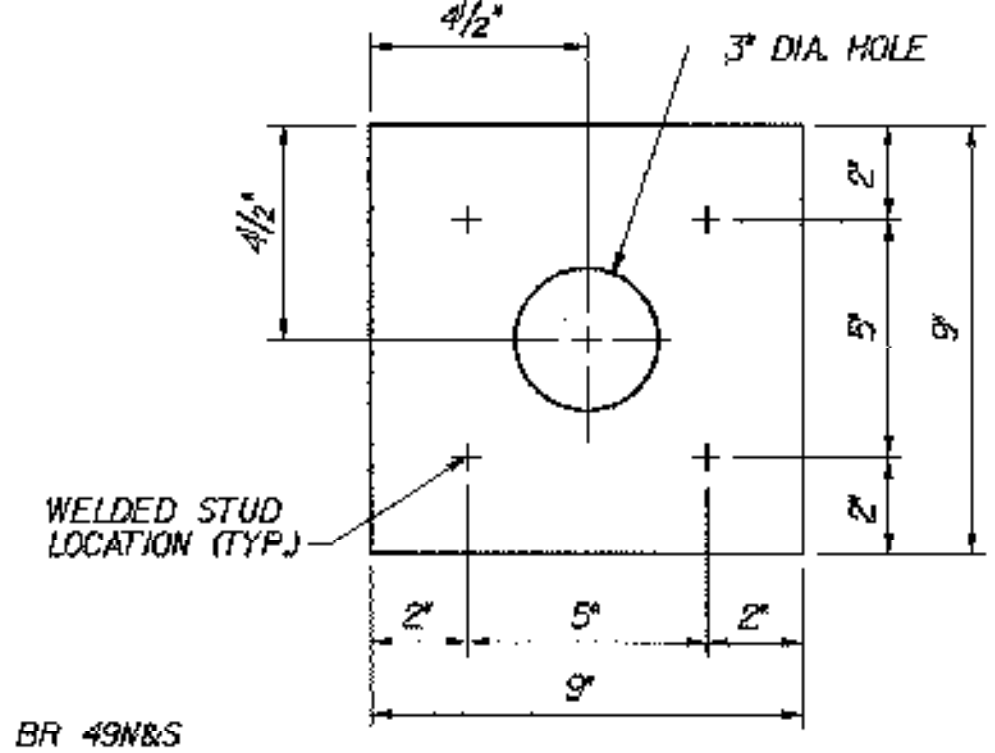


**PLATE PLAN**  
(NOT GALVANIZED)  
SCALE: 3" = 1'-0"

NOTE: ALL PLATES 1/2" THICK

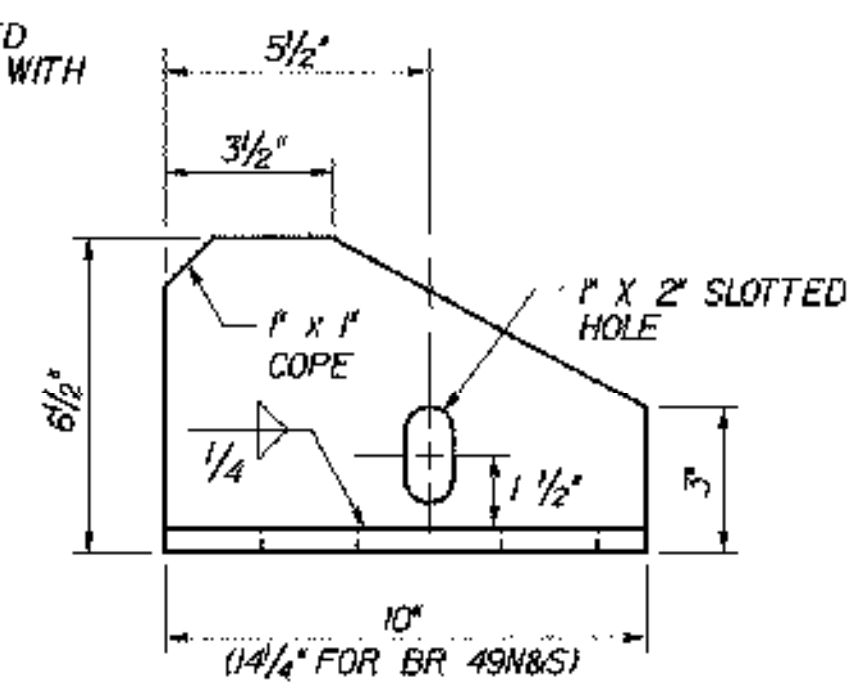

**BRACKET ELEVATION**  
SCALE: 3" = 1'-0"

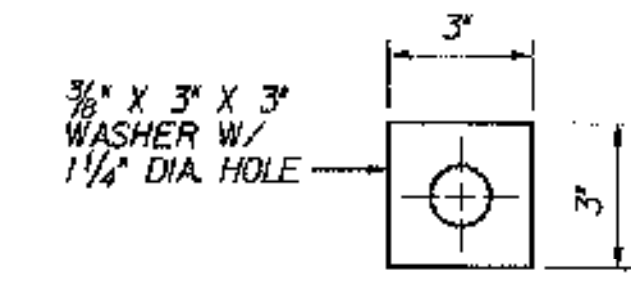

**WASHER FOR BRACKET**  
SCALE: 3" = 1'-0"




**ANCHOR FERRULE DETAIL**  
SCALE: 3" = 1'-0"

BRIDGE	EXPANSION JOINT LOCATION	"X" @ 45° F		
		@ LEFT FASCIA	@ CL CONST.	@ RIGHT FASCIA
43N	ABUT.2	8"	9 1/2"	9 1/2"
43S	ABUT.1	8"	11"	11"
49N	ABUT.2	8"	8"	8"
49S	ABUT.2	8"	8"	8"
50N	ABUT.2	8"	8"	8"
50S	ABUT.1	8"	8"	8"
51N	ABUT.2	8"	8"	8"
51S	ABUT.2	8"	8"	8"

**NOTES:**

- A DRIP BEAD OF 1/4" x 7" STRIP OF PREFORMED MATERIAL SHALL BE CEMENTED TO THE BOTTOM OF THE FABRIC TROUGH USING AN ADHESIVE APPROVED BY THE MANUFACTURER. THE DRIP BEAD SHALL BE APPLIED 1" FROM THE DOWNSPOUT END OF THE TROUGH.
- LAP CURB PLATES IN DIRECTION OF TRAFFIC. FOR DIRECTION OF LAP AT EACH EXPANSION JOINT LOCATION, SEE TABLE ON TYPICAL TYPE "H" ABUTMENT JOINT PLAN, BRIDGE SHEET C-27.

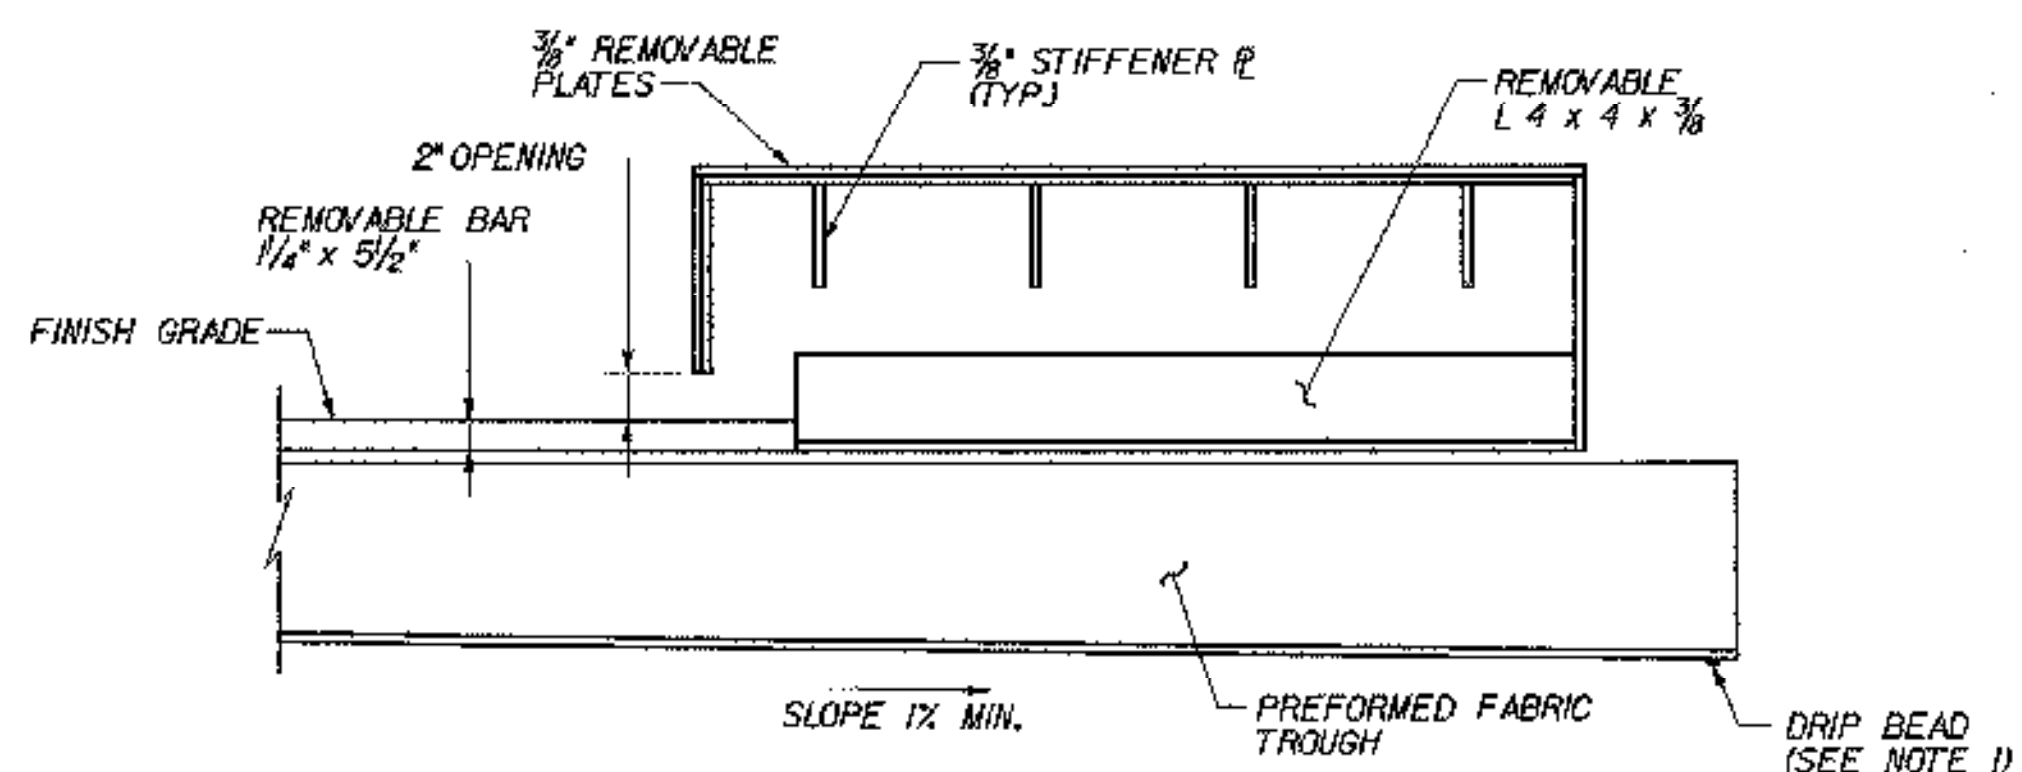

**LONGITUDINAL SECTION THROUGH ARMORED BRUSH CURB**  
N.T.S.

BRIDGE	LOCATION	"A" DIMENSION							
		0° F	15° F	30° F	45° F	60° F	75° F	90° F	105° F
43N	ABUT.2	15/8"	1 1/2"	1 3/8"	1 3/16"	1 1/16"	0 15/16"	0 13/16"	0 5/8"
43S	ABUT.1	1 13/16"	1 5/8"	1 1/2"	1 5/16"	1 3/16"	1"	0 13/16"	0 11/16"
49N	ABUT.2	1 7/16"	1 5/16"	1 3/16"	1 1/16"	0 15/16"	0 13/16"	0 3/4"	0 5/8"
49S	ABUT.2	1 7/16"	1 5/16"	1 3/16"	1 1/16"	0 15/16"	0 13/16"	0 3/4"	0 5/8"
50N	ABUT.2	2 1/16"	1 7/8"	1 11/16"	1 1/2"	1 5/16"	1 1/16"	0 7/8"	0 11/16"
50S	ABUT.1	1 15/16"	1 3/4"	1 9/16"	1 3/8"	1 3/16"	1"	0 7/8"	0 11/16"
51N	ABUT.2	2 1/8"	1 15/16"	1 3/4"	1 1/2"	1 5/16"	1 1/8"	0 15/16"	0 11/16"
51S	ABUT.2	2 1/8"	1 7/8"	1 11/16"	1 1/2"	1 5/16"	1 1/8"	0 7/8"	0 11/16"


**STATE OF VERMONT AGENCY OF TRANSPORTATION**

Town Of	MIDDLESEX-BOLTON	Bridge No.	
Highway No.	1-89	Log Sta.	
		Surv. Sta.	

**TYPE "H" ABUTMENT JOINT DETAILS (2 OF 3)**


Designed By	P.W. SZUSTAK	Drawn By	R.A. BOTZENHART
Checked By	J.P. HALSTEAD	Bridge Design Supervisor	J.P. HALSTEAD
Date	10/99	Date	10/99

PROJECT	MIDDLESEX-BOLTON	PROJECT NO.	IM-089-2(26)
---------	------------------	-------------	--------------

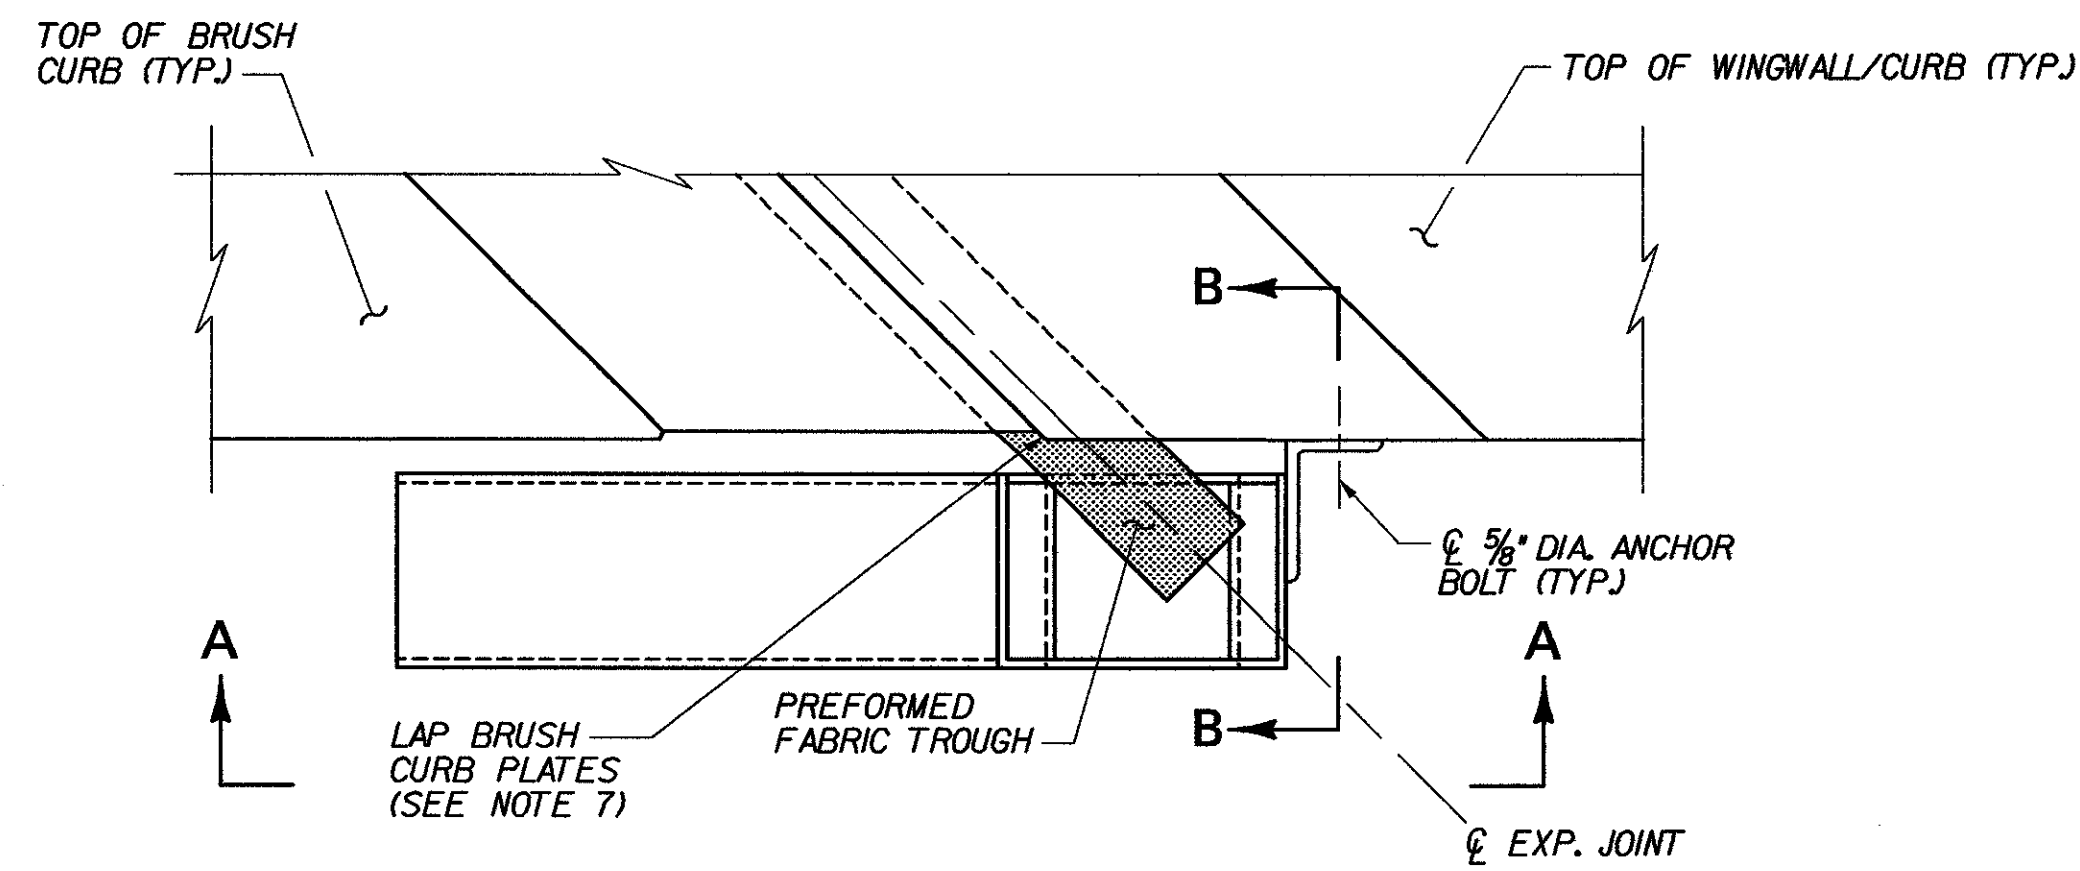


**HOPPER LOCATION PLAN**

SCALE: 1/2" = 1'-0"

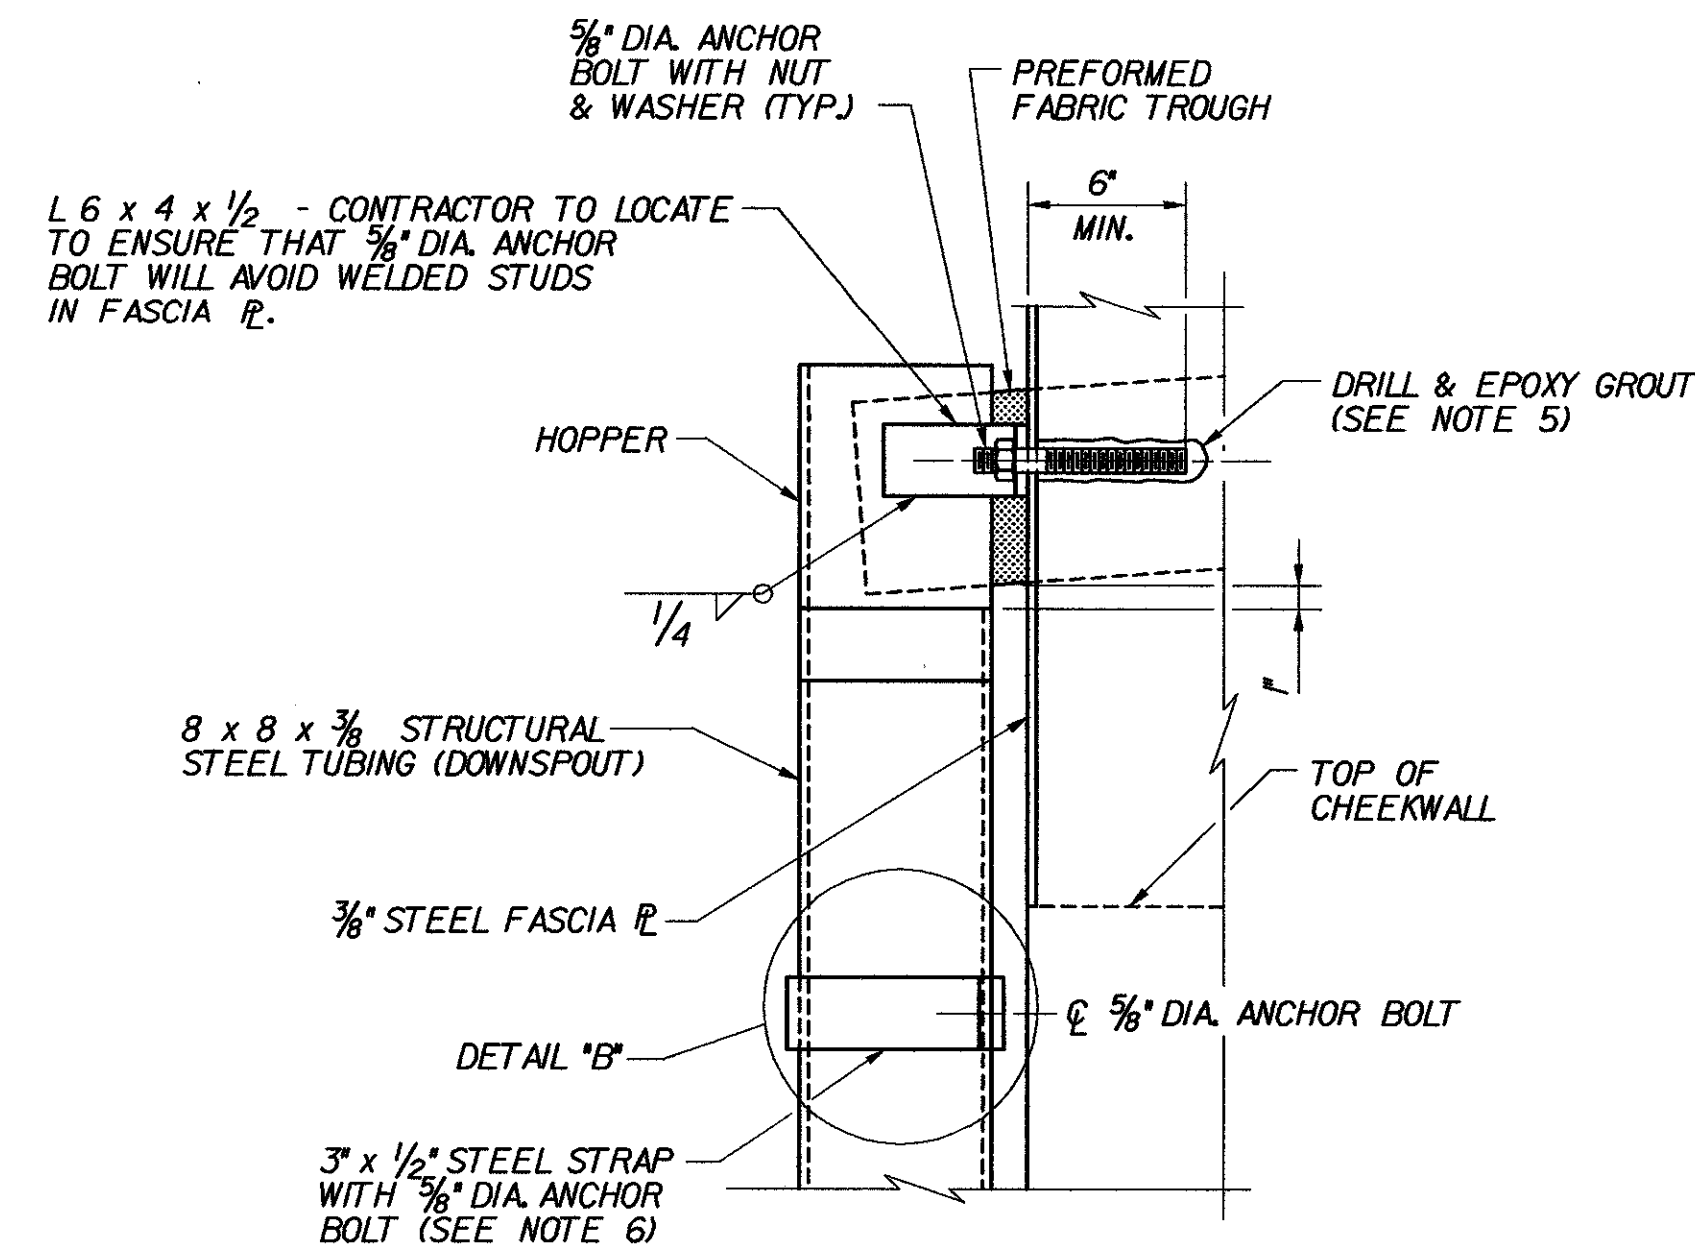

**SECTION B-B**

SCALE: 1/2" = 1'-0"

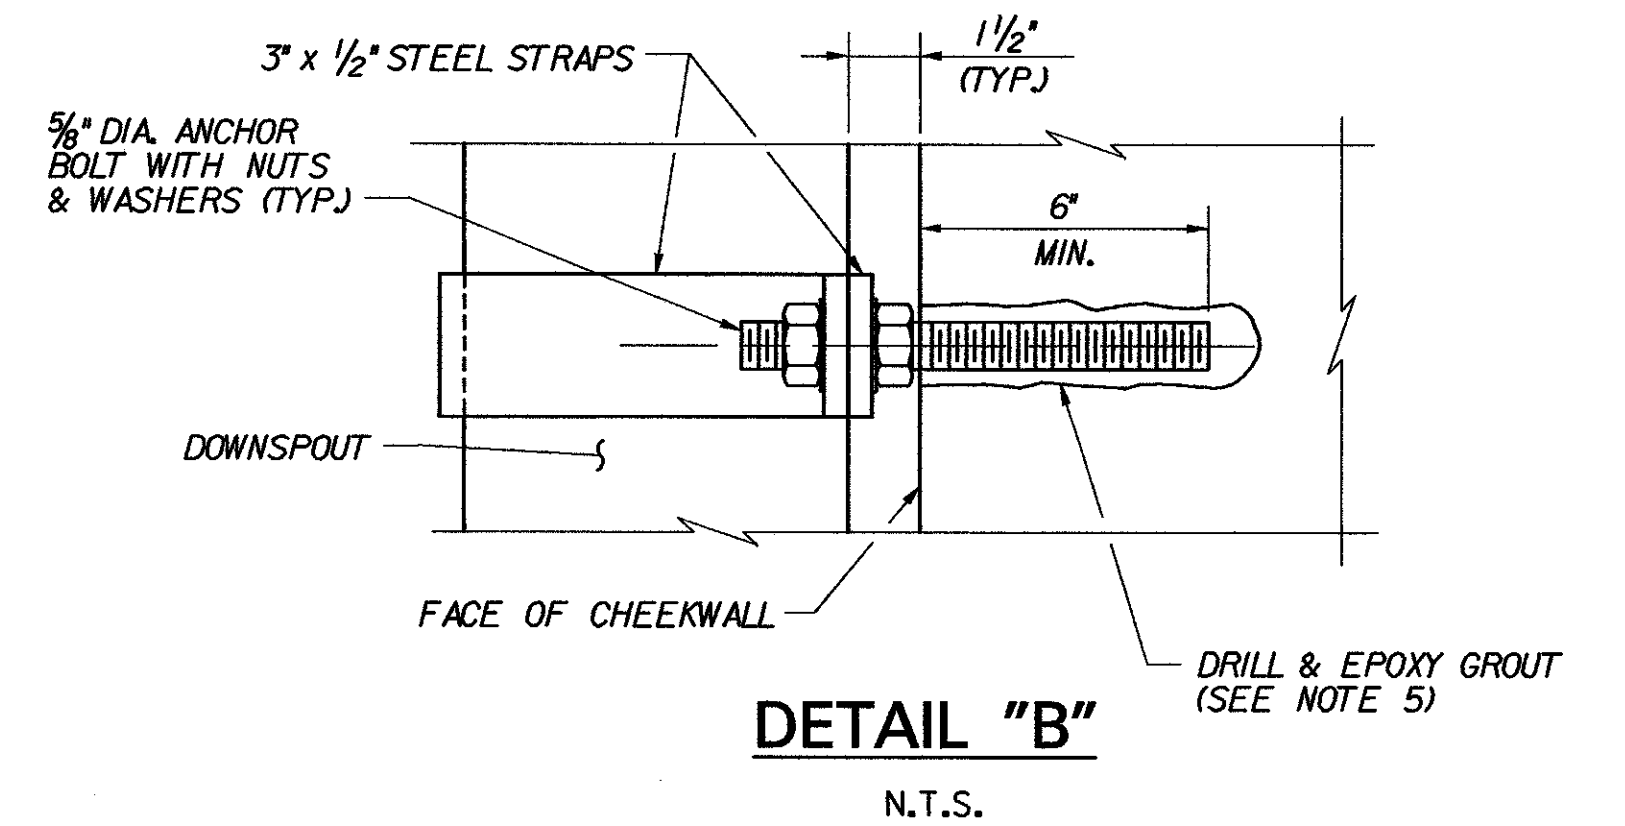


**DETAIL "B"**

N.T.S.


**NOTES:**

1. WORK THIS SHEET WITH TYPICAL TYPE "H" ABUTMENT JOINT PLAN, BRIDGE SHEET C-27, TYPE "H" ABUTMENT JOINT DETAILS (1 OF 3), BRIDGE SHEET C-28, AND TYPICAL TYPE "H" ABUTMENT JOINT DETAILS (2 OF 3), BRIDGE SHEET C-29.
2. HOPPERS AND ALL COMPONENTS SHALL BE AASHTO M270 GRADE 36 STEEL. STRUCTURAL TUBING (DOWNSPOUT) SHALL BE ASTM A-500 OR A-501 STEEL. ALL STEEL SHALL BE GALVANIZED OR METALIZED IN ACCORDANCE WITH SECTION 506.15 OF THE SPECIFICATIONS. ALL HOPPER AND DOWNSPOUT WORK SHALL BE PAID FOR UNDER ITEM 506.60, "STRUCTURAL STEEL".
3. HOPPERS SHALL BE FABRICATED FROM 3/8" STEEL PLATE. THE FABRICATION WELDS SHALL BE 1/4" FILLET WELDS ON THE INSIDE OF THE HOPPER AND SHALL BE FULL LENGTH TO ENSURE A WATERTIGHT CONTAINER.
4. THE HOPPERS SHALL BE PLACED TO LEAVE A ONE INCH VERTICAL GAP BETWEEN THE BOTTOM OF THE TROUGH AND THE HOPPER. THE TROUGH SHOULD BE ENCLOSED AS MUCH AS POSSIBLE BY THE HOPPER BUT SHOULD NOT BE BENT OR BUCKLED TO RESTRICT THE FLOW OF WATER.
5. ANCHOR BOLTS, NUTS AND WASHERS SHALL CONFORM TO SUBSECTION 714.08 OF THE SPECIFICATIONS, AND BE GALVANIZED IN ACCORDANCE WITH SUBSECTION 506.15. ANCHOR BOLTS SHALL BE DRILLED AND EPOXY GROUTED 6" MINIMUM INTO THE CONCRETE. DRILL AND EPOXY GROUT SYSTEM SHALL BE:
  - DAYTON SUPERIOR SURE-ANCHOR J-51 SYSTEM
  - HILTI, INC. HIT HY-150 SYSTEM
  - UNITEX PRO-POXY 300 FAST SYSTEM
 OR EQUIVALENT APPROVED BY VAOT MATERIALS SECTION. ALL COSTS FOR DRILLING AND EPOXY GROUTING ANCHOR BOLTS SHALL BE SUBSIDIARY TO ITEM 506.60, "STRUCTURAL STEEL".
6. STRAPS SHALL NOT BE BENT IN THE FIELD.
7. LAP CURB PLATES IN DIRECTION OF TRAFFIC. FOR DIRECTION OF LAP AT EACH EXPANSION JOINT LOCATION, SEE TABLE ON TYPICAL TYPE "H" ABUTMENT JOINT PLAN, BRIDGE SHEET C-27.

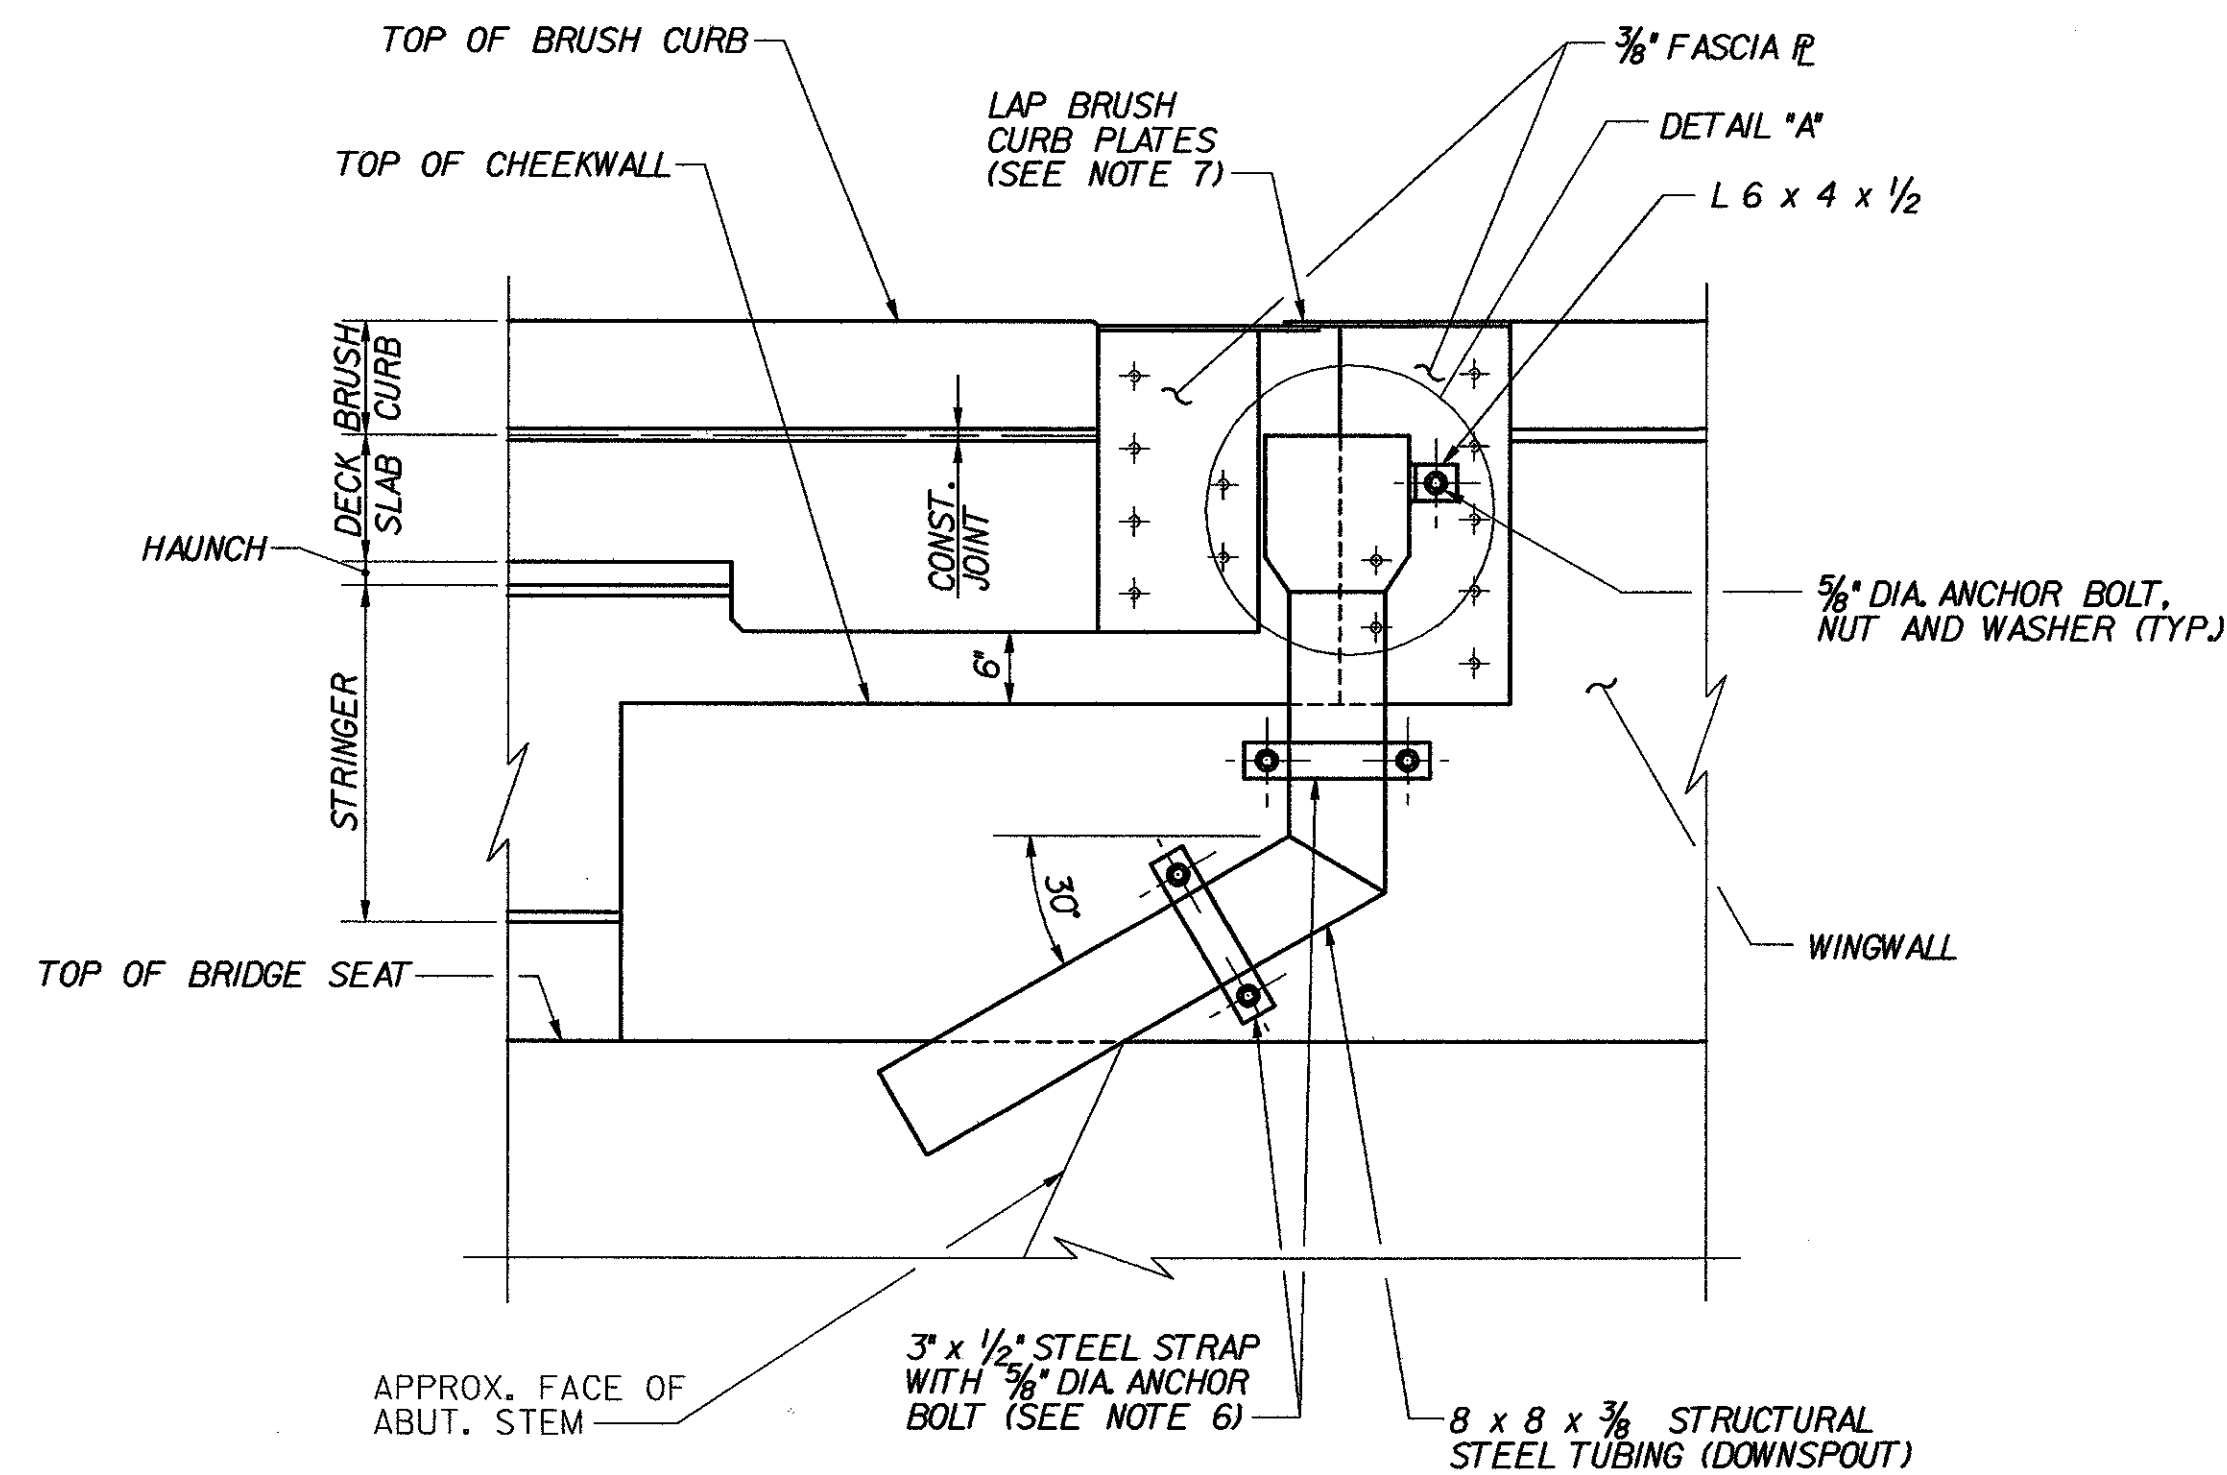

**ELEVATION A-A**

N.T.S.

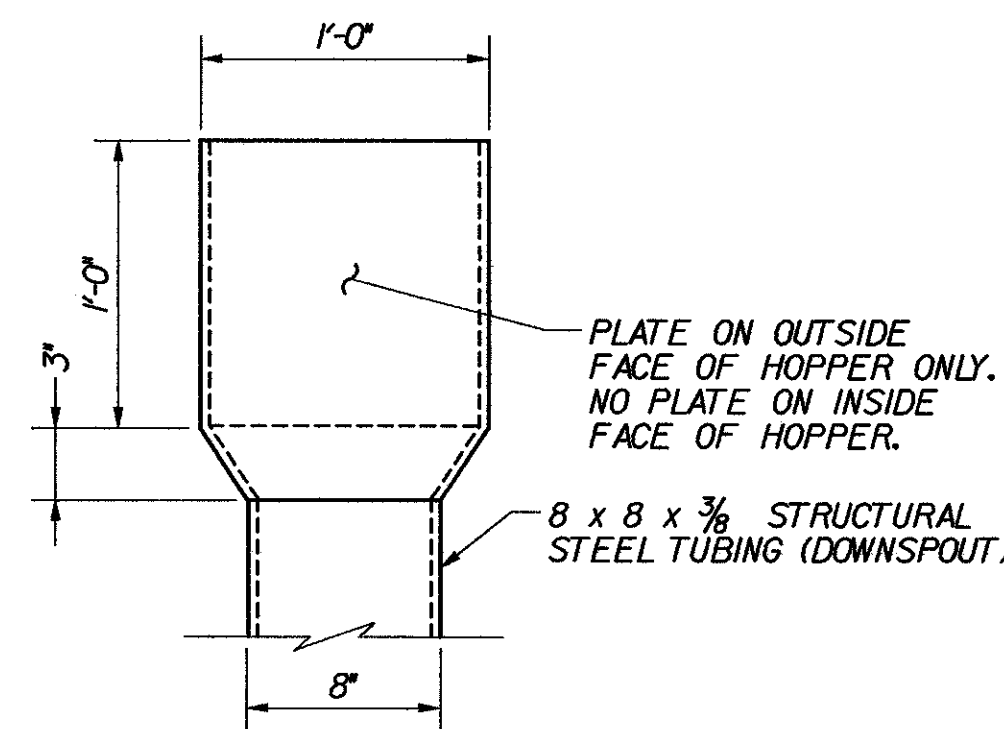

**DETAIL "A"**

SCALE: 1/2" = 1'-0"

**STATE OF VERMONT  
AGENCY OF TRANSPORTATION**


Town Of	MIDDLESEX-BOLTON	Bridge No.	
Highway No.	I-89	Log Sta.	
		Surv. Sta.	

**TYPE "H" ABUTMENT JOINT DETAILS (3 OF 3)**

Designed By	P.W. SZUSTAK	Drawn By	R.A. BOTZENHART
Checked By	J.P. HALSTEAD	Date	10/99
		Bridge Design Supervisor	J.P. HALSTEAD Date 10/99

PROJECT	MIDDLESEX-BOLTON	PROJECT NO.	IM-089-2(26)
---------	------------------	-------------	--------------


TVGA CAD Drawing No.	h-jointd3	Date	10/99
Bridge Sheet No.	C-30	Sheet	30 of 307

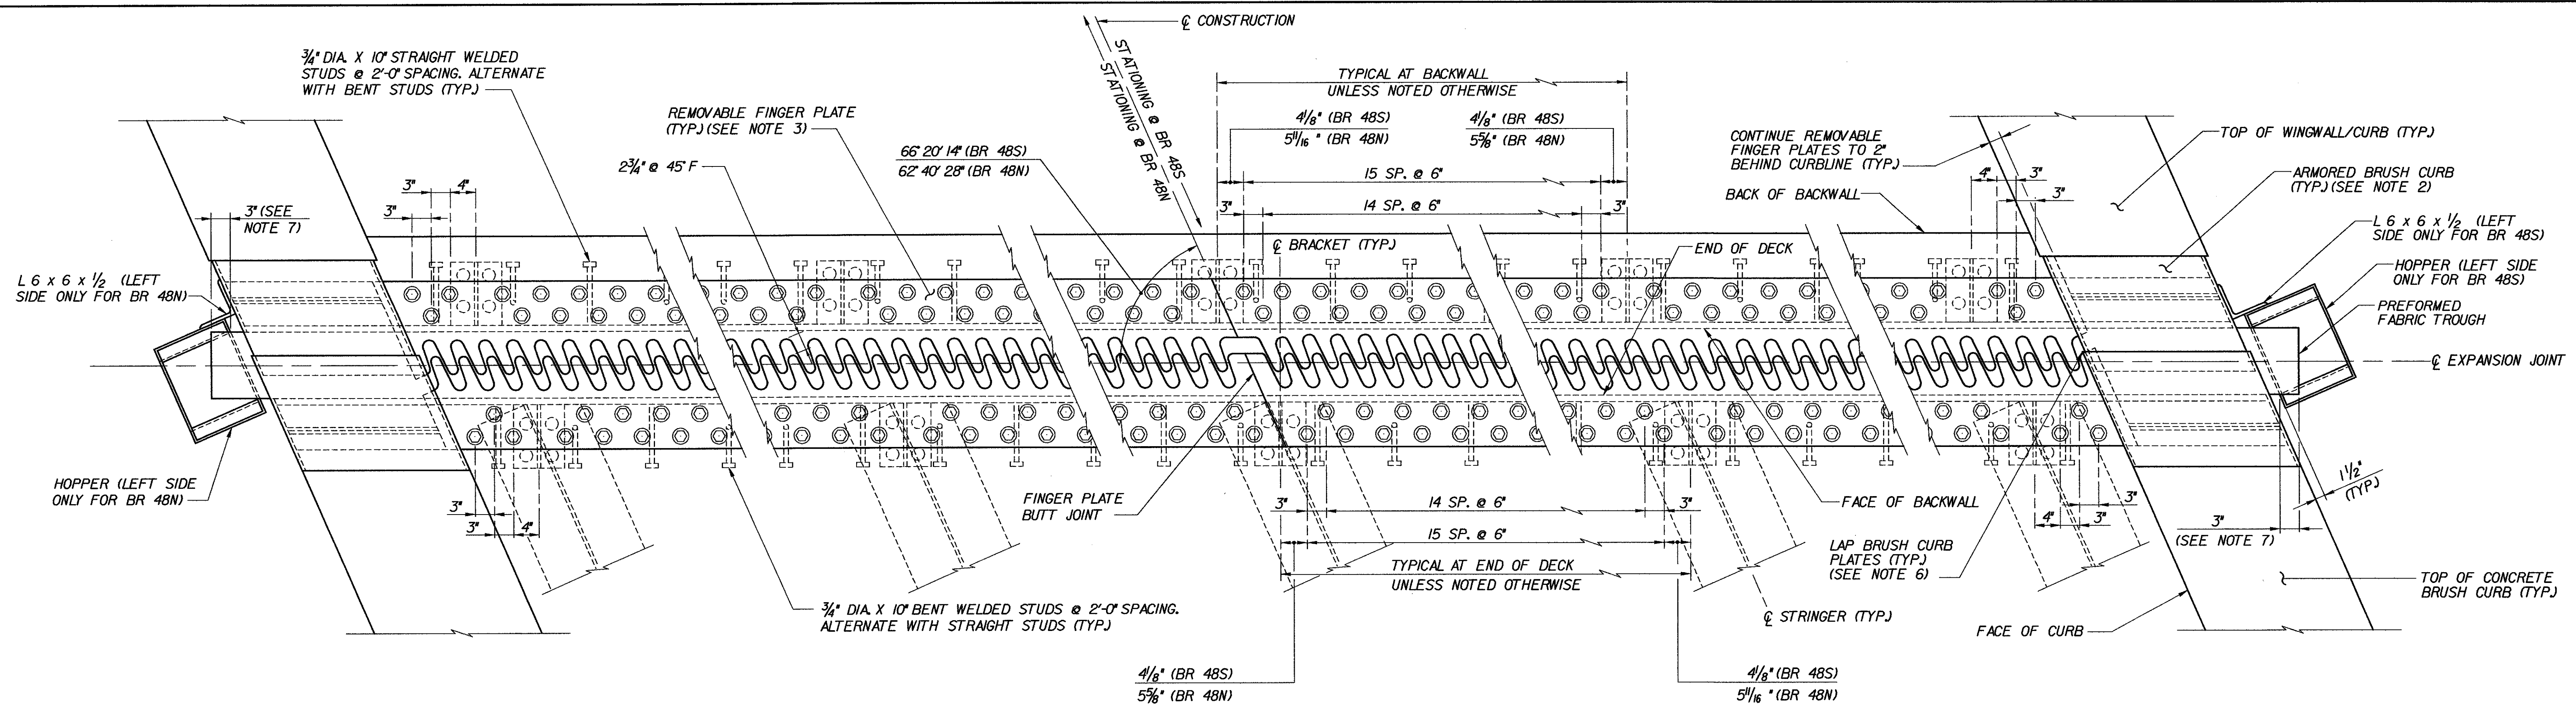

(STUDS NOT SHOWN IN BRUSH CURB FOR CLARITY)

**TYPICAL FINGER PLATE EXPANSION JOINT PLAN**


SCALE : 1" = 1'-0"

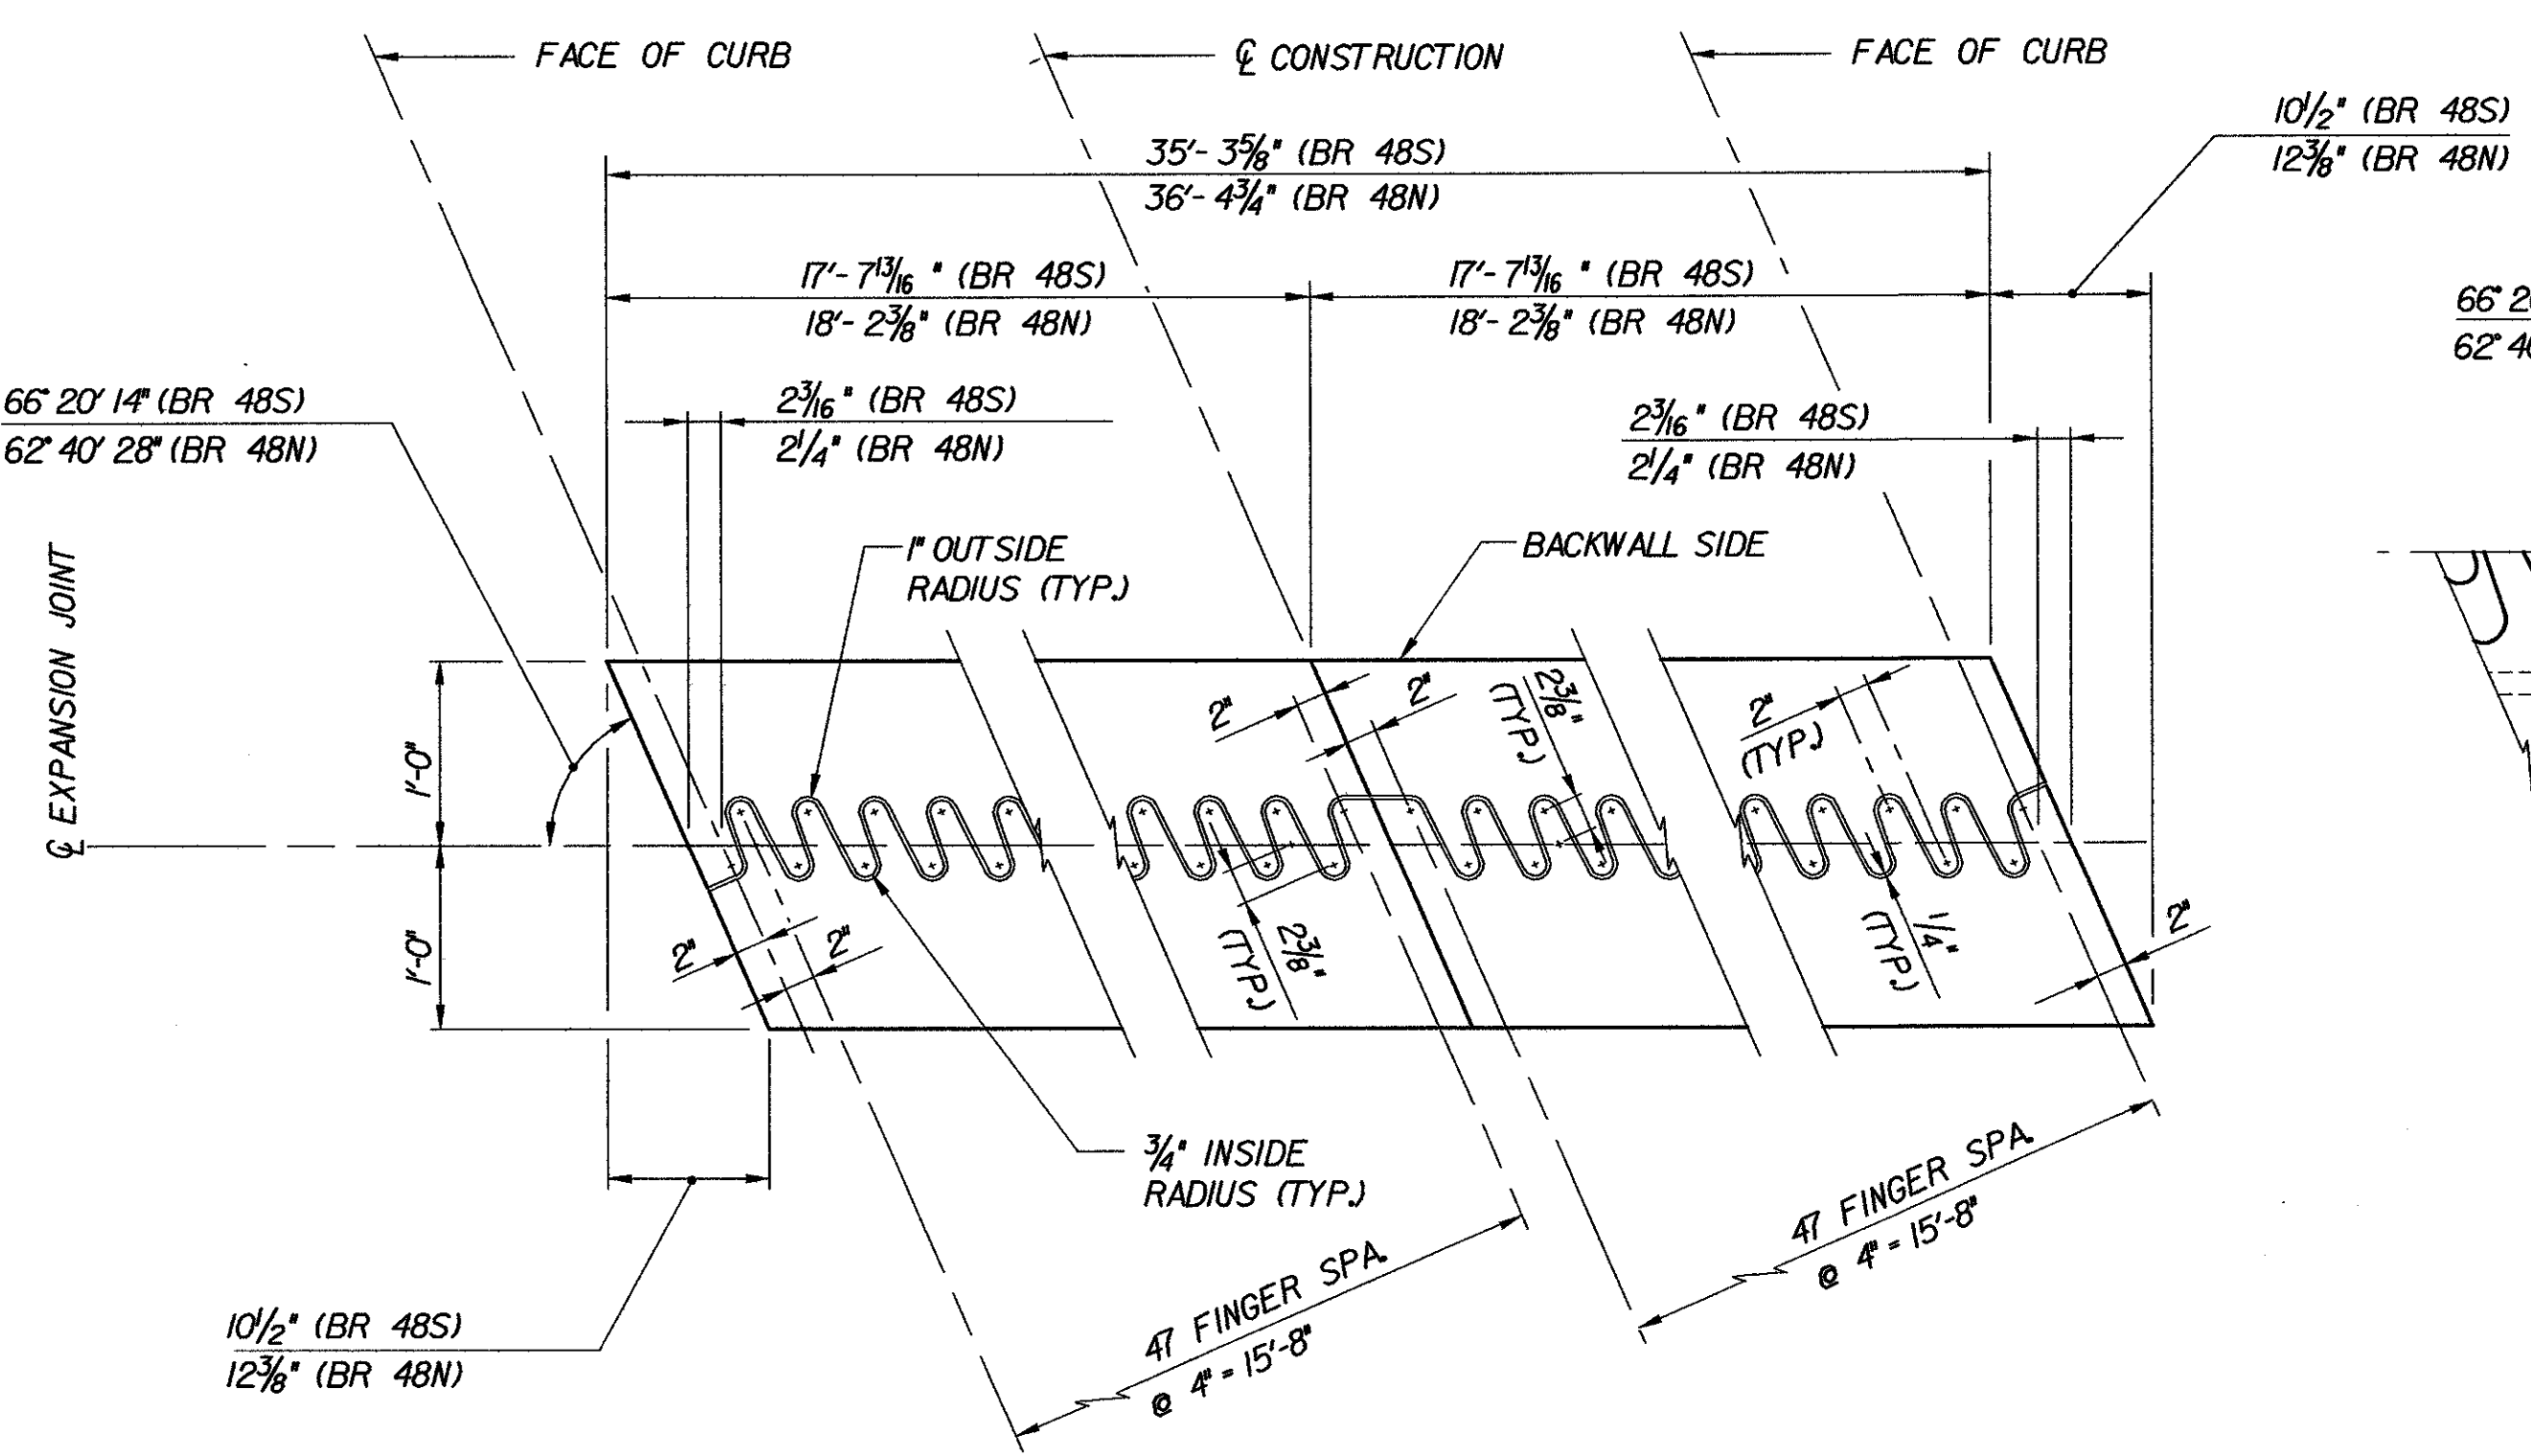

NOTE : ALL DIMENSIONS ARE TYPICAL FOR BOTH JOINTS EXCEPT AS NOTED (BR 48N OR BR 48S).

**CUTTING DETAIL**

NOT TO SCALE

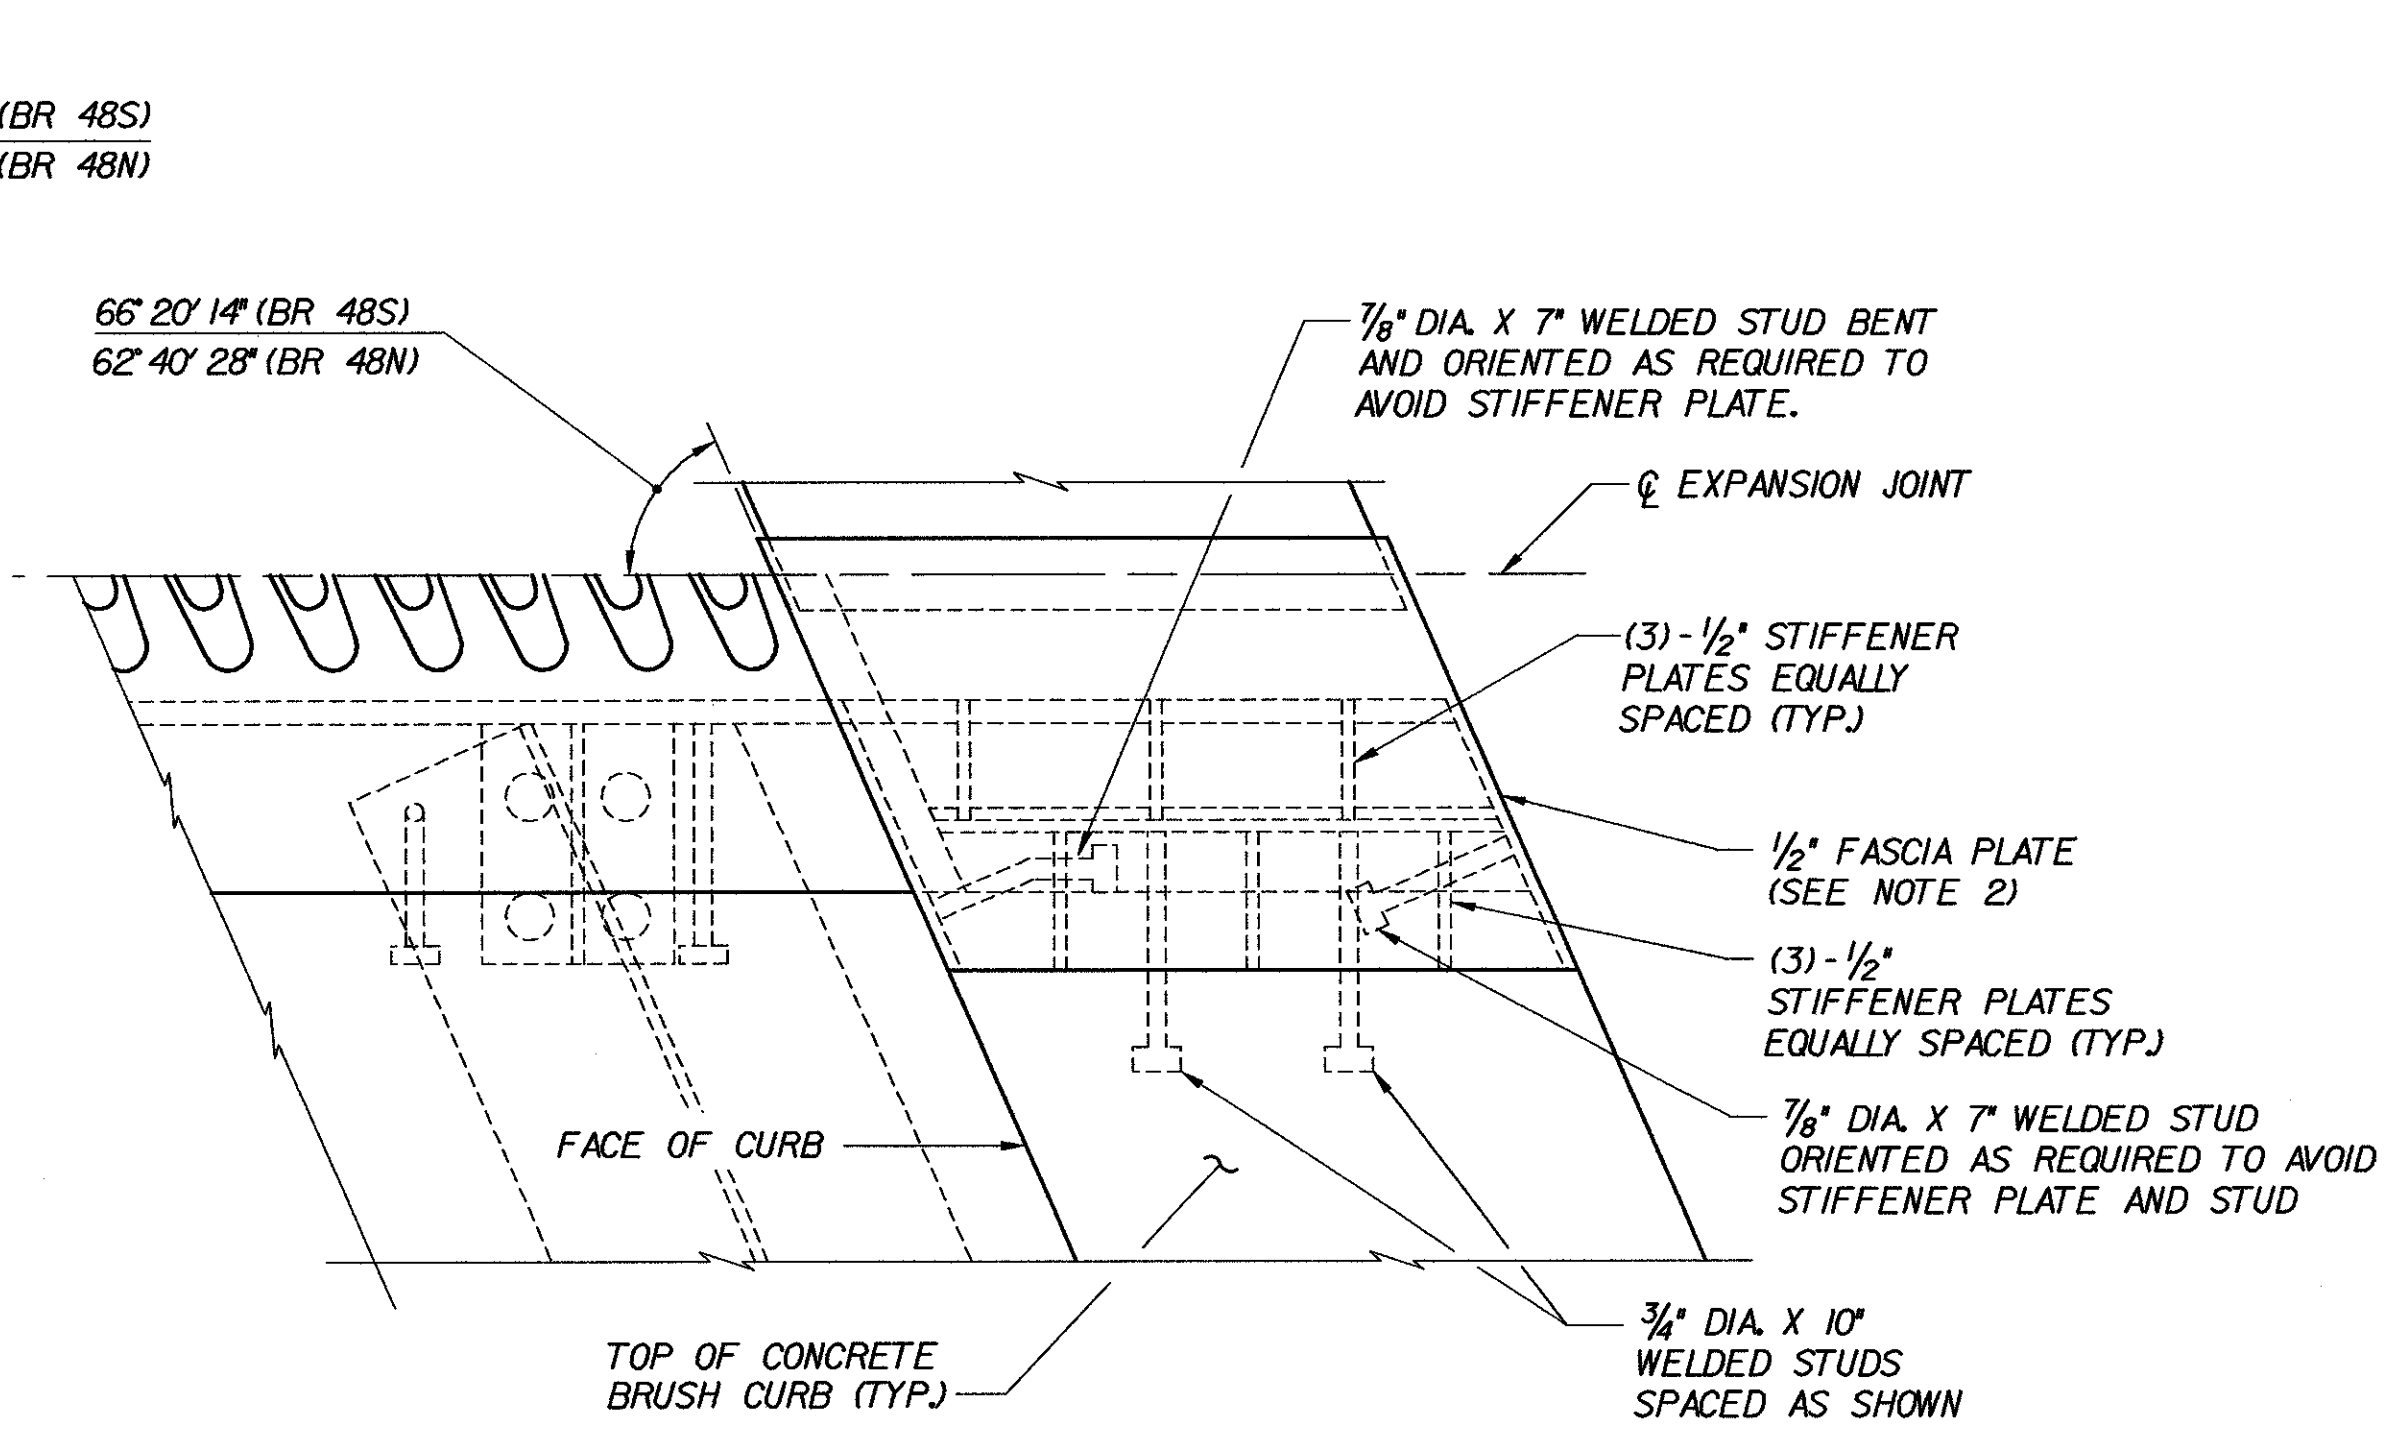

(ONE QUADRANT OF ARMORED BRUSH CURB SHOWN. ALL OTHER QUADRANTS SIMILAR.)

**ARMORED BRUSH CURB PLAN DETAIL**

SCALE : 1 1/2" = 1'-0"

**NOTES :**

1. TOP AND FACE OF BRUSH CURB ARE ATTACHED BY BOLTS AND ARE REMOVABLE TO ALLOW CLEANING AND/OR REPLACEMENT OF FABRIC TROUGH.
2. FOR TYPICAL SECTIONS OF EXPANSION JOINT AND ARMORED BRUSH CURB, SEE BRIDGE SHEETS C-36 AND C-37.
3. FINGER PLATES IN ROADWAY ARE REMOVABLE TO ALLOW CLEANING AND/OR REPLACEMENT OF FABRIC TROUGH.
4. THE DETAILS SHOWN ON THIS SHEET SHALL BE COORDINATED WITH THE DETAILS SHOWN ON BRIDGE SHEETS C-36, C-37 AND C-38.
5. SEE BRIDGE SHEET C-37 FOR TEMPERATURE ADJUSTMENT TABLE.
6. LAP BRUSH CURB PLATES IN DIRECTION OF TRAFFIC.
7. WHERE HOPPER IS NOT REQUIRED (RIGHT SIDE OF BR 48N&S), PREFORMED FABRIC DRAIN TROUGH SHALL BE TERMINATED 2" INSIDE THE ARMORED BRUSH CURB.

**STATE OF VERMONT AGENCY OF TRANSPORTATION**


Town Of	MIDDLESEX-BOLTON	Bridge No.	
Highway No.	1-89	Log Sta.	
		Surv. Sta.	

**TYPICAL FINGER JOINT PLAN**



Designed By	K.L. JAMES	Drawn By	N.J. HOYT
Checked By	M.H. GALLO	Date	10/99
		Bridge Design Supervisor	J.P. HALSTEAD Date 10/99

PROJECT	MIDDLESEX-BOLTON	PROJECT NO.	IM-089-2(26)
TVGA CAD Drawing No.	127fjl.dgn	Date	10/99
Bridge Sheet No.	C-35	Sheet	35 of 307

**Hayashi Corporation**  
Consulting Engineers

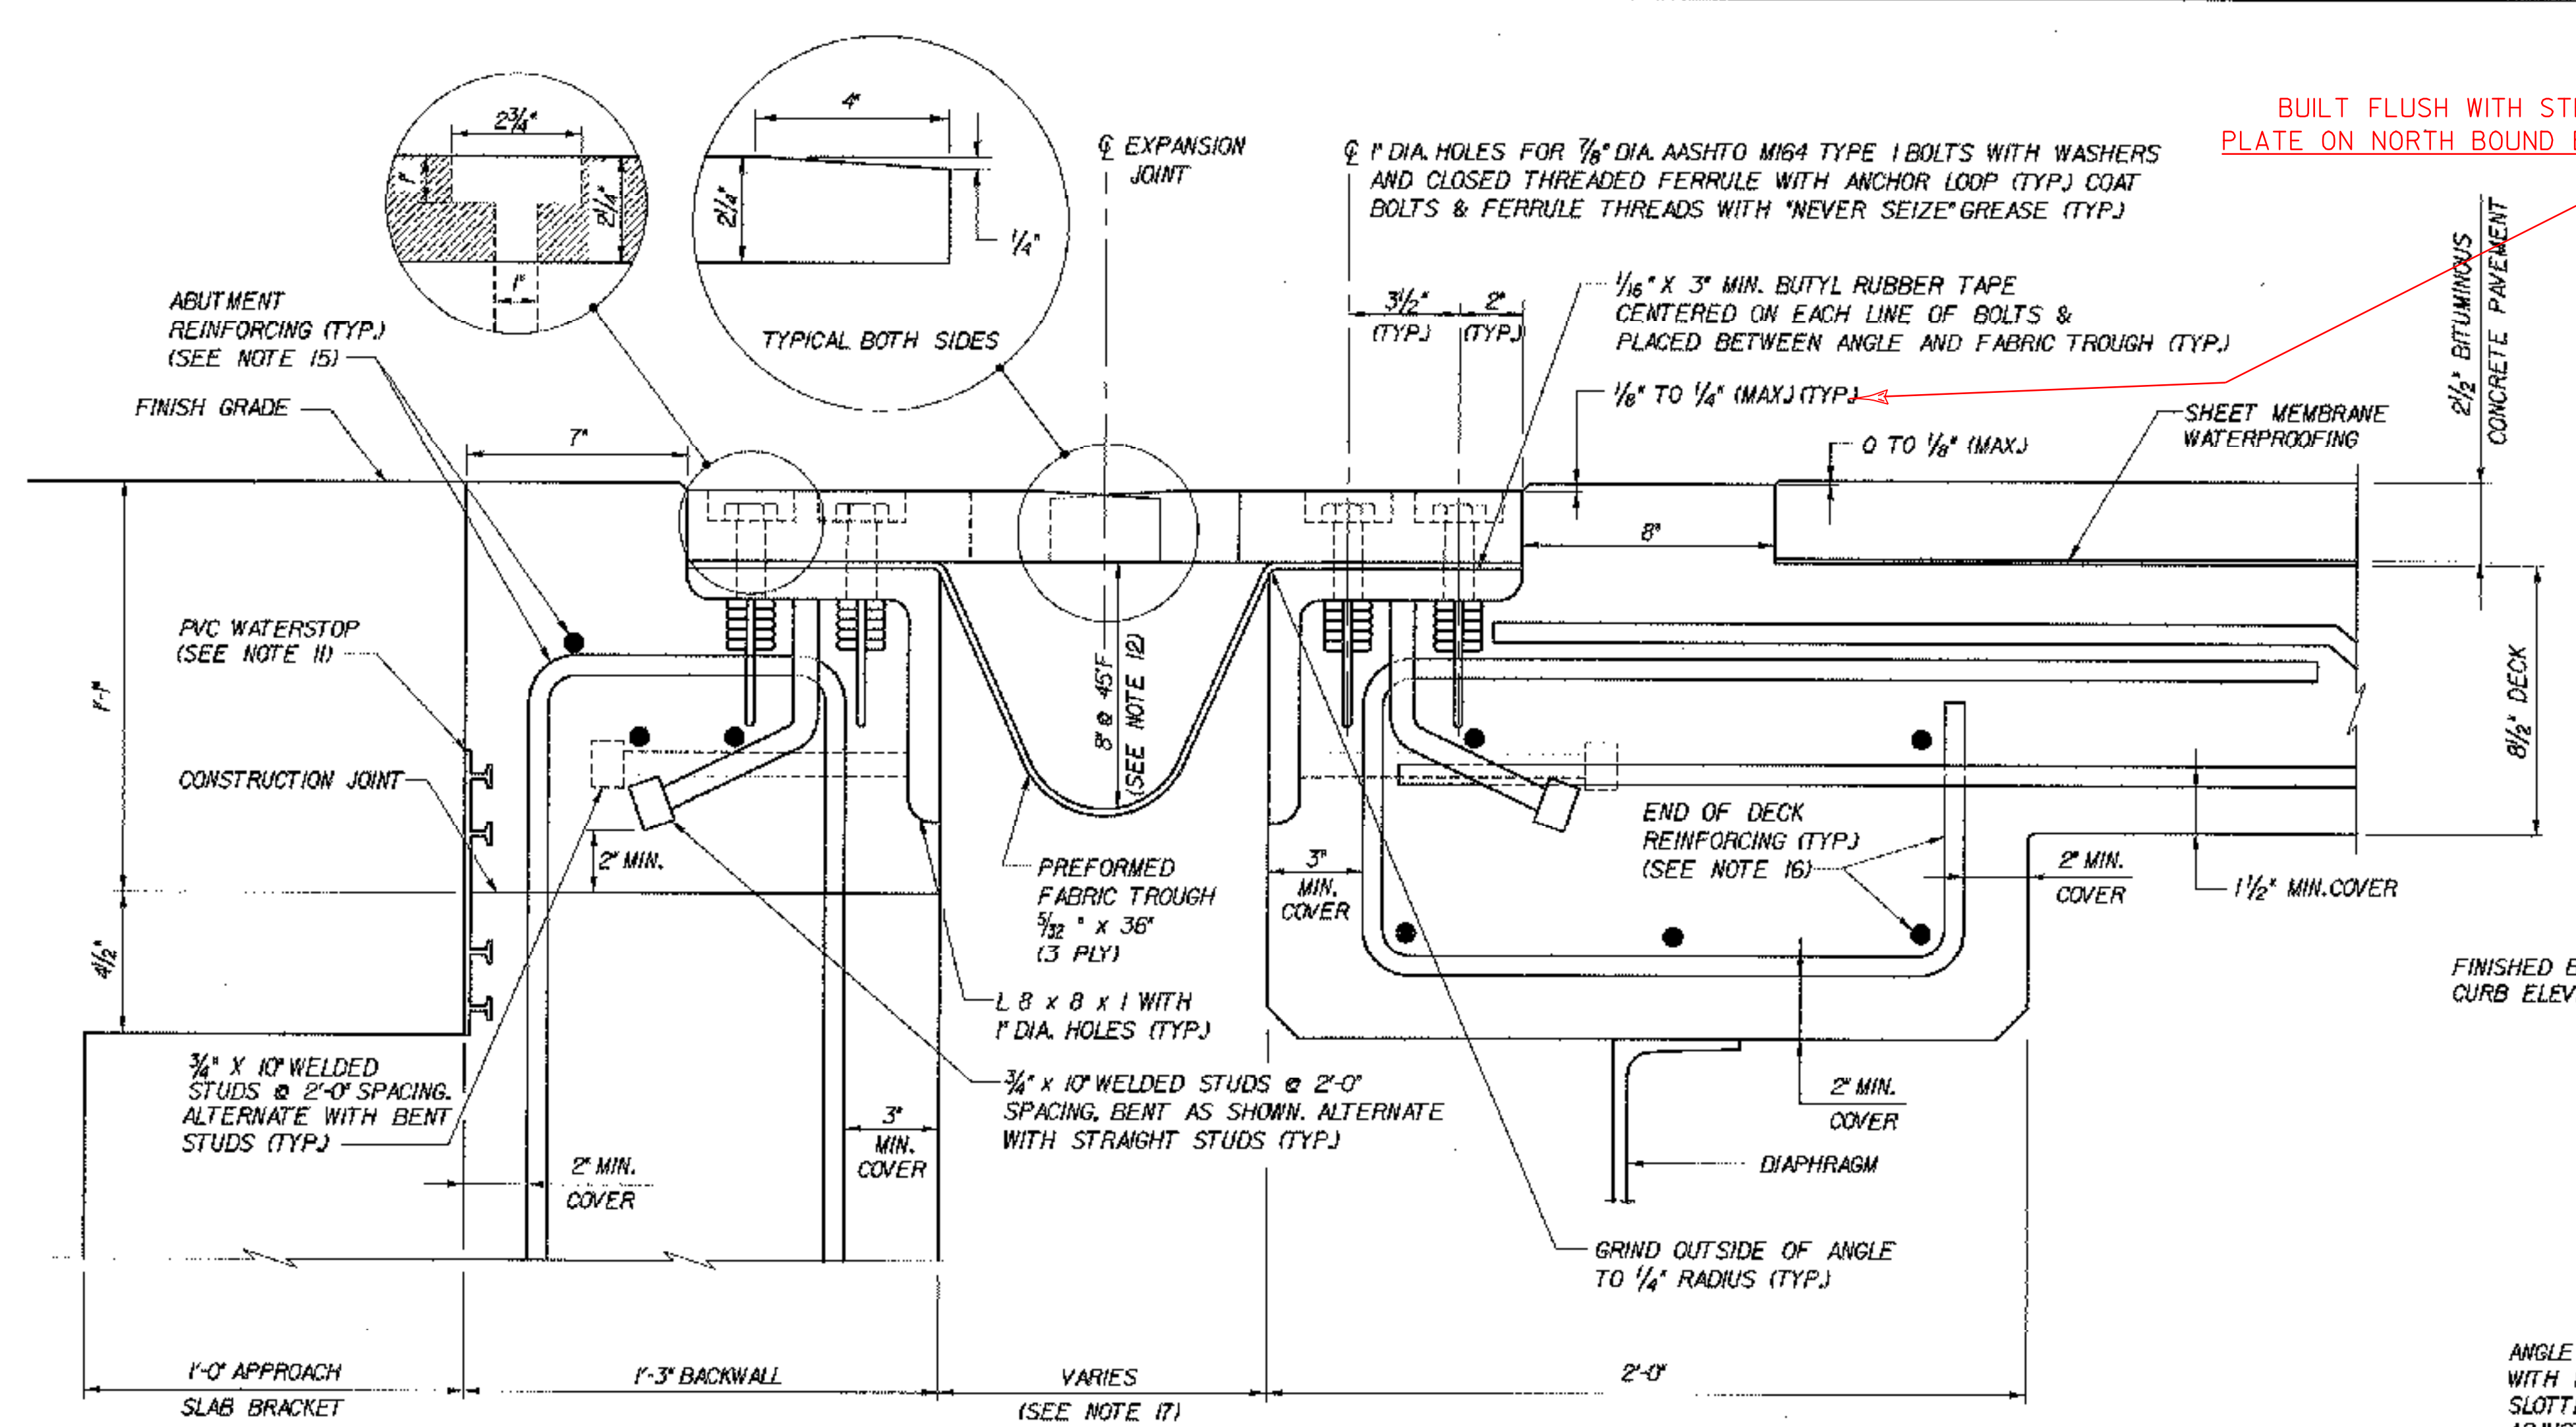

BUILT FLUSH WITH STEEL PLATE ON NORTH BOUND BRIDGES

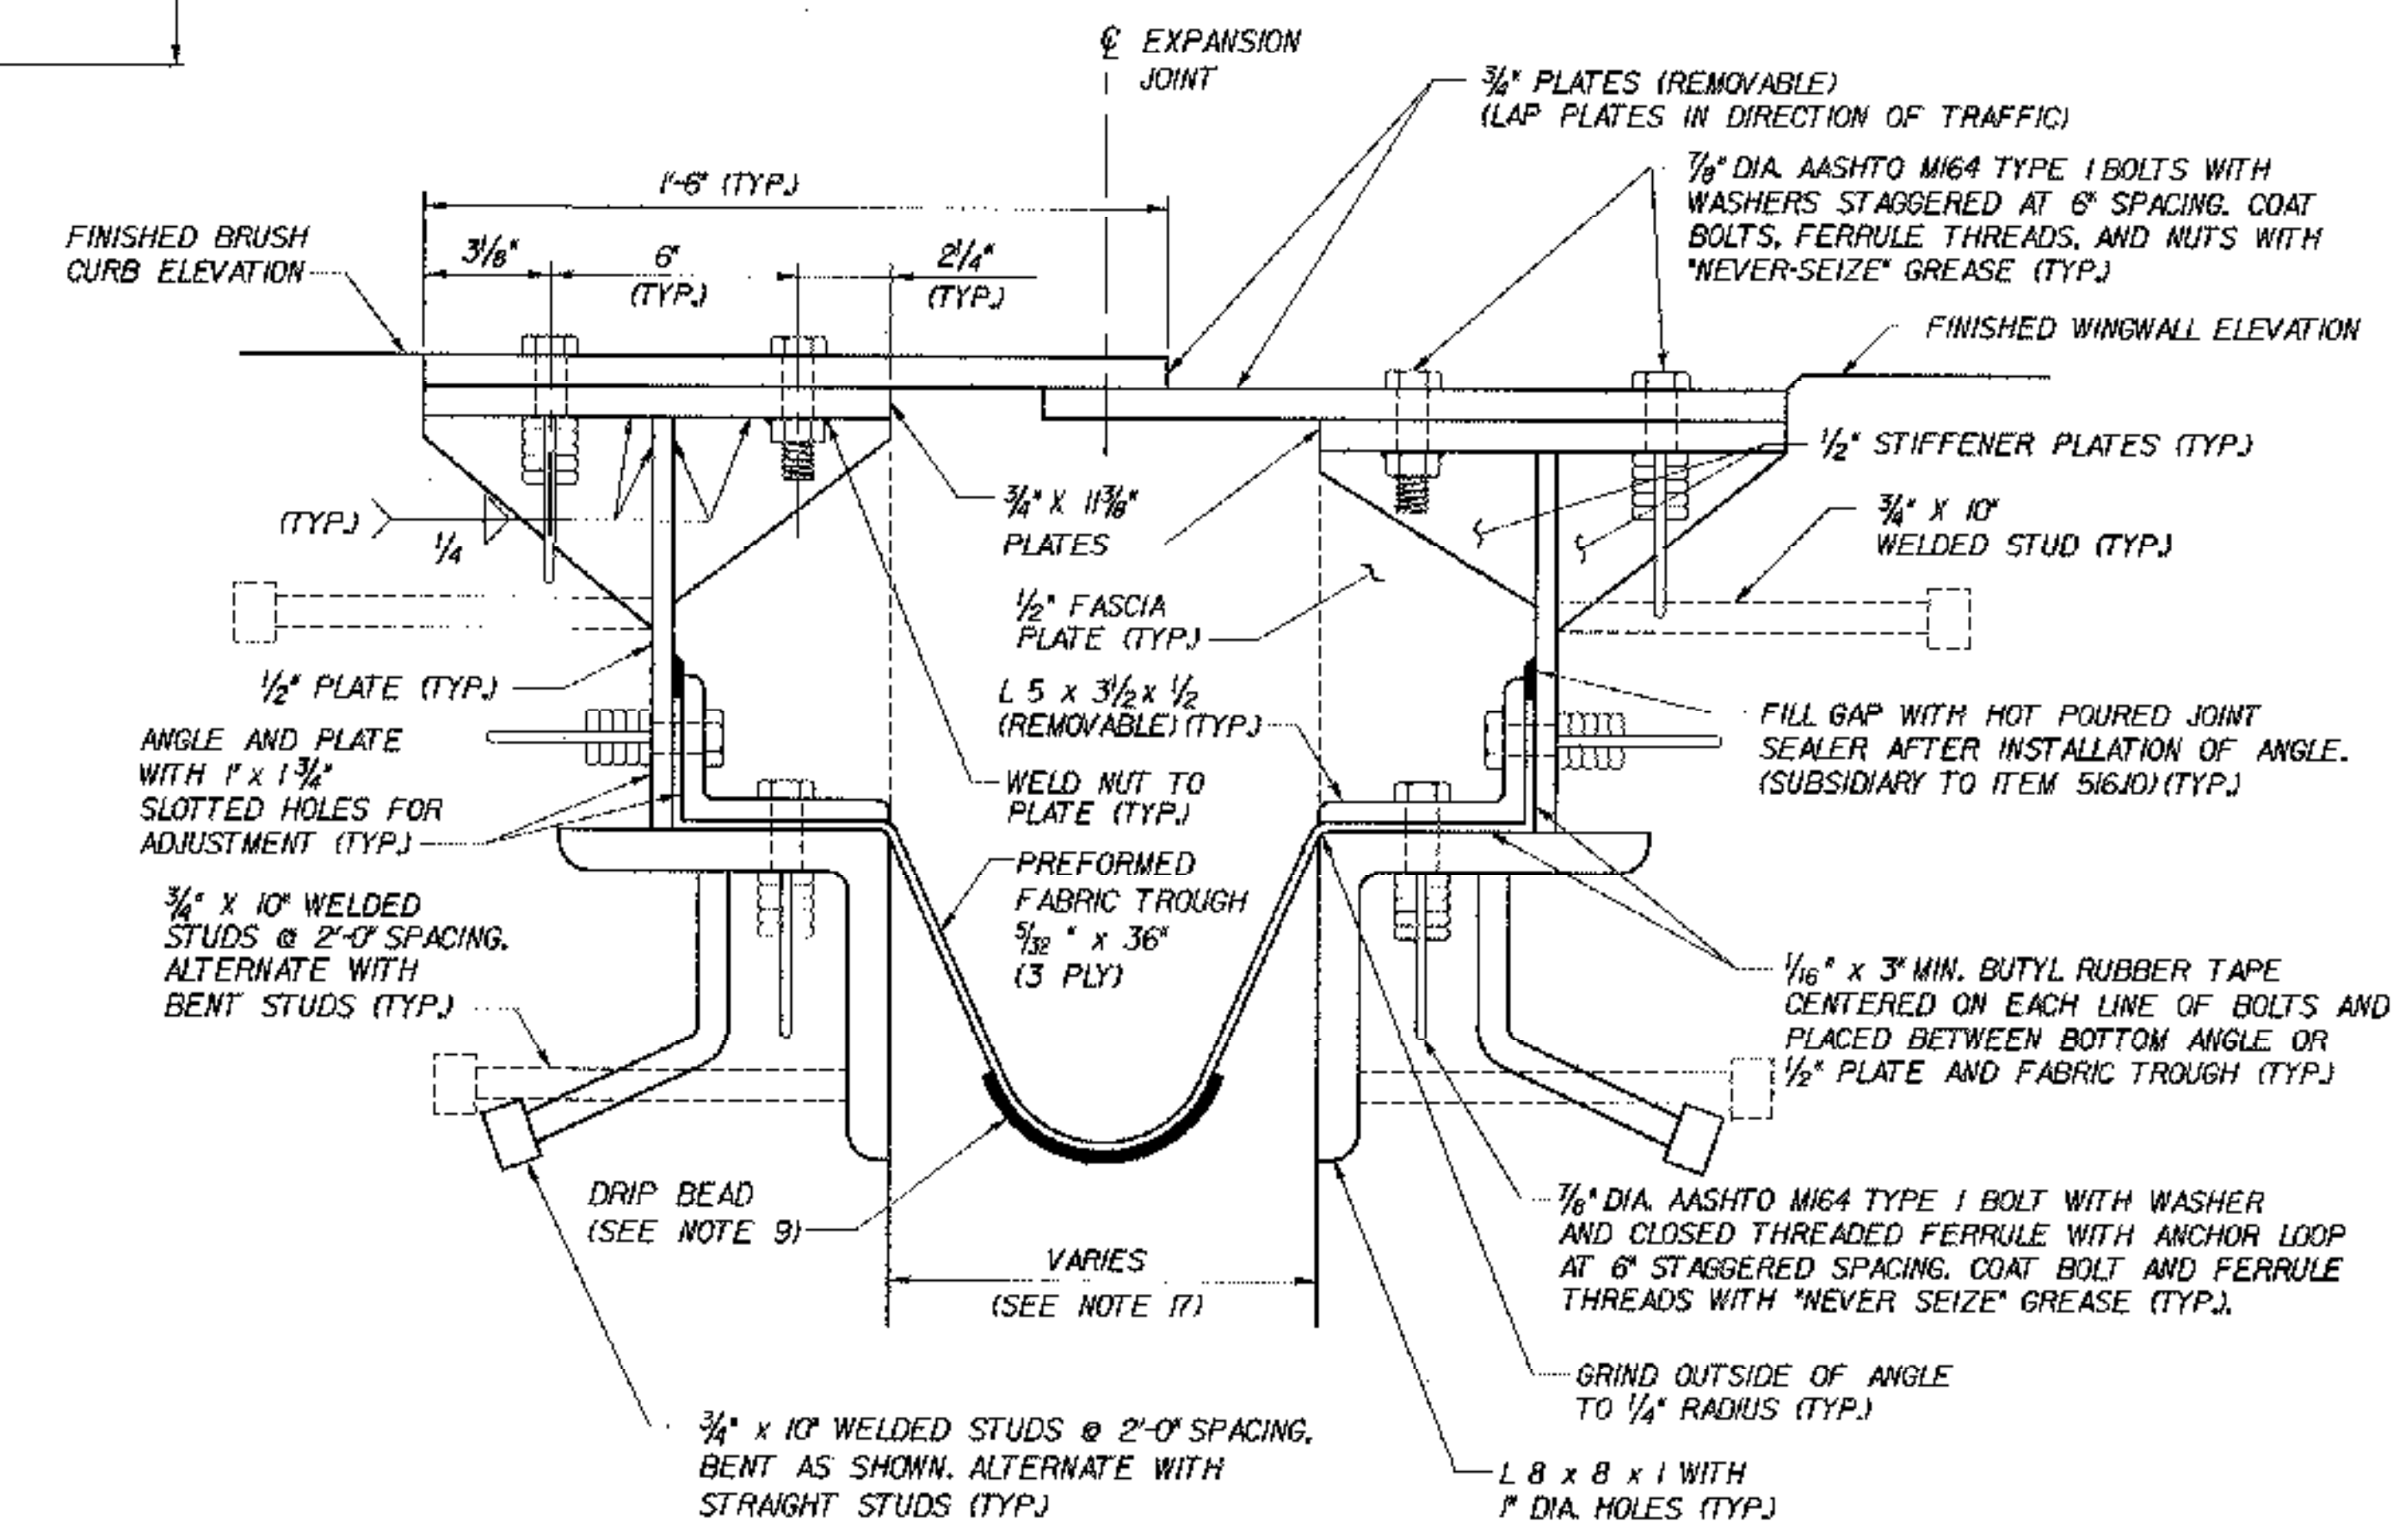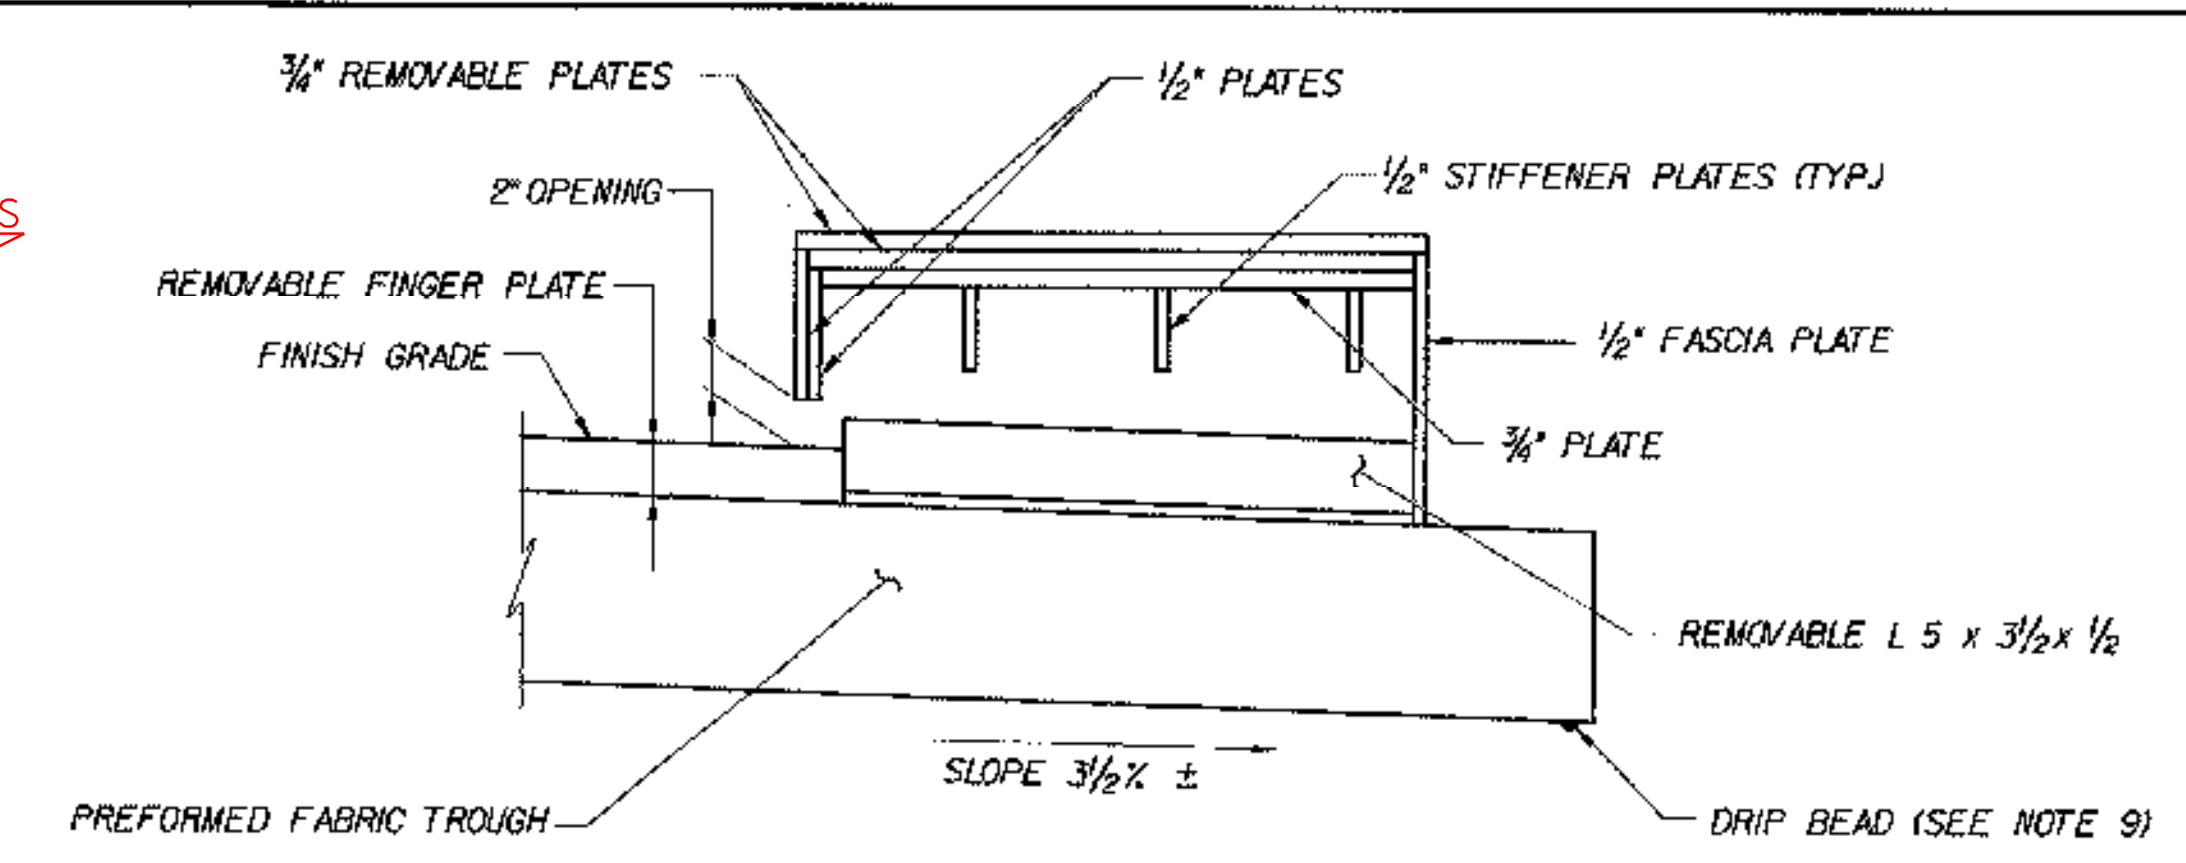

- NOTES:**
- DETAILS ON THIS SHEET ARE FOR ITEM 516.10, "BRIDGE EXPANSION JOINT".
  - PREFORMED FABRIC MATERIAL SHALL BE CONTINUOUS AND SHALL CONFORM TO SUBSECTION 707.07 OF THE SPECIFICATIONS.
  - BUTYL RUBBER TAPE SHALL CONFORM TO AASHTO SPECIFICATION M-198, TYPE B.
  - THE FINAL FINISH OF THE EXPANSION DEVICE SHALL BE COVERED DURING THE PLACING OF BRIDGE DECK CONCRETE.
  - STEEL FINGER PLATES SHALL BE AASHTO M270 GRADE 50. ALL OTHER STEEL COMPONENTS SHALL BE AASHTO M270 GRADE 36 UNLESS NOTED OTHERWISE. BOLTS, NUTS & WASHERS SHALL CONFORM TO AASHTO M164 TYPE I, UNLESS NOTED OTHERWISE. ALL STEEL COMPONENTS SHALL BE GALVANIZED OR METALIZED PER SUBSECTION 506.15 OF THE SPECIFICATIONS, UNLESS NOTED OTHERWISE.
  - PAYMENT FOR ITEM 516.10, "BRIDGE EXPANSION JOINT" SHALL INCLUDE THE FABRICATION AND ERECTION OF THE COMPLETE JOINT ASSEMBLY INCLUDING ALL STEEL PLATES, BRACKETS, ANGLES, WELDED STUDS OR RODS, PREFORMED FABRIC DRAIN TROUGH MATERIAL AND PLASTIC DRAIN TUBES, BUTYL RUBBER TAPE, JOINT FILLER AND ANY OTHER MISCELLANEOUS MATERIAL NECESSARY TO INSTALL JOINT.
  - THE 8 x 8 x 1 ANGLES SHALL BE FURNISHED AS ONE CONTINUOUS PIECE. THE FINGER PLATES ON EACH SIDE OF THE JOINT SHALL BE PROVIDED IN TWO EQUAL LENGTHS.
  - COAT CONCRETE CONTACT SURFACES WITH EPOXY BONDING COMPOUND MEETING THE REQUIREMENTS OF SUBSECTION 719.02 OF THE SPECIFICATIONS. PAYMENT SHALL BE INCLUDED IN THE UNIT PRICE BID FOR ITEM 516.10, "BRIDGE EXPANSION JOINT".

- A DRIP BEAD OF 1/4" x 7" STRIP OF PREFORMED MATERIAL SHALL BE CEMENTED TO THE BOTTOM OF THE FABRIC TROUGH USING AN ADHESIVE APPROVED BY THE MANUFACTURER. THE DRIP BEAD SHALL BE APPLIED 1" FROM THE DOWNSPOUT END OF THE TROUGH.
- FILL COUNTERBORED HOLES WITH HOT Poured JOINT SEALER AFTER BOLT INSTALLATION. COSTS FOR THE WORK SHALL BE SUBSIDIARY TO ITEM 516.10.
- PAYMENT FOR WATERSTOP SHALL BE SUBSIDIARY TO ITEM 504.25, CONCRETE CLASS B.
- FABRIC TROUGHS SHALL BE INSTALLED SO THAT MINIMUM SLOPE IS 1% FOR POSITIVE DRAINAGE.
- FABRIC TROUGH SHALL BE THOROUGHLY CLEANED AND FLUSHED AFTER PAVING OPERATION.
- EXPANSION JOINTS SHALL BE SHOP ASSEMBLED AND SHIPPED AS ONE UNIT FOR EACH BRIDGE JOINT.
- FOR ABUTMENT REINFORCEMENT DETAILS, SEE TYPICAL EXPANSION ABUTMENT REINFORCEMENT, BRIDGE SHEET C-40.
- FOR DECK SLAB REINFORCEMENT, SEE THE TRANSVERSE SECTION AND DECK REINFORCEMENT PLANS FOR EACH BRIDGE.
- SEE BRIDGE SHEET C-37 FOR TEMPERATURE ADJUSTMENT TABLE.




**STATE OF VERMONT AGENCY OF TRANSPORTATION**

Town Of **MIDDLESEX-BOLTON** Bridge No. \_\_\_\_\_  
 Highway No. **I-89** Log Sta. \_\_\_\_\_  
 Surv. Sta. \_\_\_\_\_

**FINGER JOINT DETAILS (1 OF 3)**


Designed By **K.L. JAMES** Drawn By **N.L. HOYT**  
 Checked By **M.H. GALLO** Date **10/99** Bridge Design Supervisor **J.P. HALSTEAD** Date **10/99**

PROJECT **MIDDLESEX-BOLTON** PROJECT NO. **IM-089-2(26)**  
 TVGA CAD Drawing No. **127fj2.dgn** Date **10/99**  
 Bridge Sheet No. **C-36** Sheet **36** of **307**

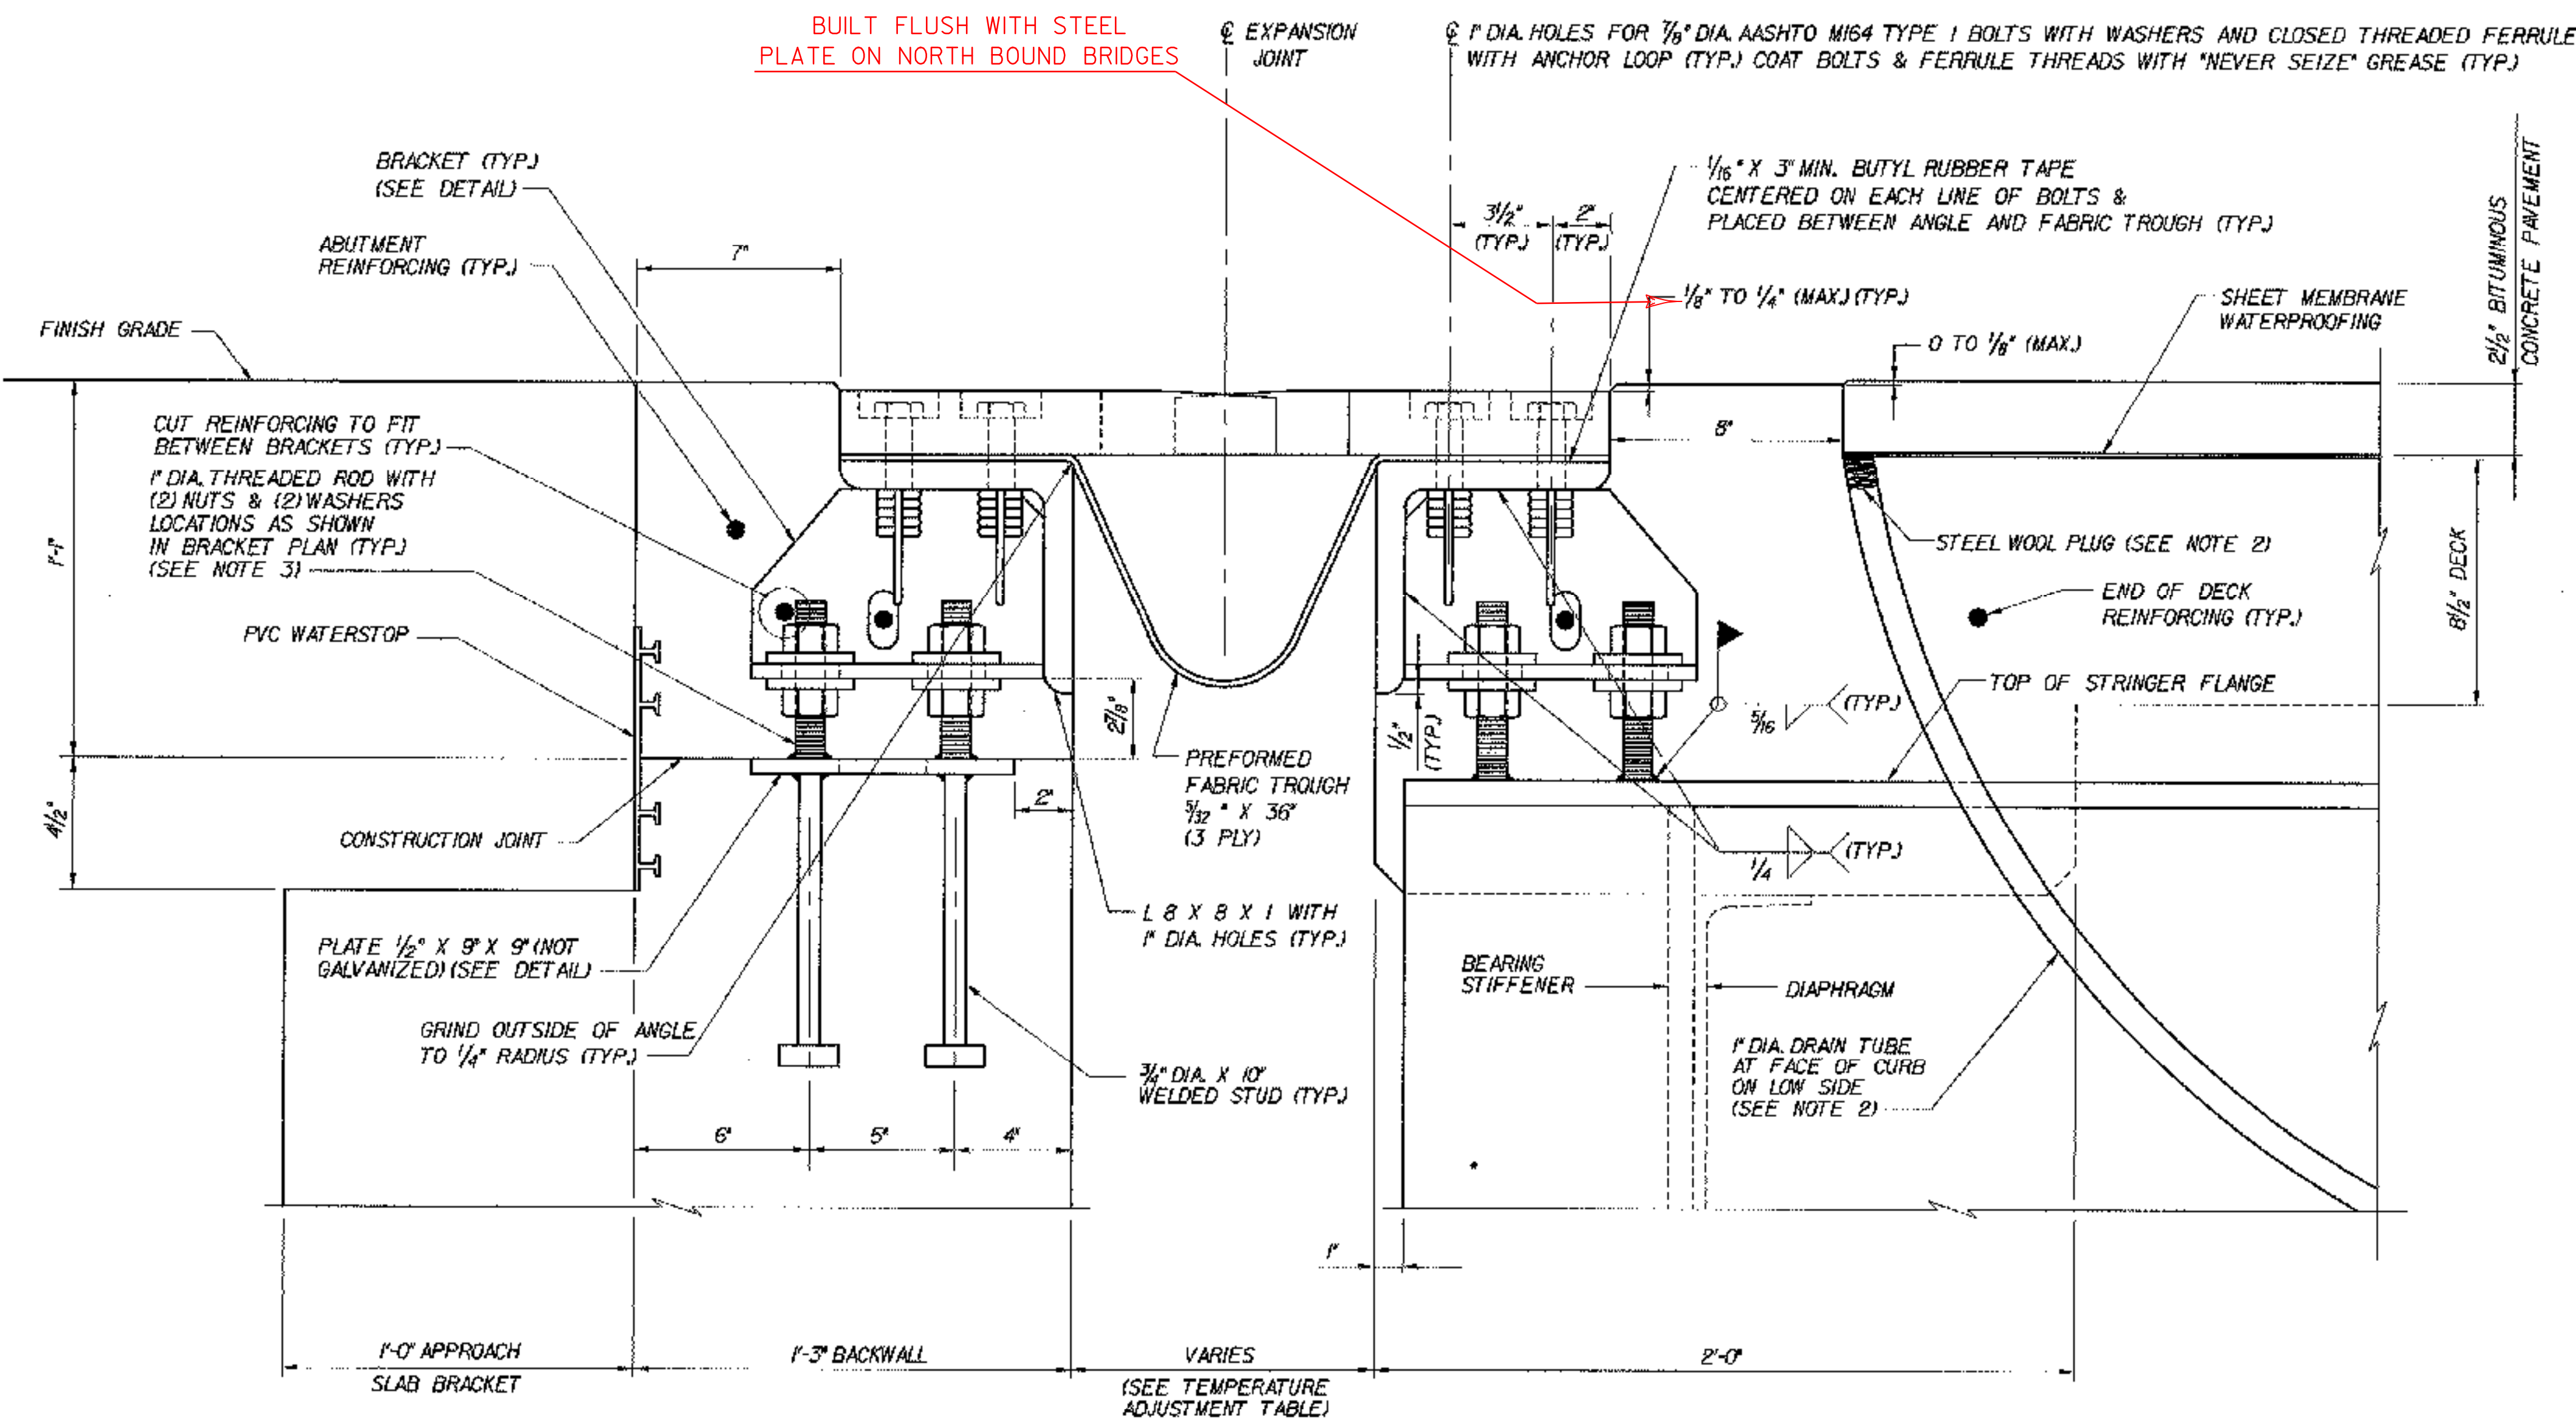


**TYPICAL SECTION AT STRINGERS**  
(NORMAL TO @ BEARING)  
SCALE: 3" = 1'-0"


TEMPERATURE ADJUSTMENT TABLE		
TEMPERATURE	BR 48N	BR 48S
0°F	11 1/8"	11 1/4"
15°F	10 13/16"	10 15/16"
30°F	10 1/2"	10 9/16"
45°F	10 3/16"	10 1/4"
60°F	9 7/8"	9 15/16"
75°F	9 9/16"	9 5/8"
90°F	9 1/4"	9 5/16"
105°F	9"	9"

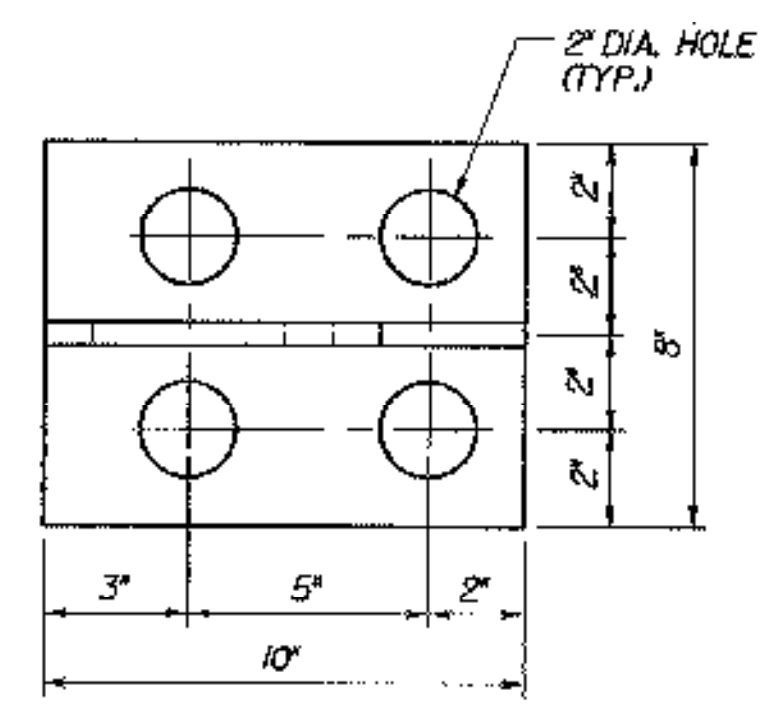


**BRACKET PLAN**  
SCALE: 3" = 1'-0"

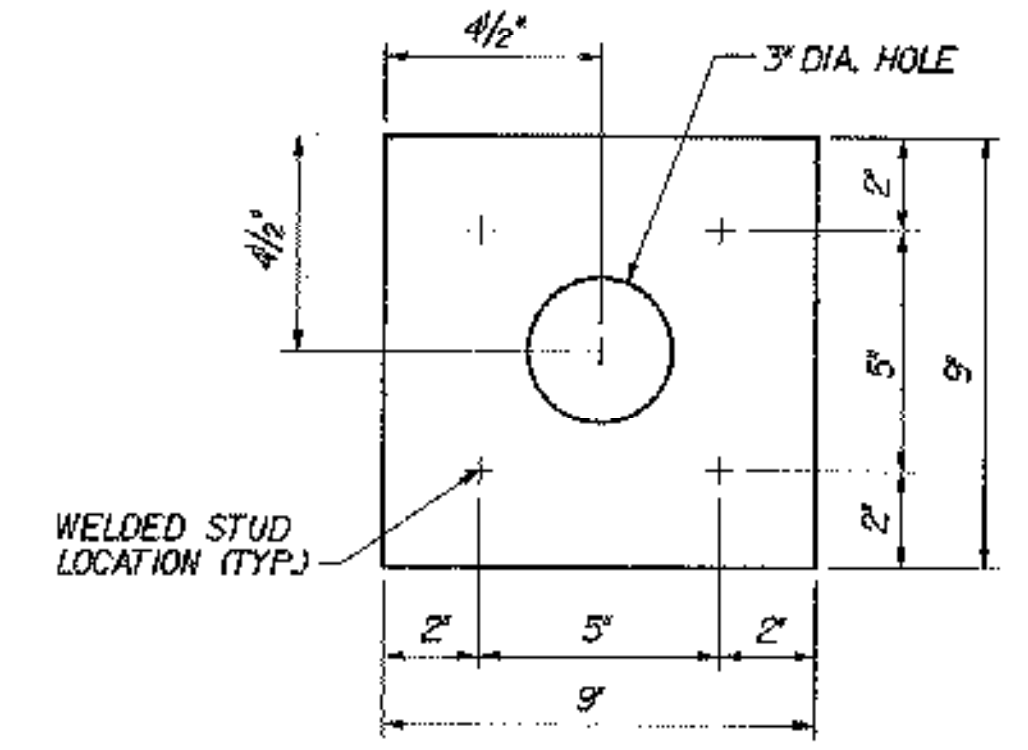

**PLATE PLAN**  
SCALE: 3" = 1'-0"  
NOTE: THIS PLATE DOES NOT NEED TO BE GALVANIZED.

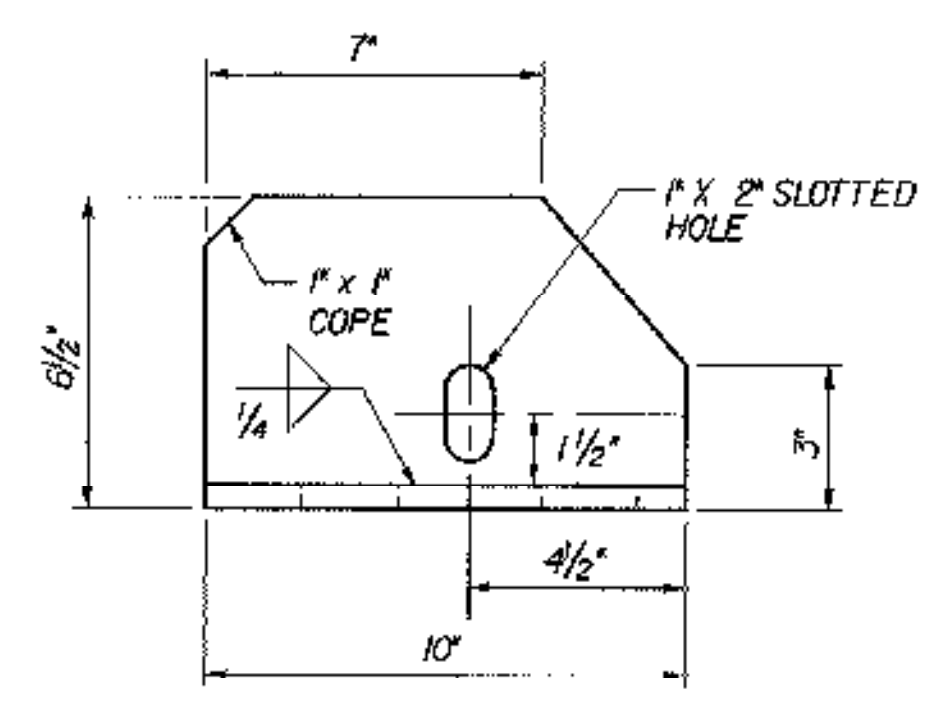

**BRACKET ELEVATION**  
SCALE: 3" = 1'-0"

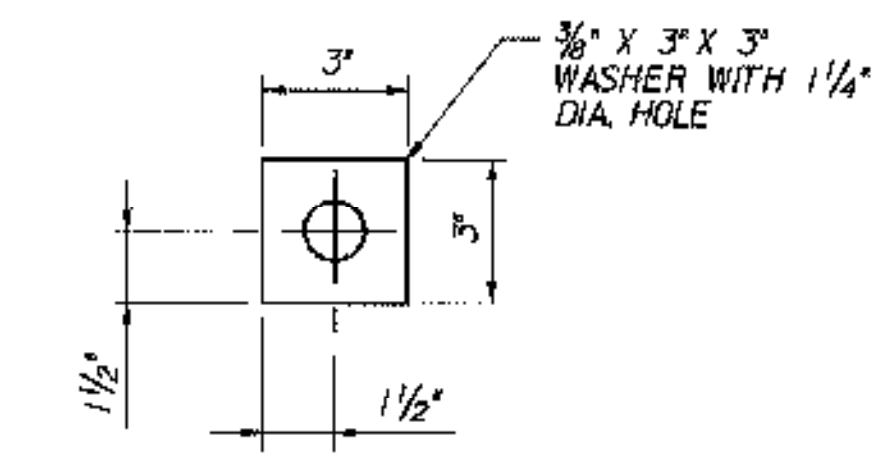

**WASHER FOR BRACKET**  
SCALE: 3" = 1'-0"



**ANCHOR FERRULE DETAIL**  
NOT TO SCALE

**NOTES:**

- SEE NOTES ON BRIDGE SHEET C-36.
- A 1" DIAMETER PLASTIC DRAIN TUBE SHALL BE INSTALLED AS SHOWN AT THE FACE OF CURB. THE UPPER END IS TO BE PLUGGED WITH STEEL WOOL AND THE LOWER END IS TO EXTEND BELOW THE BOTTOM OF THE ADJACENT STRINGER. THE DRAIN TUBES SHALL BE FASTENED TO THE STRINGERS USING A METHOD APPROVED BY THE ENGINEER.
- THREADED ROD AND ASSOCIATED NUTS AND WASHERS SHALL CONFORM TO SUBSECTION 714.08 OF THE SPECIFICATIONS.

**Hayashi Corporation**  
Consulting Engineers


**STATE OF VERMONT**  
**AGENCY OF TRANSPORTATION**

Town Of	MIDDLESEX-BOLTON	Bridge No.	
Highway No.	I-89	Log Sta.	
		Surv. Sta.	

**FINGER JOINT DETAILS (2 OF 3)**

Designed By	K.L. JAMES	Drawn By	N.J. HOYT
Checked By	M.H. GALLO	Bridge Design Supervisor	J.P. HALSTEAD
Date	10/99	Date	10/99


PROJECT: MIDDLESEX-BOLTON PROJECT NO.: IM-089-2(26)  
TVGA CAD Drawing No. 127fj3.dgn Date 10/99  
Bridge Sheet No. C-37 Sheet 37 of 307

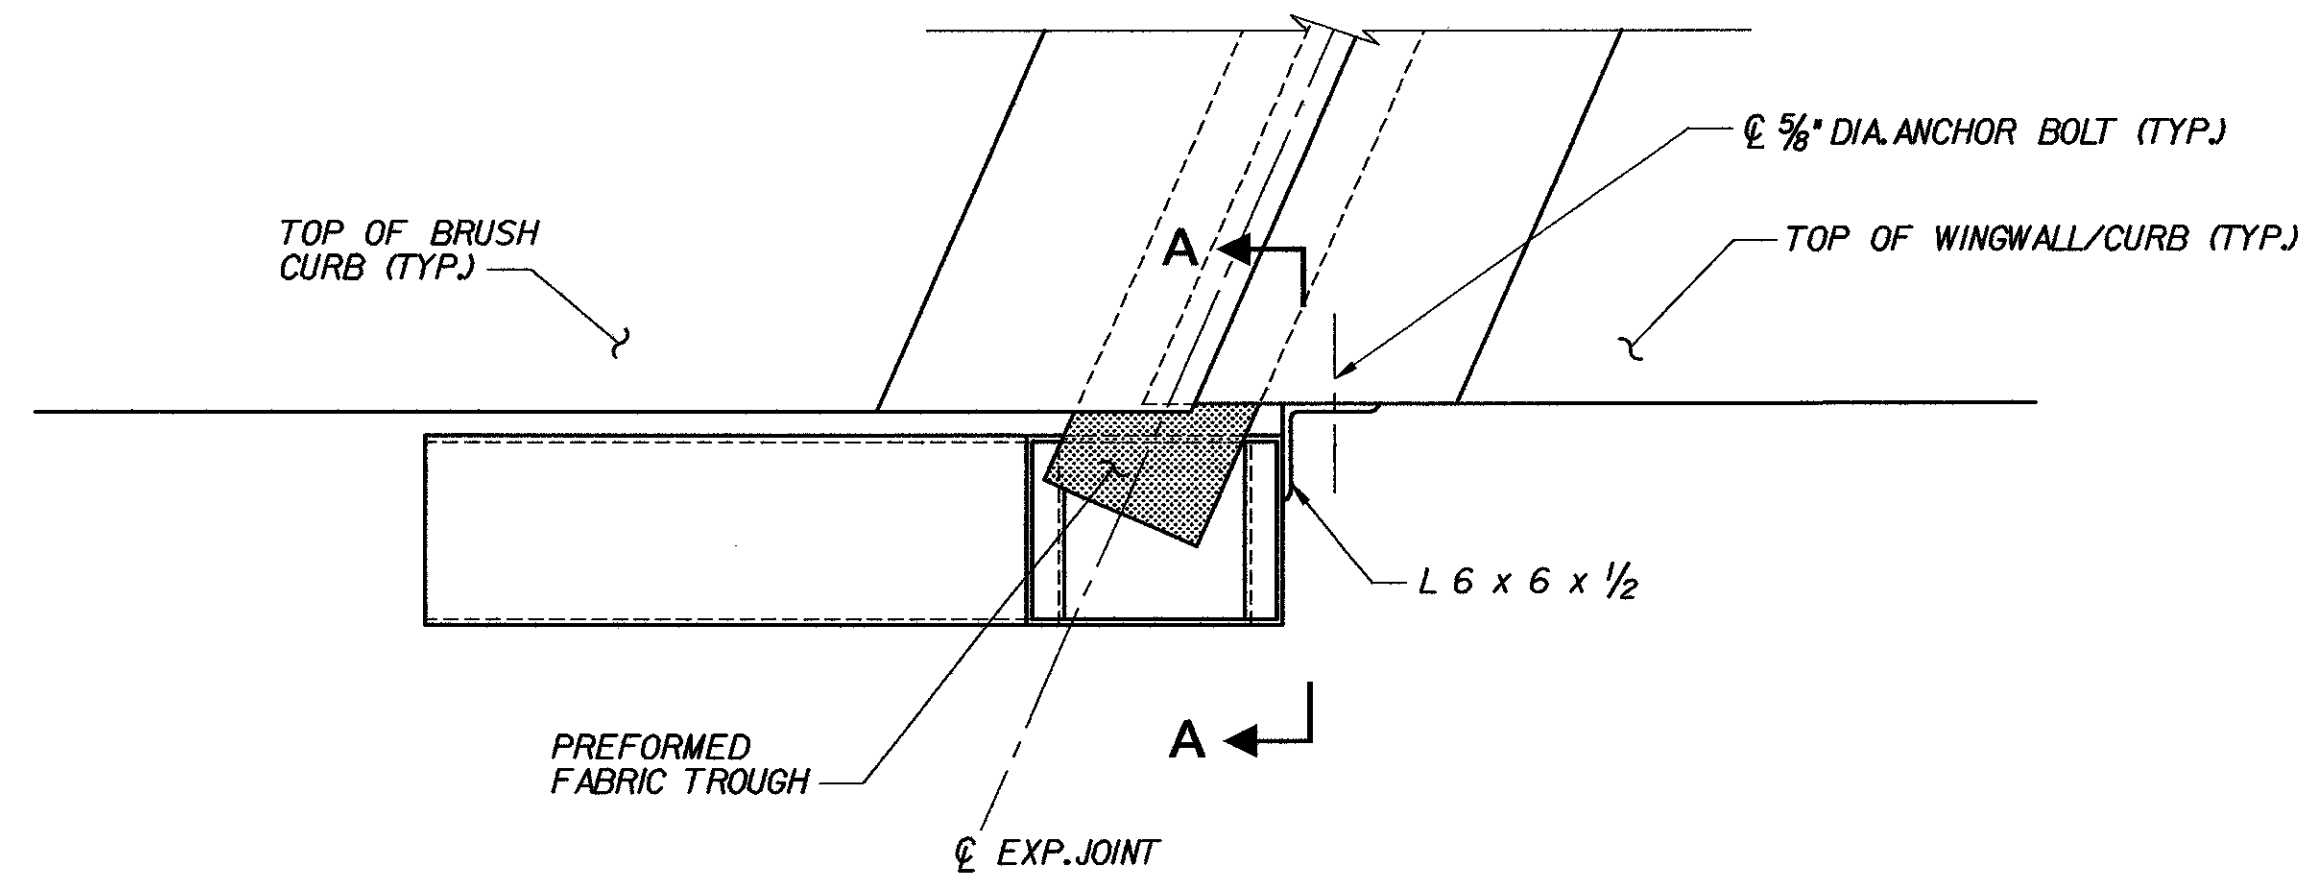

(HOPPER AT BR 48S SHOWN, HOPPER AT BR 48N SIMILAR)


**HOPPER LOCATION PLAN**

NOT TO SCALE

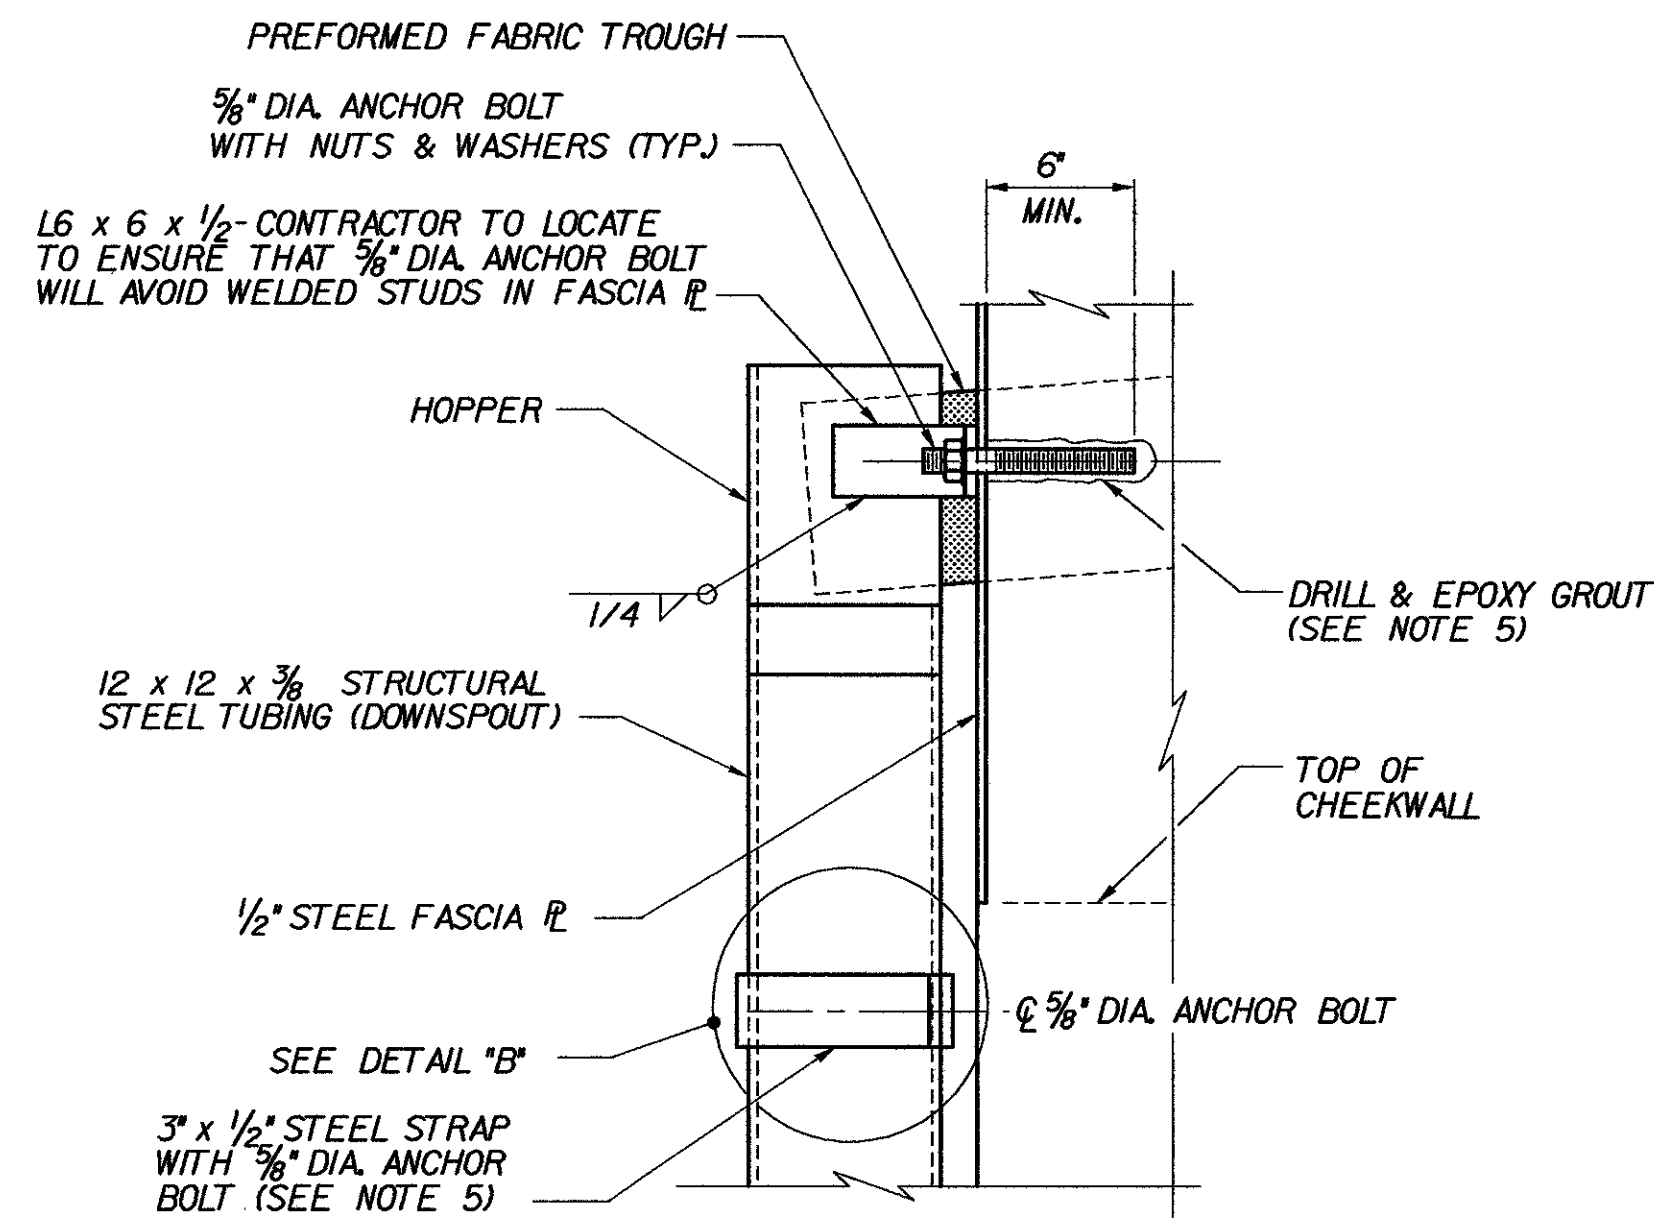


**SECTION A-A**

NOT TO SCALE

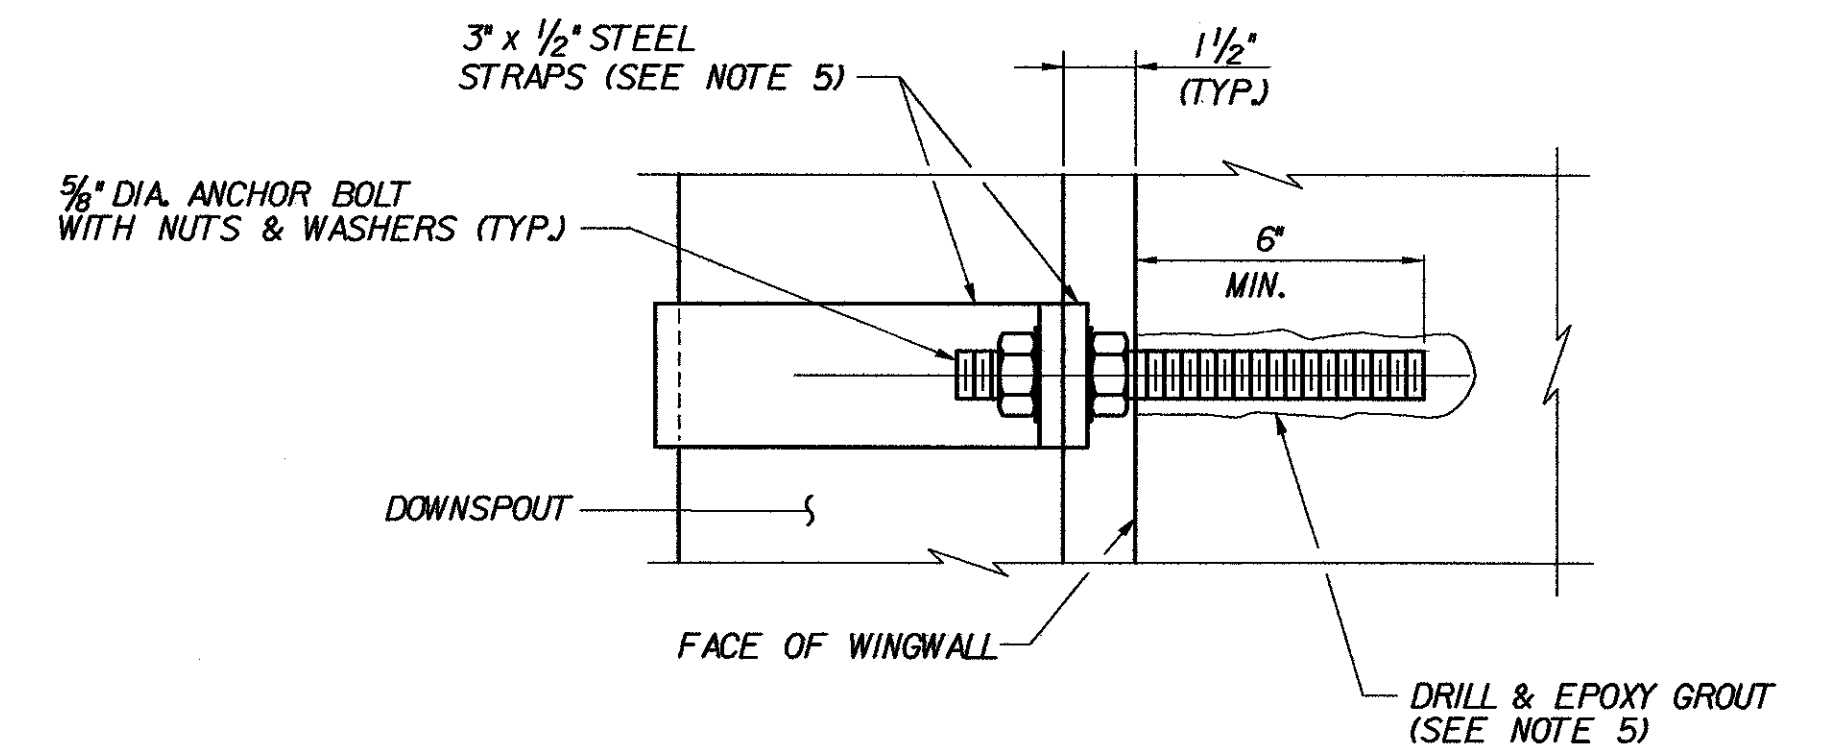


**DETAIL "B"**

NOT TO SCALE

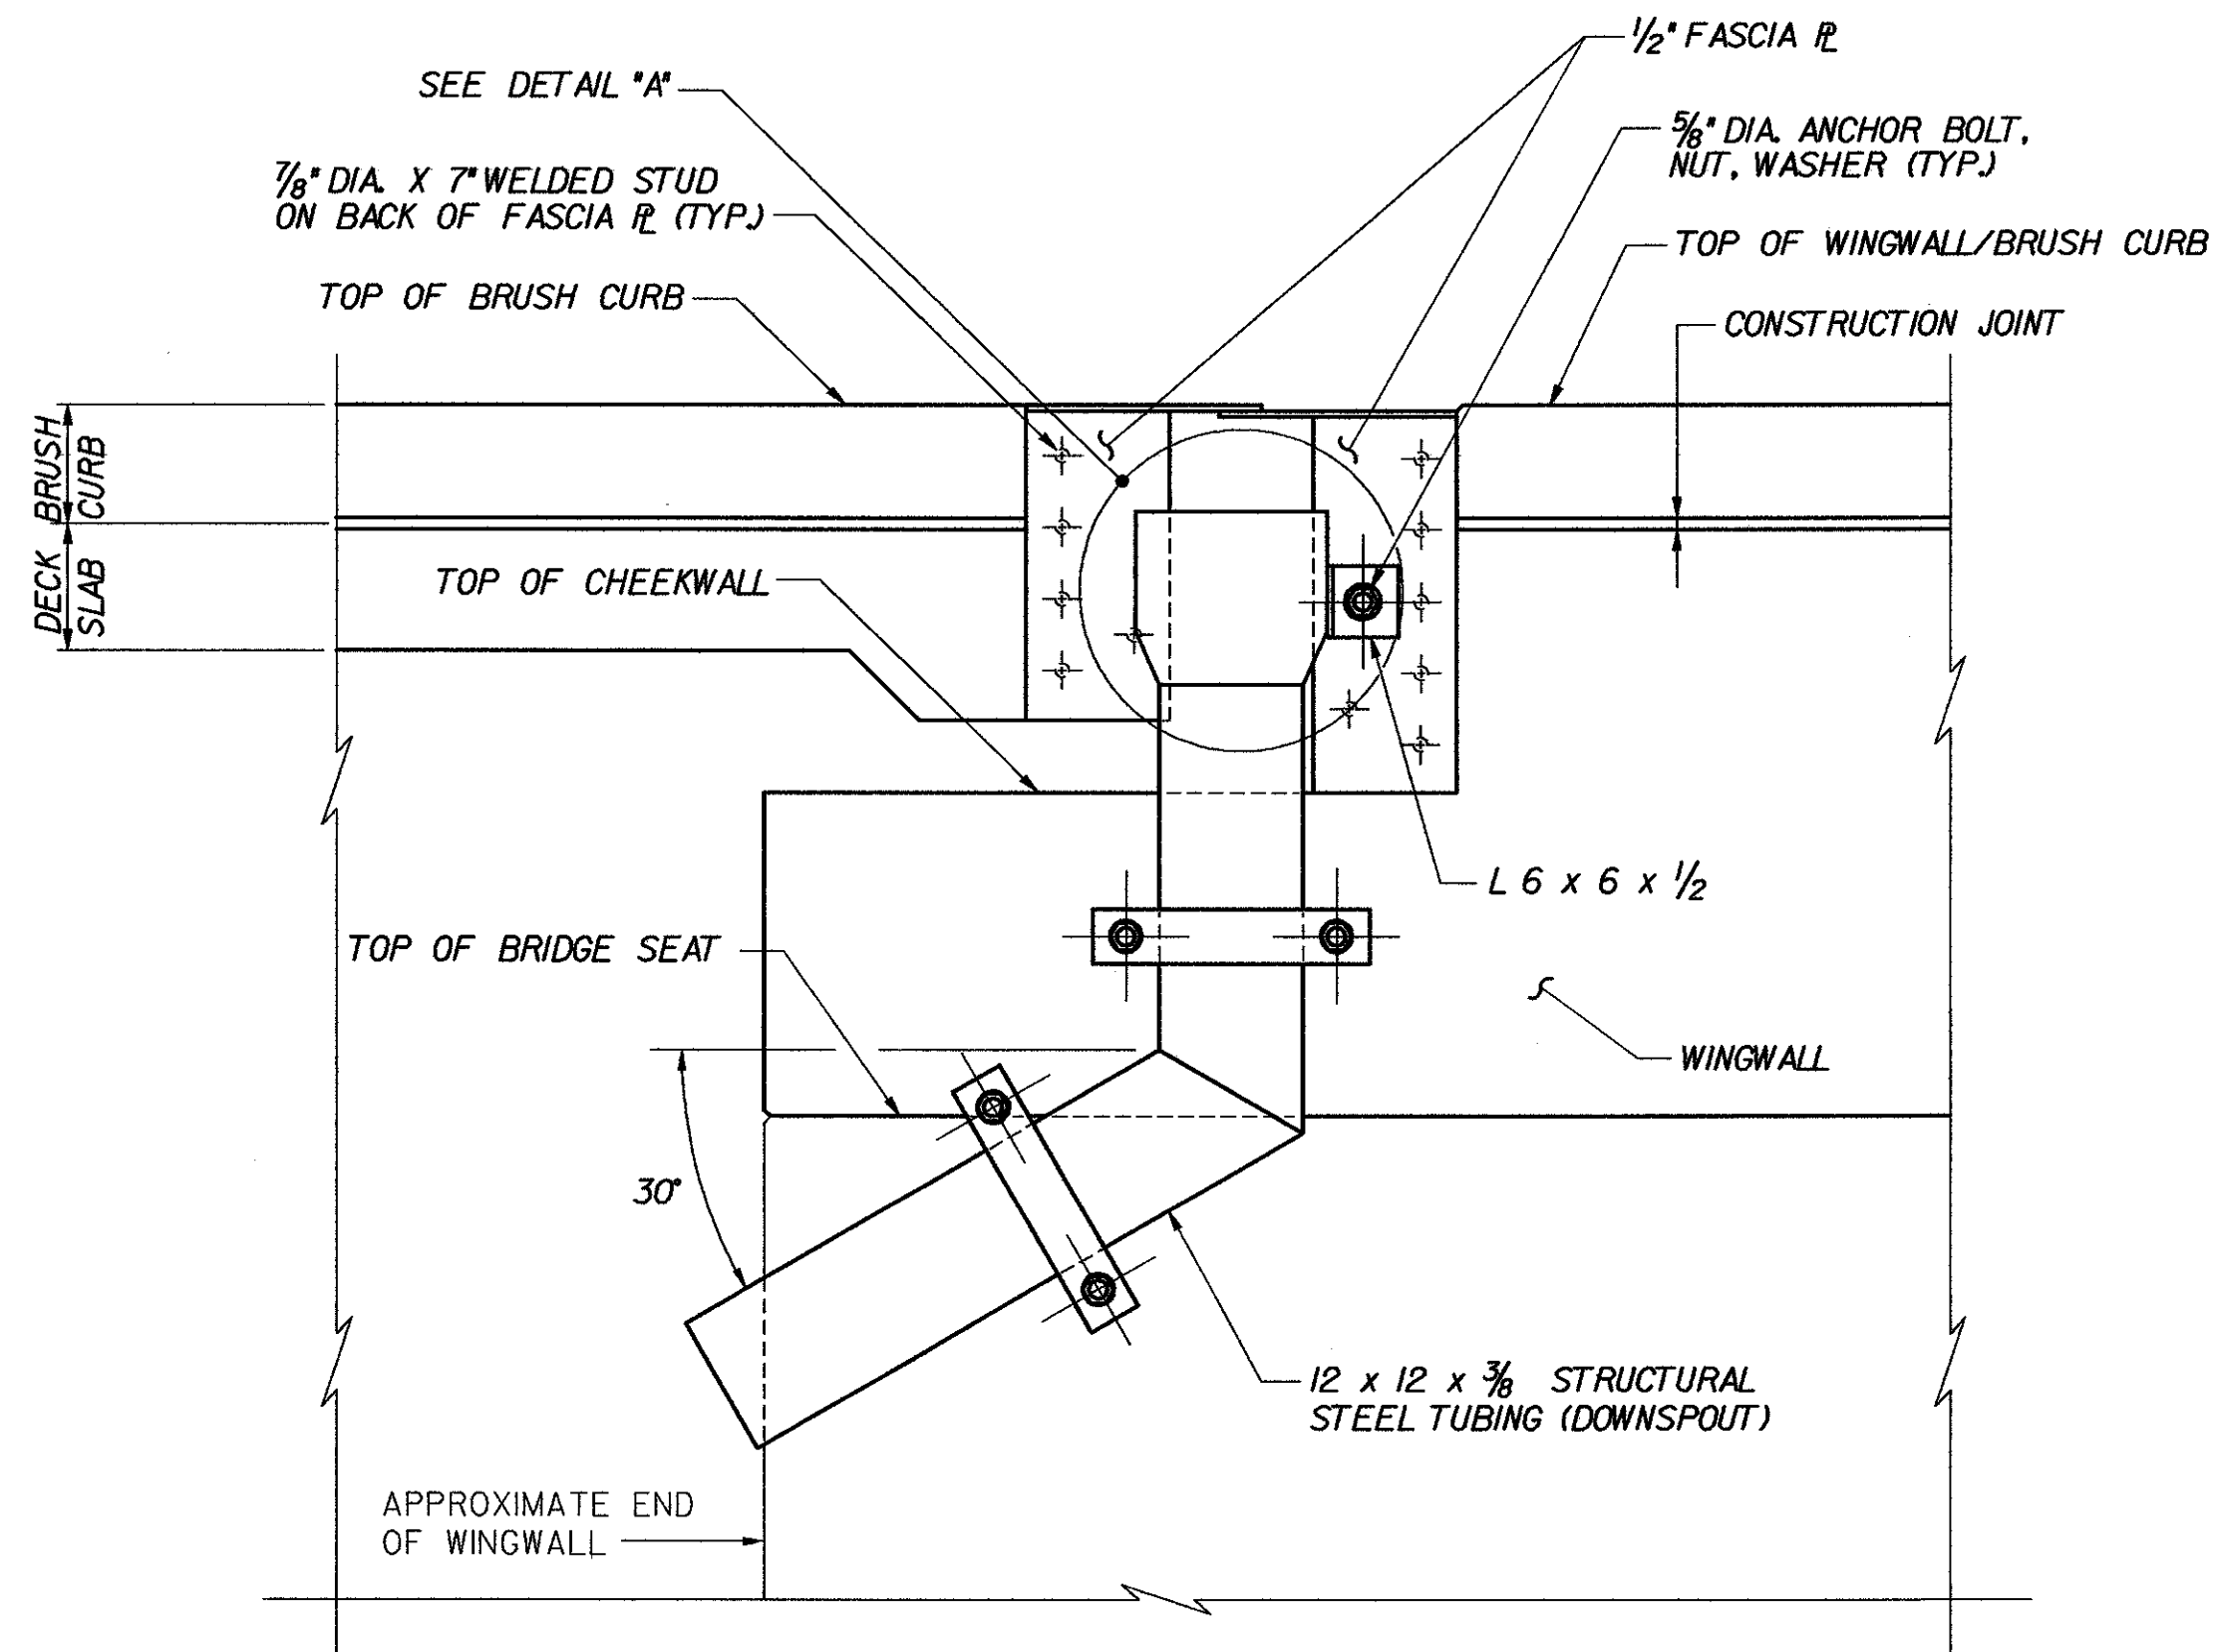

**ELEVATION**

NOT TO SCALE

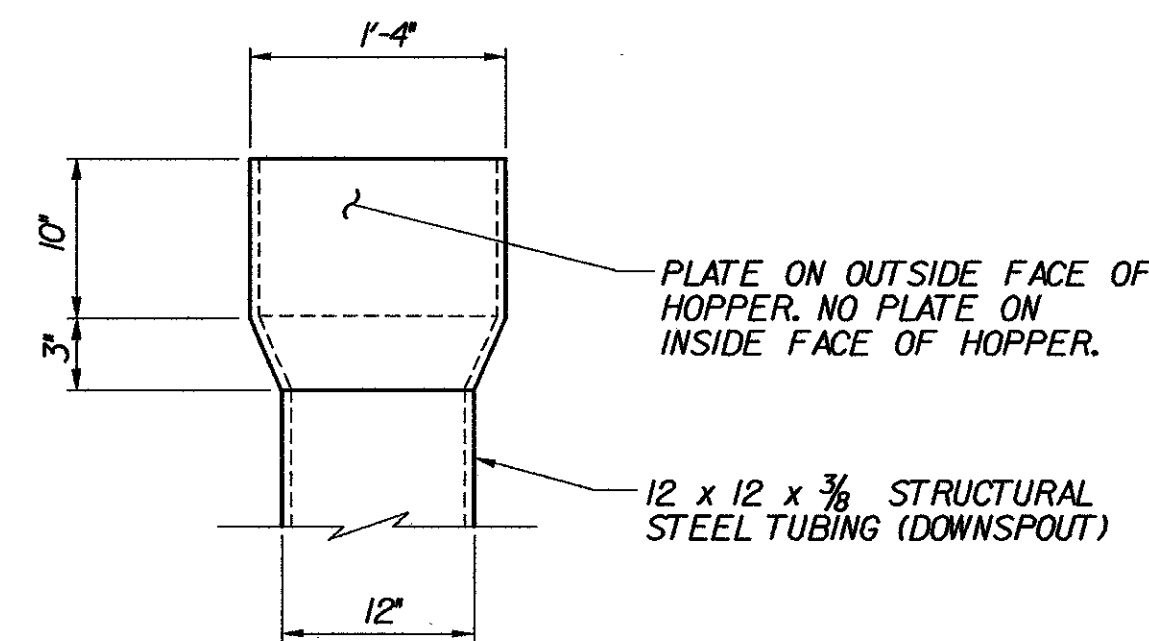

**DETAIL "A"**

NOT TO SCALE

**NOTES:**

- HOPPERS AND ALL COMPONENTS SHALL BE AASHTO M270 GRADE 36 STEEL. STRUCTURAL TUBING (DOWNSPOUT) SHALL BE ASTM A-500 OR A-501 STEEL. ALL STEEL SHALL BE GALVANIZED OR METALIZED IN ACCORDANCE WITH SECTION 506.15 OF THE SPECIFICATIONS. ALL HOPPER AND DOWNSPOUT WORK SHALL BE PAID FOR UNDER ITEM 506.60, "STRUCTURAL STEEL".
- HOPPERS SHALL BE FABRICATED FROM 3/8" STEEL PLATE. THE FABRICATION WELDS SHALL BE 1/4" FILLET WELDS ON THE INSIDE OF THE HOPPER AND SHALL BE FULL LENGTH TO ENSURE A WATERTIGHT CONTAINER.
- ANCHOR BOLTS, NUTS AND WASHERS SHALL CONFORM TO SUBSECTION 714.08 OF THE SPECIFICATIONS, AND BE GALVANIZED IN ACCORDANCE WITH SUBSECTION 506.15. ANCHOR BOLTS SHALL BE DRILLED AND EPOXY GROUTED 6" MINIMUM INTO THE CONCRETE. DRILL AND EPOXY GROUT SYSTEM SHALL BE:
  - DAYTON SUPERIOR SURE-ANCHOR J-51 SYSTEM
  - HILTI, INC. HIT HY-150 SYSTEM
  - UNITEX PRO-POXY 300 FAST SYSTEM
 OR EQUIVALENT APPROVED BY VAOT MATERIALS SECTION. ALL COSTS FOR DRILLING AND EPOXY GROUTING ANCHOR BOLTS SHALL BE SUBSIDIARY TO ITEM 506.60, "STRUCTURAL STEEL".
- THE HOPPERS SHALL BE PLACED AS SHOWN ON THIS SHEET. THIS WILL REQUIRE THAT THE HOPPER BE FORCED AS FAR AS POSSIBLE UP UNDER THE TROUGH. THE TROUGH SHOULD BE ENCLOSED AS MUCH AS POSSIBLE BY THE HOPPER BUT SHOULD NOT BE BENT OR BUCKLED TO RESTRICT THE FLOW OF WATER.
- STRAPS SHALL NOT BE BENT IN THE FIELD.

**STATE OF VERMONT  
AGENCY OF TRANSPORTATION**


Town Of	MIDDLESEX-BOLTON	Bridge No.	
Highway No.	I-89	Log Sta.	
		Surv. Sta.	

**FINGER JOINT DETAILS (3 OF 3)**

Designed By	K.L. JAMES	Drawn By	N.J. HOYT
Checked By	M.H. GALLO	Date	10/99
		Bridge Design Supervisor	J.P. HALSTEAD Date 10/99


PROJECT	MIDDLESEX-BOLTON	PROJECT NO.	IM-089-2(26)
TVGA CAD Drawing No.	I27fj4.dgn	Date	10/99
Bridge Sheet No.	C-38	Sheet	38 of 307

**Hayashi Corporation**  
Consulting Engineers

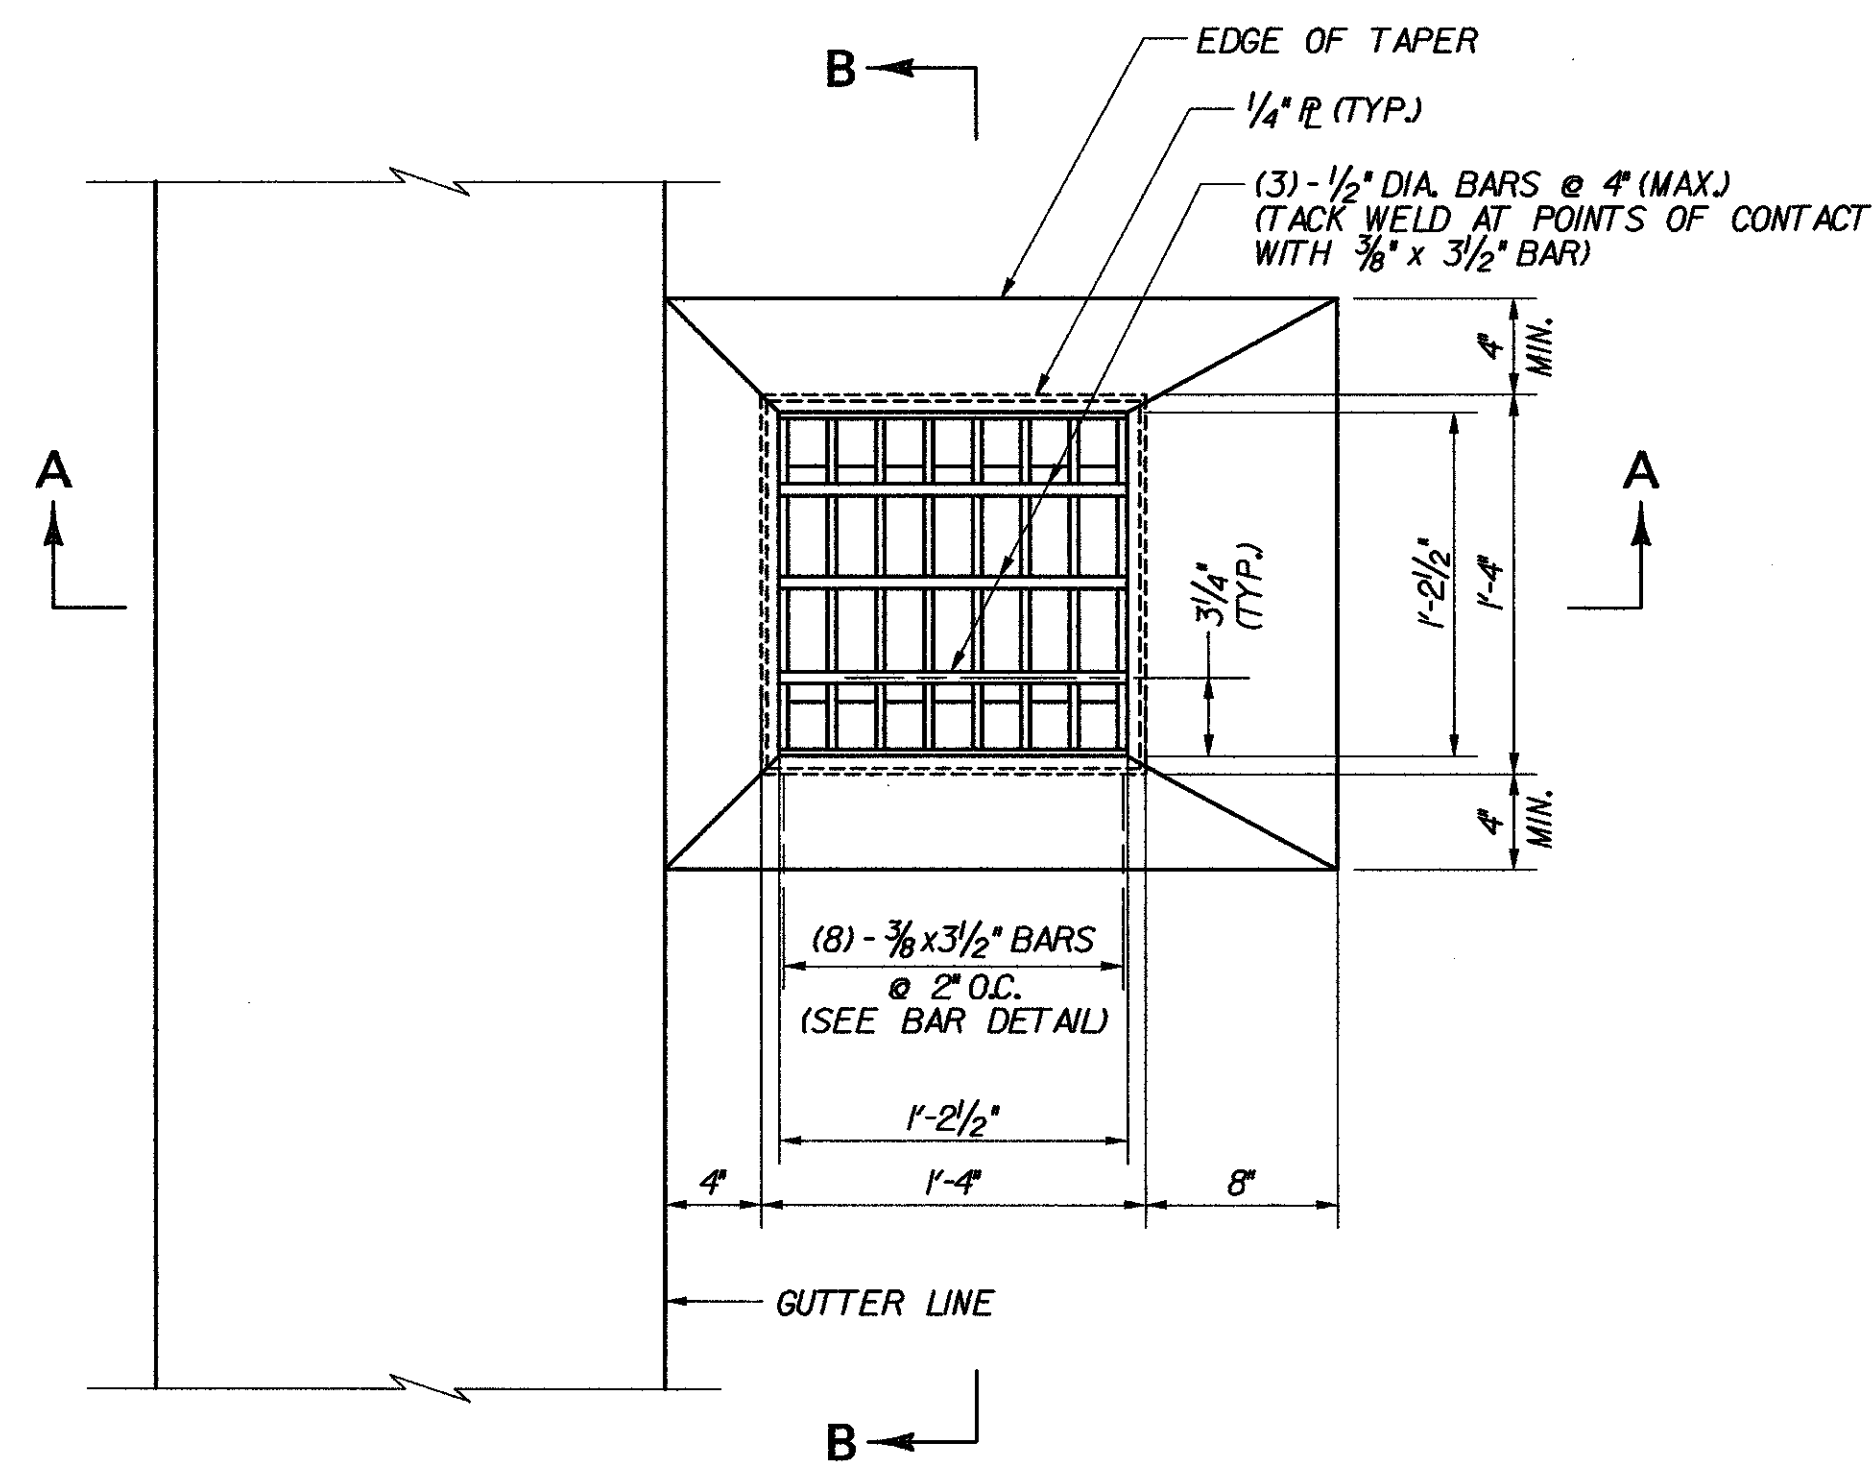


**PLAN**

SCALE: 1/2"=1'-0"

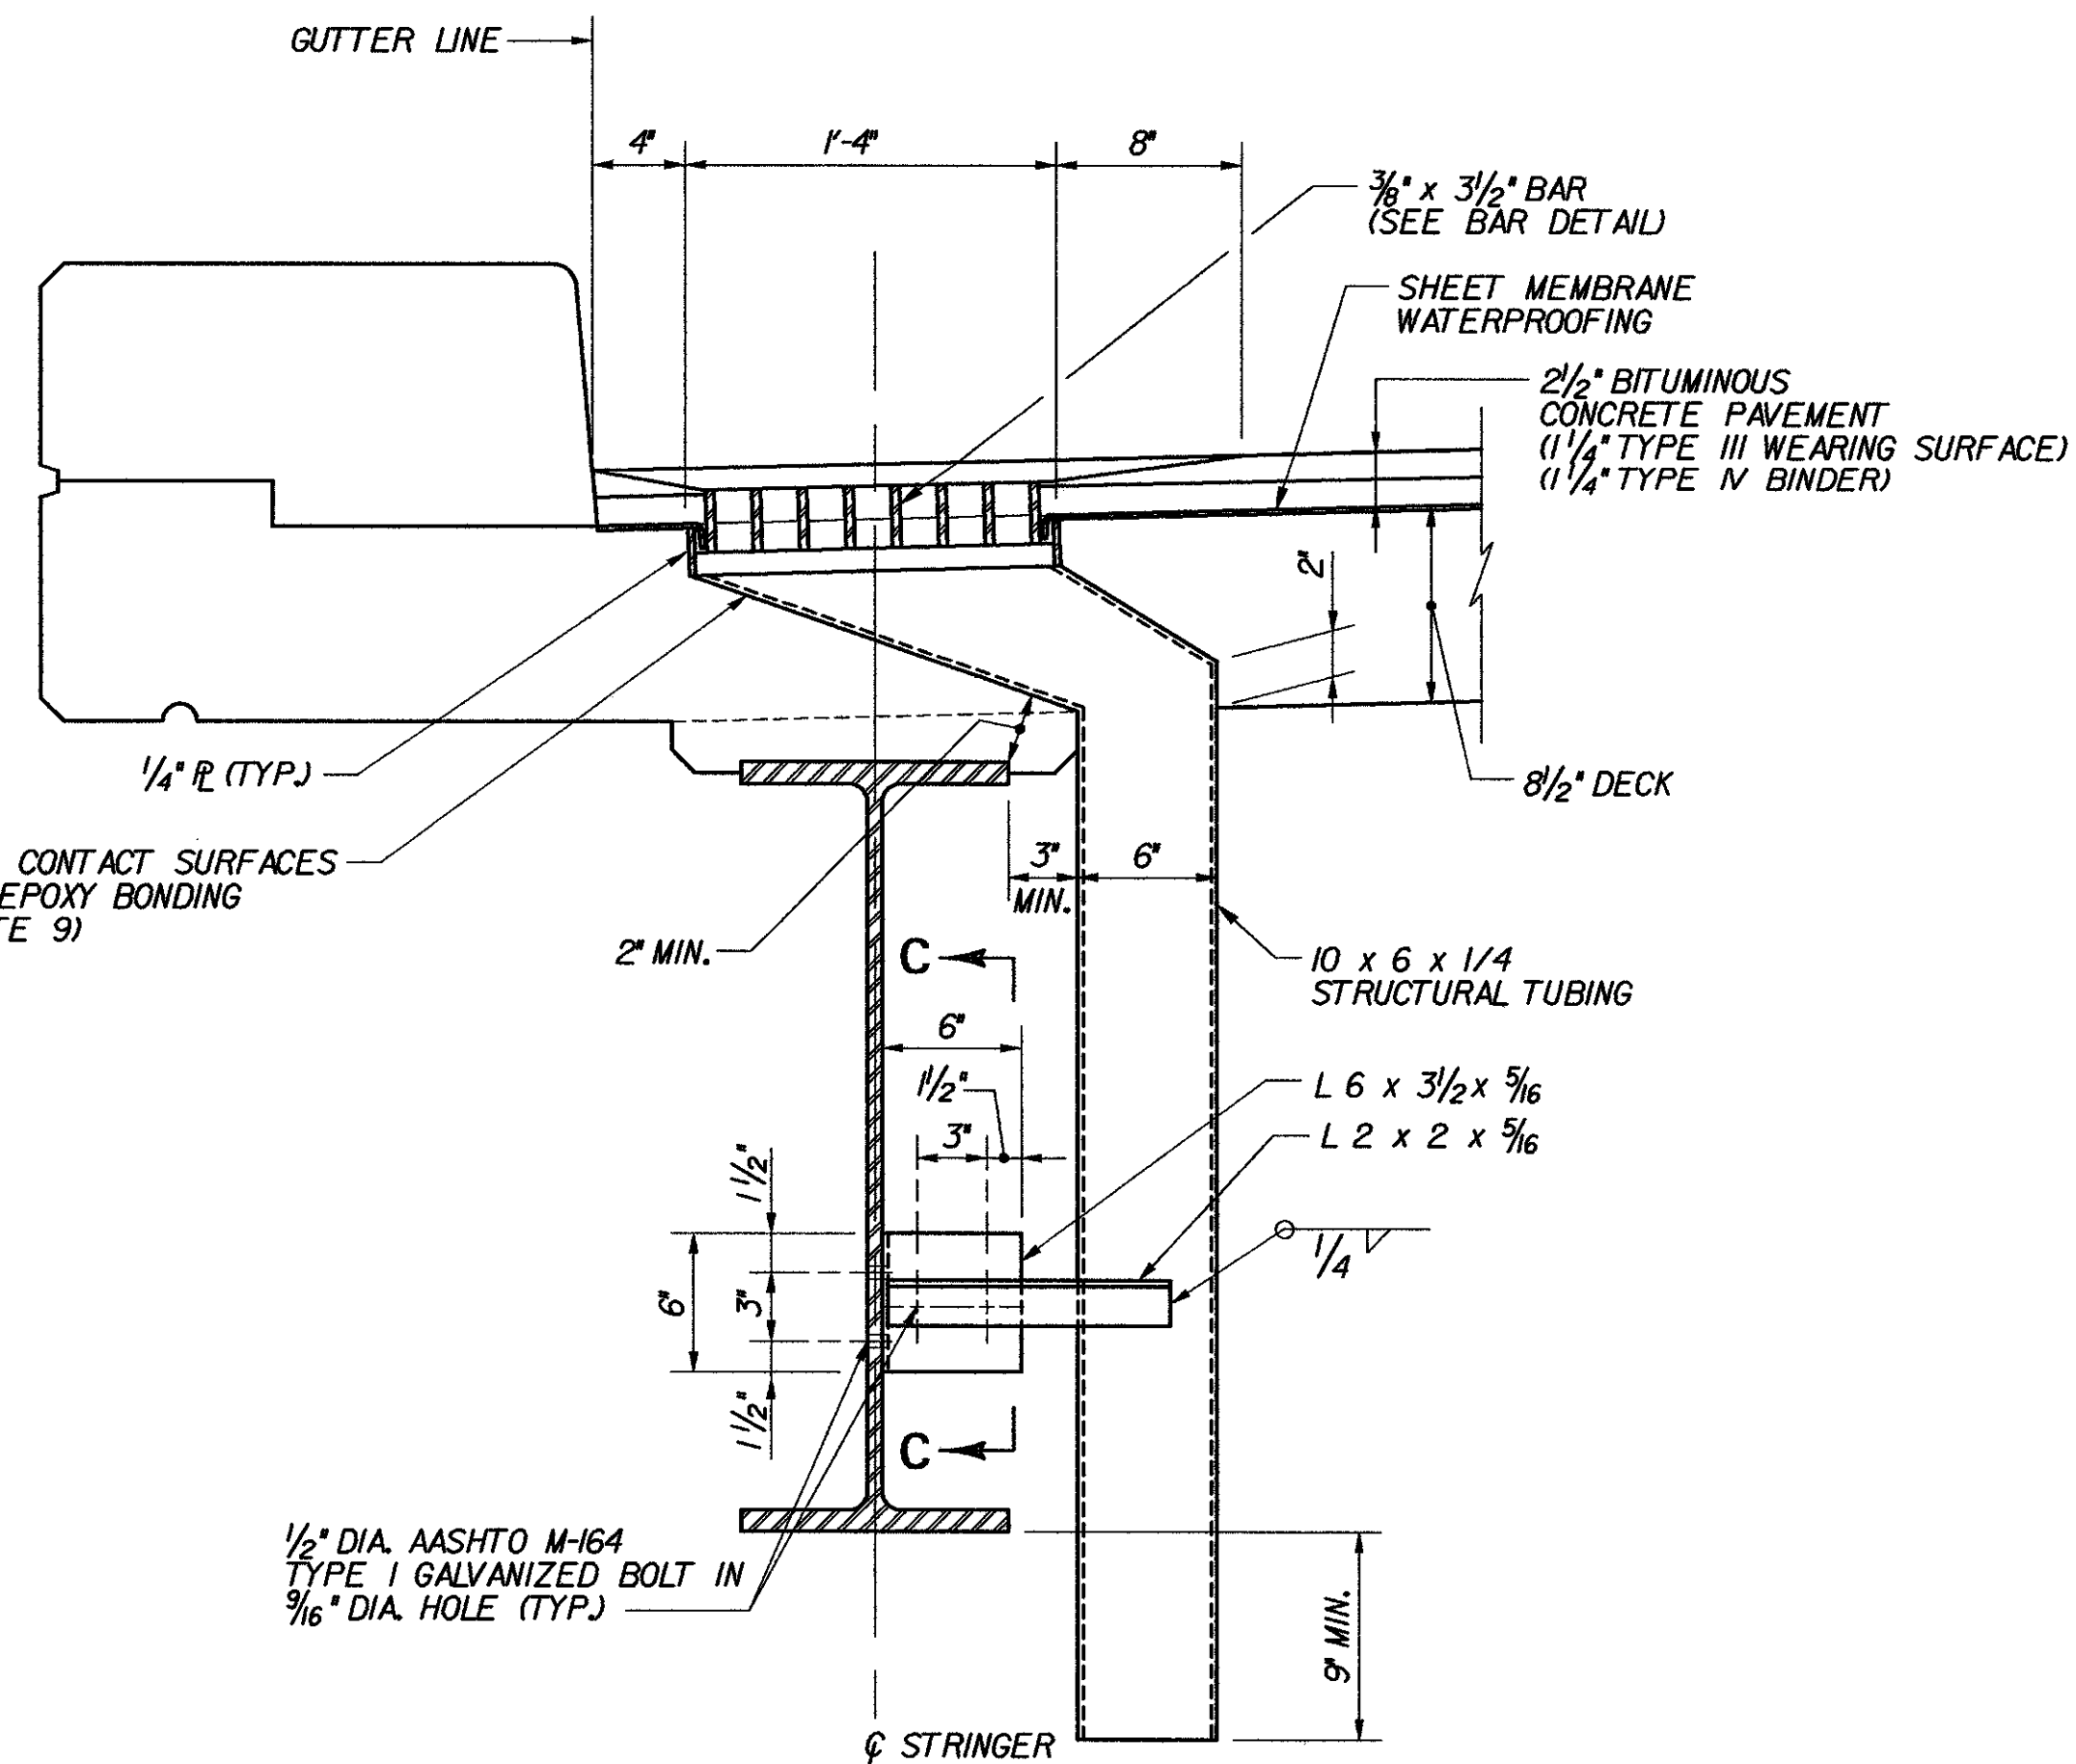



**SECTION A-A**

SCALE: 1/2"=1'-0"

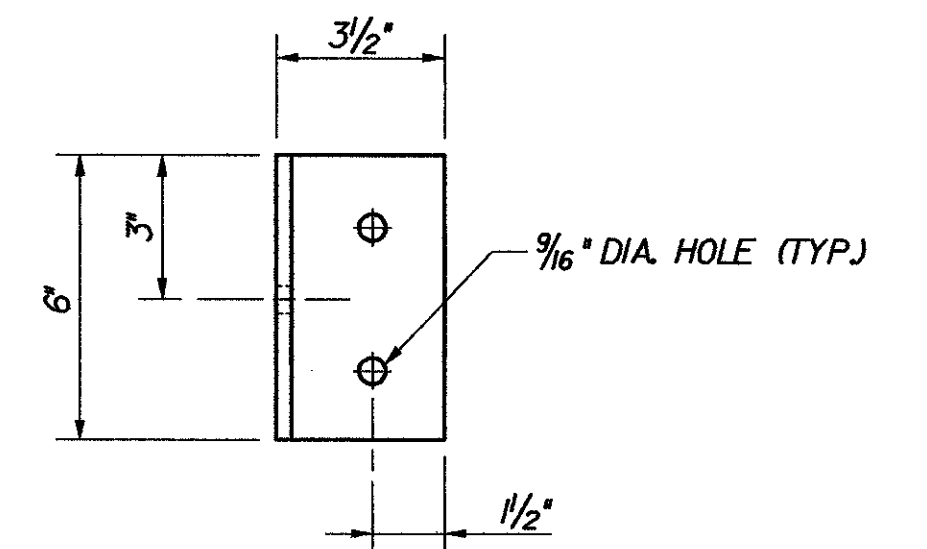


**SECTION C-C**

SCALE: 3"=1'-0"

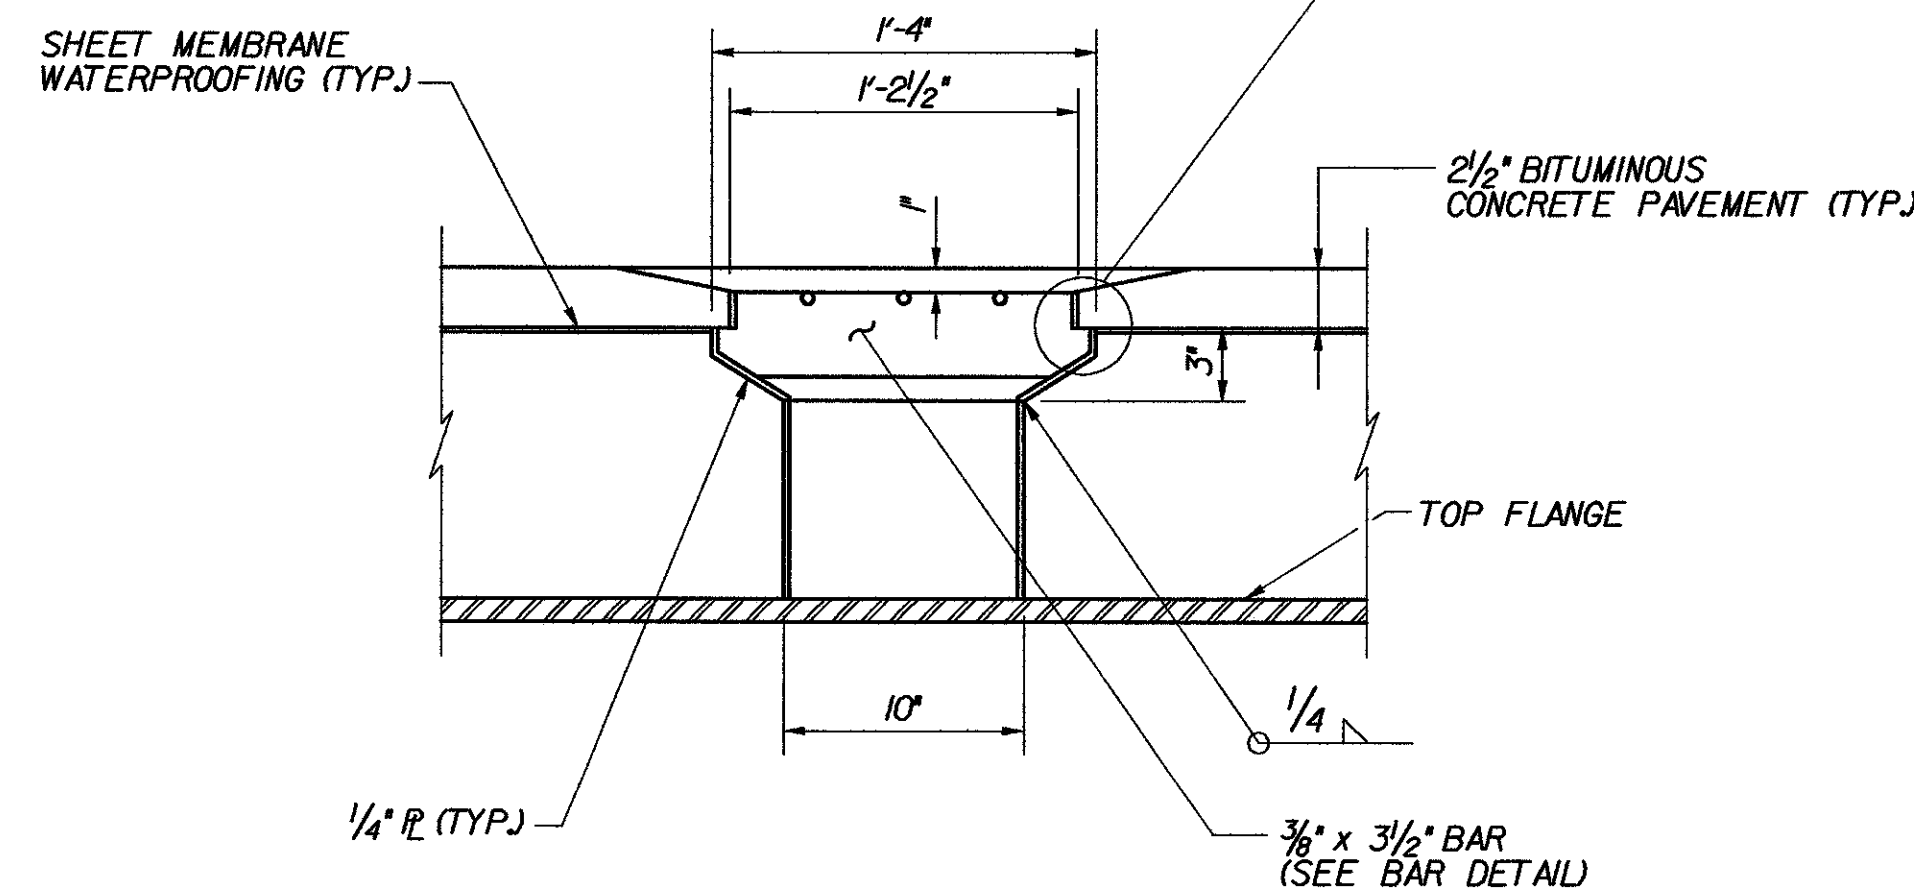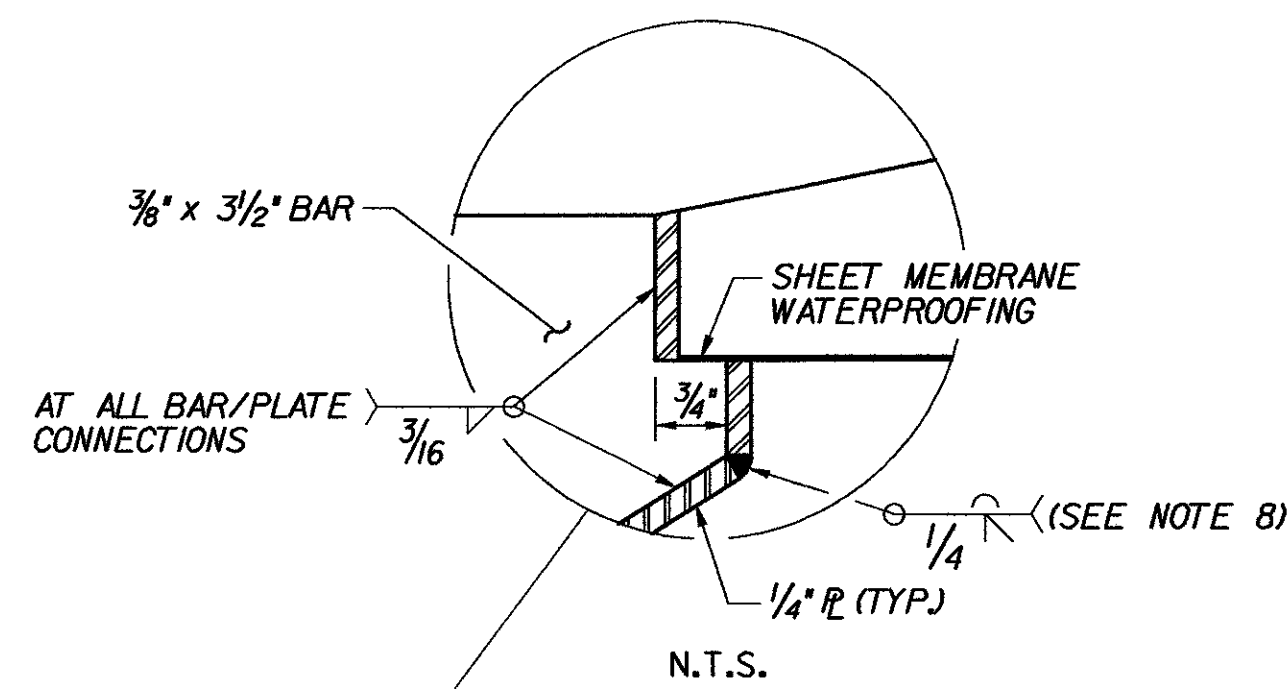

**SECTION B-B**

SCALE: 1/2"=1'-0"

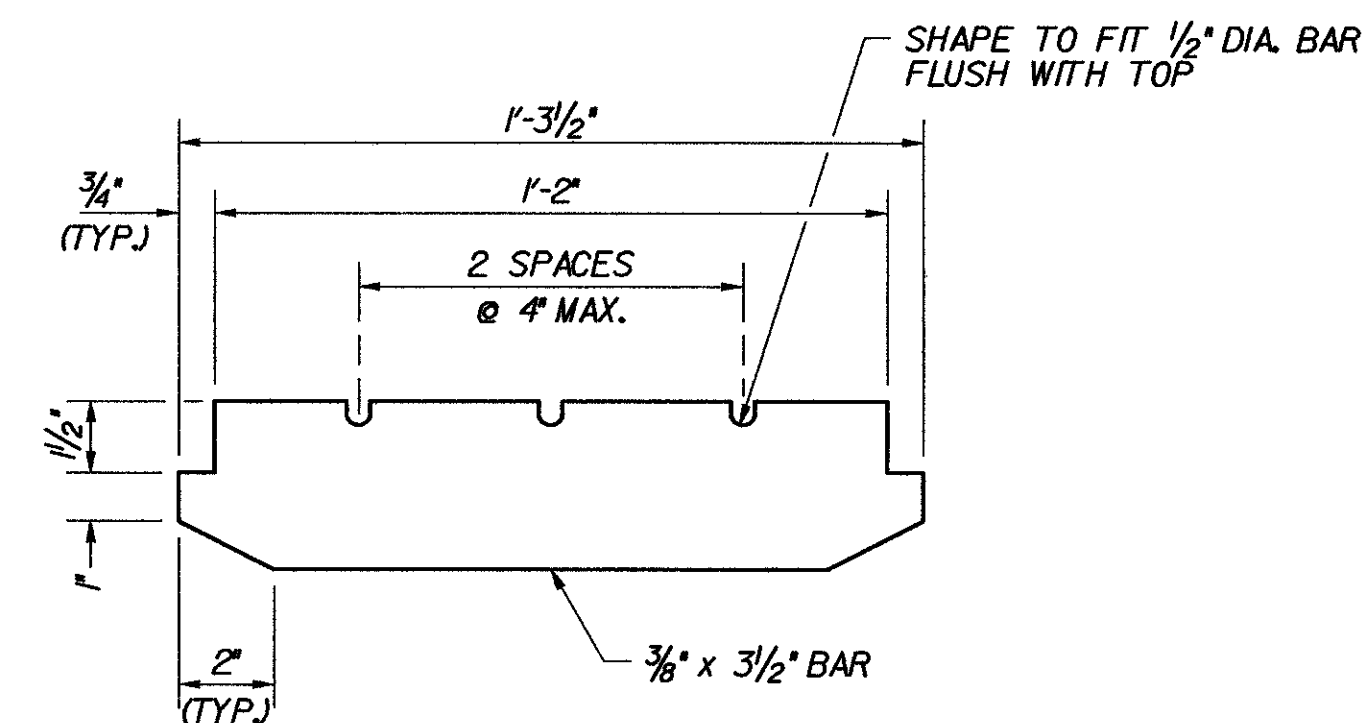

**BAR DETAIL**

SCALE: 3"=1'-0"

**NOTES:**

- FOR LOCATION OF SCUPPERS, SEE FRAMING PLAN FOR EACH BRIDGE.
- STRUCTURAL STEEL TUBING SHALL CONFORM TO ASTM A-500 OR A-501.
- ALL PLATES, BARS AND ANGLES SHALL CONFORM TO AASHTO M 270, GRADE 36. ALL BOLTS, NUTS AND WASHERS SHALL CONFORM TO AASHTO M-164, TYPE I.
- SCUPPERS, INCLUDING COMPONENTS REQUIRED FOR ATTACHMENT TO SUPERSTRUCTURE, SHALL BE GALVANIZED OR METALIZED AFTER FABRICATION, IN ACCORDANCE WITH SUBSECTION 506.15 OF THE SPECIFICATIONS.
- TOP SURFACE OF SCUPPERS MUST BE SLOPED TO MATCH ROADWAY CROSS SLOPE AND GRADE.
- THE BAR AND GRATE SECTION MAY BE PREFABRICATED PROVIDING THAT THE GEOMETRY AND SECTION PROPERTIES ARE EQUIVALENT TO THE DETAILS SHOWN.
- AT BR 43N&S, THE COST OF SCUPPERS SHALL BE PAID UNDER ITEM 506.50, "STRUCTURAL STEEL (ROLLED BEAM)". AT ALL OTHER LOCATIONS, THE COST SHALL BE PAID UNDER ITEM 506.55, "STRUCTURAL STEEL (PLATE GIRDER)".
- SCUPPER MAY BE FABRICATED BY BENDING PLATES AT THESE JOINTS IN LIEU OF A WELDED CONNECTION. INSIDE RADII SHALL BE NOT GREATER THAN 1/2". GEOMETRICS OF BENT SECTION SHALL CONFORM TO 1/16" FABRICATION TOLERANCE.
- EPOXY BONDING COMPOUND SHALL CONFORM TO THE REQUIREMENTS OF SECTION 719 OF THE SPECIFICATIONS. PAYMENT FOR EPOXY BONDING COMPOUND SHALL BE SUBSIDIARY TO ITEM 501.221, "CONCRETE CLASS A QC/QA".

**STATE OF VERMONT  
AGENCY OF TRANSPORTATION**


Town Of	MIDDLESEX-BOLTON	Bridge No.	
Highway No.	I-89	Log Sta.	
		Surv. Sta.	

**TYPICAL SCUPPER DETAILS**

Designed By	P.W. SZUSTAK	Drawn By	R.A. BOTZENHART
Checked By	Date	Bridge Design Supervisor	
J.P. HALSTEAD	10/99	J.P. HALSTEAD	Date 10/99

PROJECT	MIDDLESEX-BOLTON	PROJECT NO.	IM-089-2(126)
---------	------------------	-------------	---------------

TVGA CAD Drawing No.	scup_det	Date	10/99
Bridge Sheet No.	C-39	Sheet	39 of 307

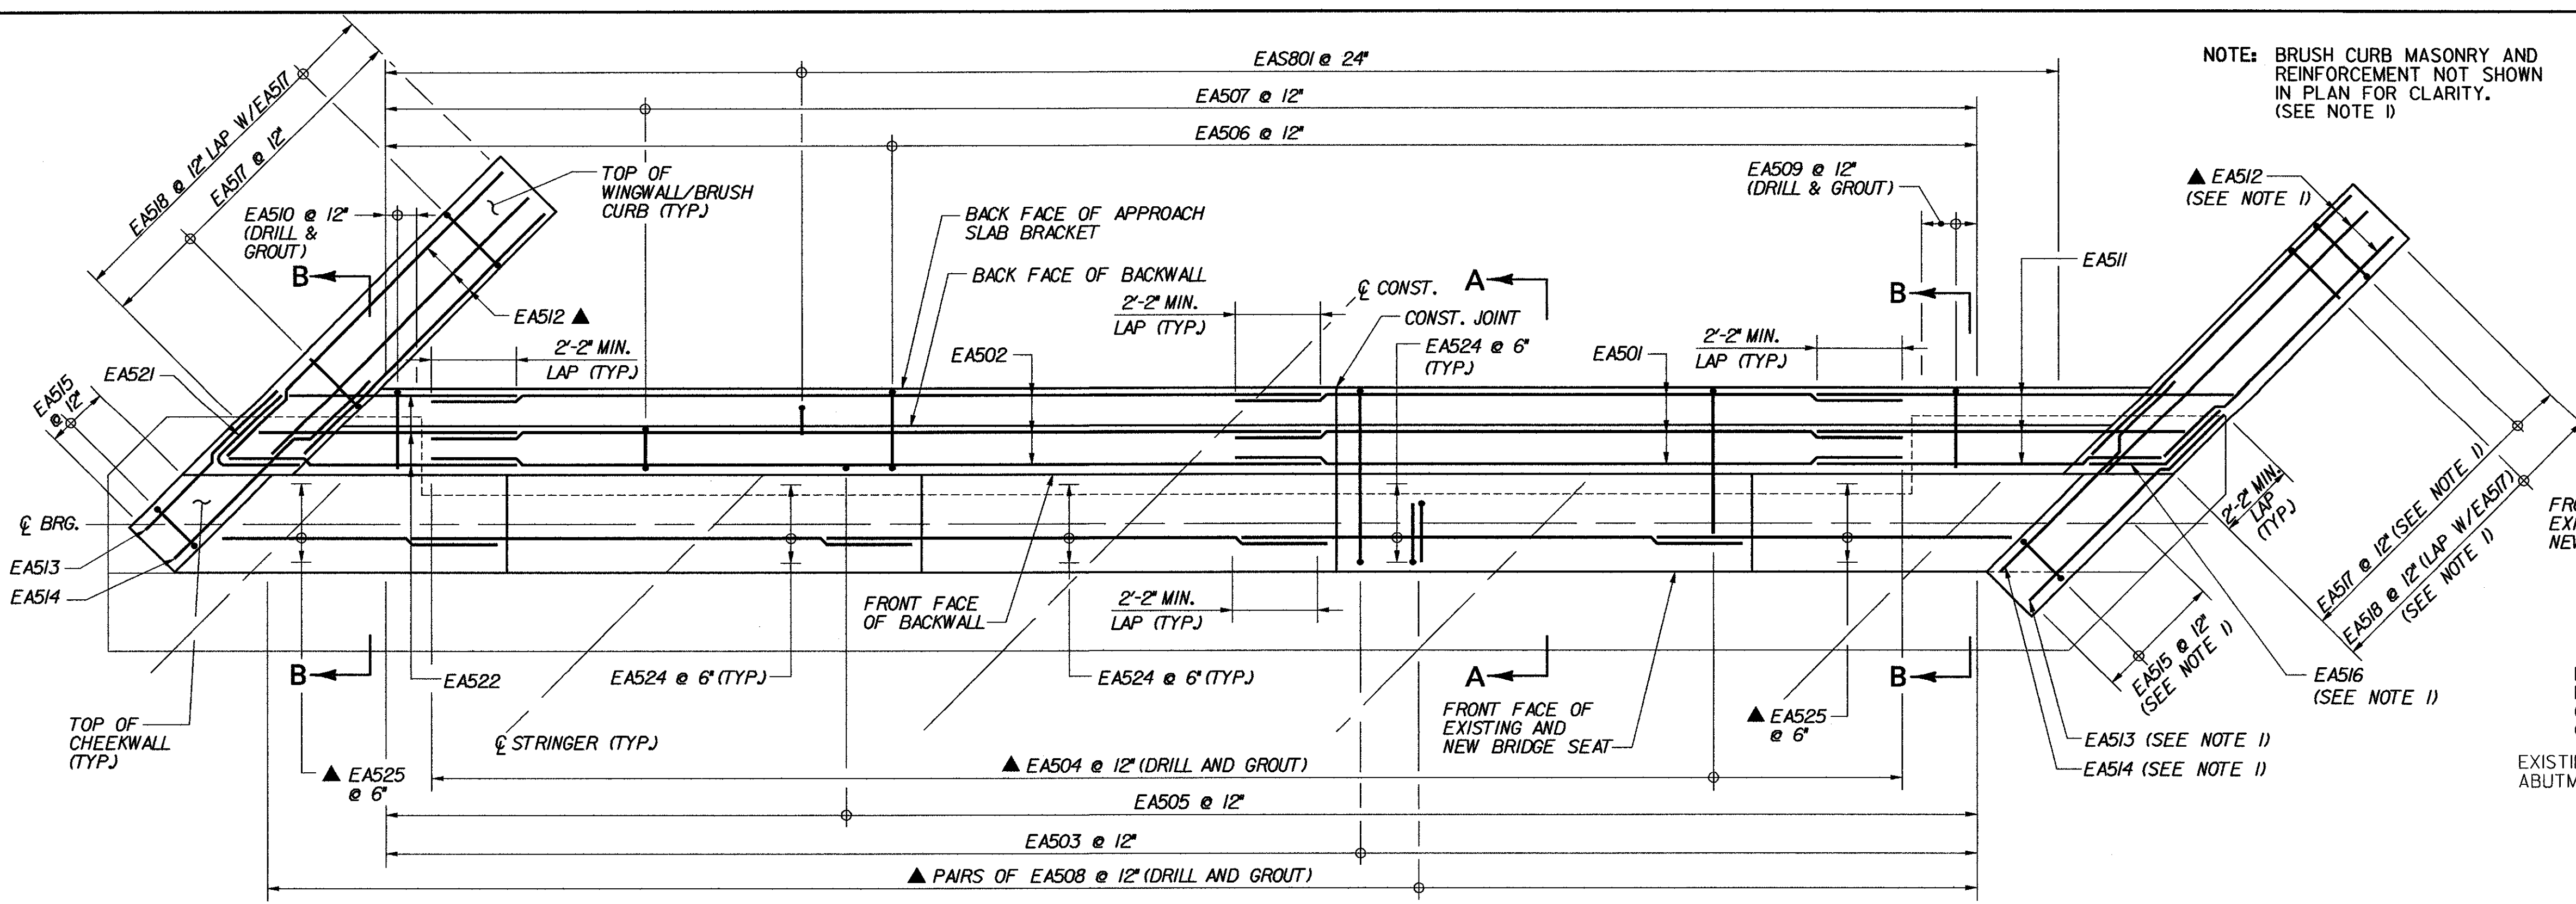


**PLAN**  
N.T.S.


REINFORCEMENT LAYOUT SHOWN IS INTENDED AS GUIDANCE ONLY. CONTRACTOR MUST MAKE ADJUSTMENTS IN ORDER TO FIT ACTUAL FIELD CONDITIONS, AS APPROVED BY THE ENGINEER, AT NO ADDITIONAL EXPENSE TO THE CONTRACT.

NOTE: ACUTE WINGWALL REINFORCEMENT NOT SHOWN FOR CLARITY. LAYOUT SIMILAR TO OBTUSE WINGWALL, EXCEPT FOR EAS16, WHICH IS REPLACED BY EAS21.


CONSTRUCTION JOINT LOCATED AT STEP IN BRIDGE SEAT. LOCATION SHALL BE REVISED AS DIRECTED BY THE RESIDENT ENGINEER AS REQUIRED TO MATCH ANY CONSTRUCTION JOINT IN THE EXISTING ABUTMENT STEM. REQUIRED REVISIONS TO REINFORCING STEEL LENGTHS WILL BE MADE BY THE CONTRACTOR AT NO ADDITIONAL EXPENSE TO THE CONTRACT.

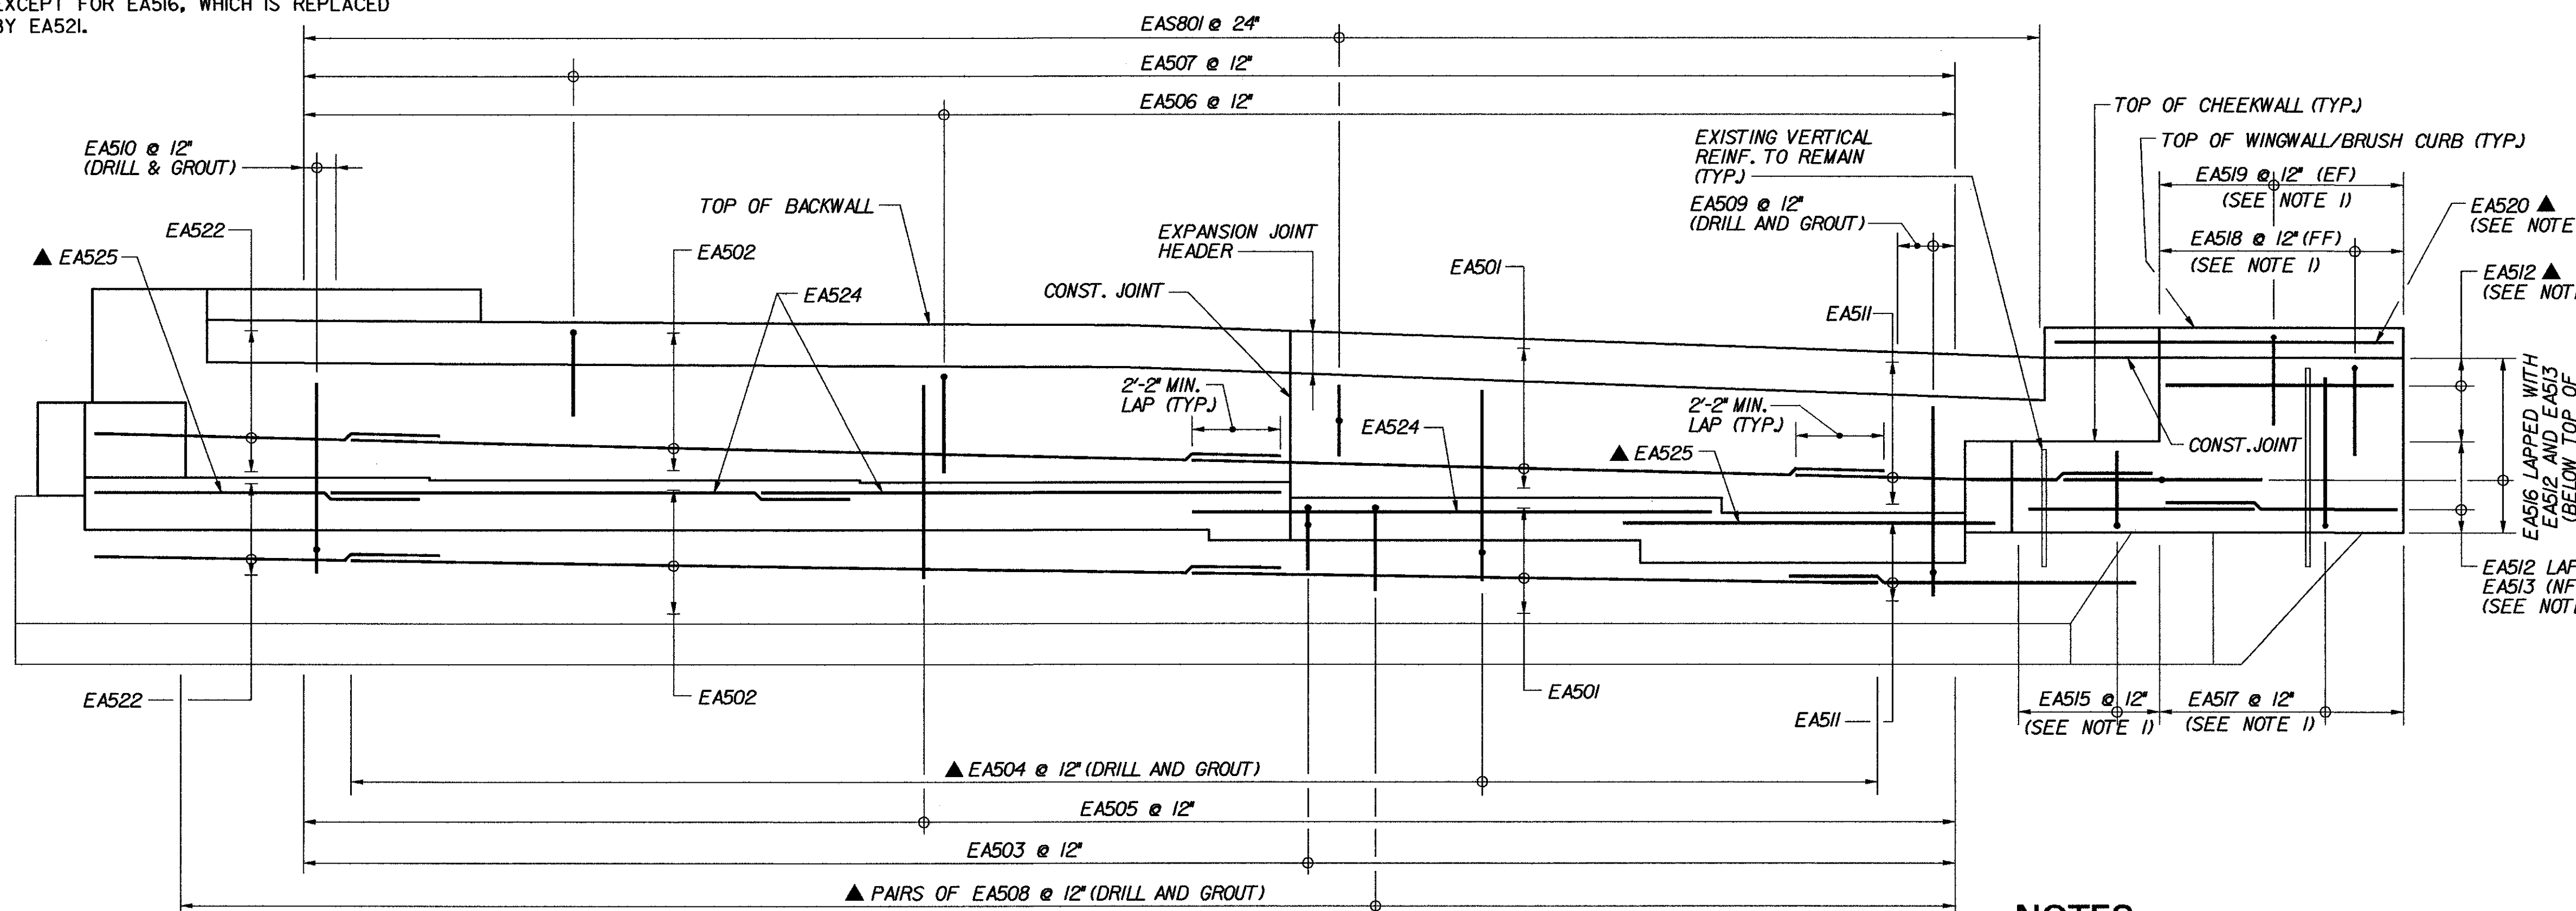

**ELEVATION**  
N.T.S.

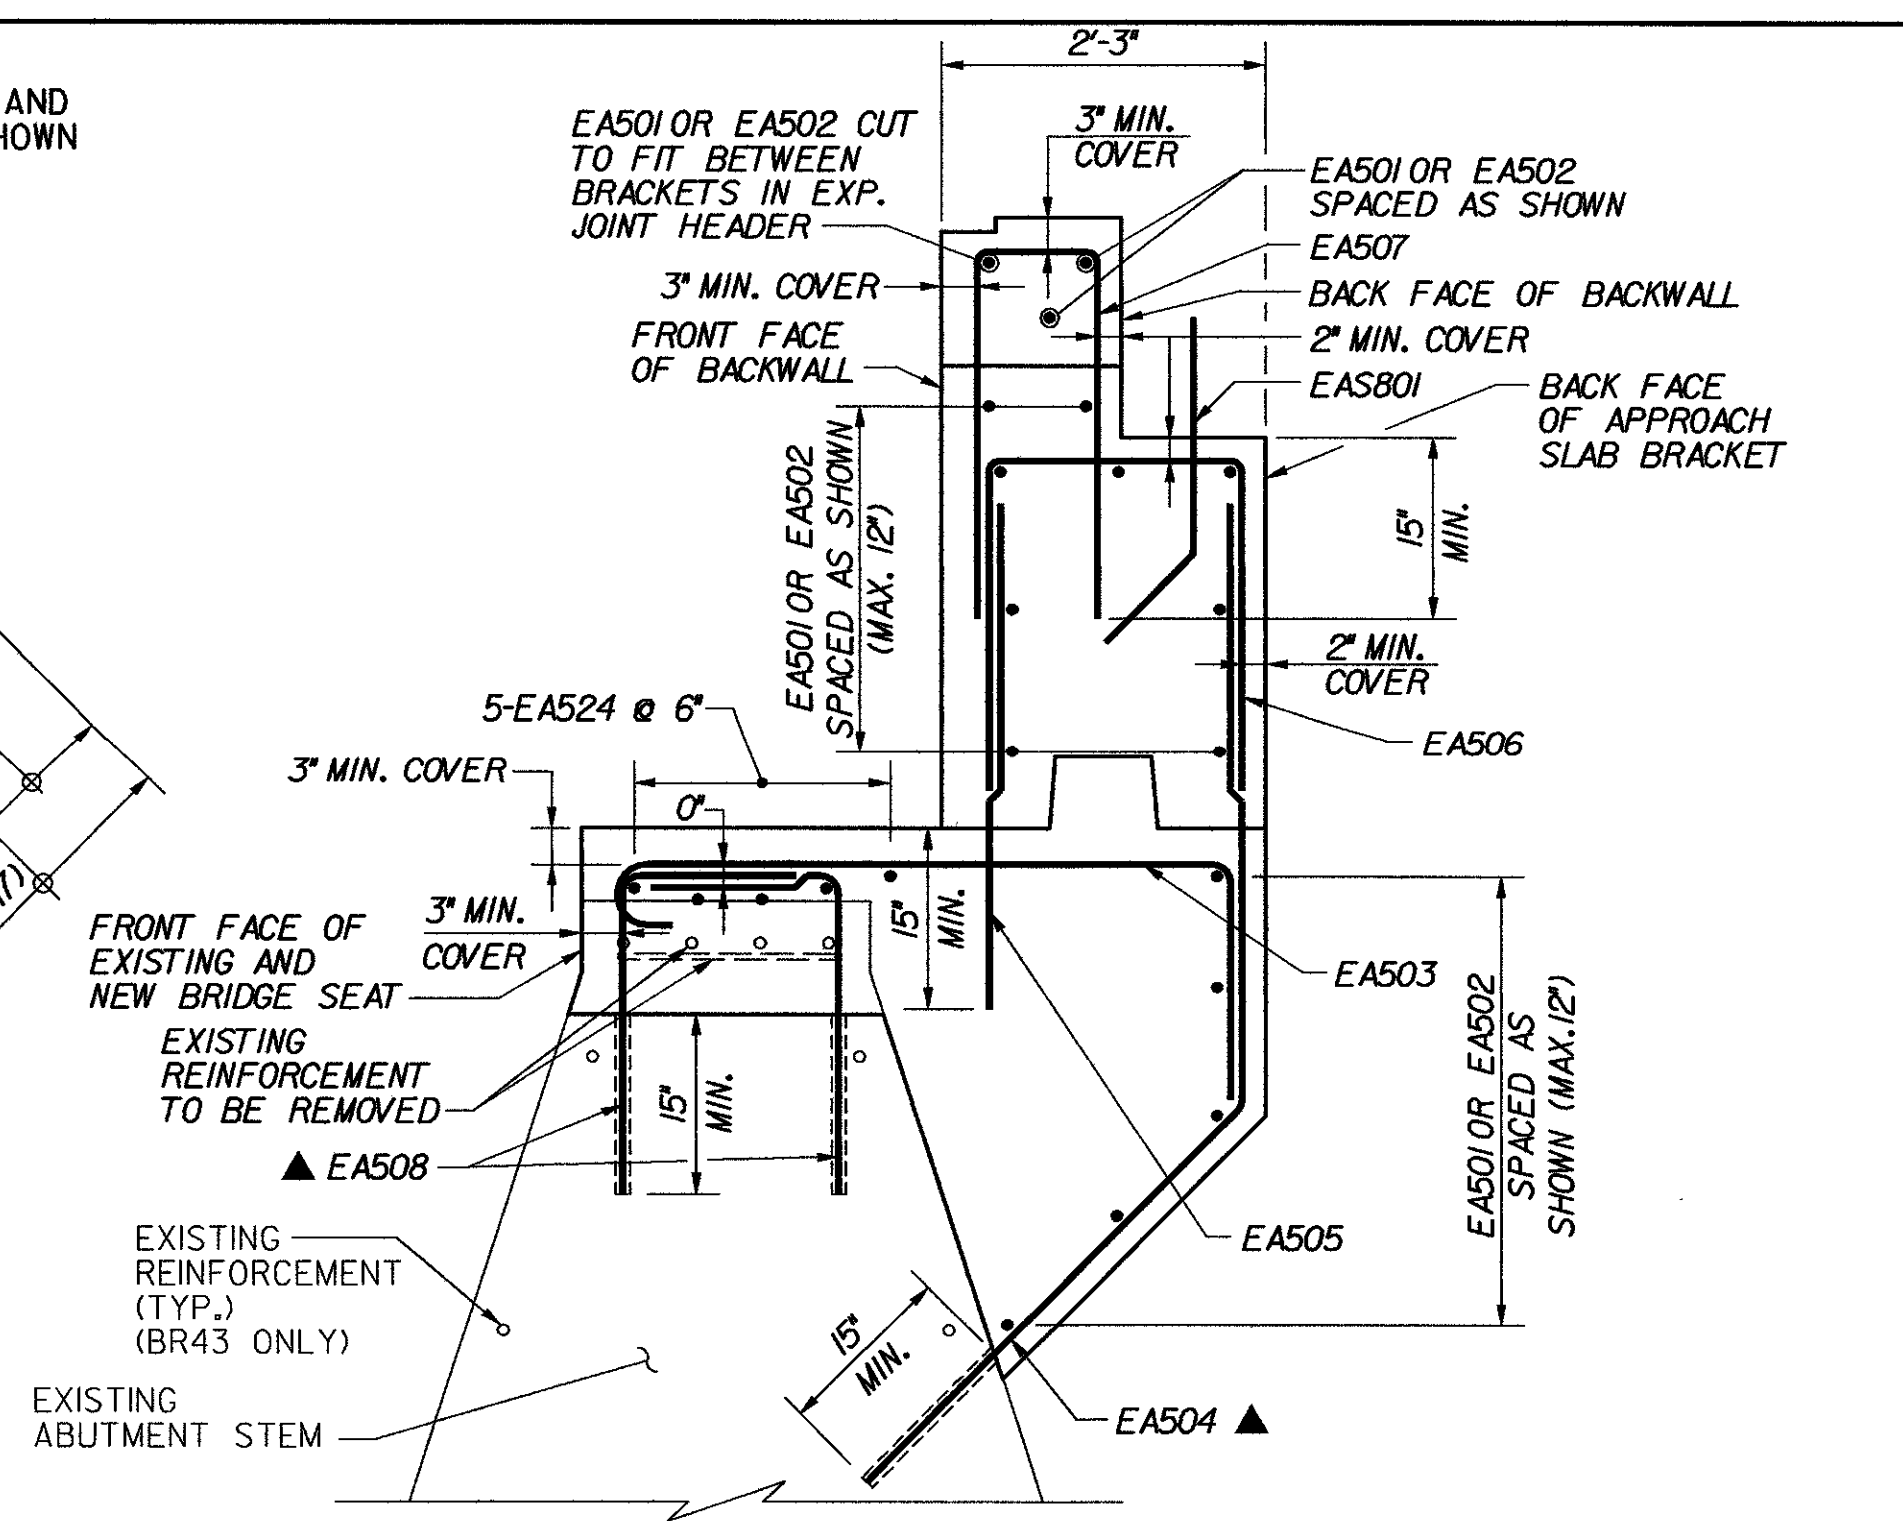

**SECTION A-A**  
N.T.S.

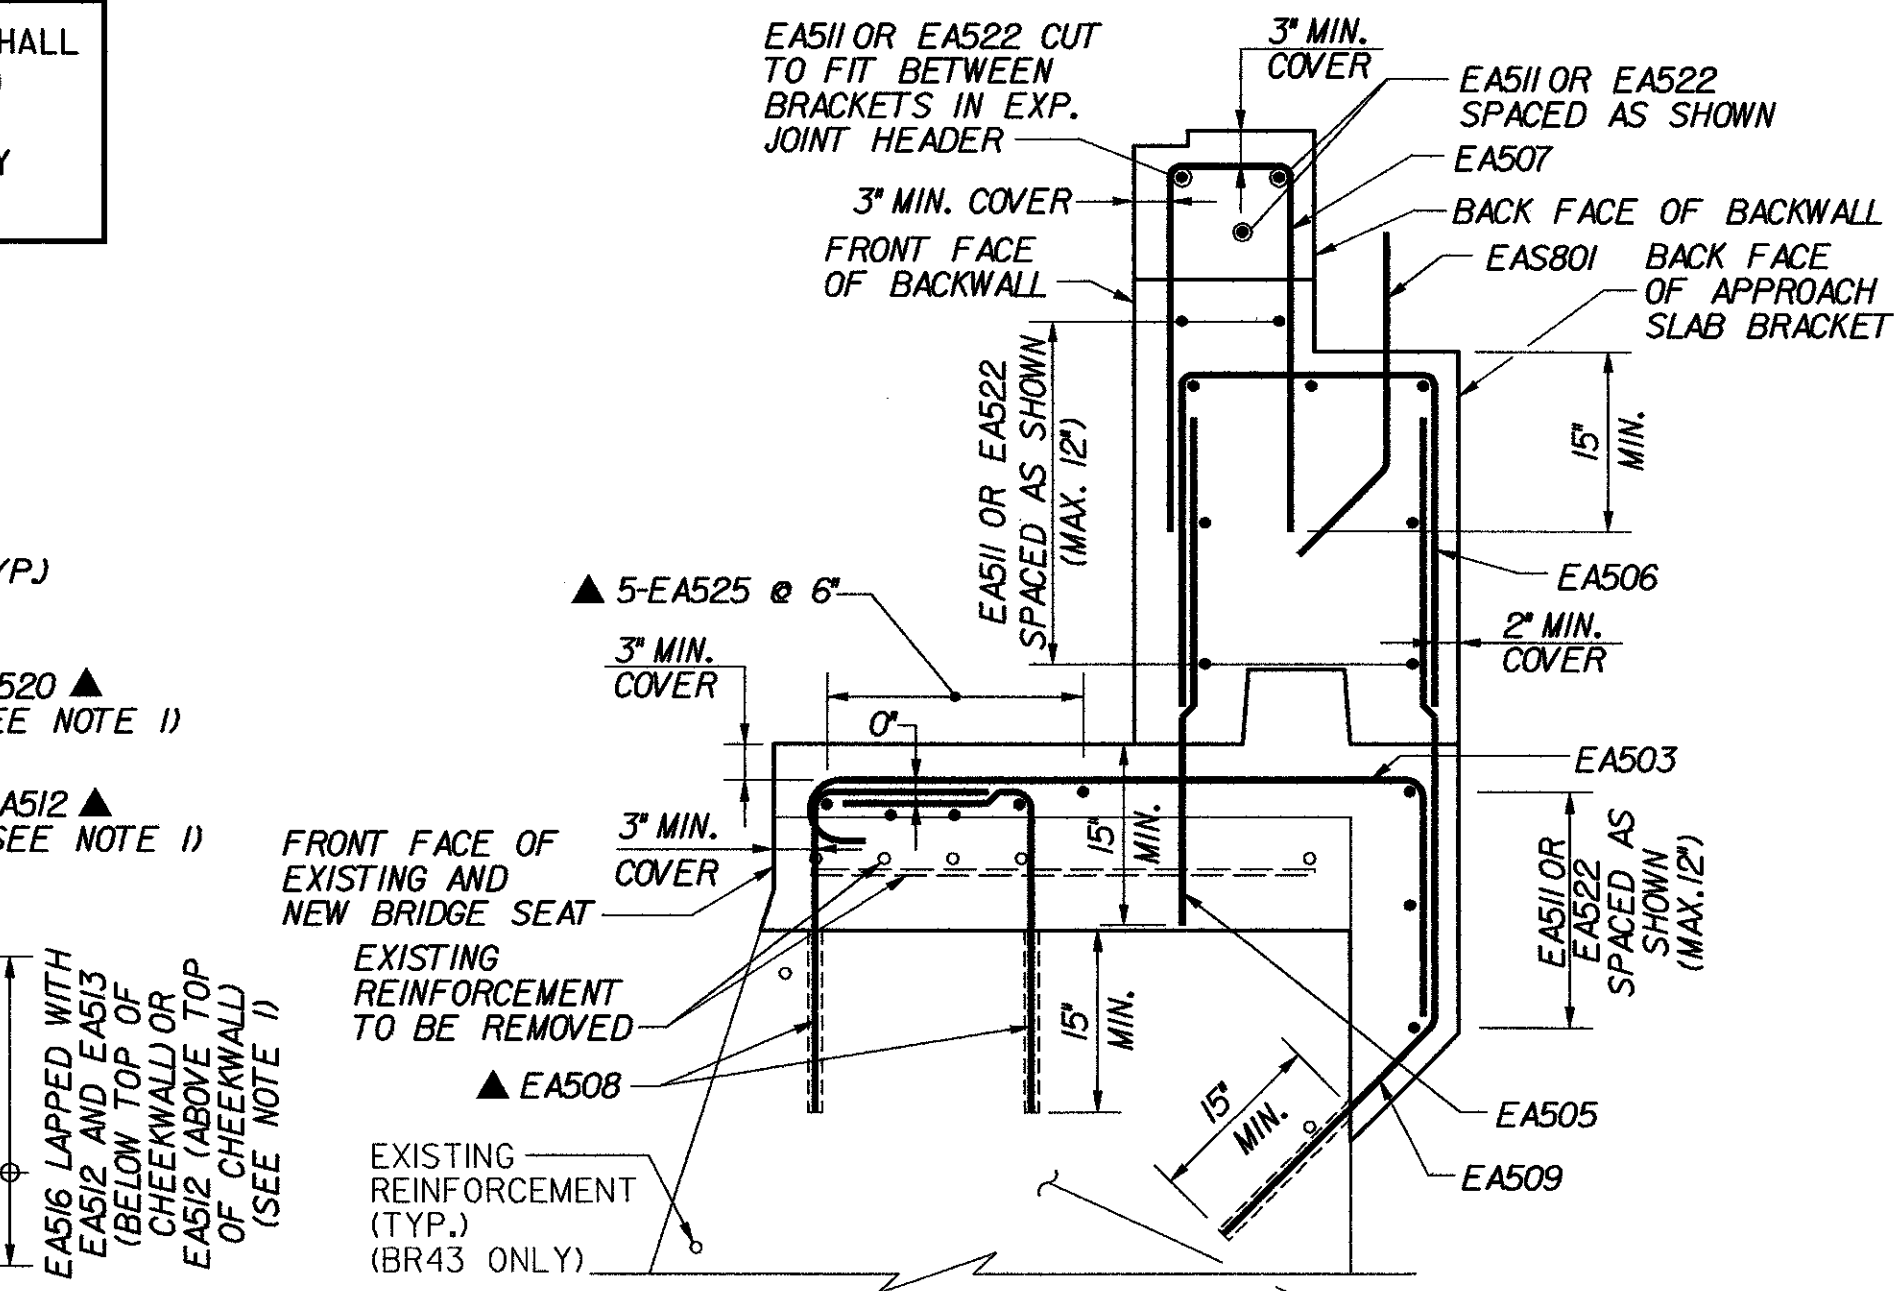


**SECTION B-B**  
N.T.S.

**KEY**  
 NF NEAR FACE  
 FF FAR FACE  
 EF EACH FACE  
 ▲ REINFORCEMENT TO BE CUT TO FIT IN THE FIELD


**NOTES:**  
 1. FOR ADDITIONAL WINGWALL AND BRUSH CURB DETAILS, SEE TYPICAL WINGWALL DETAILS, BRIDGE SHEETS C-43 AND C-44.  
 2. CONCRETE LIMITS AND DIMENSIONS ARE SHOWN IN ABUTMENT MASONRY PLANS FOR EACH BRIDGE.

**STATE OF VERMONT  
AGENCY OF TRANSPORTATION**

Town Of	MIDDLESEX-BOLTON	Bridge No.	
Highway No.	I-89	Log Sta.	
		Surv. Sta.	
<b>TYPICAL EXPANSION ABUTMENT REINFORCEMENT</b>			
Designed By	P.W. SZUSTAK	Drawn By	R.A. BOTZENHART
Checked By	J.P. HALSTEAD	Date	10/99
		Bridge Design Supervisor	J.P. HALSTEAD Date 10/99
PROJECT	MIDDLESEX-BOLTON	PROJECT NO.	IM-089-2(26)
TVGA CAD Drawing No.	abrinf_e	Date	10/99
Bridge Sheet No.	C-40	Sheet	40 of 307

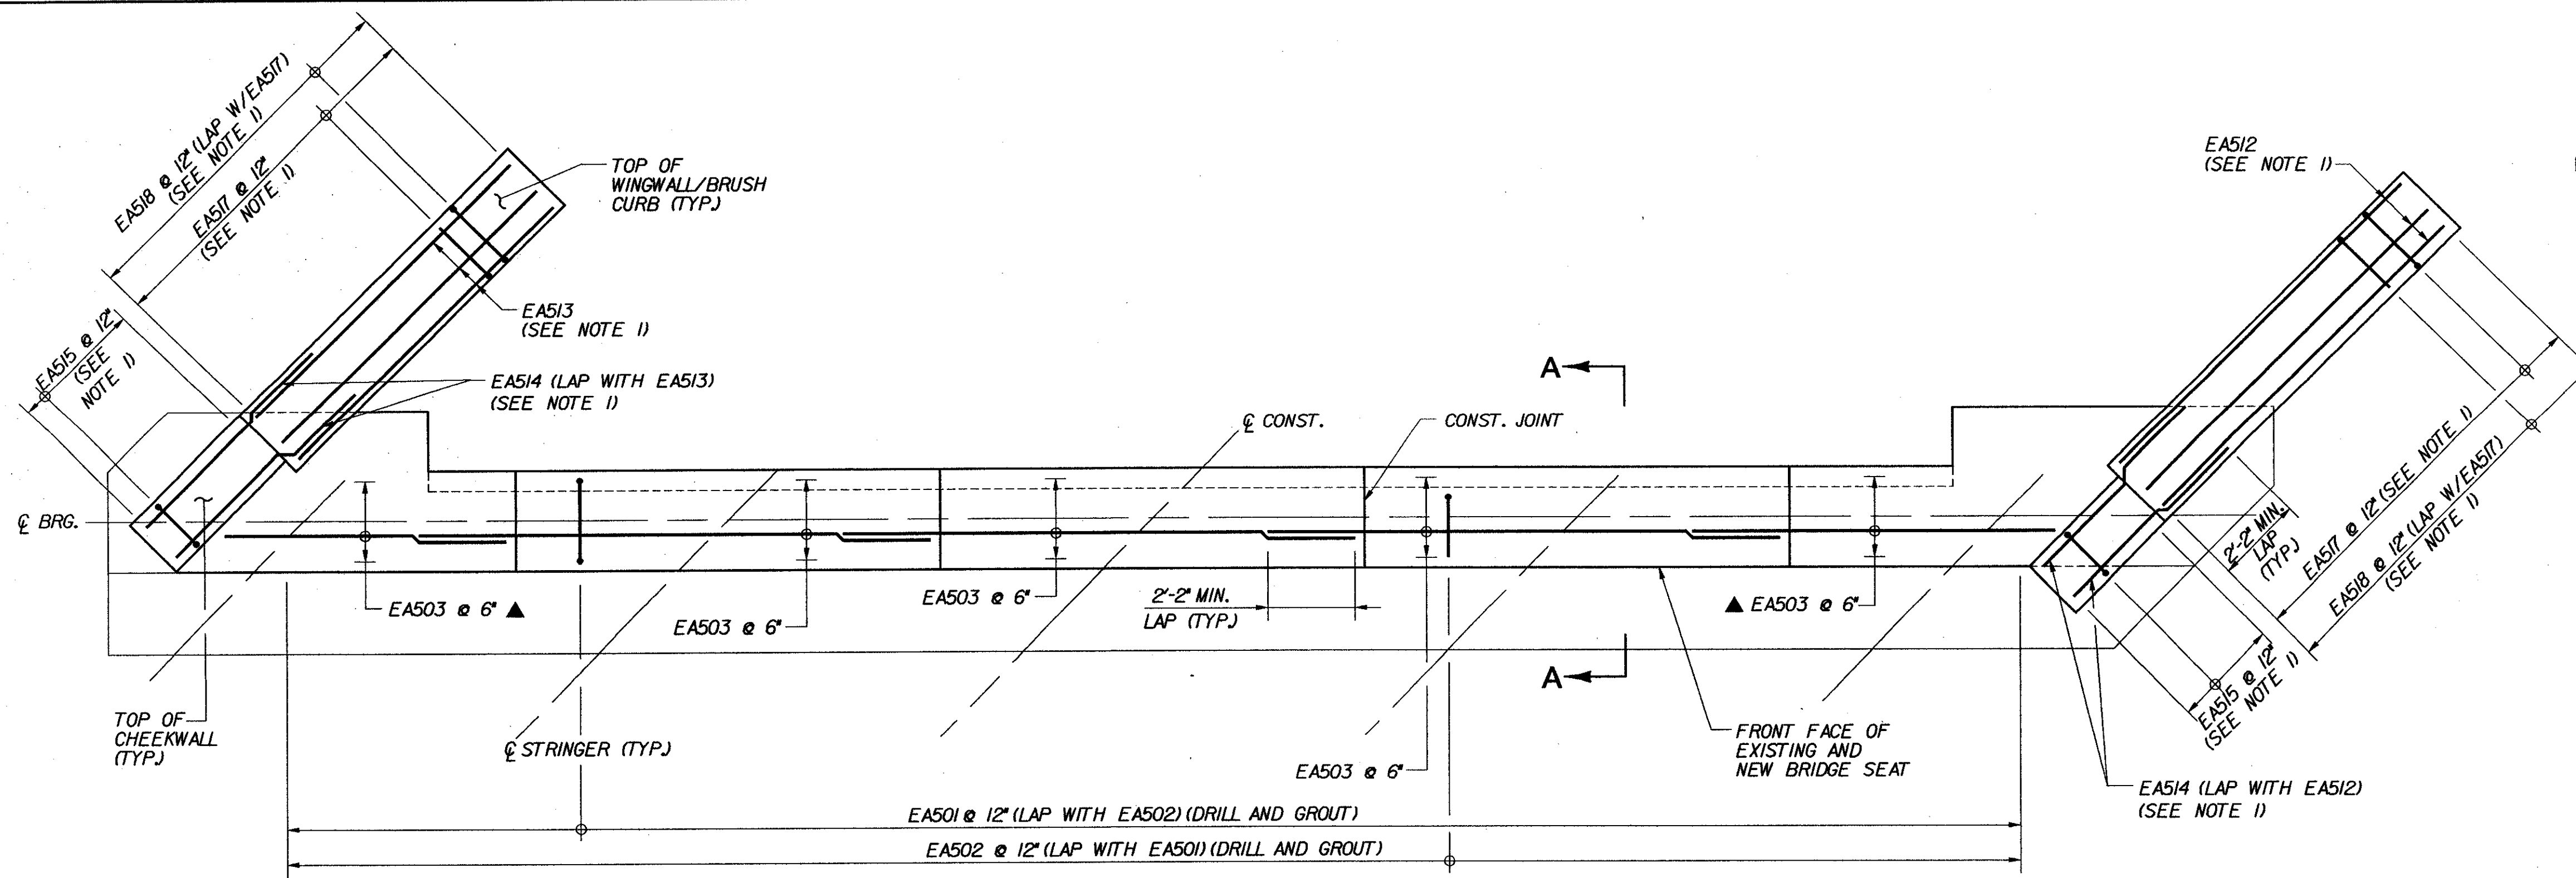


NOTE: BRUSH CURB MASONRY AND REINFORCEMENT NOT SHOWN IN PLAN FOR CLARITY. (SEE NOTE 1)

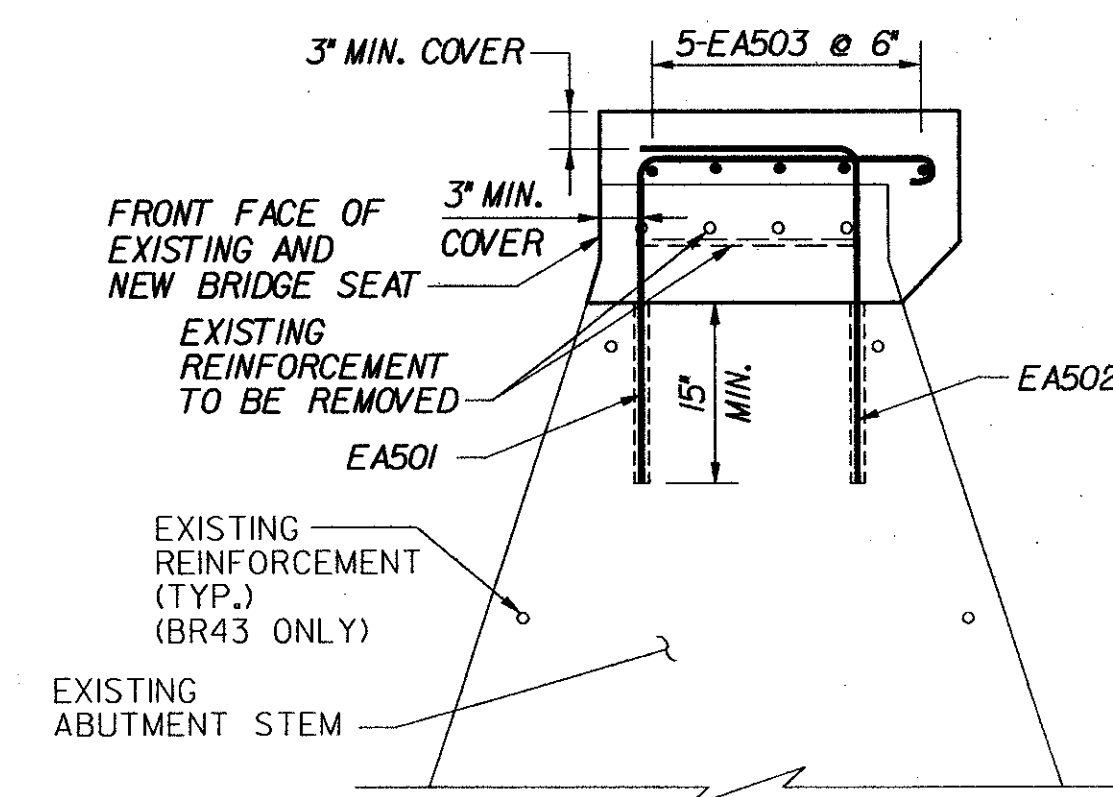

REINFORCEMENT LAYOUT SHOWN IS INTENDED AS GUIDANCE ONLY. CONTRACTOR MUST MAKE ADJUSTMENTS IN ORDER TO FIT ACTUAL FIELD CONDITIONS, AS APPROVED BY THE ENGINEER, AT NO ADDITIONAL EXPENSE TO THE CONTRACT.

CONSTRUCTION JOINT LOCATED AT STEP IN BRIDGE SEAT. LOCATION SHALL BE REVISED AS DIRECTED BY THE RESIDENT ENGINEER AS REQUIRED TO MATCH ANY CONSTRUCTION JOINT IN THE EXISTING ABUTMENT STEM. REQUIRED REVISIONS TO REINFORCING STEEL LENGTHS WILL BE MADE BY THE CONTRACTOR AT NO ADDITIONAL EXPENSE TO THE CONTRACT.

NOTE: ACUTE WINGWALL REINFORCEMENT NOT SHOWN IN ELEVATION FOR CLARITY. LAYOUT SIMILAR TO OBTUSE WINGWALL, EXCEPT FOR EA512, WHICH IS REPLACED BY EA513.

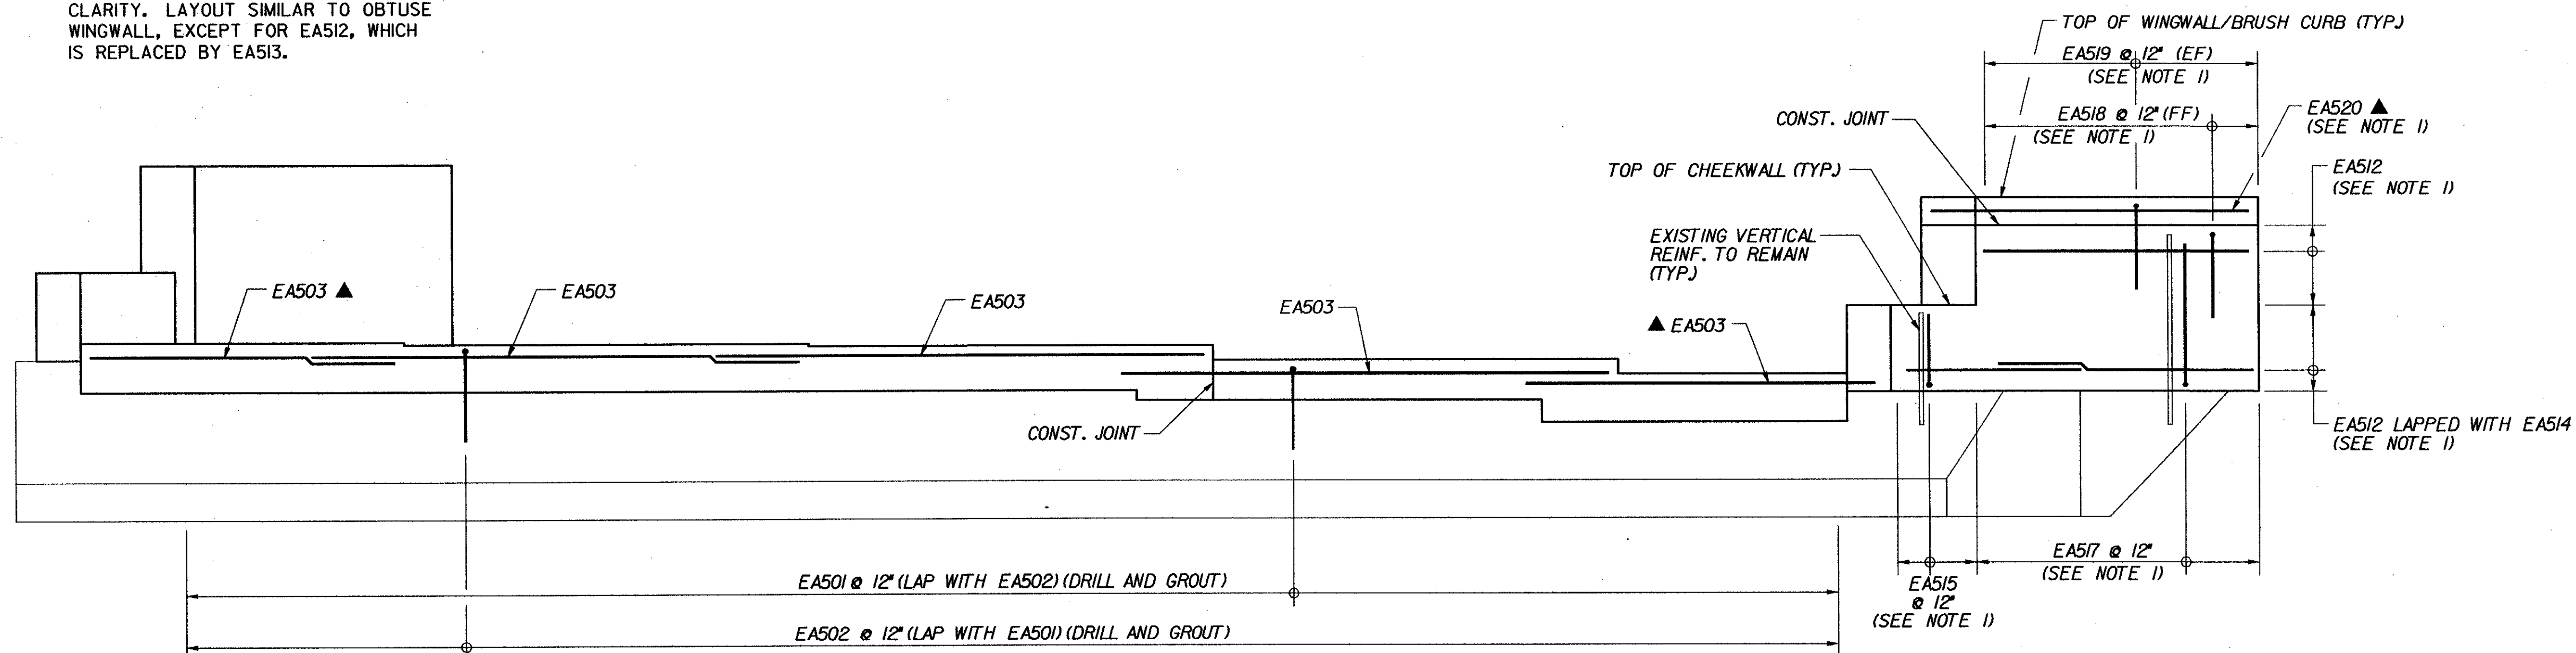

**NOTES:**


- FOR ADDITIONAL WINGWALL AND BRUSH CURB DETAILS, SEE TYPICAL WINGWALL DETAILS, BRIDGE SHEETS C-43 AND C-44.
- CONCRETE LIMITS AND DIMENSIONS ARE SHOWN IN ABUTMENT MASONRY PLANS FOR EACH BRIDGE.

**KEY**


- NF NEAR FACE
- FF FAR FACE
- EF EACH FACE
- ▲ REINFORCEMENT TO BE CUT TO FIT IN THE FIELD

**STATE OF VERMONT  
AGENCY OF TRANSPORTATION**


Town Of	MIDDLESEX-BOLTON	Bridge No.	
Highway No.	I-89	Log Sta.	
		Surv. Sta.	
<b>TYPICAL FIXED ABUTMENT REINFORCEMENT</b>			
Designed By	P.W. SZUSTAK	Drawn By	R.A. BOTZENHART
Checked By	J.P. HALSTEAD	Date	10/99
		Bridge Design Supervisor	J.P. HALSTEAD
PROJECT	MIDDLESEX-BOLTON	PROJECT NO.	IM-089-2(26)
TVGA CAD Drawing No.	abrInf_f	Date	10/99
Bridge Sheet No.	C-41	Sheet	41 of 307

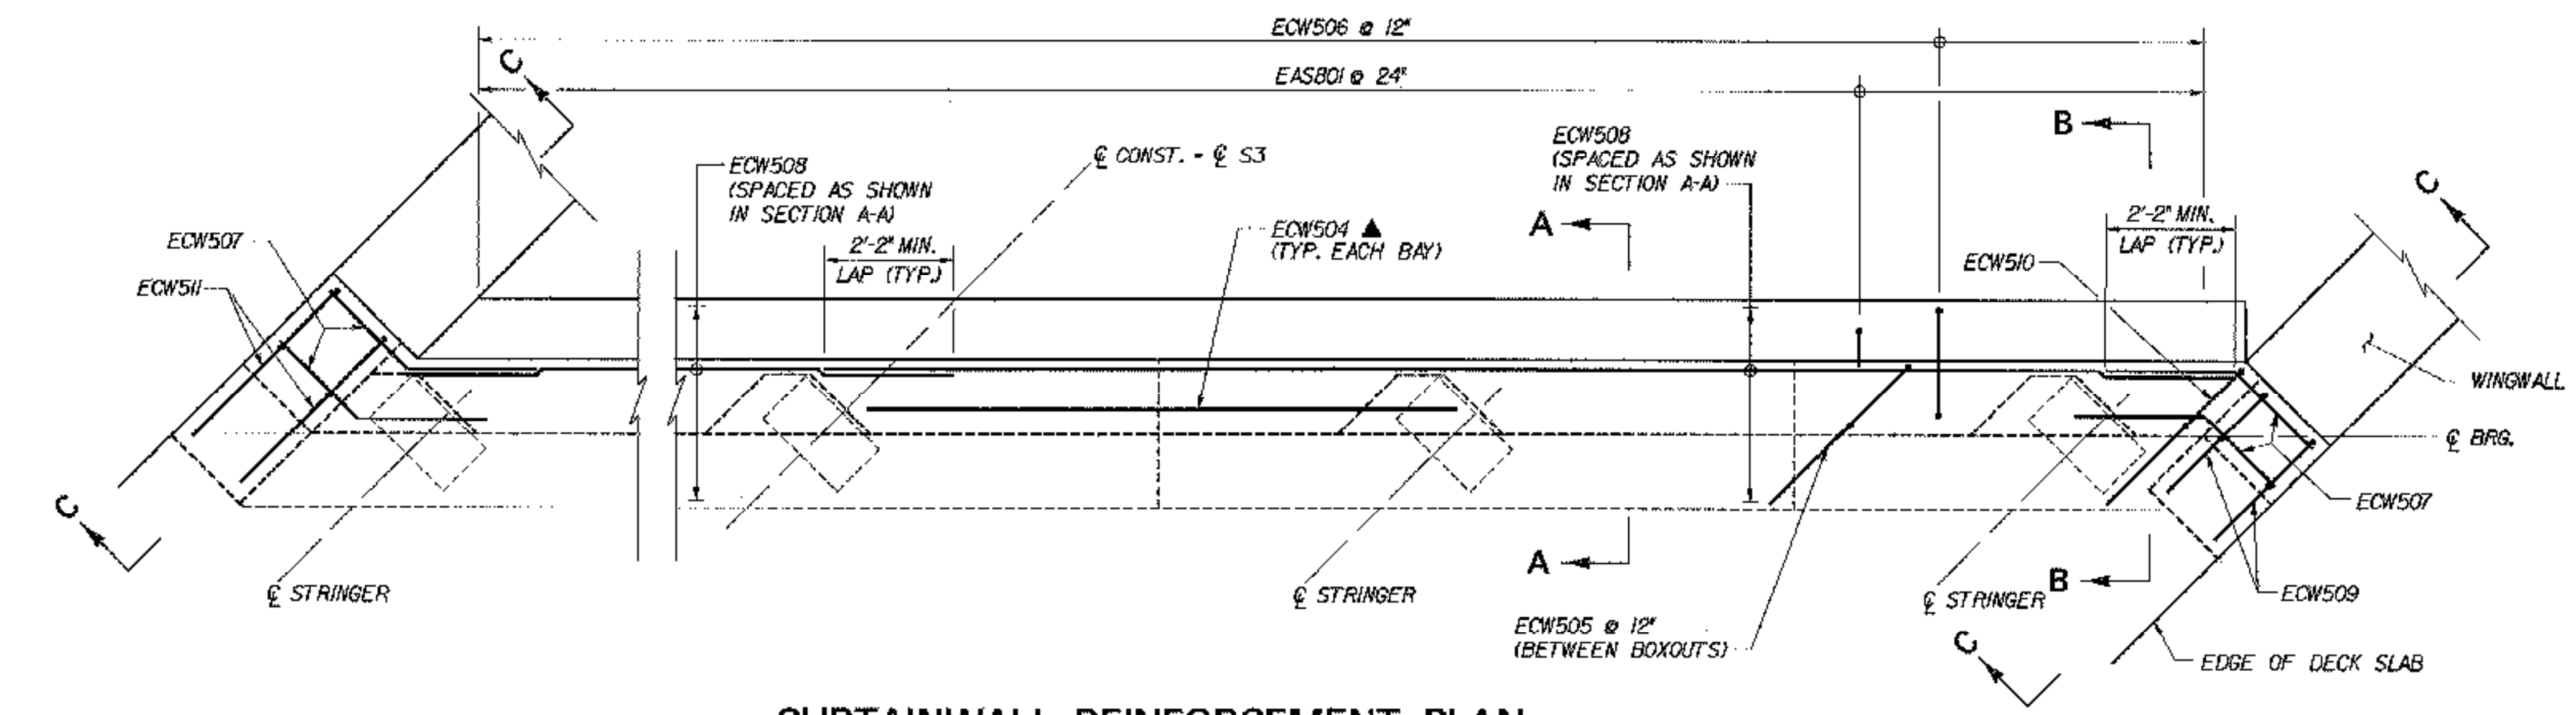


**CURTAINWALL REINFORCEMENT PLAN**  
N.T.S.

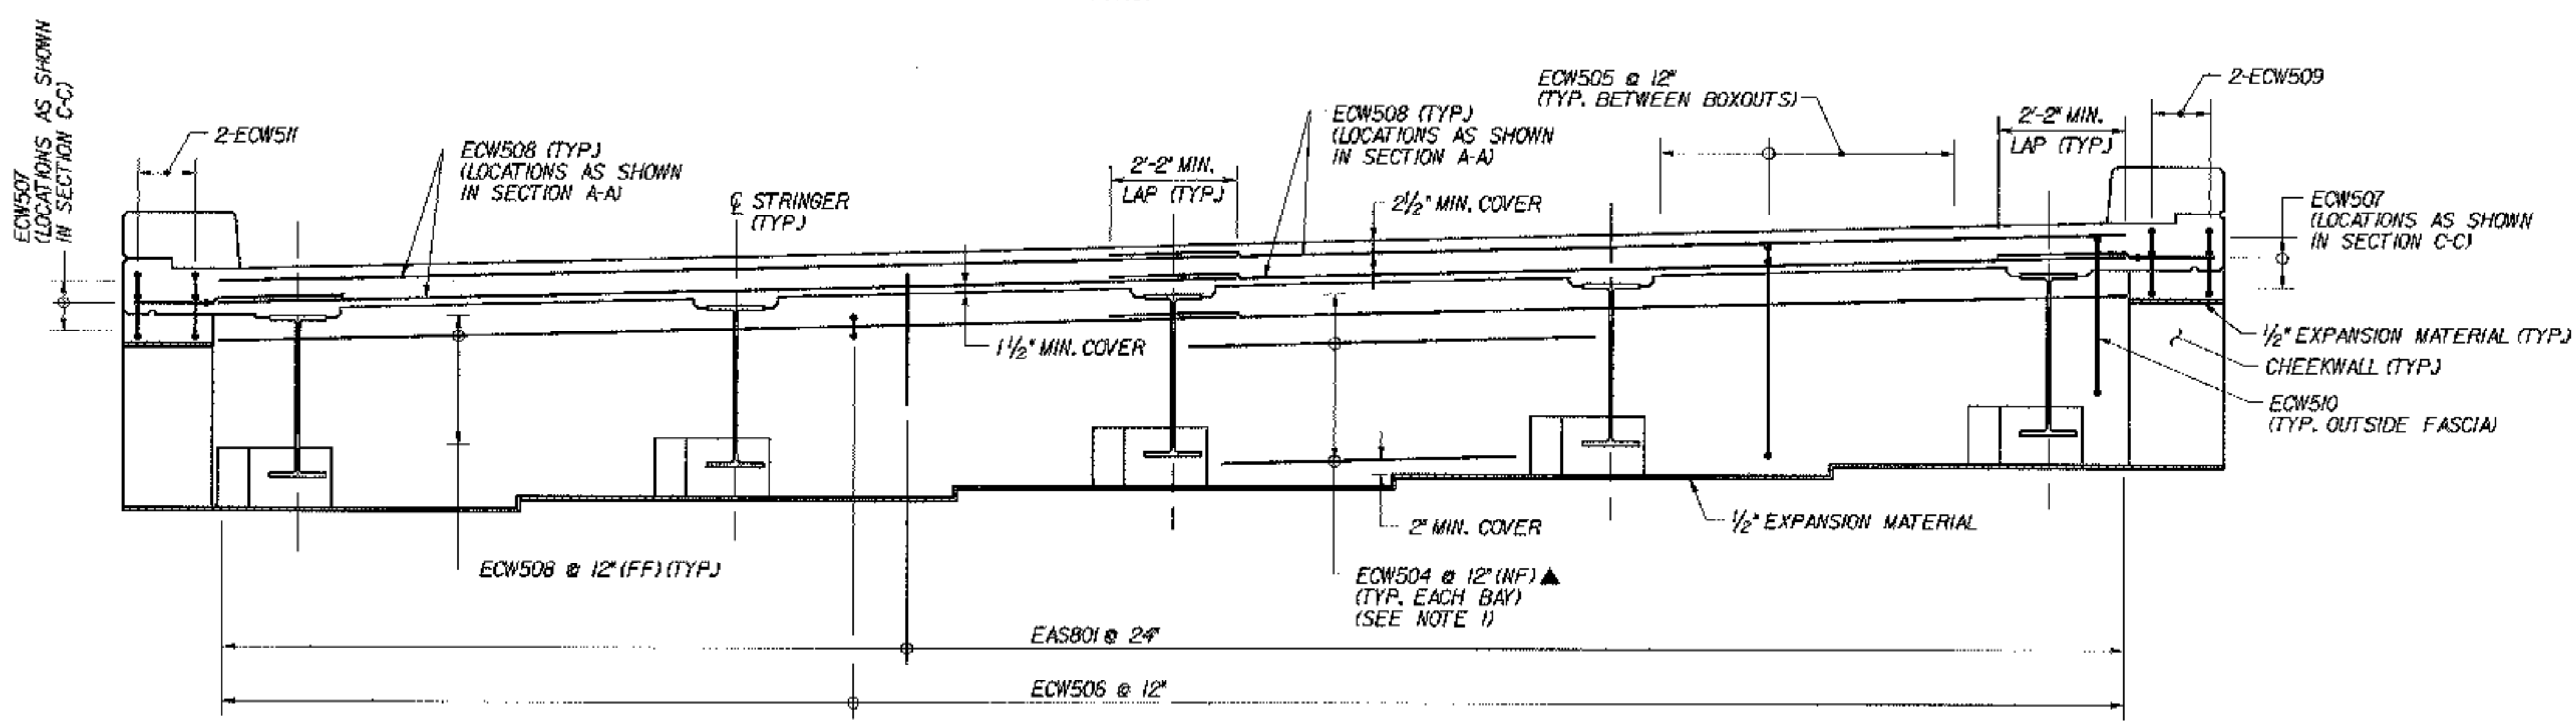


**CURTAINWALL ELEVATION**  
N.T.S.

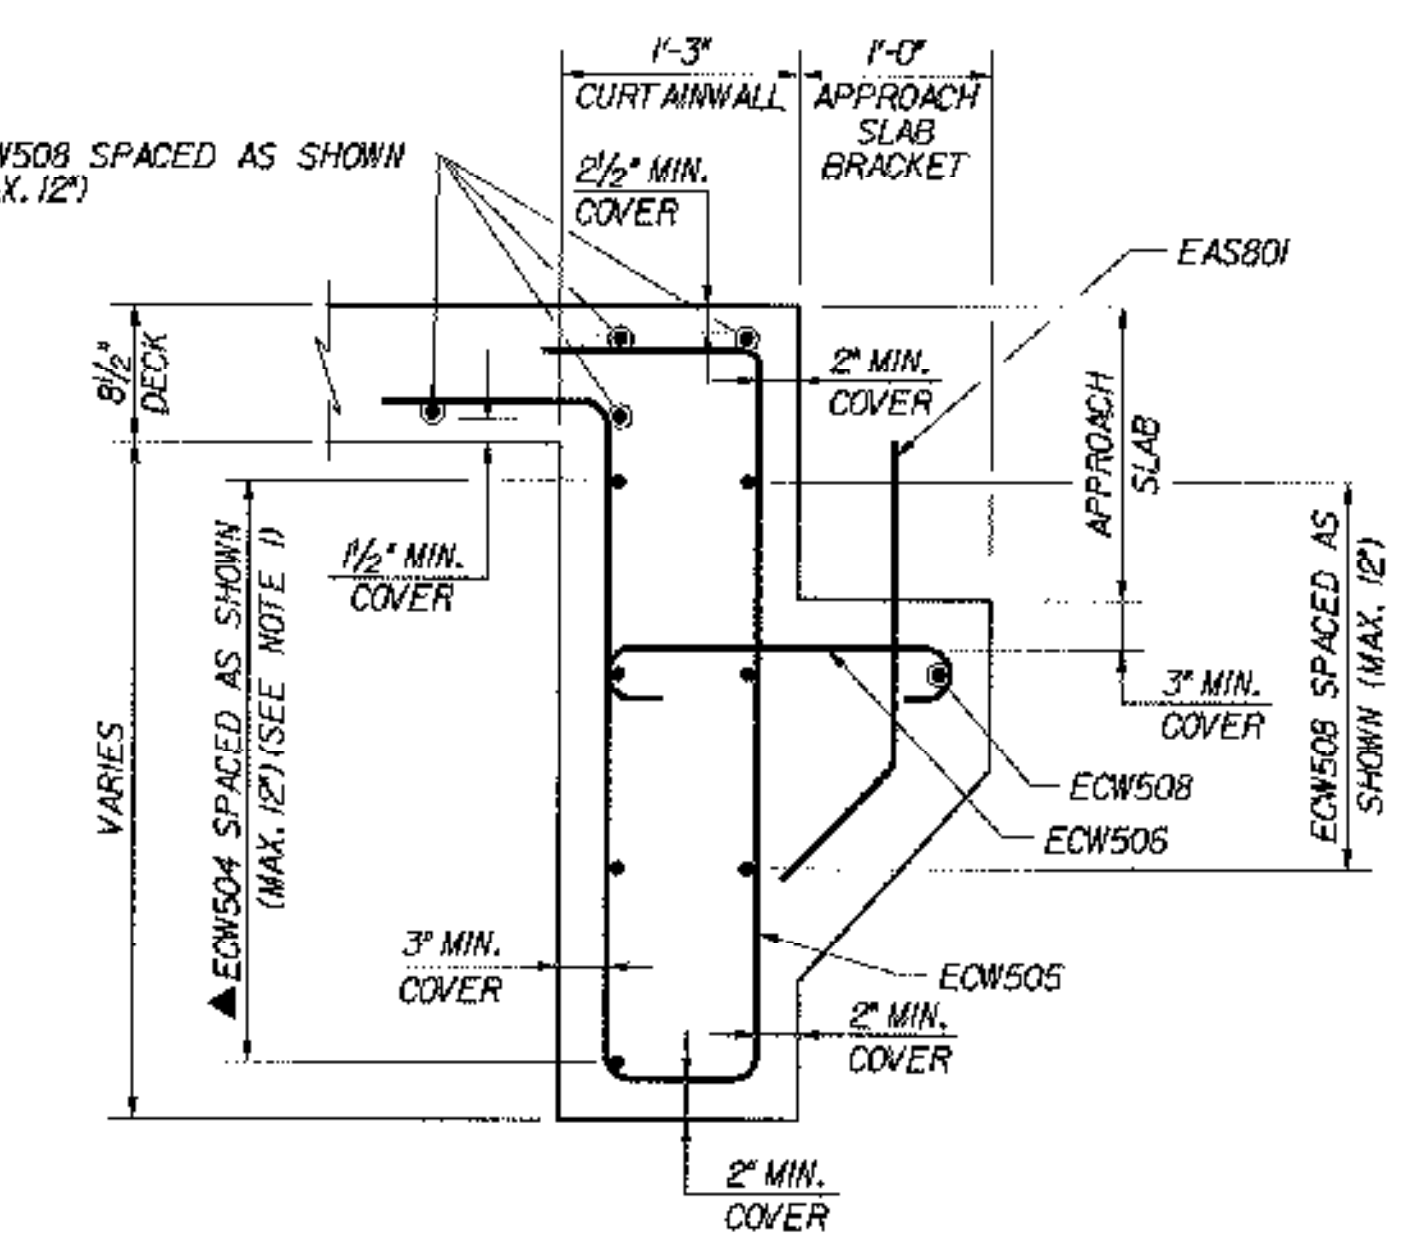

**SECTION A-A**  
N.T.S.


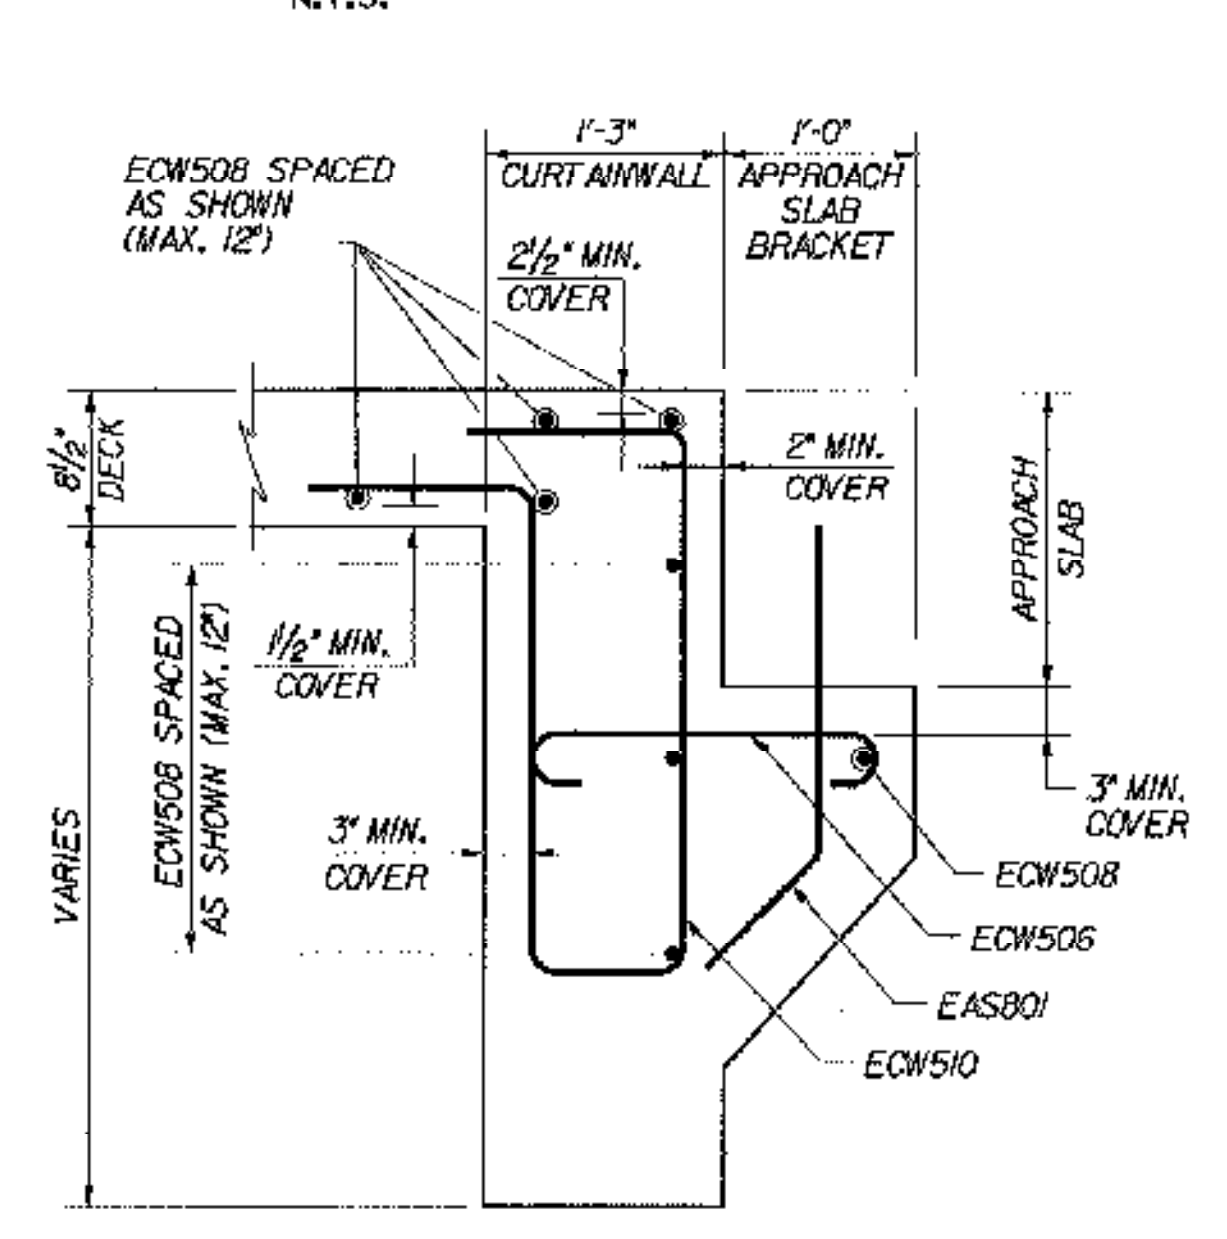


**SECTION B-B**  
N.T.S.

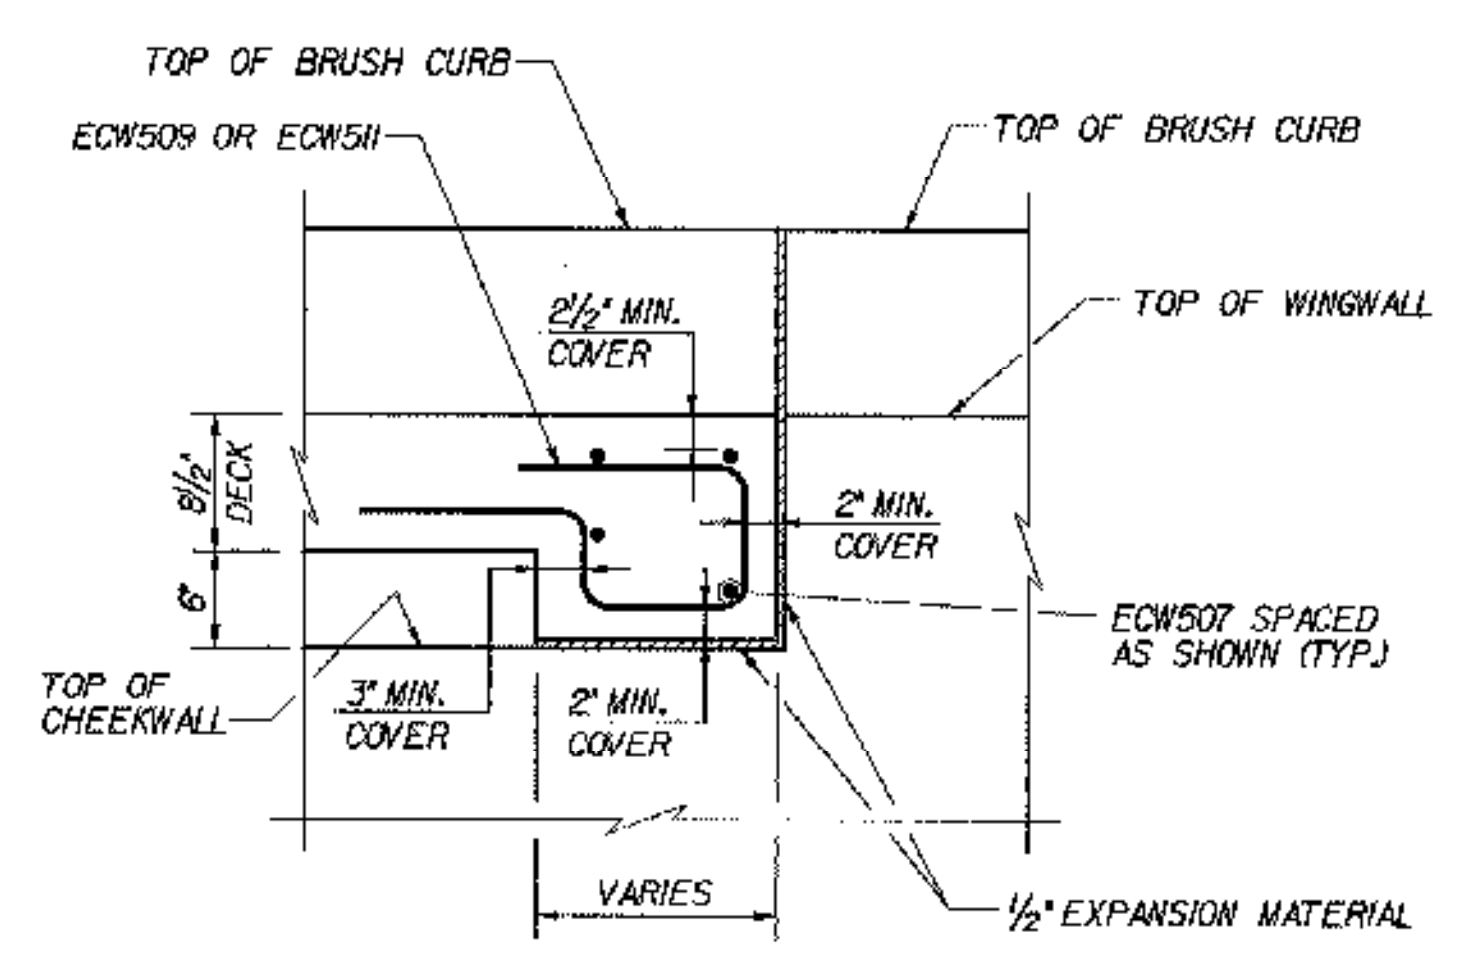

**SECTION C-C**  
N.T.S.

- KEY**
- NF NEAR FACE
  - FF FAR FACE
  - EF EACH FACE
  - ▲ REINFORCEMENT TO BE CUT TO FIT IN THE FIELD

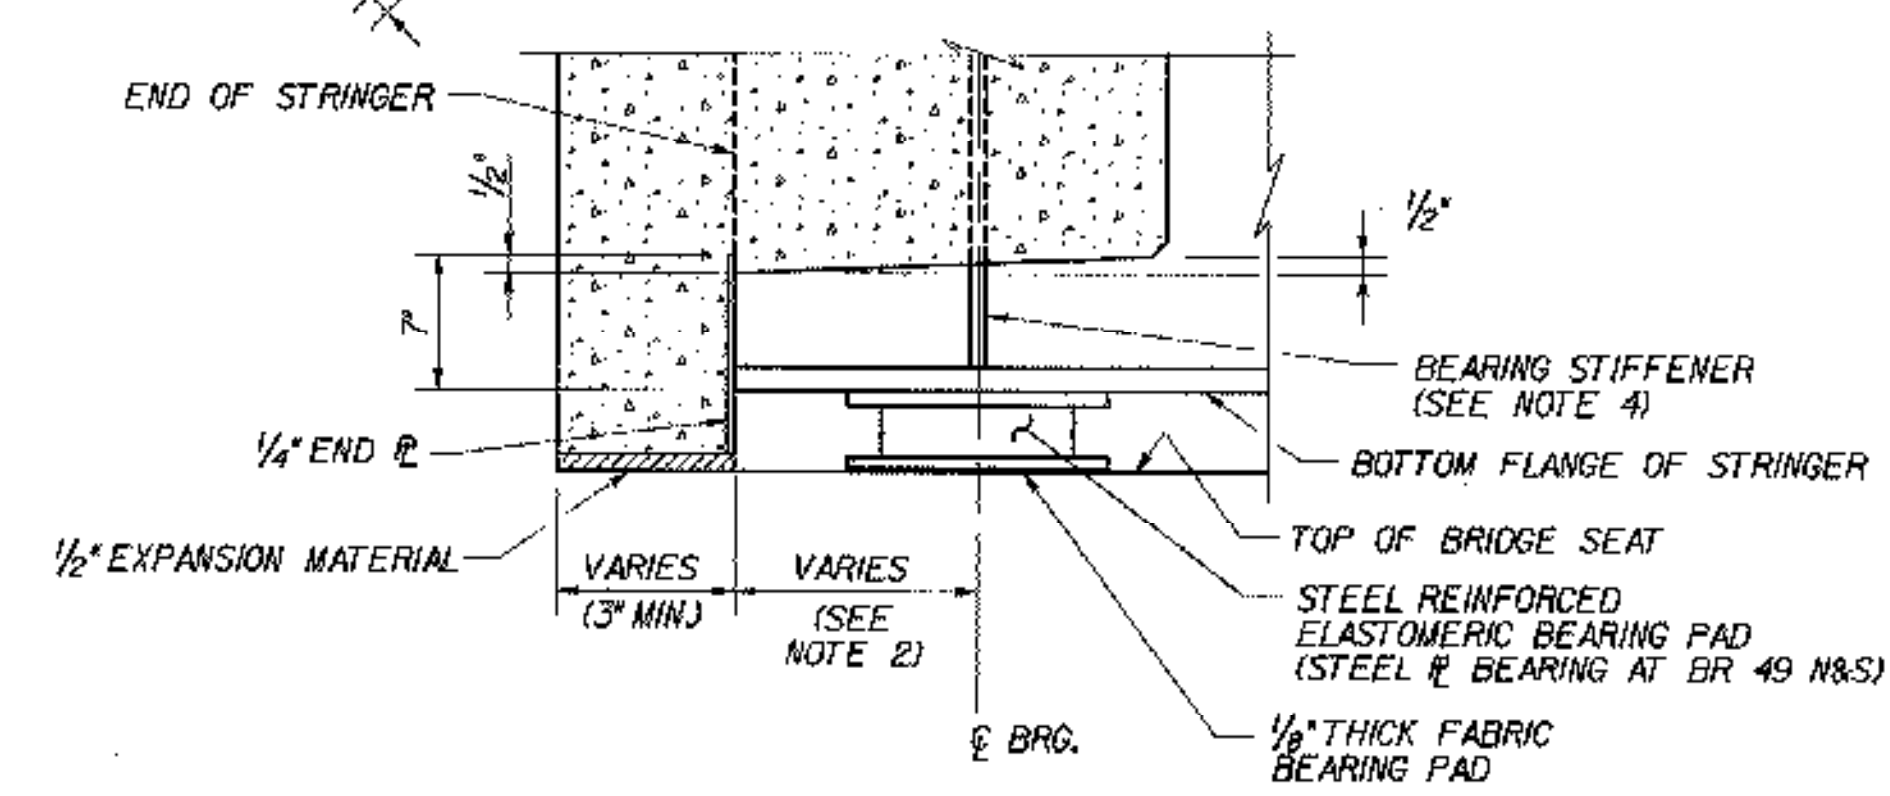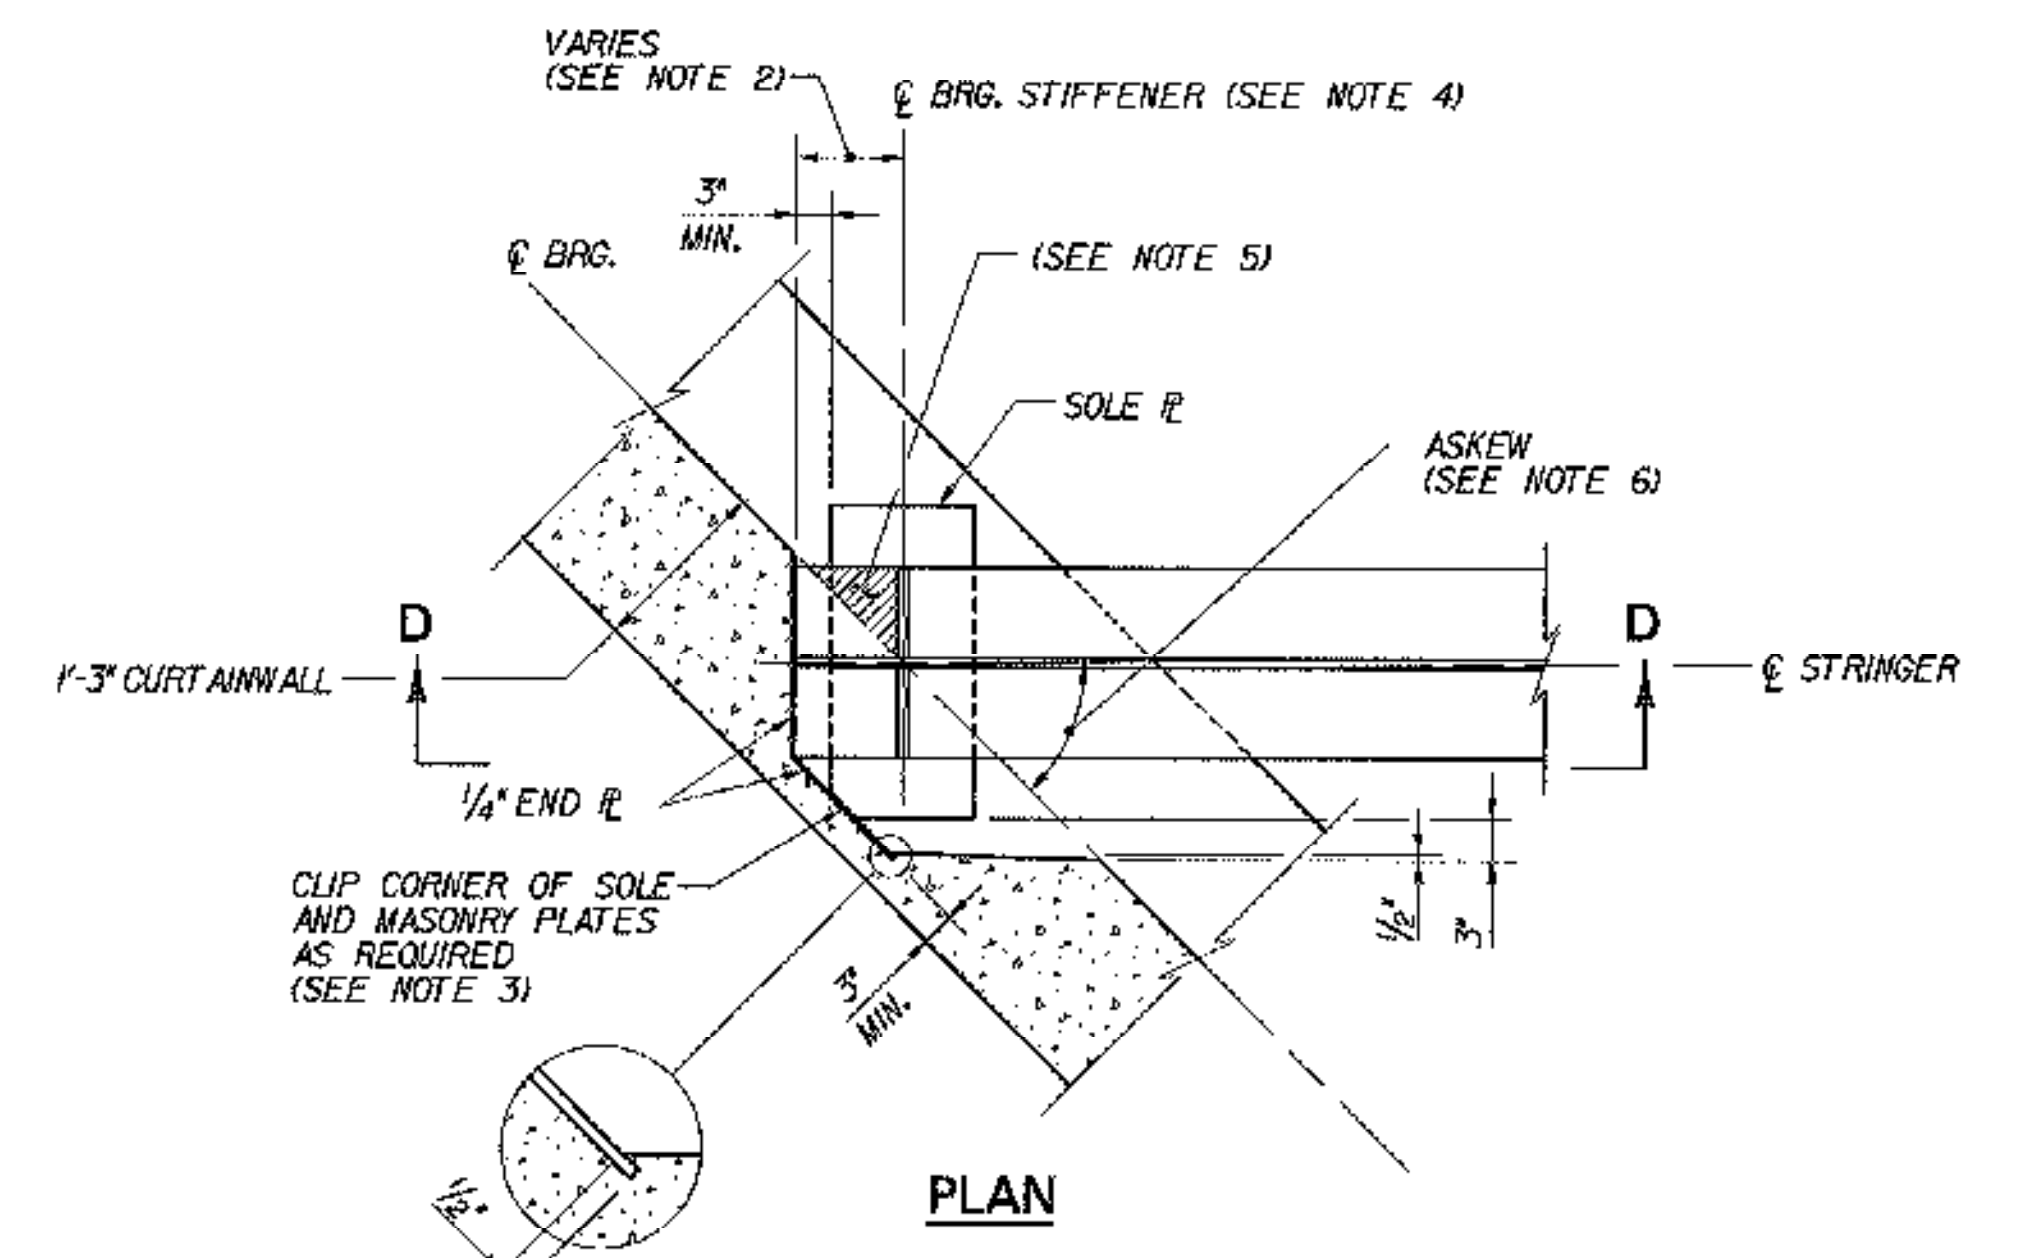


**SECTION D-D**  
**STRINGER BOXOUT DETAILS**  
N.T.S.

**NOTES:**


1. CUT BOTTOM ECW504 BARS TO FIT BETWEEN BOXOUTS.
2. THE DISTANCE FROM BRG. TO END OF STRINGER VARIES AT EACH BRIDGE. FOR THE DIMENSION AT BRIDGES 43, 48, 50 AND 54, SEE THE STRINGER ELEVATION FOR EACH BRIDGE. FOR THE DIMENSION AT BRIDGE 49, SEE TRANSVERSE SECTION (49N&S), BRIDGE SHEET BR49-4.
3. SOLE AND MASONRY PLATES MAY REQUIRE ONE CORNER TO BE CLIPPED TO CLEAR CURTAINWALL. FOR DETAILS AND DIMENSIONS OF THE CLIP, SEE FIXED BEARING DETAILS, BRIDGE SHEET C-2L.
4. BEARING STIFFENER REQUIRED FOR PLATE GIRDER BRIDGES ONLY.
5. WHEN A BEARING STIFFENER IS REQUIRED, THE SHADED AREA (ABOVE THE BOXOUT) SHALL BE CONCRETE POURED CONTINUOUSLY WITH THE CURTAINWALL.
6. THE ASKEW ANGLE VARIES AT EACH SUBSTRUCTURE LOCATION. SEE THE ABUTMENT MASONRY DRAWINGS FOR EACH BRIDGE.

<b>STATE OF VERMONT</b>	
<b>AGENCY OF TRANSPORTATION</b>	
Town Of <b>MIDDLESEX-BOLTON</b>	Bridge No.
Highway No. <b>I-89</b>	Log Sta.
	Surv. Sta.
<b>TYPICAL CURTAINWALL DETAILS</b>	
Designed By <b>P.W. SZUSTAK</b>	Drawn By <b>R.A. BOTZENHART</b>
Checked By <b>J.P. HALSTEAD</b>	Bridge Design Supervisor
Date <b>10/99</b>	Date <b>10/99</b>
PROJECT <b>MIDDLESEX-BOLTON</b>	PROJECT NO. <b>IM-089-2(26)</b>
TVGA CAD Drawing No. <b>curtain</b>	Date <b>10/99</b>
Bridge Sheet No. <b>C-42</b>	Sheet <b>42 of 307</b>

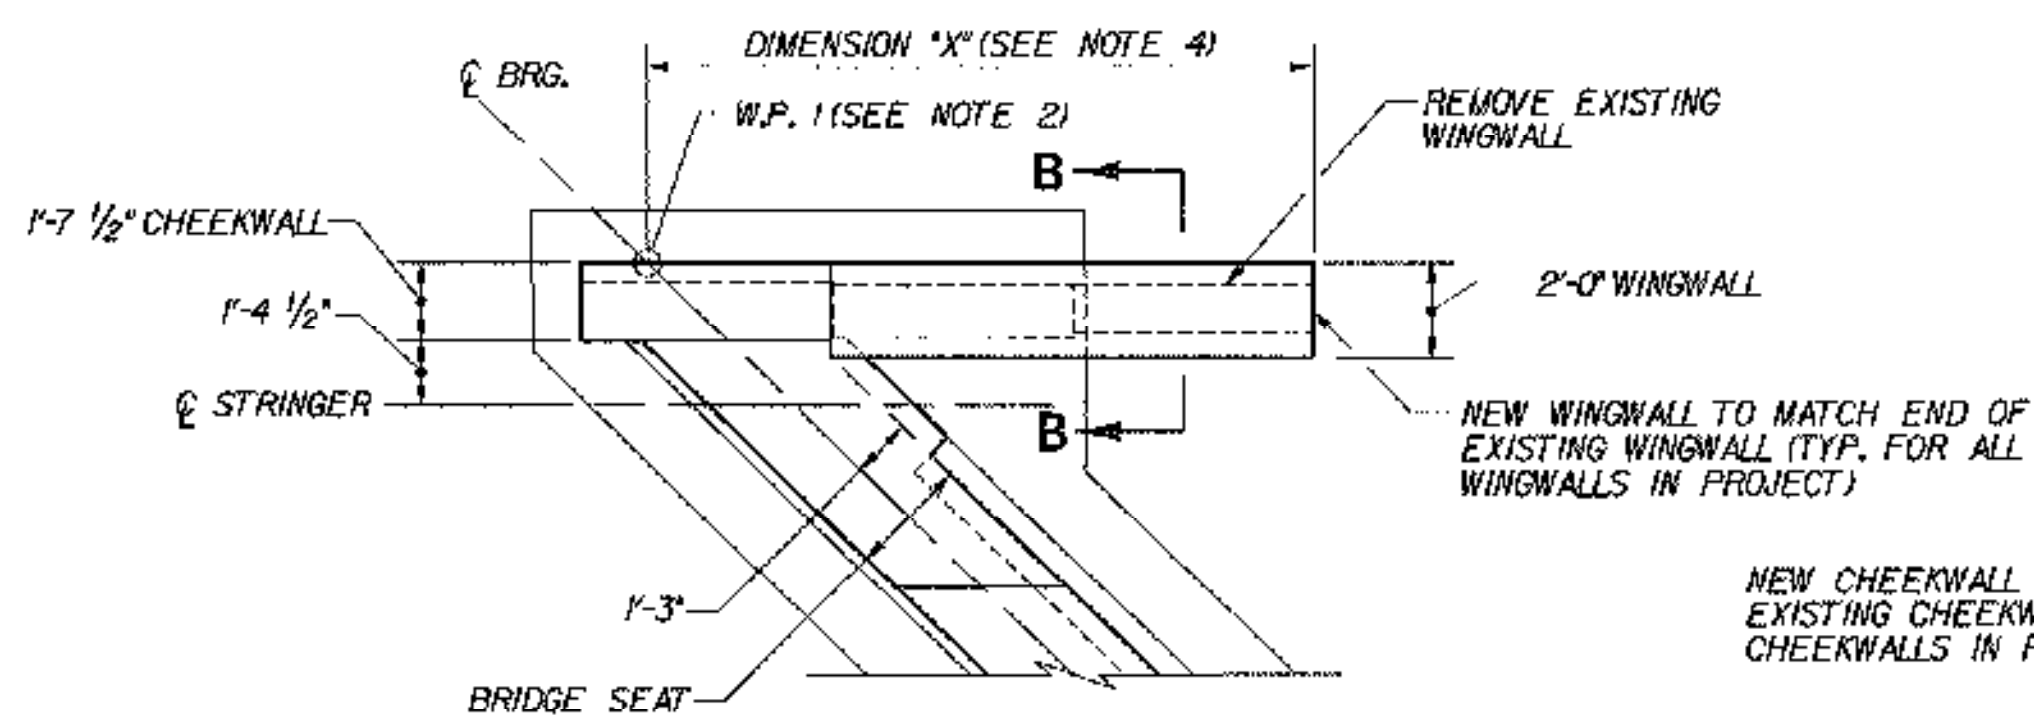


**WINGWALL PLAN AT ACUTE CORNER OF FIXED ABUTMENTS**

SCALE: 1/4"=1'-0"

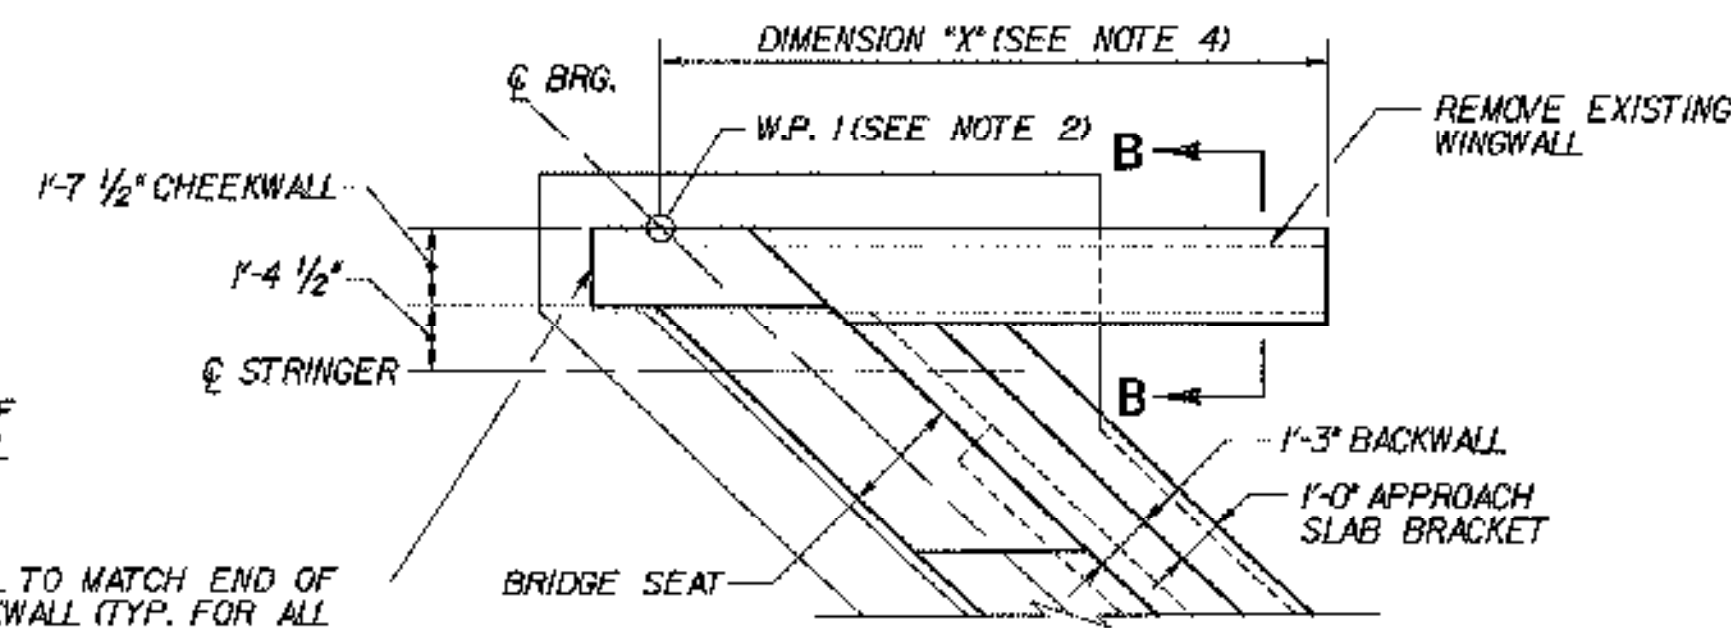


**WINGWALL PLAN AT ACUTE CORNER OF EXPANSION ABUTMENTS**

SCALE: 1/4"=1'-0"

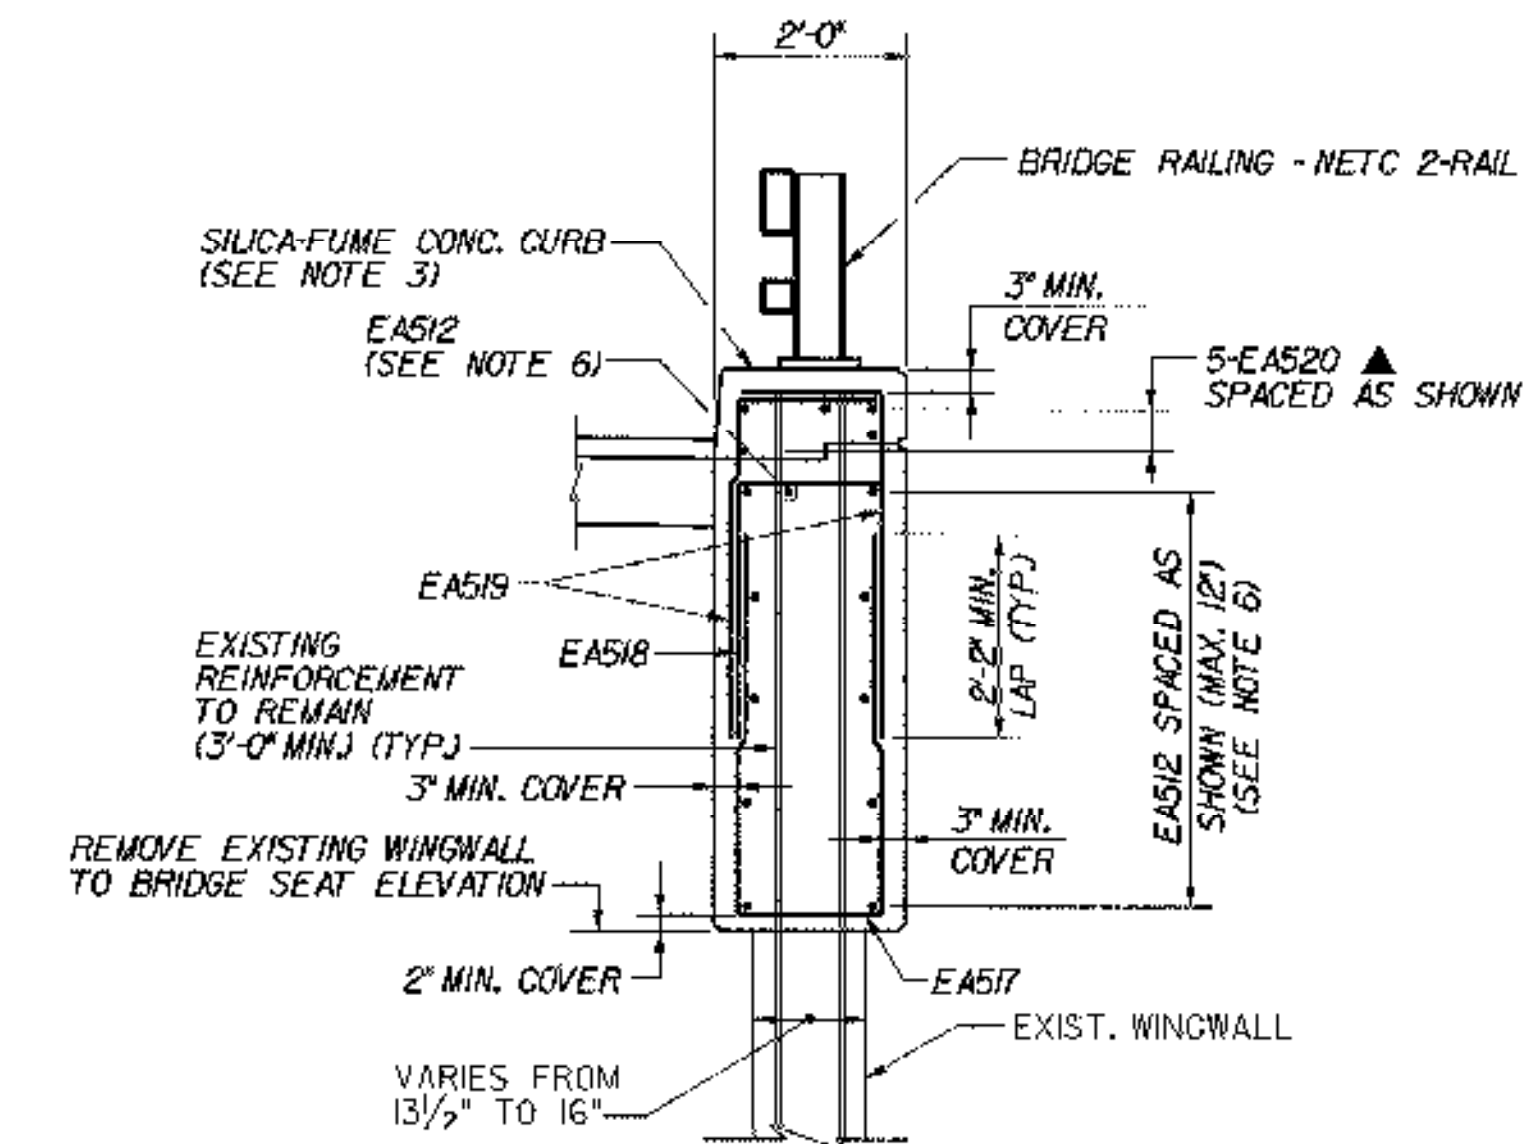


**SECTION B-B (ALL WINGWALLS SIMILAR)**

SCALE: 1/2"=1'-0"

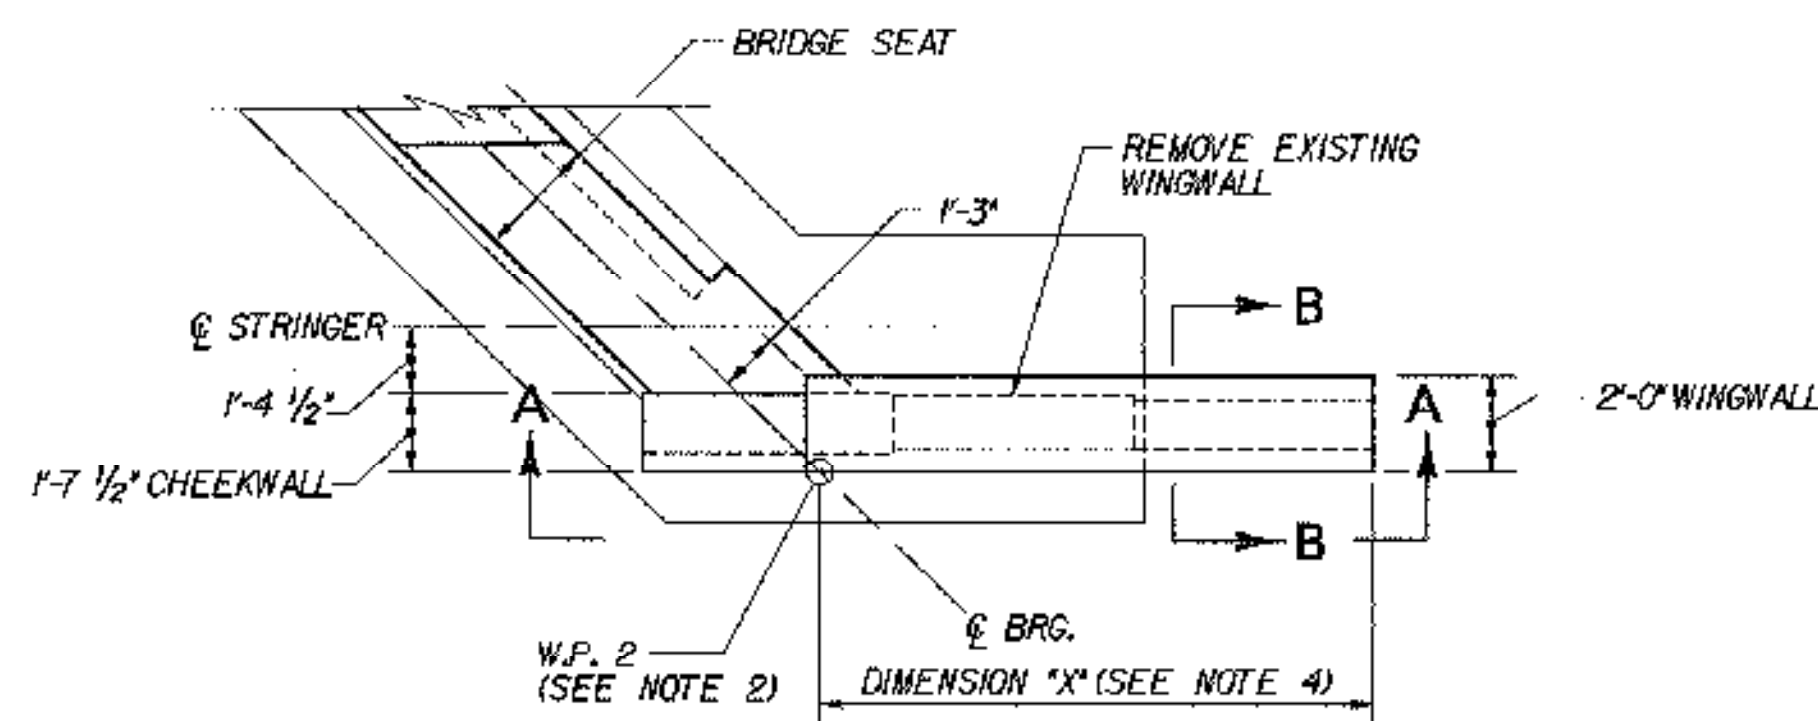


**WINGWALL PLAN AT OBTUSE CORNER OF FIXED ABUTMENTS**

SCALE: 1/4"=1'-0"

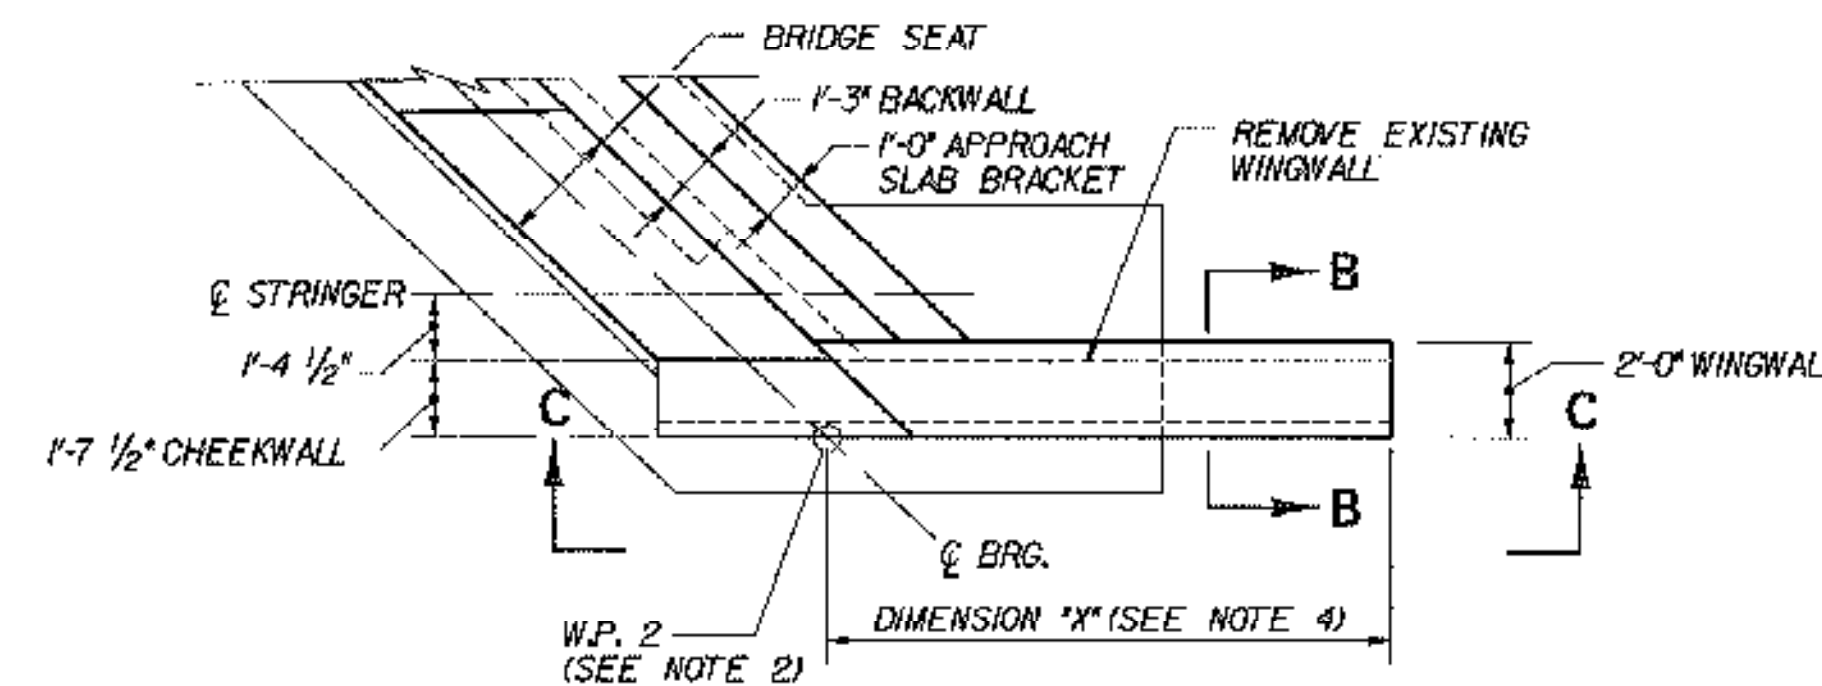


**WINGWALL PLAN AT OBTUSE CORNER OF EXPANSION ABUTMENTS**

SCALE: 1/4"=1'-0"

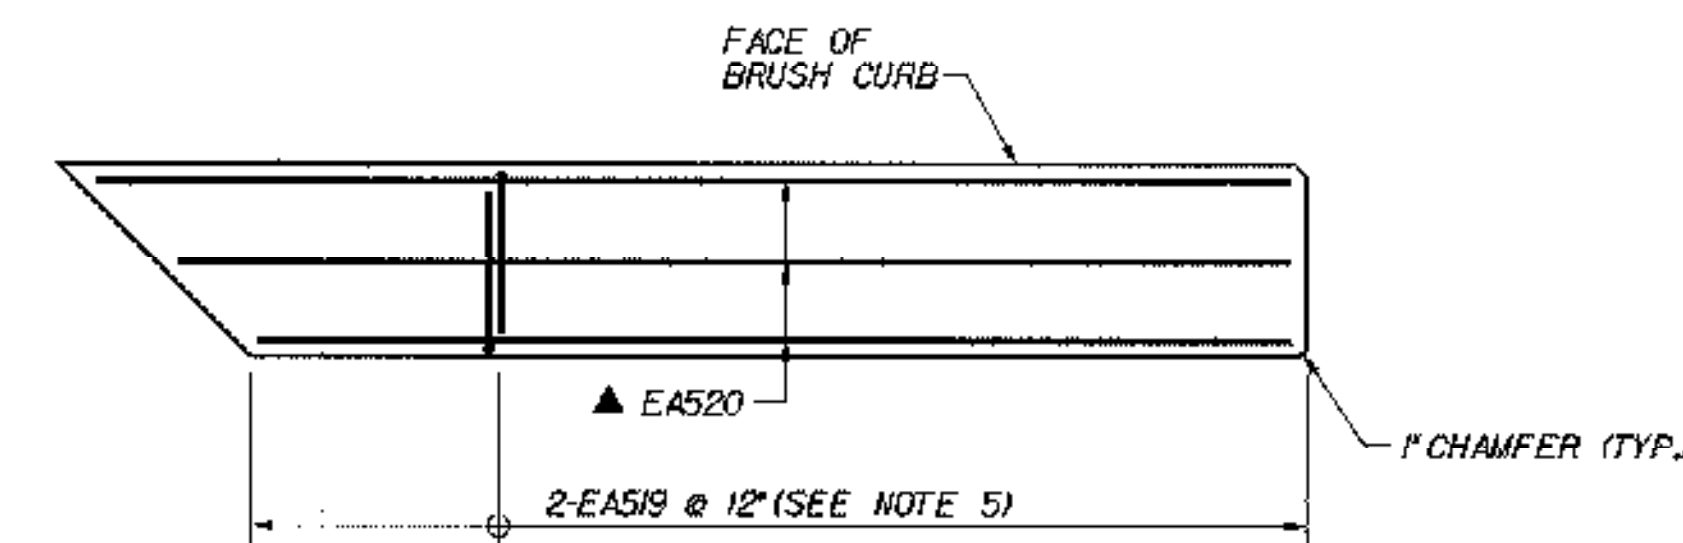


**BRUSH CURB END DETAIL (CURB AT EXPANSION ABUT. SHOWN; FIXED SIMILAR)**

SCALE: 1/2"=1'-0"

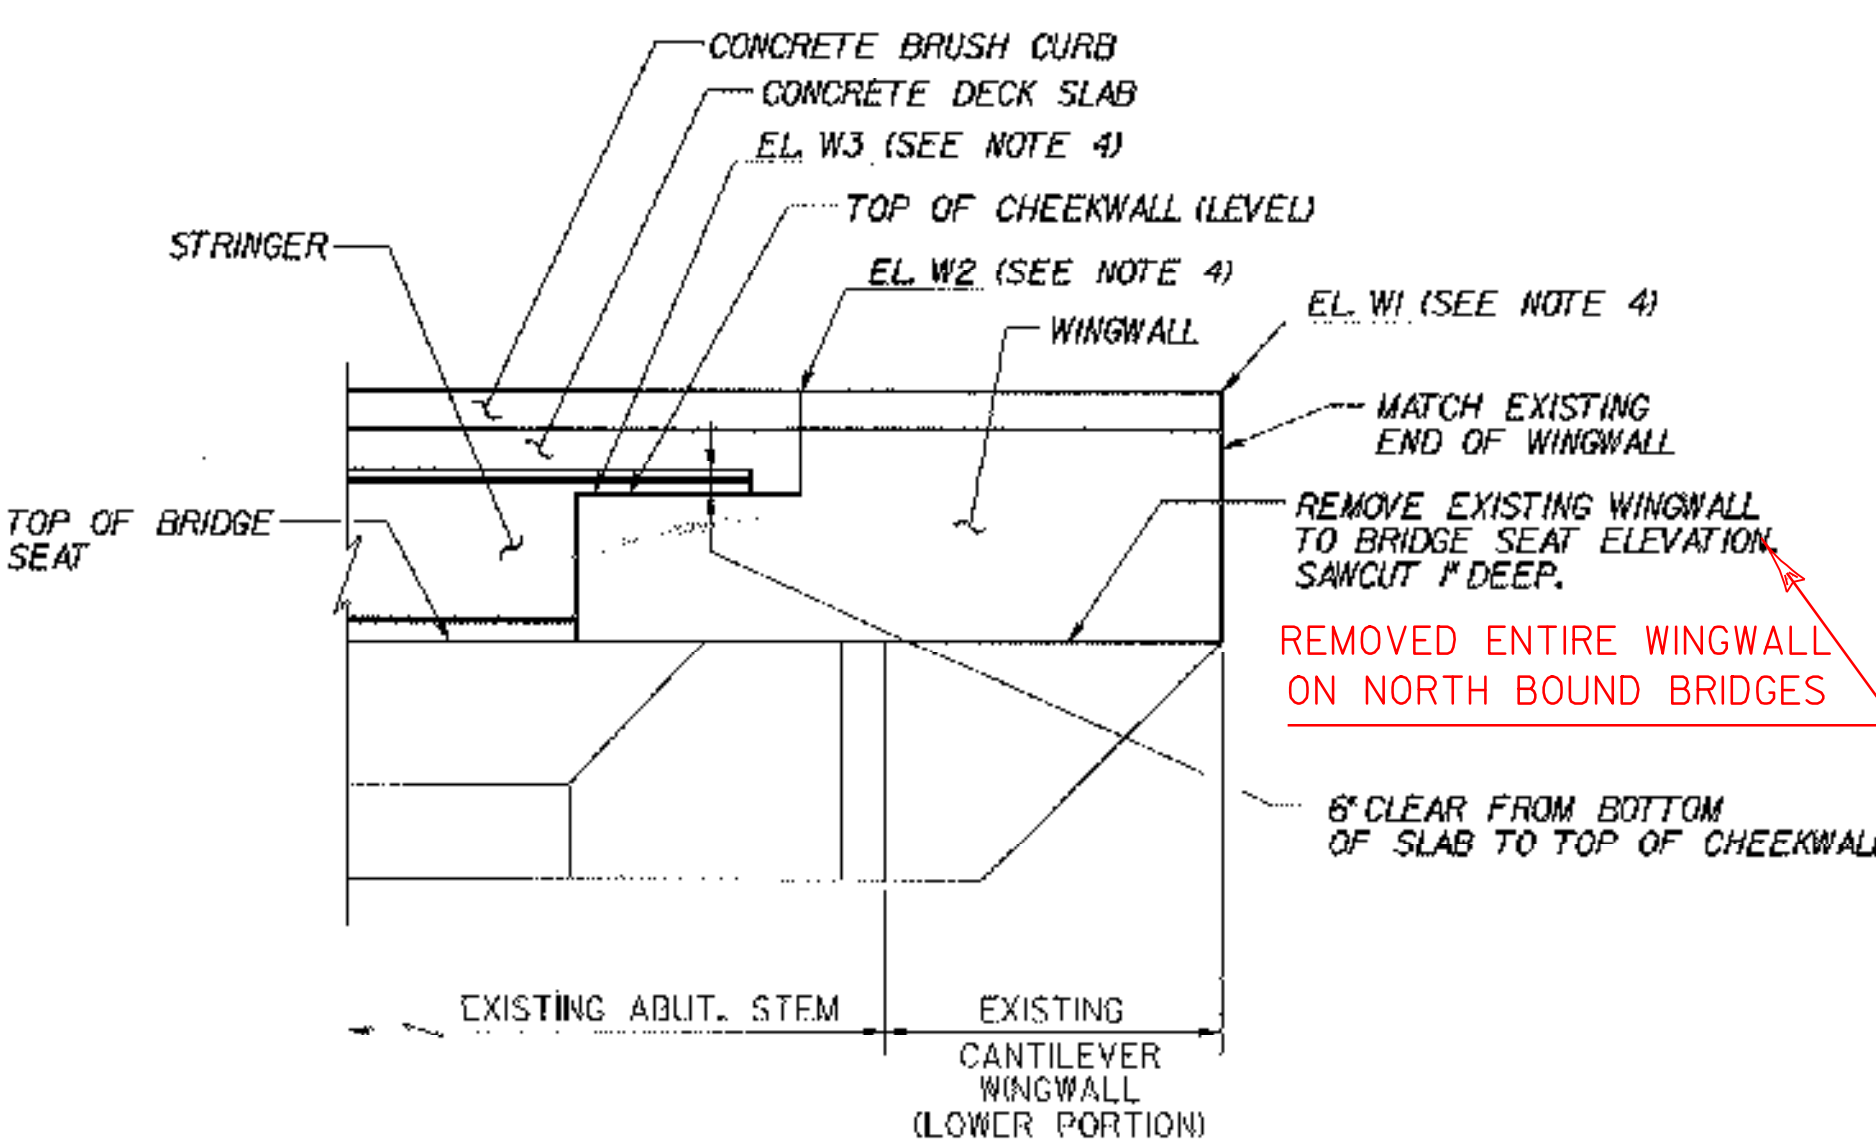

**ELEVATION A-A (FIXED ABUTMENTS) (ACUTE CORNER SIMILAR)**

SCALE: 1/4"=1'-0"

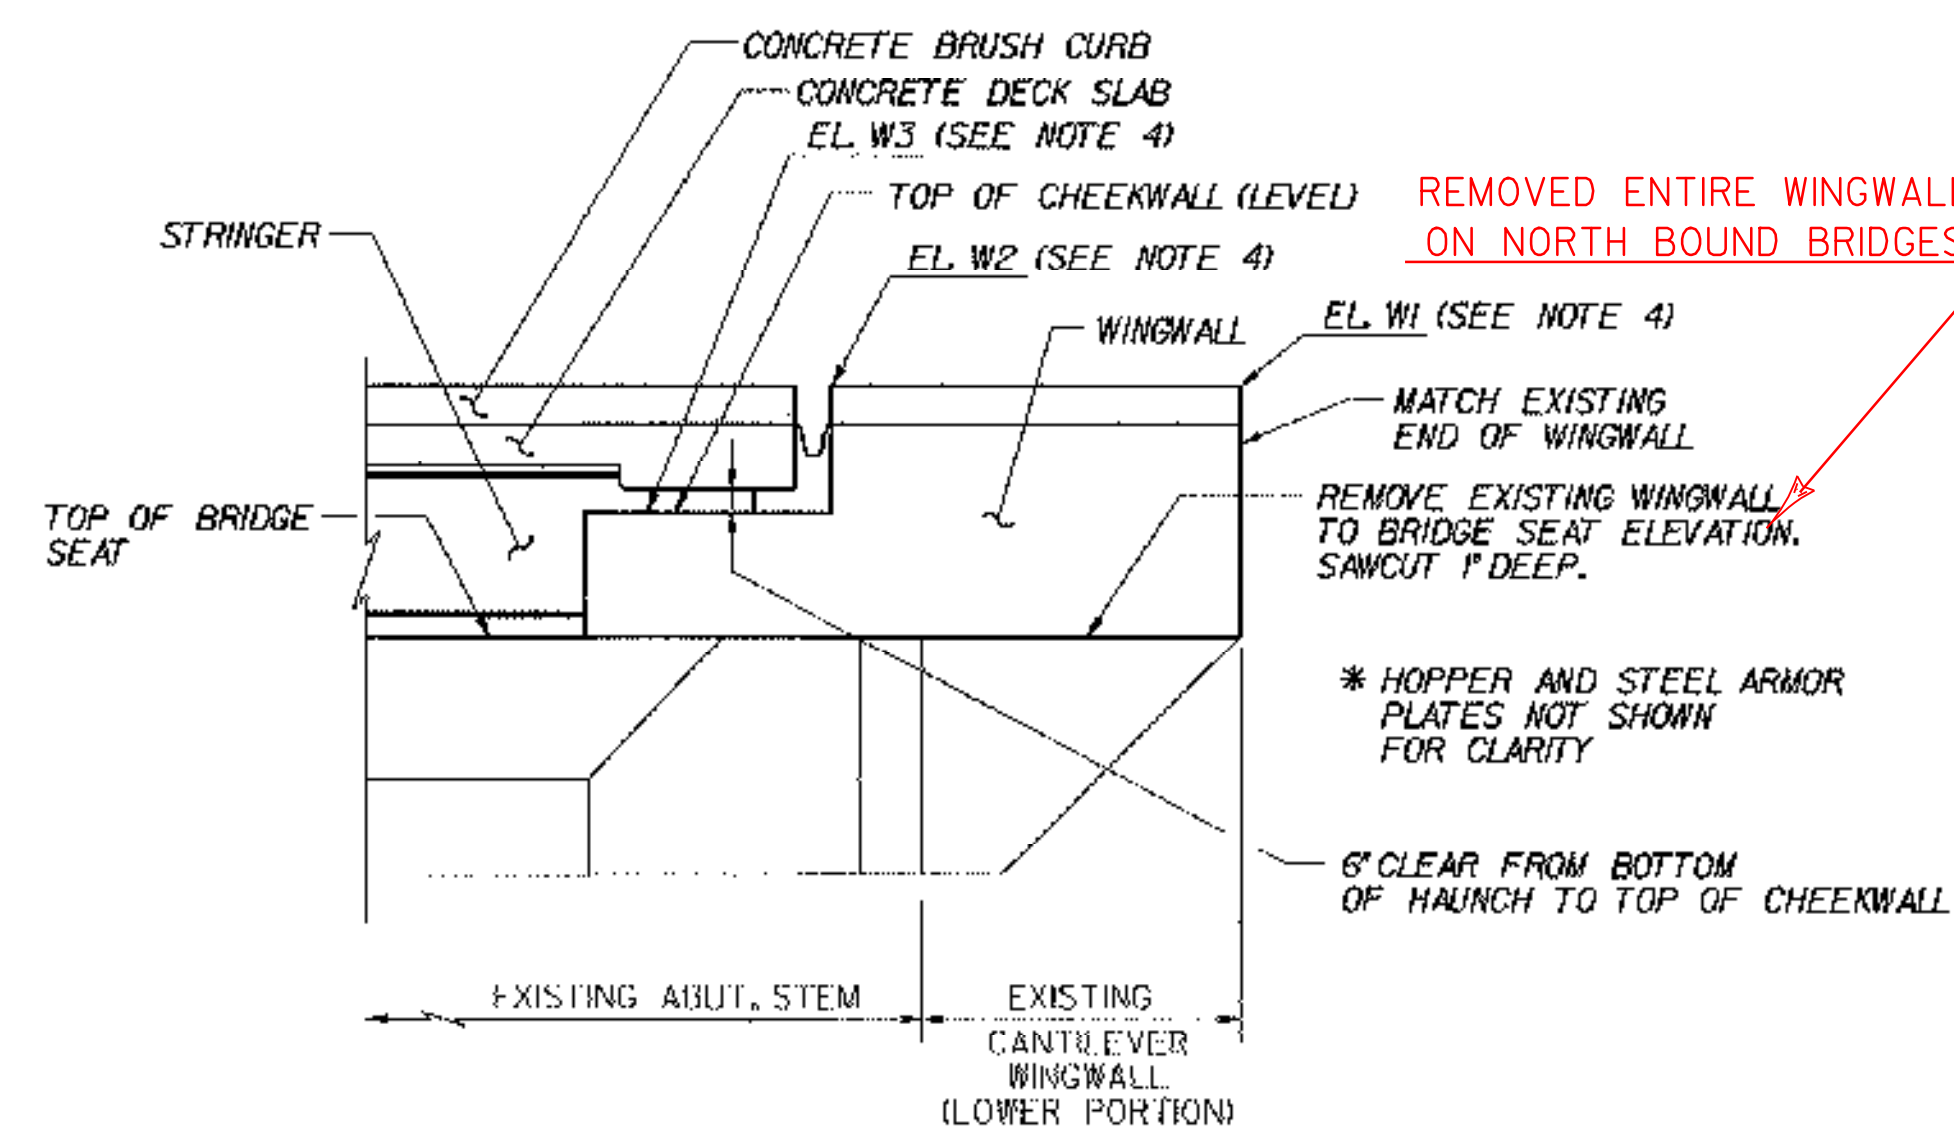

**ELEVATION C-C (EXP. ABUTMENTS) (ACUTE CORNER SIMILAR)**

SCALE: 1/4"=1'-0"

**NOTES:**

- DECK SLAB NOT SHOWN IN WINGWALL PLANS FOR CLARITY.
- WORKING POINT (W.P.) 1 AND 2 LOCATIONS ARE SHOWN ON ABUTMENT MASONRY PLANS FOR EACH BRIDGE. FROM THE WORKING POINTS, THE CONTRACTOR MAY CONSTRUCT WINGWALLS CONCENTRIC TO THE CENTERLINE OF CONSTRUCTION, OR ON AN APPROXIMATE TANGENT LINE, AS APPROVED BY THE ENGINEER.
- FOR DIMENSIONS OF CONCRETE CURB, SEE FASCIA DETAIL ON THE TRANSVERSE SECTION FOR EACH BRIDGE.
- FOR TABLE OF DIMENSION "X" AND WINGWALL AND BRUSH CURB ELEVATIONS, SEE TYPICAL WINGWALL DETAILS (2 OF 2), BRIDGE SHEET C-44.
- ADDITIONAL EAS19 BARS WILL BE REQUIRED BELOW THE BRIDGE RAIL POSTS. FOR DETAILS OF THE REQUIRED STIRRUP SPACING, SEE NETC 2-RAIL STANDARD SHEET BRI-97. FOR LOCATIONS OF THE BRIDGE RAIL POSTS, SEE THE CURB AND RAIL LAYOUT PLANS FOR EACH BRIDGE.
- AT FIXED ABUTMENTS, LONGITUDINAL REINFORCEMENT IN THE WINGWALL MAY BE EITHER EAS12 OR EAS13, AS SHOWN IN TYPICAL FIXED ABUTMENT REINFORCEMENT, BRIDGE SHEET C-41.

**KEY**

- NF NEAR FACE
- FF FAR FACE
- EF EACH FACE
- ▲ REINFORCEMENT TO BE CUT TO FIT IN THE FIELD

**STATE OF VERMONT AGENCY OF TRANSPORTATION**

Town Of	MIDDLESEX-BOLTON	Bridge No.	
Highway No.	I-89	Log Sta.	
		Surv. Sta.	

**TYPICAL WINGWALL DETAILS (1 OF 2)**

Designed By	P.W. SZUSTAK	Drawn By	R.A. BOTZENHART
Checked By	Date	Bridge Design Supervisor	Date
J.P. HALSTEAD	10/99	J.P. HALSTEAD	10/99

PROJECT	MIDDLESEX-BOLTON	PROJECT NO.	IM-089-2(26)
---------	------------------	-------------	--------------

TVGA CAD Drawing No.	wvdetail	Date	10/99
Bridge Sheet No.	C-43	Sheet	43 of 307

BRIDGE 51N AND 51S  
ARE NOT PART OF THIS PROJECT

RAISED FIN. GRADE OF WINGS

WINGWALL AND BRUSH CURB ELEVATIONS																					
BRIDGE	LOCATION	SIDE OF BRIDGE	DIM. "X" (SEE NOTE 2)	ELEVATION			BRIDGE	LOCATION	SIDE OF BRIDGE	DIM. "X" (SEE NOTE 2)	ELEVATION			BRIDGE	LOCATION	SIDE OF BRIDGE	DIM. "X" (SEE NOTE 2)	ELEVATION			
				W1	W2	W3					W1	W2	W3					W1	W2	W3	
43N	ABUT. 1 (FIXED)	LEFT	9' - 11"	544.28	543.98	541.81	49N $\frac{1}{2}$ "	ABUT. 1 (FIXED)	LEFT	14' - 1"	453.94	454.01	451.85	51N	ABUT. 1 (FIXED)	LEFT	9' - 5"	364.05	364.77	362.60	
		RIGHT	13' - 3"	543.30	543.02	540.85			RIGHT	14' - 2"	453.81	453.88	451.72			RIGHT	9' - 5"	365.30	365.44	363.27	
	ABUT. 2 (EXP.)	LEFT	13' - 3"	538.58	538.86	536.22		ABUT. 2 (EXP.)	LEFT	13' - 10"	454.64	454.67	451.74		ABUT. 2 (EXP.)	LEFT	12' - 0"	368.86	368.93	366.22	
		RIGHT	10' - 3"	537.61	537.82	535.34			RIGHT	13' - 10"	454.52	454.45	451.82			RIGHT	14' - 4"	369.47	369.41	366.67	
43S	ABUT. 1 (EXP.)	LEFT	10' - 0"	545.84	545.75	543.08	49S $\frac{5}{8}$ "	ABUT. 1 (FIXED)	LEFT	13' - 11"	453.69	453.77	451.60	51S	ABUT. 1 (FIXED)	LEFT	9' - 5"	364.42	364.56	362.39	
		RIGHT	13' - 1"	545.31	545.12	542.46			RIGHT	13' - 10"	453.82	453.90	451.73			RIGHT	9' - 5"	365.09	365.23	363.06	
	ABUT. 2 (FIXED)	LEFT	13' - 4"	540.66	540.94	538.77		ABUT. 2 (EXP.)	LEFT	13' - 11"	454.51	454.43	451.60		ABUT. 2 (EXP.)	LEFT	10' - 4"	369.02	369.02	366.22	
		RIGHT	10' - 6"	539.67	540.00	537.83			RIGHT	14' - 1"	454.64	454.56	451.73			RIGHT	18' - 7"	369.49	369.41	366.67	
46N	ABUT. 1 (FIXED)	LEFT	14' - 8"	449.44	449.50	447.34	50N $\frac{1}{4}$ "	ABUT. 1 (FIXED)	LEFT	11' - 8"	475.25	475.53	473.38								
		RIGHT	13' - 11"	450.70	450.77	448.61			RIGHT	13' - 10"	476.90	477.14	474.97								
	ABUT. 2 (EXP.)	LEFT	18' - 8"	451.23	451.13	448.46		ABUT. 2 (EXP.)	LEFT	13' - 6"	481.40	481.17	478.50								
		RIGHT	19' - 9"	452.47	452.38	449.62			RIGHT	20' - 6"	483.35	482.72	479.95								
46S	ABUT. 1 (EXP.)	LEFT	13' - 4"	449.66	449.71	447.05	50S $\frac{1}{2}$ "	ABUT. 1 (EXP.)	LEFT	11' - 8"	466.39	466.75	464.18								
		RIGHT	12' - 6"	450.82	450.86	448.24			RIGHT	13' - 10"	466.29	466.69	465.91								
	ABUT. 2 (FIXED)	LEFT	18' - 9"	451.37	451.28	449.11		ABUT. 2 (FIXED)	LEFT	13' - 3"	473.80	473.52	471.35								
		RIGHT	19' - 9"	452.63	452.54	450.37			RIGHT	11' - 3"	475.54	475.29	473.12								

RAISED FIN. GRADE OF WINGS  
 $\frac{1}{4}$ "

RAISED FIN. GRADE OF WINGS  
 $\frac{3}{8}$ "

RAISED FIN. GRADE OF WINGS  
 $\frac{5}{4}$ "

RAISED FIN. GRADE OF WINGS  
 $\frac{3}{4}$ "

RAISED FIN. GRADE OF WINGS

**NOTES:**

- FOR LOCATIONS OF W1, W2, W3, AND DIMENSION "X", SEE TYPICAL WINGWALL DETAILS (1 OF 2), BRIDGE SHEET C-43.
- DIMENSION "X" IS APPROXIMATE, BASED ON FIELD SURVEY INFORMATION. NEW WINGWALL TO MATCH END OF EXISTING WINGWALL.
- REFERENCE TO "LEFT" AND "RIGHT" IS BASED ON THE DIRECTION OF STATIONING, NOT THE DIRECTION OF TRAFFIC.

**STATE OF VERMONT  
AGENCY OF TRANSPORTATION**


Town Of	MIDDLESEX-BOLTON	Bridge No.	
Highway No.	I-89	Log Sta.	
		Surv. Sta.	

**TYPICAL WINGWALL DETAILS (2 OF 2)**

Designed By	P.W. SZUSTAK	Drawn By	R.A. BOTZENHART
Checked By	J.P. HALSTEAD	Bridge Design Supervisor	J.P. HALSTEAD
Date	10/99	Date	10/99

PROJECT	MIDDLESEX-BOLTON	PROJECT NO.	IM-089-2(26)
TVGA CAD Drawing No.	wwdetail	Date	10/99


Bridge Sheet No.	C-44	Sheet	44 of 307
------------------	------	-------	-----------

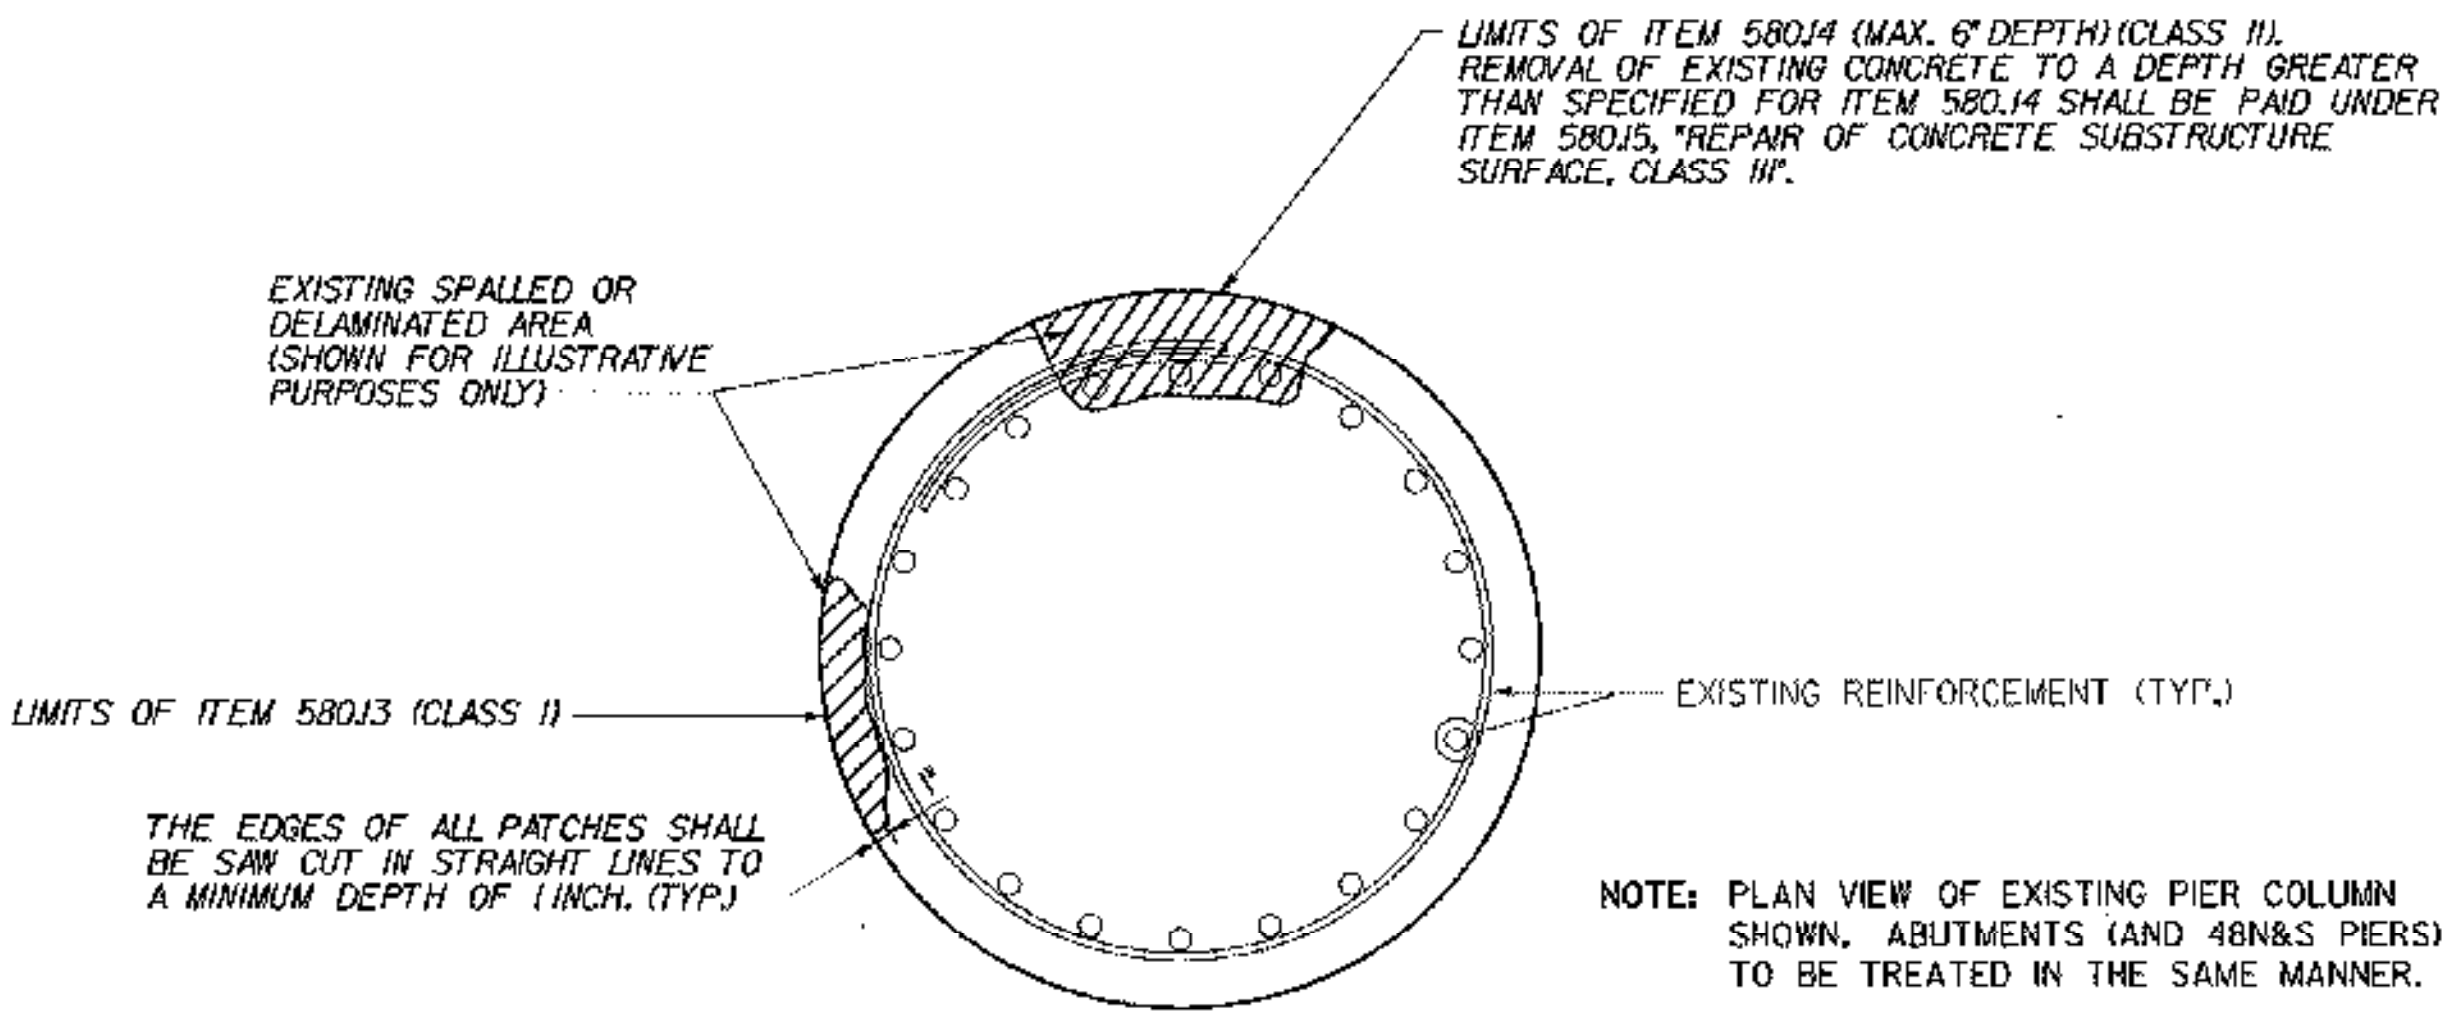

**CONCRETE REPAIR DETAIL**  
SCALE: 1" = 1'-0"

**SUBSTRUCTURE REPAIR NOTES:**

- COLUMNS, ABUTMENTS, AND 48N&S PIERS SHALL BE REPAIRED USING THE FOLLOWING ITEMS:
  - 580.13 REPAIR OF CONCRETE SUBSTRUCTURE SURFACE, CLASS I
  - 580.14 REPAIR OF CONCRETE SUBSTRUCTURE SURFACE, CLASS II
  - 580.15 REPAIR OF CONCRETE SUBSTRUCTURE SURFACE, CLASS III
- THIS WORK SHALL INCLUDE REMOVAL AND DISPOSAL OF UNSOUND AND DELAMINATED CONCRETE FROM ALL ABUTMENTS AND PIERS AS DIRECTED BY THE ENGINEER. THE PREPARED SURFACES SHALL BE THOROUGHLY BLASTED TO REMOVE ALL LOOSE MATERIAL AND ANY CONTAMINANTS OR EFFLORESCENCE. THE REINFORCING STEEL (IF EXPOSED) SHALL BE BLASTED. THE MATERIAL USED TO FILL A PATCH SHALL BE PLACED AND FINISHED OR FORMED SO THAT THE FINAL SURFACE WILL HAVE THE SAME SCORE MARKS AND EXTERIOR FACE APPEARANCE AS THE ORIGINAL SURFACES BEING REPAIRED. THE SURFACE SHALL BE THOROUGHLY WETTED PRIOR TO PLACEMENT OF PATCHING MATERIAL OR NEW CONCRETE. IMMEDIATELY PRIOR TO PLACEMENT, THE SURFACE SHALL BE COATED WITH NEAT CEMENT PASTE, MIXED TO THE CONSISTENCY OF THICK LATEX PAINT (THOROUGHLY BRUSHED INTO THE SURFACE). WHEN "OVERHEAD AND VERTICAL CONCRETE REPAIR MATERIAL" CONFORMING WITH SUPPLEMENTAL SPECIFICATION 780.02 IS USED, THE BONDING AGENT (IF ANY REQUIRED) AND ITS APPLICATION PROCEDURE SHALL COMPLY WITH THE REQUIREMENTS OF THE PATCHING MATERIAL MANUFACTURER. PAYMENT FOR BONDING AGENT SHALL BE SUBSIDIARY TO ITEM 580.13, 580.14, OR 580.15.
- THE LIMITS FOR REMOVAL OF CONCRETE UNDER ITEM 580.13, "REPAIR OF CONCRETE SUBSTRUCTURE SURFACE, CLASS I" SHALL BE FROM THE EXISTING CONCRETE SURFACE TO A MAXIMUM DEPTH OF THE OUTSIDE FACE OF THE REINFORCING STEEL. ALL WORK AND MATERIALS NECESSARY FOR PREPARING A PATCH AND FILLING IT SHALL BE INCLUDED IN THE BID PRICE FOR ITEM 580.13. THE FILLING MATERIAL SHALL BE "OVERHEAD AND VERTICAL CONCRETE REPAIR MATERIAL" CONFORMING WITH SUPPLEMENTAL SPECIFICATION 780.02. THE EDGES OF ALL PATCHES SHALL BE SAW CUT IN STRAIGHT LINES TO A MINIMUM DEPTH OF 1 INCH. IF MORE THAN 1/4 OF THE REBAR IS EXPOSED OR THE BOND BETWEEN THE REBAR AND THE CONCRETE IS BROKEN, THEN PROCEED TO ITEM 580.14.
- FOR CONCRETE NOT TO BE WRAPPED, THE LIMITS FOR REMOVAL OF CONCRETE UNDER ITEM 580.14, "REPAIR OF CONCRETE SUBSTRUCTURE SURFACE, CLASS II" SHALL BE FROM THE EXISTING CONCRETE SURFACE TO A MINIMUM DEPTH OF 3/4" ± 1/4" INSIDE THE INSIDE FACE OF REINFORCING STEEL AND TO A MAXIMUM DEPTH OF 6" FROM THE EXISTING CONCRETE SURFACE. ALL WORK AND MATERIALS NECESSARY FOR PREPARING A PATCH AND FILLING SHALL BE INCLUDED IN THE BID PRICE FOR ITEM 580.14. THE FILLING MATERIAL MAY BE EITHER "OVERHEAD AND VERTICAL CONCRETE REPAIR MATERIAL" CONFORMING WITH SUPPLEMENTAL SPECIFICATION 780.02, "CONCRETE CLASS AA" OR AN ACCEPTABLE PNEUMATICALLY APPLIED CONCRETE (SEE SPECIAL PROVISIONS). THE EDGES OF ALL PATCHES SHALL BE SAW CUT IN STRAIGHT LINES TO A MINIMUM DEPTH OF 1 INCH.
- FOR CONCRETE TO BE WRAPPED, THE LIMITS FOR REMOVAL OF CONCRETE UNDER ITEM 580.14, "REPAIR OF CONCRETE SUBSTRUCTURE SURFACE, CLASS II" SHALL BE FROM THE EXISTING CONCRETE SURFACE TO A MINIMUM DEPTH OF THE OUTSIDE FACE OF THE REINFORCING STEEL AND TO A MAXIMUM DEPTH OF 6" FROM THE EXISTING CONCRETE SURFACE. MINIMUM DEPTH OF 3/4" INSIDE THE INSIDE FACE OF REINFORCING STEEL IS NOT REQUIRED, AS LONG AS ALL UNSOUND CONCRETE IS REMOVED. ALL WORK AND MATERIALS NECESSARY FOR PREPARING A PATCH AND FILLING SHALL BE INCLUDED IN THE BID PRICE FOR ITEM 580.14. THE FILLING MATERIAL MAY BE EITHER "OVERHEAD AND VERTICAL CONCRETE REPAIR MATERIAL" CONFORMING WITH SUPPLEMENTAL SPECIFICATION 780.02, "CONCRETE CLASS AA" OR AN ACCEPTABLE PNEUMATICALLY APPLIED CONCRETE (SEE SPECIAL PROVISIONS). THE EDGES OF ALL PATCHES SHALL BE SAW CUT IN STRAIGHT LINES TO A MINIMUM DEPTH OF 1 INCH.
- THE LIMITS FOR REMOVAL OF CONCRETE UNDER THE ITEM 580.15, "REPAIR OF CONCRETE SUBSTRUCTURE SURFACE, CLASS III" SHALL BE FROM THE EXISTING CONCRETE SURFACE TO A DEPTH OF GREATER THAN 6". ALL WORK AND MATERIALS NECESSARY FOR PREPARING A PATCH AND FILLING IT SHALL BE INCLUDED IN THE BID PRICE FOR ITEM 580.15. THE FILLING MATERIAL MAY BE EITHER "CONCRETE CLASS AA, CLASS A, CLASS B" OR AN ACCEPTABLE PNEUMATICALLY APPLIED CONCRETE (SEE SPECIAL PROVISIONS). THE EDGES OF ALL PATCHES SHALL BE SAW CUT IN STRAIGHT LINES TO A MINIMUM DEPTH OF 1 INCH.
- IF PNEUMATICALLY APPLIED CONCRETE IS SELECTED FOR REPAIR OF CONCRETE SUBSTRUCTURE SURFACE, CLASS II OR III, THEN THIS TYPE OF CONCRETE REPAIR SHALL BE CONFINED ONLY TO VERTICAL AND OVERHEAD SURFACES OF THE SUBSTRUCTURE. ALSO, THE BRIDGE BEARINGS AND BEAMS SHALL BE COMPLETELY PROTECTED FROM REBOUND MATERIAL DURING SHOTCRETE APPLICATION PROCEDURES.

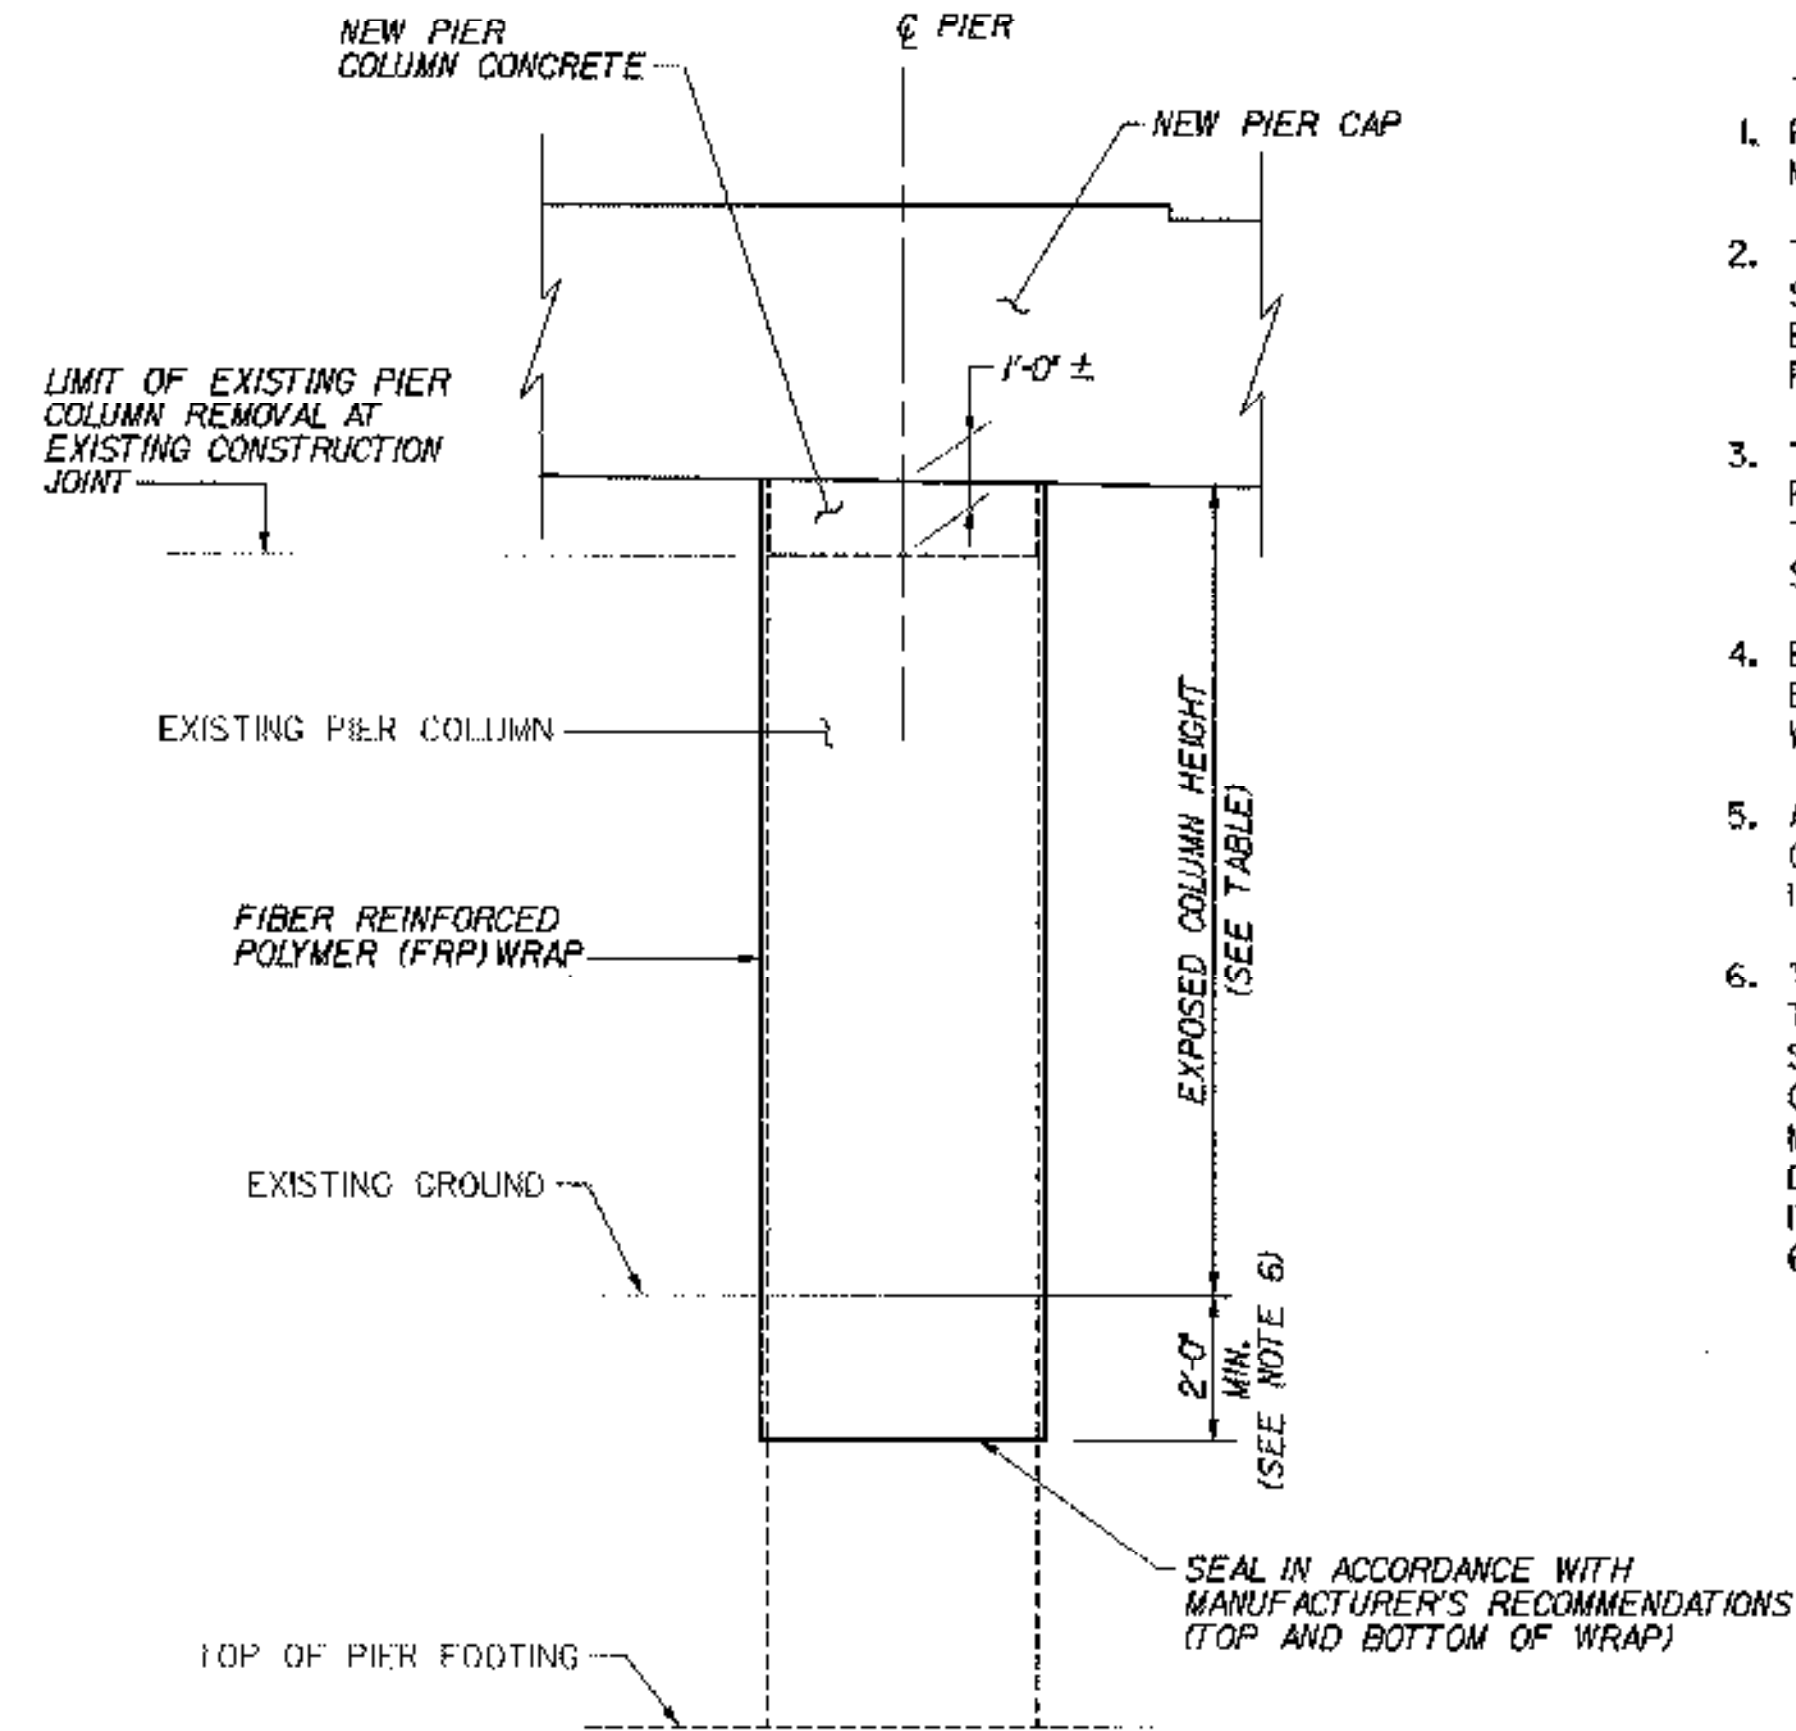

**FRP COLUMN WRAP DETAIL**  
SCALE: 3/8" = 1'-0"

BRIDGE	PIER	COLUMNS TO BE WRAPPED	AVERAGE EXPOSED COLUMN HEIGHT (APPROXIMATE)
43N	1	ALL	12'-9"
	2	ALL	9'-8"
43S	1	ALL	12'-9"
	2	ALL	8'-3"
<del>51N</del>	1	1, 2	19'-0"
	2	PIER TO BE REPLACED	-
	3	1, 3, 4	14'-10"
	4	1, 2	12'-2"
<del>51S</del>	1	1, 2, 3	18'-11"
	2	1, 2	19'-4"
	3	PIER TO BE REPLACED	-
	4	1, 2	16'-6"
	5	NONE	14'-5"

\* COLUMNS ARE NUMBERED LEFT TO RIGHT LOOKING UPSTATION

**FRP COLUMN WRAP NOTES:**

- FOLLOWING REPAIR OF COLUMNS, ALLOW CURING OF CONCRETE REPAIR MATERIAL FOR 28 DAYS MINIMUM PRIOR TO WRAPPING.
- THE CONTRACTOR SHALL SUBMIT FRP COLUMN WRAP DATA FROM THE SPECIFIC MANUFACTURER AND INSTALLATION PROCEDURES TO THE ENGINEER FOR APPROVAL, IN ACCORDANCE WITH THE SPECIAL PROVISIONS.
- THE CONTRACTOR SHALL APPLY A U.V. PROTECTIVE COATING ON THE FRP WRAP FOLLOWING CURING OF THE WRAP IN ACCORDANCE WITH THE MANUFACTURER'S RECOMMENDATIONS. THE COATING COLOR SHALL BE A NATURAL CONCRETE GREY, AS APPROVED BY THE ENGINEER.
- BACKFILL OF EXISTING GROUND AT THE BASE OF THE COLUMNS SHALL BE ACCOMPLISHED AFTER THE COATING HAS CURED, IN ACCORDANCE WITH THE MANUFACTURER'S RECOMMENDATIONS.
- ALL COSTS ASSOCIATED WITH WRAPPING COLUMNS, WITH THE EXCEPTION OF CONCRETE REPAIRS, SHALL BE INCLUDED IN THE BID PRICE FOR ITEM 580.40 "FIBER REINFORCED POLYMER WRAP."
- THE DEPTH OF FRP WRAP SHOWN IS BELOW EXISTING GROUND, NOT BELOW TOP OF STONE FILL. ANY STONE FILL DISTURBED TO ALLOW REPAIR OF SUBSTRUCTURES OR WRAPPING OF PIERS SHALL BE REPLACED TO ITS ORIGINAL CONDITION AS DIRECTED BY THE ENGINEER. THE MINIMUM DEPTH OF FRP WRAP MAY BE INCREASED DUE TO REQUIRED LIMITS OF CONCRETE REPAIR, AS DIRECTED BY THE ENGINEER. REQUIRED EXCAVATION SHALL BE PAID FOR UNDER ITEM 204.25. REQUIRED BACKFILL SHALL BE PROVIDED UNDER ITEMS 204.30, 613.10, 613.J, OR 613.J3, AS DIRECTED BY THE ENGINEER AT EACH PIER LOCATION.

BRIDGE 51N AND 51S  
ARE NOT A PART OF THIS PROJECT

**STATE OF VERMONT  
AGENCY OF TRANSPORTATION**


Town Of MIDDLESEX-BOLTON Bridge No.  
Highway No. I-89 Log Sta.  
Surv. Sta.

**SUBSTRUCTURE REPAIR DETAILS AND NOTES**

Designed By P.W. SZUSTAK Drawn By R.A. BOTZEMHART  
Checked By Date Bridge Design Supervisor  
J.P. HALSTEAD 10/99 J.P. HALSTEAD Date 10/99


PROJECT MIDDLESEX-BOLTON PROJECT NO. IM-089-2(26)

TVGA CAD Drawing No. subprprt Date 10/99  
Bridge Sheet No. C-45 Sheet 45 of 307

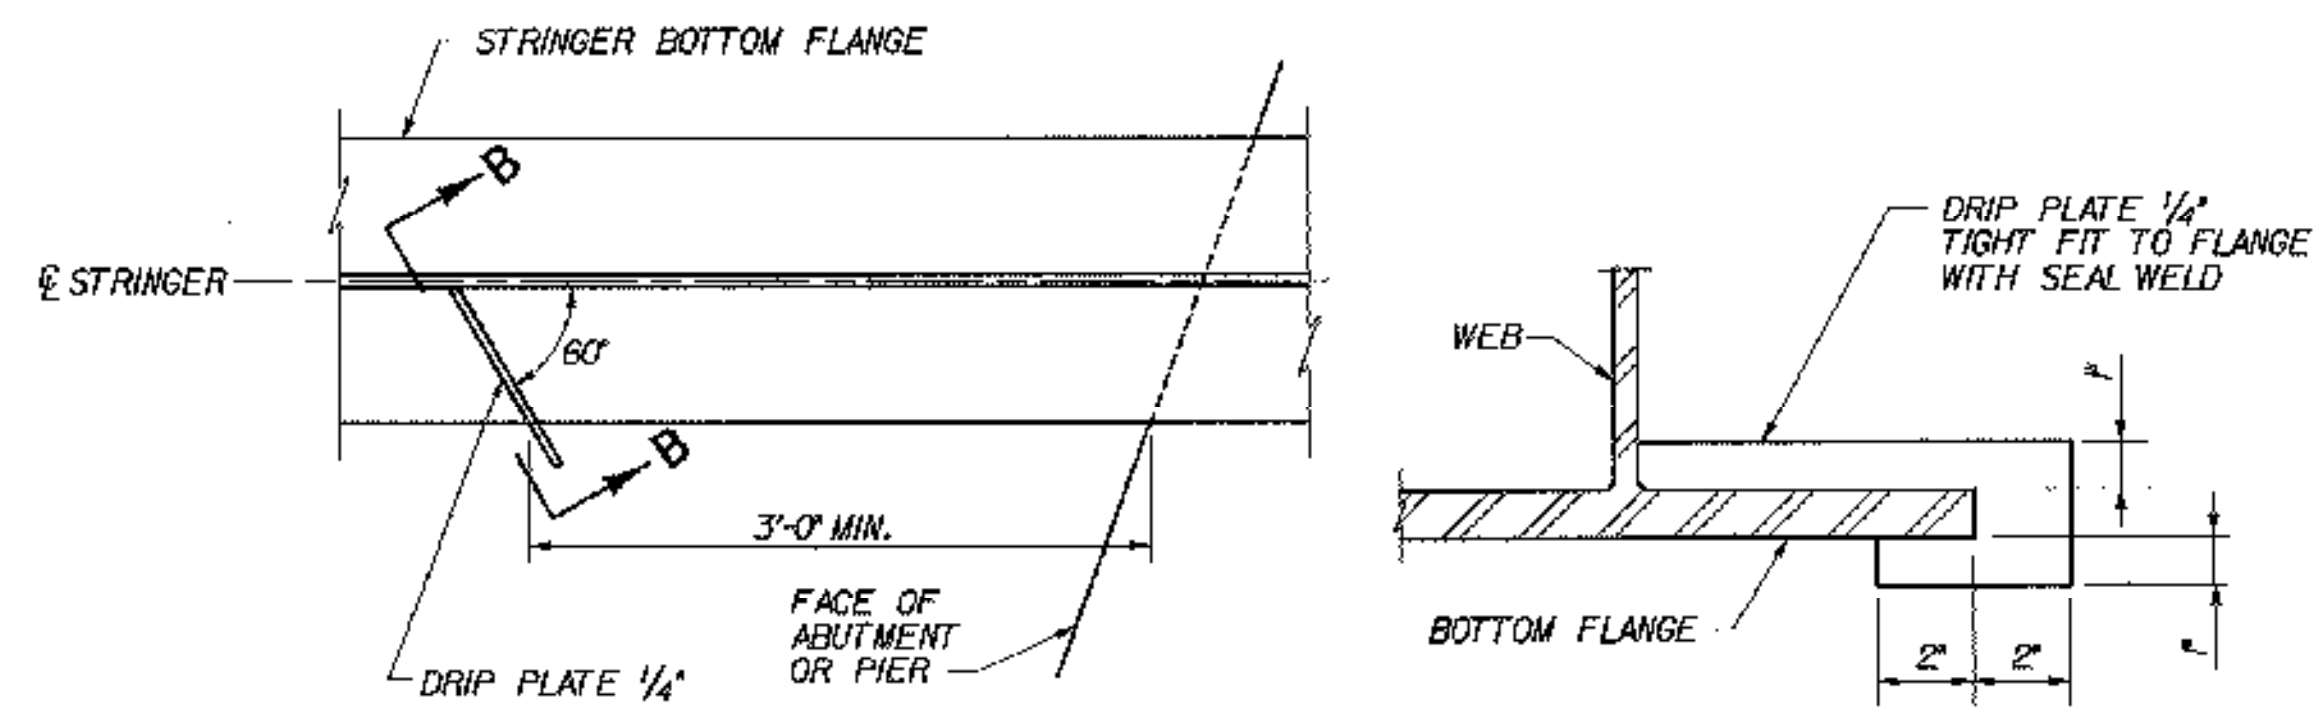


**DRIP PLATE DETAIL**  
N.T.S.

NOTE: DRIP PLATES SHALL BE PLACED ON OUTSIDE EDGE OF FASCIA STRINGERS ON THE HIGH SIDE OF ALL PIERS AND LOW ABUTMENTS OR AS INDICATED ON PROJECT PLANS.

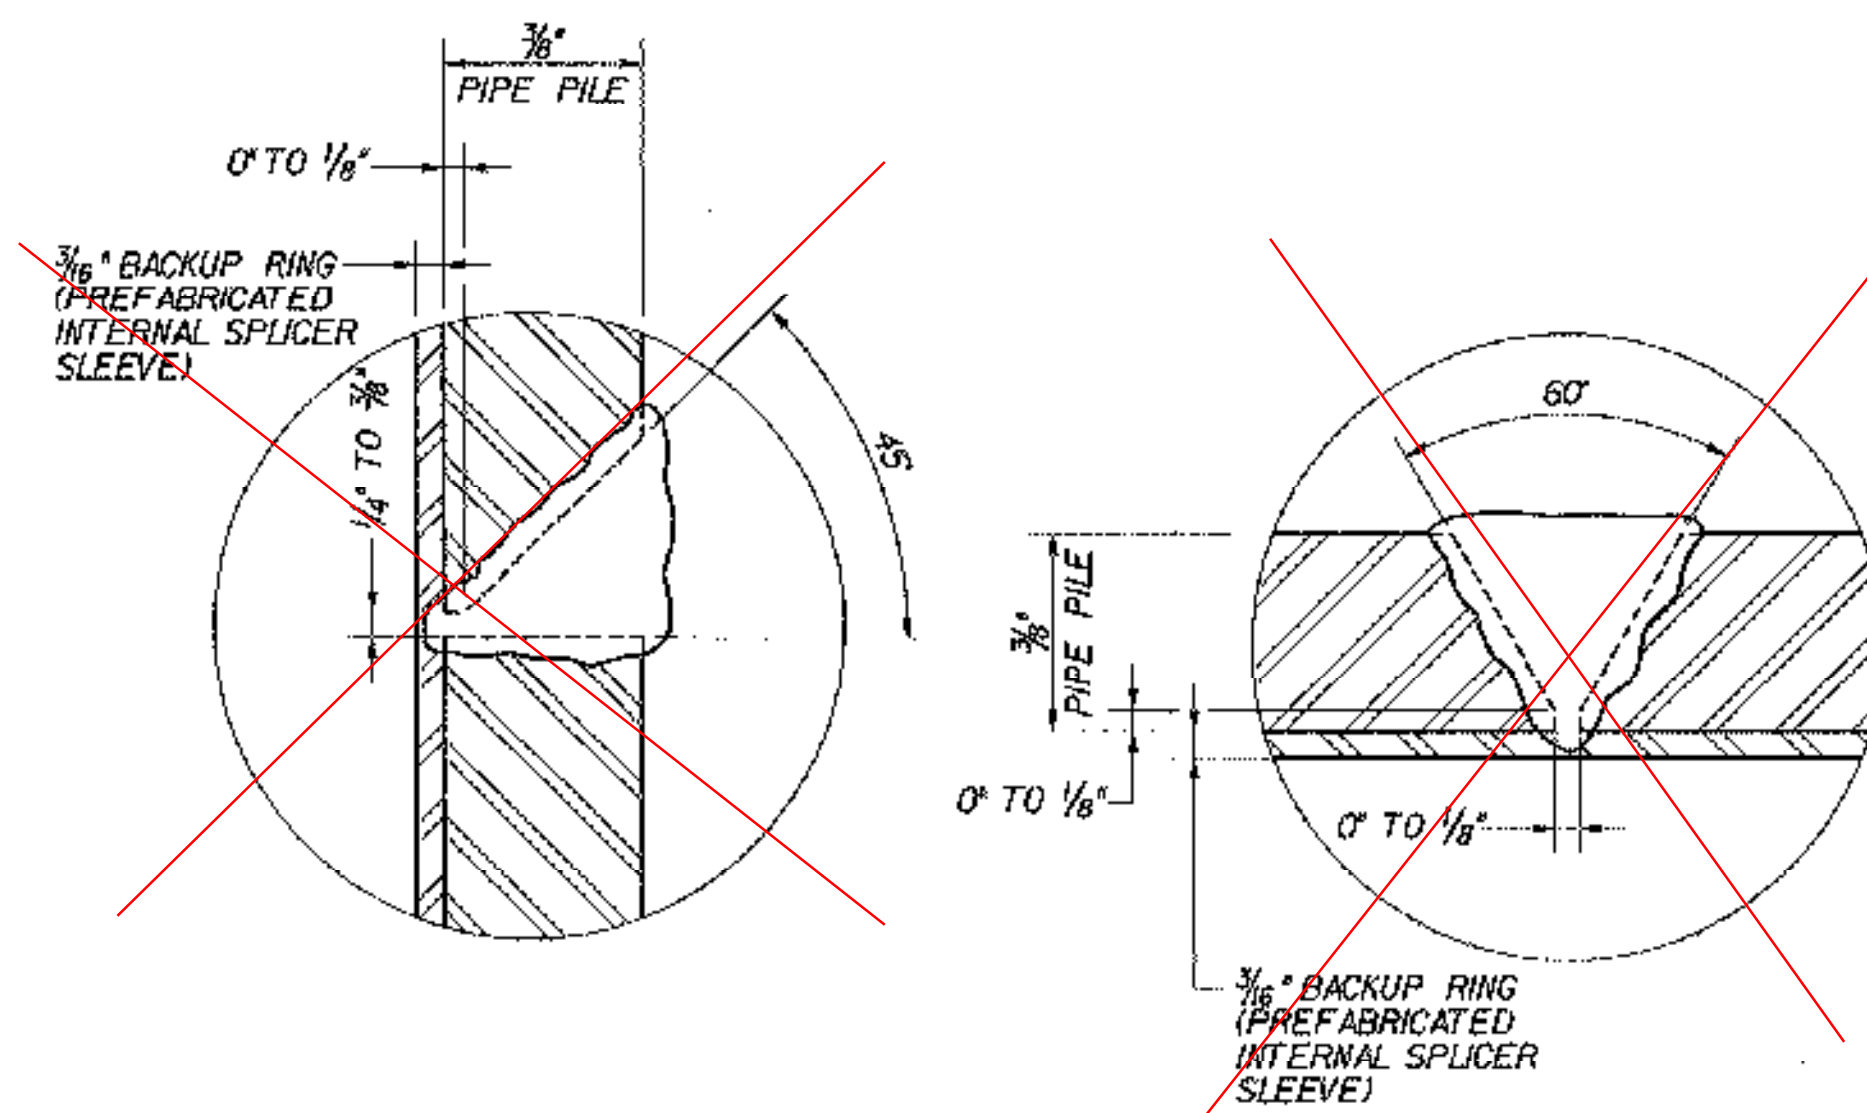


**PIPE PILE SPLICE OPTIONS**  
N.T.S.


BRIDGE 5118 NOT A PART OF THIS PROJECT

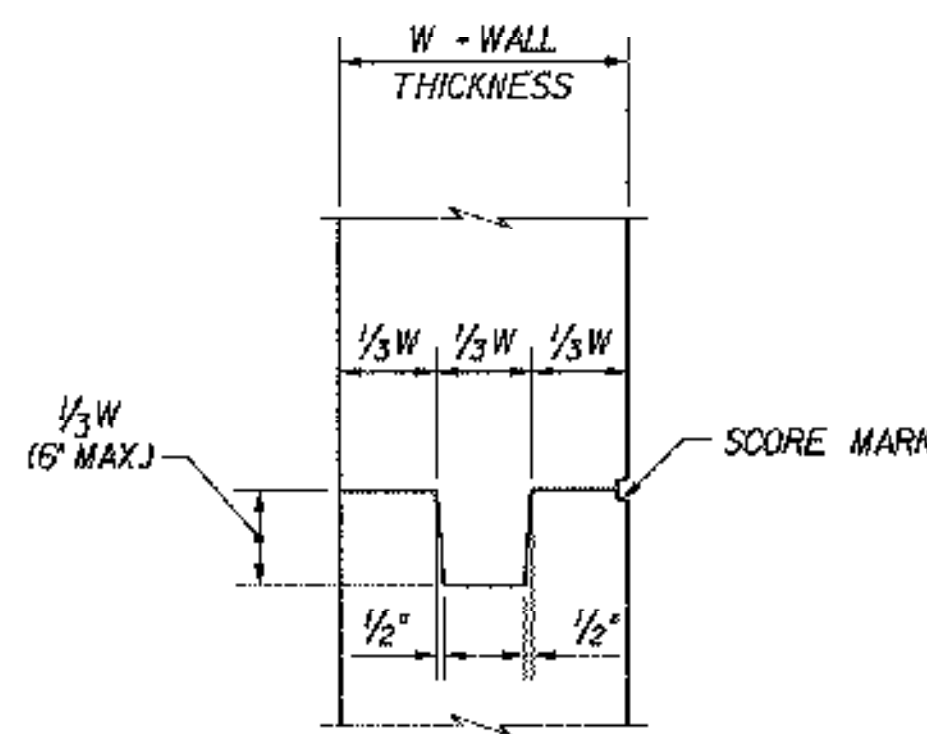


**TYPICAL CONCRETE CONSTRUCTION JOINT**  
N.T.S.

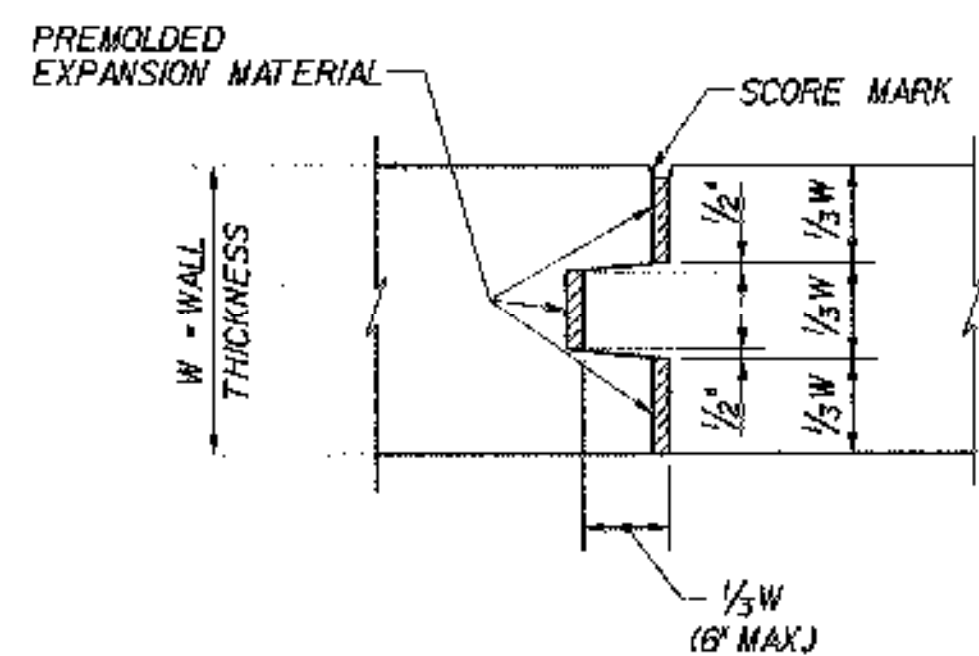


**TYPICAL CONCRETE EXPANSION JOINT**  
N.T.S.

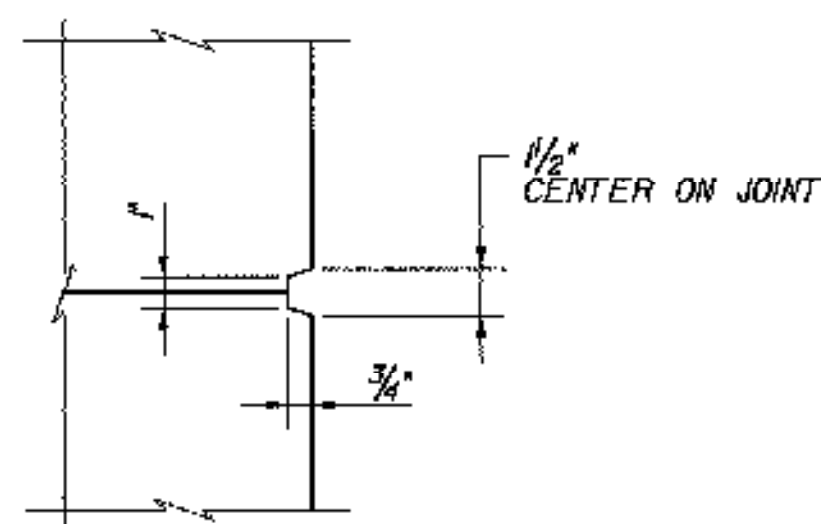

**SCORE MARK DETAIL**  
N.T.S.

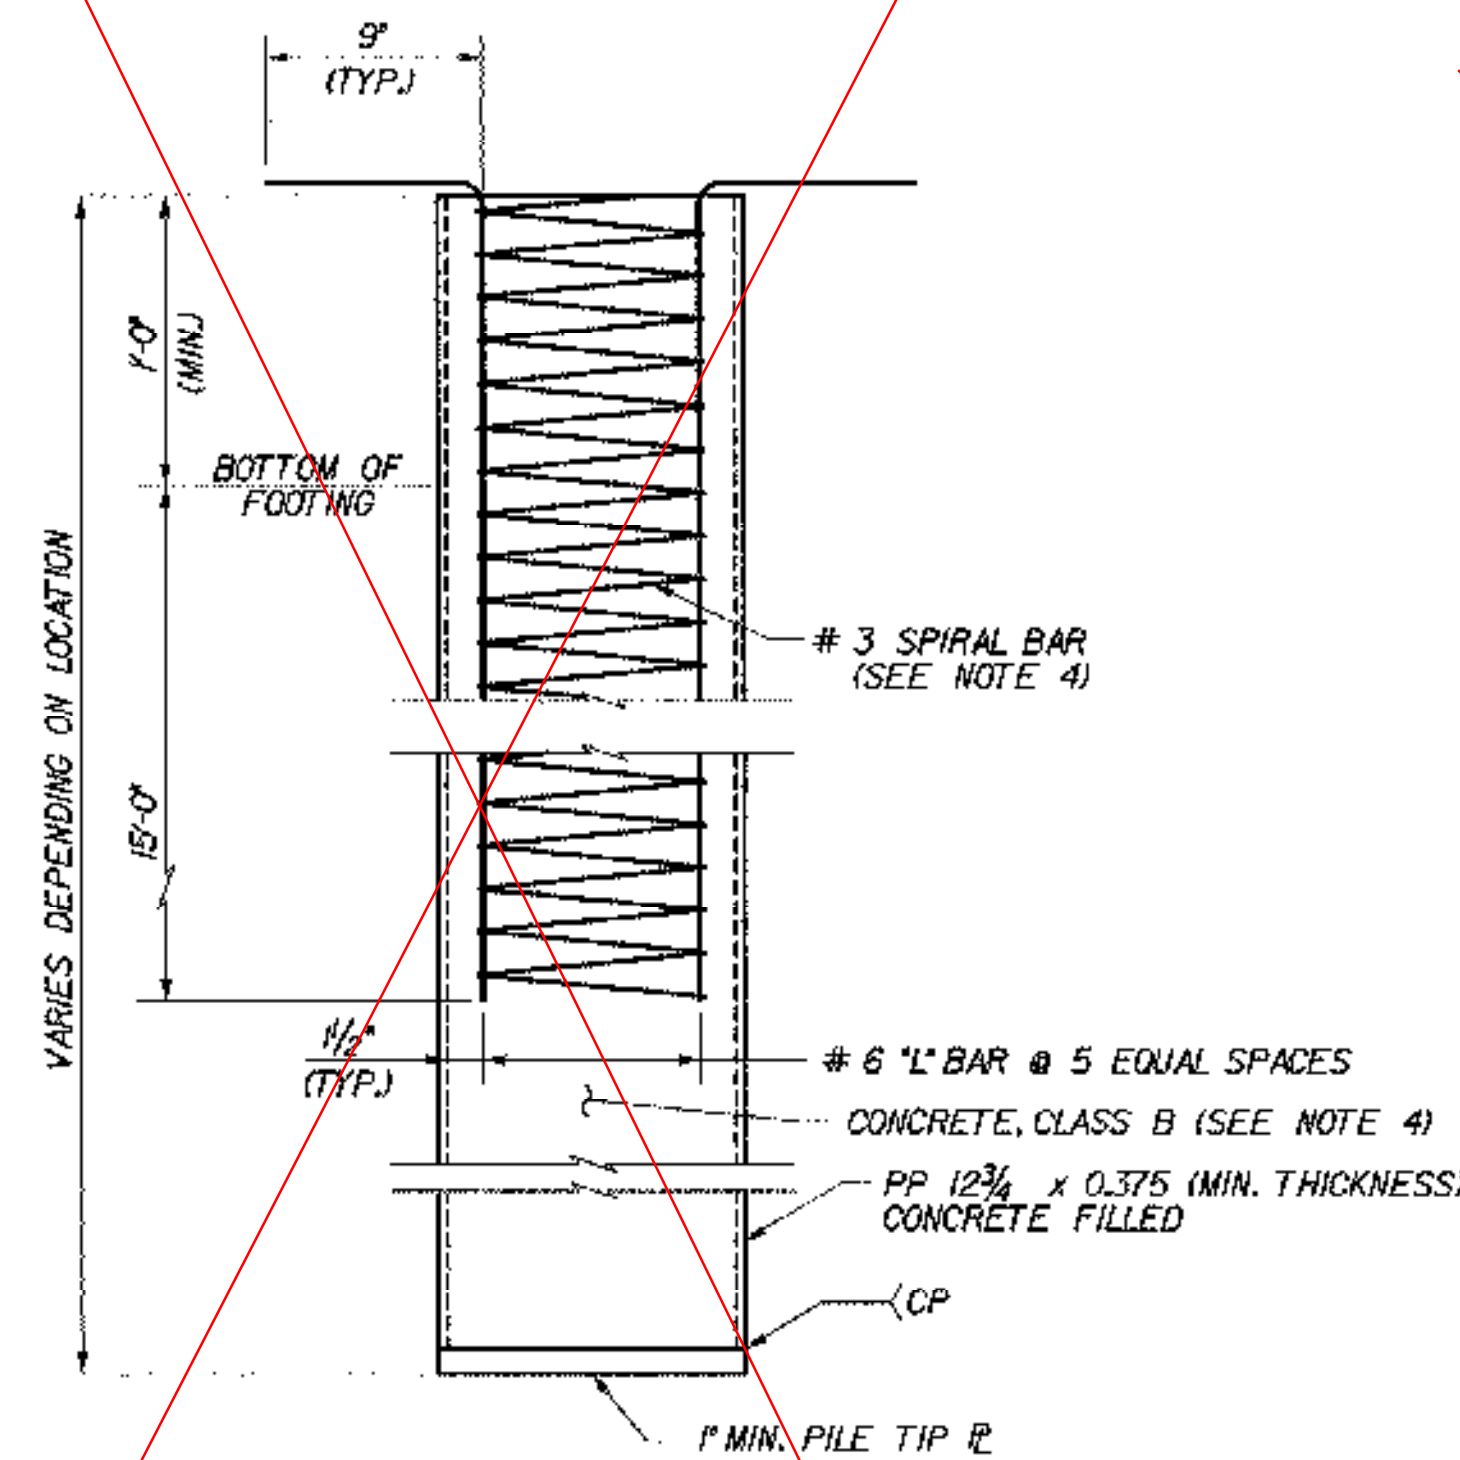


**ELEVATION**  
SCALE: 1/2" = 1'-0"

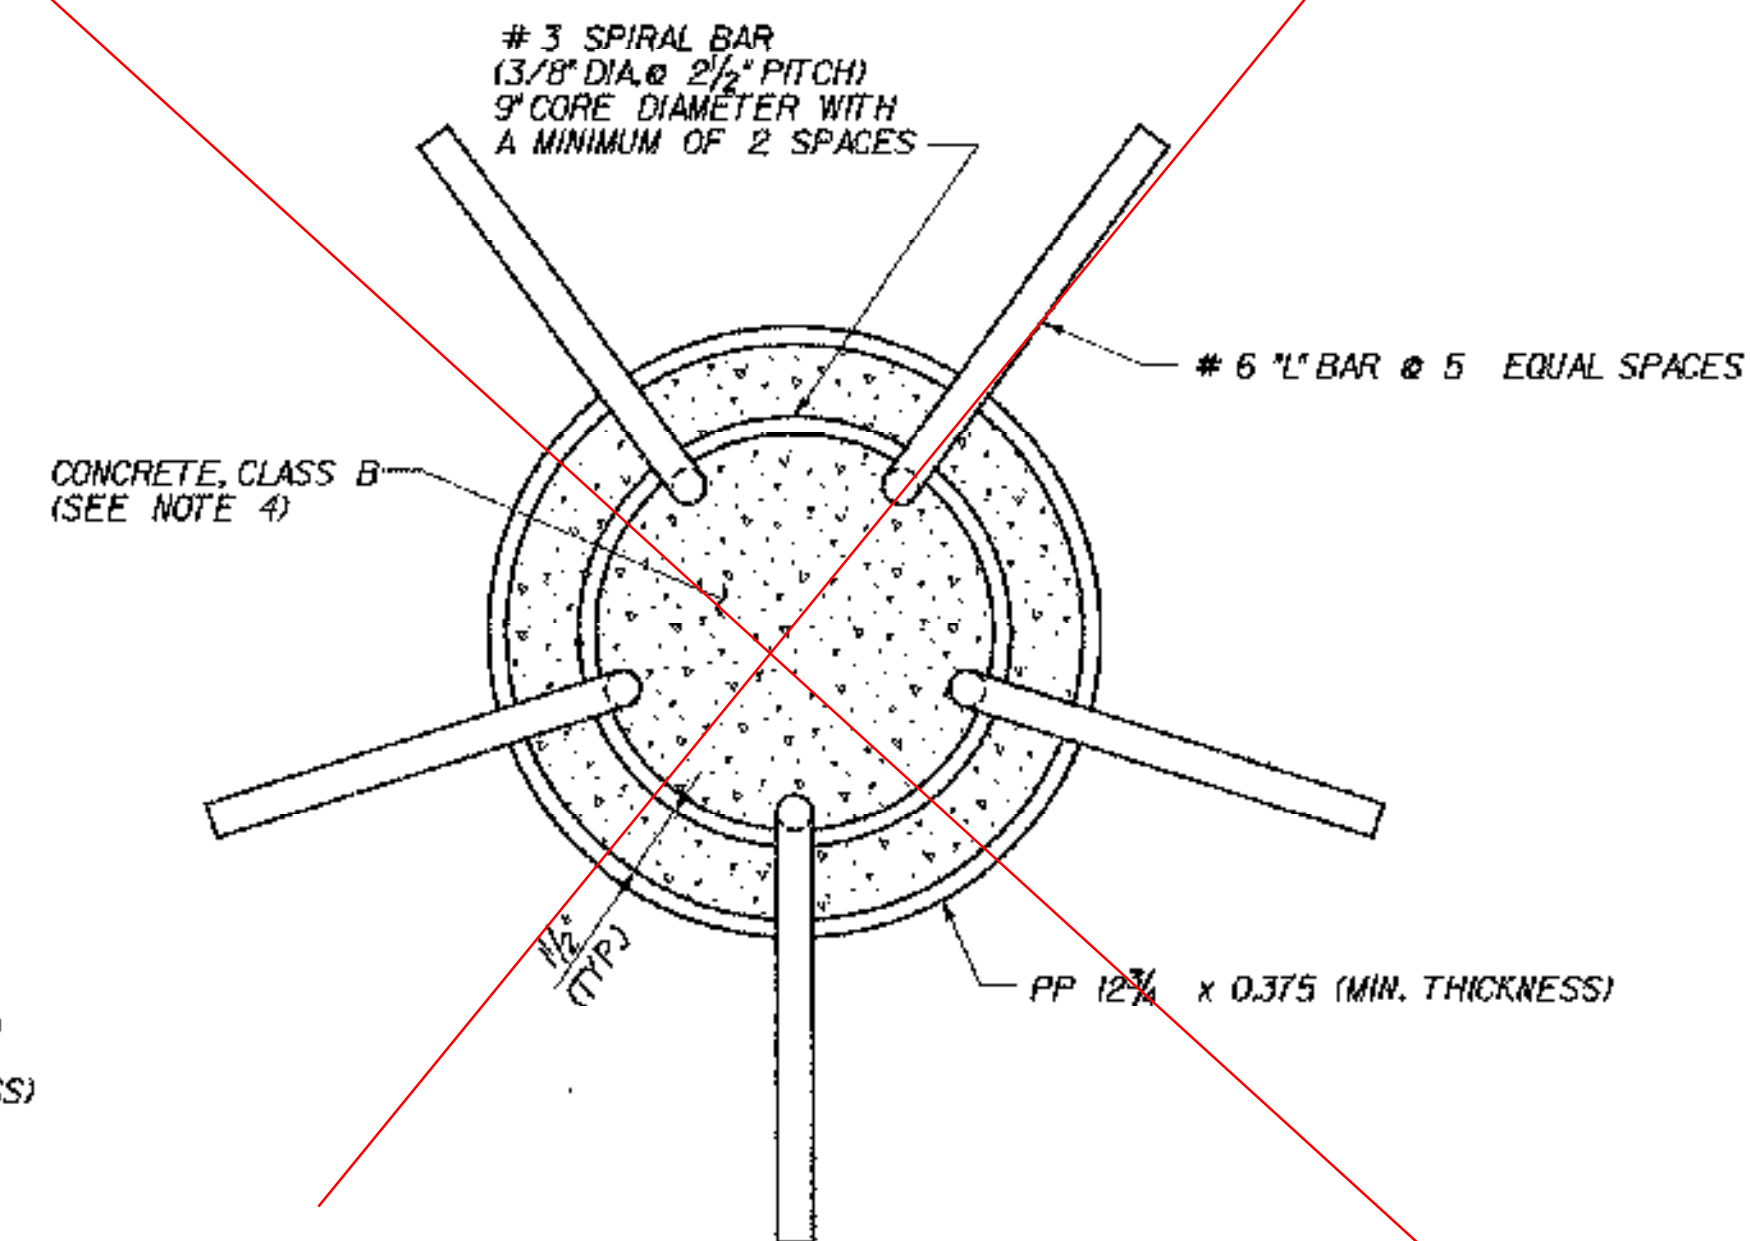


**PLAN**  
SCALE: 3" = 1'-0"


~~CAST-IN-PLACE CONCRETE PILING~~

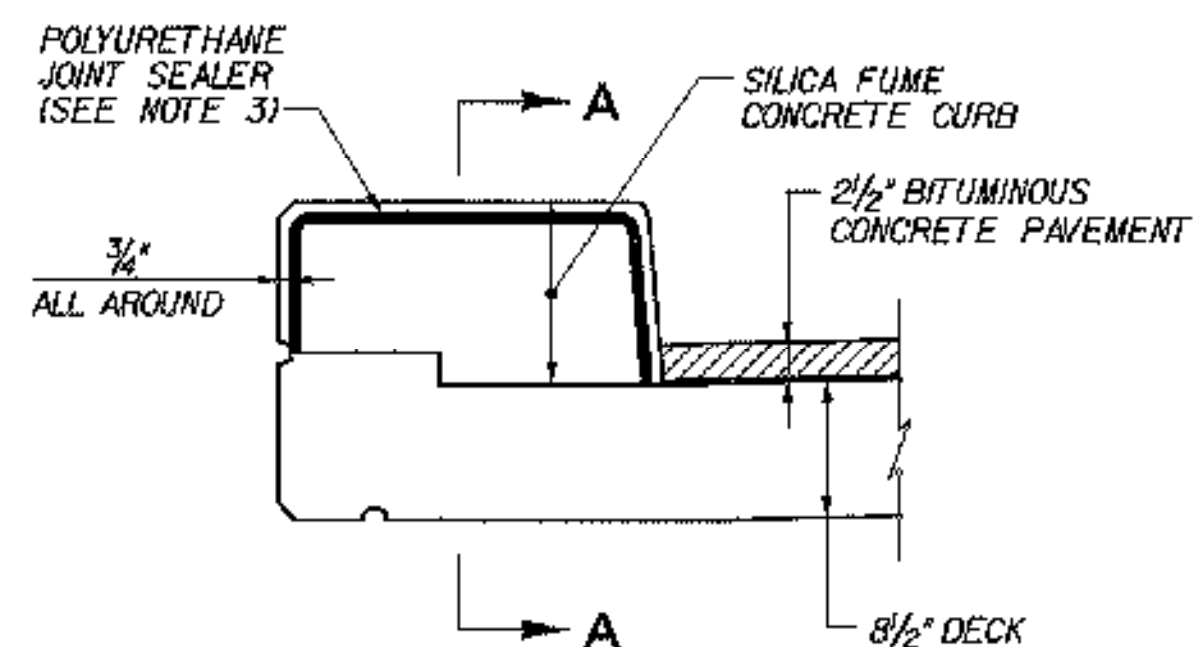

**TYPICAL SECTION THRU CONCRETE CURB CONSTRUCTION JOINT**

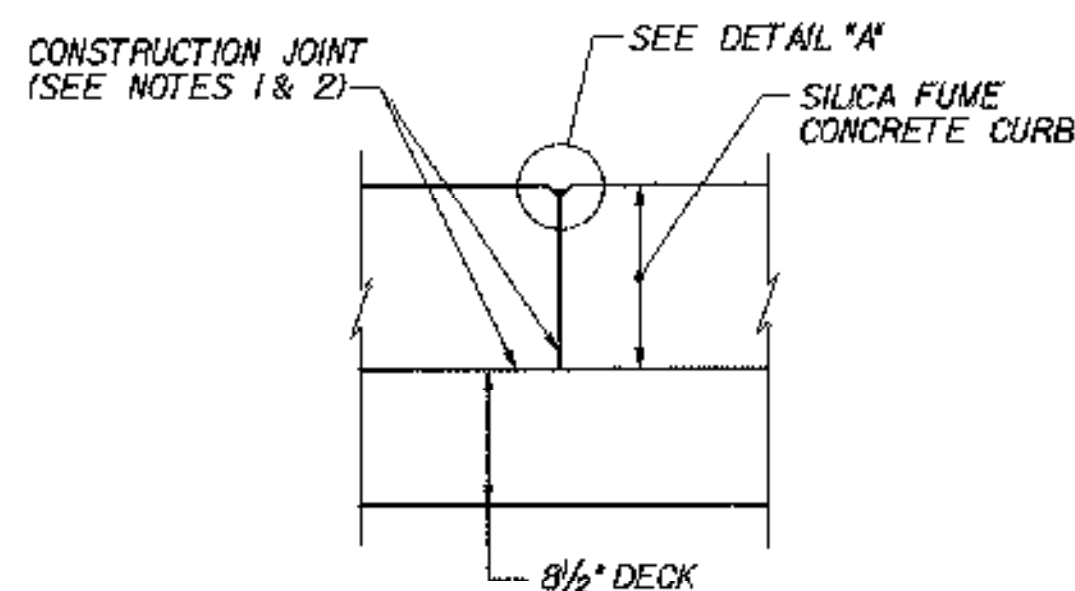

**CURB JOINT DETAILS**  
N.T.S.

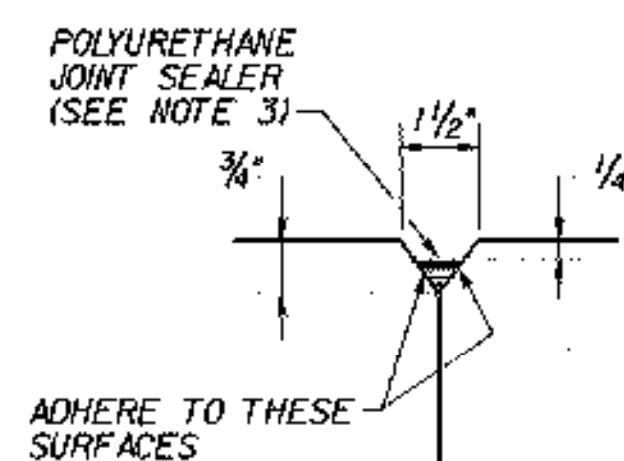

**DETAIL "A"**

**NOTES:**

- CONSTRUCTION JOINTS THROUGH CONCRETE CURB SHALL BE SPACED MAXIMUM 15'-0" CENTER TO CENTER AND SHALL BE 1'-6" MINIMUM FROM THE CENTER OF THE NEAREST BRIDGE RAIL POST. CONCRETE SHALL BE PLACED IN ALTERNATING SECTIONS WITH A MINIMUM OF 48 HOURS DELAY BETWEEN ADJACENT POURS.
- LONGITUDINAL REINFORCING SHALL PASS THROUGH CONCRETE CURB CONSTRUCTION JOINTS.
- POLYURETHANE JOINT SEALER, PER SUBSECTION 524.06(G) OF THE SPECIFICATIONS, COLOR TO MATCH CONCRETE. COST SHALL BE SUBSIDIARY TO ITEM 501.60, "SILICA-FUME CONCRETE".
- THE COST OF CONCRETE AND REINFORCING STEEL SHALL BE SUBSIDIARY TO ITEM 505.25, "CAST-IN-PLACE CONCRETE PILING".


**STATE OF VERMONT AGENCY OF TRANSPORTATION**

Town Of	MIDDLESEX-BOLTON	Bridge No.	
Highway No.	1-89	Log Sta.	
		Surv. Sta.	

**TYPICAL BRIDGE DETAILS**


Designed By	P.W. SZUSTAK	Drawn By	R.A. BOTZENHART
Checked By	J.P. HALSTEAD	Bridge Design Supervisor	J.P. HALSTEAD
Date	10/99	Date	10/99

PROJECT	MIDDLESEX-BOLTON	PROJECT NO.	IM-089-2(26)
---------	------------------	-------------	--------------

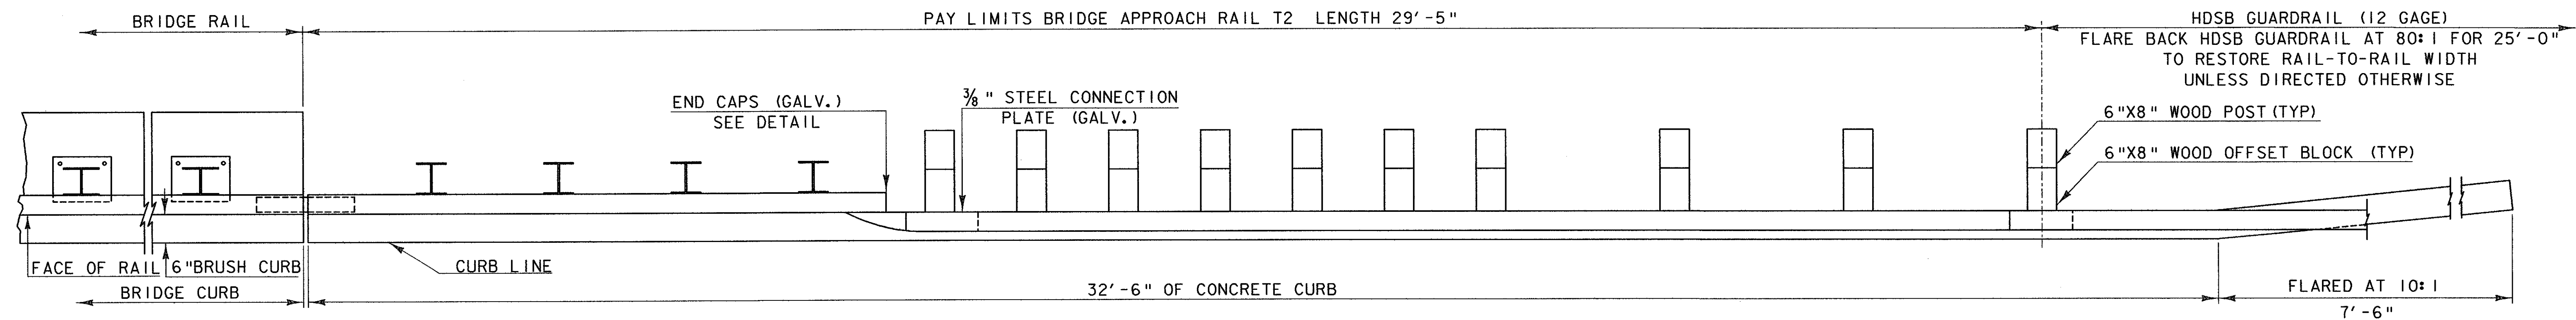

PLAN VIEW - APPROACH RAIL

SCALE  $\frac{3}{4}$ " = 1'-0"

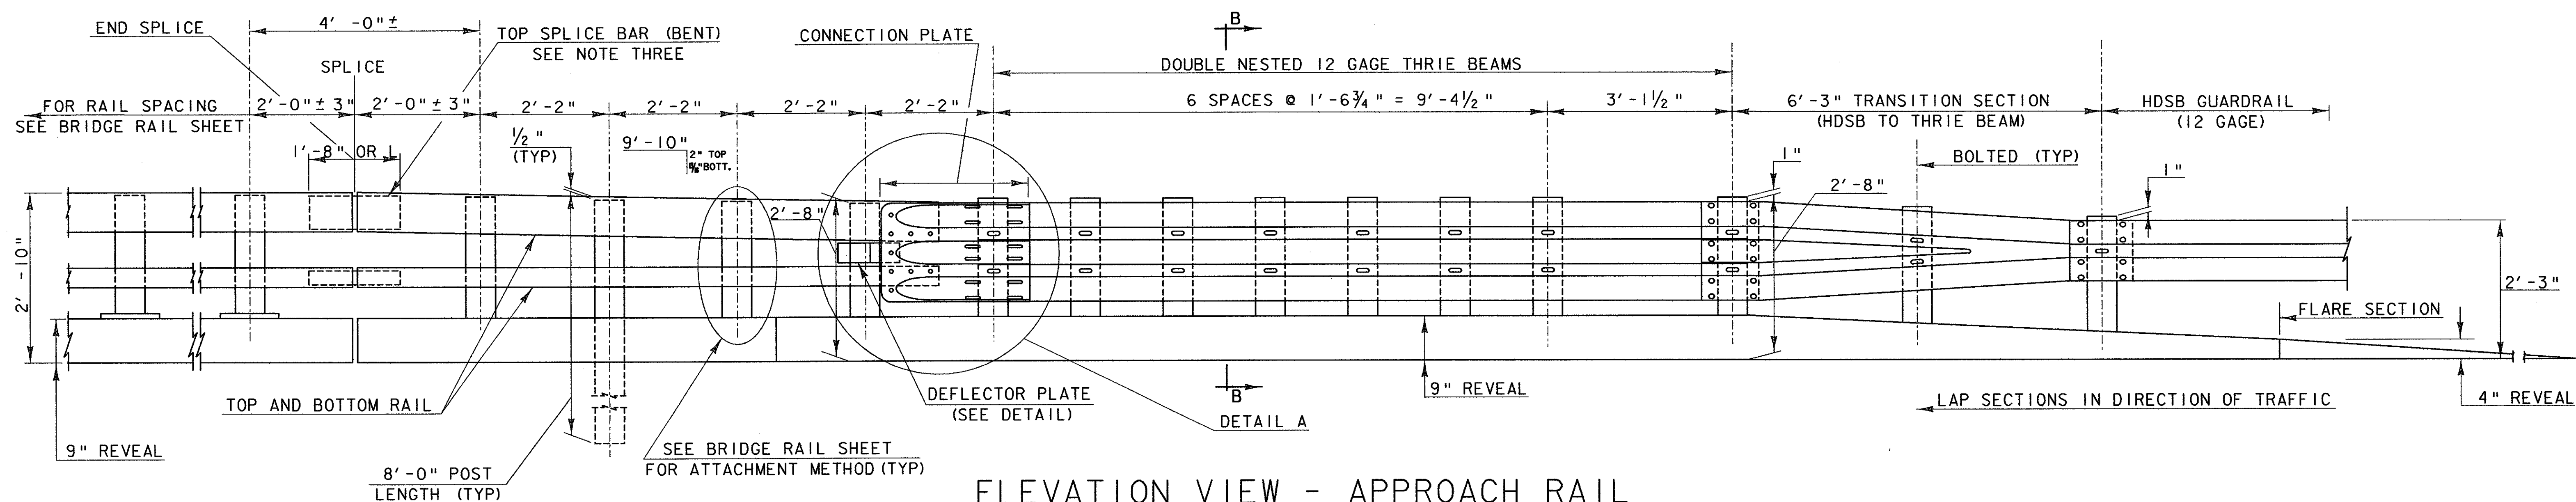

ELEVATION VIEW - APPROACH RAIL

SCALE  $\frac{3}{4}$ " = 1'-0"


NOTES:

- 1) ALL BRIDGE APPROACH RAIL MATERIALS, DIMENSION SIZES, AND NOTES SHALL BE THE SAME AS THOSE OF THE BRIDGE RAIL UNLESS OTHERWISE NOTED.
- 2) CARRIAGE BOLTS SHALL BE ASTM A307 AND NUTS SHALL BE ASTM A563 GRADE A OR BETTER (GALVANIZED).
- 3) WELD TOP SPLICE BAR TO FIT BEND. USE COMPLETE PENETRATION WELD (B-U2).
- 4) REFER TO STANDARD DETAIL BRI-97 FOR ADDITIONAL DETAILS, NOTES, AND MATERIALS SPECIFICATIONS.
- 5) THE REFLECTORIZED ALUMINUM DELINEATION IS TO BE ERRECTED EVERY 30' (OR THE CLOSEST POST) WITH 2 NO. 8 X  $\frac{3}{4}$ " SELF TAPPING SCREWS. DELINEATORS SHALL MEET SPECIFICATION REQUIREMENTS FOR ASTM B209 ALLOY 5052-H32.



- 6) REFLECTIVE MATERIAL SHALL MEET REQUIREMENTS OF SUBSECTION 750.08 AND SHALL BE ENCAPSULATED LENS SILVER OR AMBER. AMBER IS TO BE INSTALLED ON THE DRIVERS LEFT AND SILVER ON THEIR RIGHT.
- 7) ON BRIDGES WITH A SIDEWALK, DELINEATORS ARE NOT TO BE INSTALLED ON THE SIDEWALK SIDE OF THE BRIDGE (I.E. DELINEATORS INSTALLED ONLY ON THE CURB SIDE AND ON THE APPROACH ON THE CURB SIDE). PAYMENT SHALL BE SUBSIDIARY TO ALL OTHER ITEMS.

STATE OF VERMONT  
AGENCY OF TRANSPORTATION



Town Of	MIDDLESEX-BOLTON	Bridge No.	
Highway No.	I-89	Log Sta.	
		Surv. Sta.	
<b>GUARD RAIL APPROACH SECTION</b>			
<b>NETC 2 RAIL (SHEET 1 OF 2)</b>			
Designed By	C.P. WILLIAMS	Drawn By	D.G. BASSETT
Checked By	S. FARNSWORTH	Bridge Design Supervisor	J.P. HALSTEAD
Date	10/99	Date	10/99
PROJECT	MIDDLESEX-BOLTON	PROJECT NO.	IM-089-2(26)
TVGA CAD Drawing No.	netcmbob	Date	10/99
Bridge Sheet No.	C-46A	Sheet	46A of 307

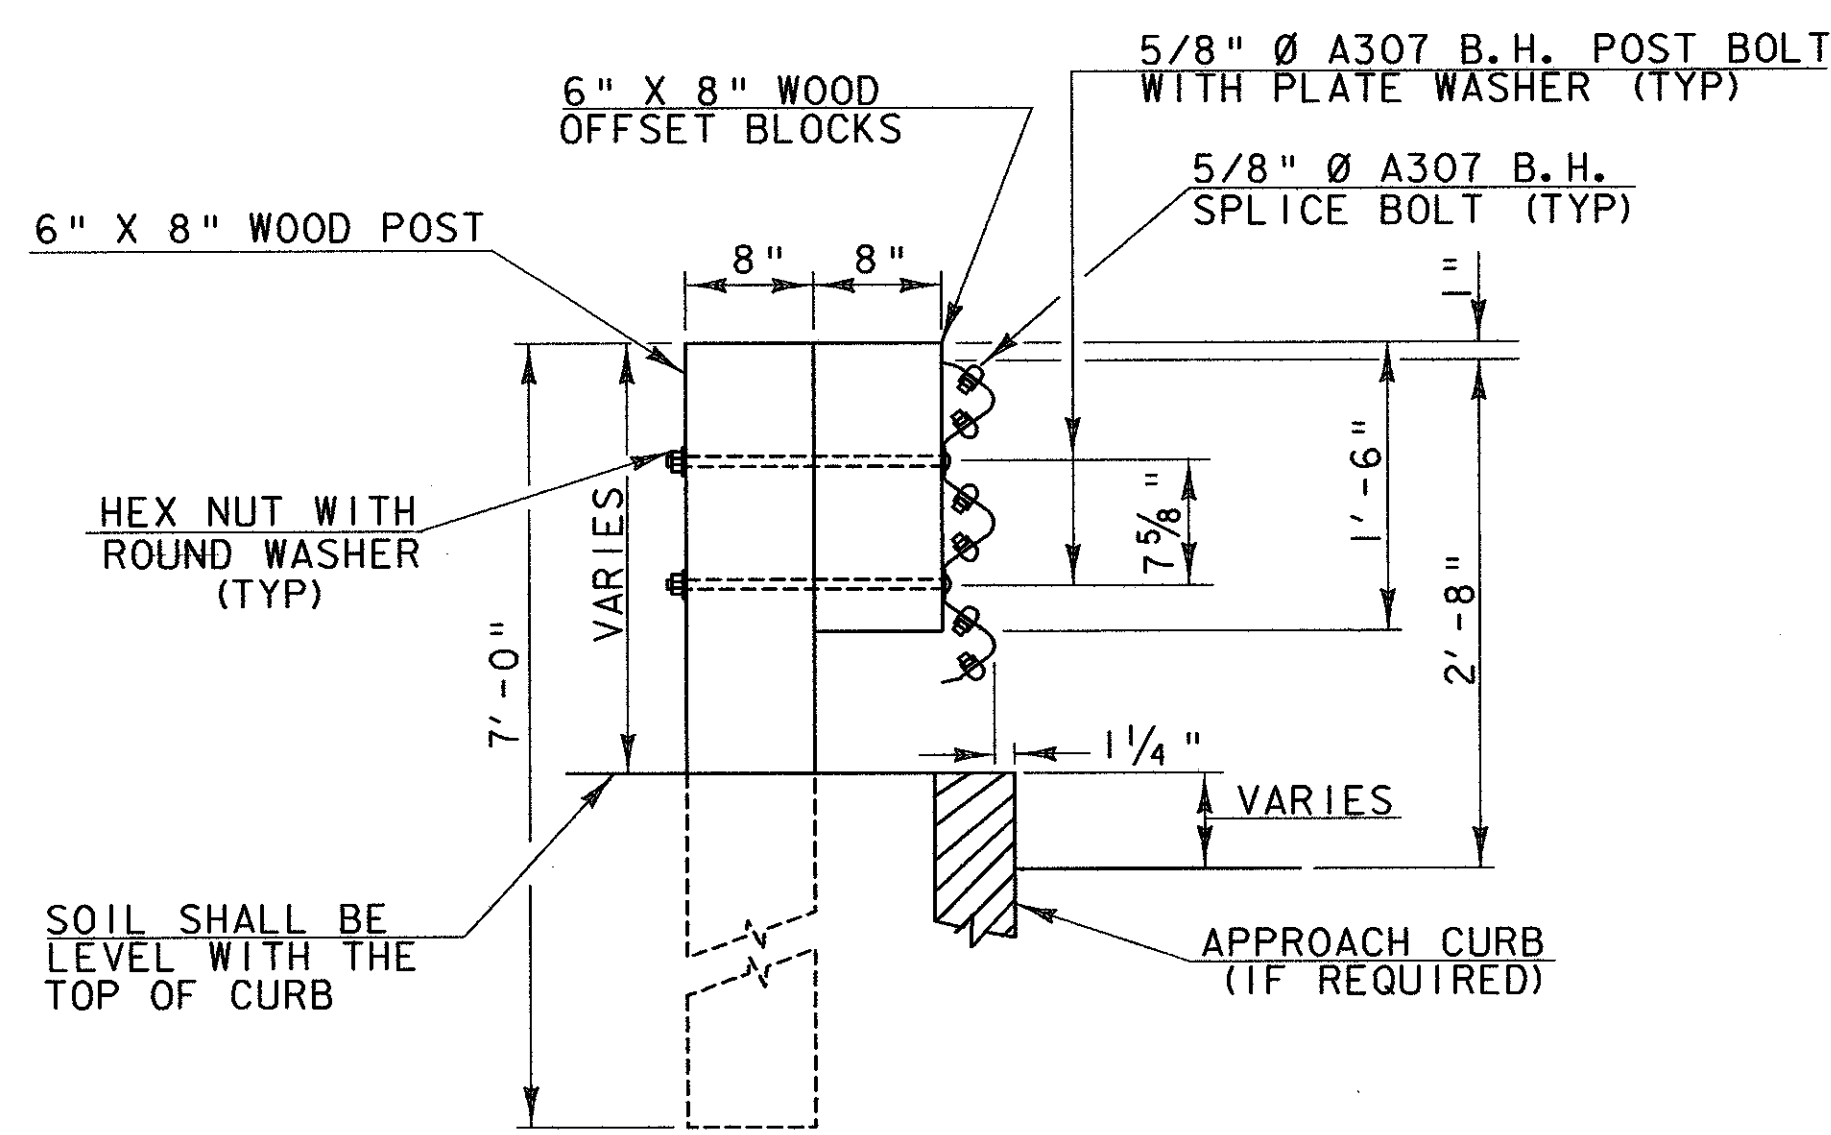



SECTION B-B (POST RAIL ASSEMBLY)

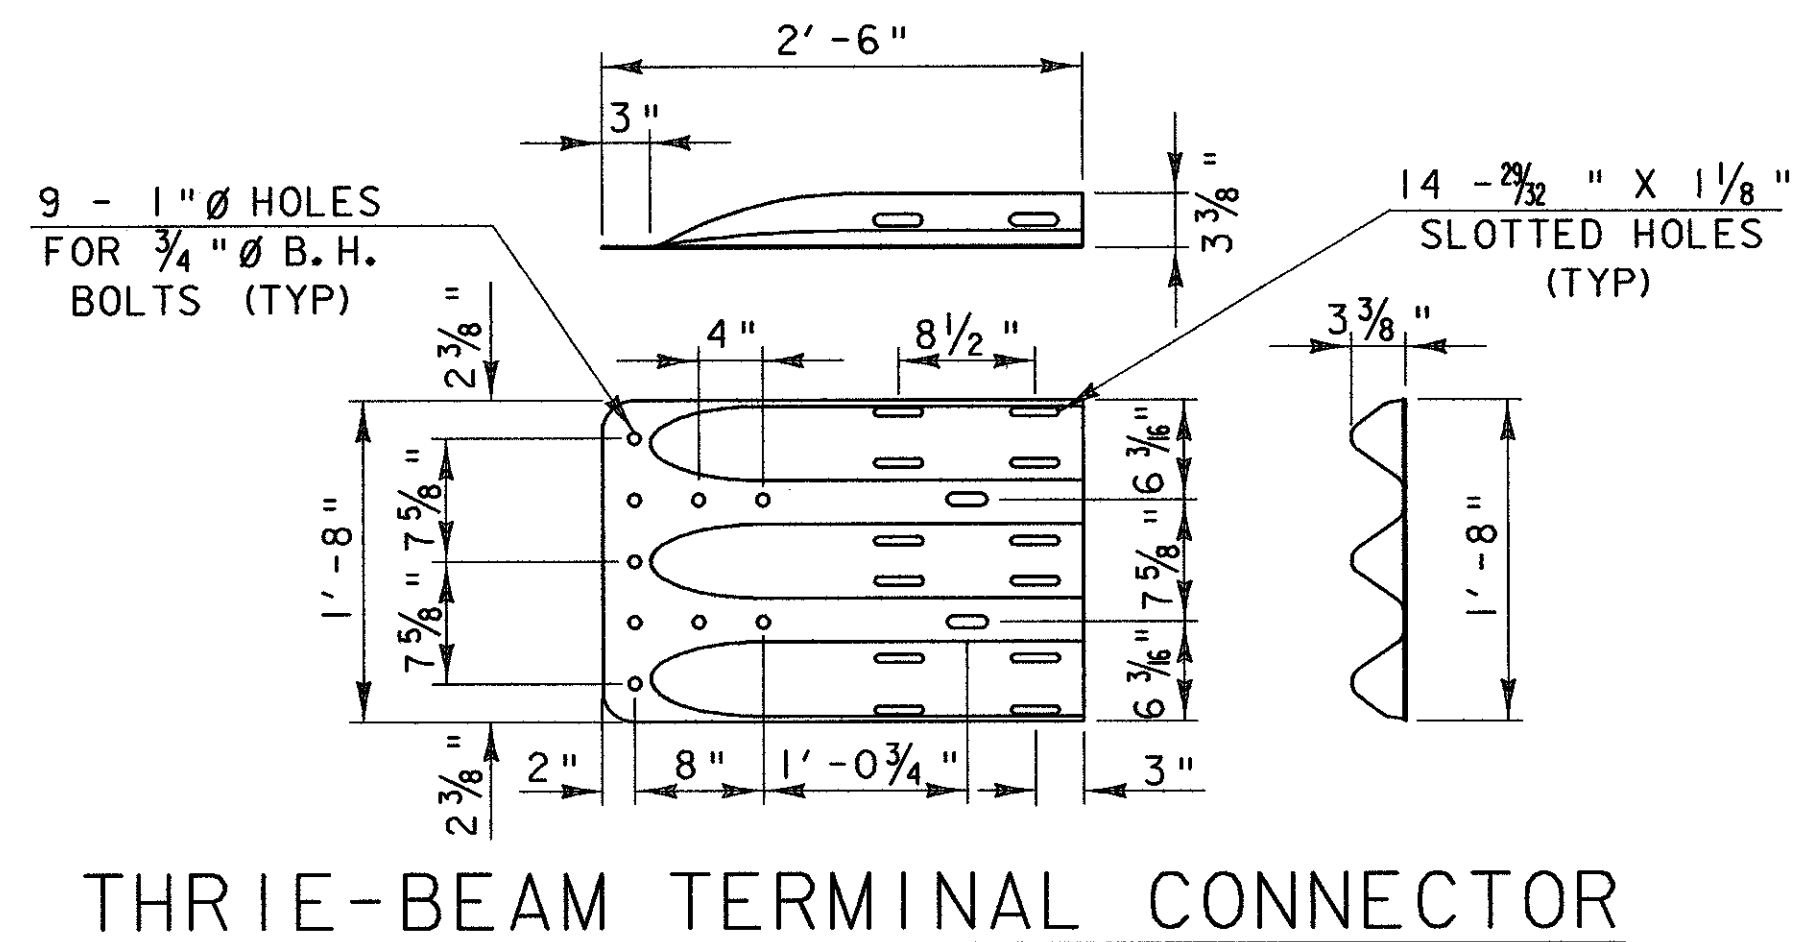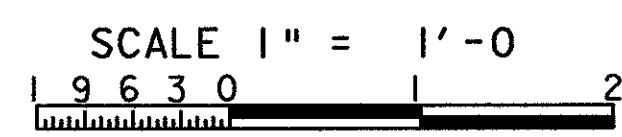



THREE-BEAM TERMINAL CONNECTOR

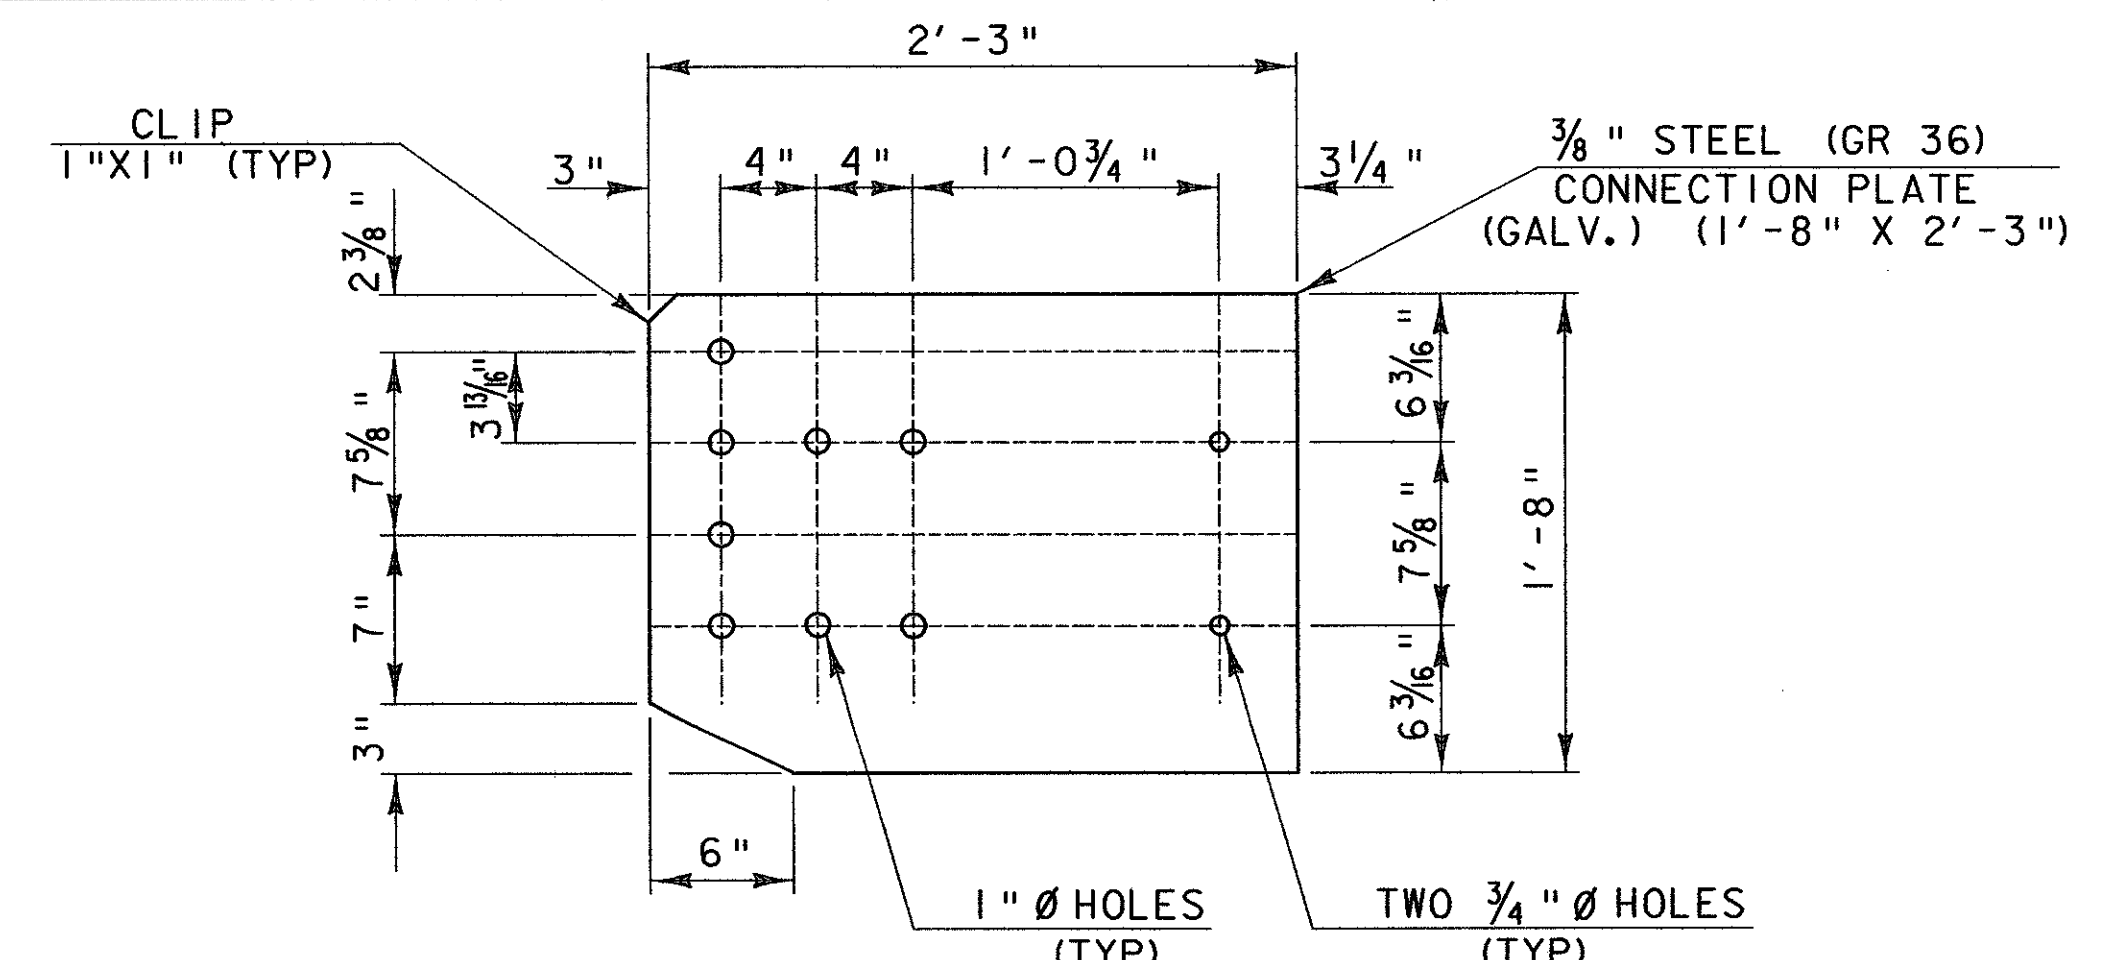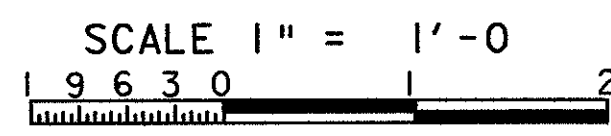



CONNECTION PLATE

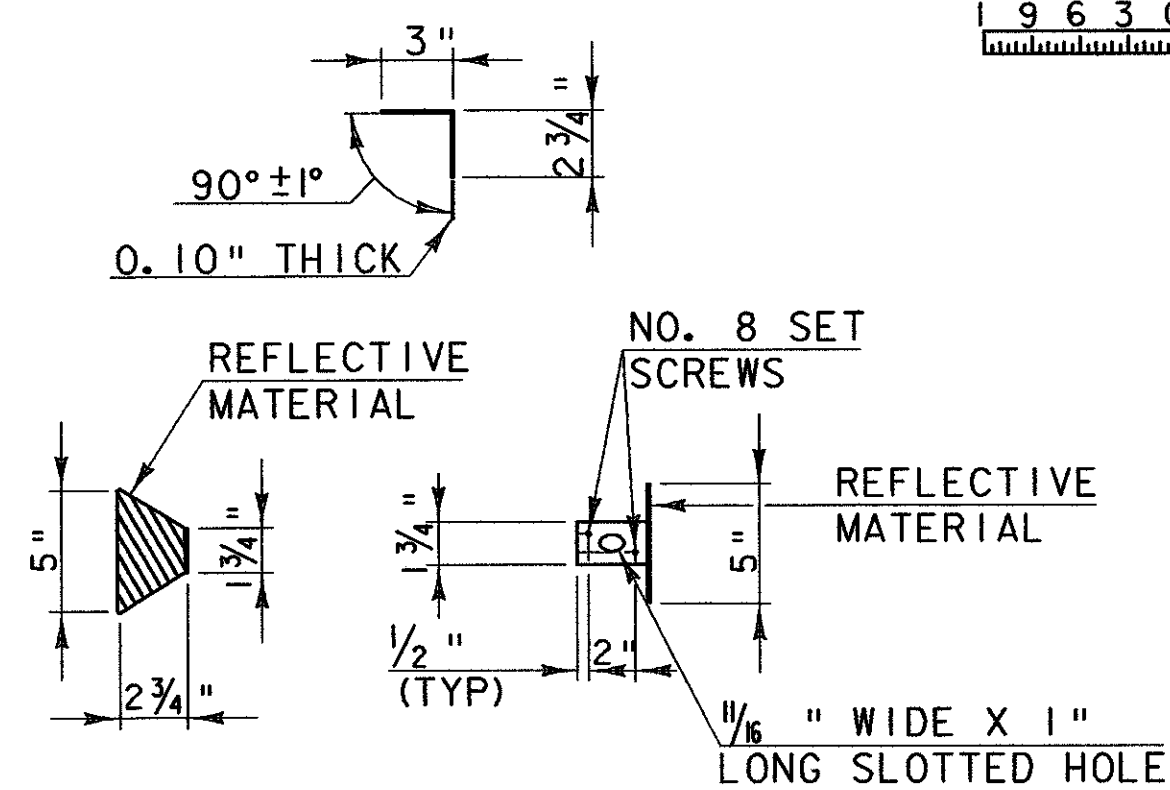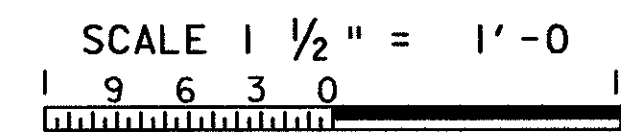



DELINEATION DEVICE DETAILS

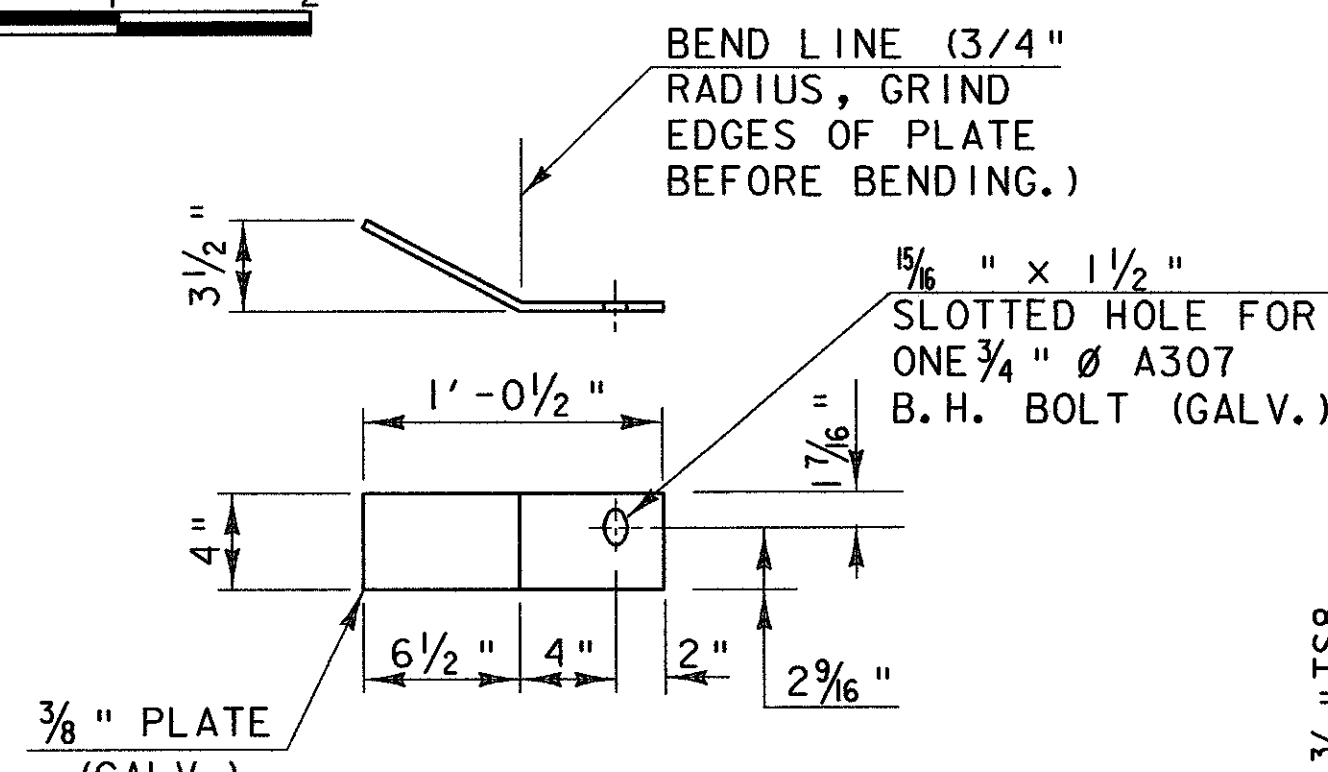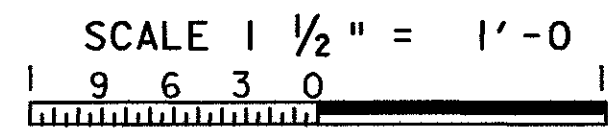

DEFLECTOR PLATE DETAIL

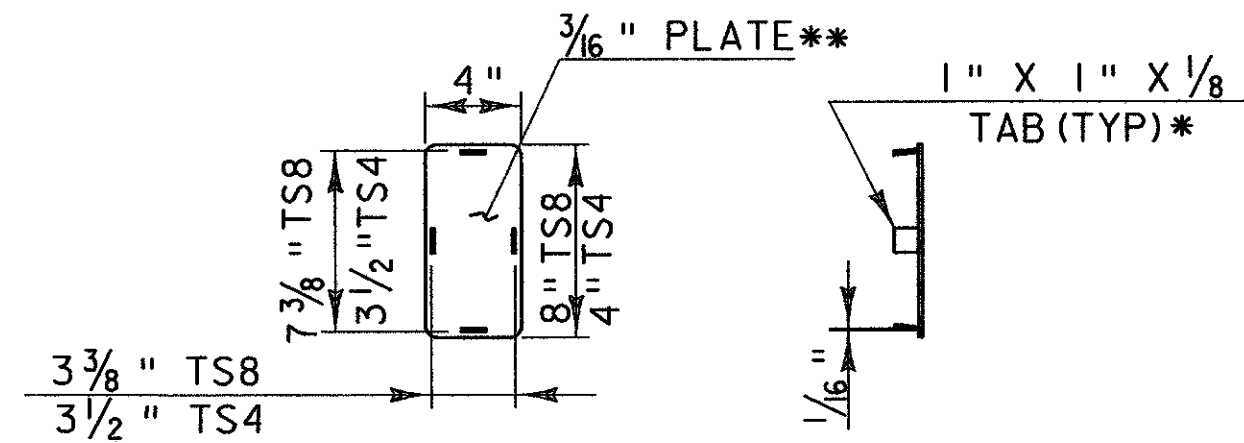
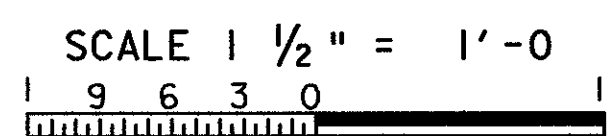


END CAP DETAIL

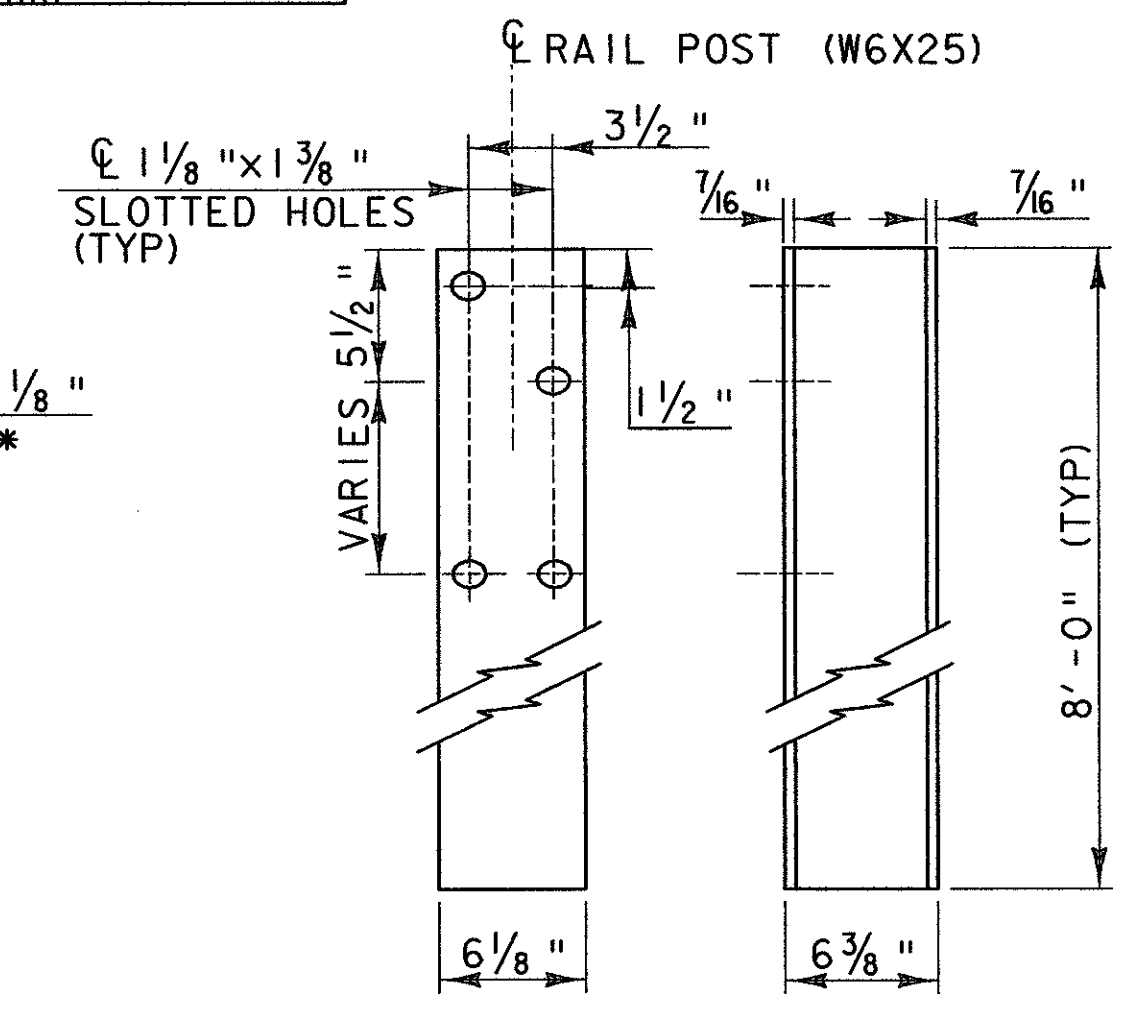
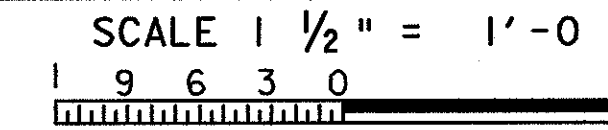


FRONT VIEW SIDE VIEW



RAIL POST

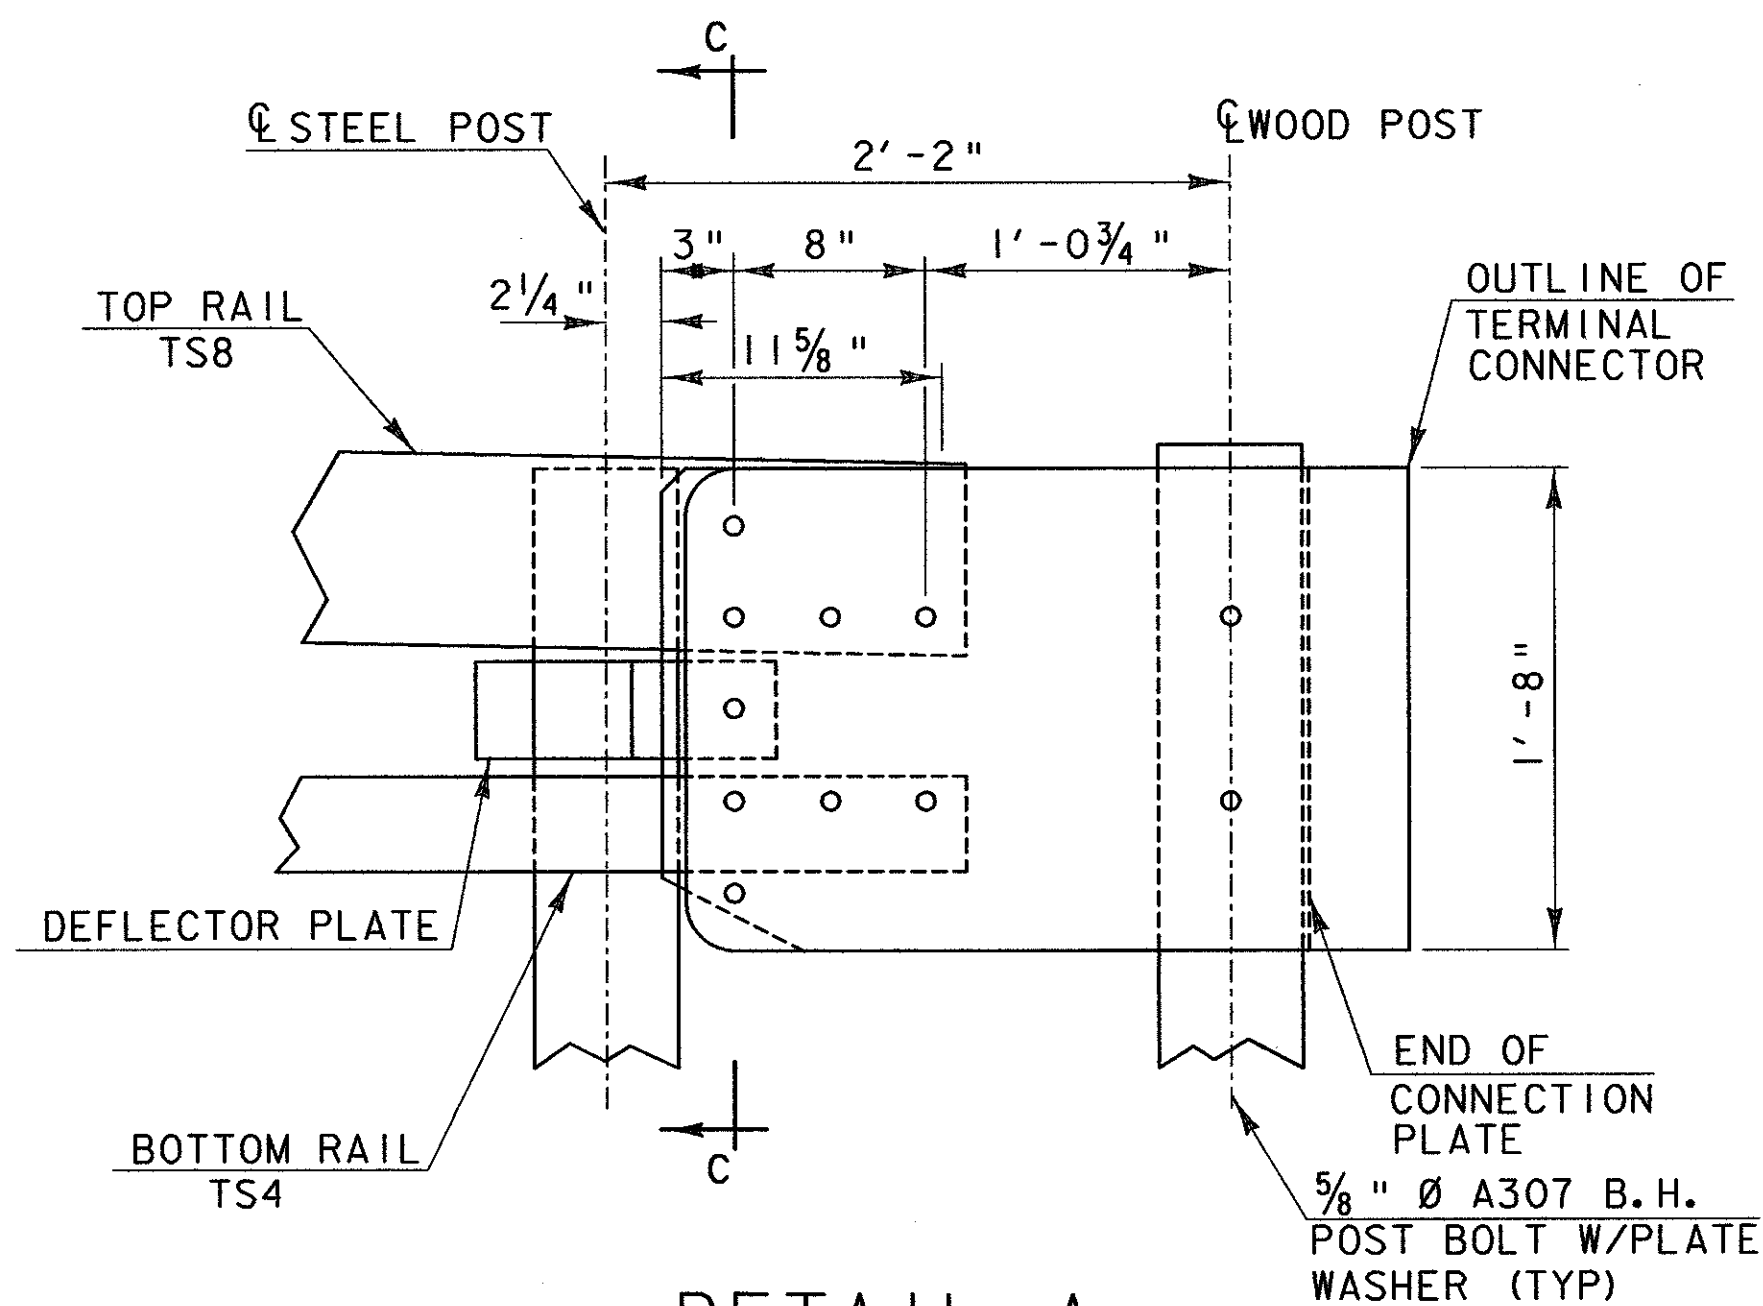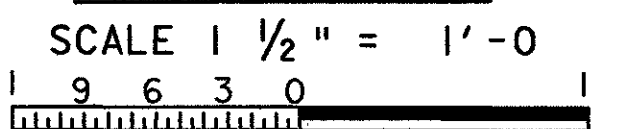

DETAIL A

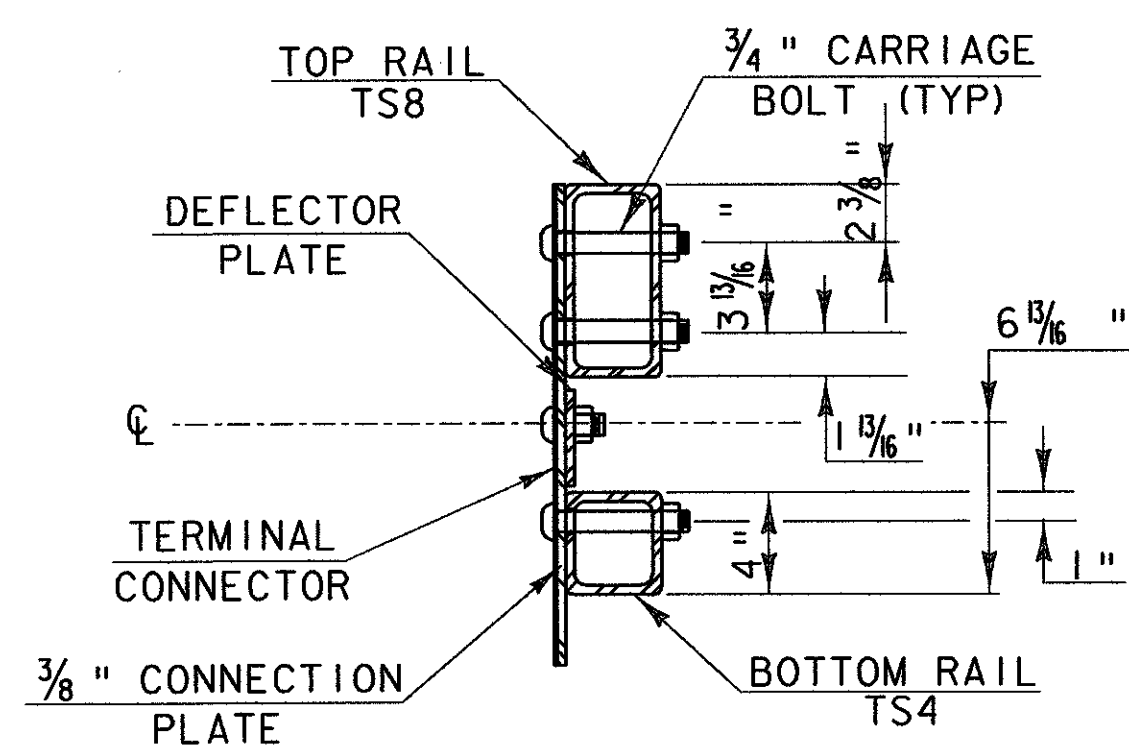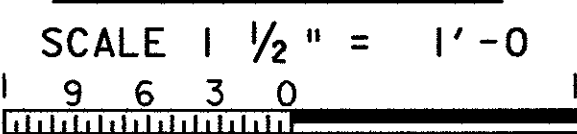

SECTION C-C (CONNECTION PLATE)

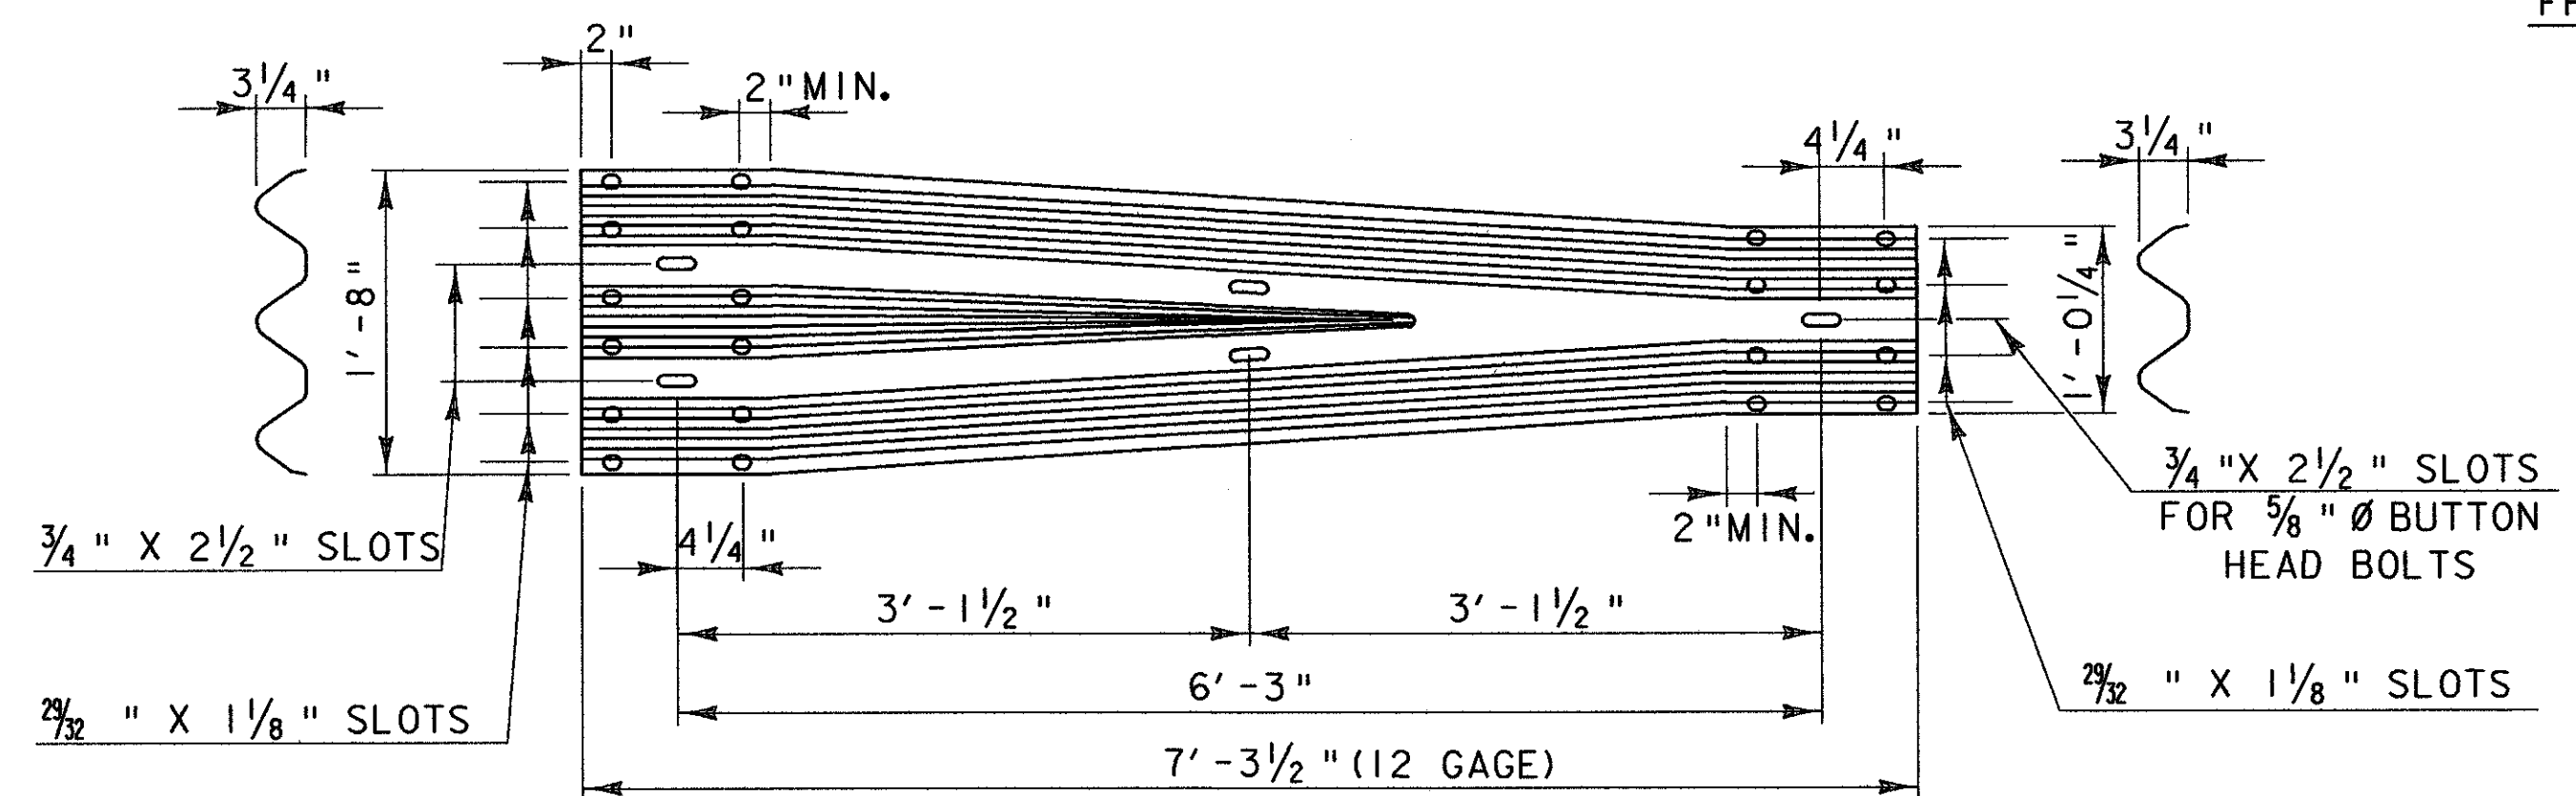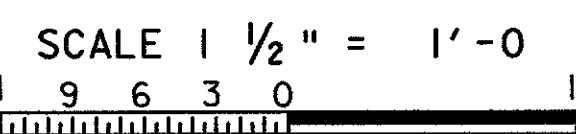


THREE-BEAM TO HDSB TRANSITION SECTION



\* WELD TABS TO END CAP PLATE IN TAPERED POSITION SO CAP CAN BE JAMMED INTO END OF RAIL TUBE.  
\*\* ROUND CORNERS 1/2\"/>

<b>STATE OF VERMONT AGENCY OF TRANSPORTATION</b>	
Town Of MIDDLESEX-BOLTON	Bridge No.
Highway No. I-89	Log Sta.
<b>GUARD RAIL APPROACH SECTION</b>	
<b>NETC 2 RAIL (SHEET 2 OF 2)</b>	
Designed By C.P. WILLIAMS	Drawn By D.G. BASSETT
Checked By S. FARNSWORTH	Bridge Design Supervisor J.P. HALSTEAD
Date 10/99	Date 10/99
PROJECT MIDDLESEX-BOLTON	PROJECT NO. IM-089-2(26)
TVGA CAD Drawing No. netambob	Date 10/99
Bridge Sheet No. C-46B	Sheet 46B of 307

## MILLED RUMBLE STRIPS U TURN DETAIL SHEET

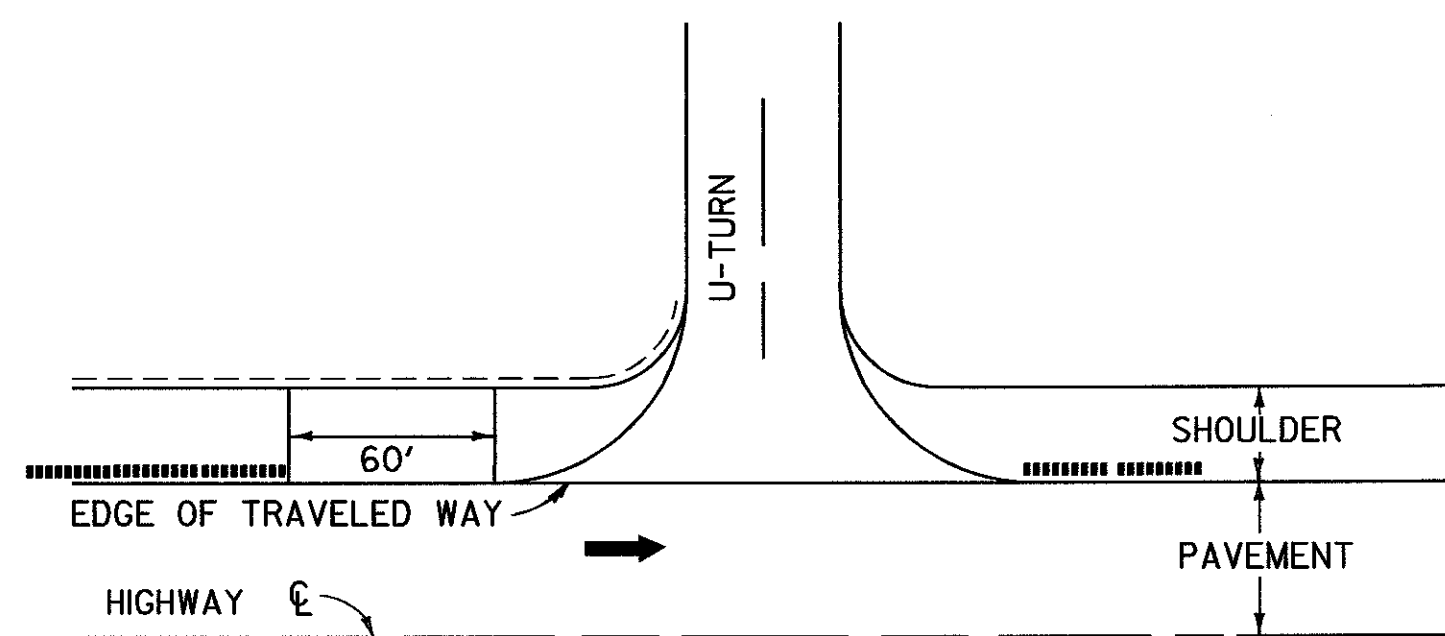


### LEGEND


- ➔ DIRECTION OF TRAFFIC FLOW
- ▬ MILLED RUMBLE STRIPS
- NOT TO SCALE

THIS DETAIL MAYBE MODIFIED AT THE RESIDENT ENGINEER DISCRETION IF ACTUAL FIELD CONDITIONS NECESSITATE SUCH ACTIONS.

## TYPICAL RUMBLE STRIP MILLING DETAIL

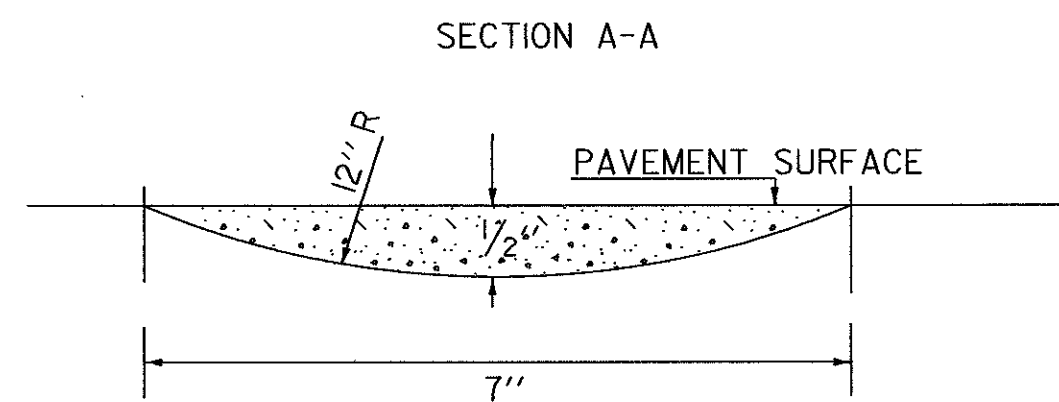


30" FROM EDGE LINE (WHITE OR YELLOW) FOR ALL SHOULDERS 6' OR WIDER  
6" FROM EDGE LINES (WHITE OR YELLOW) FOR ALL SHOULDERS LESS THAN 6' WIDE WITH NO GUARDRAIL.

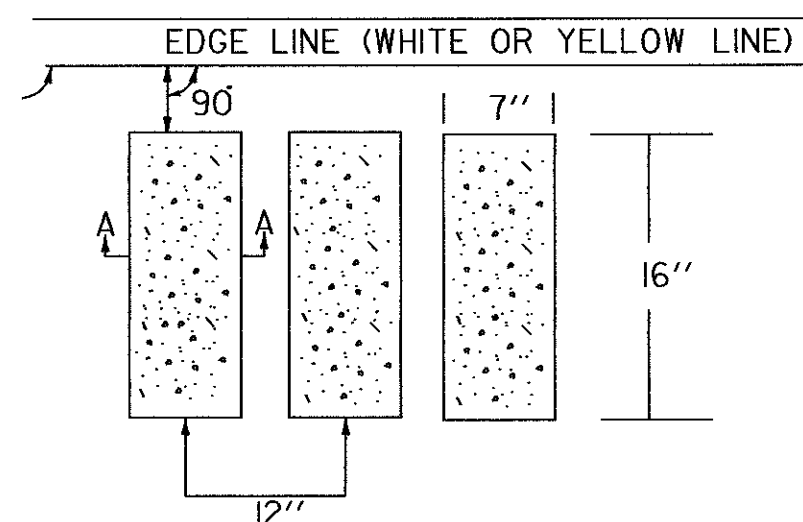

NOTE: STOP MILLED RUMBLE STRIPS WHEN GUARDRAIL IS WITHIN 4' OF TRAVEL WAY

## RUMBLE STRIP BRIDGE & DRAINAGE DETAIL

30" FROM EDGE LINE (WHITE OR YELLOW) FOR ALL SHOULDERS 6' OR WIDER  
6" FROM EDGE LINE (WHITE OR YELLOW) FOR ALL SHOULDERS LESS THAN 6' WIDE WITH NO GUARDRAIL ON LEFT SIDE


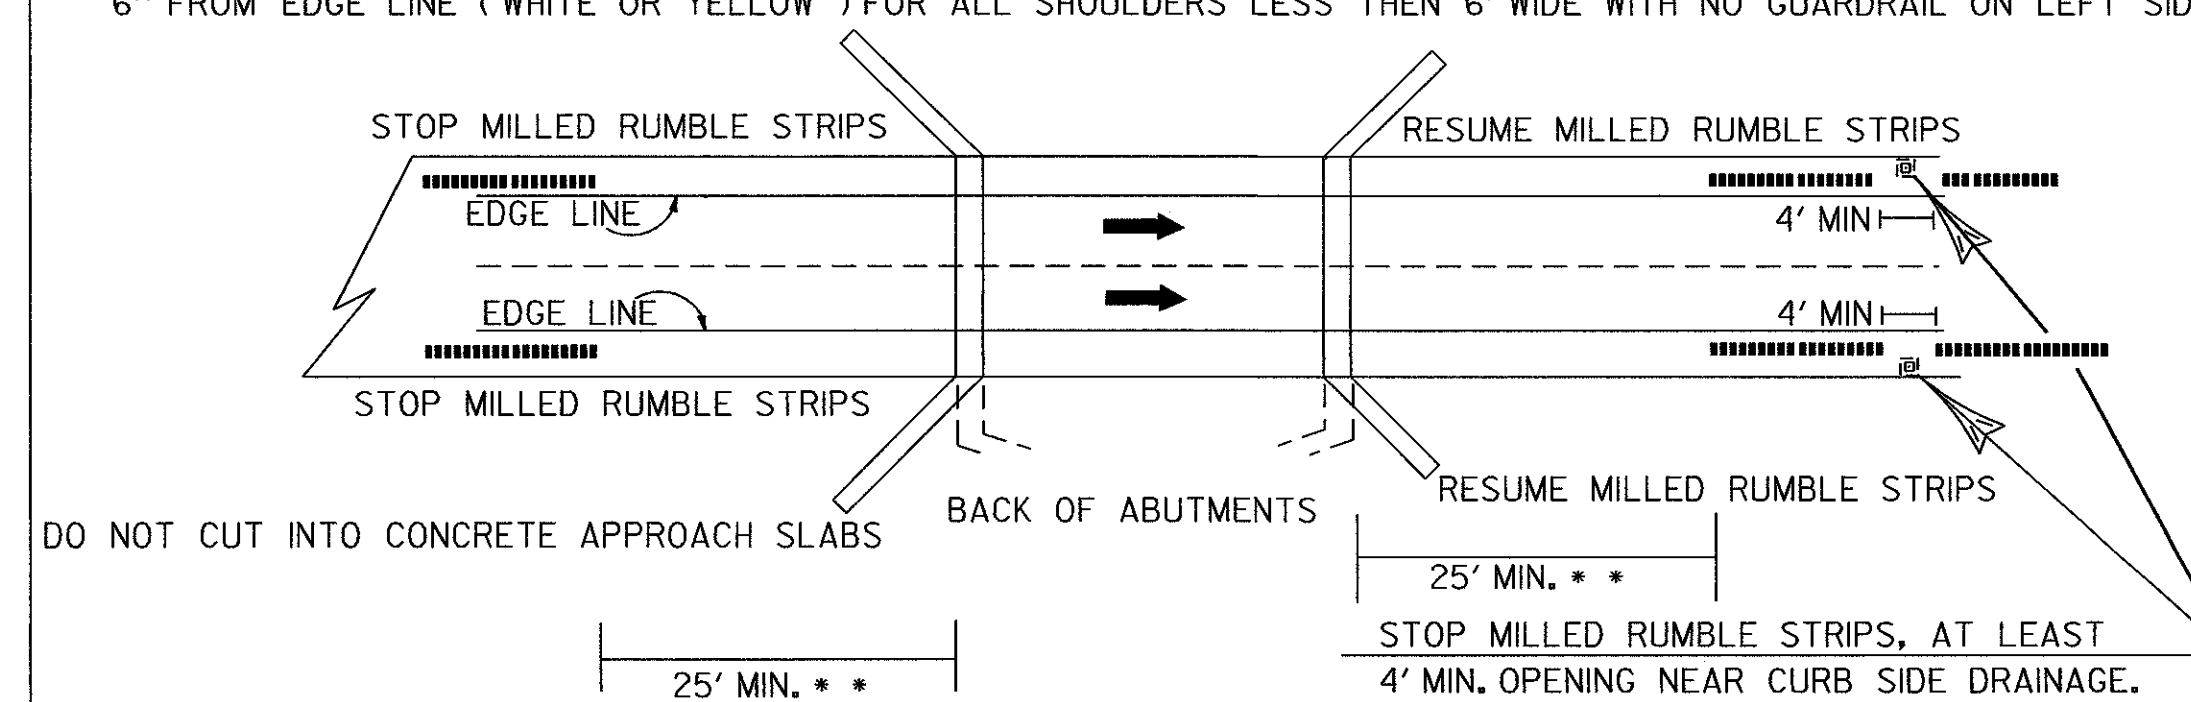


• • NOTE: 4' OFFSET TO APPROACH RAIL WILL DETERMINE MINIMUM DISTANCE IN SOME CASES.

### LEGEND

- ➔ DIRECTION OF TRAFFIC FLOW
- ▬ MILLED RUMBLE STRIPS
- NOT TO SCALE

## TYPICAL RUMBLE STRIP MILLING AT INTERCHANGES & REST AREAS

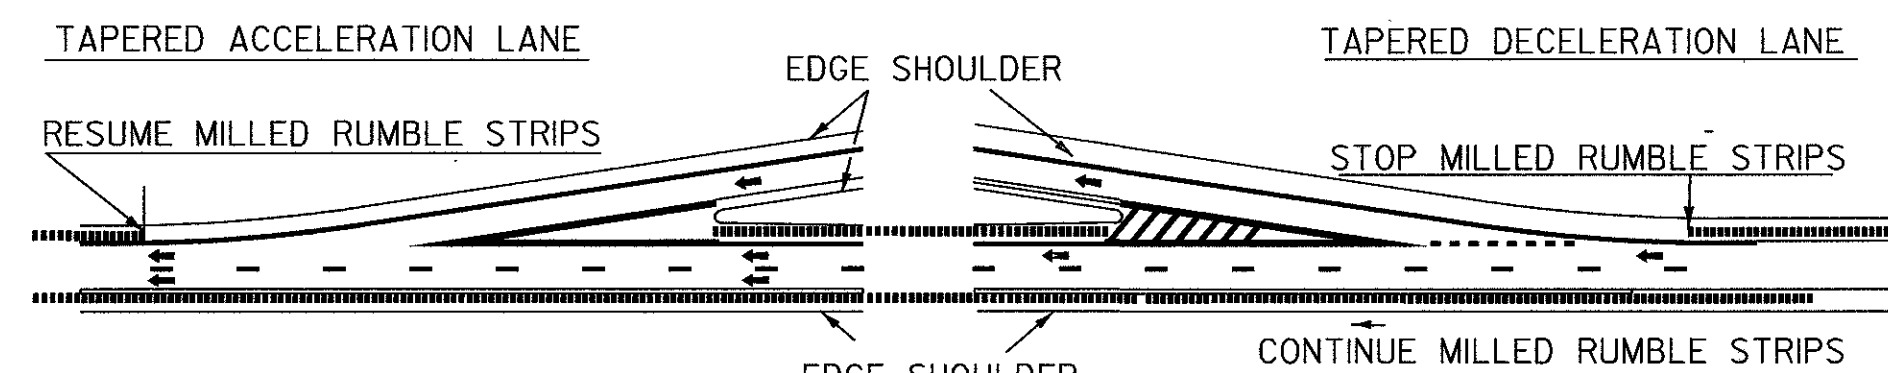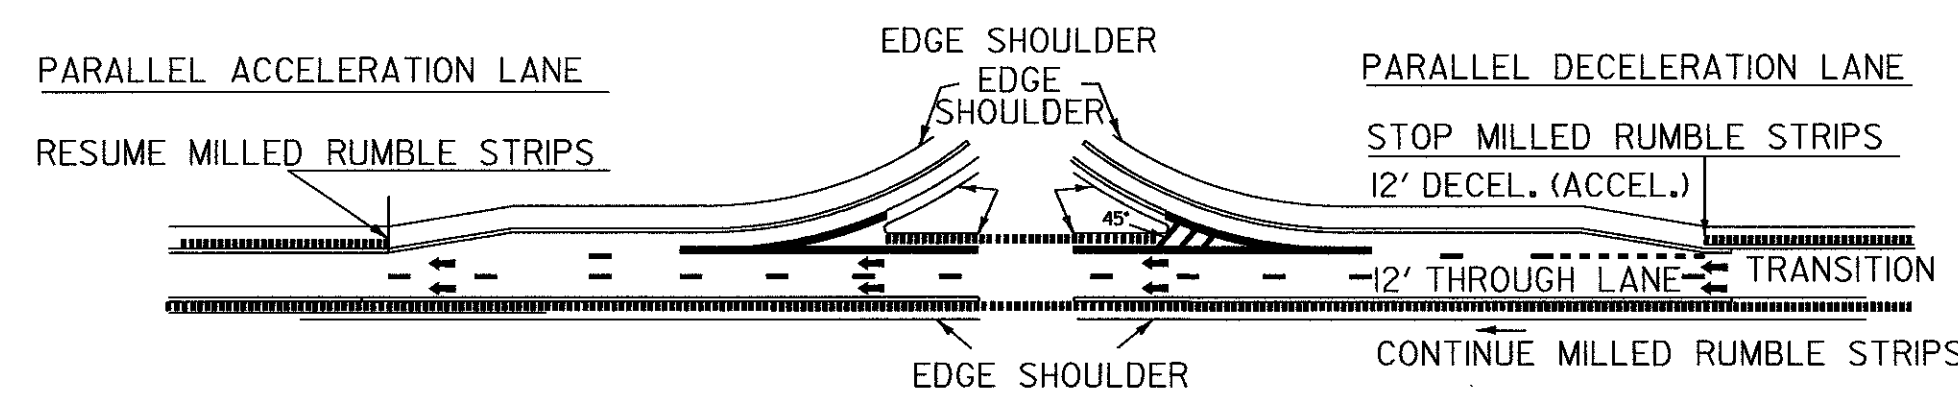

### LEGEND

- ➔ DIRECTION OF TRAFFIC FLOW
- ▬ MILLED RUMBLE STRIPS
- NOT TO SCALE

LOCATION OF STRIPS WILL VARY DEPENDING ON GUARDRAIL AND BRIDGE PRESENCE.  
THIS TYPICAL MAYBE MODIFIED AT THE RESIDENT ENGINEER DISCRETION IF ACTUAL FIELD CONDITIONS NECESSITATE SUCH ACTIONS.

1. MILLED RUMBLE STRIPS ARE TO BE INSTALLED AS DETAILED ON THIS SHEET UNLESS OTHERWISE APPROVED BY THE VTRANS PROJECT ENGINEER AND/OR VTRANS CONSULTANT PROJECT MANAGER.
2. IF MILLED RUMBLE STRIPS ARE ALREADY IN PLACE WHERE A CROSS-OVER IS TO BE CONSTRUCTED BETWEEN TWO LANES, THEN FOLLOWING APPLIES:
  - A. THE EXISTING MILLED RUMBLE STRIPS ARE NOT TO BE REMOVED OR FILLED IN MORE THEN TWO WEEKS BEFORE THE ACTUAL CROSS-OVER IS TO BE PLACED IN USE.
  - B. ONCE THE CROSSOVER FOR THE PHASE IT IS DESIGN FOR IS TAKEN OUT OF USE THE CONTRACTOR HAS A MAXIMUM OF THIRTY DAYS (30) TO CUT NEW MILLED RUMBLE STRIPS INTO THE MEDIAN SHOULDER.
  - C. MILLED RUMBLE STRIPS SHOULD BE STOPPED AT THE BEGINNING OF A CROSSOVER AS DETAILED FOR TAPERED DECELERATION LANE.

## STATE OF VERMONT AGENCY OF TRANSPORTATION

Town Of	MIDDLESEX-BOLTON	Bridge No.	---
Highway No.		Log Sta.	---
		Surv. Sta.	---


### RUMBLESTRIP DETAILS

Designed By	AL JONES	Drawn By	AL JONES
Checked By	S. FARNSWORTH	Date	8/00
		Bridge Design Supervisor	S. FARNSWORTH
		Date	8/00

PROJECT	MIDDLESEX-BOLTON	PROJECT NO.	1M 089-2 (26)
---------	------------------	-------------	---------------

I.G.C. Info.	Bridge Sheet No.	C-46C	Sheet 46C of 307
--------------	------------------	-------	------------------

**BEGIN APPROACH**  
43S STA. 1+60  
PROJECT EXTENDED BY 185 FT  
(25 FT AHEAD OF STATION 0+00)  
BEGIN MILL AND OVERLAY  
(MATCH EXISTING)

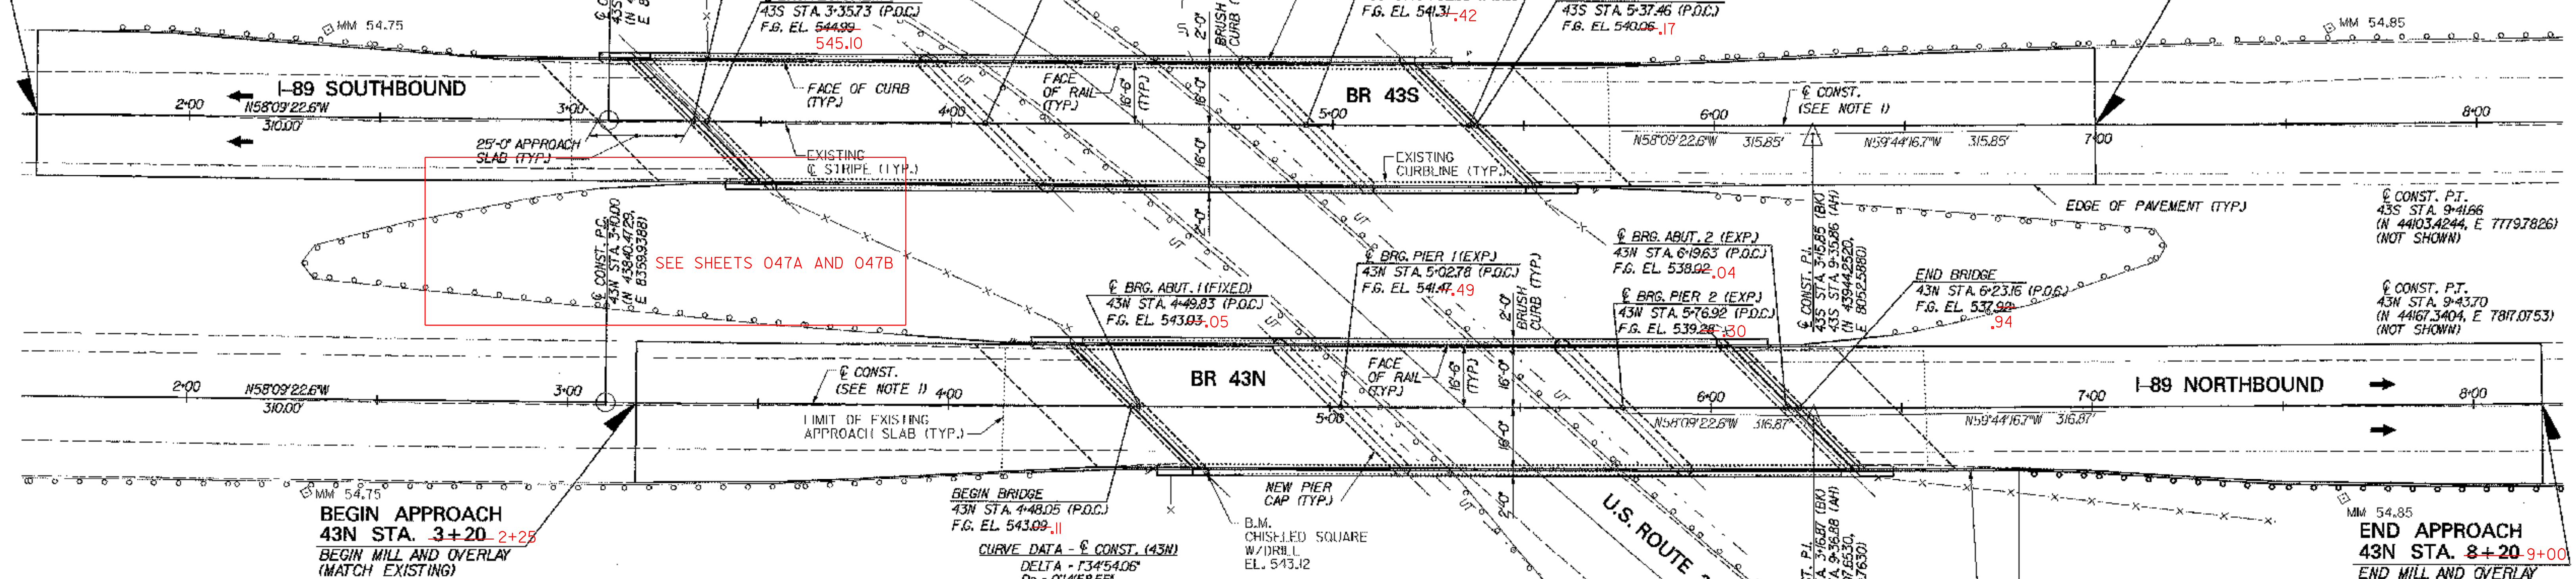

**CURVE DATA - C CONST. (43S)**  
DELTA = 134°54.06'  
Dc = 015°01.46'  
R = 22881.32'  
T = 315.85'  
L = 631.65'  
E = 2.18'

RAISED 43S FINISH GRADE 1 3/8"  
RAISED 43N FINISH GRADE 1/4"


**LOAD RATING (TONS)**

LOADING LEVELS (LOAD FACTOR)	BRIDGE NO.	TRUCK					
		H	HS	3S2	3A. STR.	4A. STR.	5A. SEMI
INVENTORY A= 2.17; B= 1.00	43N/43S	*26/*29	*47/*51				
POSTED A= 1.55; B= 1.40	43N/43S	*36/*41	*66/*72	*86/*89	*61/*65	*63/*66	*79/*80
OPERATING A= 1.30; B= 1.67	43N/43S	*78/*85	*101/*105	*96/*115	*73/*77	*75/*78	

NOTE: RATINGS ARE BASED ON A STRAIGHT-LINE GIRDER ANALYSIS, DIVIDED BY 1.05 TO ACCOUNT FOR THE EFFECTS OF CURVATURE.

STRENGTH RF =  $\frac{\phi M_u - 1.3 M_{DL}}{A X M_{LL1}}$  \* SERVICEABILITY RF =  $B \left[ \frac{0.95 F_y S_{LL1} - M_{DL} S_{LL1} - M_{SSL} S_{LL1}}{167 M_{LL1}} \right]$

BRIDGE	CL CONST. @	STATION	NORTHING	EASTING
43N	BEGIN BRIDGE	4+48.05	43912.8626	8242.4533
	CL BRG. ABUT. 1	4+49.83	43913.8830	8240.9347
	CL BRG. PIER 1	5+02.78	43941.4931	8195.7530
	CL BRG. PIER 2	5+76.92	43979.9770	8132.3833
	CL BRG. ABUT. 2	6+19.63	44002.0536	8095.8215
	END BRIDGE	6+23.16	44003.8739	8092.7999
43S	BEGIN BRIDGE	3+32.17	43789.2952	8302.0827
	CL BRG. ABUT. 1	3+35.73	43791.1710	8299.0352
	CL BRG. PIER 1	4+08.85	43829.5802	8236.8157
	CL BRG. PIER 2	4+92.95	43873.5109	8165.1017
	CL BRG. ABUT. 2	5+35.70	43895.7408	8128.6881
	END BRIDGE	5+37.46	43896.6558	8127.0793

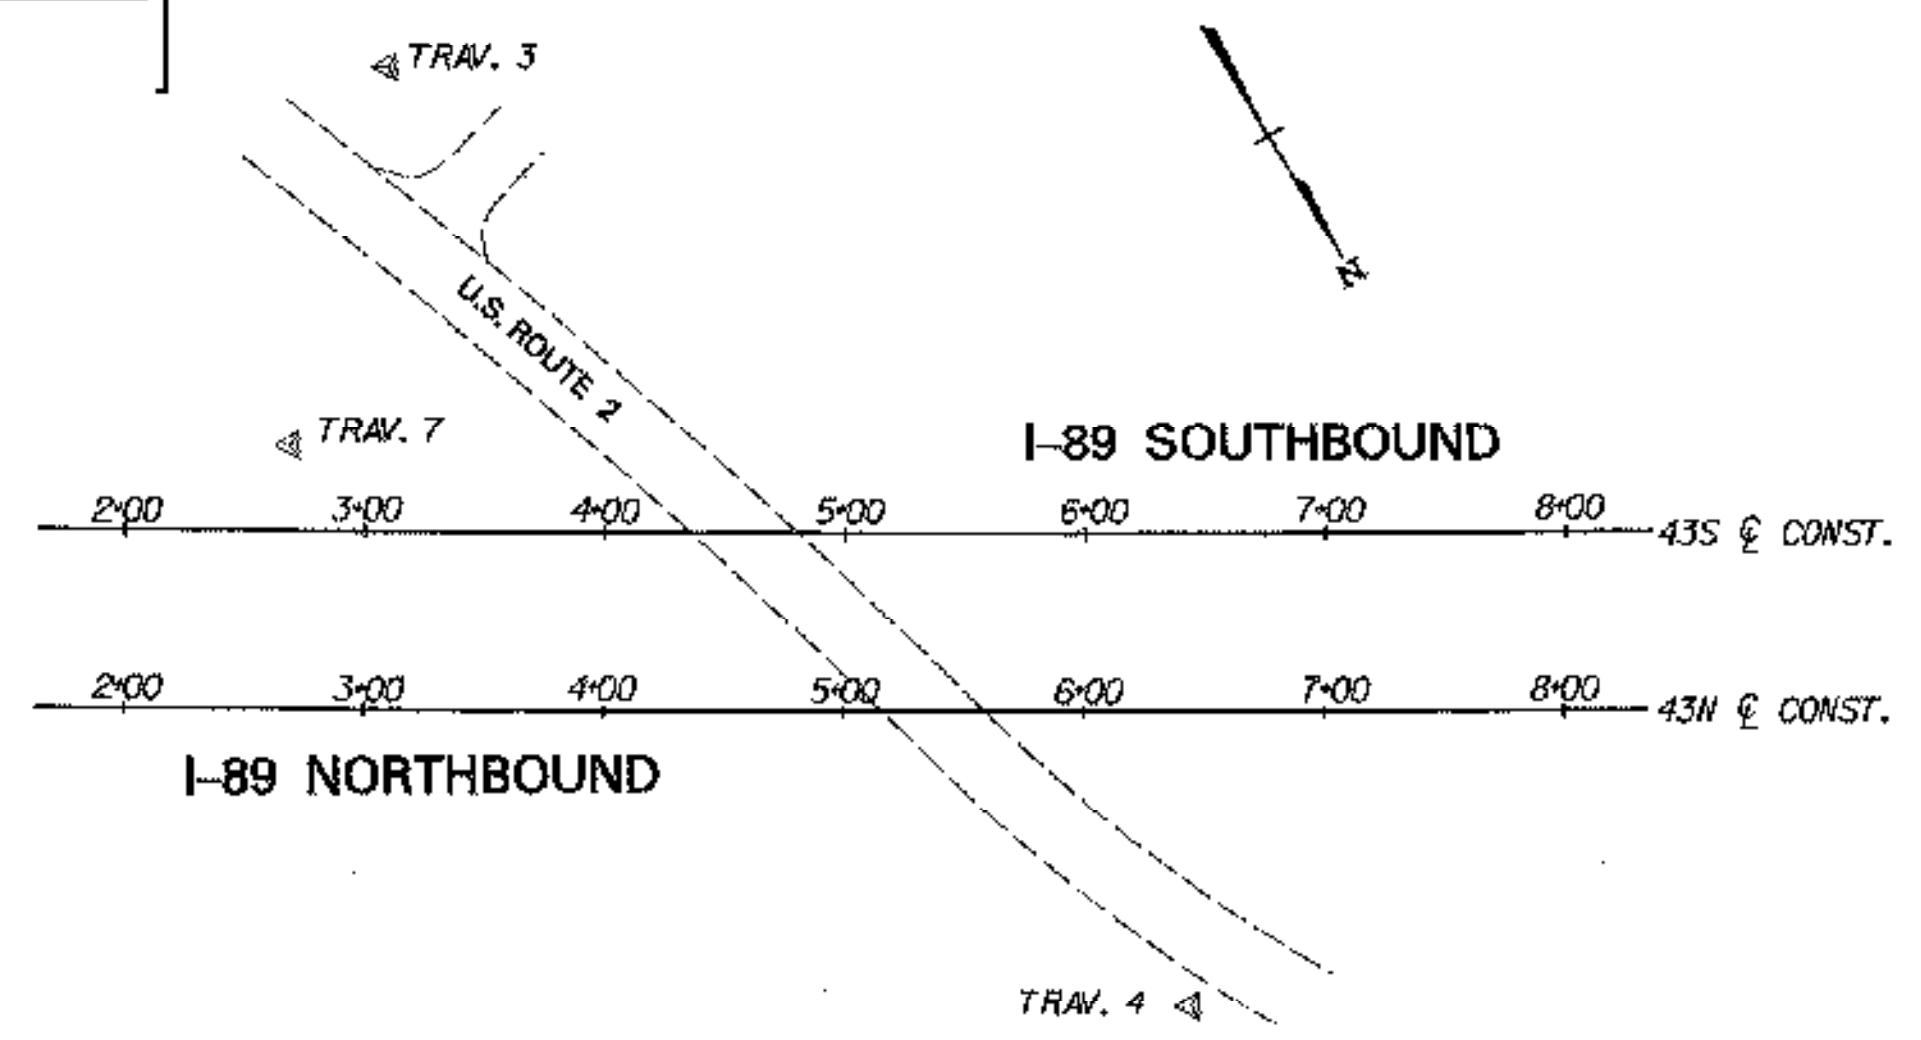

**PLAN**  
SCALE: 1"=20'

**BR 43N&S SPECIFIC CONSTRUCTION NOTES:**

1. THE PROPOSED CONSTRUCTION CENTERLINE FOR EACH BRIDGE WAS ESTABLISHED BASED ON BEST FIT BETWEEN EXISTING CURB LINES. IT DOES NOT EXACTLY MATCH THE ORIGINAL CONSTRUCTION CENTERLINE.
2. FOR CONTROL POINT TIE SKETCHES, SEE CONTROL POINT TIES (43N&S), BRIDGE SHEET C-10.
3. REPLACE PIER CAPS, SUPERSTRUCTURE STEEL, BEARINGS, DECK SLABS, APPROACH SLABS, BRIDGE RAIL AND APPROACH RAIL. RESET GUARD RAIL.
4. NEW SCUPPERS ARE REQUIRED ON BRIDGE 43N. FOR LOCATIONS OF NEW SCUPPERS, SEE FRAMING PLAN (43N), BRIDGE SHEET BR43-8.
5. CONSTRUCT NEW BACKWALLS AT EXPANSION ABUTMENTS AND NEW CURTAINWALLS AT FIXED ABUTMENTS. REBUILD ABUTMENT BRIDGE SEATS AND MODIFY WINGWALLS AS SHOWN IN THE PLANS.
6. REPAIR ALL PIER COLUMNS AND APPLY FIBER REINFORCED POLYMER (FRP) COLUMN WRAP.
7. REPAIR ABUTMENT DELAMINATED AND SPALLED AREAS.
8. REPLACE DAMAGED GUARD RAIL IMMEDIATELY NORTHEAST OF BR 43N. REPLACED BY DISTRICT BEFORE THE PROJECT BEGAN.
9. RE-STRIPE BRIDGE AND APPROACH ROADWAY.

**STATE OF VERMONT**  
**AGENCY OF TRANSPORTATION**

Town Of **MIDDLESEX-BOLTON** Bridge No. **43N&S**

Highway No. **I-89** Log Sta. **I-89 OVER U.S. ROUTE 2**

**GENERAL PLAN (43N&S)**

Designed By **P.W. SZUSTAK** Drawn By **R.A. BOTZENHART**

Checked By **J.P. HALSTEAD** Date **10/99** Bridge Design Supervisor **J.P. HALSTEAD** Date **10/99**

PROJECT **MIDDLESEX-BOLTON** PROJECT NO. **IM-089-2(26)**

TVGA CAD Drawing No. **43gen.pl** Date **10/99**

Bridge Sheet No. **BR43-1** Sheet **47 of 307**



N.T.S.  
(SEE NOTE 2)

# BRIDGE 435


SCALE: 1" = 4'

NEW D.I.

56.5'

EXISTING D.I.

435 TROUGH

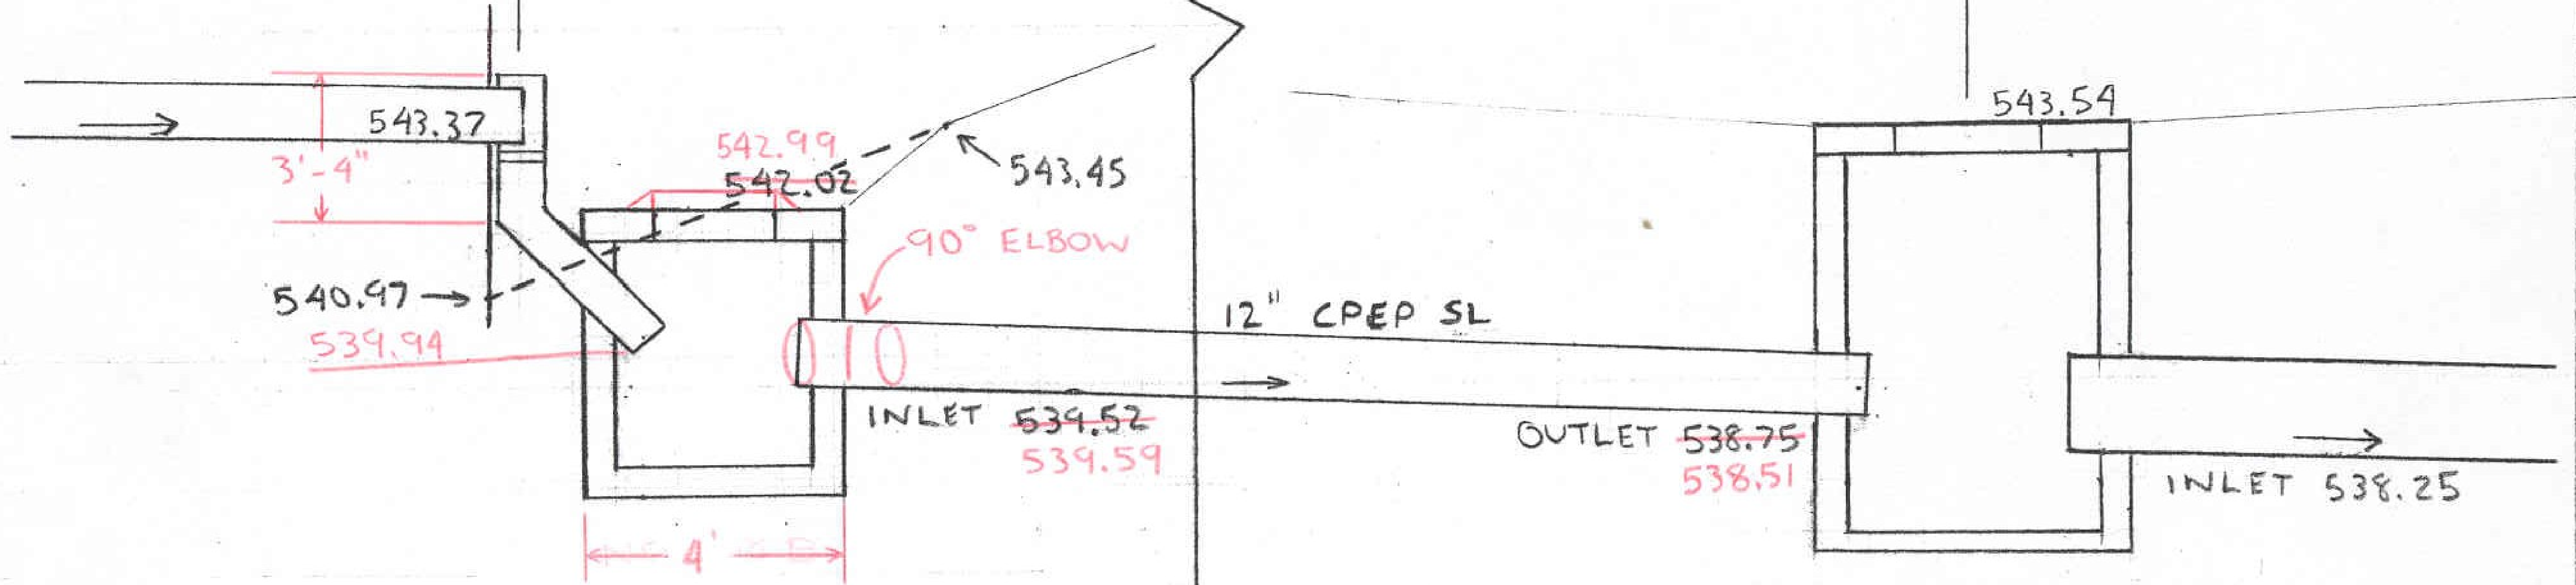

TM  
11/11/02

SOUTHBOUND

BRIDGE 43 N

FACE OF (TYP) 3/2

3+00

ABUTMENT

25'-0" APPROACH SLAB (TYP)

EXISTING C STRIPE

NEW D.I.

DOWN SPOT FOR EXPANSION DAM

EXISTING D.I.

12" CPEP SL


90° ELBOW


3+00

047B


C CONS (SEE M

LIMIT OF EX

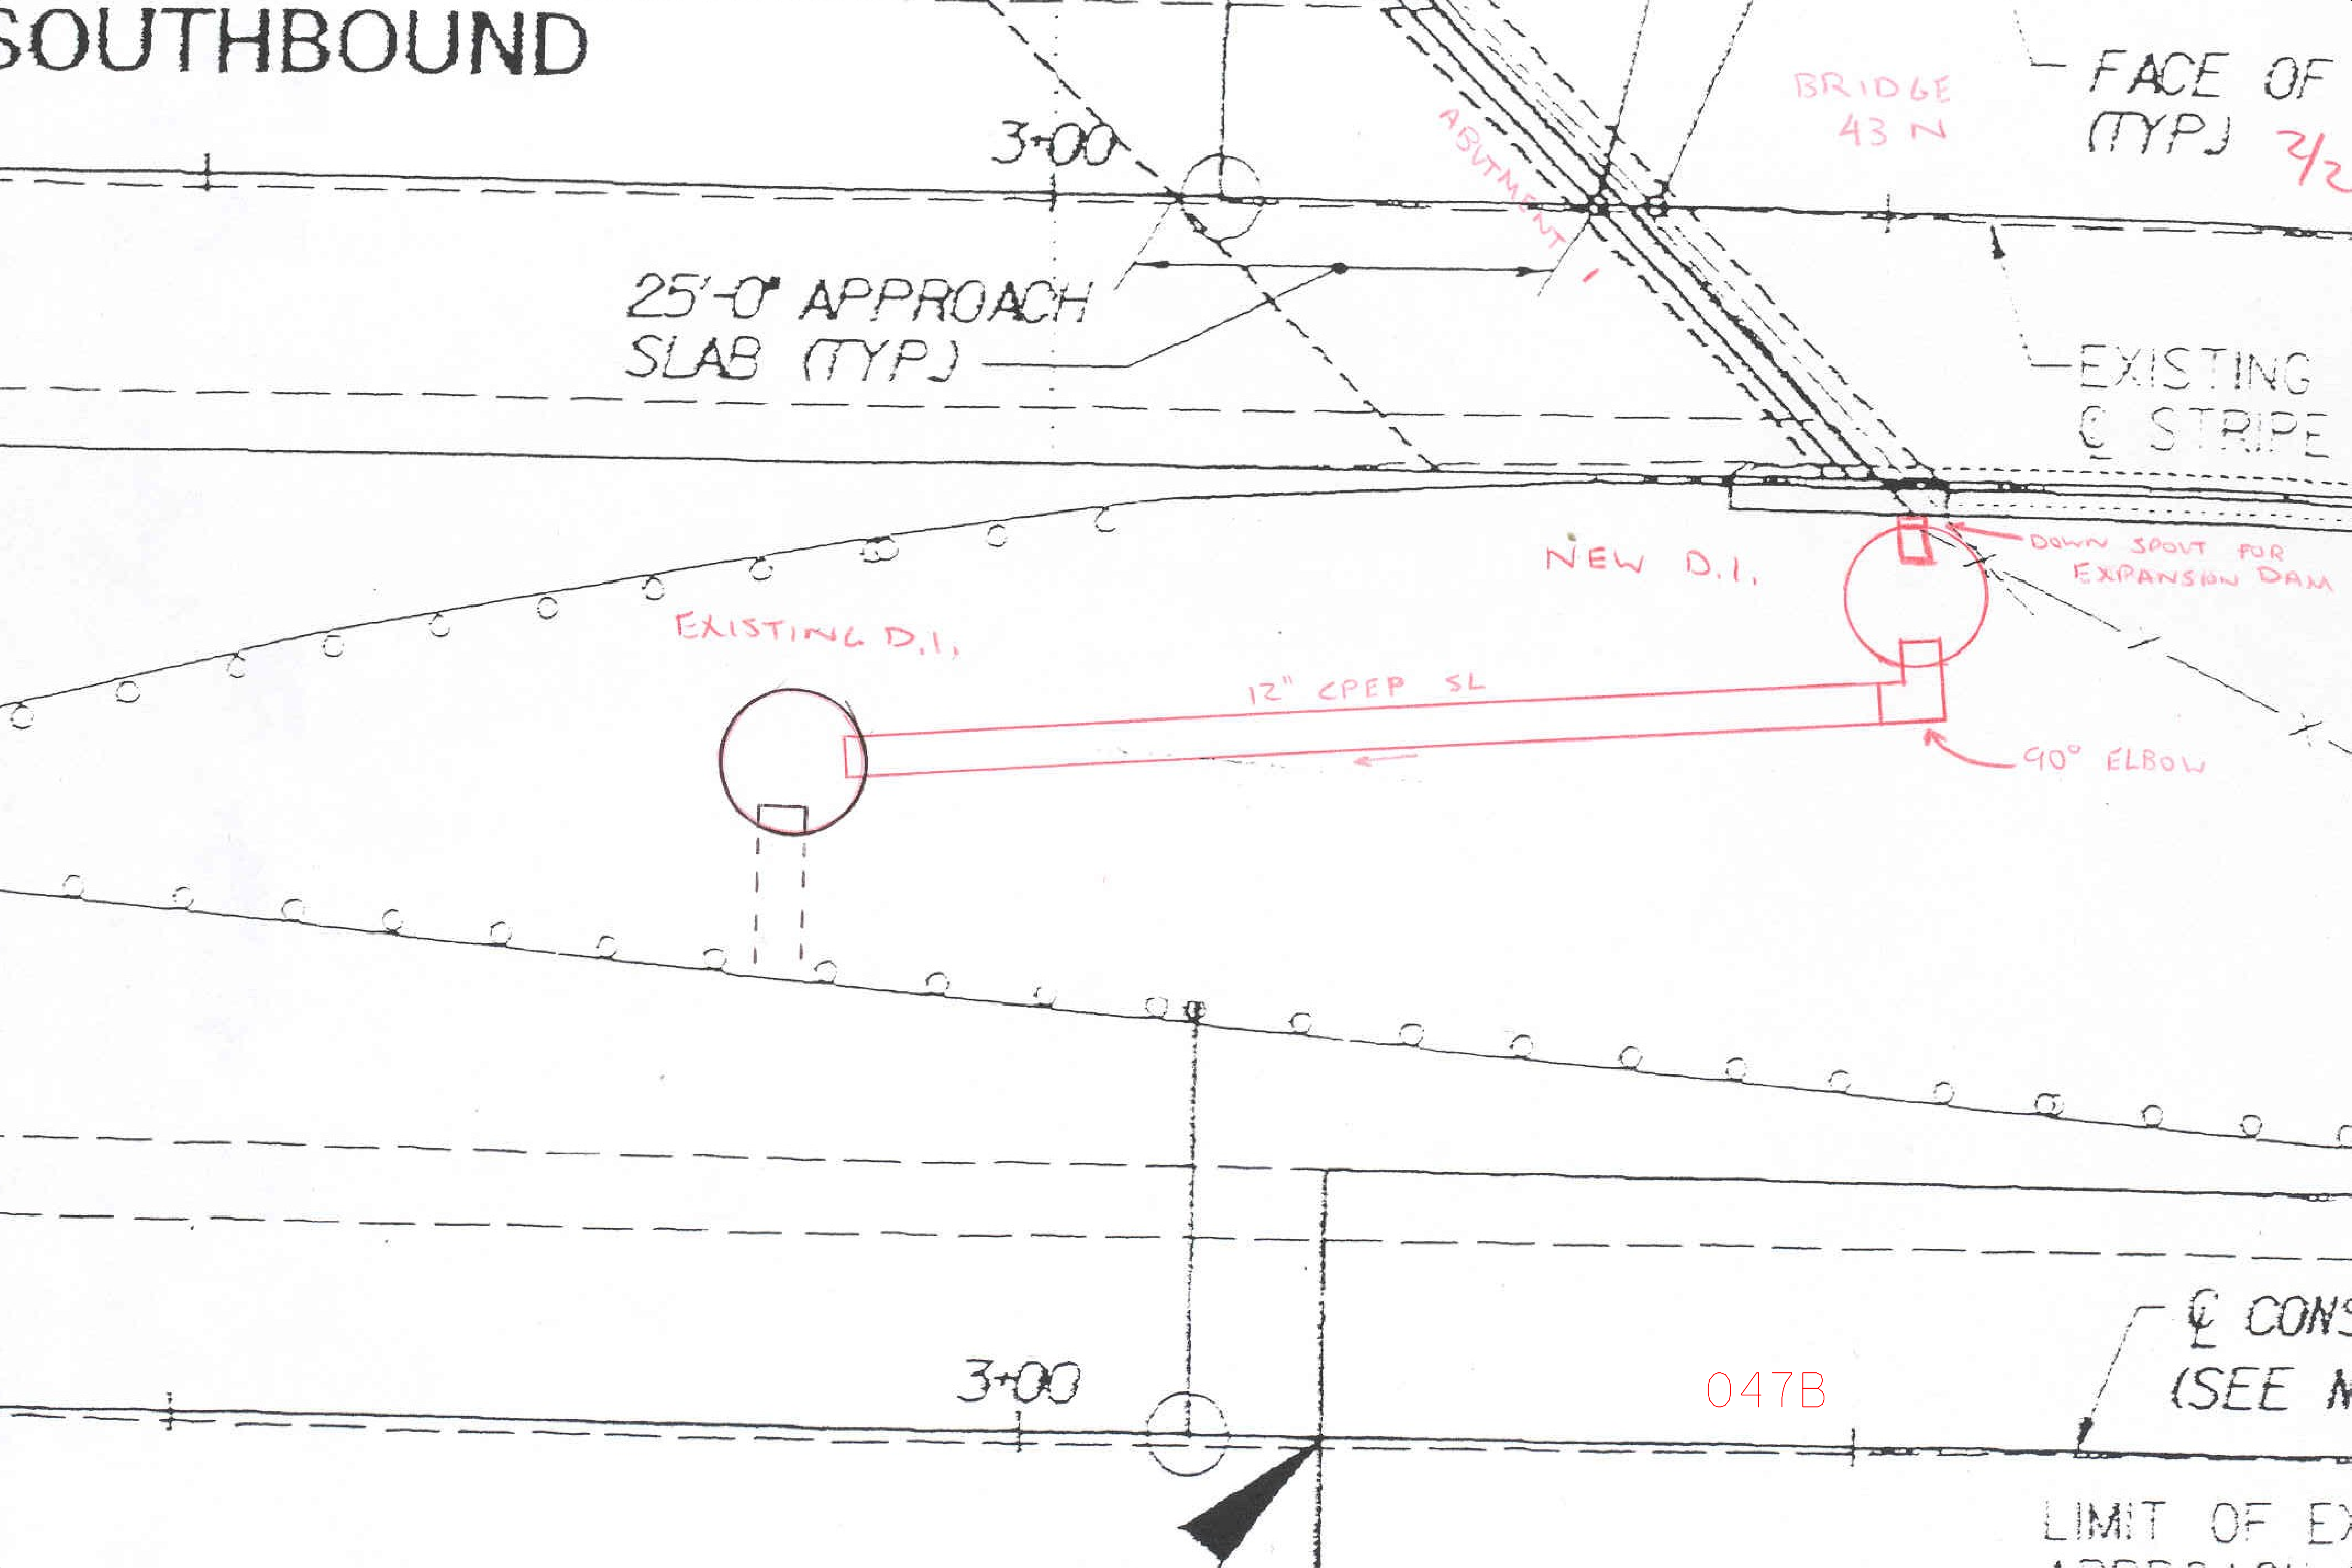



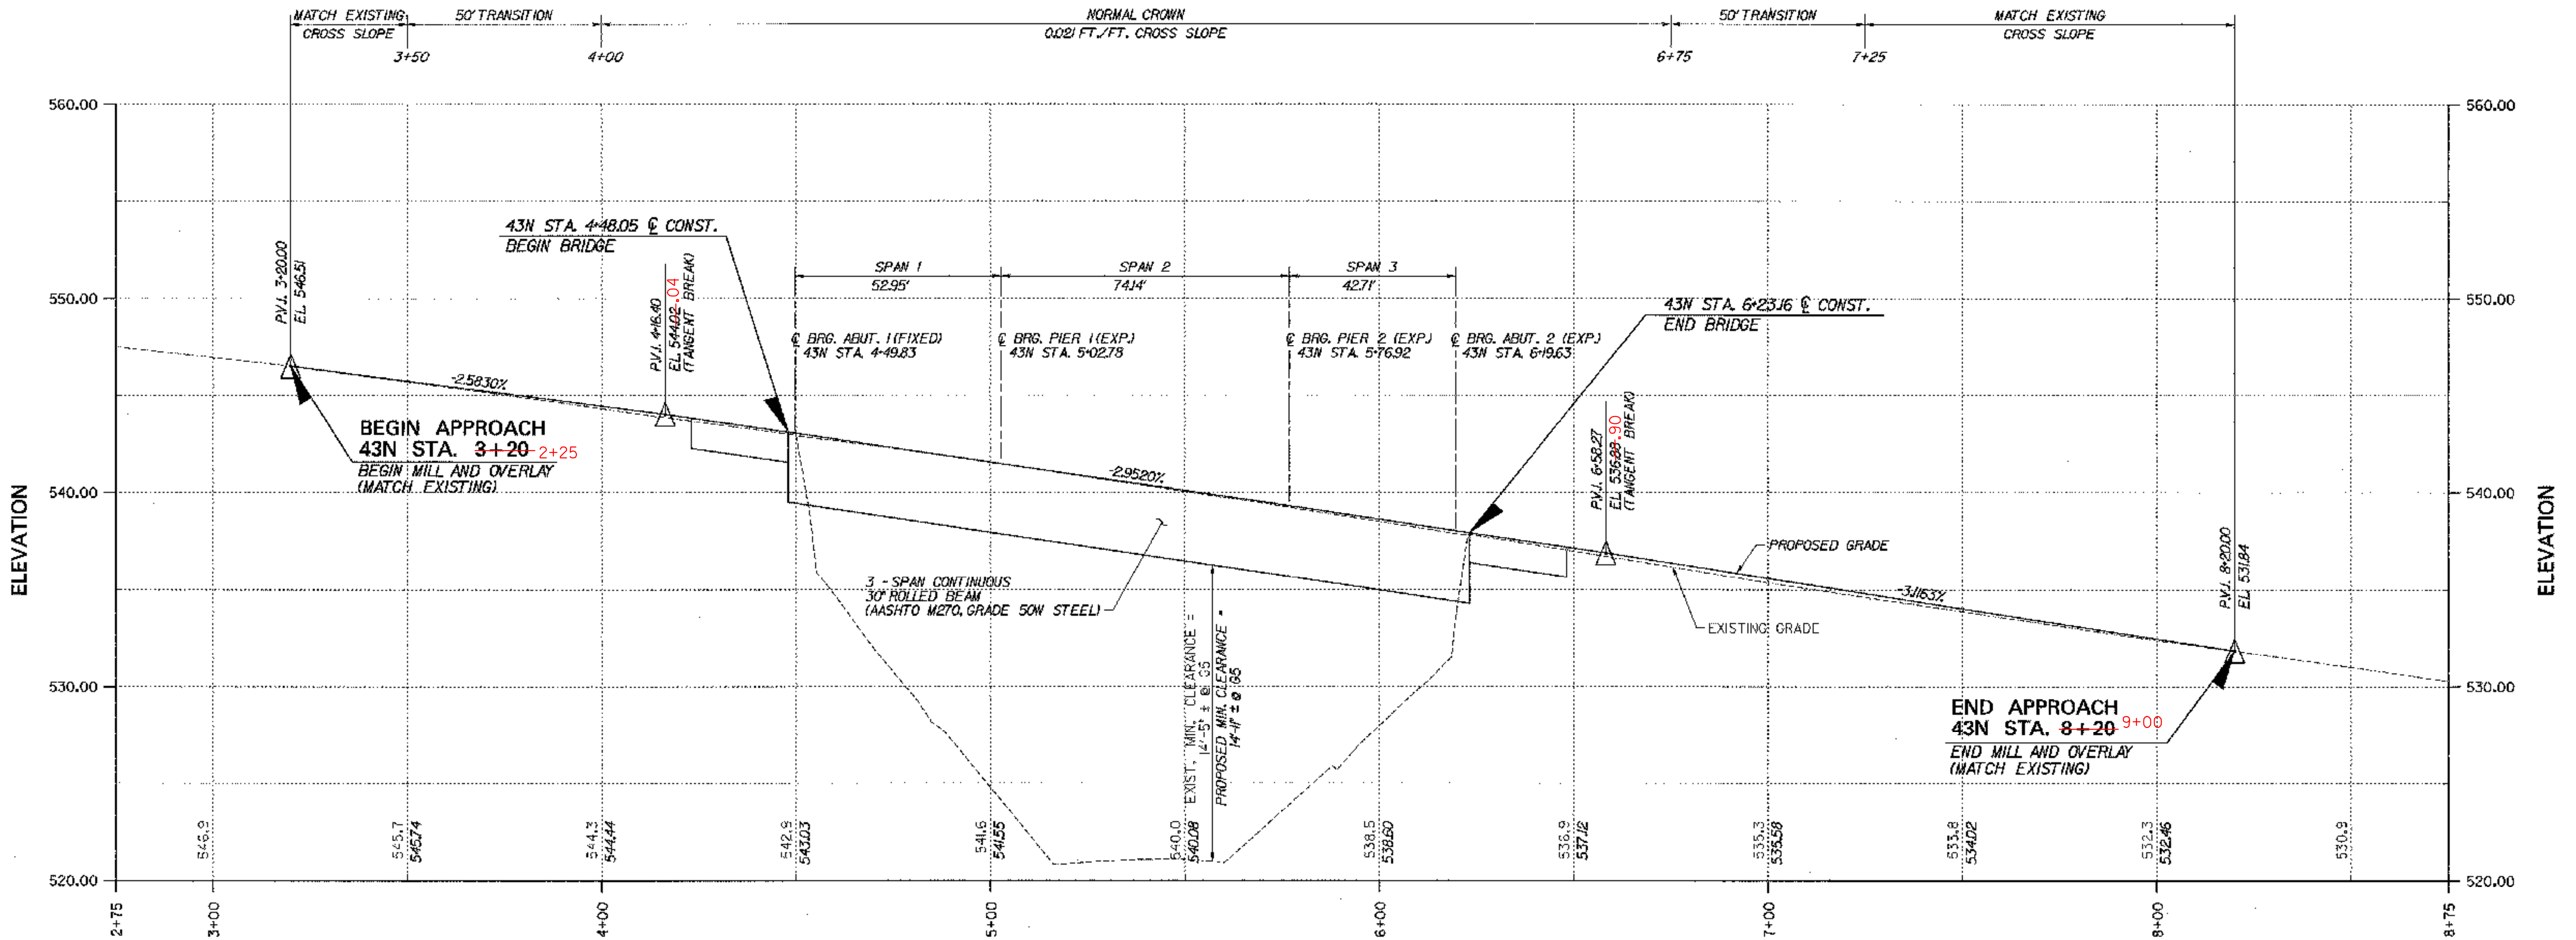


STATION  
**PROFILE - BR 43N**  
 RAISED FINISH GRADE 1/4"

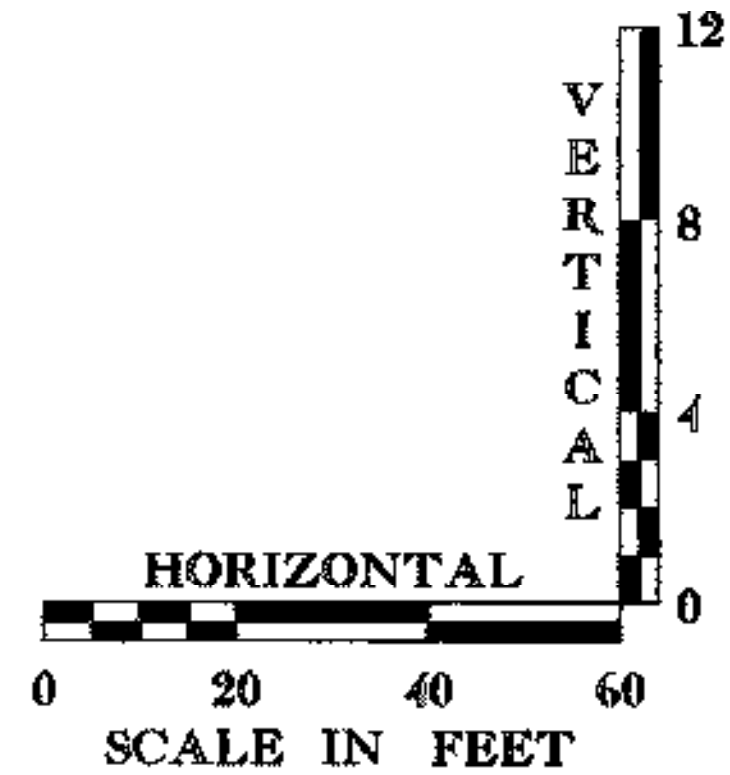



<b>STATE OF VERMONT AGENCY OF TRANSPORTATION</b>	
Town Of <b>MIDDLESEX-BOLTON</b>	Bridge No. <b>43N</b>
Highway No. <b>I-89</b>	Log Sta. Surv. Sta.
<b>I-89 NB OVER U.S. ROUTE 2</b>	
<b>PROFILE (43N)</b>	
Designed By <b>P.W. SZUSTAK</b>	Drawn By <b>R.A. BOTZENHART</b>
Checked By <b>J.P. HALSTEAD</b>	Bridge Design Supervisor Date <b>10/99</b>
PROJECT <b>MIDDLESEX-BOLTON</b>	PROJECT NO. <b>IM-089-2(26)</b>
TVGA CAD Drawing No. <b>43pro1f</b>	Date <b>10/99</b>
Bridge Sheet No. <b>BR43-2</b>	Sheet <b>48</b> of <b>307</b>

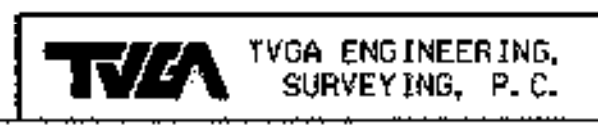

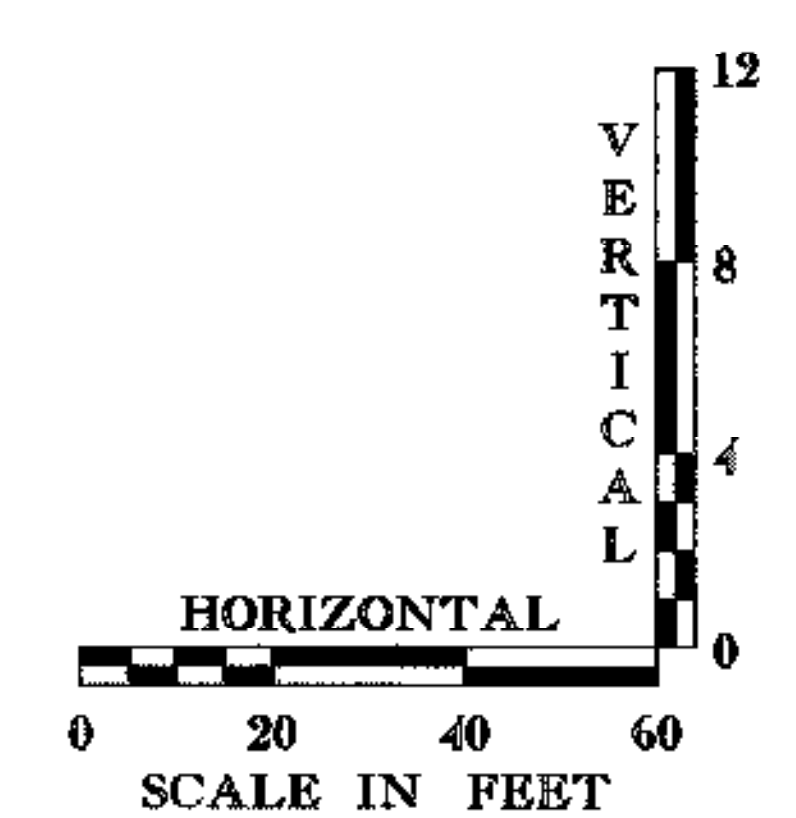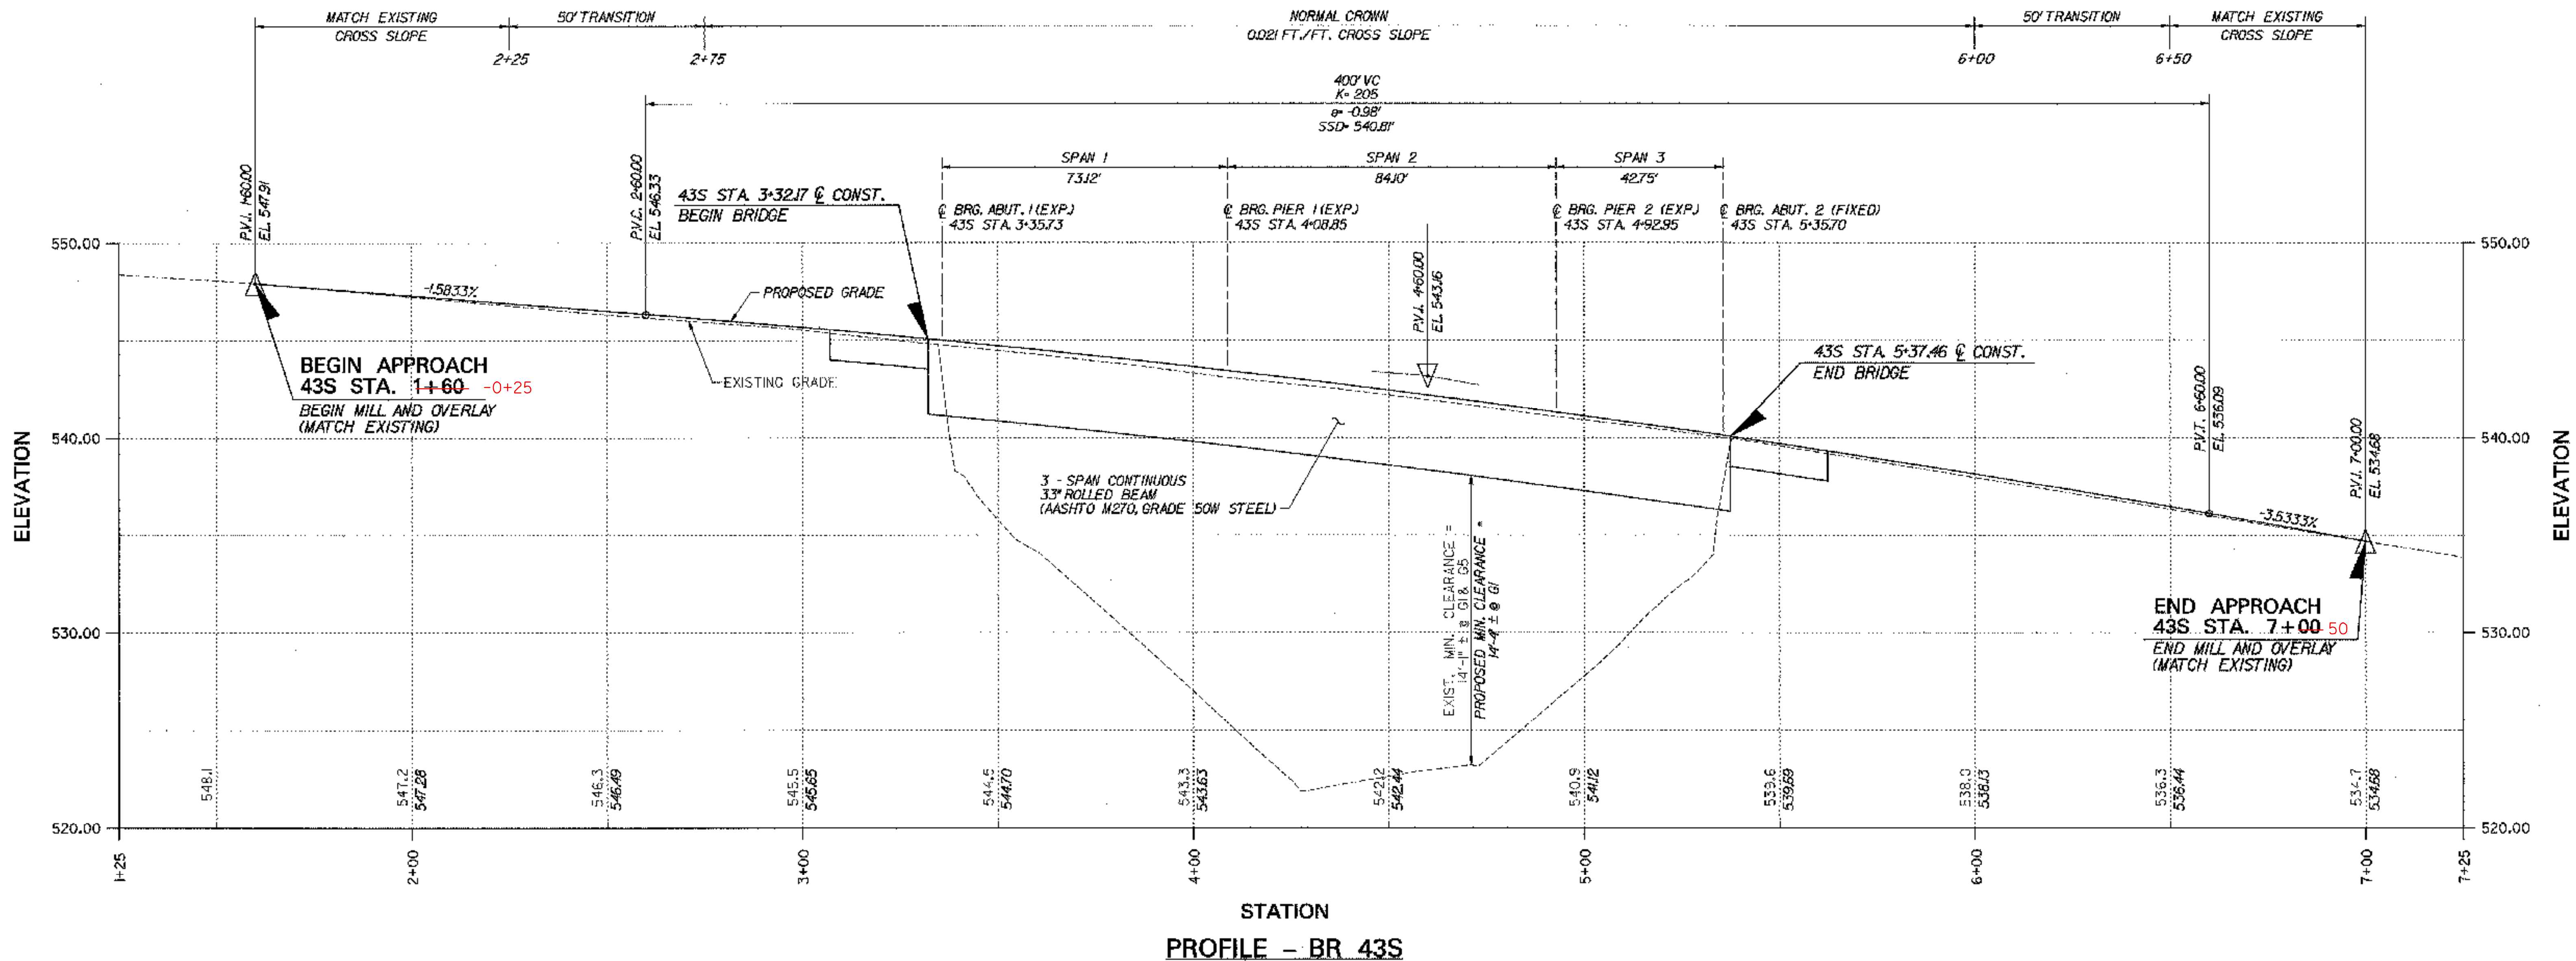

<b>STATE OF VERMONT AGENCY OF TRANSPORTATION</b>	
Town Of <b>MIDDLESEX-BOLTON</b>	Bridge No. <b>43S</b>
Highway No. <b>I-89</b>	Log Sta.
	Surv. Sta.
<b>I-89 SB OVER U.S. ROUTE 2</b>	
<b>PROFILE (43S)</b>	
Designed By <b>P.W. SZUSTAK</b>	Drawn By <b>R.A. BOTZENHART</b>
Checked By <b>J.P. HALSTEAD</b>	Bridge Design Supervisor
Date <b>10/99</b>	Date <b>10/99</b>
PROJECT <b>MIDDLESEX-BOLTON</b>	PROJECT NO. <b>IM-089-2(26)</b>
TVGA CAD Drawing No. <b>43propit</b>	Date <b>10/99</b>
Bridge Sheet No. <b>BR43-3</b>	Sheet <b>49</b> of <b>307</b>



**TVGA** TVGA ENGINEERING,  
SURVEYING, P. C.

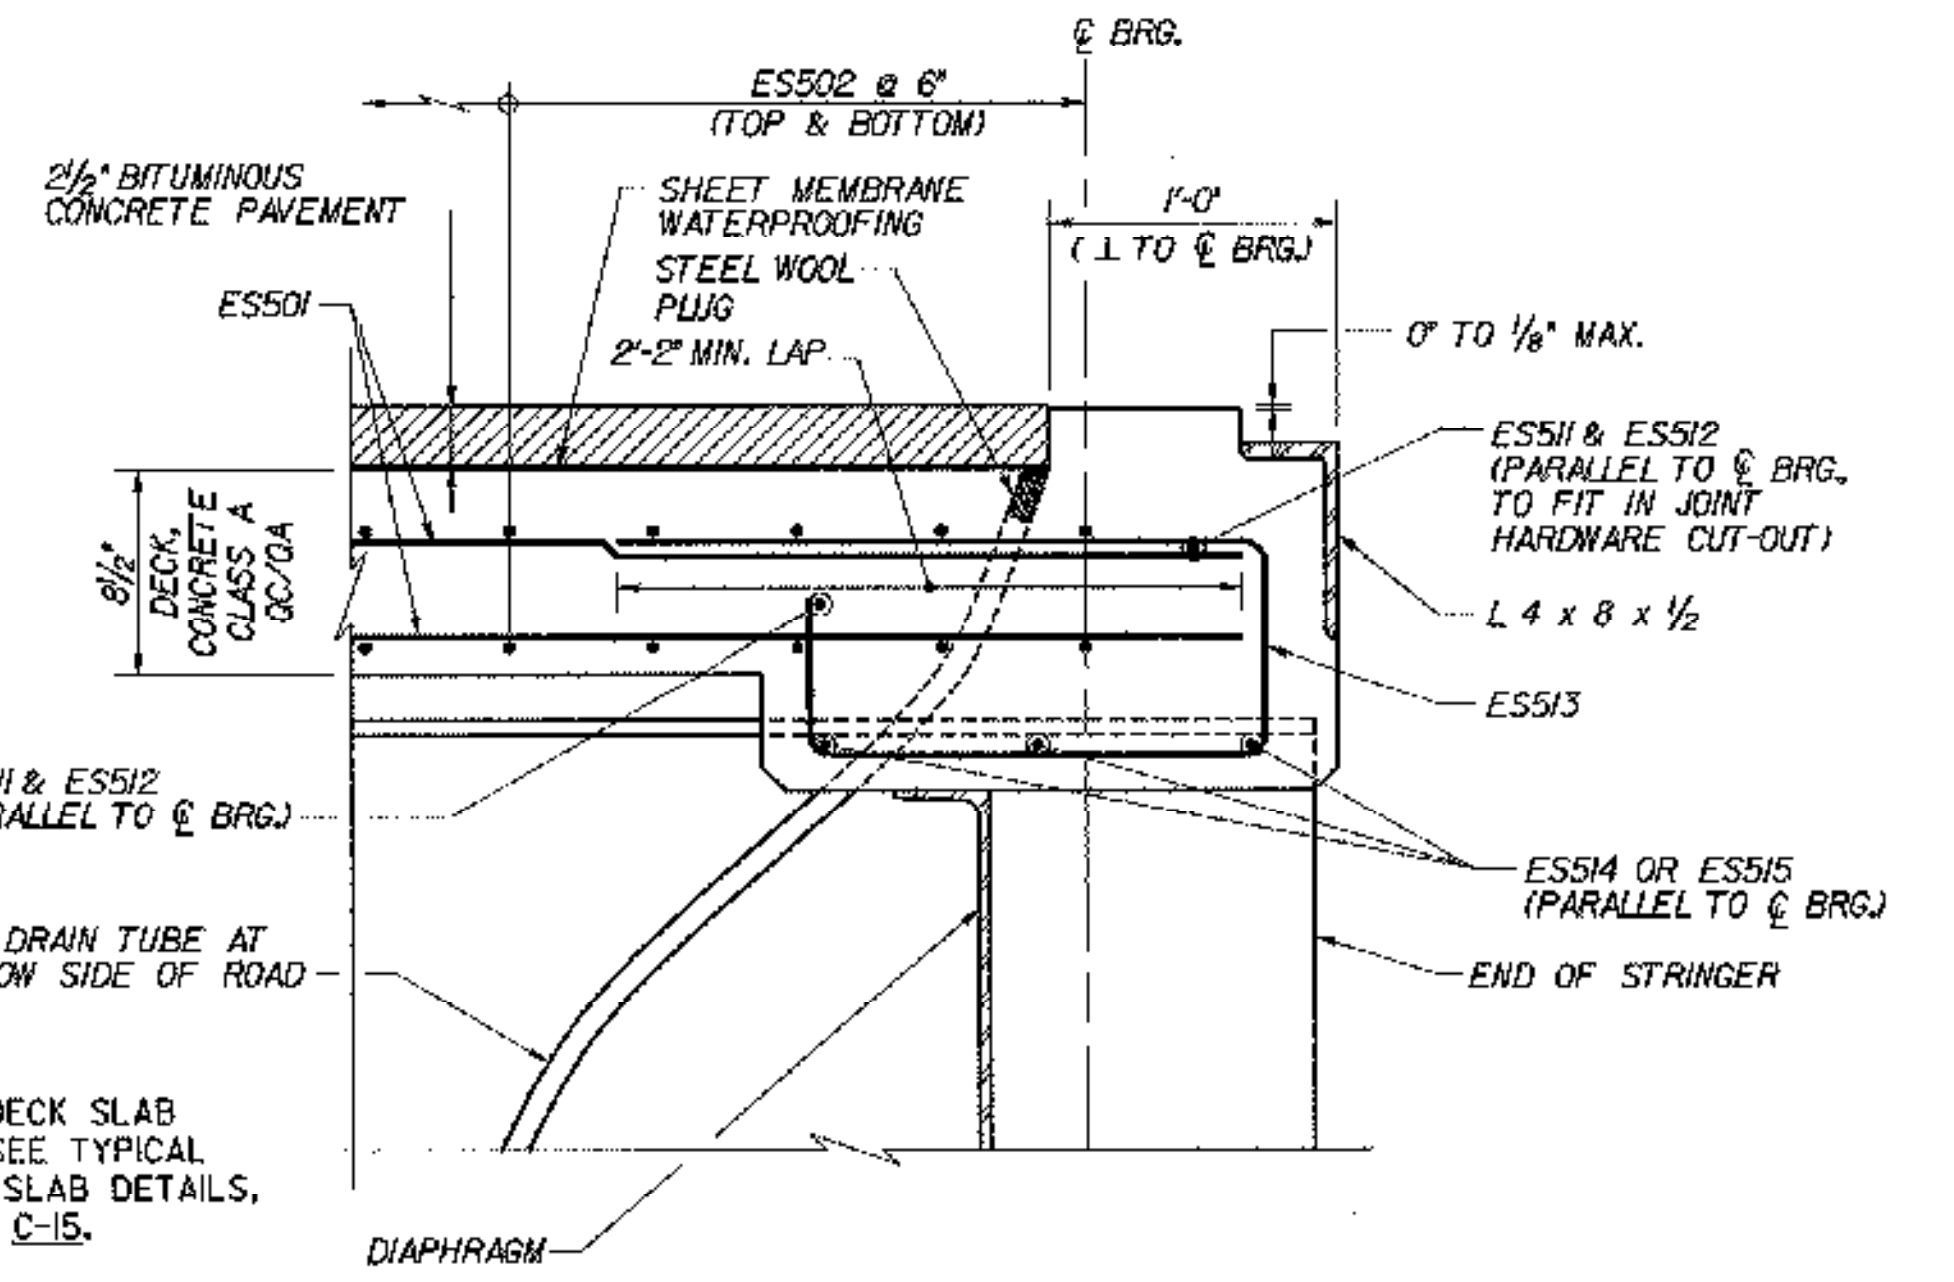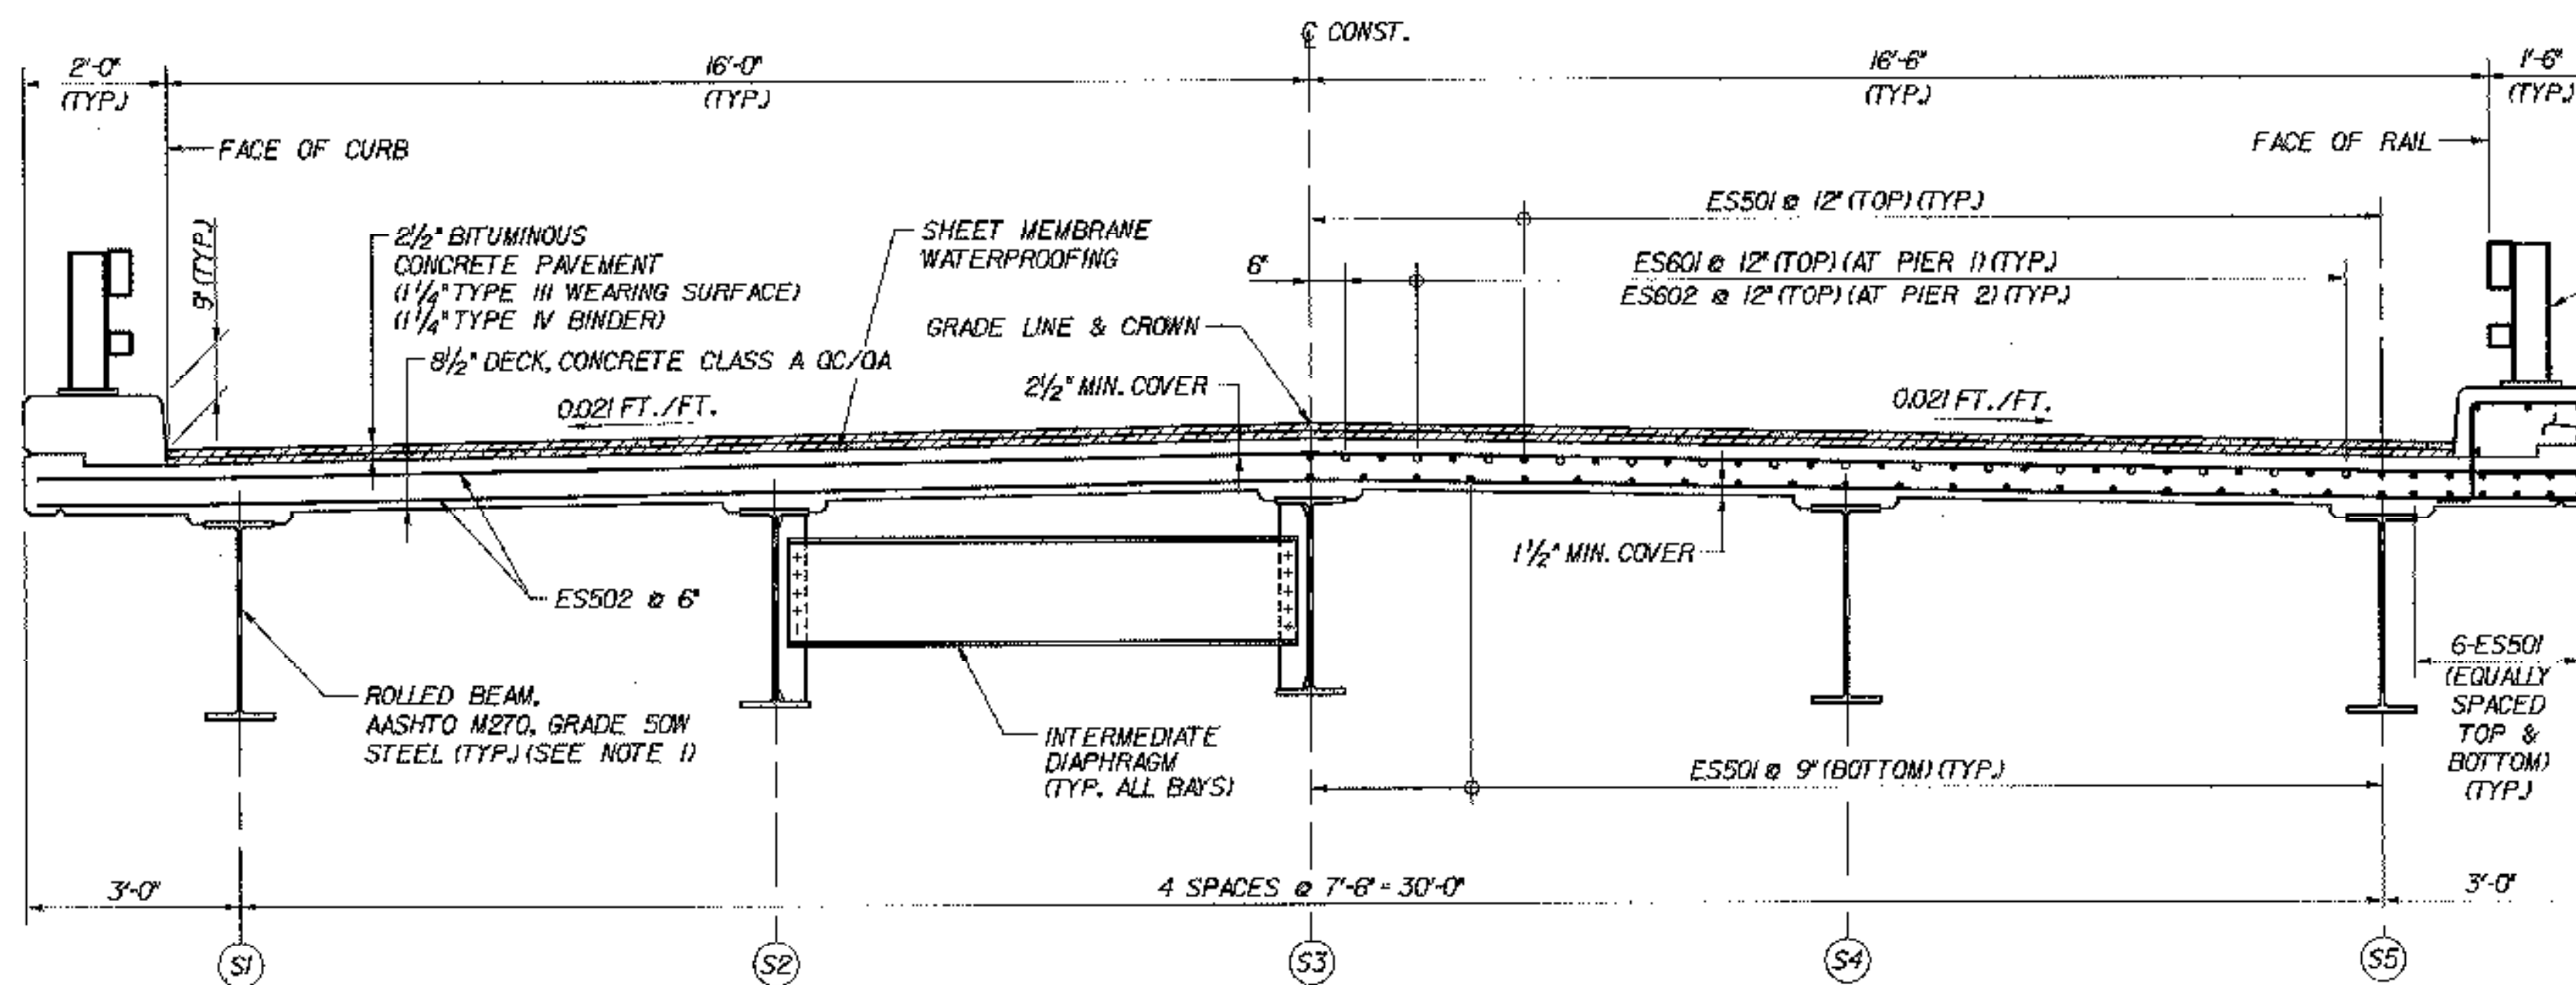

NOTE: FOR END OF DECK SLAB DIMENSIONS, SEE TYPICAL END OF DECK SLAB DETAILS, BRIDGE SHEET C-15.


TRANSVERSE SECTION  
SCALE: 1/2" = 1'-0"

END OF DECK SLAB REINFORCEMENT DETAIL  
(EXP. END)  
SCALE: 1/2" = 1'-0"

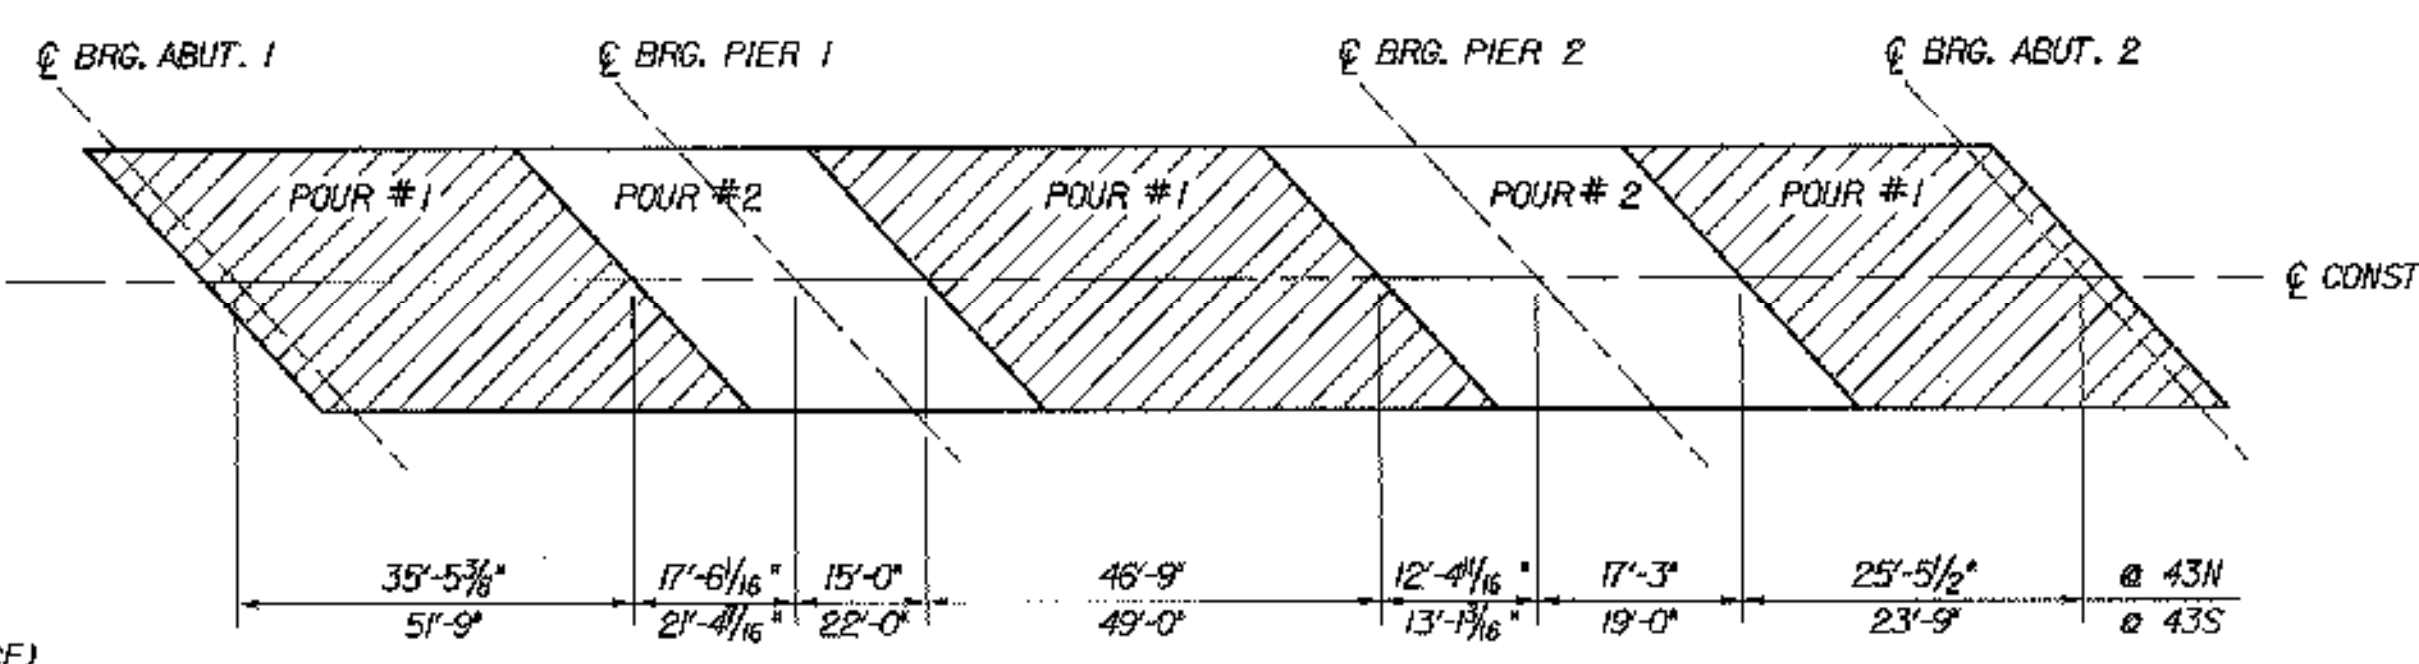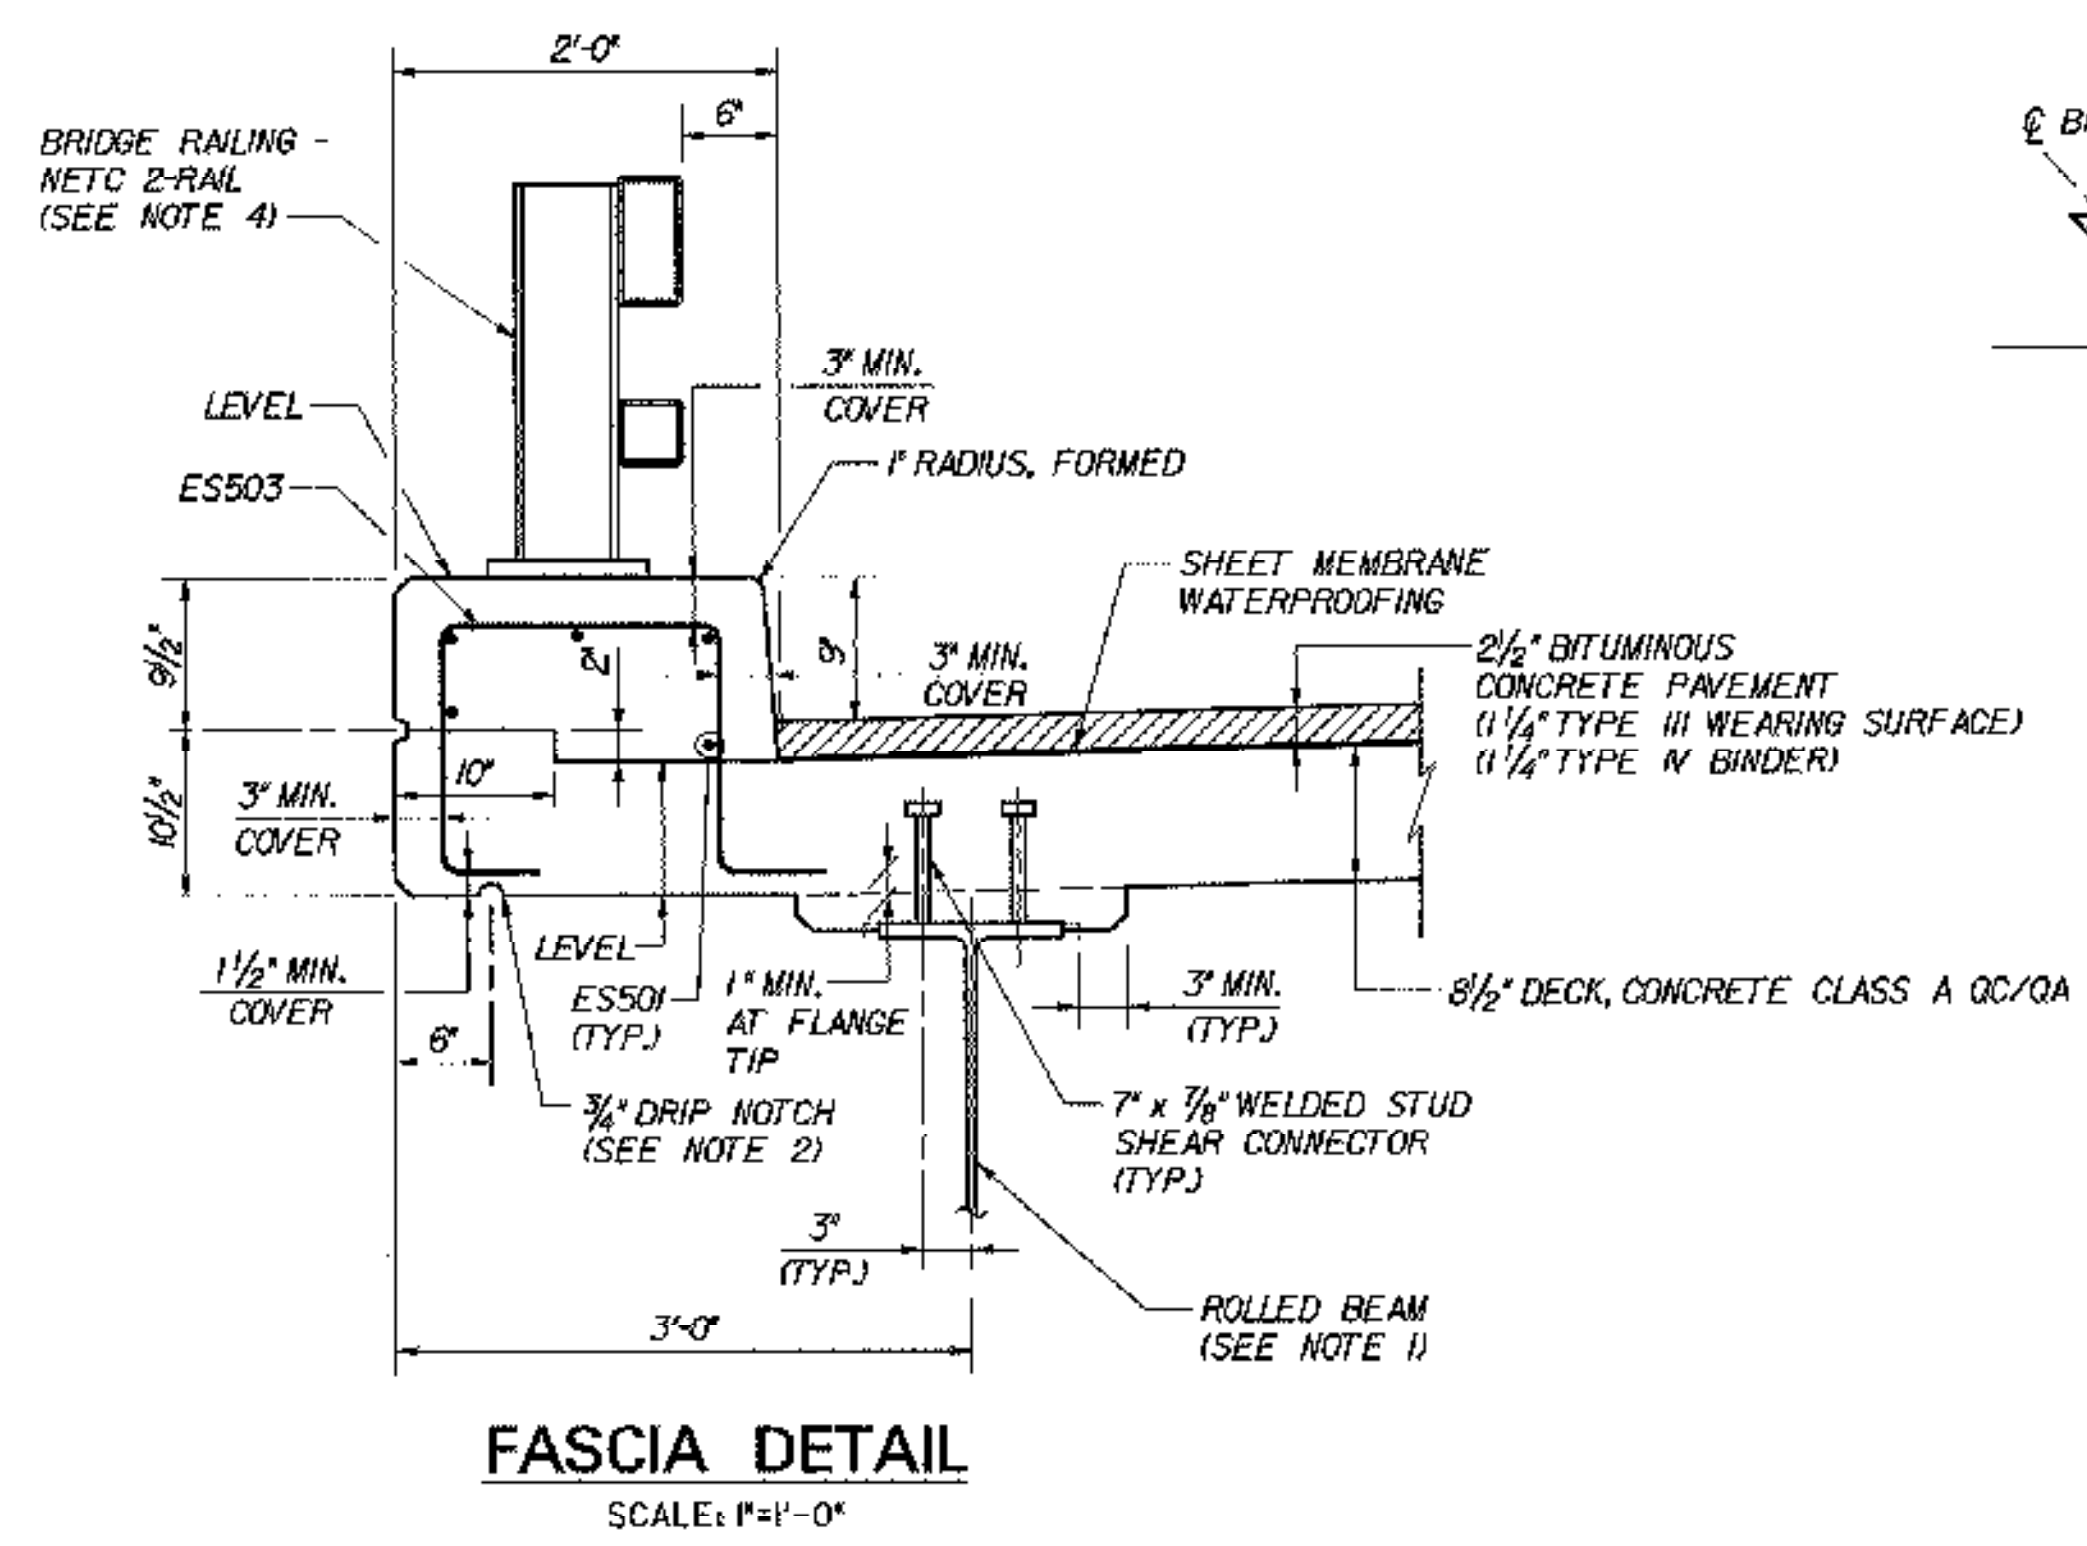

**DECK SLAB PLACEMENT NOTES**

- EACH CONCRETE DECK POUR SHALL BE PLACED CONTINUOUSLY WITHIN ONE EIGHT HOUR WORKING DAY. THERE SHALL BE A MINIMUM DELAY PERIOD OF 96 HOURS AFTER COMPLETION OF EACH POUR BEFORE BEGINNING ANOTHER POUR. INDIVIDUAL POUR NUMBERS AS SHOWN MAY BE COMBINED INTO A SINGLE POUR IF APPROVED BY THE VAOT STRUCTURES ENGINEER.
- THE DECK CONCRETE SHALL BE RETARDED SUFFICIENTLY TO REMAIN PLASTIC UNTIL EACH POUR IS COMPLETE. THE QUANTITY OF RETARDANT SHALL BE APPROVED BY THE CONCRETE ENGINEER PRIOR TO PLACEMENT. ANY DEVIATIONS FROM THIS PROCEDURE MUST BE APPROVED BY THE VAOT STRUCTURES ENGINEER IN WRITING BEFORE THE POUR BEGINS.

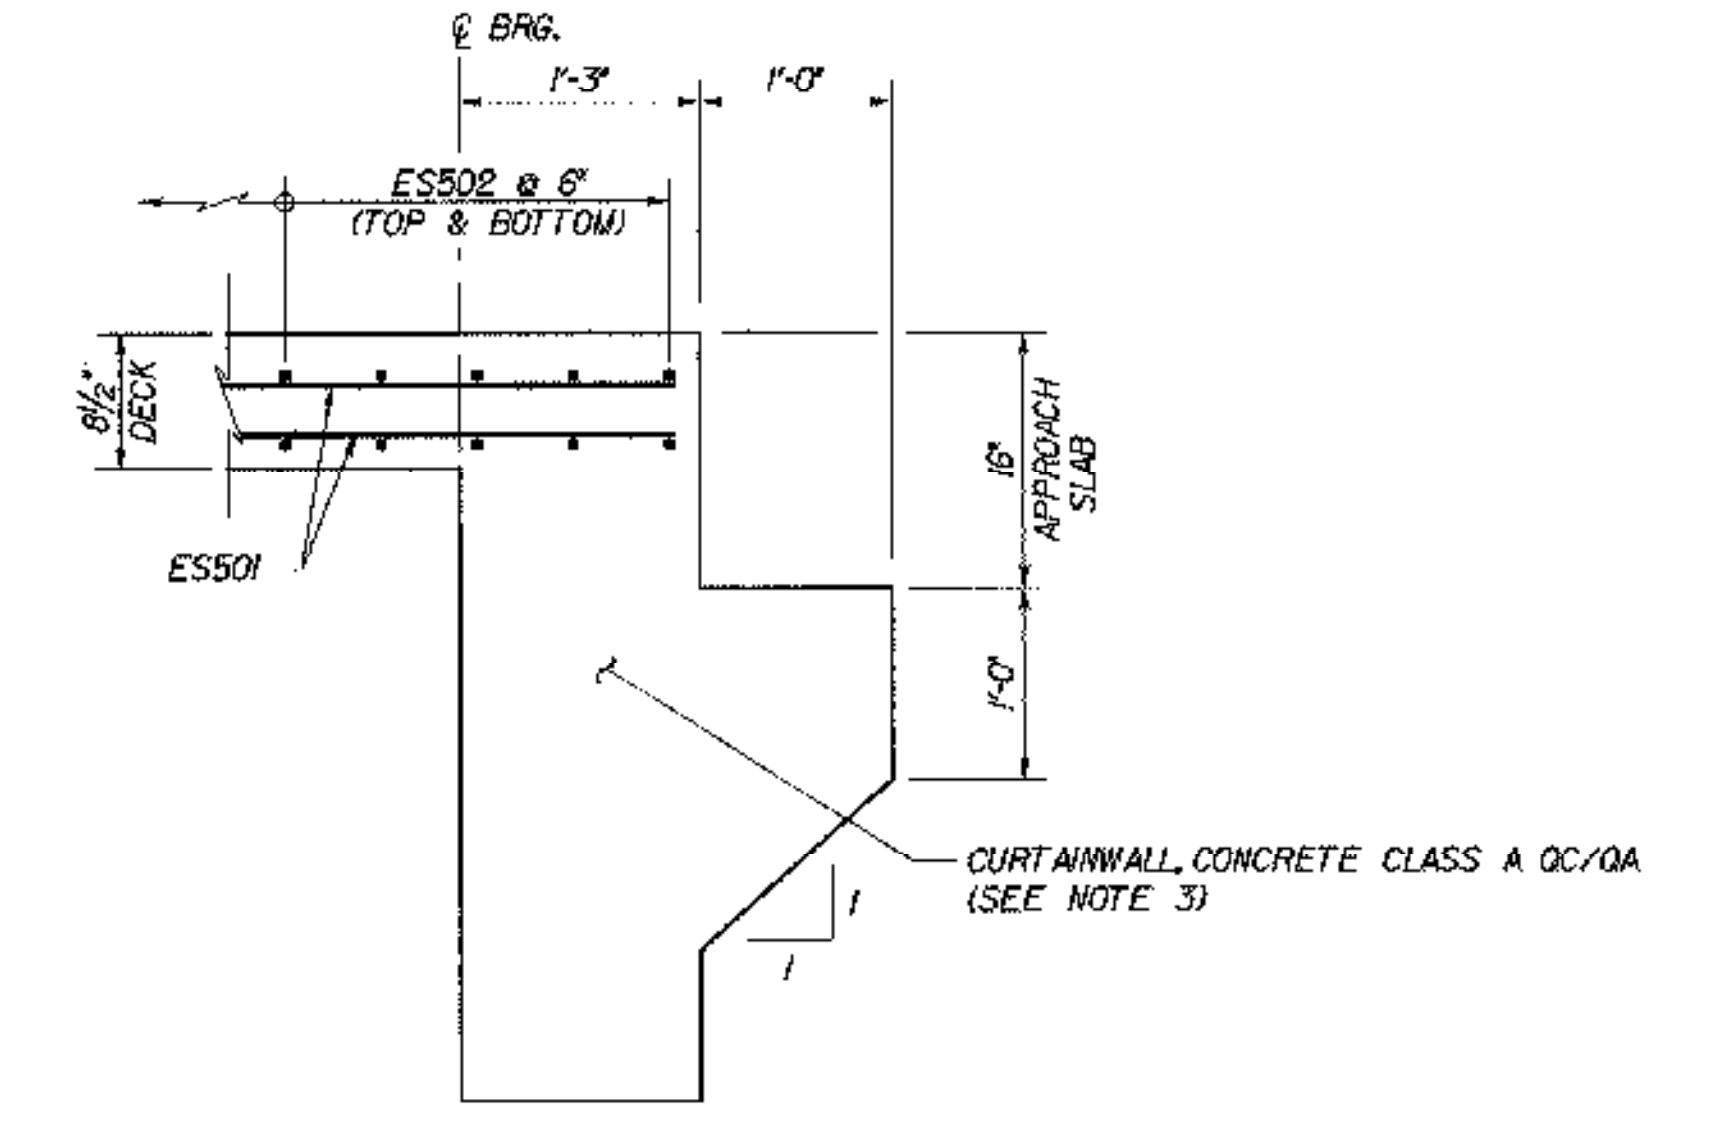


END OF DECK SLAB REINFORCEMENT DETAIL  
(FIXED END)  
SCALE: 1" = 1'-0"

**NOTES:**


- FOR ROLLED BEAM SIZES, SEE STRINGER ELEVATION (43N&S), BRIDGE SHEET BR43-10.
- END DRIP NOTCH 5 FEET BEFORE END OF SLAB AT "DOWNHILL" ABUTMENTS AT 45.
- FOR CURTAINWALL DETAILS AND REINFORCEMENT LAYOUT, SEE TYPICAL CURTAINWALL DETAILS, BRIDGE SHEET C-42.
- FOR DETAILS OF NETC BRIDGE RAIL AND APPROACH SECTION, SEE STANDARD SHEETS BR1-97 AND BR3-97, AND GUARD RAIL APPROACH SECTION, NETC 2 RAIL, BRIDGE SHEETS C-46A AND C-46B.

<b>STATE OF VERMONT AGENCY OF TRANSPORTATION</b>			
Town Of	MIDDLESEX-BOLTON	Bridge No.	<b>43N&amp;S</b>
Highway No.	I-89	Log Sta.	
		Surv. Sta.	
I-89 OVER U.S. ROUTE 2			
<b>TRANSVERSE SECTION (43N&amp;S)</b>			
Designed By	F.W. SZUSTAK	Drawn By	R.A. BOTZENHART
Checked By	Date	Bridge Design Supervisor	
J.P. HALSTEAD	10/99	J.P. HALSTEAD	Date 10/99
PROJECT	MIDDLESEX-BOLTON	PROJECT NO.	IM-089-2(26)
TYGA CAD Drawing No.	43tsect	Date	10/99
Bridge Sheet No.	<b>BR43-4</b>	Sheet	50 of 307

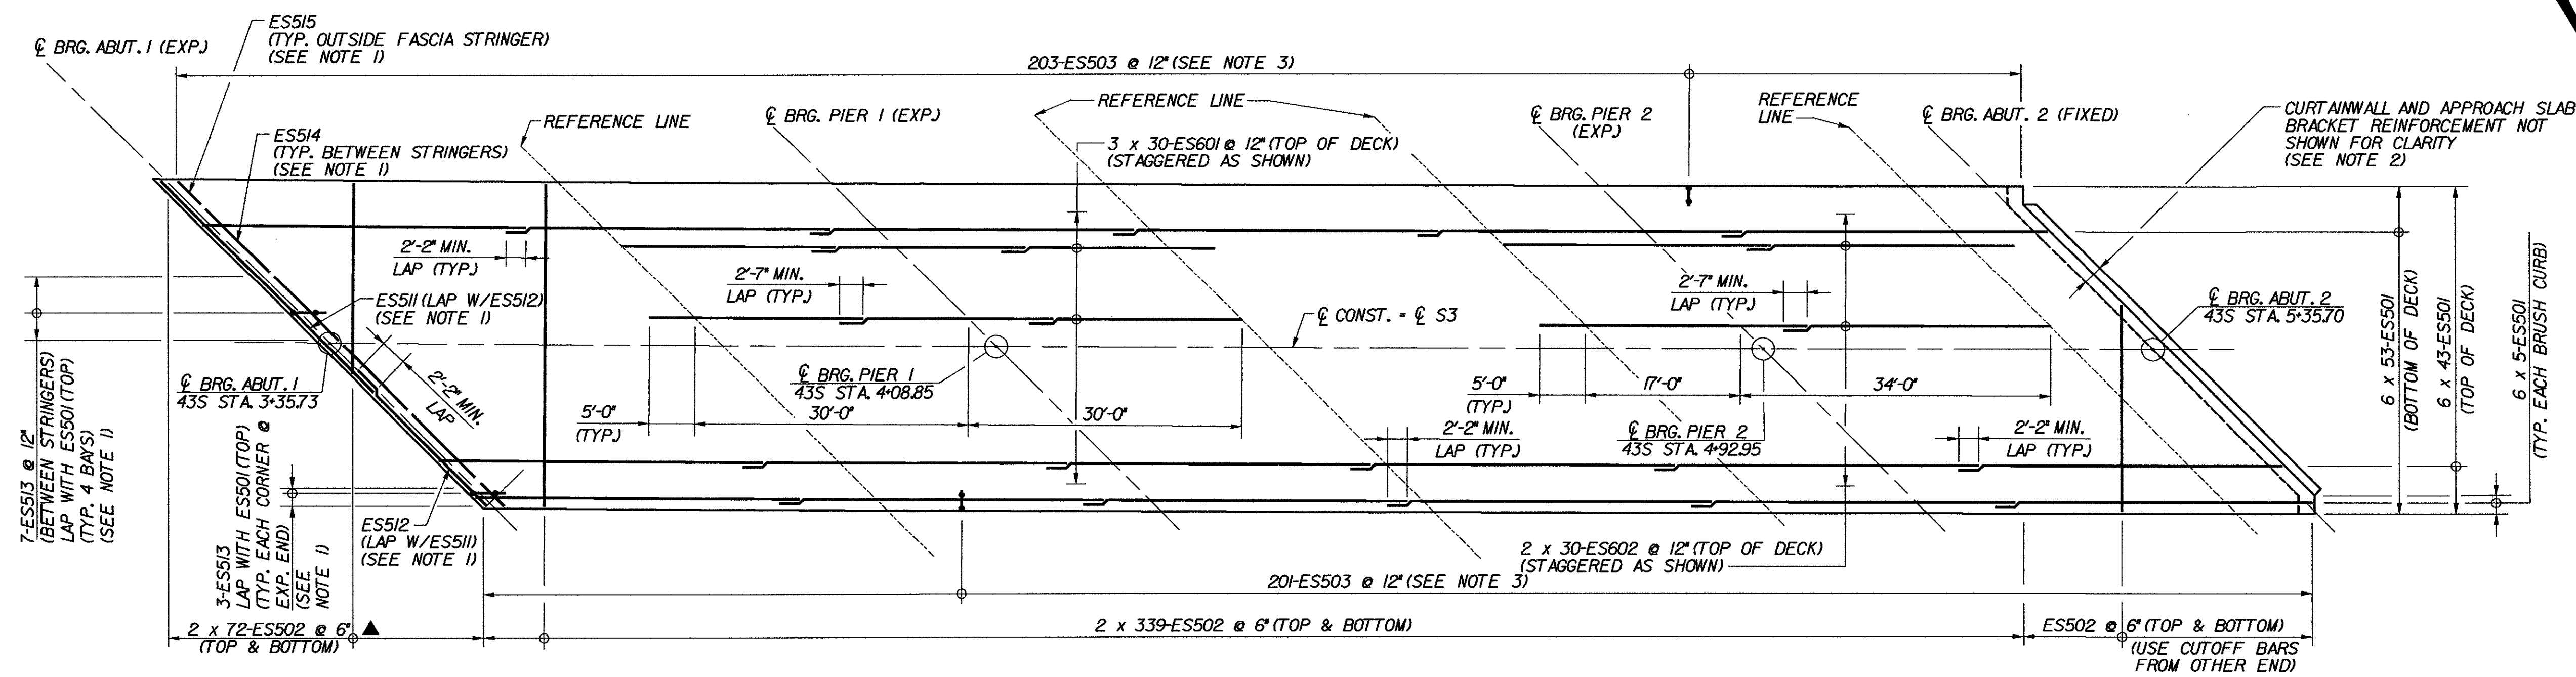

**DECK REINFORCEMENT PLAN - BR 43S**

SCALE: 3/32" = 1'-0"

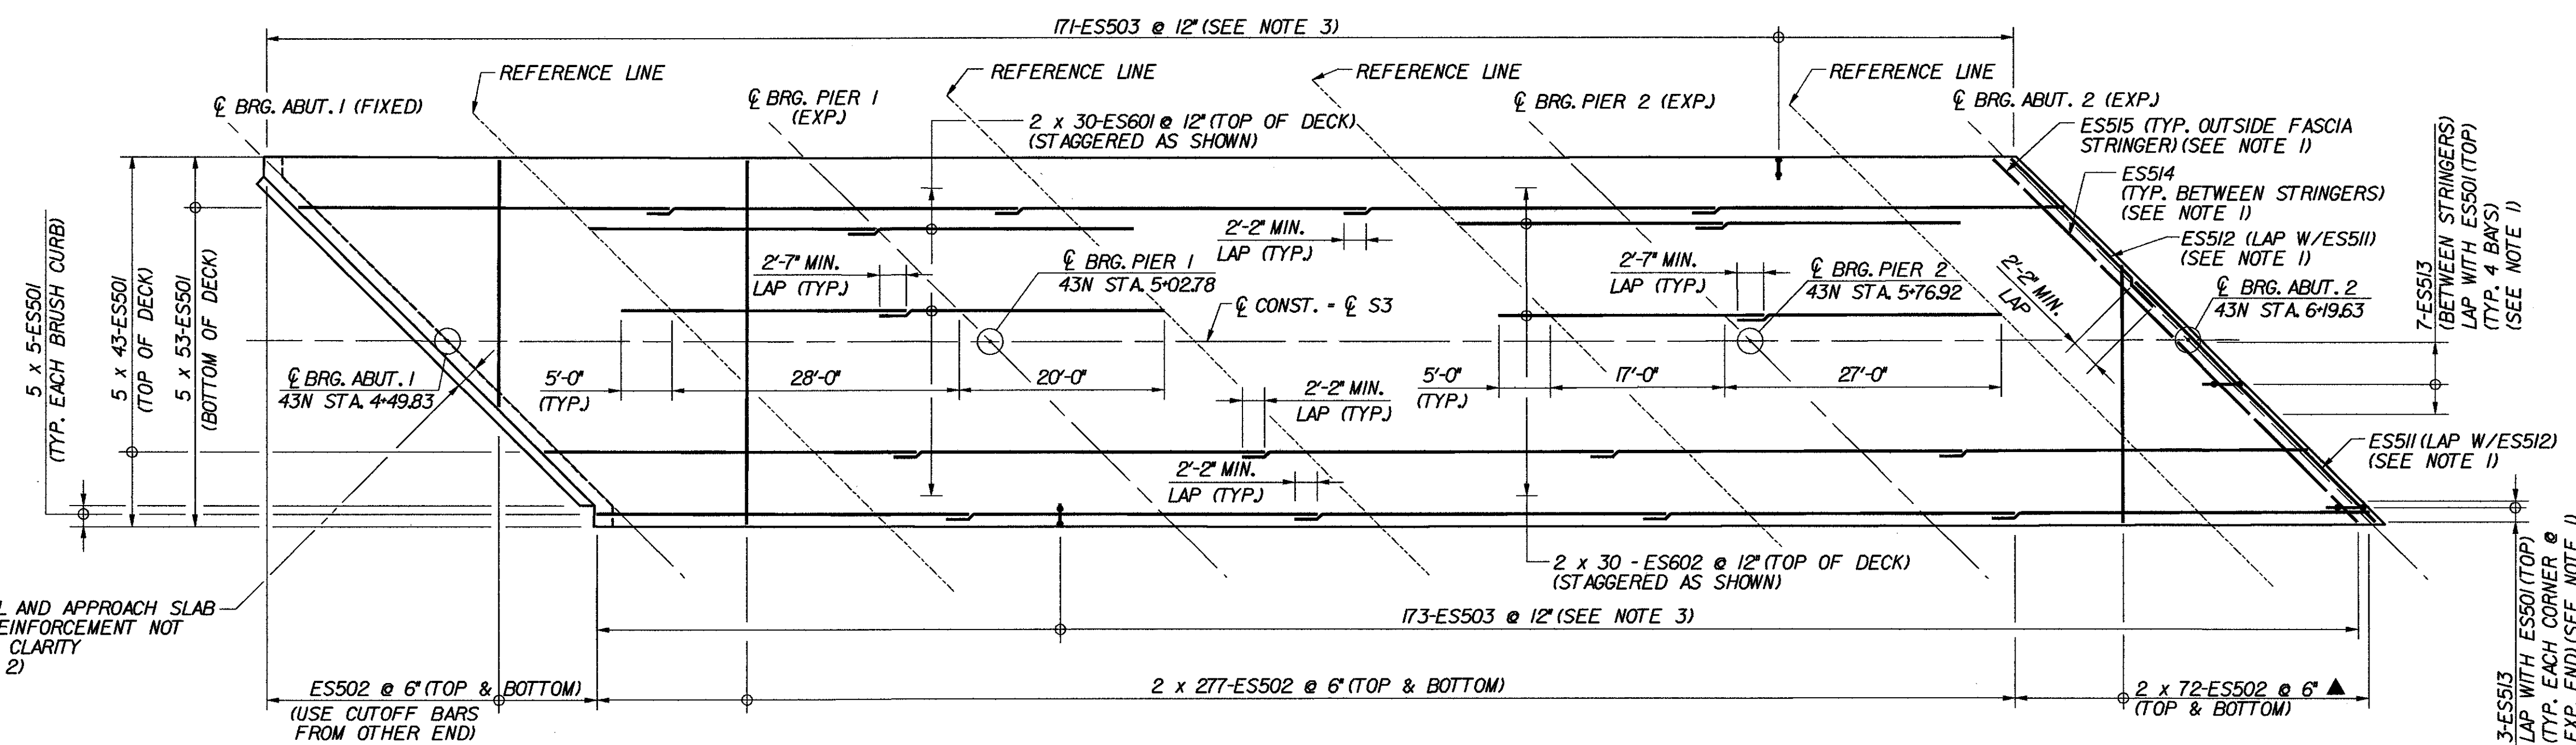

**DECK REINFORCEMENT PLAN - BR 43N**

SCALE: 3/32" = 1'-0"

**NOTES:**

1. FOR END OF DECK SLAB DETAILS, SEE TRANSVERSE SECTION (43N&S), BRIDGE SHEET BR43-4.
2. FOR CURTAINWALL REINFORCEMENT, SEE TYPICAL CURTAINWALL DETAILS, BRIDGE SHEET C-42.
3. THE QUANTITY OF ES503 BARS SHOWN DOES NOT INCLUDE ADDITIONAL BARS REQUIRED BELOW THE BRIDGE RAIL POSTS. FOR DETAILS OF THE REQUIRED STIRRUP SPACING, SEE NETC 2-RAIL STANDARD SHEET BR1-97. FOR LOCATIONS OF THE BRIDGE RAIL POSTS, SEE CURB AND RAIL LAYOUT PLANS, BRIDGE SHEET BR43-7.

**STATE OF VERMONT  
AGENCY OF TRANSPORTATION**


Town Of	MIDDLESEX-BOLTON	Bridge No.	<b>43N&amp;S</b>
Highway No.	I-89	Log Sta.	
		Surv. Sta.	
I-89 OVER U.S. ROUTE 2			

**DECK REINFORCEMENT PLANS (43N&S)**


Designed By	P.W. SZUSTAK	Drawn By	R.A. BOTZENHART
Checked By	Date	Bridge Design Supervisor	Date
J.P. HALSTEAD	10/99	J.P. HALSTEAD	10/99
PROJECT	MIDDLESEX-BOLTON	PROJECT NO.	IM-089-2(26)
TVGA CAD Drawing No.	43drp	Date	10/99
Bridge Sheet No.	<b>BR43-5</b>	Sheet	51 of 307

**KEY**


- NF NEAR FACE
- FF FAR FACE
- EF EACH FACE
- ▲ REINFORCEMENT TO BE CUT TO FIT IN THE FIELD

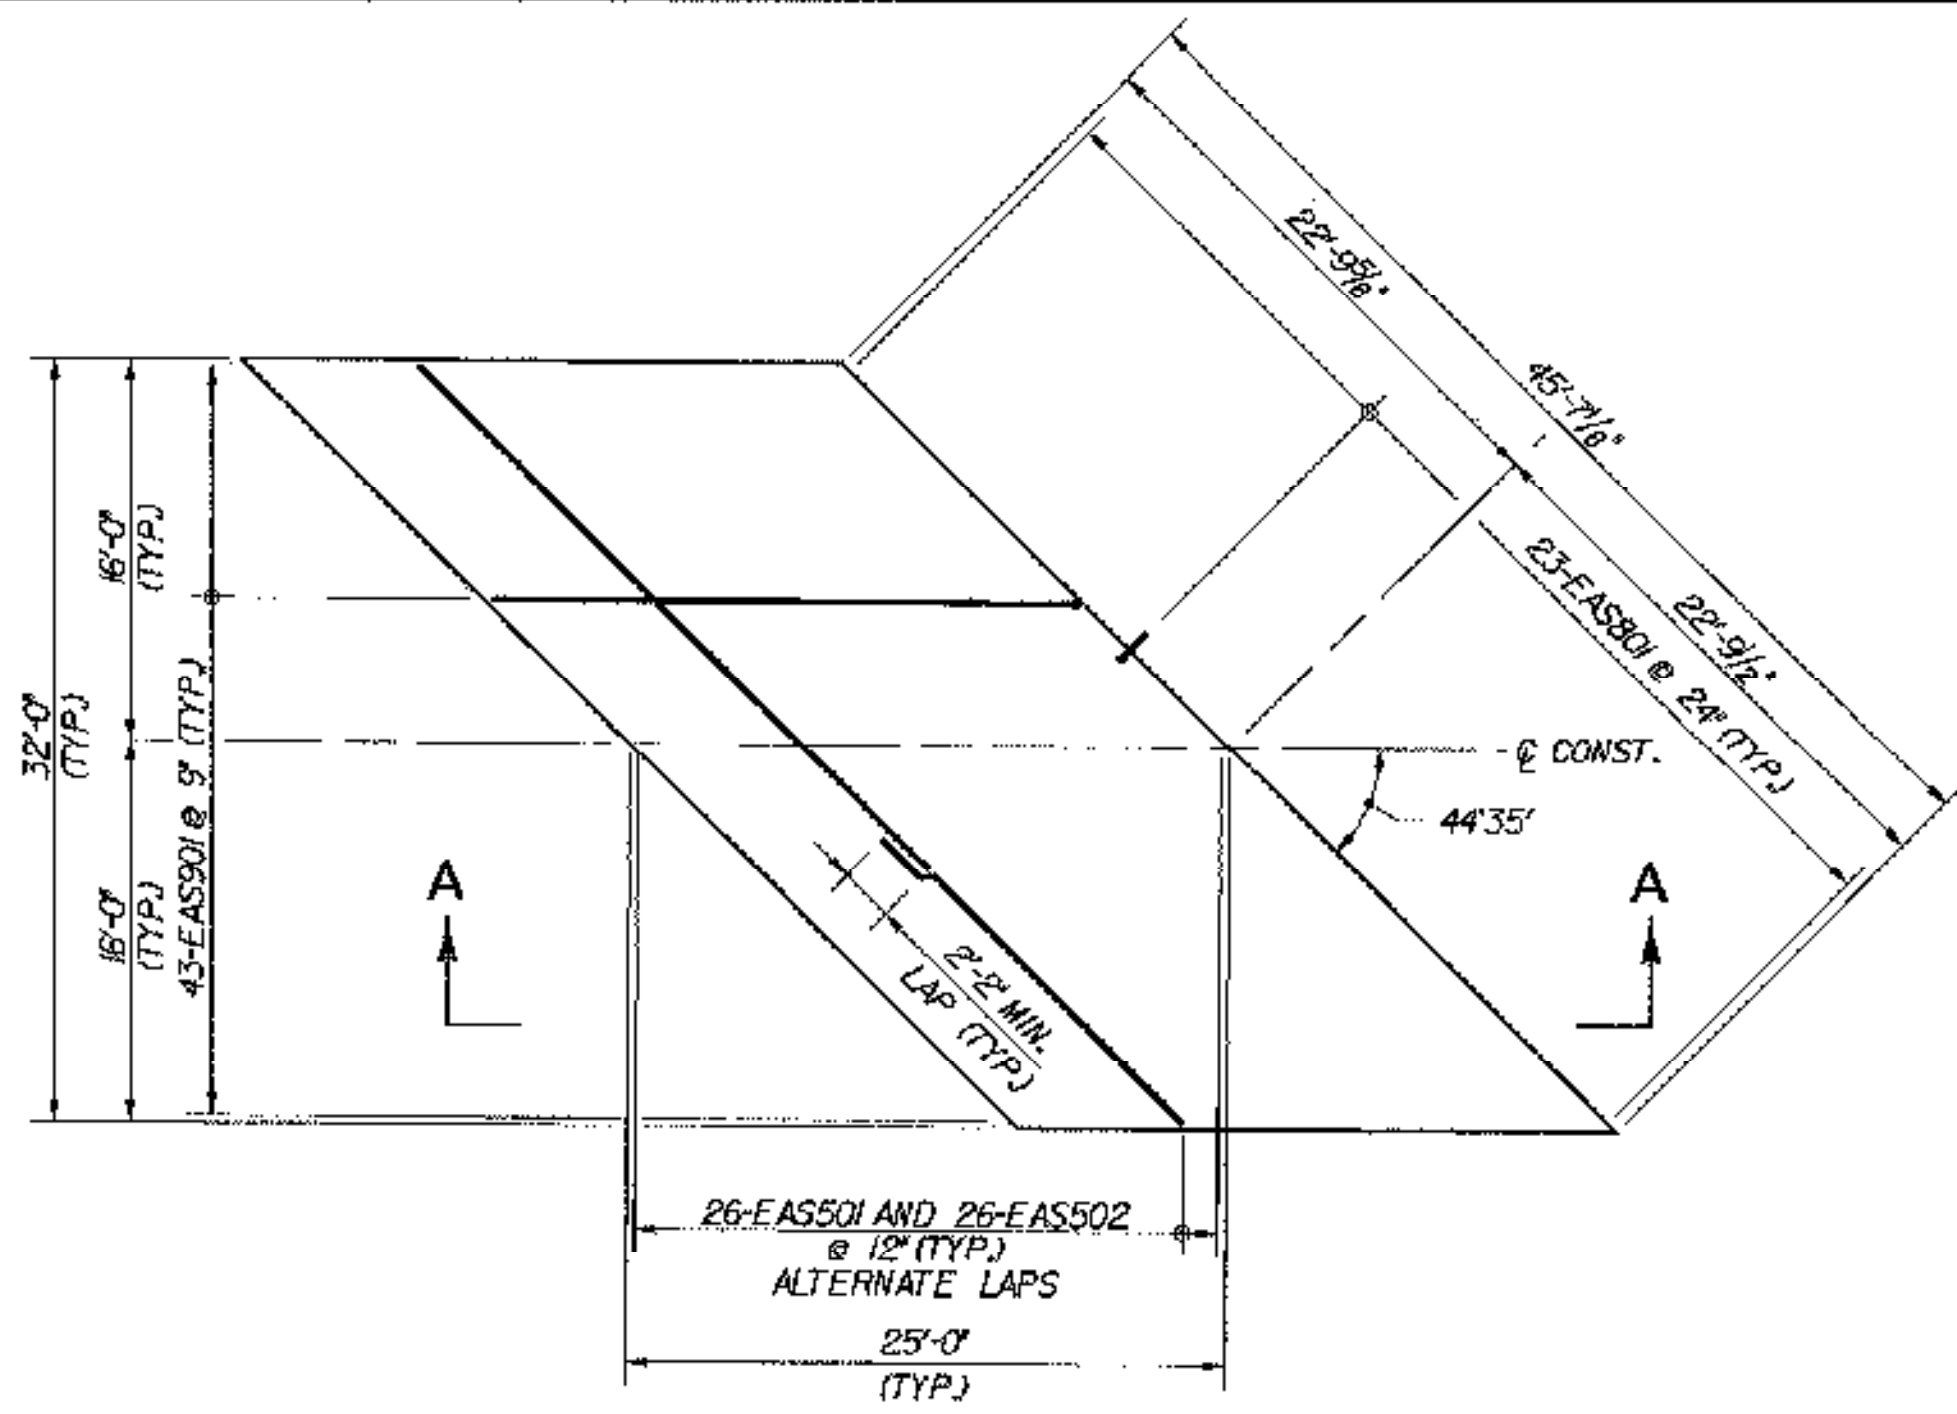


43S ABUTMENT 1

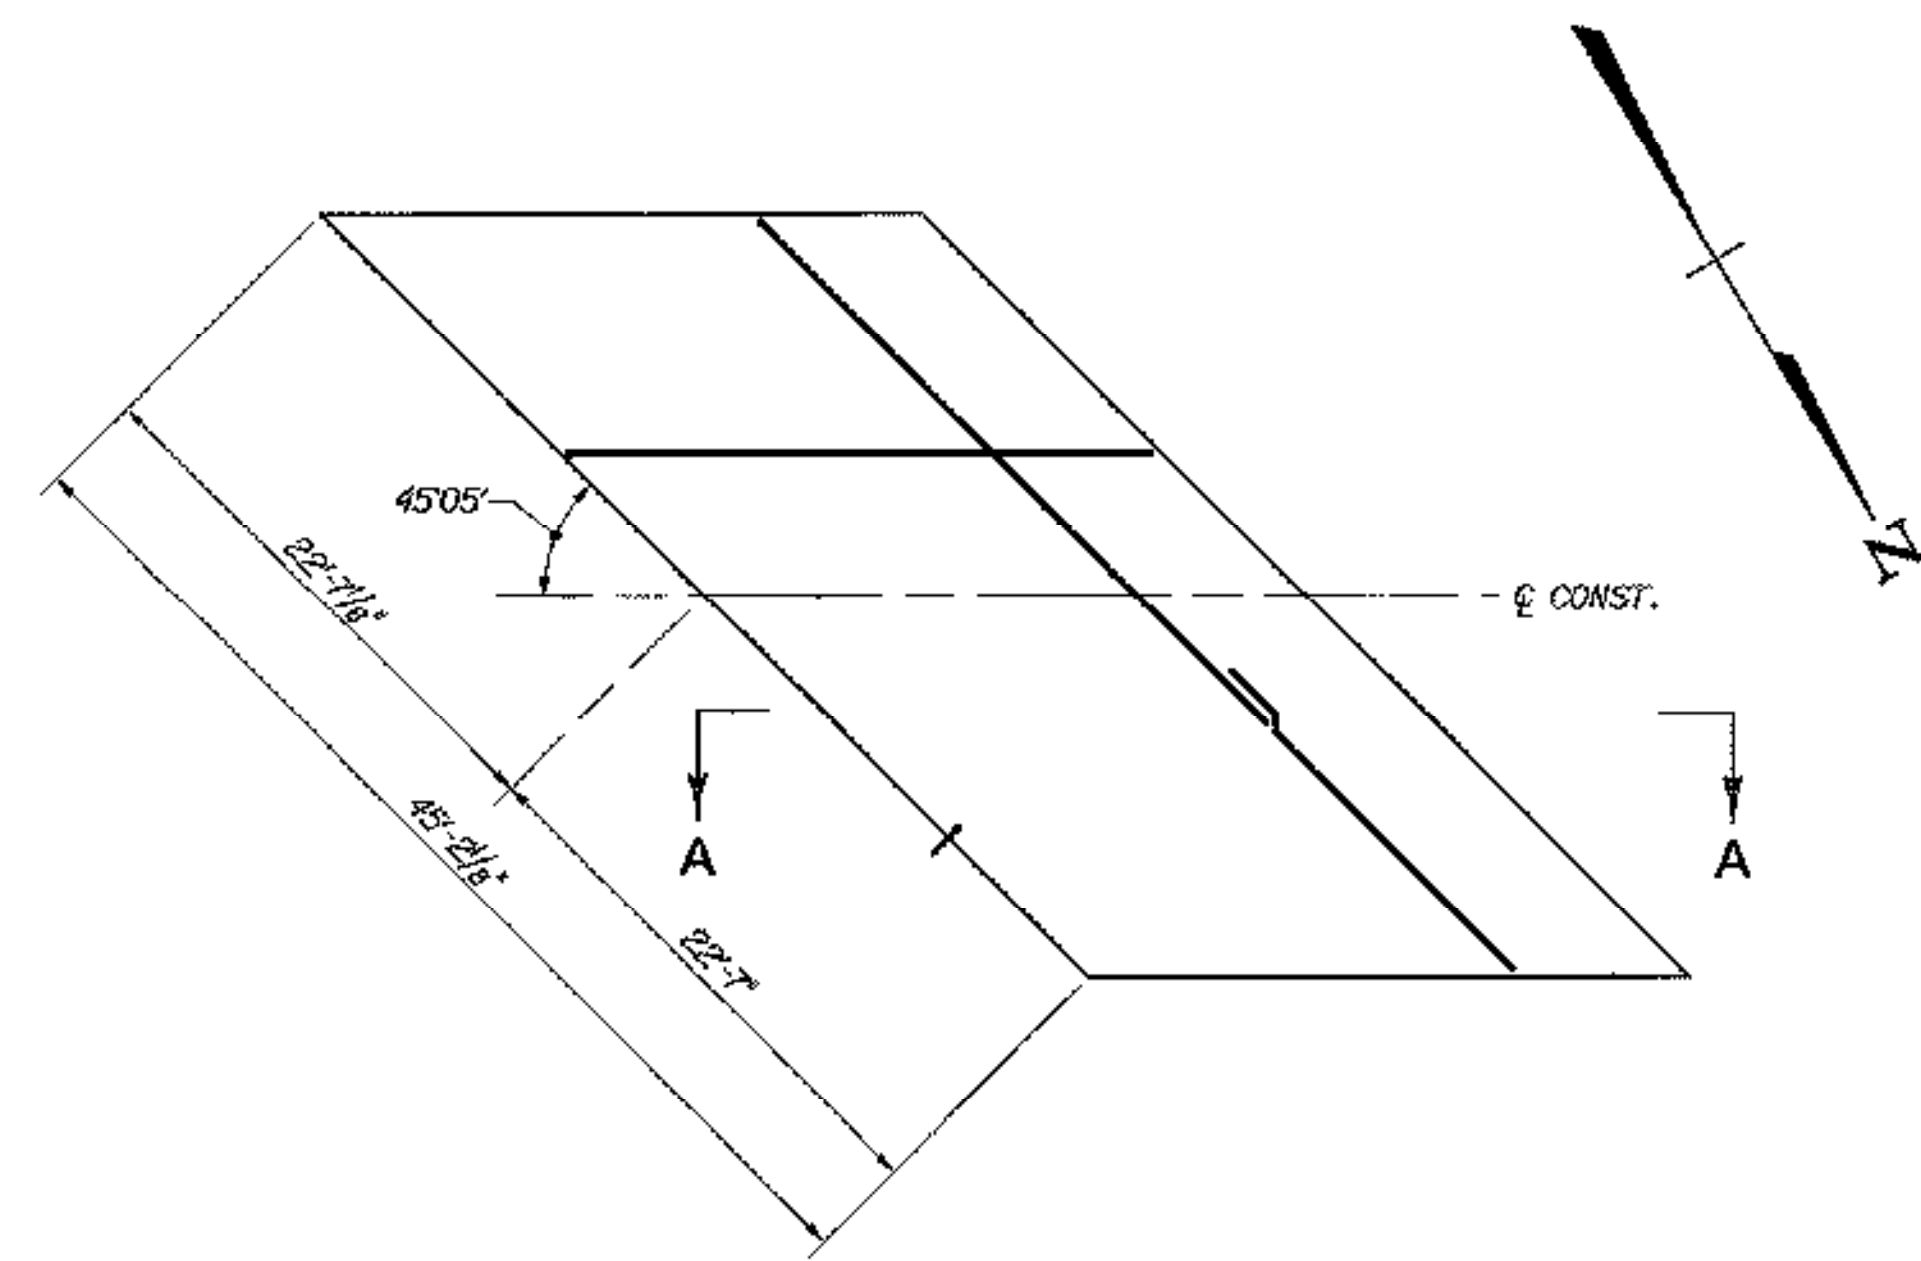


43S ABUTMENT 2

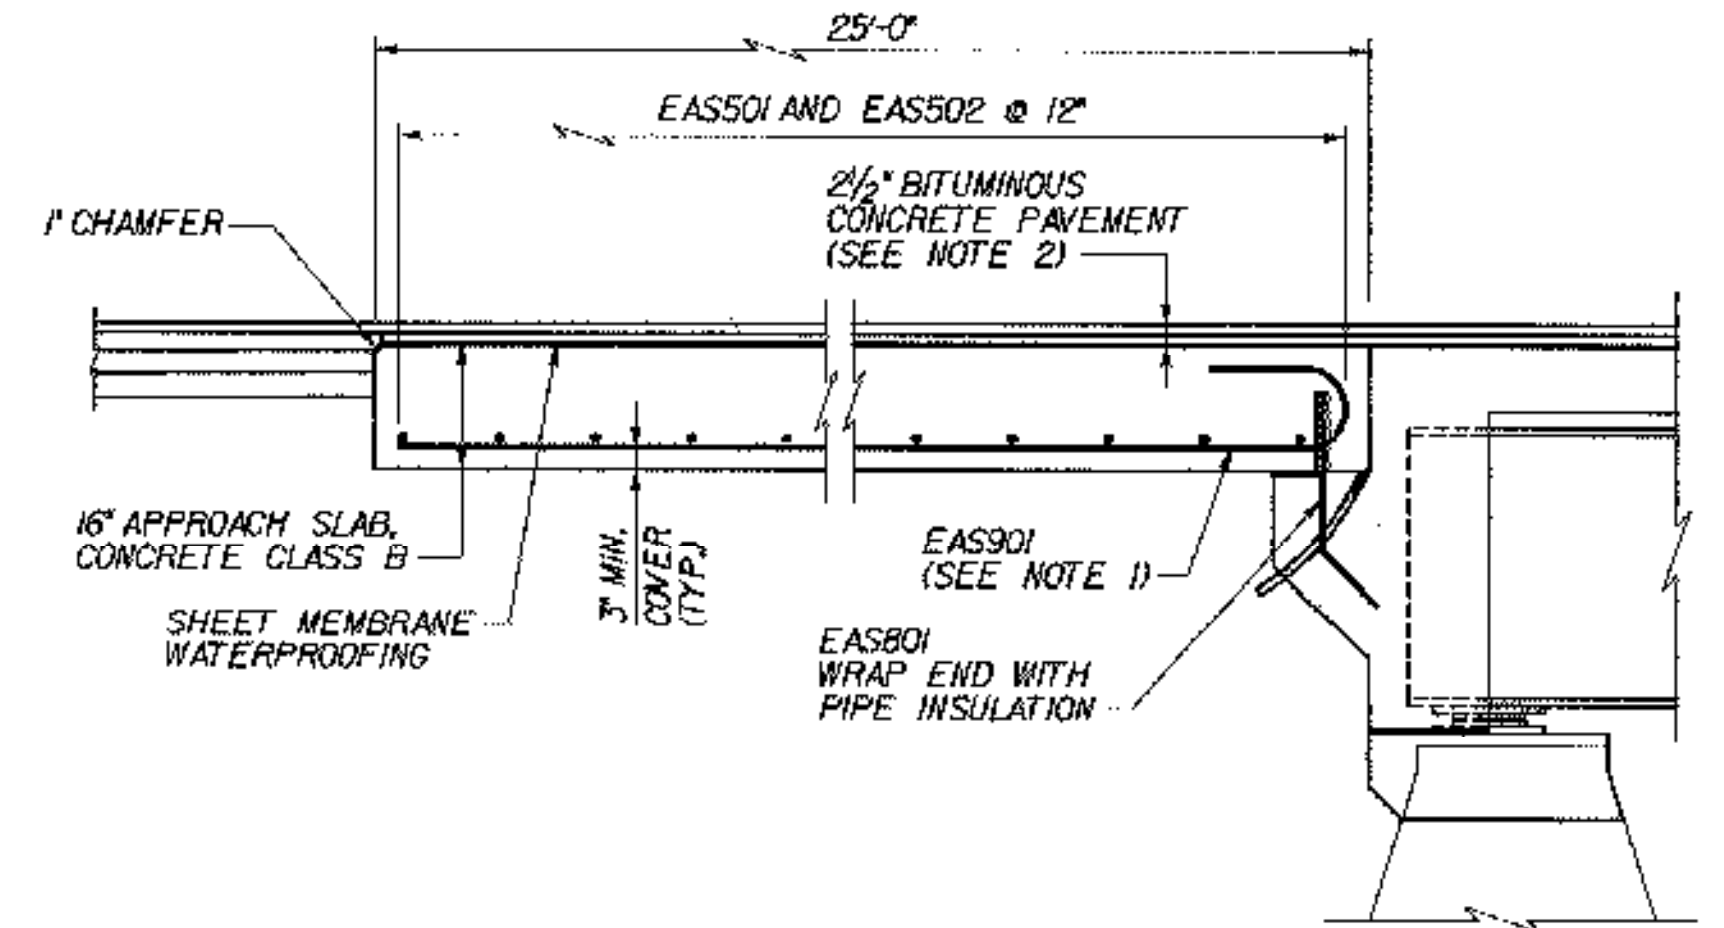

SECTION A-A  
(APPROACH SLAB AT FIXED ABUT. SHOWN;  
SLAB AT EXPANSION ABUT. SIMILAR)  
N.T.S.

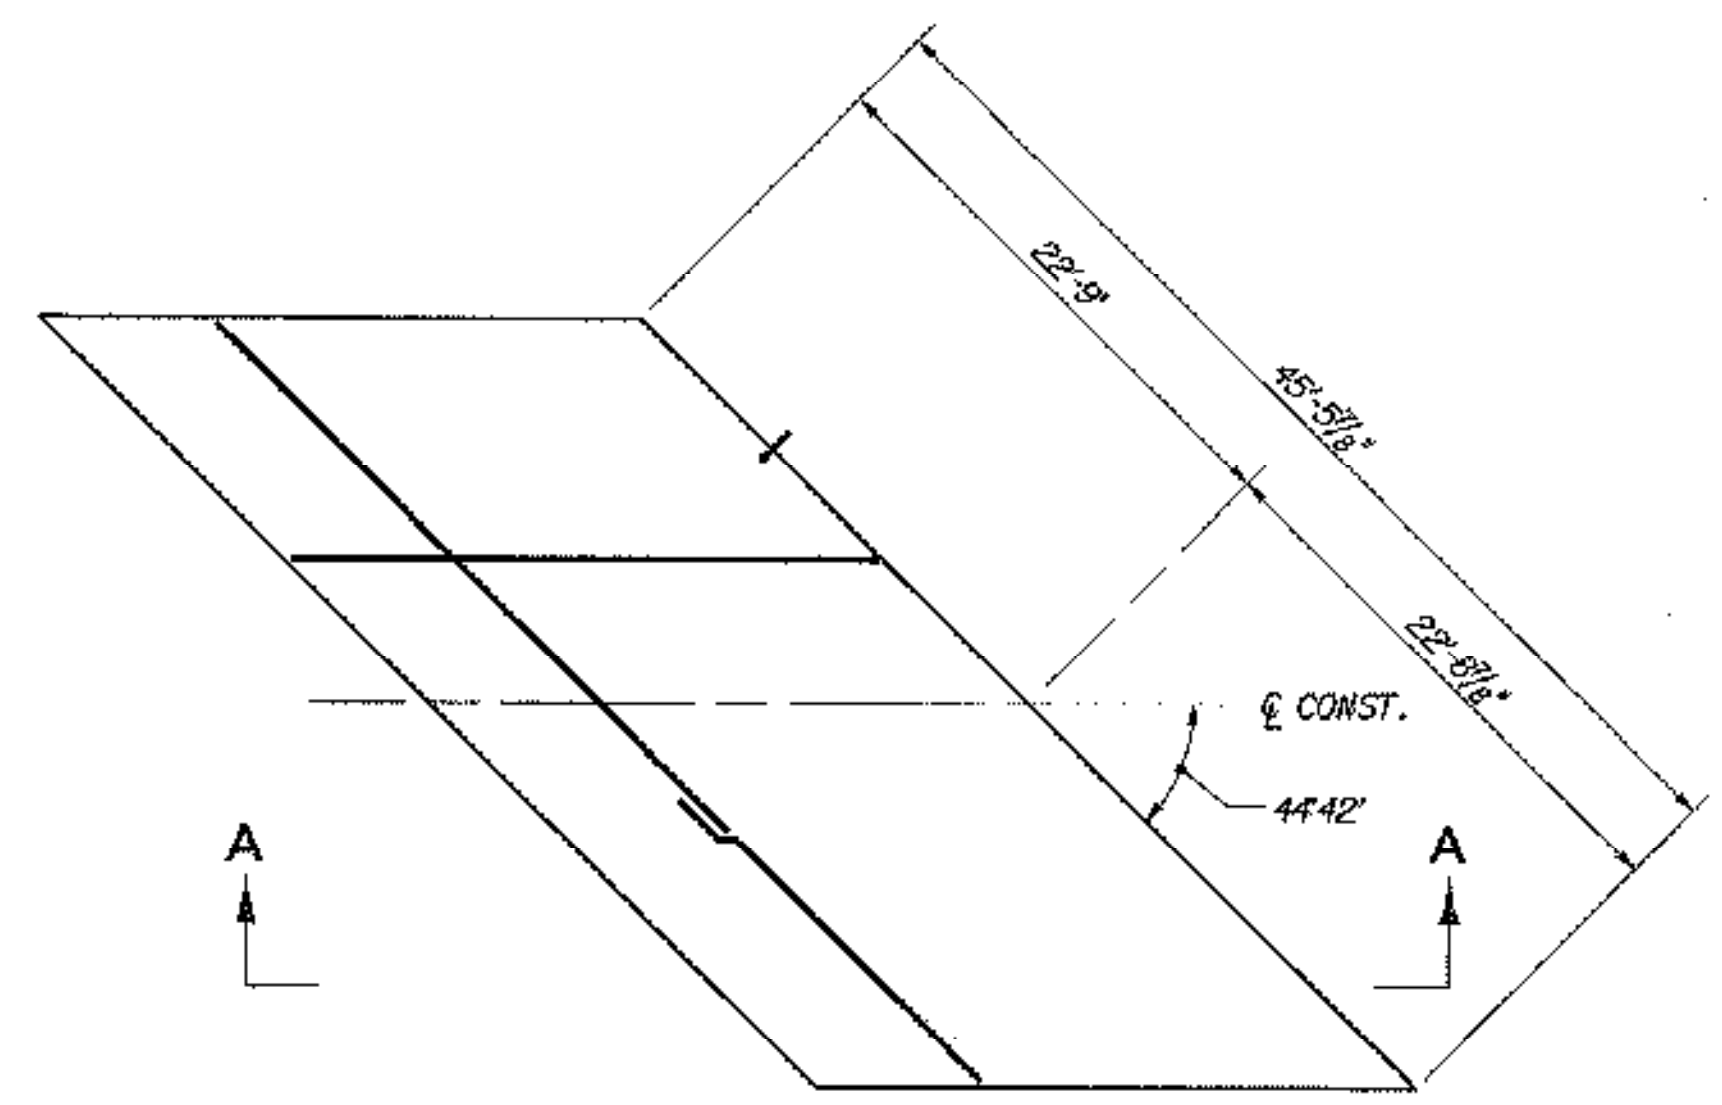

43N ABUTMENT 1

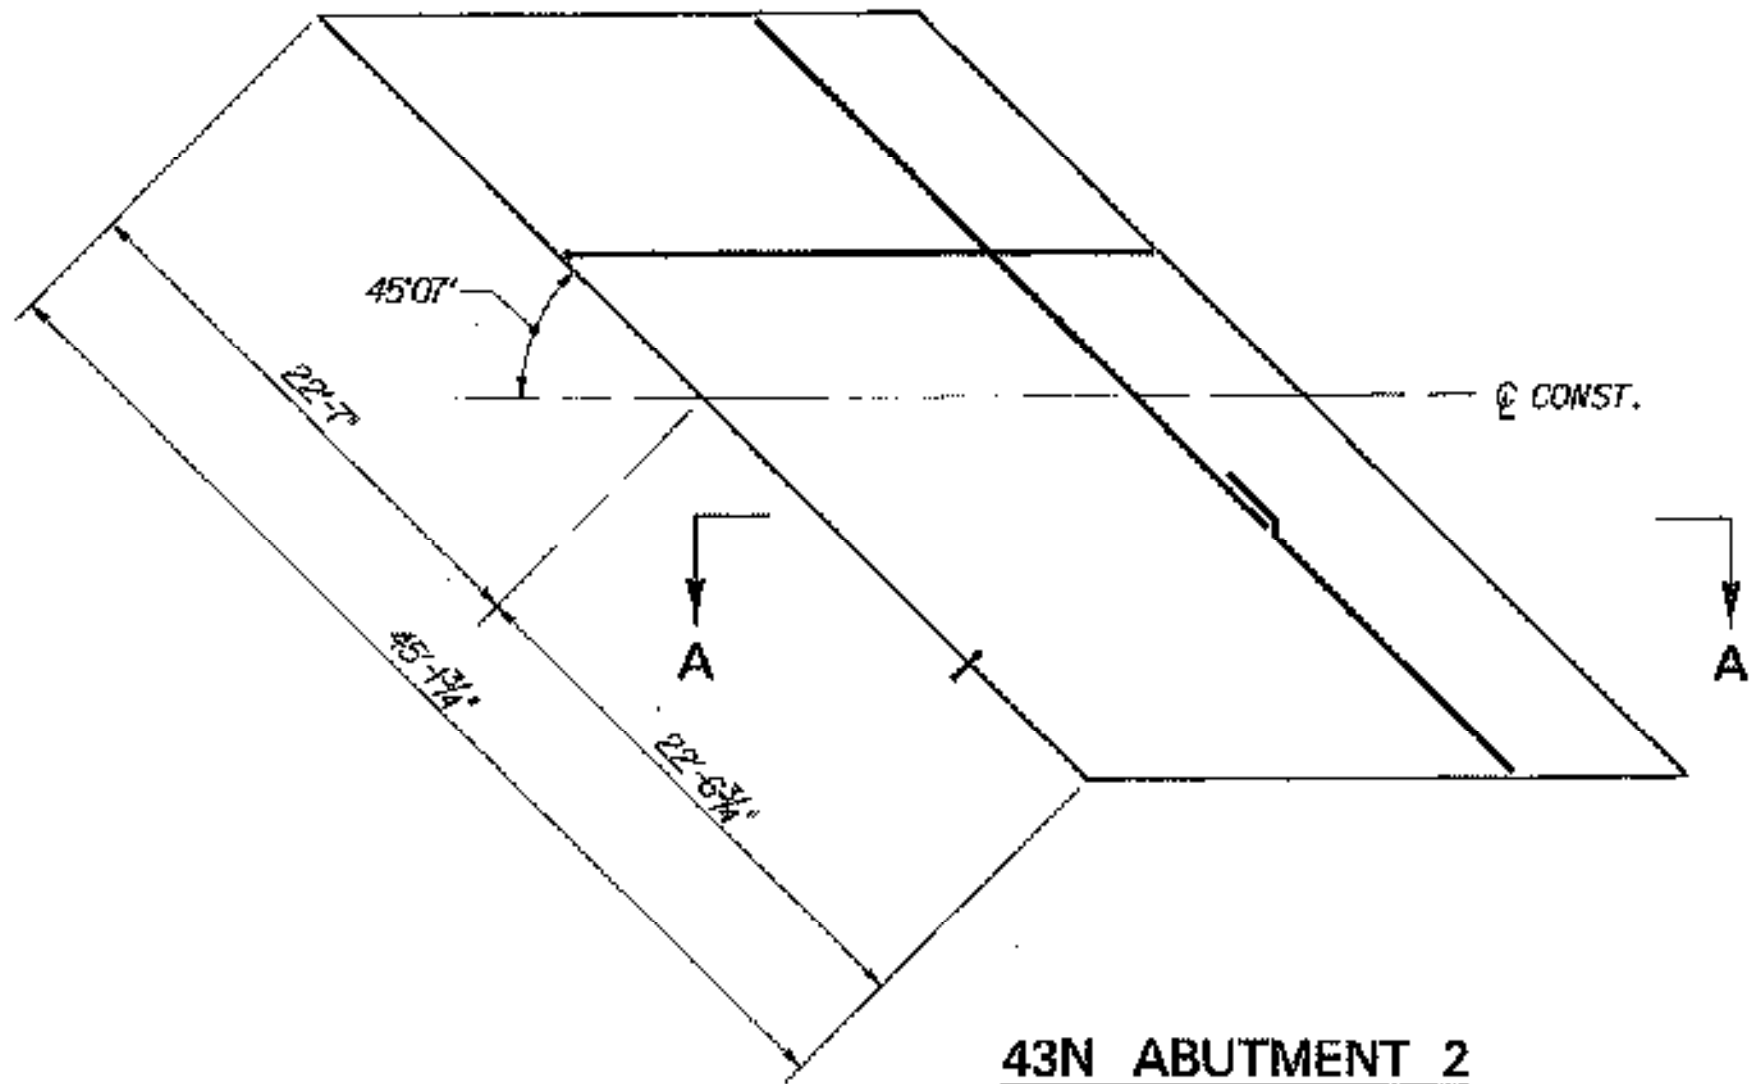

43N ABUTMENT 2


TOP OF APPROACH SLAB ELEVATIONS					
BR 43N			BR 43S		
LOCATION	STATION	ELEVATION	LOCATION	STATION	ELEVATION
A	4+31.87	543.02-.04	A	3+15.91	544.82-.93
B	4+48.05	542.88-.90	B	3+32.17	544.85-.96
C	4+64.21	542.06-.08	C	3+48.39	544.19-.30
D	4+06.83	543.72-.74	D	2+90.90	545.27-.38
E	4+23.05	543.82-.64	E	3+07.17	545.32-.43
F	4+39.24	542.80-.82	F	3+23.43	544.68-.79
G	6+07.22	537.84-.86	G	5+21.50	539.97-.08
H	8+23.16	537.74-.73	H	5+37.46	539.85-.96
J	6+38.07	536.90-.92	J	5+53.40	539.04-.15
K	6+32.25	537.10-.12	K	5+46.53	539.24-.35
L	6+48.16	536.97-.99	L	5+62.46	539.10-.21
M	6+64.03	536.15-.17	M	5+78.38	539.27-.38

RAISED FIN. GRADE OF 43N - 1/4" RAISED FIN. GRADE OF 43S - 0.11'

NOTES:

- TIP HOOK END OF BAR AS REQUIRED TO ACHIEVE MINIMUM COVER.
- FOR DETAILS OF APPROACH SLAB PAVEMENT AND TRANSITION TO EXISTING PAVEMENT, SEE DETAIL ON TYPICAL END OF DECK SLAB DETAILS, BRIDGE SHEET C-15.

APPROACH SLAB PLANS  
SCALE: 1/8" = 1'-0"

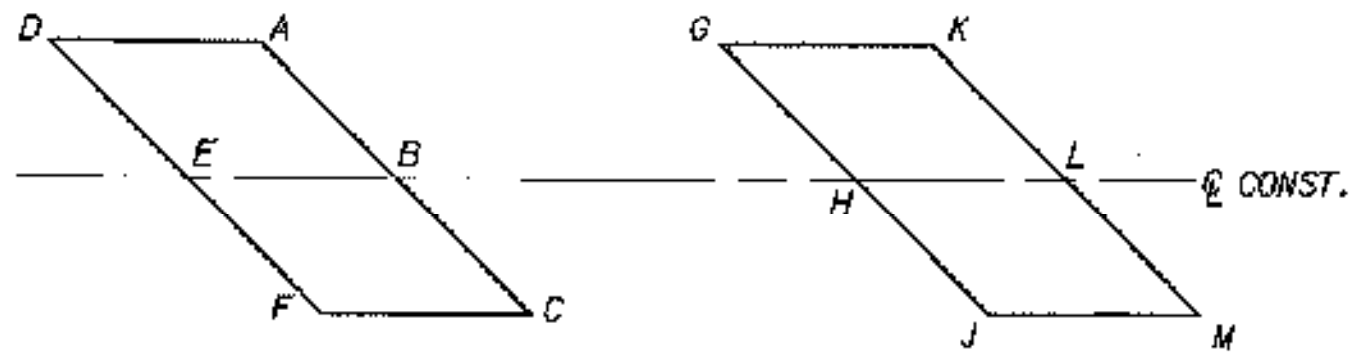

ABUTMENT 1 ABUTMENT 2

APPROACH SLAB ELEVATION KEY  
N.T.S.


STATE OF VERMONT  
AGENCY OF TRANSPORTATION

Town Of MIDDLESEX-BOLTON Bridge No. 43N&S  
Highway No. I-89 Log Sta. Surv. Sta.  
I-89 OVER U.S. ROUTE 2



APPROACH SLAB DETAILS (43N&S)

Designed By P.W. SZUSTAK Drawn By R.A. BOTZENHART  
Checked By Date Bridge Design Supervisor  
J.P. HALSTEAD 10/99 J.P. HALSTEAD Date 10/99

PROJECT MIDDLESEX-BOLTON PROJECT NO. IM-089-2(26)

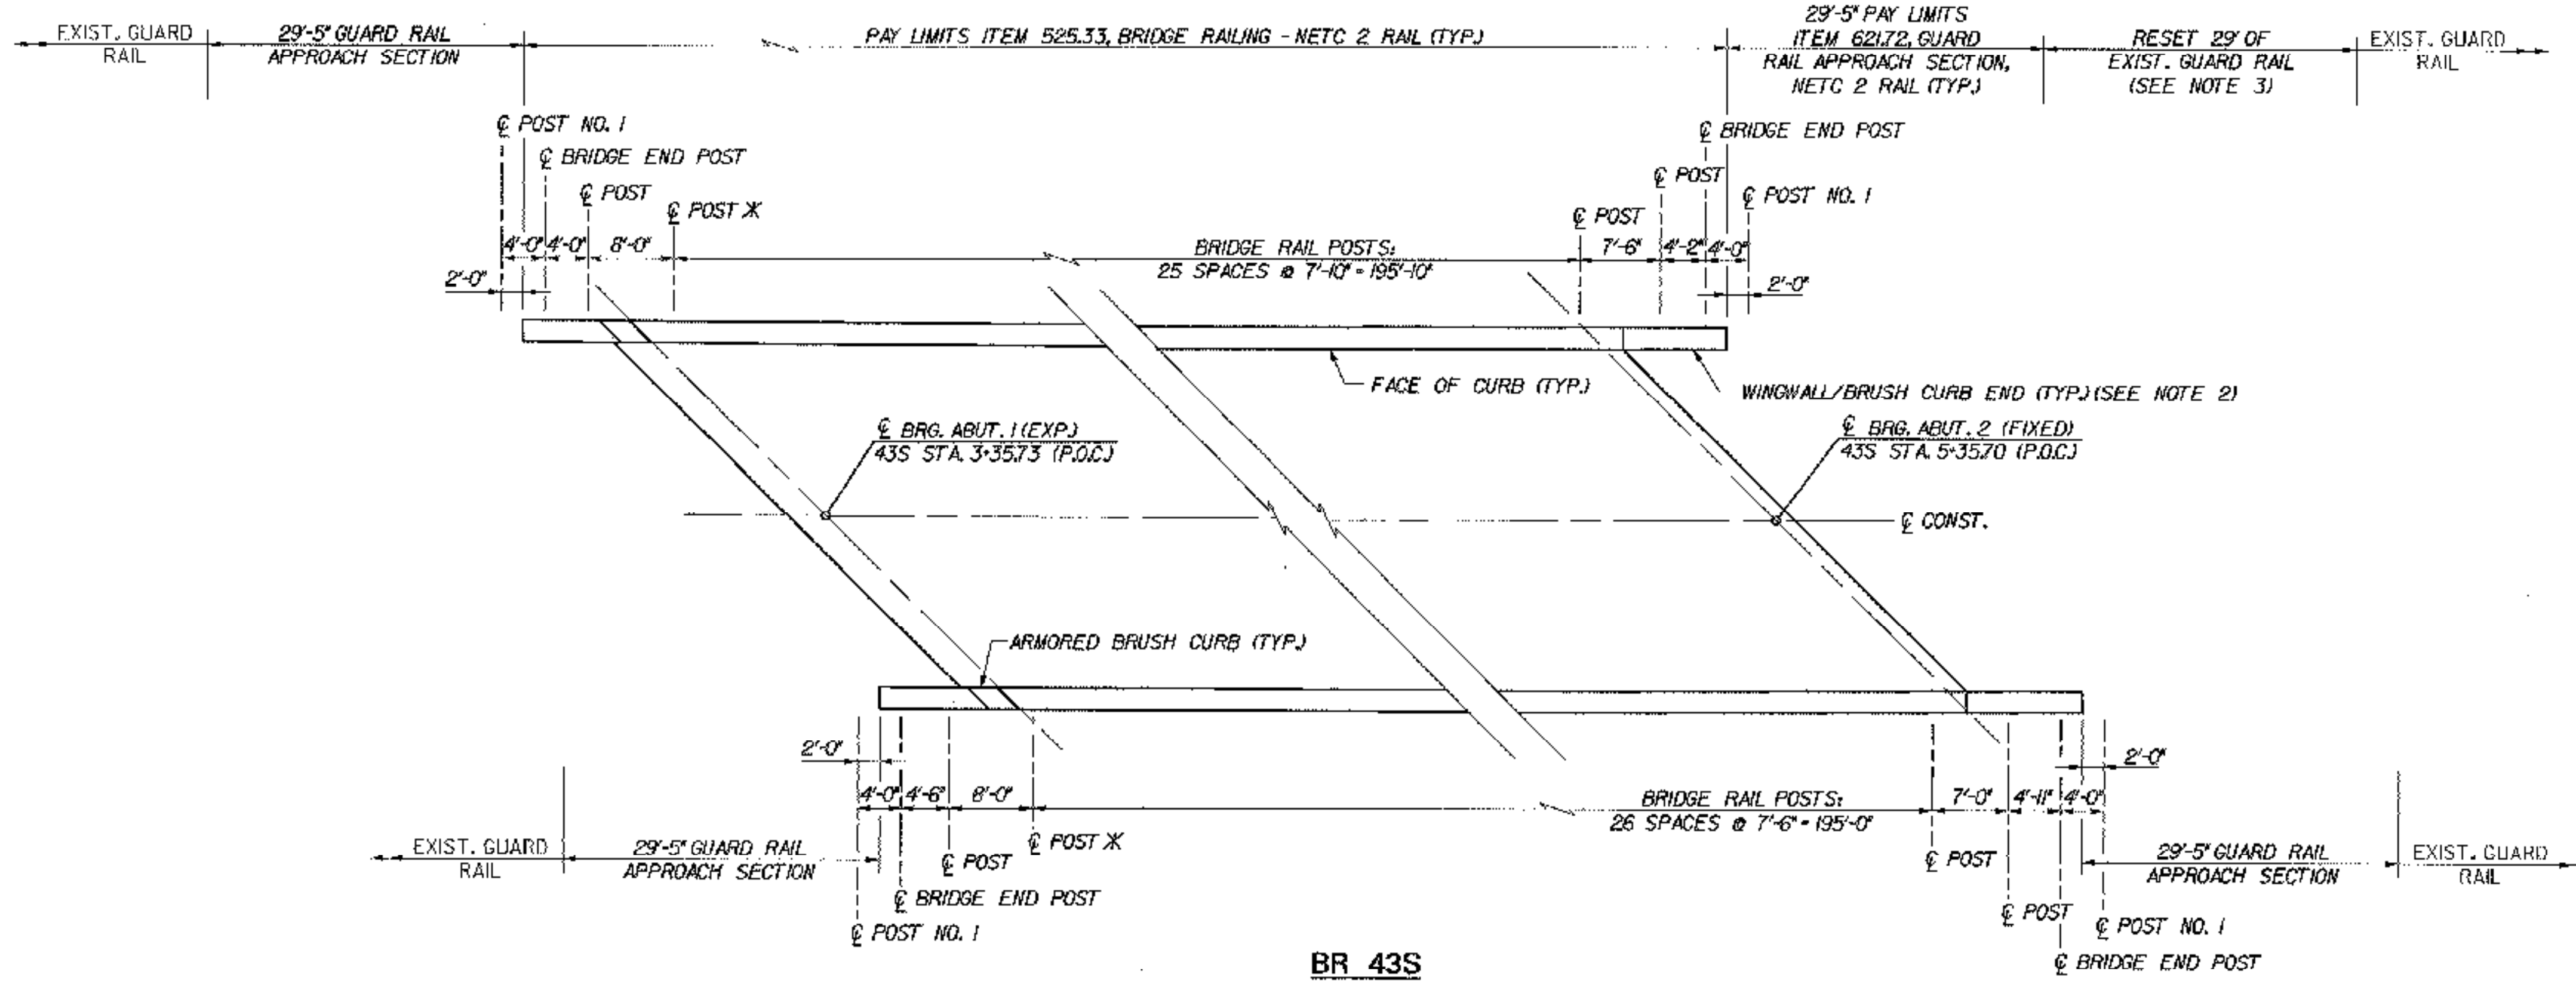

**CONSTRUCTION NOTE:**  
 END OF WINGWALLS HAVE BEEN LOCATED APPROXIMATELY BY VAOT SURVEY. CONTRACTOR SHALL VERIFY REQUIRED RAIL LENGTHS PRIOR TO SUBMITTING SHOP DRAWINGS FOR APPROVAL.

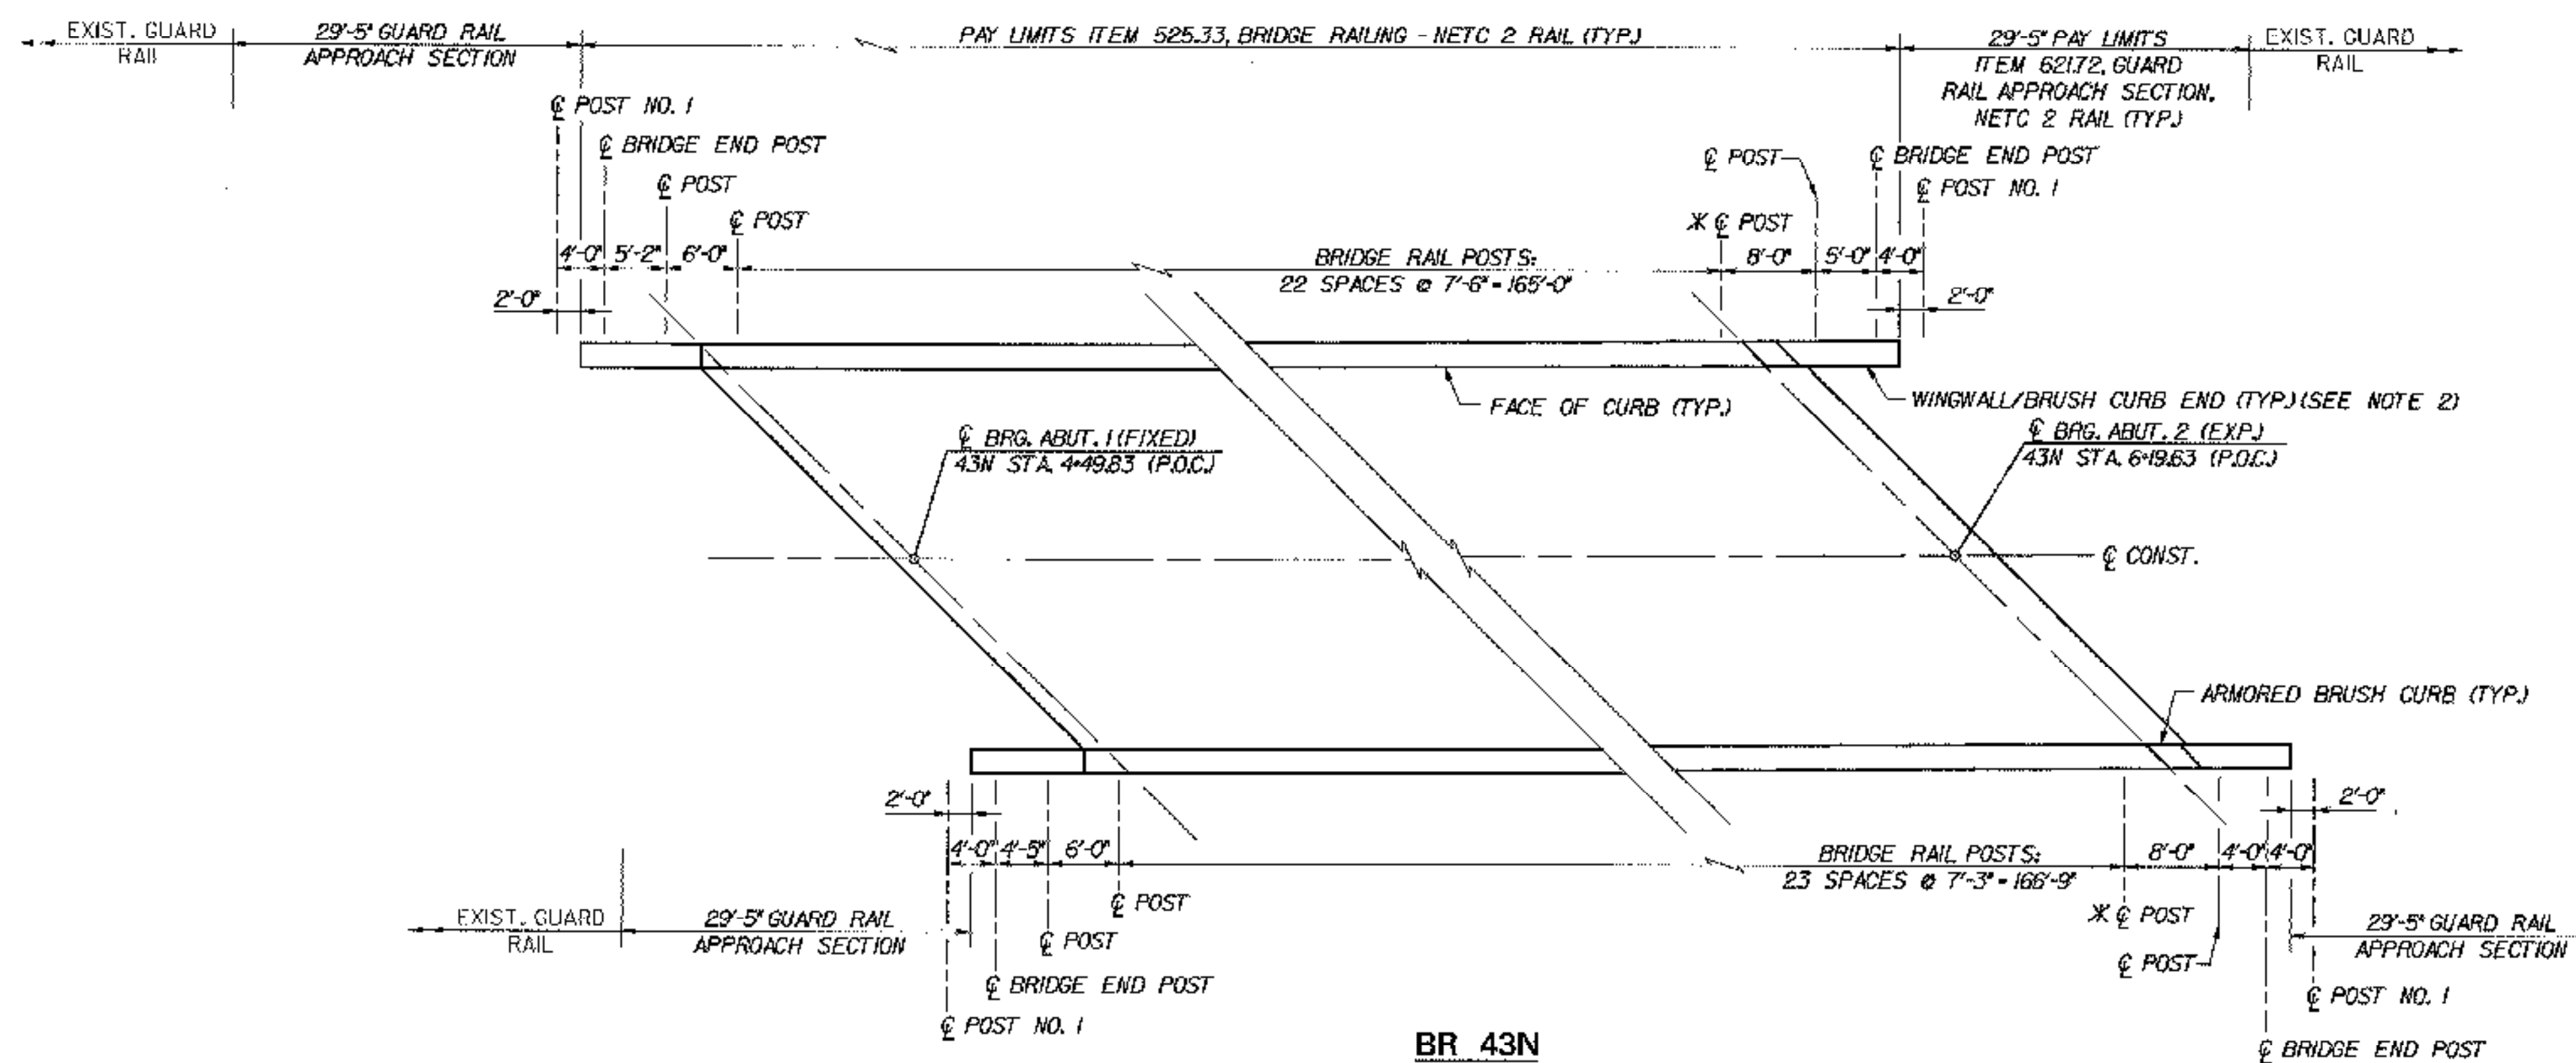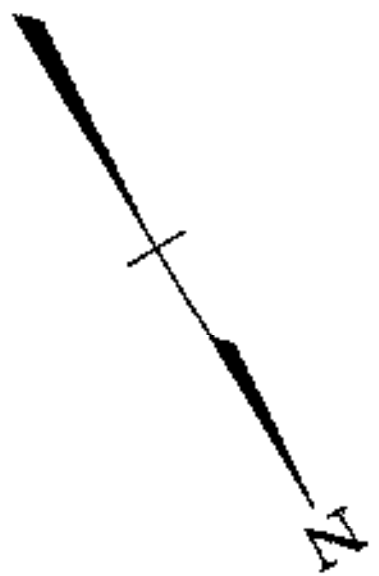


REPLACE 300' OF EXIST. GUARD RAIL NORTH OF BR 43N (SEE NOTE 4) **REPLACED BEFORE PROJECT BEGAN BY DISTRICT**

- NOTES:**
- FOR NETC 2-RAIL BRIDGE RAILING DETAILS AND INFORMATION ABOUT THE NETC GUARD RAIL APPROACH SECTION, SEE STANDARD SHEETS BR1-97 AND BR3-97, AND GUARD RAIL APPROACH SECTION, NETC 2 RAIL, BRIDGE SHEETS C-46A AND C-46B.
  - FOR BRUSH CURB END DETAIL, SEE TYPICAL WINGWALL DETAILS 1 OF 2, BRIDGE SHEET C-43.
  - ALL WORK REQUIRED TO RESET THE EXISTING GUARD RAIL SHALL BE PAID UNDER ITEM 621.75, "REMOVING AND RESET GUARD RAIL."
  - ALL WORK REQUIRED TO REPLACE GUARD RAIL, INCLUDING REMOVAL AND ATTACHMENT TO EXISTING GUARD RAIL, SHALL BE SUBSIDIARY TO ITEM 621.20, "STEEL BEAM GUARD RAIL."
  - A QUANTITY OF 40'-0" OF ITEM 616.28 'CAST-IN-PLACE CEMENT CONCRETE CURB, TYPE B' SHALL BE PLACED AT THE END OF EACH WINGWALL. SEE GUARD RAIL APPROACH SECTION, NETC 2 RAIL, BRIDGE SHEETS C-46A AND C-46B FOR DETAILS.


**RAILING LAYOUT**  
 SCALE: 3/32" = 1'-0"  
 \* RAIL EXPANSION JOINT SHALL BE LOCATED 2'-0" FROM @ OF INDICATED POST, ON BRIDGE EXPANSION JOINT SIDE OF POST.

<b>STATE OF VERMONT AGENCY OF TRANSPORTATION</b>	
Town Of <b>MIDDLESEX-BOLTON</b>	Bridge No. <b>43N&amp;S</b>
Highway No. <b>I-89</b>	Log Sta. <b></b>
<b>I-89 OVER US ROUTE 2</b>	
<b>CURB AND RAIL LAYOUT PLANS (43N&amp;S)</b>	
Designed By <b>P.W. SZUSTAK</b>	Drawn By <b>R.A. BOTZENHART</b>
Checked By <b>J.P. HALSTEAD</b>	Bridge Design Supervisor <b>J.P. HALSTEAD</b>
Date <b>10/99</b>	Date <b>10/99</b>
PROJECT <b>MIDDLESEX-BOLTON</b>	PROJECT NO. <b>IM-089-2(26)</b>
TVGA CAD Drawing No. <b>43brall</b>	Date <b>10/99</b>
Bridge Sheet No. <b>BR43-7</b>	Sheet <b>53</b> of <b>307</b>

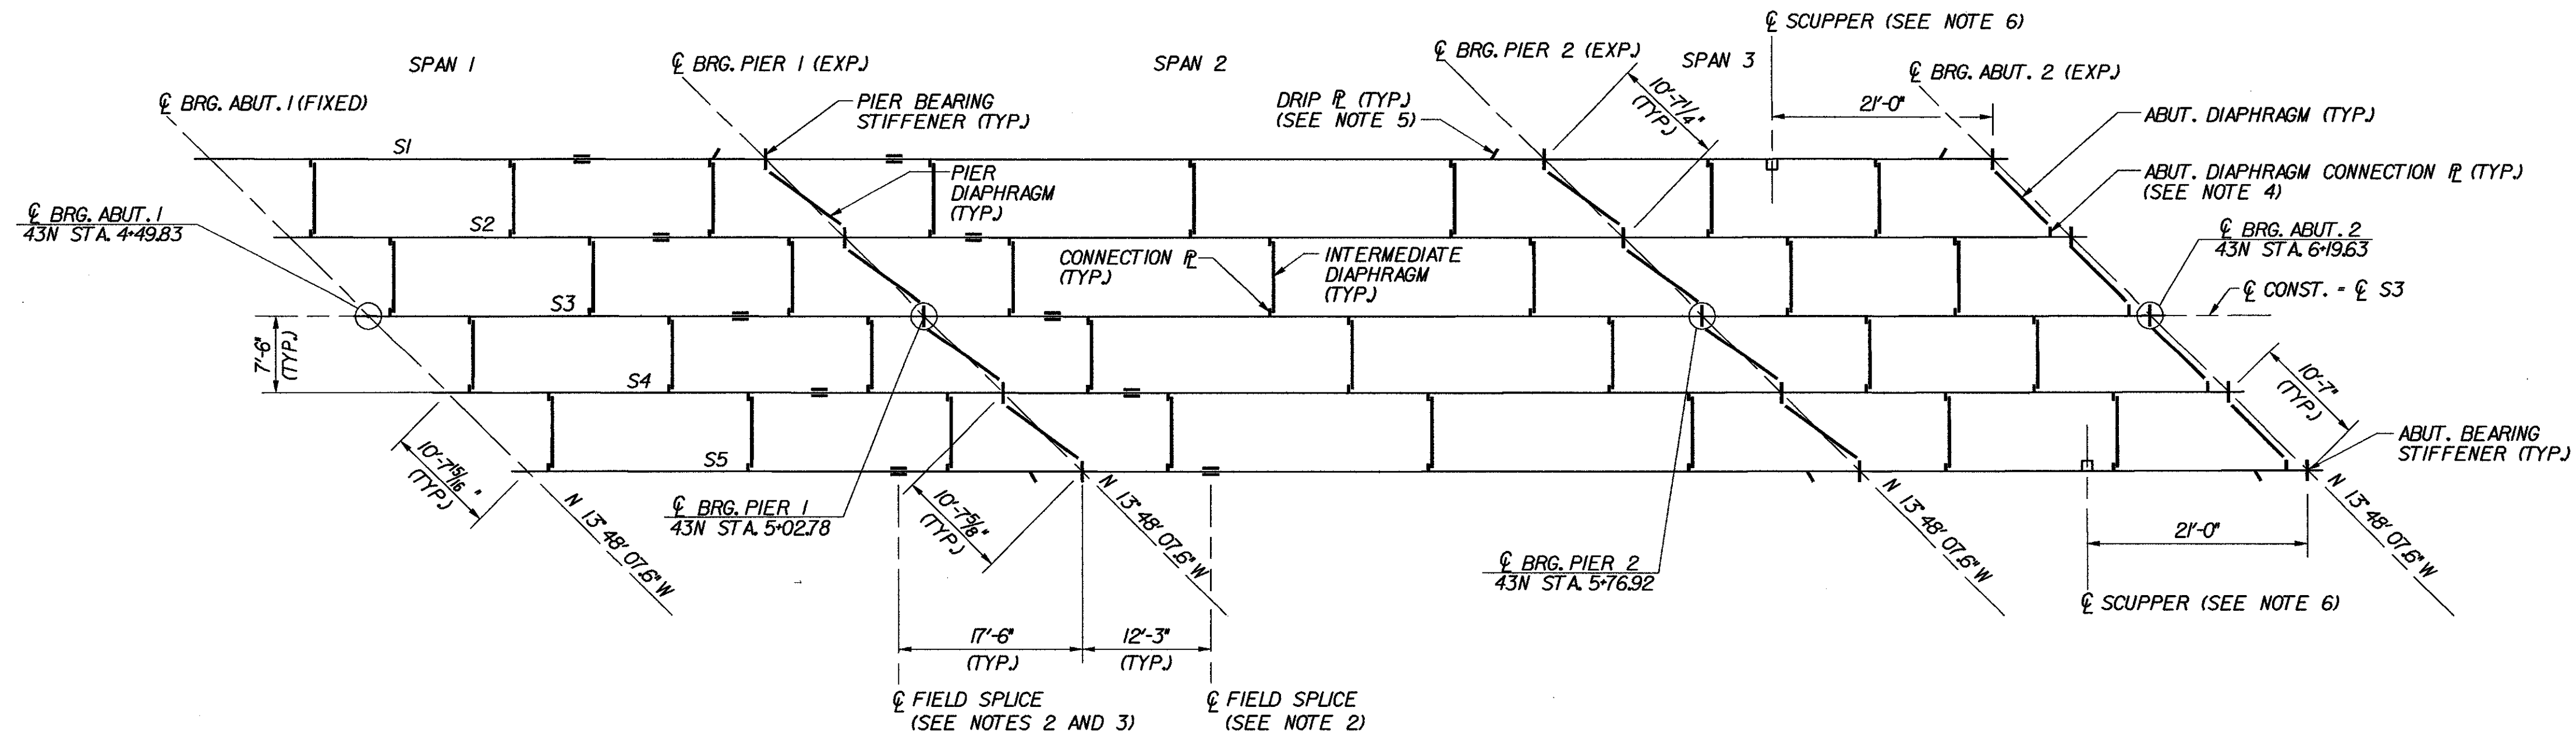

**FRAMING PLAN - BR 43N**

SCALE: 3/32" = 1'-0"

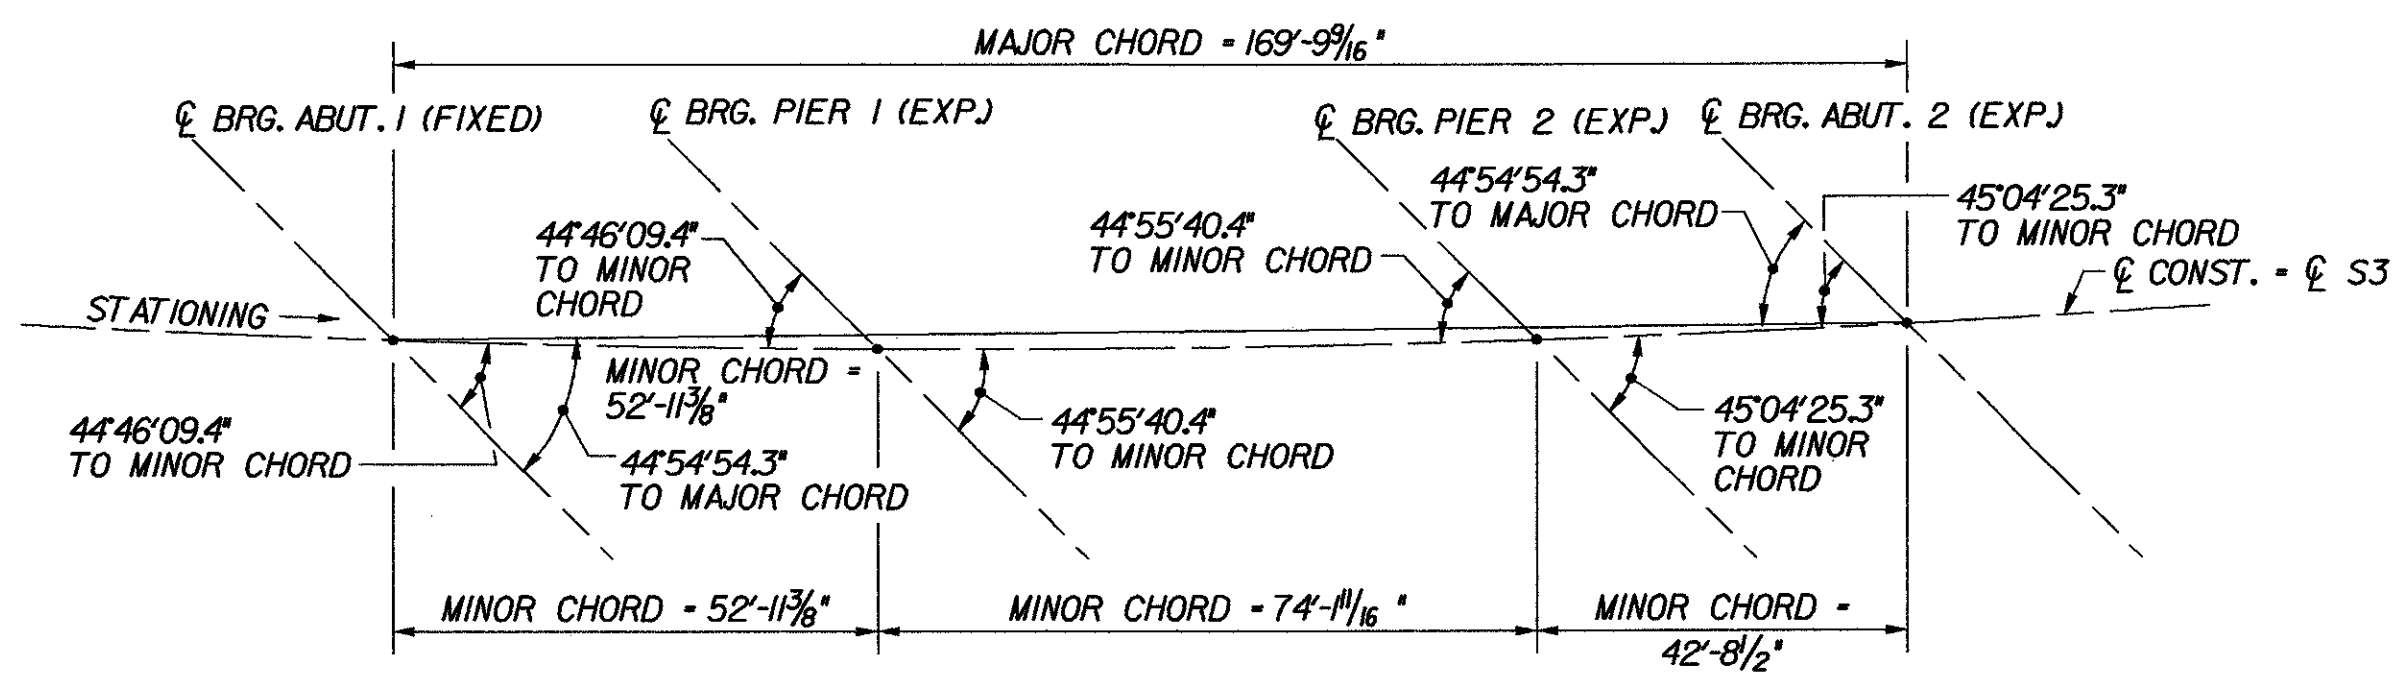

**LAYOUT DIAGRAM**

N.T.S.

**NOTES:**

- FOR ROLLED BEAM AND DIAPHRAGM DETAILS, SEE TYPICAL ROLLED BEAM DETAILS, BRIDGE SHEET C-16.
- FOR FIELD SPLICE DETAILS, SEE TYPICAL ROLLED BEAM SPLICE DETAILS, BRIDGE SHEET C-19.
- FIELD SPLICE IN SPAN 1 IS OPTIONAL.
- STRINGER LAYOUT DIMENSIONS BEGIN AND END AT ABUTMENT CENTERLINES OF BEARING. LOCATION OF ABUTMENT DIAPHRAGM CONNECTION PLATES NOT INCLUDED IN TABLE. THE CONTRACTOR SHALL PROVIDE THIS DIMENSION IN SHOP DRAWINGS IN ACCORDANCE WITH DETAILS SHOWN IN TYPICAL ROLLED BEAM DETAILS, BRIDGE SHEET C-16.
- FOR DRIP PLATE DETAIL, SEE TYPICAL BRIDGE DETAILS, BRIDGE SHEET C-46.
- FOR SCUPPER DETAILS, SEE TYPICAL SCUPPER DETAILS, BRIDGE SHEET C-39.


STRINGER NUMBER	STRINGER RADIUS	SIDE	SPAN 1 (ALONG ARC)				SPAN 2 (ALONG ARC)				SPAN 3 (ALONG ARC)					
			BRG. STIFFENER / CONNECTION PL. SPACING				TOTAL	BRG. STIFFENER / CONNECTION PL. SPACING				TOTAL	BRG. STIFFENER / CONNECTION PL. SPACING			
S1	22940.32'	LEFT					52' - 11 13/16"					74' - 2 1/4"				42' - 8 7/8"
		RIGHT	10' - 0"	19' - 0"	19' - 0"	4' - 11 13/16"		16' - 0"	25' - 0"	25' - 0"	8' - 2 1/4"		15' - 8 5/8"	16' - 0"	11' - 0 1/4"	
S2	22947.82'	LEFT	2' - 5"	19' - 0"	19' - 0"	12' - 6 5/8"	52' - 11 5/8"	8' - 5 7/16"	25' - 0"	25' - 0"	15' - 8 1/2"	74' - 1 15/16"	8' - 2 11/16"	16' - 0"	18' - 6"	42' - 8 11/16"
		RIGHT	10' - 0"	19' - 0"	19' - 0"	4' - 11 5/8"		16' - 0"	25' - 0"	25' - 0"	8' - 1 15/16"		15' - 8 3/8"	16' - 0"	11' - 0 5/16"	
S3	22955.32'	LEFT	2' - 5 1/16"	19' - 0"	19' - 0"	12' - 6 3/8"	52' - 11 7/16"	8' - 5 1/2"	25' - 0"	25' - 0"	15' - 8 3/16"	74' - 1 11/16"	8' - 2 1/2"	16' - 0"	18' - 6"	42' - 8 1/2"
		RIGHT	10' - 0"	19' - 0"	19' - 0"	4' - 11 7/16"		16' - 0"	25' - 0"	25' - 0"	8' - 1 11/16"		15' - 8 1/8"	16' - 0"	11' - 0 3/8"	
S4	22962.82'	LEFT	2' - 5 1/8"	19' - 0"	19' - 0"	12' - 6 1/16"	52' - 11 3/16"	8' - 5 9/16"	25' - 0"	25' - 0"	15' - 7 13/16"	74' - 1 3/8"	8' - 2 3/8"	16' - 0"	18' - 6"	42' - 8 3/8"
		RIGHT	10' - 0"	19' - 0"	19' - 0"	4' - 11 3/16"		16' - 0"	25' - 0"	25' - 0"	8' - 1 3/8"		15' - 7 15/16"	16' - 0"	11' - 0 7/16"	
S5	22970.32'	LEFT	2' - 5 3/16"	19' - 0"	19' - 0"	12' - 5 13/16"	52' - 11"	8' - 5 5/8"	25' - 0"	25' - 0"	15' - 7 7/16"	74' - 1 1/16"	8' - 2 3/16"	16' - 0"	18' - 6"	42' - 8 3/16"
		RIGHT														

**STRINGER LAYOUT TABLE**

(SEE NOTE 4)


**STATE OF VERMONT  
AGENCY OF TRANSPORTATION**

Town Of	MIDDLESEX-BOLTON	Bridge No.	<b>43N</b>
Highway No.	I-89	Log Sta.	
		Surv. Sta.	
I-89 NB OVER U.S. ROUTE 2			
<b>FRAMING PLAN (43N)</b>			
Designed By	P.W. SZUSTAK	Drawn By	R.A. BOTZENHART
Checked By	J.P. HALSTEAD	Date	10/99
		Bridge Design Supervisor	J.P. HALSTEAD Date 10/99
PROJECT	MIDDLESEX-BOLTON	PROJECT NO.	IM-089-2(26)
TVGA CAD Drawing No.	43nfp	Date	10/99
Bridge Sheet No.	<b>BR43-8</b>	Sheet	54 of 307

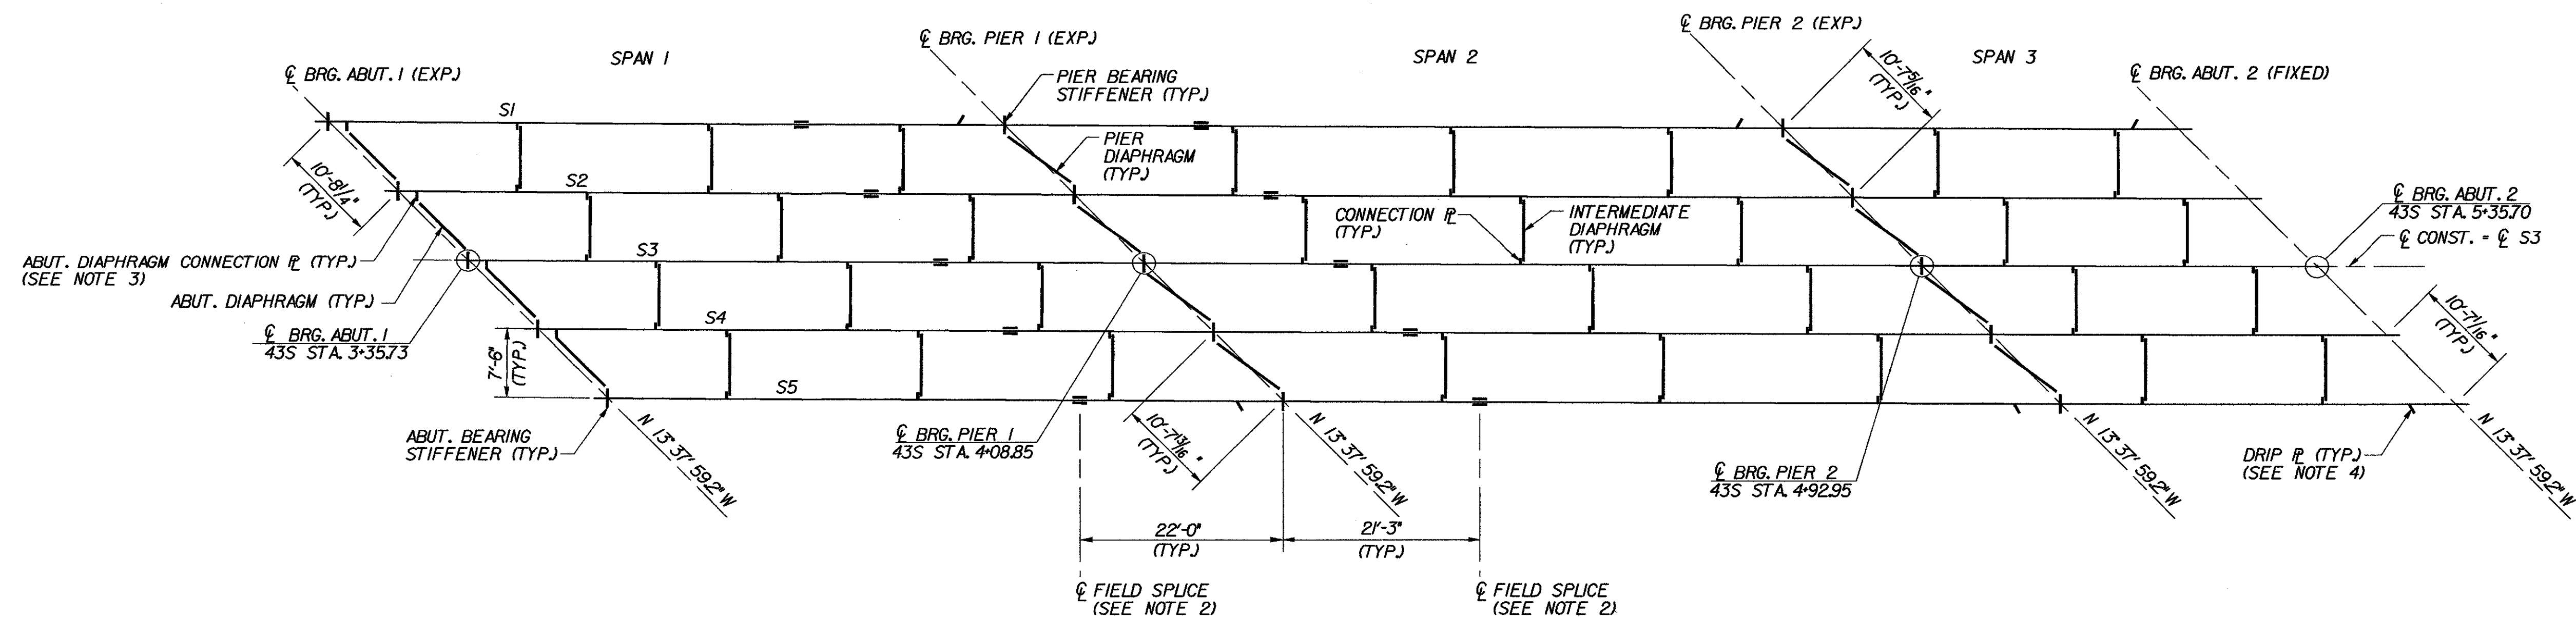

**FRAMING PLAN - BR 43S**

SCALE: 3/32" = 1'-0"

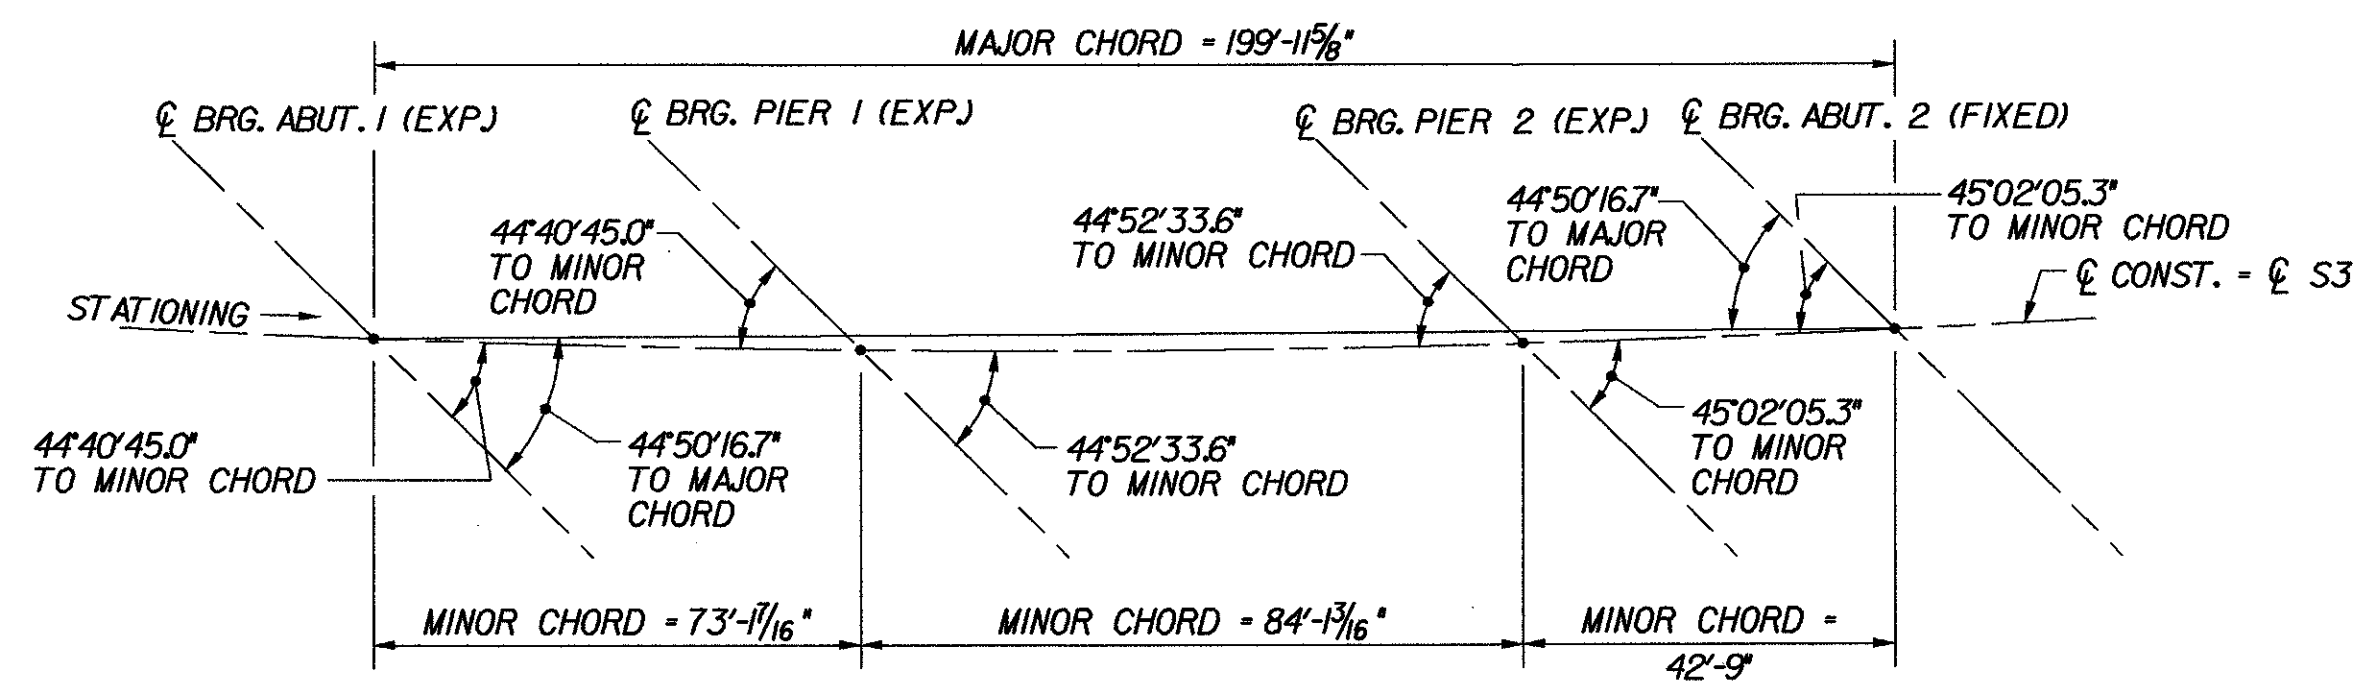

**LAYOUT DIAGRAM**

N.T.S.

**NOTES:**

- FOR ROLLED BEAM AND DIAPHRAGM DETAILS, SEE TYPICAL ROLLED BEAM DETAILS, BRIDGE SHEET C-16.
- FOR FIELD SPLICE DETAILS, SEE TYPICAL ROLLED BEAM SPLICE DETAILS, BRIDGE SHEET C-19.
- STRINGER LAYOUT DIMENSIONS BEGIN AND END AT ABUTMENT CENTERLINES OF BEARING. LOCATION OF ABUTMENT DIAPHRAGM CONNECTION PLATES NOT INCLUDED IN TABLE. THE CONTRACTOR SHALL PROVIDE THIS DIMENSION IN SHOP DRAWINGS IN ACCORDANCE WITH DETAILS SHOWN IN TYPICAL ROLLED BEAM DETAILS, BRIDGE SHEET C-16.
- FOR DRIP PLATE DETAIL, SEE TYPICAL BRIDGE DETAILS, BRIDGE SHEET C-46.


STRINGER NUMBER	STRINGER RADIUS	SIDE	SPAN 1 (ALONG ARC)				SPAN 2 (ALONG ARC)				SPAN 3 (ALONG ARC)						
			BRG. STIFFENER / CONNECTION PL. SPACING				TOTAL	BRG. STIFFENER / CONNECTION PL. SPACING				TOTAL	BRG. STIFFENER / CONNECTION PL. SPACING				TOTAL
S1	22866.32'	LEFT					73' - 2 1/16"					84' - 1 7/8"					42' - 9 5/16"
		RIGHT	21' - 6"	21' - 6"	21' - 6"	8' - 8 1/16"		25' - 0"	25' - 0"	25' - 0"	9' - 1 7/8"		16' - 9 3/16"	19' - 6"	6' - 6 1/8"		
S2	22873.82'	LEFT	13' - 10 11/16"	21' - 6"	21' - 6"	16' - 3 1/16"	73' - 1 3/4"	17' - 5 1/4"	25' - 0"	25' - 0"	16' - 8 1/4"	84' - 1 1/2"	9' - 3 3/16"	19' - 6"	14' - 0"	42' - 9 3/16"	
		RIGHT	21' - 6"	21' - 6"	21' - 6"	8' - 7 3/4"		25' - 0"	25' - 0"	25' - 0"	9' - 1 1/2"		16' - 9"	19' - 6"	6' - 6 3/16"		
S3	22881.32'	LEFT	13' - 10 3/4"	21' - 6"	21' - 6"	16' - 2 11/16"	73' - 1 7/16"	17' - 5 5/16"	25' - 0"	25' - 0"	16' - 7 7/8"	84' - 1 3/16"	9' - 3"	19' - 6"	14' - 0"	42' - 9"	
		RIGHT	21' - 6"	21' - 6"	21' - 6"	8' - 7 7/16"		25' - 0"	25' - 0"	25' - 0"	9' - 1 3/16"		16' - 8 3/4"	19' - 6"	6' - 6 1/4"		
S4	22888.82'	LEFT	13' - 10 13/16"	21' - 6"	21' - 6"	16' - 2 3/8"	73' - 1 3/16"	17' - 5 3/8"	25' - 0"	25' - 0"	16' - 7 1/2"	84' - 0 7/8"	9' - 2 13/16"	19' - 6"	14' - 0"	42' - 8 13/16"	
		RIGHT	21' - 6"	21' - 6"	21' - 6"	8' - 7 3/16"		25' - 0"	25' - 0"	25' - 0"	9' - 0 7/8"		16' - 8 1/2"	19' - 6"	6' - 6 5/16"		
S5	22896.32'	LEFT	13' - 10 7/8"	21' - 6"	21' - 6"	16' - 2"	73' - 0 7/8"	17' - 5 7/16"	25' - 0"	25' - 0"	16' - 7 1/16"	84' - 0 1/2"	9' - 2 11/16"	19' - 6"	14' - 0"	42' - 8 11/16"	
		RIGHT															

**STRINGER LAYOUT TABLE**

(SEE NOTE 3)



**STATE OF VERMONT  
AGENCY OF TRANSPORTATION**

Town Of	MIDDLESEX-BOLTON	Bridge No.	<b>43S</b>
Highway No.	I-89	Log Sta.	
		Surv. Sta.	
I-89 SB OVER U.S. ROUTE 2			
<b>FRAMING PLAN (43S)</b>			
Designed By	P.W. SZUSTAK	Drawn By	R.A. BOTZENHART
Checked By	Date	Bridge Design Supervisor	Date
	J.P. HALSTEAD 10/99	J.P. HALSTEAD	10/99
PROJECT	MIDDLESEX-BOLTON	PROJECT NO.	IM-089-2(26)
TVGA CAD Drawing No.	43sfp	Date	10/99
Bridge Sheet No.	<b>BR43-9</b>	Sheet	55 of 307

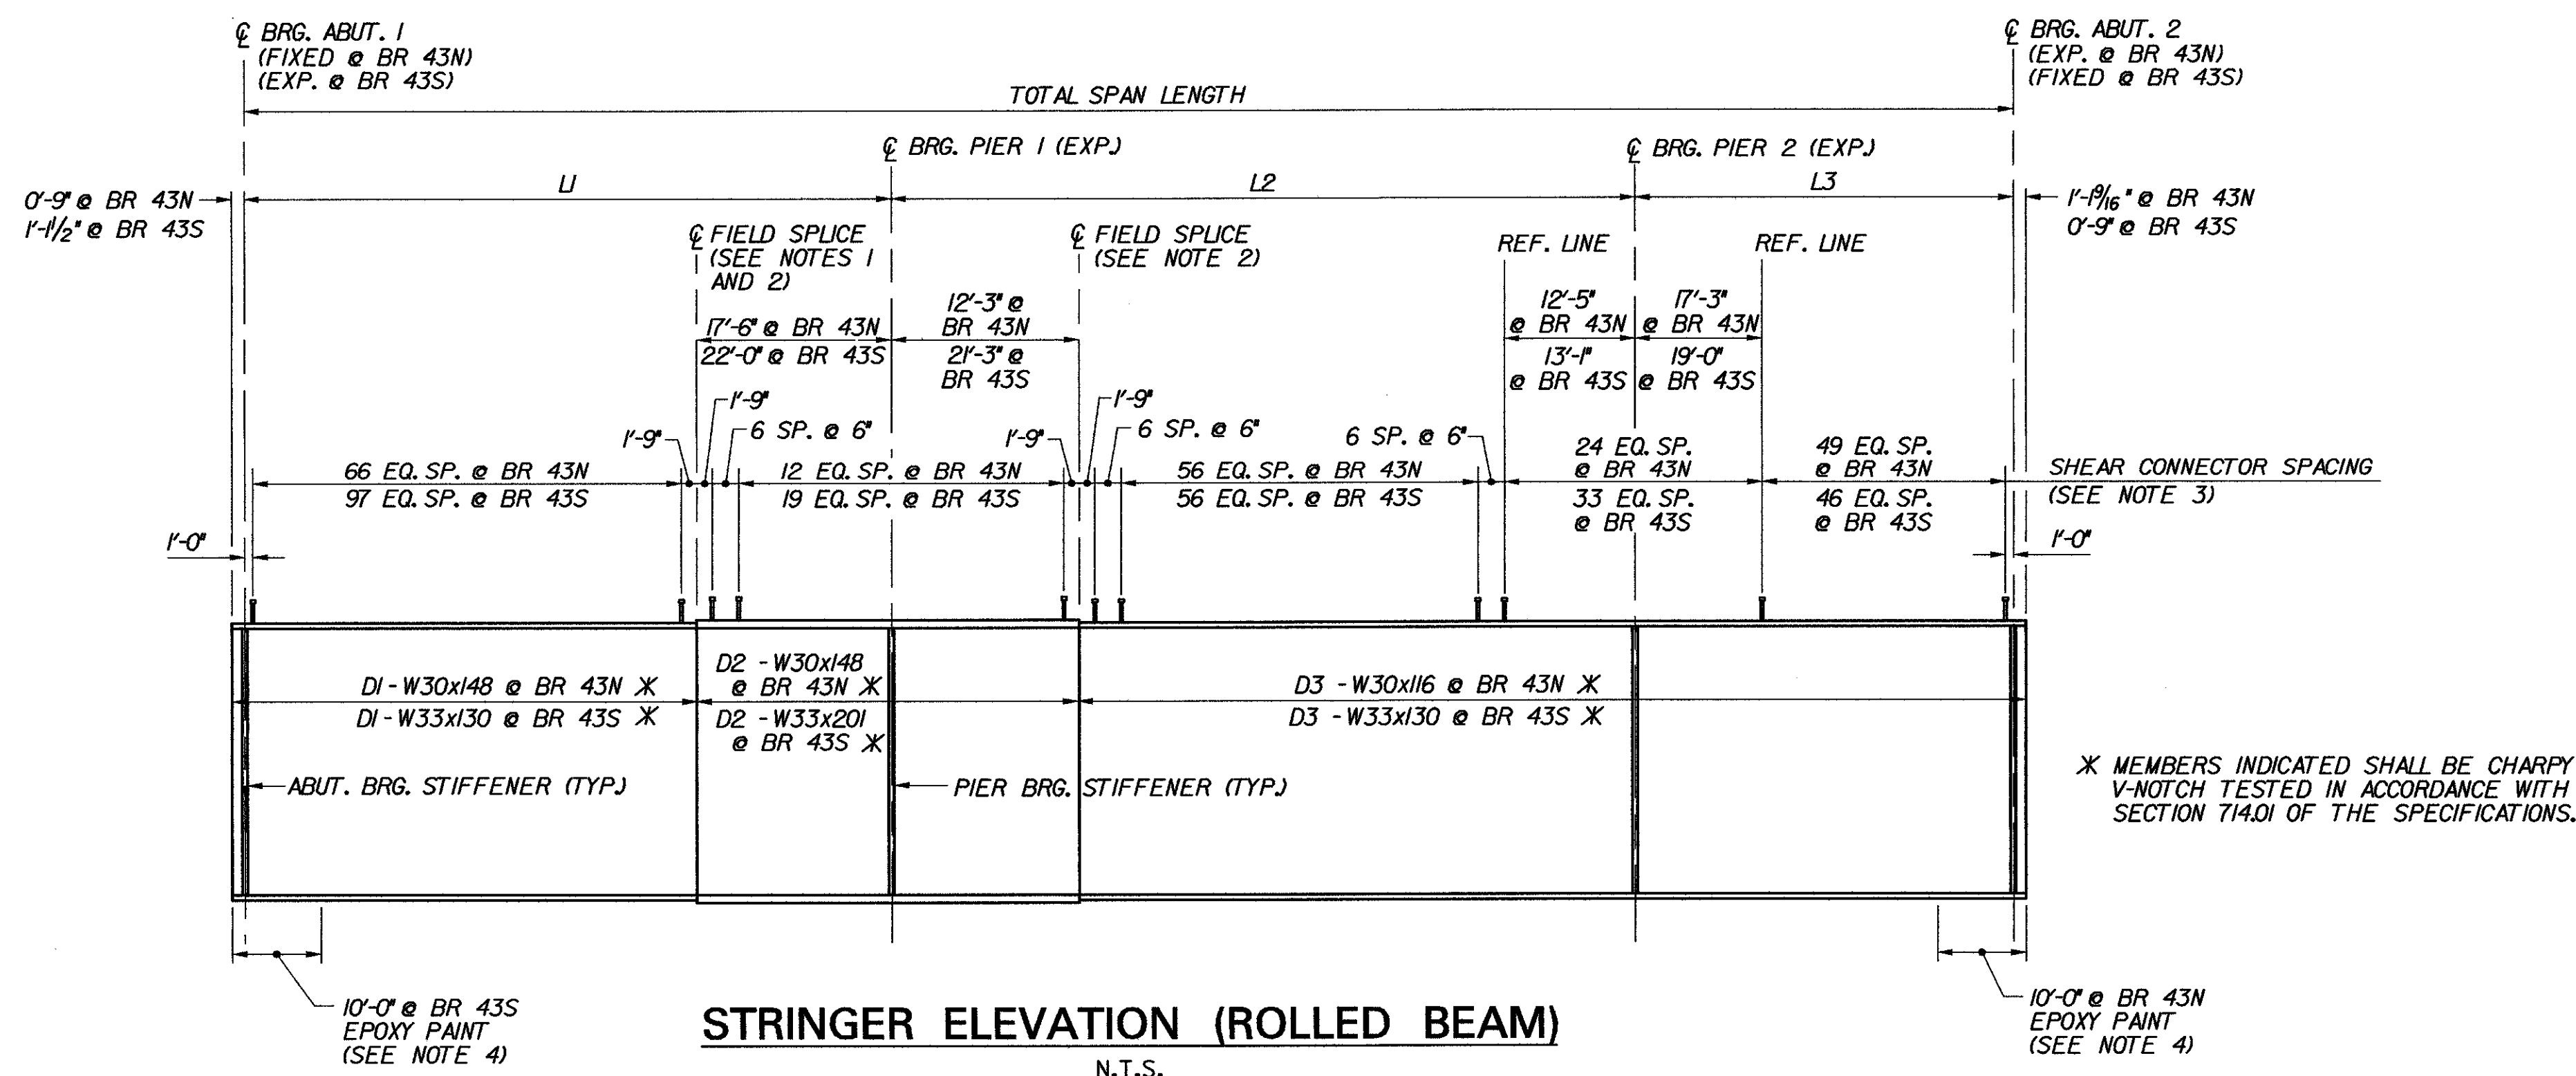

BR 43N					
STRINGER	RADIUS	SPAN LENGTHS (ALONG ARC)			TOTAL SPAN LENGTH
		L1	L2	L3	
S1	22940.32'	52' - 11 13/16"	74' - 2 1/4"	42' - 8 7/8"	169' - 10 15/16"
S2	22947.82'	52' - 11 5/8"	74' - 1 15/16"	42' - 8 11/16"	169' - 10 1/4"
S3	22955.32'	52' - 11 7/16"	74' - 1 11/16"	42' - 8 1/2"	169' - 9 5/8"
S4	22962.82'	52' - 11 3/16"	74' - 1 3/8"	42' - 8 3/8"	169' - 8 15/16"
S5	22970.32'	52' - 11"	74' - 1 1/16"	42' - 8 3/16"	169' - 8 1/4"
STRINGER		SECTION LENGTHS (ALONG ARC)			
		D1	D2	D3	
S1		36' - 2 13/16"	29' - 9"	105' - 9 11/16"	
S2		36' - 2 5/8"	29' - 9"	105' - 9 3/16"	
S3		36' - 2 7/16"	29' - 9"	105' - 8 3/4"	
S4		36' - 2 3/16"	29' - 9"	105' - 8 5/16"	
S5		36' - 2"	29' - 9"	105' - 7 13/16"	

BR 43S					
STRINGER	RADIUS	SPAN LENGTHS (ALONG ARC)			TOTAL SPAN LENGTH
		L1	L2	L3	
S1	22866.32'	73' - 2 1/16"	84' - 1 7/8"	42' - 9 5/16"	200' - 1 1/4"
S2	22873.82'	73' - 1 3/4"	84' - 1 1/2"	42' - 9 3/16"	200' - 0 7/16"
S3	22881.32'	73' - 1 7/16"	84' - 1 3/16"	42' - 9"	199' - 11 5/8"
S4	22888.82'	73' - 1 3/16"	84' - 0 7/8"	42' - 8 13/16"	199' - 10 7/8"
S5	22896.32'	73' - 0 7/8"	84' - 0 1/2"	42' - 8 11/16"	199' - 10 1/16"
STRINGER		SECTION LENGTHS (ALONG ARC)			
		D1	D2	D3	
S1		52' - 3 9/16"	43' - 3"	106' - 5 3/16"	
S2		52' - 3 1/4"	43' - 3"	106' - 4 11/16"	
S3		52' - 2 15/16"	43' - 3"	106' - 4 3/16"	
S4		52' - 2 11/16"	43' - 3"	106' - 3 11/16"	
S5		52' - 2 3/8"	43' - 3"	106' - 3 3/16"	

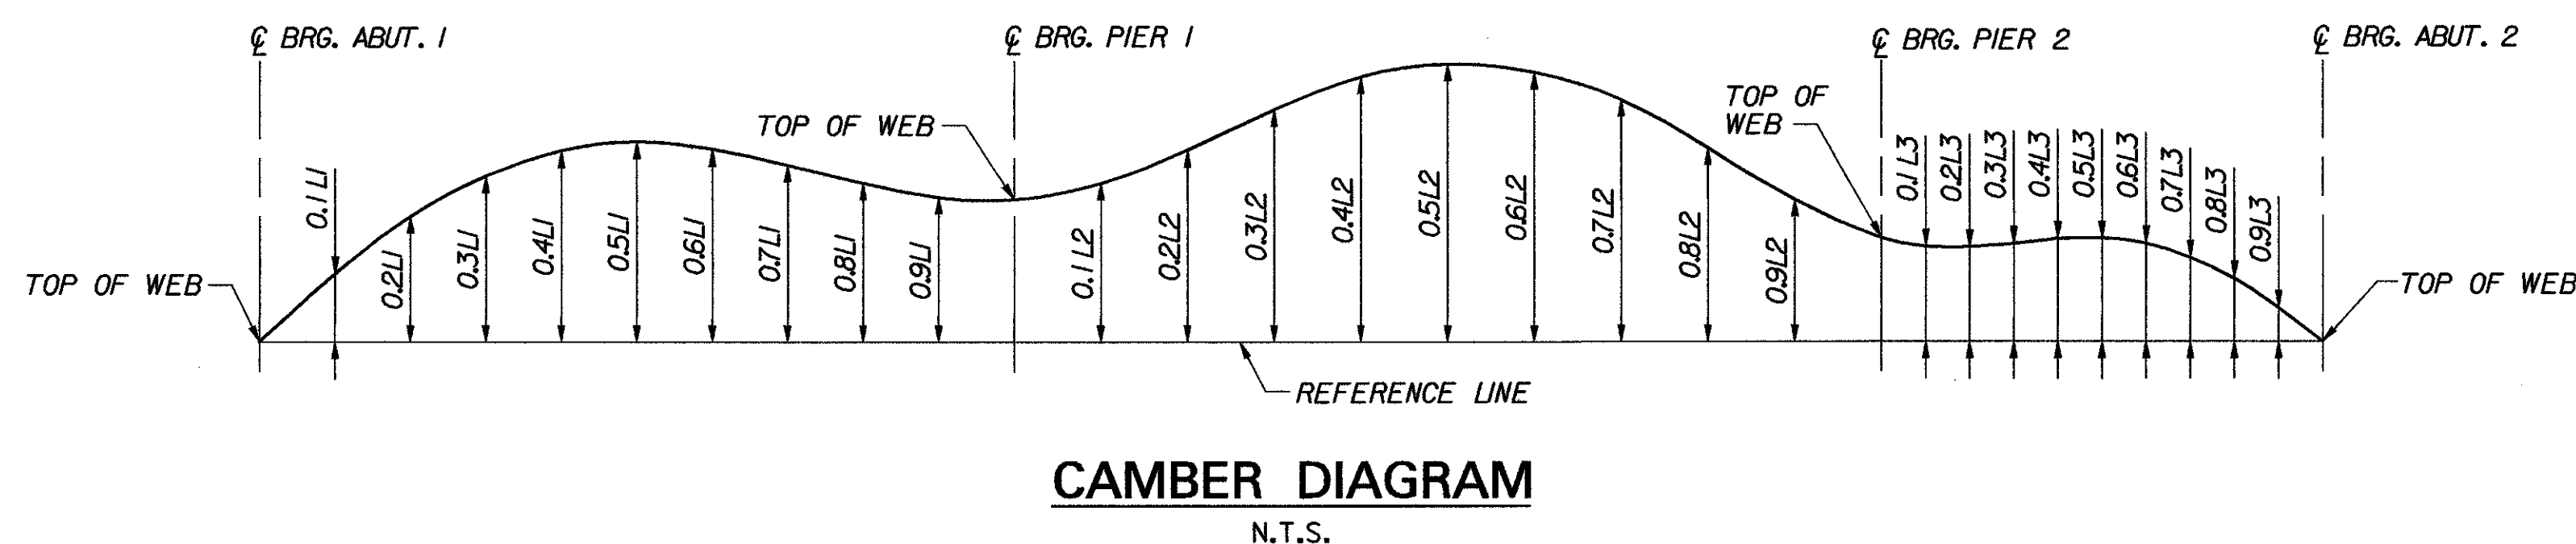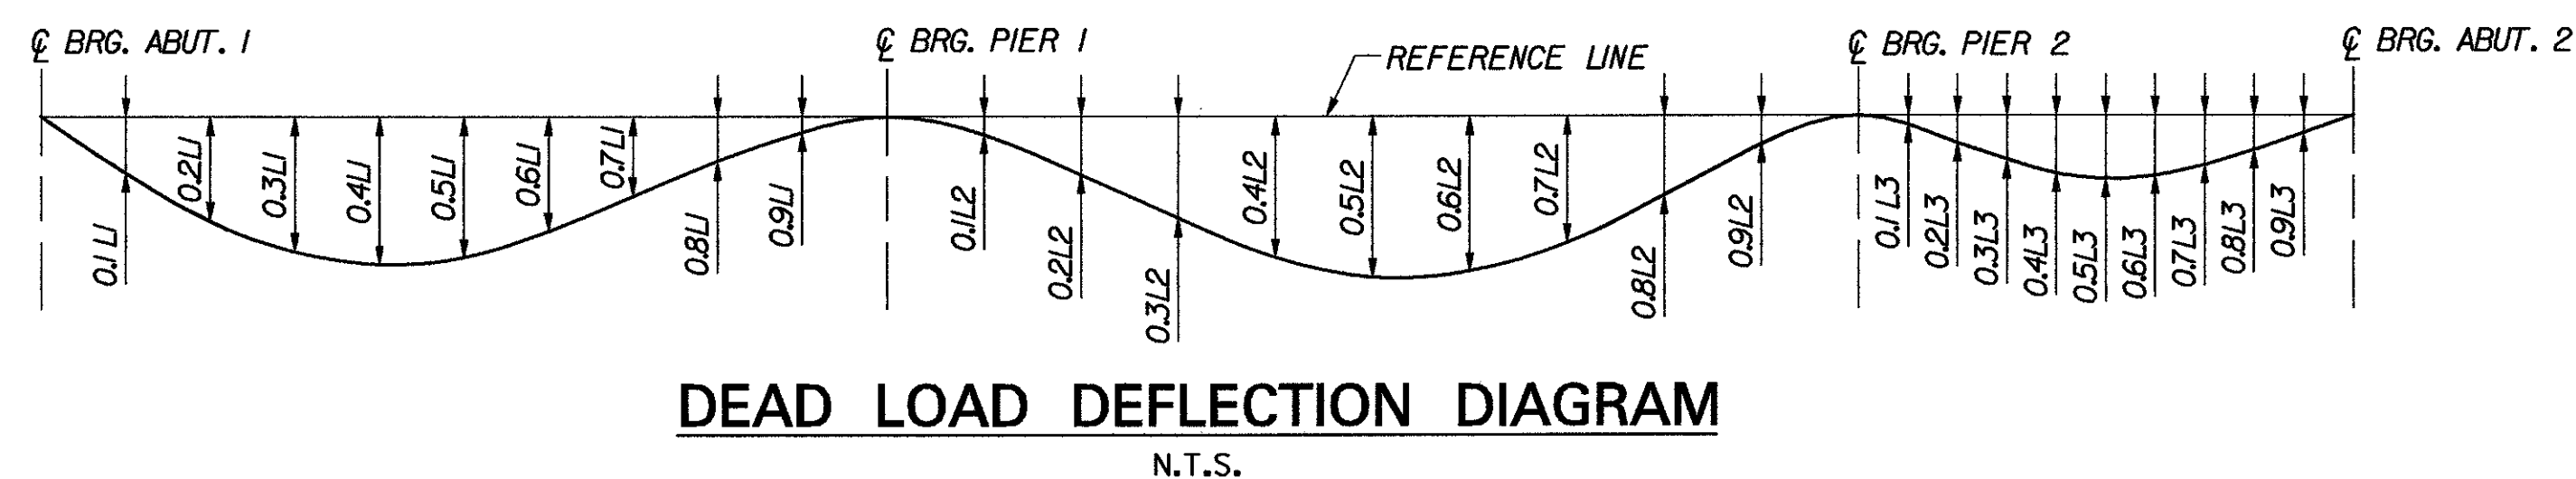

BRIDGE	DL DEFLECTION																														
	CL	L1									CL	L2									CL	L3									CL
	ABUT. 1	0.1 L1	0.2 L1	0.3 L1	0.4 L1	0.5 L1	0.6 L1	0.7 L1	0.8 L1	0.9 L1	PIER 1	0.1 L2	0.2 L2	0.3 L2	0.4 L2	0.5 L2	0.6 L2	0.7 L2	0.8 L2	0.9 L2	PIER 2	0.1 L3	0.2 L3	0.3 L3	0.4 L3	0.5 L3	0.6 L3	0.7 L3	0.8 L3	0.9 L3	ABUT. 2
43N	0"	0 1/8"	0 3/16"	0 1/4"	0 1/4"	0 3/16"	0 1/8"	0 1/16"	0"	-0 1/16"	0"	0 1/4"	0 11/16"	1 1/16"	1 5/16"	1 7/16"	1 3/8"	1 1/8"	0 3/4"	0 5/16"	0"	-0 1/16"	-0 1/8"	-0 1/16"	0"	0"	0 1/16"	0 1/16"	0 1/16"	0"	
43S	0"	0 1/2"	0 15/16"	1 3/16"	1 5/16"	1 1/4"	1"	0 11/16"	0 3/8"	0 1/8"	0"	0 1/8"	0 1/2"	0 7/8"	1 1/4"	1 7/16"	1 3/8"	1 3/16"	0 3/4"	0 5/16"	0"	-0 1/16"	-0 1/8"	-0 1/8"	-0 1/16"	-0 1/16"	0"	0"	0"	0"	

BRIDGE	TOTAL CAMBER																														
	CL	L1									CL	L2									CL	L3									CL
	ABUT. 1	0.1 L1	0.2 L1	0.3 L1	0.4 L1	0.5 L1	0.6 L1	0.7 L1	0.8 L1	0.9 L1	PIER 1	0.1 L2	0.2 L2	0.3 L2	0.4 L2	0.5 L2	0.6 L2	0.7 L2	0.8 L2	0.9 L2	PIER 2	0.1 L3	0.2 L3	0.3 L3	0.4 L3	0.5 L3	0.6 L3	0.7 L3	0.8 L3	0.9 L3	ABUT. 2
43N	0"	0 9/16"	0 15/16"	1 3/16"	1 1/4"	1 1/8"	0 7/8"	0 1/2"	0 3/16"	0"	0"	0 5/16"	0 15/16"	1 5/8"	2 3/16"	2 7/16"	2 1/4"	1 11/16"	1"	0 3/8"	0"	0"	0 1/8"	0 7/16"	0 13/16"	1"	1 1/16"	1"	0 13/16"	0 1/2"	0"
43S	0"	1 1/16"	2 1/16"	2 13/16"	3 3/8"	3 5/8"	3 9/16"	3 5/16"	3"	2 3/4"	2 11/16"	3"	3 9/16"	4 3/16"	4 3/4"	4 15/16"	4 11/16"	4 3/16"	3 3/8"	2 5/8"	1 15/16"	1 13/16"	1 13/16"	1 13/16"	1 7/8"	1 7/8"	1 13/16"	1 1/2"	1 1/8"	0 9/16"	0"







**NOTES:**

- THE FIELD SPLICE IN SPAN 1 IS OPTIONAL AT BR 43N.
- FOR FIELD SPLICE DETAILS, SEE TYPICAL ROLLED BEAM SPLICE DETAILS, BRIDGE SHEET C-19.
- EACH ROW OF SHEAR CONNECTORS SHALL CONSIST OF 2 STUDS. FOR LATERAL SPACING, SEE TRANSVERSE SECTION (43N&S), BRIDGE SHEET BR43-4.
- ALL STRUCTURAL STEEL WITHIN 10 FEET OF END OF STRINGER AT EXPANSION ENDS SHALL BE COATED WITH A PROTECTIVE PAINT SYSTEM, WITH THE FINAL COAT TO BE DARK BROWN (COLOR CHIP #20059) TO BLEND WITH THE WEATHERING STEEL. THE COST OF PAINTING SHALL BE PAID FOR UNDER ITEM 513.25, "STRUCTURAL PAINTING, SHOP APPLIED".

**STATE OF VERMONT  
AGENCY OF TRANSPORTATION**

Town Of	MIDDLESEX-BOLTON	Bridge No.	43N&S
Highway No.	I-89	Log Sta.	
		Surv. Sta.	
I-89 OVER U.S. ROUTE 2			
<b>STRINGER ELEVATION (43N&amp;S)</b>			
Designed By	P.W. SZUSTAK	Drawn By	R.A. BOTZENHART
Checked By	J.P. HALSTEAD	Date	10/99
		Bridge Design Supervisor	J.P. HALSTEAD
		Date	10/99
PROJECT	MIDDLESEX-BOLTON	PROJECT NO.	IM-089-2(26)
TVGA CAD Drawing No.	43str-el	Date	08/00
Bridge Sheet No.	BR43-10	Sheet	56 of 307

NOTE: RAISED 43N FIN. GR. - 1/4"

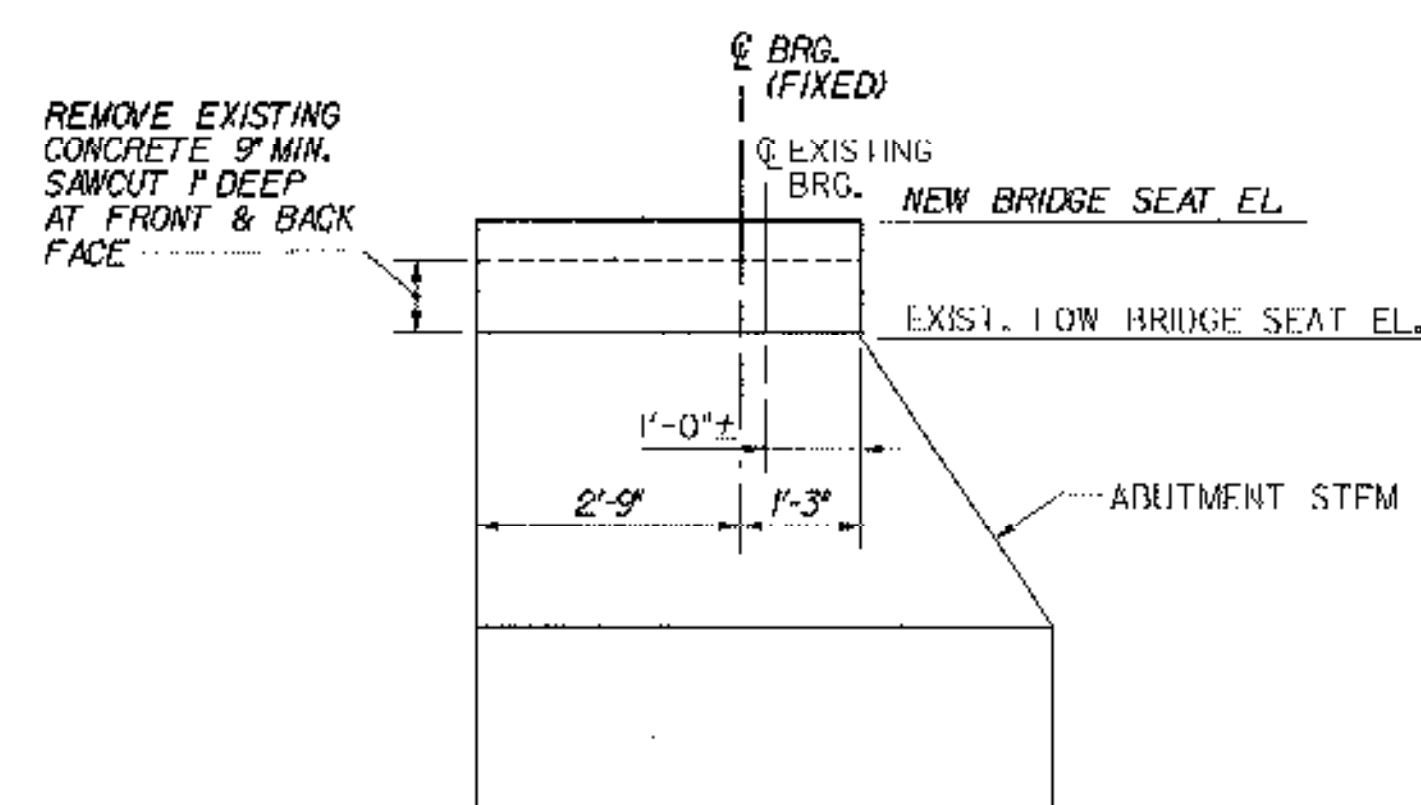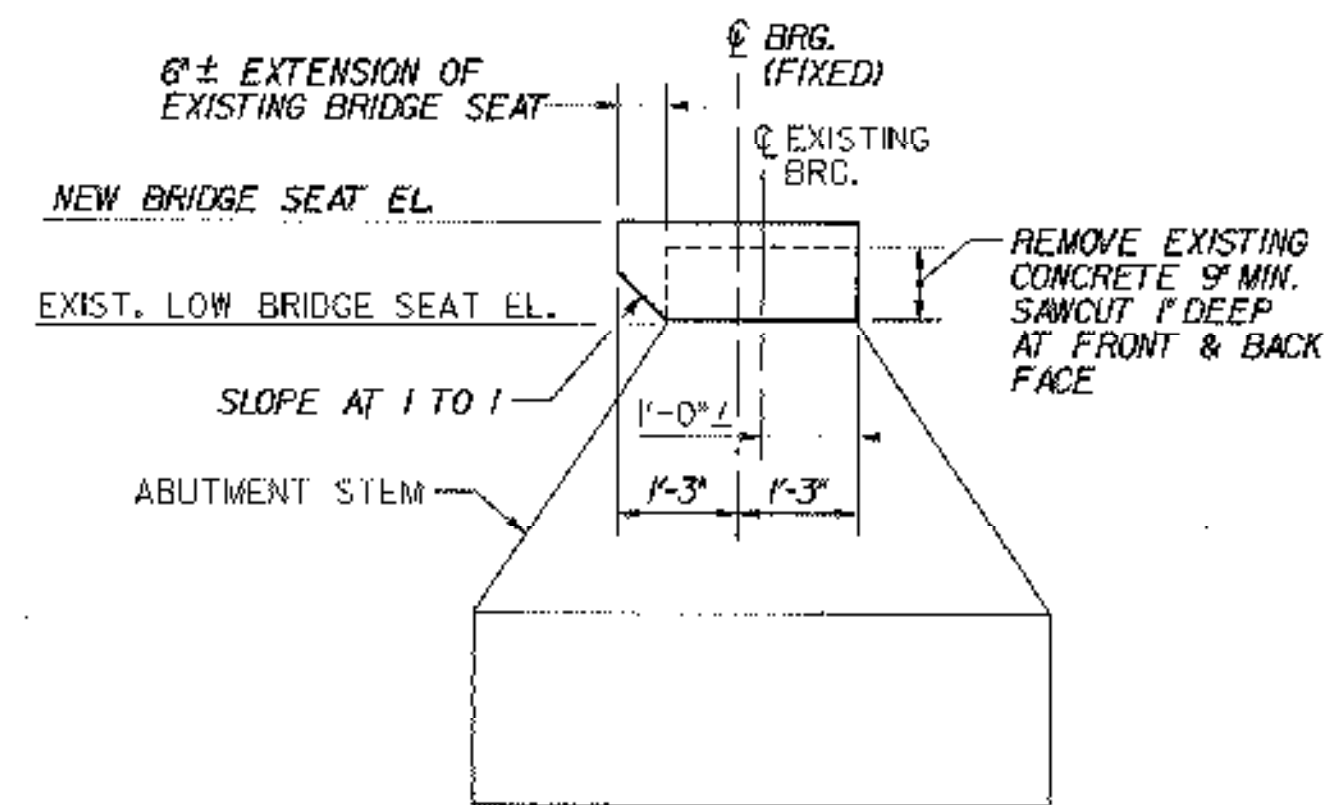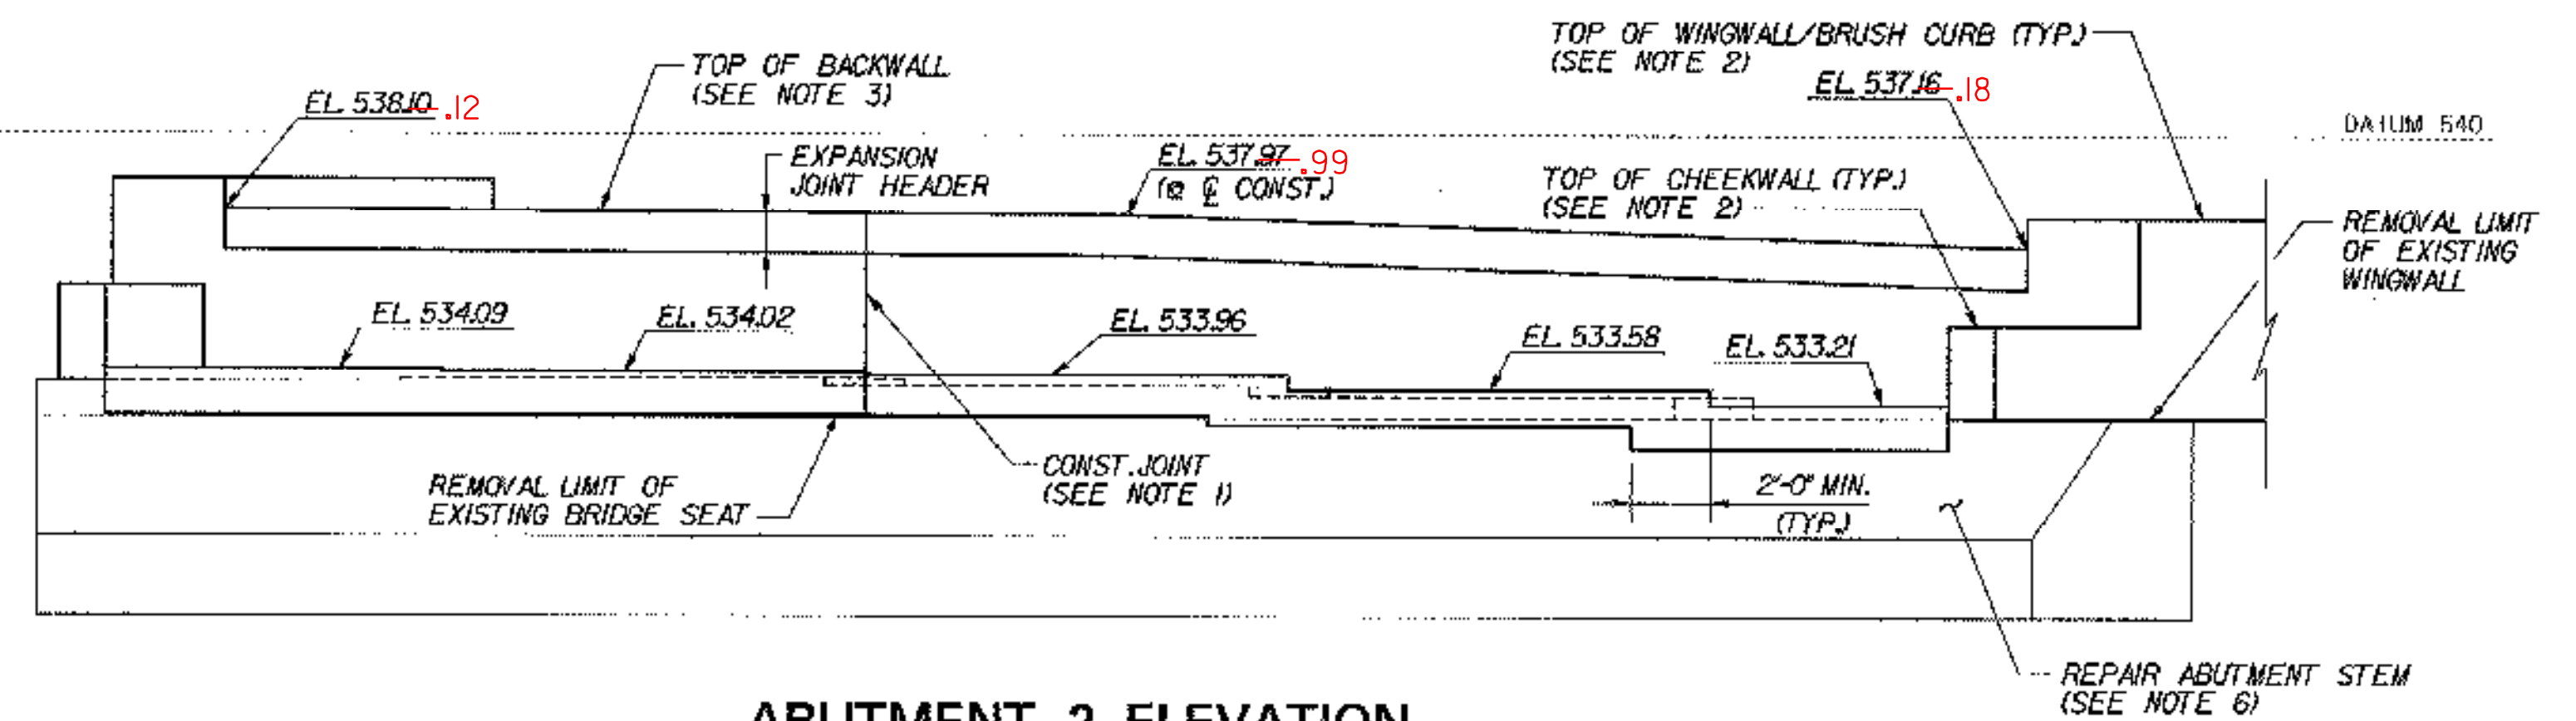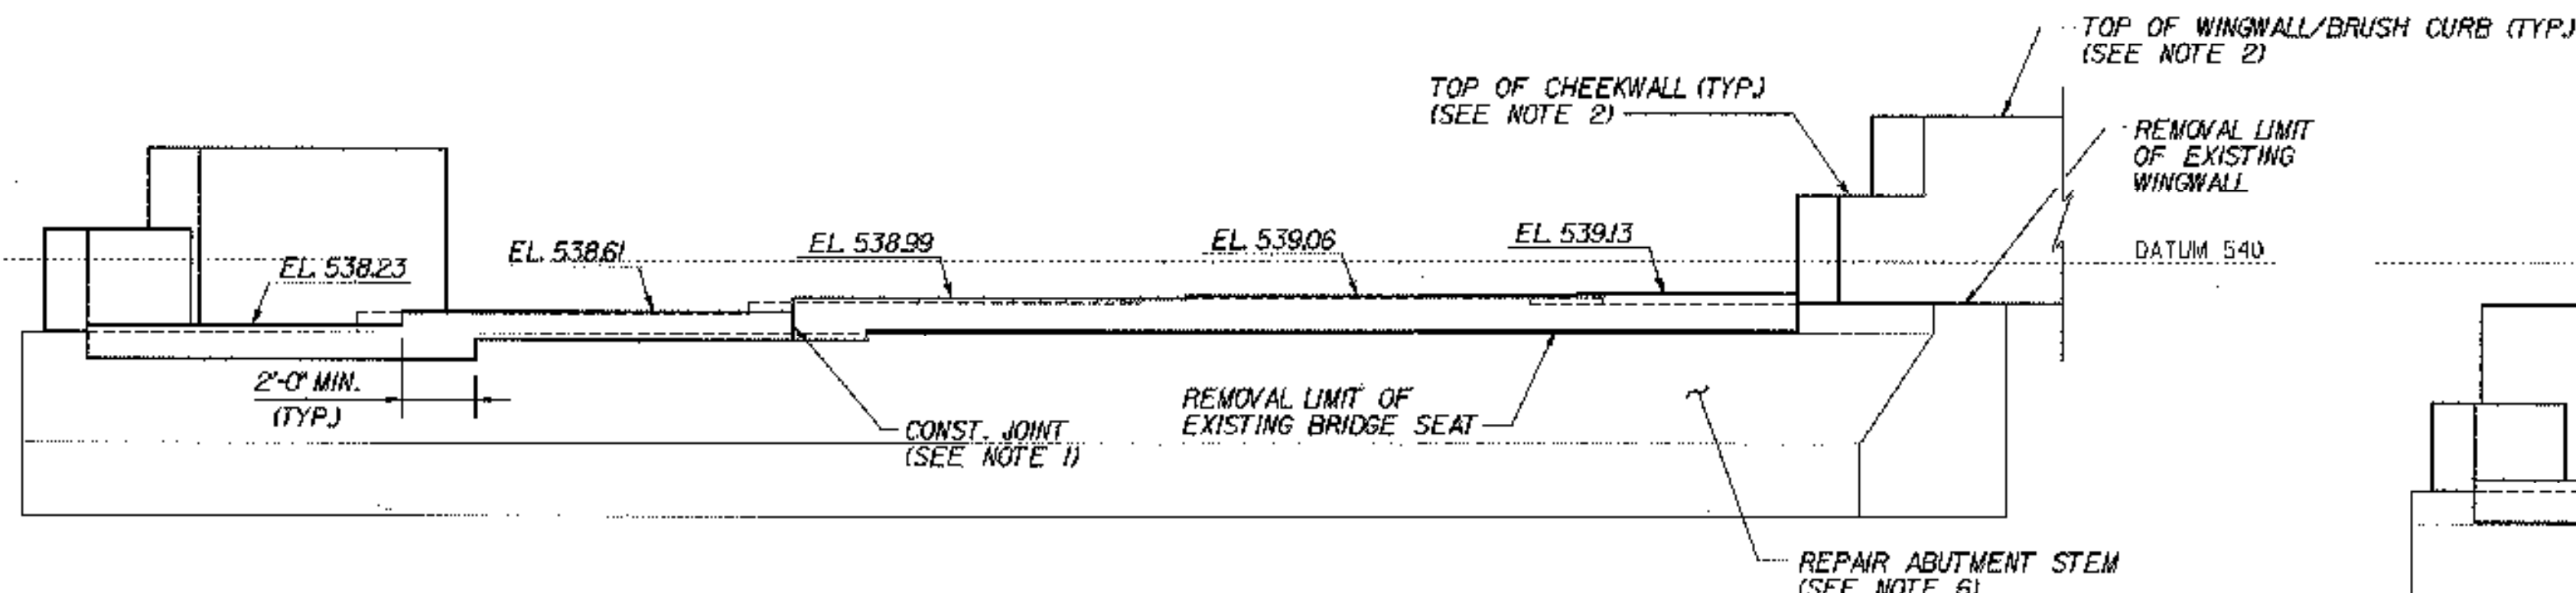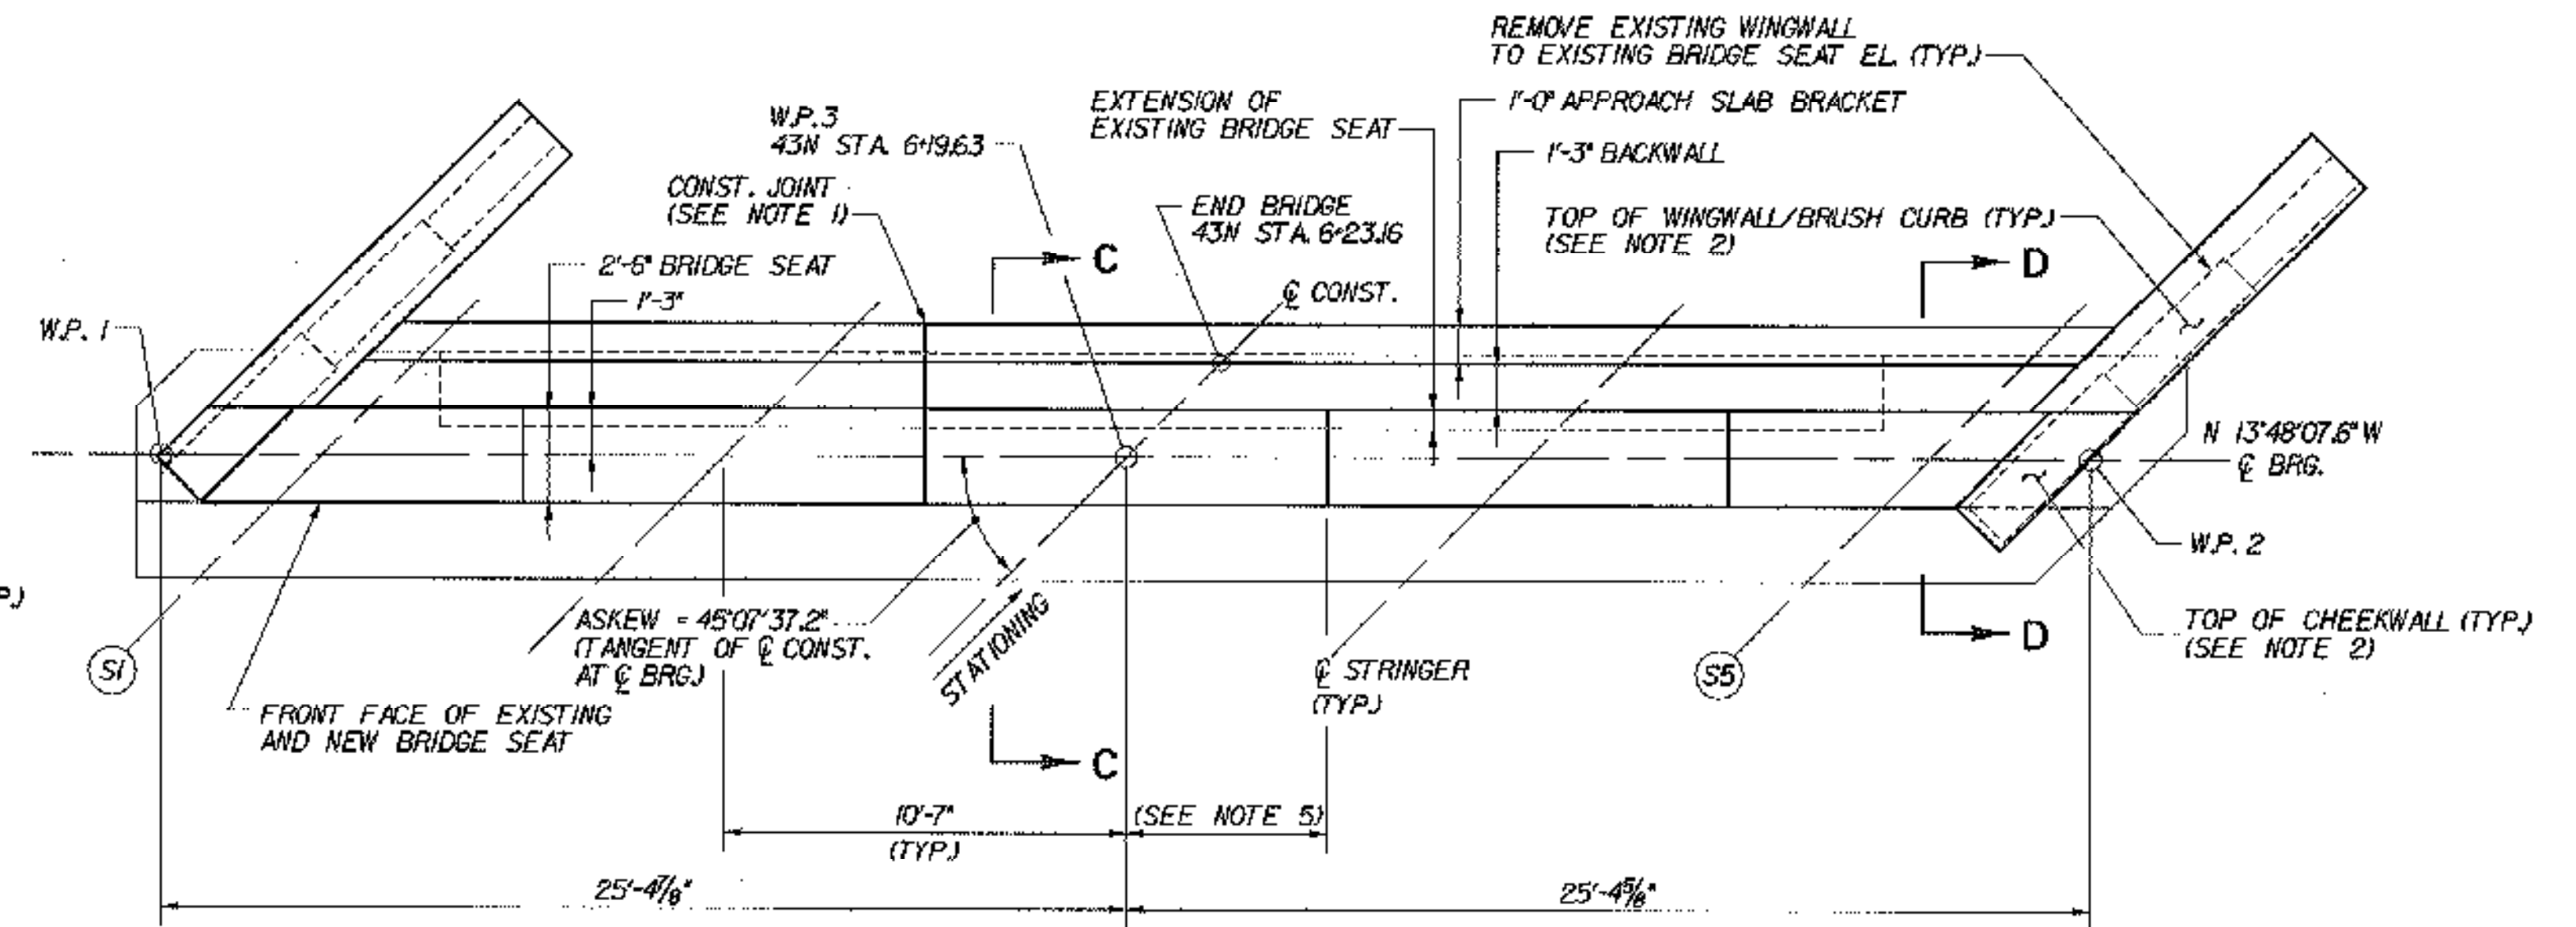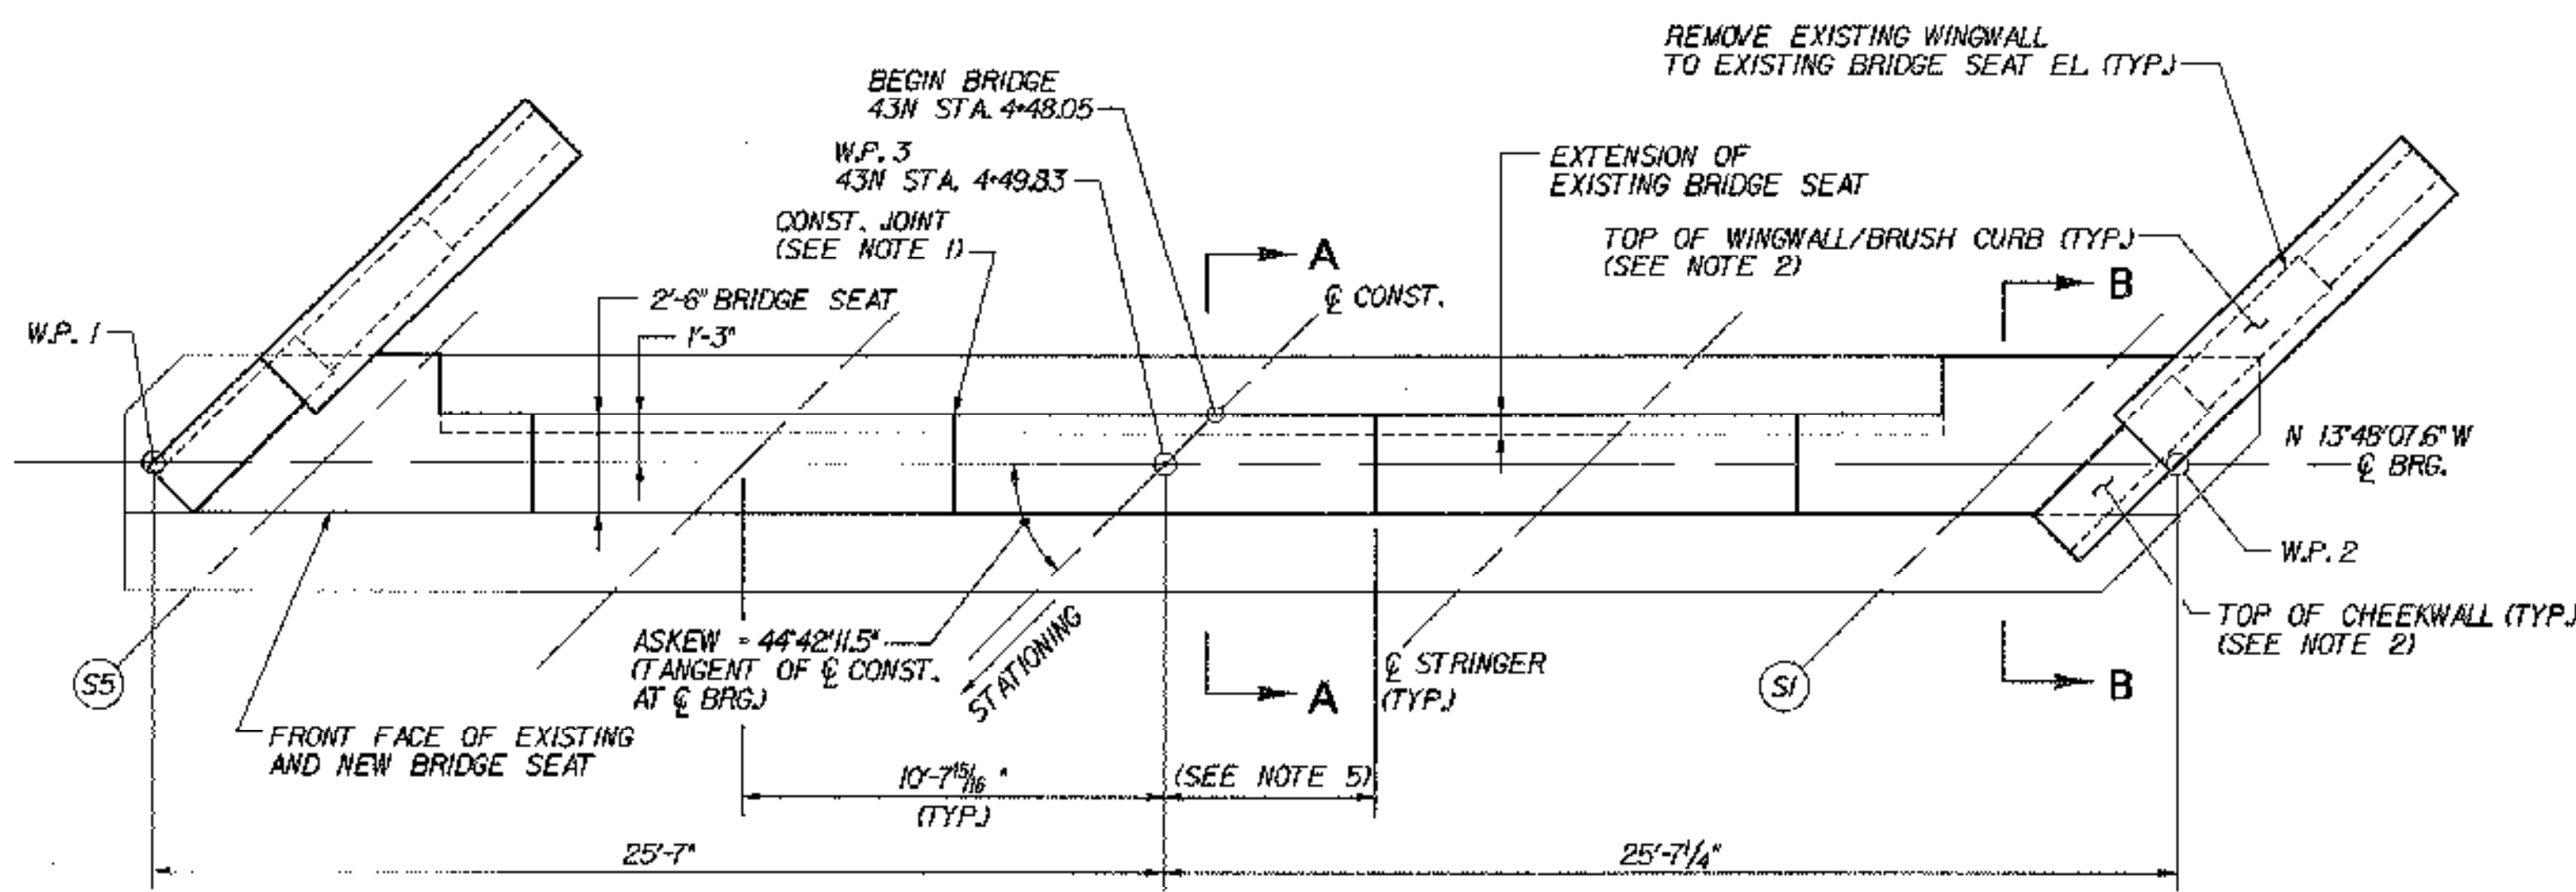



NOTE: FOR SECTIONS C-C AND D-D, SEE ABUTMENT MASONRY (43S), BRIDGE SHEET BR43-12.

**NOTES:**


- CONSTRUCTION JOINT LOCATED AT STEP IN BRIDGE SEAT. LOCATION SHALL BE REVISED AS DIRECTED BY THE RESIDENT ENGINEER AS REQUIRED TO MATCH ANY CONSTRUCTION JOINT IN THE EXISTING ABUTMENT STEM.
- FOR WINGWALL AND CHEEKWALL DIMENSIONS, DETAILS AND ELEVATIONS, SEE TYPICAL WINGWALL DETAILS, BRIDGE SHEETS C-43 AND C-44.
- BACKWALL ELEVATIONS SHOWN AT FRONT FACE OF BACKWALL.
- FOR ABUTMENT REINFORCEMENT DETAILS, SEE TYPICAL EXPANSION ABUTMENT REINFORCEMENT, BRIDGE SHEET C-40, AND TYPICAL FIXED ABUTMENT REINFORCEMENT, BRIDGE SHEET C-41.
- STEPS IN BRIDGE SEATS SHALL BE EQUIDISTANT BETWEEN STRINGERS.
- REPAIR ALL EXISTING SPALLED AND DELAMINATED AREAS ON ABUTMENT. SEE EXISTING SUBSTRUCTURE CONDITION, BRIDGE SHEETS SC-1 THROUGH SC-4 FOR APPROXIMATE CONDITION OF EXISTING SUBSTRUCTURES. FOR CONCRETE REPAIR DETAILS, SEE SUBSTRUCTURE REPAIR DETAILS AND NOTES, BRIDGE SHEET C-45.

**STATE OF VERMONT  
AGENCY OF TRANSPORTATION**

Town Of	MIDDLESEX-BOLTON	Bridge No.	43N
Highway No.	I-89	Log Sta.	
		Surv. Sta.	
I-89 NB OVER U.S. ROUTE 2			
<b>ABUTMENT MASONRY (43N)</b>			
Designed By	P.W. SZUSTAK	Drawn By	R.A. BOTZENHART
Checked By	J.P. HALSTEAD	Date	10/99
		Bridge Design Supervisor	J.P. HALSTEAD
		Date	10/99
PROJECT	MIDDLESEX-BOLTON	PROJECT NO.	IM-089-2(26)
TVGA CAD Drawing No.	43abmas	Date	10/99
Bridge Sheet No.	BR43-11	Sheet	57 of 307

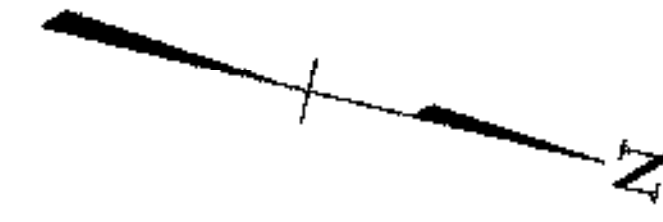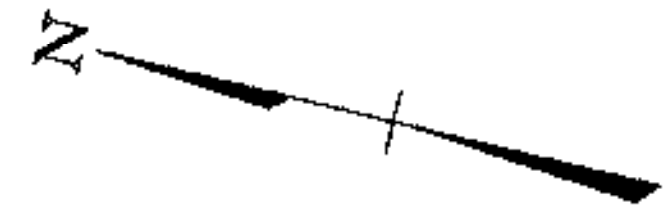


NOTE: RAISED BRIDGE 43S FIN. GRADE 1 3/8"

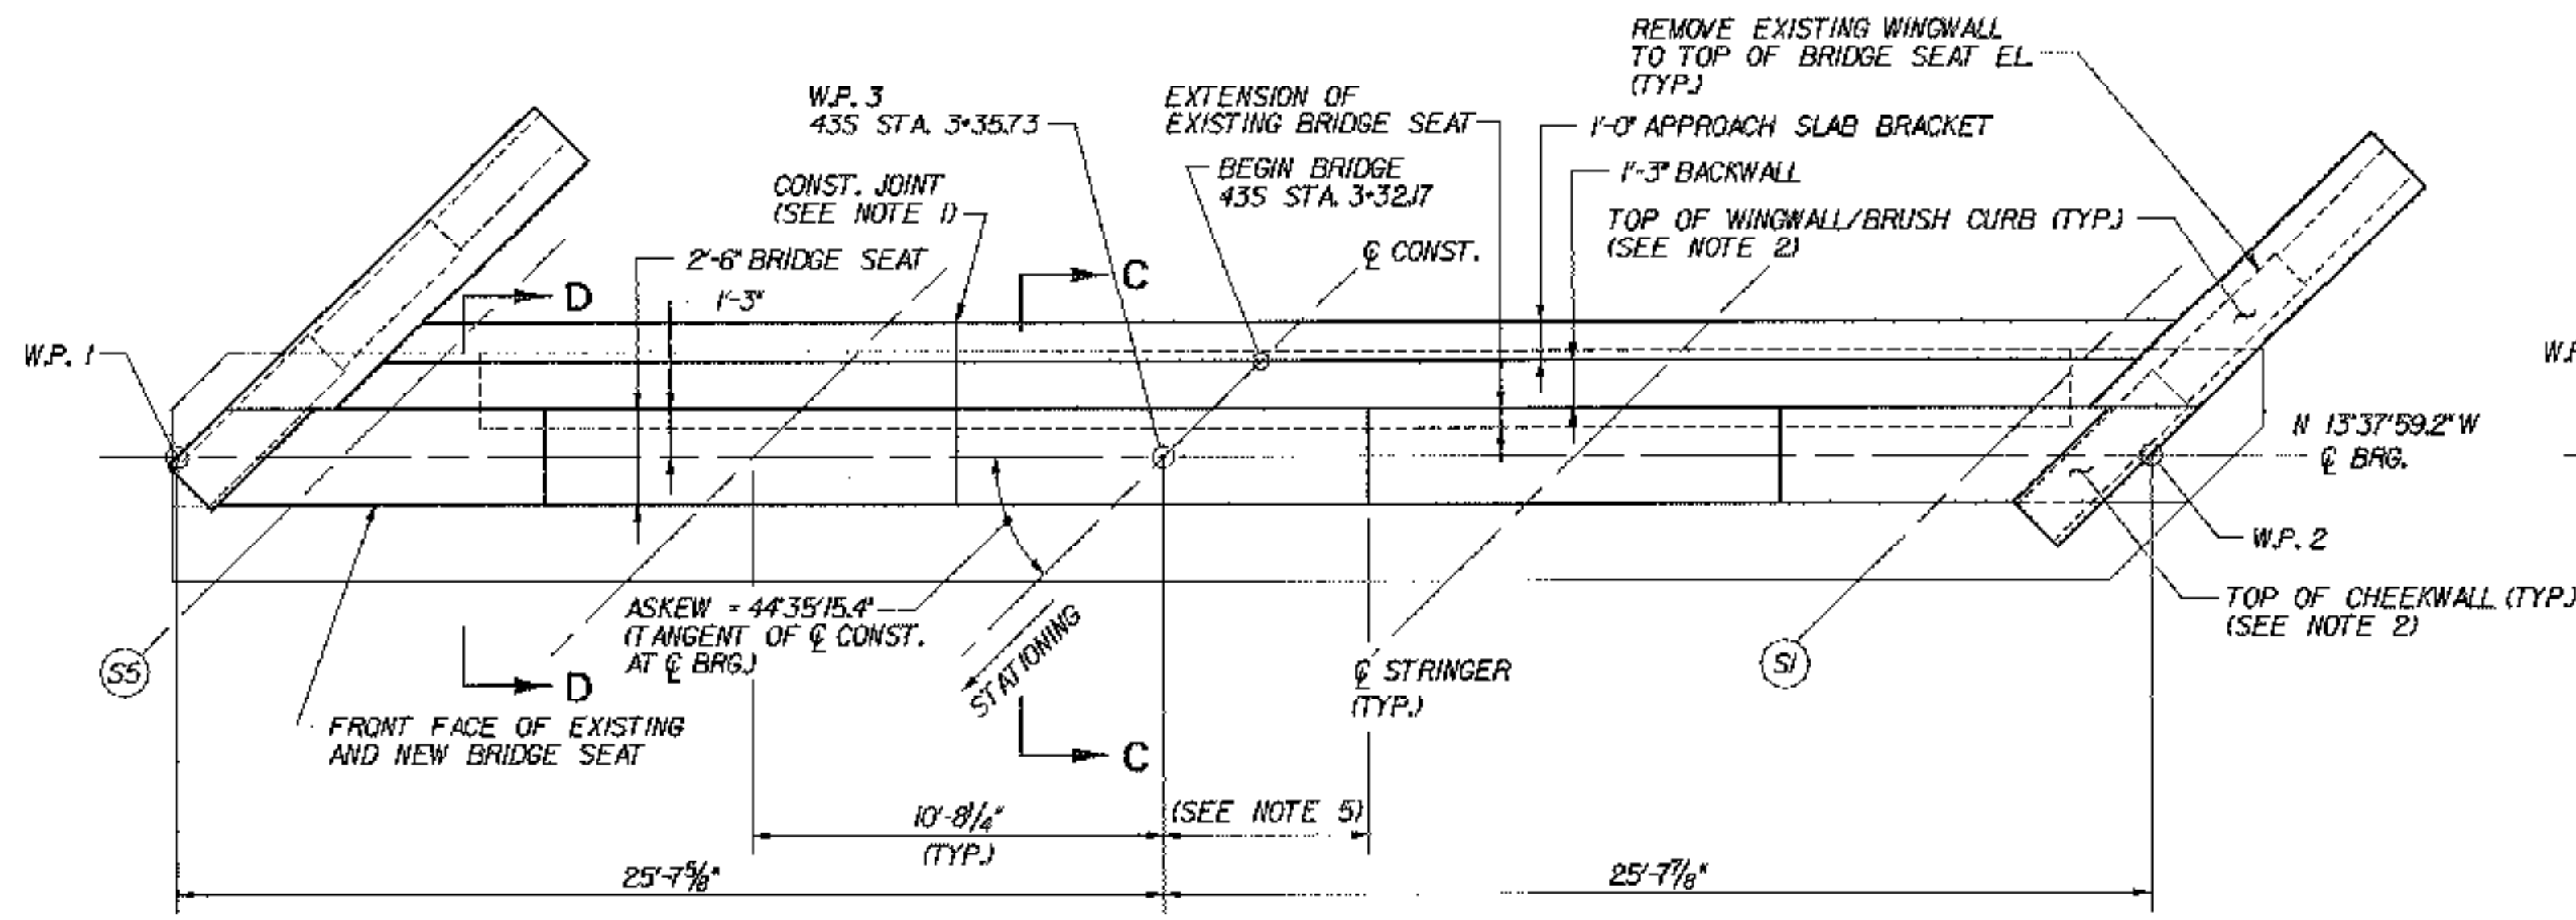


**ABUTMENT 1 PLAN (EXP.)**

SCALE: 1/4"=1'-0"

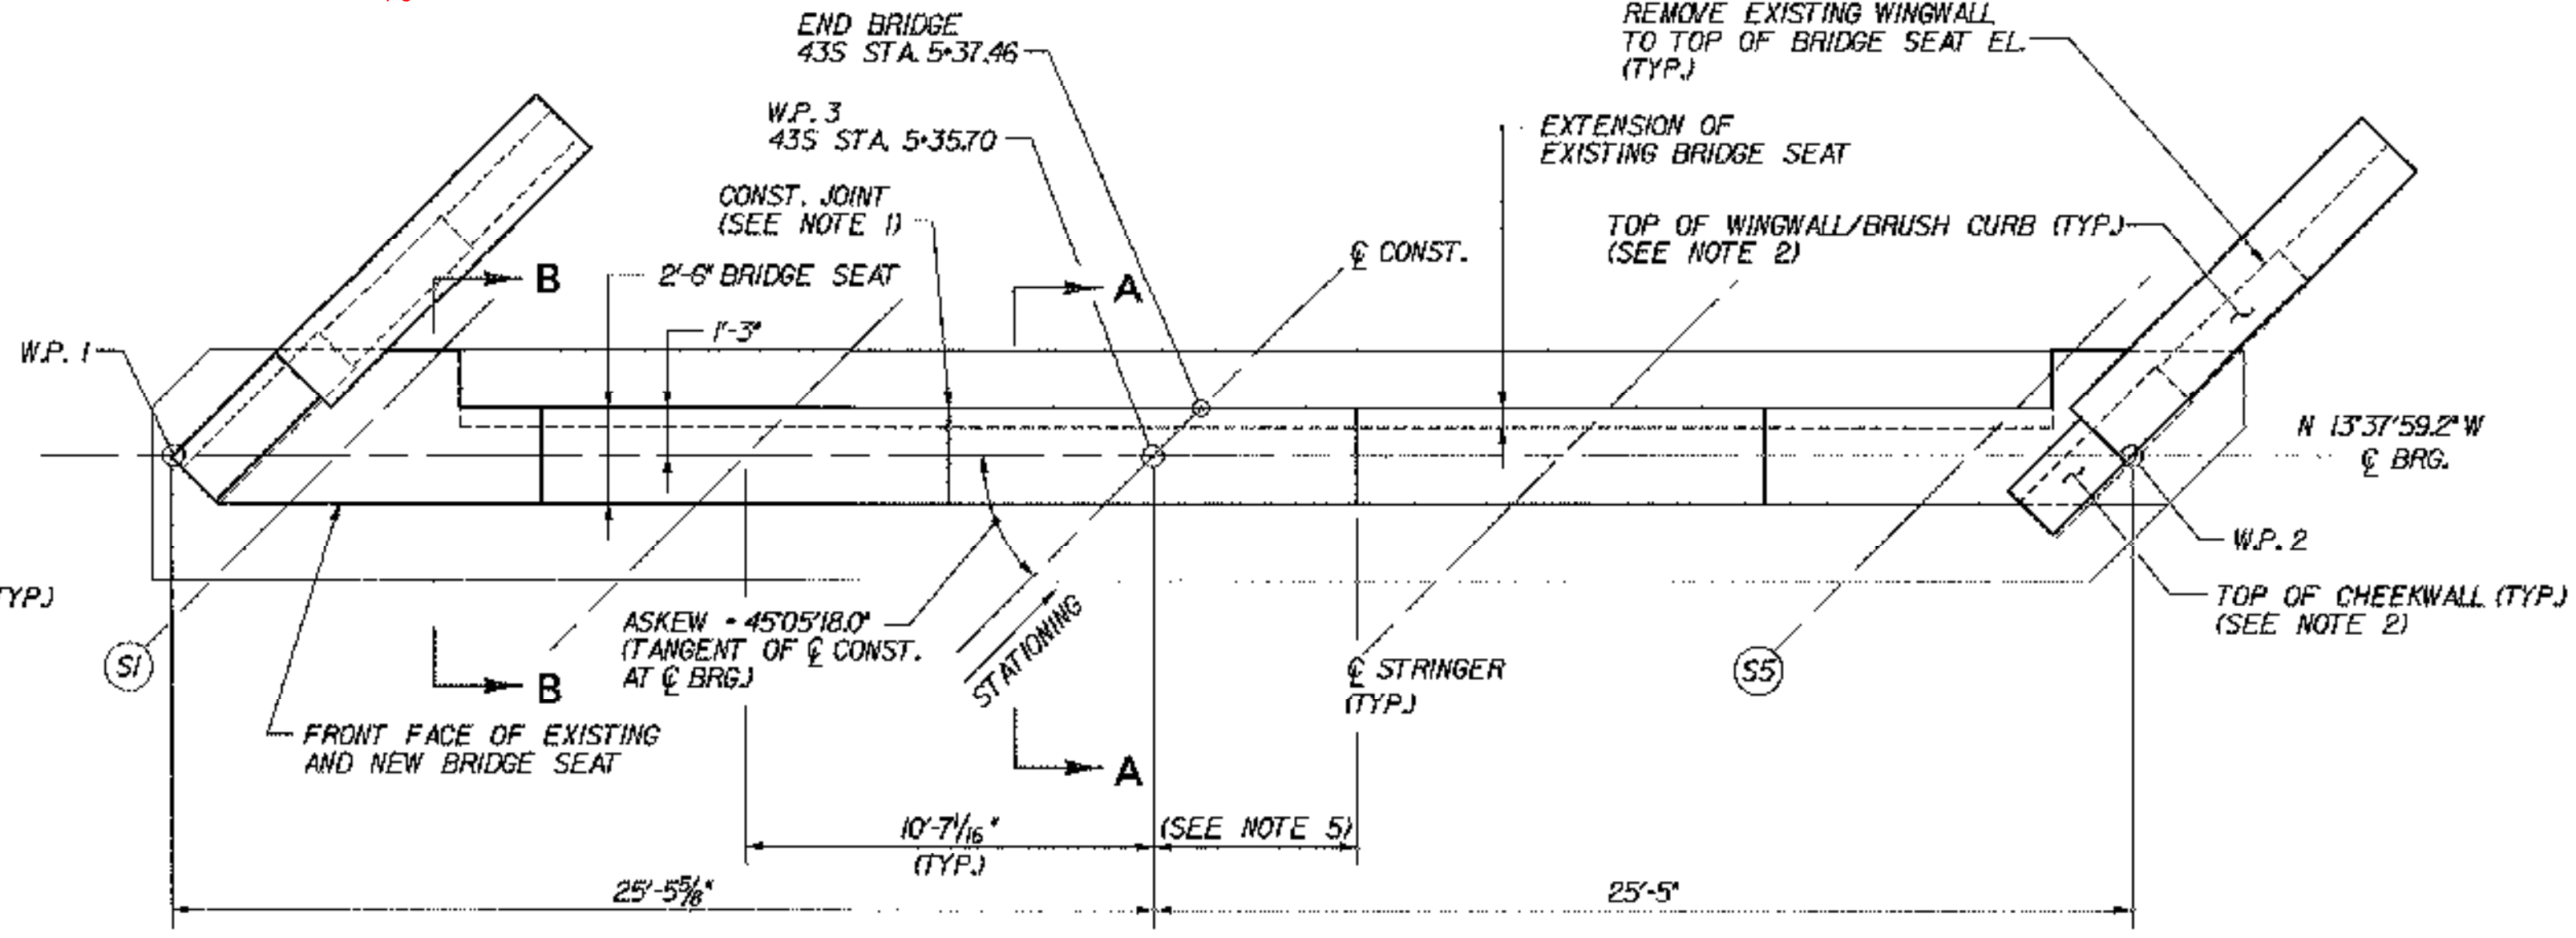


**ABUTMENT 2 PLAN (FIXED)**

SCALE: 1/4"=1'-0"

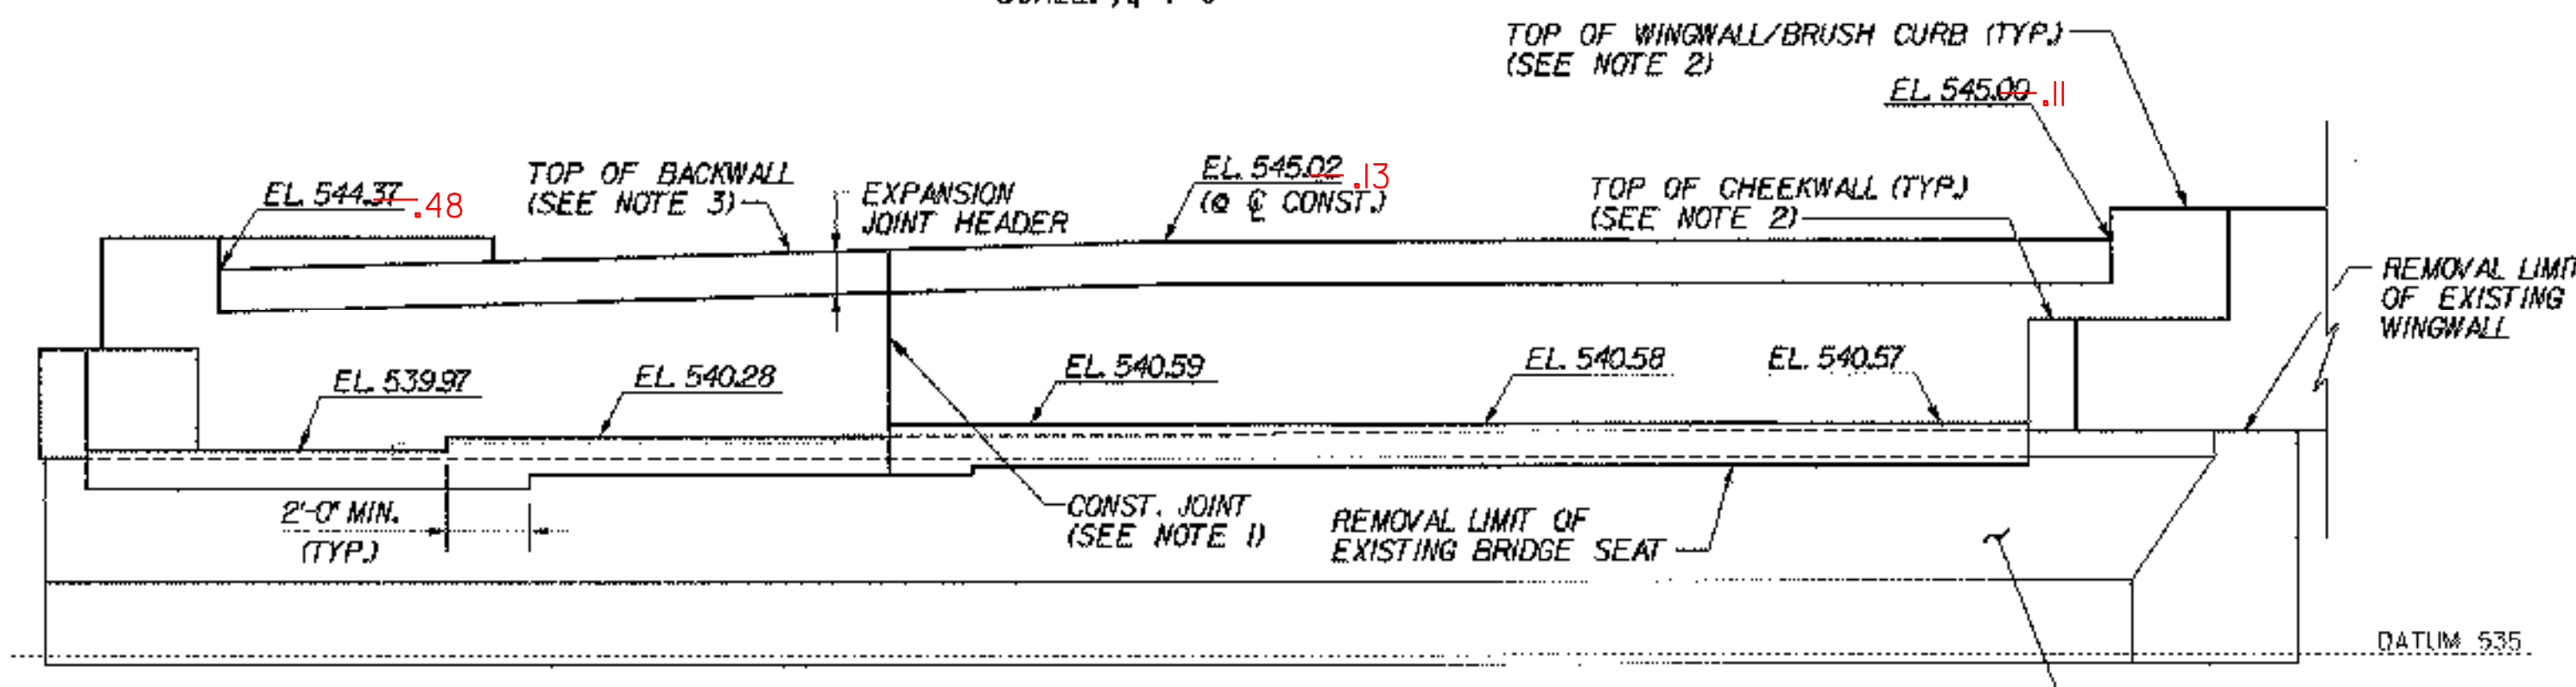


**ABUTMENT 1 ELEVATION**

SCALE: 1/4"=1'-0"

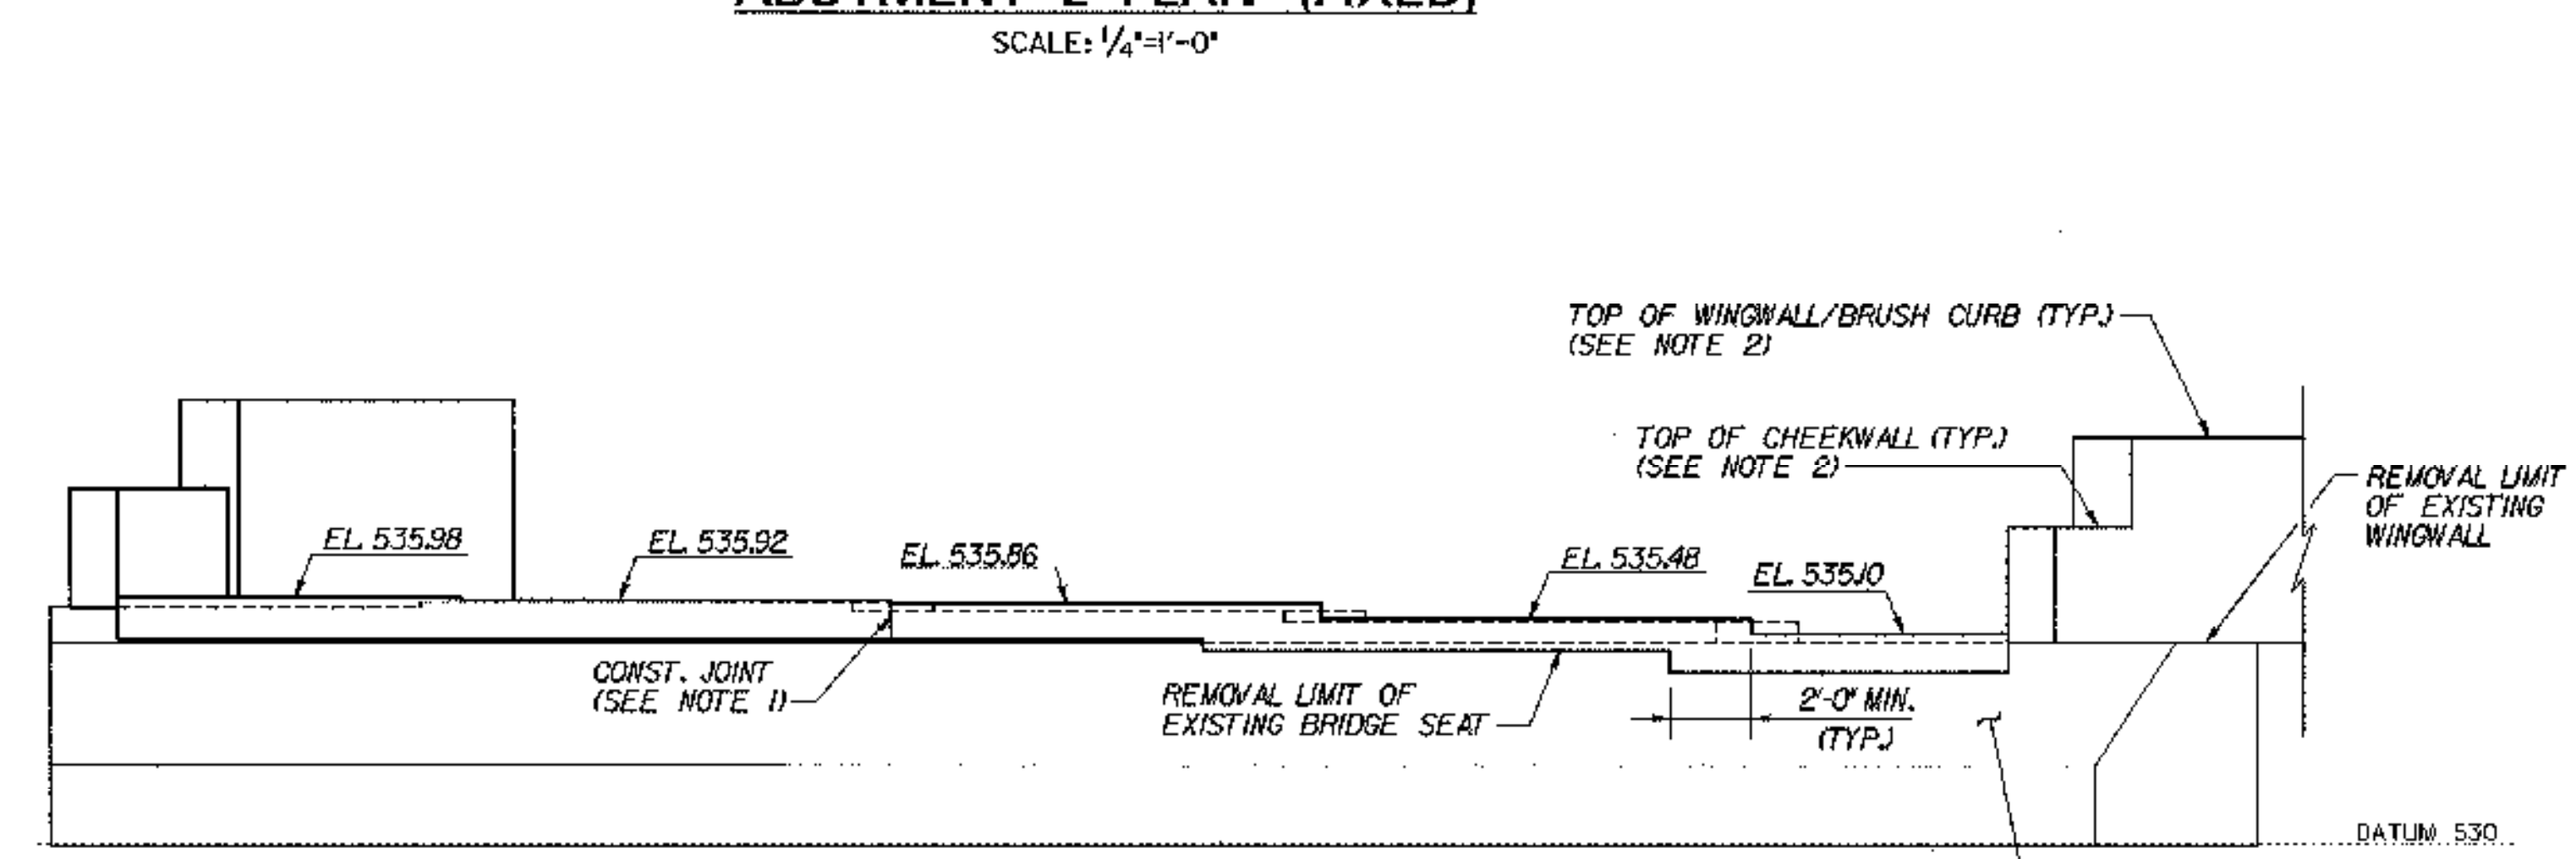


**ABUTMENT 2 ELEVATION**

SCALE: 1/4"=1'-0"

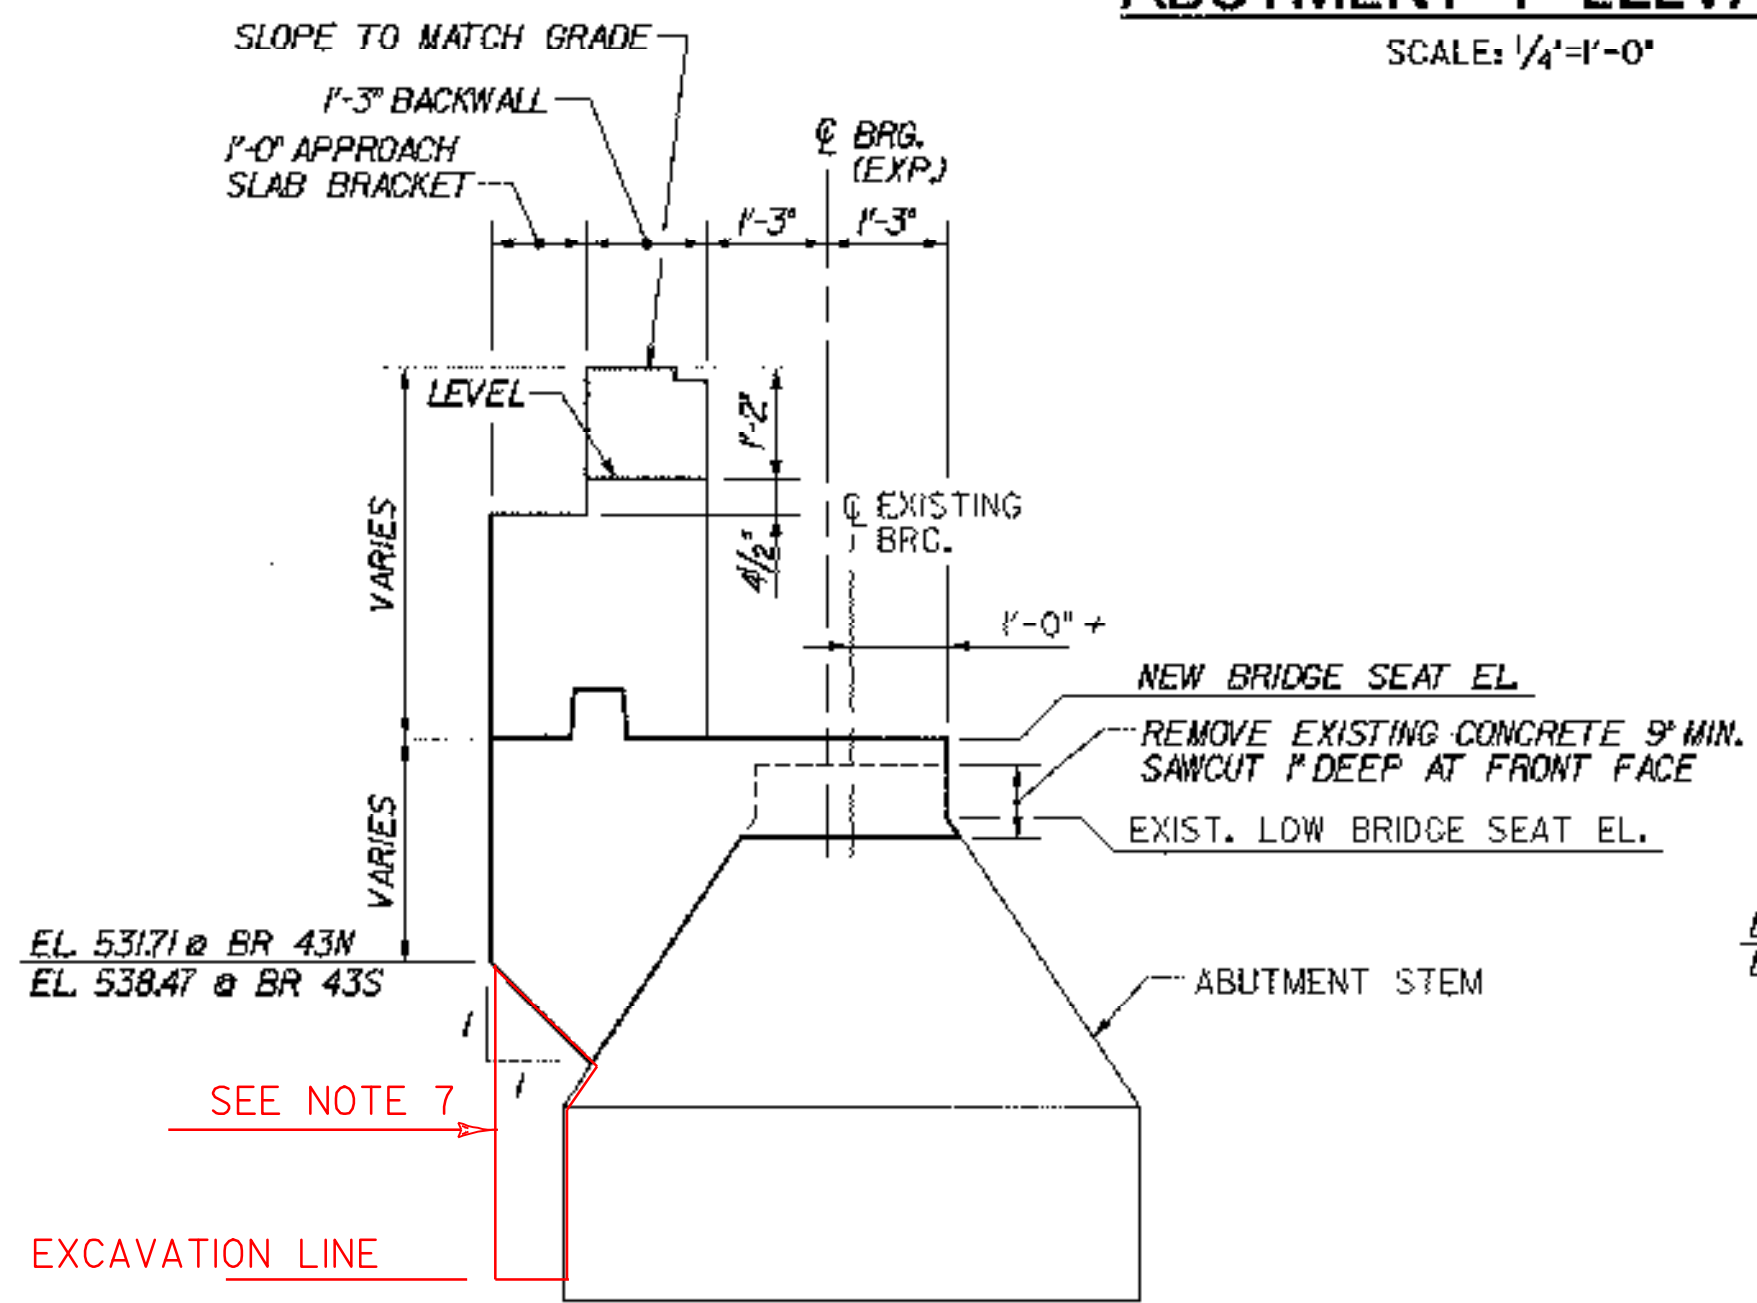

**SECTION C-C**

SCALE: 1/2"=1'-0"

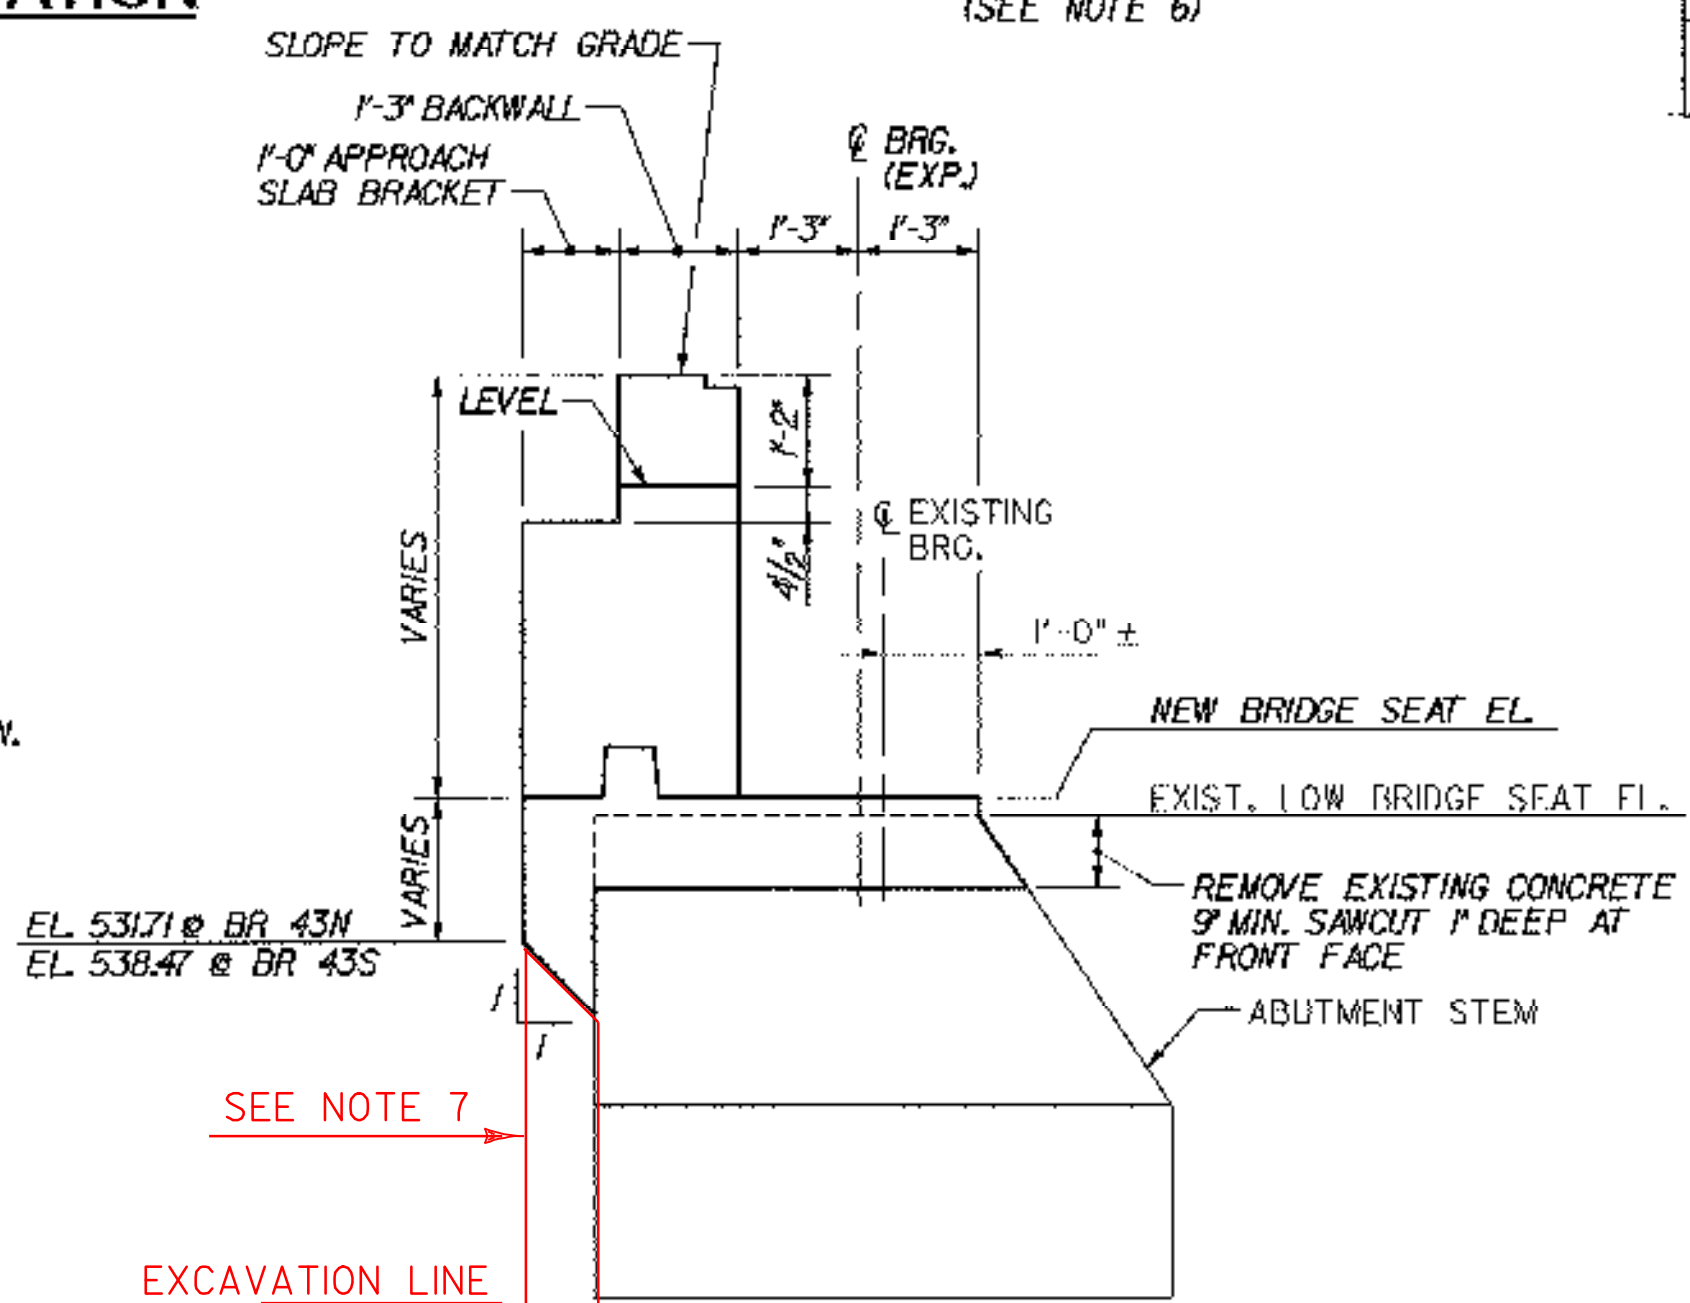

**SECTION D-D**

SCALE: 1/2"=1'-0"

NOTE: FOR SECTIONS A-A AND B-B, SEE ABUTMENT MASONRY (43N), BRIDGE SHEET BR43-11.


**NOTES:**

- CONSTRUCTION JOINT LOCATED AT STEP IN BRIDGE SEAT. LOCATION SHALL BE REVISED AS DIRECTED BY THE RESIDENT ENGINEER AS REQUIRED TO MATCH ANY CONSTRUCTION JOINT IN THE EXISTING ABUTMENT STEM.
- FOR WINGWALL AND CHEEKWALL DIMENSIONS, DETAILS AND ELEVATIONS, SEE TYPICAL WINGWALL DETAILS, BRIDGE SHEETS C-43 AND C-44.
- BACKWALL ELEVATIONS SHOWN AT FRONT FACE OF BACKWALL.
- FOR ABUTMENT REINFORCEMENT DETAILS, SEE TYPICAL EXPANSION ABUTMENT REINFORCEMENT, BRIDGE SHEET C-40, AND TYPICAL FIXED ABUTMENT REINFORCEMENT, BRIDGE SHEET C-41.
- STEPS IN BRIDGE SEATS SHALL BE EQUIDISTANT BETWEEN STRINGERS.
- REPAIR ALL EXISTING SPALLED AND DELAMINATED AREAS ON ABUTMENT. SEE EXISTING SUBSTRUCTURE CONDITION, BRIDGE SHEETS SC-1 THROUGH SC-4 FOR APPROXIMATE CONDITION OF EXISTING SUBSTRUCTURES. FOR CONCRETE REPAIR DETAILS, SEE SUBSTRUCTURE REPAIR DETAILS AND NOTES, BRIDGE SHEET C-45.


7. BRIDGE 43N ONLY: CONTRACTOR FOR EASE OF FORMING, FORMED THE BACK OF ABUTMENT #2 STRAIGHT DOWN TO THE BOTTOM OF THE EXCAVATION. THEY INSTALLED EXTRA REBAR IN THE AREA. ALL MATERIAL AND LABOR WAS AT THE EXPENSE OF THE CONTRACTOR.

**STATE OF VERMONT  
AGENCY OF TRANSPORTATION**


Town Of	MIDDLESEX-BOLTON	Bridge No.	43S
Highway No.	1-89	Log Sta.	
		Surv. Sta.	
1-89 SB OVER U.S. ROUTE 2			
<b>ABUTMENT MASONRY (43S)</b>			
Designed By	P.W. SZUSTAK	Drawn By	R.A. BOTZENHART
Checked By	J.P. HALSTEAD	Bridge Design Supervisor	J.P. HALSTEAD
Date	10/99	Date	10/99
PROJECT	MIDDLESEX-BOLTON	PROJECT NO.	IM-089-2(26)
TVGA CAD Drawing No.	43abrac	Date	10/99
Bridge Sheet No.	BR43-12	Sheet	58 of 307

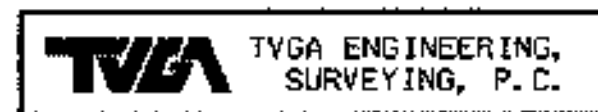

BRIDGE	PIER	STA.	ASKEW ANGLE	DIM. "A"	CL BEARING DIRECTION	PIER SEAT ELEVATIONS					BOTTOM OF PIER CAP ELEVATIONS		
						S1	S2	S3	S4	S5	C1	C2	C3
43N	1	5+02.78	44°50'07.3"	10'-7 5/8"	N 13°48'07.6" W	537.49	537.43	537.36	536.98	536.80	533.79	533.33	532.87
	2	5+76.92	45°01'13.4"	10'-7 1/4"	N 13°48'07.6" W	535.32	535.26	535.19	534.81	534.44	531.41	531.04	530.67
43S	1	4+08.85	44°46'14.5"	10'-7 13/16"	N 13°37'59.2" W	539.10	539.09	539.07	538.74	538.40	535.29	534.95	534.61
	2	4+92.95	44°58'52.7"	10'-7 5/16"	N 13°37'59.2" W	537.07	537.03	536.98	536.62	536.26	533.36	533.01	532.66

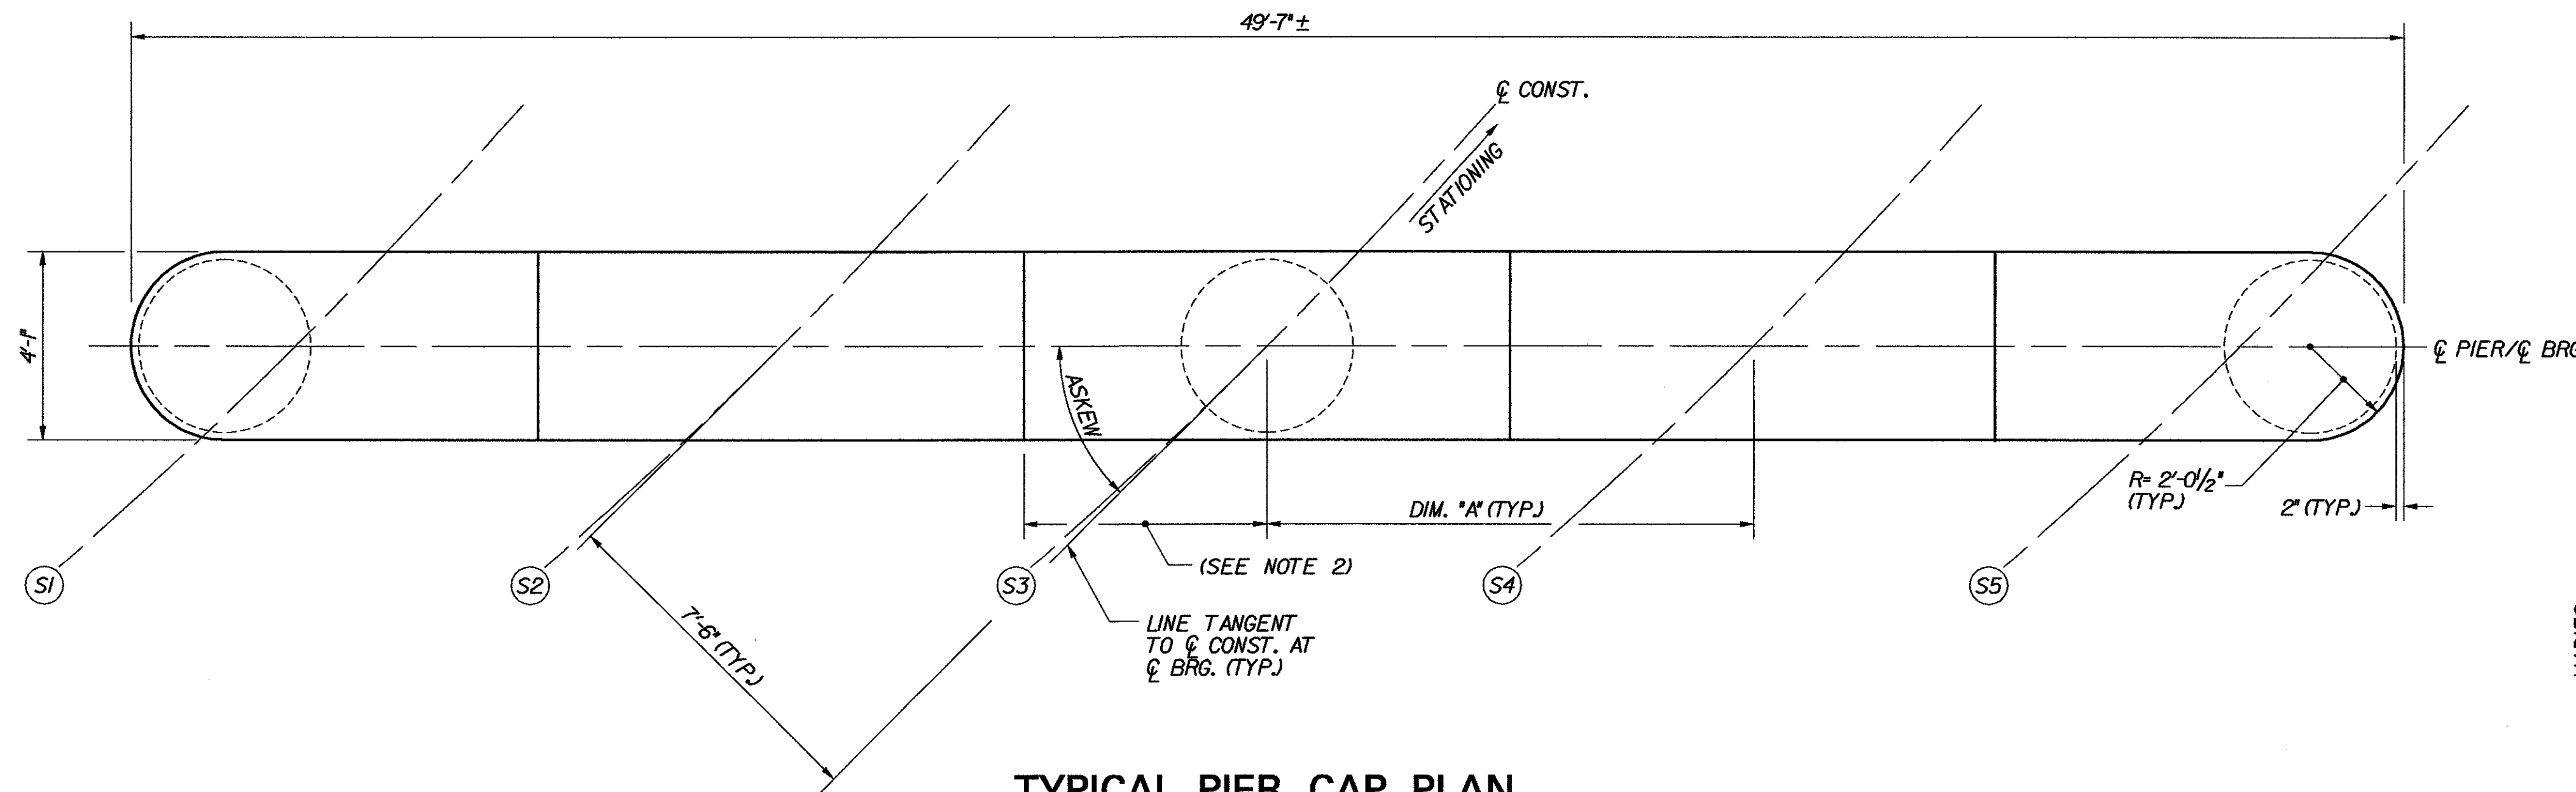


**TYPICAL PIER CAP PLAN**  
SCALE: 3/8"=1'-0"

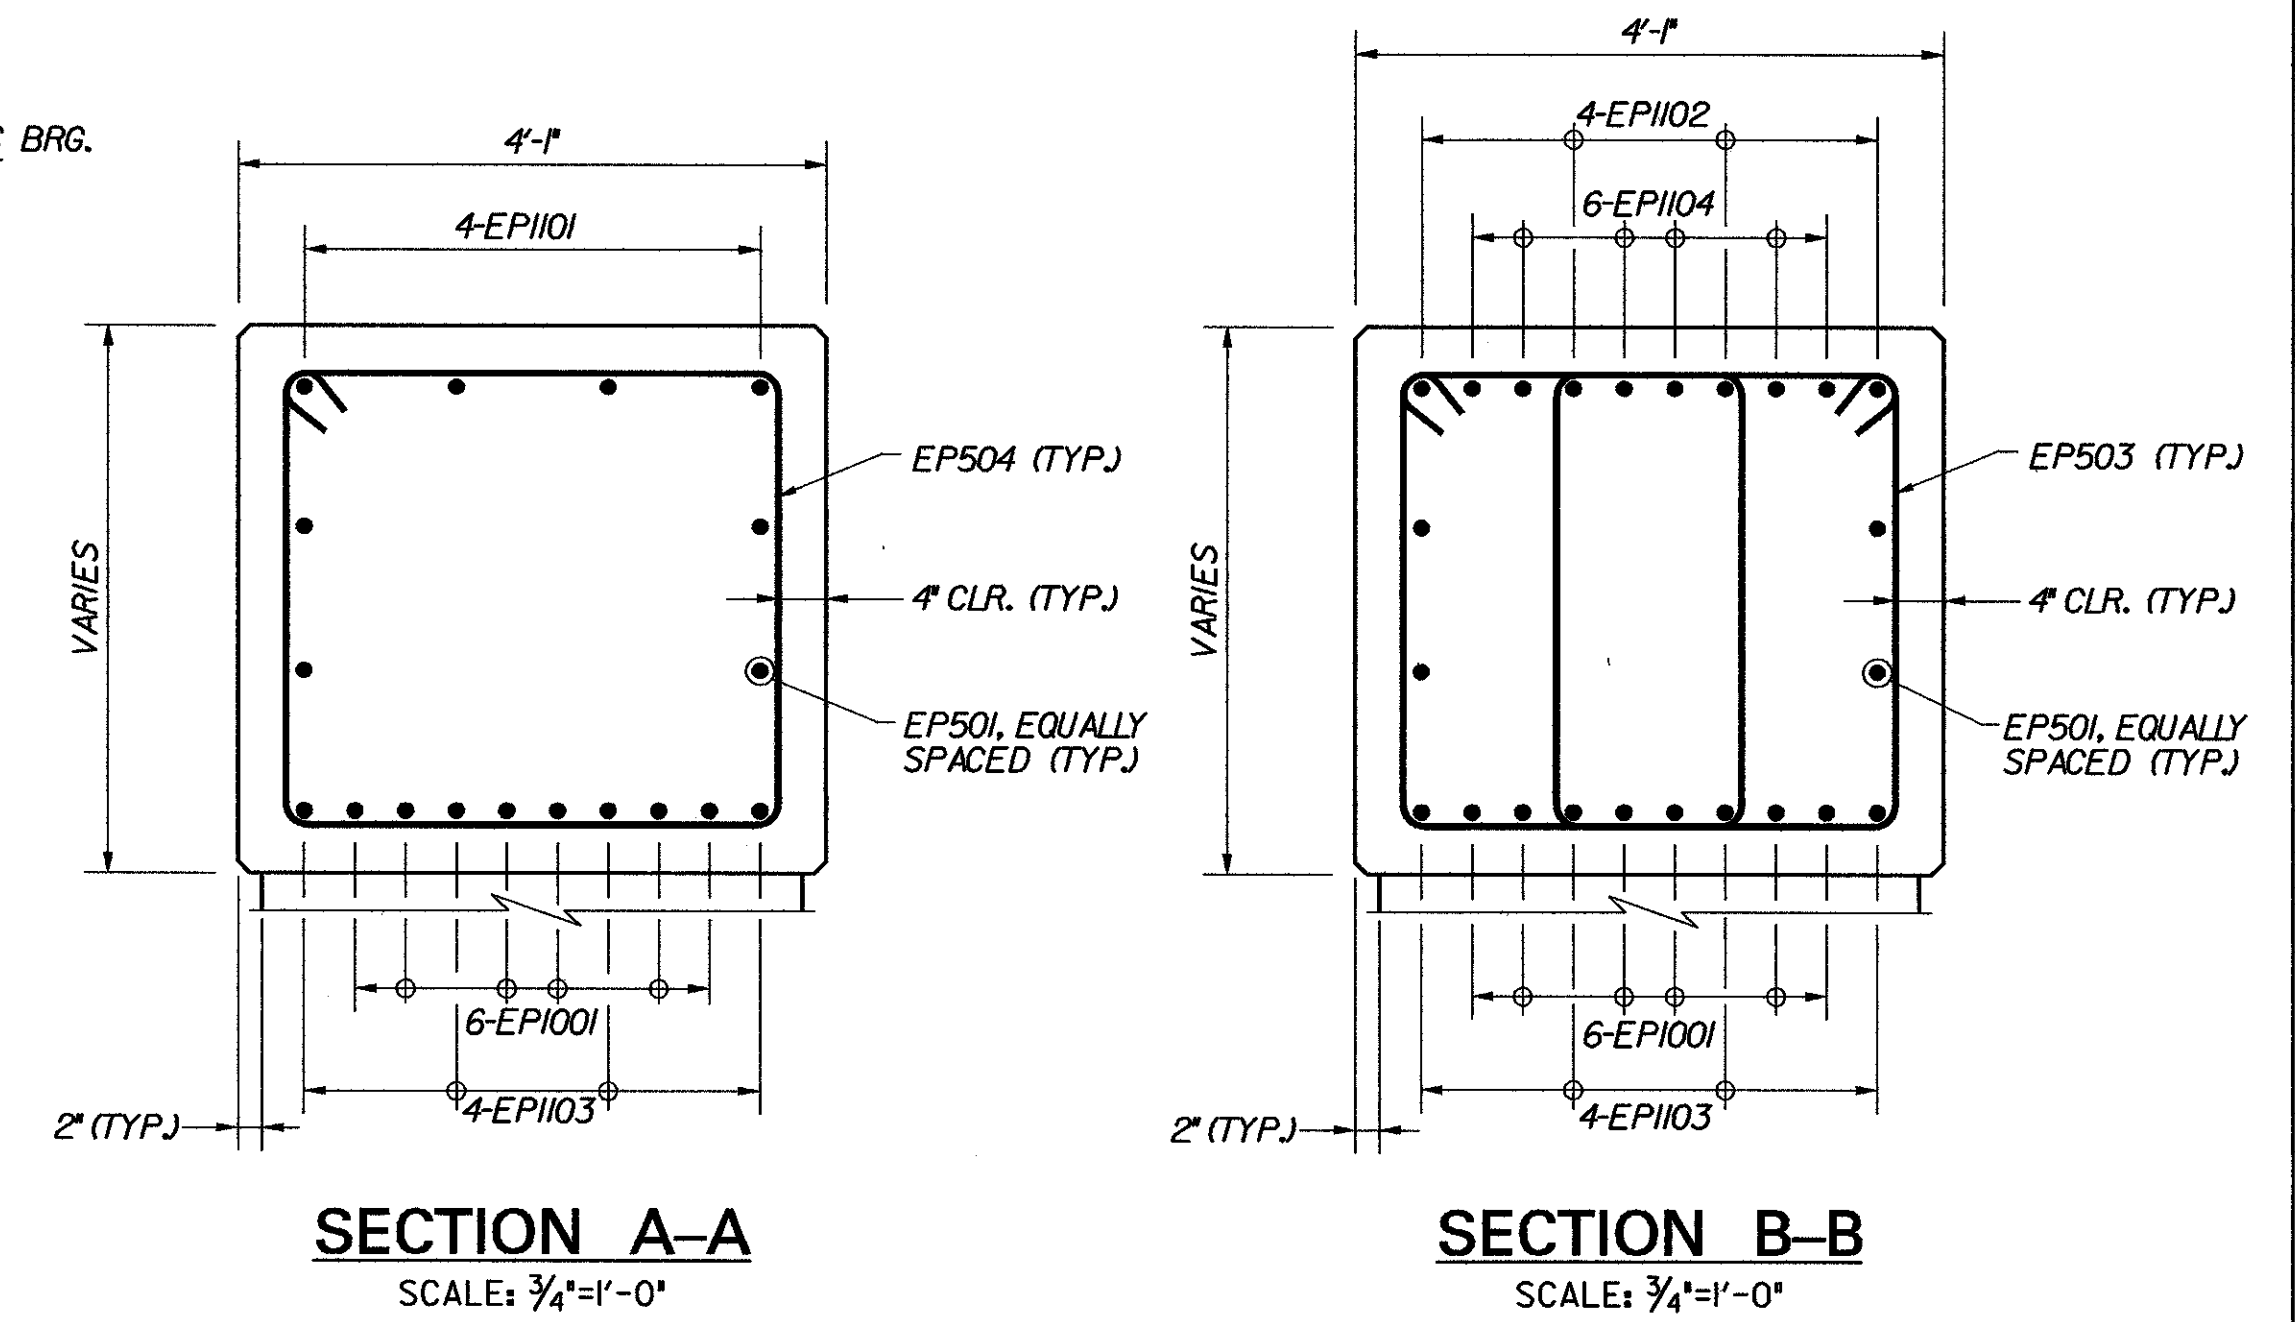

**SECTION A-A**  
SCALE: 3/4"=1'-0"

**SECTION B-B**  
SCALE: 3/4"=1'-0"

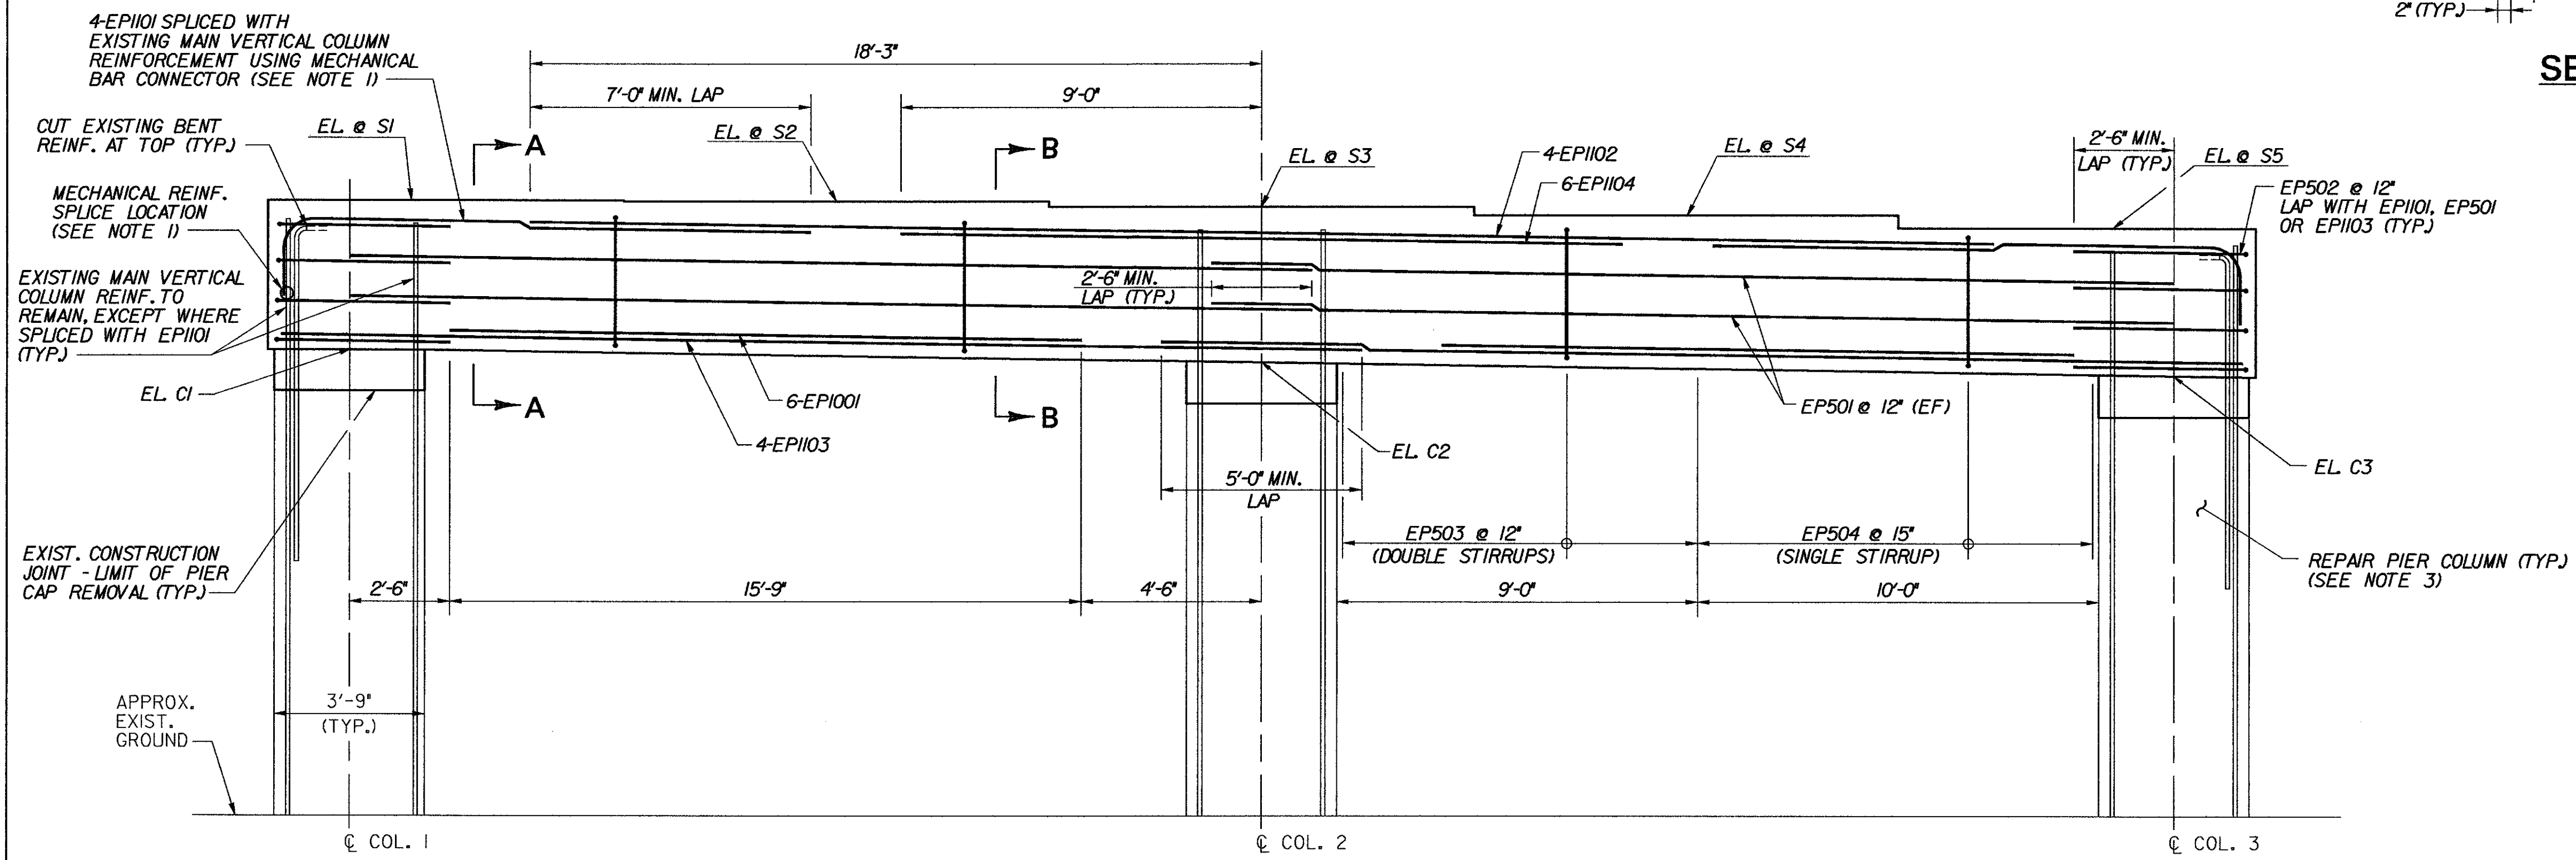

(REINFORCEMENT SYMMETRICAL ABOUT C.C. COL. 2)

**TYPICAL PIER ELEVATION**  
SCALE: 3/8"=1'-0"

- NOTES:**
1. THE CONTRACTOR SHALL SUBMIT PRODUCT DATA FROM THE MANUFACTURER OF THE PROPOSED MECHANICAL BAR CONNECTOR, FOR APPROVAL OF THE STRUCTURES ENGINEER. THE CONTRACTOR SHALL ALSO PROVIDE CERTIFICATION THAT THE SPECIFIED CONNECTOR MEETS THE REQUIRED STRENGTH PROVISIONS OF AASHTO SECTION 8.32.2. THE COST OF SUPPLYING AND PLACING THE CONNECTOR SHALL BE PAID UNDER ITEM 507.19, "MECHANICAL BAR CONNECTOR".
  2. STEPS IN PIER CAP SEAT SHALL BE EQUIDISTANT BETWEEN STRINGERS.
  3. REPAIR ALL EXISTING SPALLED AND DELAMINATED AREAS AND PLACE FIBER-REINFORCED POLYMER (FRP) COLUMN WRAP AT EACH OF THE PIER COLUMNS. CONCRETE REPAIR AND FRP WRAP SHALL BE PERFORMED IN ACCORDANCE WITH THE DETAILS SHOWN ON SUBSTRUCTURE REPAIR DETAILS AND NOTES, BRIDGE SHEET C-45.

- KEY**
- NF NEAR FACE
  - FF FAR FACE
  - EF EACH FACE
  - ▲ REINFORCEMENT TO BE CUT TO FIT IN THE FIELD


**STATE OF VERMONT  
AGENCY OF TRANSPORTATION**

Town Of	MIDDLESEX-BOLTON	Bridge No.	<b>43N&amp;S</b>
Highway No.	I-89	Log Sta.	
		Surv. Sta.	
I-89 OVER U.S. ROUTE 2			
<b>PIER CAP MASONRY &amp; REINFORCEMENT (43N&amp;S)</b>			
Designed By	P.W. SZUSTAK	Drawn By	R.A. BOTZENHART
Checked By	J.P. HALSTEAD	Date	10/99
		Bridge Design Supervisor	J.P. HALSTEAD Date 10/99
PROJECT	MIDDLESEX-BOLTON	PROJECT NO.	IM-089-2(26)
TVGA CAD Drawing No.	43piermas	Date	10/99
Bridge Sheet No.	<b>BR43-13</b>	Sheet	59 of 307

BRIDGE 43 NORTH																	
ITEM	NO. OF PIECES	SIZE	LENGTH	MARK	TYPE	A	B	C	D	E	F	G	H	J	K	R	O
APPROACH SLAB 1 (43N)																	
1	27	5	30'-0"	E1AS501	STR.												
2	27	5	17'-2"	E1AS502	STR.												
3	24	8	2'-6"	E1AS801	19		0'-10"	1'-8"	0'-0"								2'-3"
4	45	9	25'-9"	E1AS901	1	1'-3"	24'-6"					0'-0"		1'-0"			
APPROACH SLAB 2 (43N)																	
6	27	5	30'-0"	E2AS501	STR.												
7	27	5	17'-2"	E2AS502	STR.												
8	24	8	2'-6"	E2AS801	19		0'-10"	1'-8"	0'-0"								2'-3"
9	45	9	25'-9"	E2AS901	1	1'-3"	24'-6"					0'-0"		1'-0"			
SUPERSTRUCTURE (43N)																	
12	630	5	36'-2"	ES601	STR.												
13	698	5	35'-6"	ES602	STR.												
14	486	5	4'-11"	ES603	S5	0'-6"	1'-3"	1'-5"	1'-3"			0'-6"					
15	3	5	33'-0"	ES611	STR.												
16	3	5	20'-0"	ES612	STR.												
17	34	5	5'-1 1/2"	ES613	16	0'-7 1/2"	1'-6"	0'-10"	2'-2"				0'-0"				2'-2"
18	12	5	10'-1"	ES614	STR.												
19	6	5	3'-8"	ES615	STR.												
20	61	6	27'-10"	ES601	STR.												
21	61	6	25'-10"	ES602	STR.												
CURTAINWALL (43N)																	
23	17	5	10'-0"	ECW504	STR.												
24	32	5	12'-0"	ECW505	S6	2'-2"	3'-5"	1'-2"	3'-1"			2'-2"					
25	45	5	2'-11"	ECW506	1	0'-7"	1'-9"					0'-7"					
26	12	5	3'-11"	ECW507	19		2'-2"	1'-9"	0'-0"								3'-4"
27	17	5	23'-9"	ECW508	STR.												
28	2	5	4'-7"	ECW509	S5	1'-3"	0'-10"	0'-9"	0'-6"			1'-3"					
29	2	5	9'-10"	ECW510	S5	2'-2"	2'-4"	1'-2"	2'-0"			2'-2"					
30	2	5	5'-7"	ECW511	S5	1'-3"	0'-10"	1'-9"	0'-6"			1'-3"					
ABUTMENT 1 (43N)																	
32	45	5	4'-7"	E1A501	21	0'-7"	2'-0"	2'-0"									
33	45	5	3'-6"	E1A502	17		1'-6"	2'-0"	0'-0"								
34	25	5	13'-0"	E1A503	STR.												
35	11	5	9'-6"	E1A512	STR.												
36	12	5	9'-0"	E1A513	STR.												
37	12	5	6'-3"	E1A514	STR.												
38	9	5	4'-1"	E1A515	17		1'-6"	1'-1"	1'-6"								
39	22	5	7'-6"	E1A517	17		3'-0"	1'-6"	3'-0"								
40	22	5	4'-6"	E1A518	17		1'-6"	3'-0"	0'-0"								
41	67	5	5'-6"	E1A519	17		1'-6"	4'-0"	0'-0"								
42	10	5	9'-6"	E1A520	STR.												
ABUTMENT 2 (43N)																	
44	17	5	27'-6"	E2A501	STR.												
45	18	5	12'-3"	E2A502	STR.												
46	42	5	6'-1"	E2A503	21	0'-7"	4'-4"	1'-3"				0'-5"					
47	39	5	7'-1"	E2A504	19		2'-7"	4'-6"	0'-0"								6'-4"
48	42	5	3'-8"	E2A505	STR.												
49	42	5	6'-1"	E2A506	S10		2'-2"	1'-10"	2'-2"								
50	42	5	5'-10"	E2A507	17		2'-6"	0'-10"	2'-6"								
51	90	5	3'-7"	E2A508	17		1'-6"	2'-1"	0'-0"								
52	2	5	5'-7"	E2A509	19		2'-1"	3'-6"	0'-0"								5'-0"
53	1	5	6'-7"	E2A510	19		2'-1"	4'-6"	0'-0"								6'-0"
54	15	5	11'-0"	E2A511	STR.												
55	22	5	10'-6"	E2A512	STR.												
56	6	5	7'-6"	E2A513	STR.												
57	6	5	5'-9"	E2A514	STR.												
58	7	5	4'-1"	E2A515	17		1'-6"	1'-1"	1'-6"								
59	5	5	4'-6"	E2A516	19		2'-3"	2'-3"	0'-0"								3'-10"
60	19	5	7'-6"	E2A517	17		3'-0"	1'-6"	3'-0"								
61	19	5	4'-6"	E2A518	17		1'-6"	3'-0"	0'-0"								
62	62	5	5'-6"	E2A519	17		1'-6"	4'-0"	0'-0"								
63	11	5	10'-6"	E2A520	STR.												
64	5	5	4'-6"	E2A521	27		2'-3"	2'-3"	0'-0"								
65	15	5	8'-0"	E2A522	STR.												
66	15	5	12'-9"	E2A524	STR.												
67	10	5	10'-3"	E2A525	STR.												
PIER CAP 1 (43N)																	
69	9	5	24'-0"	E1P501	STR.												
70	9	5	10'-3"	E1P502	10		2'-6"	5'-3"	2'-6"							1'-8"	3'-4"
71	40	5	11'-7"	E1P503	T1	0'-5 1/2"	2'-4"	3'-0"	2'-4"	3'-0"		0'-5 1/2"					
72	16	5	13'-9"	E1P504	T1	0'-5 1/2"	3'-5"	3'-0"	3'-5"	3'-0"		0'-5 1/2"					
73	14	10	15'-9"	E1P1001	STR.												
74	9	11	15'-0"	E1P1101	20		0'-0"	13'-0"	2'-0"								
75	4	11	36'-6"	E1P1102	STR.												
76	8	11	27'-0"	E1P1103	STR.												
77	7	11	18'-0"	E1P1104	STR.												
PIER CAP 2 (43N)																	
79	8	5	24'-0"	E2P501	STR.												
80	9	5	10'-3"	E2P502	10		2'-6"	5'-3"	2'-6"							1'-8"	3'-4"
81	41	5	11'-7"	E2P503	T1	0'-5 1/2"	2'-4"	3'-0"	2'-4"	3'-0"		0'-5 1/2"					
82	17	5	13'-9"	E2P504	T1	0'-5 1/2"	3'-5"	3'-0"	3'-5"	3'-0"		0'-5 1/2"					
83	14	10	15'-9"	E2P1001	STR.												
84	8	11	15'-0"	E2P1101	20		0'-0"	13'-0"	2'-0"								
85	5	11	36'-6"	E2P1102	STR.												
86	9	11	27'-0"	E2P1103	STR.												
87	7	11	18'-0"	E2P1104	STR.												
88																	
89																	
90																	

BRIDGE 43 SOUTH																	
ITEM	NO. OF PIECES	SIZE	LENGTH	MARK	TYPE	A	B	C	D	E	F	G	H	J	K	R	O
APPROACH SLAB 1 (43S)																	
1	27	5	30'-0"	E1AS501	STR.												
2	27	5	17'-2"	E1AS502	STR.												
3	24	8	2'-6"	E1AS801	19		0'-10"	1'-8"	0'-0"								2'-3"
4	45	9	25'-9"	E1AS901	1	1'-3"	24'-6"					0'-0"		1'-0"			
APPROACH SLAB 2 (43S)																	
6	27	5	30'-0"	E2AS501	STR.												
7	27	5	17'-2"	E2AS502	STR.												
8	24	8	2'-6"	E2AS801	19		0'-10"	1'-8"	0'-0"								2'-3"
9	45	9	25'-9"	E2AS901	1	1'-3"	24'-6"					0'-0"		1'-0"			
SUPERSTRUCTURE (43S)																	
12	682	5	35'-6"	ES601	STR.												
13	823	5	35'-6"	ES602	STR.												
14	563	5	4'-11"	ES603	S5	0'-6"	1'-3"	1'-5"	1'-3"			0'-6"					
15	2	5	33'-0"	ES611													

NOTE: RAISED 48S FIN. GRADE 0.27'  
 NOTE: RAISED 48N FIN. GRADE 0.44'

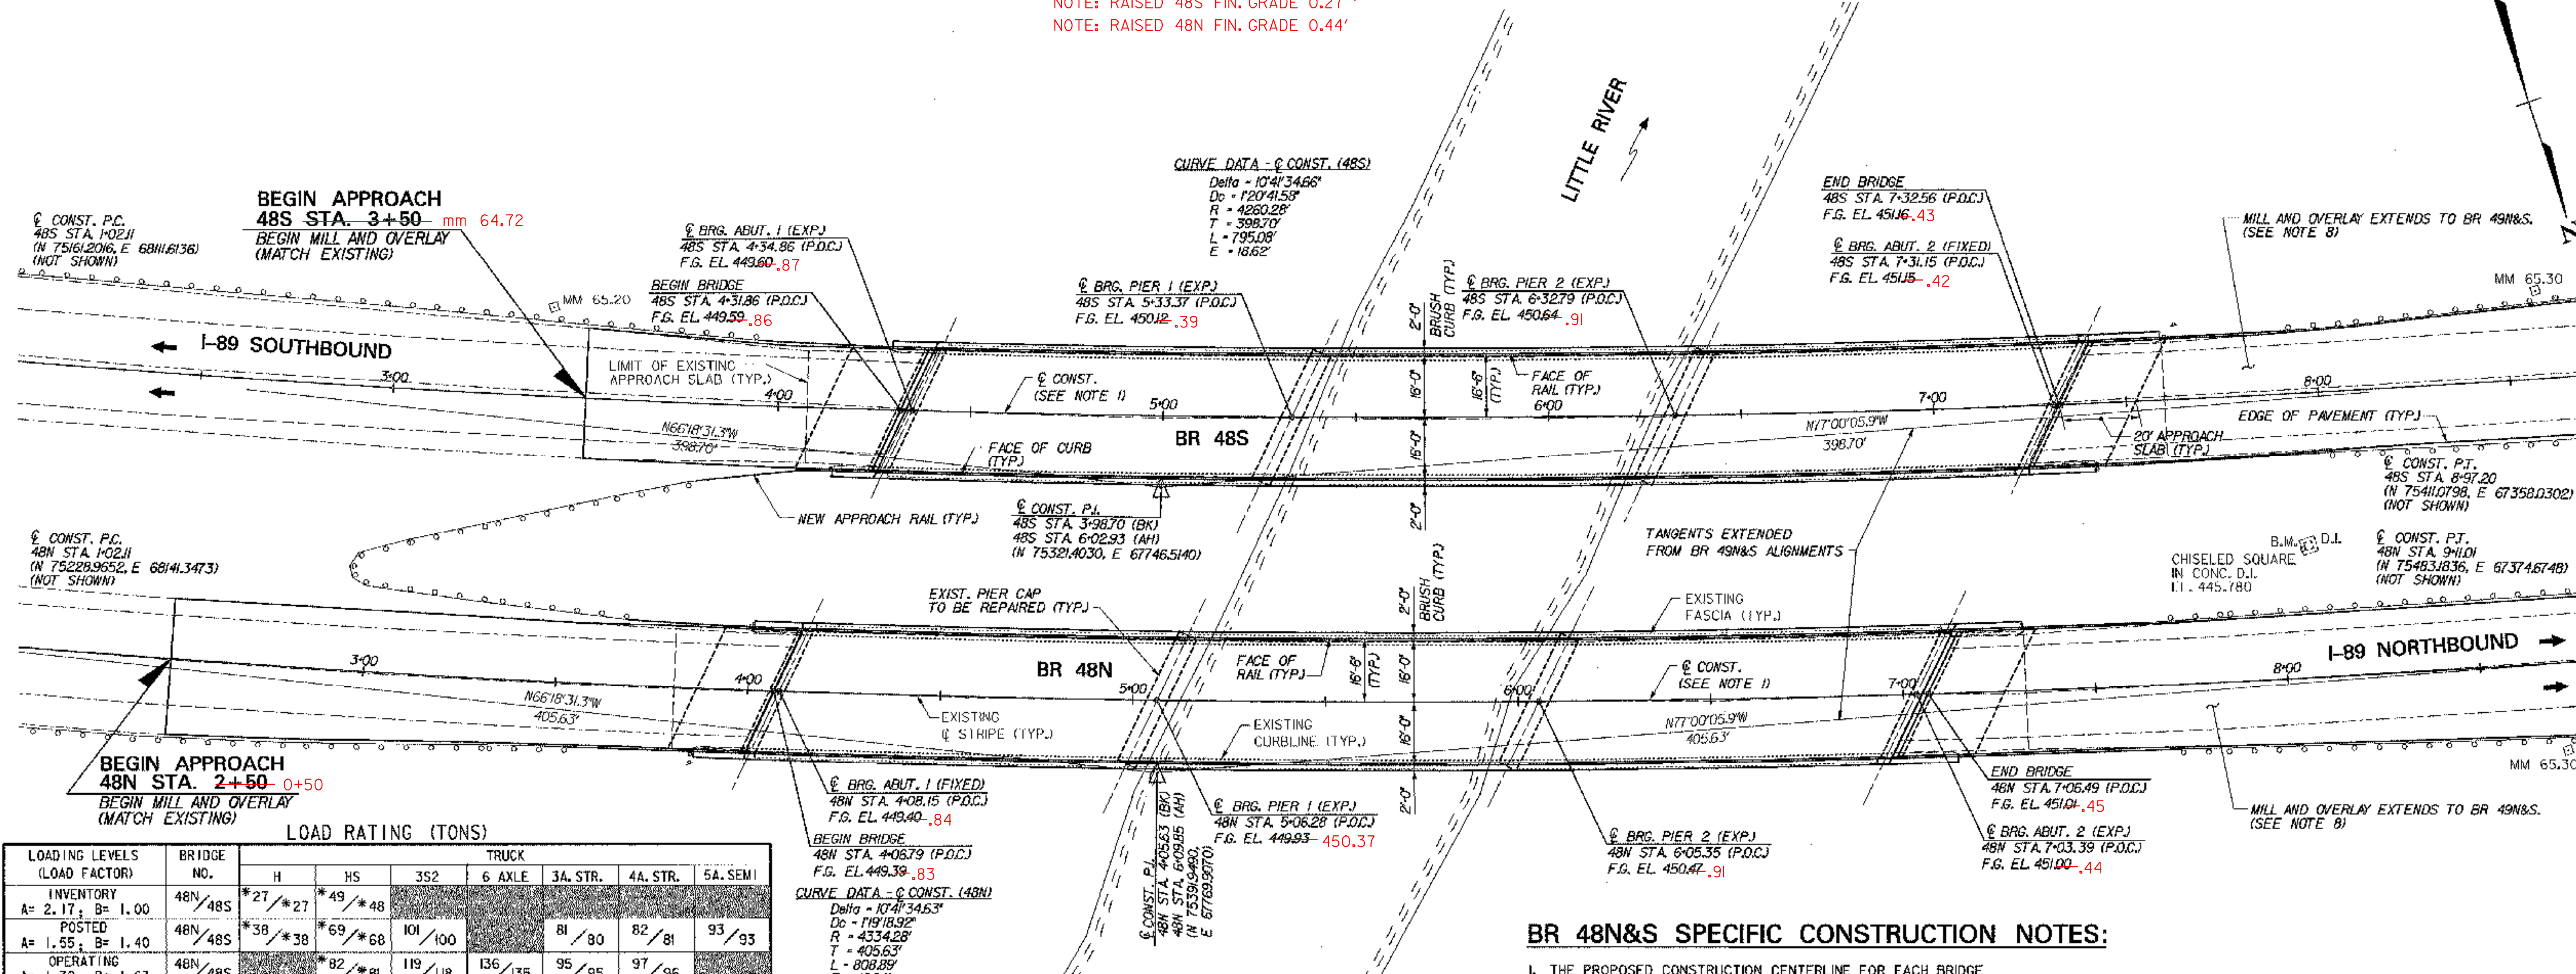

**LOAD RATING (TONS)**

LOADING LEVELS (LOAD FACTOR)	BRIDGE NO.	TRUCK						
		H	HS	3S2	6 AXLE	3A. STR.	4A. STR.	5A. SEMI
INVENTORY A= 2.17, B= 1.00	48N/48S	*27/*27	*49/*48					
POSTED A= 1.55, B= 1.40	48N/48S	*38/*38	*69/*68	101/100		81/80	82/81	93/93
OPERATING A= 1.30, B= 1.67	48N/48S	*82/*81		119/118	136/135	95/95	97/96	

NOTE: RATINGS ARE BASED ON A STRAIGHT-LINE GIRDER ANALYSIS, DIVIDED BY LOS TO ACCOUNT FOR THE EFFECTS OF CURVATURE.

STRENGTH RF =  $\frac{\phi M_n - 1.3 M_{DL}}{A X M_{UH}}$  \* SERVICEABILITY RF =  $\frac{0.95 F_y S_{LL1} - M_{DL} \frac{S_{LL1}}{S_{DL}} - M_{SD1} \frac{S_{LL1}}{S_{SD1}}}{167 M_{LL1}}$



**PLAN**  
SCALE: 1"=20'

**BR 48N&S SPECIFIC CONSTRUCTION NOTES:**

1. THE PROPOSED CONSTRUCTION CENTERLINE FOR EACH BRIDGE WAS ESTABLISHED BASED ON BEST FIT BETWEEN EXISTING CURB LINES. IT DOES NOT EXACTLY MATCH THE ORIGINAL CONSTRUCTION CENTERLINE.
2. FOR CONTROL POINT TIE SKETCHES, SEE CONTROL POINT TIES (48N&S AND 49N&S), BRIDGE SHEET C-11.
3. REPLACE SUPERSTRUCTURE STEEL, BEARINGS, DECK SLABS, APPROACH SLABS, BRIDGE RAIL AND APPROACH RAIL. RESET GUARD RAIL.
4. NEW SCUPPERS ARE REQUIRED ON BRIDGE 48S. FOR LOCATION OF NEW SCUPPERS, SEE FRAMING PLAN (48S), BRIDGE SHEET BR48-9.
5. CONSTRUCT NEW BACKWALLS AT EXPANSION ABUTMENTS AND NEW CURTAINWALLS AT FIXED ABUTMENTS. REBUILD ABUTMENT BRIDGE SEATS AND MODIFY WINGWALLS AS SHOWN IN THE PLANS.
6. REPAIR PIER STEM AND PIER CAP DELAMINATED AND SPALLED AREAS. REBUILD PIER SEAT TO PROPOSED ELEVATIONS.
7. REPAIR ABUTMENT DELAMINATED AND SPALLED AREAS.
8. MILL AND OVERLAY EXTENDS TO BR 49N&S. FOR END LIMITS OF MILL AND OVERLAY, SEE GENERAL PLAN (49N&S), BRIDGE SHEET BR49-L.
9. RE-STRIPE BRIDGE AND APPROACH ROADWAY.

**TABLE OF BRIDGE COORDINATES**

BRIDGE	CL CONST. @	STATION	NORTHING	EASTING
48N	BEGIN BRIDGE	4+06.79	75341.4836	67856.2782
	CL BRG. ABUT. 1	4+08.15	75341.9417	67856.9955
	CL BRG. PIER 1	5+06.28	75373.8843	67764.2122
	CL BRG. PIER 2	6+05.35	75403.8939	67669.8307
	CL BRG. ABUT. 2	7+03.39	75431.5592	67575.7772
	END BRIDGE	7+06.49	75432.4882	67572.7971
48S	BEGIN BRIDGE	4+31.88	75281.8840	67804.8348
	CL BRG. ABUT. 1	4+34.86	75282.8731	67802.0004
	CL BRG. PIER 1	5+33.37	75314.2178	67708.6125
	CL BRG. PIER 2	6+32.79	75343.6544	67813.6526
	CL BRG. ABUT. 2	7+31.15	75370.5887	67519.0545
	END BRIDGE	7+32.56	75370.9593	67517.6927

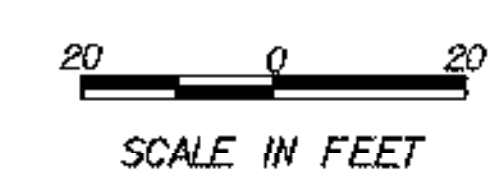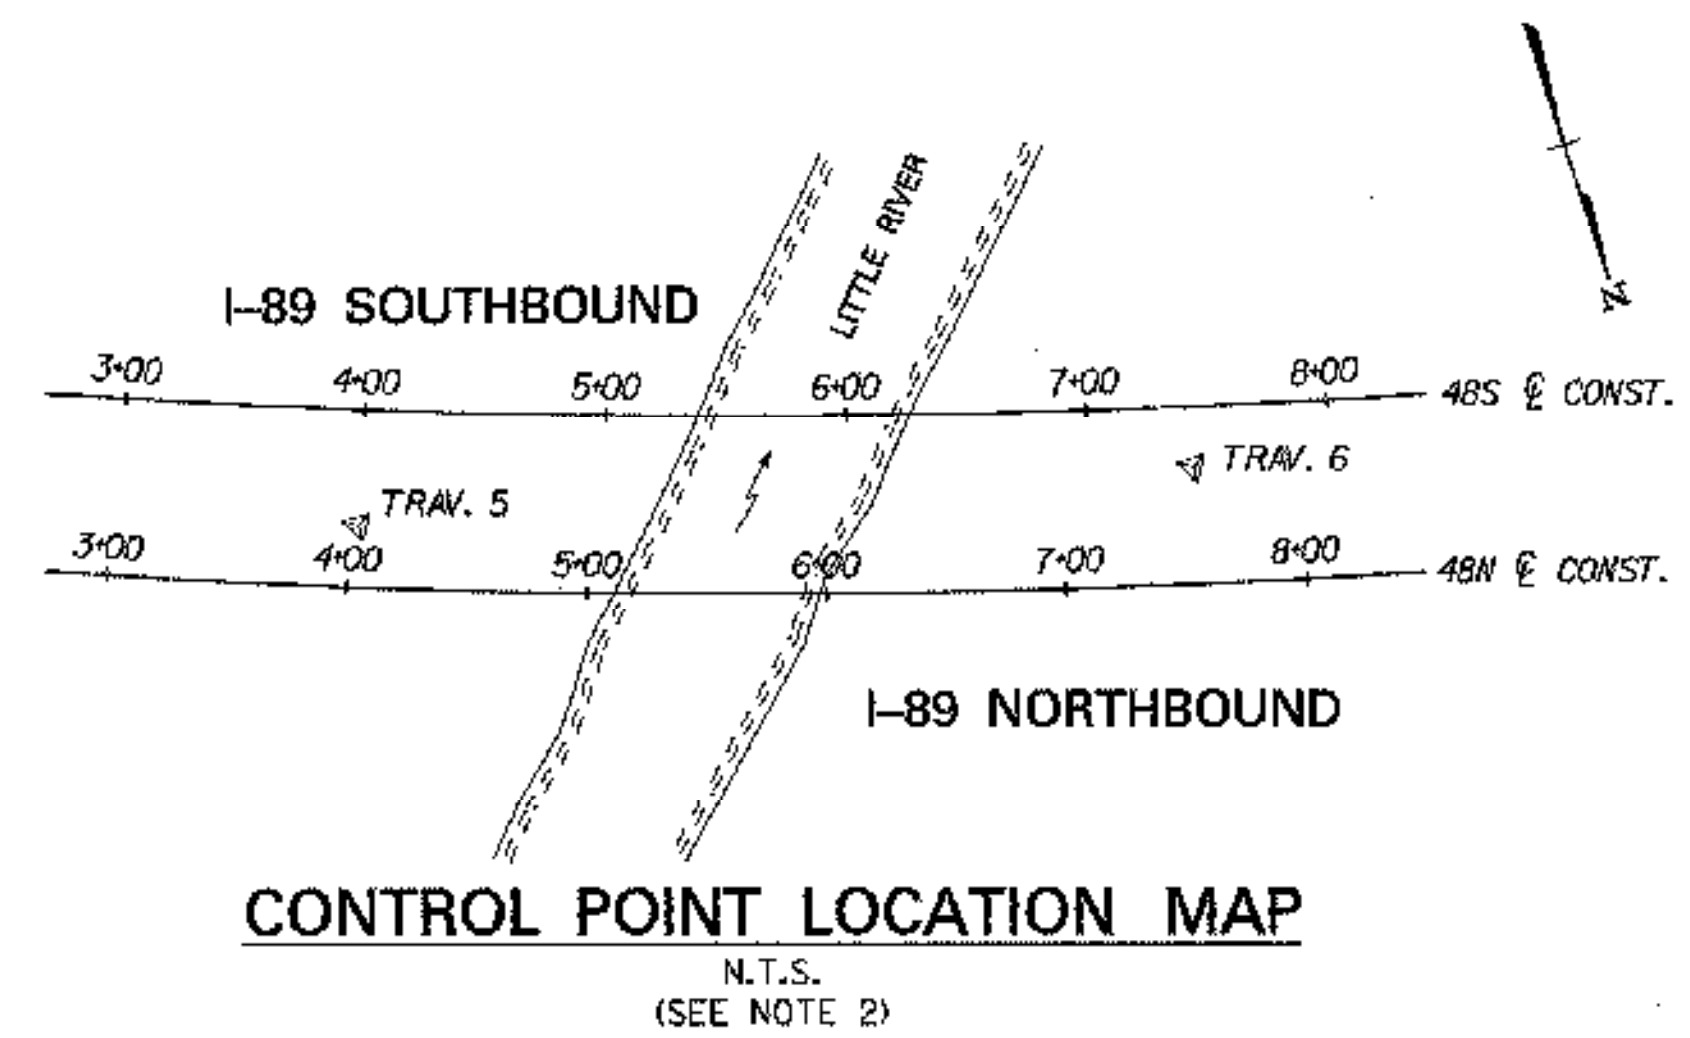

**STATE OF VERMONT AGENCY OF TRANSPORTATION**

Town Of MIDDLESEX-BOLTON Bridge No. **48N&S**

Highway No. I-89 Log Sta. \_\_\_\_\_  
 Surv. Sta. \_\_\_\_\_

**I-89 OVER LITTLE RIVER**


**GENERAL PLAN (48N&S)**

Designed By P.W. SZUSTAK Drawn By R.A. BOTZENHART  
 Checked By J.P. HALSTEAD Date 10/99 Bridge Design Supervisor  
 J.P. HALSTEAD 10/99 J.P. HALSTEAD Date 10/99


PROJECT MIDDLESEX-BOLTON PROJECT NO. IM-089-2(26)  
 TVGA CAD Drawing No. 48gen.pl Date 10/99  
 Bridge Sheet No. **BR48-1** Sheet 61 of 307

**TVA** TVGA ENGINEERING, SURVEYING, P.C.

NOTE: RAISED BRIDGE 48N FIN. GRADE 0.44'

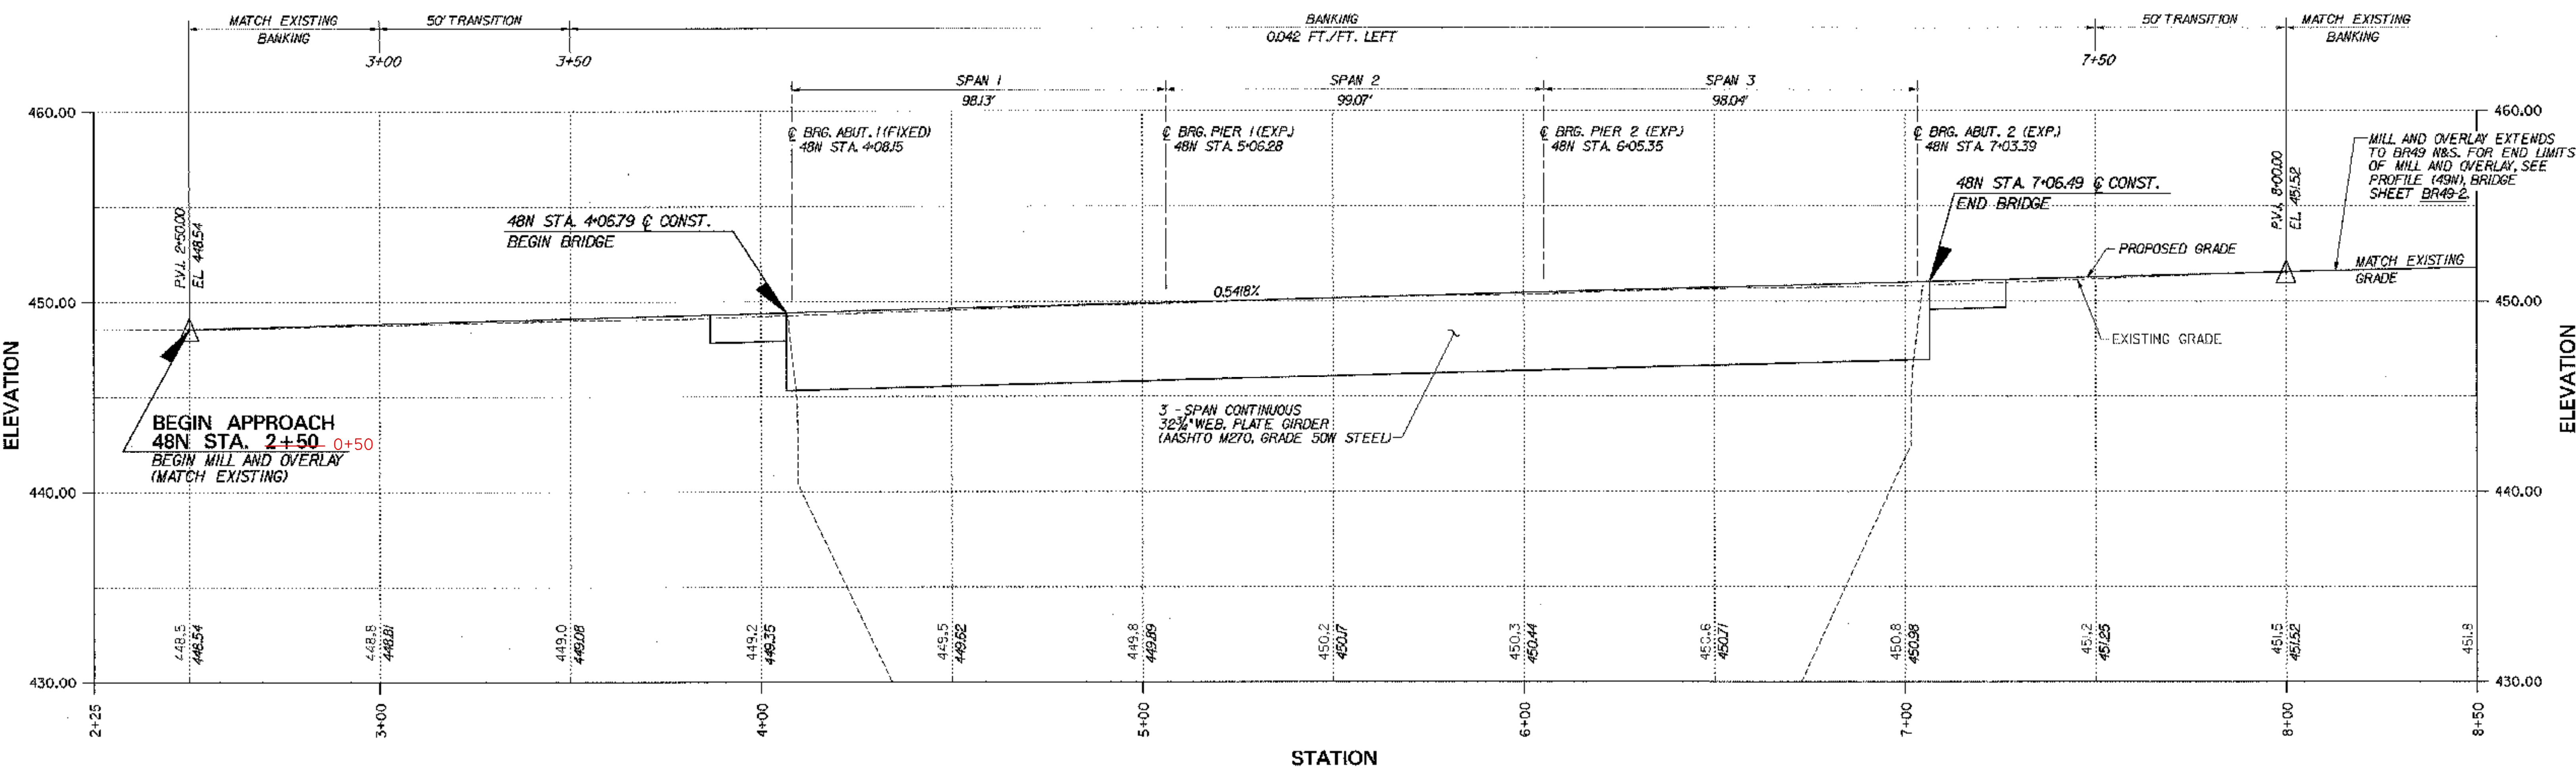


PROFILE - BR 48N

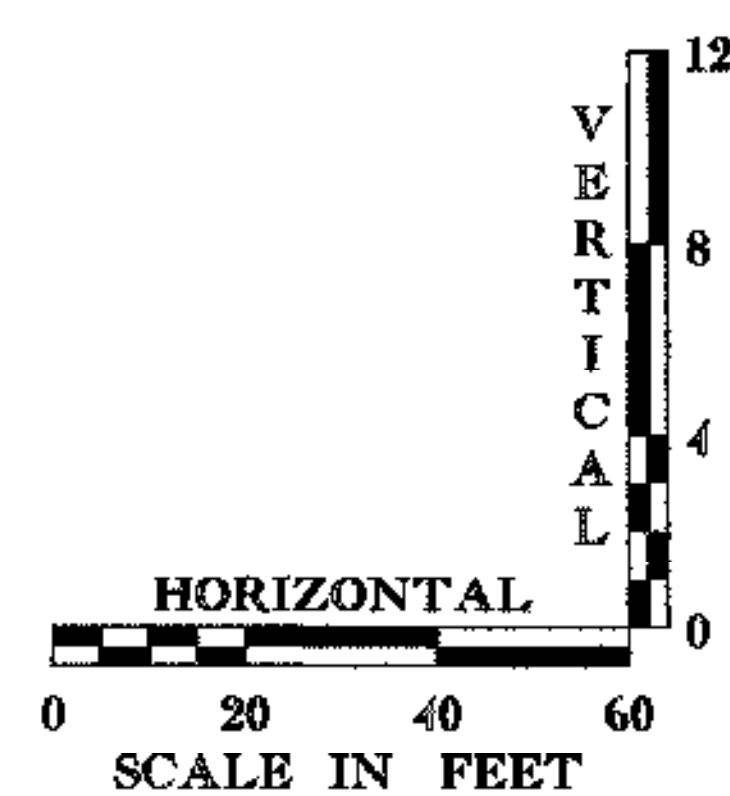


<b>STATE OF VERMONT AGENCY OF TRANSPORTATION</b>			
Town Of	MIDDLESEX-BOLTON	Bridge No.	<b>48N</b>
Highway No.	I-89	Log Sta.	
		Surv. Sta.	
I-89 NB OVER LITTLE RIVER			
<b>PROFILE (48N)</b>			
Designed By	P.W. SZUSTAK	Drawn By	R.A. BOTZENHART
Checked By	J.P. HALSTEAD	Bridge Design Supervisor	J.P. HALSTEAD
Date	10/99	Date	10/99
PROJECT	MIDDLESEX-BOLTON	PROJECT NO.	IM-089-2(26)
TVGA CAD Drawing No.	48nprof	Date	10/99
Bridge Sheet No.	<b>BR48-2</b>	Sheet	62 of 307

**TVGA** TVGA ENGINEERING, SURVEYING, P.C.

NOTE: RAISED BRIDGE 48S FIN. GRADE 0.27'

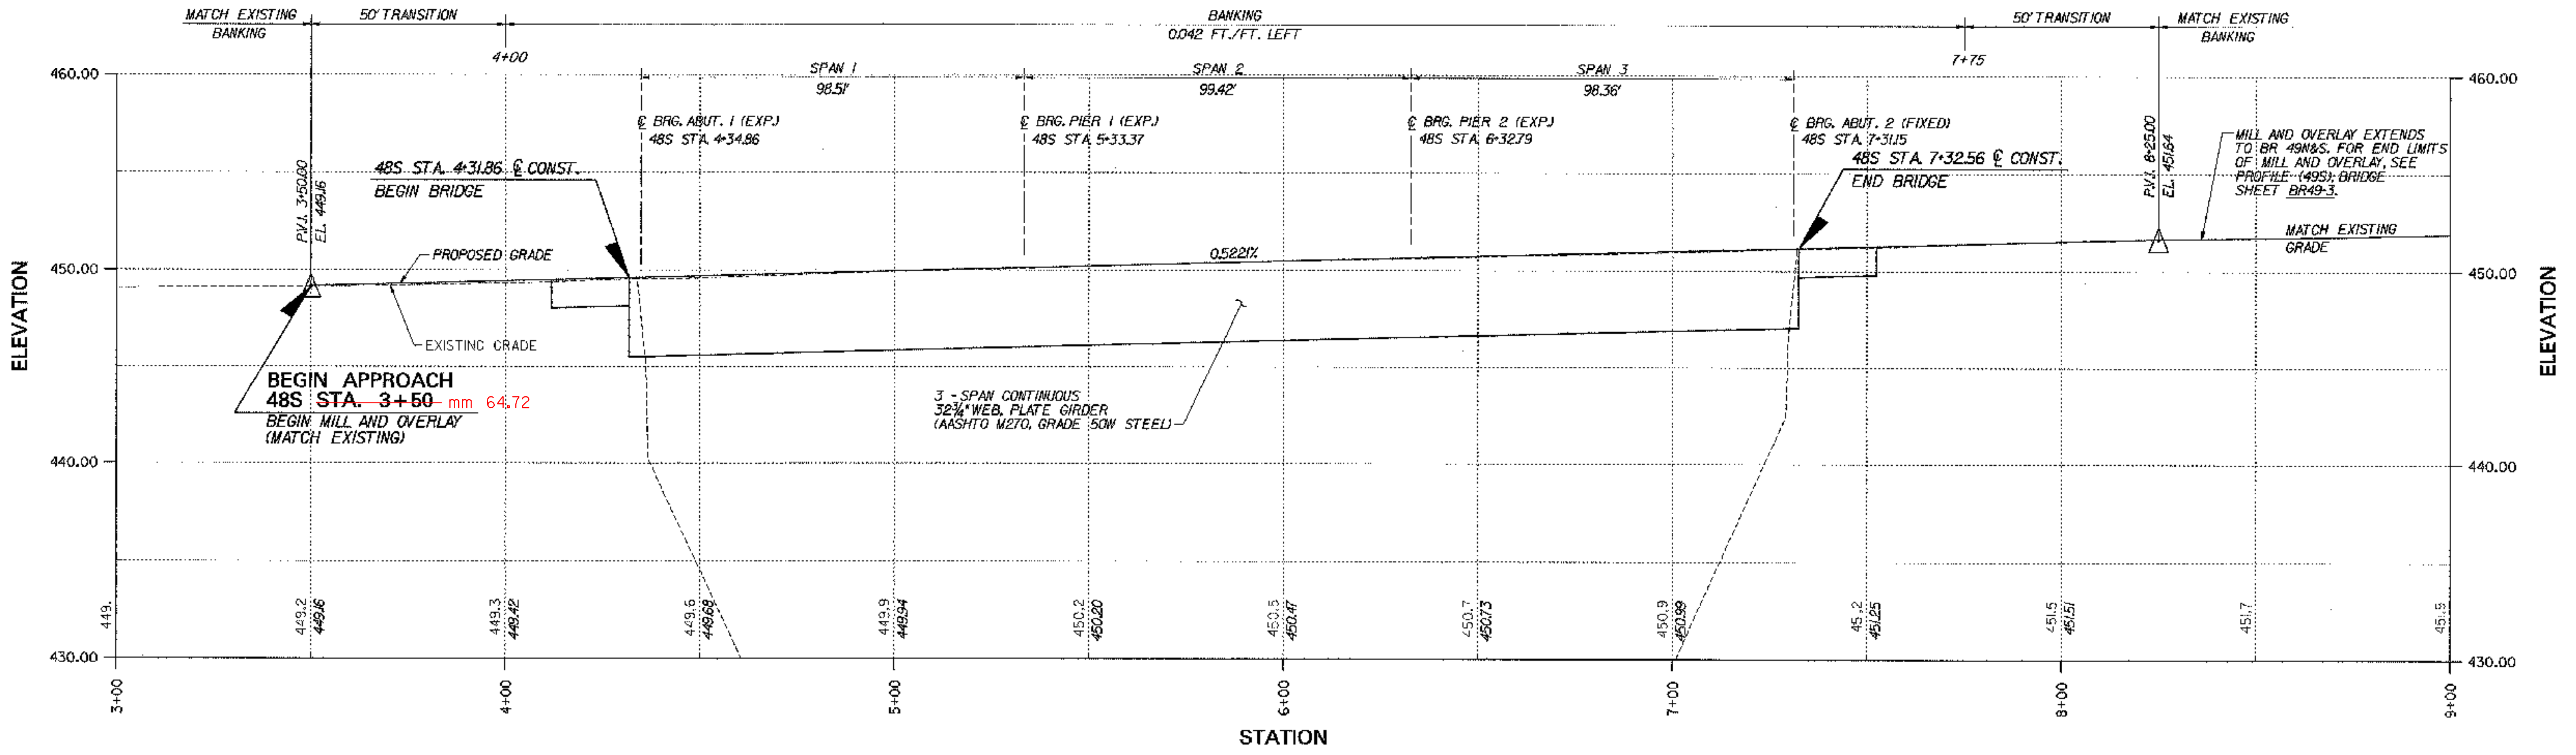


PROFILE - BR 48S

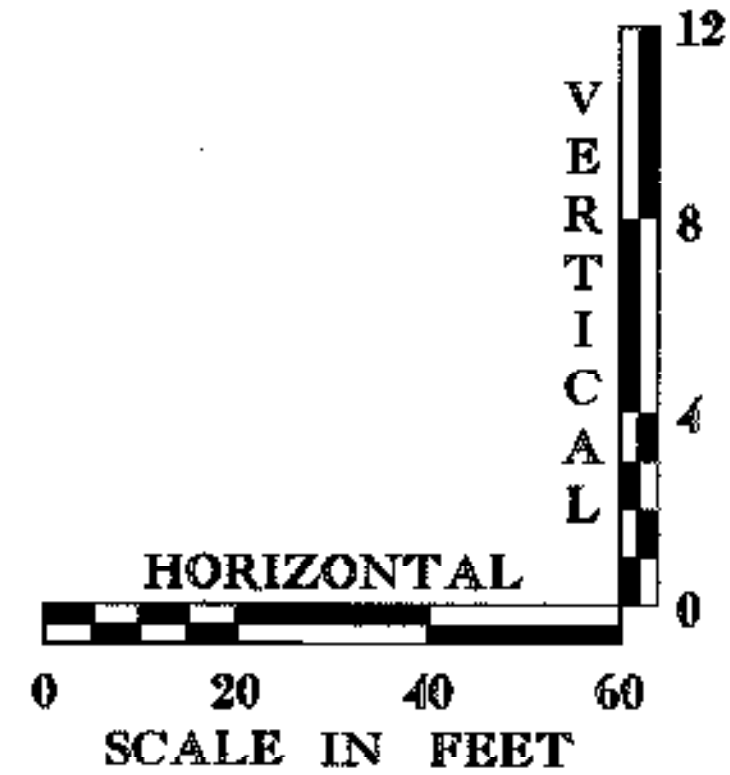


<b>STATE OF VERMONT AGENCY OF TRANSPORTATION</b>	
Town Of <b>MIDDLESEX-BOLTON</b>	Bridge No. <b>485</b>
Highway No. <b>I-89</b>	Log Sta. Surv. Sta.
<b>I-89 SB OVER LITTLE RIVER</b>	
<b>PROFILE (485)</b>	
Designed By <b>P.W. SZUSTAK</b>	Drawn By <b>R.A. BOTZENHART</b>
Checked By <b>J.P. HALSTEAD</b>	Bridge Design Supervisor
Date <b>10/99</b>	Date <b>10/99</b>
PROJECT <b>MIDDLESEX-BOLTON</b>	PROJECT NO. <b>IM-089-2(26)</b>
TVGA CAD Drawing No. <b>48spraf</b>	Date <b>10/99</b>
Bridge Sheet No. <b>BR48-3</b>	Sheet <b>63</b> of <b>307</b>

**TVGA** TVGA ENGINEERING,  
SURVEYING, P. C.

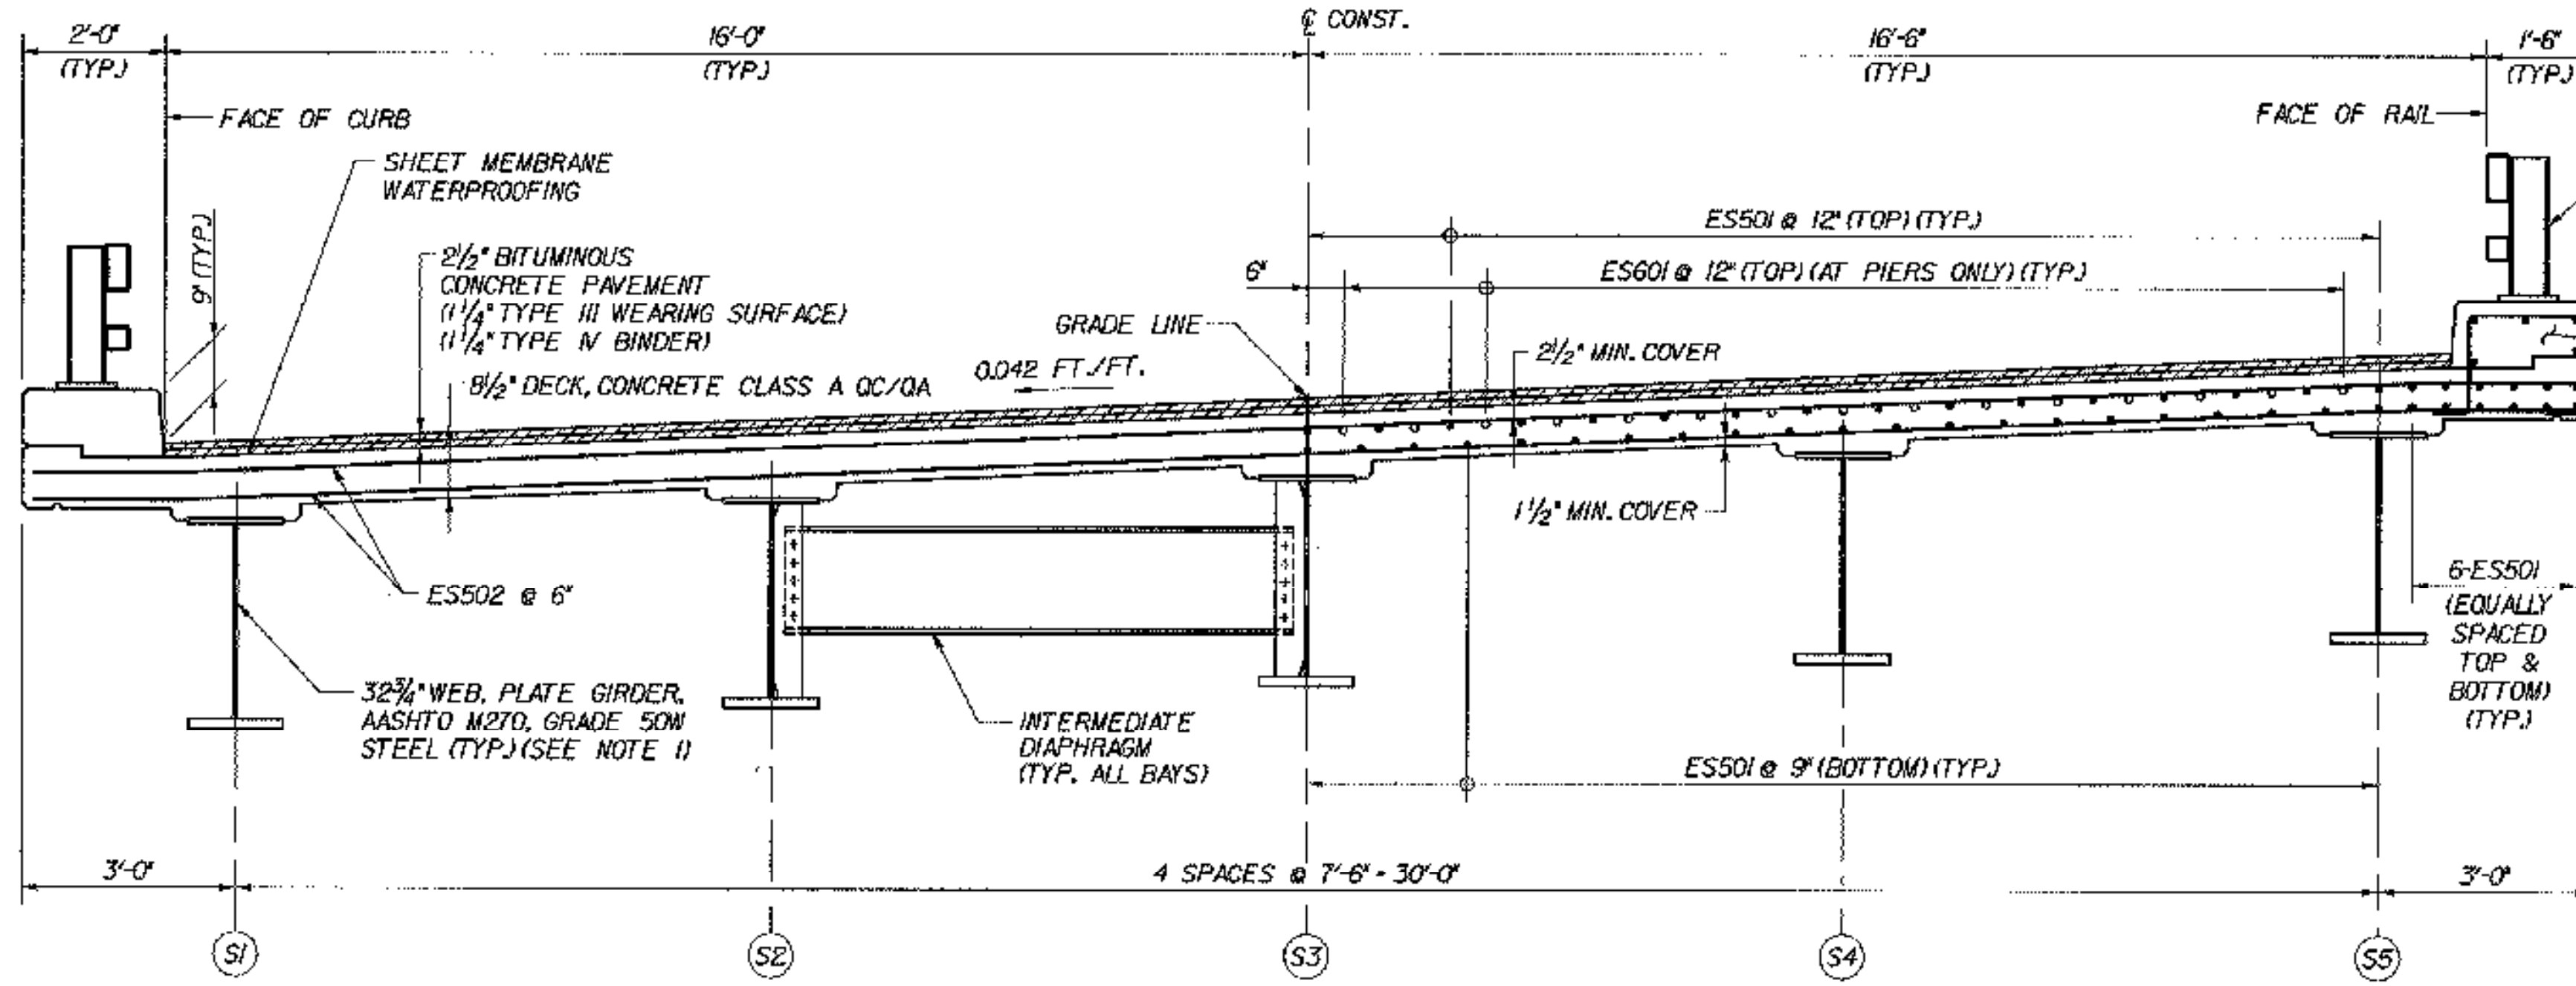


TRANSVERSE SECTION  
SCALE: 1/2" = 1'-0"

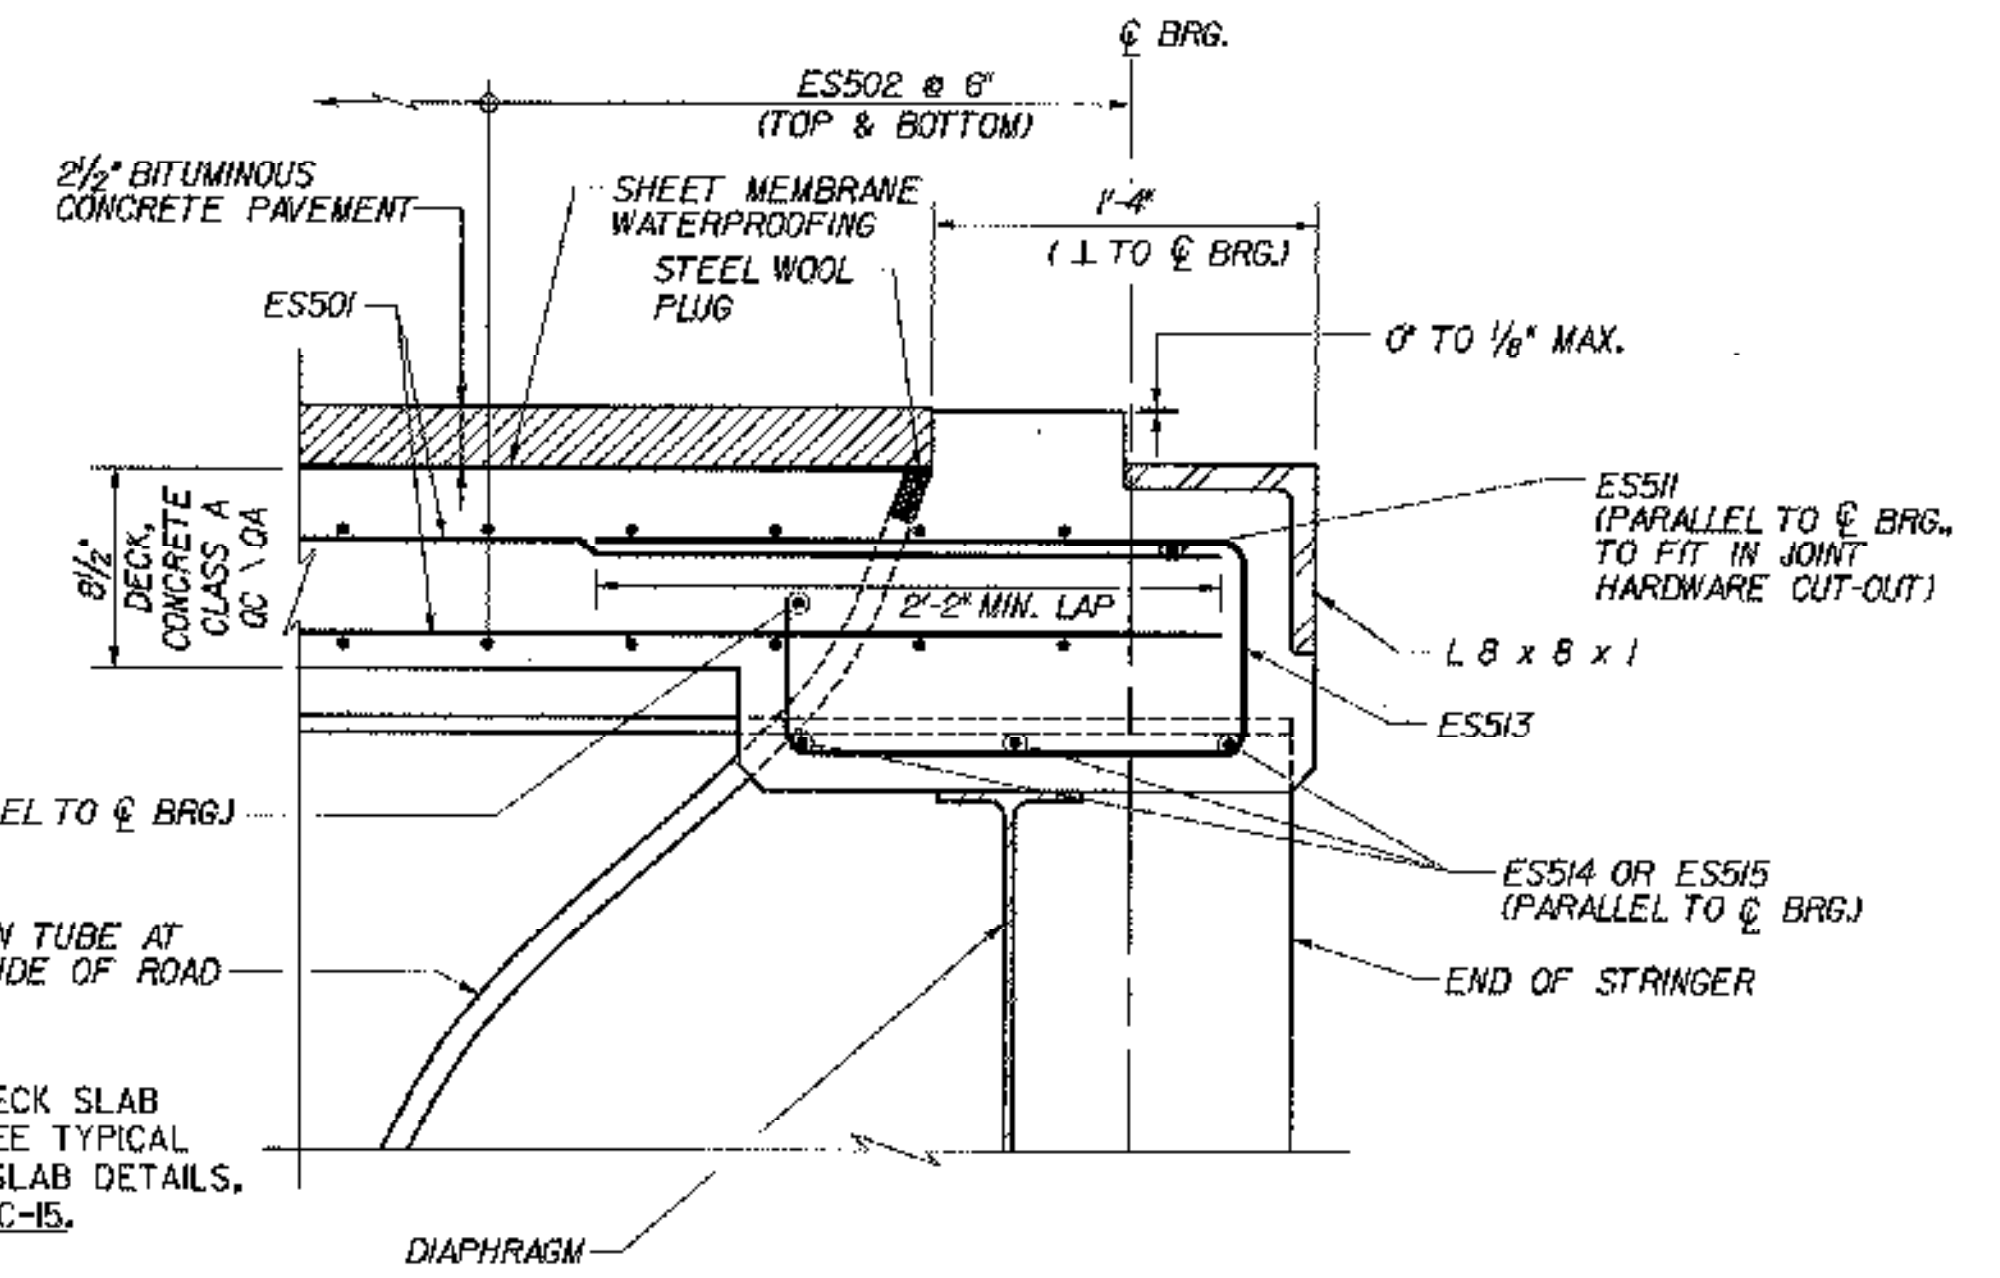


END OF DECK SLAB REINFORCEMENT DETAIL  
(EXP. END)

(EXP. END)  
SCALE: 1 1/2" = 1'-0"

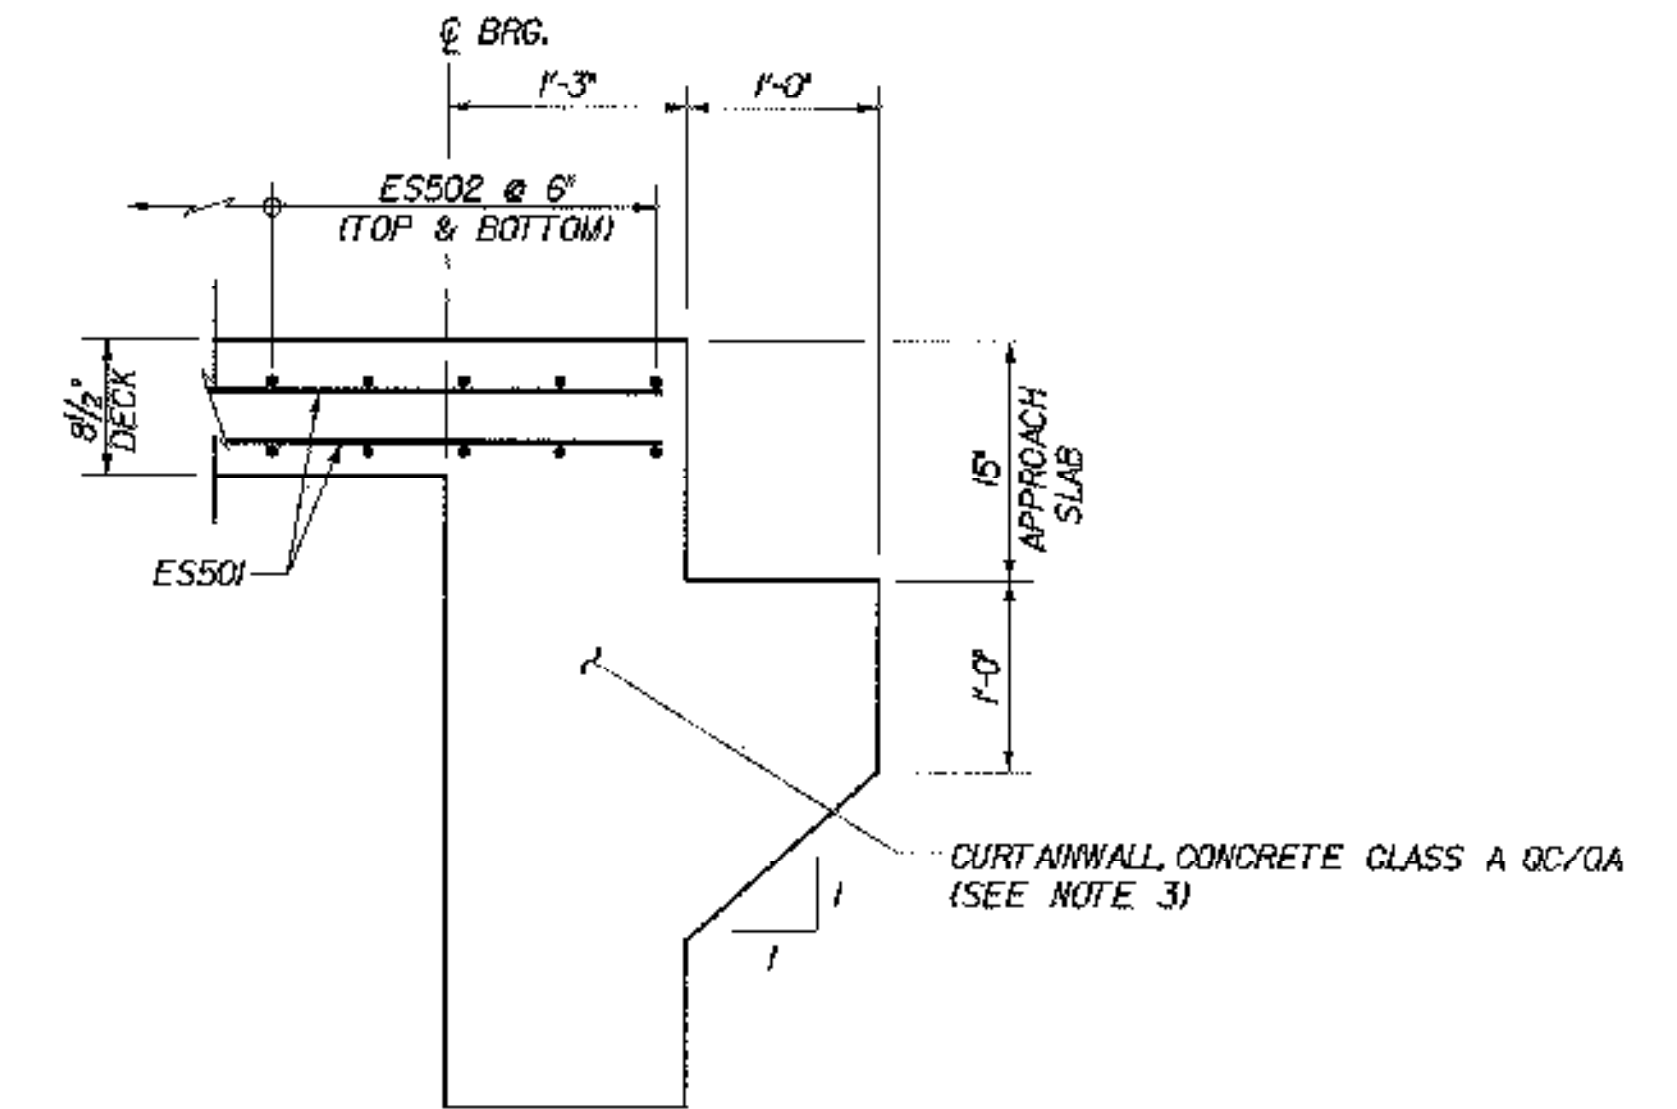


END OF DECK SLAB REINFORCEMENT DETAIL  
(FIXED END)

(FIXED END)  
SCALE: 1" = 1'-0"

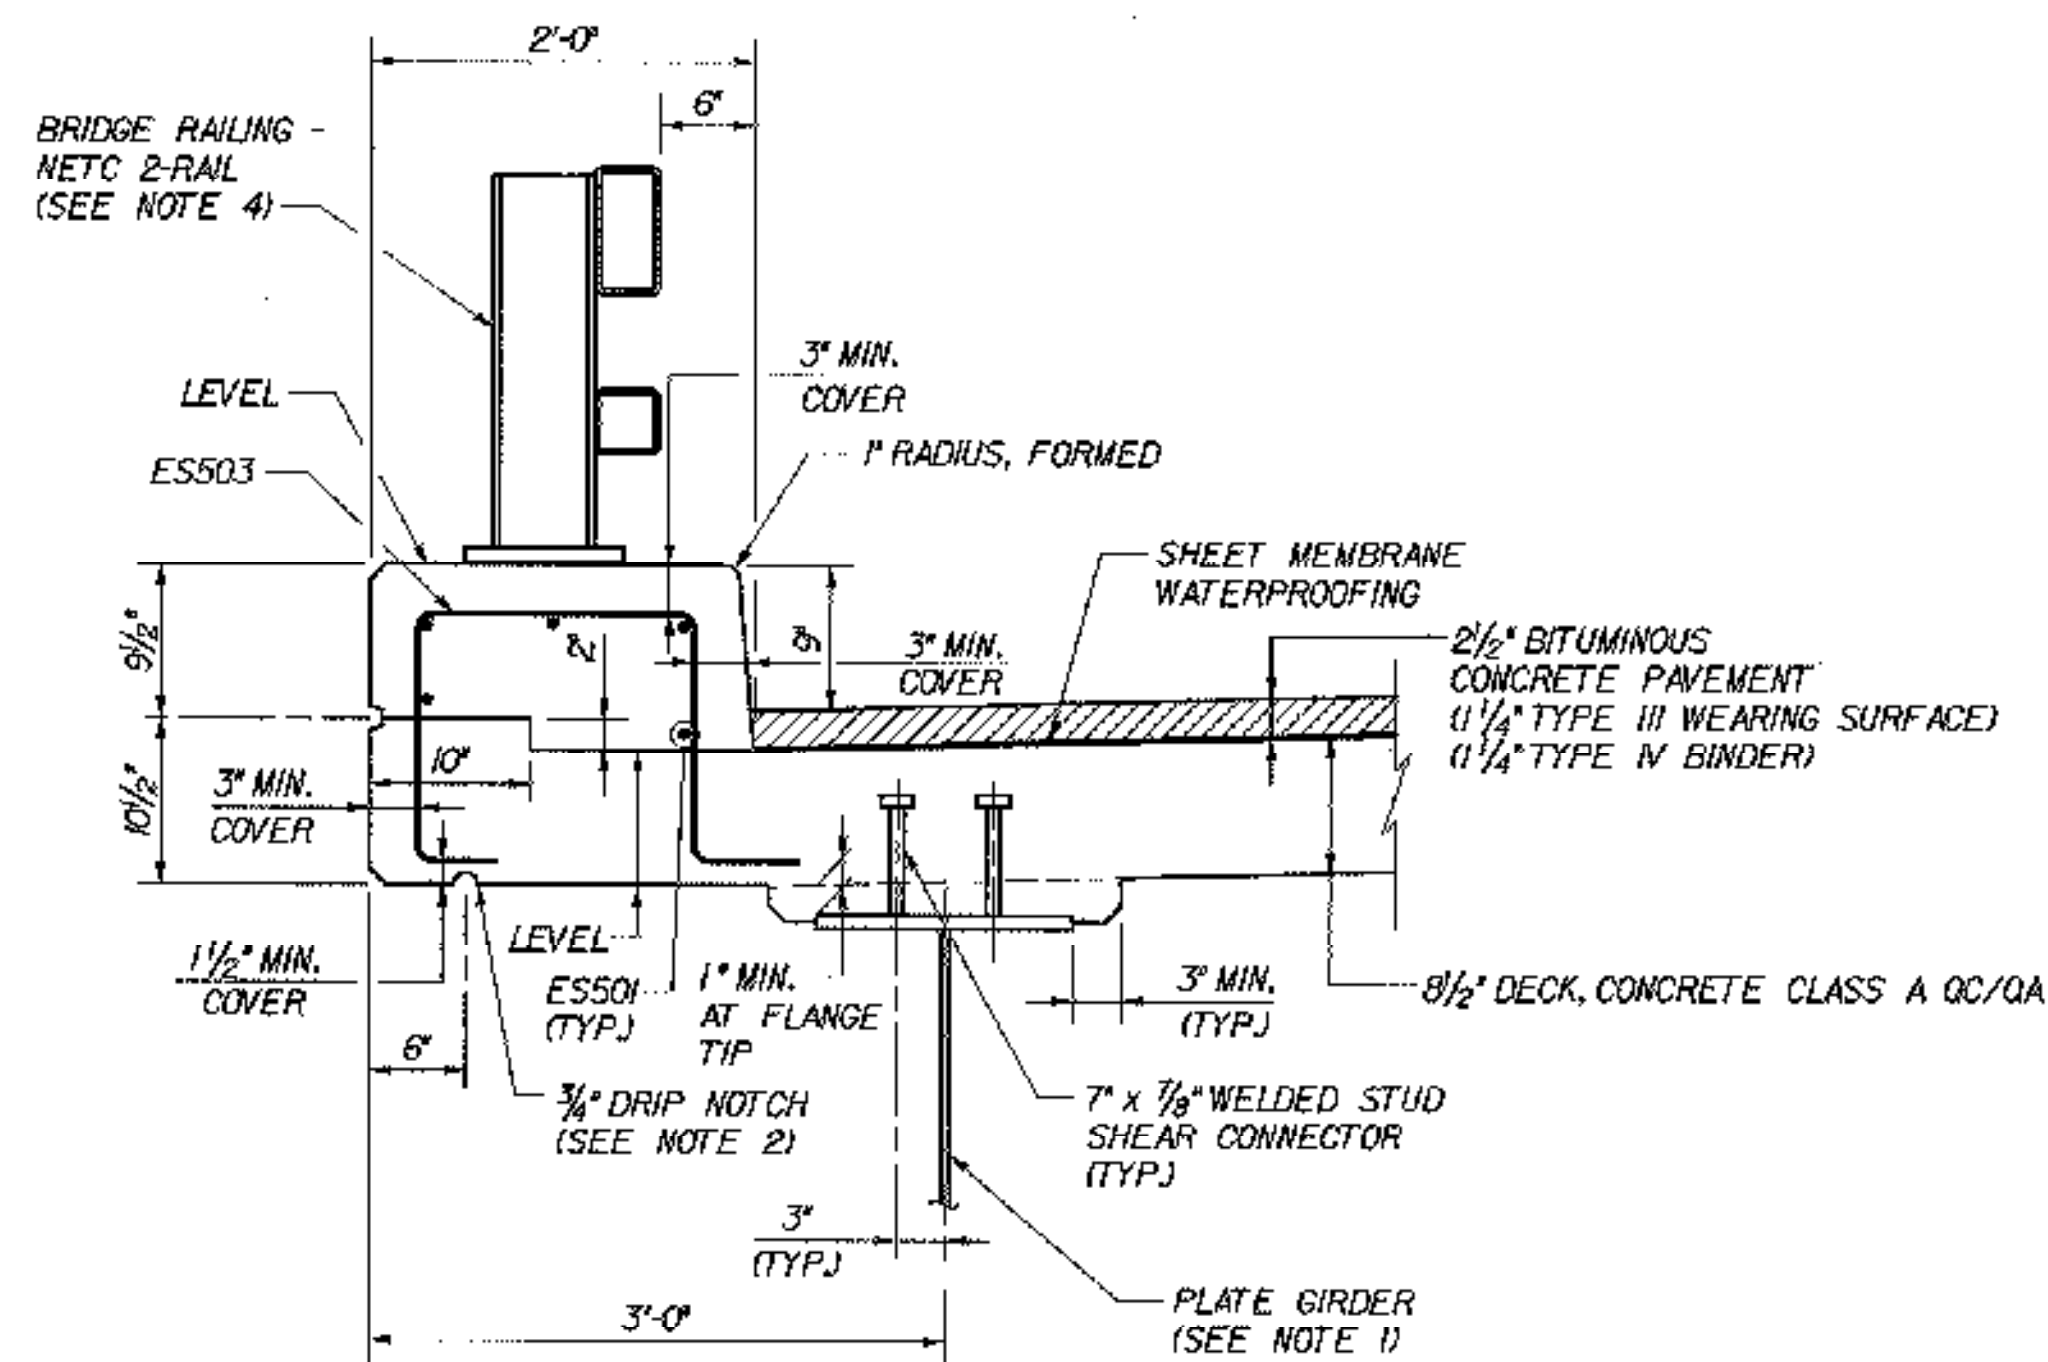

FASCIA DETAIL  
SCALE: 1" = 1'-0"

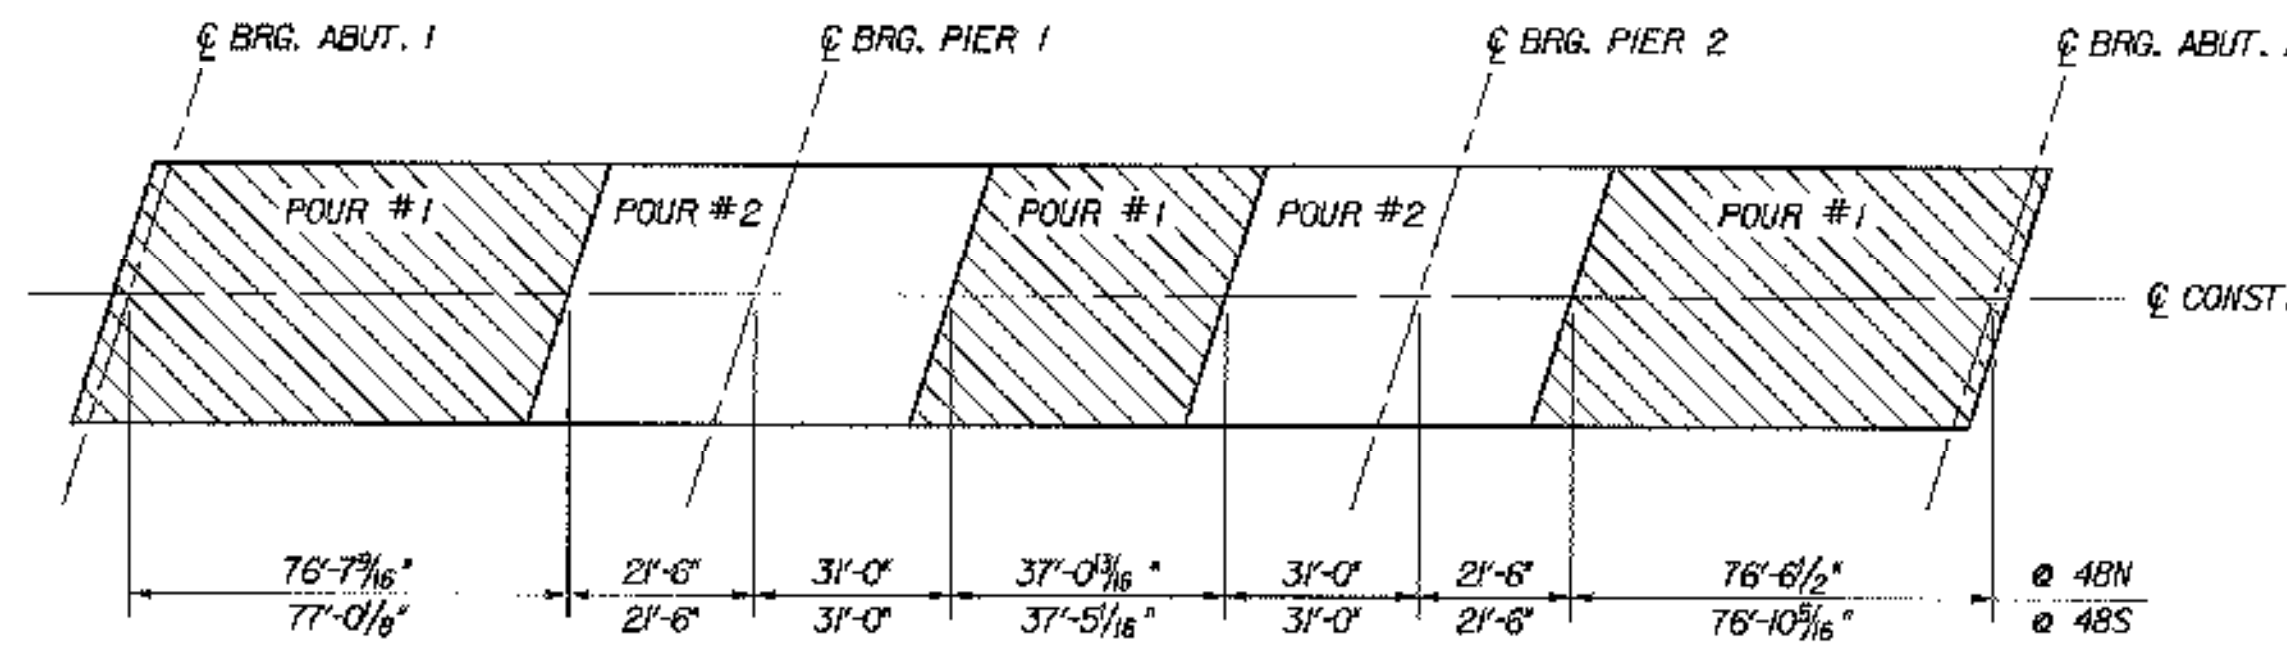

DECK POUR SEQUENCE  
N.T.S.

DECK SLAB PLACEMENT NOTES

BRIDGE 48N AND 48S WAS DONE IN A SINGLE POUR WITH NO CONSTRUCTION JOINT.

- EACH CONCRETE DECK POUR SHALL BE PLACED CONTINUOUSLY WITHIN ONE EIGHT HOUR WORKING DAY. THERE SHALL BE A MINIMUM DELAY PERIOD OF 96 HOURS AFTER COMPLETION OF EACH POUR BEFORE BEGINNING ANOTHER POUR. INDIVIDUAL POUR NUMBERS AS SHOWN MAY BE COMBINED INTO A SINGLE POUR IF APPROVED BY THE VAOT STRUCTURES ENGINEER.
- THE DECK CONCRETE SHALL BE RETARDANT SUFFICIENTLY TO REMAIN PLASTIC UNTIL EACH POUR IS COMPLETE. THE QUANTITY OF RETARDANT SHALL BE APPROVED BY THE CONCRETE ENGINEER PRIOR TO PLACEMENT. ANY DEVIATIONS FROM THIS PROCEDURE MUST BE APPROVED BY THE VAOT STRUCTURES ENGINEER IN WRITING BEFORE THE POUR BEGINS.

NOTES:

- FOR PLATE GIRDER SIZES SEE STRINGER ELEVATION (48N&S), BRIDGE SHEET BR48-10.
- END DRIP NOTCH 5 FEET BEFORE END OF SLAB AT "DOWNHILL" ABUTMENTS AT 45°.
- FOR CURTAINWALL DETAILS AND REINFORCEMENT LAYOUT, SEE TYPICAL CURTAINWALL DETAILS, BRIDGE SHEET C-42.
- FOR DETAILS OF NETC BRIDGE RAIL AND APPROACH SECTION, SEE STANDARD SHEETS BR1-97 AND BR3-97, AND GUARD RAIL APPROACH SECTION, NETC 2 RAIL, BRIDGE SHEETS C-46A AND C-46B.

STATE OF VERMONT  
AGENCY OF TRANSPORTATION


Town Of MIDDLESEX-BOLTON Bridge No. 48N&S  
Highway No. 1-89 Log Sta. Surv. Sta.

1-89 OVER LITTLE RIVER


TRANSVERSE SECTION (48N&S)  
Designed By P.W. SZUSTAK Drawn By R.A. BOTZENHART  
Checked By J.P. HALSTEAD Date 10/99 Bridge Design Supervisor J.P. HALSTEAD Date 10/99

PROJECT MIDDLESEX-BOLTON PROJECT NO. IM-089-2(26)

TVGA CAD Drawing No. 48tsec Date 10/99  
Bridge Sheet No. BR48-4 Sheet 64 of 307

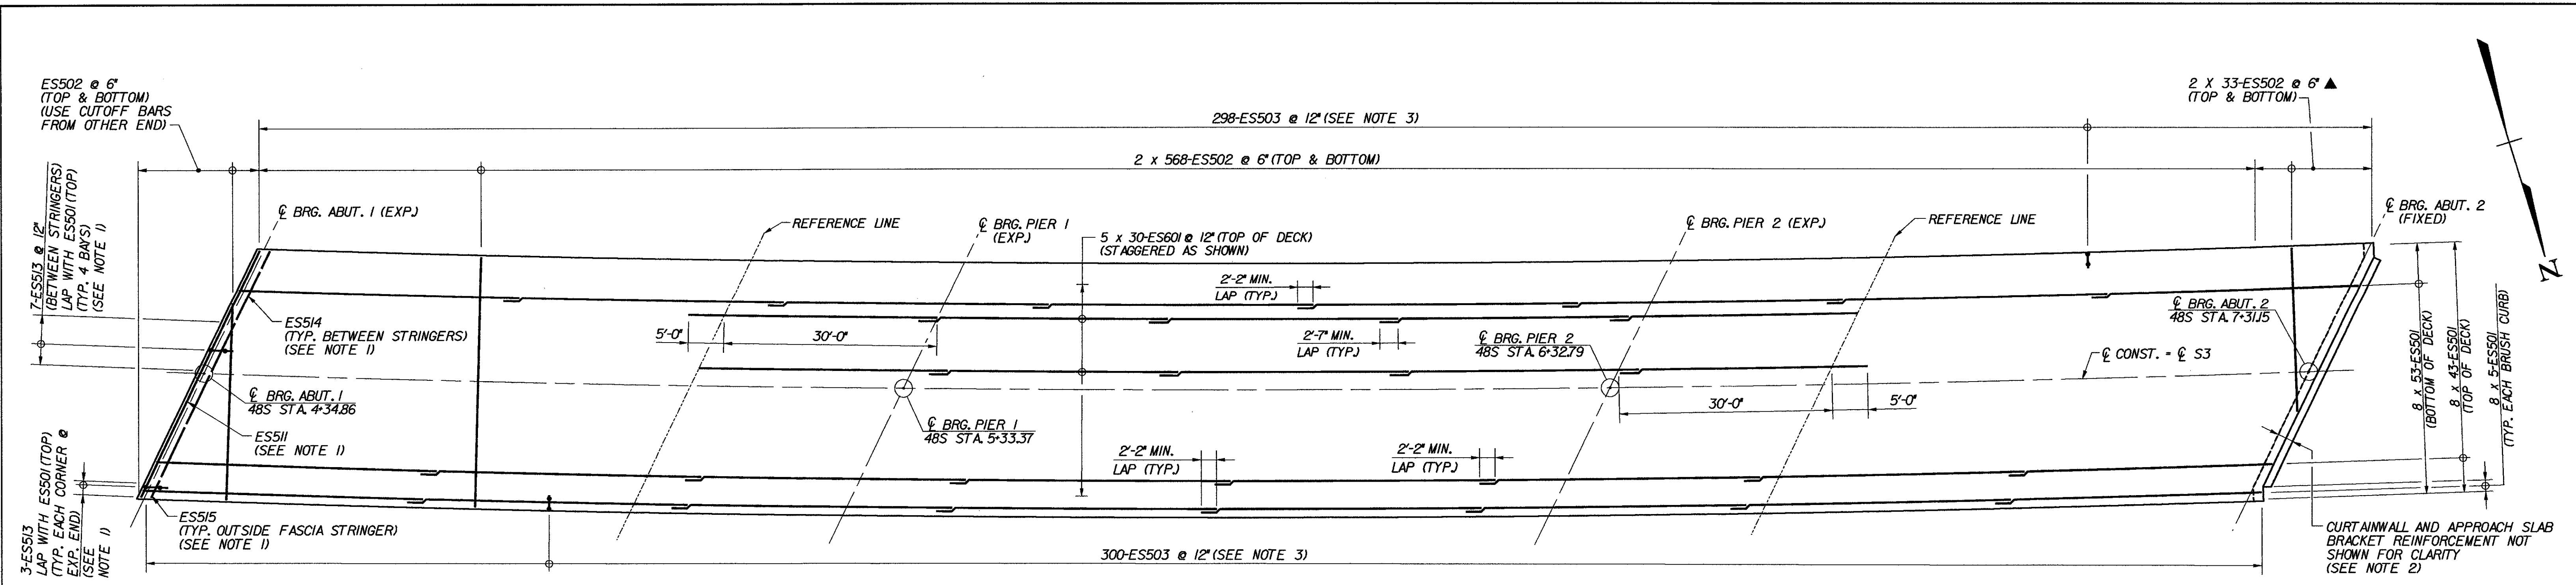

**DECK REINFORCEMENT PLAN - BR 48S**  
SCALE: 3/32" = 1'-0"

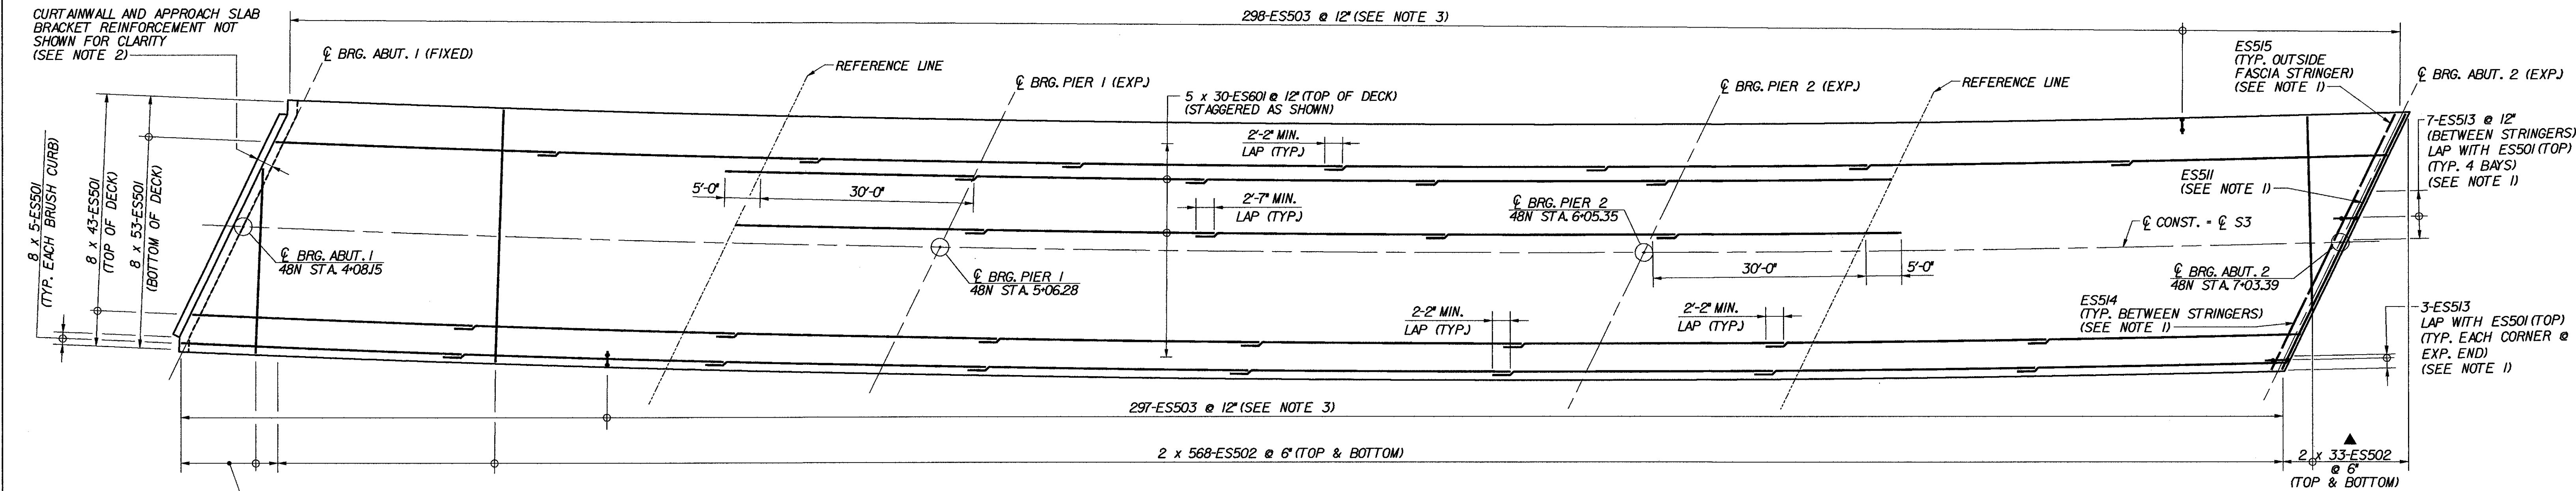

**DECK REINFORCEMENT PLAN - BR 48N**  
SCALE: 3/32" = 1'-0"

**NOTES:**


1. FOR END OF DECK SLAB DETAILS, SEE TRANSVERSE SECTION (48N&S), BRIDGE SHEET BR48-4.
2. FOR CURTAINWALL REINFORCEMENT, SEE TYPICAL CURTAINWALL DETAILS, BRIDGE SHEET C-42.
3. THE QUANTITY OF ES503 BARS SHOWN DOES NOT INCLUDE ADDITIONAL BARS REQUIRED BELOW THE BRIDGE RAIL POSTS. FOR DETAILS OF THE REQUIRED STIRRUP SPACING, SEE NETC 2-RAIL STANDARD SHEET BRI-97. FOR LOCATIONS OF THE BRIDGE RAIL POSTS, SEE CURB AND RAIL LAYOUT PLANS, BRIDGE SHEET BR48-7.


**KEY**

- NF NEAR FACE
- FF FAR FACE
- EF EACH FACE
- ▲ REINFORCEMENT TO BE CUT TO FIT IN THE FIELD


**STATE OF VERMONT  
AGENCY OF TRANSPORTATION**

Town Of	MIDDLESEX-BOLTON	Bridge No.	48N&S
Highway No.	I-89	Log Sta.	
		Surv. Sta.	
I-89 OVER LITTLE RIVER			
<b>DECK REINFORCEMENT PLANS (48N&amp;S)</b>			
Designed By	P.W. SZUSTAK	Drawn By	R.A. BOTZENHART
Checked By	J.P. HALSTEAD	Date	10/99
		Bridge Design Supervisor	J.P. HALSTEAD Date 10/99
PROJECT	MIDDLESEX-BOLTON	PROJECT NO.	IM-089-2(26)
TVGA CAD Drawing No.	48drp	Date	10/99
Bridge Sheet No.	BR48-5	Sheet	65 of 307

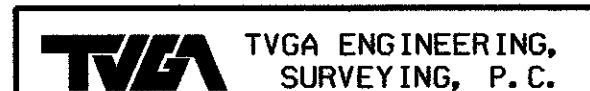


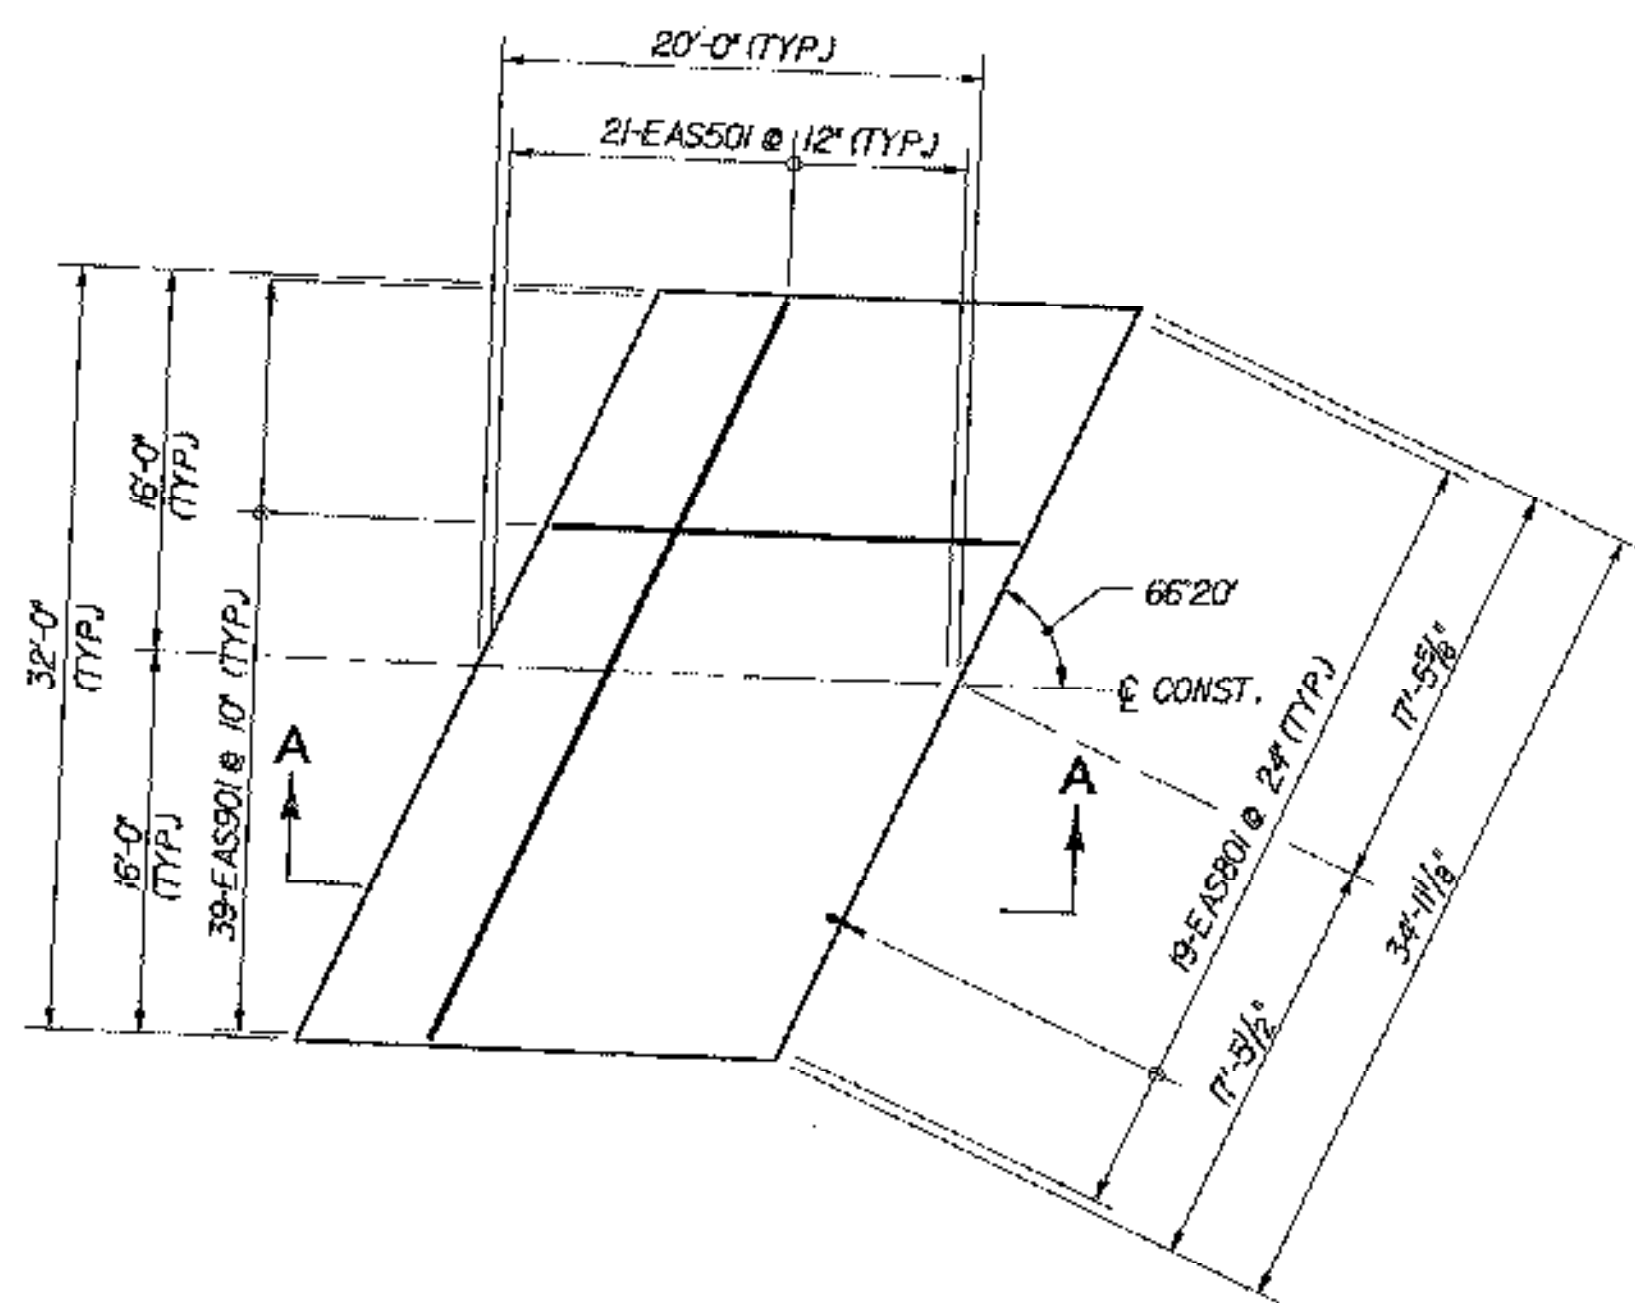


48S ABUTMENT 1

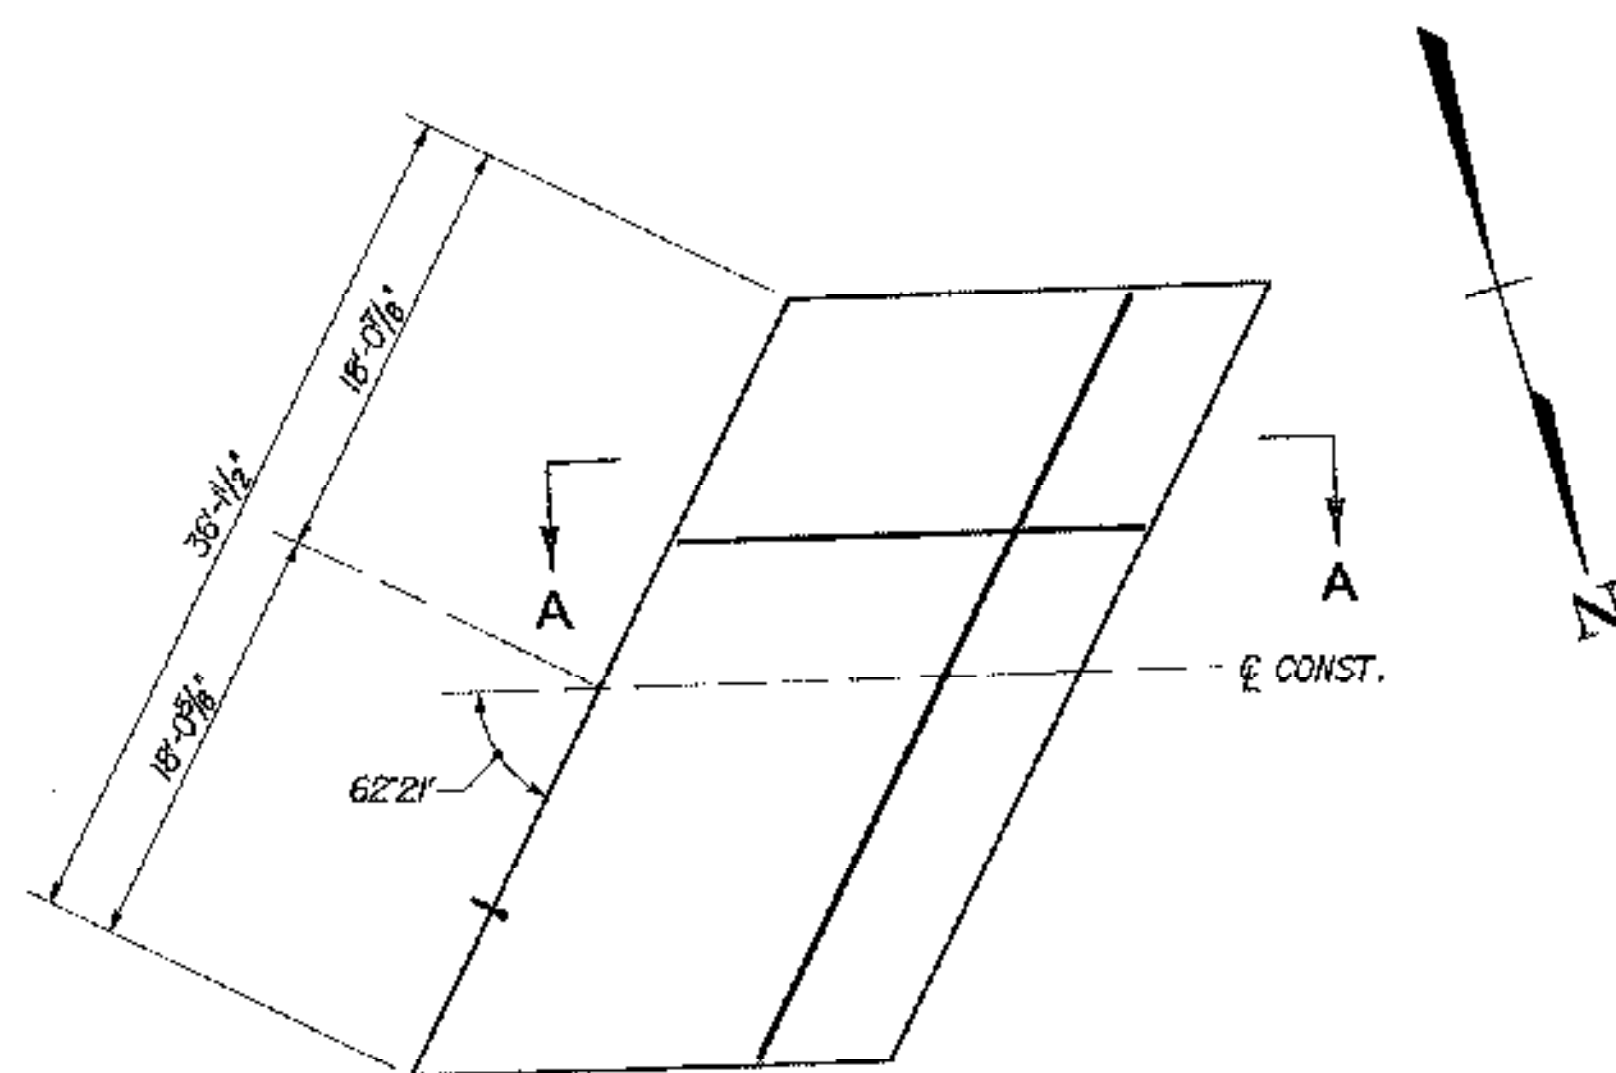

48S ABUTMENT 2

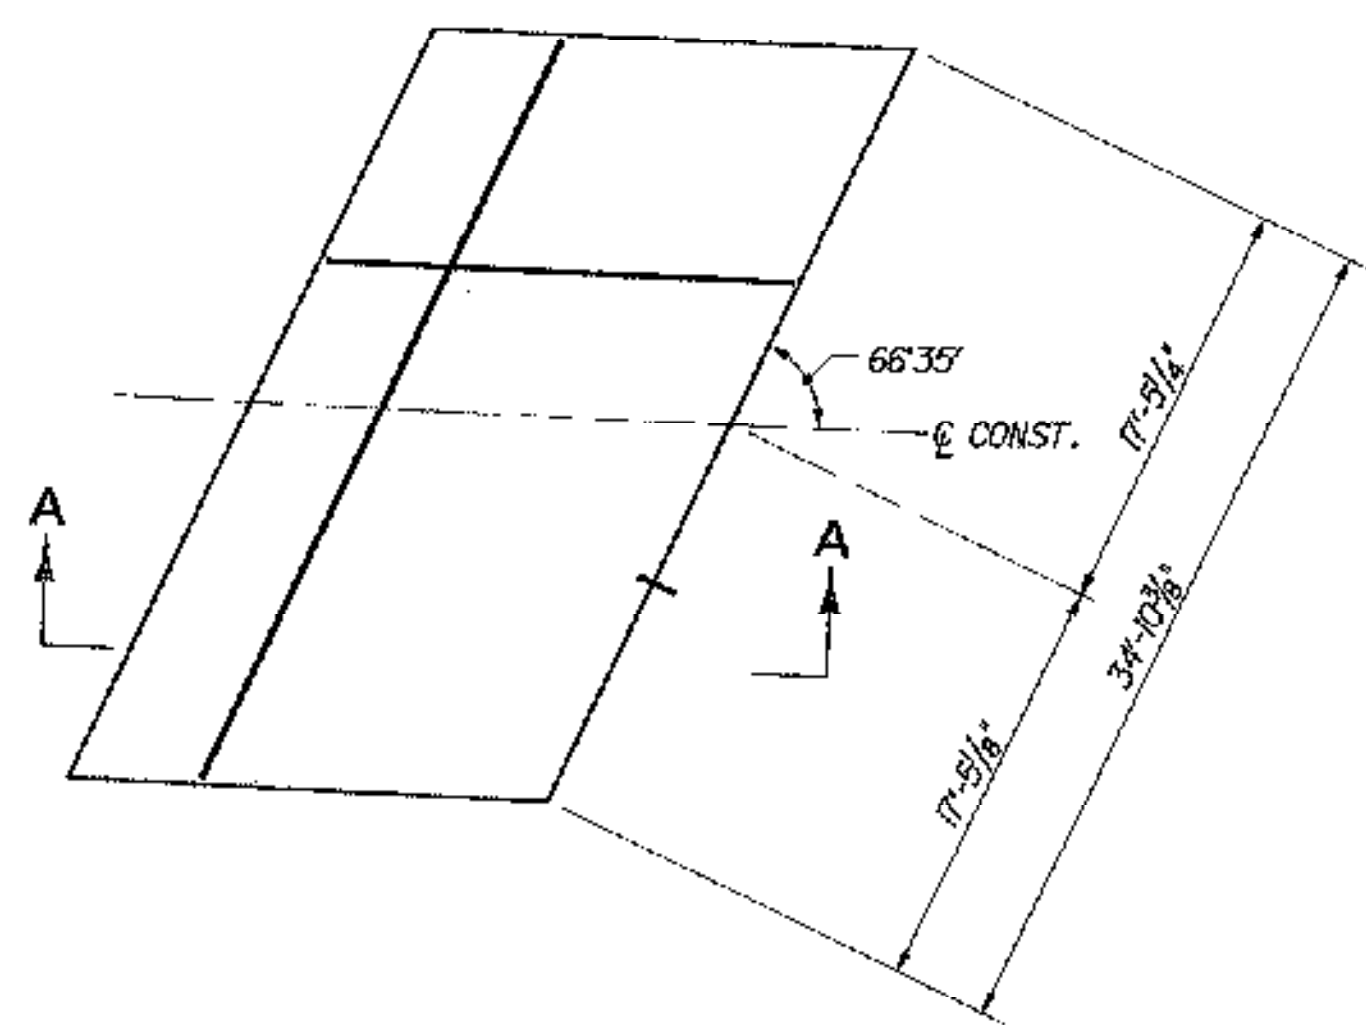


48N ABUTMENT 1

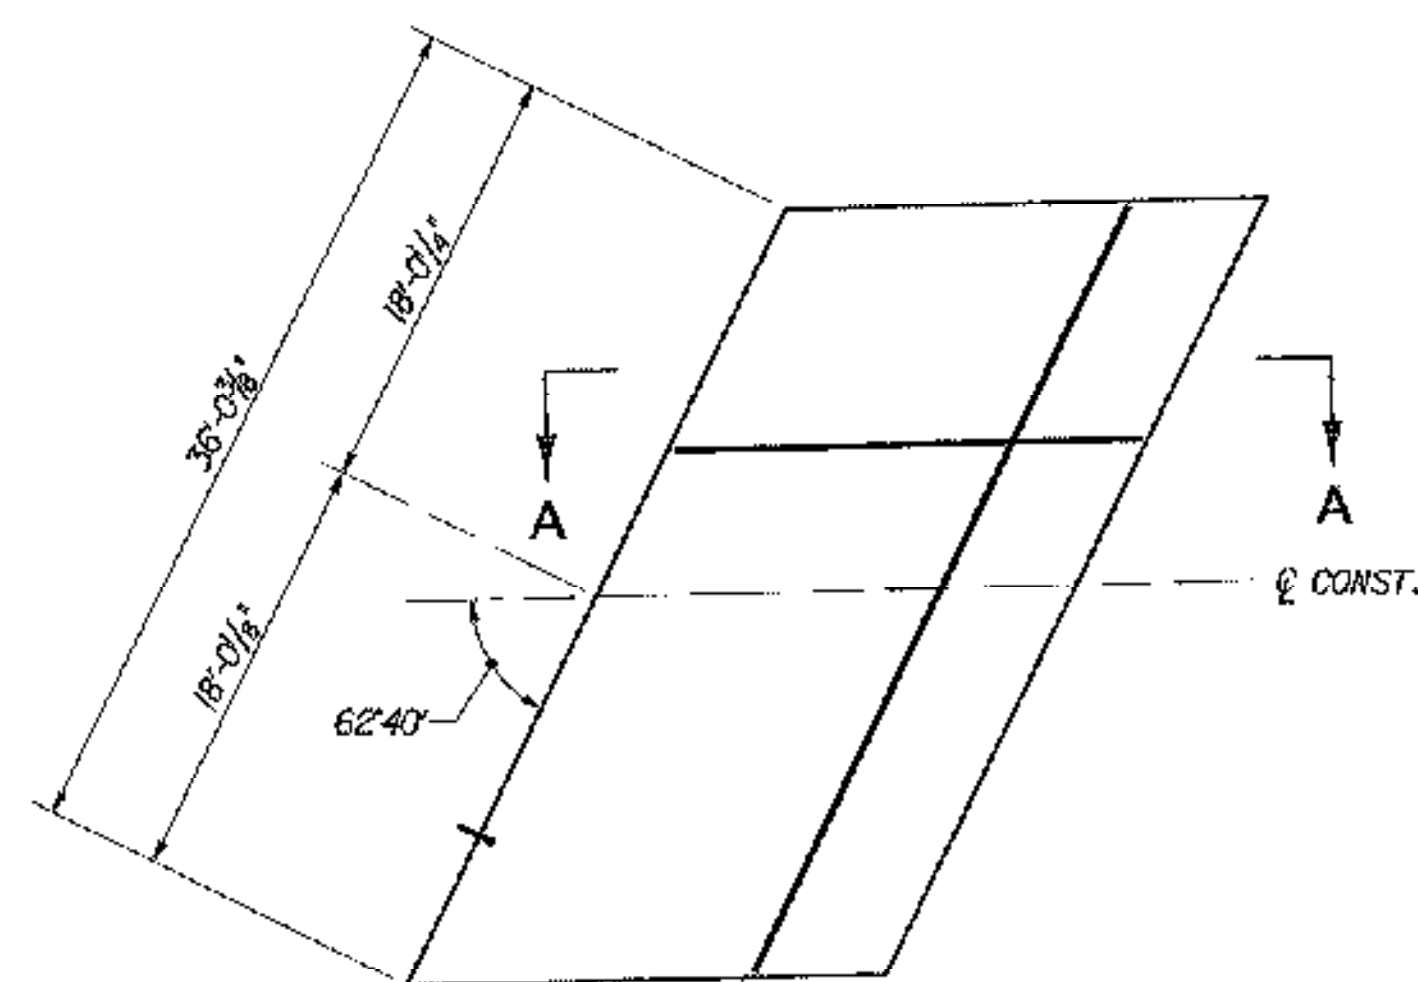

48N ABUTMENT 2

APPROACH SLAB PLANS

SCALE: 1/8" = 1'-0"

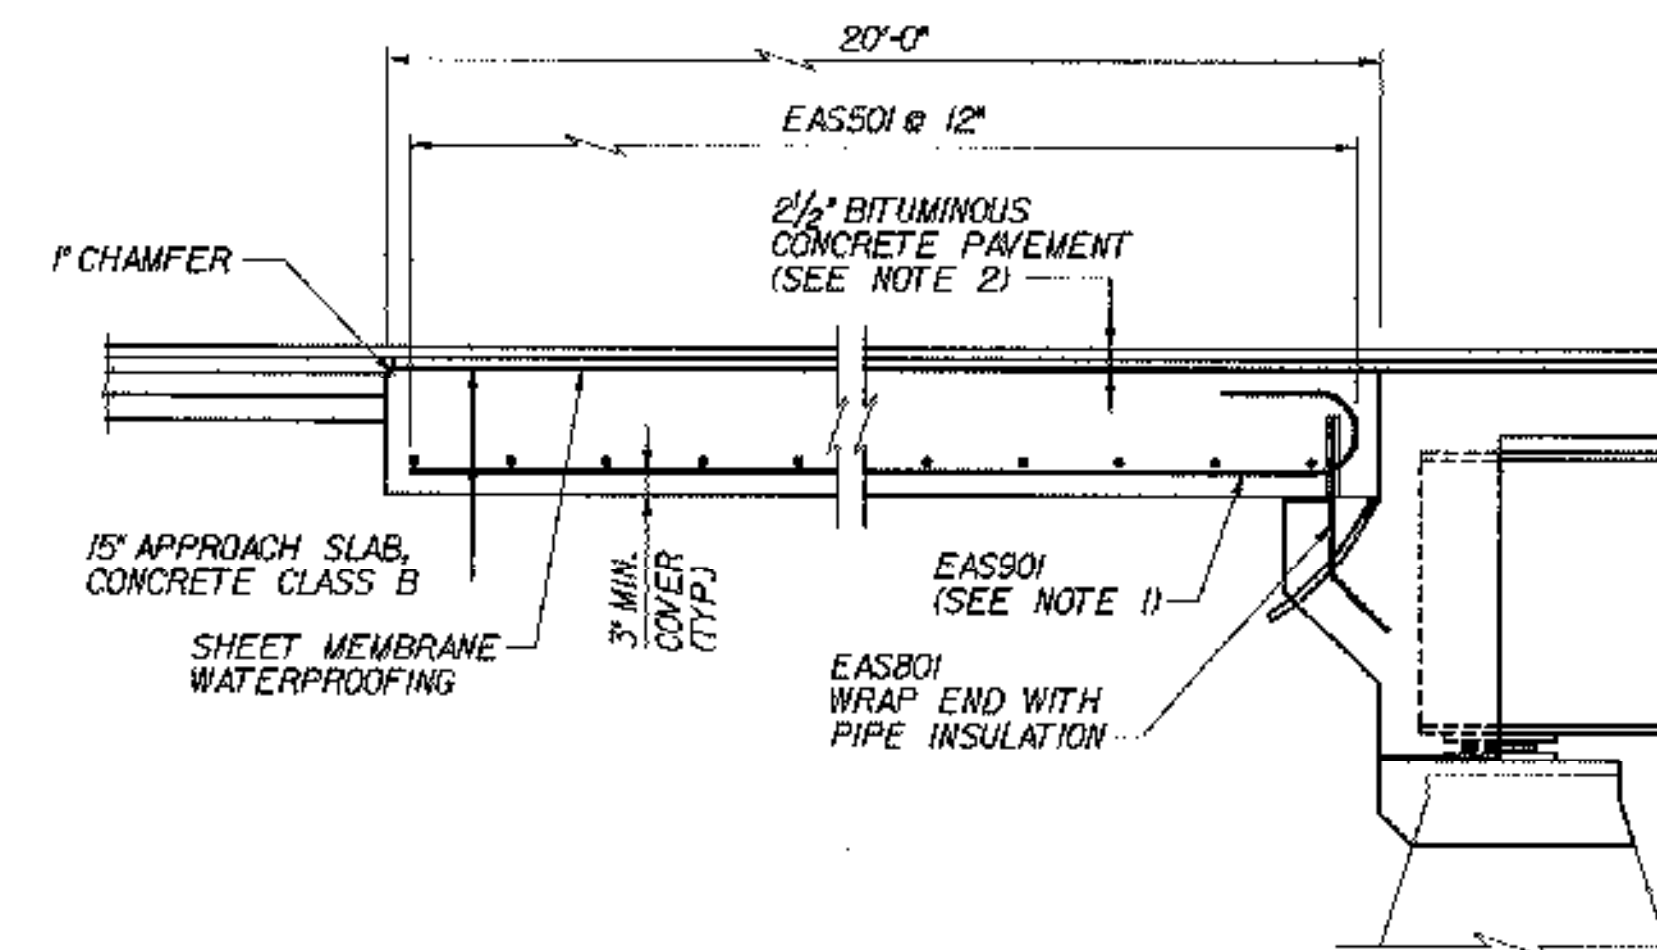


SECTION A-A  
(APPROACH SLAB AT FIXED ABUT. SHOWN;  
SLAB AT EXPANSION ABUT. SIMILAR)  
N.T.S.

RAISED FINISHED GRADE 5/4" RAISED FINISHED GRADE 3/4"

TOP OF APPROACH SLAB ELEVATIONS						
BR 48N			BR 48S			
LOCATION	STATION	ELEVATION	LOCATION	STATION	ELEVATION	
A	4+13.74	449.55.99	A	4+30.00	448.74	449.01
B	4+06.79	449.18.62	B	4+31.88	449.38	449.65
C	3+88.89	449.81.25	C	4+24.89	450.01	450.28
D	3+83.66	449.44.88	D	4+18.80	448.64	448.91
E	3+86.70	449.07.51	E	4+11.86	449.27	449.54
F	3+79.88	449.71.15	F	4+04.98	449.91	450.18
G	7+14.80	450.17.61	G	7+40.99	450.32	450.59
H	7+06.49	450.80.24	H	7+32.56	450.95	451.22
J	6+98.24	451.43.87	J	7+24.21	451.68	451.85
K	7+34.89	450.28.72	K	7+61.08	450.43	450.70
L	7+26.49	450.94.35	L	7+52.56	451.05	451.32
M	7+18.14	451.54.98	M	7+44.11	451.88	451.95

NOTES:

- TIP HOOK END OF BAR AS REQUIRED TO ACHIEVE MINIMUM COVER.
- FOR DETAILS OF APPROACH SLAB PAVEMENT AND TRANSITION TO EXISTING PAVEMENT, SEE DETAIL ON TYPICAL END OF DECK SLAB DETAILS, BRIDGE SHEET C-15.

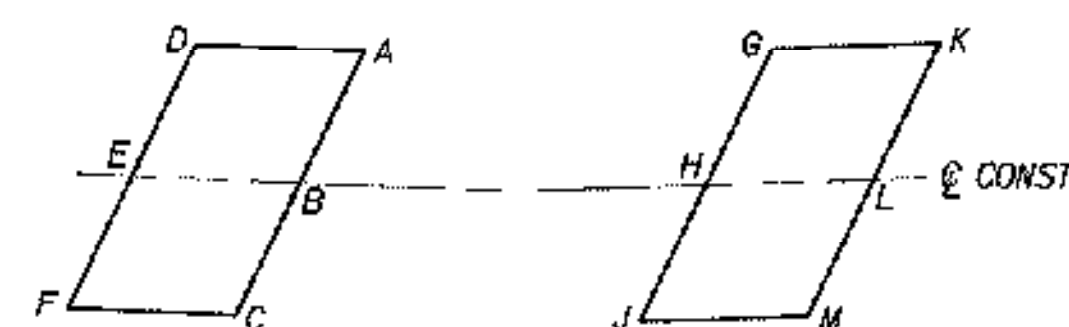

ABUTMENT 1

ABUTMENT 2

APPROACH SLAB ELEVATION KEY

N.T.S.

STATE OF VERMONT  
AGENCY OF TRANSPORTATION

Town Of MIDDLESEX-BOLTON Bridge No. 48N&S  
Highway No. I-89 Log Sta. Surv. Sta.


I-89 OVER LITTLE RIVER

APPROACH SLAB DETAILS (48N&S)


Designed By P.W. SZUSTAK Drawn By R.A. BOTZENHART  
Checked By J.P. HALSTEAD Date 10/99 Bridge Design Supervisor J.P. HALSTEAD Date 10/99

PROJECT MIDDLESEX-BOLTON PROJECT NO. IM-089-2(26)

TVGA CAD Drawing No. 48apslab Date 10/99  
Bridge Sheet No. BR48-6 Sheet 66 of 307

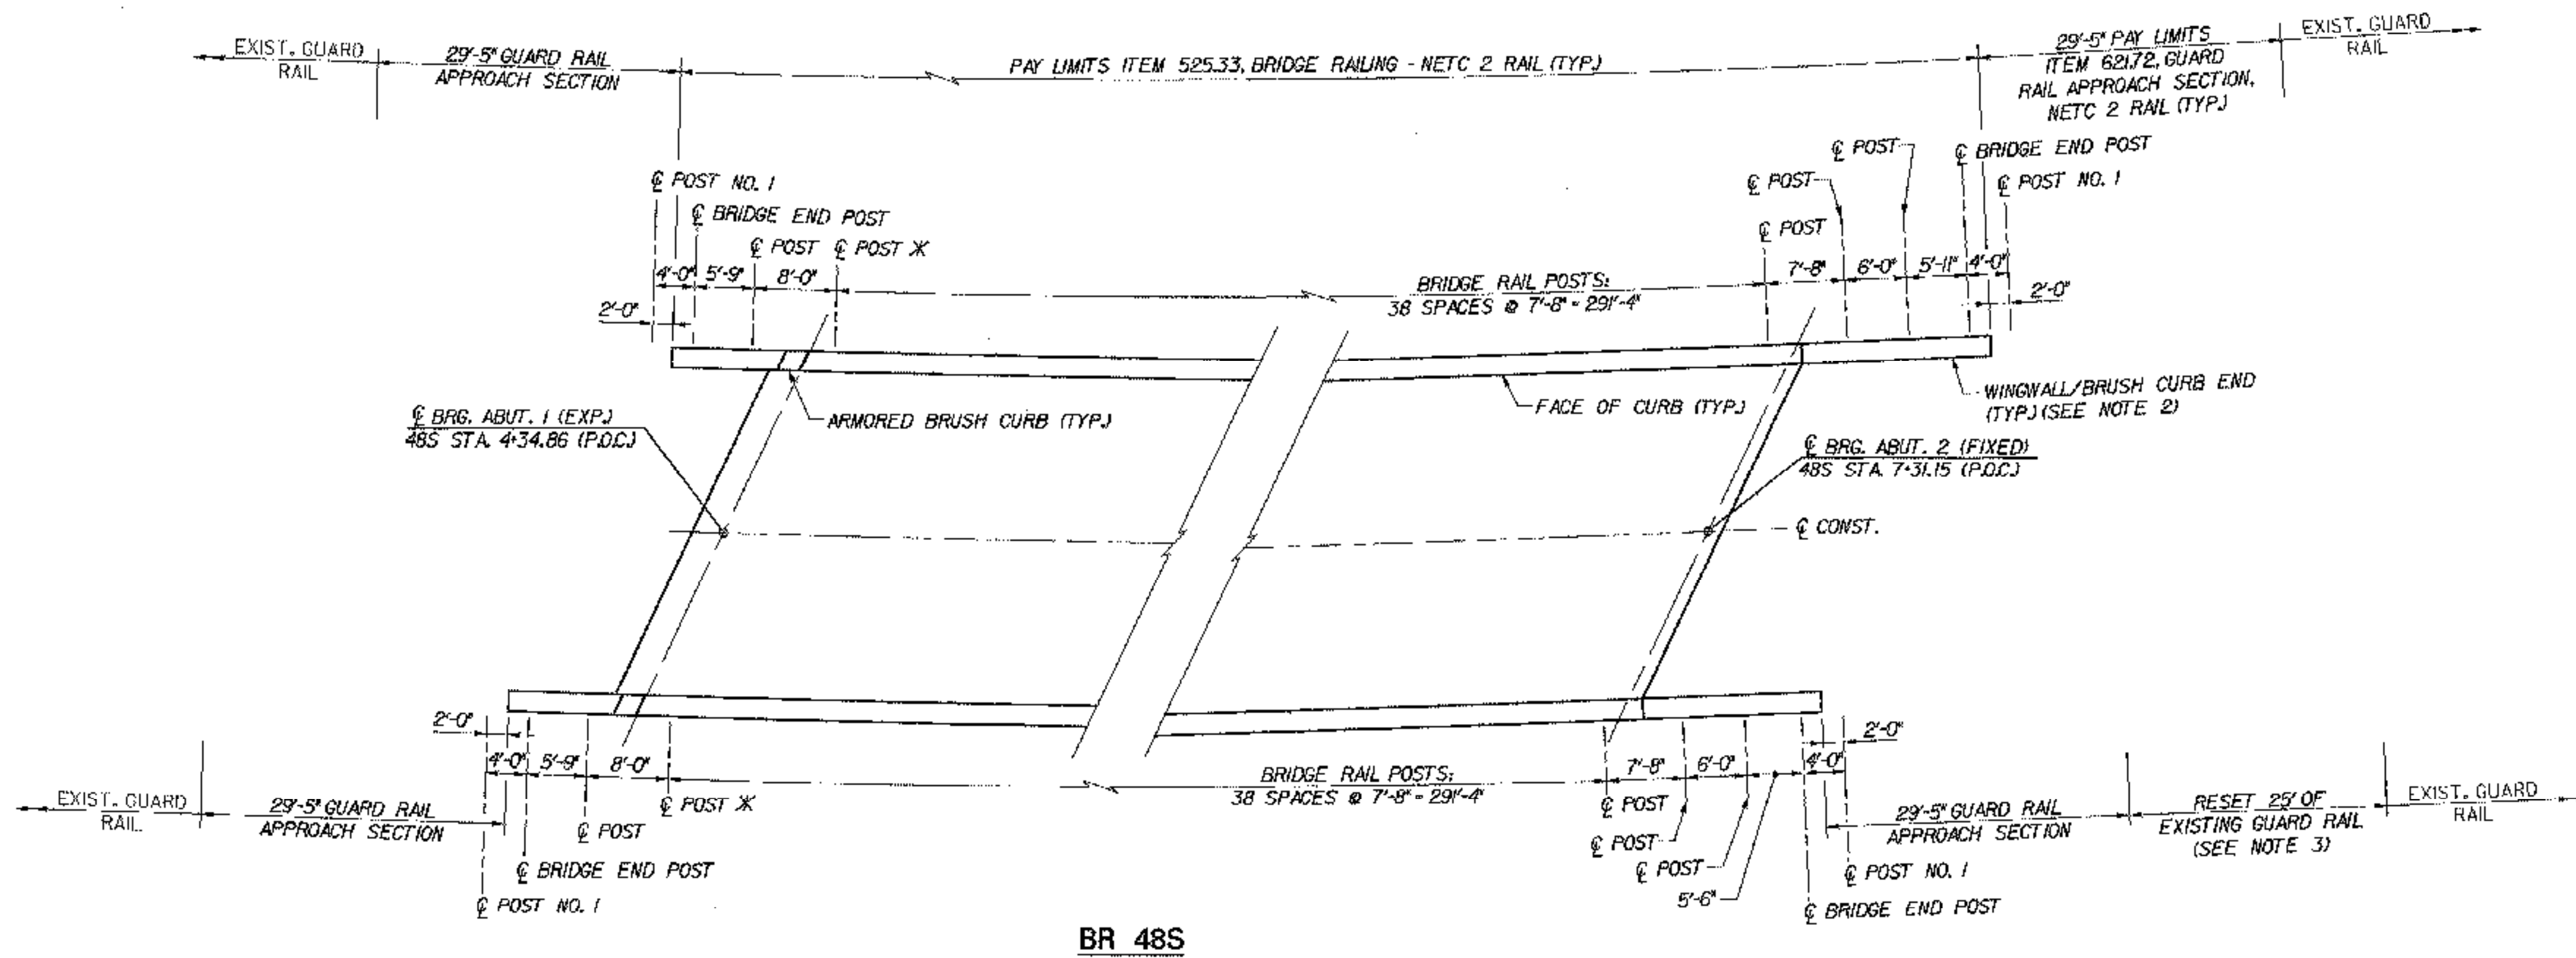


**CONSTRUCTION NOTE:**  
 END OF WINGWALLS HAVE BEEN LOCATED APPROXIMATELY BY  
 VAOT SURVEY. CONTRACTOR SHALL VERIFY REQUIRED RAIL  
 LENGTHS PRIOR TO SUBMITTING SHOP DRAWINGS FOR APPROVAL.

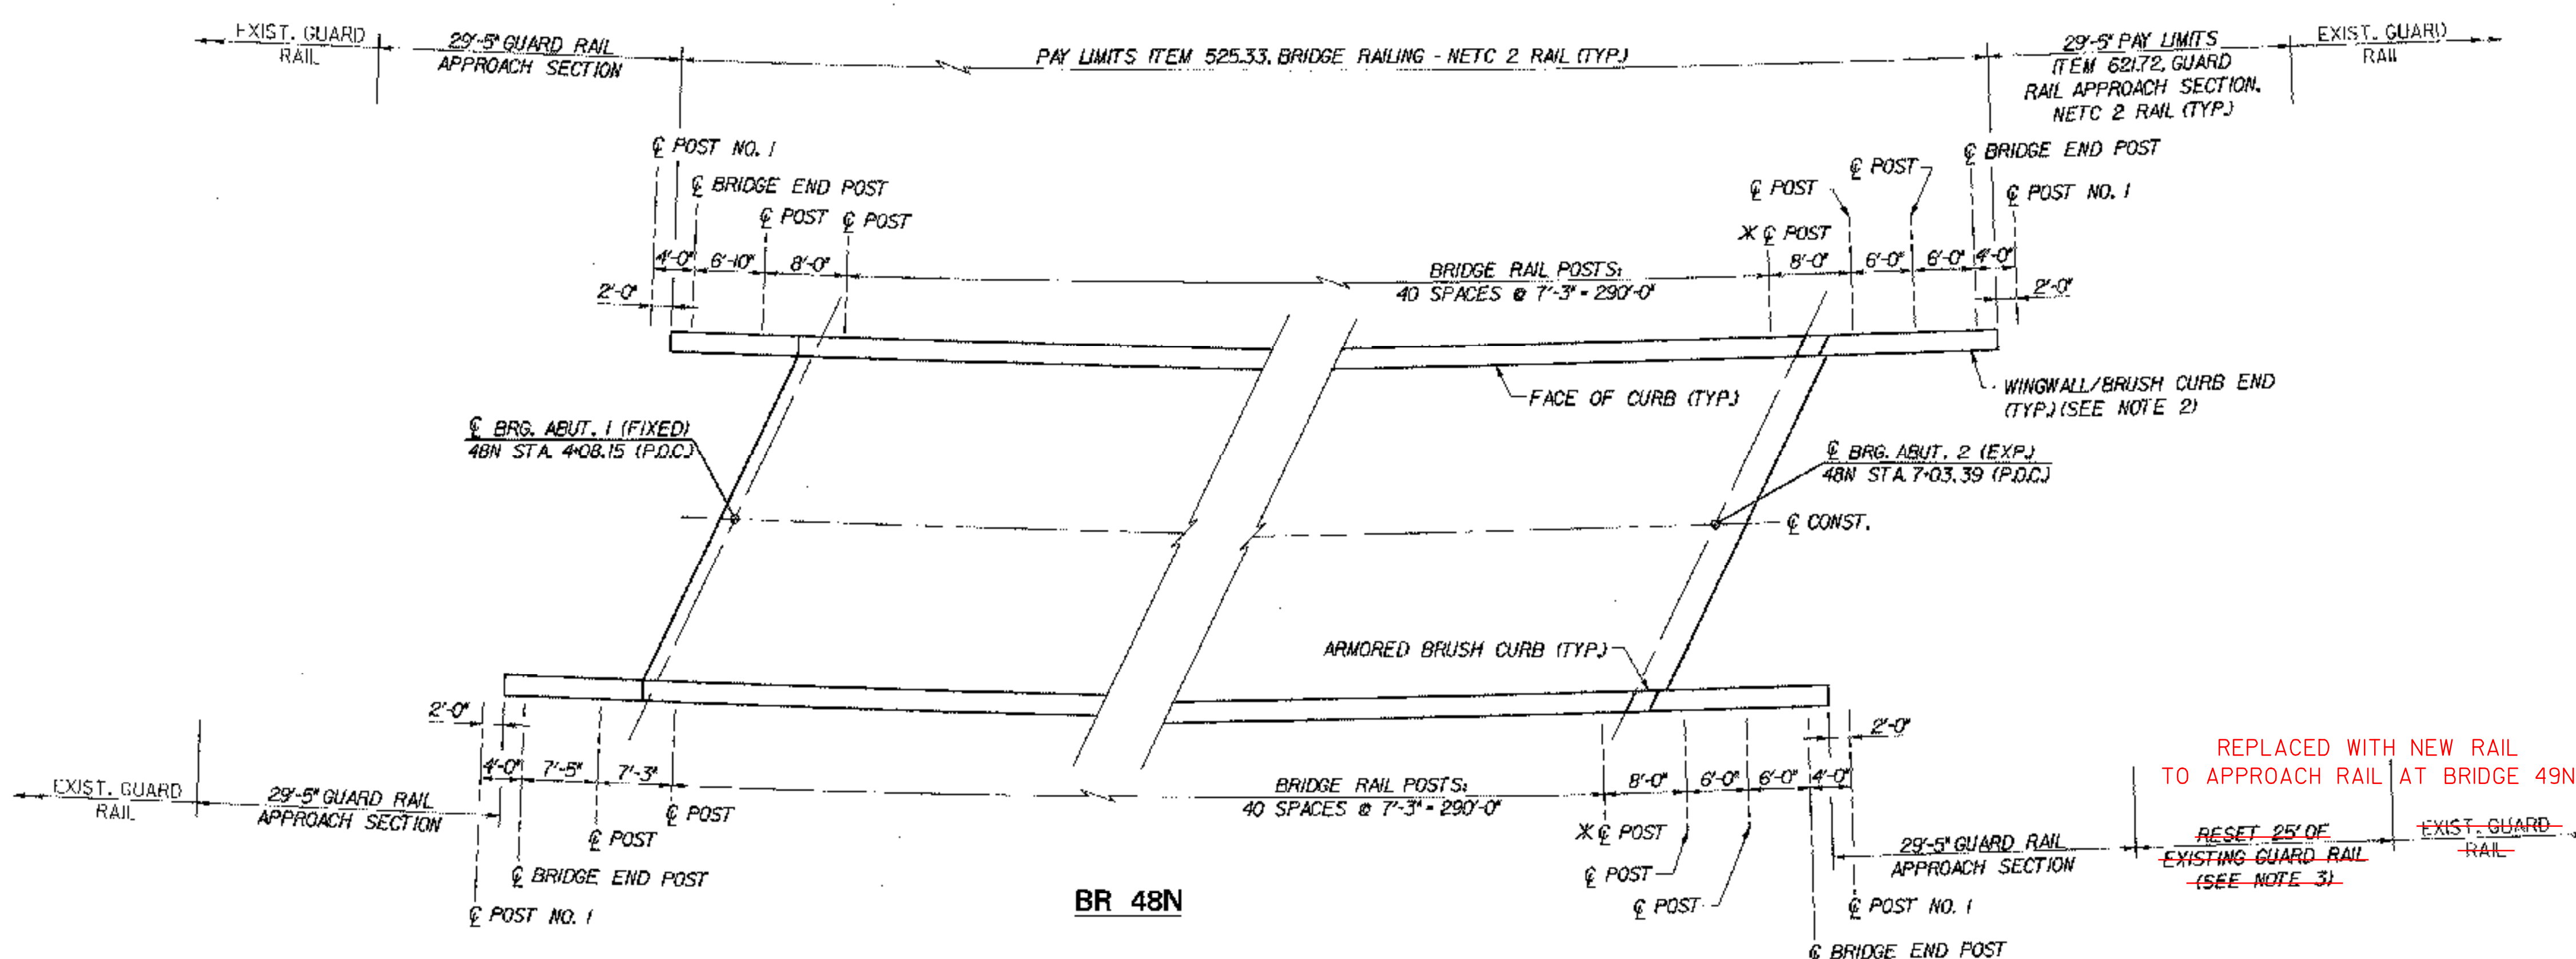

- NOTES:**
1. FOR NETC 2-RAIL BRIDGE RAILING DETAILS AND INFORMATION ABOUT THE NETC GUARD RAIL APPROACH SECTION, SEE STANDARD SHEETS BR1-97 AND BR3-97, AND GUARD RAIL APPROACH SECTION, NETC 2 RAIL, BRIDGE SHEETS C-46A AND C-46B.
  2. FOR BRUSH CURB END DETAIL, SEE TYPICAL WINGWALL DETAILS (1 OF 2), BRIDGE SHEET C-43.
  3. ALL WORK REQUIRED TO RESET THE EXISTING GUARD RAIL SHALL BE PAID UNDER ITEM 621.75, "REMOVING AND RESET GUARD RAIL."
  4. A QUANTITY OF 40'-0" OF ITEM 616.28 "CAST-IN-PLACE CEMENT CONCRETE CURB, TYPE B" SHALL BE PLACED AT THE END OF EACH WINGWALL. SEE GUARD RAIL APPROACH SECTION, NETC 2 RAIL, BRIDGE SHEETS C-46A AND C-46B FOR DETAILS.


**RAILING LAYOUT**  
 SCALE: 1/32" = 1'-0"  
 \* RAIL EXPANSION JOINT SHALL BE LOCATED  
 2'-0" FROM C/O OF INDICATED POST, ON  
 BRIDGE EXPANSION JOINT SIDE OF POST.

<b>STATE OF VERMONT AGENCY OF TRANSPORTATION</b>	
Town Of <b>MIDDLESEX-BOLTON</b>	Bridge No. <b>48N&amp;S</b>
Highway No. <b>I-89</b>	Log Sta. _____ Surv. Sta. _____
<b>1-89 OVER LITTLE RIVER</b>	
<b>CURB AND RAIL LAYOUT PLANS (48N&amp;S)</b>	
Designed By <b>P.W. SZUSTAK</b>	Drawn By <b>R.A. BOTZENHART</b>
Checked By <b>J.P. HALSTEAD</b>	Bridge Design Supervisor
Date <b>10/99</b>	Date <b>10/99</b>
PROJECT <b>MIDDLESEX-BOLTON</b>	PROJECT NO. <b>IM-089-2(26)</b>
TVGA CAD Drawing No. <b>48brail</b>	Date <b>10/99</b>
Bridge Sheet No. <b>BR48-7</b>	Sheet <b>67</b> of <b>307</b>

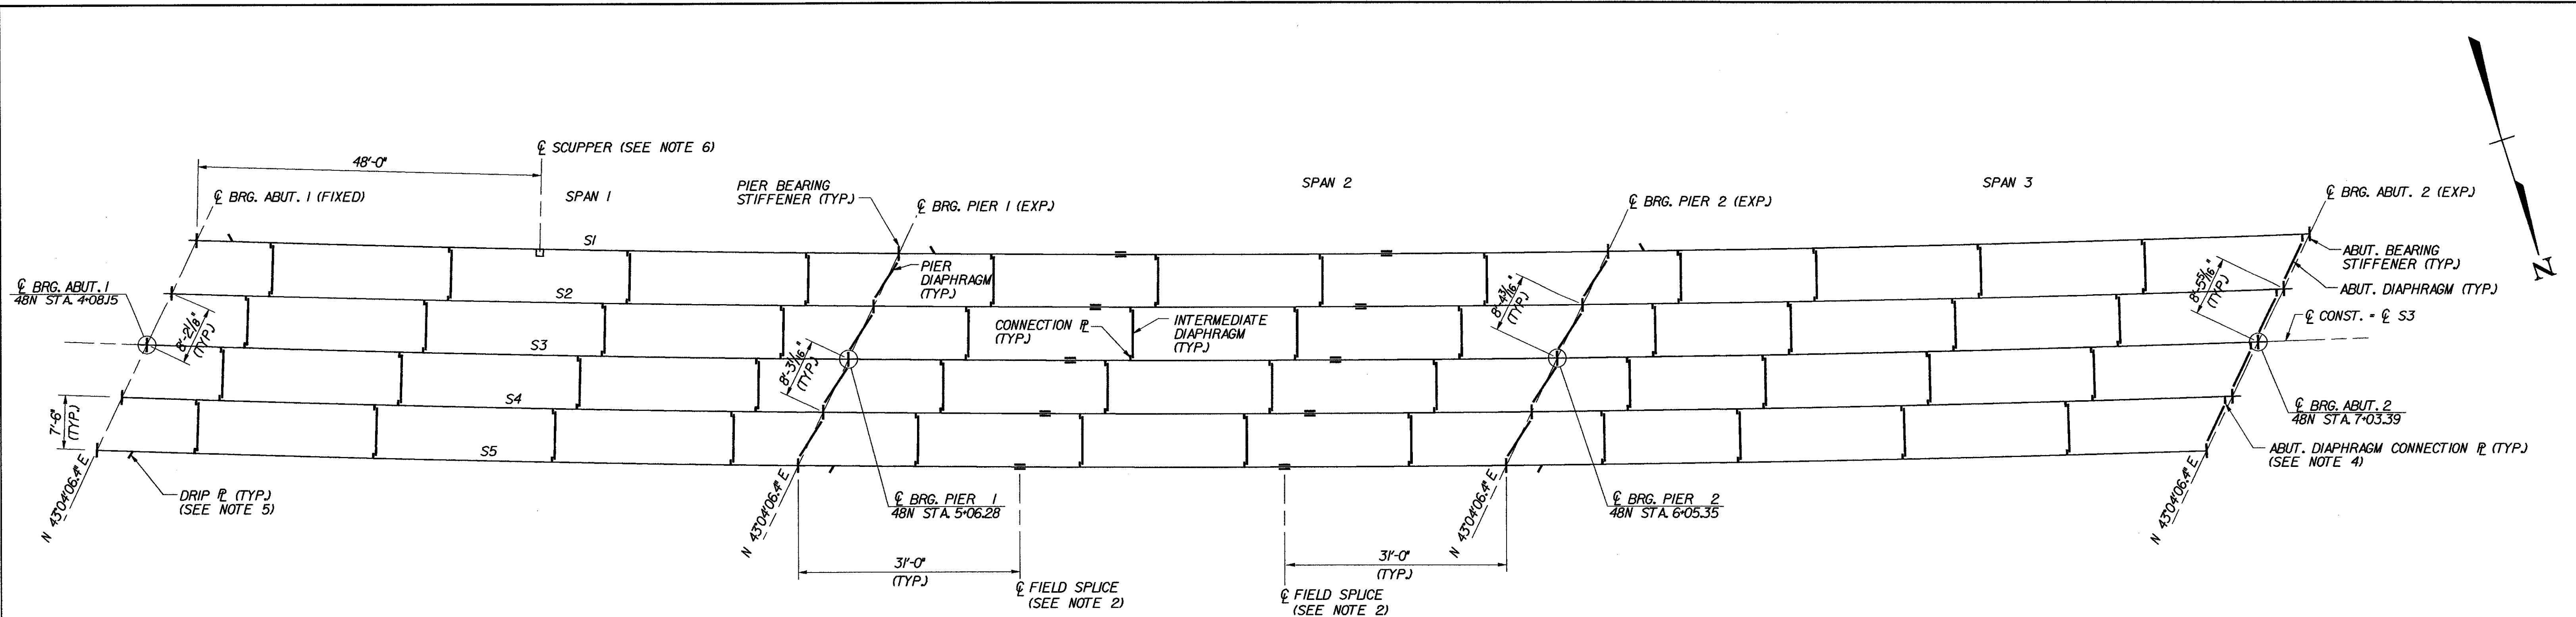

**FRAMING PLAN - BR 48N**

SCALE: 1/2" = 1'-0"

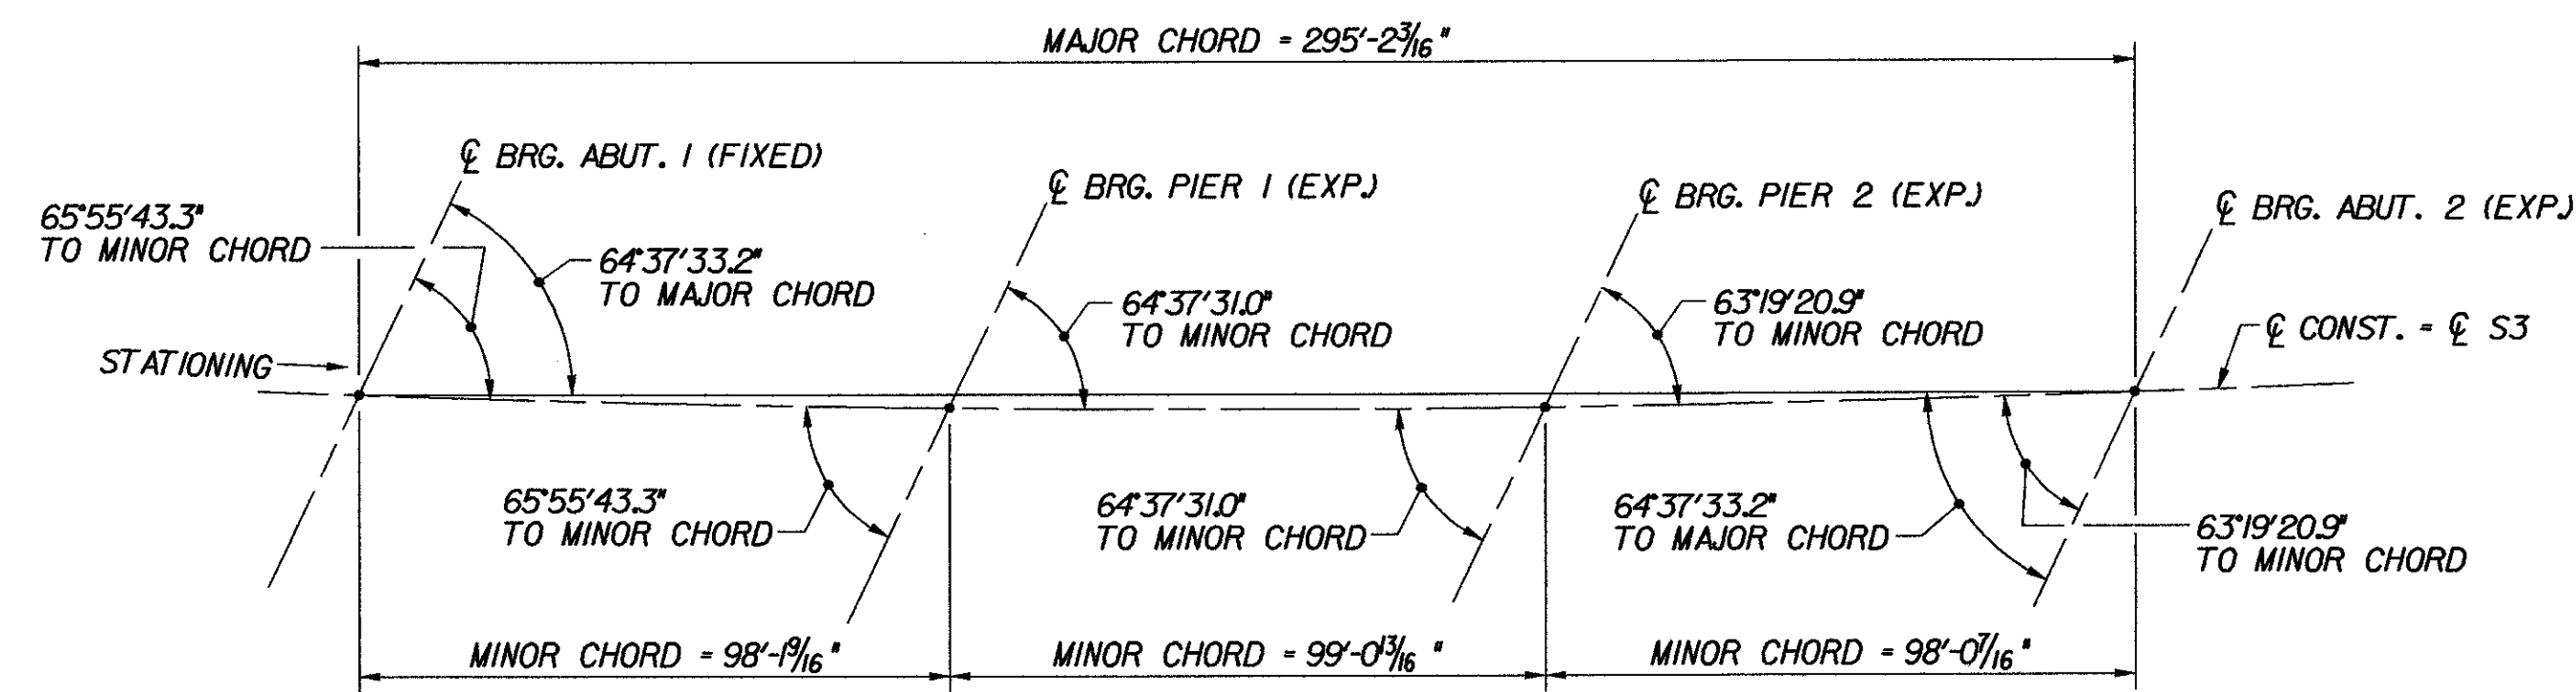

**LAYOUT DIAGRAM**

N.T.S.

**NOTES:**

- FOR PLATE GIRDER AND DIAPHRAGM DETAILS, SEE TYPICAL PLATE GIRDER DETAILS, BRIDGE SHEETS C-17 AND C-18.
- FOR FIELD SPLICE DETAILS, SEE TYPICAL GIRDER SPLICE DETAILS, BRIDGE SHEET C-20.
- THE CONTRACTOR SHALL HAVE THE OPTION TO PLACE ADDITIONAL FIELD SPLICES AT POINTS OF DL CONTRAFLEXURE IN SPANS 1 AND 3 (TO BE APPROVED BY THE STRUCTURES ENGINEER).
- STRINGER LAYOUT DIMENSIONS BEGIN AND END AT ABUTMENT CENTERLINES OF BEARING. LOCATION OF ABUTMENT DIAPHRAGM CONNECTION PLATES NOT INCLUDED IN TABLE. THE CONTRACTOR SHALL PROVIDE THIS DIMENSION IN SHOP DRAWINGS IN ACCORDANCE WITH DETAILS SHOWN IN TYPICAL PLATE GIRDER DETAILS, BRIDGE SHEETS C-17 AND C-18.
- FOR DRIP PLATE DETAIL, SEE TYPICAL BRIDGE DETAILS, BRIDGE SHEET C-46.
- FOR SCUPPER DETAILS, SEE TYPICAL SCUPPER DETAILS, BRIDGE SHEET C-39.


STRINGER NUMBER	STRINGER RADIUS	SIDE	SPAN 1 (ALONG ARC)						SPAN 2 (ALONG ARC)						SPAN 3 (ALONG ARC)					
			BRG. STIFFENER / CONNECTION PL. SPACING						BRG. STIFFENER / CONNECTION PL. SPACING						BRG. STIFFENER / CONNECTION PL. SPACING					
S1	4319.28'	LEFT	10' - 8 5/8"	25' - 0"	25' - 0"	25' - 0"	12' - 5 3/4"	98' - 2 3/8"	13' - 3 1/8"	23' - 0"	23' - 0"	23' - 0"	16' - 10 11/16"	99' - 1 13/16"	10' - 1 1/2"	19' - 0"	23' - 0"	23' - 0"	23' - 0"	98' - 1 1/2"
		RIGHT	14' - 0"	25' - 0"	25' - 0"	25' - 0"	9' - 1 15/16"	98' - 1 15/16"	16' - 9"	23' - 0"	23' - 0"	23' - 0"	13' - 4 5/16"	99' - 1 5/16"	13' - 11 3/16"	19' - 0"	23' - 0"	23' - 0"	19' - 1 13/16"	98' - 1'
S2	4326.78'	LEFT	10' - 8 11/16"	25' - 0"	25' - 0"	25' - 0"	12' - 5 1/4"	98' - 1 9/16"	13' - 3 1/4"	23' - 0"	23' - 0"	23' - 0"	16' - 10 1/16"	99' - 0 13/16"	10' - 1"	19' - 0"	23' - 0"	23' - 0"	23' - 0"	98' - 0 1/2"
		RIGHT	14' - 0"	25' - 0"	25' - 0"	25' - 0"	9' - 1 9/16"	98' - 1 9/16"	16' - 9"	23' - 0"	23' - 0"	23' - 0"	13' - 3 13/16"	99' - 0 13/16"	13' - 10 5/8"	19' - 0"	23' - 0"	23' - 0"	19' - 1 7/8"	98' - 0 1/2"
S3	4334.28'	LEFT	10' - 8 13/16"	25' - 0"	25' - 0"	25' - 0"	12' - 4 3/4"	98' - 1 1/8"	13' - 3 5/16"	23' - 0"	23' - 0"	23' - 0"	16' - 9 1/2"	99' - 0 3/8"	10' - 0 1/2"	19' - 0"	23' - 0"	23' - 0"	23' - 0"	98' - 0"
		RIGHT	14' - 0"	25' - 0"	25' - 0"	25' - 0"	9' - 1 1/8"	98' - 1 1/8"	16' - 9"	23' - 0"	23' - 0"	23' - 0"	13' - 3 3/8"	99' - 0 3/8"	13' - 10"	19' - 0"	23' - 0"	23' - 0"	19' - 2"	98' - 0"
S4	4341.78'	LEFT	10' - 8 7/8"	25' - 0"	25' - 0"	25' - 0"	12' - 4 1/4"	98' - 0 3/4"	13' - 3 7/16"	23' - 0"	23' - 0"	23' - 0"	16' - 8 15/16"	98' - 11 15/16"	10' - 0"	19' - 0"	23' - 0"	23' - 0"	23' - 0"	97' - 11 7/16"
		RIGHT	14' - 0"	25' - 0"	25' - 0"	25' - 0"	9' - 0 3/4"	98' - 0 3/4"	16' - 9"	23' - 0"	23' - 0"	23' - 0"	13' - 2 15/16"	98' - 11 15/16"	13' - 9 3/8"	19' - 0"	23' - 0"	23' - 0"	19' - 2 1/16"	97' - 11 7/16"

**STRINGER LAYOUT TABLE**


(SEE NOTE 4)

**STATE OF VERMONT  
AGENCY OF TRANSPORTATION**

Town Of	MIDDLESEX-BOLTON	Bridge No.	<b>48N</b>
Highway No.	I-89	Log Sta.	
		Surv. Sta.	
<b>I-89 NB OVER LITTLE RIVER</b>			
<b>FRAMING PLAN (48N)</b>			
Designed By	P.W. SZUSTAK	Drawn By	R.A. BOTZENHART
Checked By	J.P. HALSTEAD	Date	10/99
		Bridge Design Supervisor	J.P. HALSTEAD Date 10/99
PROJECT	MIDDLESEX-BOLTON	PROJECT NO.	IM-089-2(26)
TVGA CAD Drawing No.	48nfp	Date	10/99
Bridge Sheet No.	<b>BR48-8</b>	Sheet	68 of 307

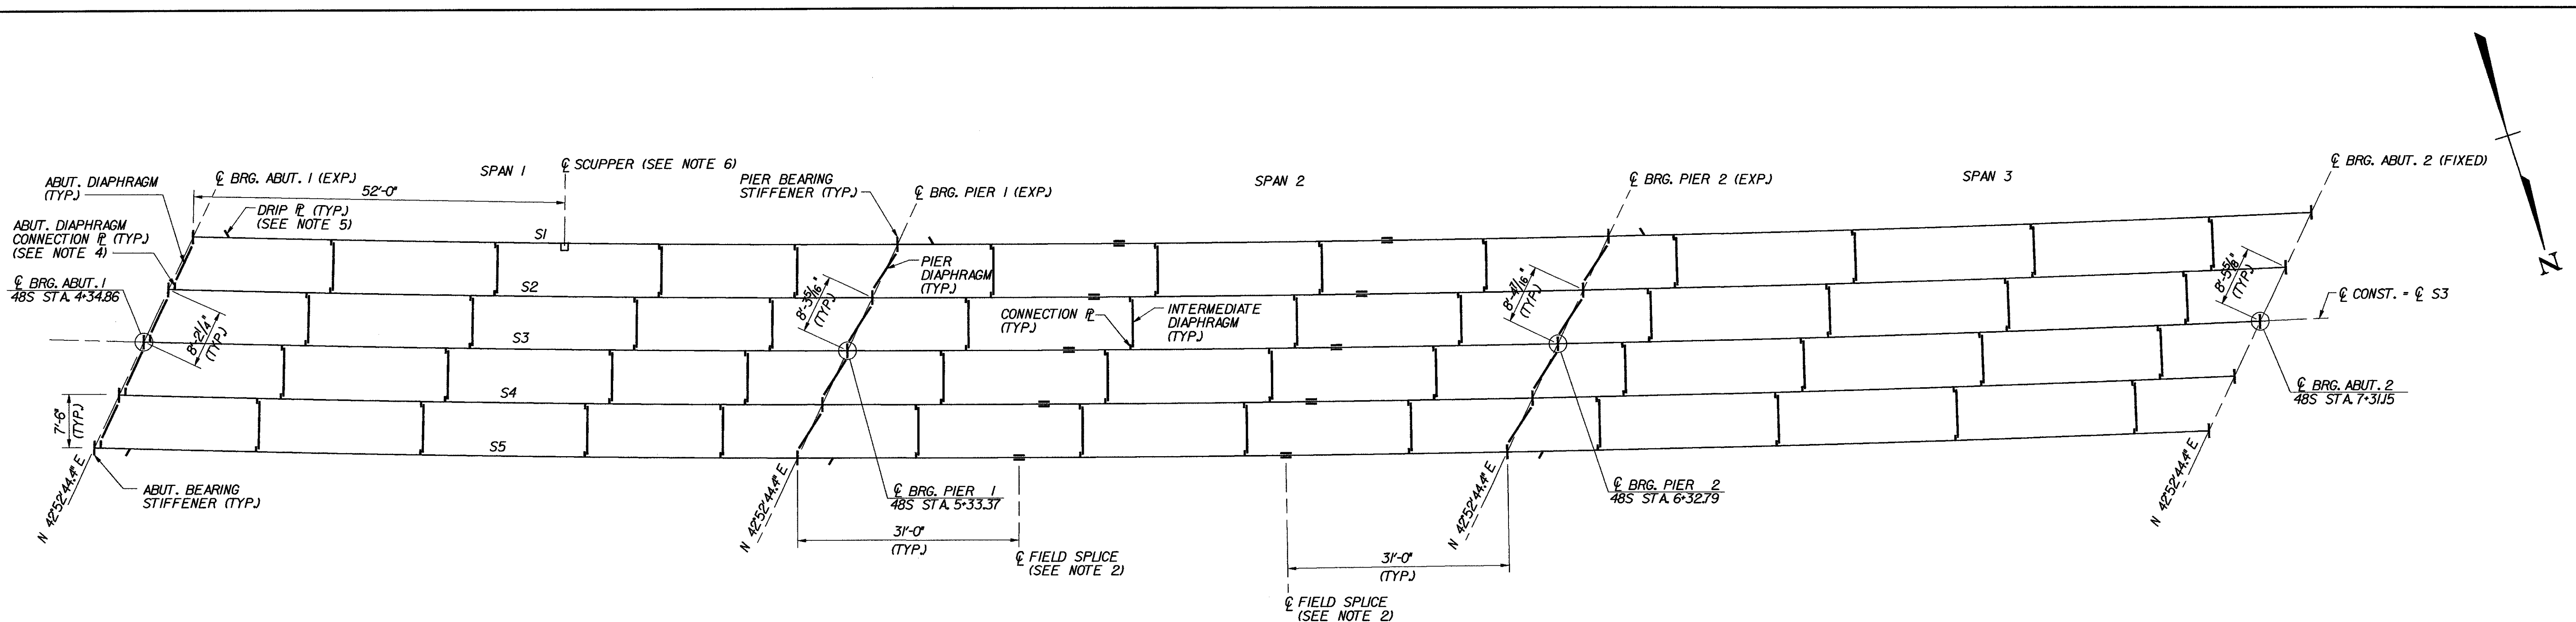

**FRAMING PLAN - BR 48S**  
SCALE: 3/32" = 1'-0"

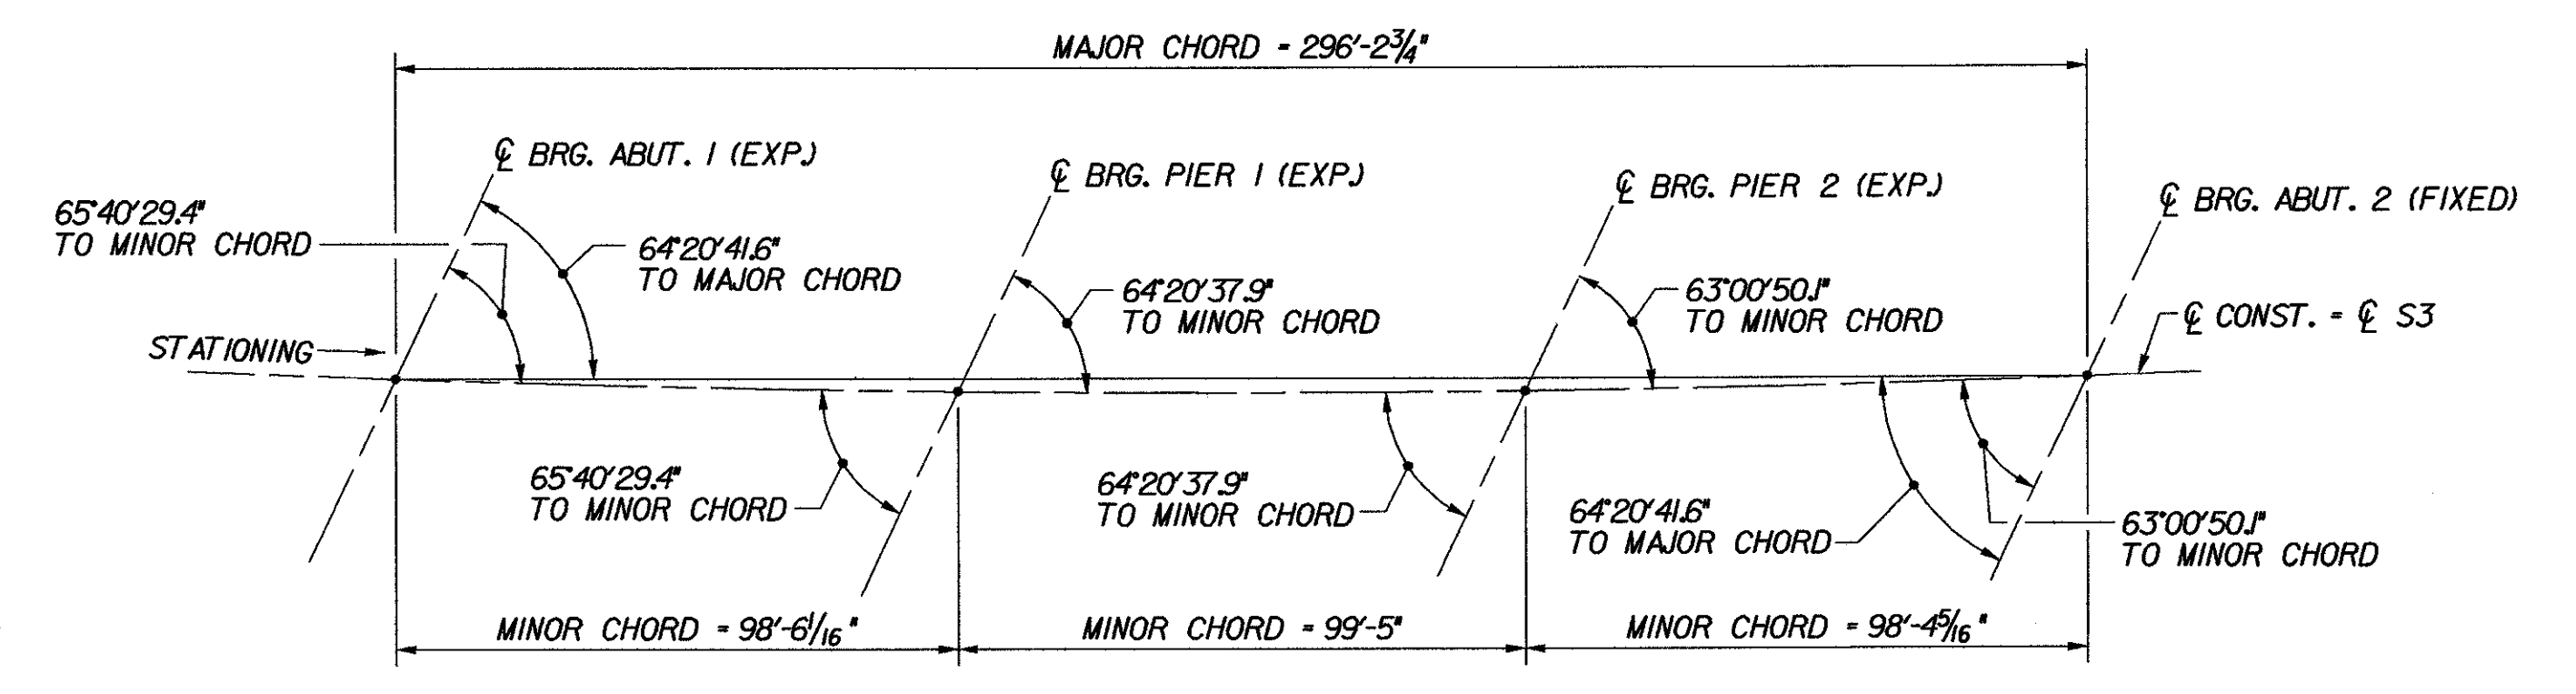

**LAYOUT DIAGRAM**  
N.T.S.


- NOTES:**
- FOR PLATE GIRDER AND DIAPHRAGM DETAILS, SEE TYPICAL PLATE GIRDER DETAILS, BRIDGE SHEETS C-17 AND C-18.
  - FOR FIELD SPLICE DETAILS, SEE TYPICAL GIRDER SPLICE DETAILS, BRIDGE SHEET C-20.
  - THE CONTRACTOR SHALL HAVE THE OPTION TO PLACE ADDITIONAL FIELD SPLICES AT POINTS OF DL CONTRAFLEXURE IN SPANS 1 AND 3 (TO BE APPROVED BY THE STRUCTURES ENGINEER).
  - STRINGER LAYOUT DIMENSIONS BEGIN AND END AT ABUTMENT CENTERLINES OF BEARING. LOCATION OF ABUTMENT DIAPHRAGM CONNECTION PLATES NOT INCLUDED IN TABLE. THE CONTRACTOR SHALL PROVIDE THIS DIMENSION IN SHOP DRAWINGS IN ACCORDANCE WITH DETAILS SHOWN IN TYPICAL PLATE GIRDER DETAILS, BRIDGE SHEETS C-17 AND C-18.
  - FOR DRIP PLATE DETAIL, SEE TYPICAL BRIDGE DETAILS, BRIDGE SHEET C-46.
  - FOR SCUPPER DETAILS, SEE TYPICAL SCUPPER DETAILS, BRIDGE SHEET C-39.

STRINGER NUMBER	STRINGER RADIUS	SIDE	SPAN 1 (ALONG ARC)						SPAN 2 (ALONG ARC)						SPAN 3 (ALONG ARC)					
			BRG. STIFFENER / CONNECTION PL. SPACING						BRG. STIFFENER / CONNECTION PL. SPACING						BRG. STIFFENER / CONNECTION PL. SPACING					
S1	4245.28'	RIGHT	19' - 8"	23' - 0"	23' - 0"	19' - 0"	13' - 11"	98' - 7"	13' - 5 1/2"	23' - 0"	23' - 0"	23' - 0"	17' - 0 1/2"	99' - 6"	9' - 5 3/8"	25' - 0"	25' - 0"	25' - 0"	14' - 0"	98' - 5 3/8"
S2	4252.78'	LEFT	23' - 0"	23' - 0"	23' - 0"	19' - 0"	10' - 6 9/16"	98' - 6 9/16"	17' - 0"	23' - 0"	23' - 0"	23' - 0"	13' - 5 1/2"	99' - 5 1/2"	13' - 3 15/16"	25' - 0"	25' - 0"	25' - 0"	10' - 0 15/16"	98' - 4 7/8"
S3	4260.28'	RIGHT	19' - 8 1/16"	23' - 0"	23' - 0"	19' - 0"	13' - 10 1/2"	98' - 6 1/8"	17' - 0"	23' - 0"	23' - 0"	23' - 0"	16' - 11 15/16"	99' - 5 1/16"	9' - 4 7/8"	25' - 0"	25' - 0"	25' - 0"	14' - 0"	98' - 4 5/16"
S4	4267.78'	LEFT	23' - 0"	23' - 0"	23' - 0"	19' - 0"	10' - 6 1/8"	98' - 5 11/16"	17' - 0"	23' - 0"	23' - 0"	23' - 0"	13' - 5 1/16"	99' - 4 9/16"	13' - 3 1/4"	25' - 0"	25' - 0"	25' - 0"	10' - 1 1/16"	98' - 3 13/16"
S5	4275.28'	RIGHT	19' - 8 1/4"	23' - 0"	23' - 0"	19' - 0"	13' - 9 7/16"	98' - 5 11/16"	17' - 0"	23' - 0"	23' - 0"	23' - 0"	16' - 10 13/16"	99' - 4 9/16"	9' - 3 13/16"	25' - 0"	25' - 0"	25' - 0"	14' - 0"	98' - 3 13/16"
			23' - 0"	23' - 0"	23' - 0"	19' - 0"	10' - 5 5/16"	98' - 5 5/16"	17' - 0"	23' - 0"	23' - 0"	23' - 0"	13' - 4 1/16"	99' - 4 1/16"	13' - 2"	25' - 0"	25' - 0"	25' - 0"	10' - 1 1/4"	98' - 3 1/4"

**STRINGER LAYOUT TABLE**  
(SEE NOTE 4)

**STATE OF VERMONT  
AGENCY OF TRANSPORTATION**

Town Of	MIDDLESEX-BOLTON	Bridge No.	<b>485</b>
Highway No.	I-89	Log Sta.	
		Surv. Sta.	
I-89 SB OVER LITTLE RIVER			
<b>FRAMING PLAN (48S)</b>			
Designed By	P.W. SZUSTAK	Drawn By	R.A. BOTZENHART
Checked By	J.P. HALSTEAD	Date	10/99
		Bridge Design Supervisor	J.P. HALSTEAD
		Date	10/99
PROJECT	MIDDLESEX-BOLTON	PROJECT NO.	IM-089-2(26)
TVGA CAD Drawing No.	48sfp	Date	10/99
Bridge Sheet No.	<b>BR48-9</b>	Sheet	69 of 307

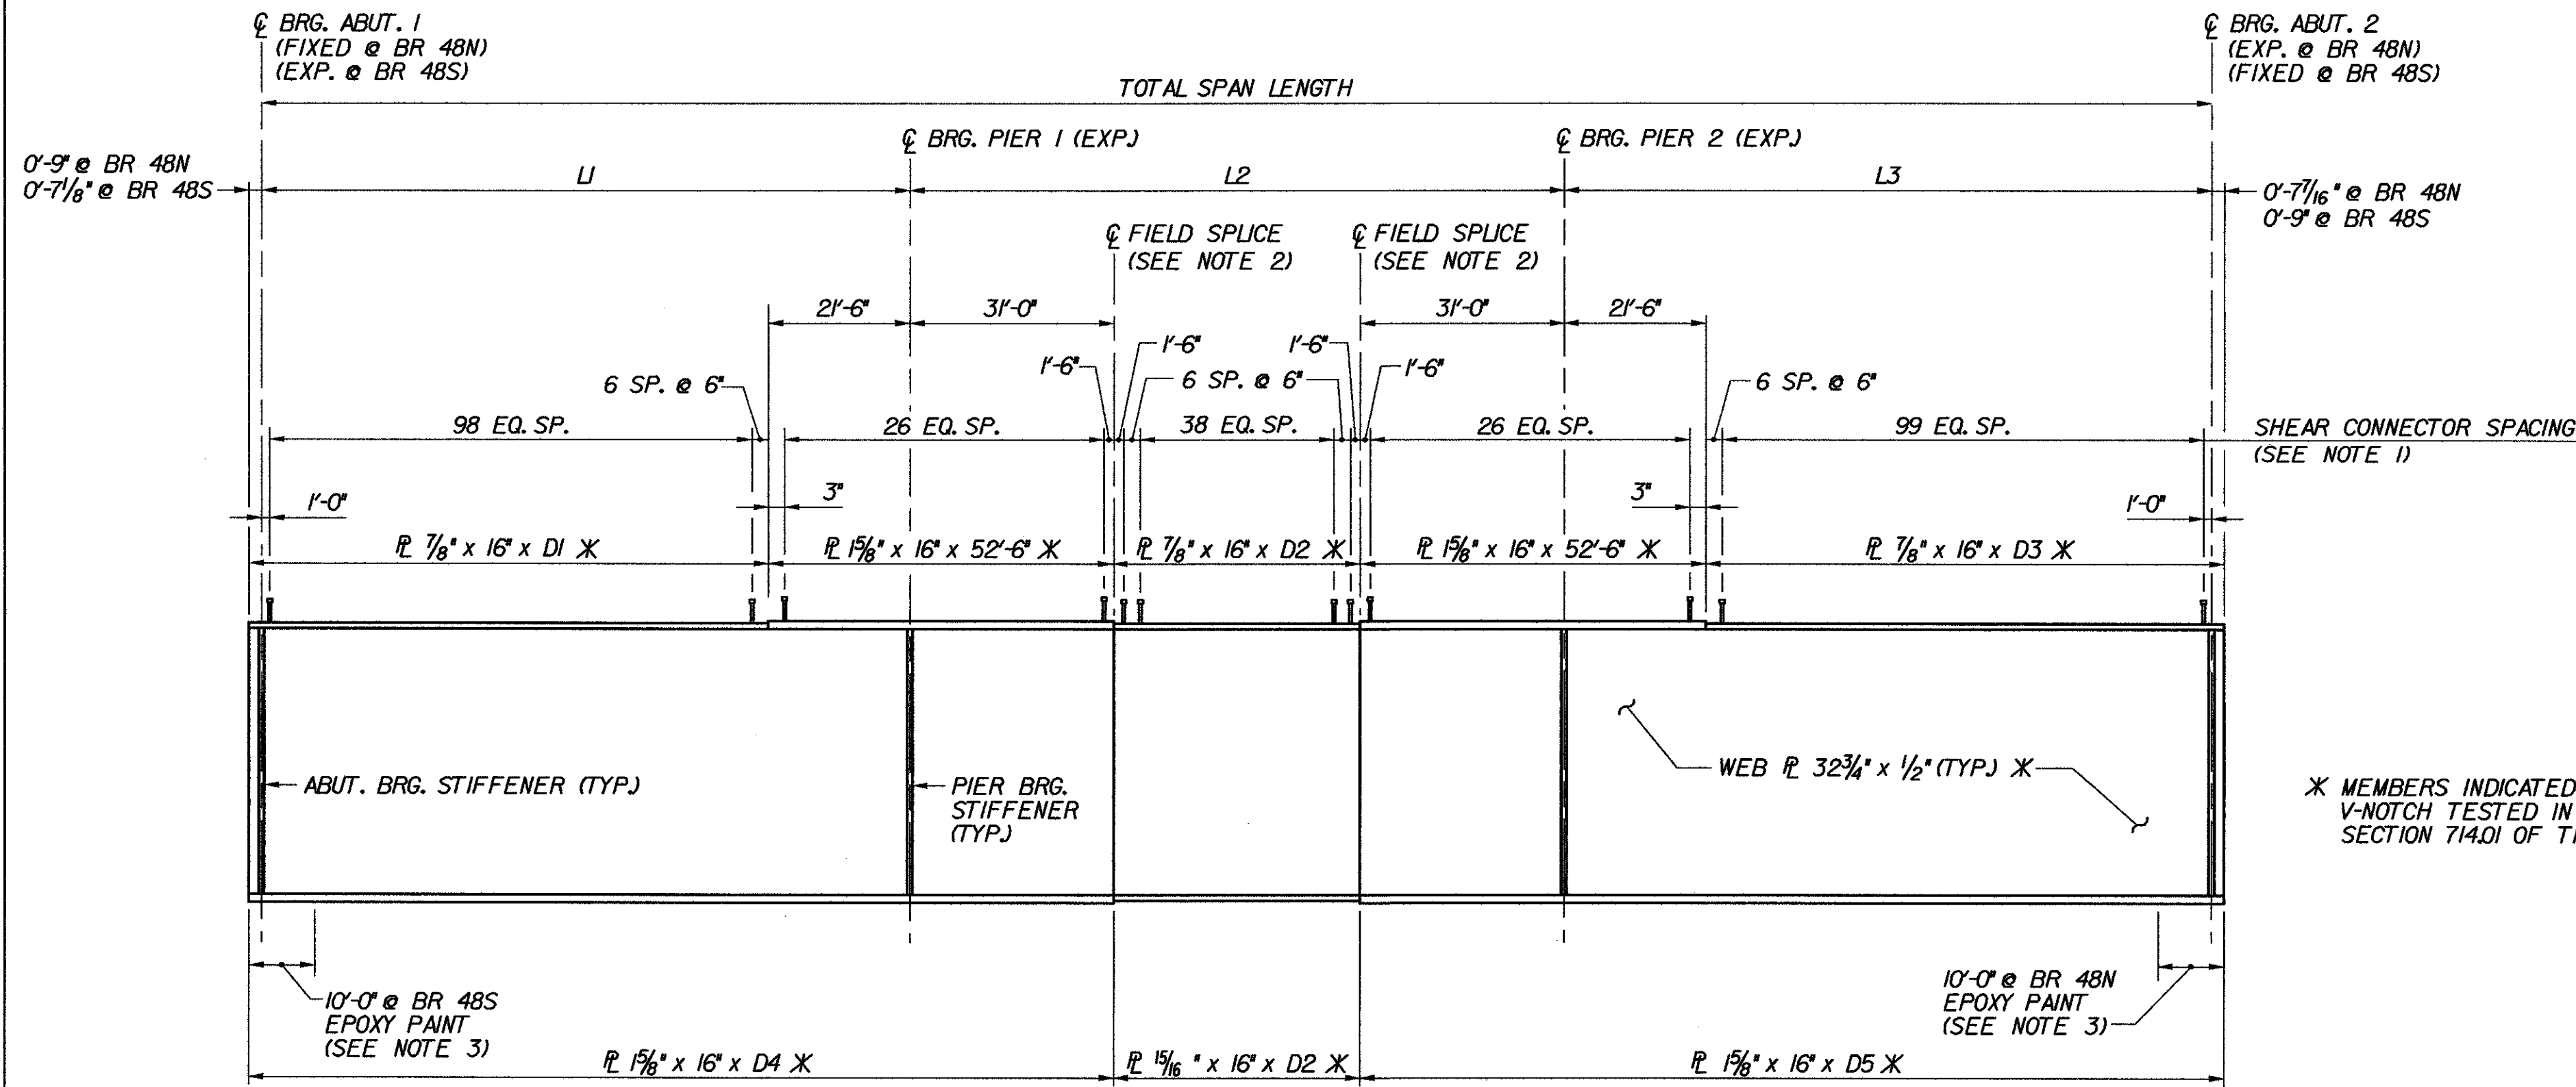


**STRINGER ELEVATION (PLATE GIRDER)**

N.T.S.

\* MEMBERS INDICATED SHALL BE CHAMPY V-NOTCH TESTED IN ACCORDANCE WITH SECTION 714.D1 OF THE SPECIFICATIONS.


BR 48N					
STRINGER	RADIUS	SPAN LENGTHS (ALONG ARC)			TOTAL SPAN LENGTH
		L1	L2	L3	
S1	4319.28'	98' - 2 3/8"	99' - 1 13/16"	98' - 1 1/2"	295' - 5 11/16"
S2	4326.78'	98' - 1 15/16"	99' - 1 5/16"	98' - 1"	295' - 4 1/4"
S3	4334.28'	98' - 1 9/16"	99' - 0 13/16"	98' - 0 1/2"	295' - 2 7/8"
S4	4341.78'	98' - 1 1/8"	99' - 0 3/8"	98' - 0"	295' - 1 1/2"
S5	4349.28'	98' - 0 3/4"	98' - 11 15/16"	97' - 11 7/16"	295' - 0 1/8"
STRINGER	SECTION LENGTHS (ALONG ARC)				
	D1	D2	D3	D4	D5
S1	77' - 5 3/8"	37' - 1 13/16"	77' - 2 15/16"	129' - 11 3/8"	129' - 8 15/16"
S2	77' - 4 15/16"	37' - 1 5/16"	77' - 2 7/16"	129' - 10 15/16"	129' - 8 7/16"
S3	77' - 4 9/16"	37' - 0 13/16"	77' - 1 15/16"	129' - 10 9/16"	129' - 7 15/16"
S4	77' - 4 1/8"	37' - 0 3/8"	77' - 1 7/16"	129' - 10 1/8"	129' - 7 7/16"
S5	77' - 3 3/4"	36' - 11 15/16"	77' - 0 7/8"	129' - 9 3/4"	129' - 6 7/8"

BR 48S					
STRINGER	RADIUS	SPAN LENGTHS (ALONG ARC)			TOTAL SPAN LENGTH
		L1	L2	L3	
S1	4245.28'	98' - 7"	99' - 6"	98' - 5 3/8"	296' - 6 3/8"
S2	4252.78'	98' - 6 9/16"	99' - 5 1/2"	98' - 4 7/8"	296' - 4 15/16"
S3	4252.78'	98' - 6 1/8"	99' - 5 1/16"	98' - 4 5/16"	296' - 3 1/2"
S4	4252.78'	98' - 5 11/16"	99' - 4 9/16"	98' - 3 13/16"	296' - 2 1/16"
S5	4252.78'	98' - 5 5/16"	99' - 4 1/16"	98' - 3 1/4"	296' - 0 5/8"
STRINGER	SECTION LENGTHS (ALONG ARC)				
	D1	D2	D3	D4	D5
S1	77' - 8 1/8"	37' - 6"	77' - 8 3/8"	130' - 2 1/8"	130' - 2 3/8"
S2	77' - 7 11/16"	37' - 5 1/2"	77' - 7 7/8"	130' - 1 11/16"	130' - 1 7/8"
S3	77' - 7 1/4"	37' - 5 1/16"	77' - 7 5/16"	130' - 1 1/4"	130' - 1 5/16"
S4	77' - 6 13/16"	37' - 4 9/16"	77' - 6 13/16"	130' - 0 13/16"	130' - 0 13/16"
S5	77' - 6 7/16"	37' - 4 1/16"	77' - 6 1/4"	130' - 0 7/16"	130' - 0 1/4"

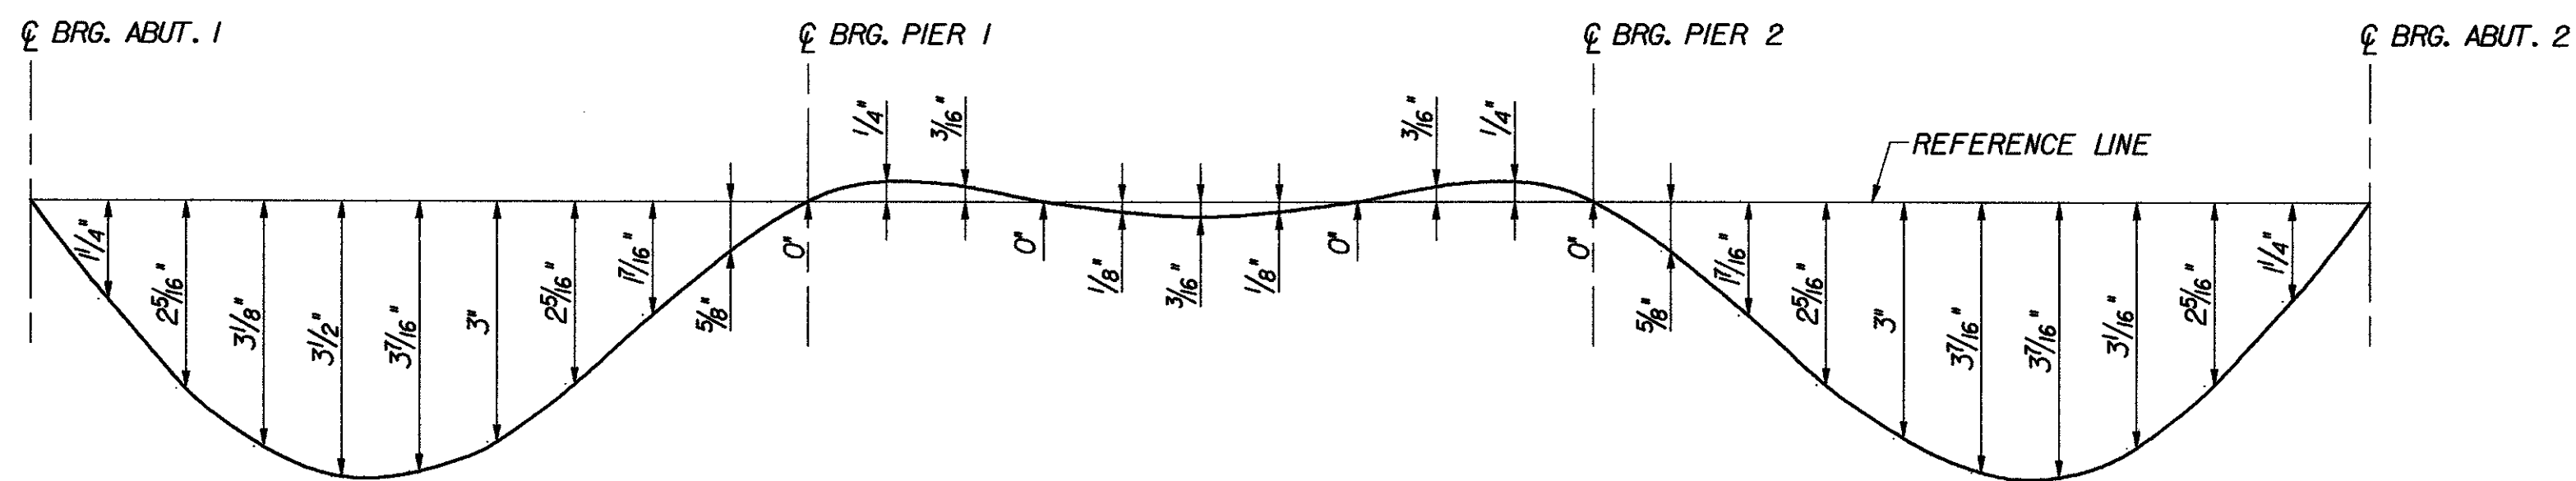

**DEAD LOAD DEFLECTION DIAGRAM**

N.T.S.

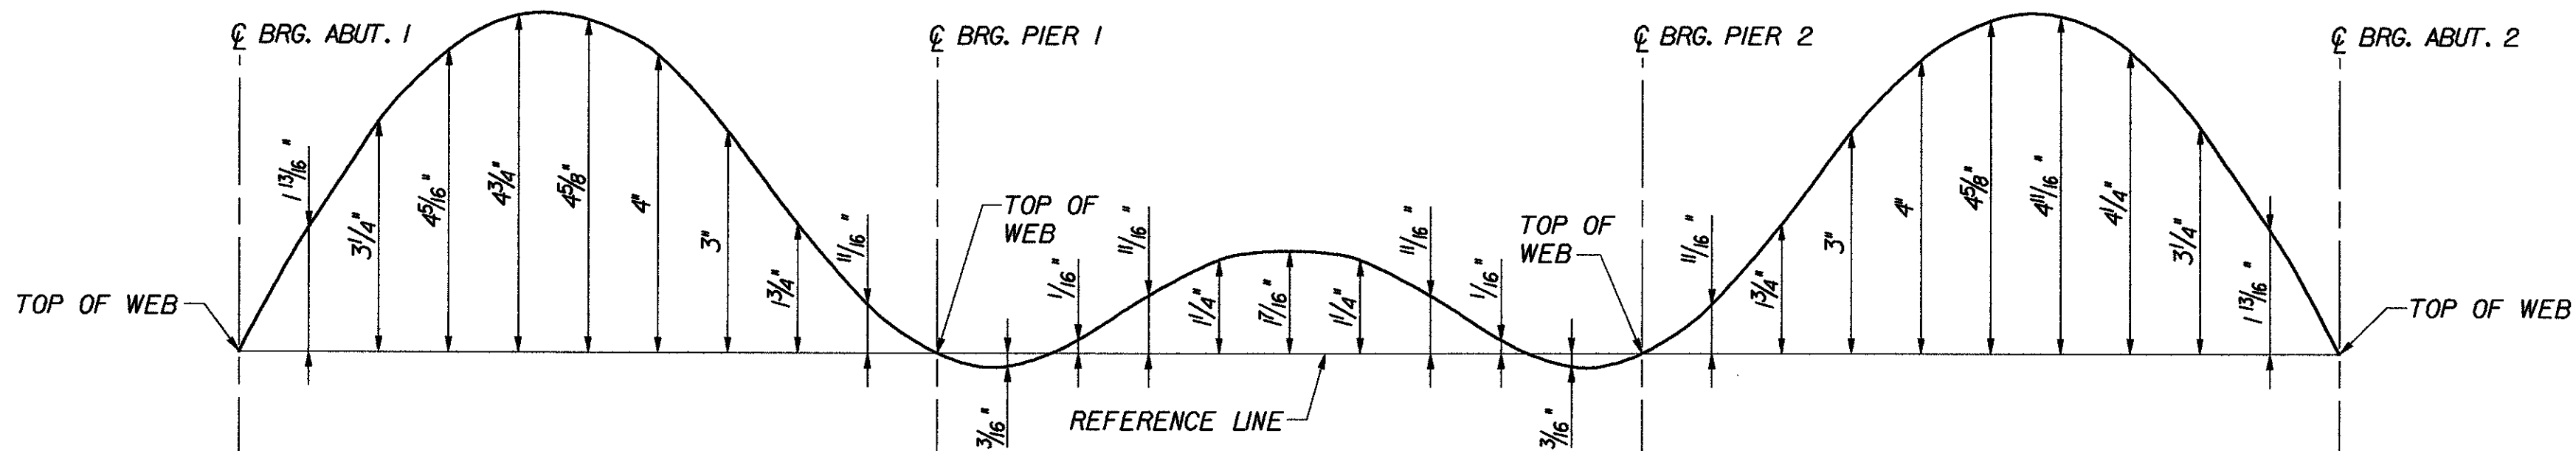

**CAMBER DIAGRAM**

N.T.S.


**NOTES:**

1. EACH ROW OF SHEAR CONNECTORS SHALL CONSIST OF 2 STUDS. FOR LATERAL SPACING, SEE TRANSVERSE SECTION (48N&S), BRIDGE SHEET BR48-4.
2. FOR FIELD SPLICE DETAILS, SEE TYPICAL GIRDER SPLICE DETAILS, BRIDGE SHEET C-20.
3. ALL STRUCTURAL STEEL WITHIN 10 FEET OF END OF STRINGER AT EXPANSION ENDS SHALL BE COATED WITH A PROTECTIVE PAINT SYSTEM, WITH THE FINAL COAT TO BE DARK BROWN (COLOR CHIP #20059) TO BLEND WITH THE WEATHERING STEEL. THE COST OF PAINTING SHALL BE PAID FOR UNDER ITEM 513.25, "STRUCTURAL PAINTING, SHOP APPLIED".

**STATE OF VERMONT  
AGENCY OF TRANSPORTATION**

Town Of	MIDDLESEX-BOLTON	Bridge No.	48N&S
Highway No.	I-89	Log Sta.	
		Surv. Sta.	
I-89 OVER LITTLE RIVER			
<b>STRINGER ELEVATION (48N&amp;S)</b>			
Designed By	P.W. SZUSTAK	Drawn By	R.A. BOTZENHART
Checked By	J.P. HALSTEAD	Date	10/99
	10/99	Bridge Design Supervisor	J.P. HALSTEAD Date 10/99
PROJECT	MIDDLESEX-BOLTON	PROJECT NO.	IM-089-2(126)
TVGA CAD Drawing No.	48str_el	Date	10/99
Bridge Sheet No.	BR48-10	Sheet	70 of 307


NOTE: RAISED 48N FINISH GR. 5/4"

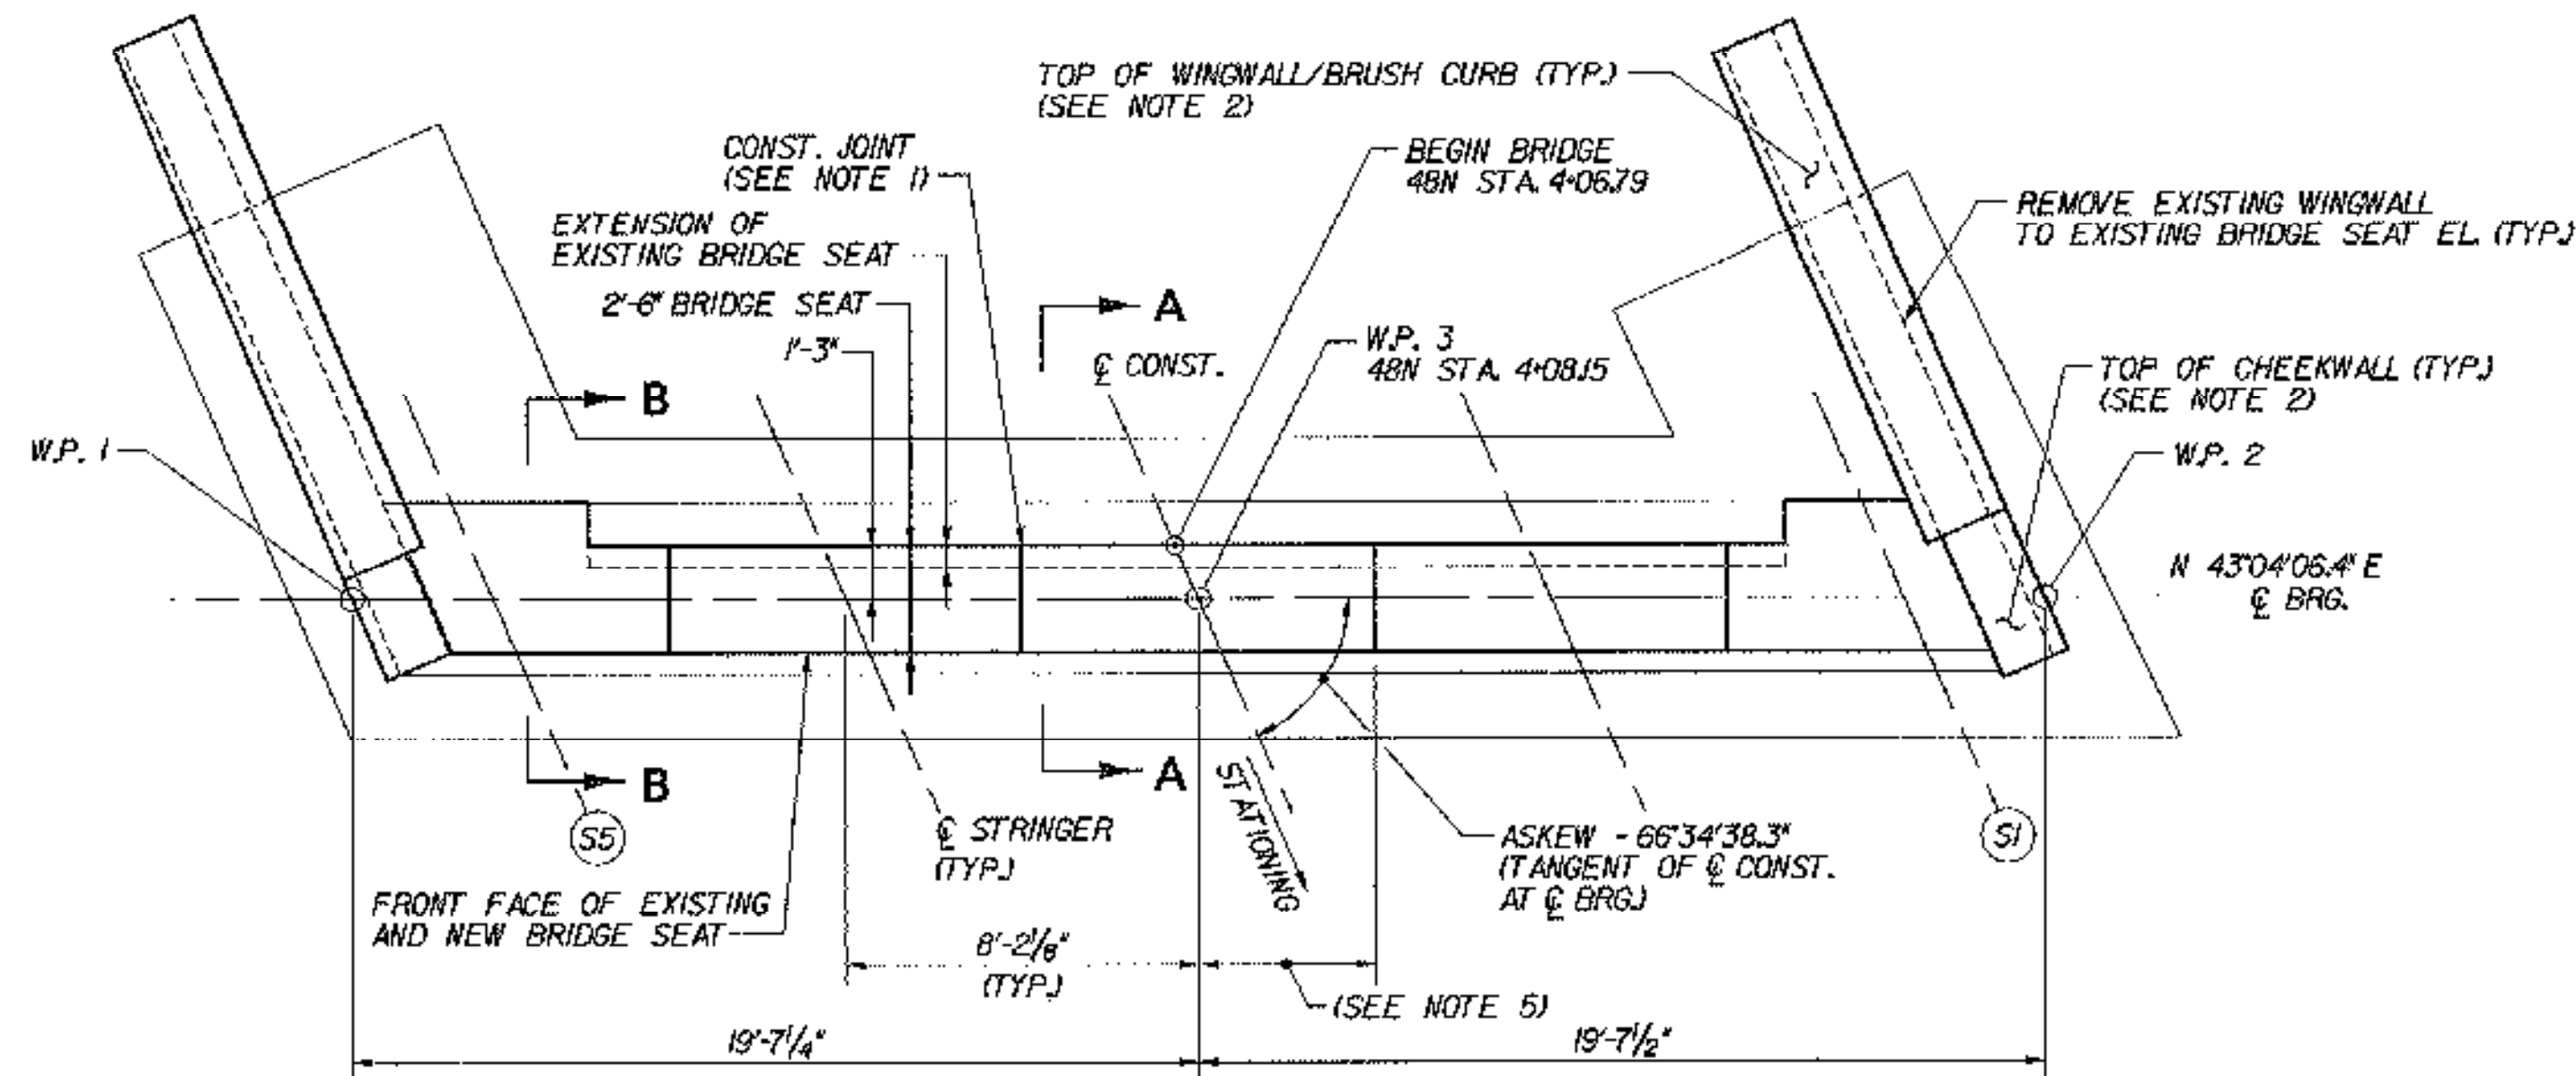

ABUTMENT 1 PLAN (FIXED)


SCALE: 1/4"=1'-0"

NOTE: RAISED PIER AND ABUT. SEATS 4"

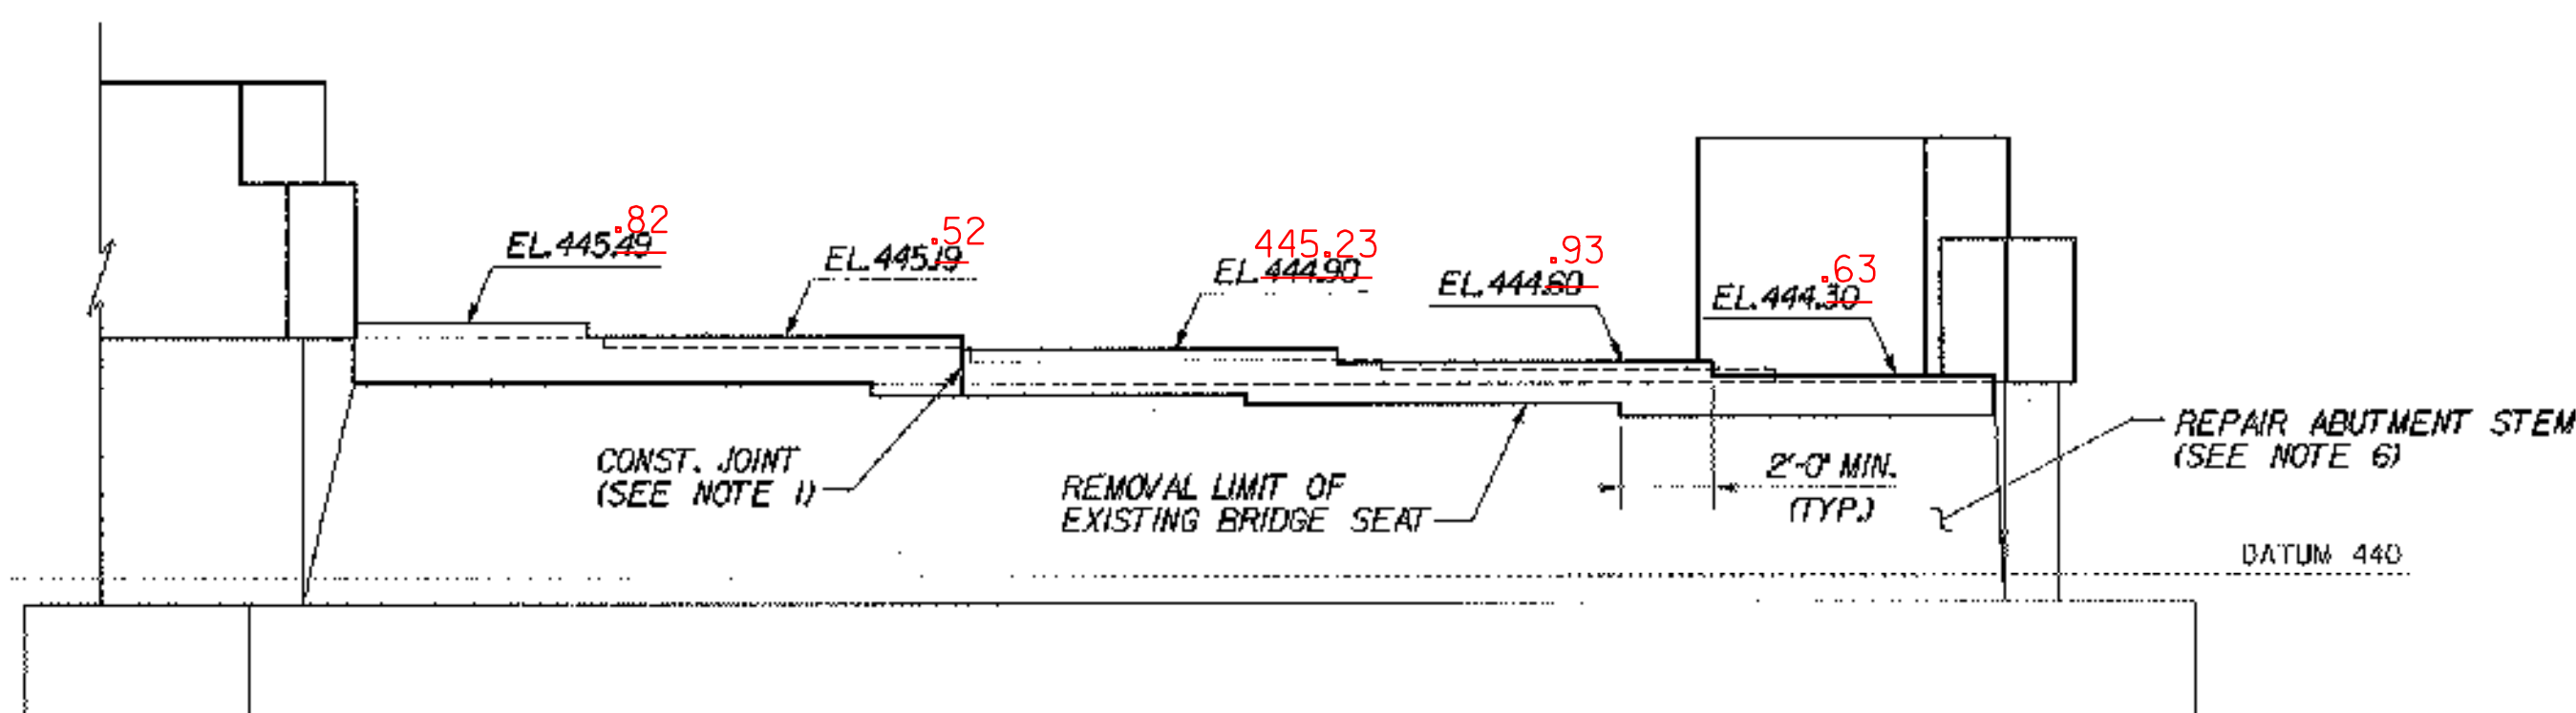

ABUTMENT 1 ELEVATION


SCALE: 1/4"=1'-0"

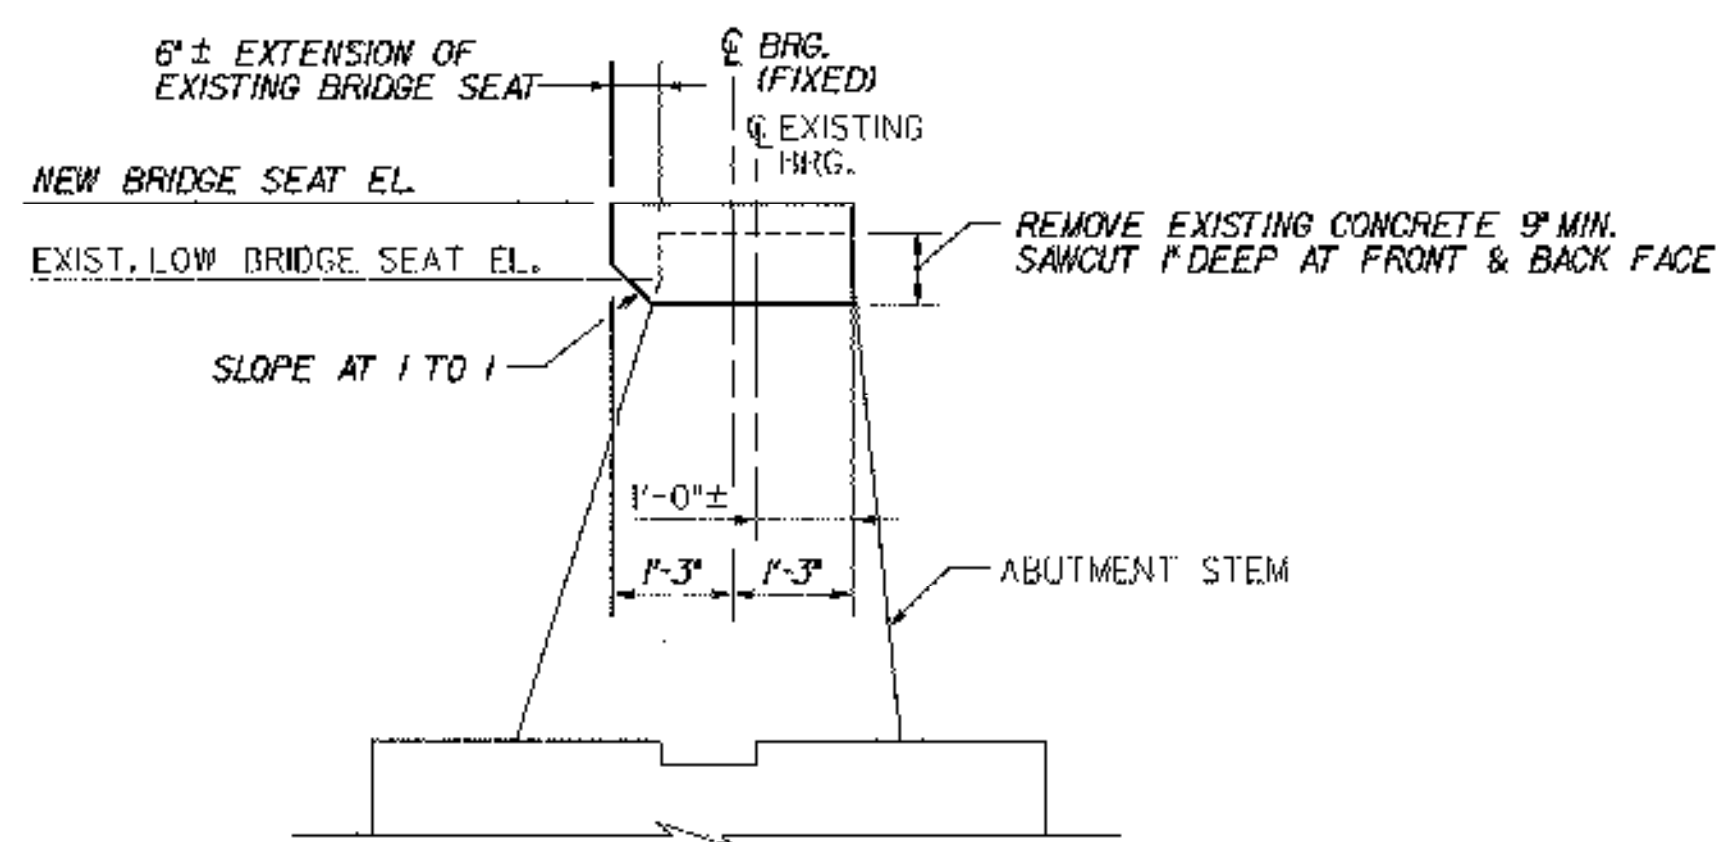

SECTION A-A


SCALE: 1/2"=1'-0"

NOTE: FOR SECTIONS C-C AND D-D, SEE ABUTMENT MASONRY (48S), BRIDGE SHEET BR48-12.

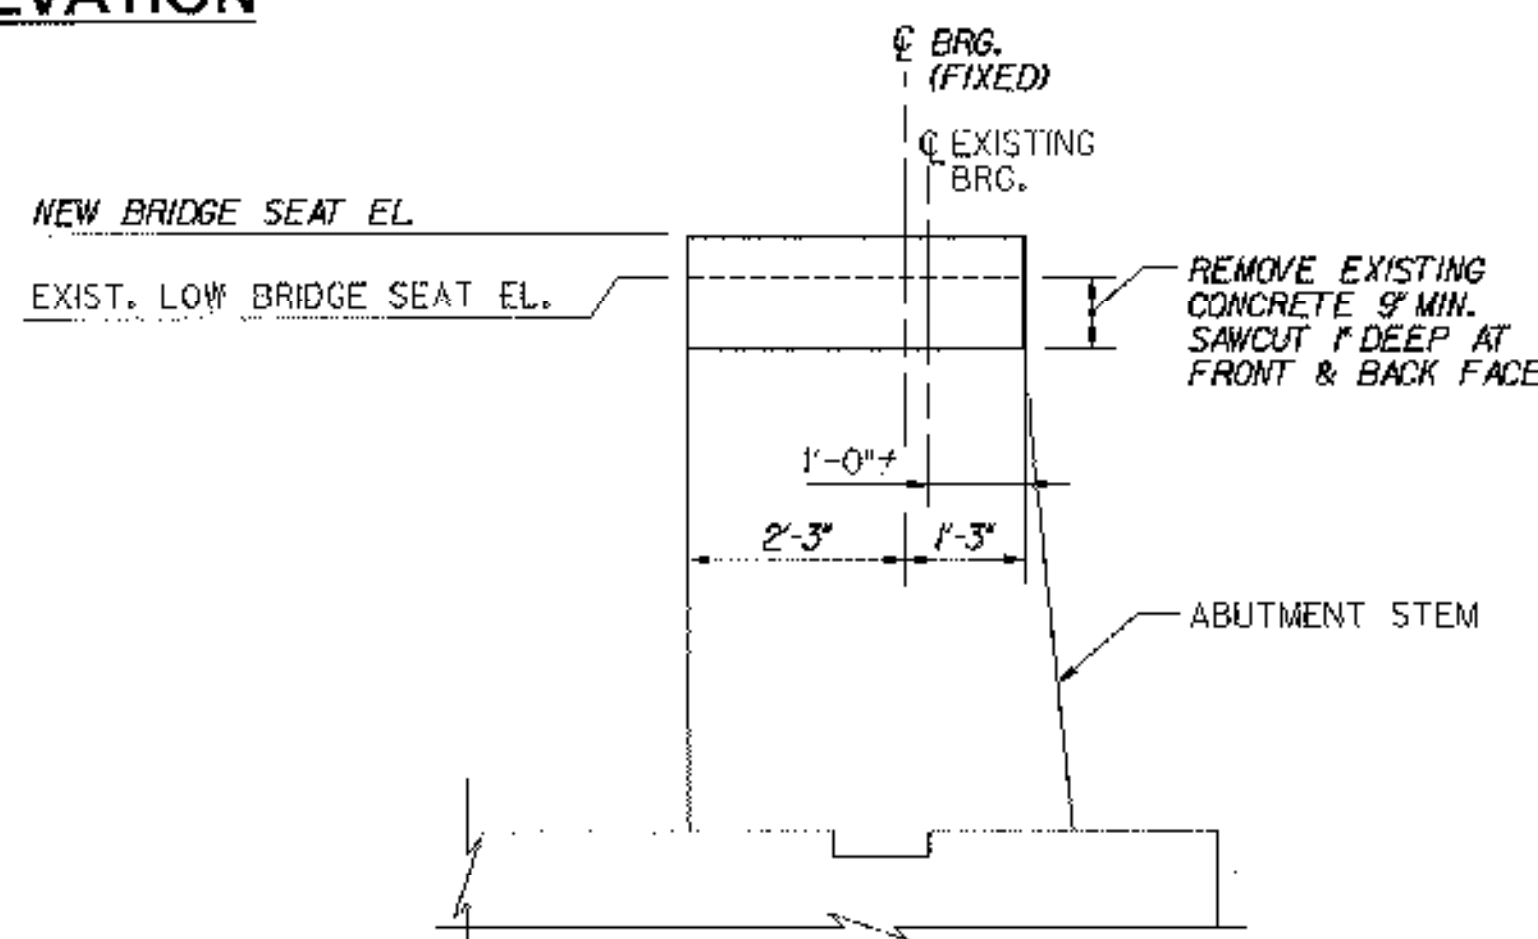


SECTION B-B

SCALE: 1/2"=1'-0"

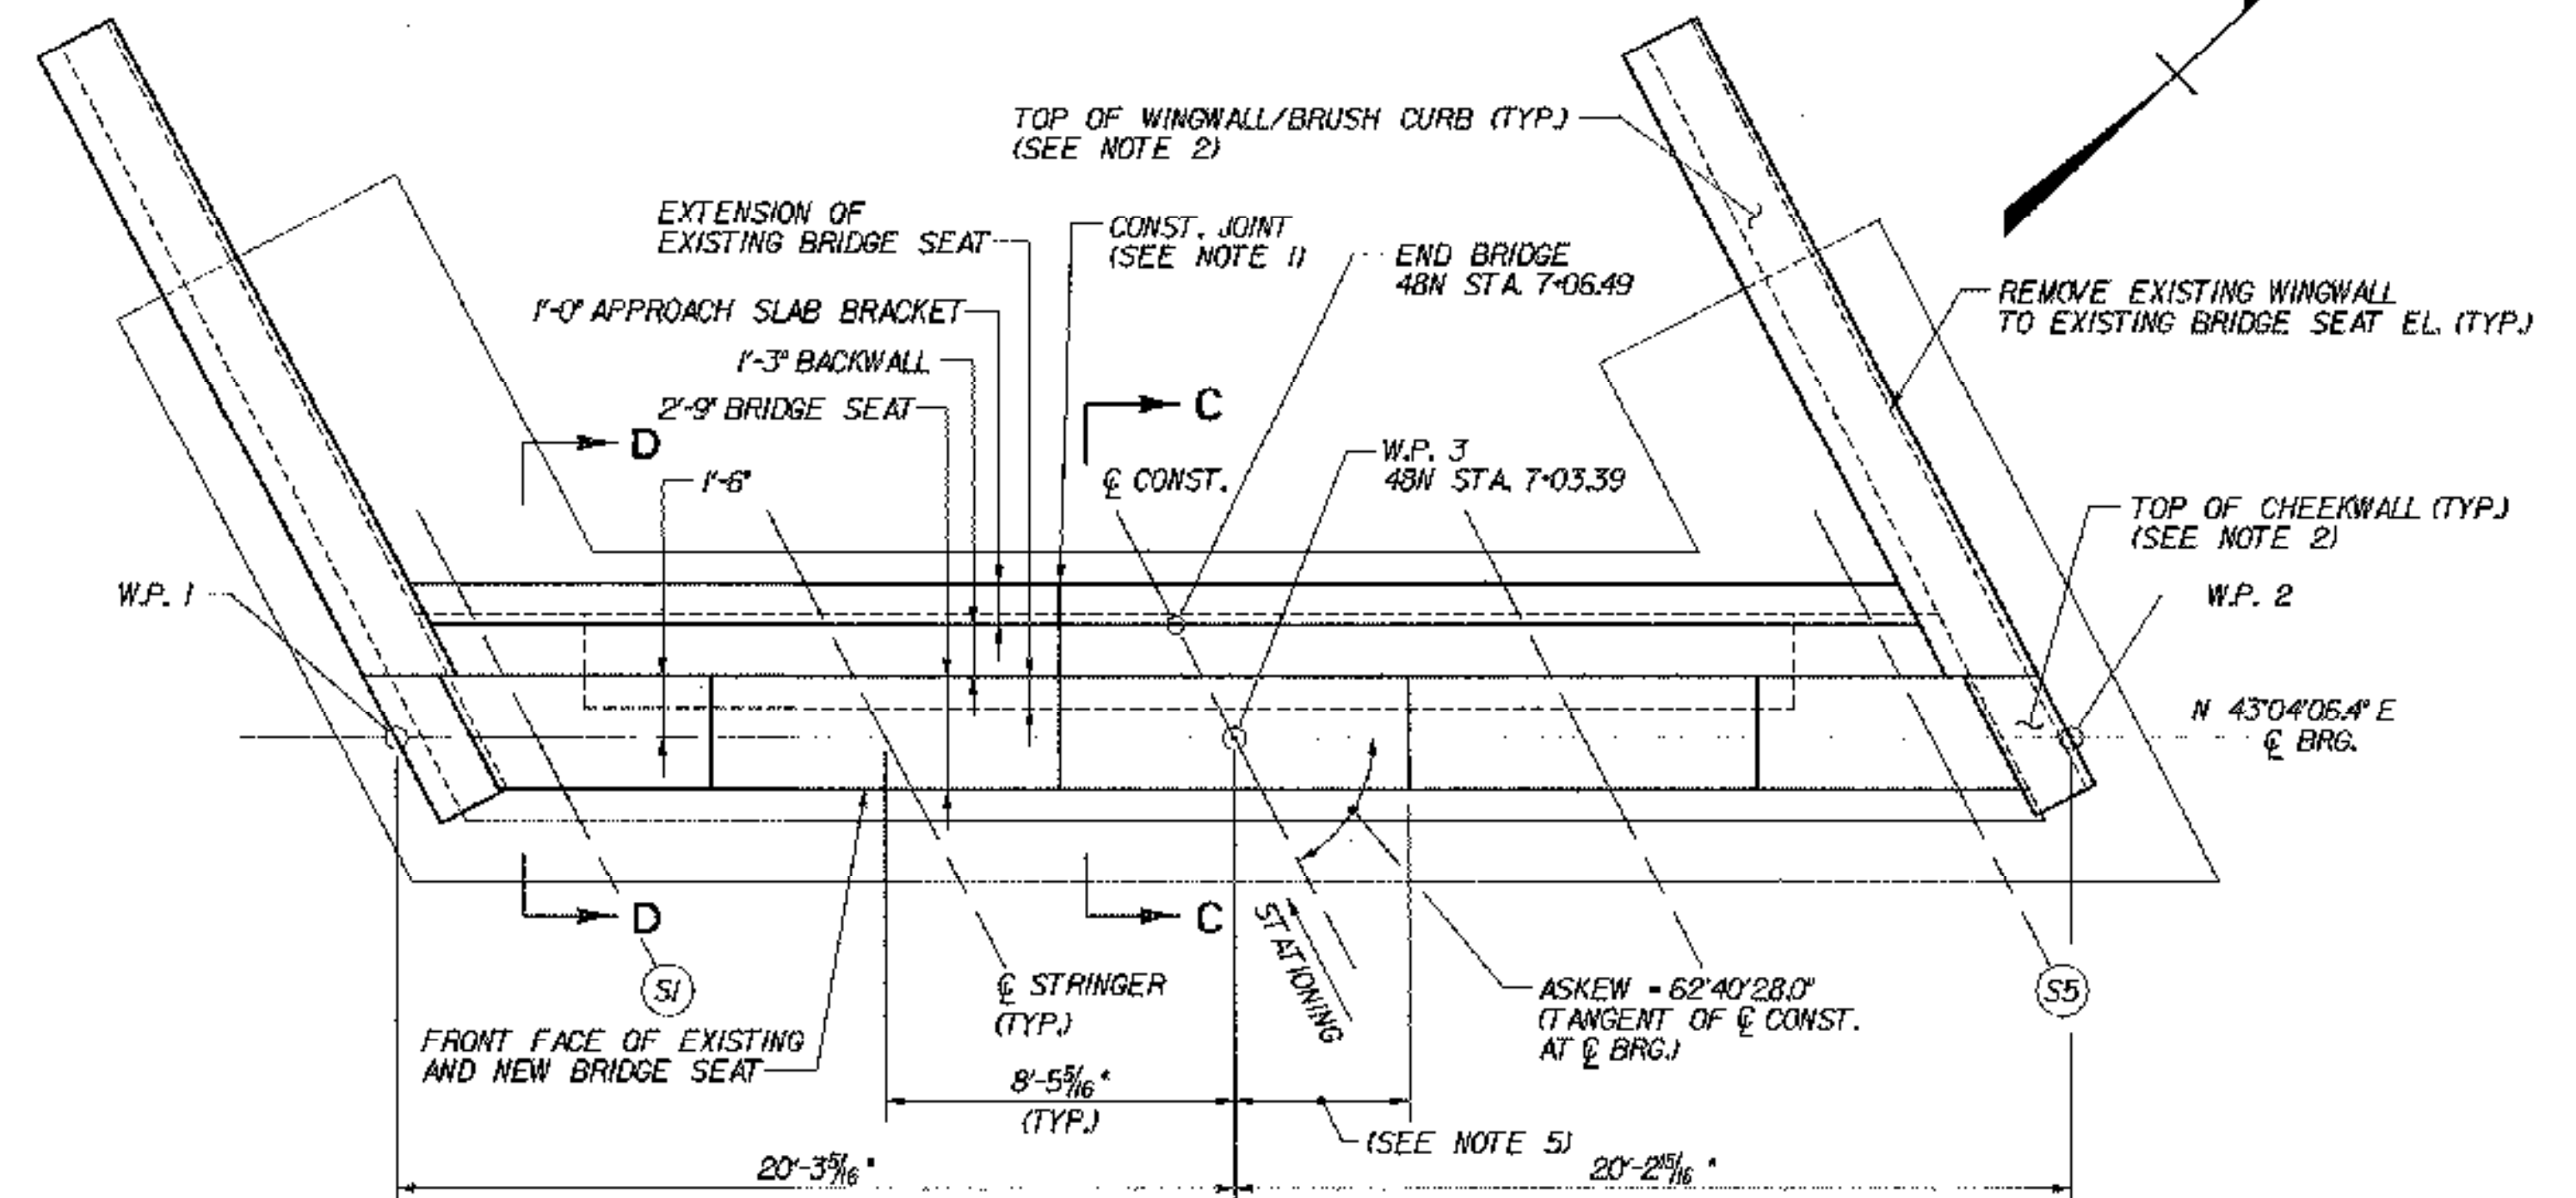

ABUTMENT 2 PLAN (EXP.)

SCALE: 1/4"=1'-0"

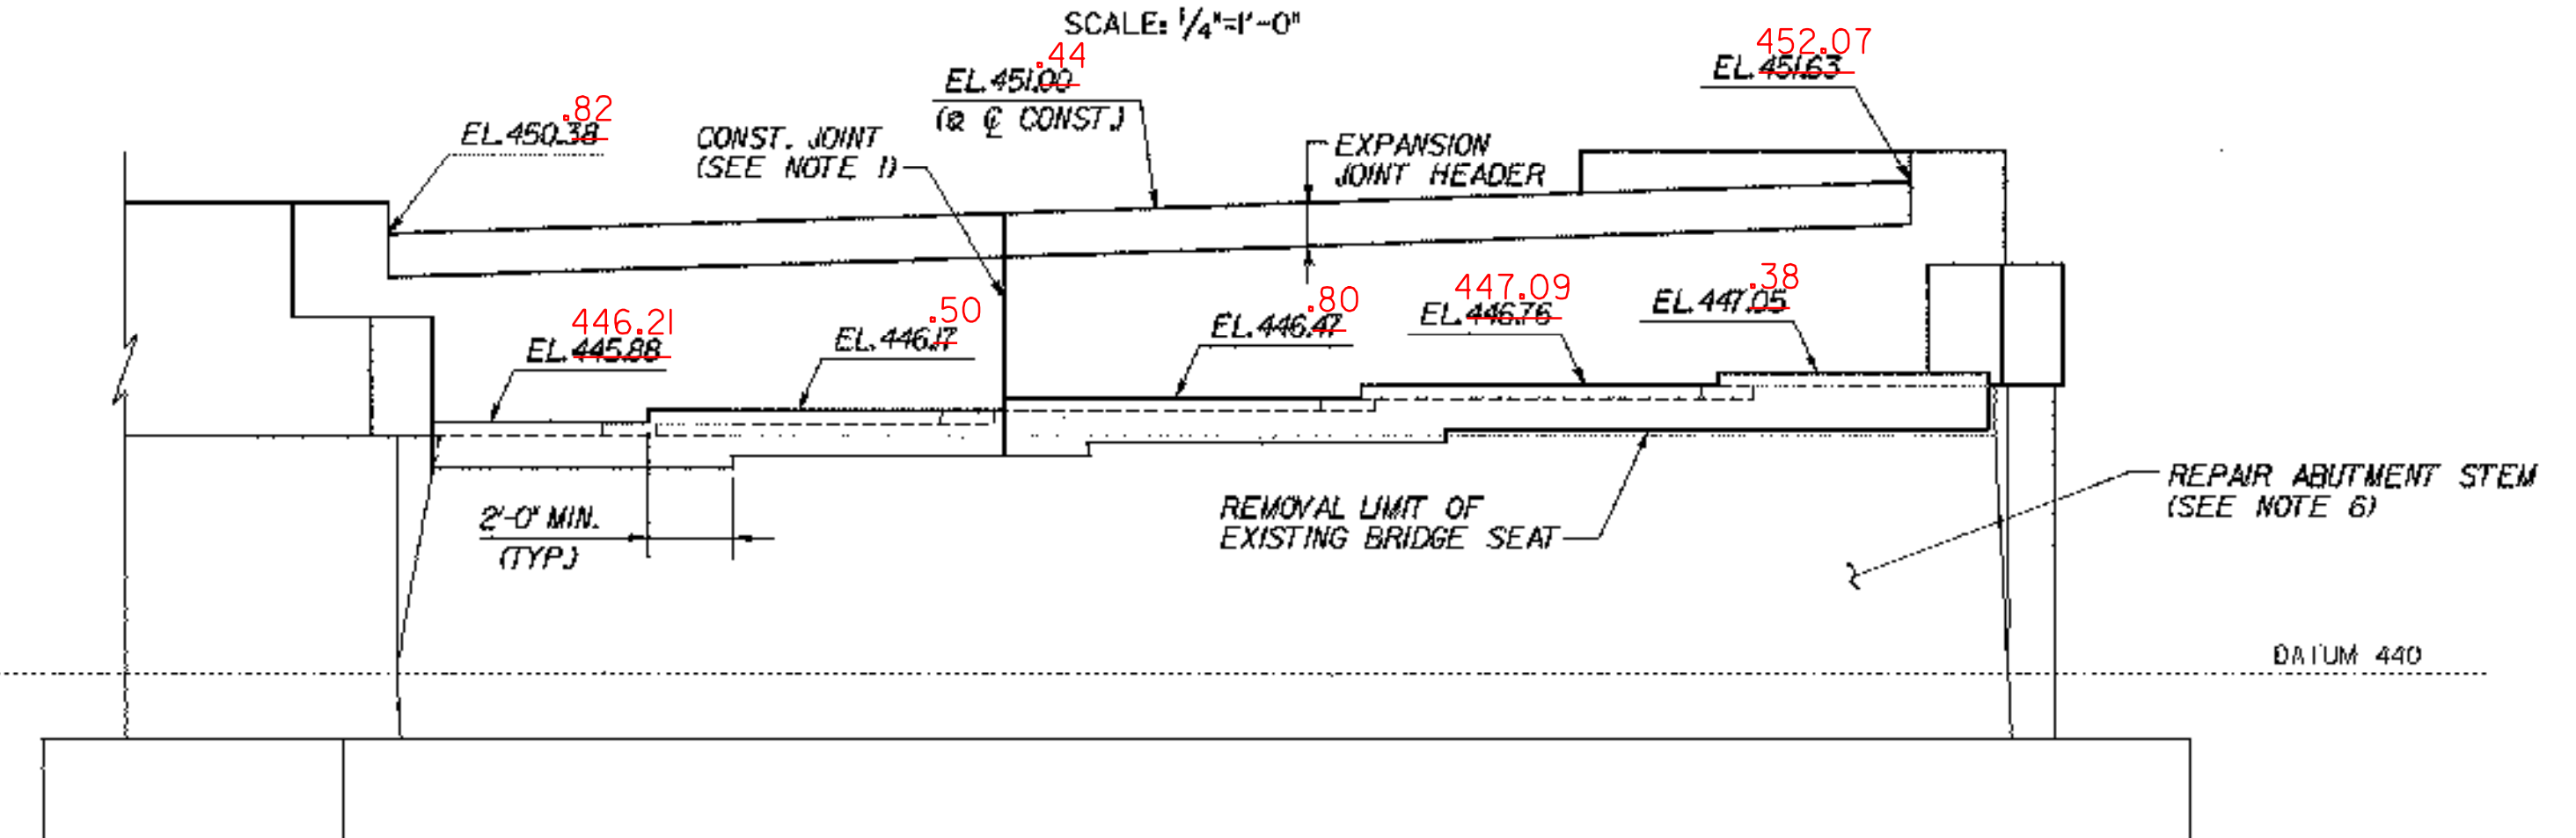

ABUTMENT 2 ELEVATION

SCALE: 1/4"=1'-0"





NOTES:

- CONSTRUCTION JOINT LOCATED AT STEP IN BRIDGE SEAT. LOCATION SHALL BE REVISED AS DIRECTED BY THE RESIDENT ENGINEER AS REQUIRED TO MATCH ANY CONSTRUCTION JOINT IN THE EXISTING ABUTMENT STEM.
- FOR WINGWALL AND CHEEKWALL DIMENSIONS, DETAILS AND ELEVATIONS, SEE TYPICAL WINGWALL DETAILS, BRIDGE SHEETS C-43 AND C-44.
- BACKWALL ELEVATIONS SHOWN AT FRONT FACE OF BACKWALL.
- FOR ABUTMENT REINFORCEMENT DETAILS, SEE TYPICAL EXPANSION ABUTMENT REINFORCEMENT, BRIDGE SHEET C-40, AND TYPICAL FIXED ABUTMENT REINFORCEMENT, BRIDGE SHEET C-41.
- STEPS IN BRIDGE SEATS SHALL BE EQUIDISTANT BETWEEN STRINGERS.
- REPAIR ALL EXISTING SPALLED AND DELAMINATED AREAS ON ABUTMENT. SEE EXISTING SUBSTRUCTURE CONDITION, BRIDGE SHEETS SC-5 THROUGH SC-10 FOR APPROXIMATE CONDITION OF EXISTING SUBSTRUCTURES. FOR CONCRETE REPAIR DETAILS, SEE SUBSTRUCTURE REPAIR DETAILS AND NOTES, BRIDGE SHEET C-45.



STATE OF VERMONT  
AGENCY OF TRANSPORTATION

Town Of	MIDDLESEX-BOLTON	Bridge No.	48N
Highway No.	I-89	Log Sta.	
		Surv. Sta.	
I-89 NB OVER LITTLE RIVER			
<b>ABUTMENT MASONRY (48N)</b>			
Designed By	P.W. SZUSTAK	Drawn By	R.A. BOTZENHART
Checked By	J.P. HALSTEAD	Date	10/99
		Bridge Design Supervisor	J.P. HALSTEAD
		Date	10/99
PROJECT	MIDDLESEX-BOLTON	PROJECT NO.	IM-089-2(26)
TVGA CAD Drawing No.	48cbmas	Date	10/99
Bridge Sheet No.	BR48-11	Sheet	11 of 307

RAISED BRIDGE 48S FINISH GRADE 3/4"

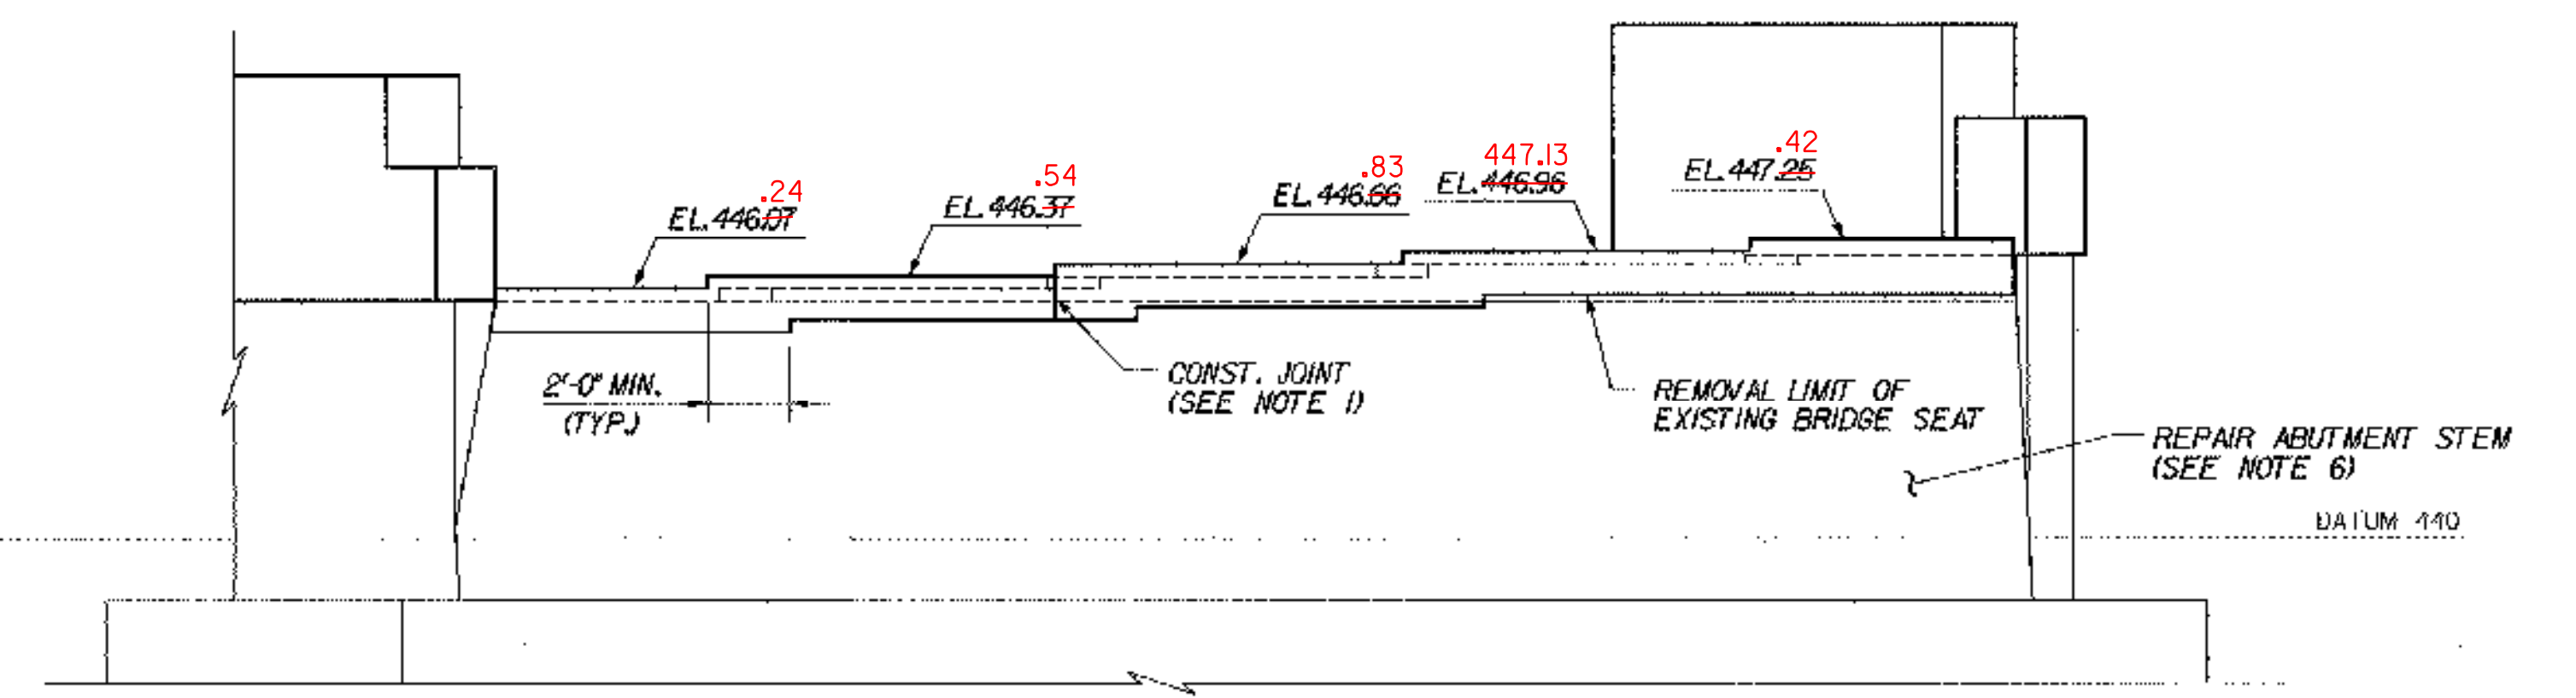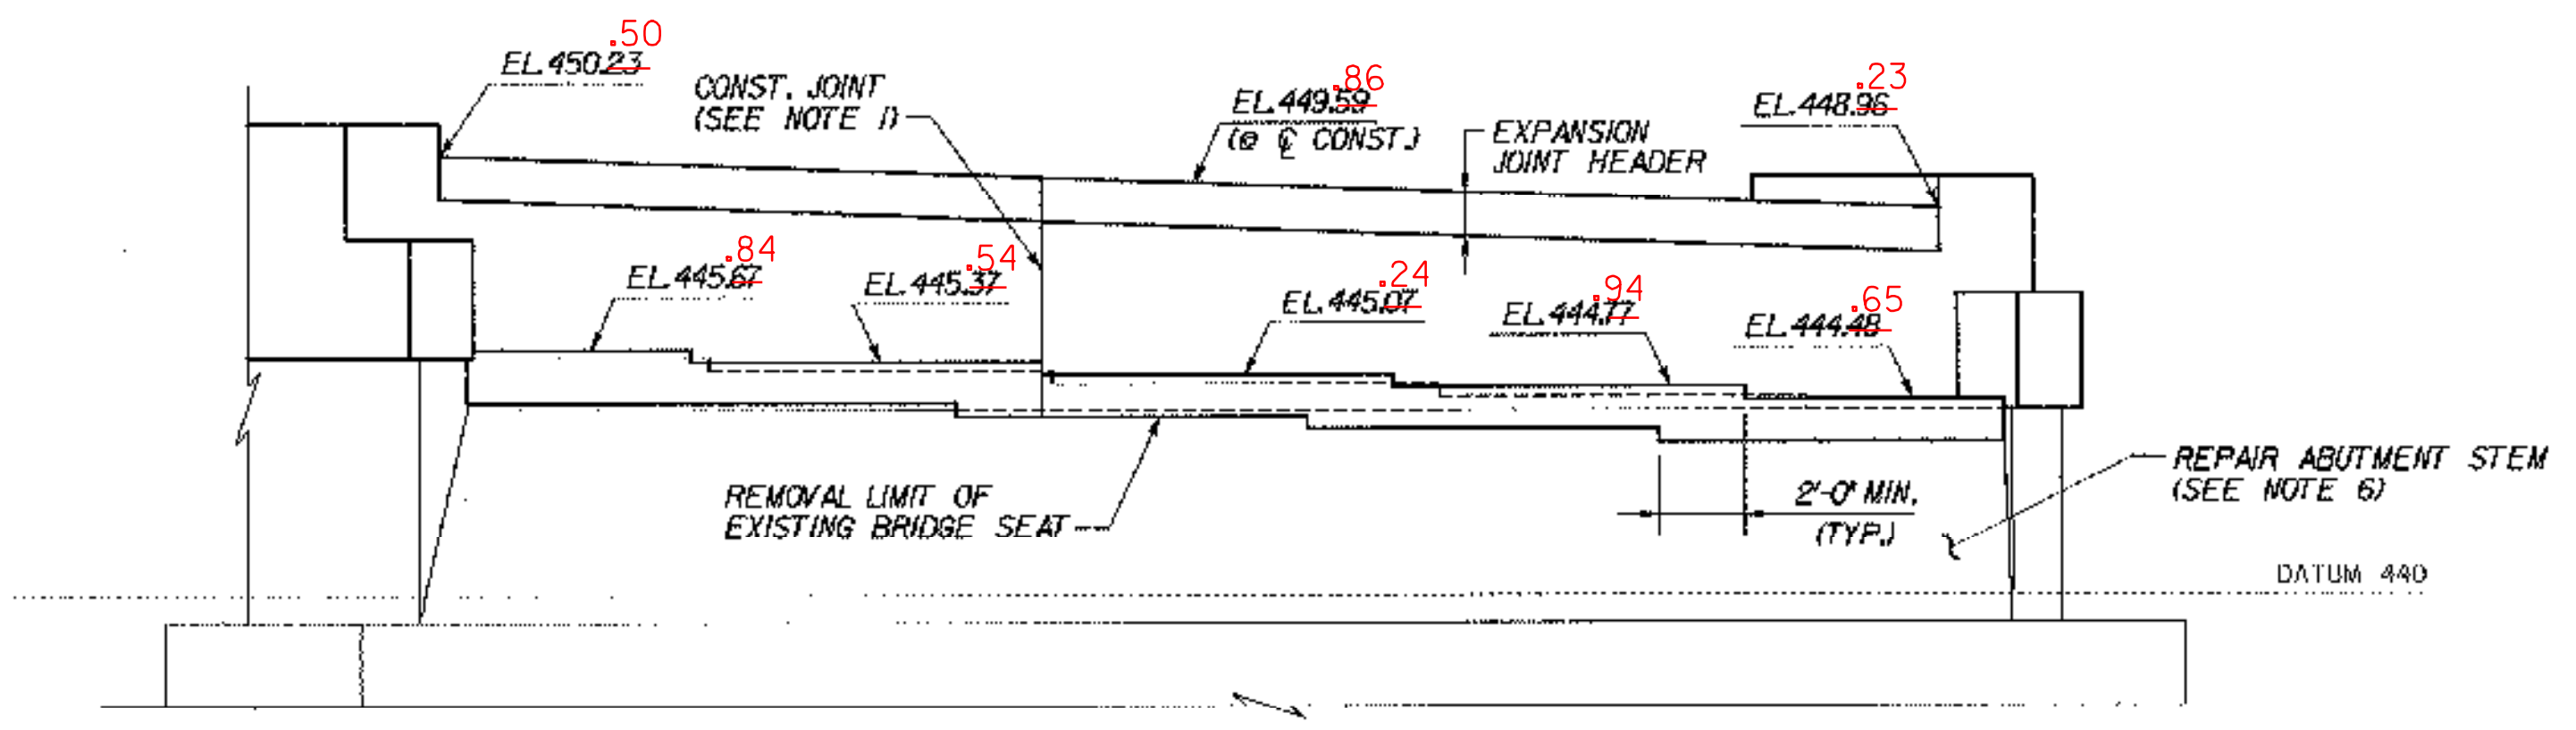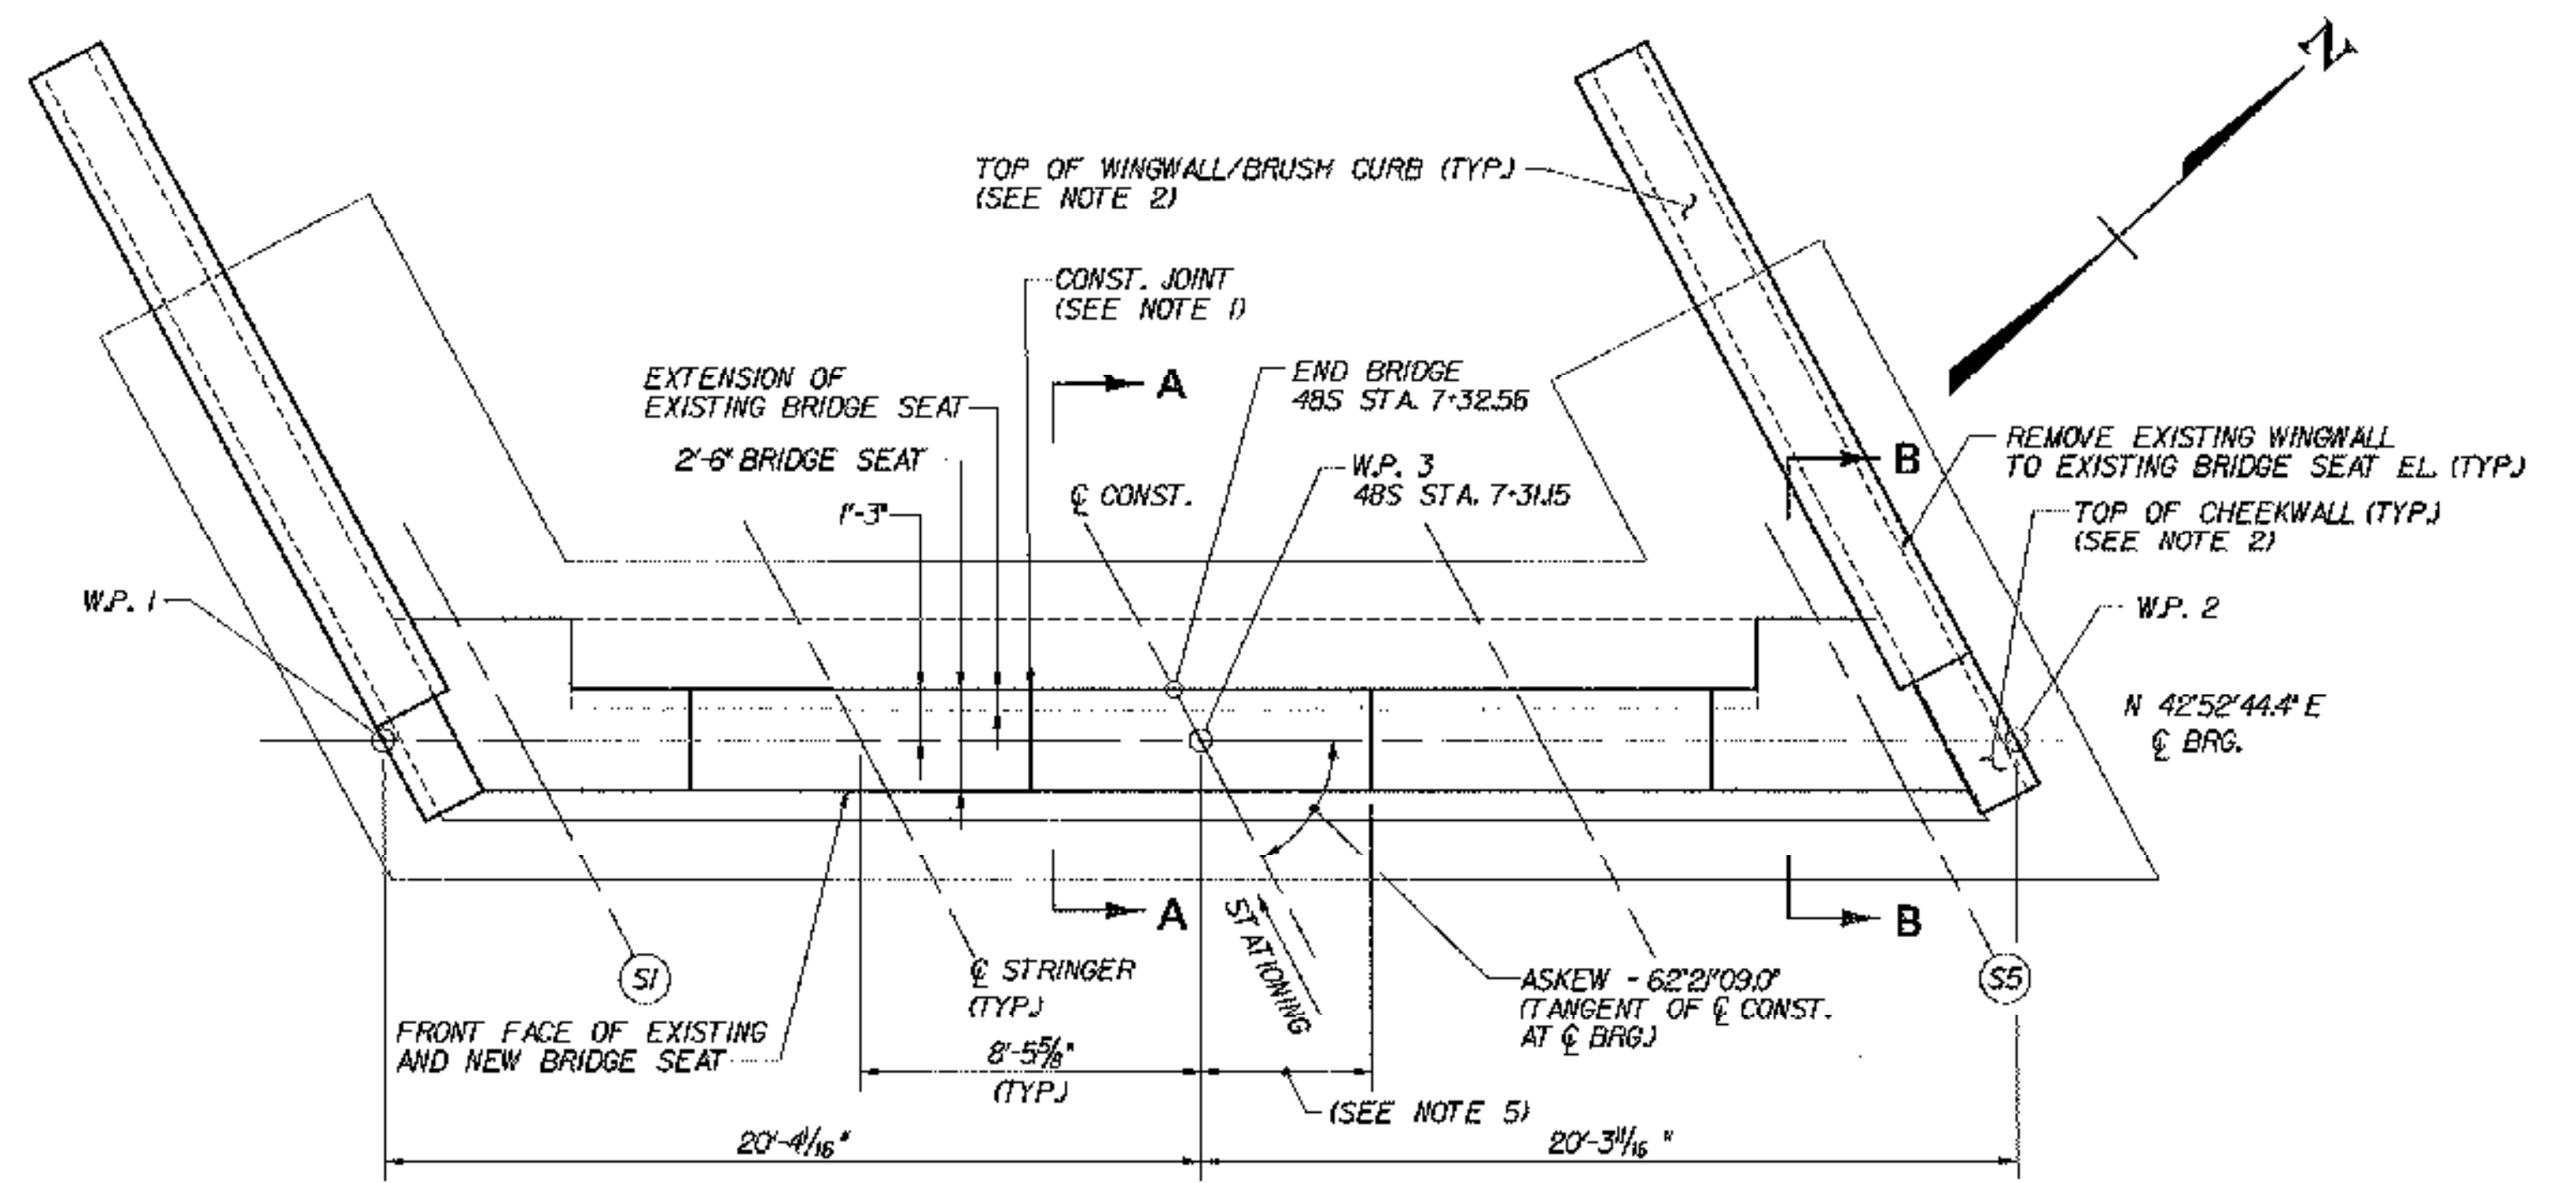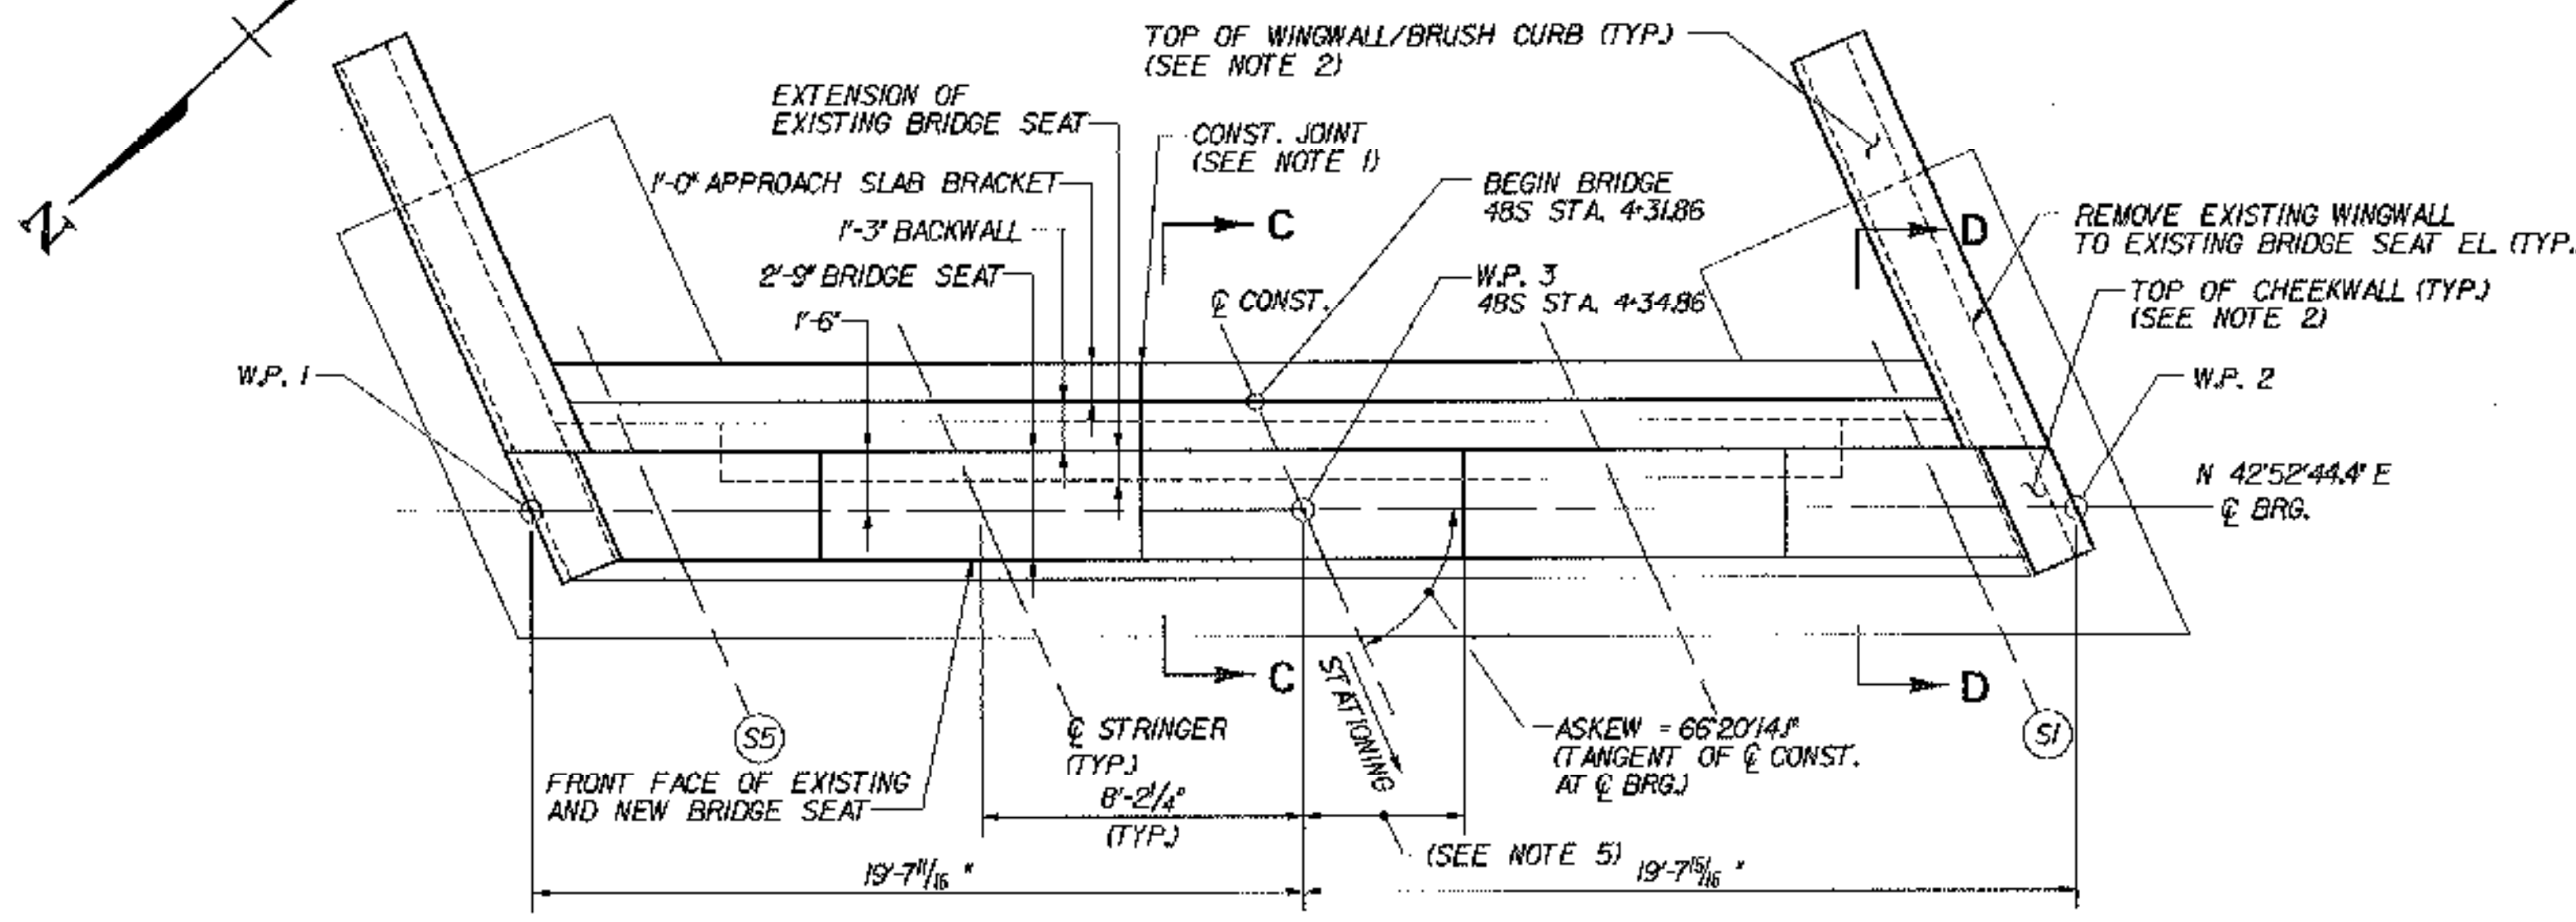

NOTE: RAISED BRIDGE 48S ABUT. SEAT ELEVS. 2.0'

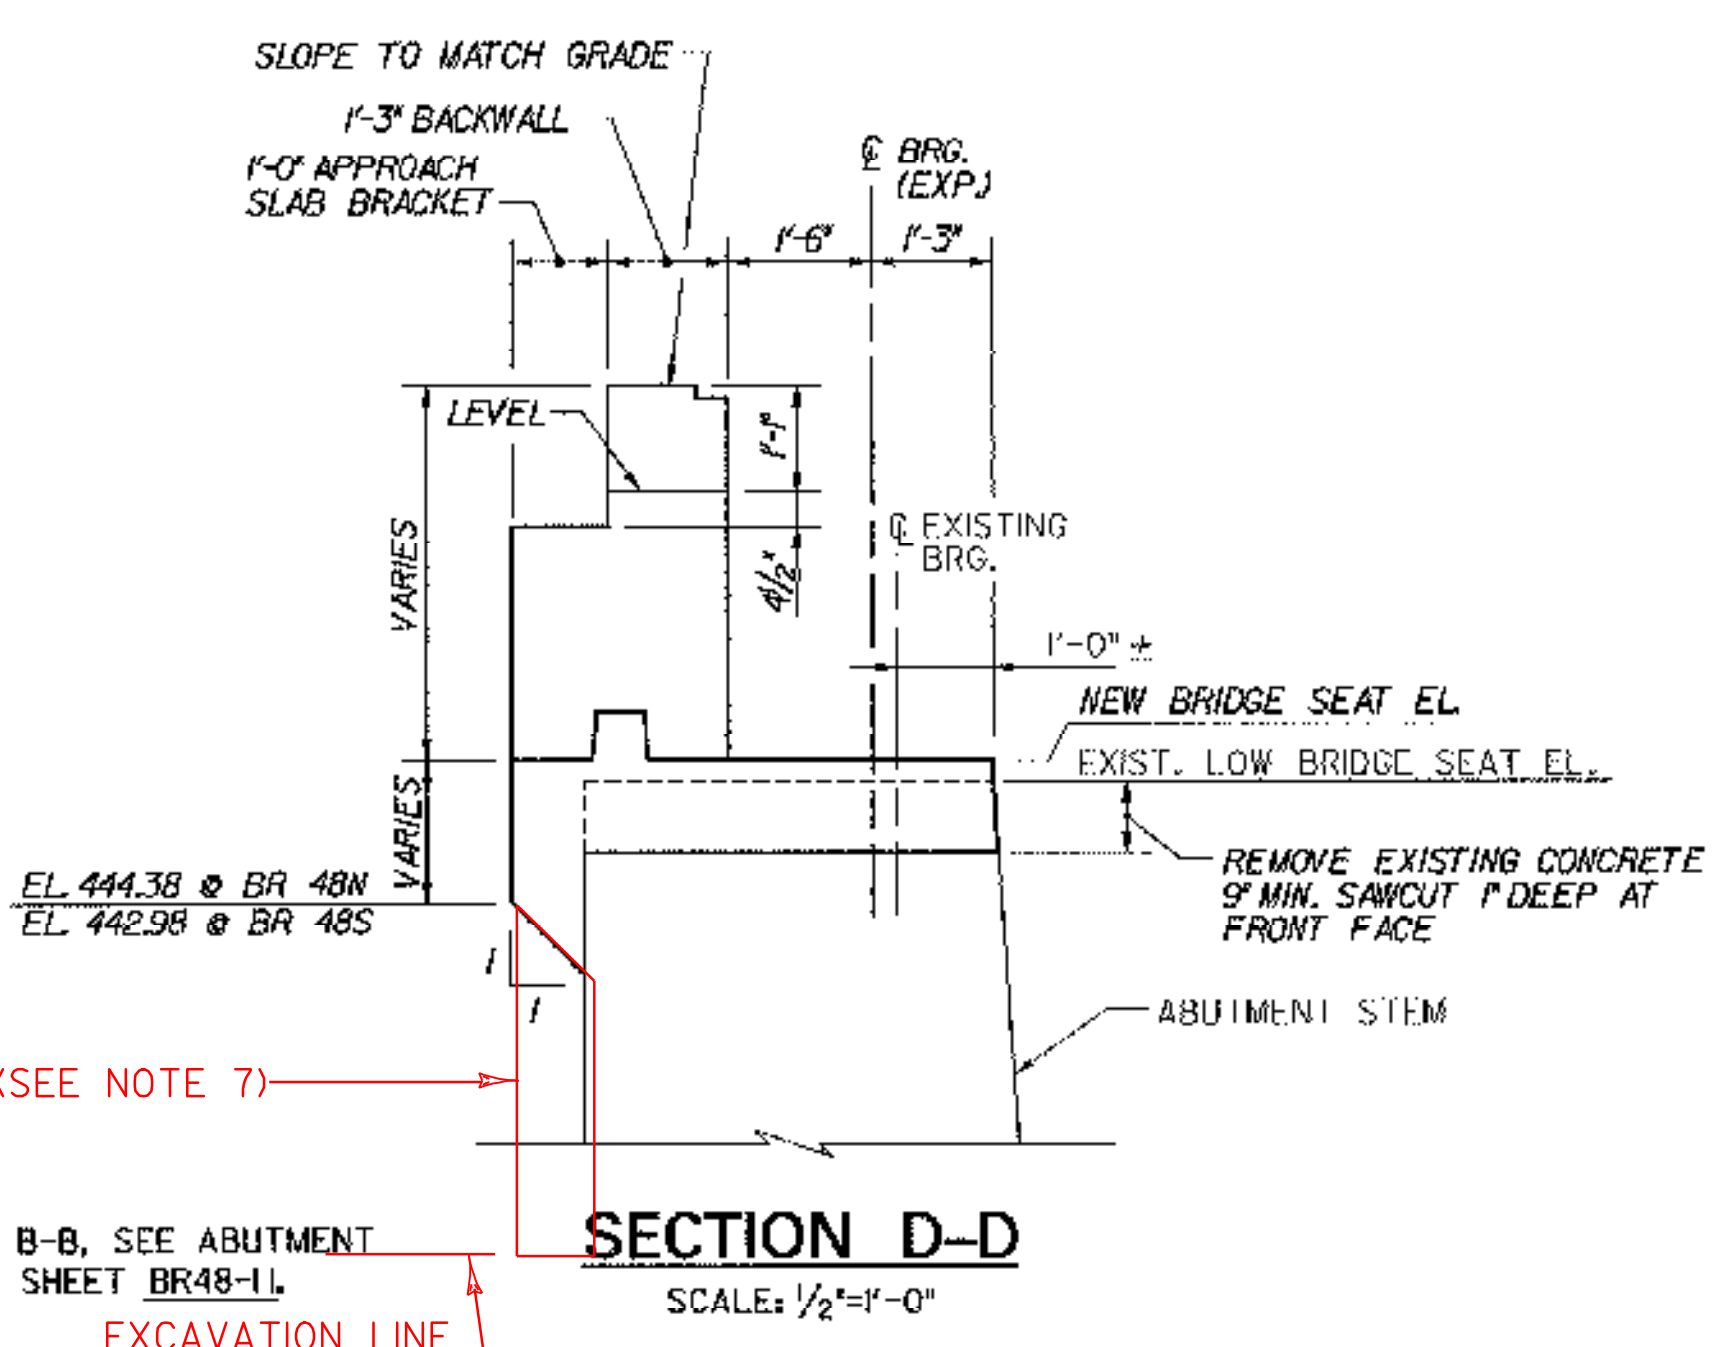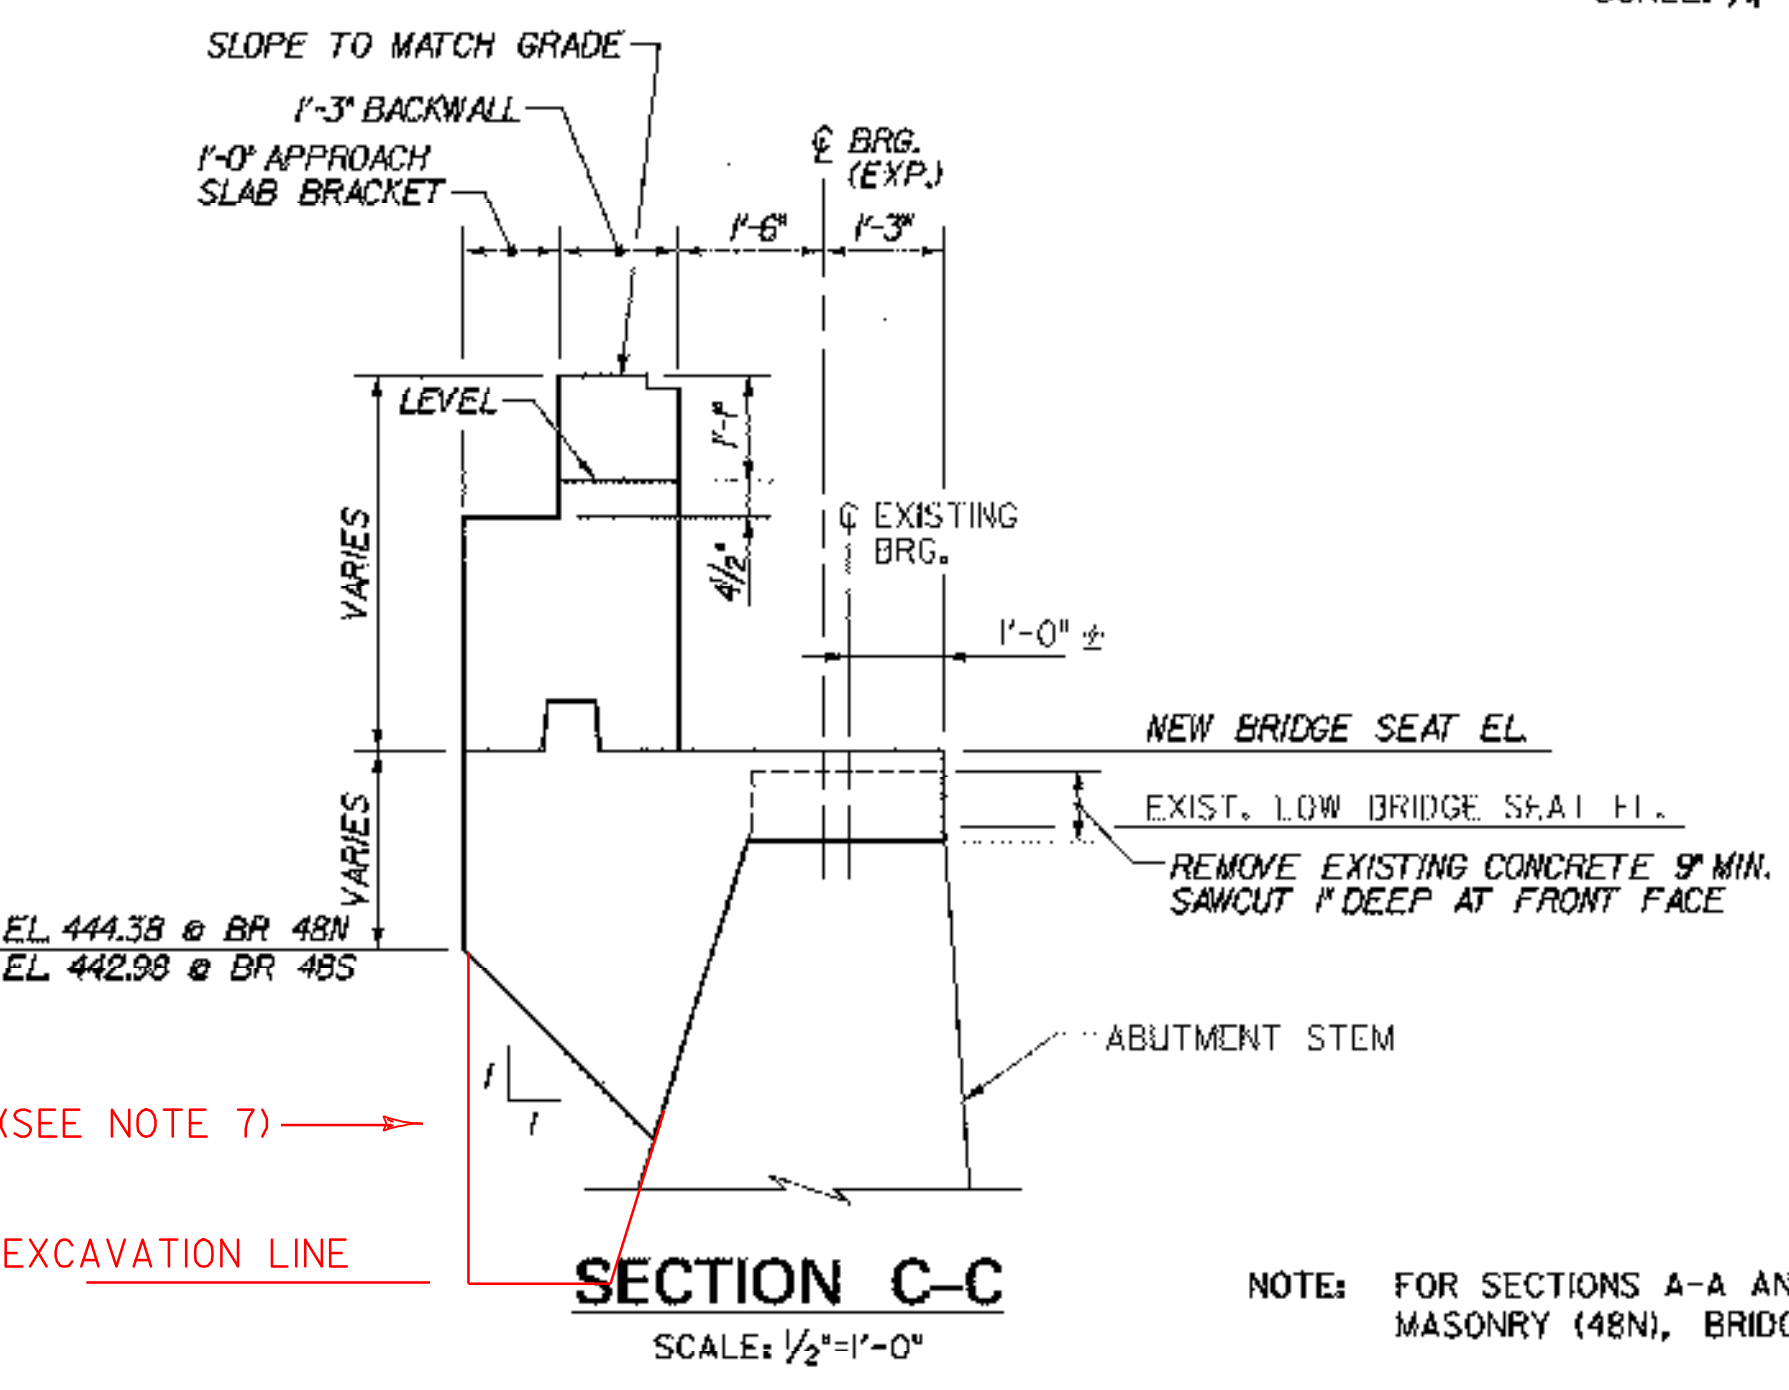


**NOTES:**

- CONSTRUCTION JOINT LOCATED AT STEP IN BRIDGE SEAT. LOCATION SHALL BE REVISED AS DIRECTED BY THE RESIDENT ENGINEER AS REQUIRED TO MATCH ANY CONSTRUCTION JOINT IN THE EXISTING ABUTMENT STEM.
- FOR WINGWALL AND CHEEKWALL DIMENSIONS, DETAILS AND ELEVATIONS, SEE TYPICAL WINGWALL DETAILS, BRIDGE SHEETS C-43 AND C-44.
- BACKWALL ELEVATIONS SHOWN AT FRONT FACE OF BACKWALL.
- FOR ABUTMENT REINFORCEMENT DETAILS, SEE TYPICAL EXPANSION ABUTMENT REINFORCEMENT, BRIDGE SHEET C-40, AND TYPICAL FIXED ABUTMENT REINFORCEMENT, BRIDGE SHEET C-41.
- STEPS IN BRIDGE SEATS SHALL BE EQUIDISTANT BETWEEN STRINGERS.
- REPAIR ALL EXISTING SPALLED AND DELAMINATED AREAS ON ABUTMENT. SEE EXISTING SUBSTRUCTURE CONDITION, BRIDGE SHEETS SC-5 THROUGH SC-10 FOR APPROXIMATE CONDITION OF EXISTING SUBSTRUCTURES. FOR CONCRETE REPAIR DETAILS, SEE SUBSTRUCTURE REPAIR DETAILS AND NOTES, BRIDGE SHEET C-45.

7. APPLIES TO BRIDGES 48N AND S. THE CONTRACTOR FOR EASE OF FORMING FORMED THE BACK OF THE EXPANSION ABUTMENT STRAIGHT DOWN TO THE BOTTOM OF THE EXCAVATION. THEY INSTALLED EXTRA REBAR IN THE AREA. ALL MATERIAL AND LABOR WAS AT THE EXPENSE OF THE CONTRACTOR

<b>STATE OF VERMONT AGENCY OF TRANSPORTATION</b>			
Town Of	MIDDLESEX-BOLTON	Bridge No.	485
Highway No.	I-89	Log Sta.	
		Surv. Sta.	
I-89 SB OVER LITTLE RIVER			
<b>ABUTMENT MASONRY (48S)</b>			
Designed By	P.W. SZUSTAK	Drawn By	R.A. BOTZENHART
Checked By	Date	Bridge Design Supervisor	Date
J.P. HALSTEAD	10/99	J.P. HALSTEAD	Date 10/99
PROJECT	MIDDLESEX-BOLTON	PROJECT NO.	IM-089-2(26)
TVGA CAD Drawing No.	48abmas	Date	10/99
Bridge Sheet No.	BR48-12	Sheet	72 of 307

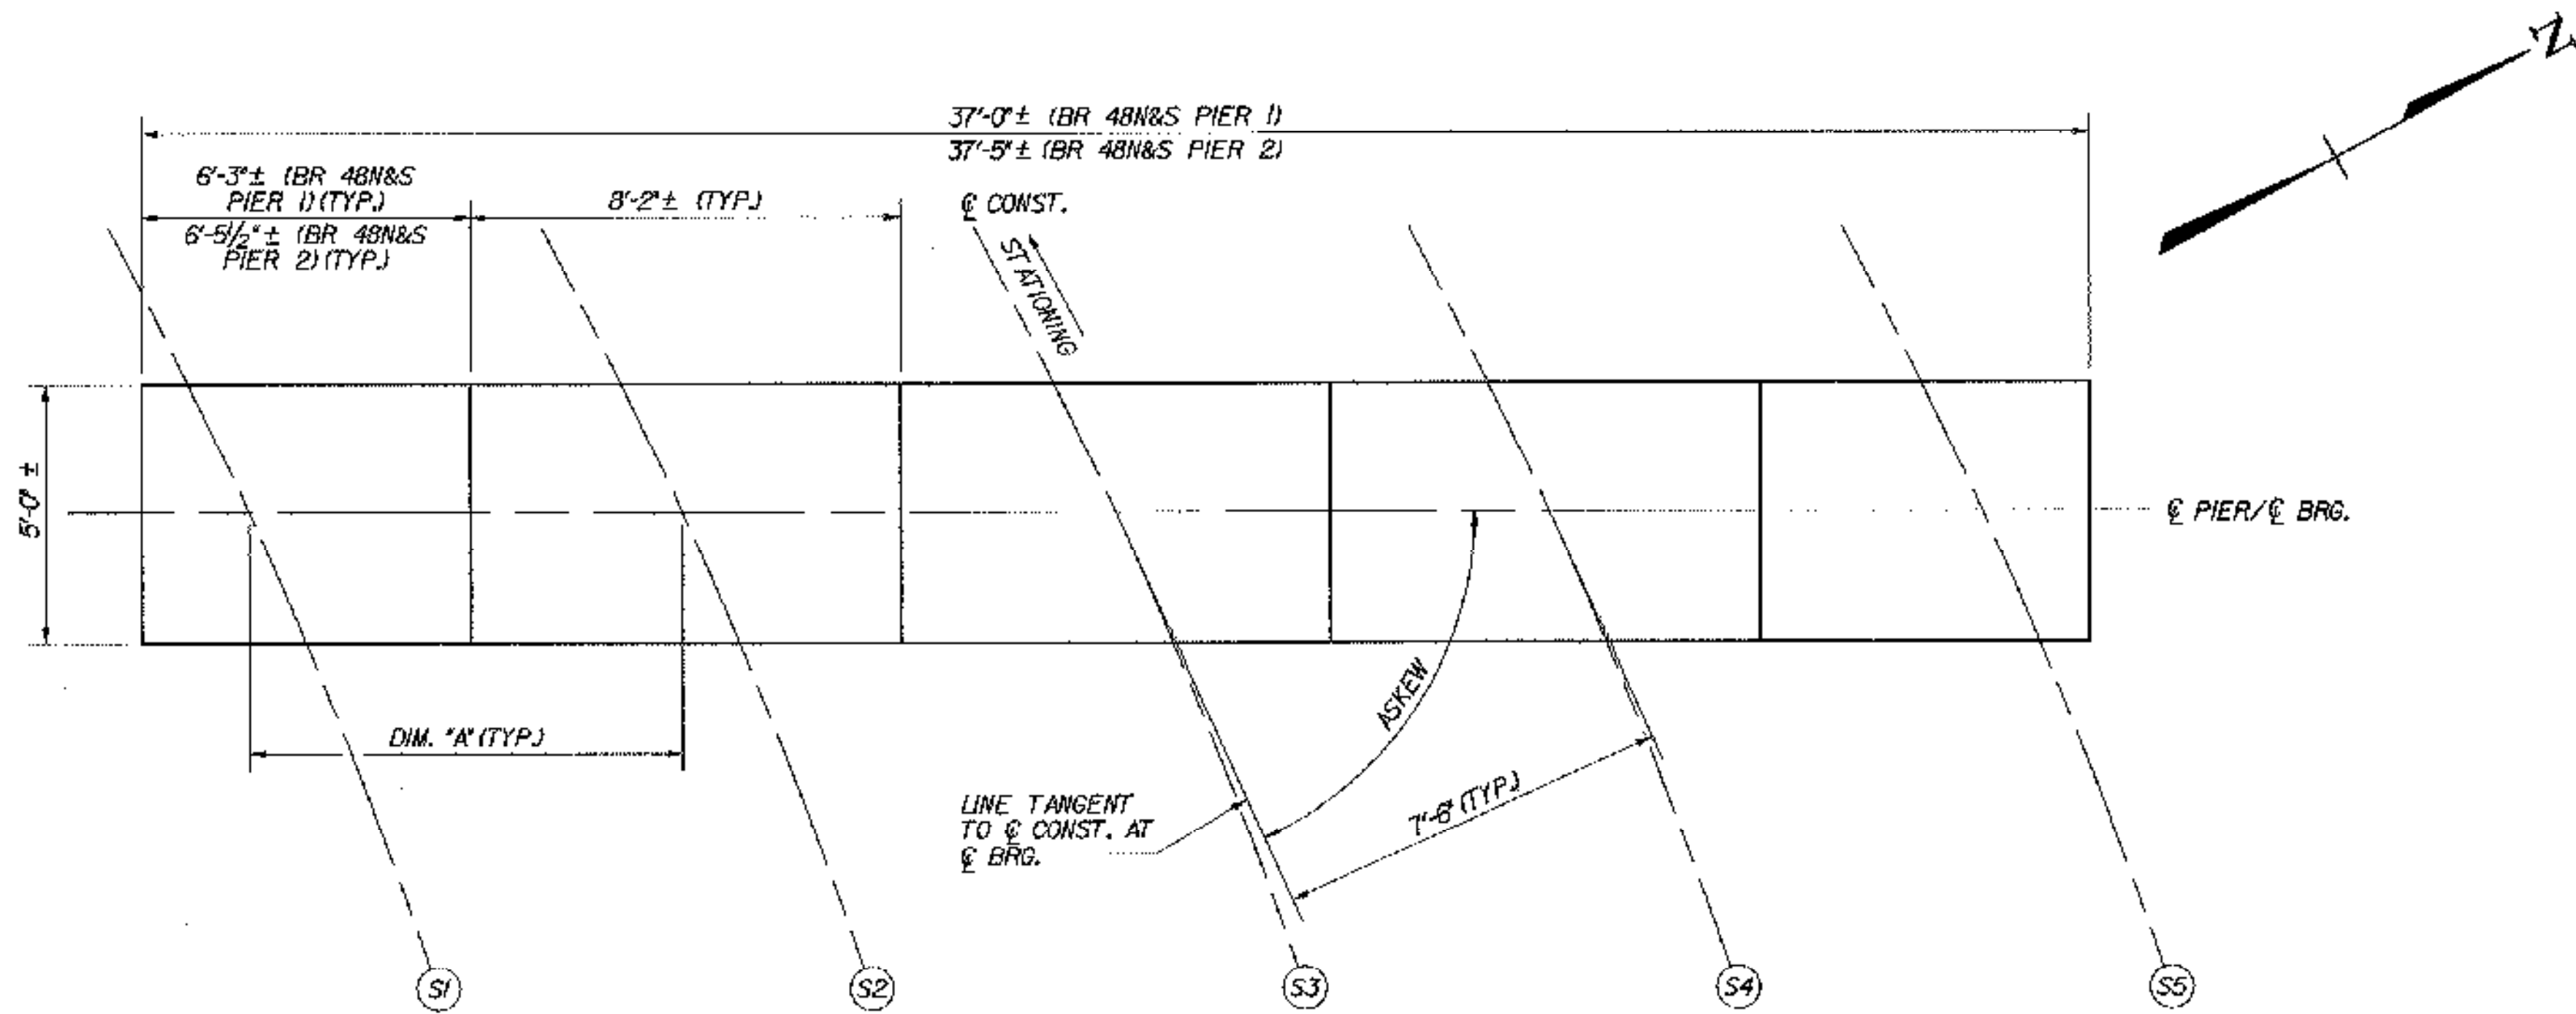


**TYPICAL PIER CAP PLAN**  
SCALE: 3/8"=1'-0"

RAISED BM SEAT ELEVATIONS 4" SO AS TO GET PROPER CLR. FOR REINFORCING STEEL

BRIDGE	PIER	STA.	ASKEW ANGLE	DIM. "A"	CL BEARING DIRECTION	BEARING SEAT ELEVATIONS AT CL BRG. (SEE NOTE 1)				
						S1	S2	S3	S4	S5
48N	1	5+08.26	65°16'48.3"	8'-3 1/16"	N 43°04'06.4" E	444.83	445.12	445.42	445.72	446.01
	2	6+05.35	63°58'13.7"	8'-4 3/16"	N 43°04'06.4" E	445.36	445.66	445.96	446.25	446.55
48S	1	5+33.37	66°00'44.7"	8'-3 5/16"	N 42°52'44.4" E	445.01	445.31	445.61	445.90	446.20
	2	6+32.79	63°40'31.2"	8'-4 7/16"	N 42°52'44.4" E	445.54	445.85	446.13	446.42	446.72

RAISED PIER CAP GRADES 0.17 FT.

48S RAISED BM SEAT ELEVATIONS 2" SO AS TO GET PROPER CLEARANCE FOR REINFORCING STEEL.

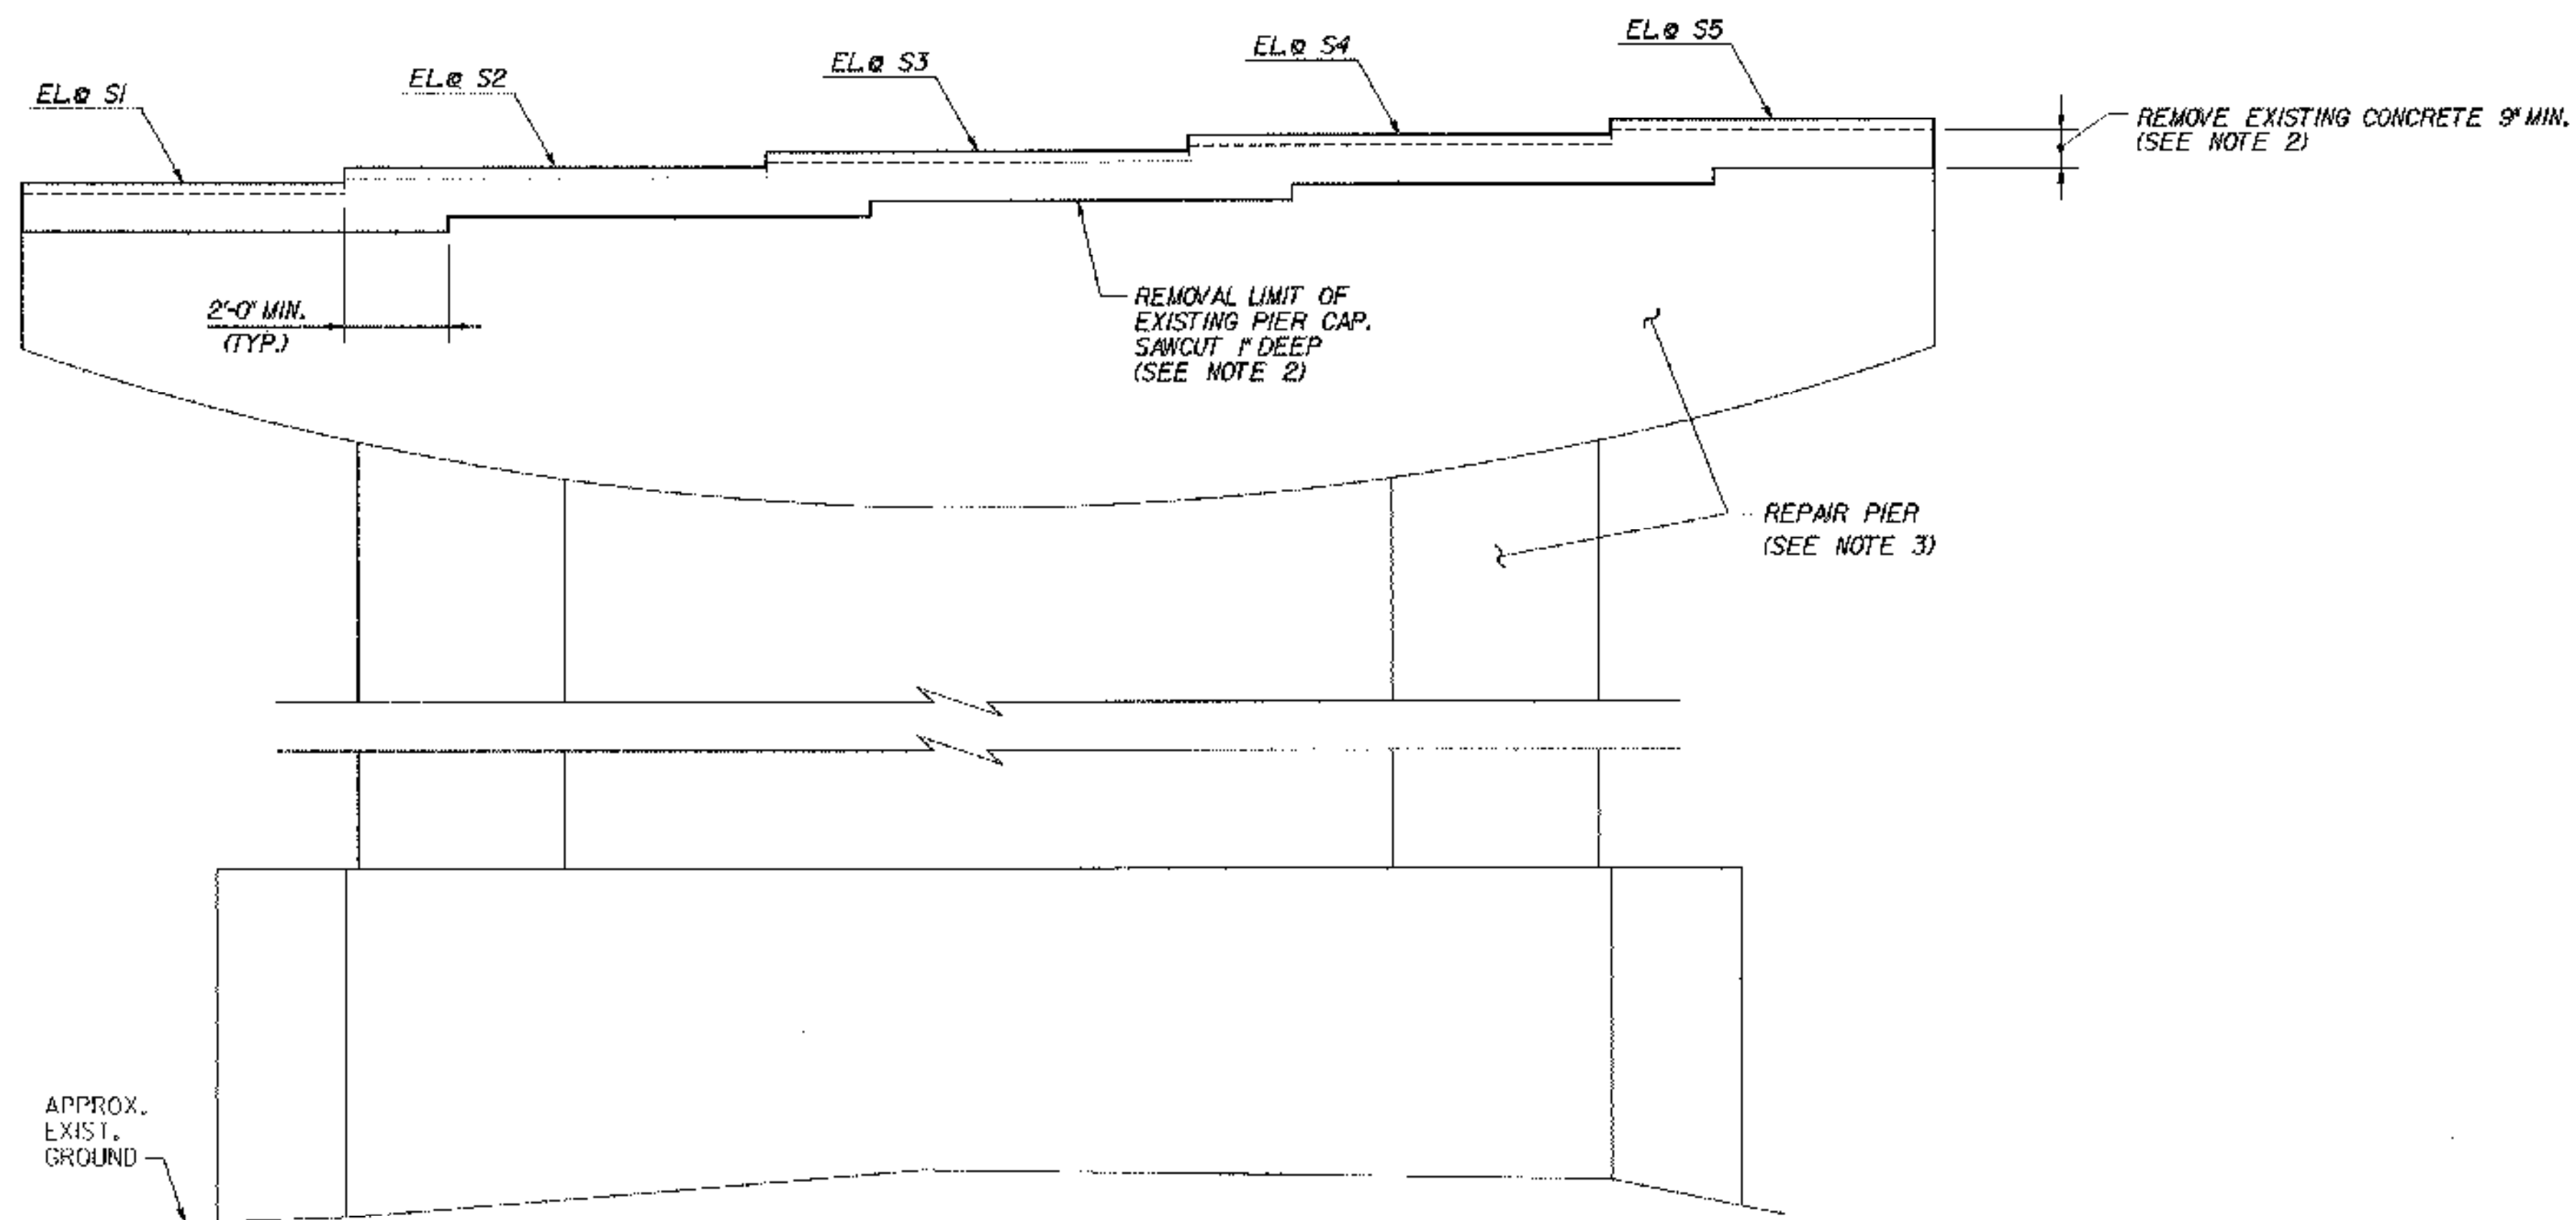

**TYPICAL PIER ELEVATION**  
SCALE: 3/8"=1'-0"


**NOTES:**

1. AS REQUIRED BY THE BEARING DESIGN, THE NEW BEARING SEATS SHALL BE SLOPED TO MATCH THE  $\phi$  CONST. GRADE.
2. ALL EXISTING REINFORCEMENT IN THE PIER CAP TO REMAIN. REMOVAL LIMITS SHALL EXTEND 3" MINIMUM BELOW EXISTING LONGITUDINAL REINFORCEMENT.
3. REPAIR ALL EXISTING SPALLED AND DELAMINATED AREAS ON PIER. SEE EXISTING SUBSTRUCTURE CONDITION, BRIDGE SHEETS SC-5 THROUGH SC-10 FOR APPROXIMATE CONDITION OF EXISTING SUBSTRUCTURES. FOR CONCRETE REPAIR DETAILS, SEE SUBSTRUCTURE REPAIR DETAILS AND NOTES, BRIDGE SHEET C-45.

**STATE OF VERMONT  
AGENCY OF TRANSPORTATION**

Town Of	MIDDLESEX-BOLTON	Bridge No.	48N&S
Highway No.	I-89	Log Sta.	
		Surv. Sta.	
I-89 OVER LITTLE RIVER			
<b>PIER CAP MASONRY (48N&amp;S)</b>			
Designed By	P.W. SZUSTAK	Drawn By	R.A. BOTZENHART
Checked By	J.P. HALSTEAD	Date	10/99
		Bridge Design Supervisor	J.P. HALSTEAD Date 10/99
PROJECT	MIDDLESEX-BOLTON	PROJECT NO.	IM-089-2(26)
TVGA CAD Drawing No.	48piermas	Date	10/99
Bridge Sheet No.	BR48-13	Sheet	73 of 307



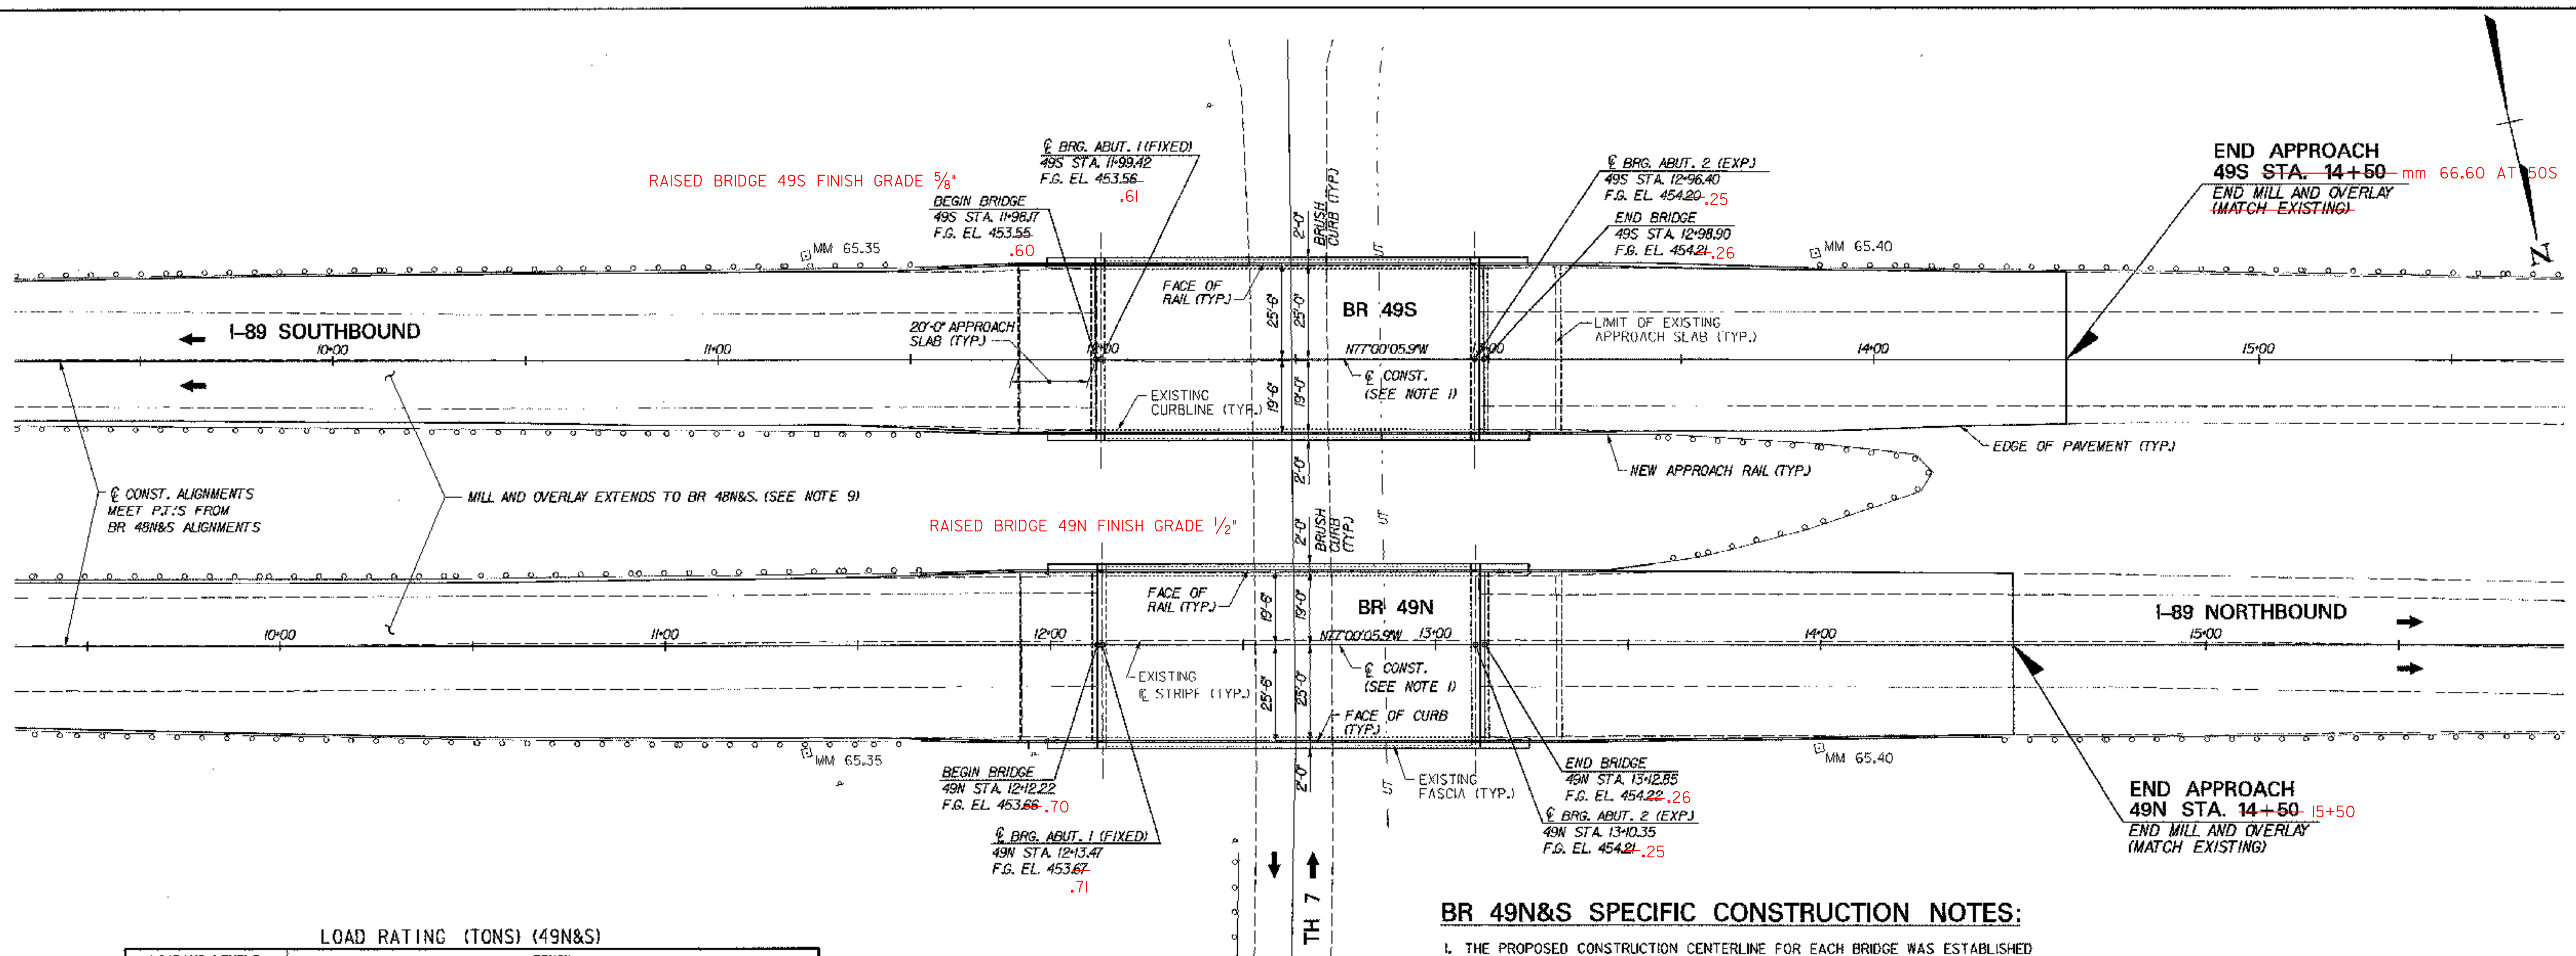

**BR 49N&S SPECIFIC CONSTRUCTION NOTES:**

1. THE PROPOSED CONSTRUCTION CENTERLINE FOR EACH BRIDGE WAS ESTABLISHED BASED ON BEST FIT BETWEEN EXISTING CURB LINES. IT DOES NOT EXACTLY MATCH THE ORIGINAL CONSTRUCTION CENTERLINE.
2. ADDITIONAL CONTROL POINTS ARE LOCATED ADJACENT TO BR 49N&S, AS SHOWN ON GENERAL PLAN (49N&S), BRIDGE SHEET BR48-I. FOR CONTROL POINT TIE SKETCHES, SEE CONTROL POINT TIES (49N&S AND 49S&S), BRIDGE SHEET C-11.
3. REMOVE SCUPPERS. REPLACE DECK SLABS, SHEAR CONNECTORS, APPROACH SLABS, BRIDGE RAIL AND APPROACH RAIL. RESET GUARD RAIL.
4. NEW SCUPPERS ARE NOT REQUIRED ON THESE BRIDGES.
5. AT EXPANSION ABUTMENTS, CONSTRUCT NEW BACKWALLS, REBUILD BRIDGE SEATS AND MODIFY WINGWALLS AS SHOWN IN THE PLANS. INSTALL NEW ELASTOMERIC BEARINGS. INSTALL NEW BEARING STIFFENERS AND DIAPHRAGMS.
6. AT FIXED ABUTMENTS, CONSTRUCT NEW CURTAINWALLS AND MODIFY WINGWALLS AS SHOWN IN THE PLANS. AT FASCIA STRINGERS, REPLACE BEARINGS IN KIND. AT INTERIOR STRINGERS, JACK, CLEAN, PAINT AND GREASE EXISTING BEARINGS.
7. REPAIR ABUTMENT DELAMINATED AND SPALLED AREAS.
8. REMOVE 100% OF EXISTING PAINT COATING FROM EXISTING STRUCTURAL STEEL. PAINT EXISTING AND NEW STRUCTURAL STEEL.
9. MILL AND OVERLAY EXTENDS TO BR 49N&S. FOR BEGIN LIMITS OF MILL AND OVERLAY, SEE GENERAL PLAN (49N&S), BRIDGE SHEET BR48-I.
10. RE-STRIPE BRIDGE AND APPROACH ROADWAY.
11. THE CONTRACTOR SHALL MAINTAIN A MINIMUM 12' WIDE TRAFFIC LANE AT ALL TIMES ON TH 7. FOR ADDITIONAL TRAFFIC CONTROL REQUIREMENTS, SEE TRAFFIC CONTROL NOTES, BRIDGE SHEETS TC-1A AND TC-1B.

**LOAD RATING (TONS) (49N&S)**



LOADING LEVELS (LOAD FACTOR)	TRUCK						
	H	HS	3S2	6 AXLE	3A. STR.	4A. STR.	5A. SEMI
INVENTORY A= 2.17; B= 1.00	52	76					
POSTED A= 1.55; B= 1.40	73	107	124		100	102	115
OPERATING A= 1.30; B= 1.67		127	147	171	118	121	

STRENGTH RF =  $\frac{\phi M_n - 1.3 M_{DL}}{A X M_{LL1}}$

\* SERVICEABILITY RF =  $B \left[ \frac{0.95 F_y S_{LL1} - M_{DL} \frac{S_{LL1}}{S_{DL}} - M_{SDL} \frac{S_{LL1}}{S_{SDL}}}{187 M_{LL1}} \right]$

**TABLE OF BRIDGE COORDINATES**

BRIDGE	CL CONST. @	STATION	NORTHING	EASTING
49N	BEGN BRIDGE	12+12.22	75550.9332	67081.1808
	CL BRG. ABUT. 1	12+13.47	75551.2144	67079.9828
	CL BRG. ABUT. 2	13+10.35	75573.0049	66985.5853
	END BRIDGE	13+12.85	75573.5872	66983.1293
49S	BEGN BRIDGE	11+98.17	75478.7754	67054.7699
	CL BRG. ABUT. 1	11+98.42	75479.0588	67083.5519
	CL BRG. ABUT. 2	12+96.40	75500.8898	66989.0569
	END BRIDGE	12+98.90	75501.4320	66986.6209

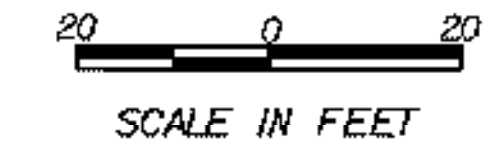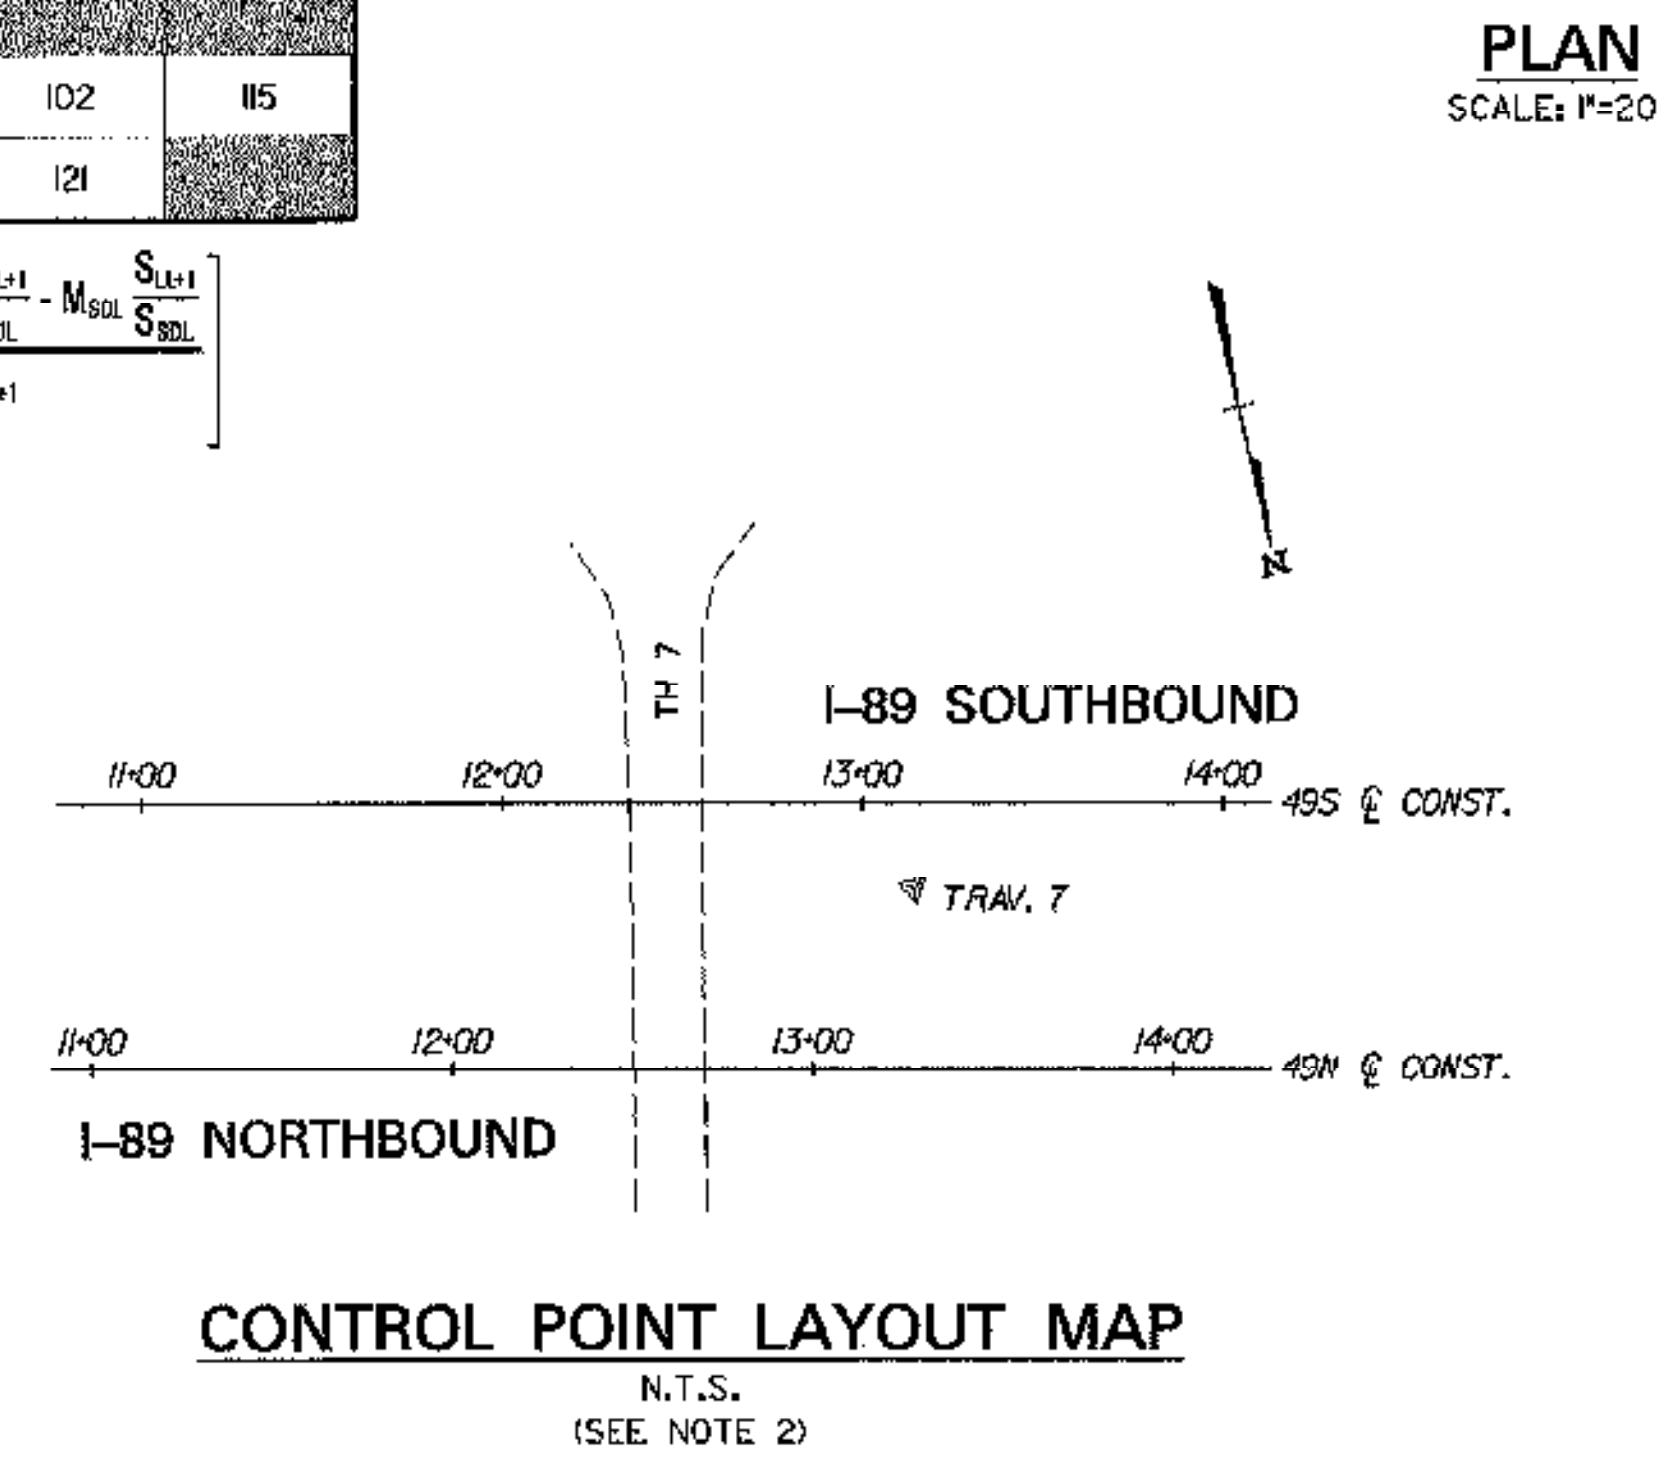

**STATE OF VERMONT**  
**AGENCY OF TRANSPORTATION**

Town Of **MIDDLESEX-BOLTON** Bridge No. **49N&S**

Highway No. **I-89** Log Sta.

**I-89 OVER TH 7**

**GENERAL PLAN (49N&S)**

Designed By **P.W. SZUSTAK** Drawn By **R.A. BOTZENHART**


Checked By **J.P. HALSTEAD** Date **10/99** Bridge Design Supervisor **J.P. HALSTEAD** Date **10/99**

PROJECT **MIDDLESEX-BOLTON** PROJECT NO. **IM-089-2(26)**


TVGA CAD Drawing No. **49gen pl** Date **10/99**

Bridge Sheet No. **BR49-1** Sheet **75** of **307**

NOTE: RAISED BRIDGE 49N FINISHED GRADE 1/2"

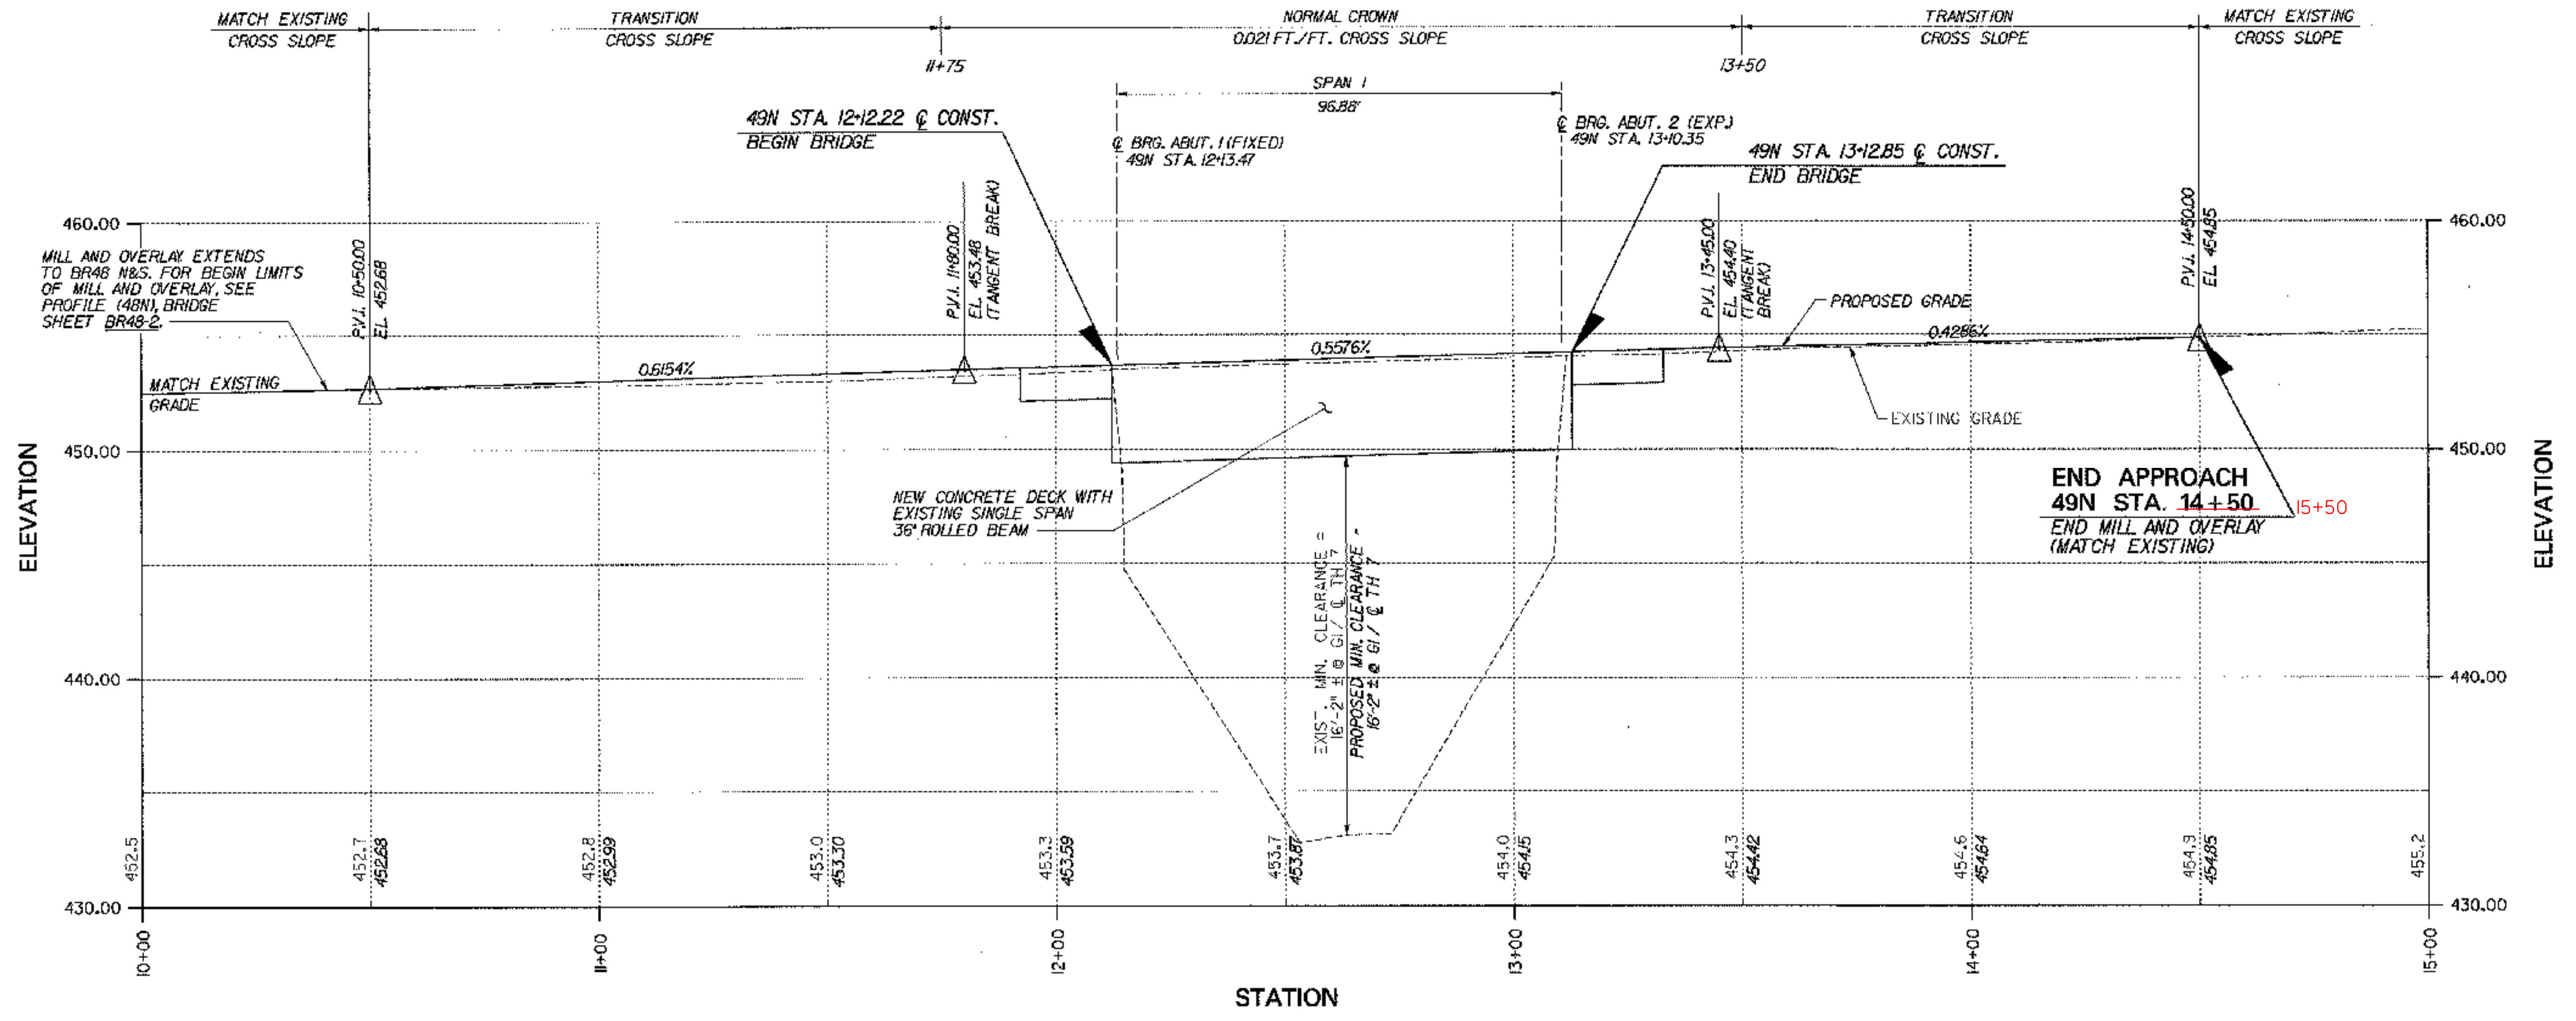




STATION  
PROFILE - BR 49N

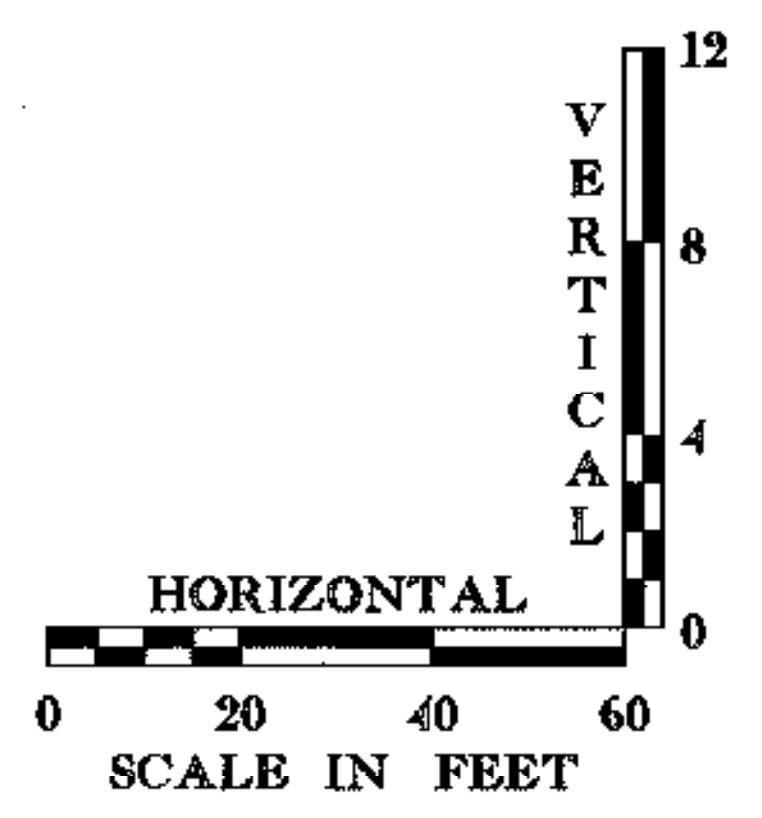





<b>STATE OF VERMONT AGENCY OF TRANSPORTATION</b>	
Town Of <b>MIDDLESEX-BOLTON</b>	Bridge No. <b>49N</b>
Highway No. <b>I-89</b>	Log Sta. Surv. Sta.
<b>I-89 NB OVER TH 7</b>	
<b>PROFILE (49N)</b>	
Designed By <b>P.W. SZUSTAK</b>	Drawn By <b>R.A. BOTZENHART</b>
Checked By <b>J.P. HALSTEAD</b> Date <b>10/99</b>	Bridge Design Supervisor <b>J.P. HALSTEAD</b> Date <b>10/99</b>
PROJECT <b>MIDDLESEX-BOLTON</b>	PROJECT NO. <b>IM-089-2(26)</b>
TVGA CAD Drawing No. <b>49nprof</b>	Date <b>10/99</b>
Bridge Sheet No. <b>BR49-2</b>	Sheet <b>76</b> of <b>307</b>

**TVGA** TVGA ENGINEERING,  
SURVEYING, P. C.

NOTE: RAISED BRIDGE 49S FINISH GRADE 5/8"

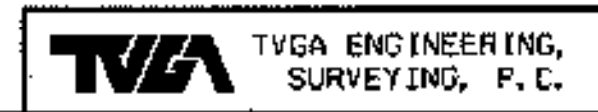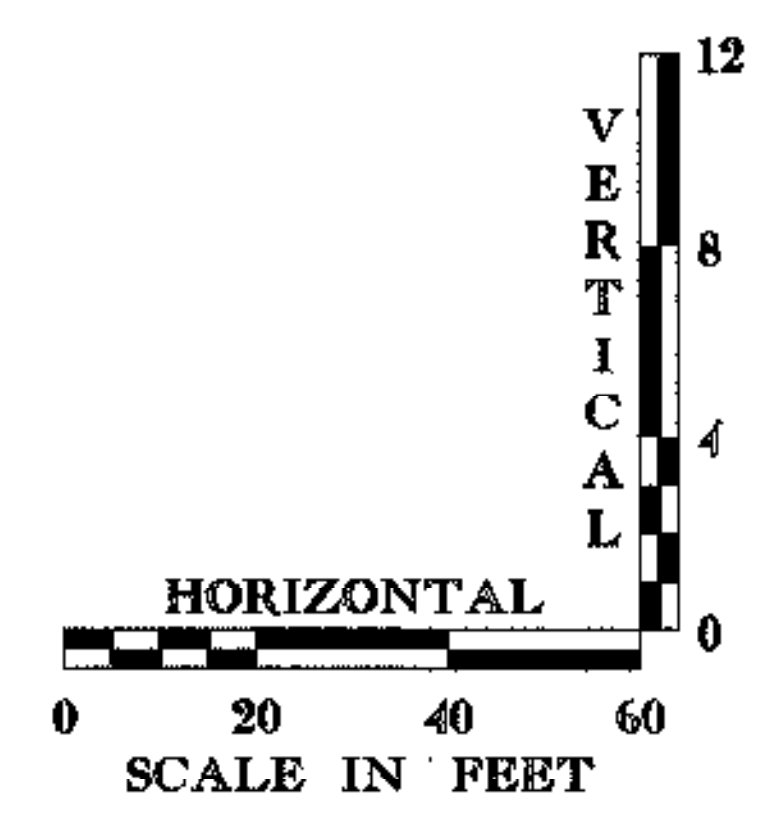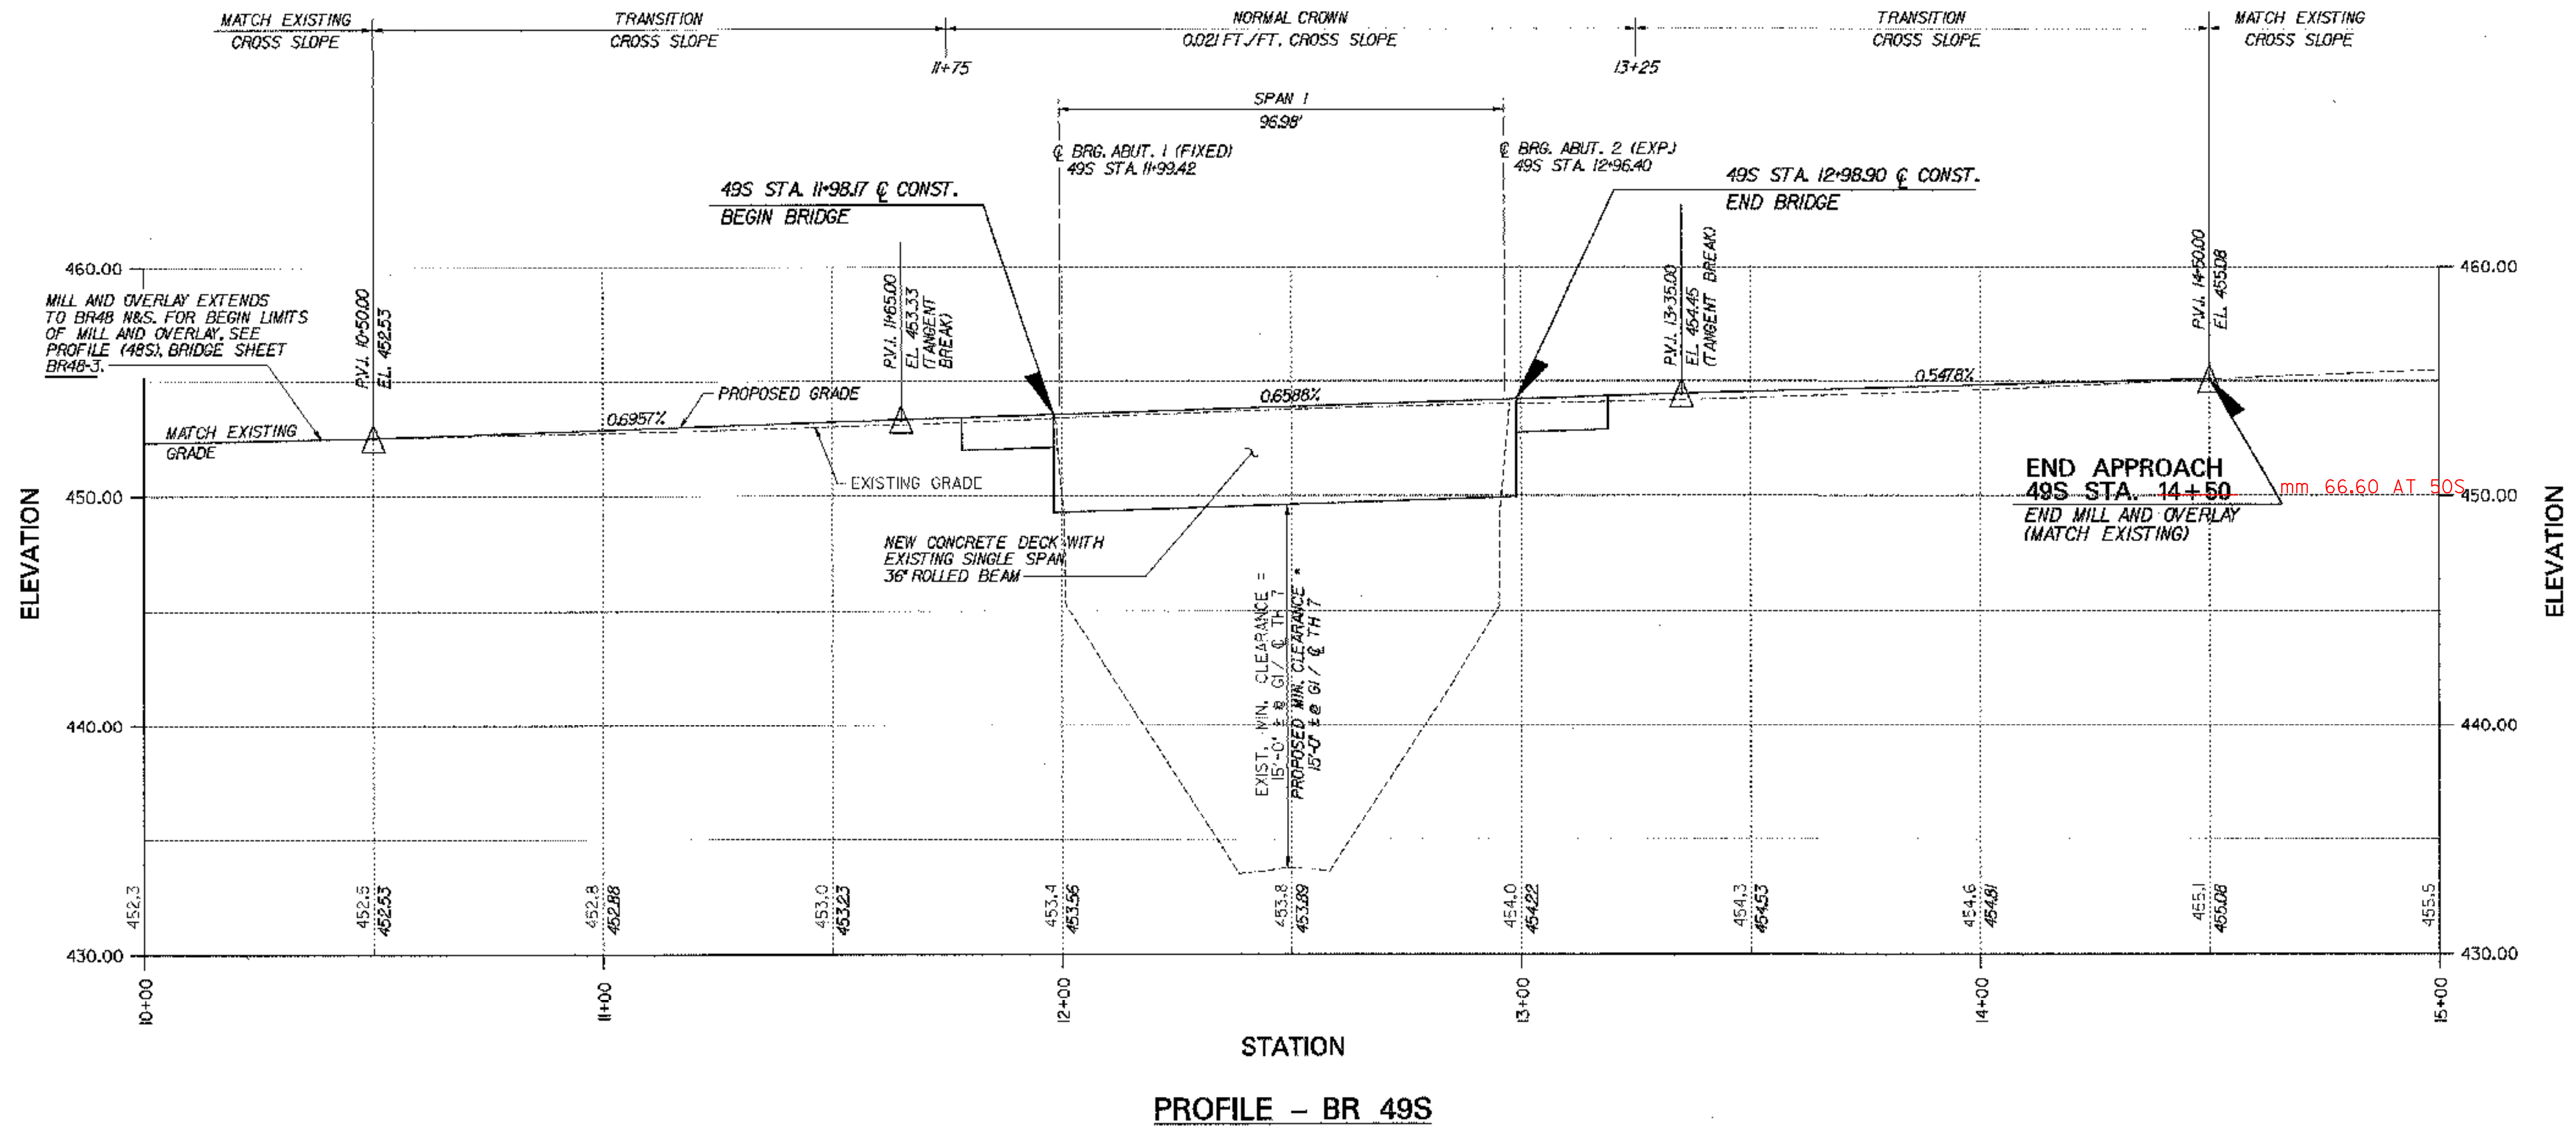


<b>STATE OF VERMONT AGENCY OF TRANSPORTATION</b>			
Town Of <b>MIDDLESEX-BOLTON</b>		Bridge No. <b>49S</b>	
Highway No. <b>I-89</b>		Log Sta. _____ Surv. Sta. _____	
<b>I-89 SB OVER TH 7</b>			
<b>PROFILE (49S)</b>			
Designed By <b>P.W. SZUSTAK</b>	Drawn By <b>R.A. BOTZENHART</b>		
Checked By <b>J.P. HALSTEAD</b>	Date <b>10/99</b>	Bridge Design Supervisor <b>J.P. HALSTEAD</b> Date <b>10/99</b>	
PROJECT <b>MIDDLESEX-BOLTON</b>		PROJECT NO. <b>IM-089-2(26)</b>	
TVGA CAD Drawing No. <b>49sprof</b>		Date <b>10/99</b>	
Bridge Sheet No. <b>BR49-3</b>		Sheet <b>77</b> of <b>307</b>	

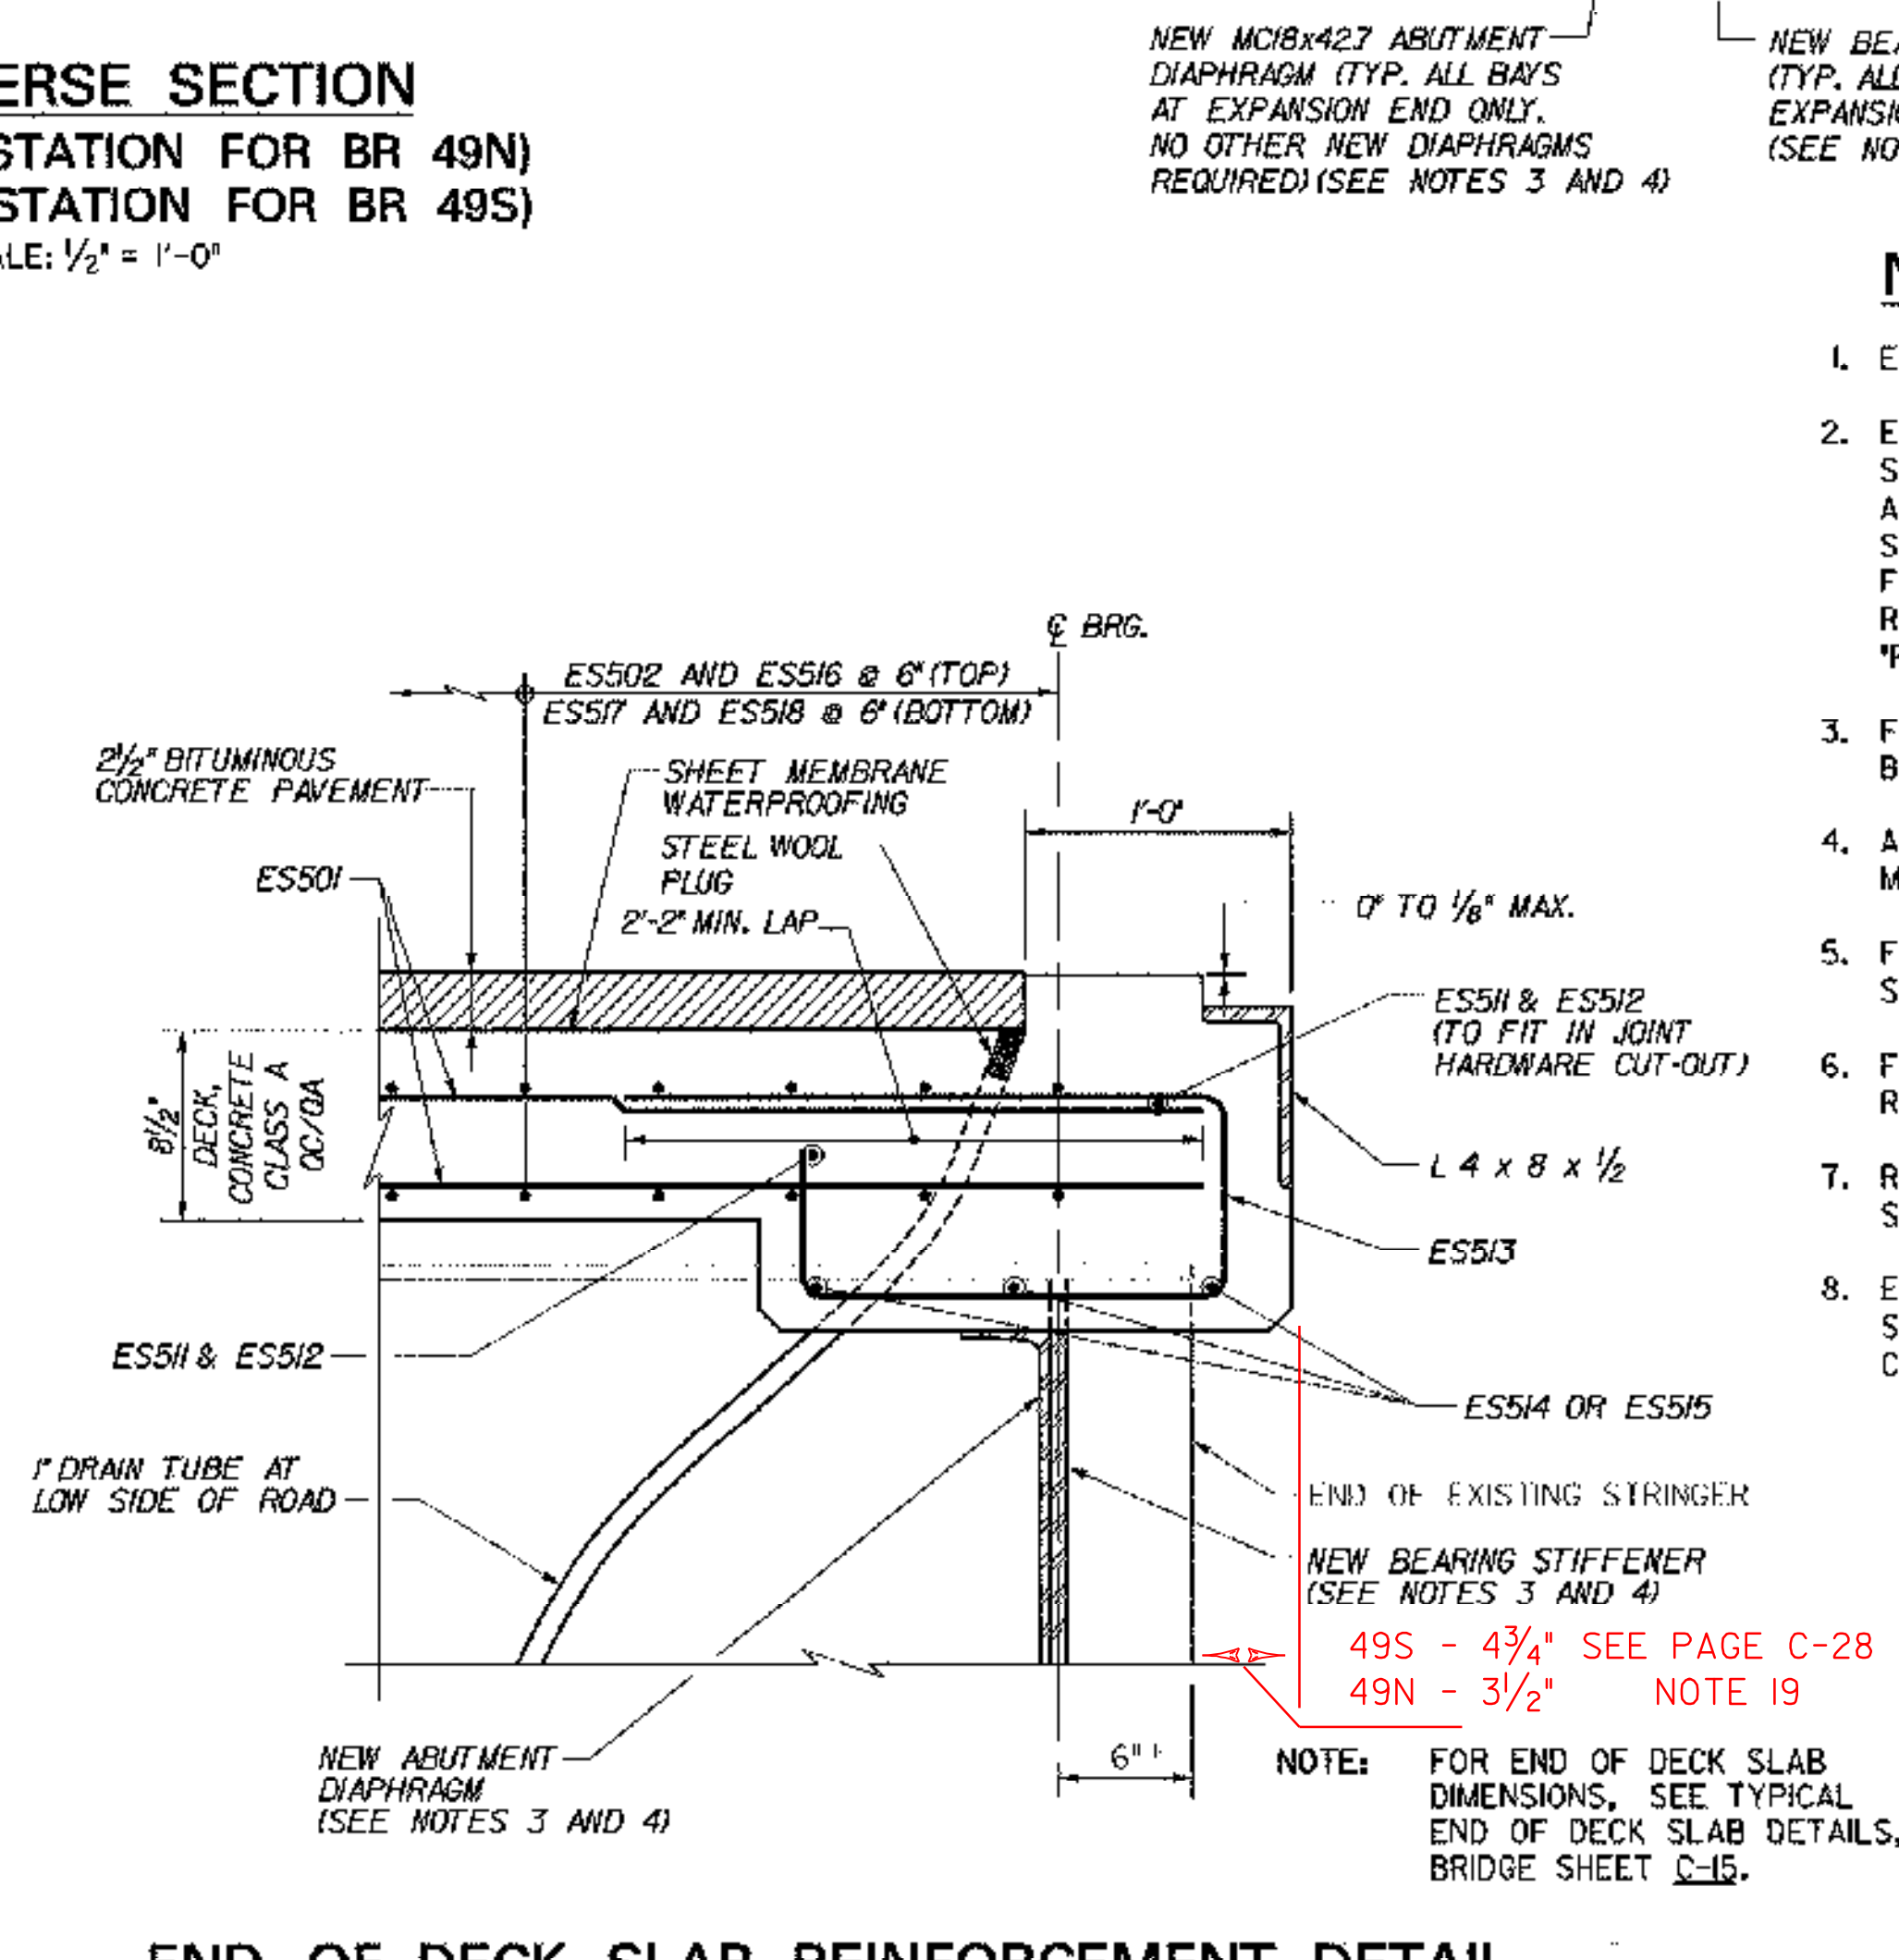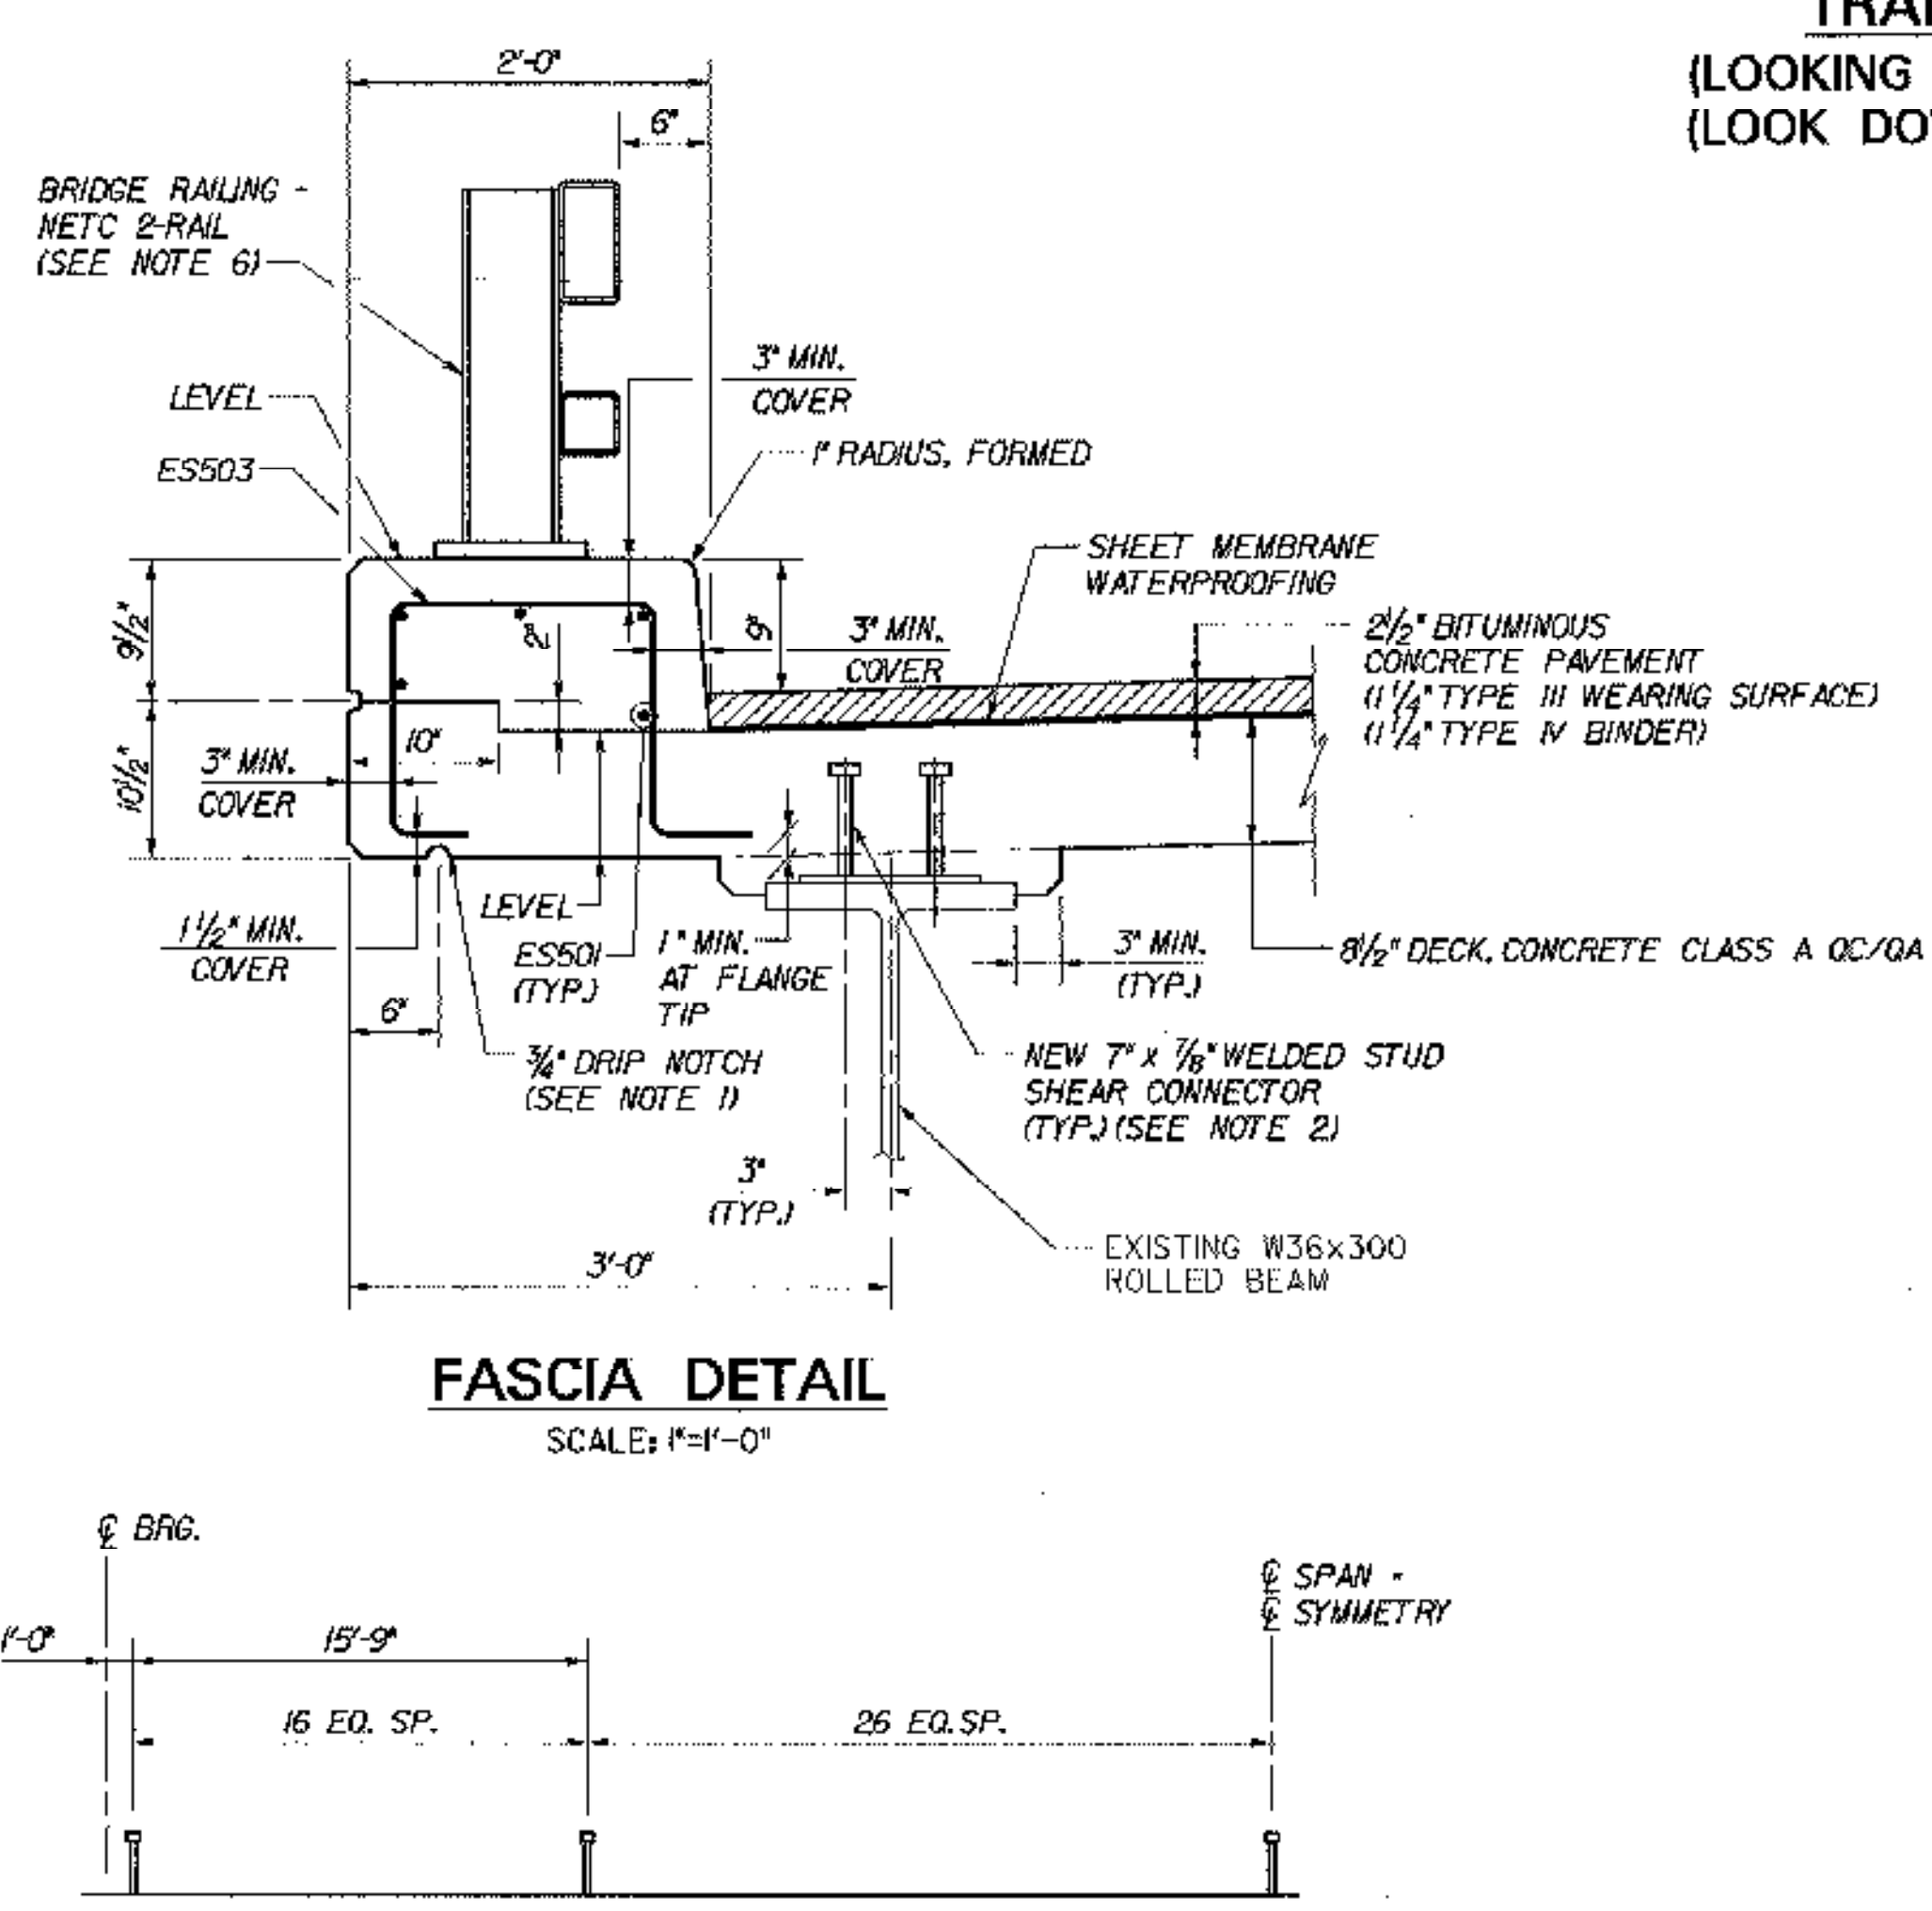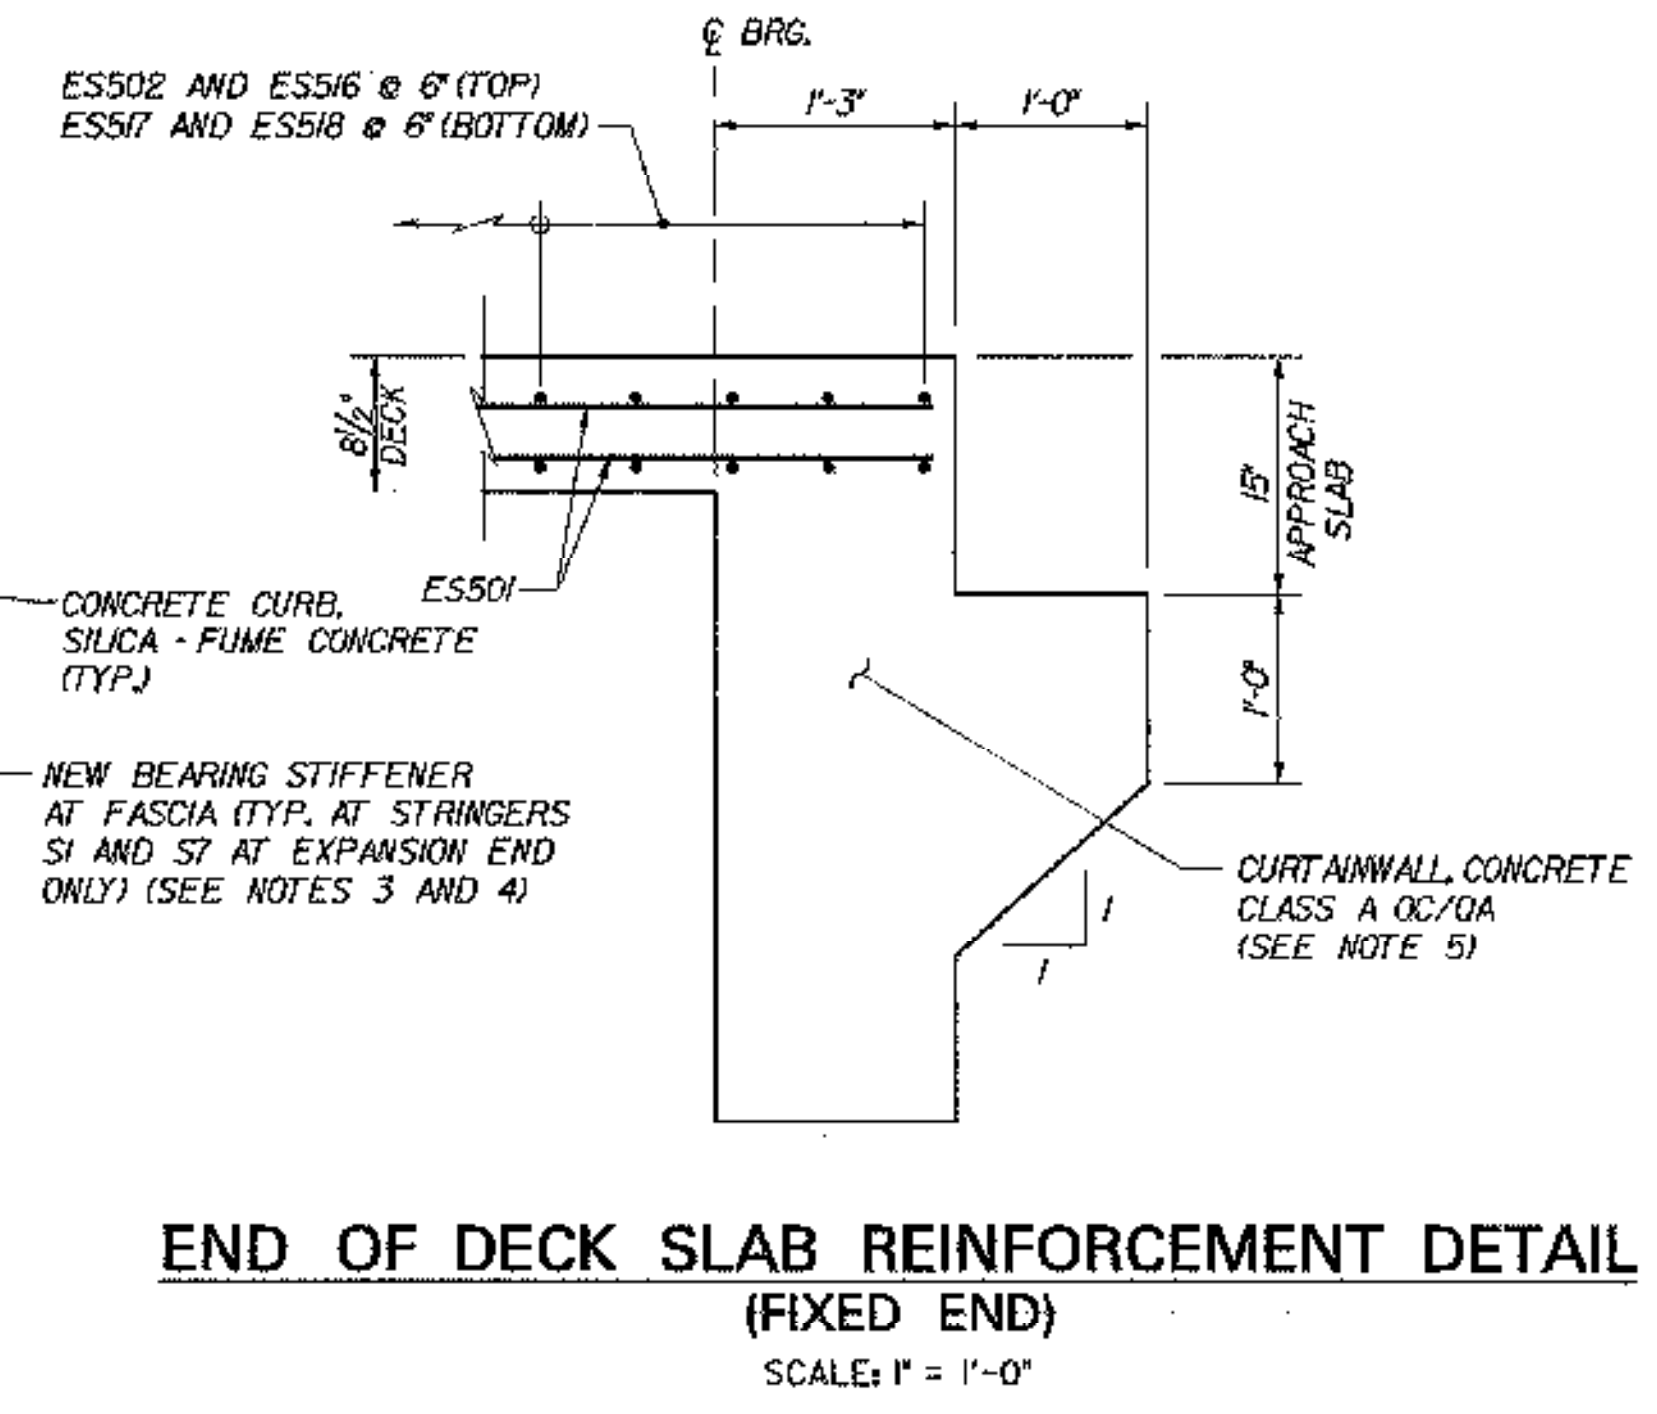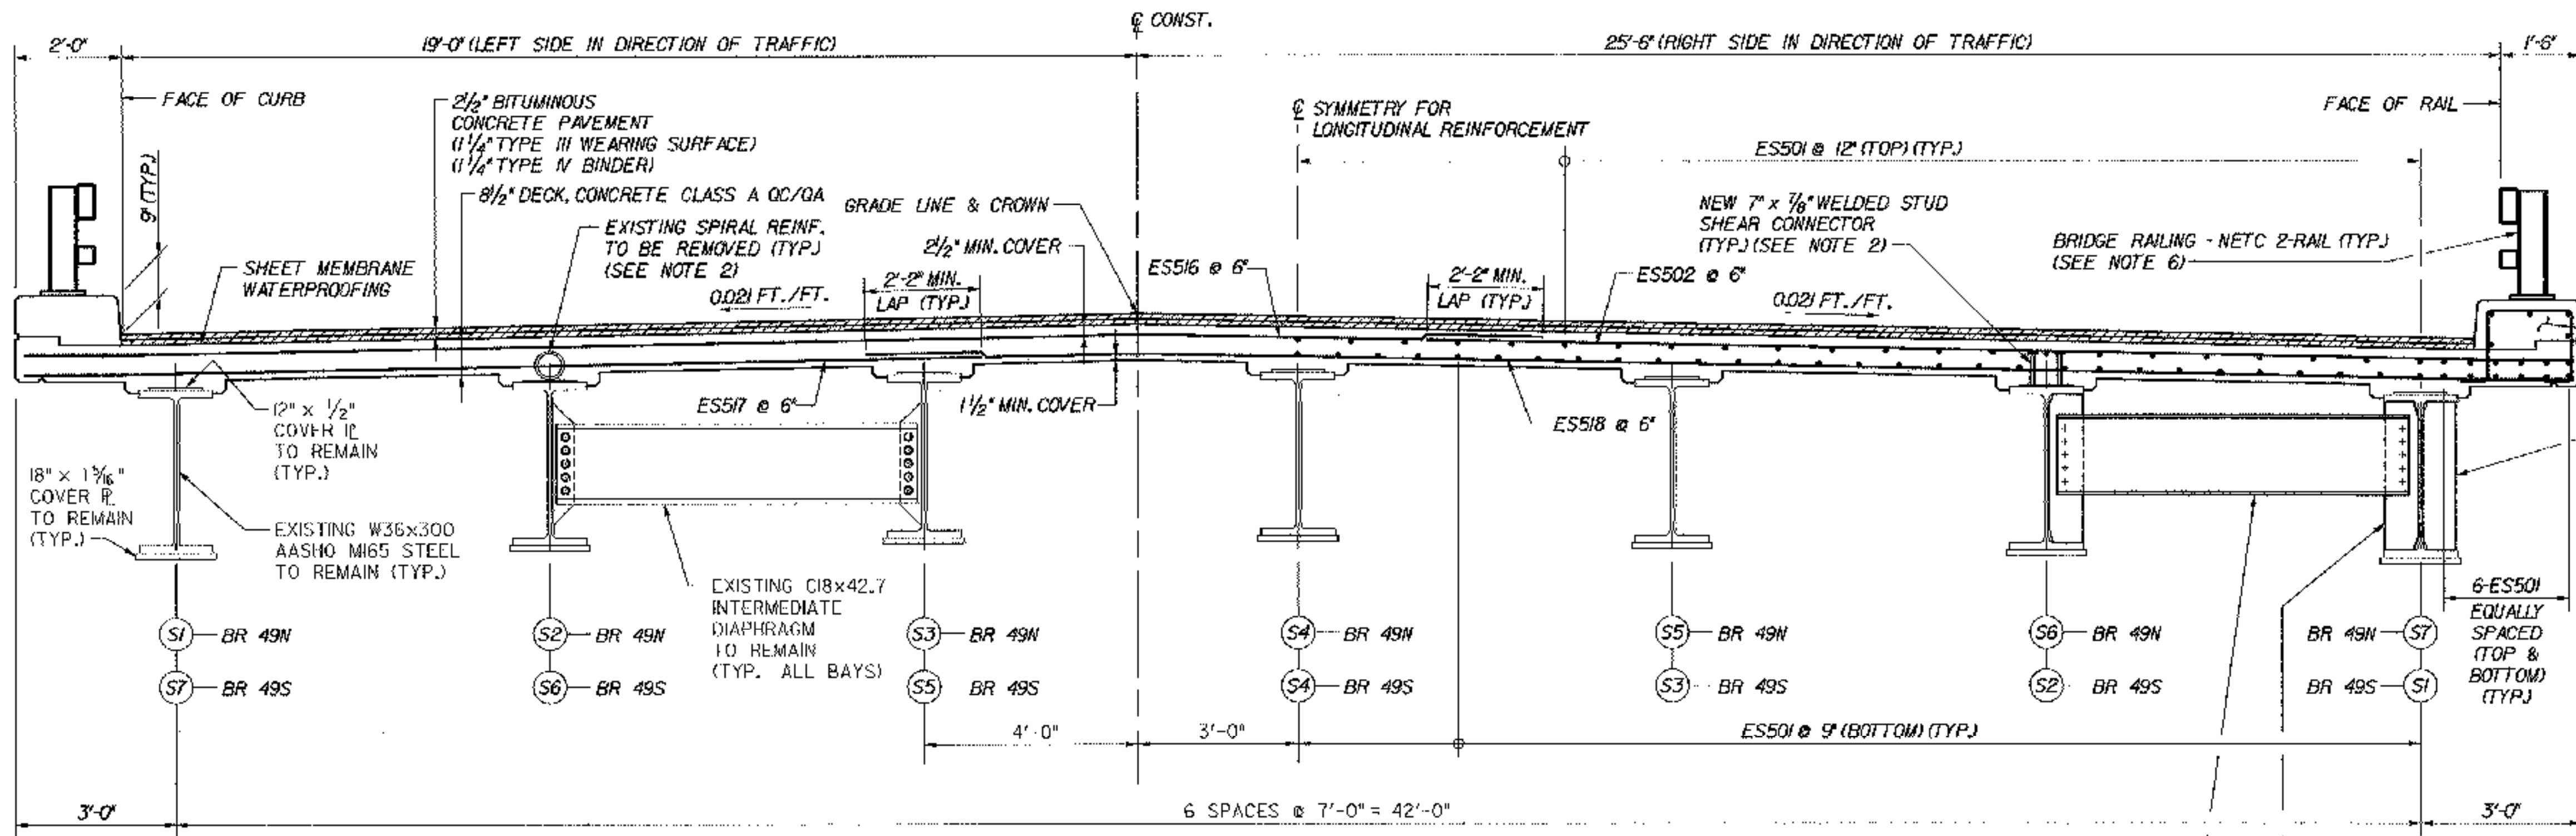


**NOTES:**


1. END DRIP NOTCH 5 FEET BEFORE END OF SLAB AT "DOWNHILL" ABUTMENTS AT 45°.
2. EXISTING SPIRAL REINFORCEMENT (IF ENCOUNTERED) SHALL BE REMOVED AND REPLACED WITH WELDED STUD SHEAR CONNECTORS, ITEM 508.15, AS SHOWN. EXISTING SHEAR STUDS (IF ENCOUNTERED) SHALL BE REMOVED AND REPLACED WITH WELDED SHEAR STUDS AT THE DISCRETION OF THE RESIDENT ENGINEER. THESE ATTACHMENTS SHALL BE CUT OFF SLIGHTLY ABOVE THE FLANGE, THEN REMAINING MATERIAL SHALL BE GROUND FLUSH WITH THE FLANGE. GRINDING SHALL BE DONE IN THE LONGITUDINAL DIRECTION SO THAT NO TRANSVERSE MARKS ARE LEFT. REMOVAL OF EXISTING SPIRAL REINFORCEMENT OR STUDS SHALL BE INCLUDED IN THE BID PRICE FOR ITEM 529.20, "PARTIAL REMOVAL OF STRUCTURE."
3. FOR DETAILS OF NEW BEARING STIFFENERS AND ABUTMENT DIAPHRAGMS, SEE TYPICAL ROLLED BEAM DETAILS, BRIDGE SHEET C-16.
4. ALL NEW STRUCTURAL STEEL SHALL BE AASHTO M270, GRADE 50W STEEL. BOLTS SHALL BE 7/8" DIAMETER AASHTO M-164 TYPE 3 BOLTS IN 1 5/16" DIAMETER HOLES.
5. FOR CURTAINWALL DETAILS AND REINFORCEMENT LAYOUT, SEE TYPICAL CURTAINWALL REINFORCEMENT, BRIDGE SHEET C-42.
6. FOR DETAILS OF NETC BRIDGE RAIL AND APPROACH SECTION, SEE STANDARD SHEETS BR1-97 AND BR3-97, AND GUARD RAIL APPROACH SECTION, NETC 2 RAIL, BRIDGE SHEETS C-46A AND C-46B.
7. REMOVE 100% OF EXISTING PAINT COATING FROM EXISTING STRUCTURAL STEEL. PAINT ALL NEW AND EXISTING STRUCTURAL STEEL, USING ITEMS 513.30, 513.36 AND 513.41. FINAL COAT TO BE DARK BROWN (COLOR CHIP #20059).
8. EXISTING SCUPPER DOWNSPOUTS SHALL BE REMOVED PRIOR TO REMOVAL OF DECK CONCRETE. REMOVAL OF WELDS SHALL BE PERFORMED BY GRINDING, IN ACCORDANCE WITH THE PROCEDURES SHOWN IN NOTE 2. THIS SHEET. ALL COSTS FOR THIS WORK SHALL BE SUBSIDIARY TO ITEM 529.20, "PARTIAL REMOVAL OF STRUCTURE".

<b>STATE OF VERMONT AGENCY OF TRANSPORTATION</b>	
Town Of <b>MIDDLESEX-BOLTON</b>	Bridge No. <b>49N&amp;S</b>
Highway No. <b>I-89</b>	Log Sta. <b></b> Surv. Sta. <b></b>
<b>I-89 OVER TH 7</b>	
<b>TRANSVERSE SECTION (49N&amp;S)</b>	
Designed By <b>P.W. SZUSTAK</b>	Drawn By <b>R.A. BOTZENHART</b>
Checked By <b>J.P. HALSTEAD</b>	Bridge Design Supervisor <b>J.P. HALSTEAD</b>
Date <b>10/99</b>	Date <b>10/99</b>
PROJECT <b>MIDDLESEX-BOLTON</b>	PROJECT NO. <b>IM-089-2(26)</b>
TVGA CAD Drawing No. <b>49tsect</b>	Date <b>10/99</b>
Bridge Sheet No. <b>BR49-4</b>	Sheet <b>78</b> of <b>307</b>

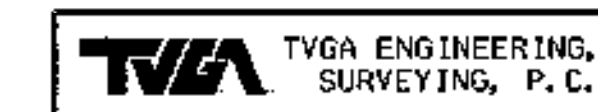

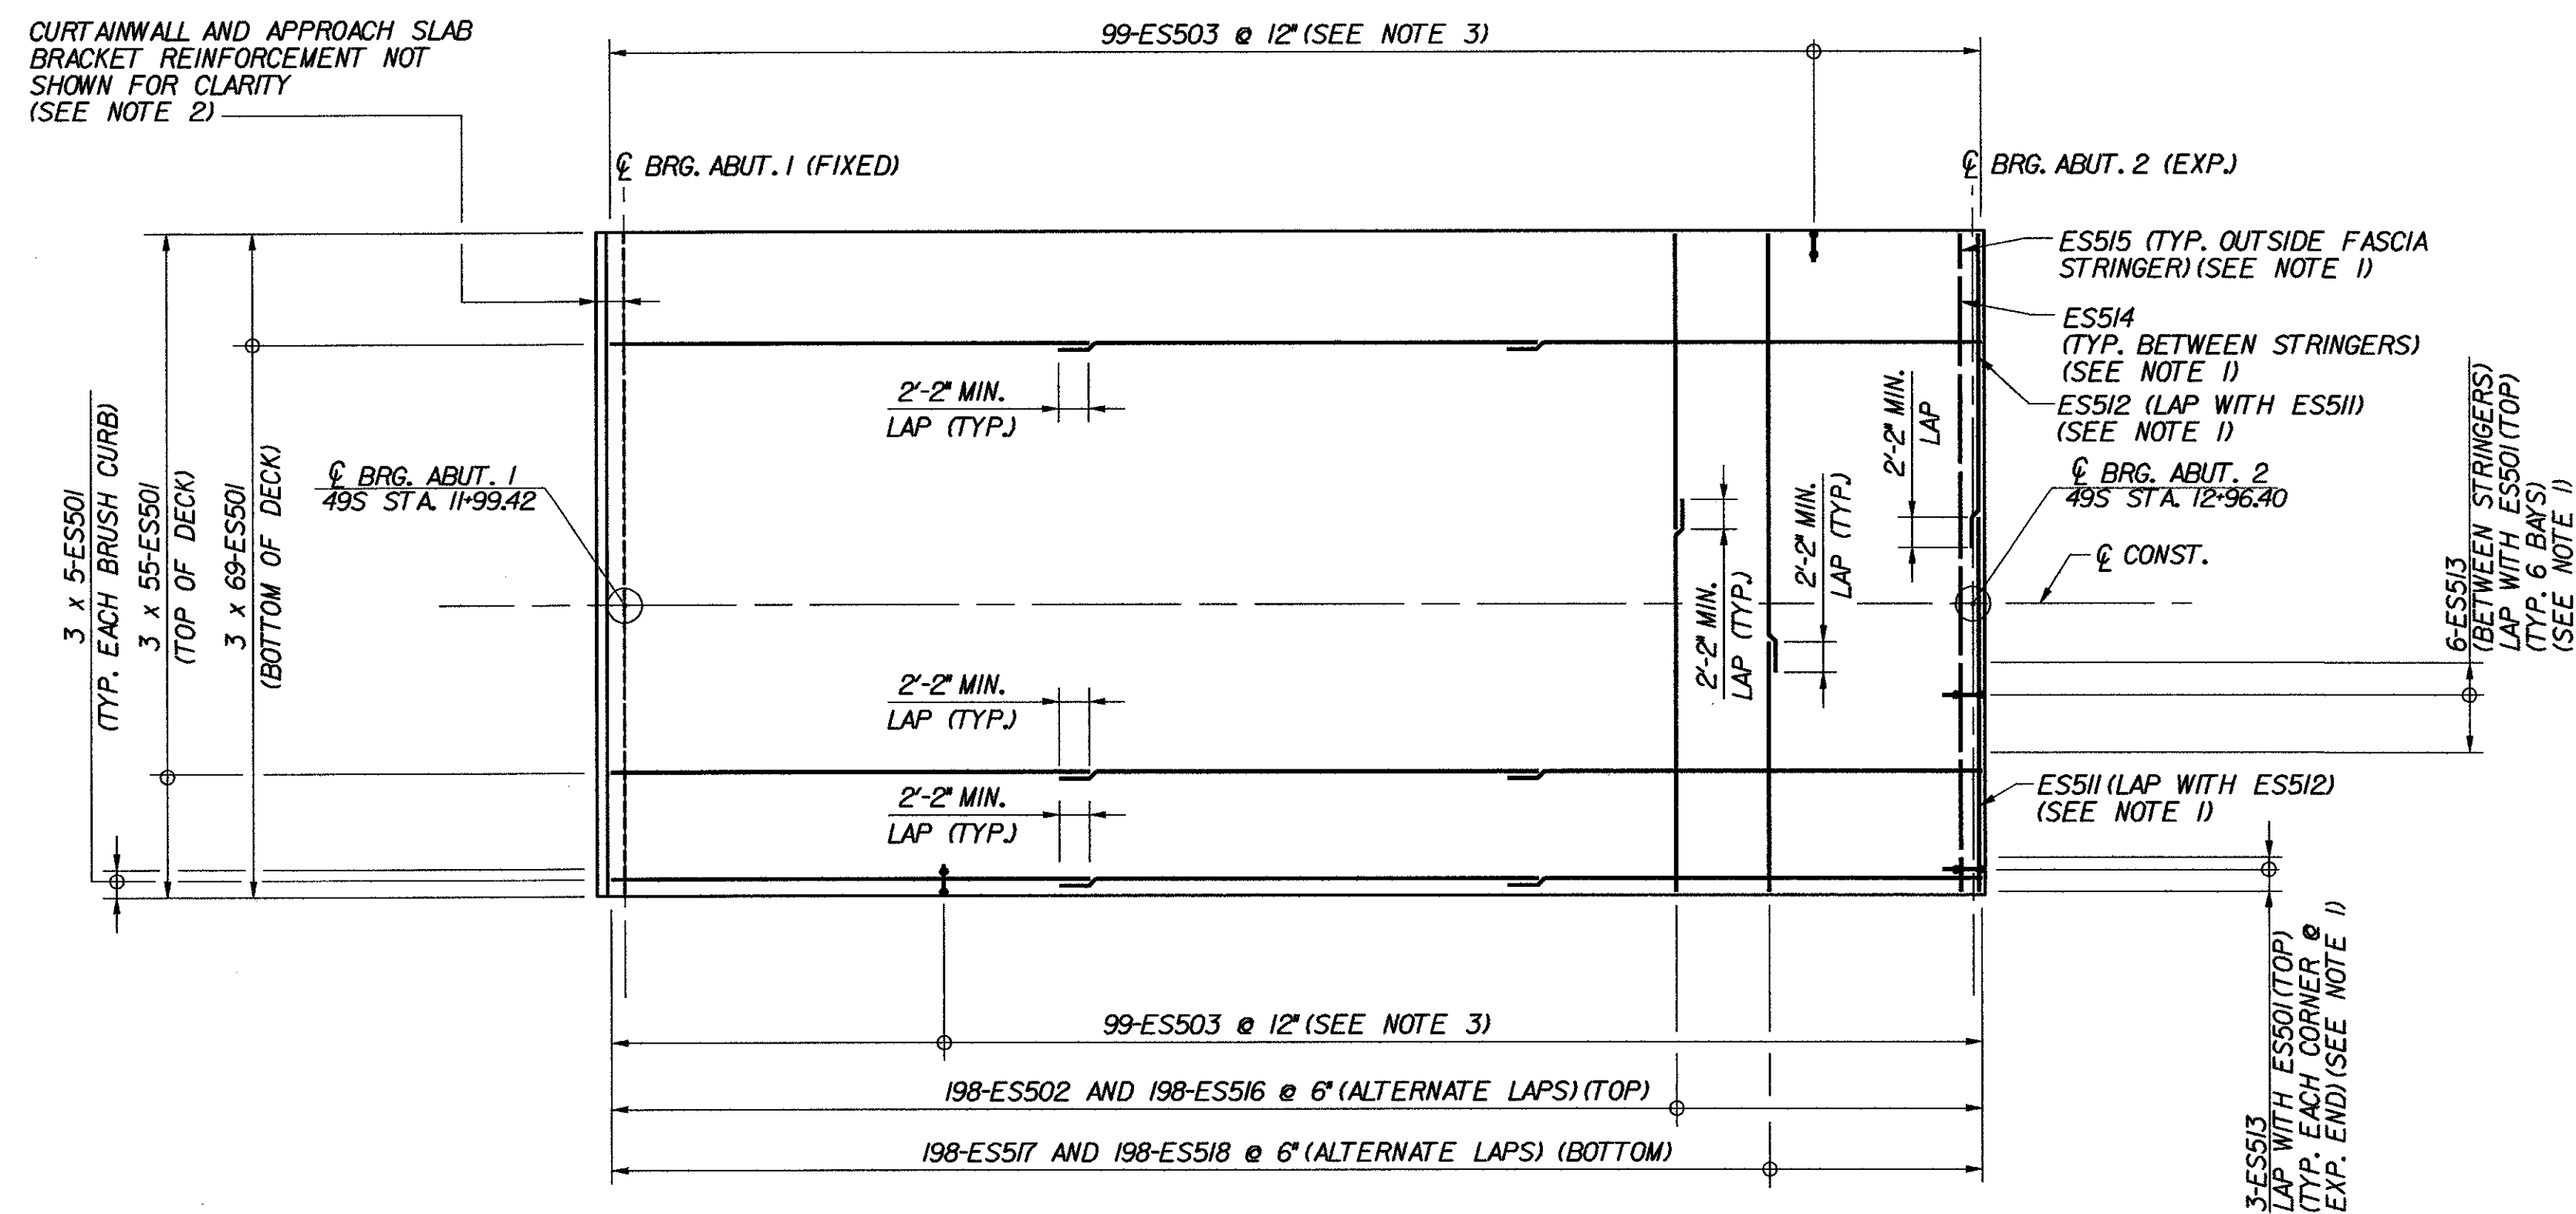

**DECK REINFORCEMENT PLAN - BR 49S**  
SCALE: 3/32" = 1'-0"

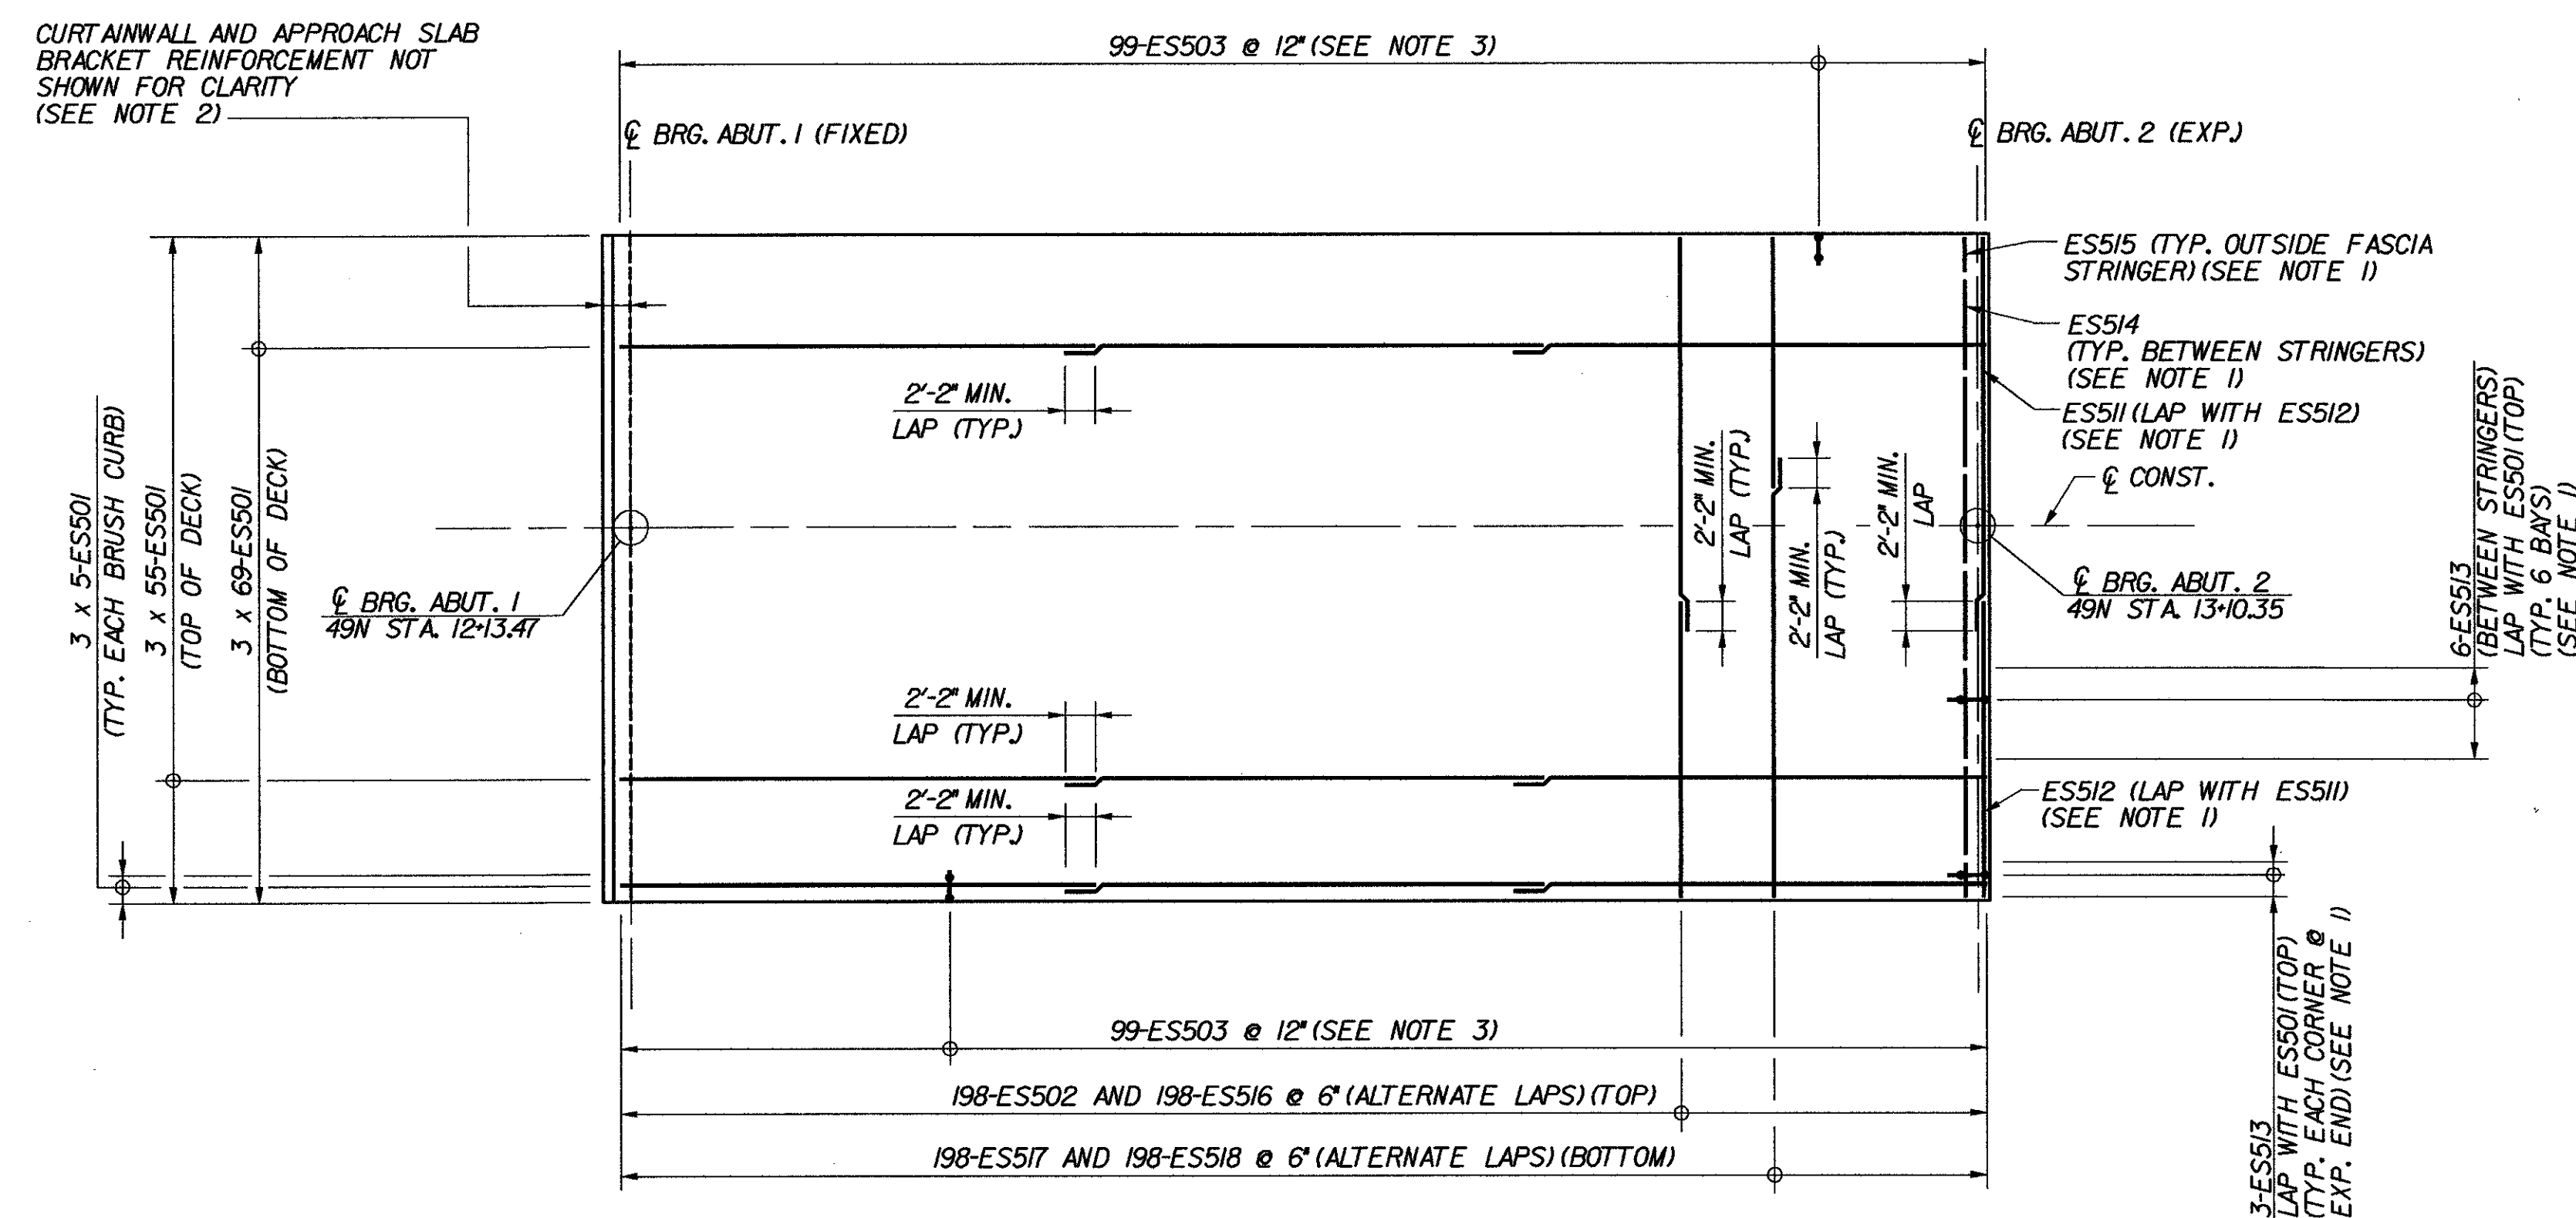


**DECK REINFORCEMENT PLAN - BR 49N**  
SCALE: 3/32" = 1'-0"

**NOTES:**


- FOR END OF DECK SLAB DETAILS, SEE TRANSVERSE SECTION (49N&S), BRIDGE SHEET BR49-4.
- FOR CURTAINWALL REINFORCEMENT, SEE TYPICAL CURTAINWALL DETAILS, BRIDGE SHEET C-42.
- THE QUANTITY OF ES503 BARS SHOWN DOES NOT INCLUDE ADDITIONAL BARS REQUIRED BELOW THE BRIDGE RAIL POSTS. FOR DETAILS OF THE REQUIRED STIRRUP SPACING, SEE NETC 2-RAIL STANDARD SHEET BRI-97. FOR LOCATIONS OF THE BRIDGE RAIL POSTS, SEE CURB AND RAIL LAYOUT PLANS, BRIDGE SHEET BR49-7.

**STATE OF VERMONT  
AGENCY OF TRANSPORTATION**

Town Of	MIDDLESEX-BOLTON	Bridge No.	49N&S
Highway No.	I-89	Log Sta.	
		Surv. Sta.	
I-89 OVER TH 7			
<b>DECK REINFORCEMENT PLANS (49N&amp;S)</b>			
Designed By	P.W. SZUSTAK	Drawn By	R.A. BOTZENHART
Checked By	Date	Bridge Design Supervisor	
J.P. HALSTEAD	10/99	J.P. HALSTEAD	Date 10/99
PROJECT	MIDDLESEX-BOLTON	PROJECT NO.	IM-089-2(26)
TVGA CAD Drawing No.	49drp	Date	10/99
Bridge Sheet No.	BR49-5	Sheet	79 of 307

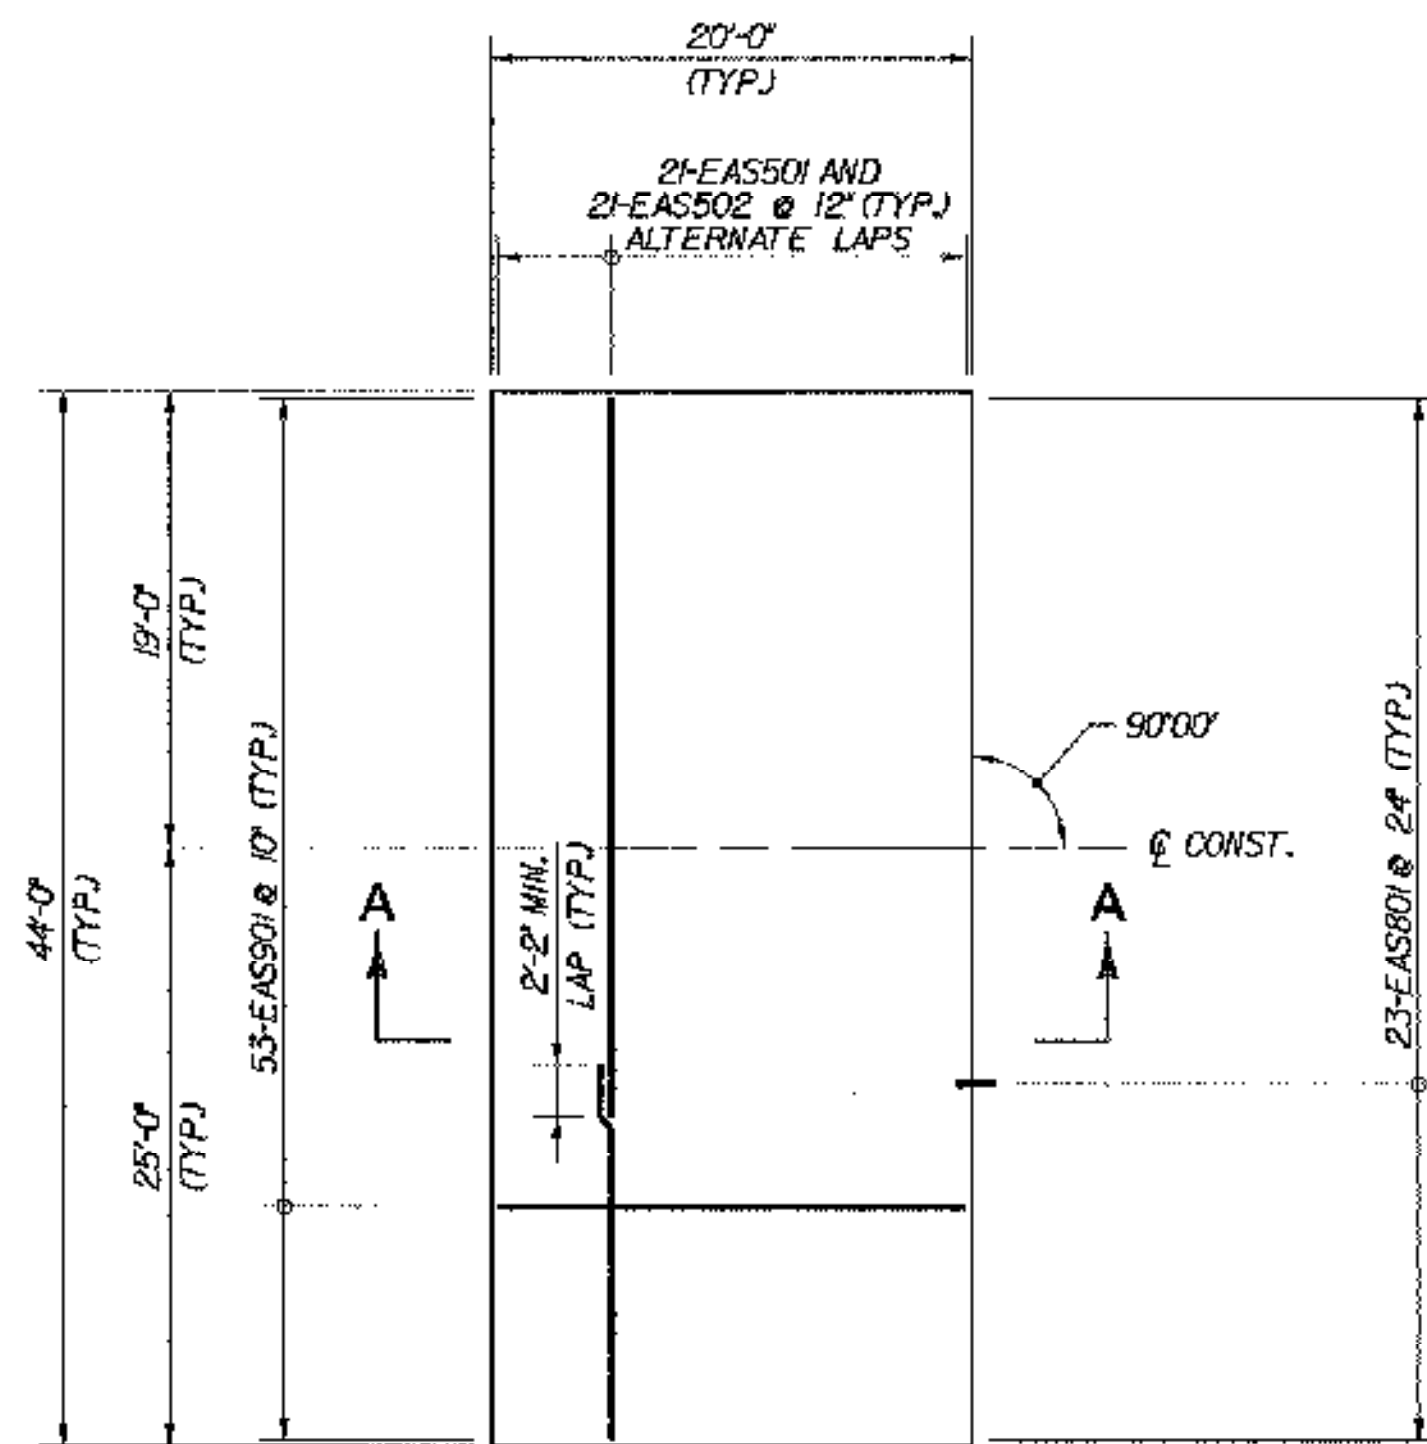


49N ABUTMENT 1

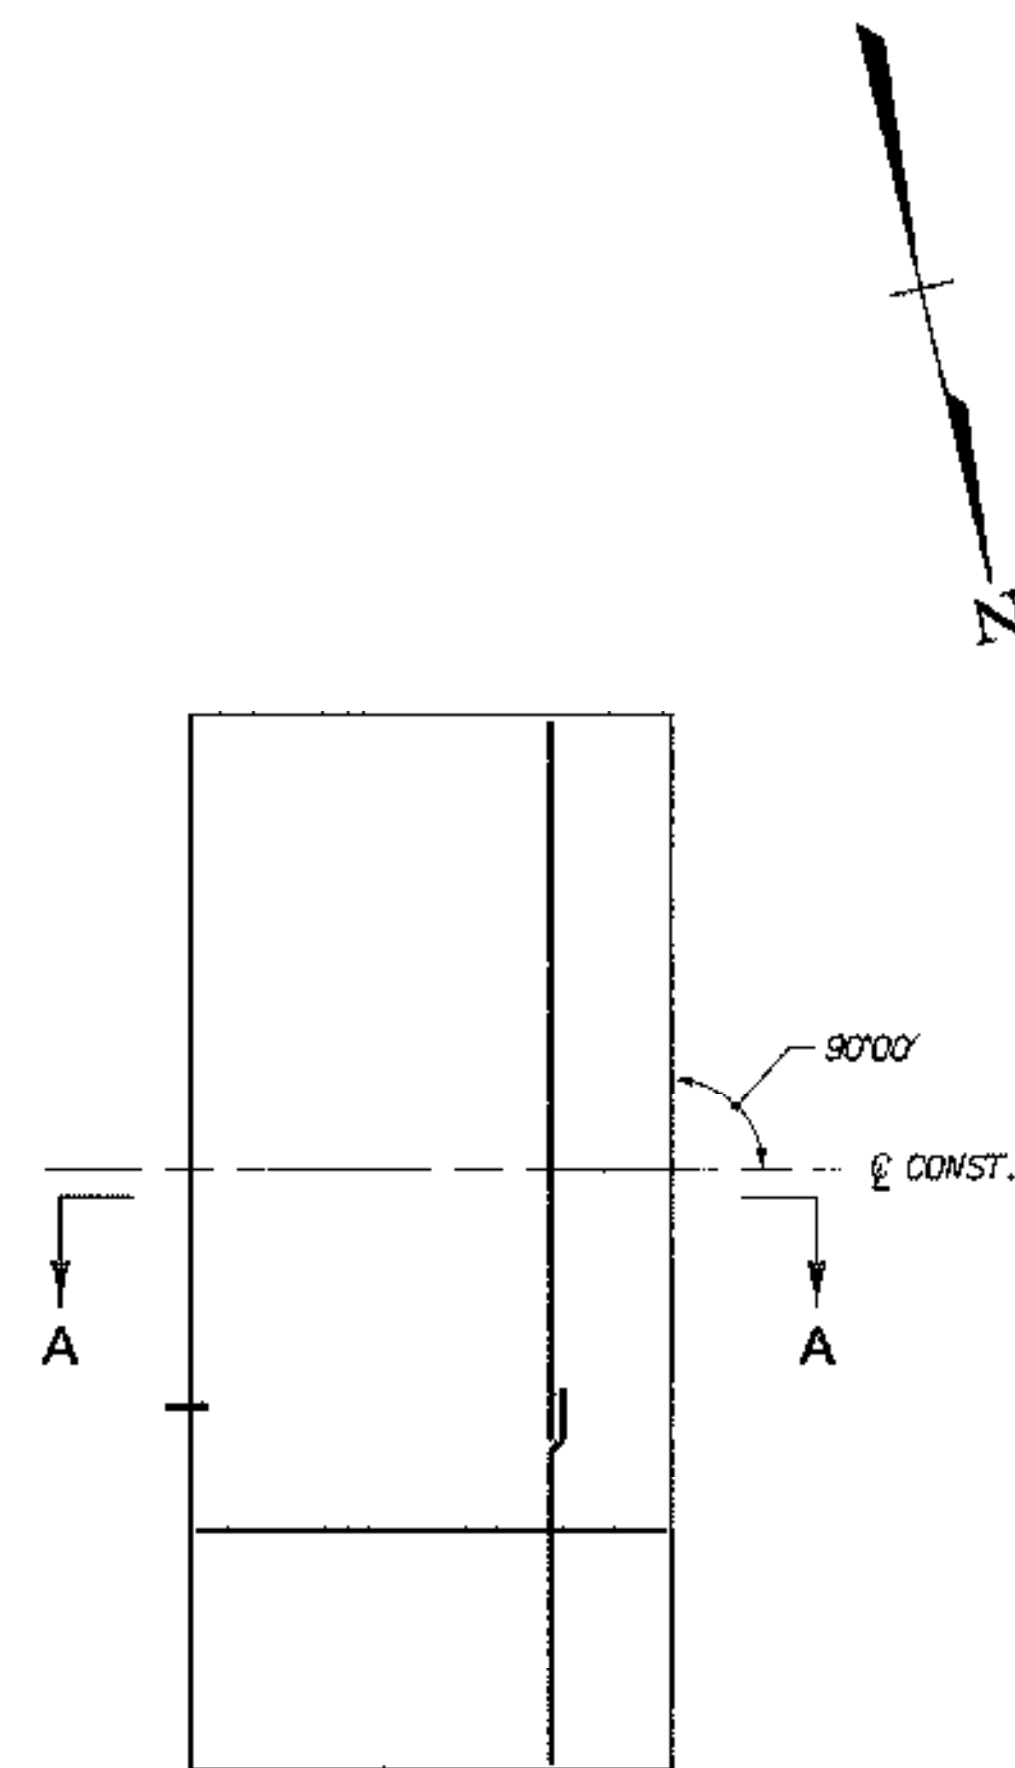

49N ABUTMENT 2

APPROACH SLAB PLANS  
(49N SHOWN; 49S SIMILAR)  
SCALE: 1/8" = 1'-0"

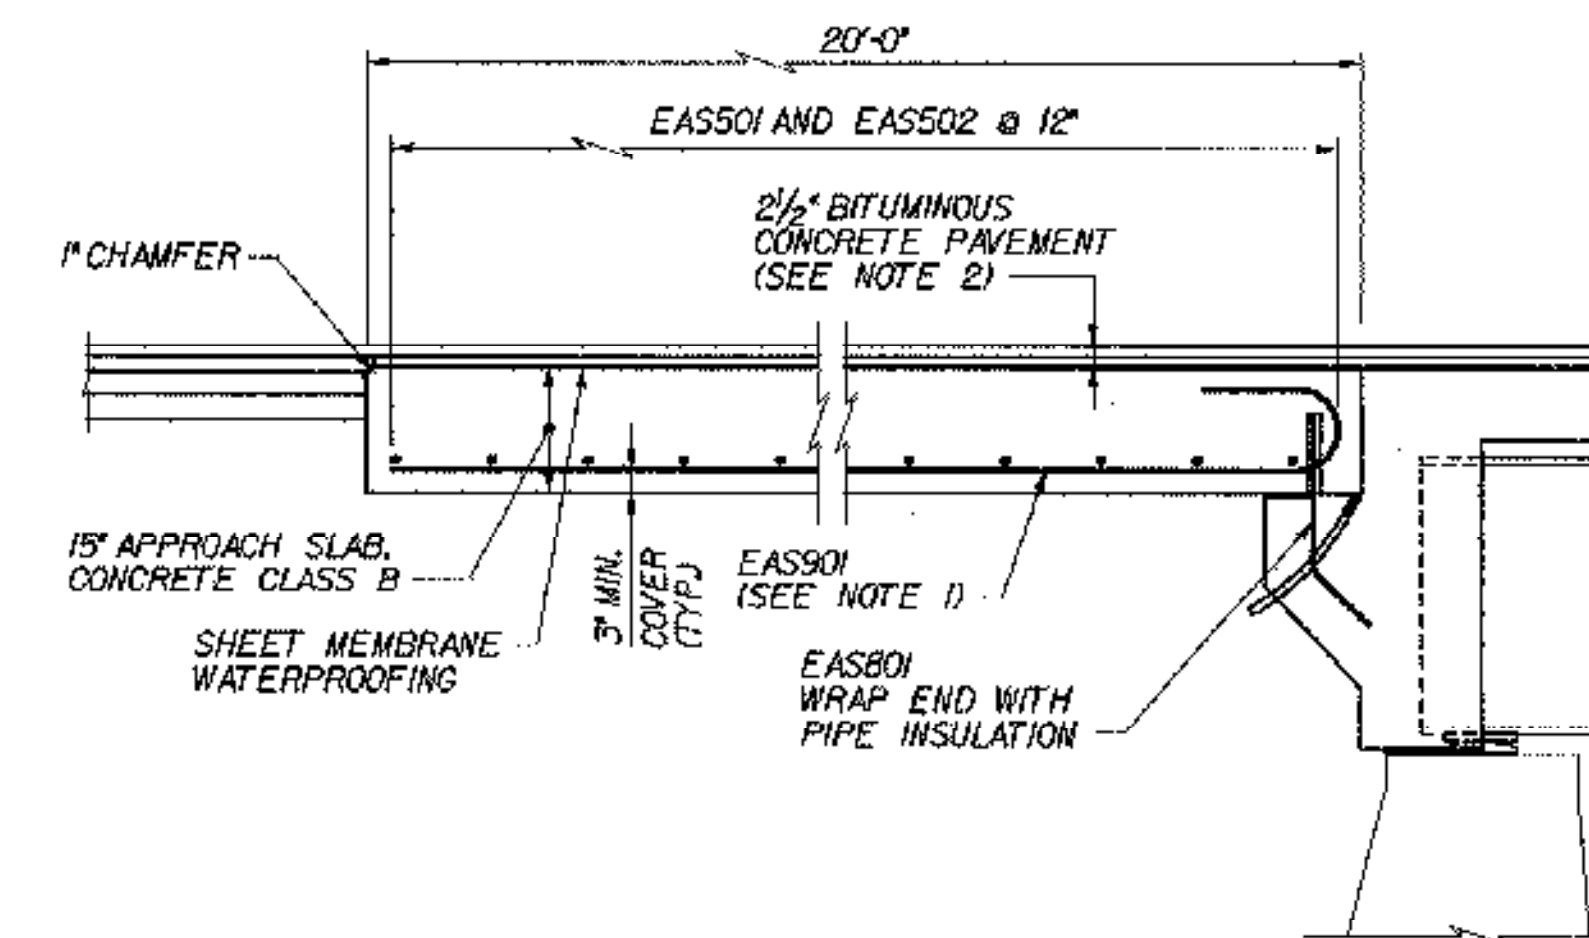


SECTION A-A  
(APPROACH SLAB AT FIXED ABUT. SHOWN;  
SLAB AT EXPANSION ABUT. SIMILAR)  
N.T.S.

RAISED BRIDGE 49N FINISH GR. 1/2"  
RAISED BRIDGE 49S FINISHED GR. 5/8"

TOP OF APPROACH SLAB ELEVATIONS						
BR 49N			BR 49S			
LOCATION	STATION	ELEVATION	LOCATION	STATION	ELEVATION	
A	12+12.22	453.06-.09	A	11+98.17	452.82	452.87
B	12+12.22	453.45-.49	B	11+98.17	453.34	453.39
C	12+12.22	452.93-.97	C	11+98.17	452.94	453.99
D	11+92.22	452.94-.98	D	11+78.17	452.68	452.73
E	11+92.22	453.34-.38	E	11+78.17	453.21	453.26
F	11+92.22	452.82-.86	F	11+78.17	452.81	452.86
G	13+12.85	453.61-.65	G	12+98.90	453.48	453.53
H	13+12.85	454.01-.05	H	12+98.90	454.00	454.05
J	13+12.85	453.49-.53	J	12+98.90	453.60	453.65
K	13+32.85	453.73-.77	K	13+18.90	453.61	453.66
L	13+32.85	454.12-.16	L	13+18.90	454.13	454.18
M	13+32.85	453.80-.64	M	13+18.90	453.73	453.78

NOTES:


- TIP HOOK END OF BAR AS REQUIRED TO ACHIEVE MINIMUM COVER.
- FOR DETAILS OF APPROACH SLAB PAVEMENT AND TRANSITION TO EXISTING PAVEMENT, SEE DETAIL ON TYPICAL END OF DECK SLAB DETAILS, BRIDGE SHEET C-15.

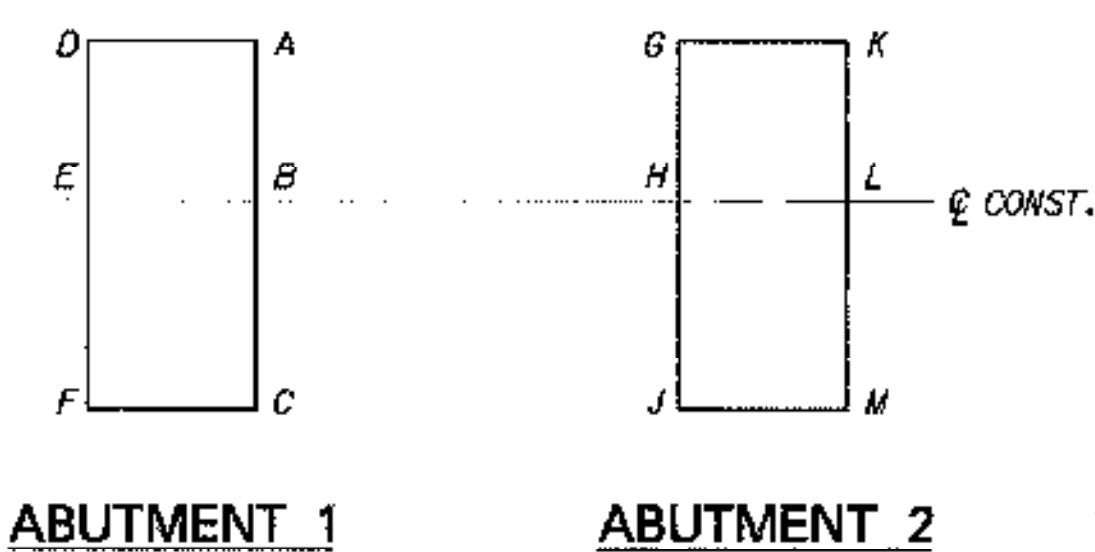


APPROACH SLAB ELEVATION KEY  
N.T.S.

**STATE OF VERMONT  
AGENCY OF TRANSPORTATION**

Town Of	MIDDLESEX-BOLTON	Bridge No.	49N&S
Highway No.	I-89	Log Sta.	
		Surv. Sta.	
I-89 OVER TH 7			
<b>APPROACH SLAB DETAILS (49N&amp;S)</b>			
Designed By	P.W. SZUSTAK	Drawn By	R.A. BOTZENHART
Checked By	J.P. HALSTEAD	Bridge Design Supervisor	J.P. HALSTEAD
Date	10/99	Date	10/99
PROJECT	MIDDLESEX-BOLTON	PROJECT NO.	IM-089-2(26)
TVGA CAD Drawing No.	49apslab	Date	10/99
Bridge Sheet No.	BR49-6	Sheet	80 of 307

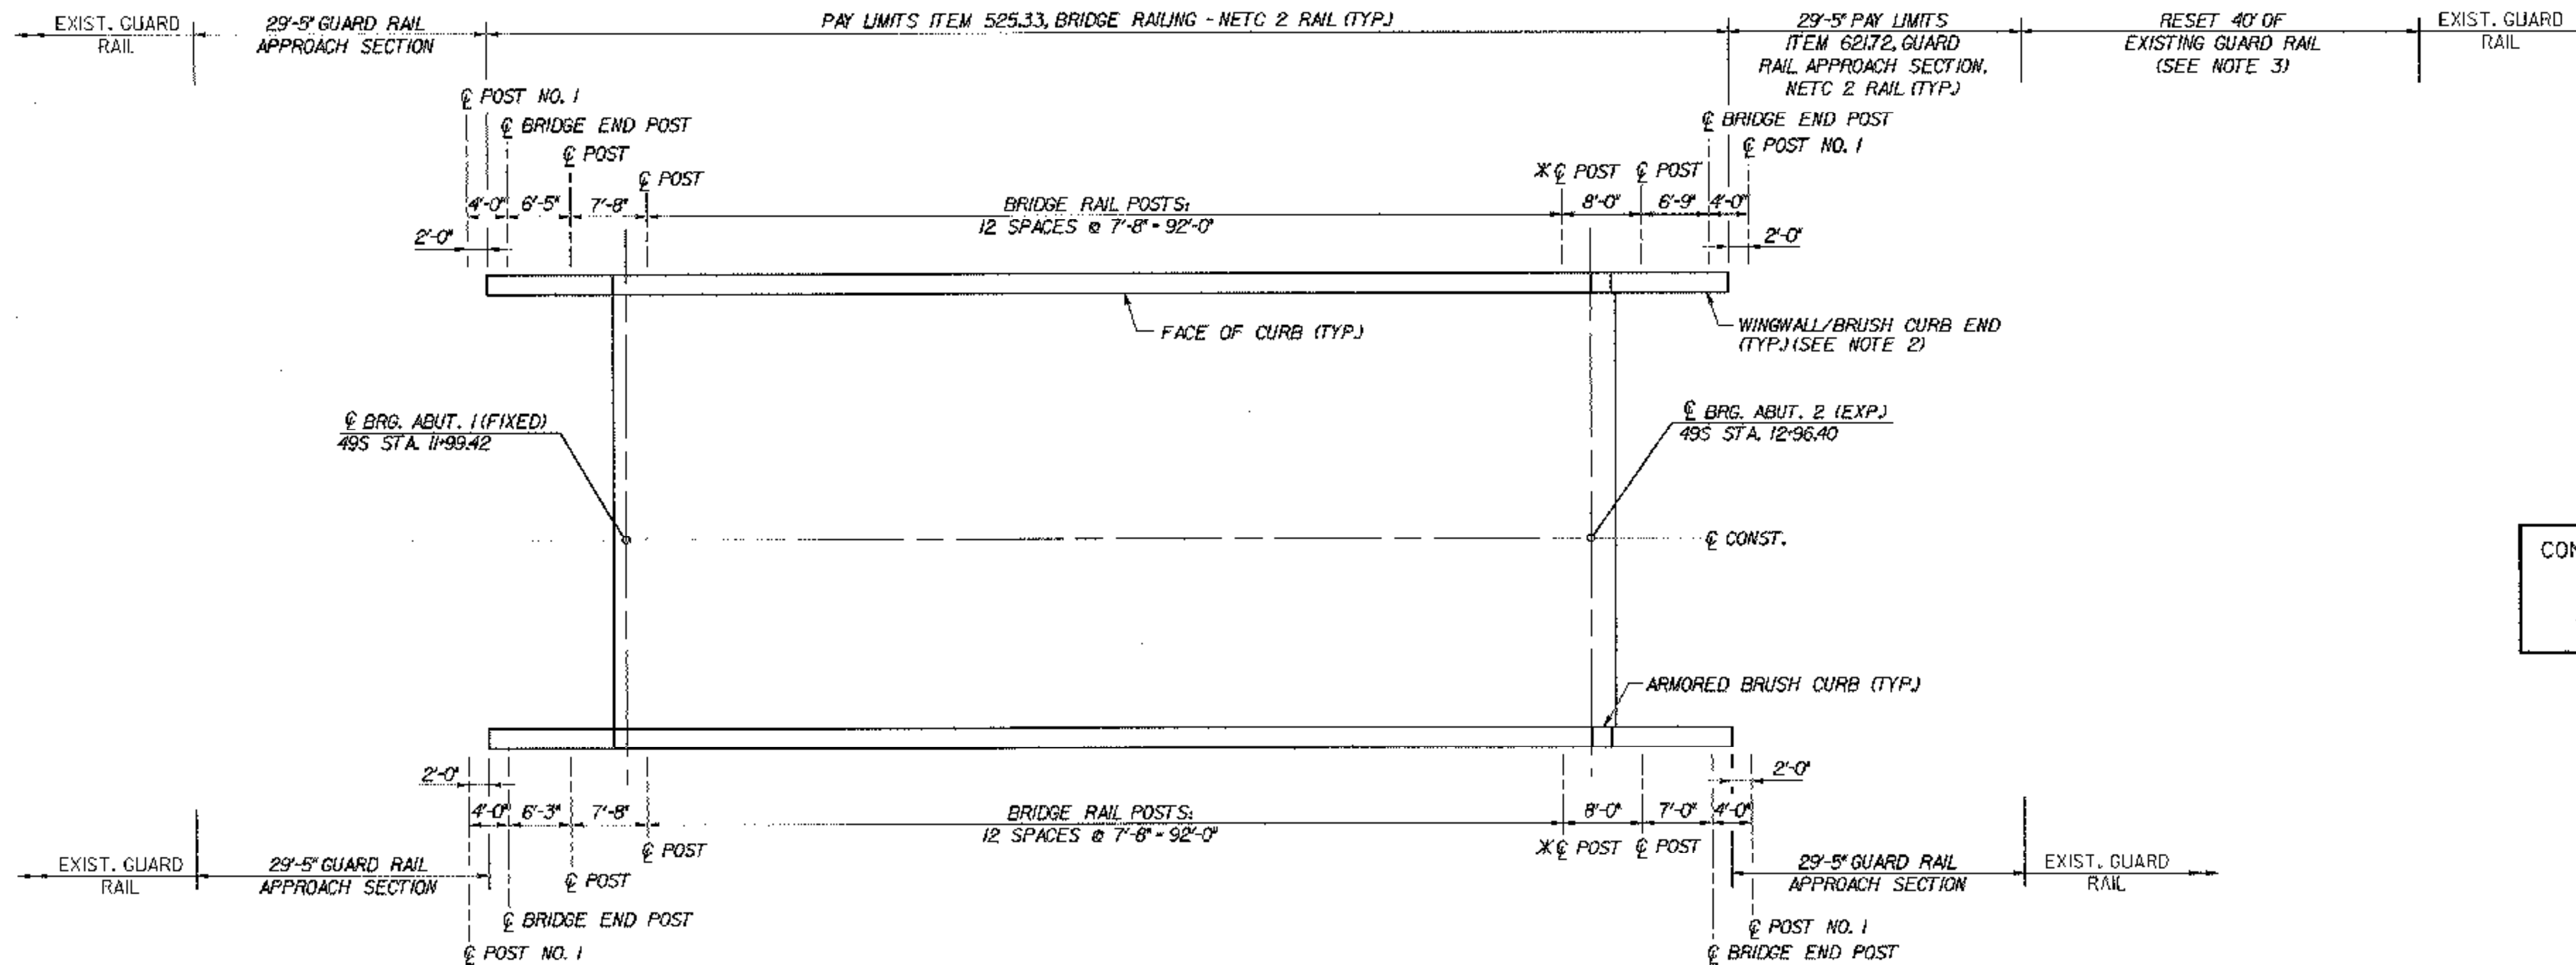

**BR 49S**

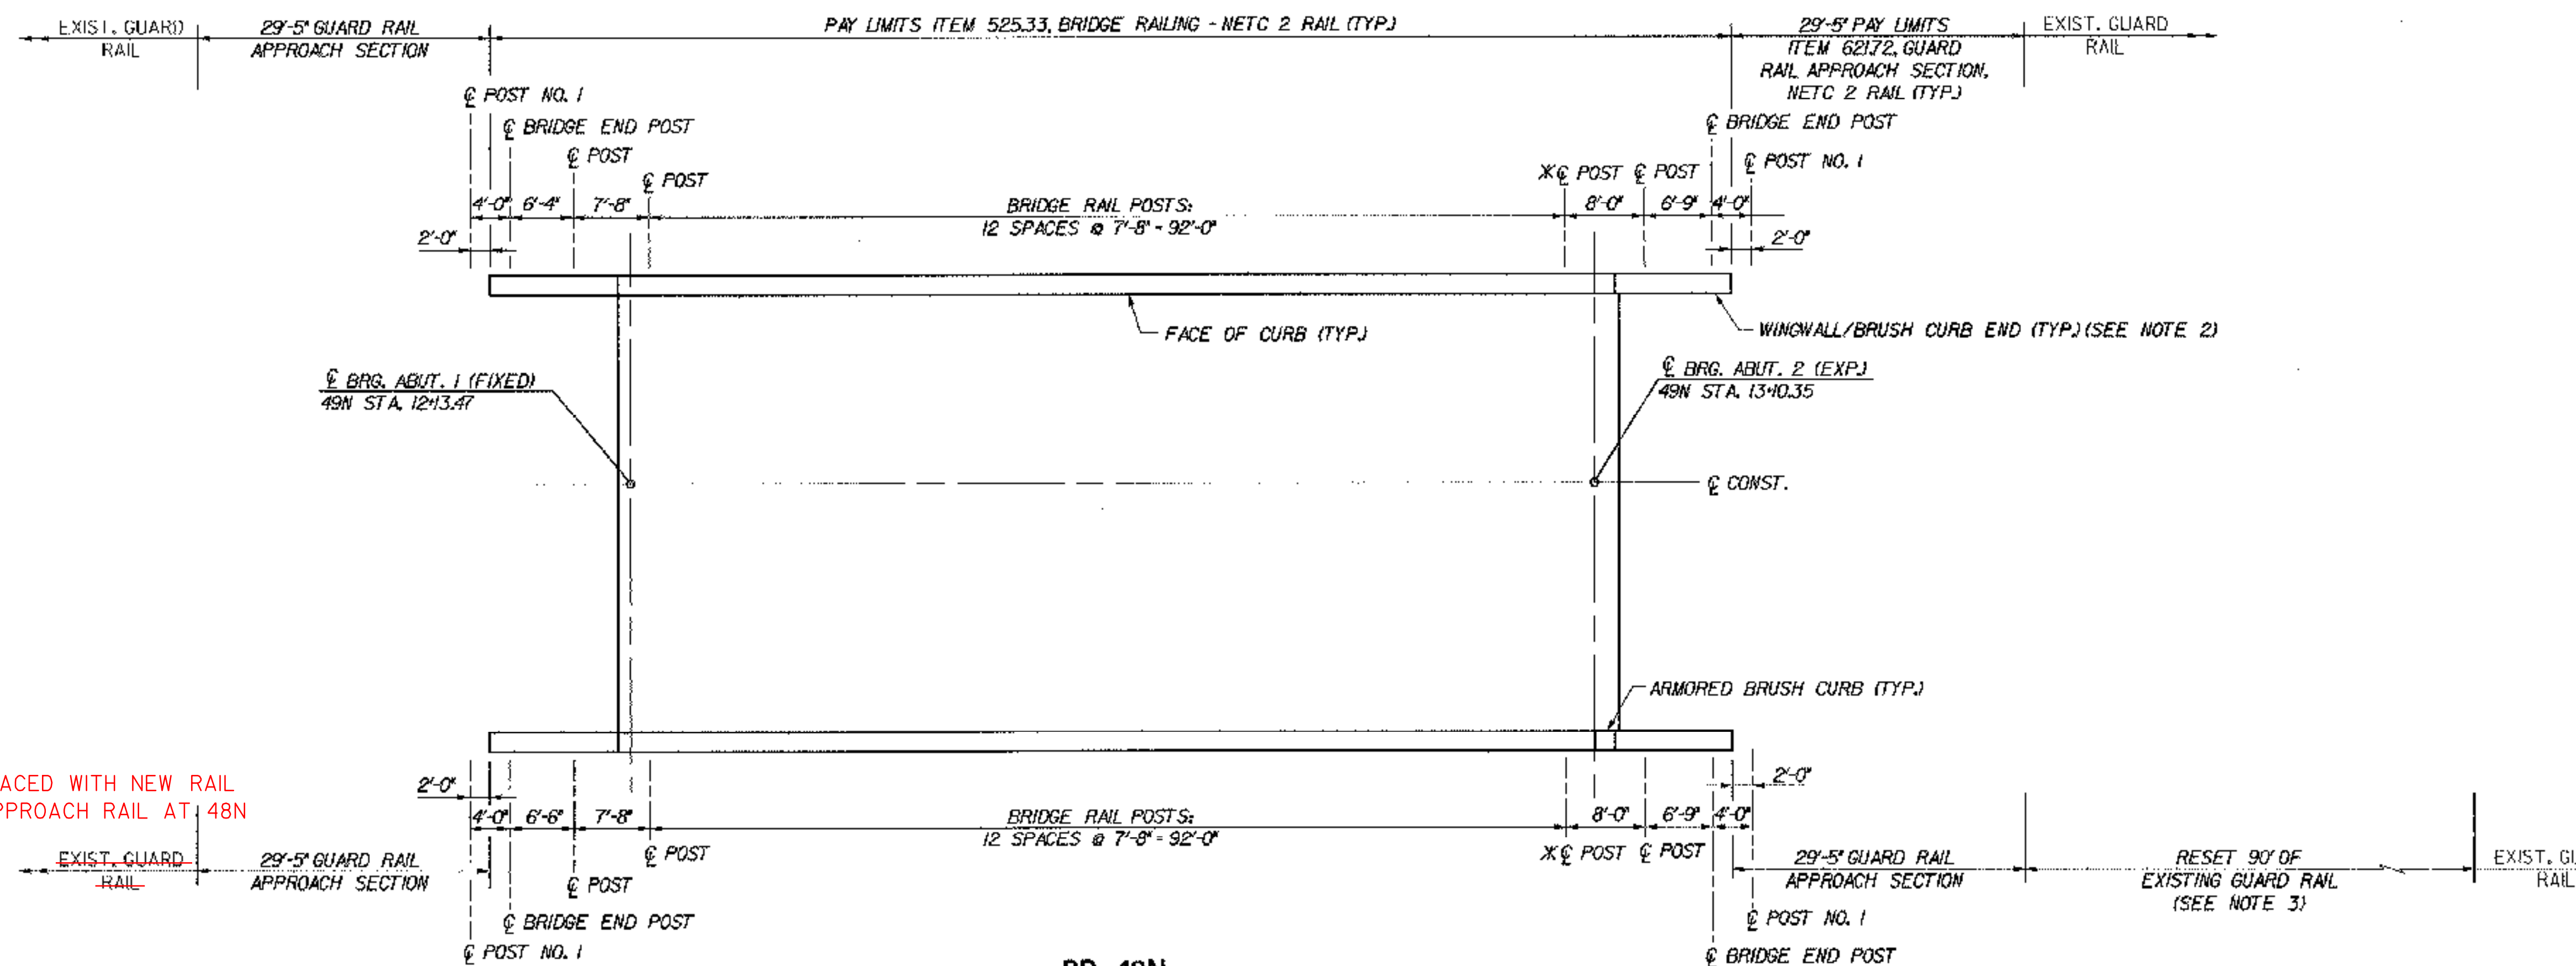

**BR 49N**

**RAILING LAYOUT**

SCALE: 1/2" = 1'-0"

\* RAIL EXPANSION JOINT SHALL BE LOCATED 2'-0" FROM C/O INDICATED POST, ON BRIDGE EXPANSION JOINT SIDE OF POST.


**CONSTRUCTION NOTE:**  
 END OF WINGWALLS HAVE BEEN LOCATED APPROXIMATELY BY VAOT SURVEY. CONTRACTOR SHALL VERIFY REQUIRED RAIL LENGTHS PRIOR TO SUBMITTING SHOP DRAWINGS FOR APPROVAL.


**NOTES:**

- FOR NETC 2-RAIL BRIDGE RAILING DETAILS AND INFORMATION ABOUT THE NETC GUARD RAIL APPROACH SECTION, SEE STANDARD SHEETS BR1-97 AND BR3-97, AND GUARD RAIL APPROACH SECTION, NETC 2 RAIL, BRIDGE SHEETS C-46A AND C-46B.
- FOR BRUSH CURB END DETAIL, SEE TYPICAL WINGWALL DETAILS (1 OF 2), BRIDGE SHEET C-43.
- ALL WORK REQUIRED TO RESET THE EXISTING GUARD RAIL SHALL BE PAID UNDER ITEM 621.75, "REMOVING AND RESET GUARD RAIL."
- A QUANTITY OF 40'-0" OF ITEM 616.28 "CAST-IN-PLACE CEMENT CONCRETE CURB, TYPE B" SHALL BE PLACED AT THE END OF EACH WINGWALL. SEE GUARD RAIL APPROACH SECTION, NETC 2 RAIL, BRIDGE SHEETS C-46A AND C-46B FOR DETAILS.



REPLACED WITH NEW RAIL TO APPROACH RAIL AT 48N

<b>STATE OF VERMONT AGENCY OF TRANSPORTATION</b>	
Town Of <b>MIDDLESEX-BOLTON</b>	Bridge No. <b>49N&amp;S</b>
Highway No. <b>I-89</b>	Log Sta. <b>Surv. Sta.</b>
<b>I-89 OVER TH 7</b>	
<b>CURB AND RAIL LAYOUT PLANS (49N&amp;S)</b>	
Designed By <b>P.W. SZUSTAK</b>	Drawn By <b>R.A. BOTZENHART</b>
Checked By <b>J.P. HALSTEAD</b>	Bridge Design Supervisor <b>J.P. HALSTEAD</b>
Date <b>10/99</b>	Date <b>10/99</b>
PROJECT <b>MIDDLESEX-BOLTON</b>	PROJECT NO. <b>IM-089-2(26)</b>
TVGA CAD Drawing No. <b>49brall</b>	Date <b>10/99</b>
Bridge Sheet No. <b>BR49-7</b>	Sheet <b>81</b> of <b>307</b>

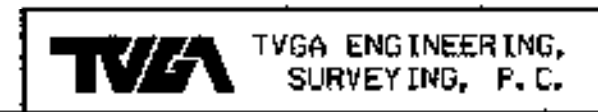

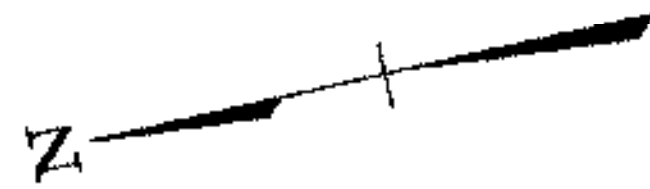


RAISED FINISHED GRADE AT BRIDGE 49N 0.04'

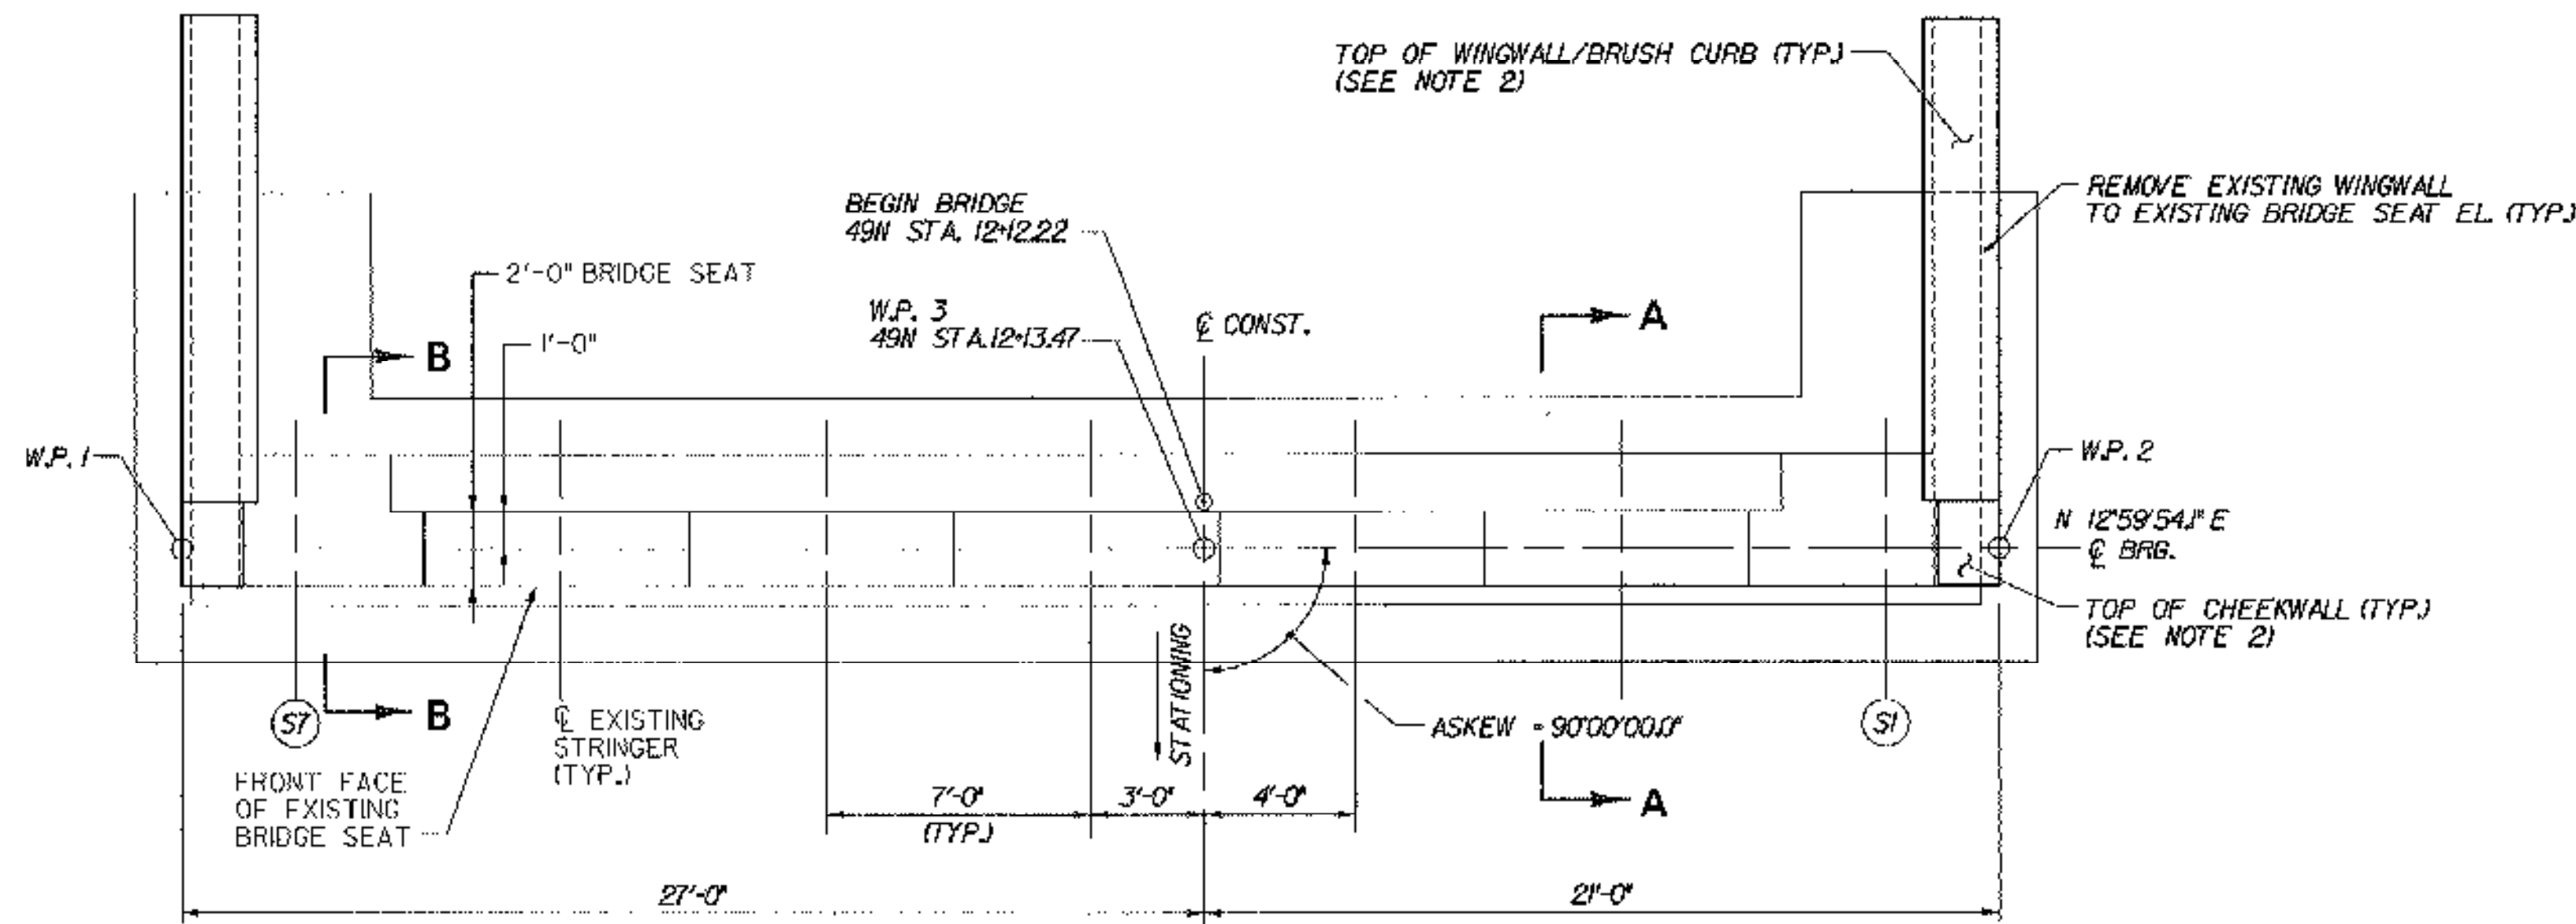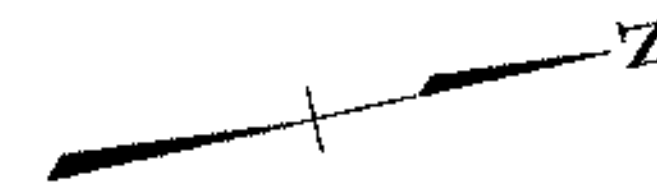


ABUTMENT 1 PLAN (FIXED)

SCALE: 1/4"=1'-0"

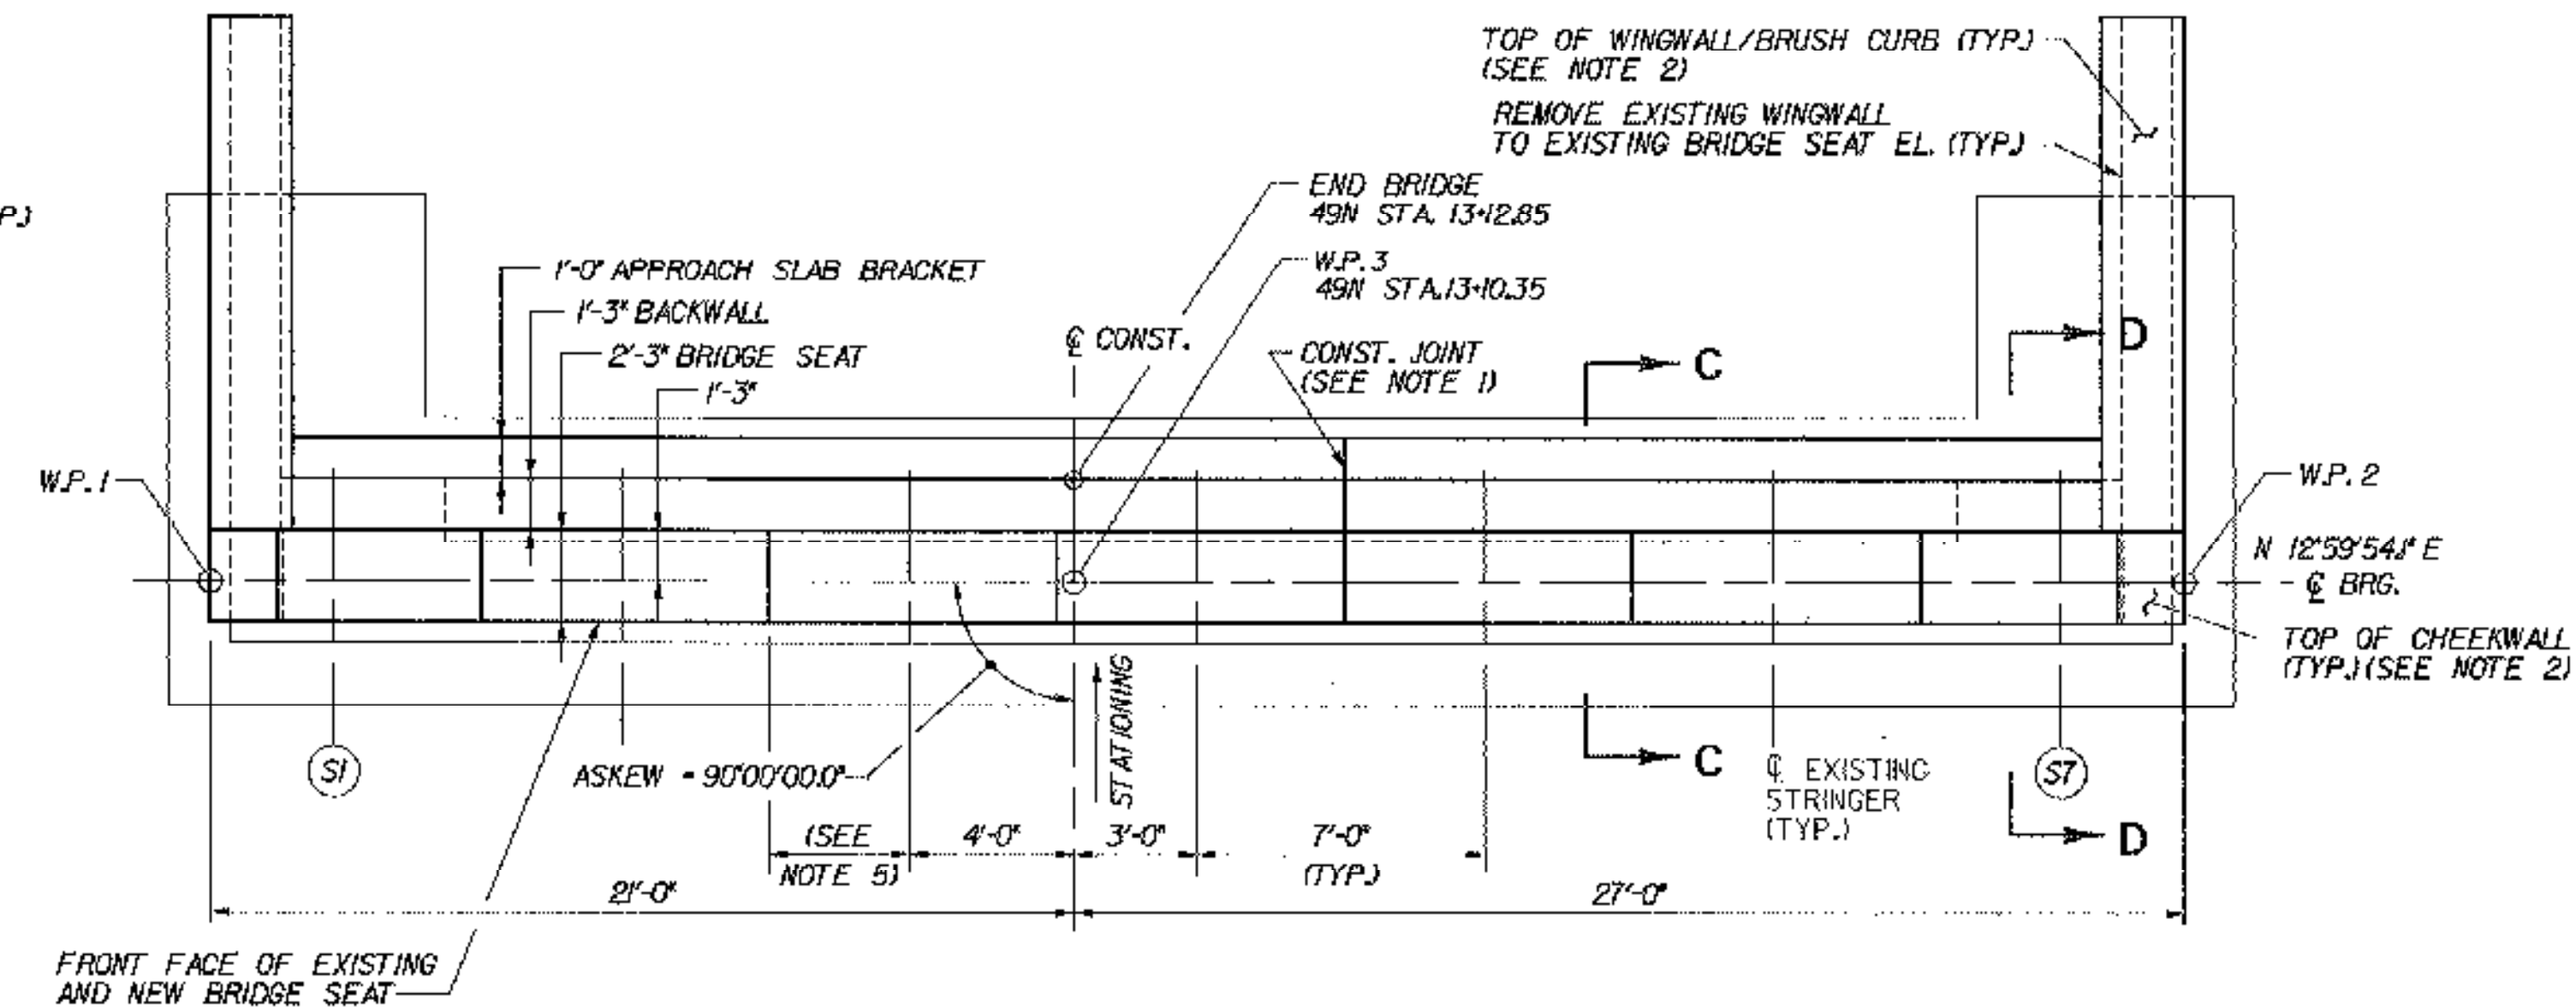


ABUTMENT 2 PLAN (EXP.)

SCALE: 1/4"=1'-0"

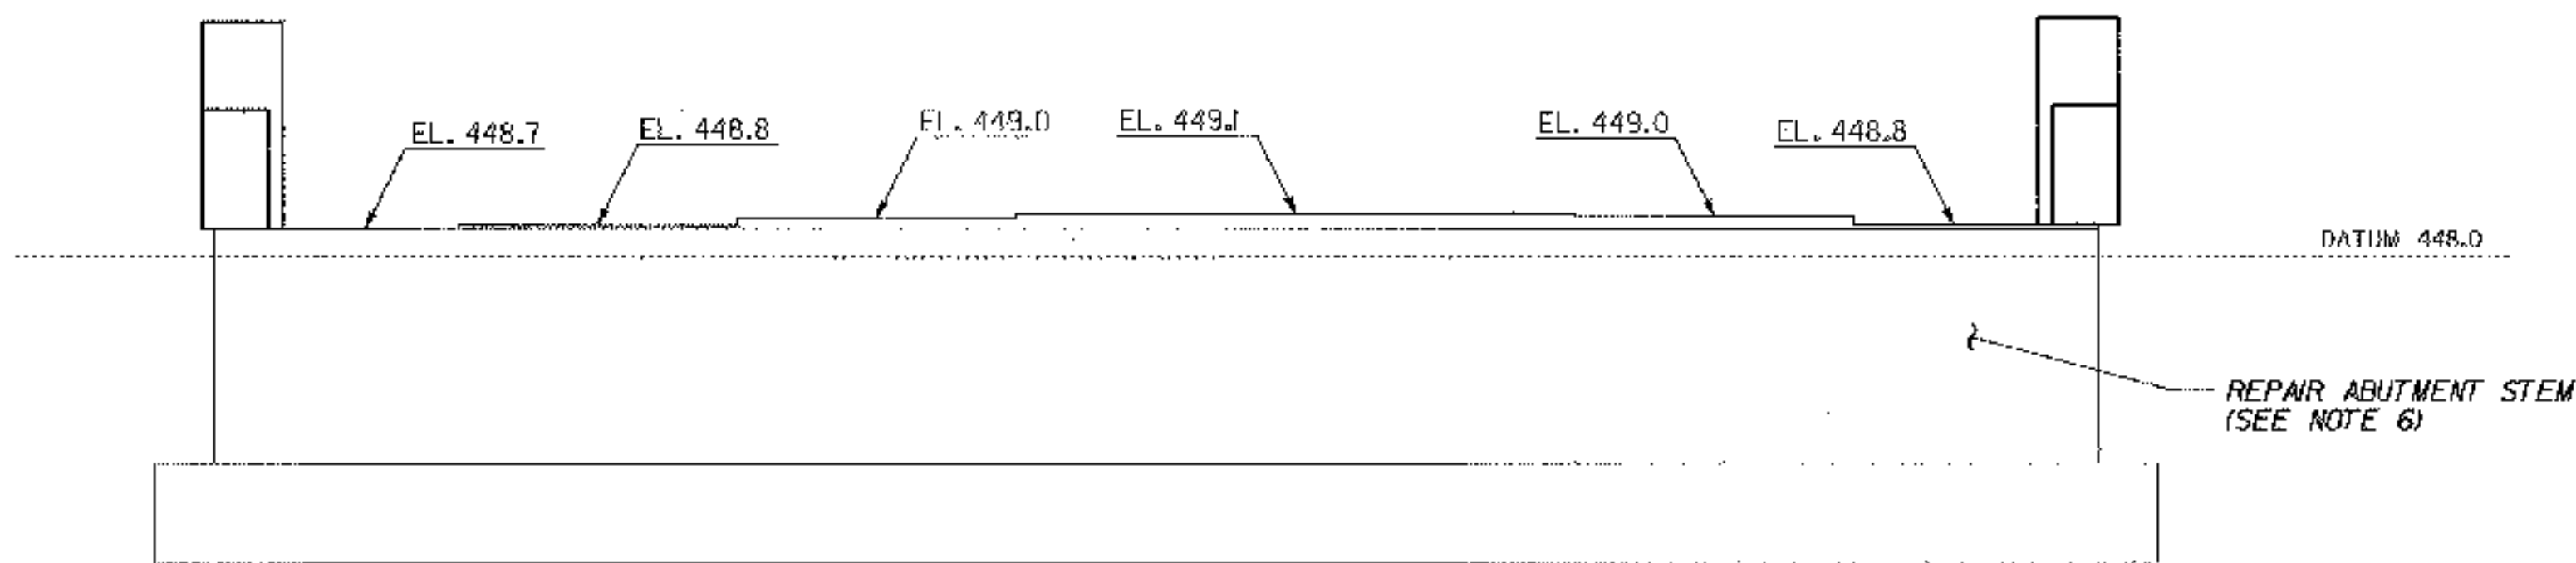


ABUTMENT 1 ELEVATION

SCALE: 1/4"=1'-0"

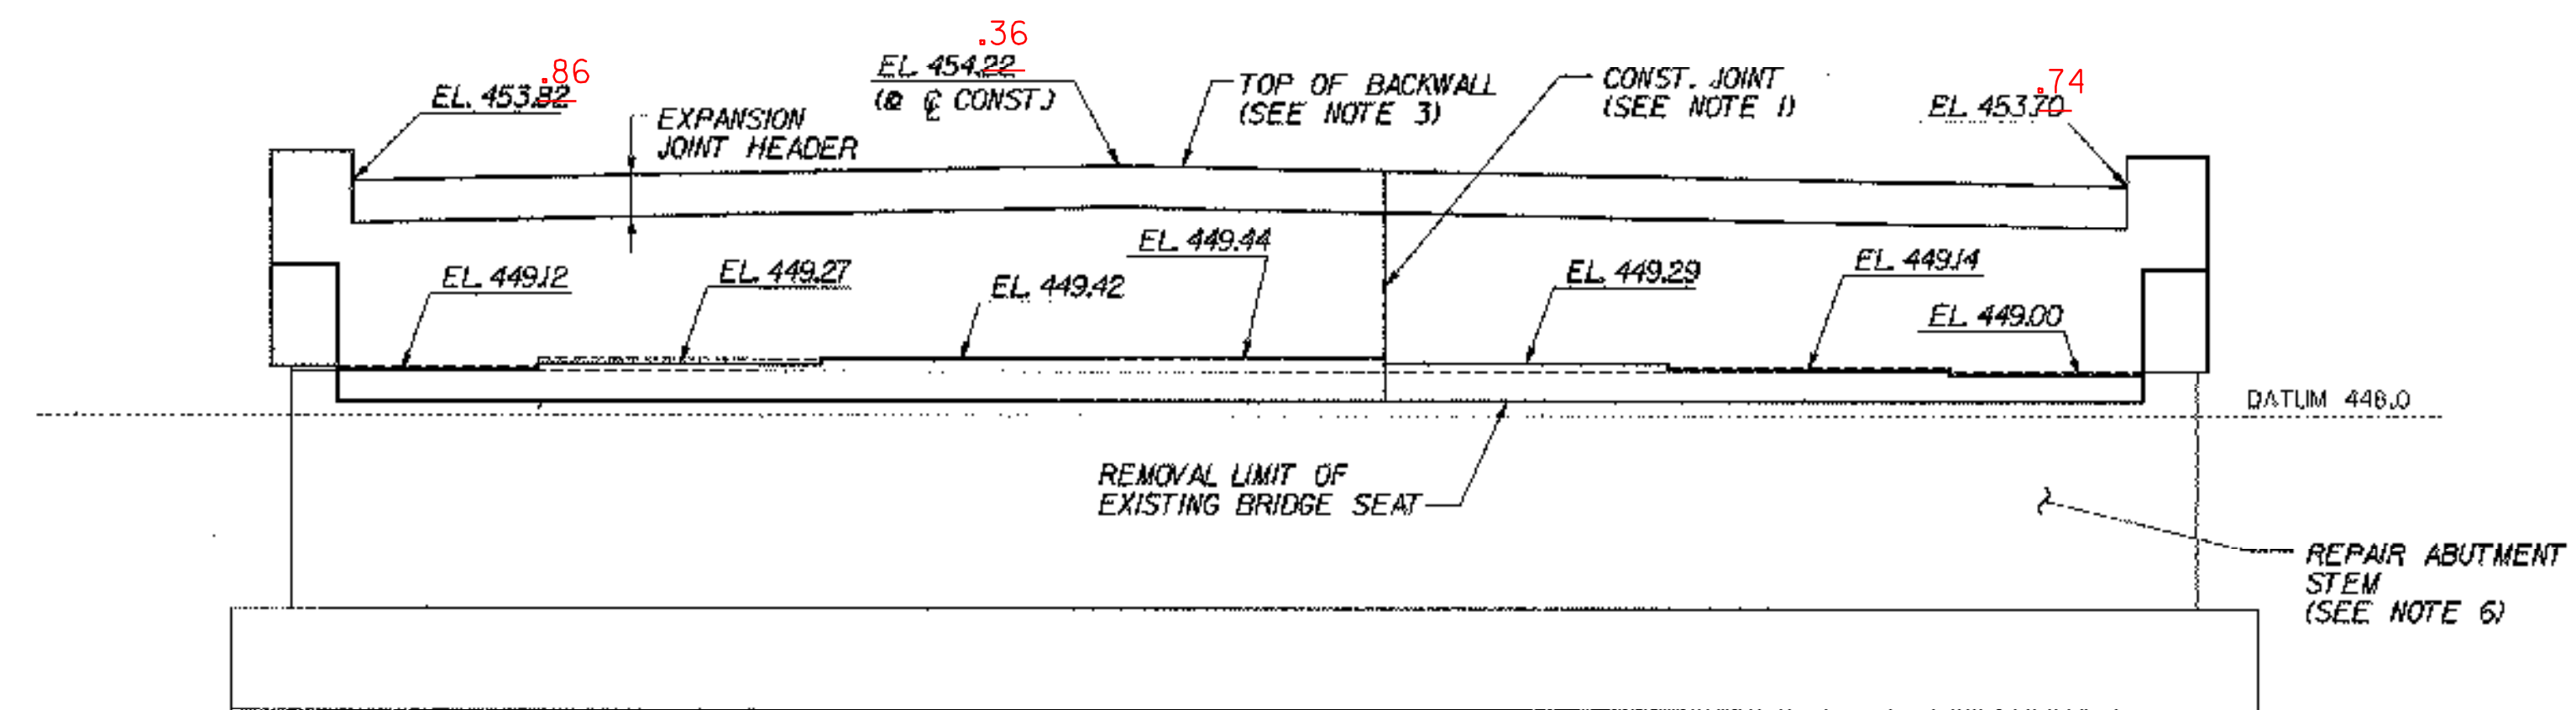


ABUTMENT 2 ELEVATION

SCALE: 1/4"=1'-0"

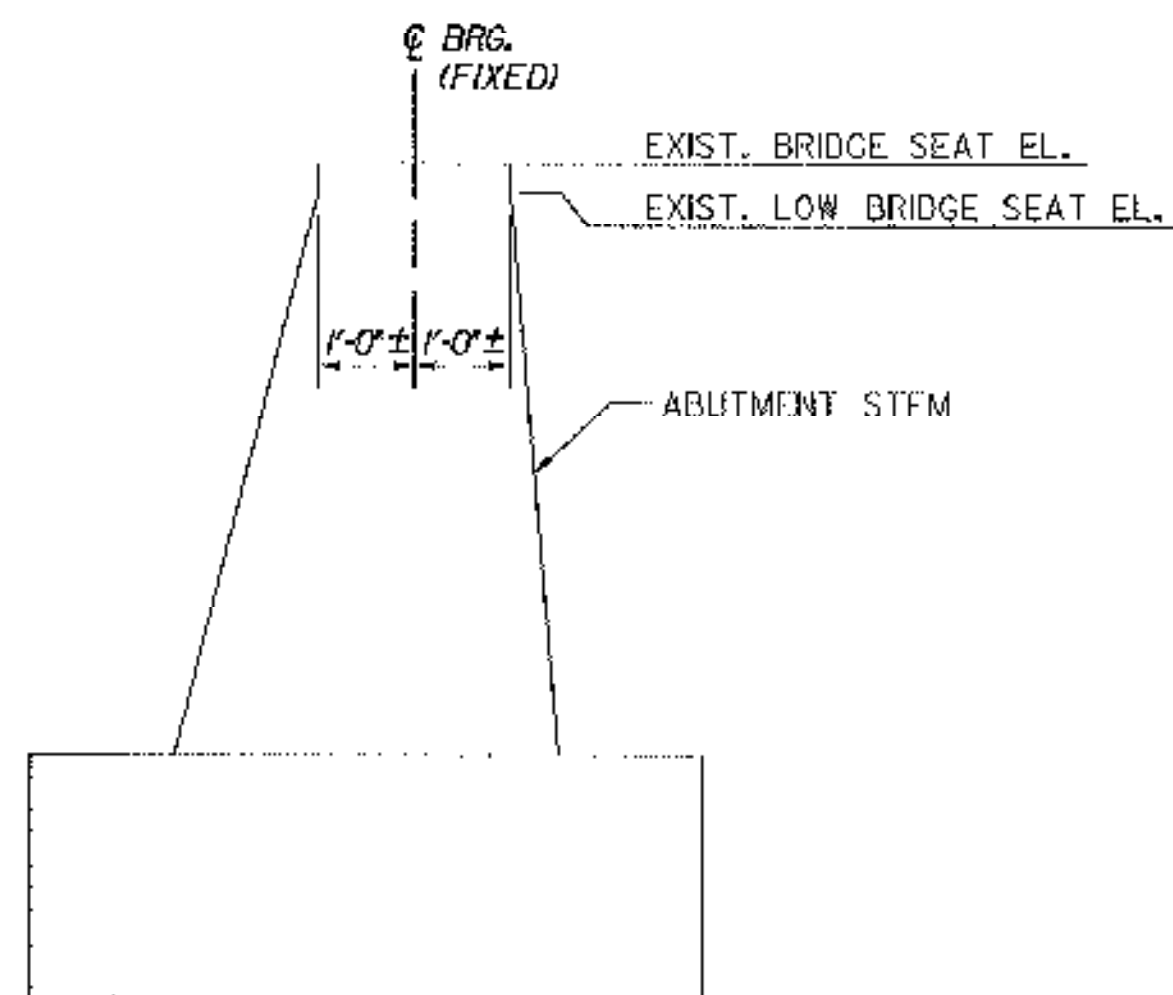

SECTION A-A

SCALE: 1/2"=1'-0"

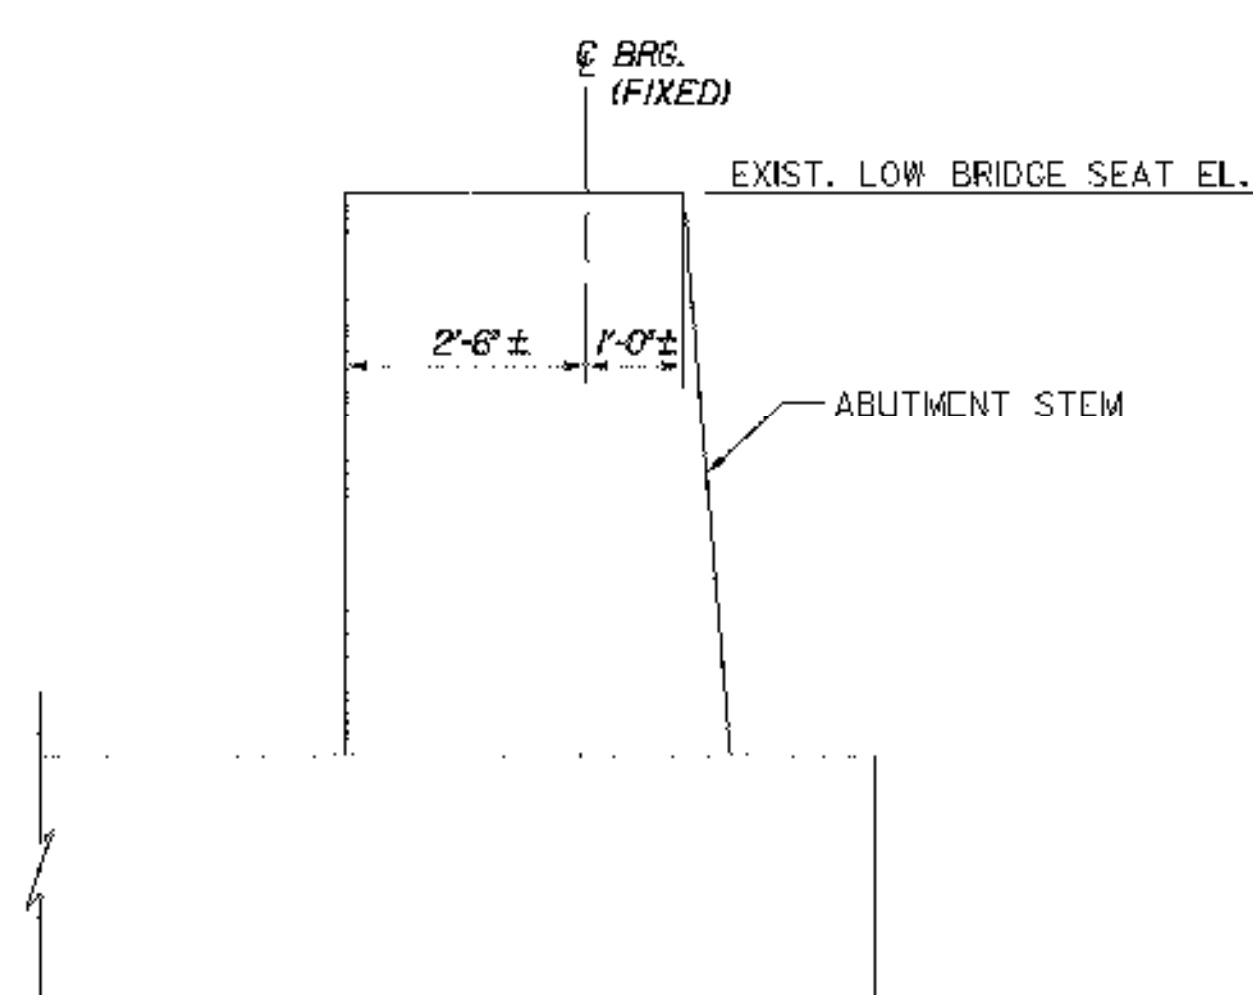

SECTION B-B

SCALE: 1/2"=1'-0"



NOTE: FOR SECTIONS C-C AND D-D, SEE ABUTMENT MASONRY (49S), BRIDGE SHEET BR49-9.

NOTES:

- CONSTRUCTION JOINT LOCATED AT STEP IN BRIDGE SEAT. LOCATION SHALL BE REVISED AS DIRECTED BY THE RESIDENT ENGINEER AS REQUIRED TO MATCH ANY CONSTRUCTION JOINT IN THE EXISTING ABUTMENT STEM.
- FOR WINGWALL AND CHEEKWALL DIMENSIONS, DETAILS AND ELEVATIONS, SEE TYPICAL WINGWALL DETAILS, BRIDGE SHEETS C-43 AND C-44.
- BACKWALL ELEVATIONS SHOWN AT FRONT FACE OF BACKWALL.
- FOR ABUTMENT REINFORCEMENT DETAILS, SEE TYPICAL EXPANSION ABUTMENT REINFORCEMENT, BRIDGE SHEET C-40, AND TYPICAL FIXED ABUTMENT REINFORCEMENT, BRIDGE SHEET C-41.
- STEPS IN BRIDGE SEATS SHALL BE EQUIDISTANT BETWEEN STRINGERS.
- REPAIR ALL EXISTING SPALLED AND DELAMINATED AREAS ON ABUTMENT. SEE EXISTING SUBSTRUCTURE CONDITION, BRIDGE SHEETS SC-11 AND SC-12 FOR APPROXIMATE CONDITION OF EXISTING SUBSTRUCTURES. FOR CONCRETE REPAIR DETAILS, SEE SUBSTRUCTURE REPAIR DETAILS AND NOTES, BRIDGE SHEET C-45.


STATE OF VERMONT AGENCY OF TRANSPORTATION

Town Of	MIDDLESEX-BOLTON	Bridge No.	49N
Highway No.	I-89	Log Sta.	
		Surv. Sta.	
I-89 NB OVER TH 7			
<b>ABUTMENT MASONRY (49N)</b>			
Designed By	P.W. SZUSTAK	Drawn By	R.A. BOTZENHART
Checked By	J.P. HALSTEAD	Date	10/99
		Bridge Design Supervisor	J.P. HALSTEAD
PROJECT	MIDDLESEX-BOLTON	PROJECT NO.	IM-089-2(26)
TVGA CAD Drawing No.	49abmas	Date	10/99
Bridge Sheet No.	BR49-8	Sheet	82 of 307

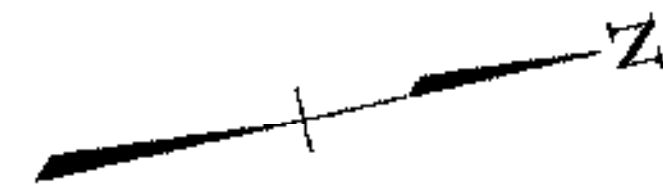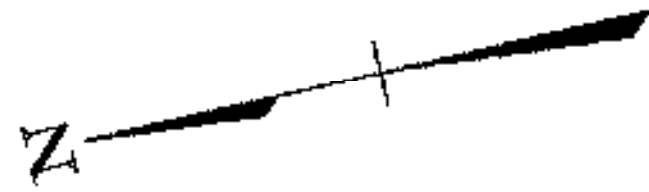


NOTE: RAISED FINISH GRADE AT BRIDGE 49S 0.05'

7. THIS APPLIES TO BRIDGES 49N AND S. THE CONTRACTOR FOR EASE OF FORMING FORMED THE BACK OF THE EXPANSION ABUTMENT STRAIGHT DOWN TO THE BOTTOM OF THE EXCAVATION. THEY INSTALLED EXTRA REBAR IN THE AREA. ALL MATERIAL AND LABOR WAS AT THE EXPENSE OF THE CONTRACTOR

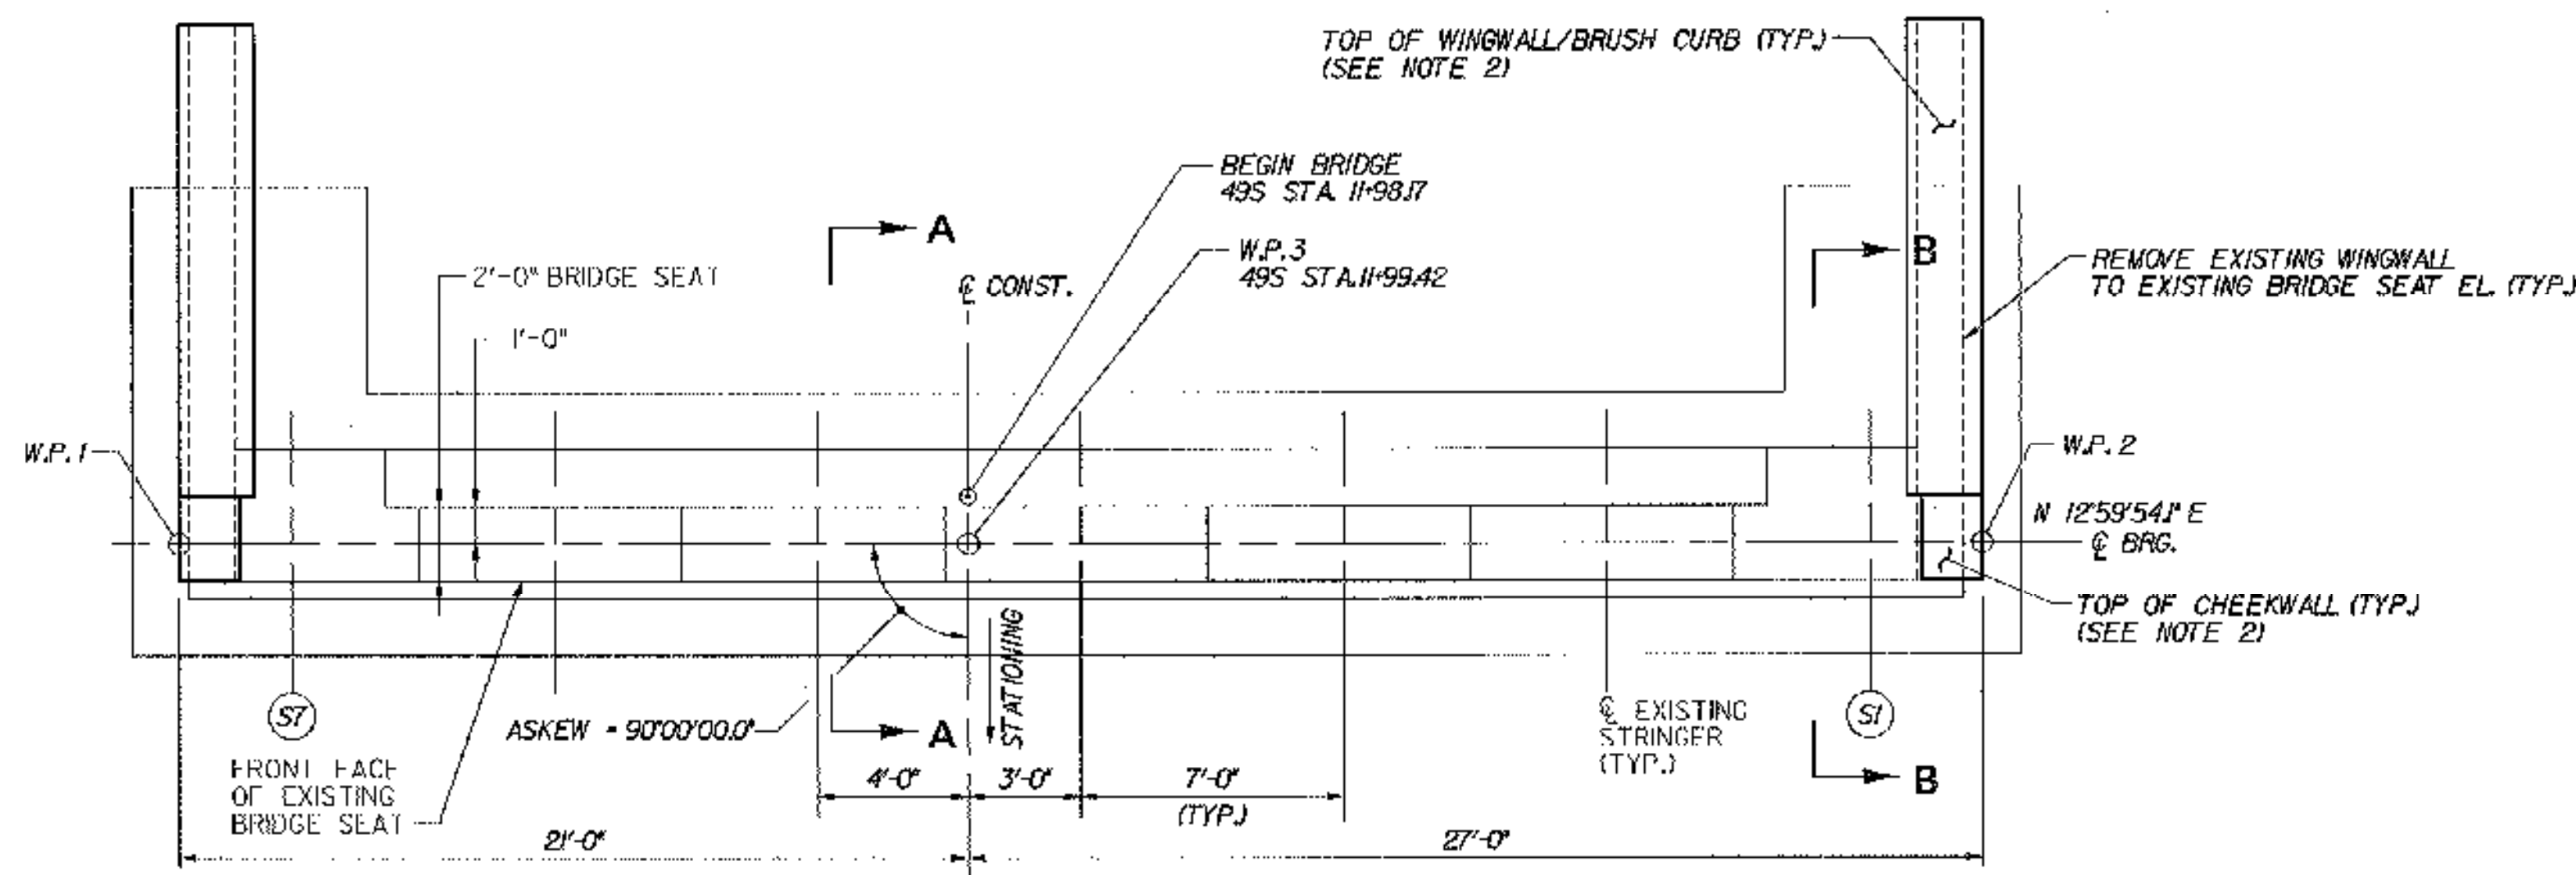


ABUTMENT 1 PLAN (FIXED)

SCALE: 1/4"=1'-0"

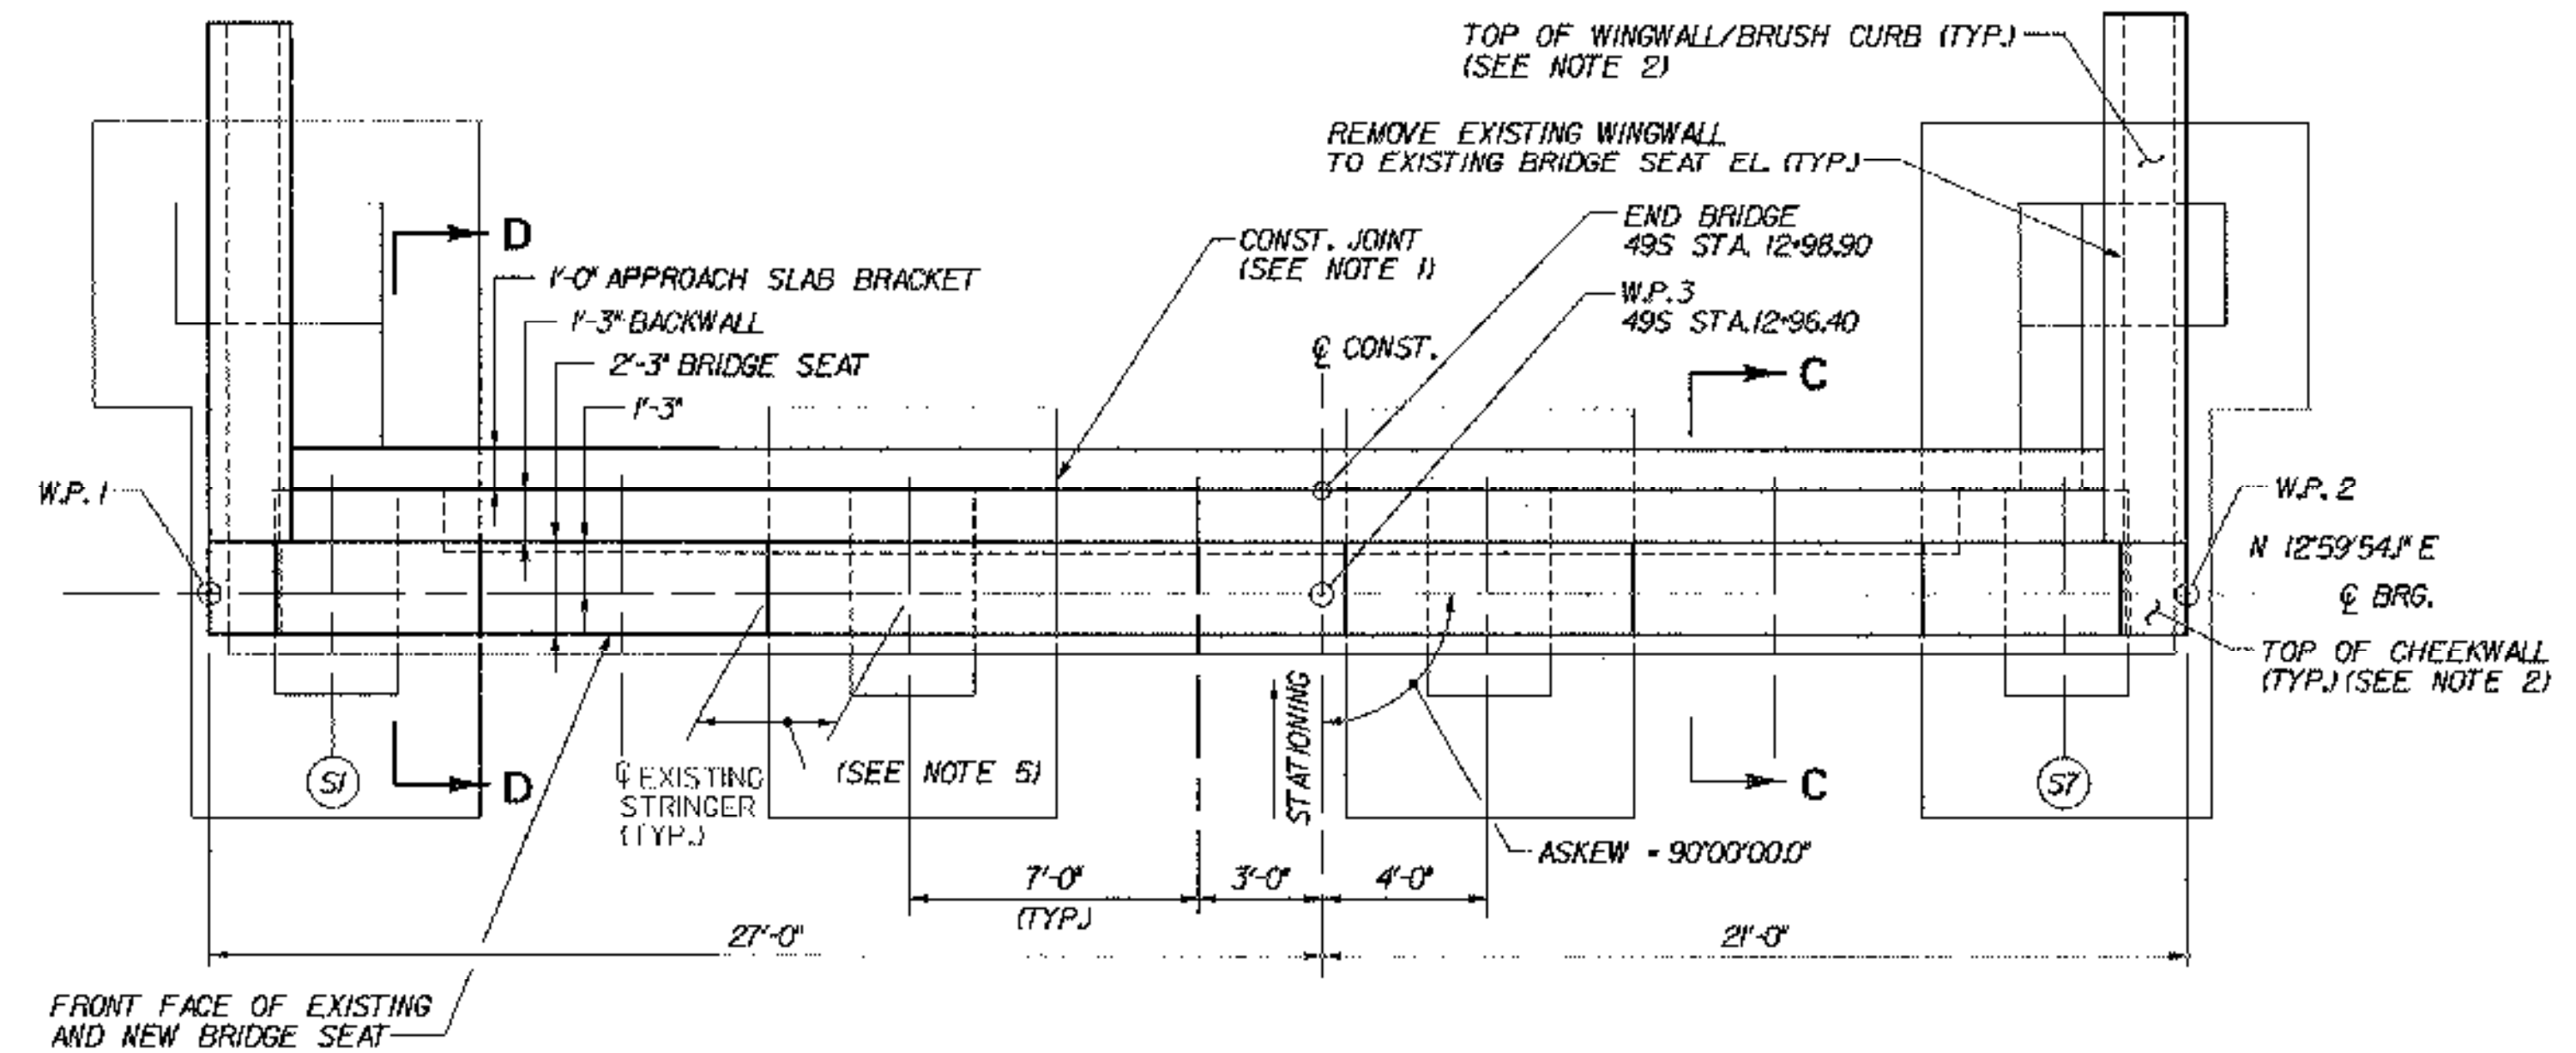


ABUTMENT 2 PLAN (EXP.)

SCALE: 1/4"=1'-0"

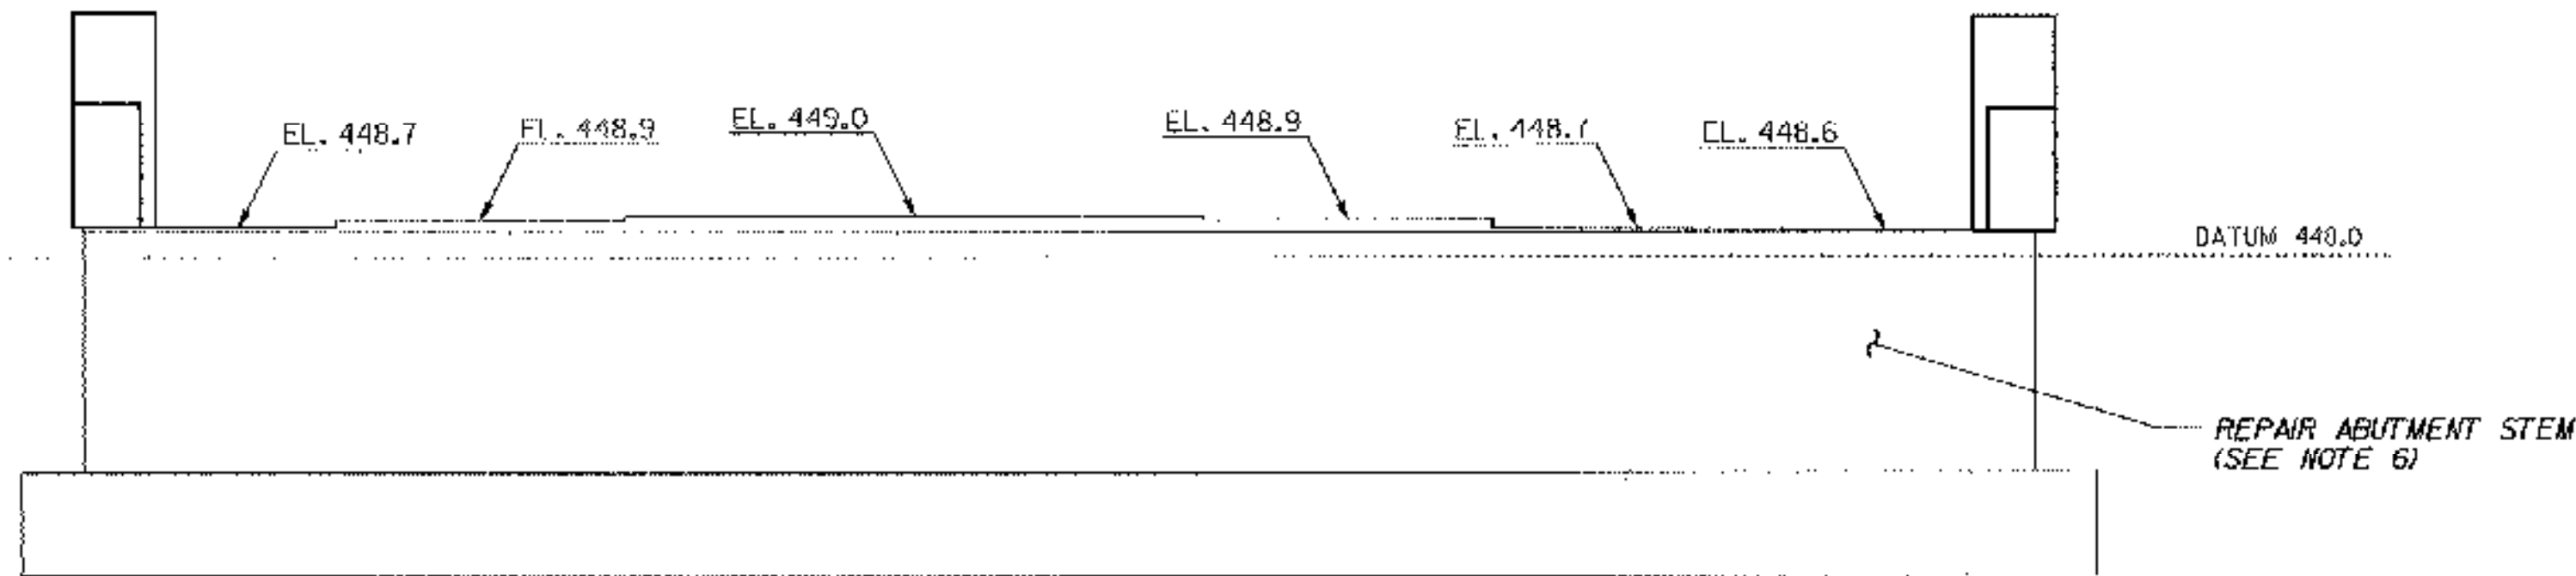

ABUTMENT 1 ELEVATION

SCALE: 1/4"=1'-0"

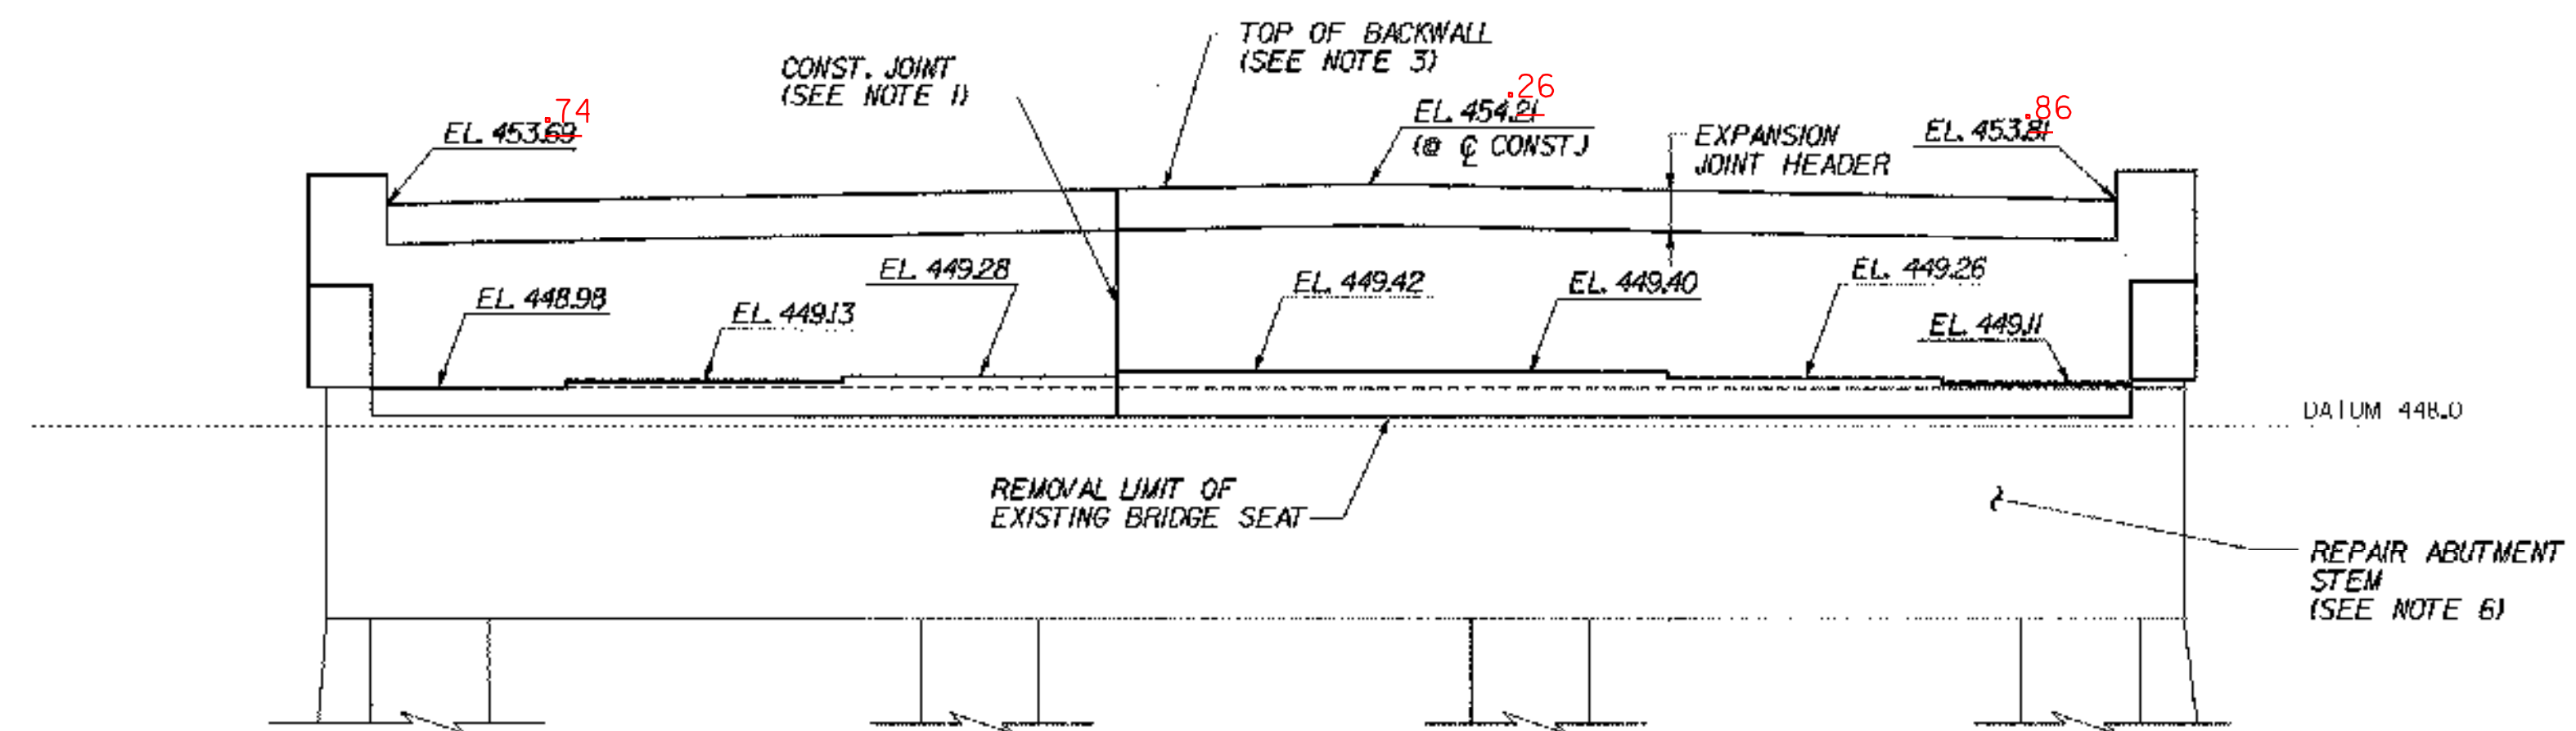


ABUTMENT 2 ELEVATION

SCALE: 1/4"=1'-0"


NOTES:

- 1. CONSTRUCTION JOINT LOCATED AT STEP IN BRIDGE SEAT. LOCATION SHALL BE REVISED AS DIRECTED BY THE RESIDENT ENGINEER AS REQUIRED TO MATCH ANY CONSTRUCTION JOINT IN THE EXISTING ABUTMENT STEM.
2. FOR WINGWALL AND CHEEKWALL DIMENSIONS, DETAILS AND ELEVATIONS, SEE TYPICAL WINGWALL DETAILS, BRIDGE SHEETS C-43 AND C-44.
3. BACKWALL ELEVATIONS SHOWN AT FRONT FACE OF BACKWALL.
4. FOR ABUTMENT REINFORCEMENT DETAILS, SEE TYPICAL EXPANSION ABUTMENT REINFORCEMENT, BRIDGE SHEET C-40, AND TYPICAL FIXED ABUTMENT REINFORCEMENT, BRIDGE SHEET C-41.
5. STEPS IN BRIDGE SEATS SHALL BE EQUIDISTANT BETWEEN STRINGERS.
6. REPAIR ALL EXISTING SPALLED AND DELAMINATED AREAS ON ABUTMENT. SEE EXISTING SUBSTRUCTURE CONDITION, BRIDGE SHEETS SC-11 AND SC-12 FOR APPROXIMATE CONDITION OF EXISTING SUBSTRUCTURES. FOR CONCRETE REPAIR DETAILS, SEE SUBSTRUCTURE REPAIR DETAILS AND NOTES, BRIDGE SHEET C-45.

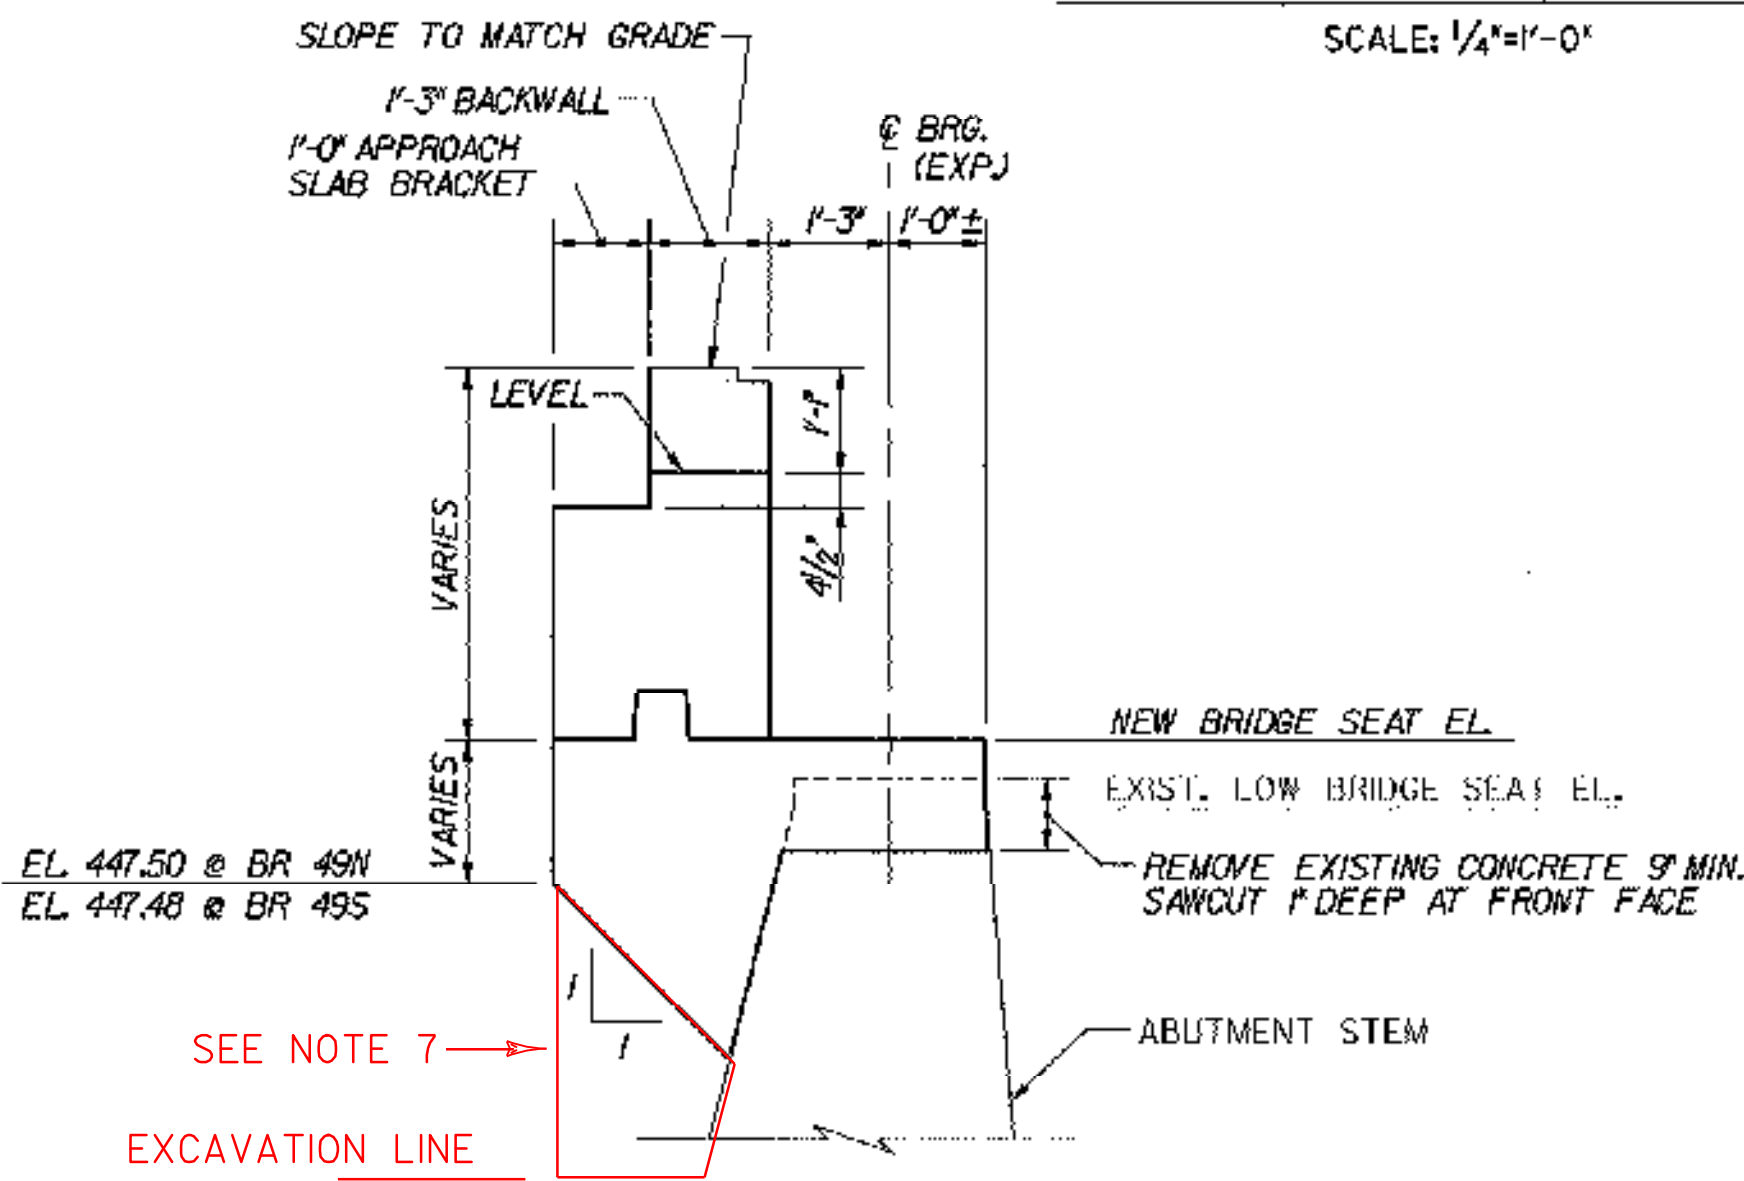

SECTION C-C

SCALE: 1/2"=1'-0"

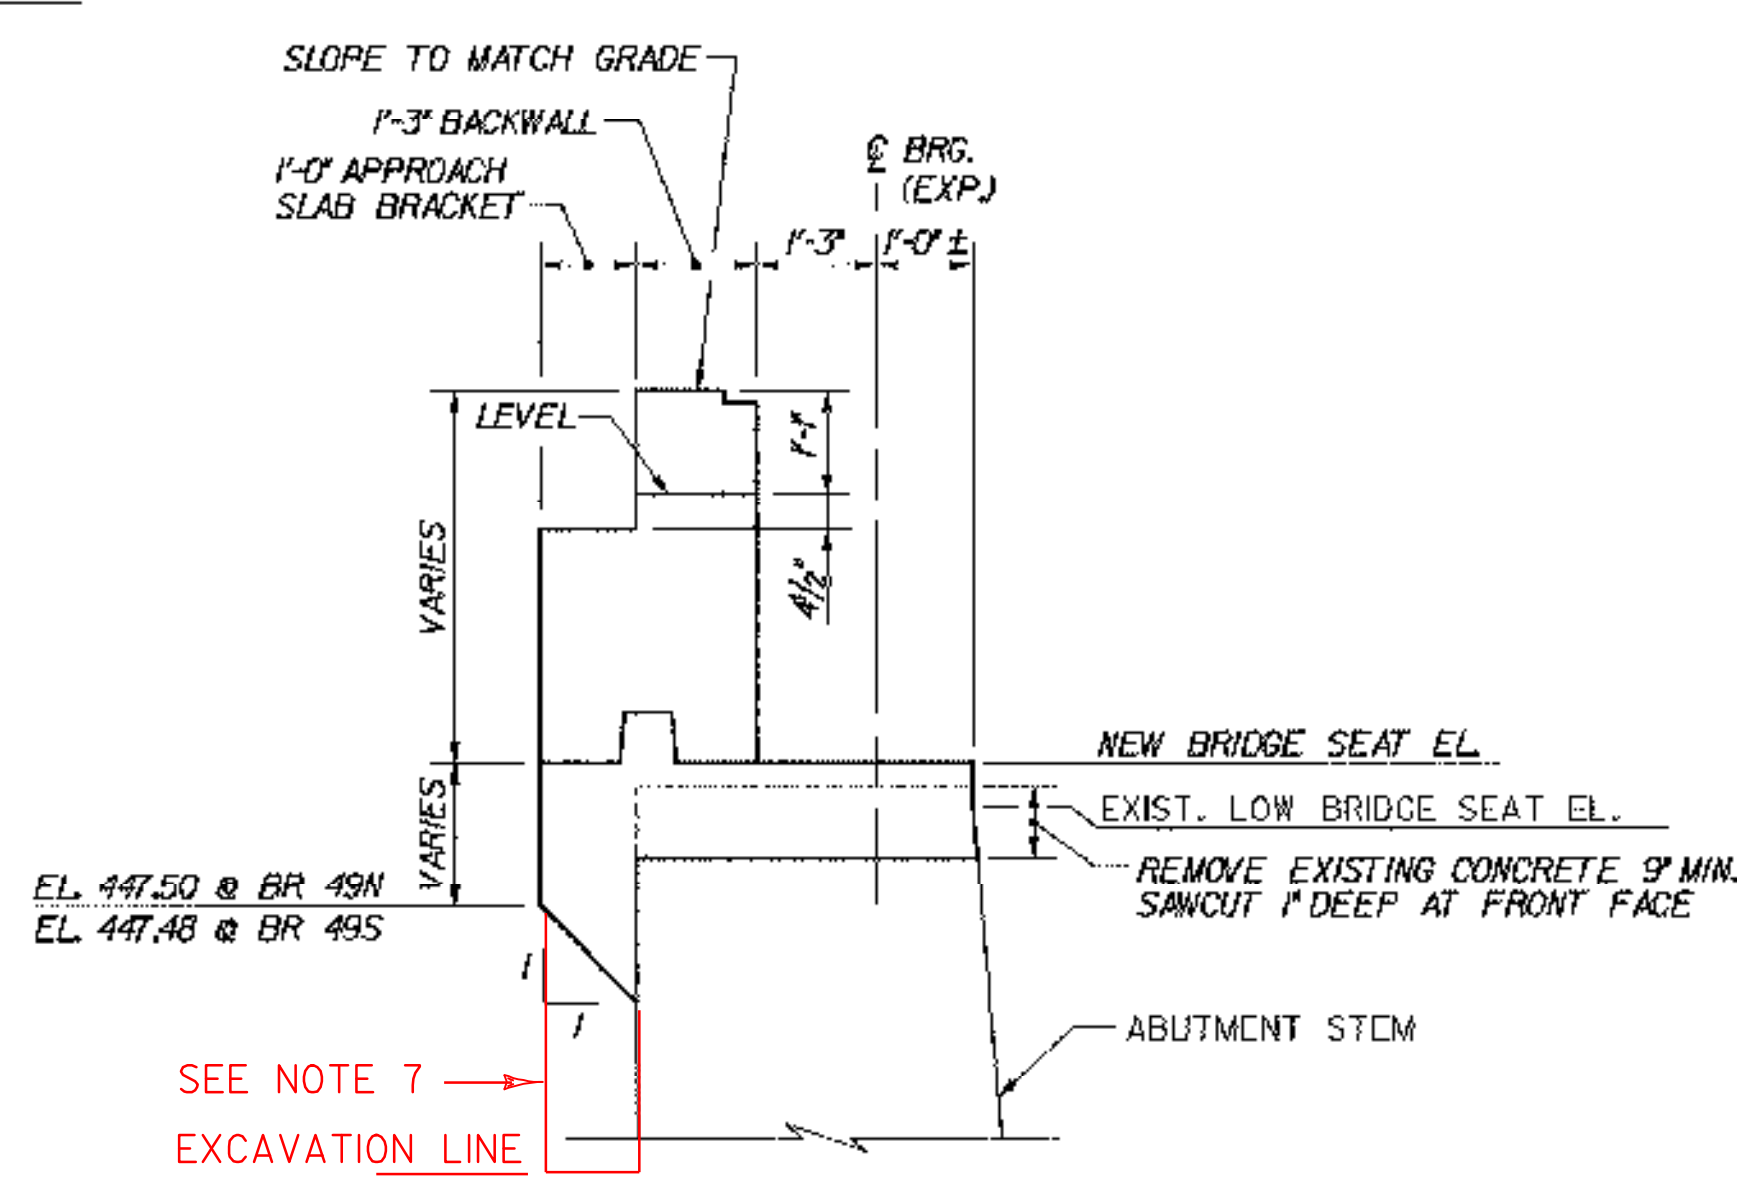

SECTION D-D

SCALE: 1/2"=1'-0"

NOTE: FOR SECTIONS A-A AND B-B, SEE ABUTMENT MASONRY (49N), BRIDGE SHEET BR49-8.

STATE OF VERMONT AGENCY OF TRANSPORTATION


Table with project information: Town Of MIDDLESEX-BOLTON, Bridge No. 49S, Highway No. I-89, Log Sta., Surv. Sta., I-89 SB OVER TH 7

ABUTMENT MASONRY (49S)

Table with design information: Designed By P.W. SZUSTAK, Drawn By R.A. BOTZENHART, Checked By J.P. HALSTEAD, Date 10/99, Bridge Design Supervisor J.P. HALSTEAD, Date 10/99


Table with project details: PROJECT MIDDLESEX-BOLTON, PROJECT NO. IM-089-2(26)

Table with drawing info: TYGA CAD Drawing No. 49abms, Date 10/99, Bridge Sheet No. BR49-9, Sheet 83 of 307

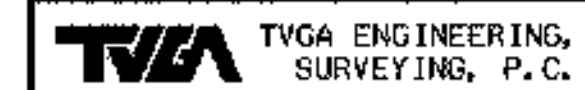

BRIDGE 49 NORTH																	
ITEM	NO. OF PIECES	SIZE	LENGTH	MARK	TYPE	A	B	C	D	E	F	G	H	J	K	R	O
APPROACH SLAB 1 (49N)																	
1																	
2	22	5	30'-0"	E1A501	STR.												
3	22	5	15'-6"	E1A502	STR.												
4	23	8	2'-6"	E1A501	19			0'-10"	1'-8"	0'-0"							2'-3"
5	55	9	20'-9"	E1A501	1	1'-3"	19'-6"						0'-0"			1'-0"	
6																	
APPROACH SLAB 2 (49N)																	
7	22	5	30'-0"	E2A501	STR.												
8	22	5	15'-6"	E2A502	STR.												
9	23	8	2'-6"	E2A501	19			0'-10"	1'-8"	0'-0"							2'-3"
10	55	9	20'-9"	E2A501	1	1'-3"	19'-6"						0'-0"			1'-0"	
11																	
SUPERSTRUCTURE (49N)																	
12	403	5	34'-4"	ES501	STR.												
13	198	5	21'-4"	ES502	STR.												
14	276	5	4'-11"	ES503	S5	0'-6"	1'-3"	1'-5"	1'-3"				0'-6"				
15	2	5	28'-4"	ES511	STR.												
16	2	5	21'-4"	ES512	STR.												
17	42	5	5'-5 1/2"	ES513	16	0'-10"	1'-6"	0'-11 1/2"	2'-2"				0'-0"			2'-2"	
18	18	5	6'-6"	ES514	STR.												
19	6	5	2'-6"	ES515	STR.												
20	198	5	28'-4"	ES516	STR.												
21	198	5	17'-10"	ES517	STR.												
22	198	5	31'-10"	ES518	STR.												
23																	
CURTAIN WALL (49N)																	
24	30	5	6'-6"	ECW504	STR.												
25	31	5	12'-6"	ECW505	S5	2'-2"	3'-10"	0'-10"	3'-6"							2'-2"	
26	45	5	2'-11"	ECW506	1	0'-7"	1'-9"									0'-7"	
27	12	5	3'-11"	ECW507	STR.												
28	17	5	23'-3"	ECW508	STR.												
29	2	5	4'-7"	ECW509	S5	1'-3"	0'-10"	0'-9"	0'-6"							1'-3"	
30	2	5	10'-7"	ECW510	S5	2'-2"	3'-0"	0'-10"	2'-5"							2'-2"	
31	2	5	4'-7"	ECW511	S5	1'-3"	0'-10"	0'-9"	0'-6"							1'-3"	
32																	
ABUTMENT 1 (49N)																	
33	11	5	12'-0"	E2A512	STR.												
34	12	5	11'-9"	E2A513	STR.												
35	6	5	6'-1"	E2A515	17		2'-6"	1'-1"	2'-6"								
36	27	5	8'-6"	E2A517	17		3'-6"	1'-6"	3'-6"								
37	27	5	4'-6"	E2A518	17		1'-6"	3'-0"	0'-0"								
38	78	5	5'-6"	E2A519	17		1'-6"	4'-0"	0'-0"								
39	11	5	11'-6"	E2A520	STR.												
40																	
ABUTMENT 2 (49N)																	
41	19	5	24'-0"	E2A501	STR.												
42	19	5	14'-3"	E2A502	STR.												
43	45	5	6'-9"	E2A503	21	0'-7"	4'-0"	2'-2"								0'-5"	
44	37	5	7'-3"	E2A504	19		3'-3"	4'-0"	0'-0"								6'-4"
45	45	5	3'-9"	E2A505	STR.												
46	45	5	8'-6"	E2A506	S10		3'-4"	1'-10"	3'-4"								
47	45	5	5'-10"	E2A507	17		2'-6"	0'-10"	2'-6"								
48	90	5	3'-7"	E2A508	17		1'-6"	2'-1"	0'-0"								
49	4	5	6'-3"	E2A509	19		2'-3"	4'-0"	0'-0"								5'-7"
50	4	5	6'-3"	E2A510	19		2'-3"	4'-0"	0'-0"								5'-7"
51	17	5	7'-8"	E2A511	STR.												
52	23	5	12'-0"	E2A512	STR.												
53	6	5	4'-6"	E2A513	STR.												
54	6	5	4'-6"	E2A514	STR.												
55	6	5	5'-1"	E2A515	17		2'-0"	1'-1"	2'-0"								
56	6	5	5'-0"	E2A516	17		2'-6"	2'-6"	0'-0"								
57	28	5	8'-6"	E2A517	17		3'-6"	1'-6"	3'-6"								
58	28	5	4'-6"	E2A518	17		1'-6"	3'-0"	0'-0"								
59	80	5	5'-6"	E2A519	17		1'-6"	4'-0"	0'-0"								
60	10	5	12'-0"	E2A520	STR.												
61	6	5	5'-0"	E2A521	17		2'-6"	2'-6"	0'-0"								
62	18	5	8'-0"	E2A522	STR.												
63	25	5	9'-3"	E2A524	STR.												
64	10	10	7'-3"	E2A525	STR.												
65																	
66																	
BRIDGE 49 SOUTH																	
ITEM	NO. OF PIECES	SIZE	LENGTH	MARK	TYPE	A	B	C	D	E	F	G	H	J	K	R	O
APPROACH SLAB 1 (49S)																	
1																	
2	22	5	30'-0"	E1A501	STR.												
3	22	5	15'-6"	E1A502	STR.												
4	23	8	2'-6"	E1A501	19			0'-10"	1'-8"	0'-0"							2'-3"
5	55	9	20'-9"	E1A501	1	1'-3"	19'-6"						0'-0"			1'-0"	
6																	
APPROACH SLAB 2 (49S)																	
7	22	5	30'-0"	E2A501	STR.												
8	22	5	15'-6"	E2A502	STR.												
9	23	8	2'-6"	E2A501	19			0'-10"	1'-8"	0'-0"							2'-3"
10	55	9	20'-9"	E2A501	1	1'-3"	19'-6"						0'-0"			1'-0"	
11																	
SUPERSTRUCTURE (49S)																	
12	402	5	34'-4"	ES501	STR.												
13	198	5	21'-4"	ES502	STR.												
14	276	5	4'-11"	ES503	S5	0'-6"	1'-3"	1'-5"	1'-3"				0'-6"				
15	2	5	28'-4"	ES511	STR.												
16	2	5	21'-4"	ES512	STR.												
17	42	5	5'-5 1/2"	ES513	16	0'-10"	1'-6"	0'-11 1/2"	2'-2"				0'-0"			2'-2"	
18	19	5	6'-6"	ES514	STR.												
19	6	5	2'-6"	ES515	STR.												
20	198	5	28'-4"	ES516	STR.												
21	198	5	17'-10"	ES517	STR.												
22	198	5	31'-10"	ES518	STR.												
23																	
CURTAIN WALL (49S)																	
24	31	5	6'-6"	ECW504	STR.												
25	30	5	12'-6"	ECW505	S5	2'-2"	3'-10"	0'-10"	3'-6"							2'-2"	
26	45	5	2'-11"	ECW506	1	0'-7"	1'-9"									0'-7"	
27	12	5	3'-11"	ECW507	STR.												
28	17	5	23'-3"	ECW508	STR.												
29	2	5	4'-7"	ECW509	S5	1'-3"	0'-10"	0'-9"	0'-6"							1'-3"	
30	2	5	10'-7"	ECW510	S5	2'-2"	3'-0"	0'-10"	2'-5"							2'-2"	
31	2	5	4'-7"	ECW511	S5	1'-3"	0'-10"	0'-9"	0'-6"							1'-3"	
32																	
ABUTMENT 1 (49S)																	
33	12	5	12'-0"	E2A512	STR.												
34	11	5	11'-9"	E2A513	STR.												
35	6	5	6'-1"	E2A515	17		2'-6"	1'-1"	2'-6"								
36	28	5	8'-6"	E2A517	17		3'-6"	1'-6"	3'-6"								
37	27	5	4'-6"	E2A518	17		1'-6"	3'-0"	0'-0"								
38	78	5	5'-6"	E2A519	17		1'-6"	4'-0"	0'-0"								
39																	

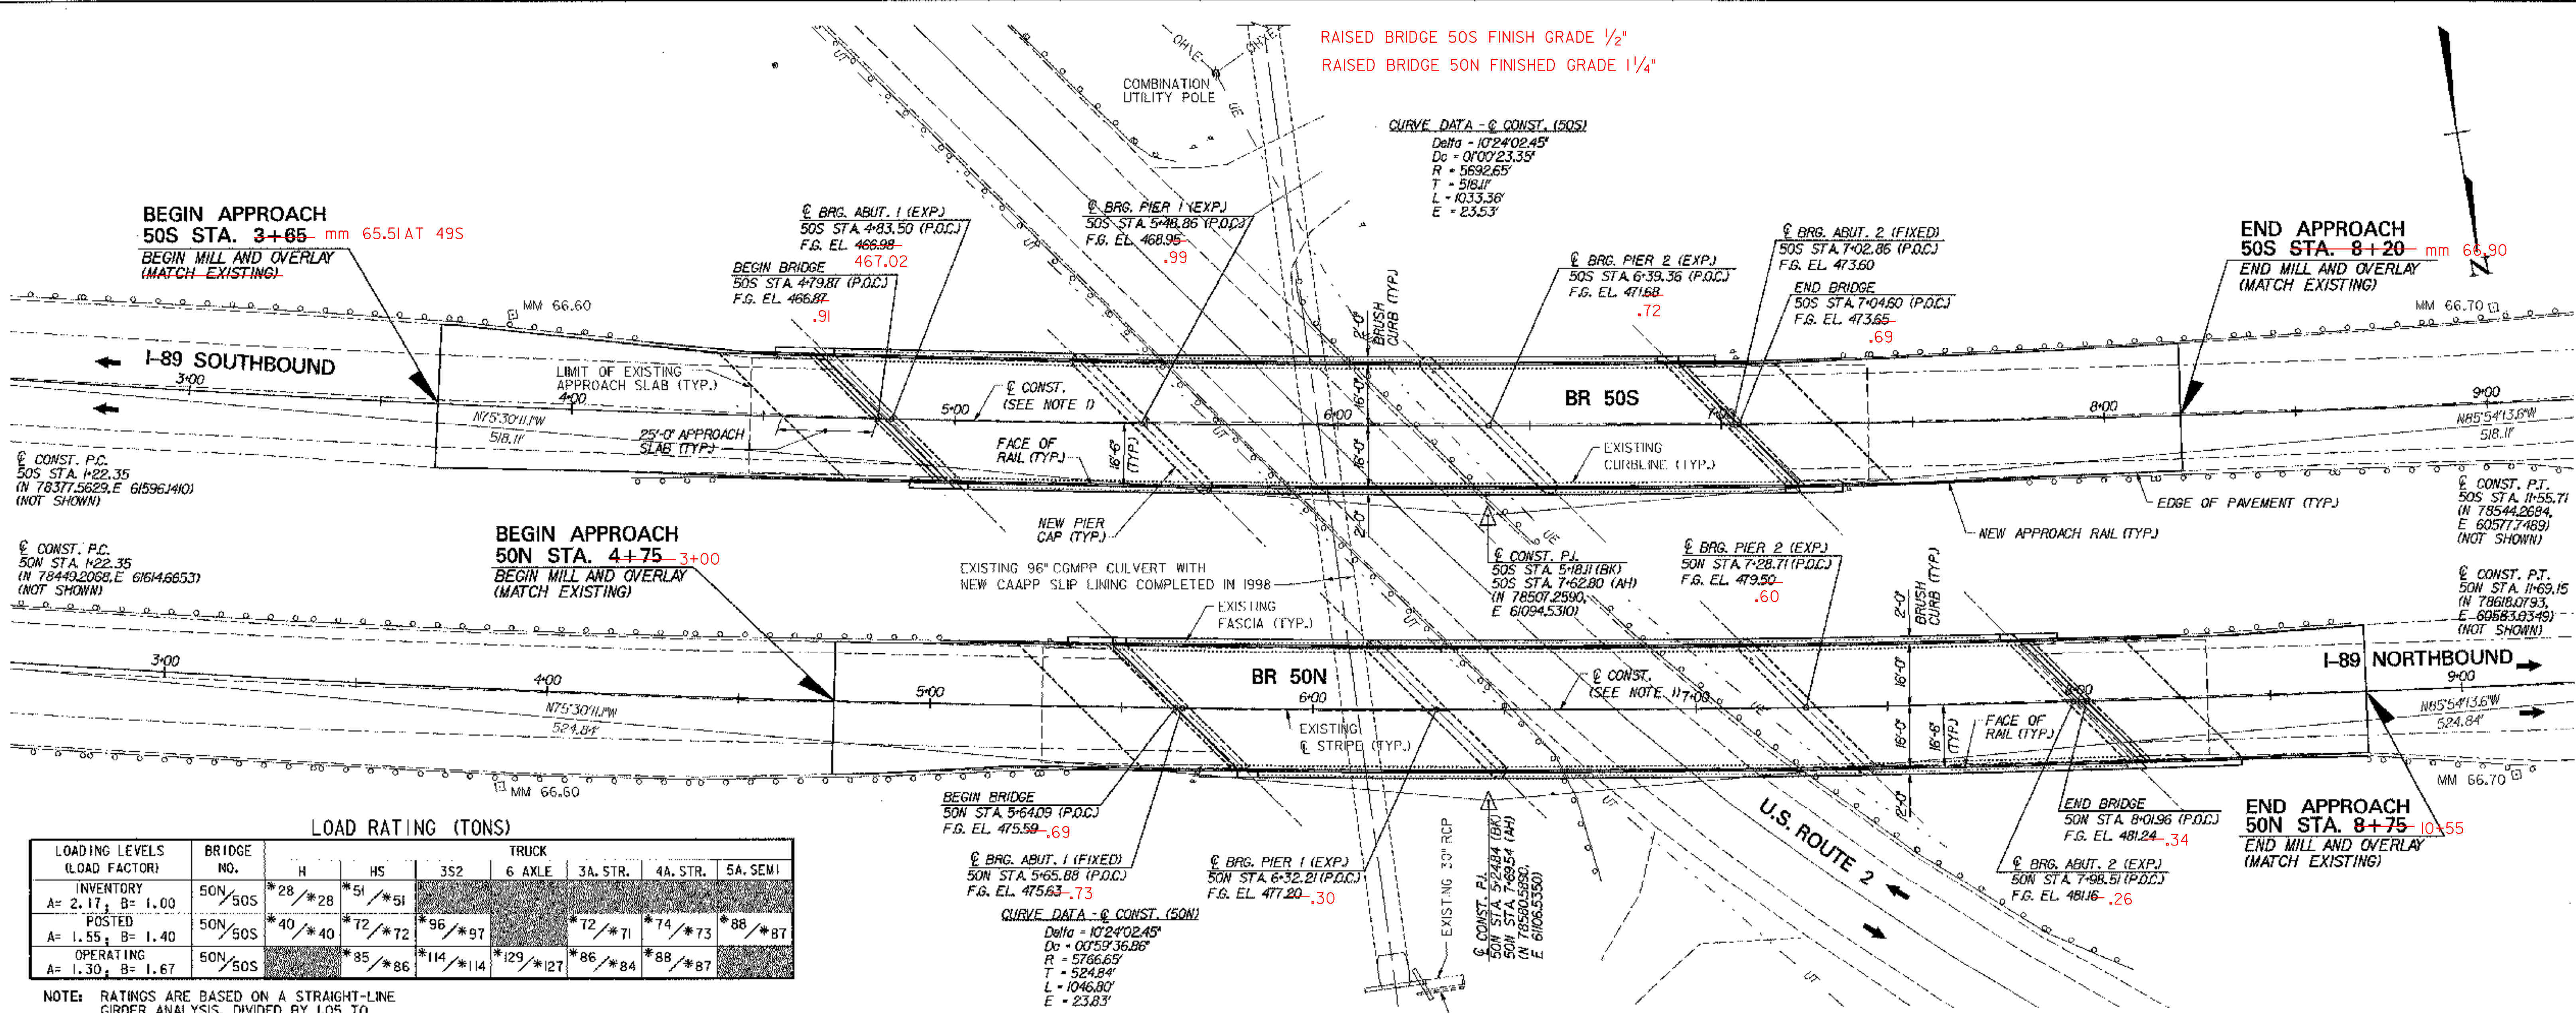

RAISED BRIDGE 50S FINISH GRADE 1/2"  
 RAISED BRIDGE 50N FINISHED GRADE 1 1/4"

CURVE DATA - @ CONST. (50S)  
 Delta = 102°40'24.5"  
 Dc = 0°00'23.35"  
 R = 5692.65'  
 T = 516.11'  
 L = 1033.36'  
 E = 23.53'

BEGIN APPROACH  
 50S STA. 3+65 - mm 65.51 AT 49S  
 BEGIN MILL AND OVERLAY  
 (MATCH EXISTING)

END APPROACH  
 50S STA. 8+20 - mm 66.90  
 END MILL AND OVERLAY  
 (MATCH EXISTING)

BEGIN APPROACH  
 50N STA. 4+75 - 3+00  
 BEGIN MILL AND OVERLAY  
 (MATCH EXISTING)

END APPROACH  
 50N STA. 8+75 - 10+55  
 END MILL AND OVERLAY  
 (MATCH EXISTING)

LOAD RATING (TONS)

LOADING LEVELS (LOAD FACTOR)	BRIDGE NO.	TRUCK						
		H	HS	3S2	6 AXLE	3A. STR.	4A. STR.	5A. SEMI
INVENTORY A= 2.17, B= 1.00	50N/50S	*28/*28	*51/*51					
POSTED A= 1.55, B= 1.40	50N/50S	*40/*40	*72/*72	*96/*97		*72/*71	*74/*73	*88/*87
OPERATING A= 1.30, B= 1.67	50N/50S	*85/*86	*114/*114	*129/*127		*86/*84	*88/*87	

NOTE: RATINGS ARE BASED ON A STRAIGHT-LINE GIRDER ANALYSIS, DIVIDED BY LOS TO ACCOUNT FOR THE EFFECTS OF CURVATURE.


STRENGTH RF =  $\frac{\phi M_N - 1.3 M_{DL}}{A X M_{ULH}}$  \* SERVICEABILITY RF =  $B \frac{0.95 F_y S_{LL1} - M_{DL} \frac{S_{LL1}}{S_{DL}} - M_{SDL} \frac{S_{LL1}}{S_{SDL}}}{1.87 M_{ULH}}$

PLAN  
 SCALE: 1"=20'


BR 50N&S SPECIFIC CONSTRUCTION NOTES:

1. THE PROPOSED CONSTRUCTION CENTERLINE FOR EACH BRIDGE WAS ESTABLISHED BASED ON BEST FIT BETWEEN EXISTING CURB LINES. IT DOES NOT EXACTLY MATCH THE ORIGINAL CONSTRUCTION CENTERLINE.
2. FOR CONTROL POINT TIE SKETCHES, SEE CONTROL POINT TIES (50N&S), BRIDGE SHEET C-12.
3. REPLACE PIER CAPS, SUPERSTRUCTURE STEEL, BEARINGS, DECK SLABS, APPROACH SLABS, BRIDGE RAIL AND APPROACH RAIL. RESET GUARD RAIL.
4. NEW SCUPPERS ARE REQUIRED ON BRIDGE 50S. FOR LOCATION OF NEW SCUPPERS, SEE FRAMING PLAN (50S), BRIDGE SHEET BR50-9.
5. CONSTRUCT NEW BACKWALLS AT EXPANSION ABUTMENTS AND NEW CURTAINWALLS AT FIXED ABUTMENTS. REBUILD ABUTMENT BRIDGE SEATS AND MODIFY WINGWALLS AS SHOWN IN THE PLANS.
6. REPAIR PIER COLUMNS.
7. REPAIR ABUTMENT DELAMINATED AND SPALLED AREAS.
8. RE-STRIPE BRIDGE AND APPROACH ROADWAY.

TABLE OF BRIDGE COORDINATES				
BRIDGE	CL CONST. @	STATION	NORTHING	EASTING
50N	BEGIN BRIDGE	5+54.09	78543.3058	61183.1758
	CL BRG. ABUT. 1	5+95.86	78543.6203	61181.4100
	CL BRG. PIER 1	6+32.21	78554.8653	61118.0405
	CL BRG. PIER 2	7+28.71	78569.8306	61020.7170
	CL BRG. ABUT. 2	7+98.51	78579.7462	60951.6182
50S	END BRIDGE	8+01.96	78580.2116	60948.2039
	BEGIN BRIDGE	4+79.87	78456.1358	61247.4208
	CL BRG. ABUT. 1	4+93.50	78456.8211	61243.8550
	CL BRG. PIER 1	5+48.86	78468.7890	61179.5867
	CL BRG. PIER 2	6+39.36	78484.0929	61090.4046
50S	CL BRG. ABUT. 2	7+02.86	78493.9977	61027.6820
	END BRIDGE	7+04.60	78484.2590	61025.9573

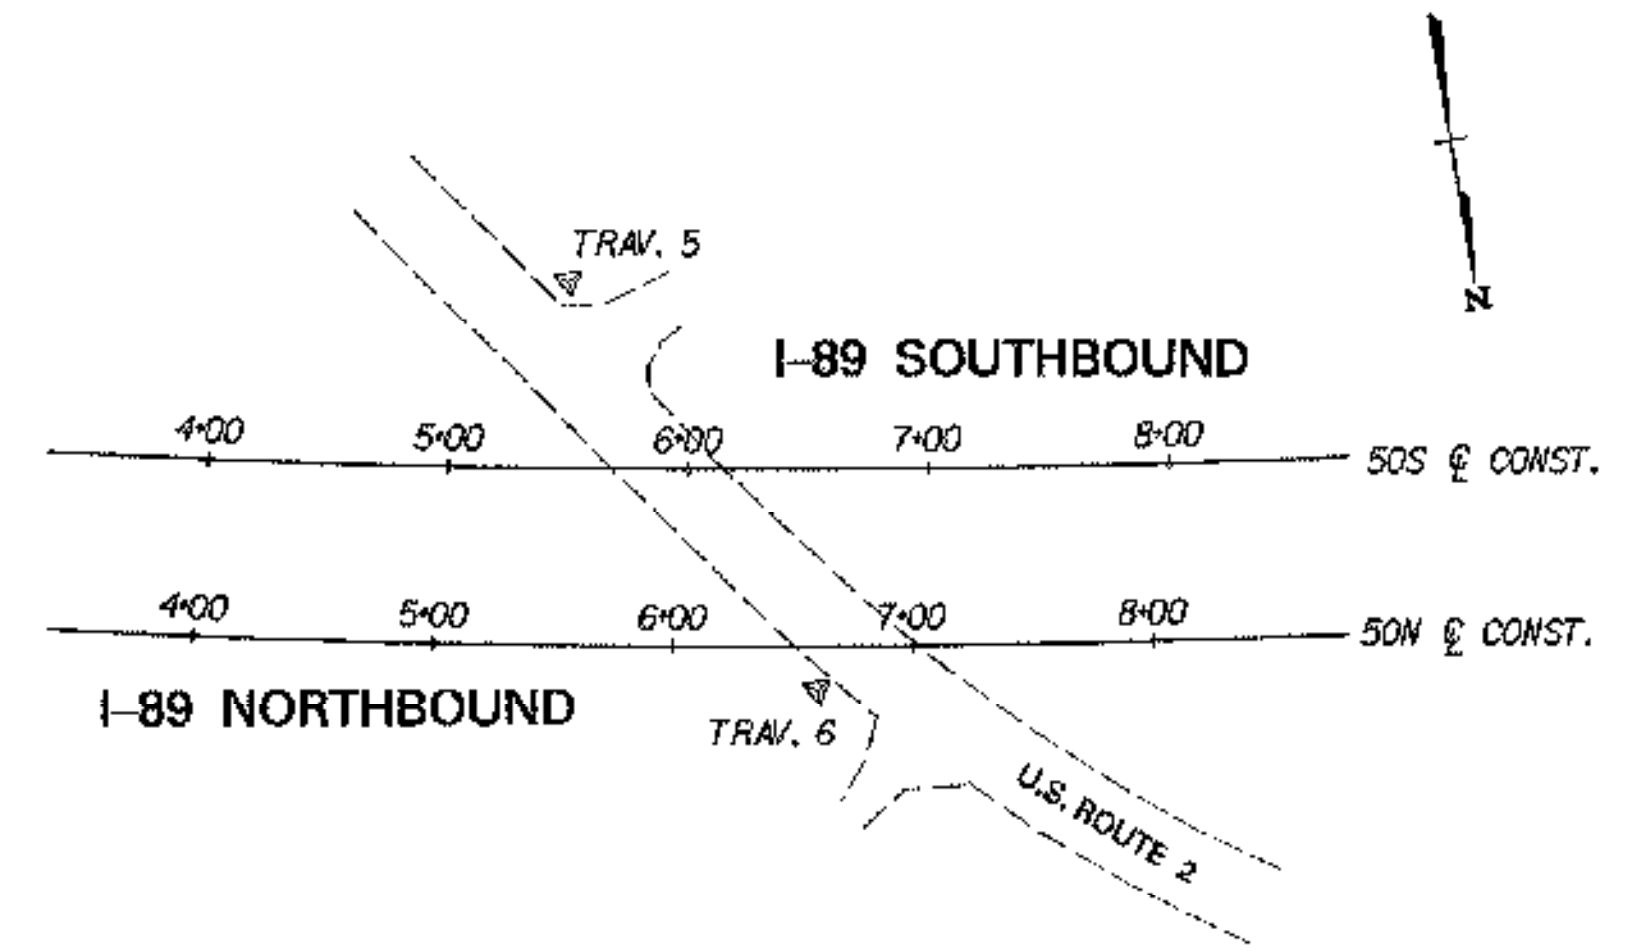

CONTROL POINT LOCATION MAP  
 N.T.S.  
 (SEE NOTE 2)

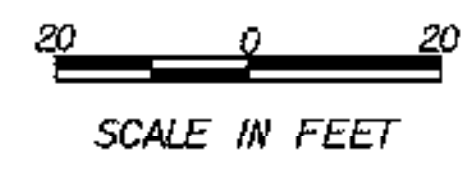

**STATE OF VERMONT  
 AGENCY OF TRANSPORTATION**



Town Of MIDDLESEX-BOLTON Bridge No. **50N&S**  
 Highway No. I-89 Log Sta.   
 Surv. Sta.   
**I-89 OVER U.S. ROUTE 2**

**GENERAL PLAN (50N&S)**

Designed By P.W. SZUSTAK Drawn By R.A. BOTZEMHART  
 Checked By J.P. HALSTEAD Date 10/99 Bridge Design Supervisor  
 J.P. HALSTEAD Date 10/99 J.P. HALSTEAD Date 10/99

PROJECT MIDDLESEX-BOLTON PROJECT NO. IM-089-2(26)  
 IVGA CAD Drawing No. 50gen.pl Date 10/99  
 Bridge Sheet No. **BR50-1** Sheet 85 of 307


RAISED BRIDGE 50N FINISH GRADE 1/4"

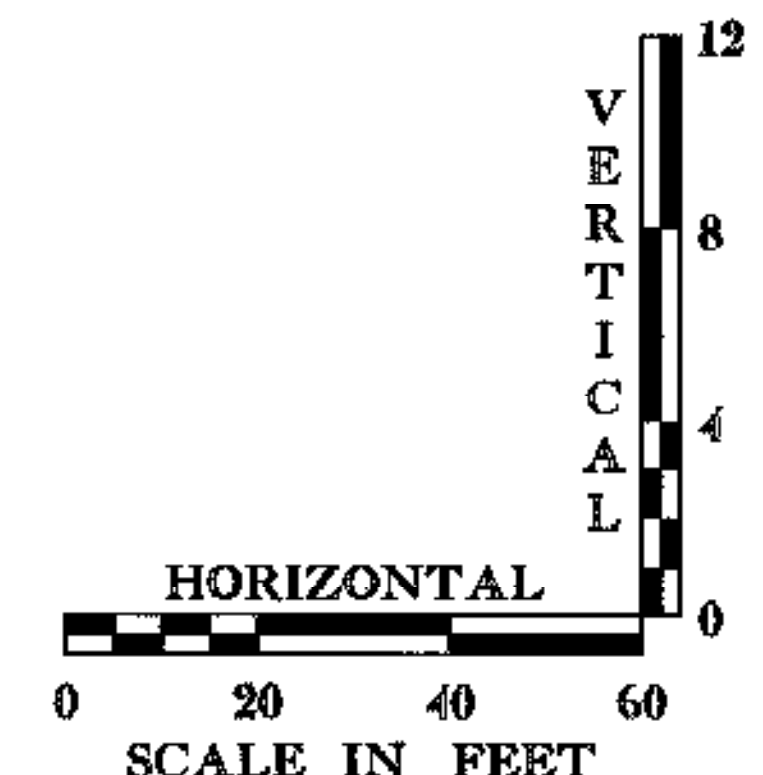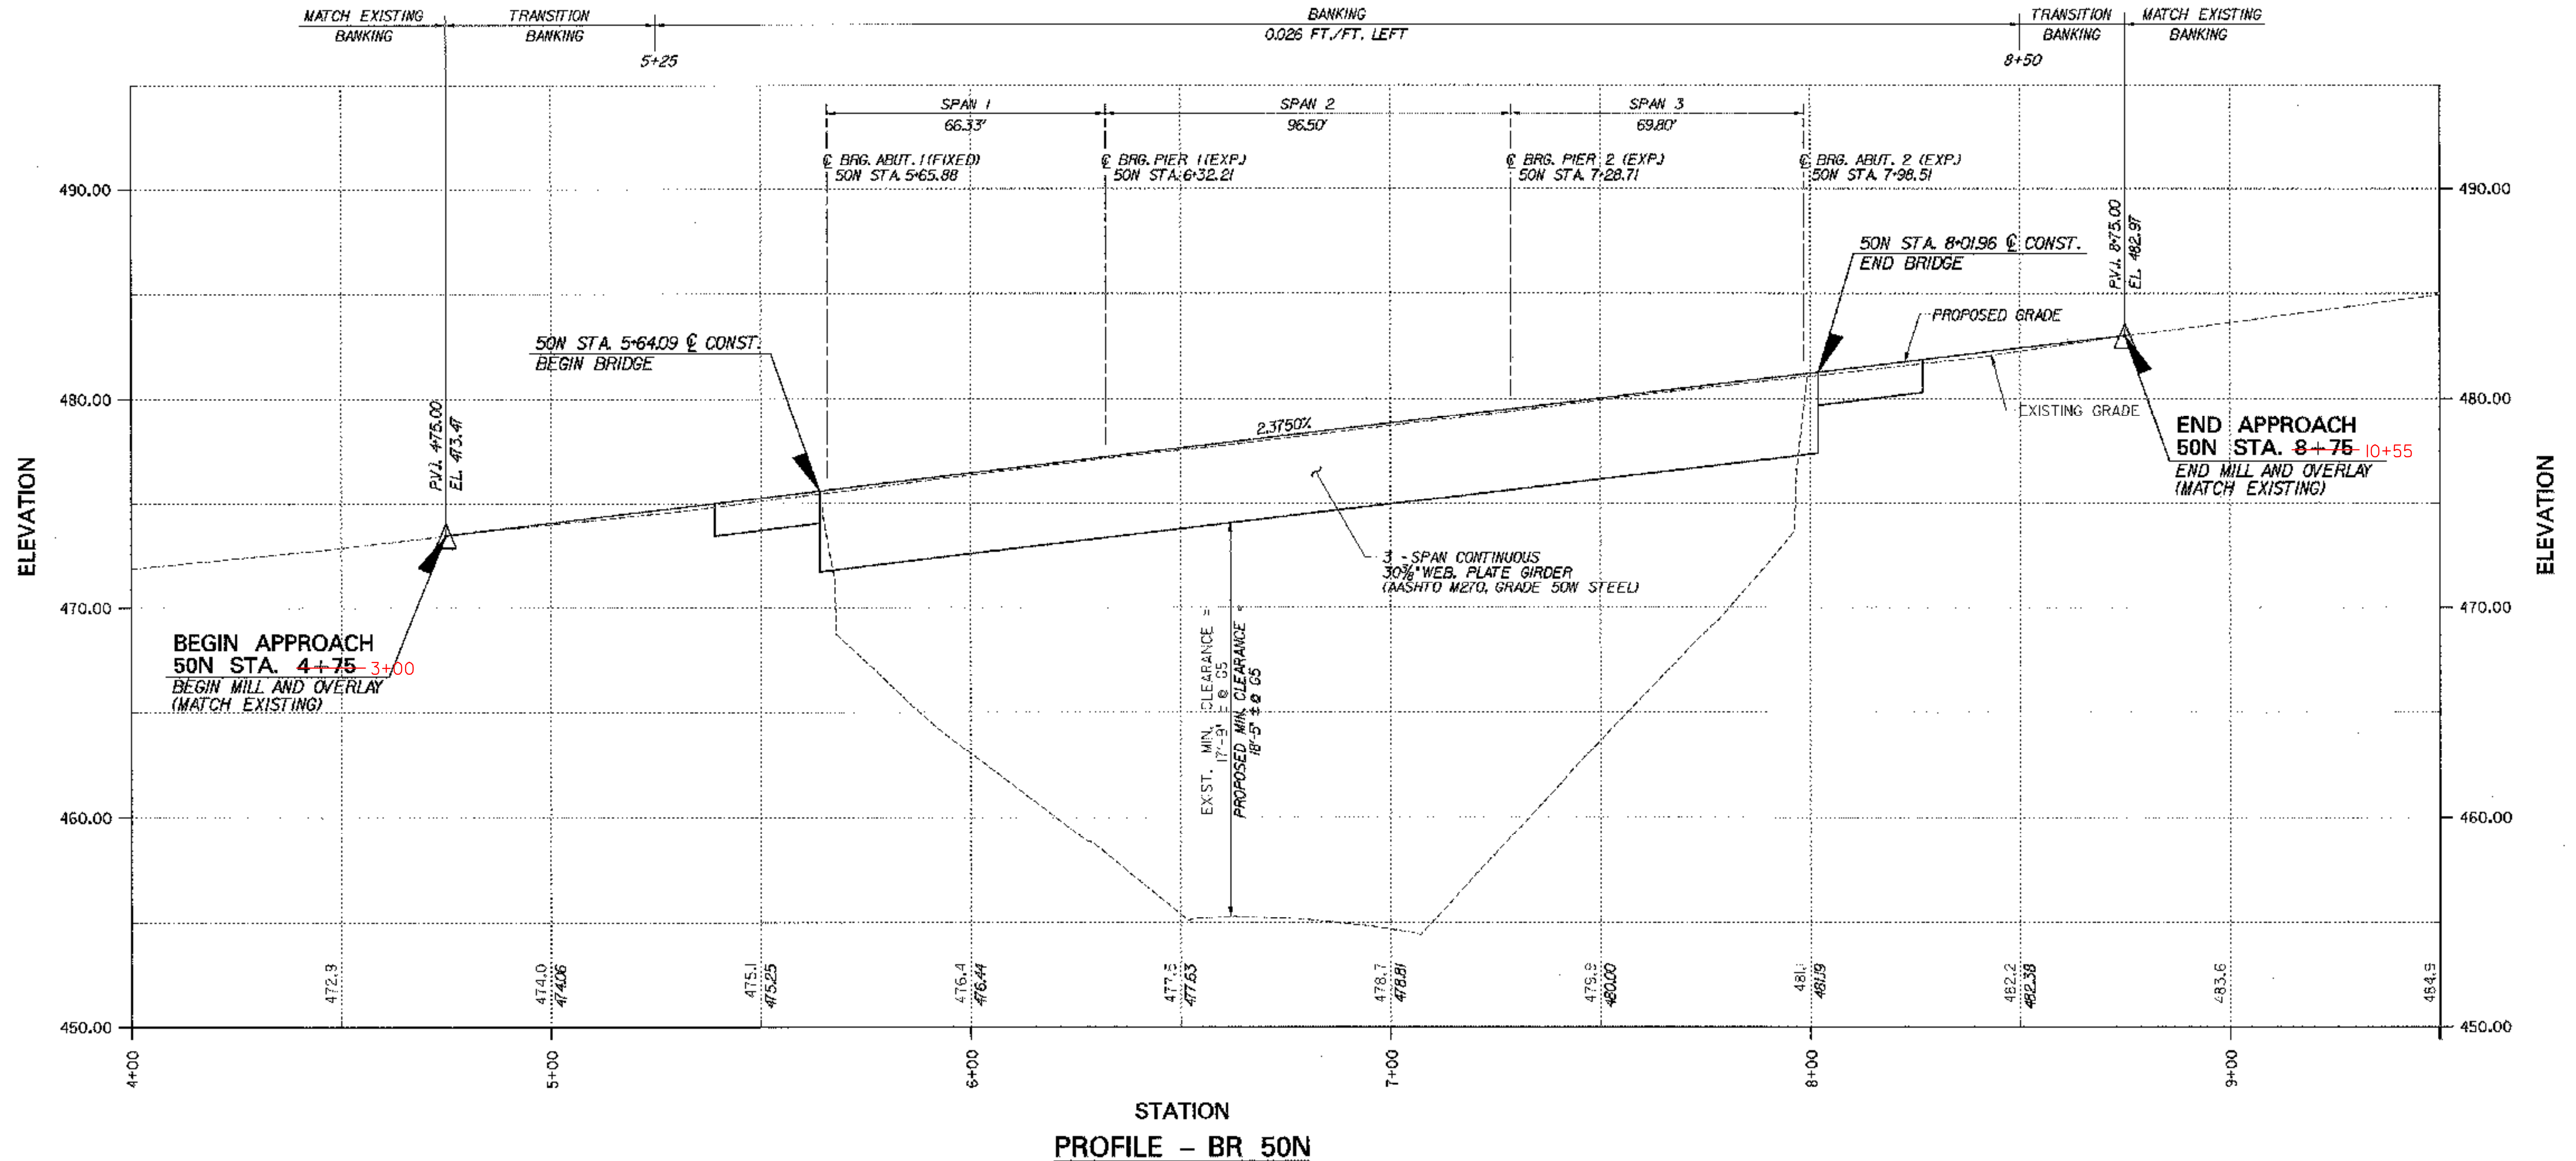


<b>STATE OF VERMONT AGENCY OF TRANSPORTATION</b>	
Town Of <b>MIDDLESEX-BOLTON</b>	Bridge No. <b>50N</b>
Highway No. <b>I-89</b>	Log Sta. Surv. Sta.
<b>I-89 NB OVER U.S. ROUTE 2</b>	
<b>PROFILE (50N)</b>	
Designed By <b>P.W. SZUSTAK</b>	Drawn By <b>R.A. BOTZENHART</b>
Checked By <b>J.P. HALSTEAD</b>	Bridge Design Supervisor
Date <b>10/99</b>	Date <b>10/99</b>
PROJECT <b>MIDDLESEX-BOLTON</b>	PROJECT NO. <b>IM-089-2(26)</b>
TVGA CAD Drawing No. <b>50nprof</b>	Date <b>10/99</b>
Bridge Sheet No. <b>BR50-2</b>	Sheet <b>86</b> of <b>307</b>

**TVGA** TVGA ENGINEERING,  
SURVEYING, P. C.

RAISED BRIDGE 50S FINISH GRADE 1/2"

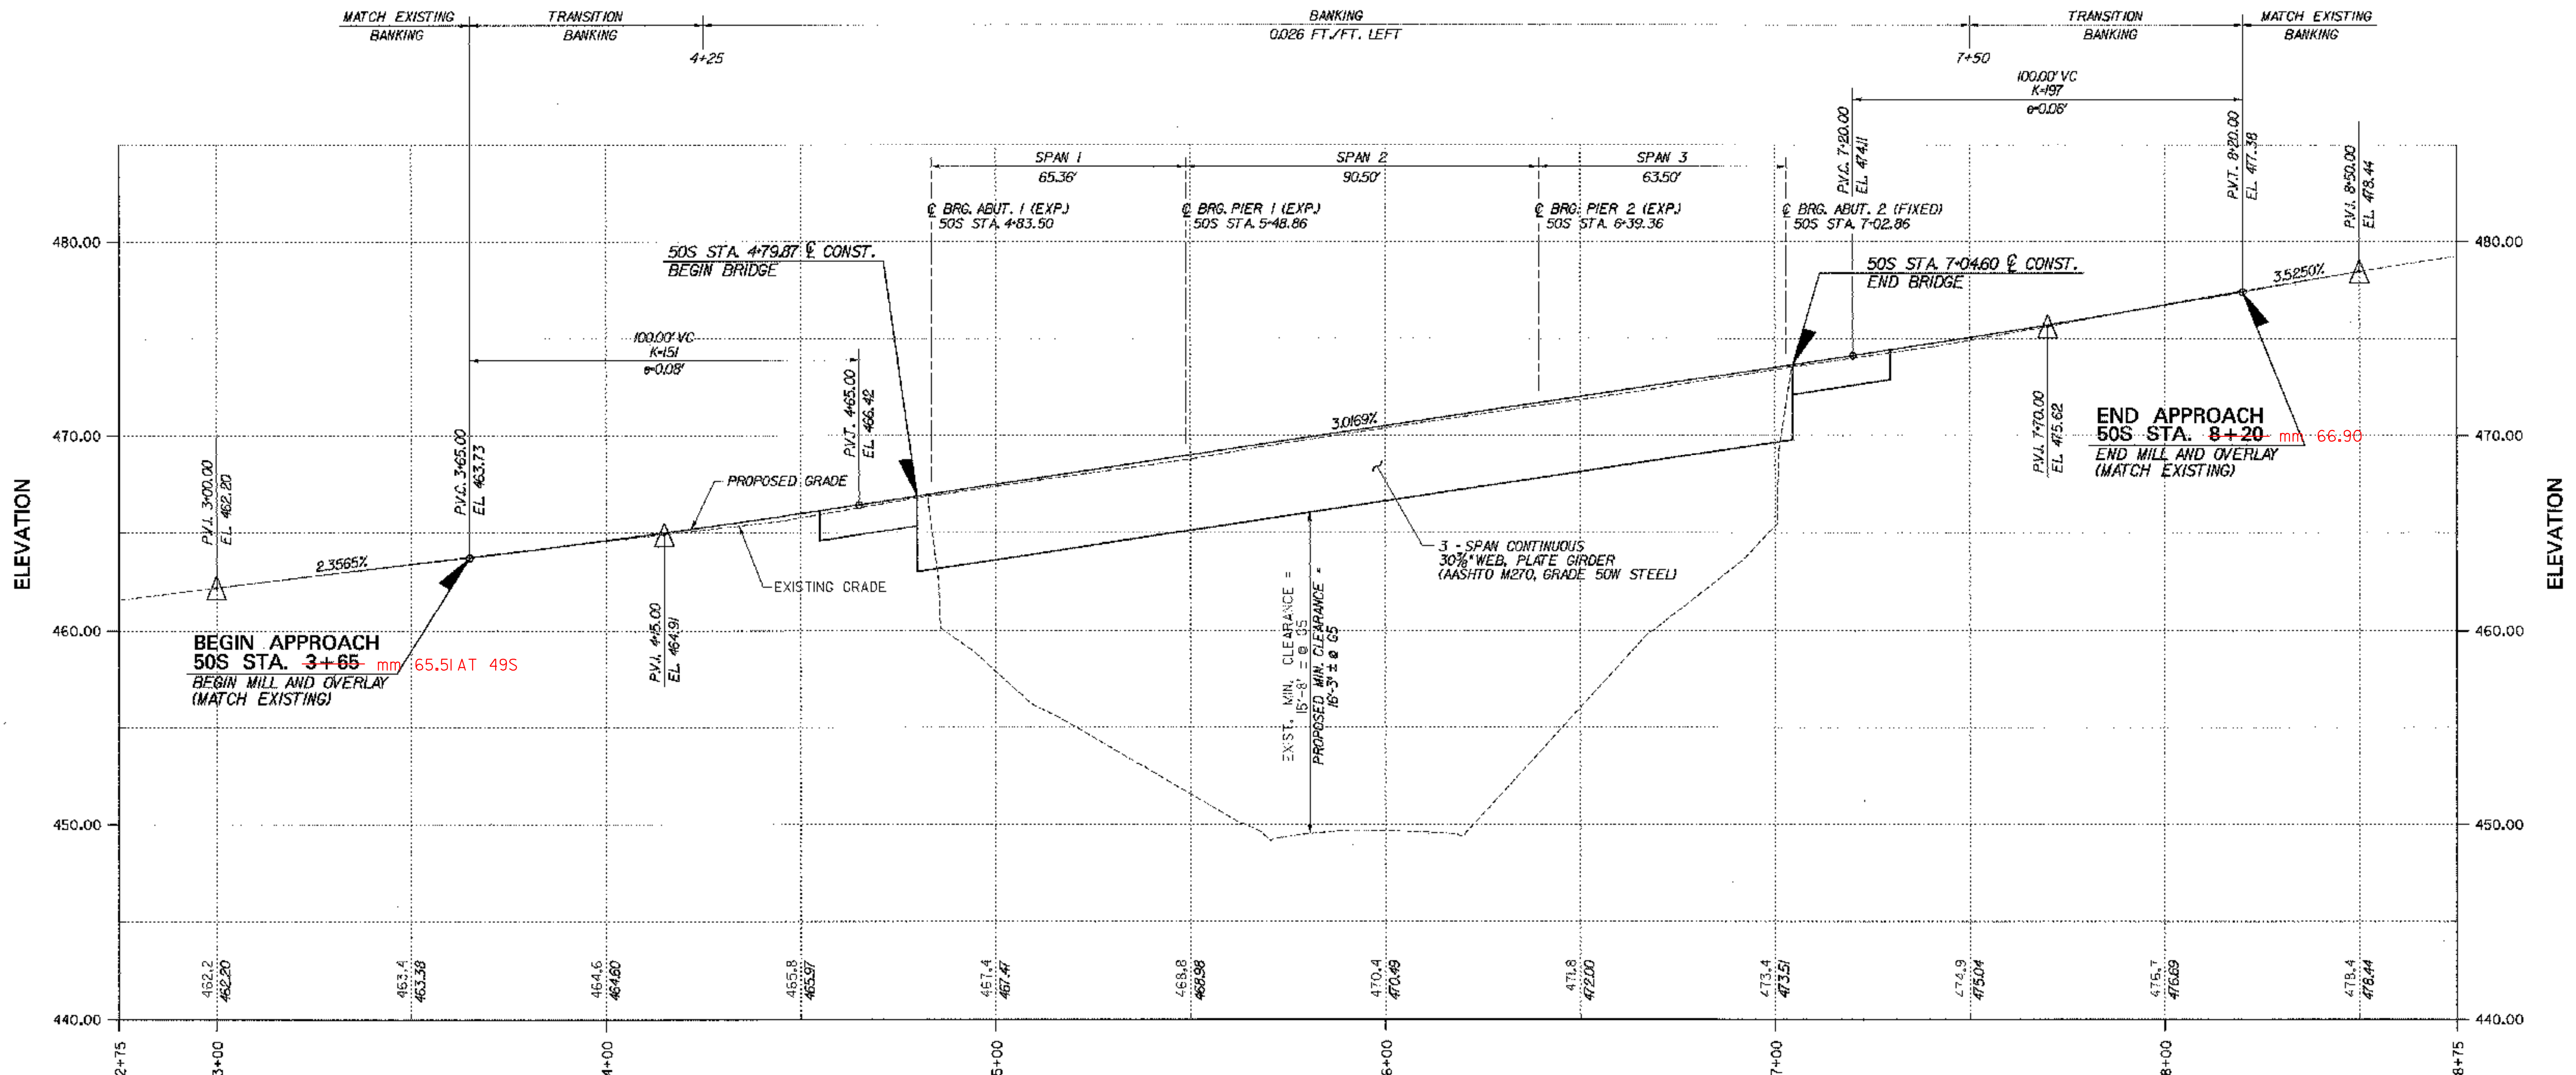


STATION  
PROFILE - BR 50S

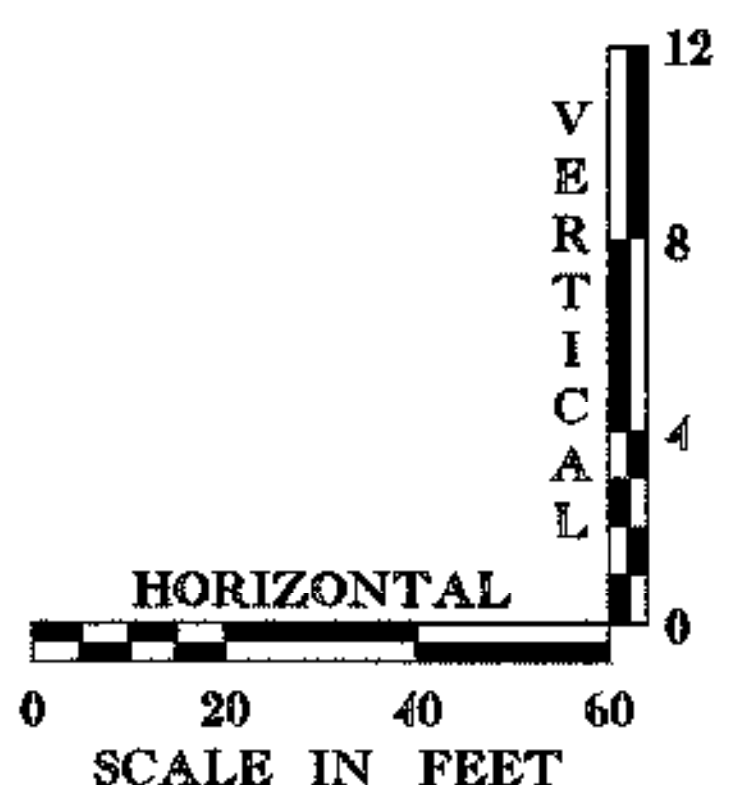


<b>STATE OF VERMONT AGENCY OF TRANSPORTATION</b>	
Town Of <b>MIDDLESEX-BOLTON</b>	Bridge No. <b>50S</b>
Highway No. <b>I-89</b>	Log Sta. Surv. Sta.
<b>I-89 SB OVER U.S. ROUTE 2</b>	
<b>PROFILE (50S)</b>	
Designed By <b>P.W. SZUSTAK</b>	Drawn By <b>R.A. BOTZENHART</b>
Checked By <b>J.P. HALSTEAD</b>	Bridge Design Supervisor
Date <b>10/99</b>	Date <b>10/99</b>
PROJECT <b>MIDDLESEX-BOLTON</b>	PROJECT NO. <b>IM-089-2(26)</b>
TVGA CAD Drawing No. <b>50spr0f</b>	Date <b>10/99</b>
Bridge Sheet No. <b>BR50-3</b>	Sheet <b>87</b> of <b>307</b>

**TVGA** TVGA ENGINEERING,  
SURVEYING, P. C.

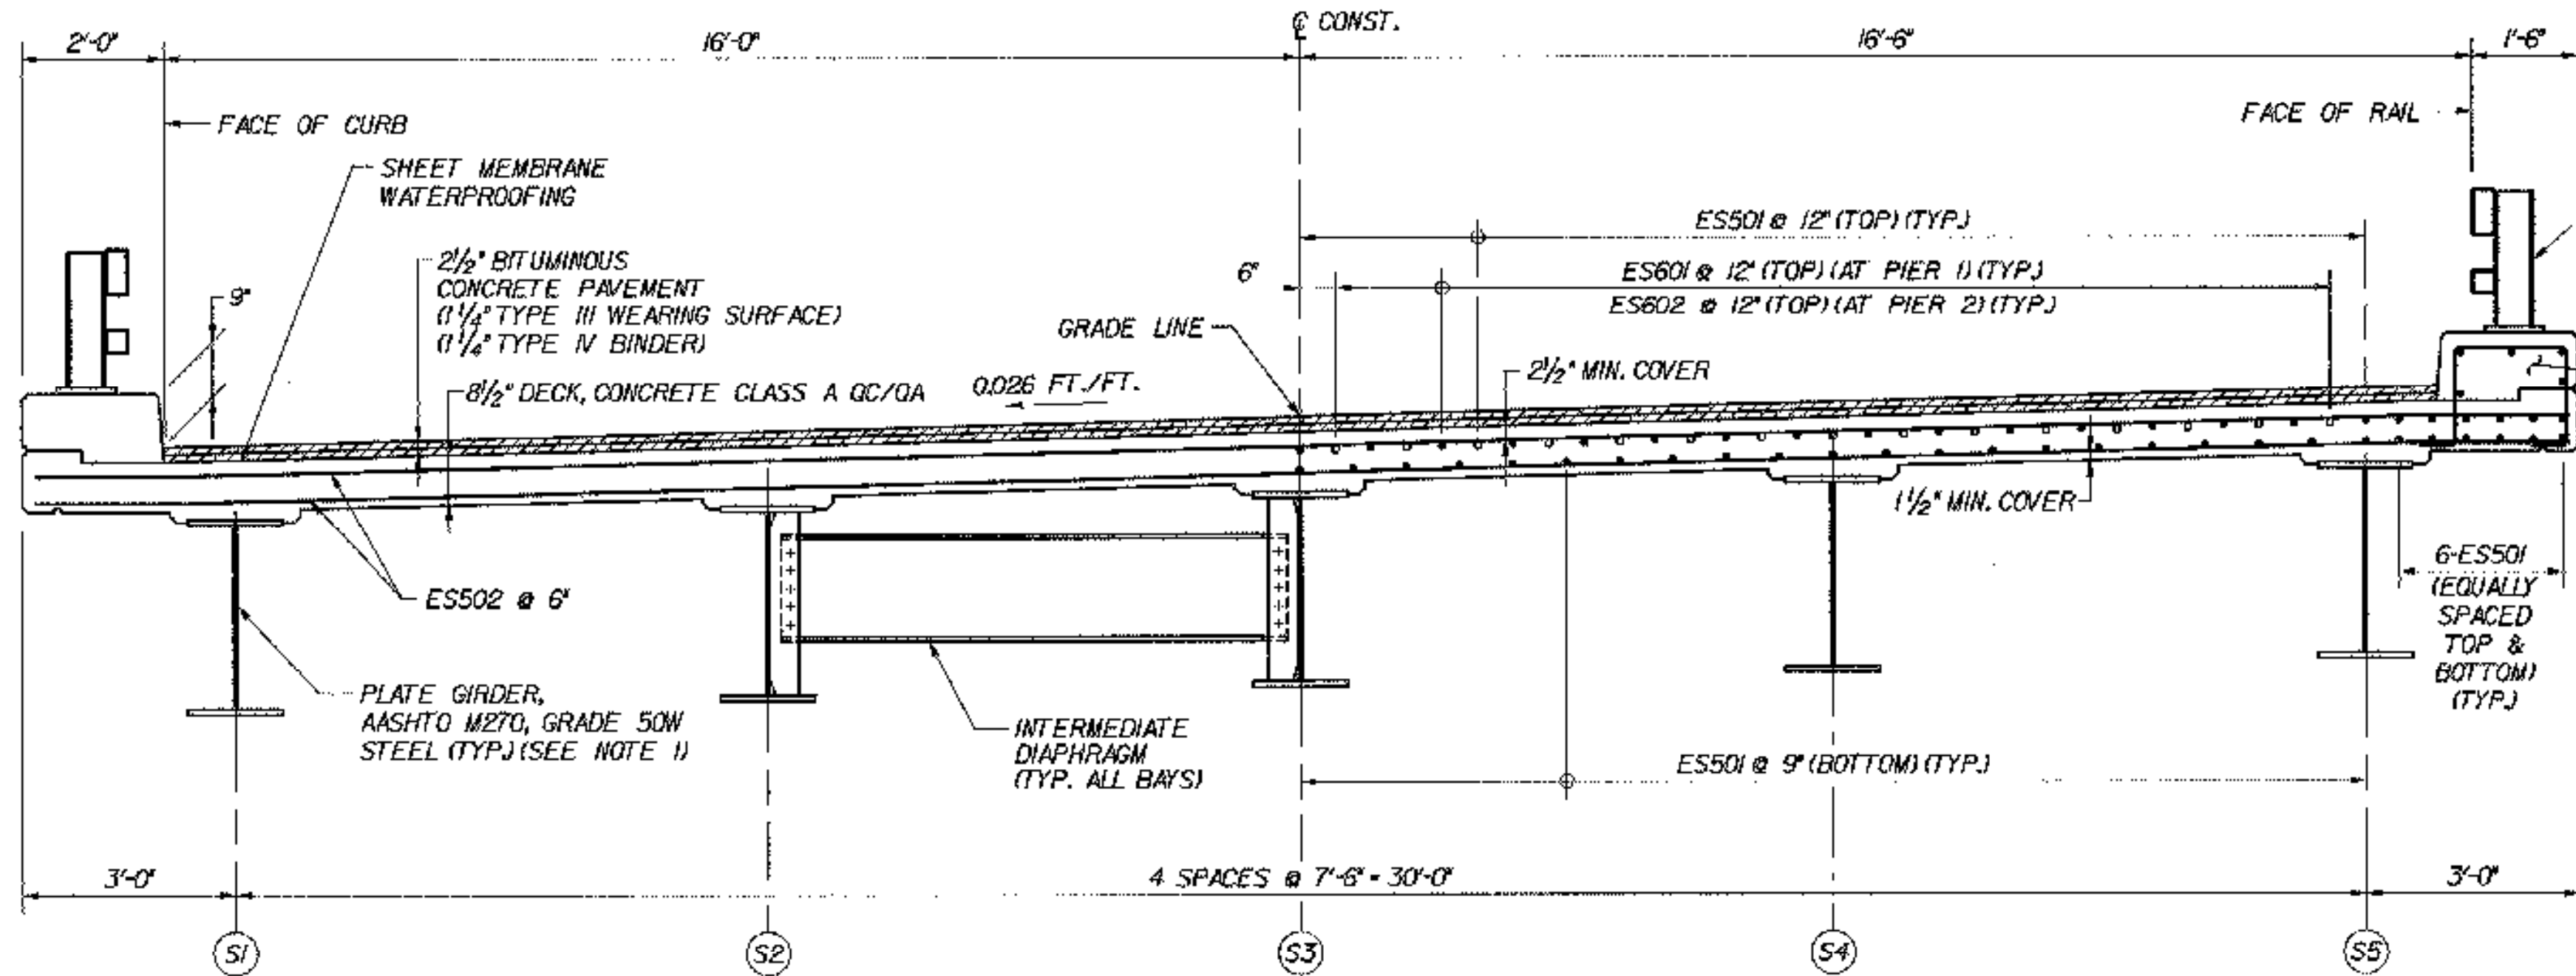

**TRANSVERSE SECTION**


SCALE: 1/2" = 1'-0"

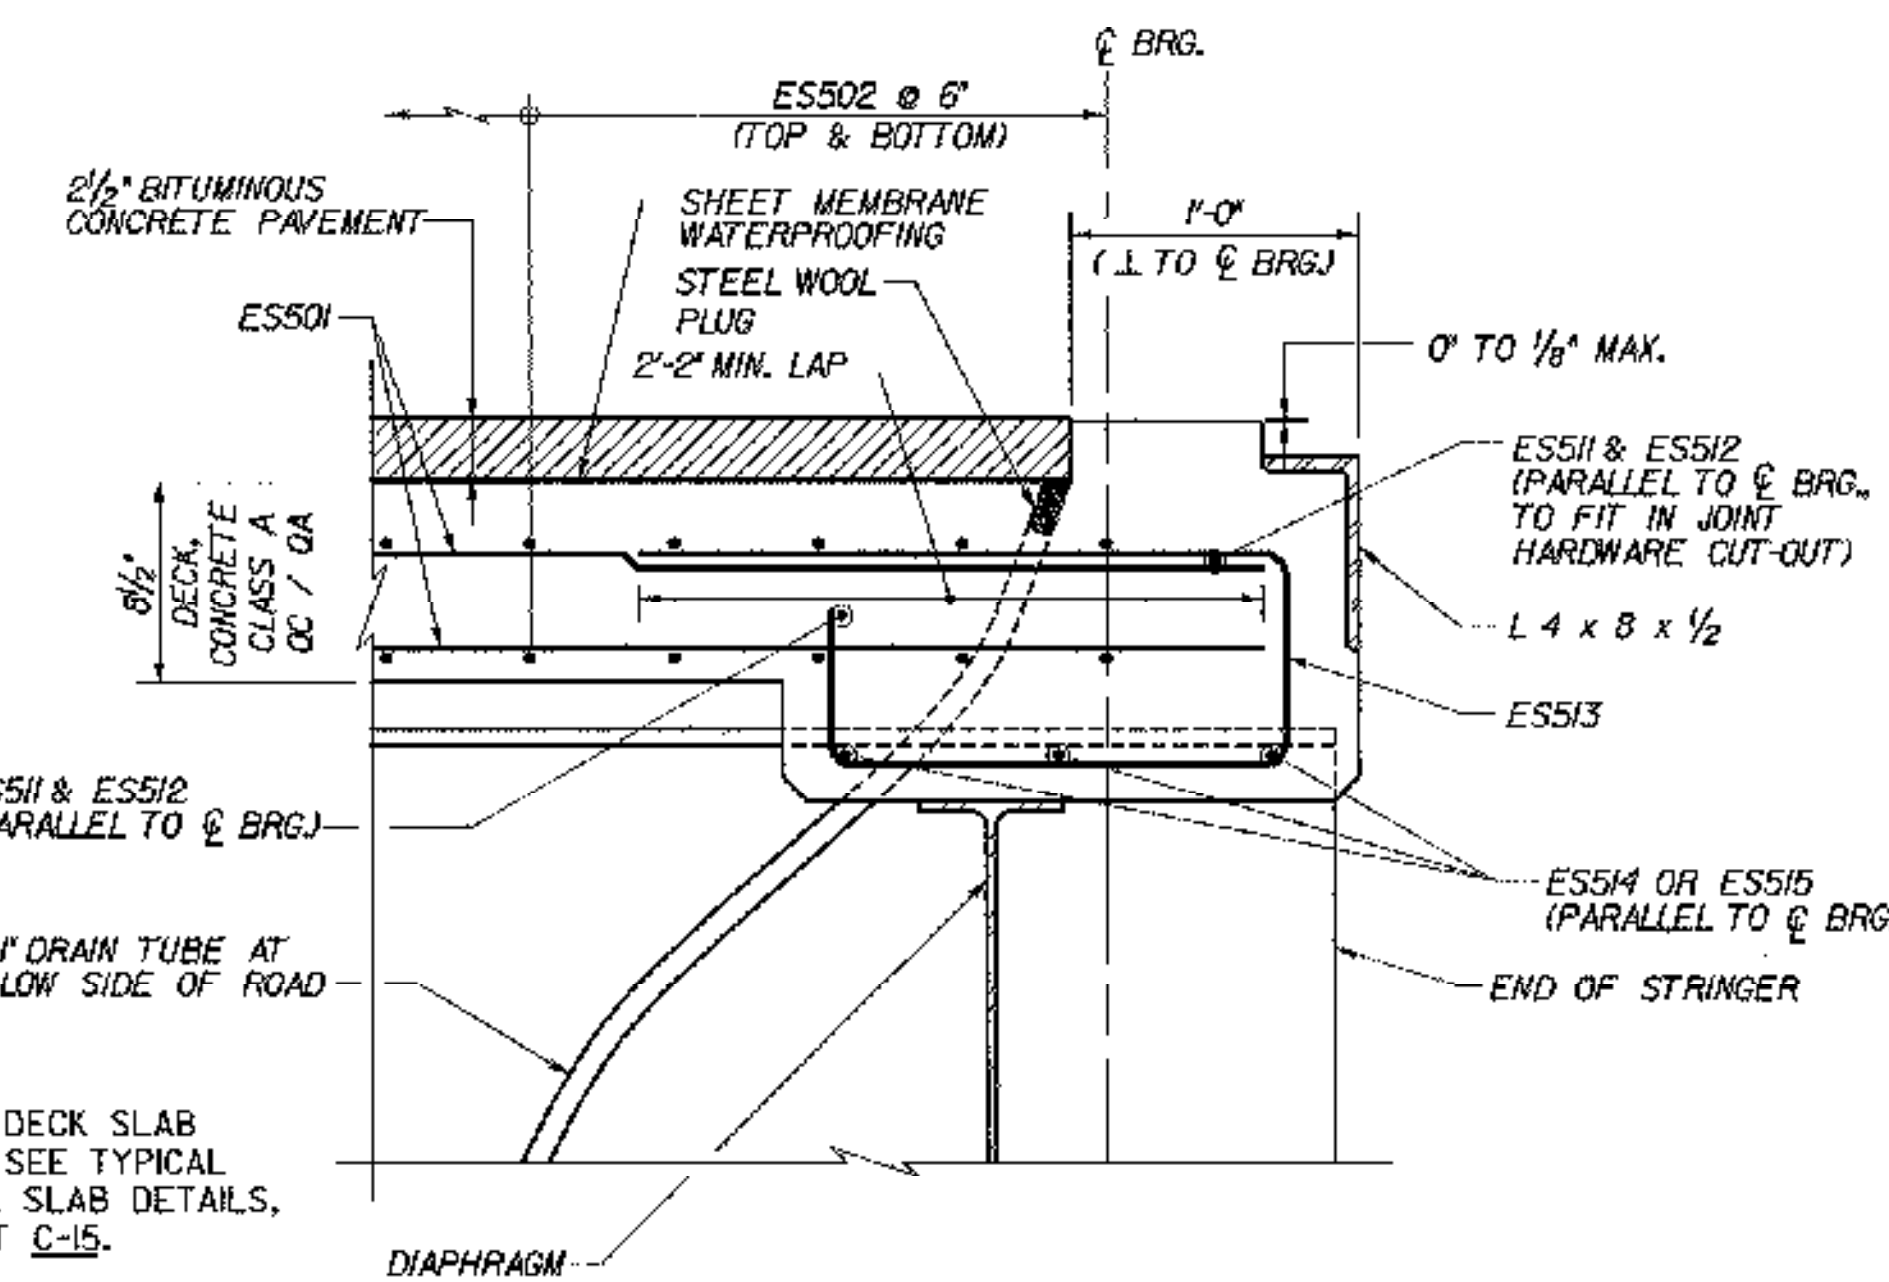

**END OF DECK SLAB REINFORCEMENT DETAIL**


(EXP. END)

SCALE: 1 1/2" = 1'-0"

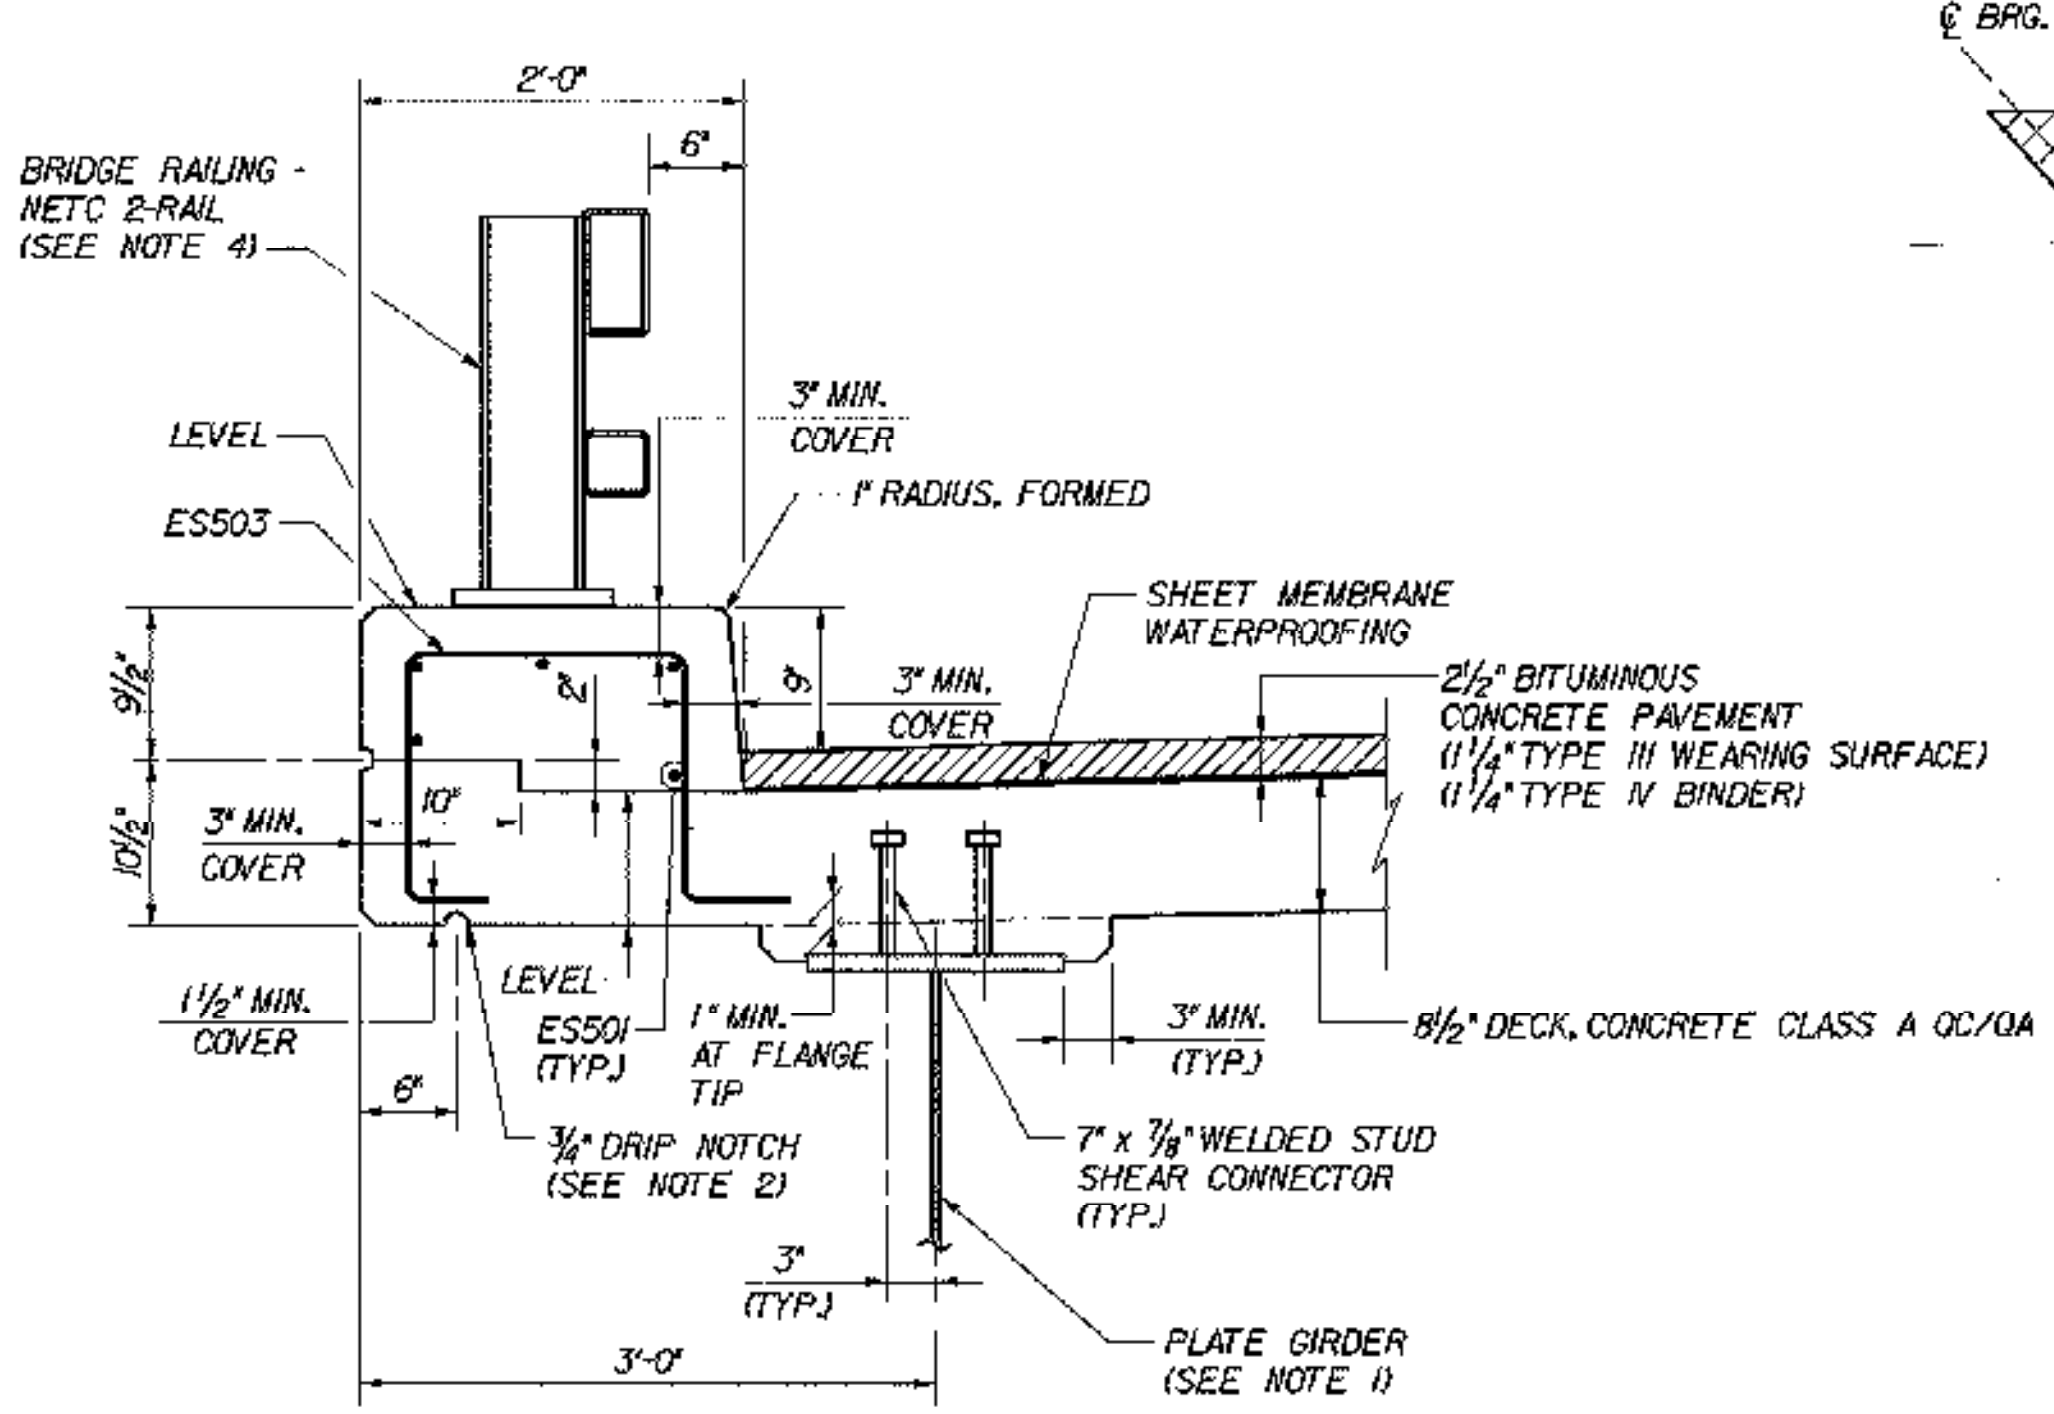

**FASCIA DETAIL**

SCALE: 1" = 1'-0"

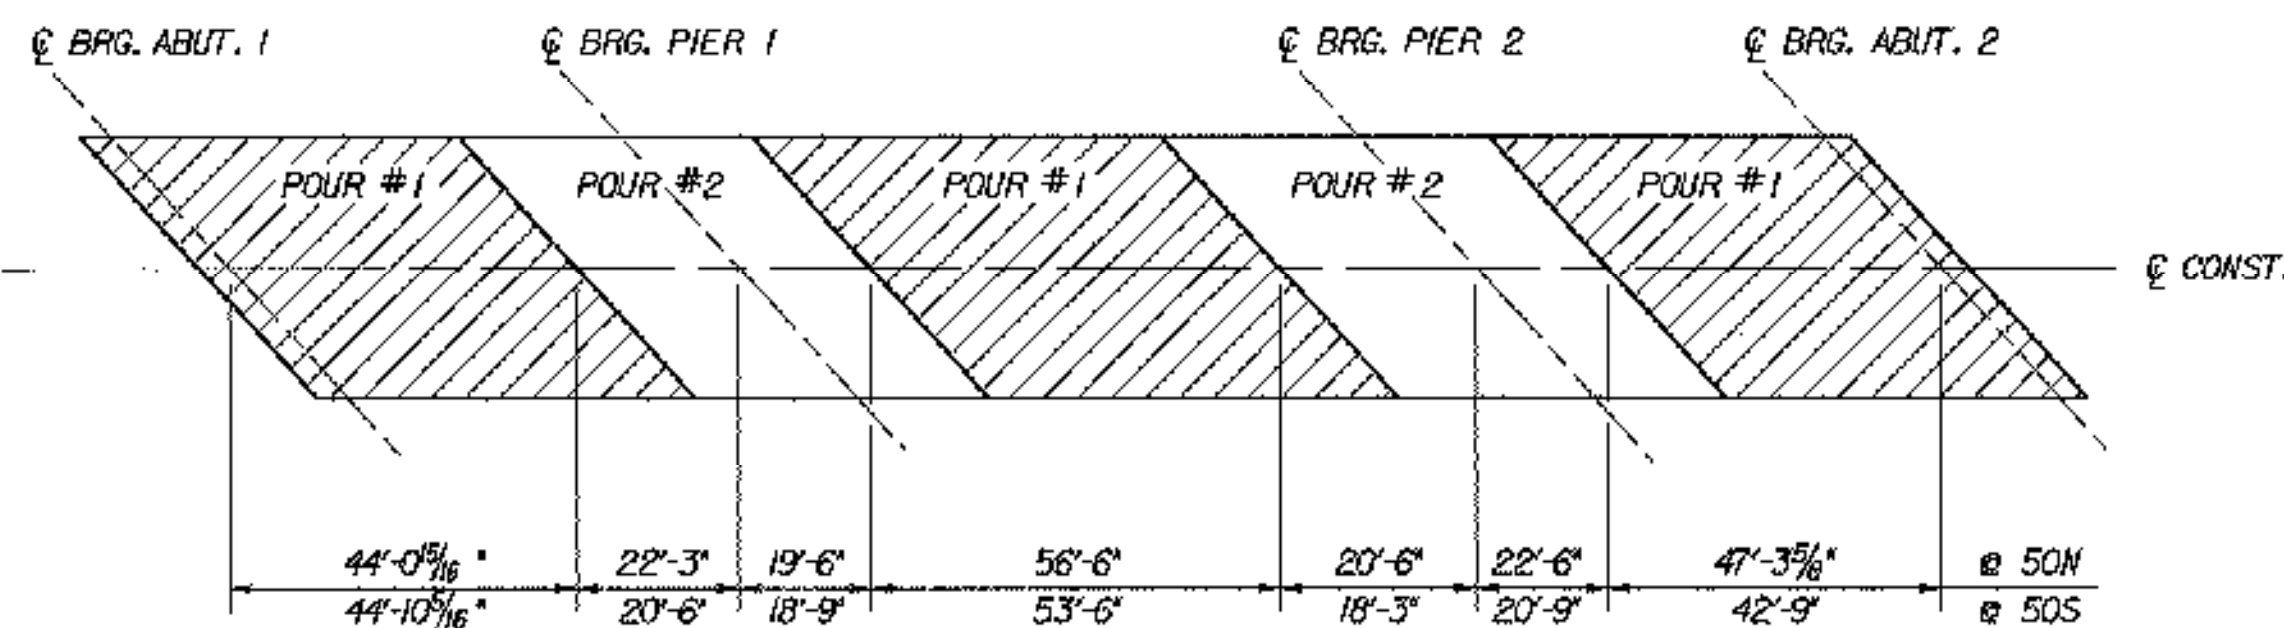


**DECK POUR SEQUENCE**

N.T.S.

BRIDGE 50N AND S WAS DONE IN A SINGLE POUR WITH NO CONSTRUCTION JOINTS.

**DECK SLAB PLACEMENT NOTES**

- EACH CONCRETE DECK POUR SHALL BE PLACED CONTINUOUSLY WITHIN ONE EIGHT HOUR WORKING DAY. THERE SHALL BE A MINIMUM DELAY PERIOD OF 96 HOURS AFTER COMPLETION OF EACH POUR BEFORE BEGINNING ANOTHER POUR. INDIVIDUAL POUR NUMBERS AS SHOWN MAY BE COMBINED INTO A SINGLE POUR IF APPROVED BY THE VAOT STRUCTURES ENGINEER.
- THE DECK CONCRETE SHALL BE RETARDED SUFFICIENTLY TO REMAIN PLASTIC UNTIL EACH POUR IS COMPLETE. THE QUANTITY OF RETARDANT SHALL BE APPROVED BY THE CONCRETE ENGINEER PRIOR TO PLACEMENT. ANY DEVIATIONS FROM THIS PROCEDURE MUST BE APPROVED BY THE VAOT STRUCTURES ENGINEER IN WRITING BEFORE THE POUR BEGINS.

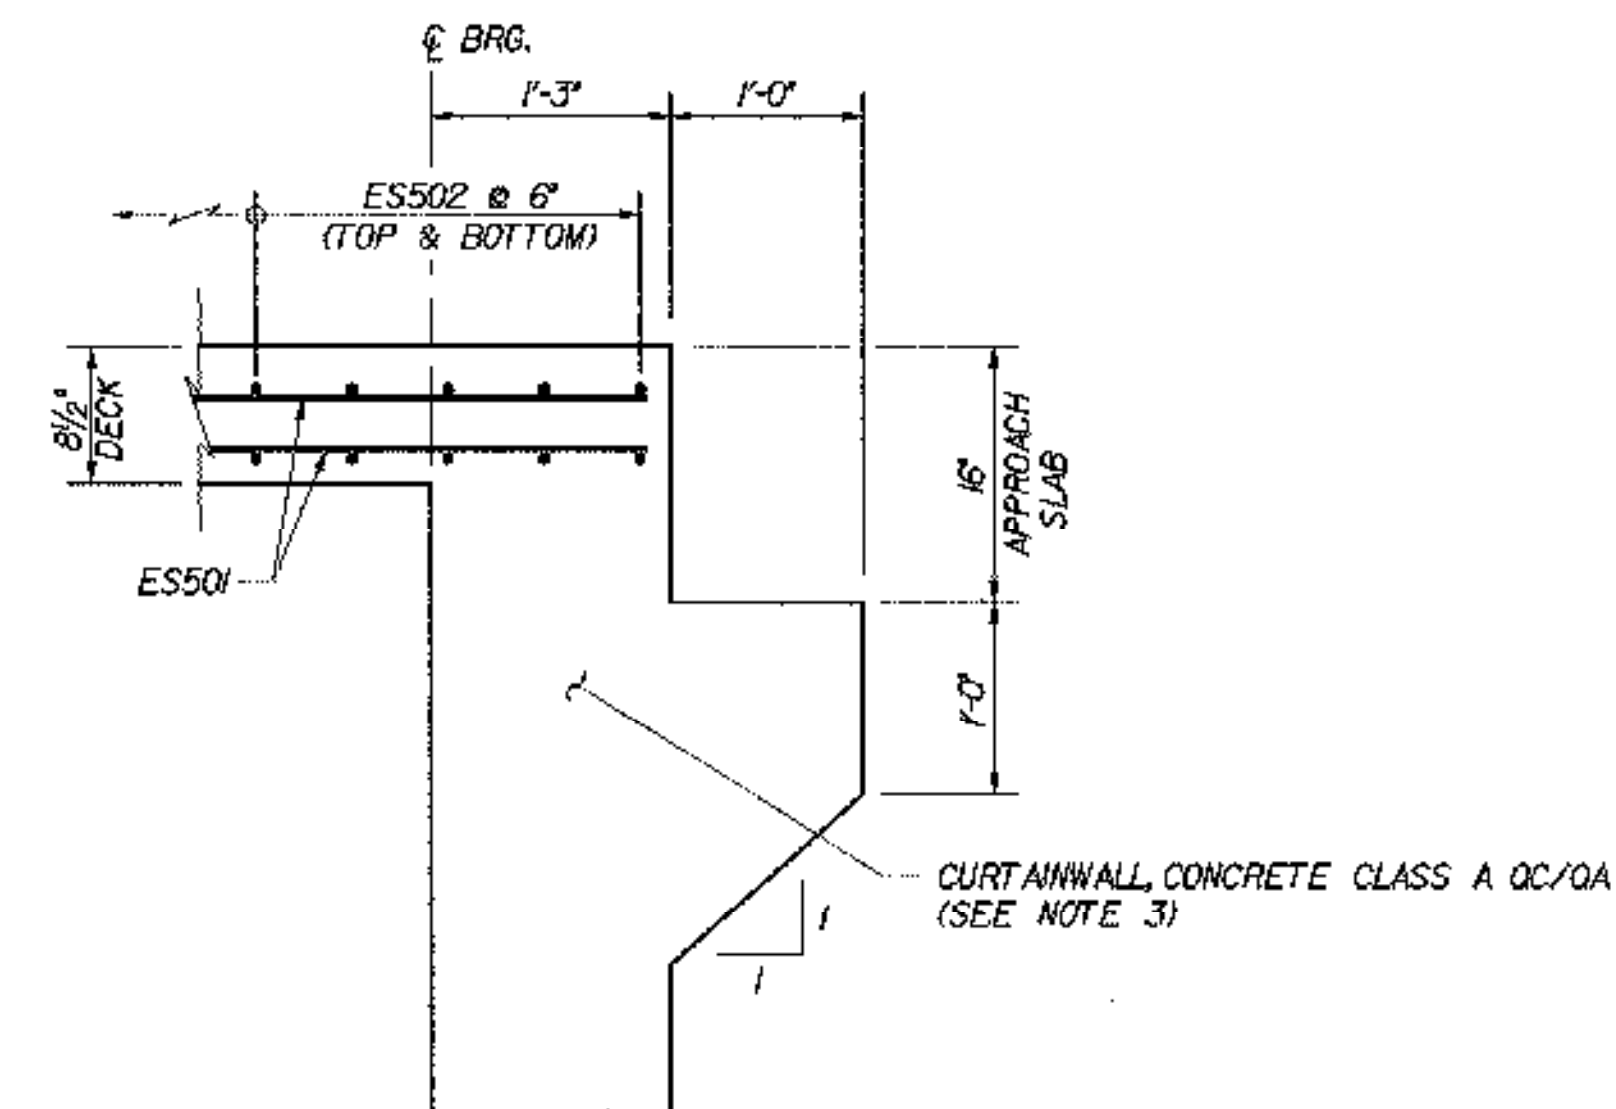

**END OF DECK SLAB REINFORCEMENT DETAIL**


(FIXED END)

SCALE: 1" = 1'-0"


**NOTES:**

- FOR PLATE GIRDER SIZES SEE STRINGER ELEVATION (50N&S), BRIDGE SHEET BR50-10.
- END DRIP NOTCH 5 FEET BEFORE END OF SLAB AT "DOWNHILL" ABUTMENTS AT 45°.
- FOR CURTAINWALL DETAILS AND REINFORCEMENT LAYOUT, SEE TYPICAL CURTAINWALL DETAILS, BRIDGE SHEET C-42.
- FOR DETAILS OF NETC BRIDGE RAIL AND APPROACH SECTION, SEE STANDARD SHEETS BR1-97 AND BR3-97, AND GUARD RAIL APPROACH SECTION, NETC 2 RAIL, BRIDGE SHEETS C-46A AND C-46B.

STATE OF VERMONT AGENCY OF TRANSPORTATION			
Town Of	MIDDLESEX-BOLTON	Bridge No.	50N&S
Highway No.	I-89	Log Sta.	
		Surv. Sta.	
I-89 OVER U.S. ROUTE 2			
<b>TRANSVERSE SECTION (50N&amp;S)</b>			
Designed By	P.W. SZUSTAK	Drawn By	R.A. BOTZENHART
Checked By	Date	Bridge Design Supervisor	
J.P. HALSTEAD	10/99	J.P. HALSTEAD	Date 10/99
PROJECT	MIDDLESEX-BOLTON	PROJECT NO.	IM-089-2(26)
TVGA CAD Drawing No.	50tsect	Date	10/99
Bridge Sheet No.	BR50-4	Sheet	88 of 307

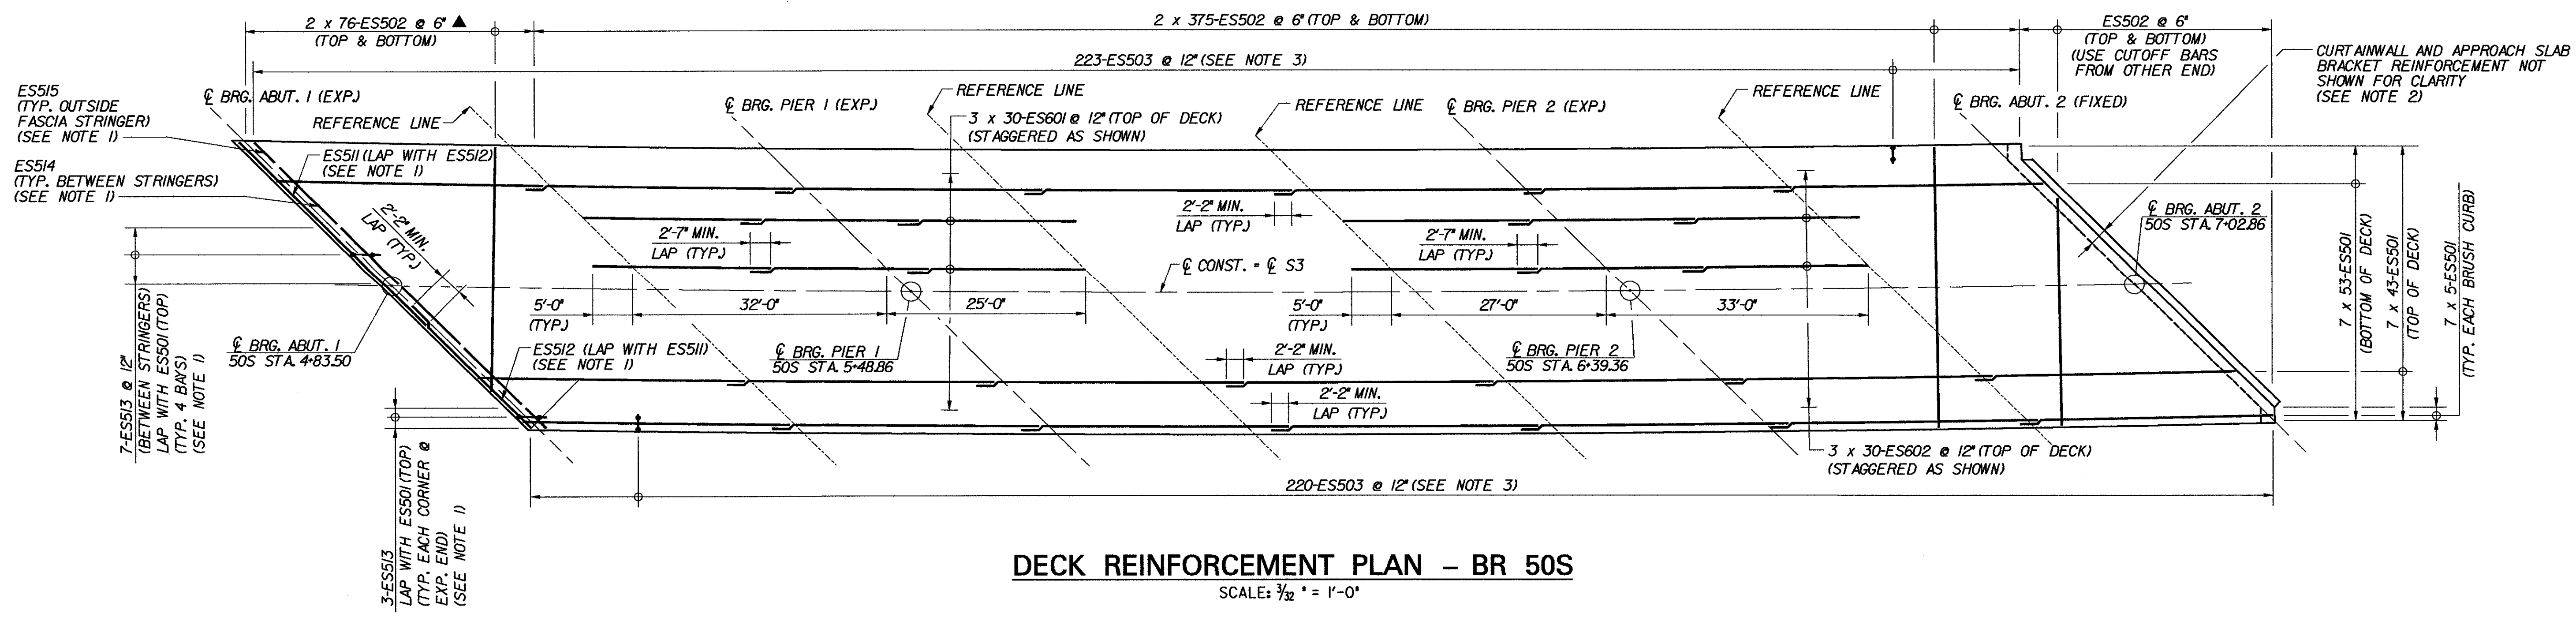

**DECK REINFORCEMENT PLAN - BR 50S**  
SCALE: 3/32" = 1'-0"

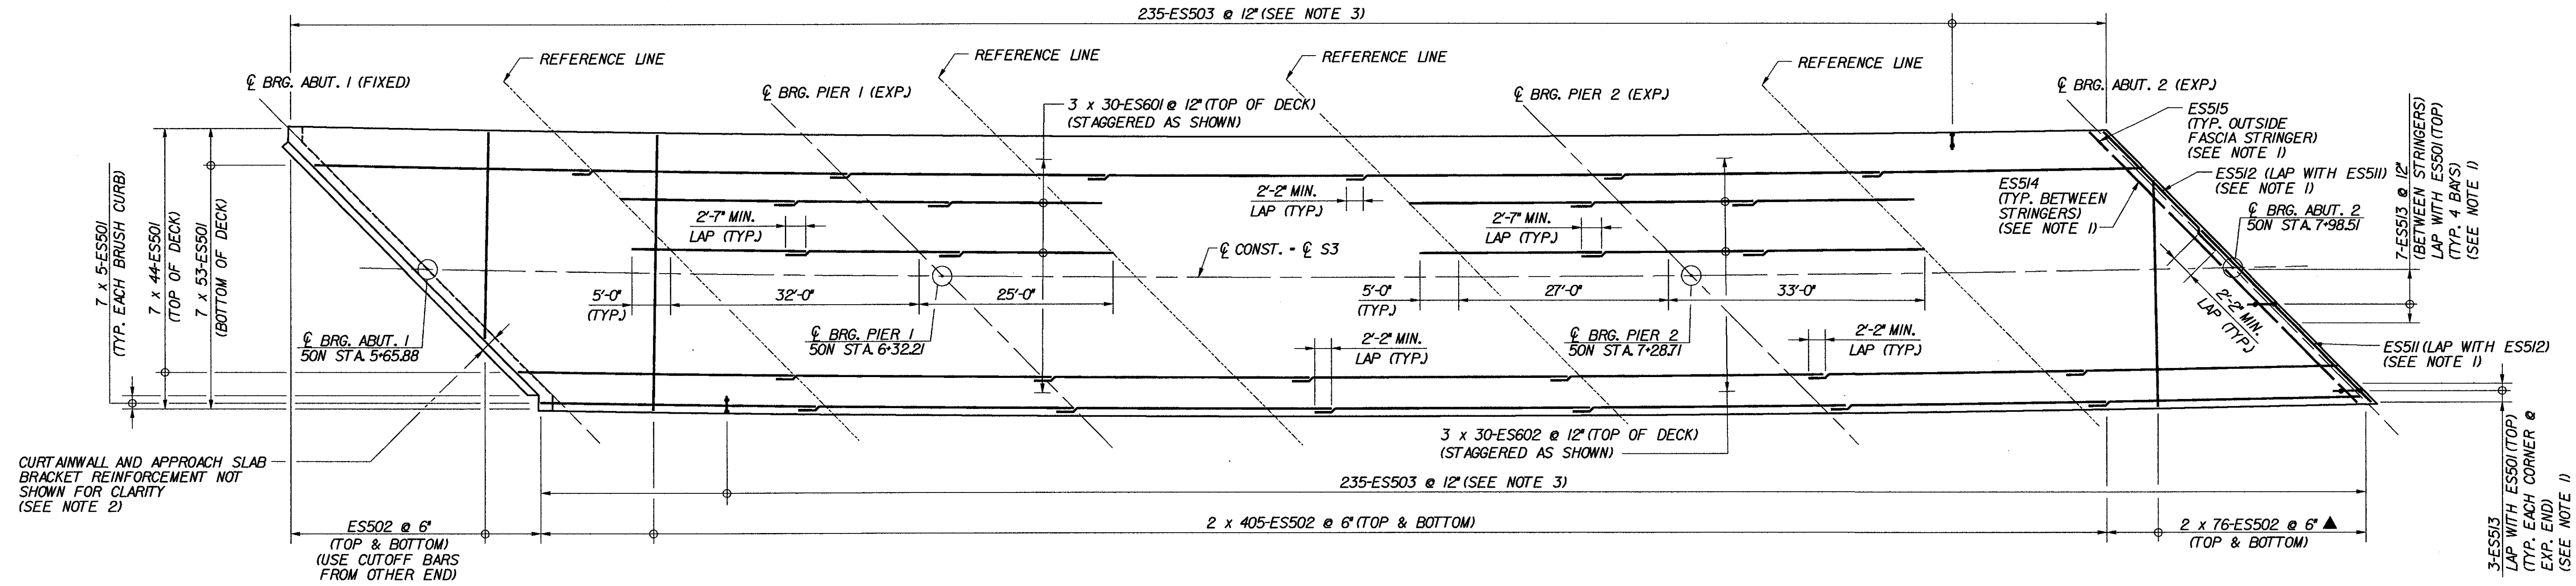

**DECK REINFORCEMENT PLAN - BR 50N**  
SCALE: 3/32" = 1'-0"

**NOTES:**

- FOR END OF DECK SLAB DETAILS, SEE TRANSVERSE SECTION (50N&S), BRIDGE SHEET BR50-4.
- FOR CURTAINWALL REINFORCEMENT, SEE TYPICAL CURTAINWALL DETAILS, BRIDGE SHEET C-42.
- THE QUANTITY OF ES503 BARS SHOWN DOES NOT INCLUDE ADDITIONAL BARS REQUIRED BELOW THE BRIDGE RAIL POSTS. FOR DETAILS OF THE REQUIRED STIRRUP SPACING, SEE NETC 2-RAIL STANDARD SHEET BRI-97. FOR LOCATIONS OF THE BRIDGE RAIL POSTS, SEE CURB AND RAIL LAYOUT PLANS, BRIDGE SHEET BR50-7.


**KEY**

- NF NEAR FACE
- FF FAR FACE
- EF EACH FACE
- ▲ REINFORCEMENT TO BE CUT TO FIT IN THE FIELD


**STATE OF VERMONT  
AGENCY OF TRANSPORTATION**

Town Of	MIDDLESEX-BOLTON	Bridge No.	<b>50N&amp;S</b>
Highway No.	I-89	Log Sta.	
		Surv. Sta.	
I-89 OVER U.S. ROUTE 2			
<b>DECK REINFORCEMENT PLANS (50N&amp;S)</b>			
Designed By	P.W. SZUSTAK	Drawn By	R.A. BOTZENHART
Checked By	Date	Bridge Design Supervisor	
J.P. HALSTEAD	10/99	J.P. HALSTEAD	Date 10/99
PROJECT	MIDDLESEX-BOLTON	PROJECT NO.	IM-089-2(26)
TVGA CAD Drawing No.	50drp	Date	10/99
Bridge Sheet No.	<b>BR50-5</b>	Sheet	89 of 307


**TVGA** TVGA ENGINEERING,  
SURVEYING, P.C.

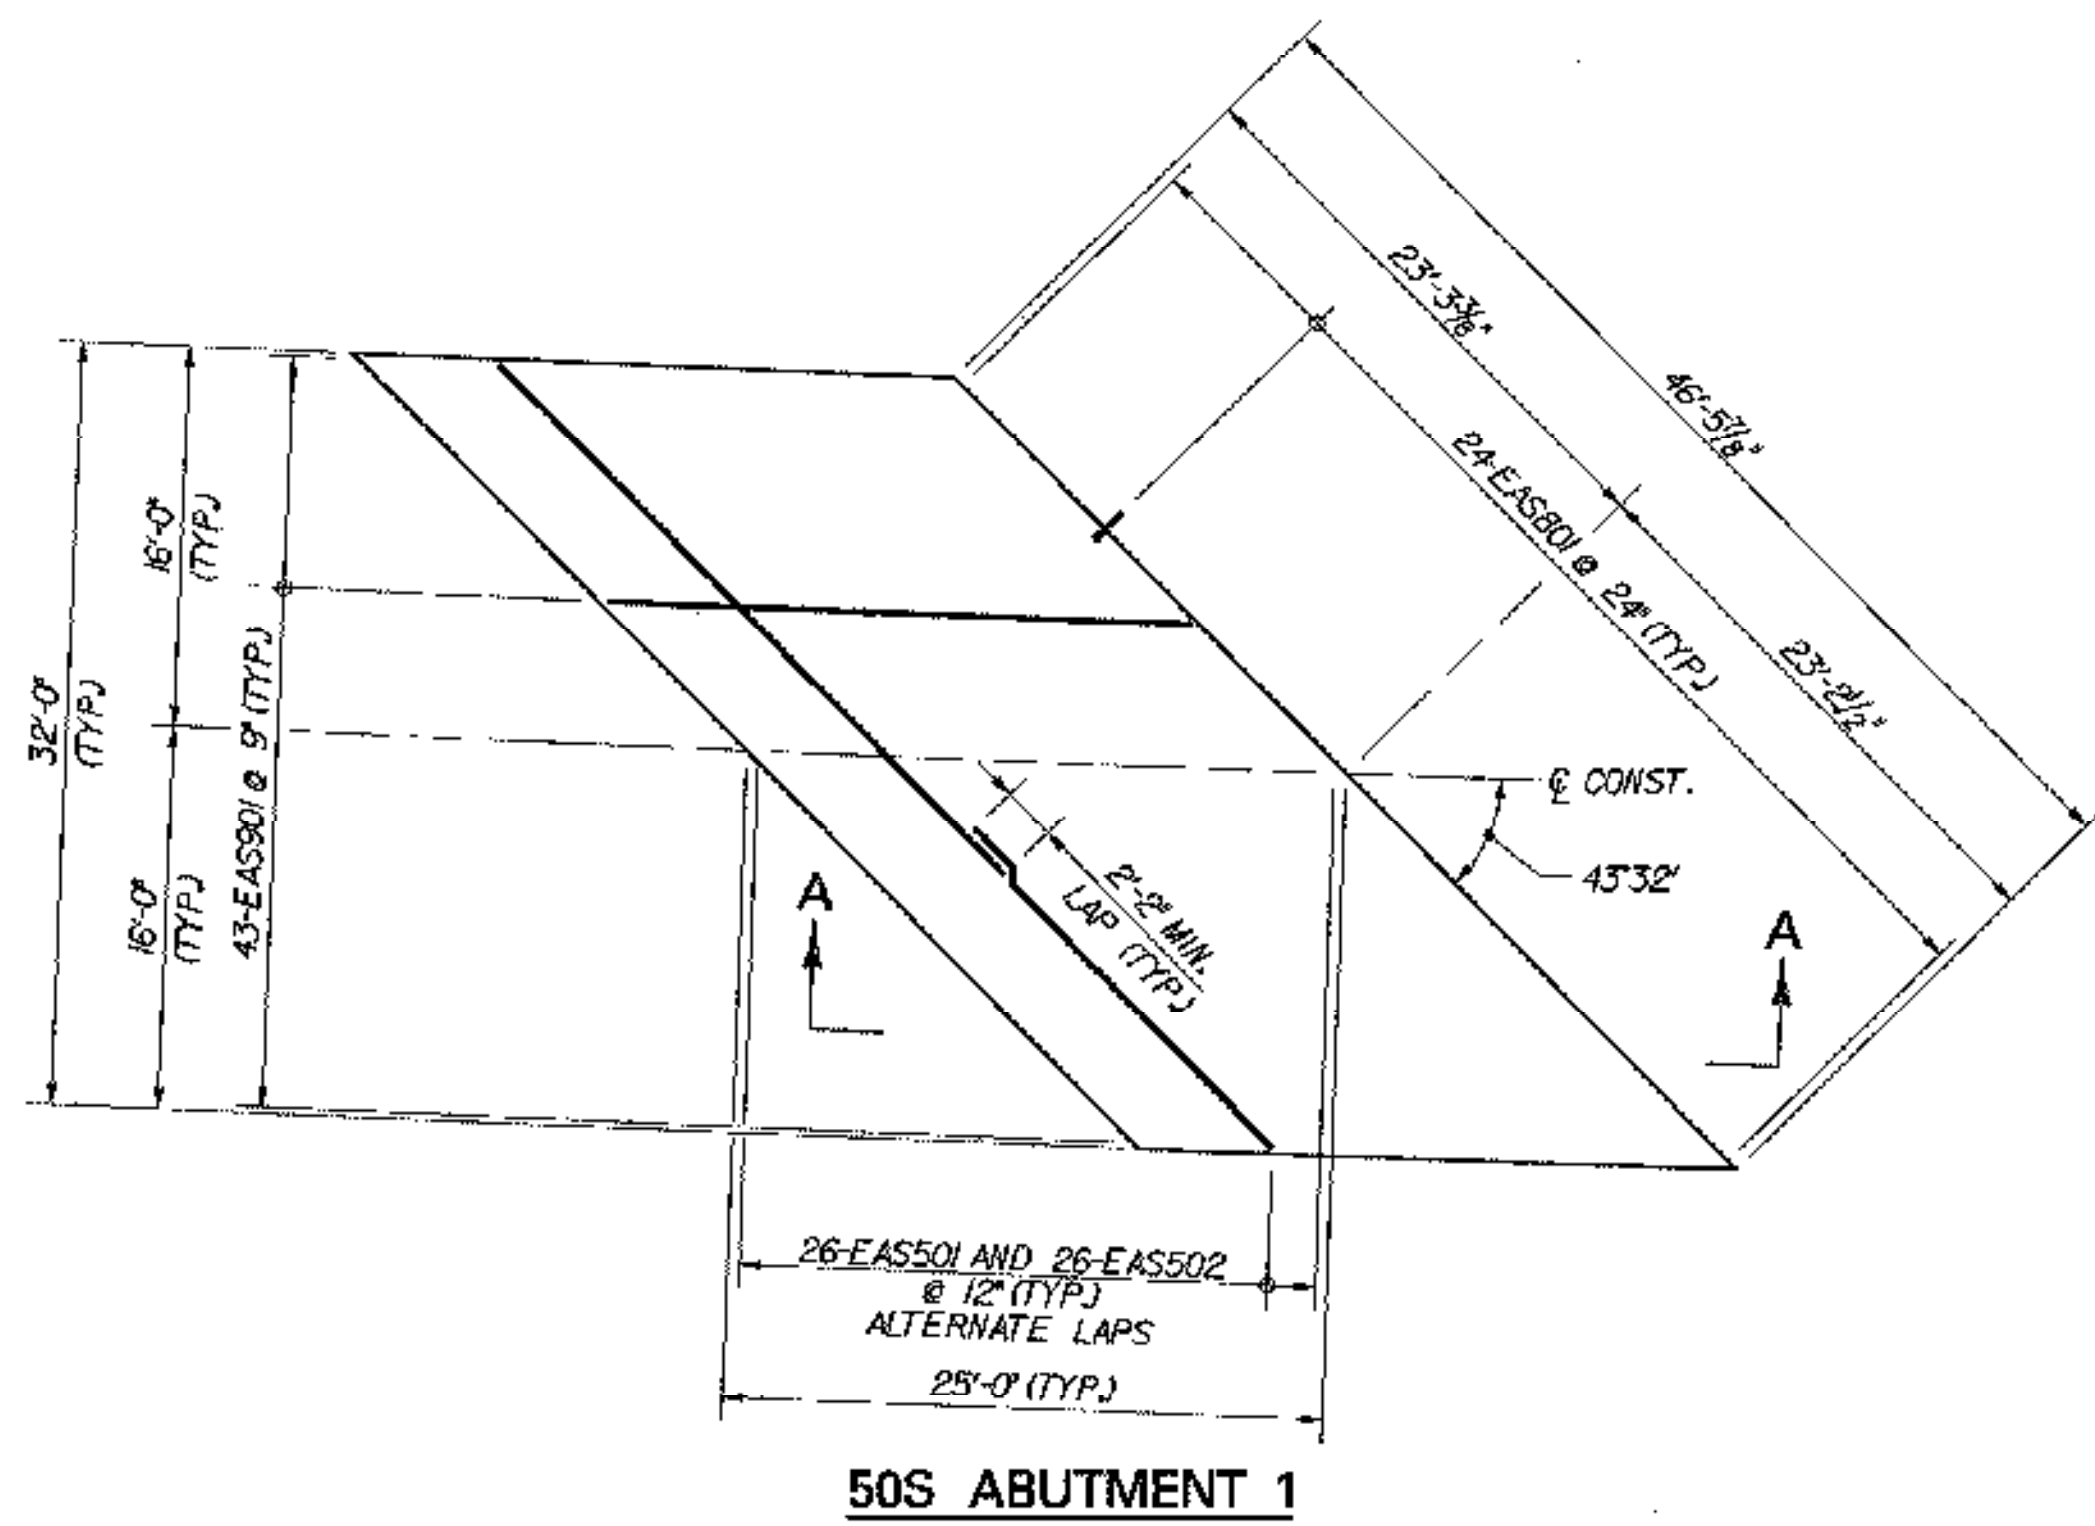


50S ABUTMENT 1

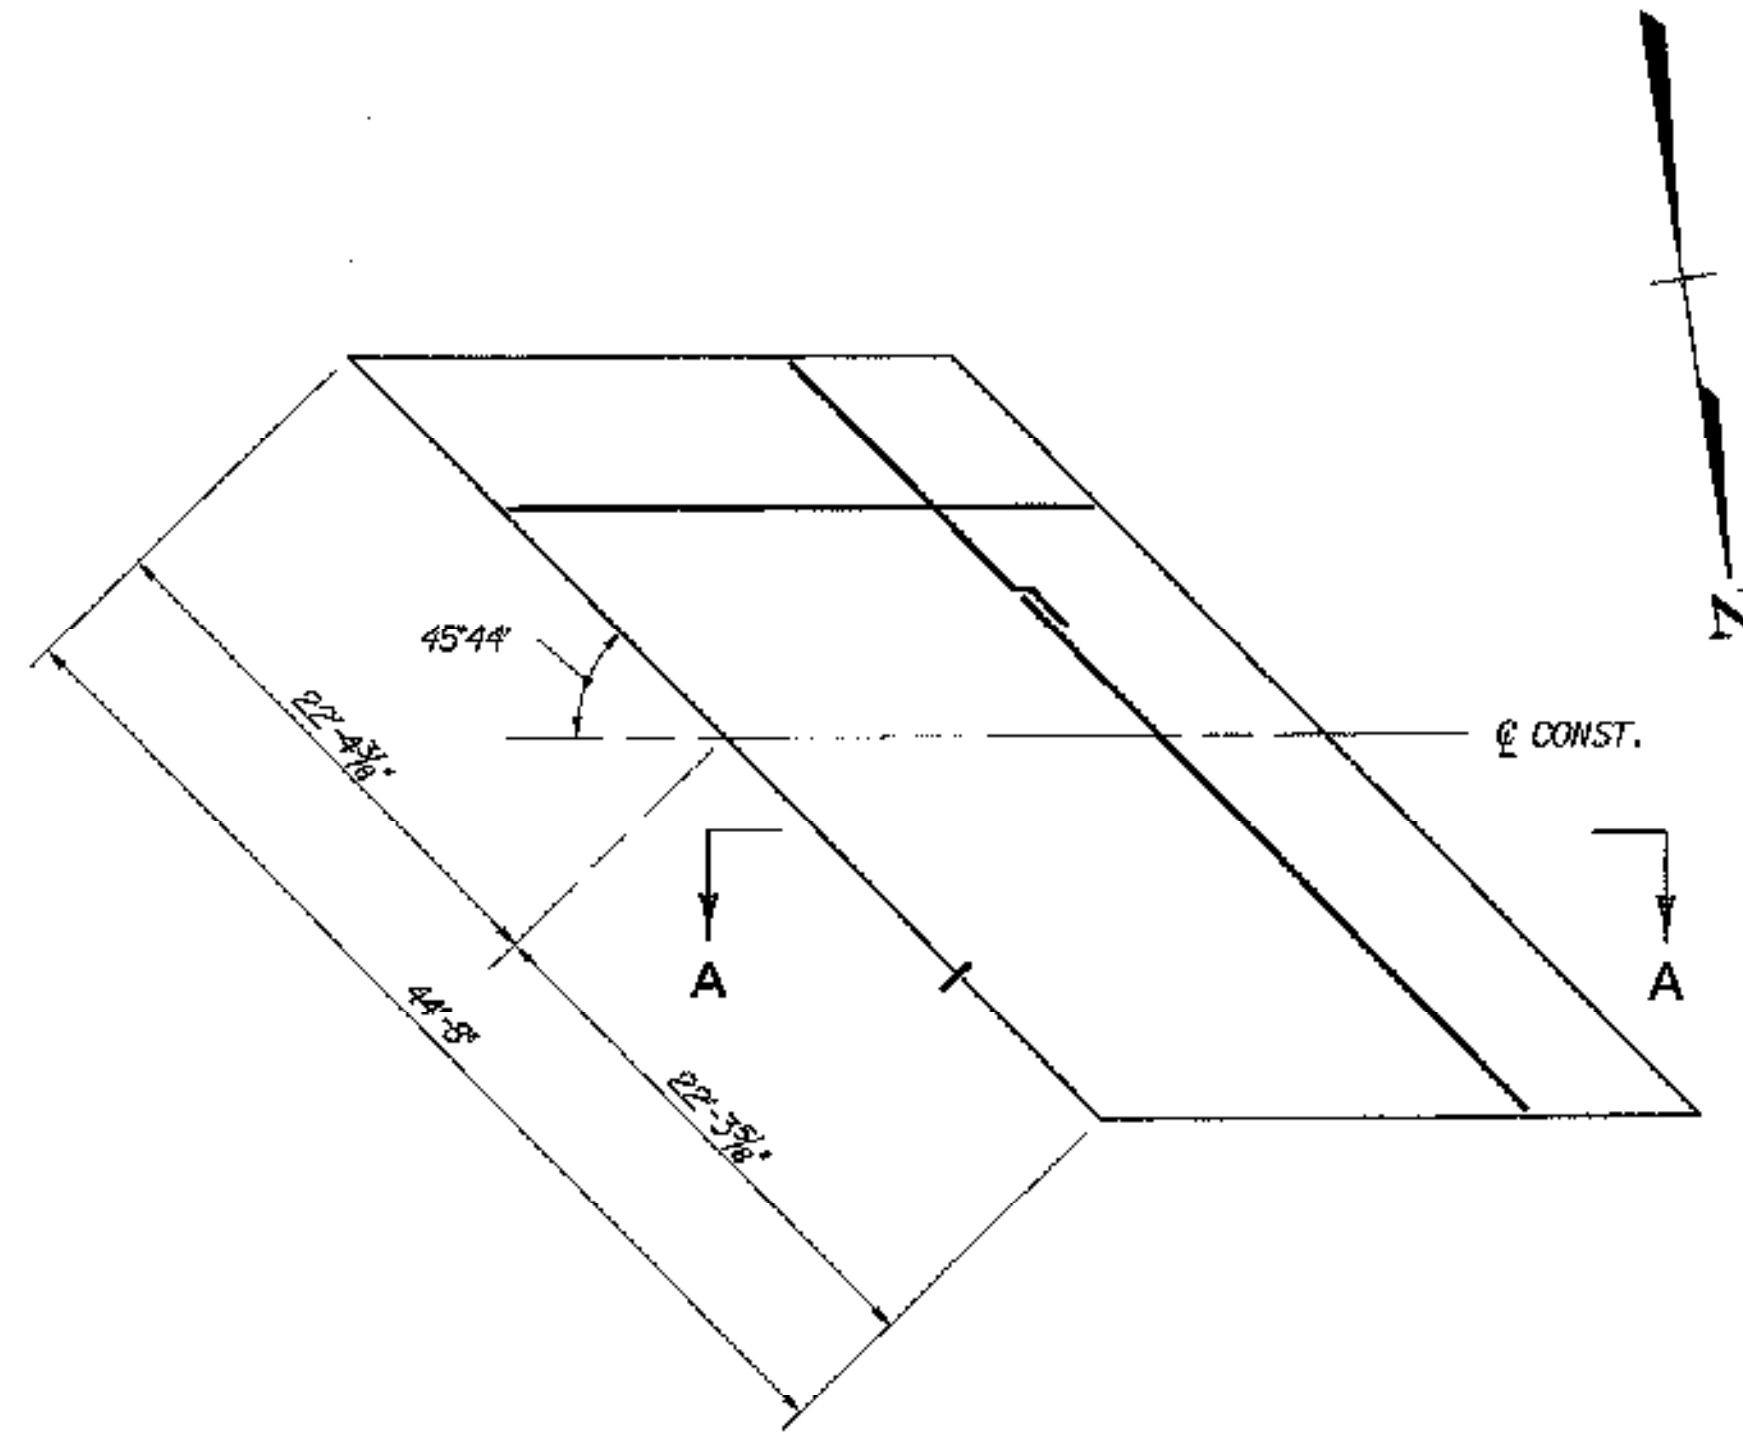


50S ABUTMENT 2

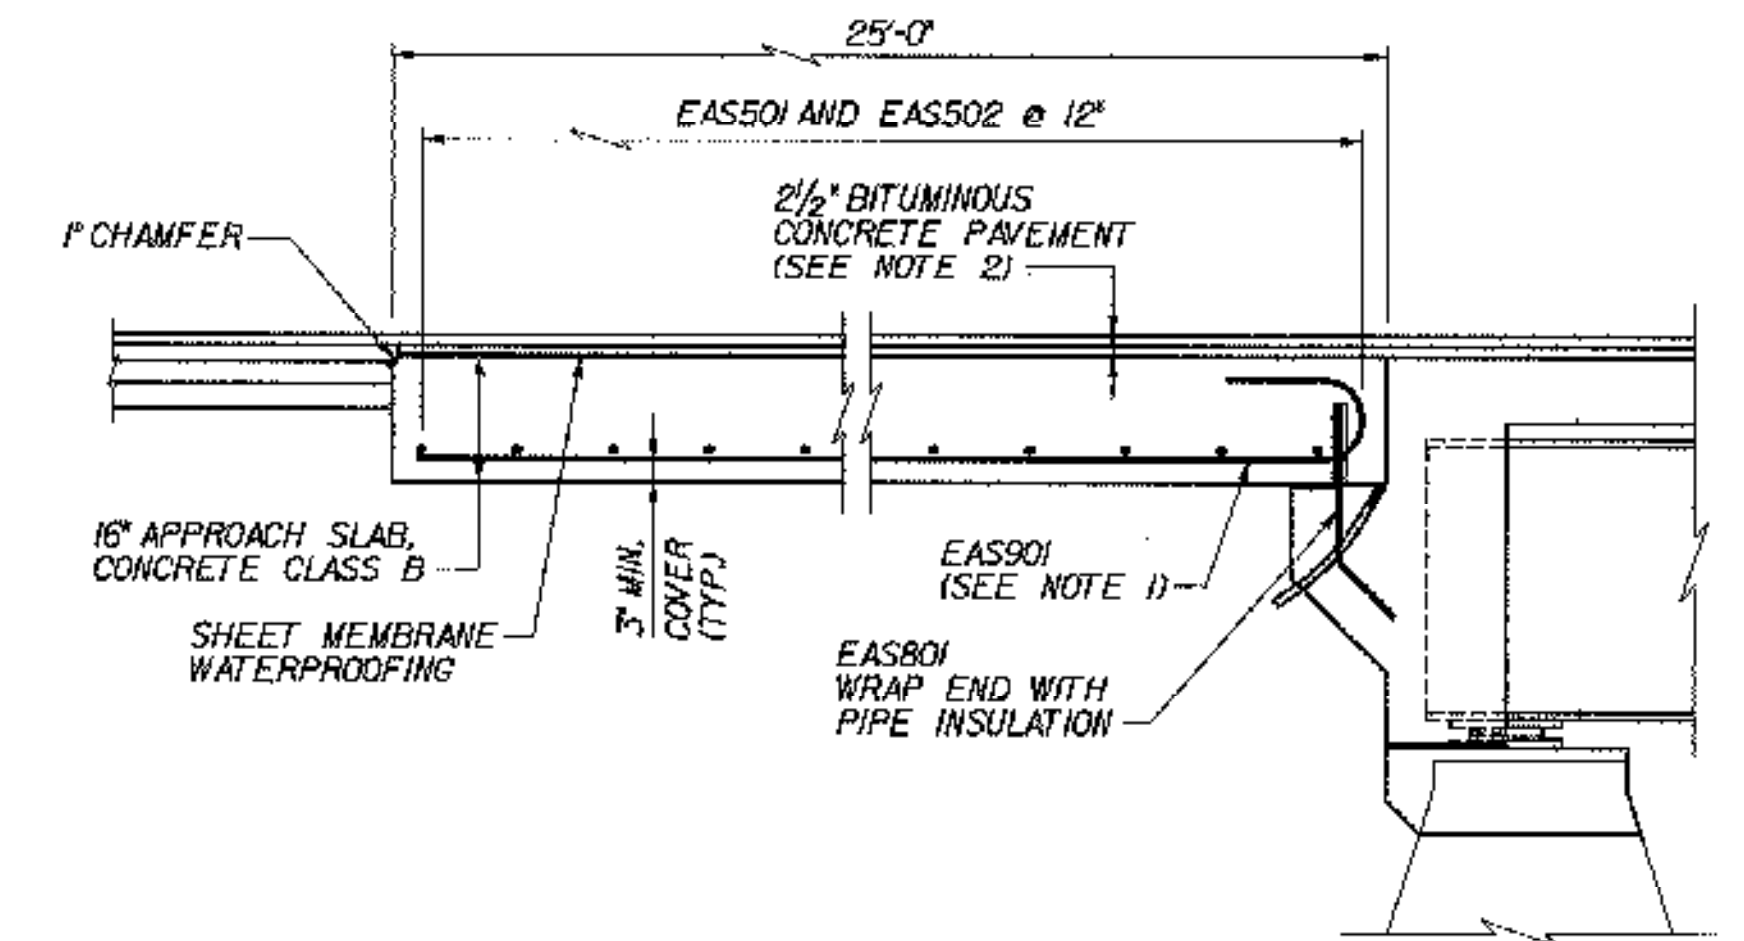

SECTION A-A  
(APPROACH SLAB AT FIXED ABUT. SHOWN;  
SLAB AT EXPANSION ABUT. SIMILAR)  
N.T.S.

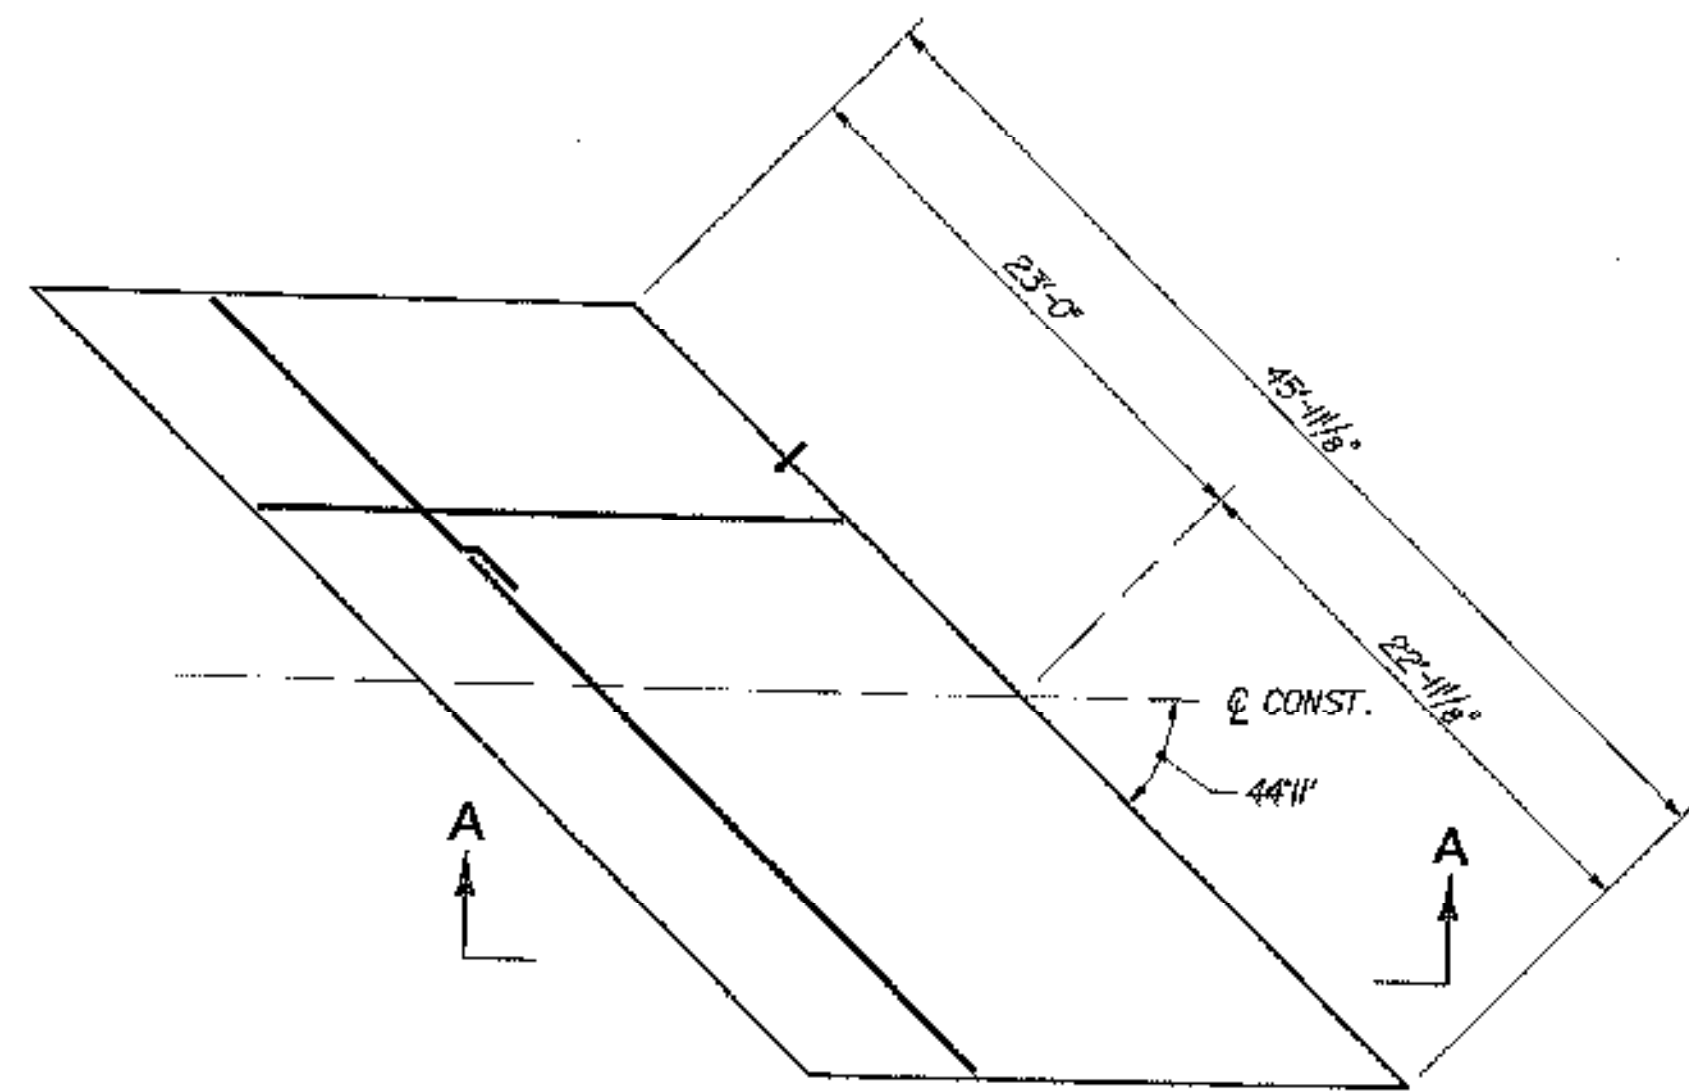


50N ABUTMENT 1

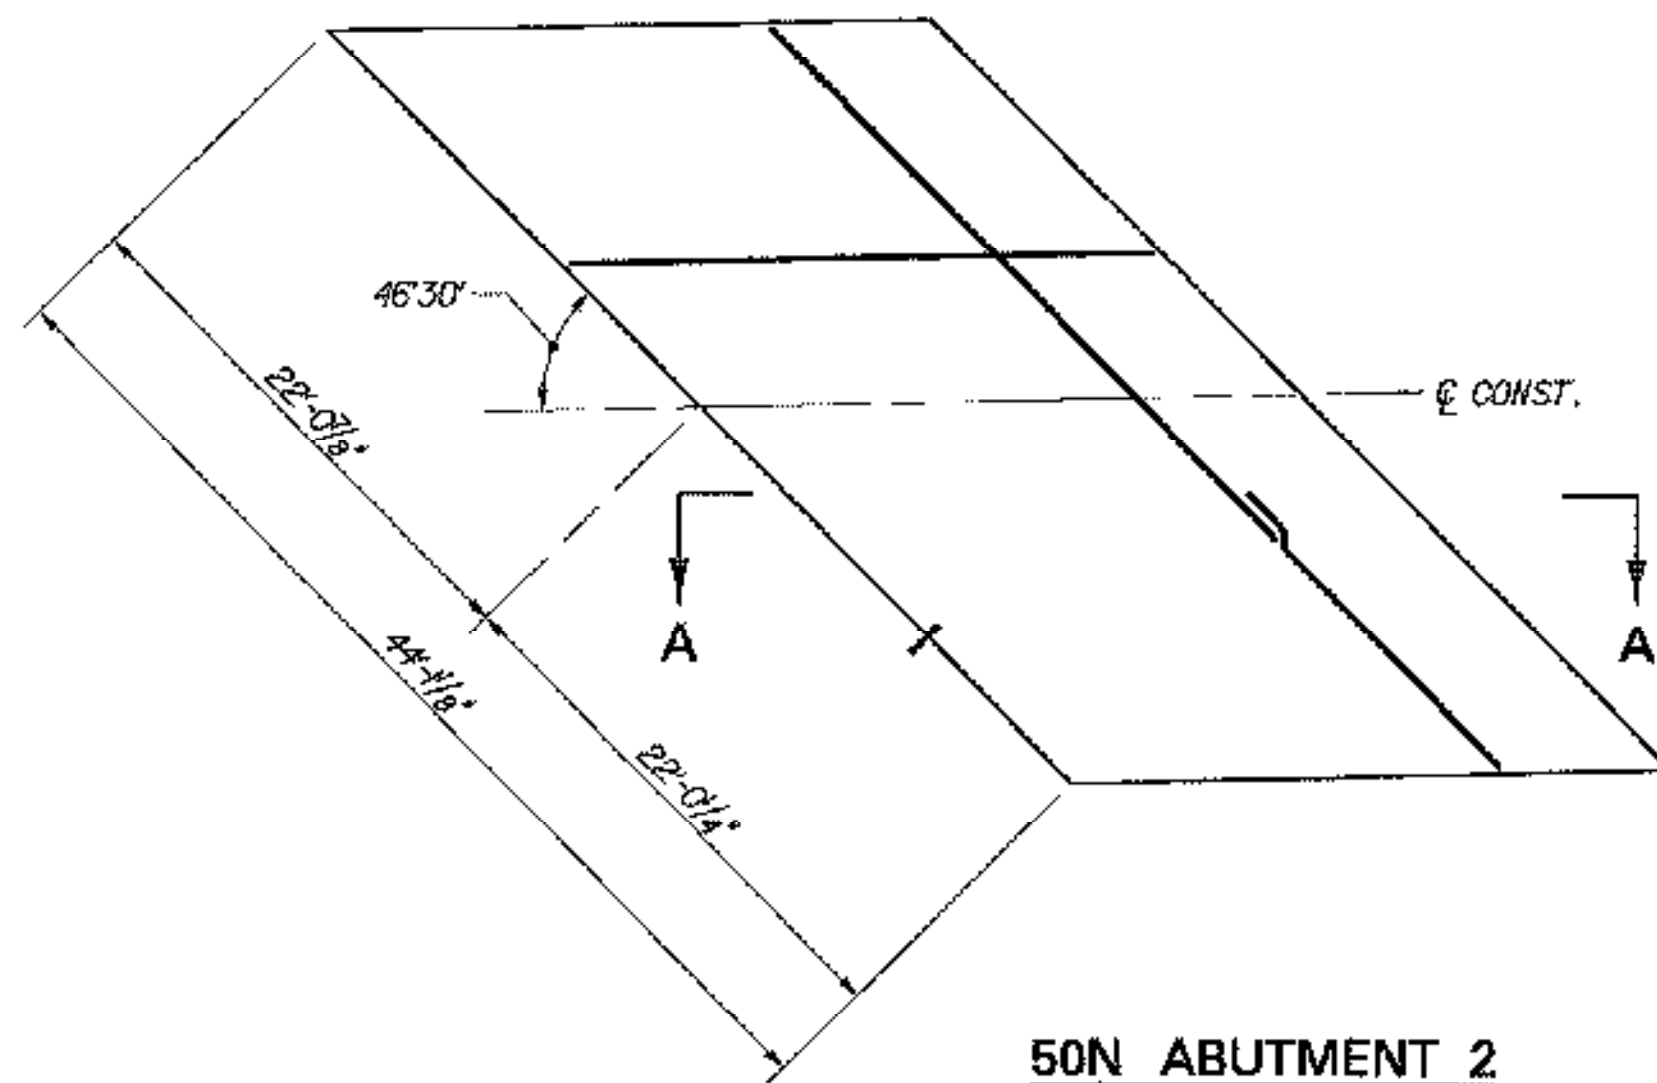

50N ABUTMENT 2

APPROACH SLAB PLANS  
SCALE: 1/8" = 1'-0"

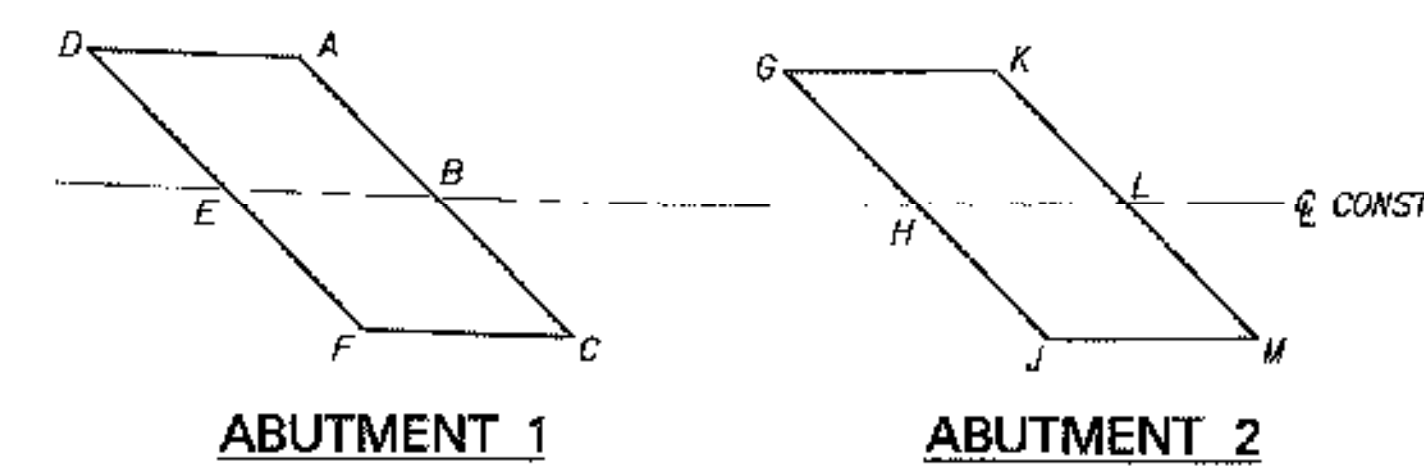

APPROACH SLAB ELEVATION KEY  
N.T.S.

RAISED FINISHED GRADE 1/4"  
RAISED FINISHED GRADE 1/2"

TOP OF APPROACH SLAB ELEVATIONS					
BR 50N			BR 50S		
LOCATION	STATION	ELEVATION	LOCATION	STATION	ELEVATION
A	5+47.54	474.57-.67	A	4+62.93	465.73
B	5+84.08	475.38-.48	B	4+79.87	466.86
C	5+80.49	476.18-.28	C	4+96.66	467.58
D	5+22.40	473.97-.07	D	4+37.78	465.00
E	5+39.09	474.78-.88	E	4+54.87	465.91
F	5+55.63	475.58-.69	F	4+71.81	466.83
G	7+86.73	480.25-.35	G	6+88.96	472.55
H	8+01.06	481.03-.13	H	7+04.60	473.44
J	8+17.06	481.80-.90	J	7+20.13	474.33
K	8+11.86	480.85-.95	K	7+14.09	473.31
L	8+26.98	481.62-.72	L	7+29.60	474.20
M	8+41.94	482.39-.49	M	7+44.98	475.09

NOTES:

- TIP HOOK END OF BAR AS REQUIRED TO ACHIEVE MINIMUM COVER.
- FOR DETAILS OF APPROACH SLAB PAVEMENT AND TRANSITION TO EXISTING PAVEMENT, SEE DETAIL ON TYPICAL END OF DECK SLAB DETAILS, BRIDGE SHEET C-15.


STATE OF VERMONT  
AGENCY OF TRANSPORTATION

Town Of MIDDLESEX-BOLTON Bridge No. 50N&S  
Highway No. I-89 Log Sta. Surv. Sta.

I-89 OVER U.S. ROUTE 2  
APPROACH SLAB DETAILS (50N&S)


Designed By P.W. SZUSTAK Drawn By R.A. BOTZENHART  
Checked By J.P. HALSTEAD Date 10/99 Bridge Design Supervisor

PROJECT MIDDLESEX-BOLTON PROJECT NO. IM-089-2(26)

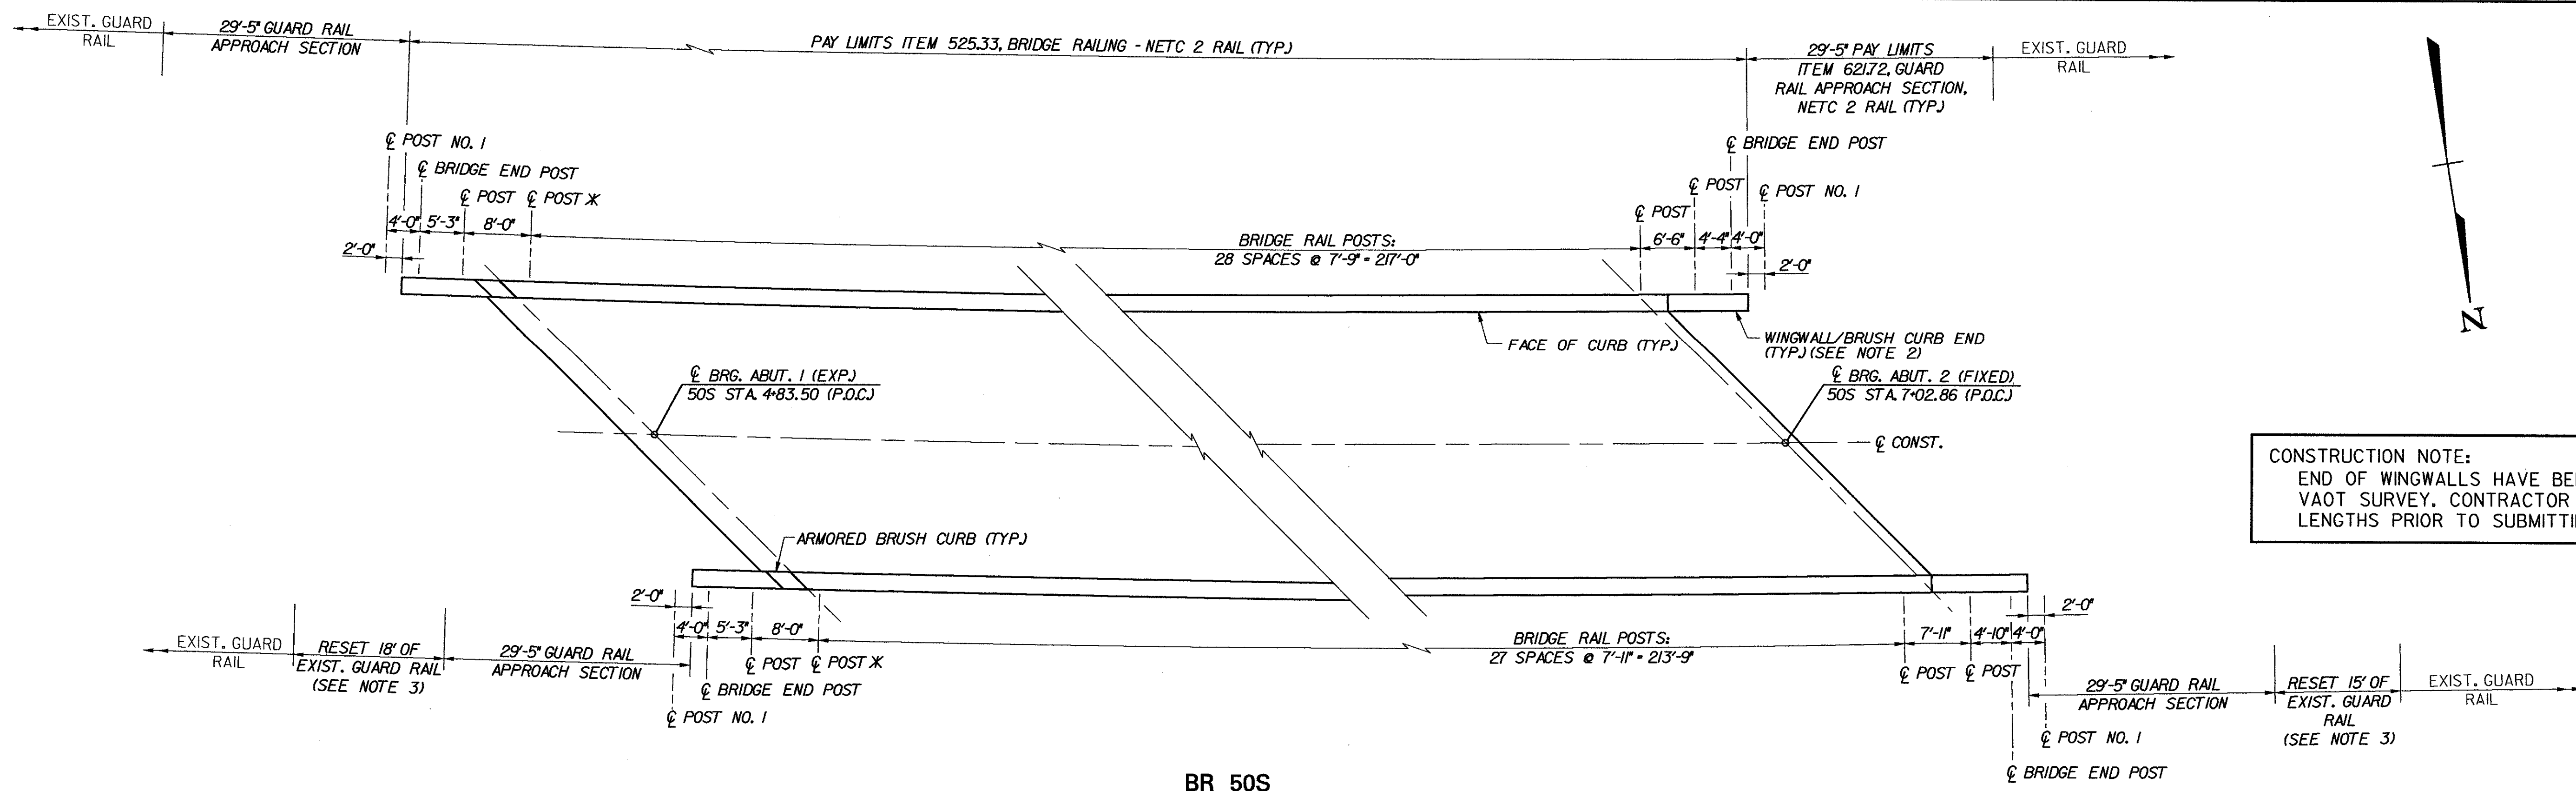

**CONSTRUCTION NOTE:**  
 END OF WINGWALLS HAVE BEEN LOCATED APPROXIMATELY BY VAOT SURVEY. CONTRACTOR SHALL VERIFY REQUIRED RAIL LENGTHS PRIOR TO SUBMITTING SHOP DRAWINGS FOR APPROVAL.

**BR 50S**

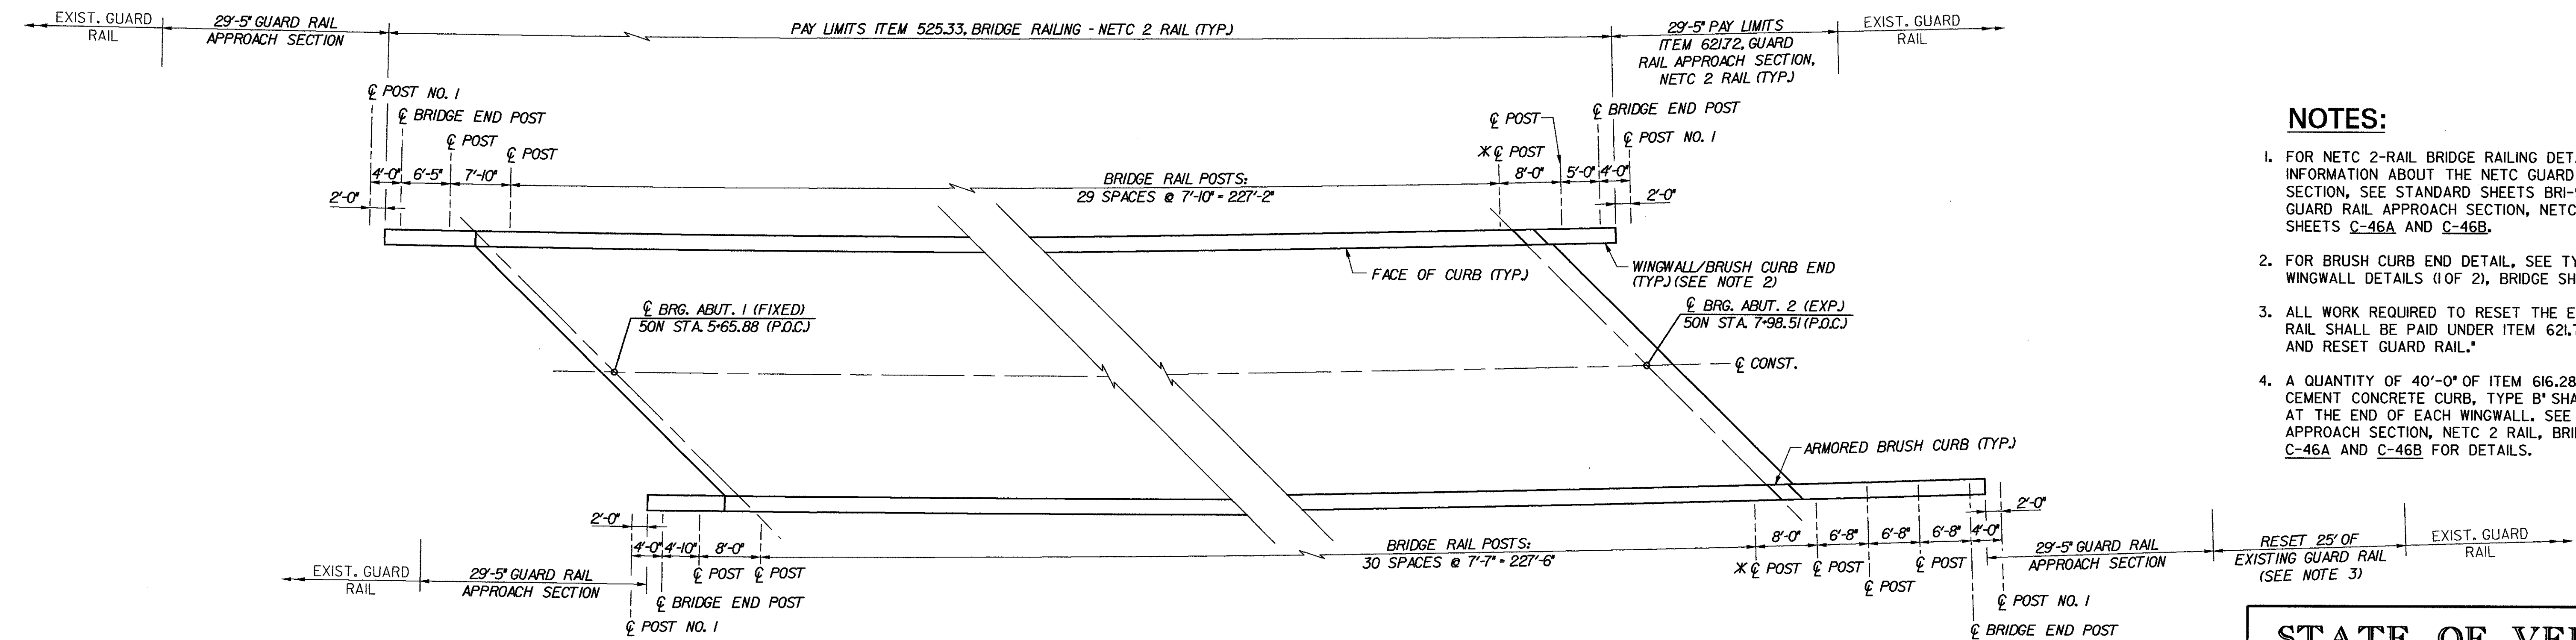

**BR 50N**

**RAILING LAYOUT**

SCALE: 3/32" = 1'-0"


\* RAIL EXPANSION JOINT SHALL BE LOCATED 2'-0" FROM C. OF INDICATED POST, ON BRIDGE EXPANSION JOINT SIDE OF POST.

**NOTES:**

- FOR NETC 2-RAIL BRIDGE RAILING DETAILS AND INFORMATION ABOUT THE NETC GUARD RAIL APPROACH SECTION, SEE STANDARD SHEETS BR1-97 AND BR3-97, AND GUARD RAIL APPROACH SECTION, NETC 2 RAIL, BRIDGE SHEETS C-46A AND C-46B.
- FOR BRUSH CURB END DETAIL, SEE TYPICAL WINGWALL DETAILS (1 OF 2), BRIDGE SHEET C-43.
- ALL WORK REQUIRED TO RESET THE EXISTING GUARD RAIL SHALL BE PAID UNDER ITEM 621.75, "REMOVING AND RESET GUARD RAIL."
- A QUANTITY OF 40'-0" OF ITEM 616.28 "CAST-IN-PLACE CEMENT CONCRETE CURB, TYPE B" SHALL BE PLACED AT THE END OF EACH WINGWALL. SEE GUARD RAIL APPROACH SECTION, NETC 2 RAIL, BRIDGE SHEETS C-46A AND C-46B FOR DETAILS.


**STATE OF VERMONT  
 AGENCY OF TRANSPORTATION**

Town Of	MIDDLESEX-BOLTON	Bridge No.	<b>50N&amp;S</b>
Highway No.	I-89	Log Sta.	
		Surv. Sta.	
I-89 OVER US ROUTE 2			
<b>CURB AND RAIL LAYOUT PLANS (50N&amp;S)</b>			
Designed By	P.W. SZUSTAK	Drawn By	R.A. BOTZENHART
Checked By	Date	Bridge Design Supervisor	Date
J.P. HALSTEAD	10/99	J.P. HALSTEAD	Date 10/99
PROJECT	MIDDLESEX-BOLTON	PROJECT NO.	IM-089-2(26)
TVGA CAD Drawing No.	50brall	Date	10/99
Bridge Sheet No.	<b>BR50-7</b>	Sheet	91 of 307

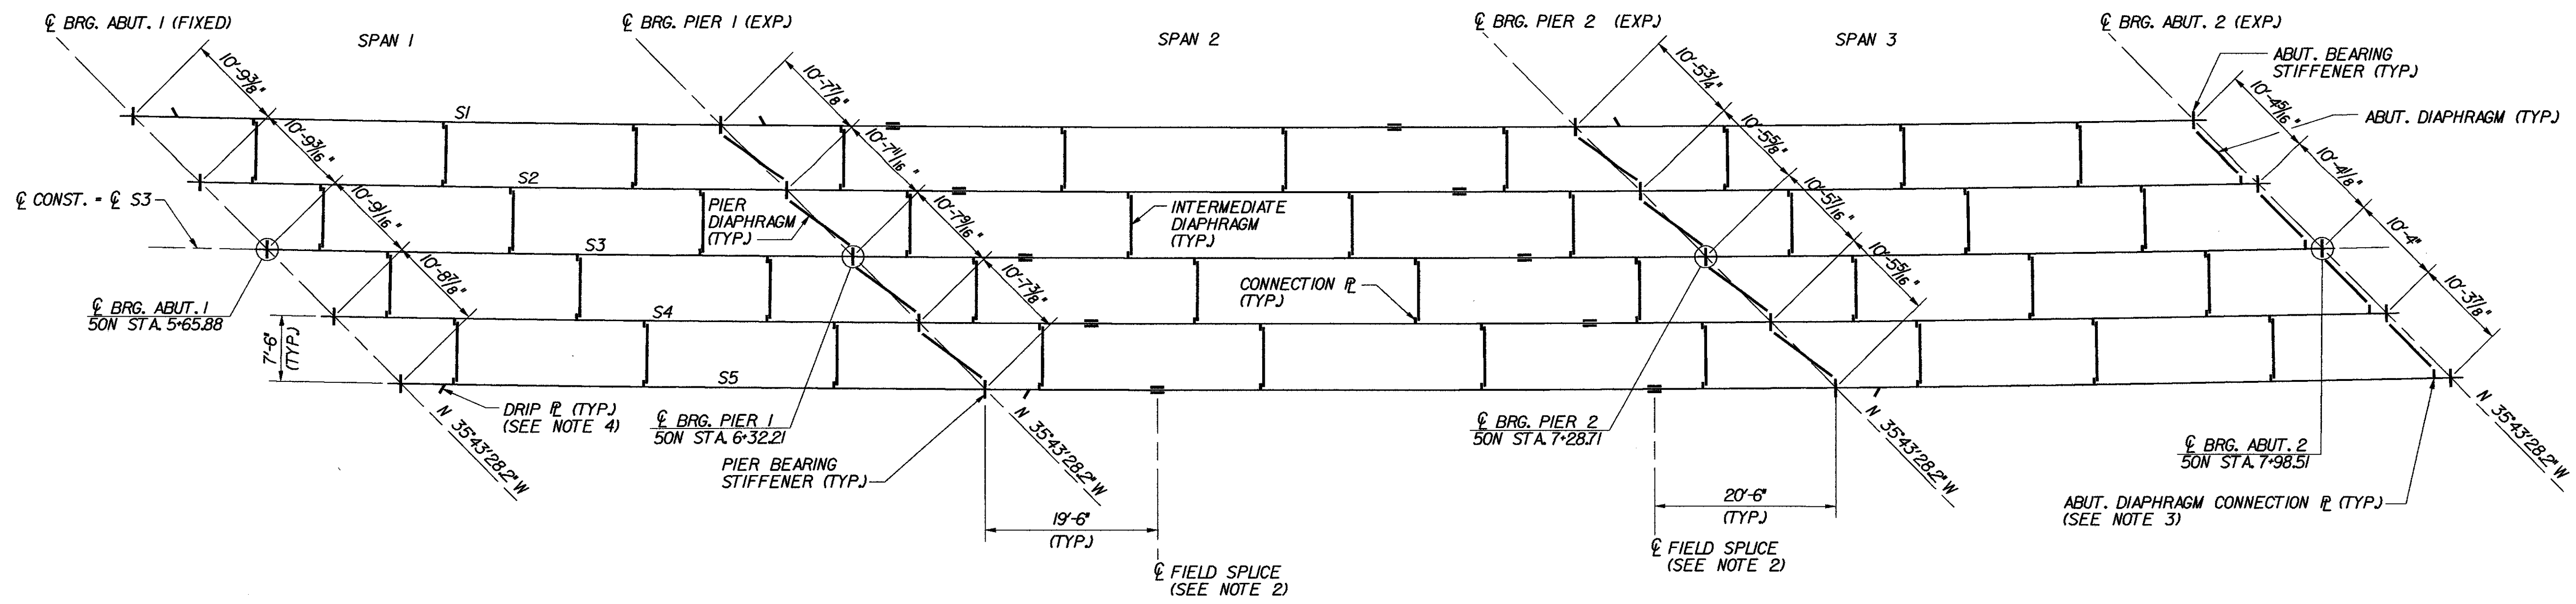

**FRAMING PLAN - BR 50N**

SCALE: 1/32" = 1'-0"

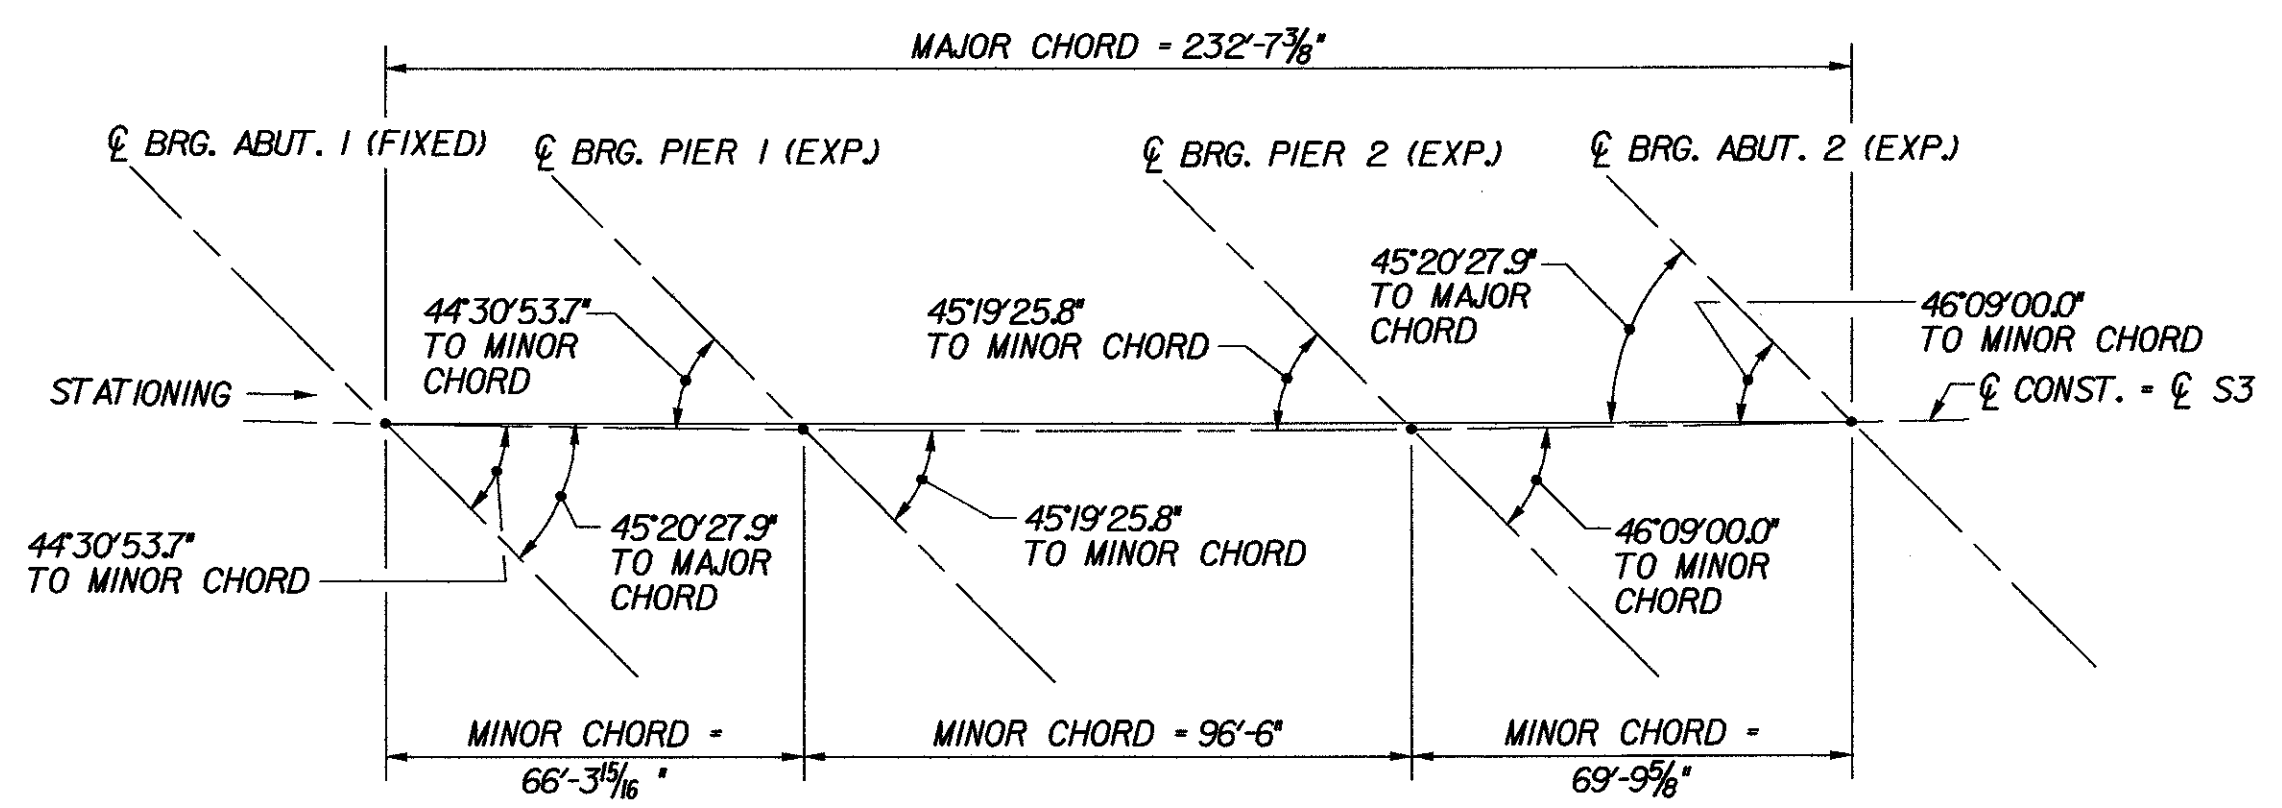

**LAYOUT DIAGRAM**

N.T.S.

**NOTES:**

- FOR PLATE GIRDER AND DIAPHRAGM DETAILS, SEE TYPICAL PLATE GIRDER DETAILS, BRIDGE SHEETS C-17 AND C-18.
- FOR FIELD SPLICE DETAILS, SEE TYPICAL GIRDER SPLICE DETAILS, BRIDGE SHEET C-20.
- STRINGER LAYOUT DIMENSIONS BEGIN AND END AT ABUTMENT CENTERLINES OF BEARING. LOCATION OF ABUTMENT DIAPHRAGM CONNECTION PLATES NOT INCLUDED IN TABLE. THE CONTRACTOR SHALL PROVIDE THIS DIMENSION IN SHOP DRAWINGS IN ACCORDANCE WITH DETAILS SHOWN IN TYPICAL PLATE GIRDER DETAILS, BRIDGE SHEETS C-17 AND C-18.
- FOR DRIP PLATE DETAIL, SEE TYPICAL BRIDGE DETAILS, BRIDGE SHEET C-46.


STRINGER NUMBER	STRINGER RADIUS	SIDE	SPAN 1 (ALONG ARC)				SPAN 2 (ALONG ARC)				SPAN 3 (ALONG ARC)				
			BRG. STIFFENER / CONNECTION PL. SPACING				BRG. STIFFENER / CONNECTION PL. SPACING				BRG. STIFFENER / CONNECTION PL. SPACING				
S1	5751.65'	LEFT	14'-0"	21'-6"	21'-6"	9'-6 1/8"	14'-0"	25'-0"	25'-0"	25'-0"	7'-8 15/16"	17'-1 5/8"	20'-0"	20'-0"	12'-10"
		RIGHT	6'-3 3/16"	21'-6"	21'-6"	17'-1 13/16"	6'-5 5/16"	25'-0"	25'-0"	25'-0"	15'-2 3/16"	9'-10 5/8"	20'-0"	20'-0"	20'-0"
S2	5759.15'	LEFT	14'-0"	21'-6"	21'-6"	9'-5"	14'-0"	25'-0"	25'-0"	25'-0"	7'-7 1/2"	17'-0 3/8"	20'-0"	20'-0"	12'-10 1/4"
		RIGHT	6'-3 7/16"	21'-6"	21'-6"	17'-0 1/2"	6'-5 9/16"	25'-0"	25'-0"	25'-0"	15'-0 7/16"	9'-9 5/8"	20'-0"	20'-0"	20'-0"
S3	5766.65'	LEFT	14'-0"	21'-6"	21'-6"	9'-3 15/16"	14'-0"	25'-0"	25'-0"	25'-0"	7'-6"	16'-11 3/16"	20'-0"	20'-0"	12'-10 7/16"
		RIGHT	6'-3 11/16"	21'-6"	21'-6"	16'-11 3/16"	6'-5 13/16"	25'-0"	25'-0"	25'-0"	14'-10 11/16"	9'-8 5/8"	20'-0"	20'-0"	20'-0"
S4	5774.15'	LEFT	14'-0"	21'-6"	21'-6"	9'-2 7/8"	14'-0"	25'-0"	25'-0"	25'-0"	7'-4 1/2"	16'-10"	20'-0"	20'-0"	12'-10 5/8"
		RIGHT	6'-3 15/16"	21'-6"	21'-6"	16'-9 7/8"	6'-6"	25'-0"	25'-0"	25'-0"	14'-9 1/16"	9'-7 5/8"	20'-0"	20'-0"	20'-0"
S5	5781.65'	LEFT													
		RIGHT													

**STRINGER LAYOUT TABLE**

(SEE NOTE 3)


**STATE OF VERMONT  
AGENCY OF TRANSPORTATION**

Town Of	MIDDLESEX-BOLTON	Bridge No.	<b>50N</b>
Highway No.	I-89	Log Sta.	
		Surv. Sta.	
I-89 NB OVER U.S. ROUTE 2			
<b>FRAMING PLAN (50N)</b>			
Designed By	P.W. SZUSTAK	Drawn By	R.A. BOTZENHART
Checked By	Date	Bridge Design Supervisor	
J.P. HALSTEAD	10/99	J.P. HALSTEAD	Date 10/99
PROJECT	MIDDLESEX-BOLTON	PROJECT NO.	IM-089-2(26)
TVGA CAD Drawing No.	50nfp	Date	10/99
Bridge Sheet No.	<b>BR50-8</b>	Sheet	92 of 307

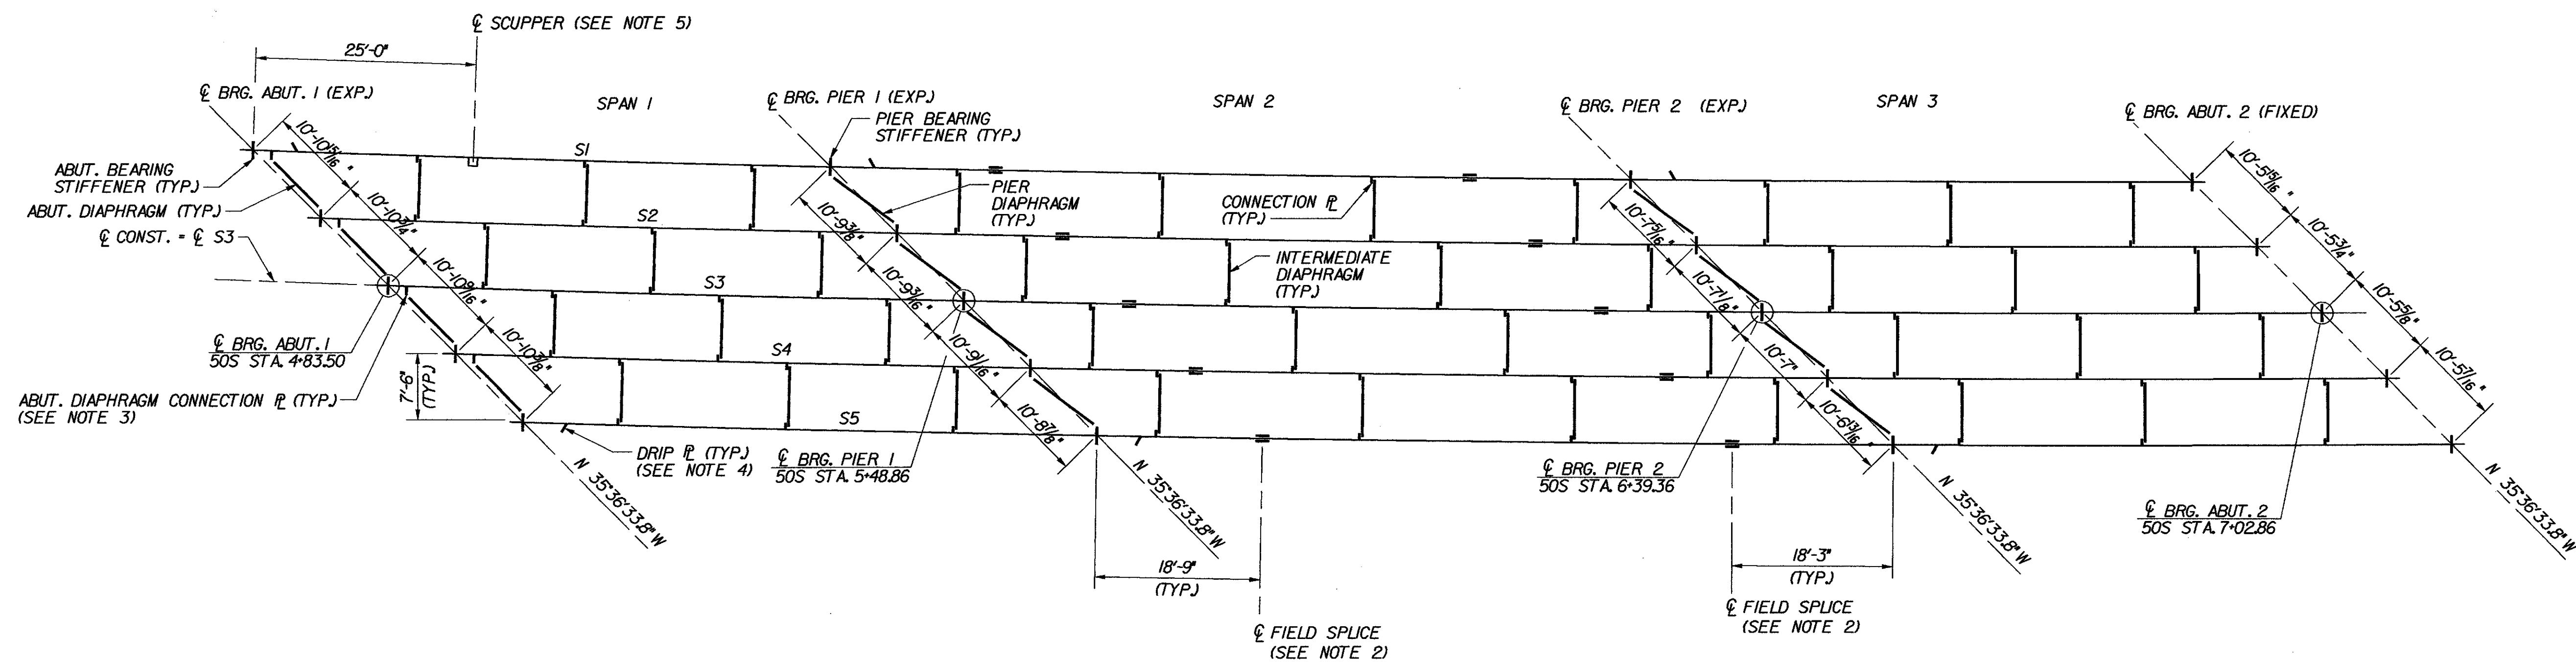

**FRAMING PLAN - BR 50S**

SCALE: 3/32" = 1'-0"

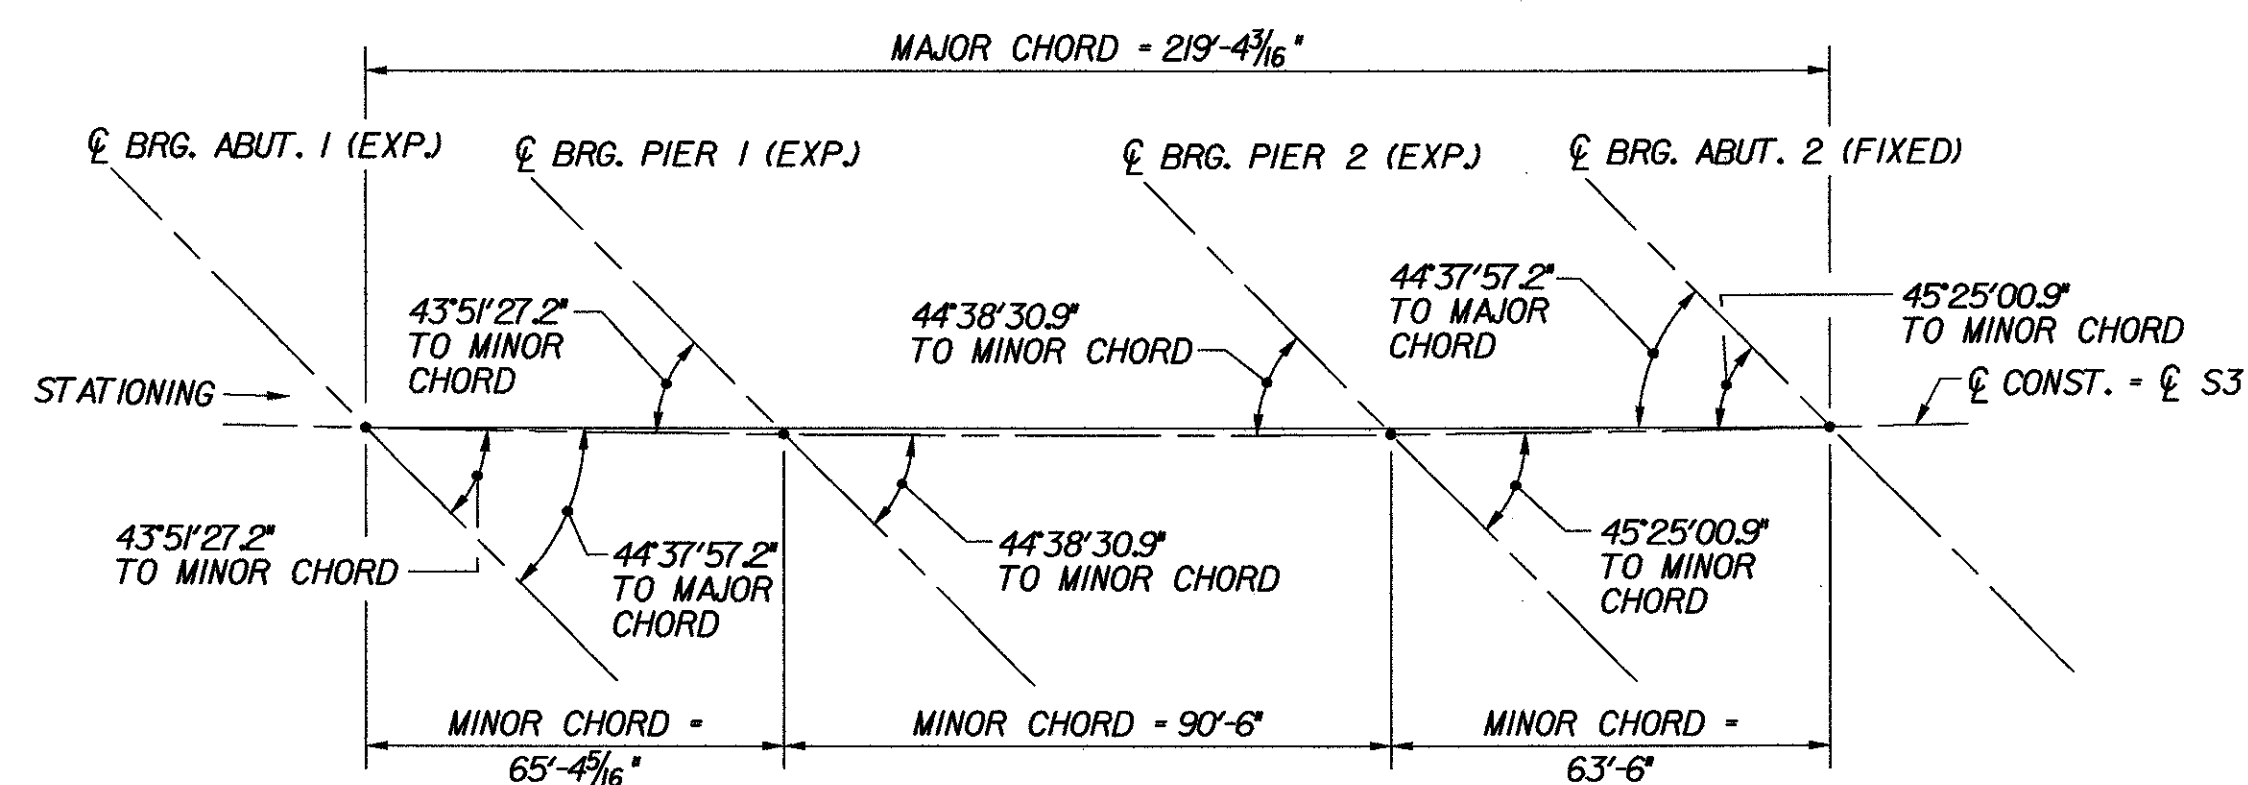

**LAYOUT DIAGRAM**

N.T.S.

**NOTES:**

- FOR PLATE GIRDER AND DIAPHRAGM DETAILS, SEE TYPICAL PLATE GIRDER DETAILS, BRIDGE SHEETS C-17 AND C-18.
- FOR FIELD SPLICE DETAILS, SEE TYPICAL GIRDER SPLICE DETAILS, BRIDGE SHEET C-20.
- STRINGER LAYOUT DIMENSIONS BEGIN AND END AT ABUTMENT CENTERLINES OF BEARING. LOCATION OF ABUTMENT DIAPHRAGM CONNECTION PLATES NOT INCLUDED IN TABLE. THE CONTRACTOR SHALL PROVIDE THIS DIMENSION IN SHOP DRAWINGS IN ACCORDANCE WITH DETAILS SHOWN IN TYPICAL PLATE GIRDER DETAILS, BRIDGE SHEETS C-17 AND C-18.
- FOR DRIP PLATE DETAIL, SEE TYPICAL BRIDGE DETAILS, BRIDGE SHEET C-46.
- FOR SCUPPER DETAILS, SEE TYPICAL SCUPPER DETAILS, BRIDGE SHEET C-39.


STRINGER NUMBER	STRINGER RADIUS	SIDE	SPAN 1 (ALONG ARC)				TOTAL	SPAN 2 (ALONG ARC)				TOTAL	SPAN 3 (ALONG ARC)				TOTAL	
			BRG. STIFFENER / CONNECTION PL. SPACING					BRG. STIFFENER / CONNECTION PL. SPACING					BRG. STIFFENER / CONNECTION PL. SPACING					
S1	5677.65'	LEFT				8' - 6 9/16"	65' - 6 9/16"	14' - 9"	23' - 0"	24' - 0"	23' - 0"	5' - 11 15/16"	90' - 8 15/16"	15' - 6 1/4"	20' - 9"	20' - 9"	6' - 7 3/4"	63' - 8"
		RIGHT	19' - 0"	19' - 0"	19' - 0"	8' - 6 9/16"	65' - 6 9/16"	14' - 9"	23' - 0"	24' - 0"	23' - 0"	5' - 11 15/16"	90' - 8 15/16"	15' - 6 1/4"	20' - 9"	20' - 9"	6' - 7 3/4"	63' - 8"
S2	5685.15'	LEFT	11' - 1 1/8"	19' - 0"	19' - 0"	16' - 4 5/16"	65' - 5 7/16"	7' - 0 1/16"	23' - 0"	24' - 0"	13' - 7 3/8"	90' - 7 7/16"	8' - 1"	20' - 9"	20' - 9"	14' - 0"	63' - 7"	
		RIGHT	19' - 0"	19' - 0"	19' - 0"	8' - 5 7/16"	65' - 5 7/16"	14' - 9"	23' - 0"	24' - 0"	5' - 10 7/16"	90' - 7 7/16"	15' - 5"	20' - 9"	20' - 9"	6' - 8"	63' - 7"	
S3	5692.65'	LEFT	11' - 1 3/8"	19' - 0"	19' - 0"	16' - 2 15/16"	65' - 4 5/16"	7' - 0 5/16"	23' - 0"	24' - 0"	13' - 5 11/16"	90' - 6"	8' - 0"	20' - 9"	20' - 9"	14' - 0"	63' - 6"	
		RIGHT	19' - 0"	19' - 0"	19' - 0"	8' - 4 5/16"	65' - 4 5/16"	14' - 9"	23' - 0"	24' - 0"	5' - 9"	90' - 6"	14' - 8 1/4"	20' - 9"	20' - 9"	7' - 3 3/4"	63' - 6"	
S4	5700.15'	LEFT	11' - 1 5/8"	19' - 0"	19' - 0"	16' - 1 9/16"	65' - 3 3/16"	7' - 0 9/16"	23' - 0"	24' - 0"	13' - 4"	90' - 4 9/16"	7' - 1 1/4"	20' - 9"	20' - 9"	14' - 0"	63' - 5"	
		RIGHT	19' - 0"	19' - 0"	19' - 0"	8' - 3 3/16"	65' - 3 3/16"	14' - 9"	23' - 0"	24' - 0"	5' - 7 9/16"	90' - 4 9/16"	15' - 2 9/16"	20' - 9"	20' - 9"	6' - 8 7/16"	63' - 5"	
S5	5707.65'	LEFT	11' - 1 7/8"	19' - 0"	19' - 0"	16' - 0 1/4"	65' - 2 1/8"	7' - 0 13/16"	23' - 0"	24' - 0"	13' - 2 1/4"	90' - 3 1/16"	7' - 10 1/16"	20' - 9"	20' - 9"	14' - 0"	63' - 4 1/16"	
		RIGHT	19' - 0"	19' - 0"	19' - 0"	8' - 2 1/8"	65' - 2 1/8"	14' - 9"	23' - 0"	24' - 0"	13' - 2 1/4"	90' - 3 1/16"	7' - 10 1/16"	20' - 9"	20' - 9"	14' - 0"	63' - 4 1/16"	

**STRINGER LAYOUT TABLE**

(SEE NOTE 3)

**STATE OF VERMONT  
AGENCY OF TRANSPORTATION**


Town Of	MIDDLESEX-BOLTON	Bridge No.	<b>50S</b>
Highway No.	I-89	Log Sta.	
		Surv. Sta.	
I-89 SB OVER U.S. ROUTE 2			
<b>FRAMING PLAN (50S)</b>			
Designed By	P.W. SZUSTAK	Drawn By	R.A. BOTZENHART
Checked By	Date	Bridge Design Supervisor	
	J.P. HALSTEAD 10/99	J.P. HALSTEAD	Date 10/99
PROJECT	MIDDLESEX-BOLTON	PROJECT NO.	IM-089-2(26)
TVGA CAD Drawing No.	50sfp	Date	10/99
Bridge Sheet No.	<b>BR50-9</b>	Sheet	93 of 307

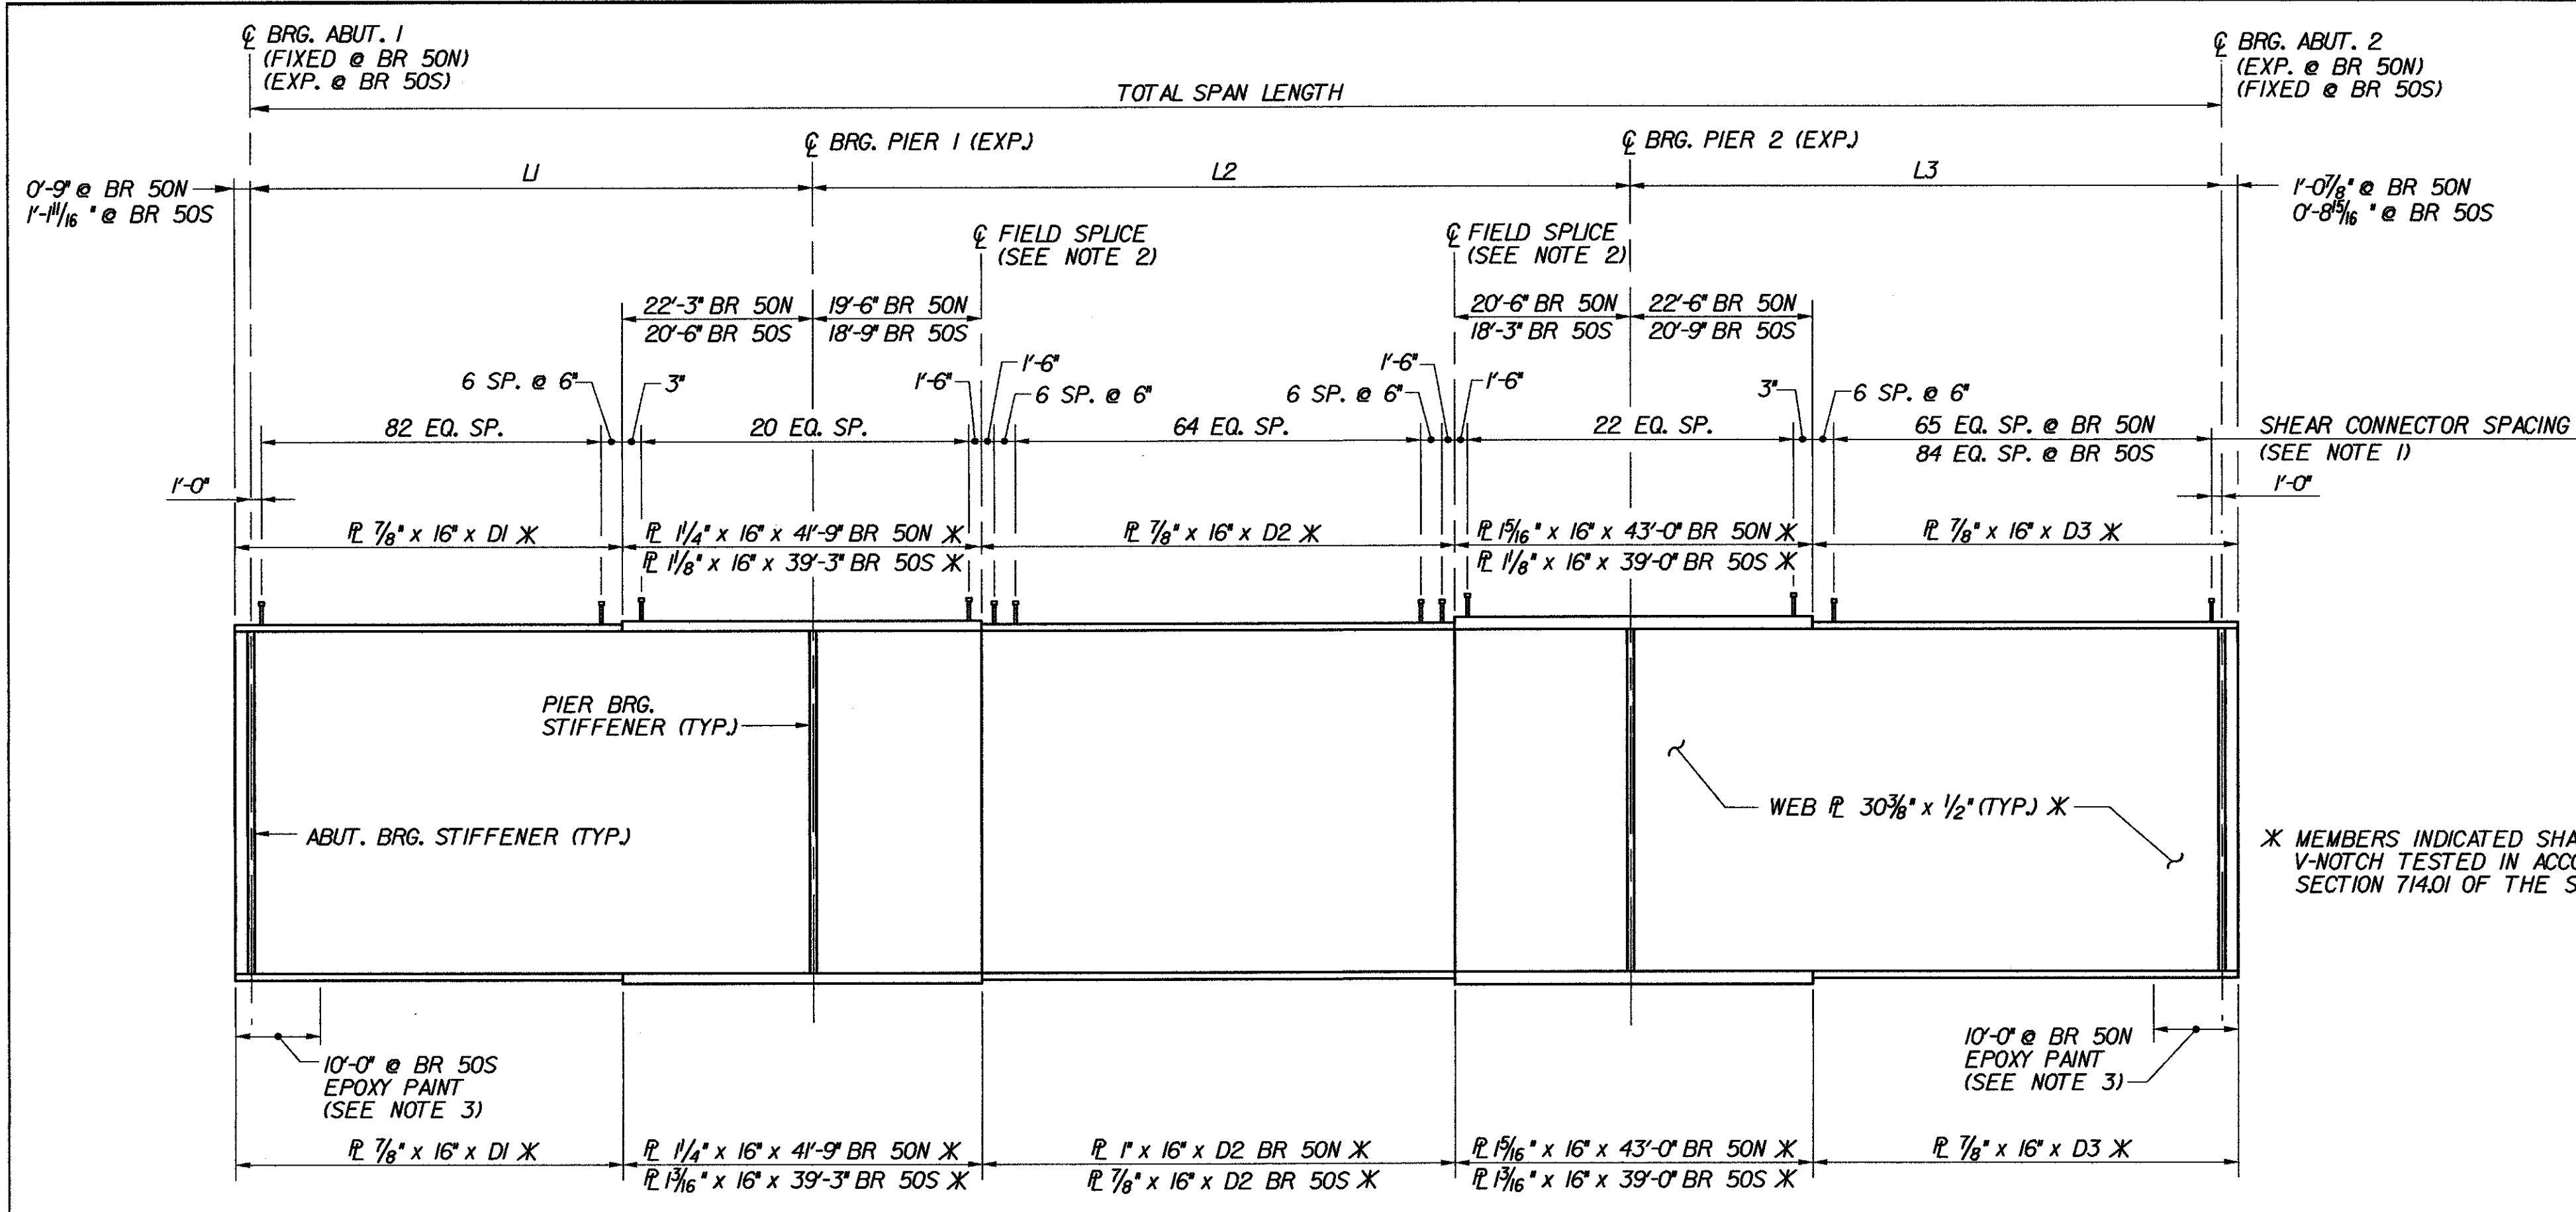


**STRINGER ELEVATION (PLATE GIRDER)**  
N.T.S.

BR 50N					
STRINGER	RADIUS	SPAN LENGTHS (ALONG ARC)			TOTAL SPAN LENGTH
		L1	L2	L3	
S1	5751.65'	66' - 6 1/8"	96' - 8 15/16"	69' - 11 5/8"	233' - 2 11/16"
S2	5759.15'	66' - 5"	96' - 7 1/2"	69' - 10 5/8"	232' - 11 1/8"
S3	5766.65'	66' - 3 15/16"	96' - 6"	69' - 9 5/8"	232' - 7 9/16"
S4	5774.15'	66' - 2 7/8"	96' - 4 1/2"	69' - 8 5/8"	232' - 4"
S5	5781.65'	66' - 1 13/16"	96' - 3 1/16"	69' - 7 5/8"	232' - 0 1/2"
SECTION LENGTHS (ALONG ARC)					
STRINGER	RADIUS	SECTION LENGTHS (ALONG ARC)			TOTAL SPAN LENGTH
		D1	D2	D3	
S1	5751.65'	45' - 0 1/8"	56' - 8 15/16"	48' - 6 1/2"	
S2	5759.15'	44' - 11"	56' - 7 1/2"	48' - 5 1/2"	
S3	5766.65'	44' - 9 15/16"	56' - 6"	48' - 4 1/2"	
S4	5774.15'	44' - 8 7/8"	56' - 4 1/2"	48' - 3 1/2"	
S5	5781.65'	44' - 7 13/16"	56' - 3 1/16"	48' - 2 1/2"	

BR 50S					
STRINGER	RADIUS	SPAN LENGTHS (ALONG ARC)			TOTAL SPAN LENGTH
		L1	L2	L3	
S1	5677.65'	65' - 6 9/16"	90' - 8 15/16"	63' - 8"	219' - 11 1/2"
S2	5685.15'	65' - 5 7/16"	90' - 7 7/16"	63' - 7"	219' - 7 7/8"
S3	5692.65'	65' - 4 5/16"	90' - 6"	63' - 6"	219' - 4 5/16"
S4	5700.15'	65' - 3 3/16"	90' - 4 9/16"	63' - 5"	219' - 0 3/4"
S5	5707.65'	65' - 2 1/8"	90' - 3 1/16"	63' - 4 1/16"	218' - 9 1/4"
SECTION LENGTHS (ALONG ARC)					
STRINGER	RADIUS	SECTION LENGTHS (ALONG ARC)			TOTAL SPAN LENGTH
		D1	D2	D3	
S1	5677.65'	46' - 2 1/4"	53' - 8 15/16"	43' - 7 15/16"	
S2	5685.15'	46' - 1 1/8"	53' - 7 7/16"	43' - 6 15/16"	
S3	5692.65'	46' - 0"	53' - 6"	43' - 5 15/16"	
S4	5700.15'	45' - 10 7/8"	53' - 4 9/16"	43' - 4 15/16"	
S5	5707.65'	45' - 9 13/16"	53' - 3 1/16"	43' - 4"	

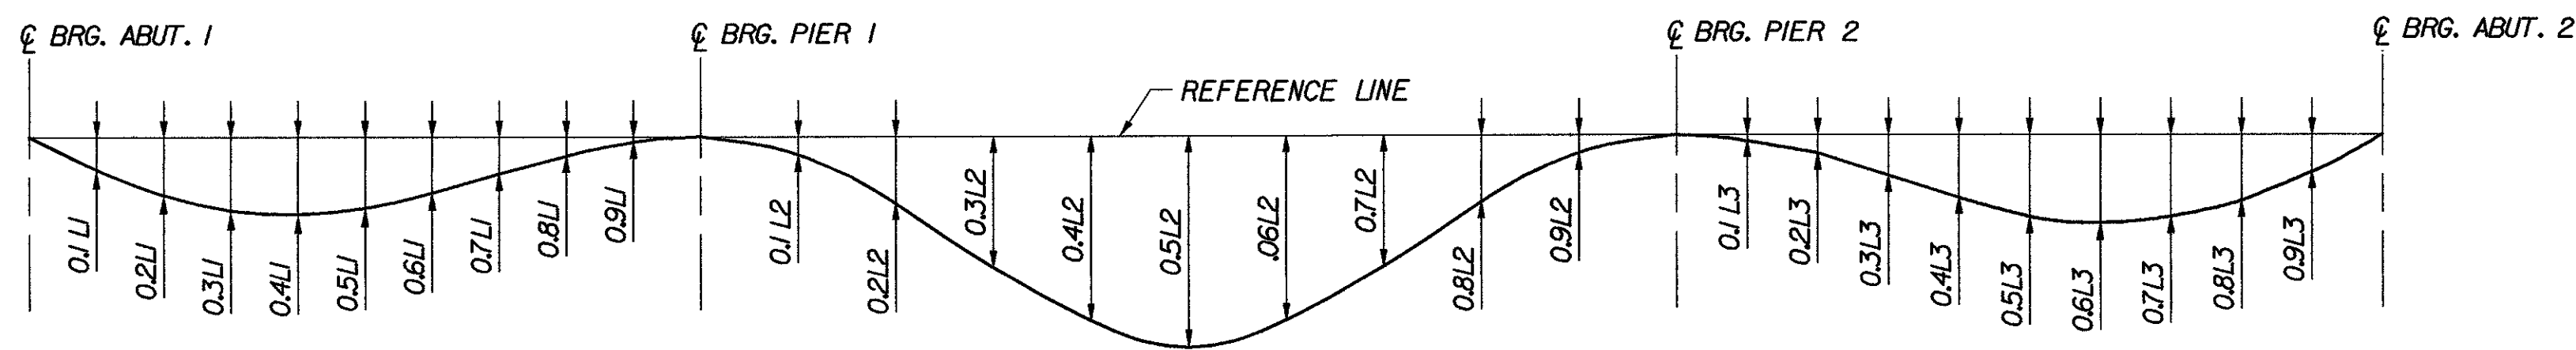

**DEAD LOAD DEFLECTION DIAGRAM**  
N.T.S.

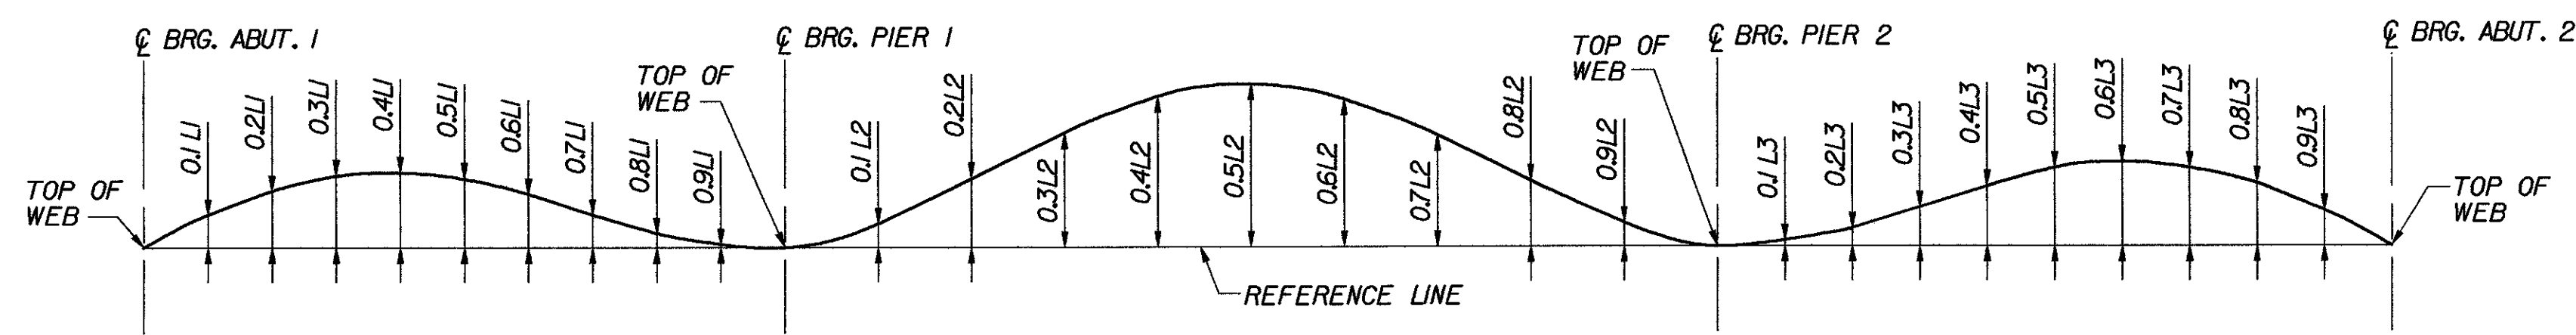

**CAMBER DIAGRAM**  
N.T.S.

BRIDGE	DL DEFLECTION																														
	CL	ABUT. 1									CL	PIER 1									CL	PIER 2									CL
	ABUT. 1	0.1 L1	0.2 L1	0.3 L1	0.4 L1	0.5 L1	0.6 L1	0.7 L1	0.8 L1	0.9 L1	PIER 1	0.1 L2	0.2 L2	0.3 L2	0.4 L2	0.5 L2	0.6 L2	0.7 L2	0.8 L2	0.9 L2	PIER 2	0.1 L3	0.2 L3	0.3 L3	0.4 L3	0.5 L3	0.6 L3	0.7 L3	0.8 L3	0.9 L3	ABUT. 2
50N	0"	0 1/4"	0 7/16"	0 9/16"	0 9/16"	0 1/2"	0 3/8"	0 3/8"	0"	-0 1/16"	0"	0 3/8"	1"	1 9/16"	2"	2 1/8"	1 15/16"	1 1/2"	0 15/16"	0 3/8"	0"	0"	0 1/8"	0 5/16"	0 1/2"	0 11/16"	0 3/4"	0 11/16"	0 9/16"	0 5/16"	0"
50S	0"	0 1/4"	0 7/16"	0 9/16"	0 5/8"	0 9/16"	0 7/16"	0 1/4"	0 1/16"	0"	0"	0 5/16"	0 13/16"	1 5/16"	1 5/8"	1 3/4"	1 5/8"	1 5/16"	0 13/16"	0 5/16"	0"	-0 1/16"	0 1/16"	0 3/16"	0 5/16"	0 7/16"	0 1/2"	0 1/2"	0 3/8"	0 3/16"	0"

BRIDGE	TOTAL CAMBER																														
	CL	ABUT. 1									CL	PIER 1									CL	PIER 2									CL
	ABUT. 1	0.1 L1	0.2 L1	0.3 L1	0.4 L1	0.5 L1	0.6 L1	0.7 L1	0.8 L1	0.9 L1	PIER 1	0.1 L2	0.2 L2	0.3 L2	0.4 L2	0.5 L2	0.6 L2	0.7 L2	0.8 L2	0.9 L2	PIER 2	0.1 L3	0.2 L3	0.3 L3	0.4 L3	0.5 L3	0.6 L3	0.7 L3	0.8 L3	0.9 L3	ABUT. 2
50N	0"	0 11/16"	1 3/16"	1 1/2"	1 9/16"	1 7/16"	1 1/8"	0 11/16"	0 1/4"	0"	0"	0 1/2"	1 7/16"	2 3/8"	3 1/8"	3 3/8"	3 1/16"	2 5/16"	1 3/8"	0 1/2"	0"	0 1/16"	0 3/8"	0 13/16"	1 1/4"	1 5/8"	1 3/4"	1 5/8"	1 5/16"	0 3/4"	0"
50S	0"	0 11/16"	1 3/16"	1 1/2"	1 5/8"	1 1/2"	1 3/16"	0 3/4"	0 5/16"	0 1/16"	0"	0 3/8"	1 1/8"	2"	2 3/4"	3"	2 3/4"	2"	1 1/8"	0 3/8"	0"	0"	0 5/16"	0 11/16"	1 1/16"	1 3/8"	1 1/2"	1 7/16"	1 1/8"	0 5/8"	0"


**NOTES:**

- EACH ROW OF SHEAR CONNECTORS SHALL CONSIST OF 2 STUDS. FOR LATERAL SPACING, SEE TRANSVERSE SECTION (50N&S), BRIDGE SHEET BR50-4.
- FOR FIELD SPLICE DETAILS, SEE TYPICAL GIRDER SPLICE DETAILS, BRIDGE SHEET C-20.
- ALL STRUCTURAL STEEL WITHIN 10 FEET OF END OF STRINGER AT EXPANSION ENDS SHALL BE COATED WITH A PROTECTIVE PAINT SYSTEM, WITH THE FINAL COAT TO BE DARK BROWN (COLOR CHIP #20059) TO BLEND WITH THE WEATHERING STEEL. THE COST OF PAINTING SHALL BE PAID FOR UNDER ITEM 513.25, 'STRUCTURAL PAINTING, SHOP APPLIED'.

**STATE OF VERMONT  
AGENCY OF TRANSPORTATION**


Town Of	MIDDLESEX-BOLTON	Bridge No.	50N&S
Highway No.	I-89	Log Sta.	
		Surv. Sta.	
I-89 OVER U.S. ROUTE 2			
<b>STRINGER ELEVATION (50N&amp;S)</b>			
Designed By	P.W. SZUSTAK	Drawn By	R.A. BOTZENHART
Checked By	Date	Bridge Design Supervisor	Date
	J.P. HALSTEAD 10/99	J.P. HALSTEAD	Date 10/99
PROJECT	MIDDLESEX-BOLTON	PROJECT NO.	IM-089-2(26)
TVGA CAD Drawing No.	50str-el	Date	08/00
Bridge Sheet No.	BR50-10	Sheet	94 of 307

NOTE: RAISED FINISHED GRADE OF BRIDGE 50N 0.104'

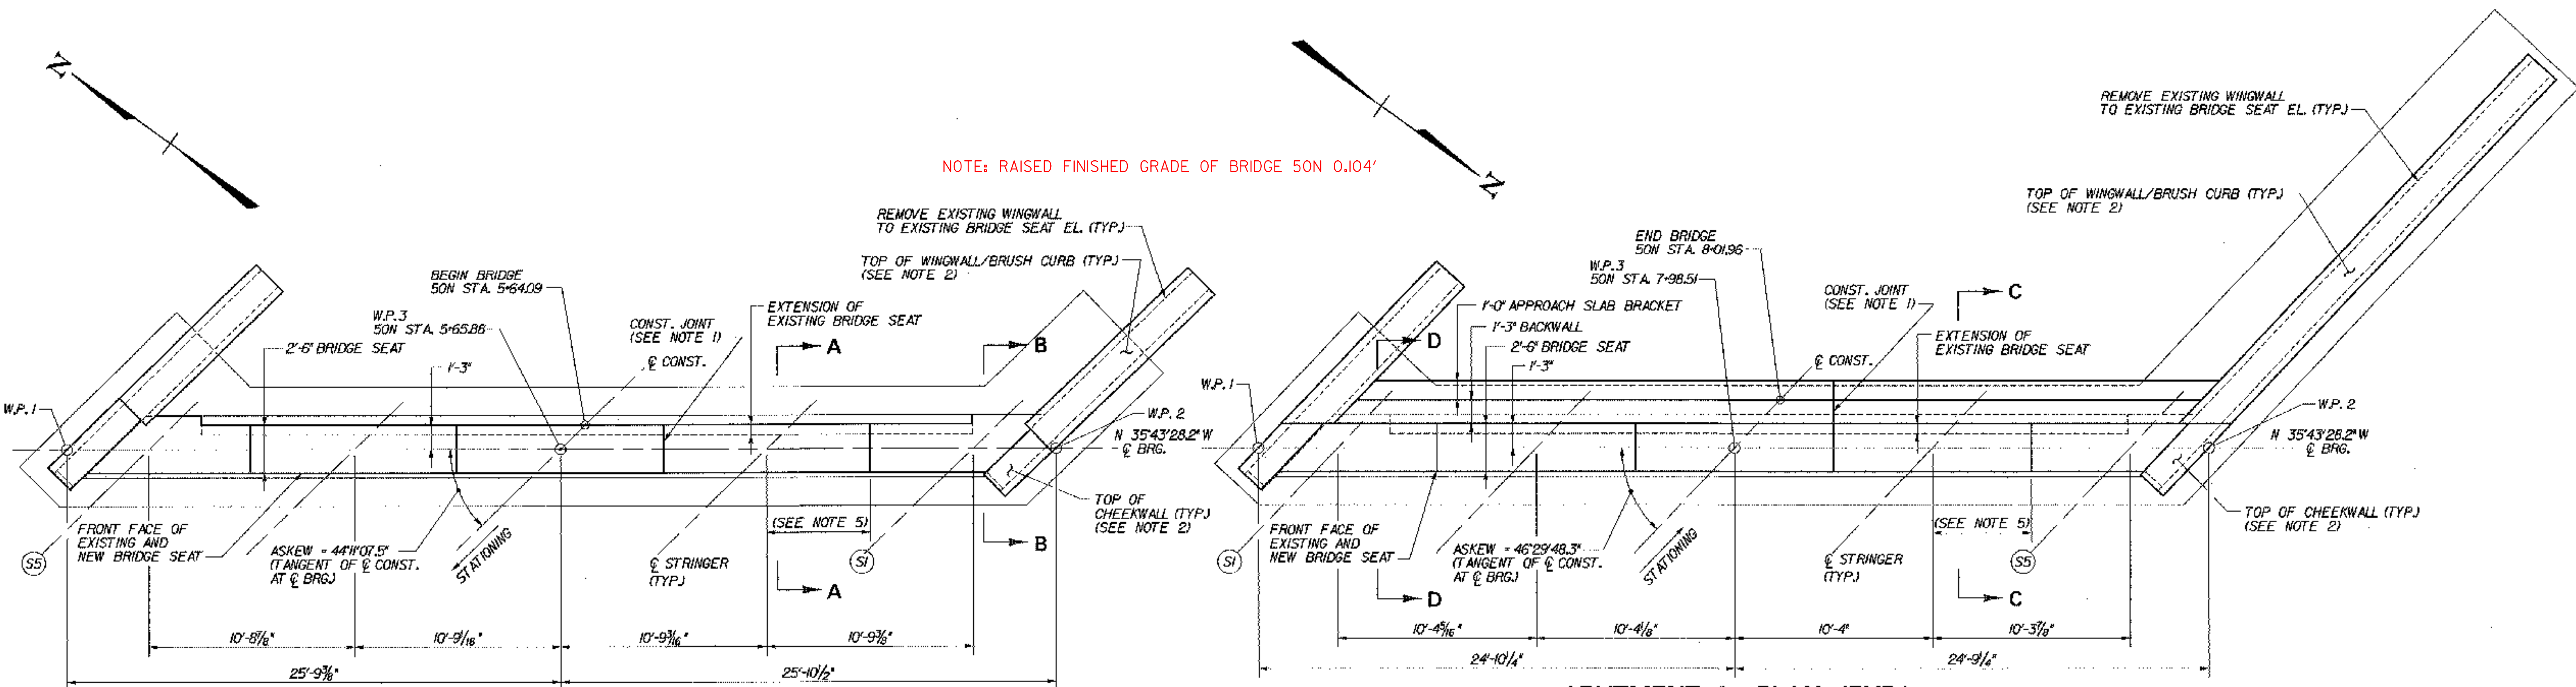


**ABUTMENT 1 PLAN (FIXED)**  
SCALE: 1/4"=1'-0"


**ABUTMENT 2 PLAN (EXP.)**  
SCALE: 1/4"=1'-0"

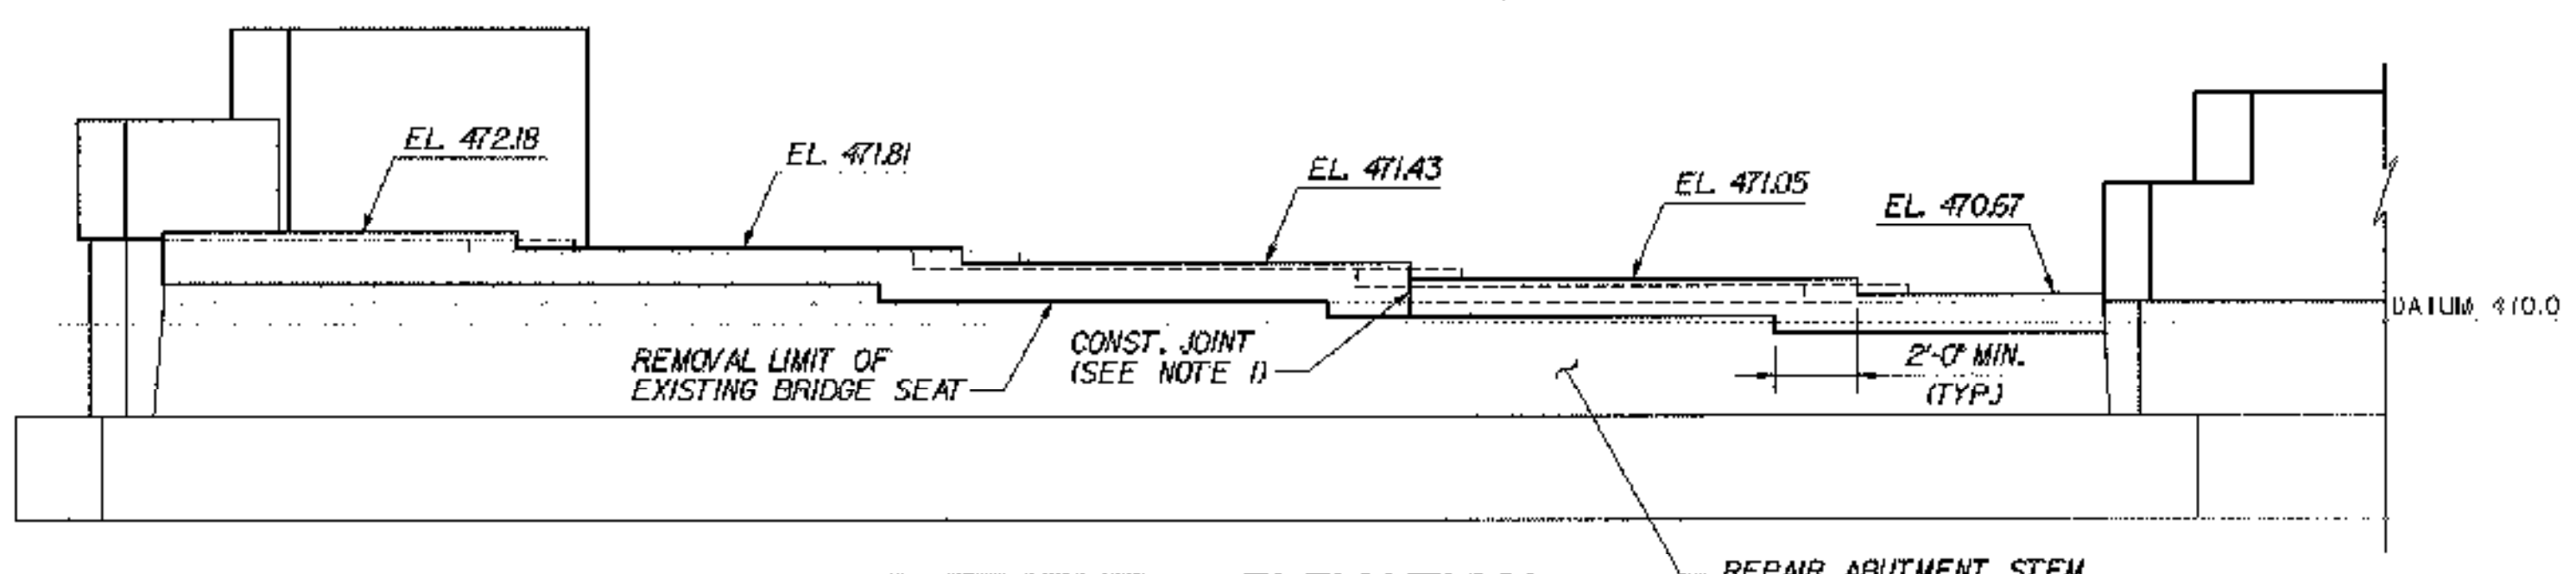


**ABUTMENT 1 ELEVATION**  
SCALE: 1/4"=1'-0"

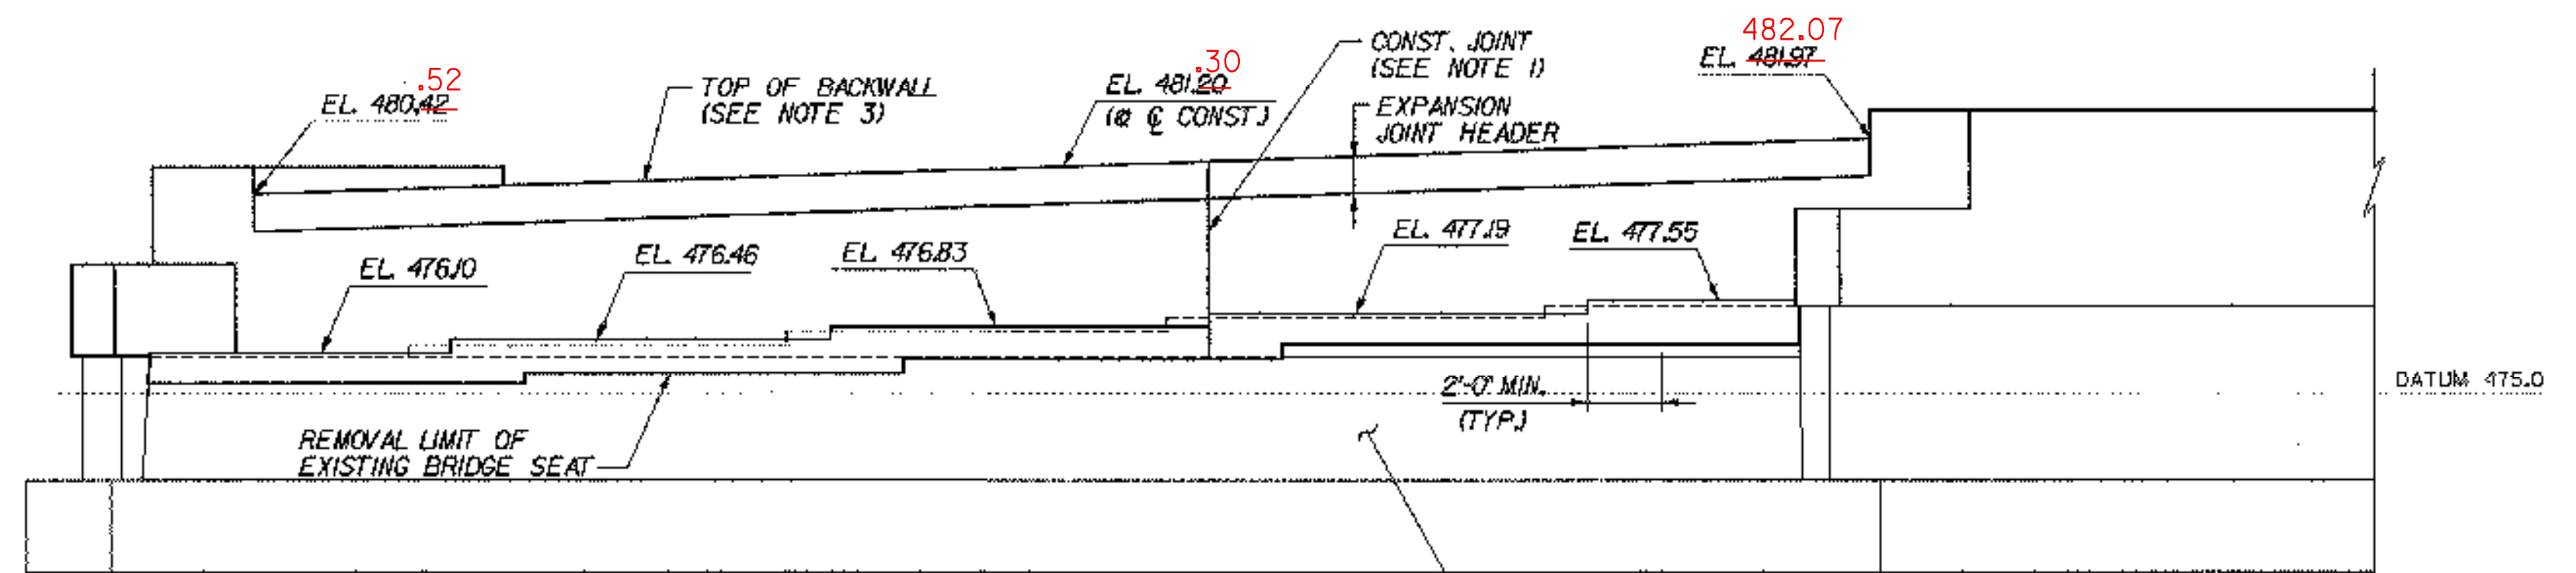

**ABUTMENT 2 ELEVATION**  
SCALE: 1/4"=1'-0"

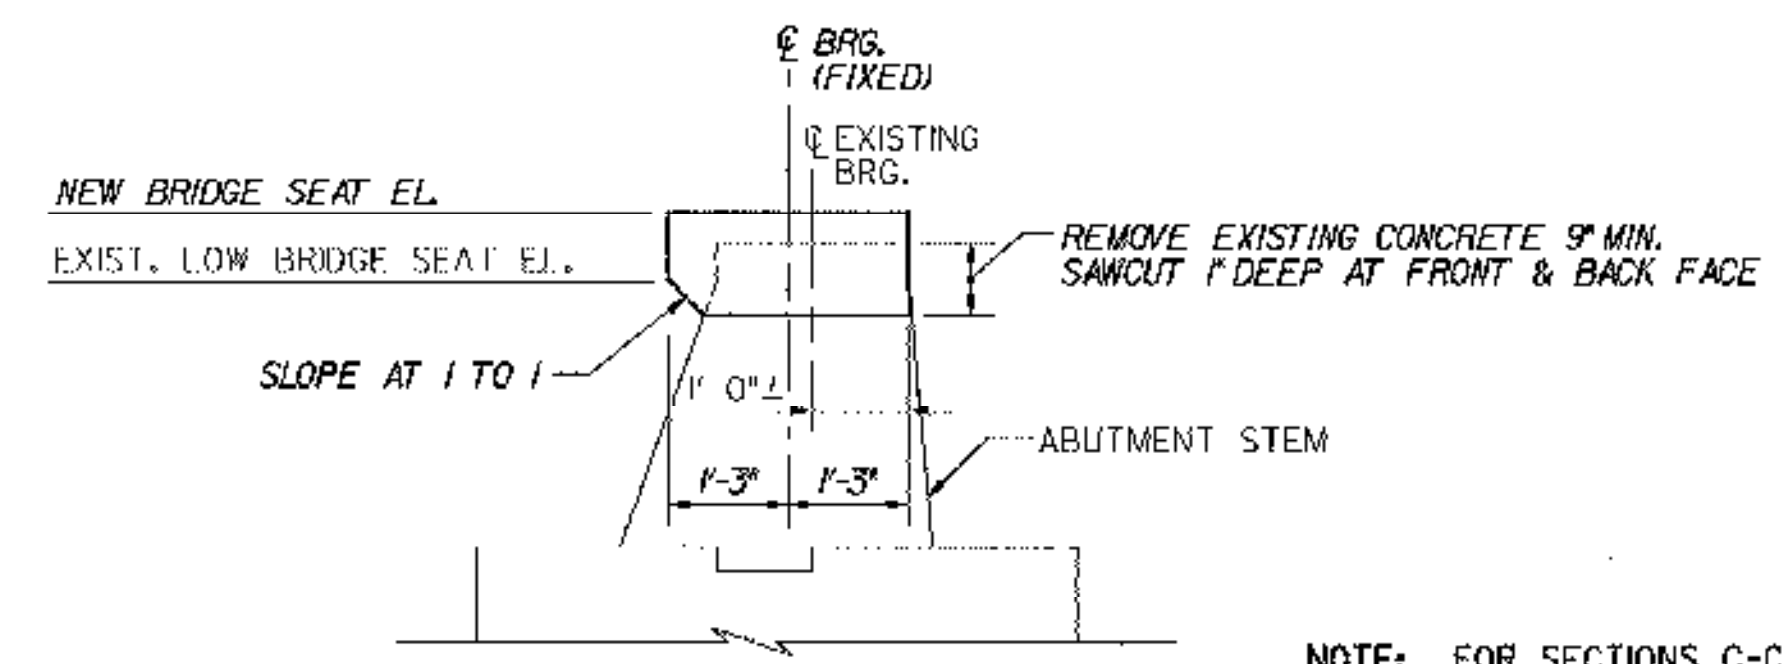

**SECTION A-A**  
SCALE: 1/2"=1'-0"

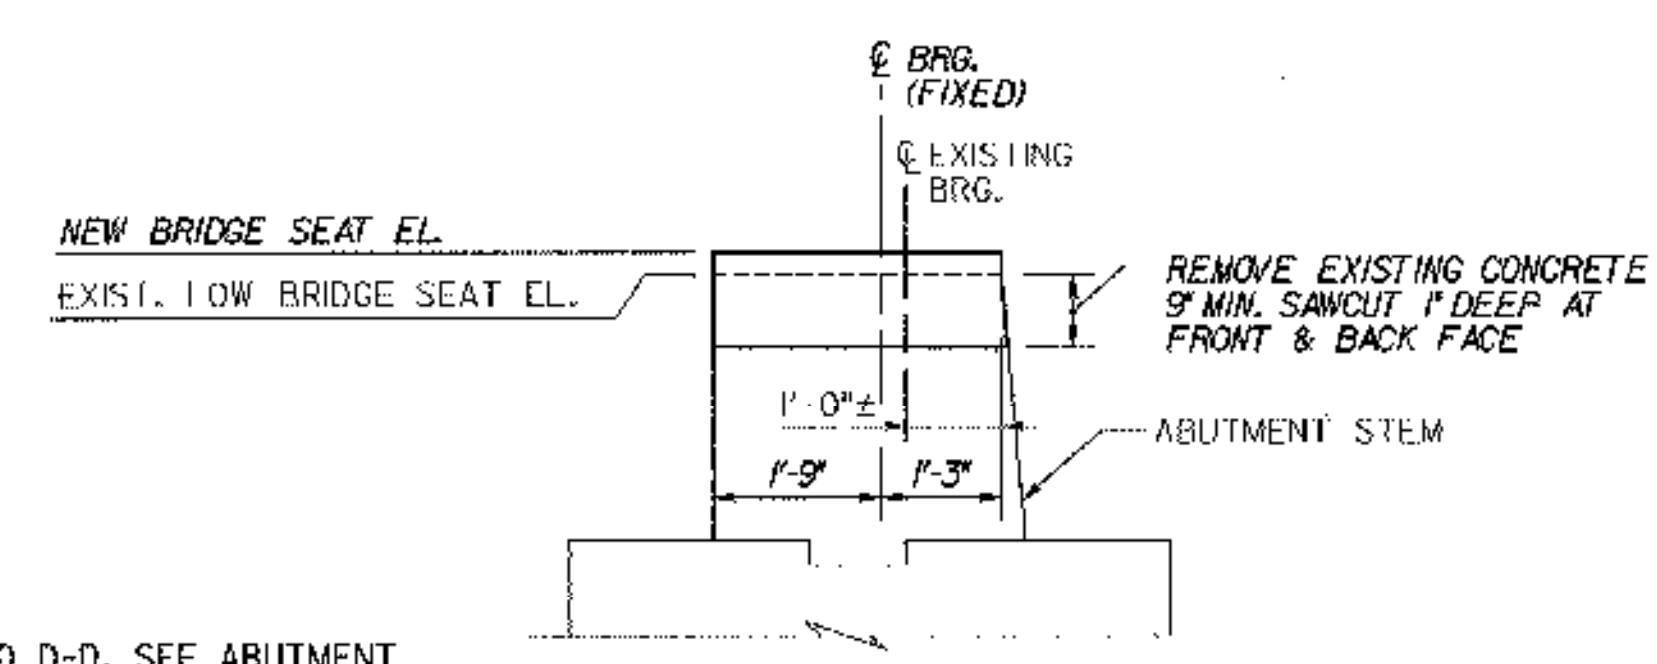

**SECTION B-B**  
SCALE: 1/2"=1'-0"


NOTE: FOR SECTIONS C-C AND D-D, SEE ABUTMENT MASONRY (50S), BRIDGE SHEET BR50-12.

**NOTES:**


- CONSTRUCTION JOINT LOCATED AT STEP IN BRIDGE SEAT. LOCATION SHALL BE REVISED AS DIRECTED BY THE RESIDENT ENGINEER AS REQUIRED TO MATCH ANY CONSTRUCTION JOINT IN THE EXISTING ABUTMENT STEM.
- FOR WINGWALL AND CHEEKWALL DIMENSIONS, DETAILS AND ELEVATIONS, SEE TYPICAL WINGWALL DETAILS, BRIDGE SHEETS C-43 AND C-44.
- BACKWALL ELEVATIONS SHOWN AT FRONT FACE OF BACKWALL.
- FOR ABUTMENT REINFORCEMENT DETAILS, SEE TYPICAL EXPANSION ABUTMENT REINFORCEMENT, BRIDGE SHEET C-40, AND TYPICAL FIXED ABUTMENT REINFORCEMENT, BRIDGE SHEET C-41.
- STEPS IN BRIDGE SEATS SHALL BE EQUIDISTANT BETWEEN STRINGERS.
- REPAIR ALL EXISTING SPALLED AND DELAMINATED AREAS ON ABUTMENT. SEE EXISTING SUBSTRUCTURE CONDITION, BRIDGE SHEETS SC-13 THROUGH SC-16 FOR APPROXIMATE CONDITION OF EXISTING SUBSTRUCTURES. FOR CONCRETE REPAIR DETAILS, SEE SUBSTRUCTURE REPAIR DETAILS AND NOTES, BRIDGE SHEET C-45.

<b>STATE OF VERMONT AGENCY OF TRANSPORTATION</b>	
Town Of <b>MIDDLESEX-BOLTON</b>	Bridge No. <b>50N</b>
Highway No. <b>I-89</b>	Log Sta. <b></b>
<b>1-89 NB OVER U.S. ROUTE 2</b>	
<b>ABUTMENT MASONRY (50N)</b>	
Designed By <b>P.W. SZUSTAK</b>	Drawn By <b>R.A. BOTZENHART</b>
Checked By <b>J.P. HALSTEAD</b>	Bridge Design Supervisor <b>J.P. HALSTEAD</b>
Date <b>10/99</b>	Date <b>10/99</b>
PROJECT <b>MIDDLESEX-BOLTON</b>	PROJECT NO. <b>1M-089-2(26)</b>
TVGA CAD Drawing No. <b>50cbmas</b>	Date <b>10/99</b>
Bridge Sheet No. <b>BR50-11</b>	Sheet <b>95</b> of <b>307</b>


NOTE: RAISED FINISHED GRADE OF BRIDGE 50S 0.04'

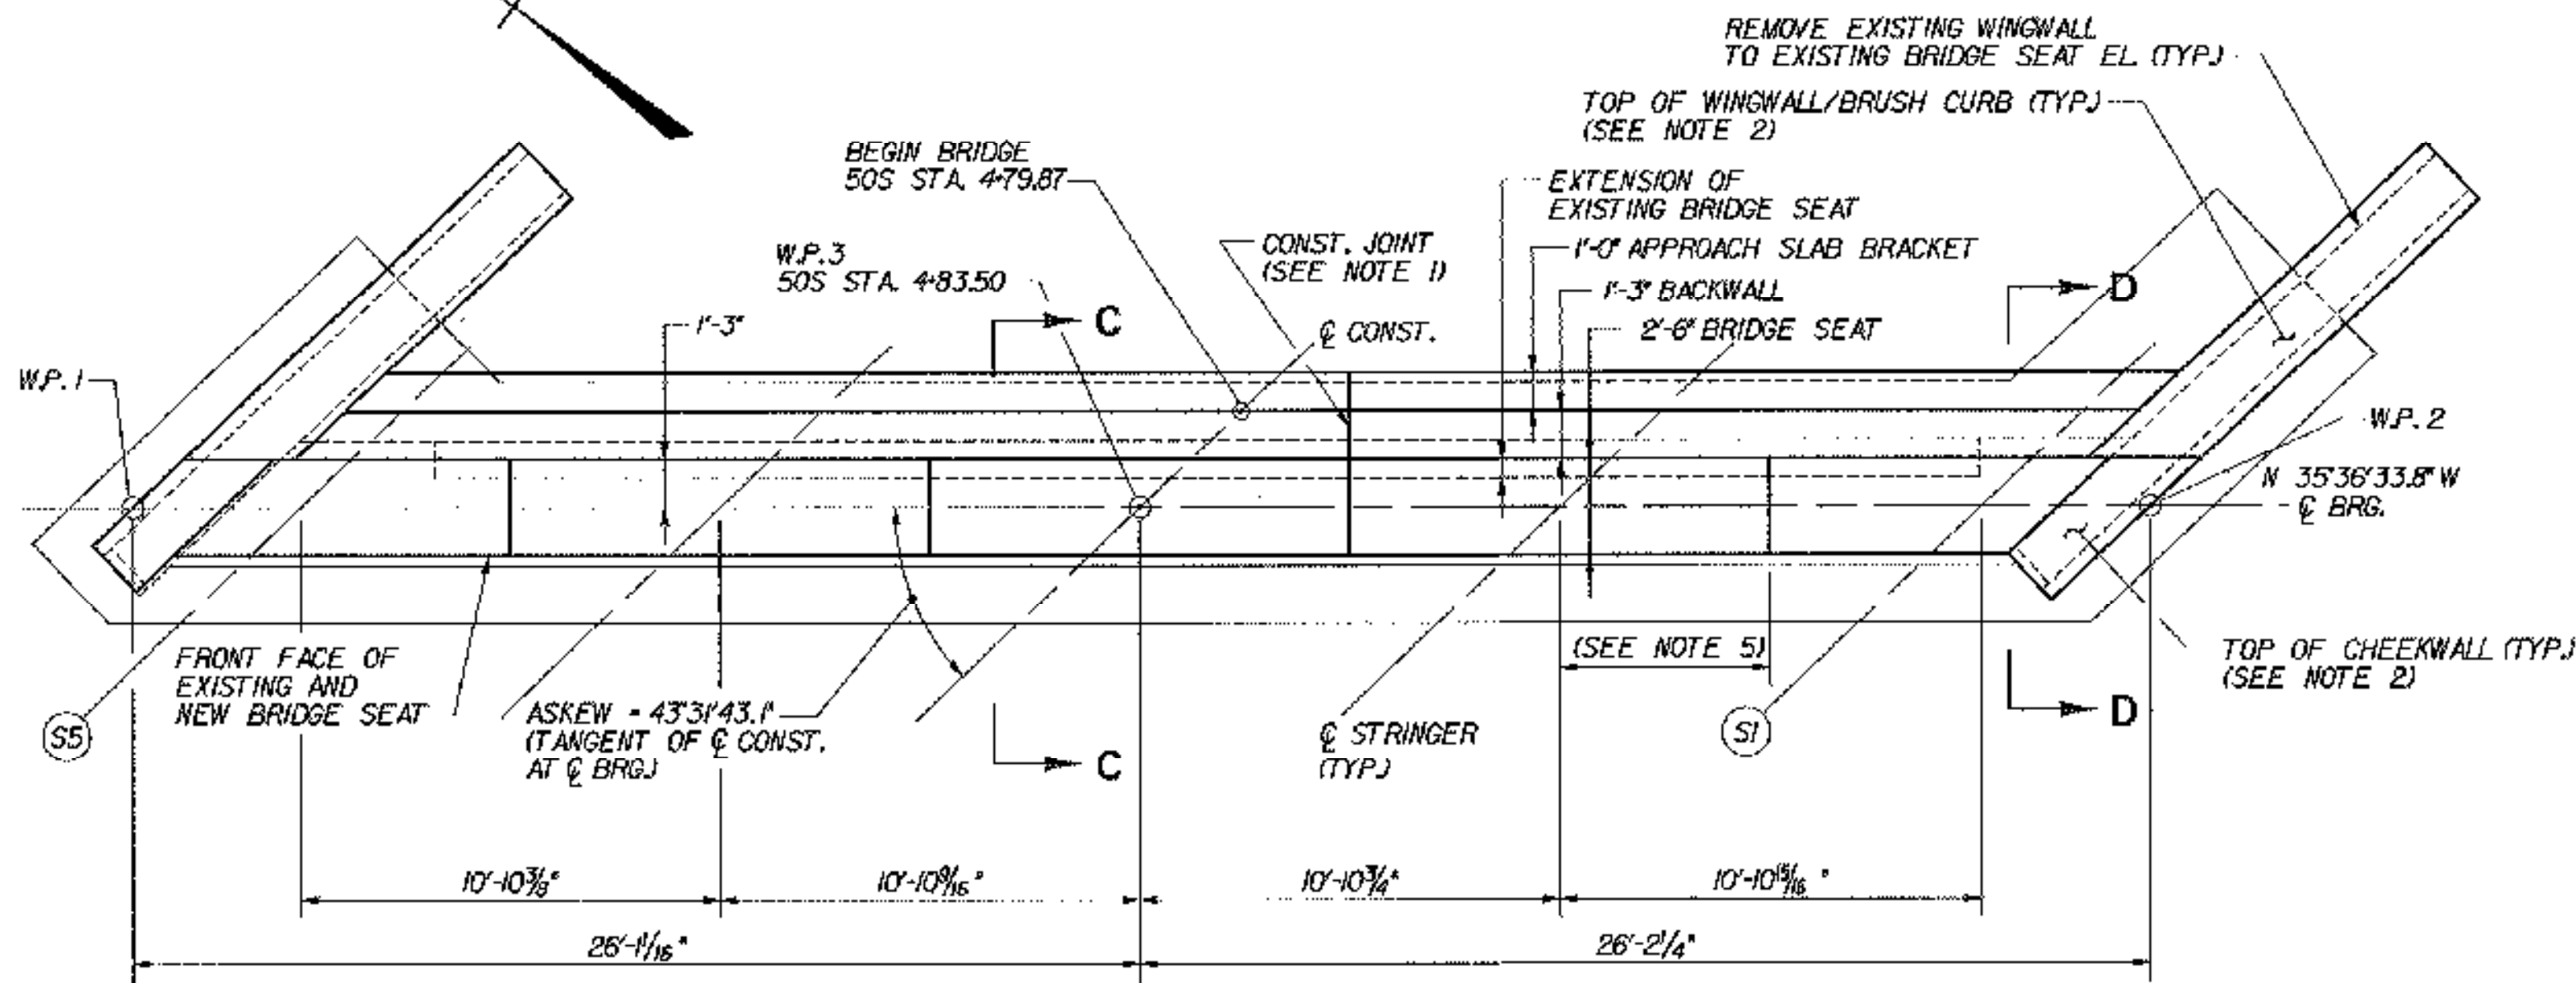


**ABUTMENT 1 PLAN (EXP.)**  
SCALE: 1/4"=1'-0"

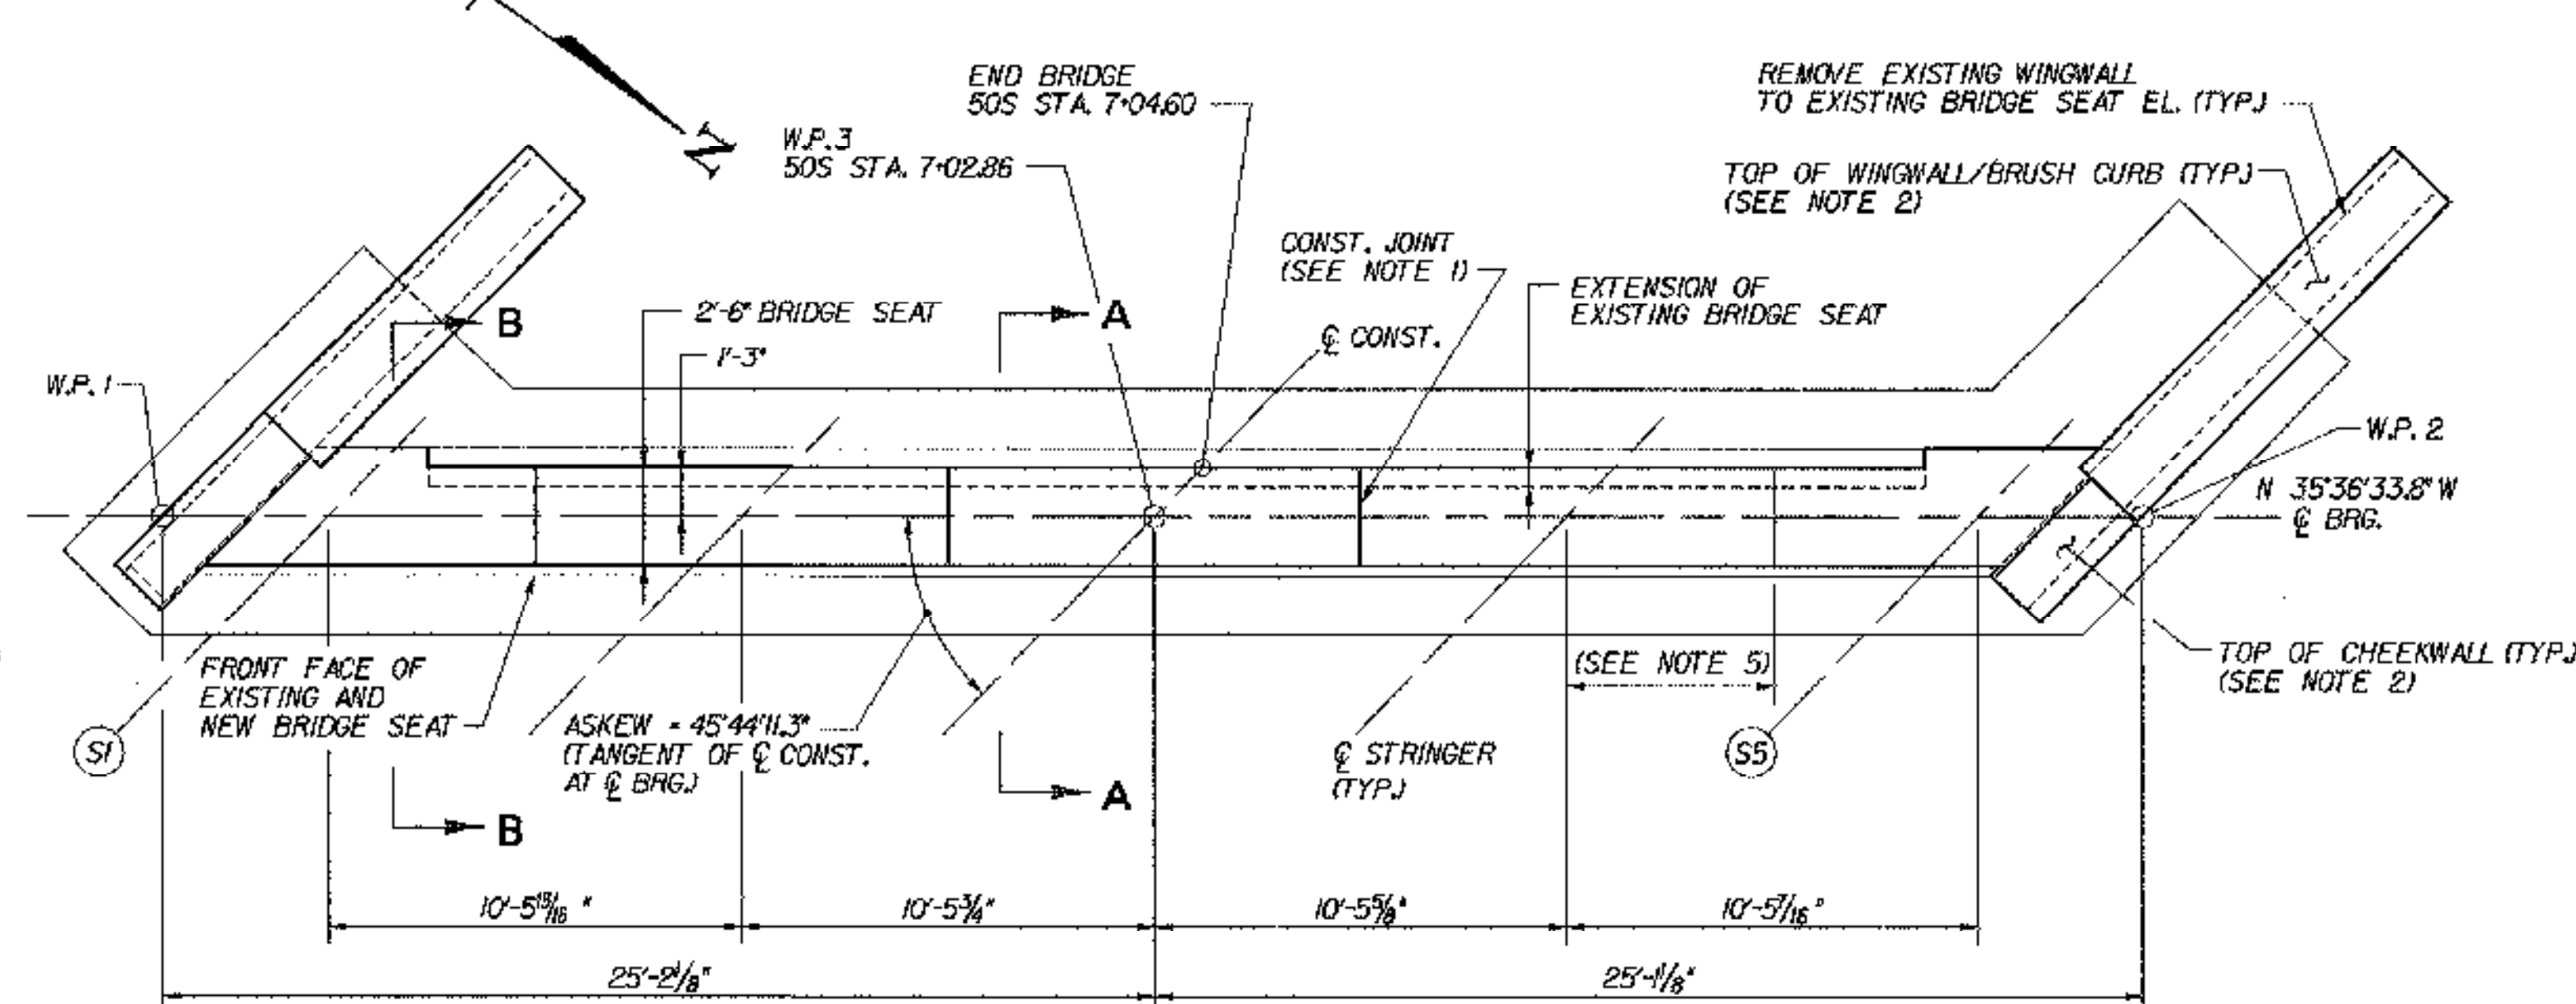


**ABUTMENT 2 PLAN (FIXED)**  
SCALE: 1/4"=1'-0"

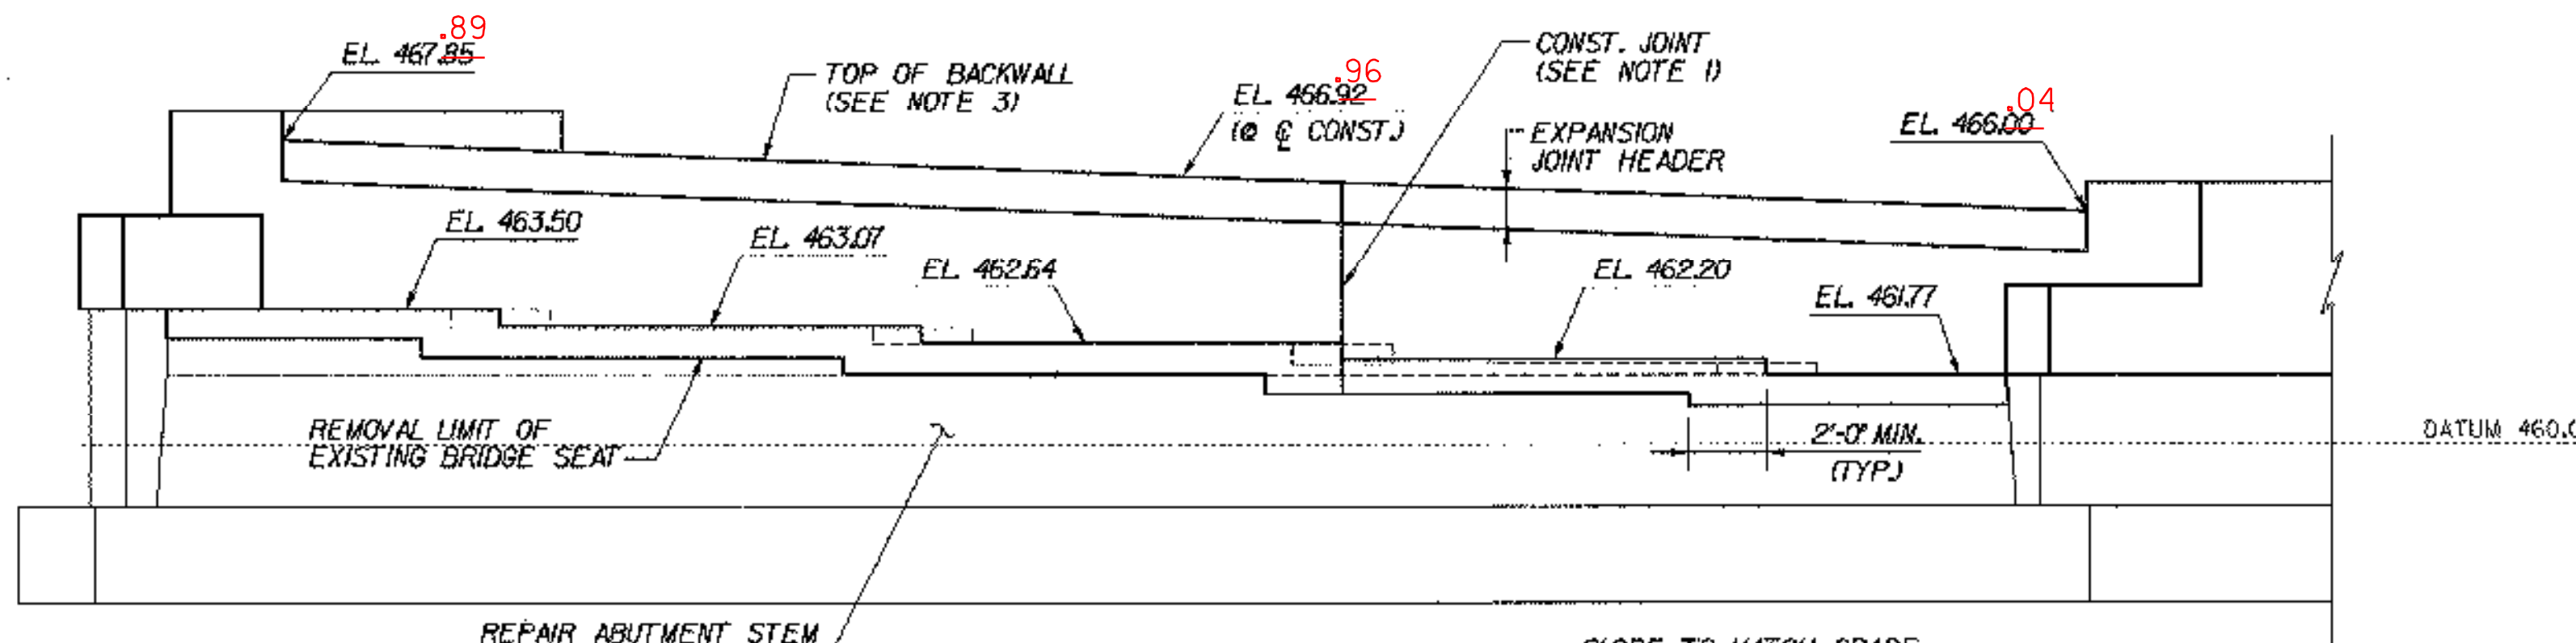


**ABUTMENT 1 ELEVATION**  
SCALE: 1/4"=1'-0"

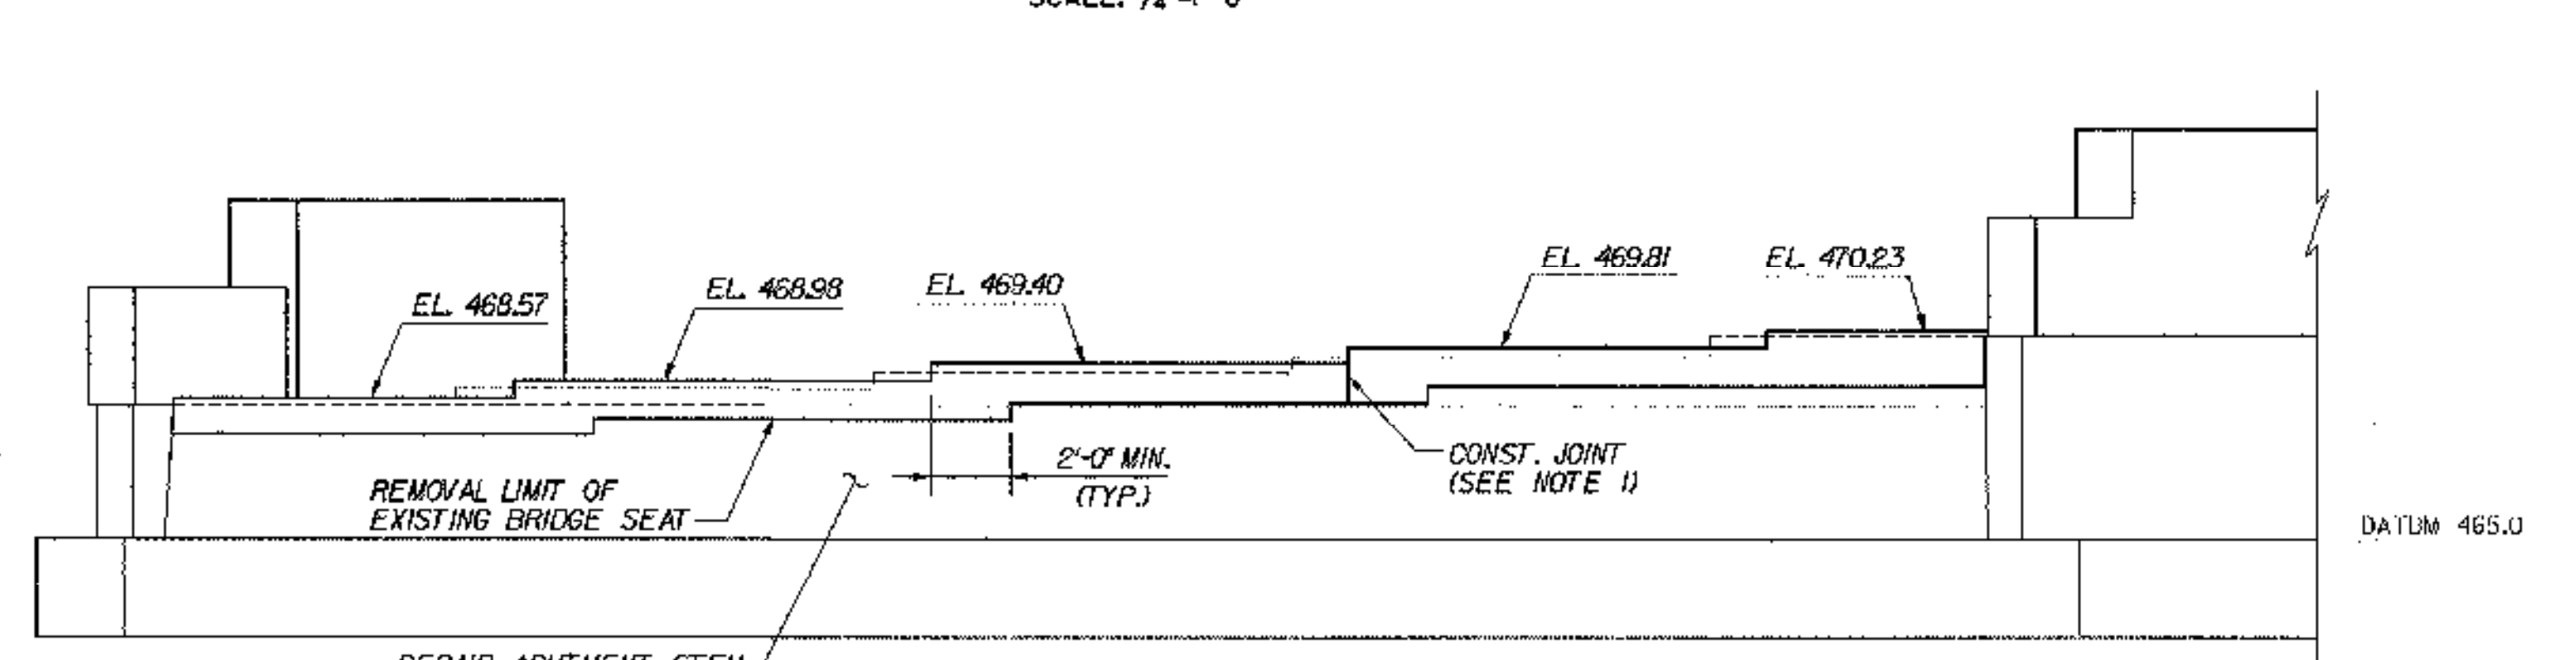

**ABUTMENT 2 ELEVATION**  
SCALE: 1/4"=1'-0"

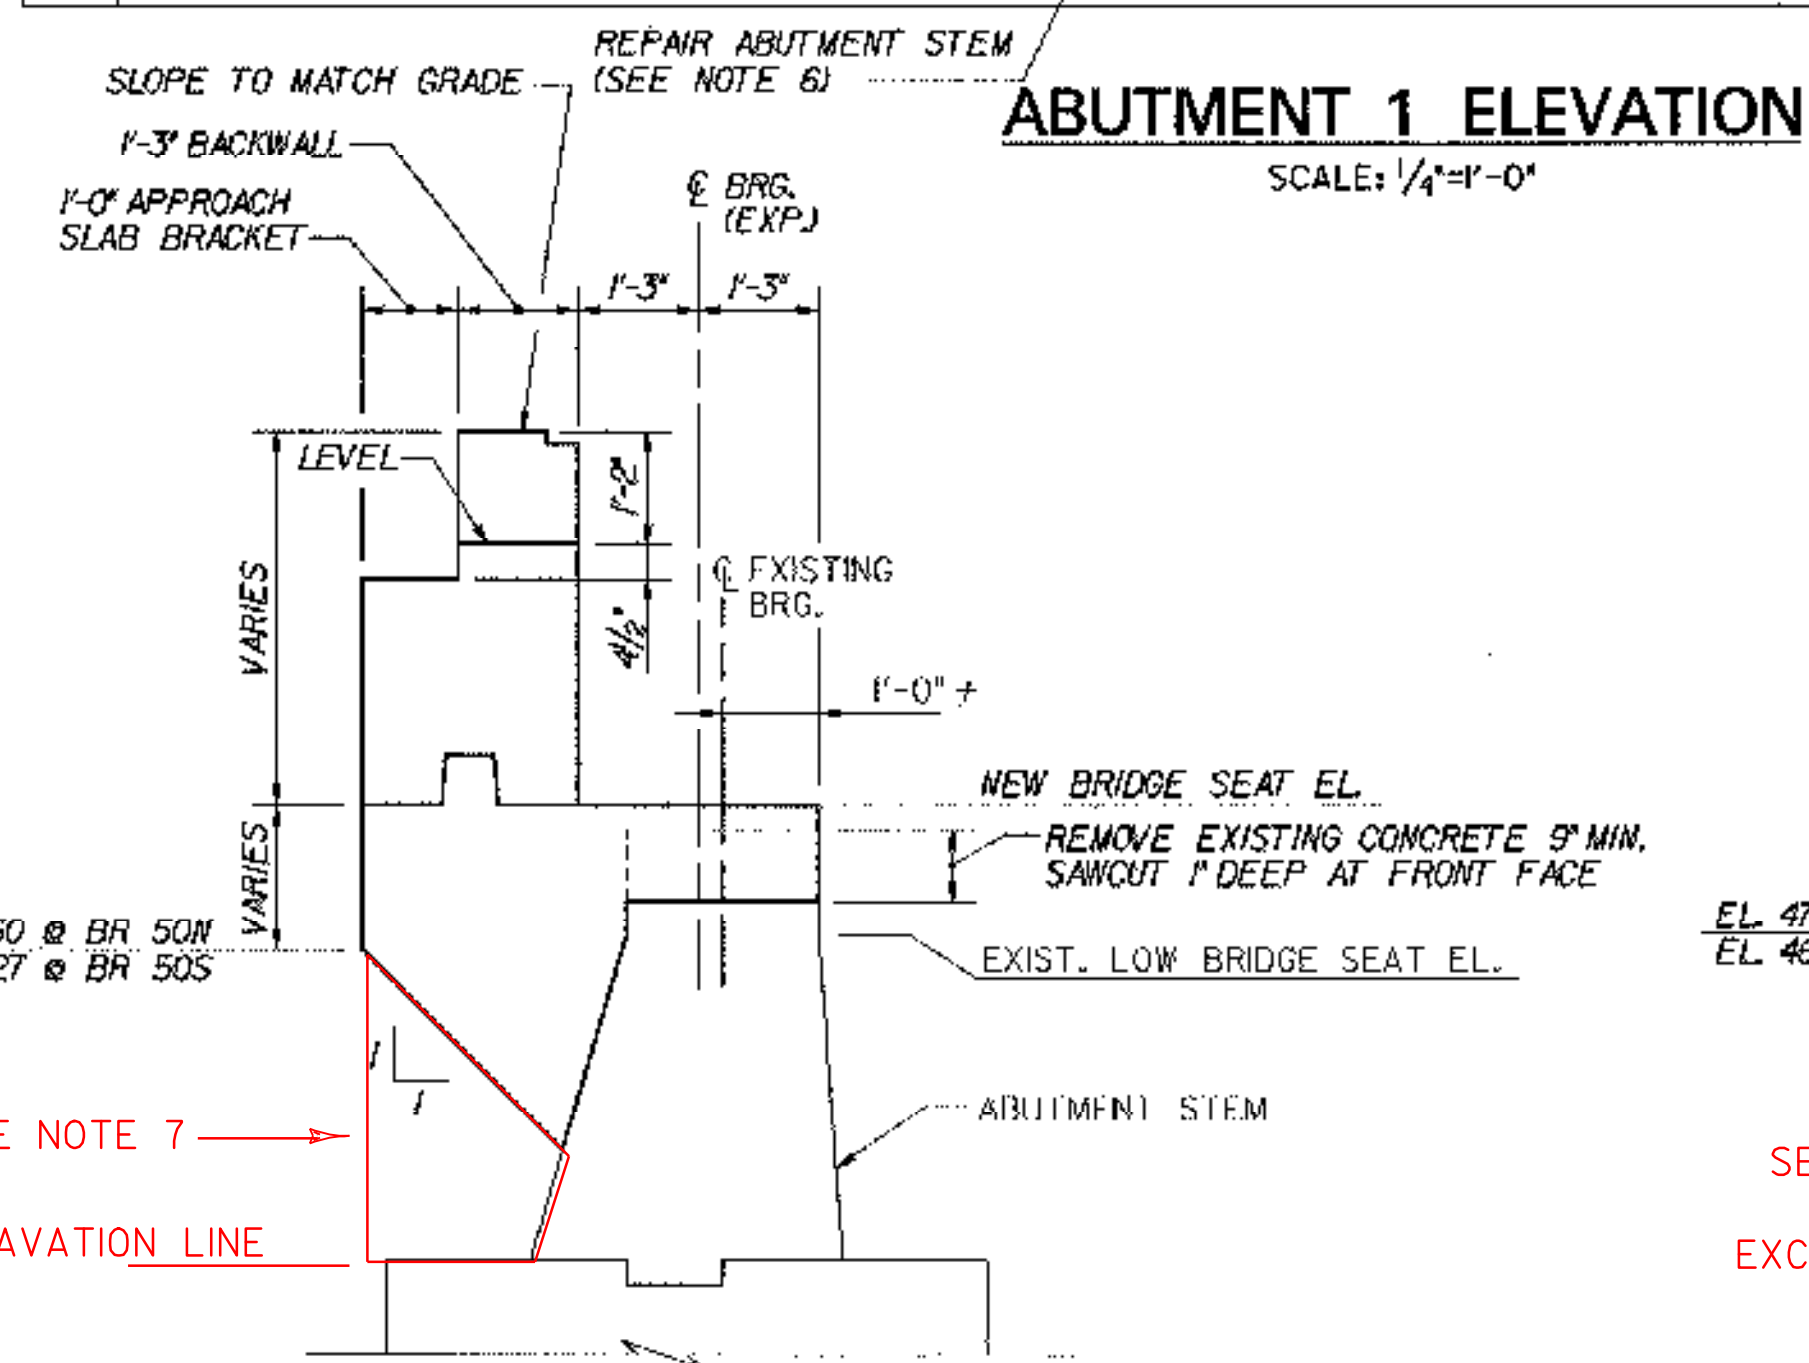

**SECTION C-C**  
SCALE: 1/2"=1'-0"

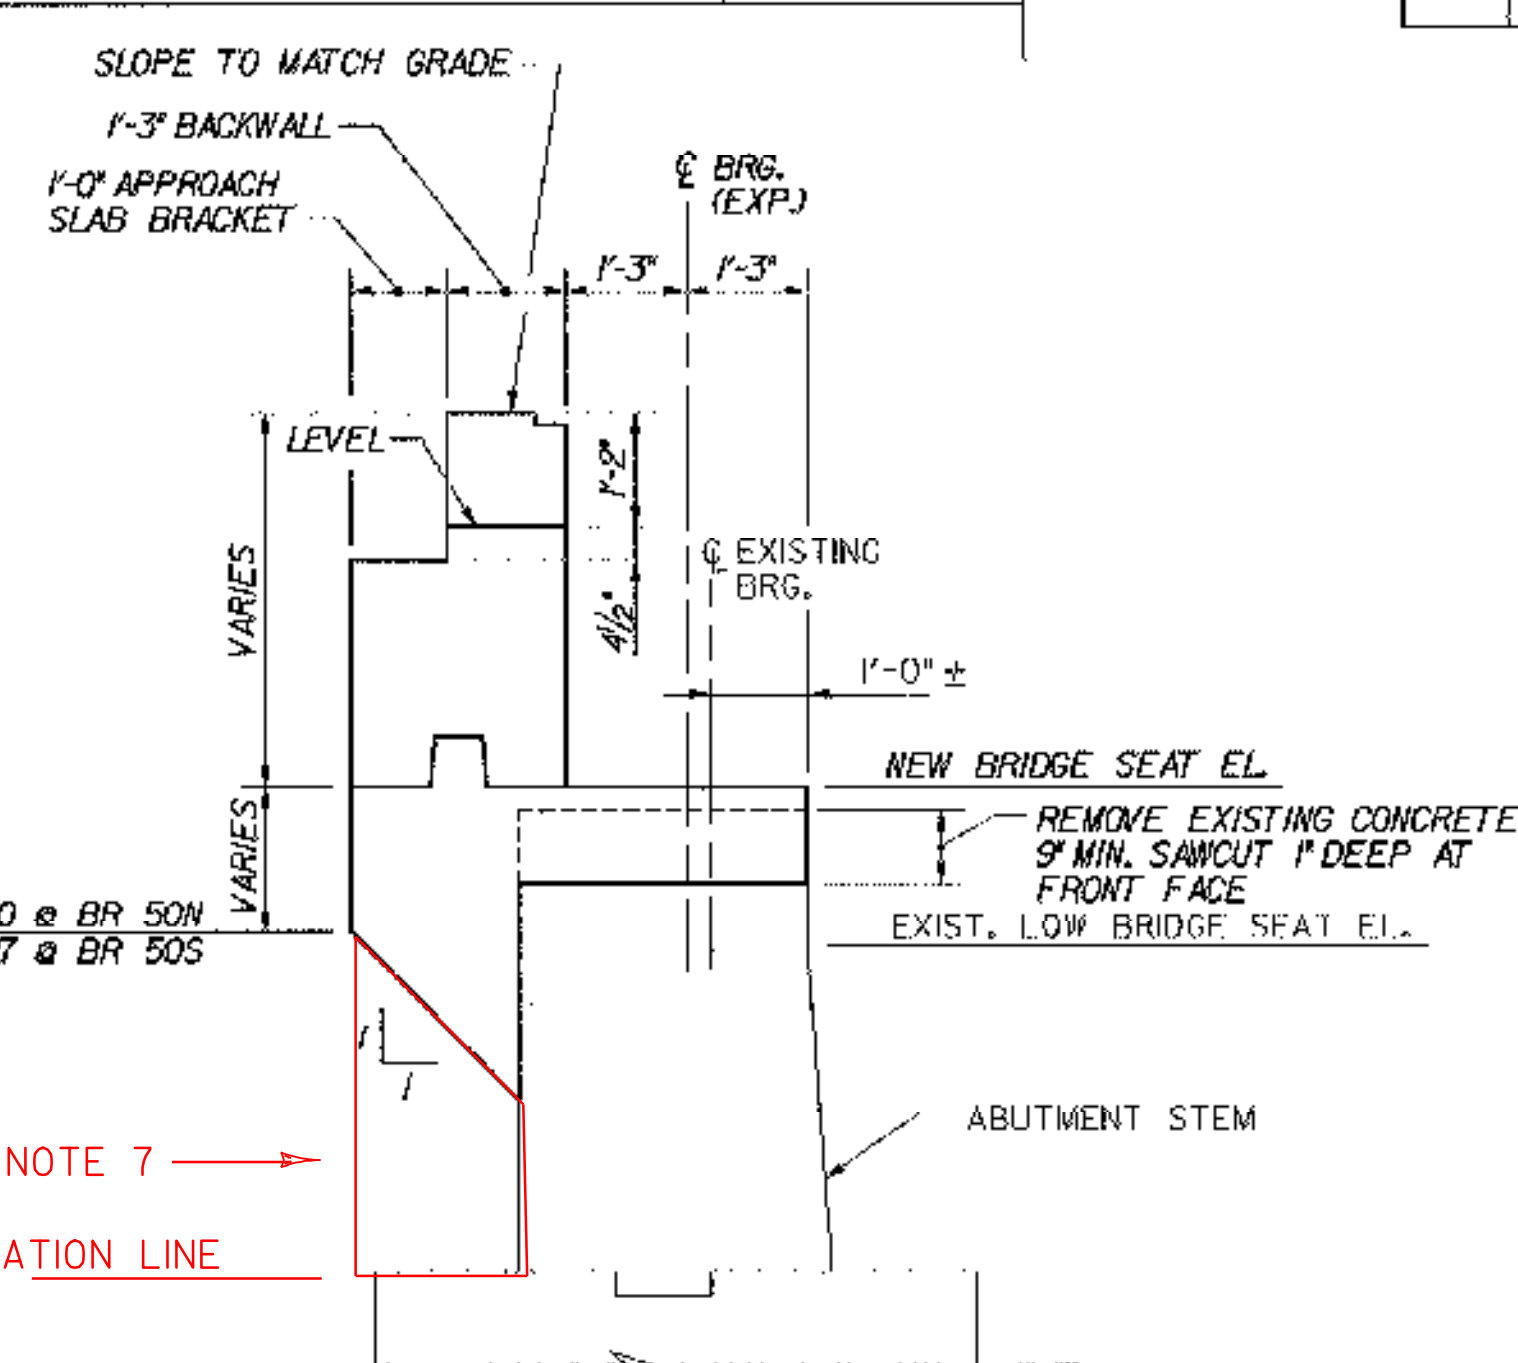

**SECTION D-D**  
SCALE: 1/2"=1'-0"

NOTE: FOR SECTIONS A-A AND B-B, SEE ABUTMENT MASONRY (50N), BRIDGE SHEET BR50-11.


7. APPLIES TO BRIDGE 50N AND S. THE CONTRACTOR FOR EASE OF FORMING FORMED THE BACK OF THE EXPANSION ABUTMENT STRAIGHT DOWN TO THE BOTTOM OF THE EXCAVATION. THEY INSTALLED EXTRA REBAR IN THE AREA. ALL MATERIALS AND LABOR WAS AT THE EXPENSE OF THE CONTRACTOR

**NOTES:**


1. CONSTRUCTION JOINT LOCATED AT STEP IN BRIDGE SEAT. LOCATION SHALL BE REVISED AS DIRECTED BY THE RESIDENT ENGINEER AS REQUIRED TO MATCH ANY CONSTRUCTION JOINT IN THE EXISTING ABUTMENT STEM.
2. FOR WINGWALL AND CHEEKWALL DIMENSIONS, DETAILS AND ELEVATIONS, SEE TYPICAL WINGWALL DETAILS, BRIDGE SHEETS C-43 AND C-44.
3. BACKWALL ELEVATIONS SHOWN AT FRONT FACE OF BACKWALL.
4. FOR ABUTMENT REINFORCEMENT DETAILS, SEE TYPICAL EXPANSION ABUTMENT REINFORCEMENT, BRIDGE SHEET C-40, AND TYPICAL FIXED ABUTMENT REINFORCEMENT, BRIDGE SHEET C-41.
5. STEPS IN BRIDGE SEATS SHALL BE EQUIDISTANT BETWEEN STRINGERS.
6. REPAIR ALL EXISTING SPALLED AND DELAMINATED AREAS ON ABUTMENT. SEE EXISTING SUBSTRUCTURE CONDITION, BRIDGE SHEETS SC-13 THROUGH SC-16 FOR APPROXIMATE CONDITION OF EXISTING SUBSTRUCTURES. FOR CONCRETE REPAIR DETAILS, SEE SUBSTRUCTURE REPAIR DETAILS AND NOTES, BRIDGE SHEET C-45.

**STATE OF VERMONT  
AGENCY OF TRANSPORTATION**


Town Of	MIDDLESEX-BOLTON	Bridge No.	50S
Highway No.	I-89	Log Sta.	
		Surv. Sta.	
I-89 SB OVER U.S. ROUTE 2			
<b>ABUTMENT MASONRY (50S)</b>			
Designed By	P.W. SZUSTAK	Drawn By	R.A. BOTZENHART
Checked By	Date	Bridge Design Supervisor	
J.P. HALSTEAD	10/99	J.P. HALSTEAD	Date 10/99
PROJECT	MIDDLESEX-BOLTON	PROJECT NO.	IM-089-2(26)
TVGA CAD Drawing No.	50cbmas	Date	10/99
Bridge Sheet No.	BR50-12	Sheet	96 of 307

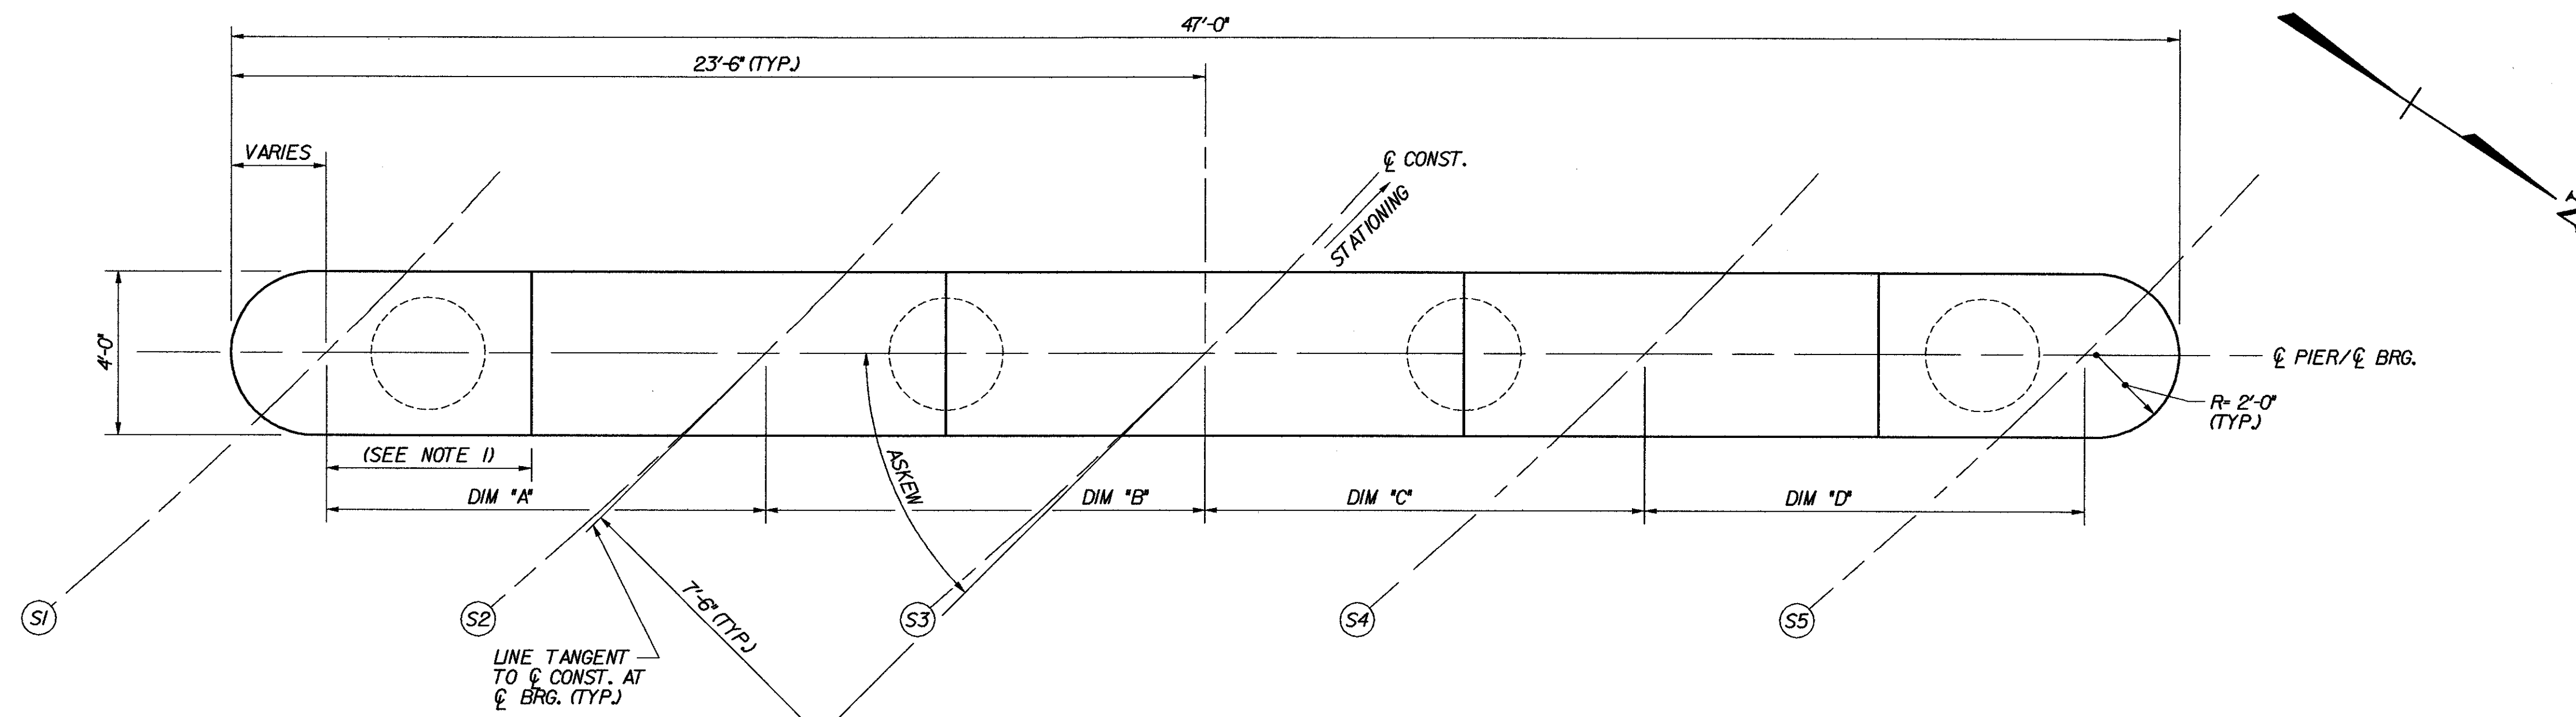


**TYPICAL PIER CAP PLAN**  
SCALE: 3/8"=1'-0"

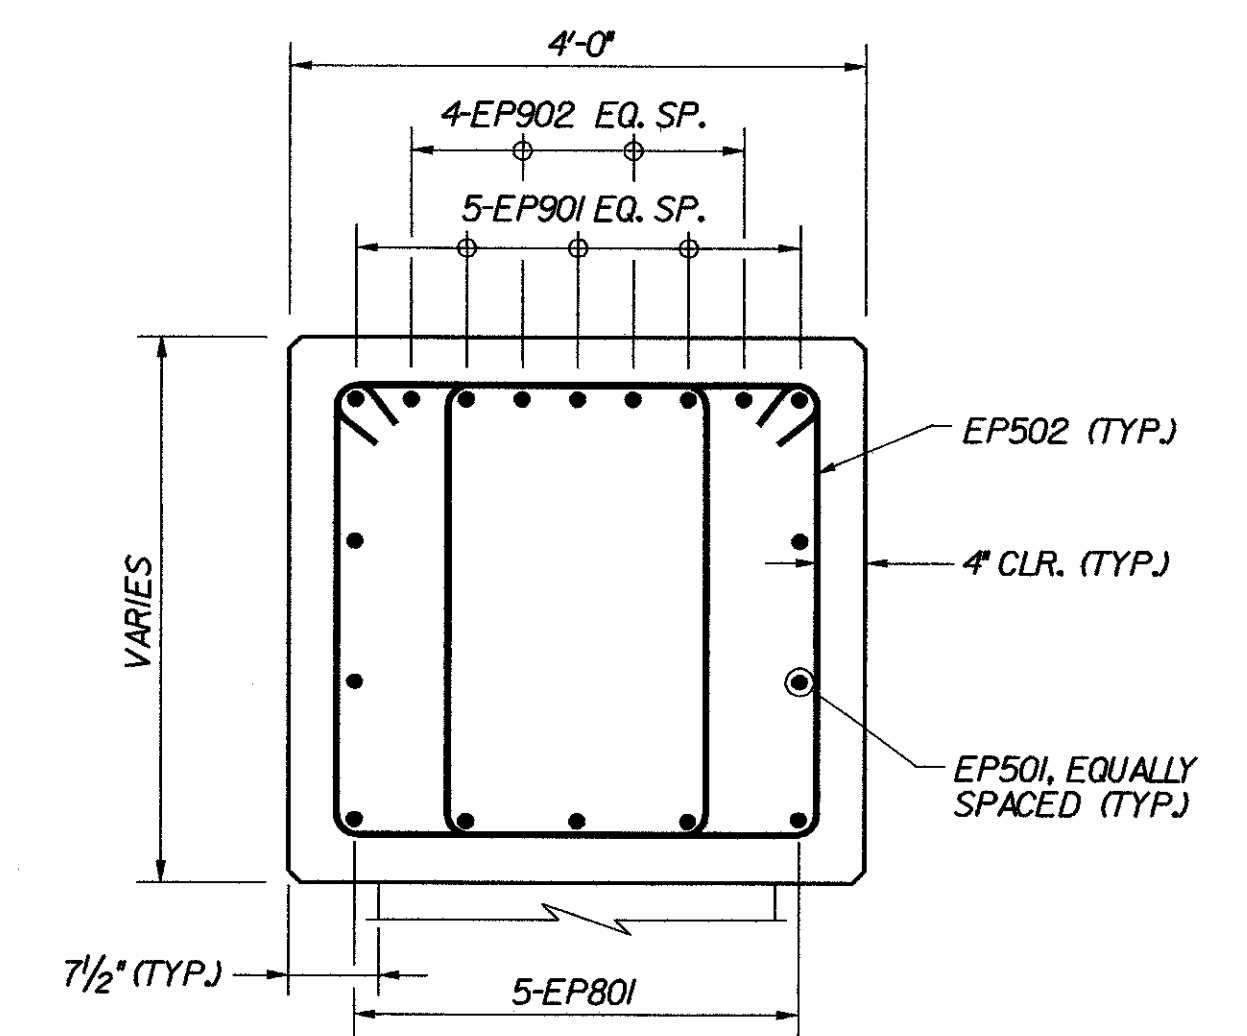

**SECTION A-A**  
SCALE: 3/4"=1'-0"

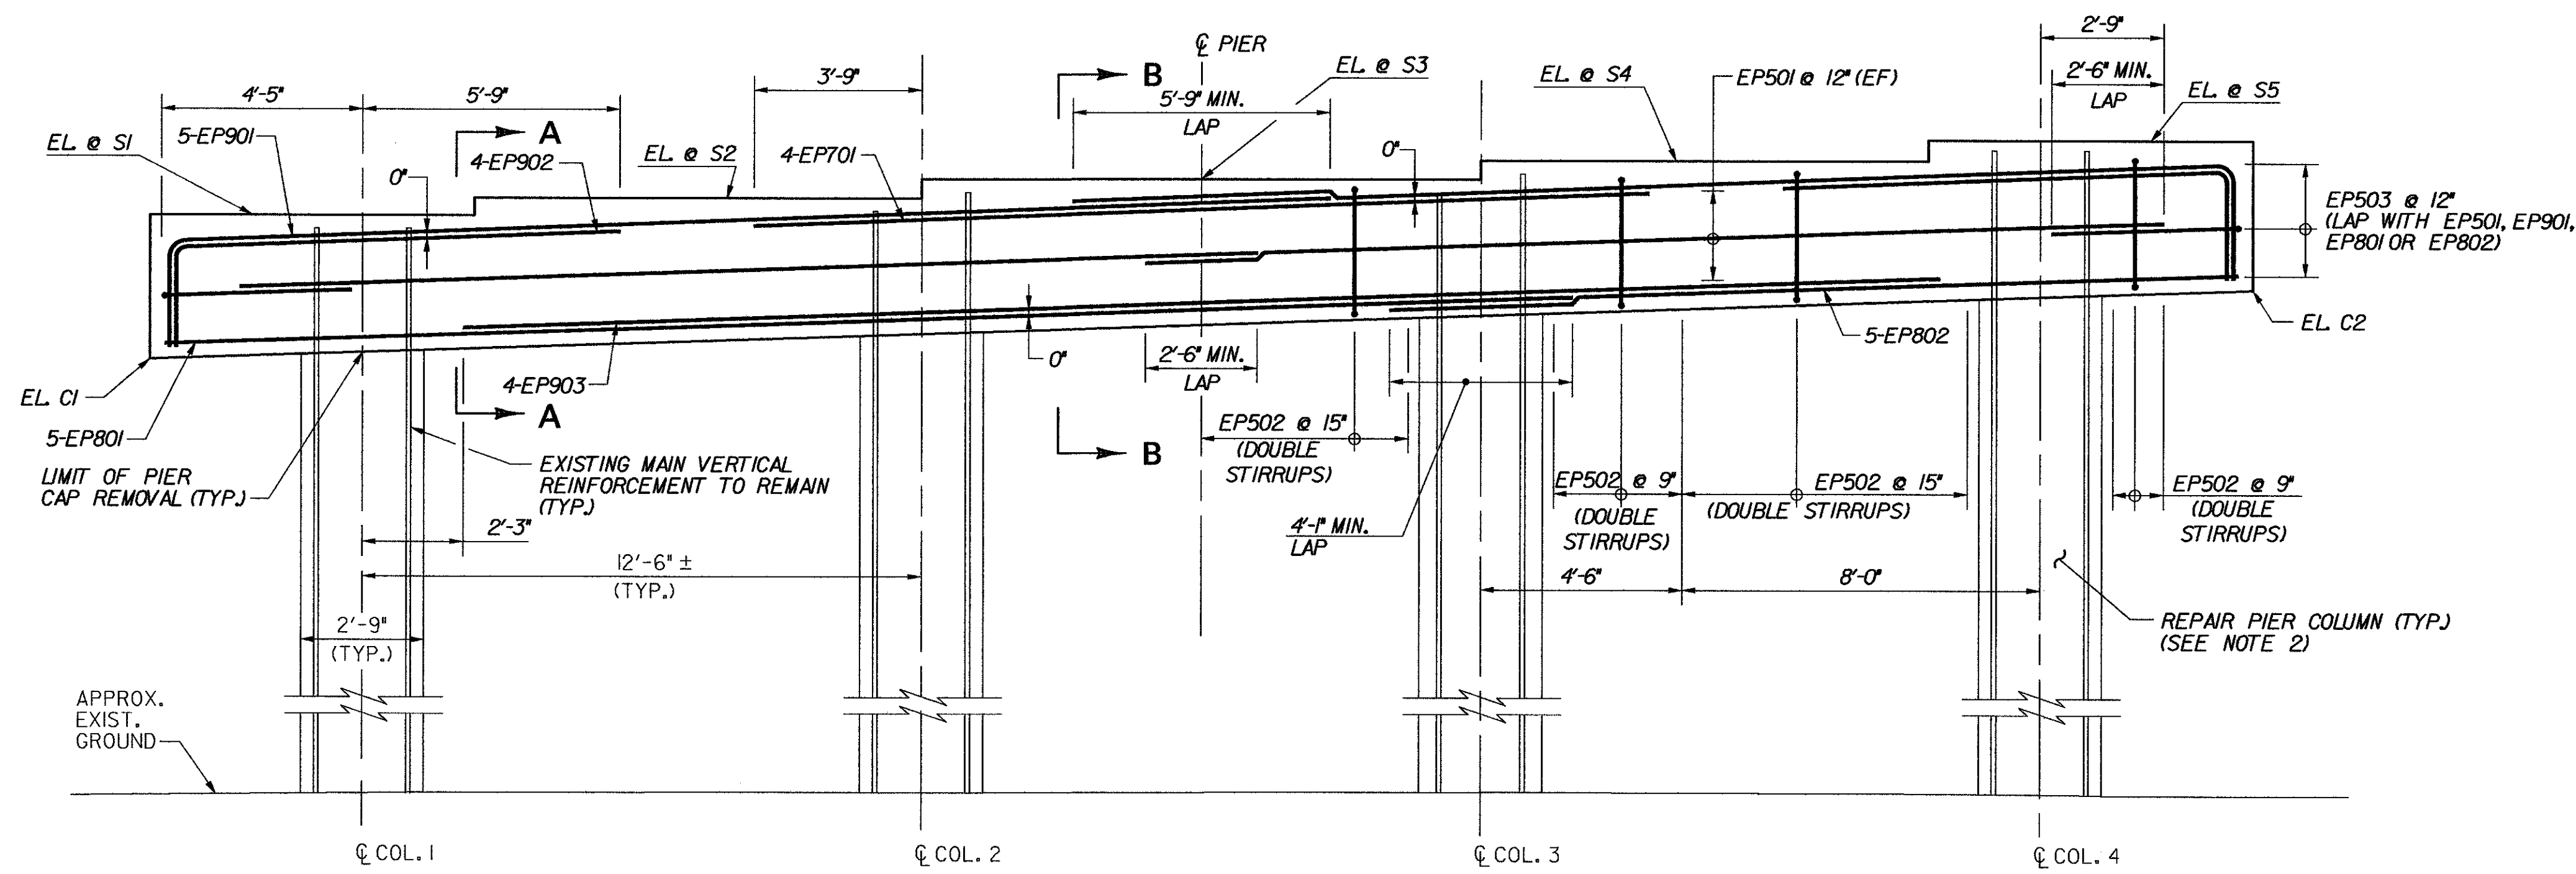

**TYPICAL PIER ELEVATION**  
SCALE: 3/8"=1'-0"

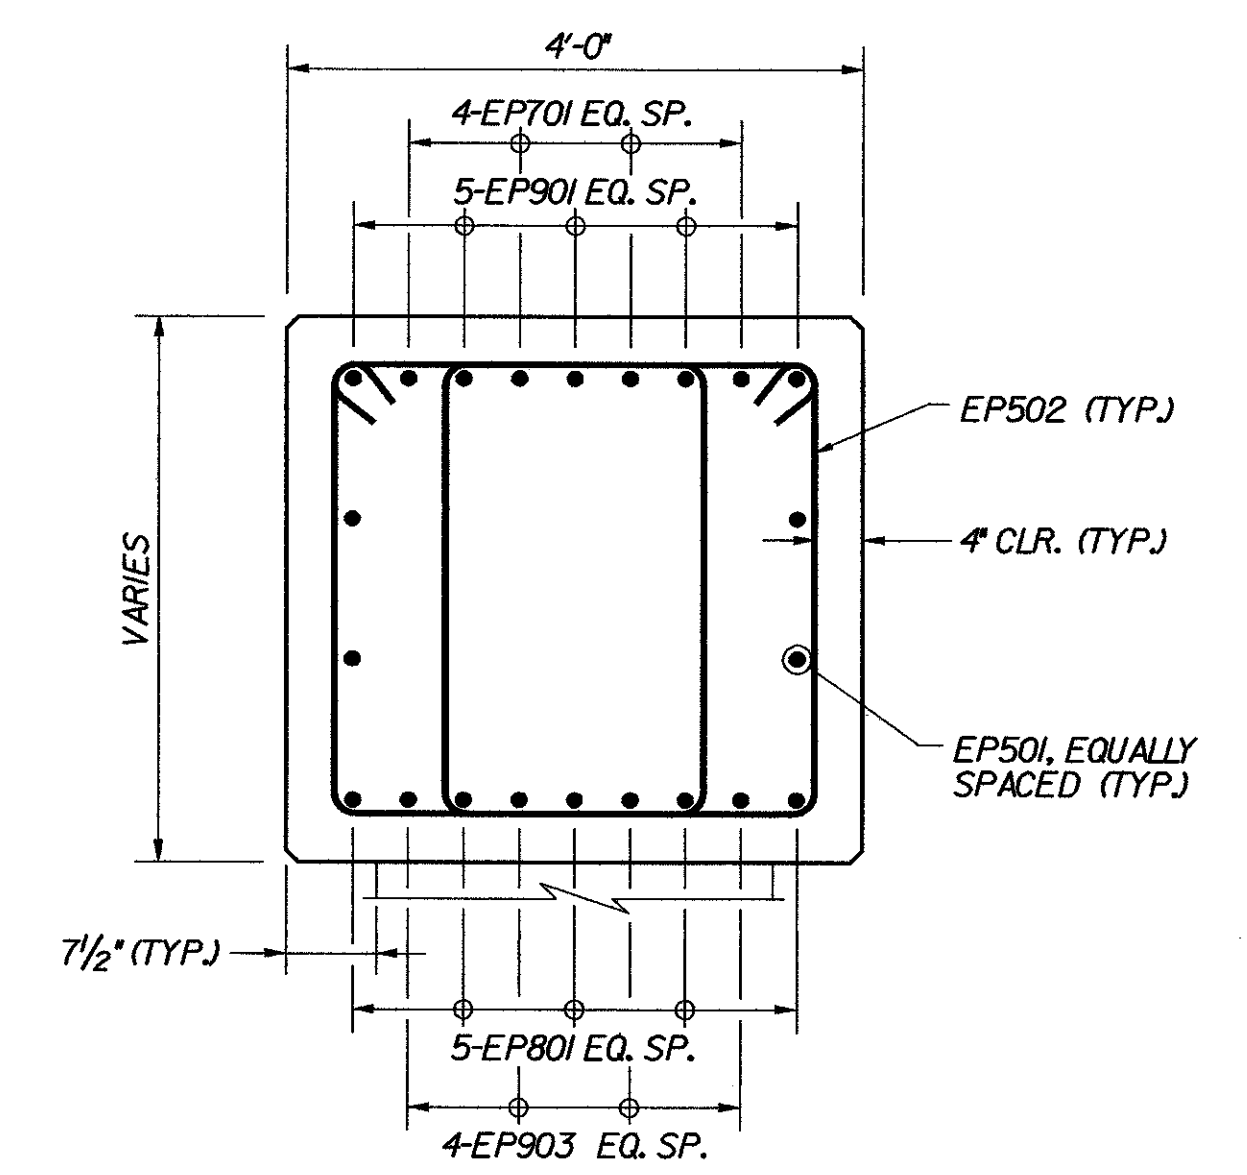

**SECTION B-B**  
SCALE: 3/4"=1'-0"

- NOTES:**
- STEPS ON PIER CAP SEAT SHALL BE EQUIDISTANT BETWEEN STRINGERS.
  - REPAIR ALL EXISTING SPALLED AND DELAMINATED AREAS ON PIER. SEE EXISTING SUBSTRUCTURE CONDITION, BRIDGE SHEETS SC-13 THROUGH SC-16 FOR APPROXIMATE CONDITION OF EXISTING SUBSTRUCTURES. FOR CONCRETE REPAIR DETAILS, SEE SUBSTRUCTURE REPAIR DETAILS AND NOTES, BRIDGE SHEET C-45.


BRIDGE	PIER	STA.	ASKEW ANGLE	CL BRG. DIRECTION	DIM. "A"	DIM. "B"	DIM. "C"	DIM. "D"	PIER SEAT ELEVATIONS					BOTTOM OF PIER CAP ELEVATIONS	
									S1	S2	S3	S4	S5	C1	C2
50N	1	6+32.21	44°50'40.0"	N 35°43'28.2" W	10'-7 7/8"	10'-7 11/16"	10'-7 9/16"	10'-7 3/8"	472.16	472.54	472.91	473.29	473.66	468.65	470.01
	2	7+28.71	45°48'11.7"	N 35°43'28.2" W	10'-5 3/4"	10'-5 5/8"	10'-5 7/16"	10'-5 5/16"	474.46	474.83	475.20	475.57	475.93	470.70	472.14
50S	1	5+48.86	44°11'11.3"	N 35°36'33.8" W	10'-9 3/8"	10'-9 3/16"	10'-9 1/16"	10'-8 7/8"	463.80	464.23	464.66	465.09	465.52	460.37	461.90
	2	6+39.36	45°05'50.5"	N 35°36'33.8" W	10'-7 5/16"	10'-7 1/8"	10'-7"	10'-6 13/16"	466.55	466.97	467.39	467.81	468.23	462.84	464.52

- KEY**
- NF NEAR FACE
  - FF FAR FACE
  - EF EACH FACE
  - ▲ REINFORCEMENT TO BE CUT TO FIT IN THE FIELD


**STATE OF VERMONT  
AGENCY OF TRANSPORTATION**

Town Of	MIDDLESEX-BOLTON	Bridge No.	<b>50N&amp;S</b>
Highway No.	I-89	Log Sta.	
		Surv. Sta.	
I-89 OVER U.S. ROUTE 2			
<b>PIER CAP MASONRY &amp; REINF. (50N&amp;S)</b>			
Designed By	P.W. SZUSTAK	Drawn By	R.A. BOTZENHART
Checked By	J.P. HALSTEAD	Date	10/99
		Bridge Design Supervisor	J.P. HALSTEAD Date 10/99
PROJECT	MIDDLESEX-BOLTON	PROJECT NO.	IM-089-2(26)
TVGA CAD Drawing No.	50pmas	Date	10/99
Bridge Sheet No.	<b>BR50-13</b>	Sheet	97 of 307




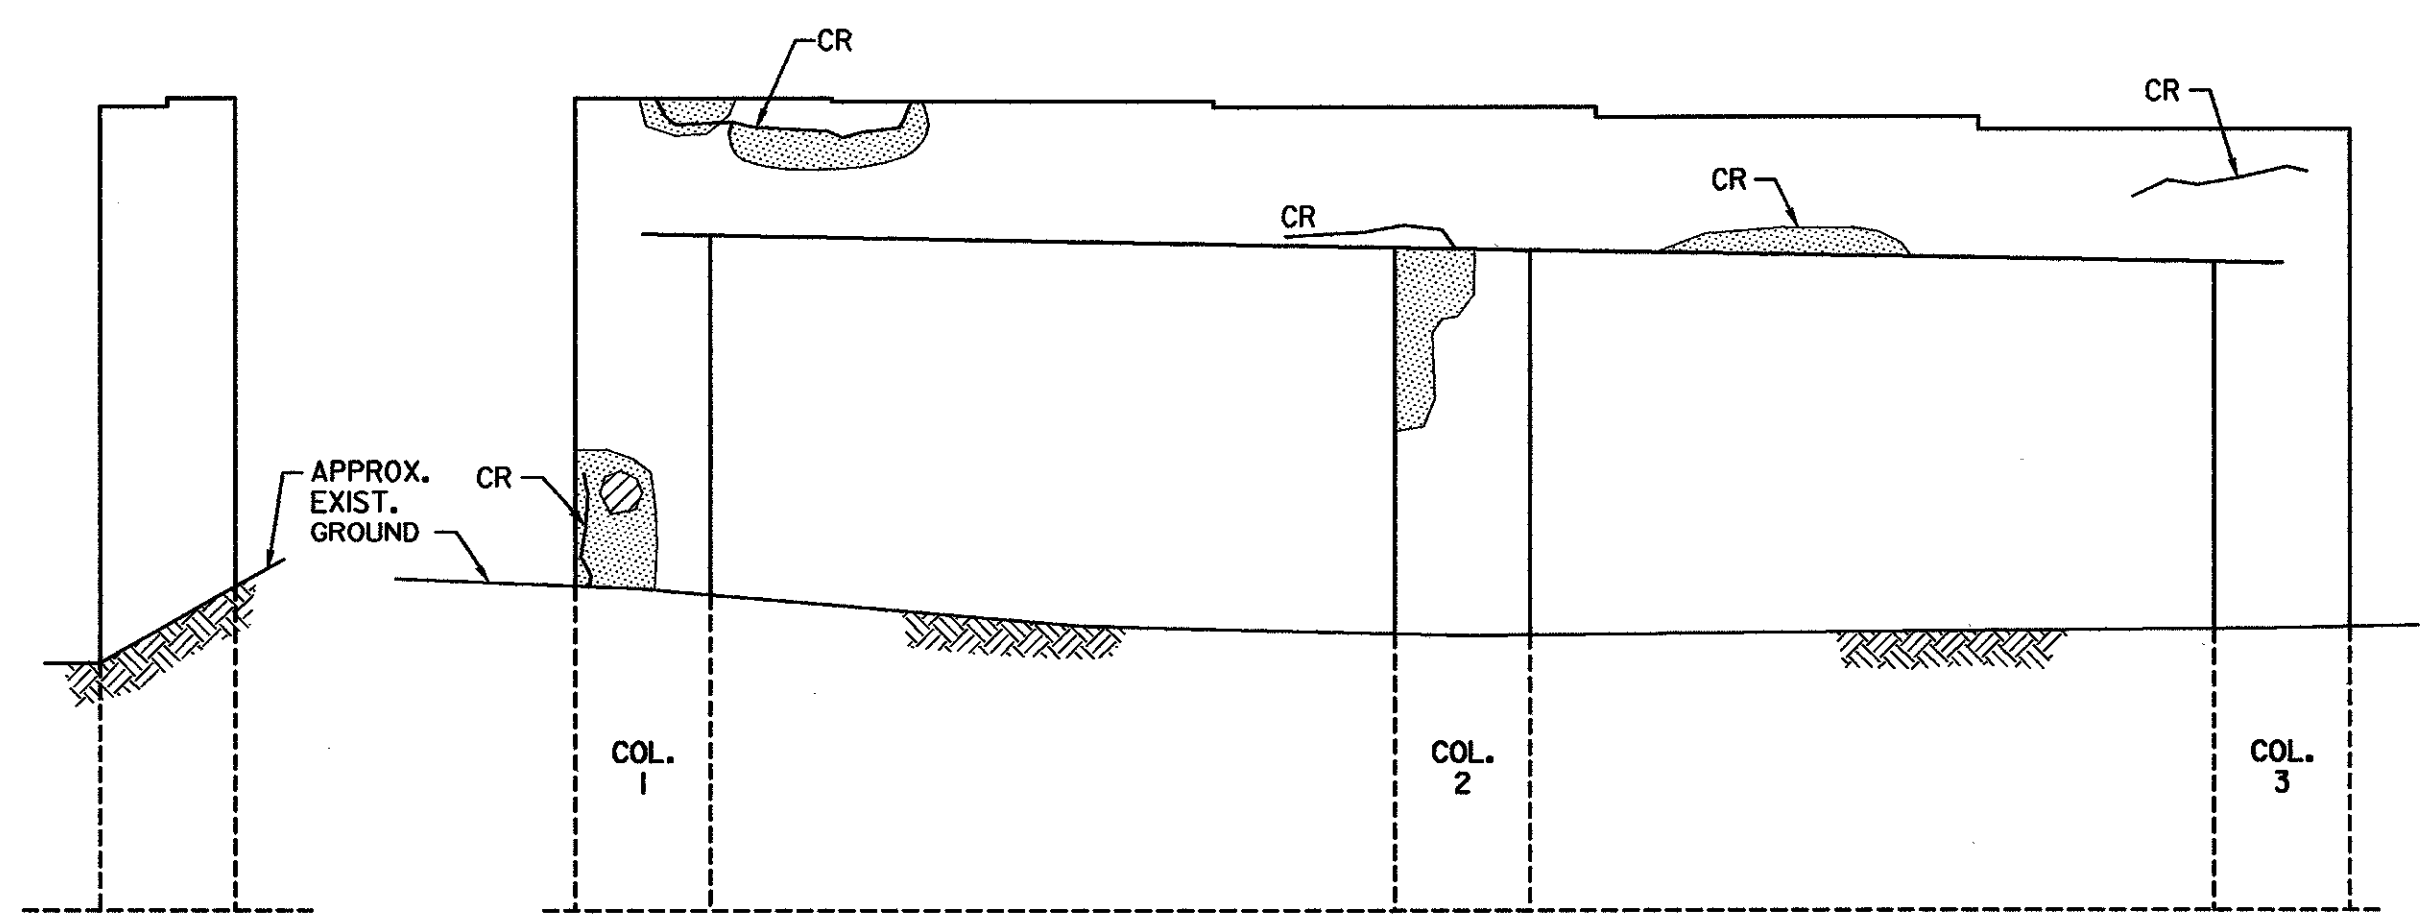


(ABUT. 1 SIDE)

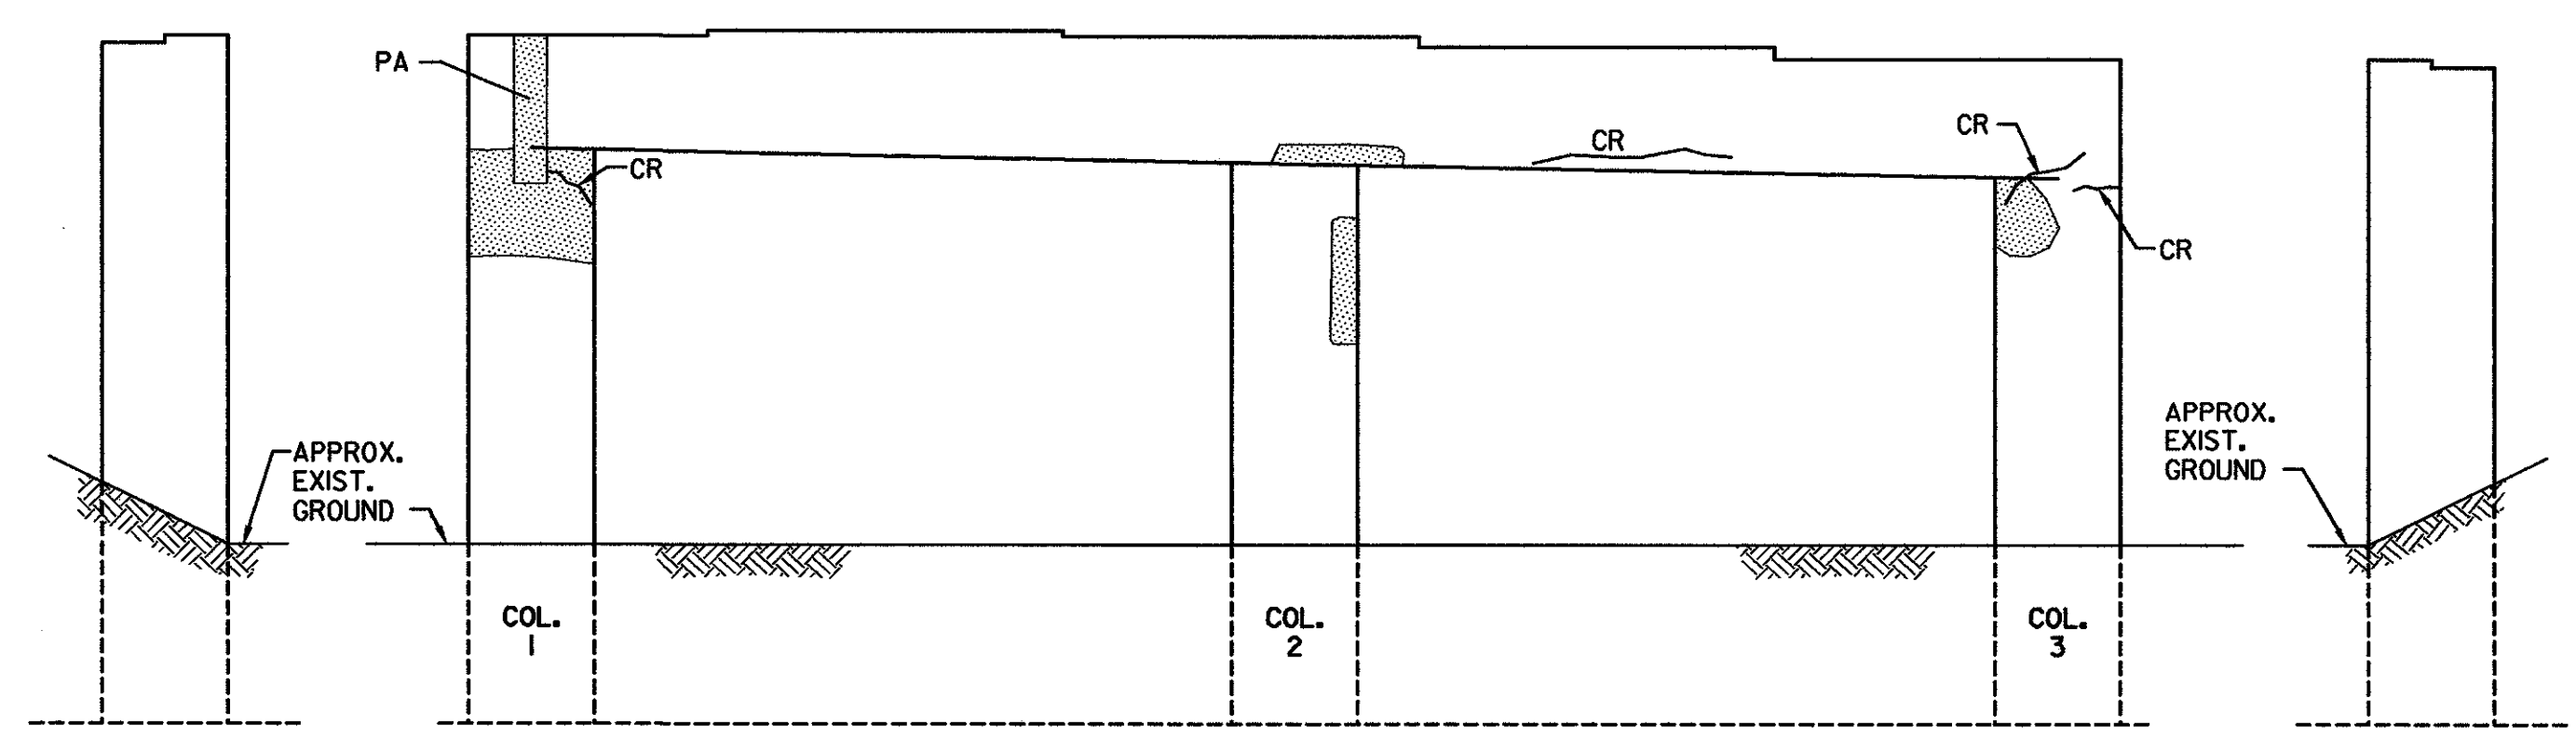


(PIER 1 SIDE)

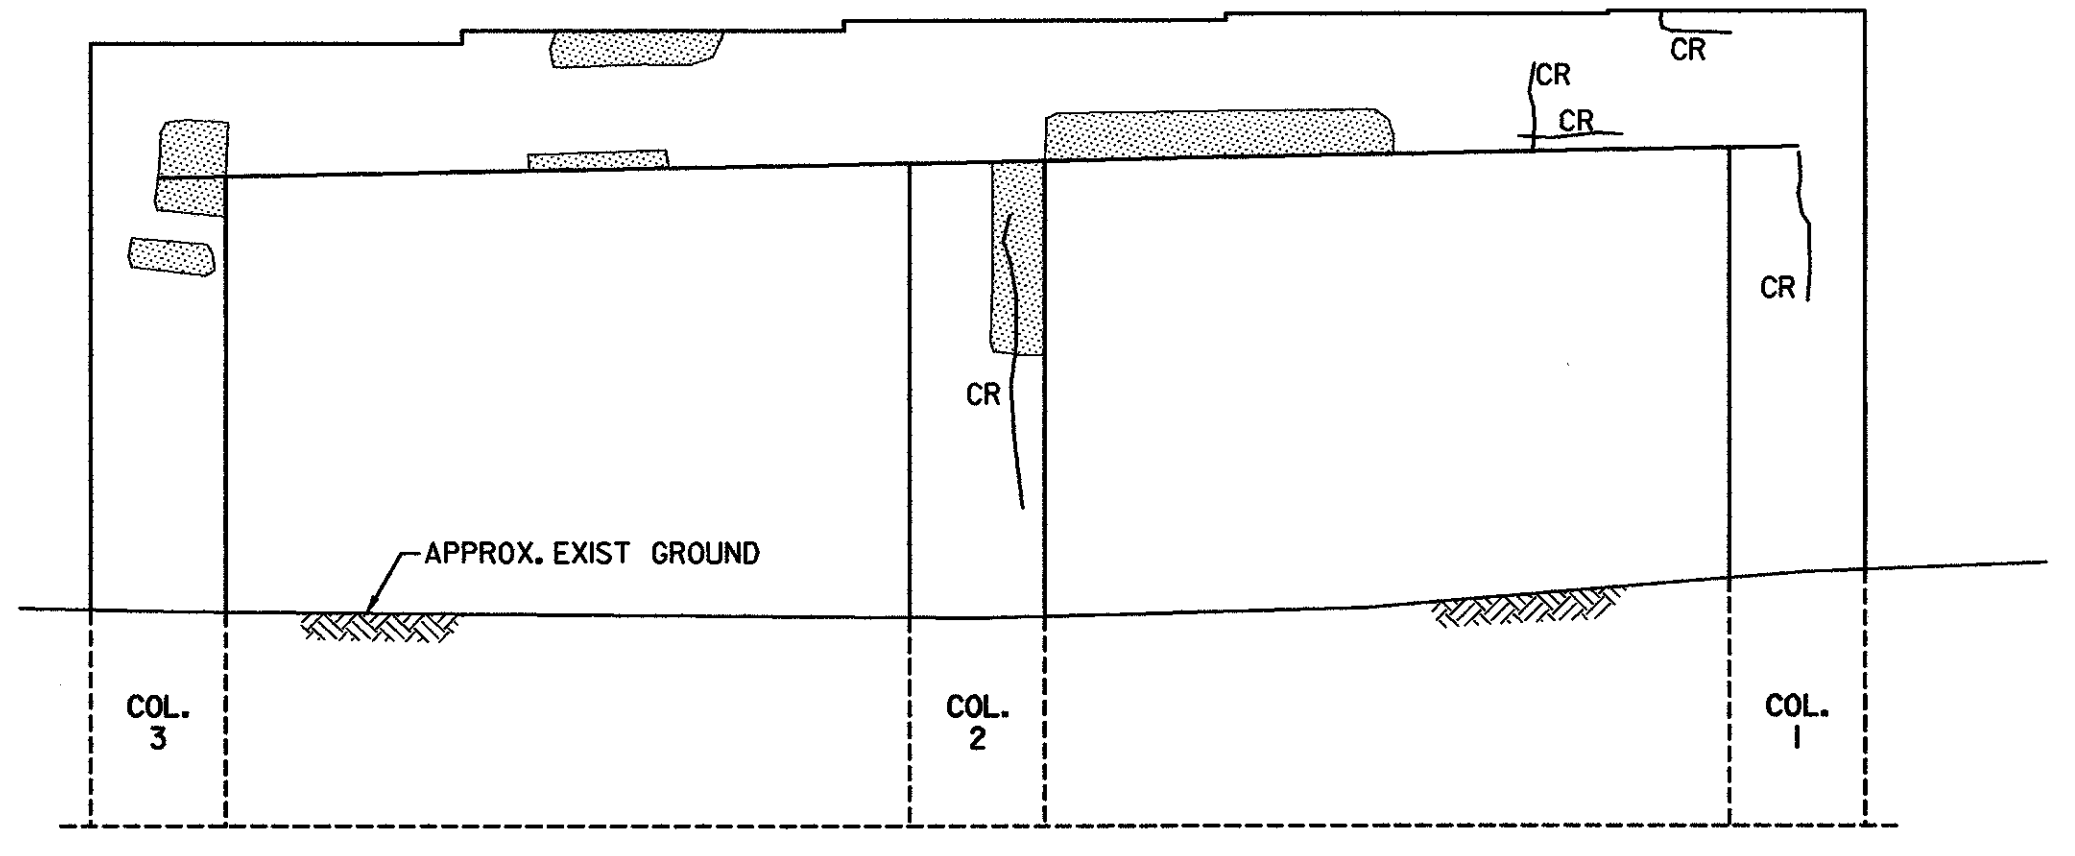


(PIER 2 SIDE)  
PIER 1 ELEVATIONS  
SCALE: 3/16"=1'-0"

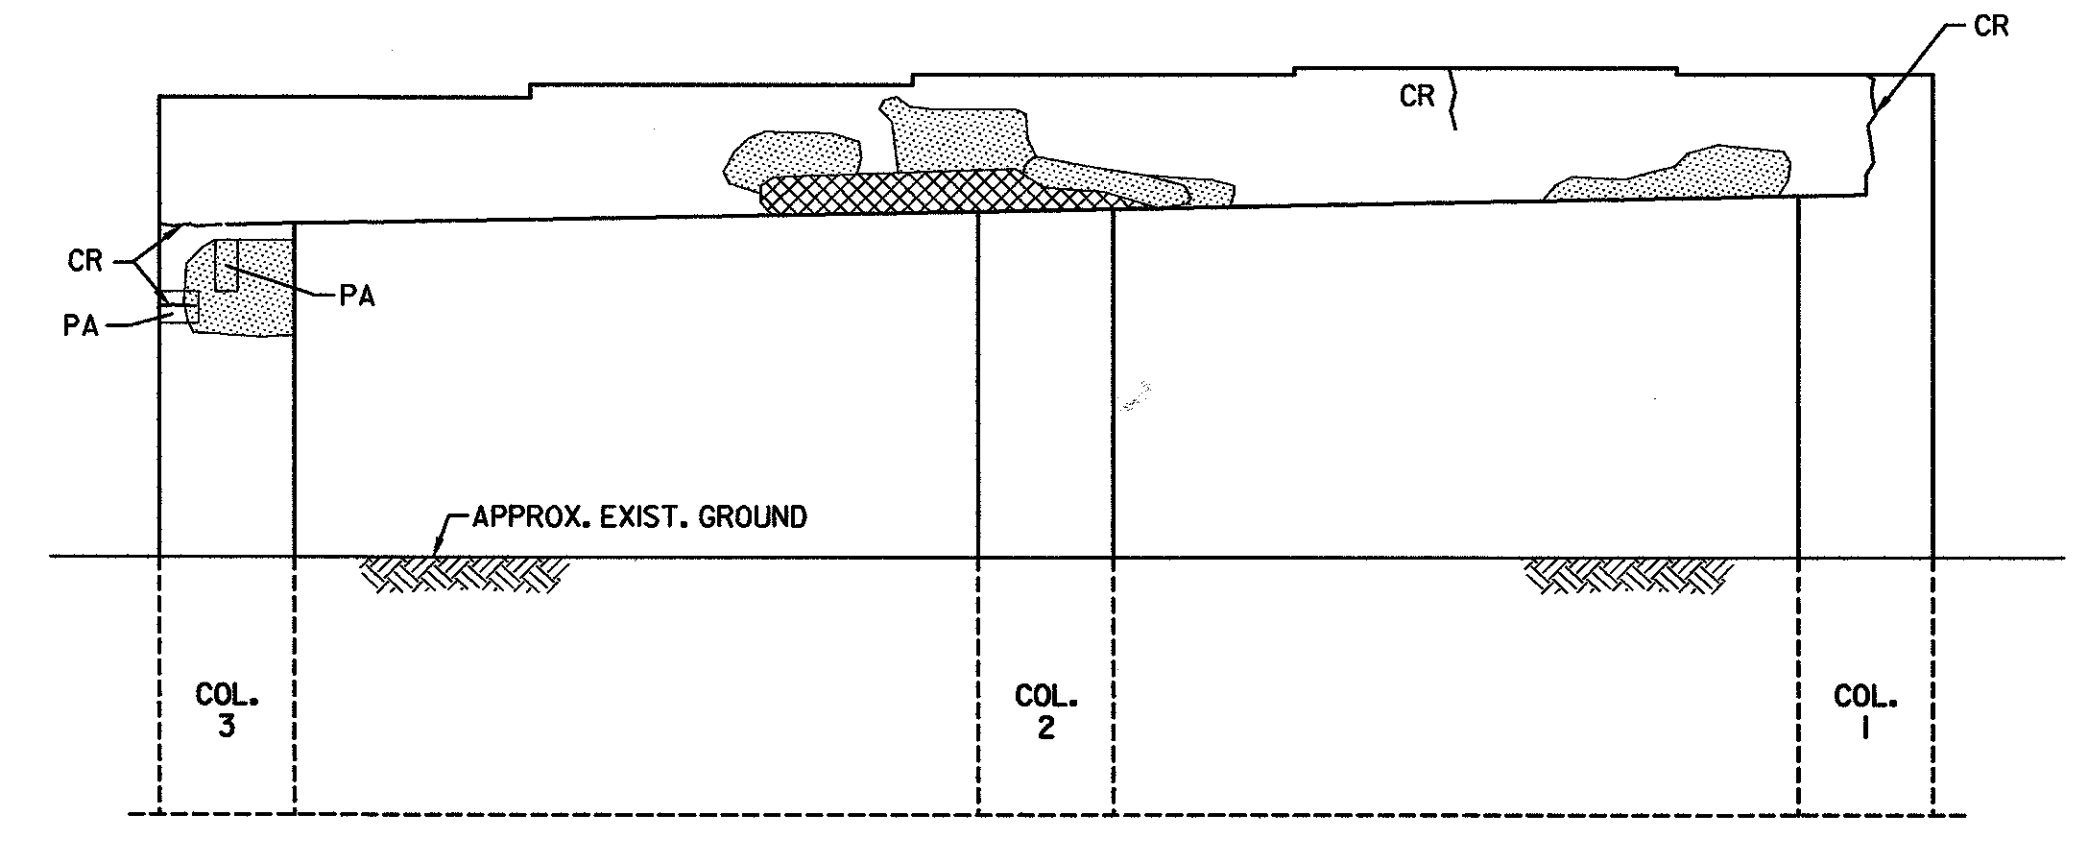


(ABUT. 2 SIDE)  
PIER 2 ELEVATIONS  
SCALE: 3/16"=1'-0"

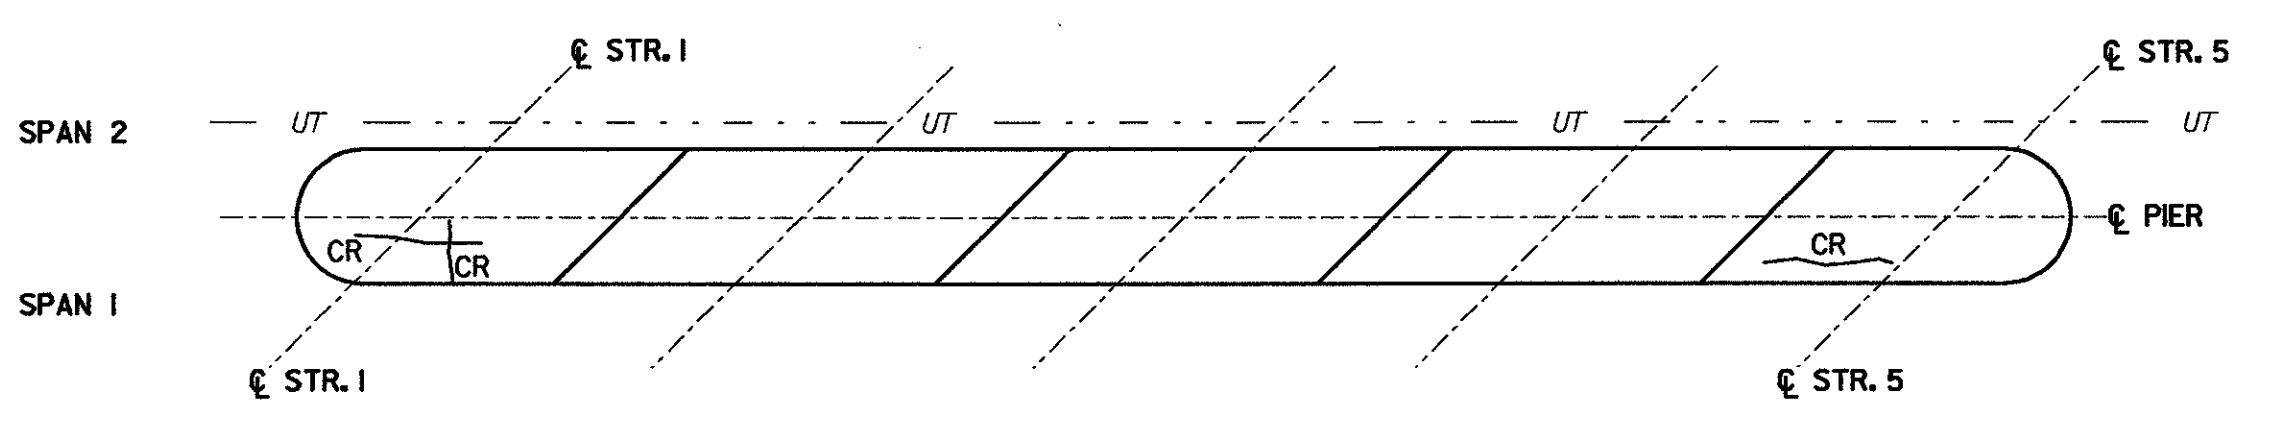


(TOP)

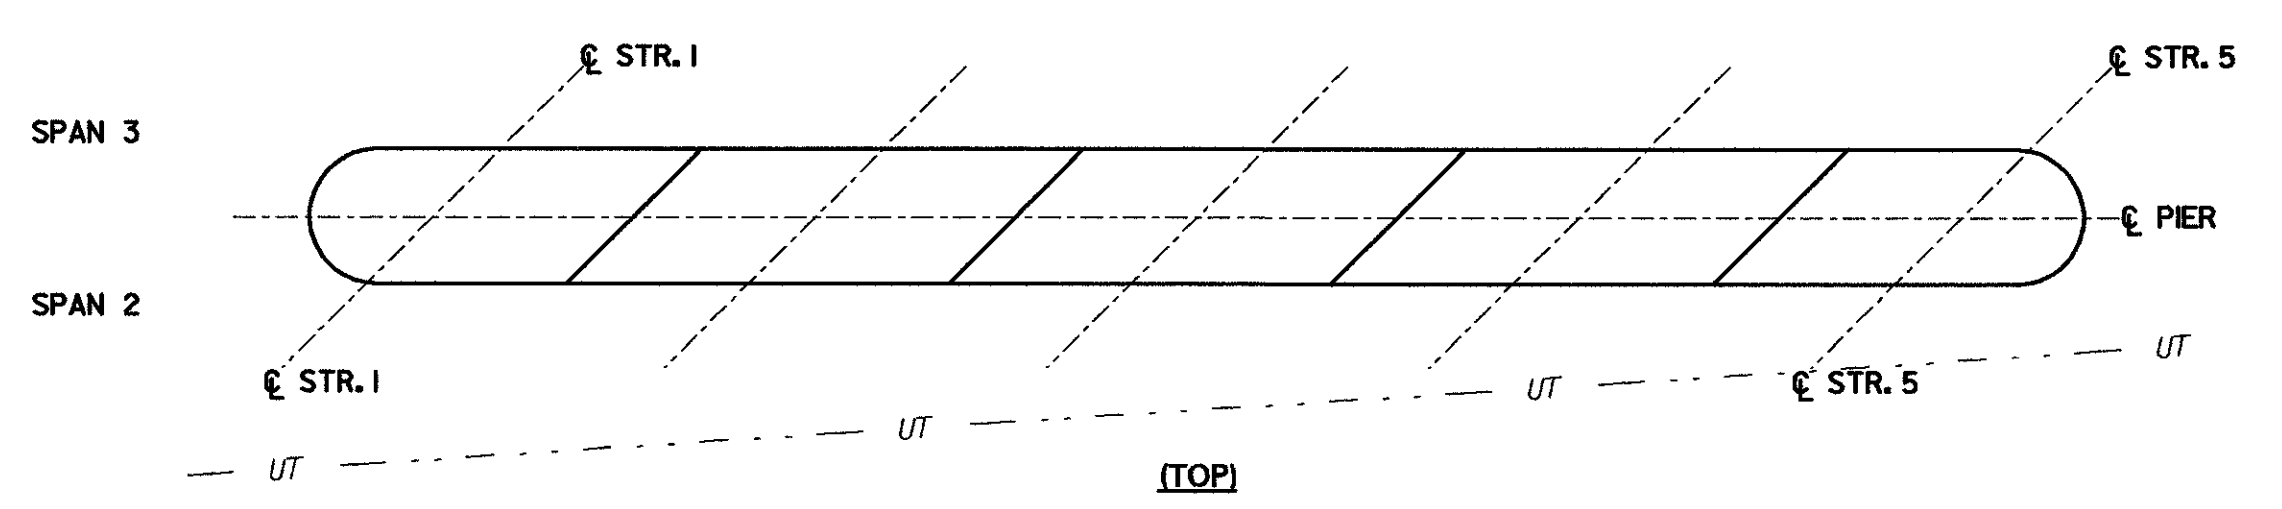

(TOP)

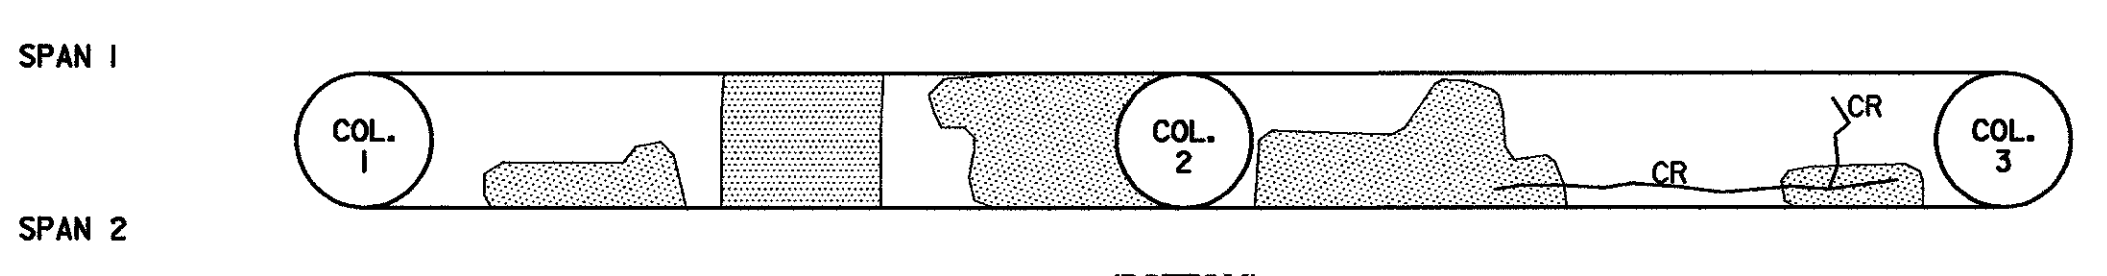

(BOTTOM)  
PIER 1 CAP  
SCALE: 3/16"=1'-0"

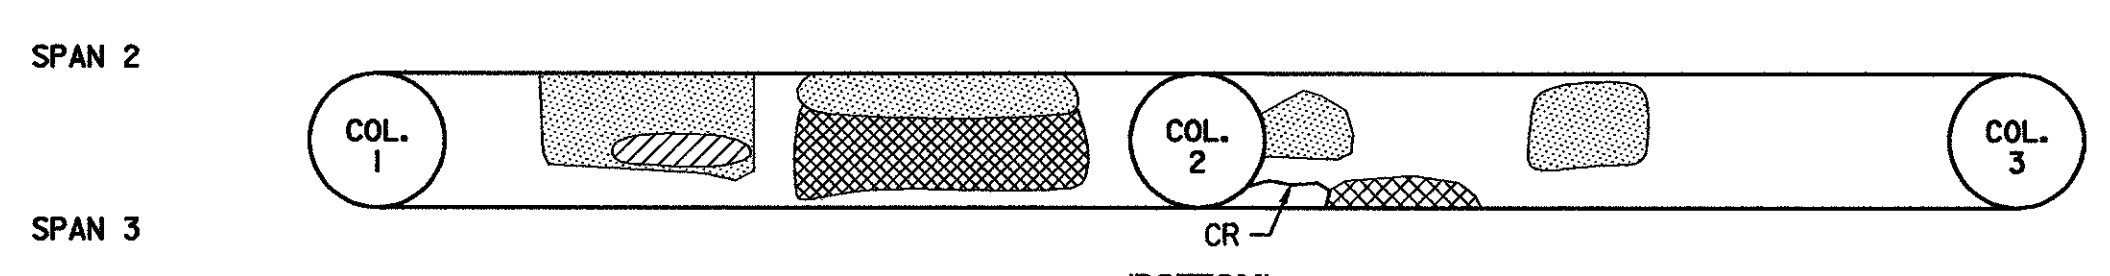


(BOTTOM)  
PIER 2 CAP  
SCALE: 3/16"=1'-0"


- ABBREVIATIONS**
- CR CRACK
  - PA PREVIOUSLY PATCHED AREA
- LEGEND**
- CRACK
  - DELAMINATED AREA
  - SPALLED AREA
  - DEEPLY SPALLED WITH EXPOSED REBAR
  - UNDERGROUND TELEPHONE
  - EXISTING GROUND

**STATE OF VERMONT  
AGENCY OF TRANSPORTATION**

Town Of MIDDLESEX-BOLTON		Bridge No. <b>43N</b>
Highway No. I-89		Log Sta.
		Surv. Sta.
I-89 NB OVER U.S. ROUTE 2		
<b>EXIST. SUBSTR. CONDITION (43N) (1 OF 2)</b>		
Designed By P.W. SZUSTAK	Drawn By R.A. BOTZENHART	
Checked By J.P. HALSTEAD	Date 10/99	Bridge Design Supervisor J.P. HALSTEAD Date 10/99
PROJECT MIDDLESEX-BOLTON		PROJECT NO. IM-089-2(26)
TVGA CAD Drawing No. 43piers		Date 10/99
Bridge Sheet No. <b>SC-1</b>		Sheet 135 of 307

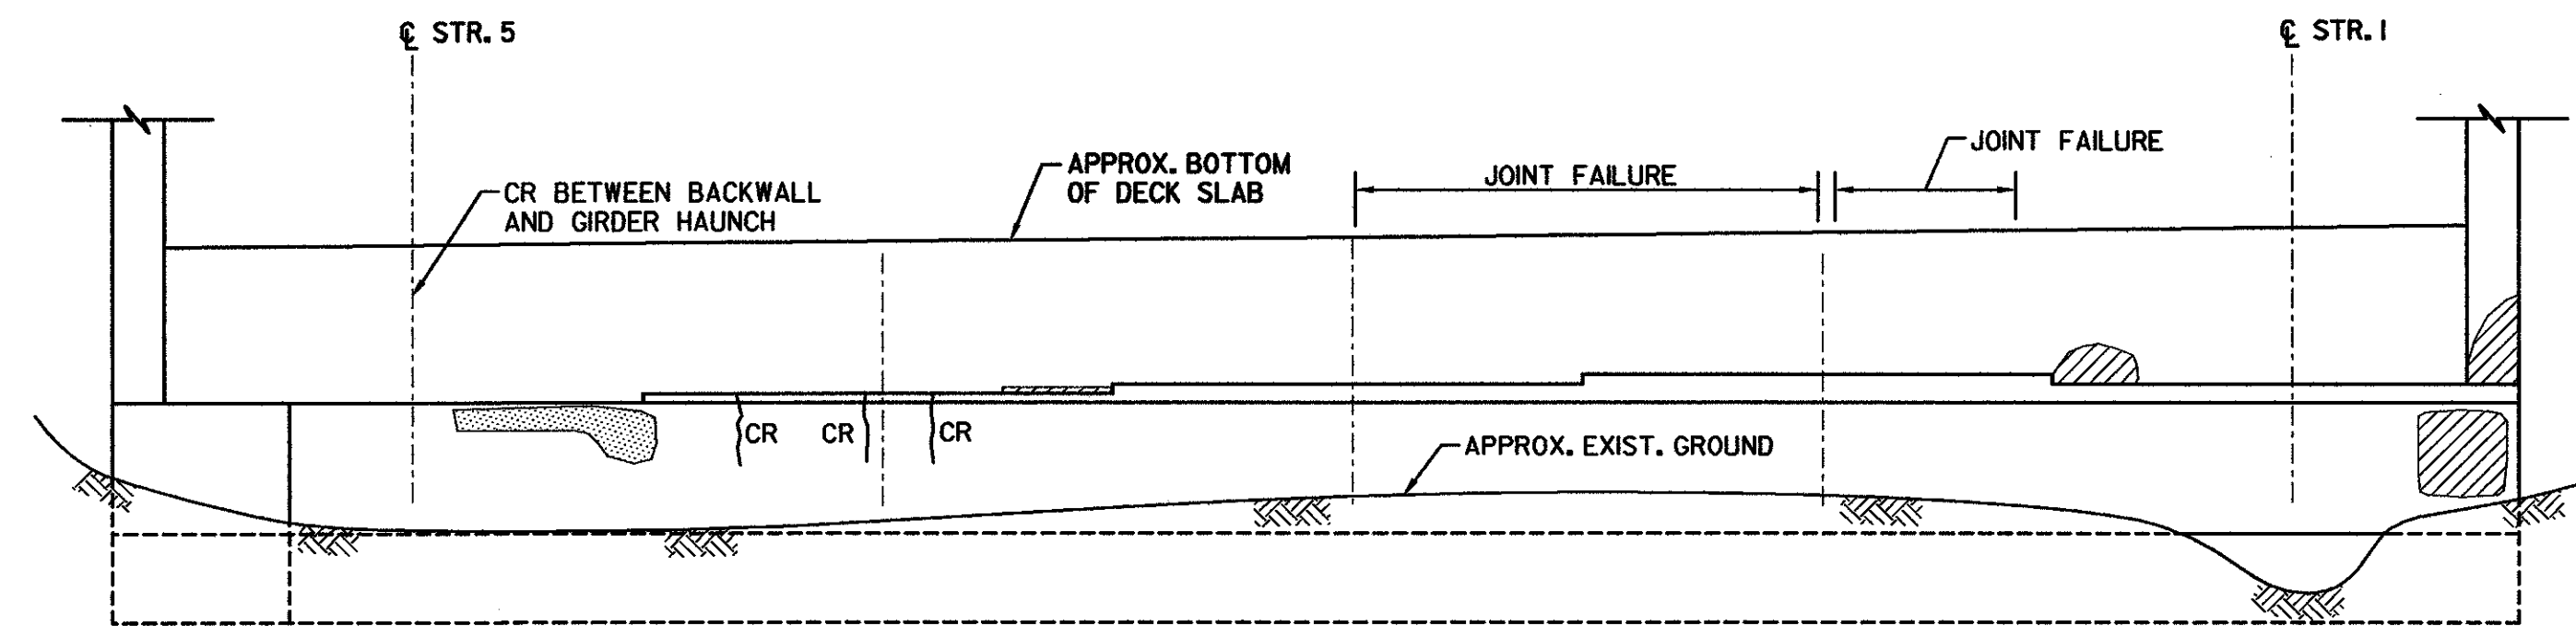

**ABUT. 1 ELEVATION**  
SCALE: 1/4"=1'-0"

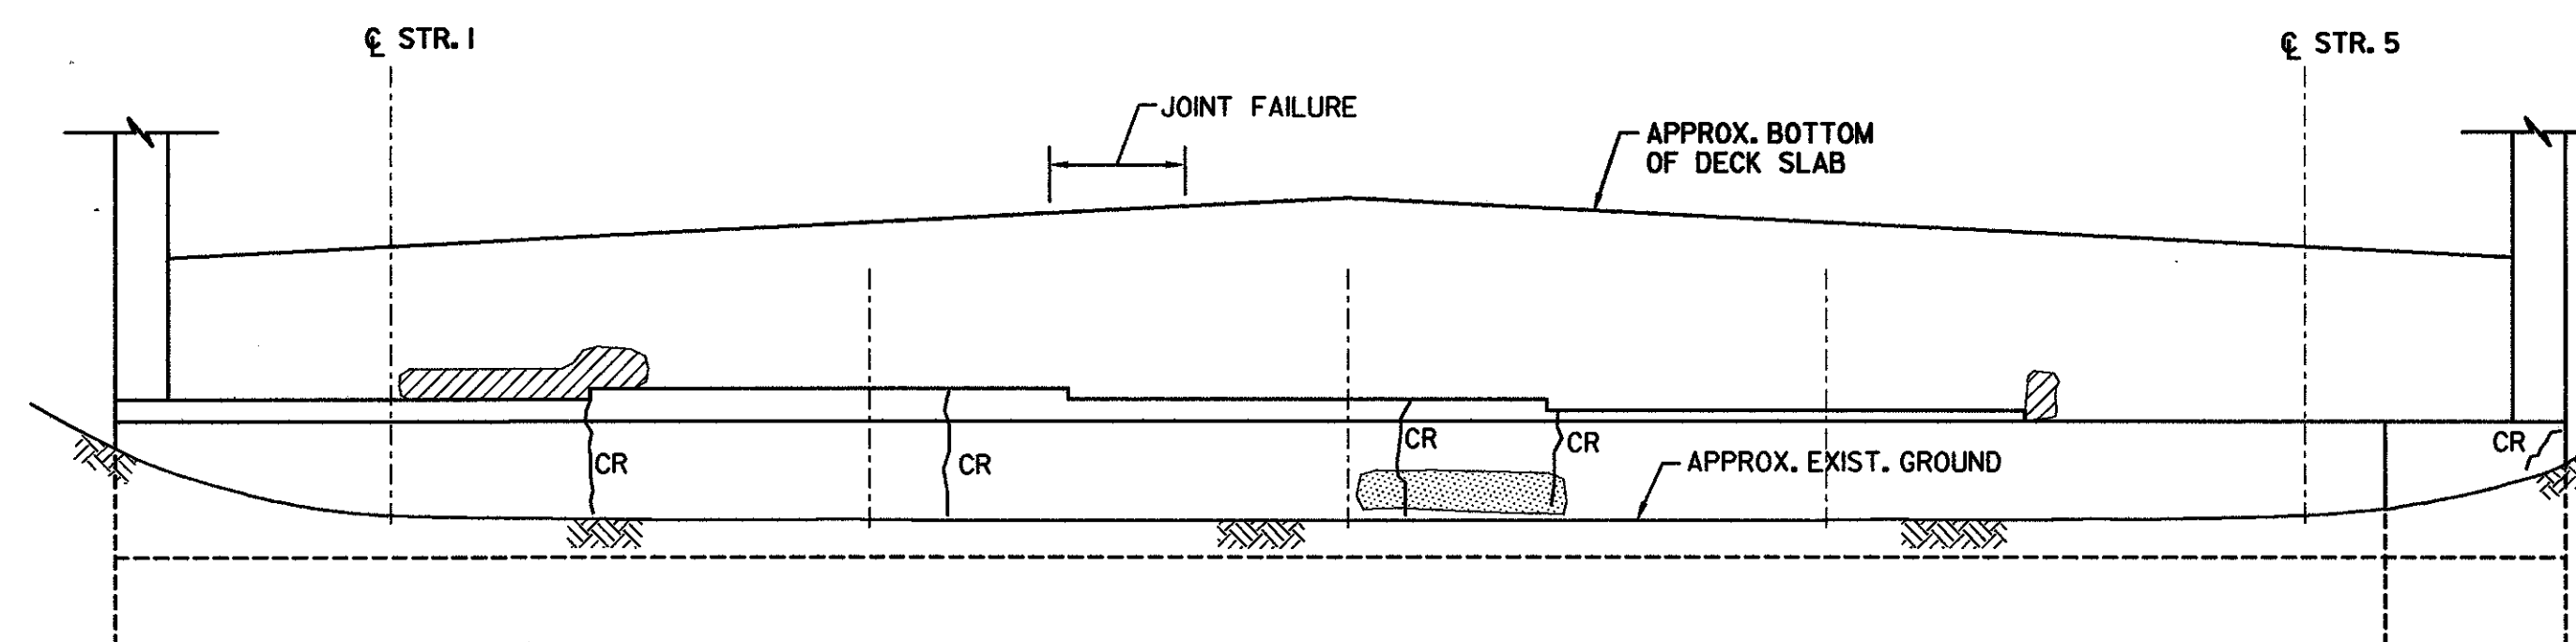


**ABUT. 2 ELEVATION**  
SCALE: 1/4"=1'-0"

**ABBREVIATIONS**  
CR CRACK  
PA PREVIOUSLY PATCHED AREA


**LEGEND**  
CRACK  
DELAMINATED AREA  
SPALLED AREA  
DEEPLY SPALLED WITH EXPOSED REBAR  
EXISTING GROUND

**STATE OF VERMONT  
AGENCY OF TRANSPORTATION**


Town Of	MIDDLESEX-BOLTON	Bridge No.	43N
Highway No.	I-89	Log Sta.	
	I-89 NB OVER U.S. ROUTE 2	Surv. Sta.	
<b>EXIST. SUBSTR. CONDITION (43N) (2 OF 2)</b>			
Designed By	P.W. SZUSTAK	Drawn By	R.A. BOTZENHART
Checked By	J.P. HALSTEAD	Bridge Design Supervisor	J.P. HALSTEAD
Date	10/99	Date	10/99
PROJECT	MIDDLESEX-BOLTON	PROJECT NO.	IM-089-2(26)
TVGA CAD Drawing No.	43abut	Date	10/99
Bridge Sheet No.	SC-2	Sheet	136 of 307

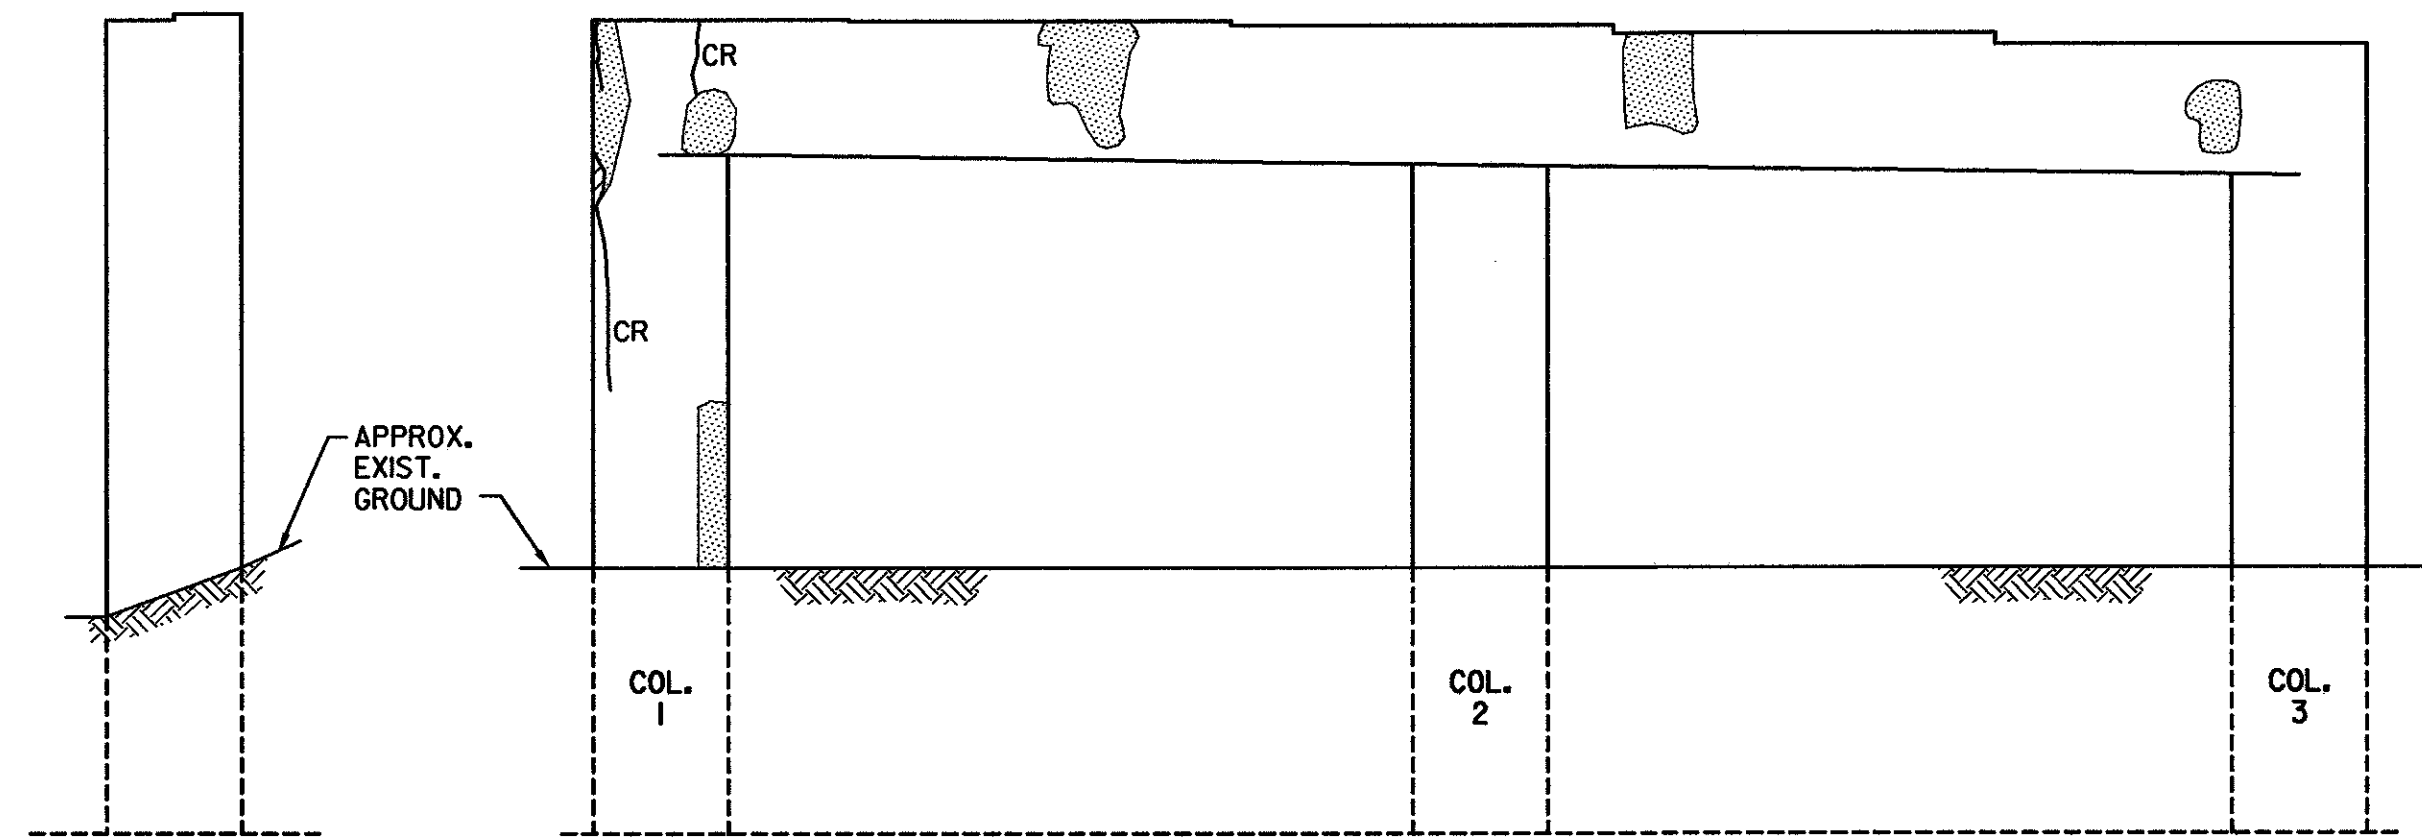


(ABUT. 1 SIDE)

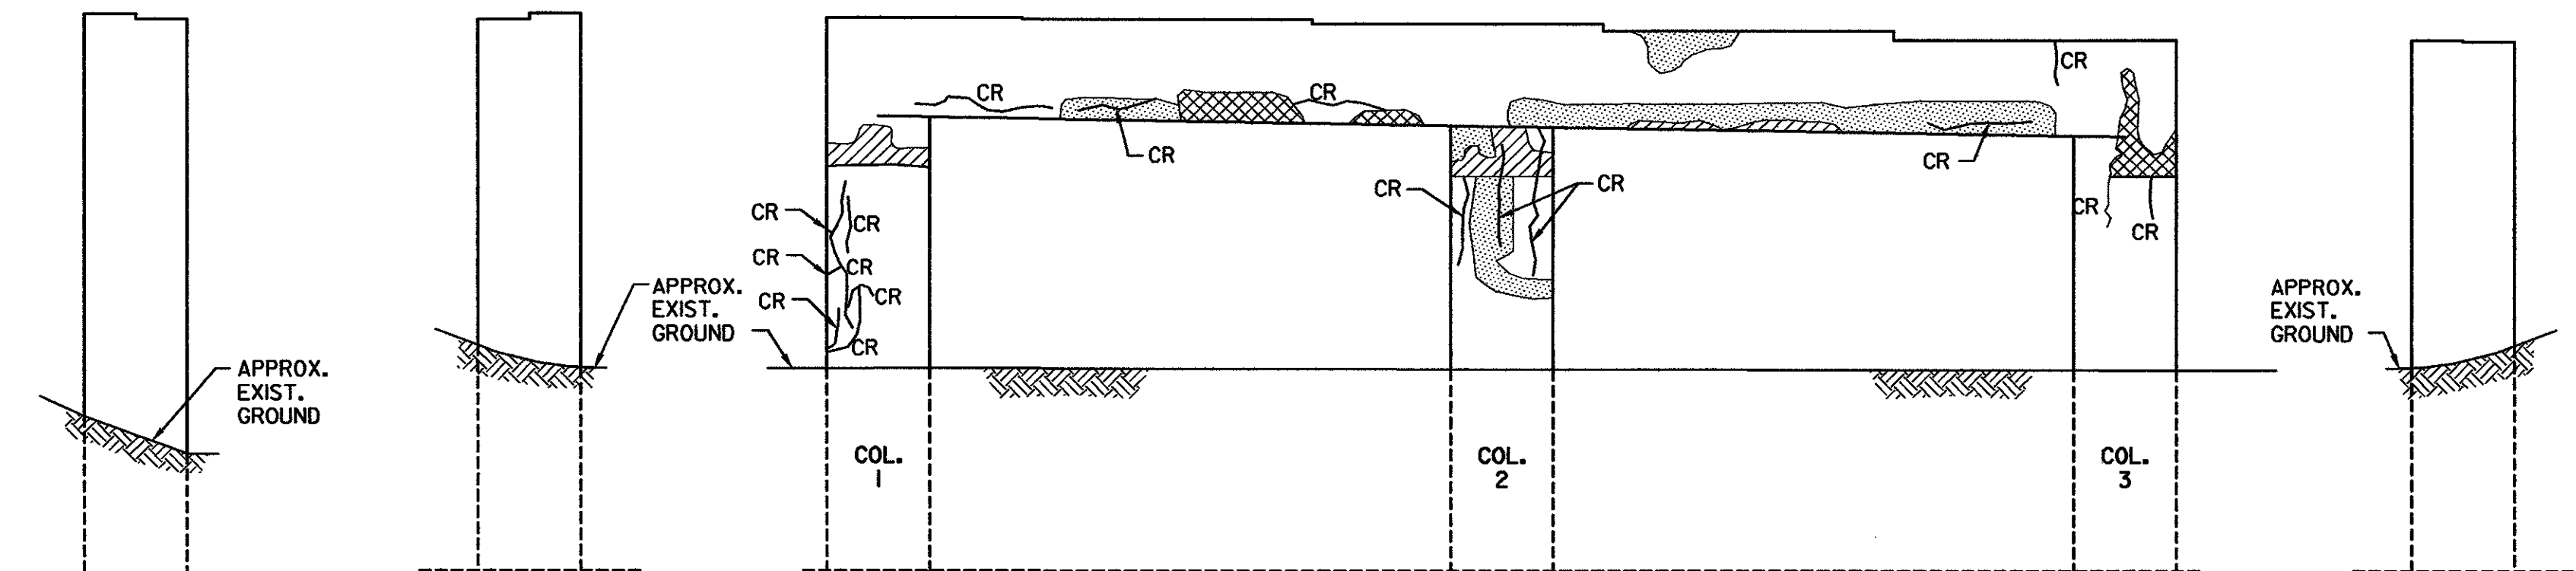


(PIER 1 SIDE)

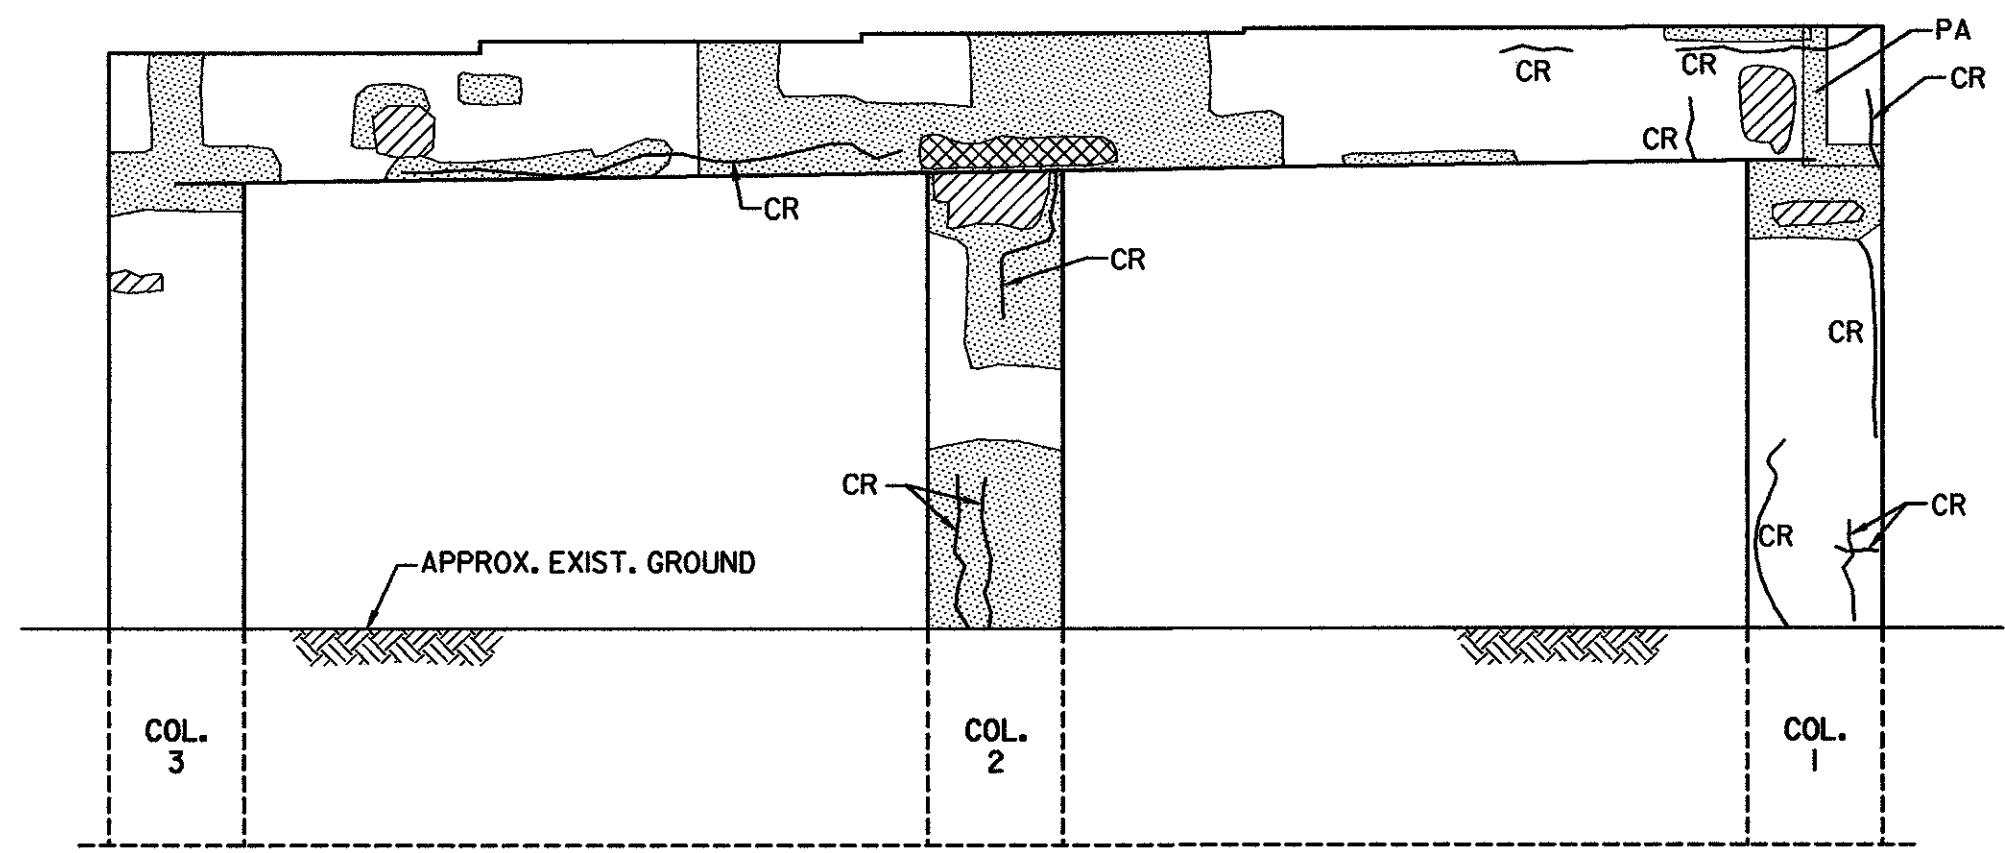


(PIER 2 SIDE)  
PIER 1 ELEVATIONS  
SCALE: 3/16"=1'-0"

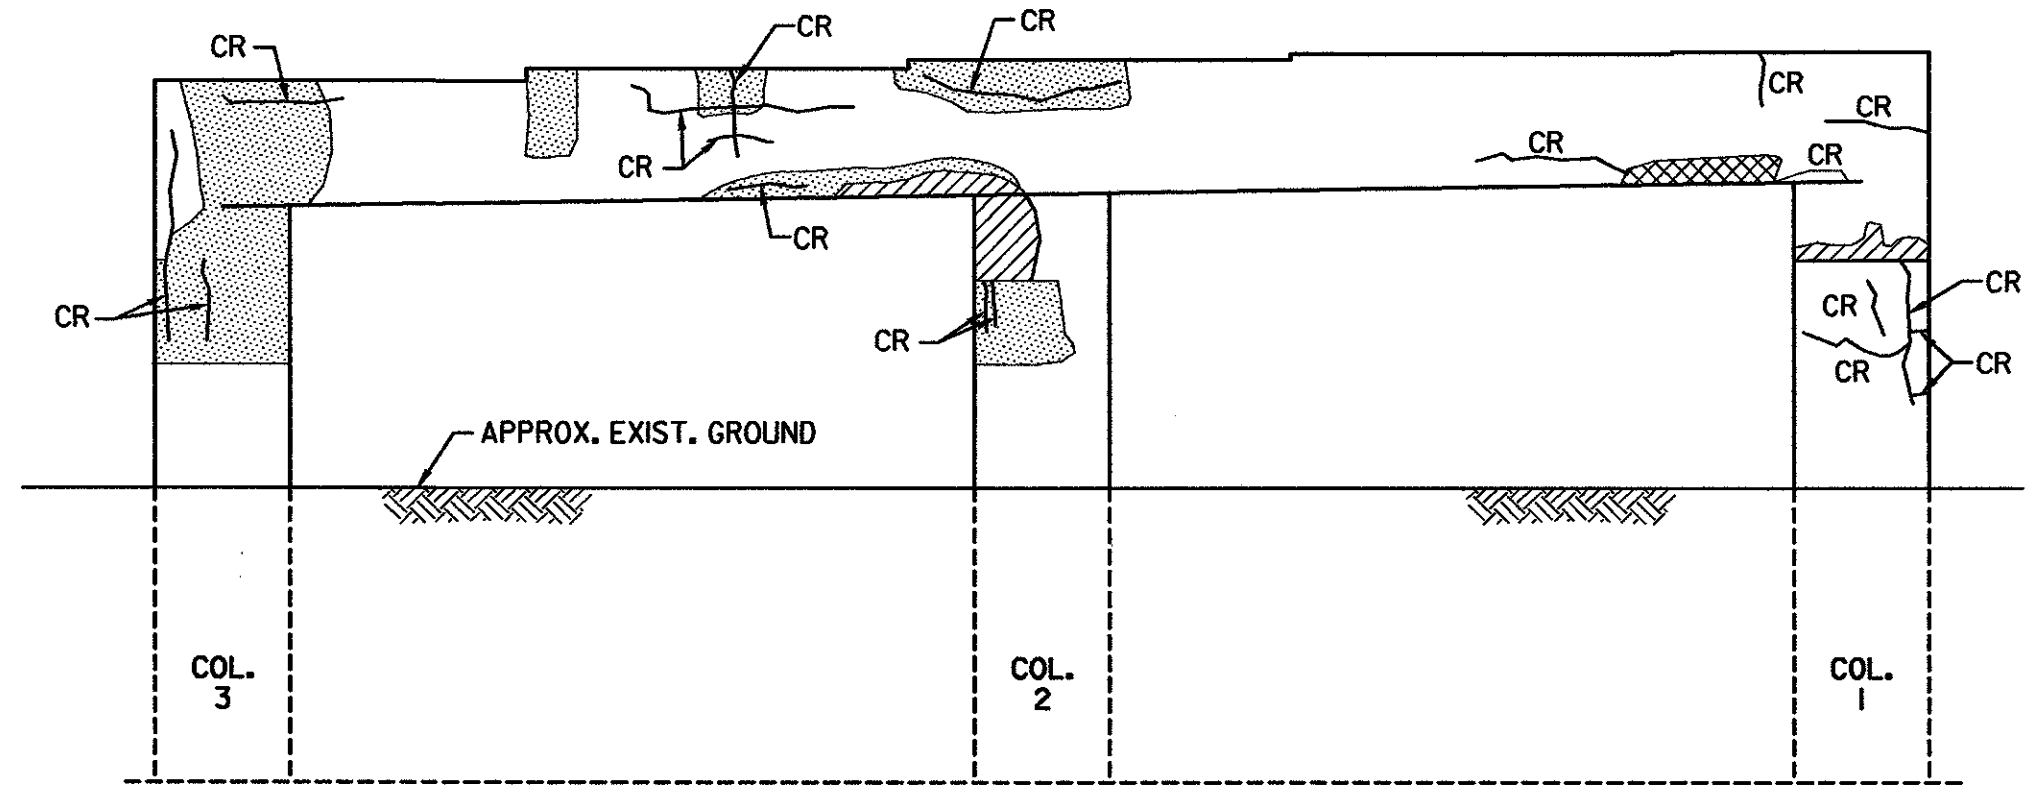


(ABUT. 2 SIDE)  
PIER 2 ELEVATIONS  
SCALE: 3/16"=1'-0"

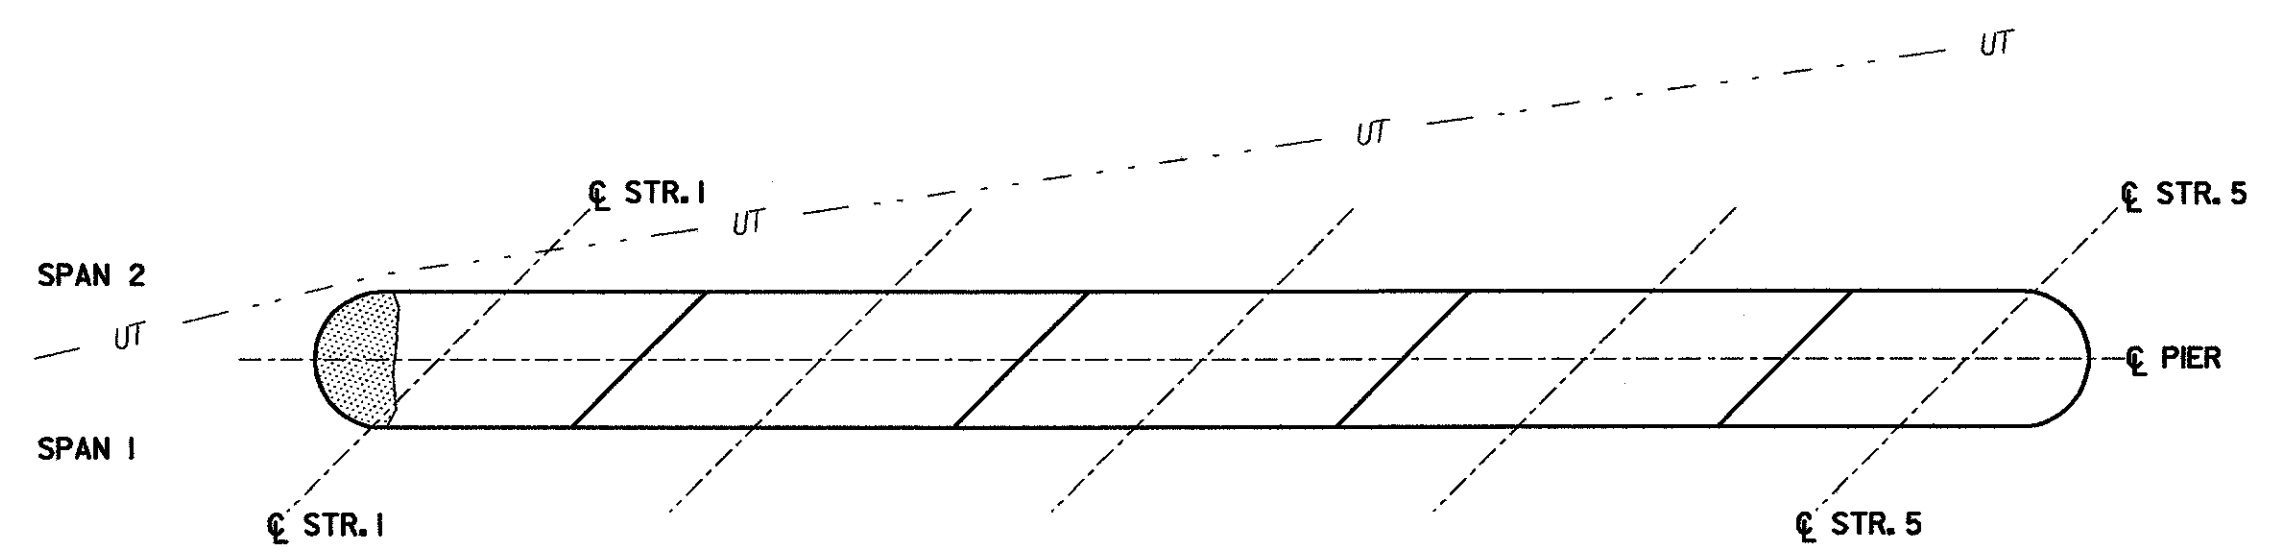


(TOP)

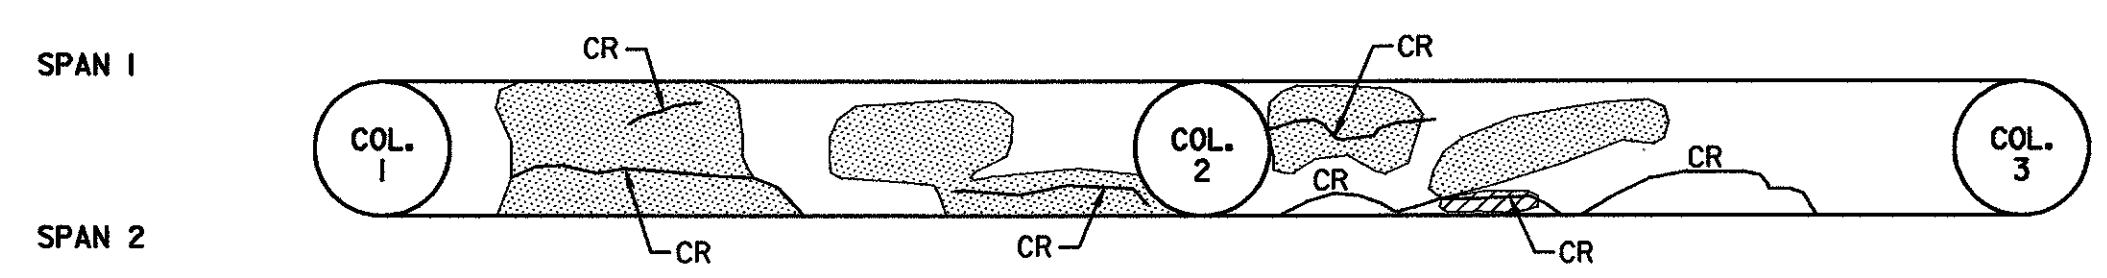

PIER 1 CAP  
SCALE: 3/16"=1'-0"

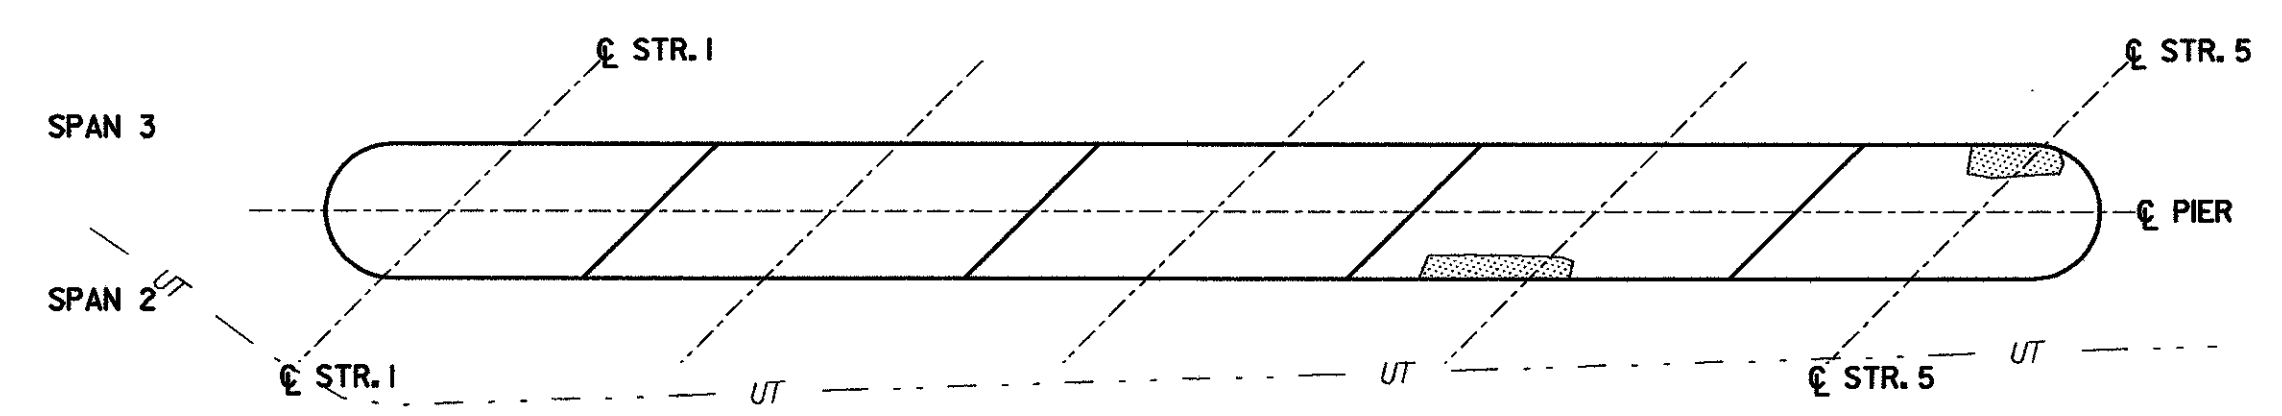

(TOP)

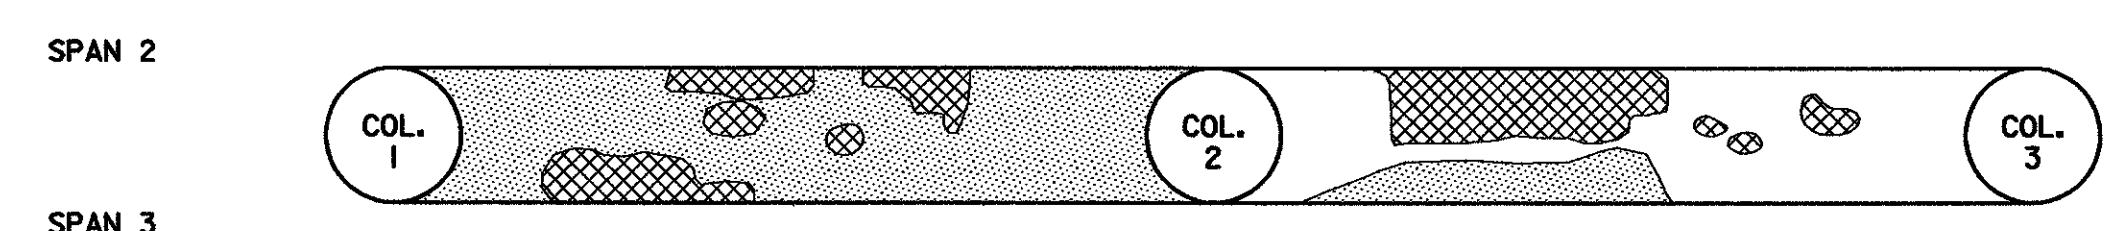


PIER 2 CAP  
SCALE: 3/16"=1'-0"

**ABBREVIATIONS**  
CR CRACK  
PA PREVIOUSLY PATCHED AREA


**LEGEND**  
CRACK  
DELAMINATED AREA  
SPALLED AREA  
DEEPLY SPALLED WITH EXPOSED REBAR  
UNDERGROUND TELEPHONE  
EXISTING GROUND

**STATE OF VERMONT  
AGENCY OF TRANSPORTATION**

Town Of	MIDDLESEX-BOLTON	Bridge No.	435
Highway No.	I-89	Log Sta.	
		Surv. Sta.	
I-89 SB OVER U.S. ROUTE 2			
<b>EXIST. SUBSTR. CONDITION (435) (1 OF 2)</b>			
Designed By	P.W. SZUSTAK	Drawn By	R.A. BOTZENHART
Checked By	J.P. HALSTEAD	Date	10/99
		Bridge Design Supervisor	J.P. HALSTEAD Date 10/99
PROJECT	MIDDLESEX-BOLTON	PROJECT NO.	IM-089-2(26)
TVGA CAD Drawing No.	43plers	Date	10/99
Bridge Sheet No.	SC-3	Sheet	137 of 307

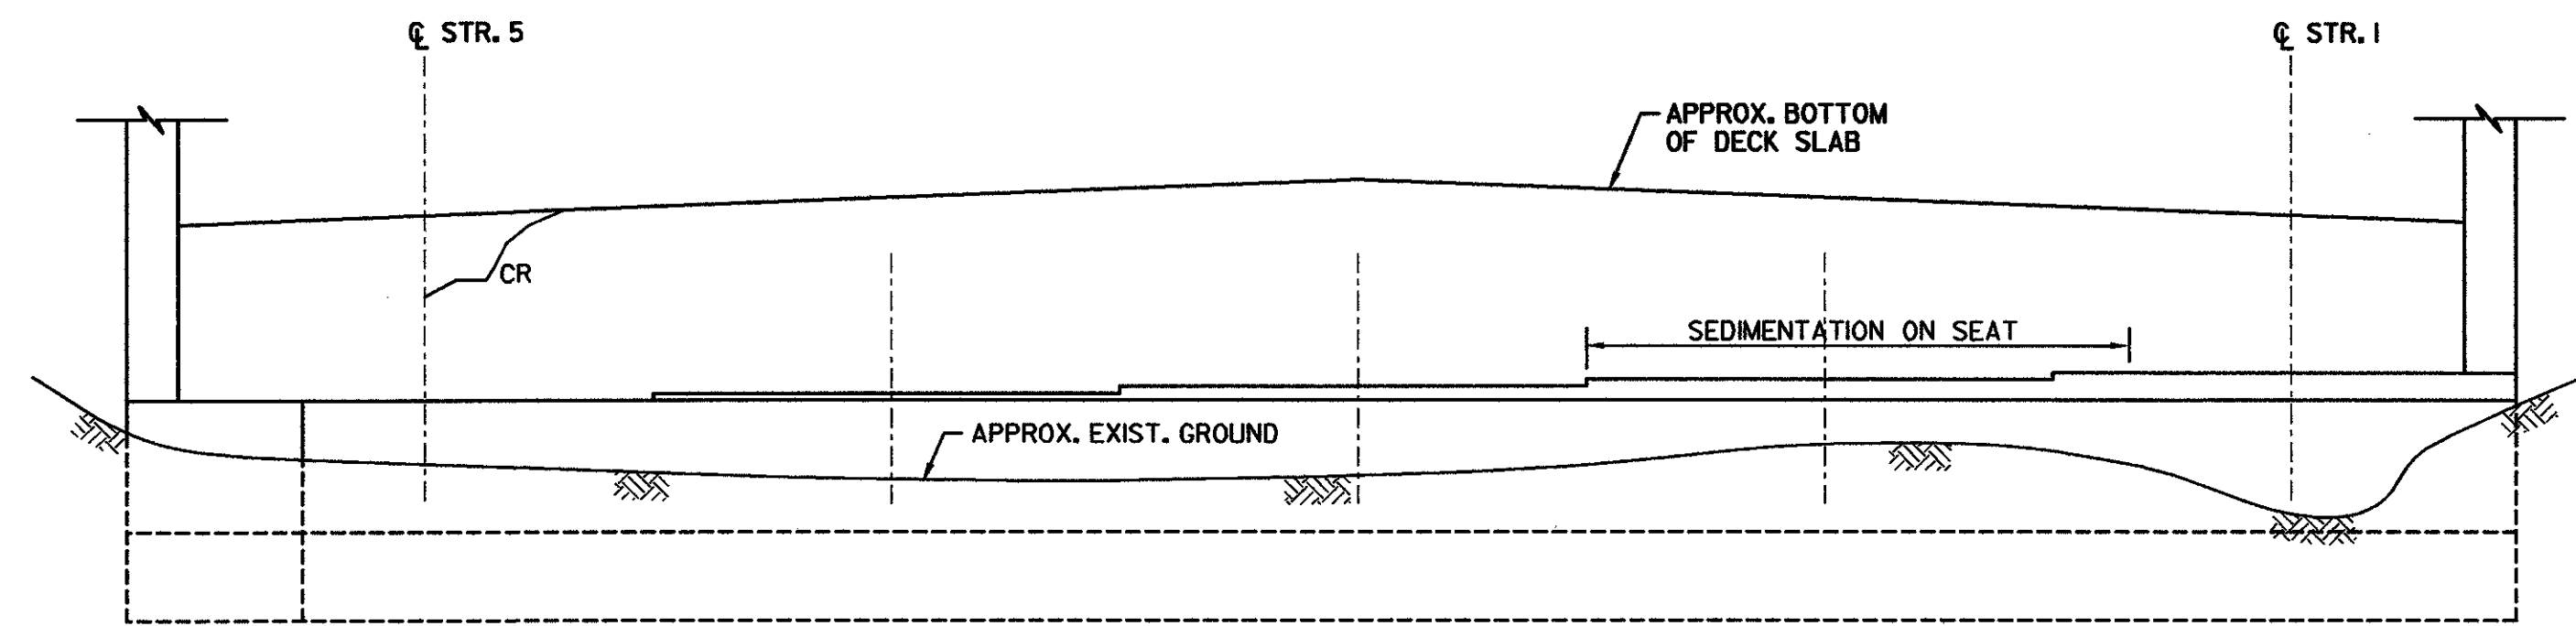

**ABUT. 1 ELEVATION**  
SCALE: 1/4"=1'-0"

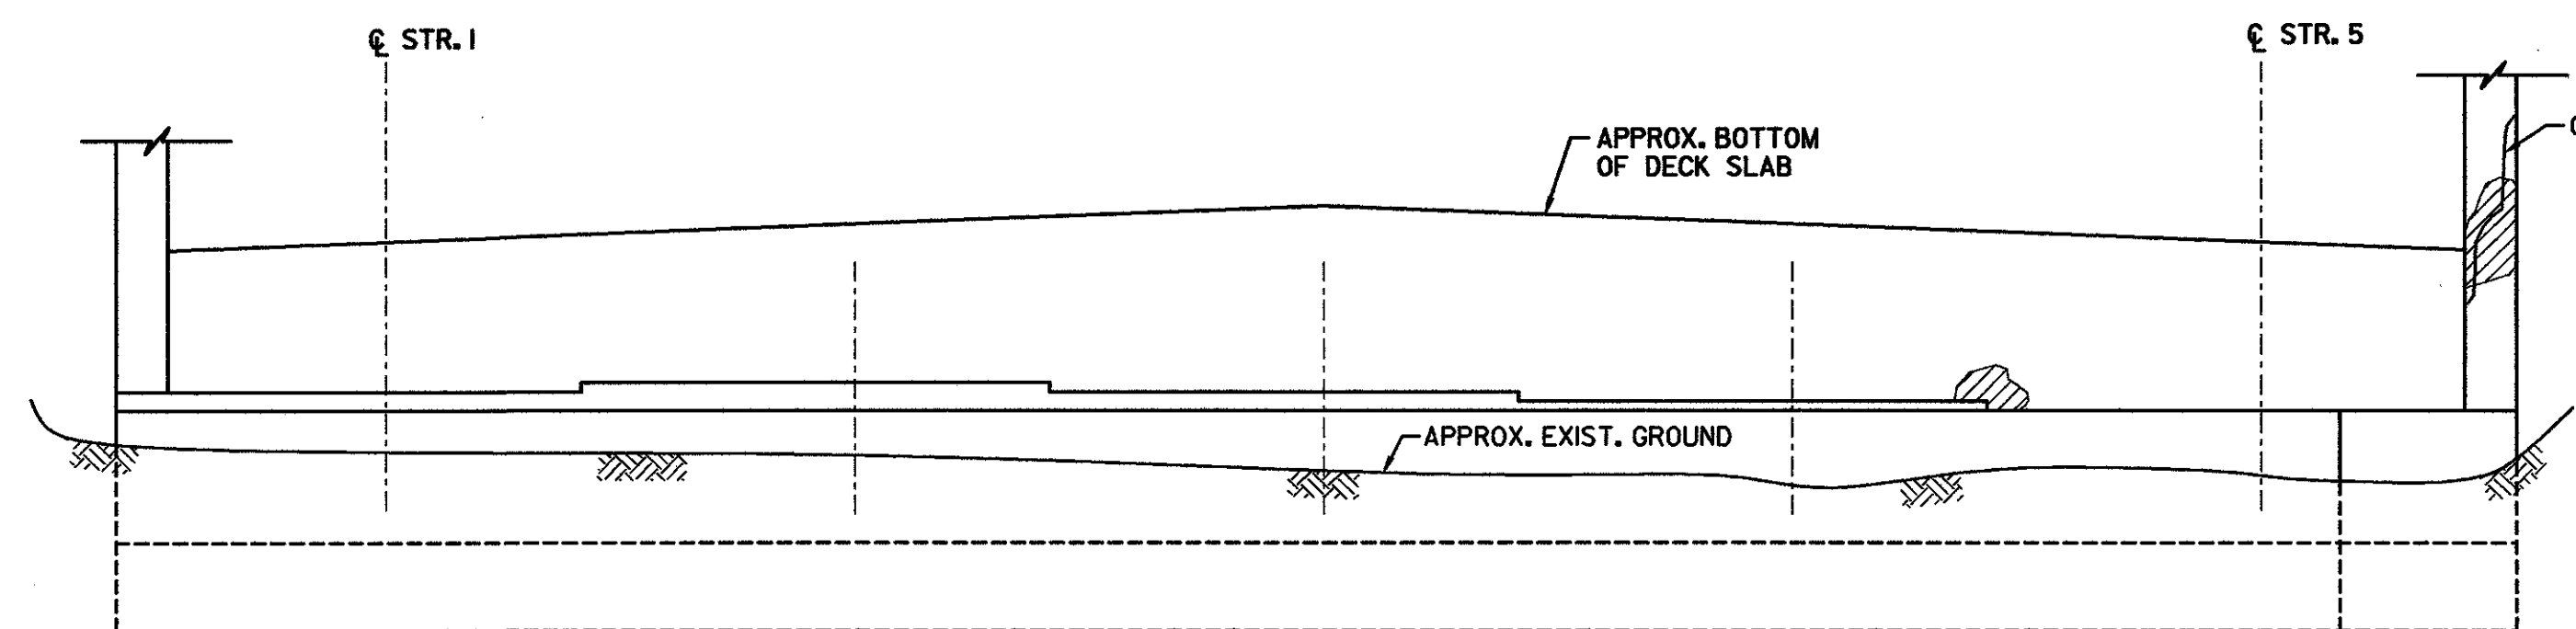

**ABUT. 2 ELEVATION**  
SCALE: 1/4"=1'-0"

**ABBREVIATIONS**  
CR CRACK  
PA PREVIOUSLY PATCHED AREA

**LEGEND**  
CRACK  
DELAMINATED AREA  
SPALLED AREA  
DEEPLY SPALLED WITH EXPOSED REBAR  
EXISTING GROUND


**STATE OF VERMONT  
AGENCY OF TRANSPORTATION**

Town Of	MIDDLESEX-BOLTON	Bridge No.	<b>43S</b>
Highway No.	I-89	Log Sta.	
		Surv. Sta.	
I-89 SB OVER U.S. ROUTE 2			

**EXIST. SUBSTR. CONDITION (43S) (2 OF 2)**


Designed By	P.W. SZUSTAK	Drawn By	R.A. BOTZENHART
Checked By	J.P. HALSTEAD	Bridge Design Supervisor	J.P. HALSTEAD
Date	10/99	Date	10/99
PROJECT	MIDDLESEX-BOLTON	PROJECT NO.	IM-089-2(26)

TVGA CAD Drawing No.	43abut	Date	10/99
Bridge Sheet No.	<b>SC-4</b>	Sheet	138 of 307

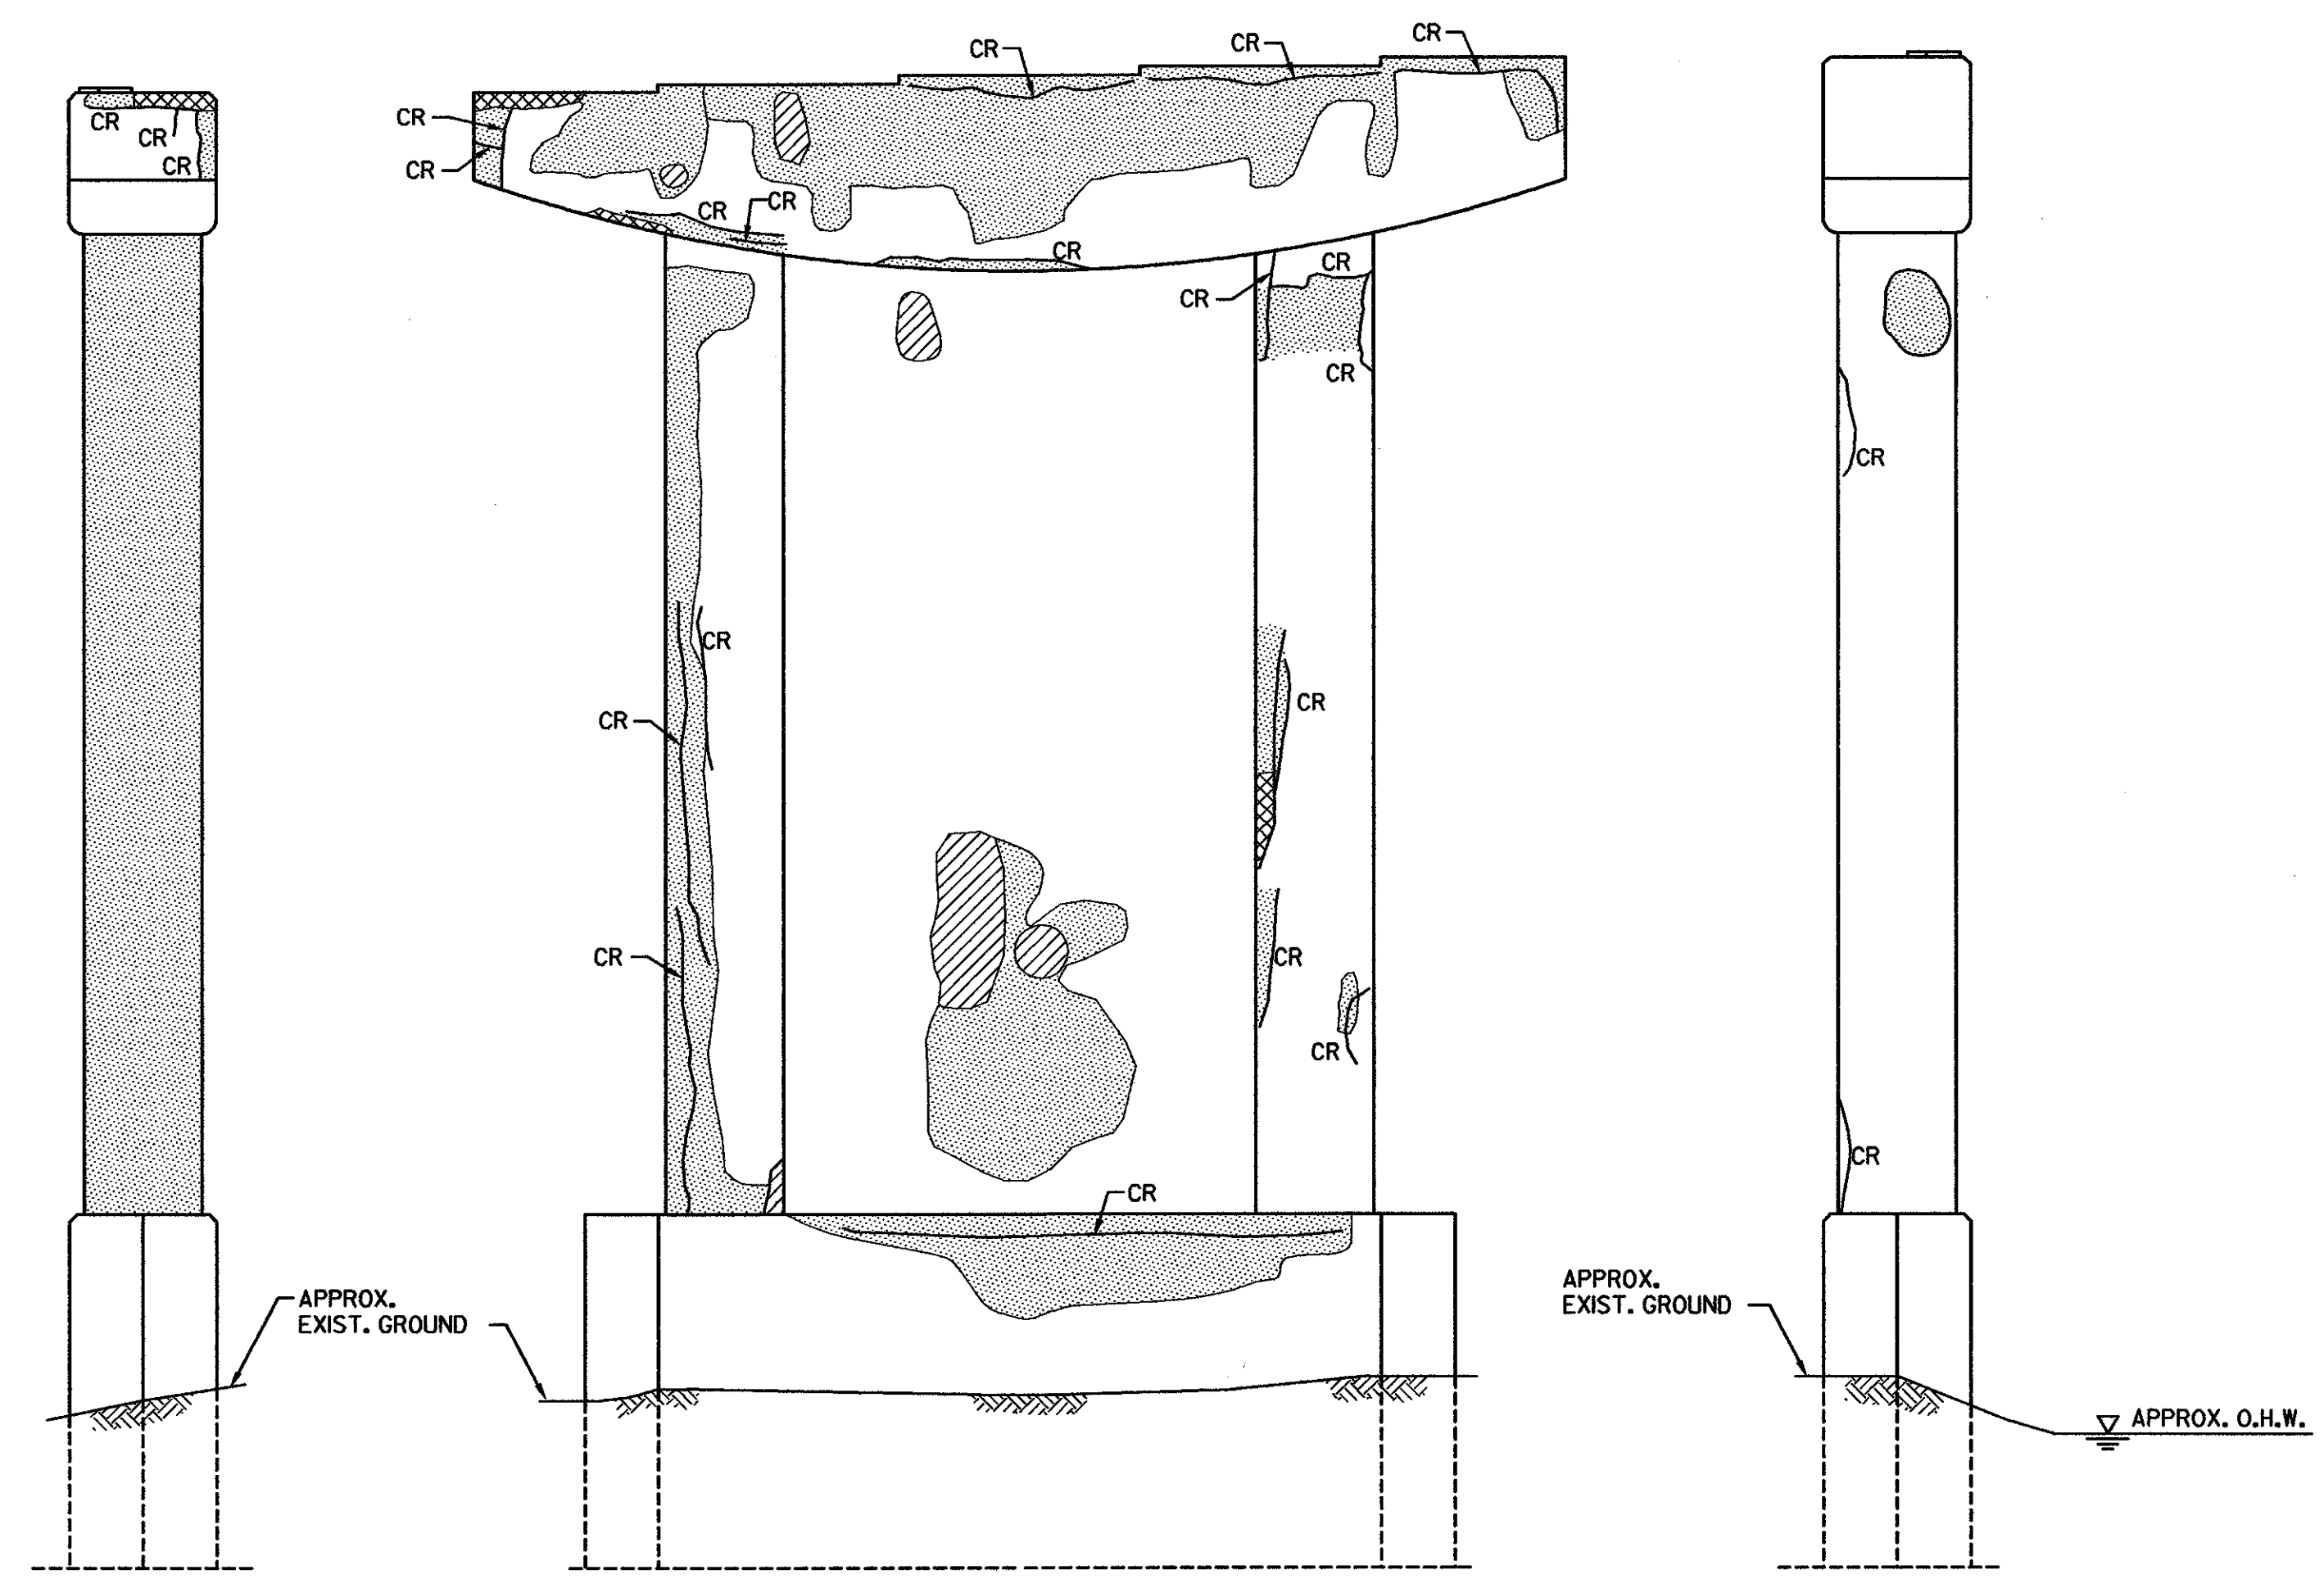


(ABUT. 1 SIDE)

**PIER 1 ELEVATION**  
SCALE: 3/16"=1'-0"

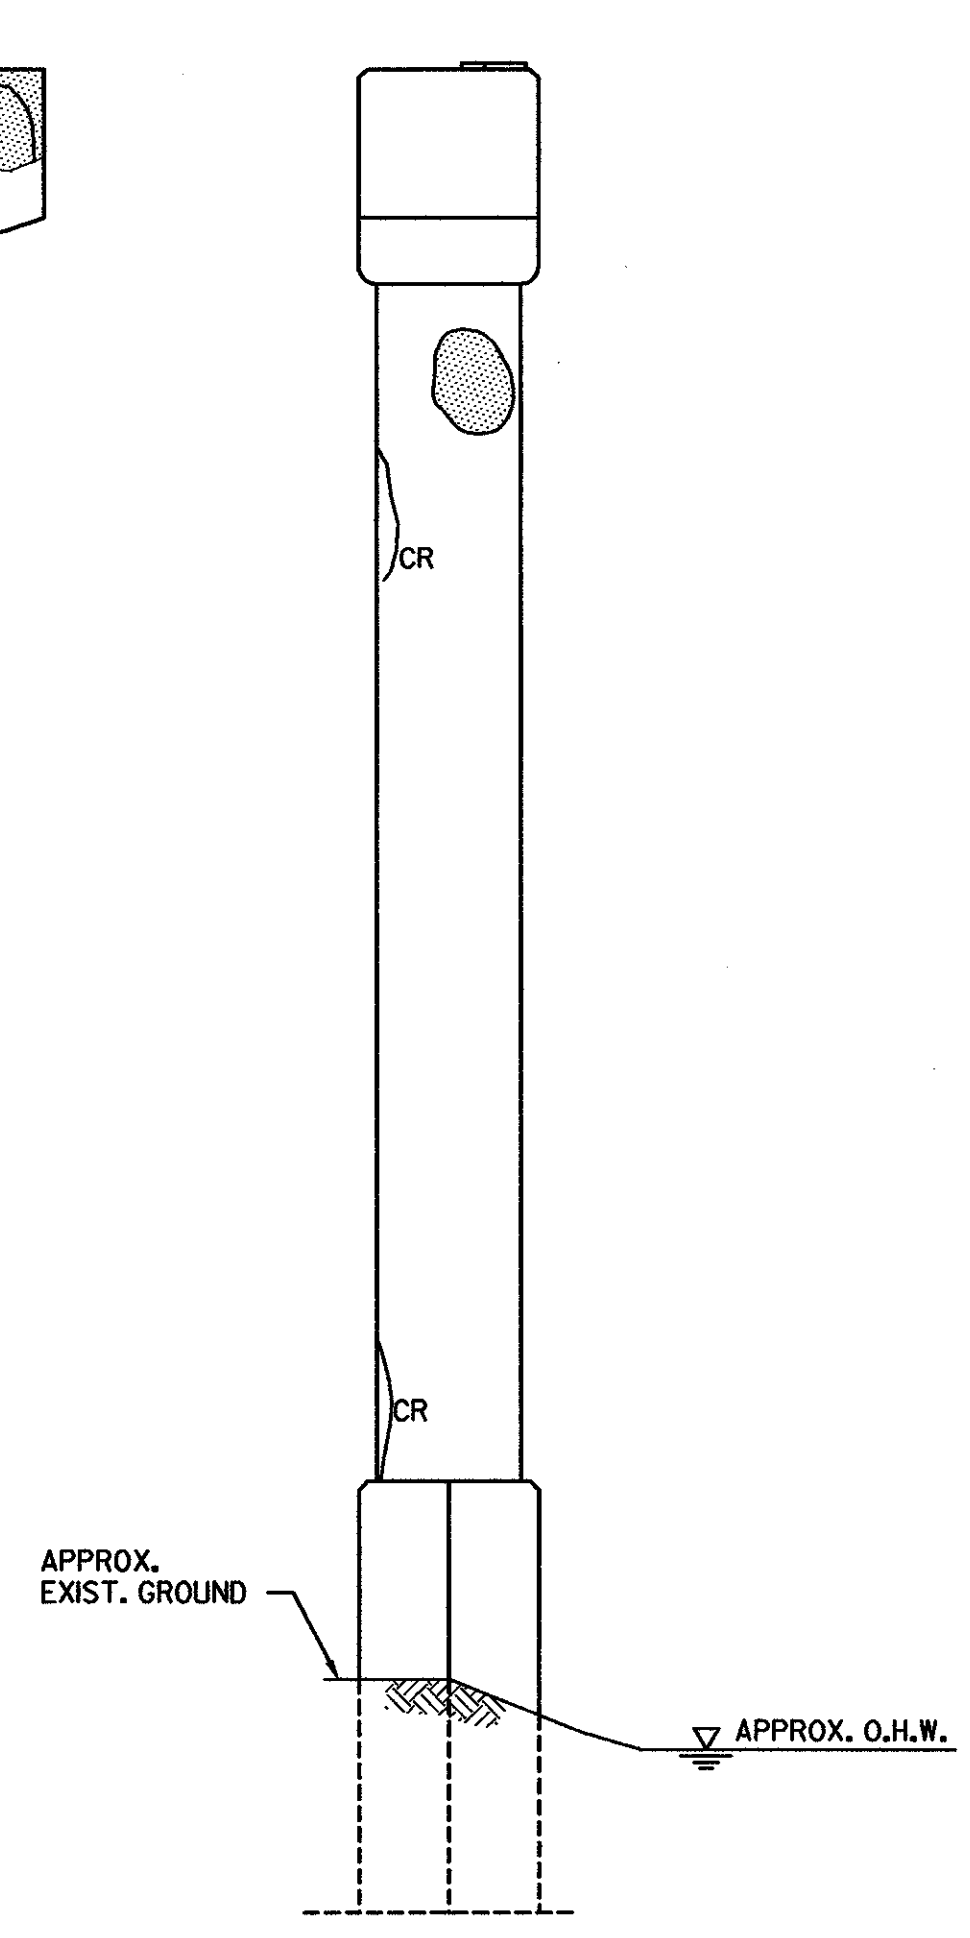


(PIER 2 SIDE)

**PIER 1 ELEVATION**  
SCALE: 3/16"=1'-0"

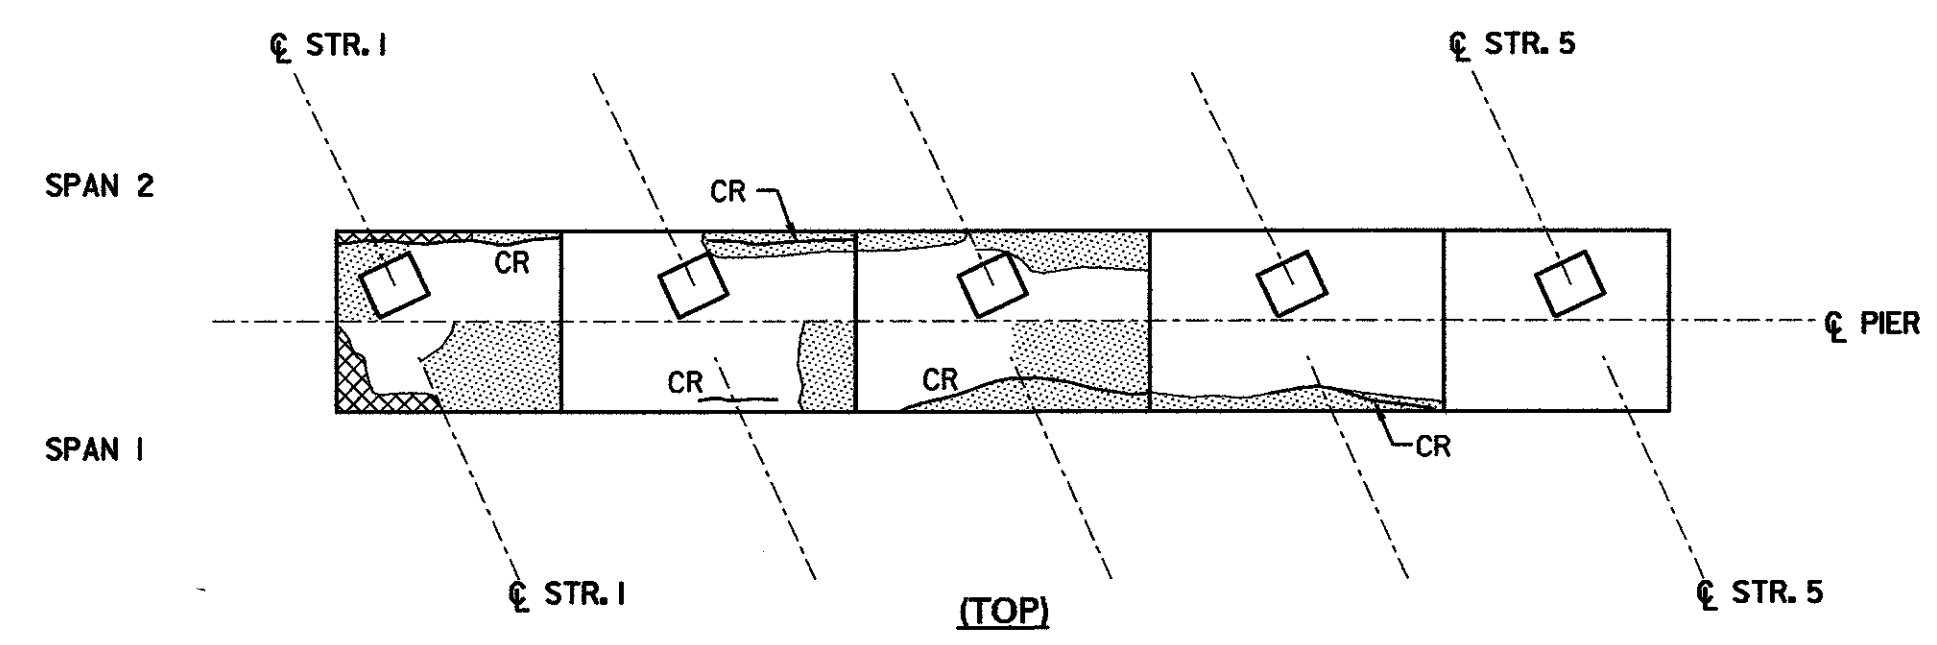


(TOP)

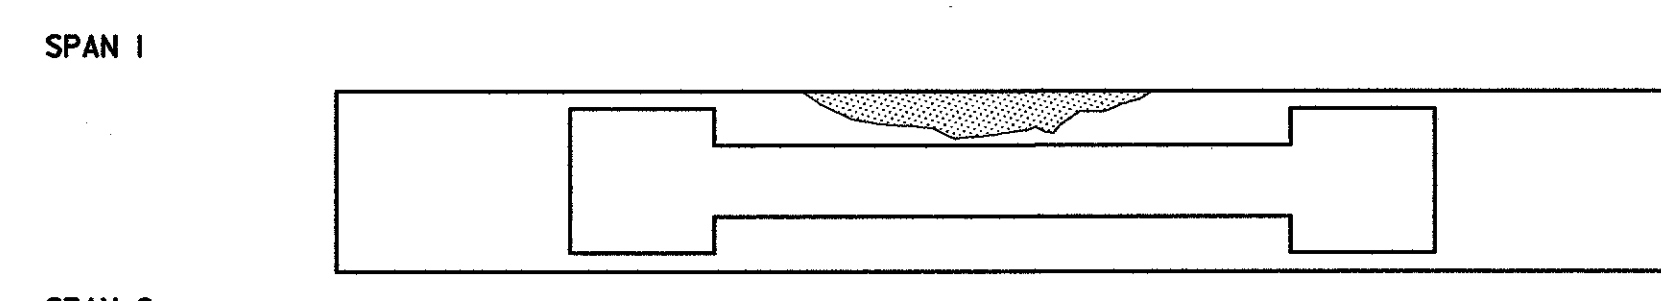

(BOTTOM)

**PIER 1 PLAN**  
SCALE: 3/16"=1'-0"

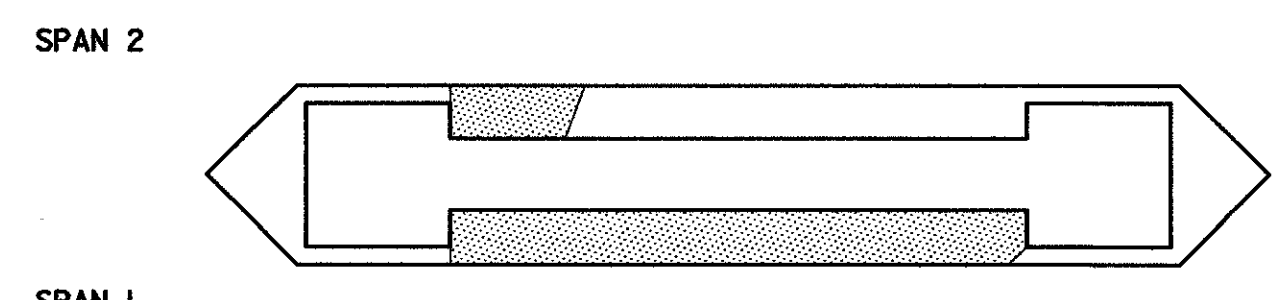

(TOP)

**PIER 1 BASE**  
SCALE: 3/16"=1'-0"


**ABBREVIATIONS**

CR CRACK  
PA PREVIOUSLY PATCHED AREA

**LEGEND**


CRACK [Symbol]  
DELAMINATED AREA [Symbol]  
SPALLED AREA [Symbol]  
DEEPLY SPALLED WITH EXPOSED REBAR [Symbol]  
EXISTING GROUND [Symbol]

<b>STATE OF VERMONT AGENCY OF TRANSPORTATION</b>			
Town Of	MIDDLESEX-BOLTON	Bridge No.	<b>48N</b>
Highway No.	I-89	Log Sta.	
		Surv. Sta.	
I-89 NB OVER LITTLE RIVER			
<b>EXIST. SUBSTR. CONDITION (48N) (1 OF 3)</b>			
Designed By	P.W. SZUSTAK	Drawn By	R.A. BOTZENHART
Checked By	Date	Bridge Design Supervisor	Date
J.P. HALSTEAD	10/99	J.P. HALSTEAD	10/99
PROJECT	MIDDLESEX-BOLTON	PROJECT NO.	IM-089-2(26)
TVGA CAD Drawing No.	48piers	Date	10/99
Bridge Sheet No.	SC-5	Sheet	139 of 307

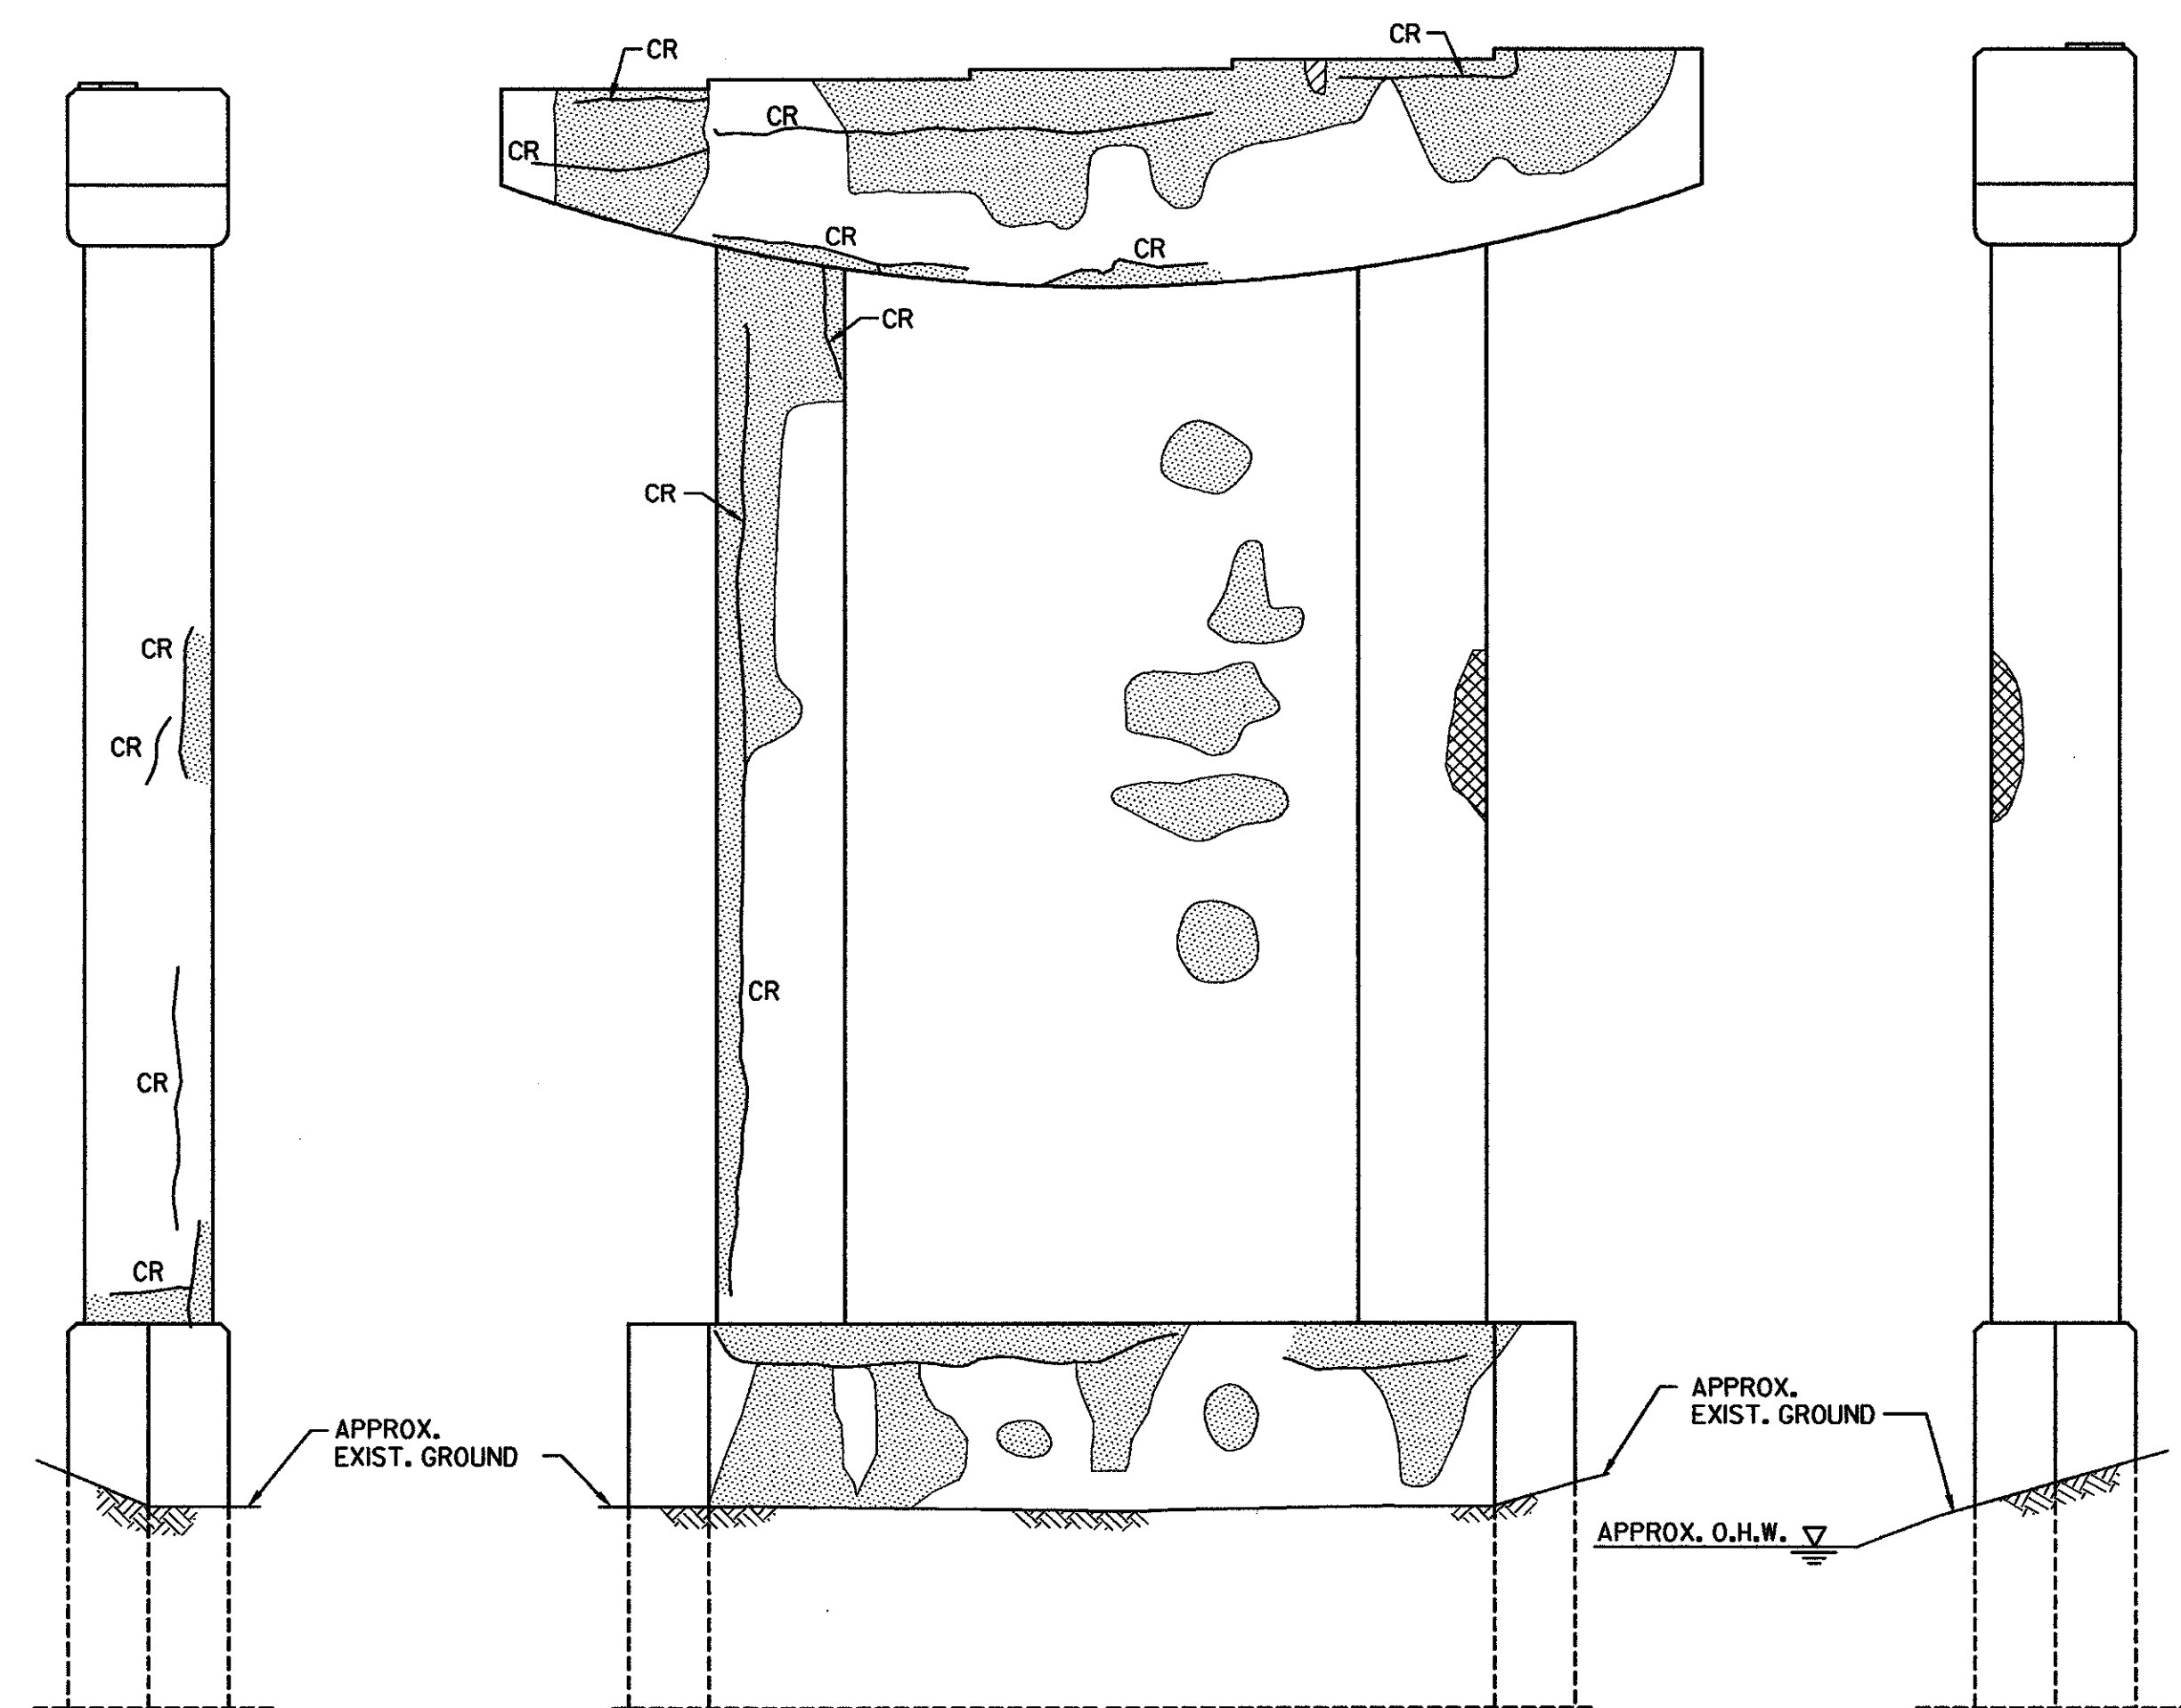


(PIER 1 SIDE)

**PIER 2 ELEVATION**  
SCALE: 3/16"=1'-0"

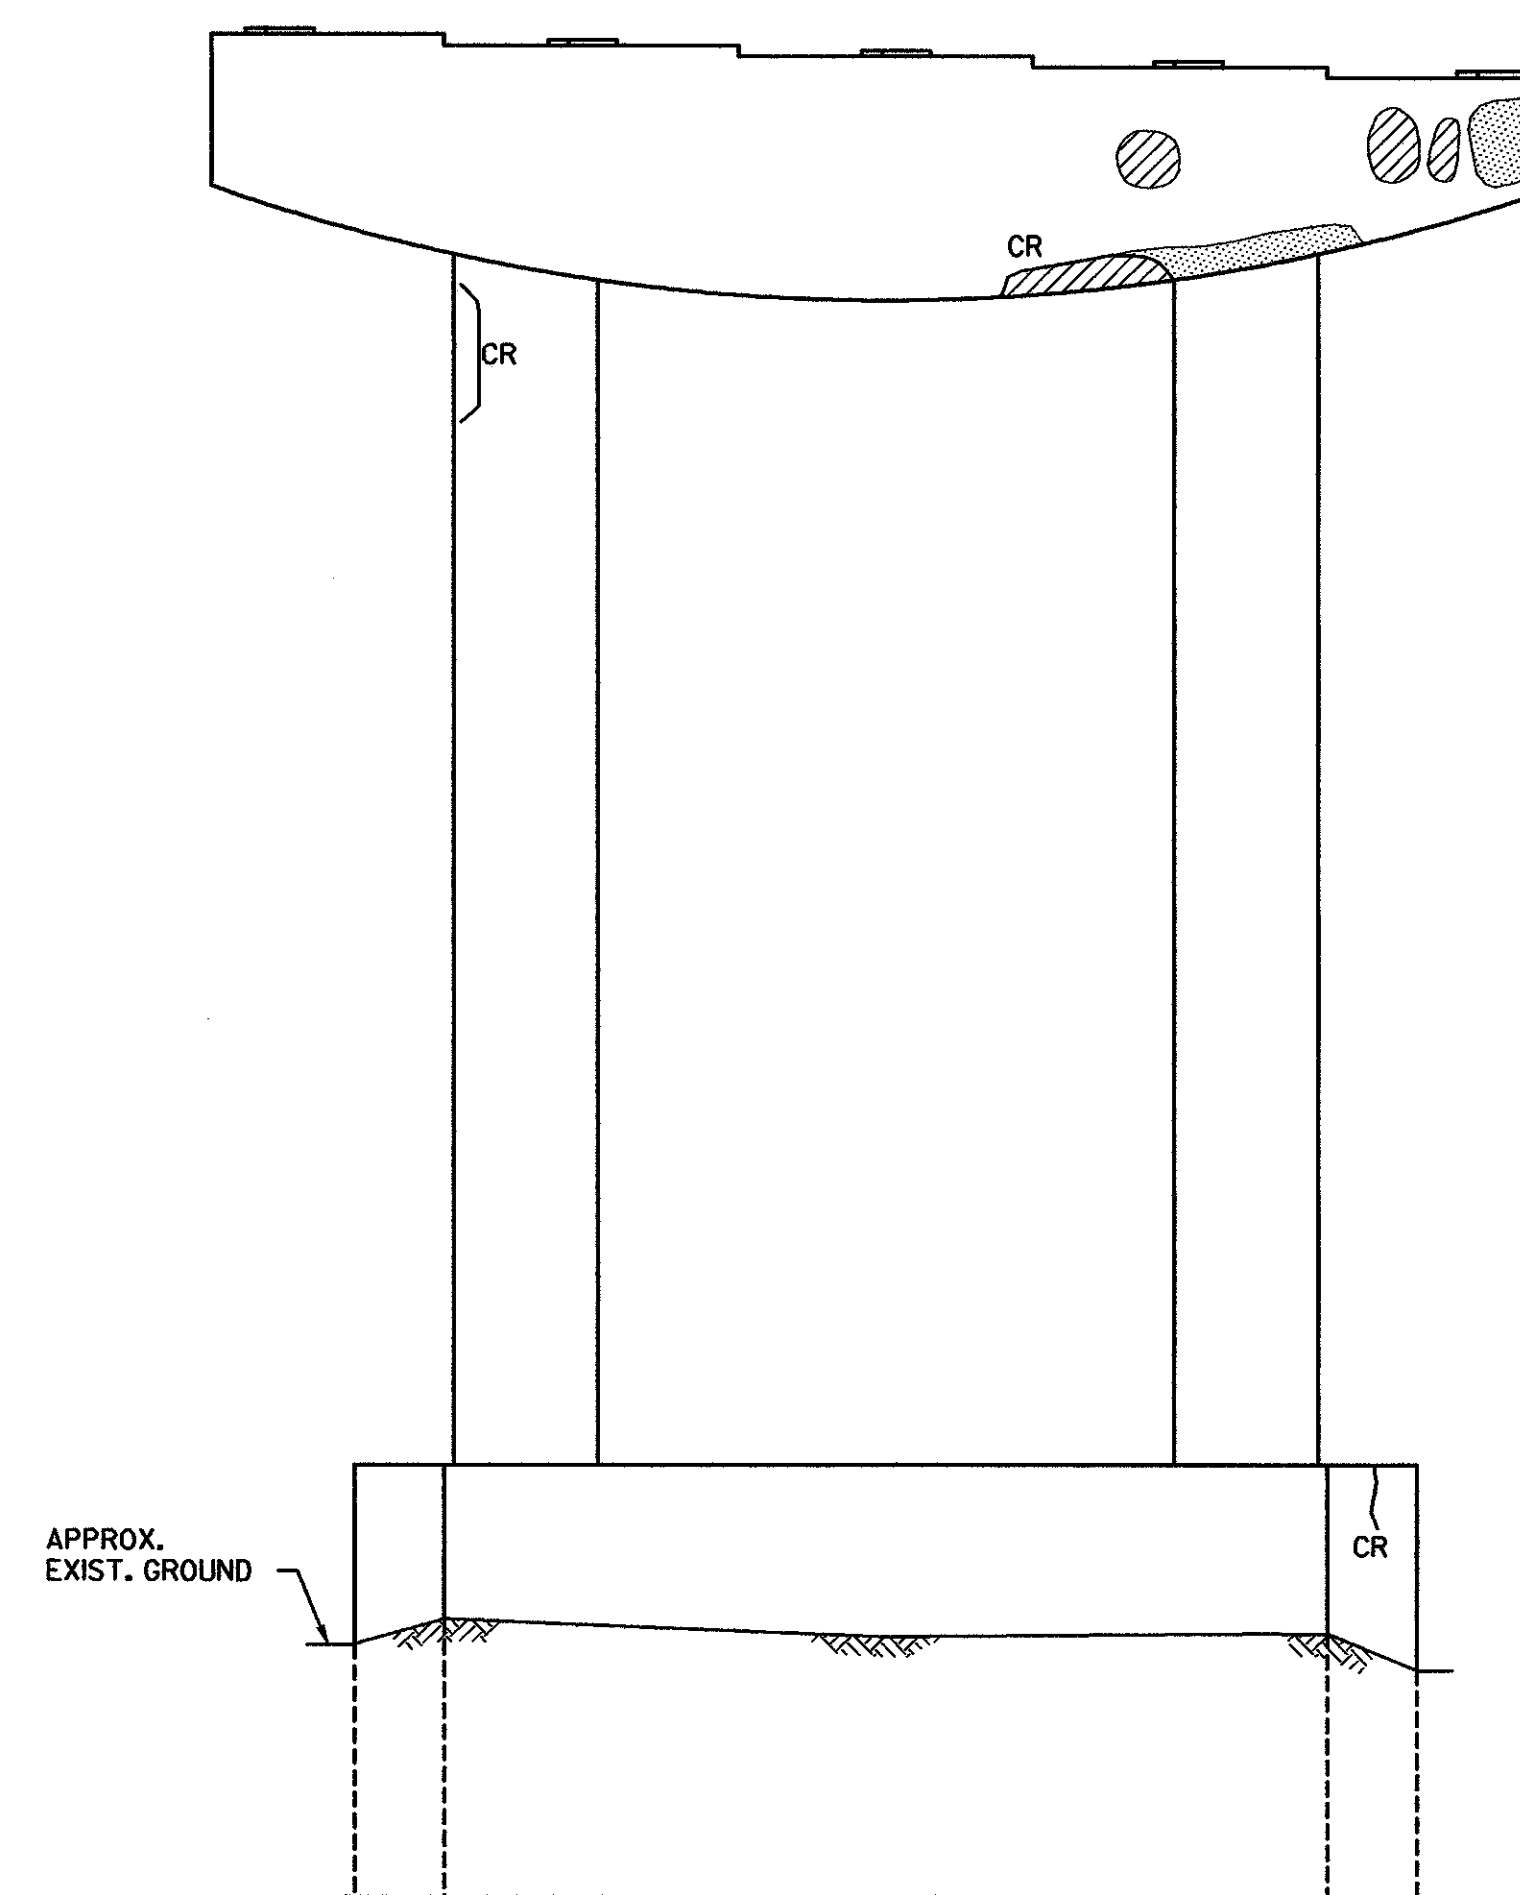


(ABUT. 2 SIDE)

**PIER 2 ELEVATION**  
SCALE: 3/16"=1'-0"

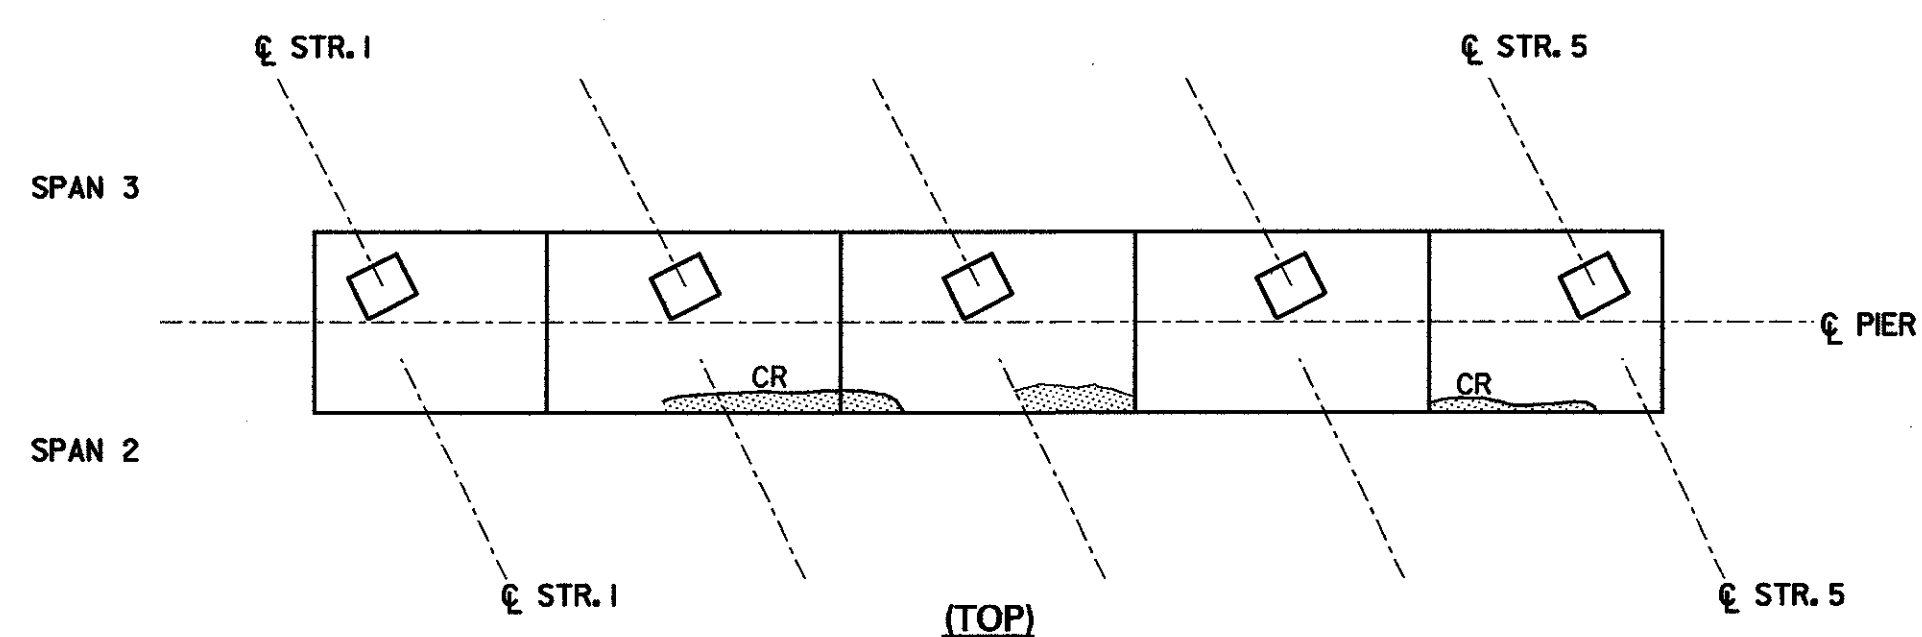


(TOP)

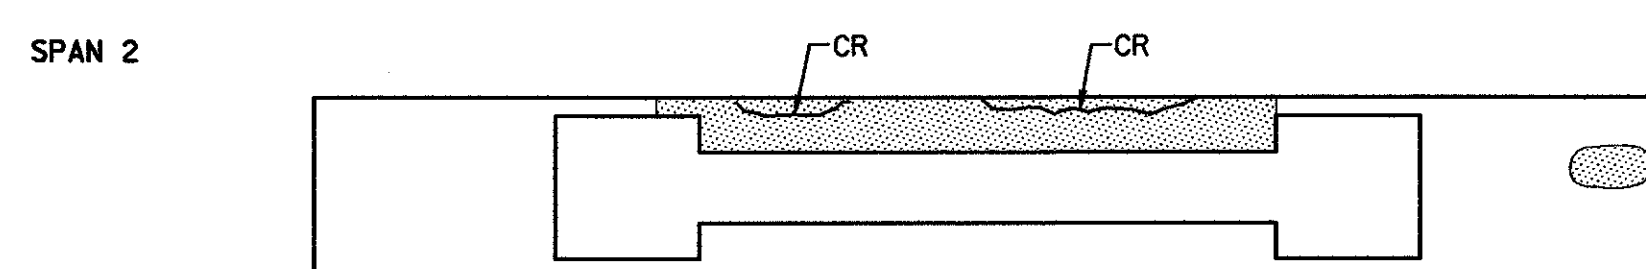

(BOTTOM)

**PIER 2 PLAN**  
SCALE: 3/16"=1'-0"

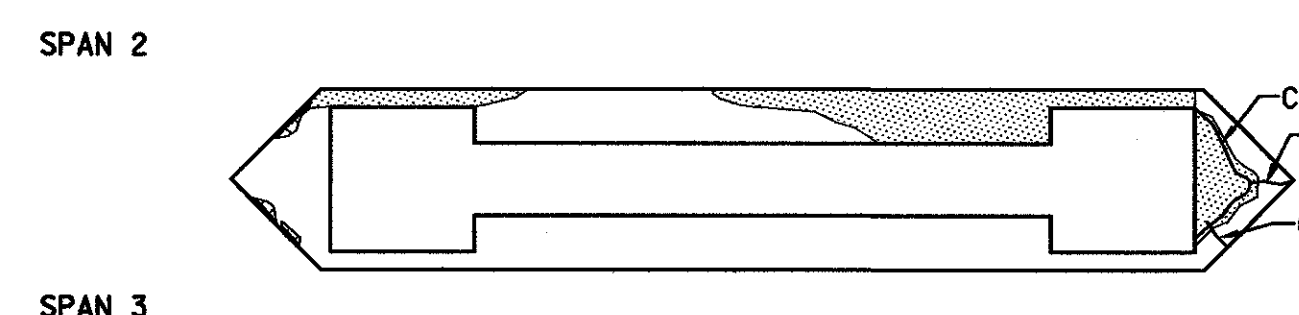

(TOP)

**PIER 2 BASE**  
SCALE: 3/16"=1'-0"

**ABBREVIATIONS**


CR CRACK  
PA PREVIOUSLY PATCHED AREA

**LEGEND**


CRACK  
DELAMINATED AREA  
SPALLED AREA  
DEEPLY SPALLED WITH EXPOSED REBAR  
EXISTING GROUND

**STATE OF VERMONT  
AGENCY OF TRANSPORTATION**

Town Of	MIDDLESEX-BOLTON	Bridge No.	<b>48N</b>
Highway No.	I-89	Log Sta.	
		Surv. Sta.	
I-89 NB OVER LITTLE RIVER			
<b>EXIST. SUBSTR. CONDITION (48N) (2 OF 3)</b>			
Designed By	P.W. SZUSTAK	Drawn By	R.A. BOTZENHART
Checked By	J.P. HALSTEAD	Bridge Design Supervisor	J.P. HALSTEAD
Date	10/99	Date	10/99
PROJECT	MIDDLESEX-BOLTON	PROJECT NO.	IM-089-2(26)
TVGA CAD Drawing No.	48piers	Date	10/99
Bridge Sheet No.	SC-6	Sheet	140 of 307

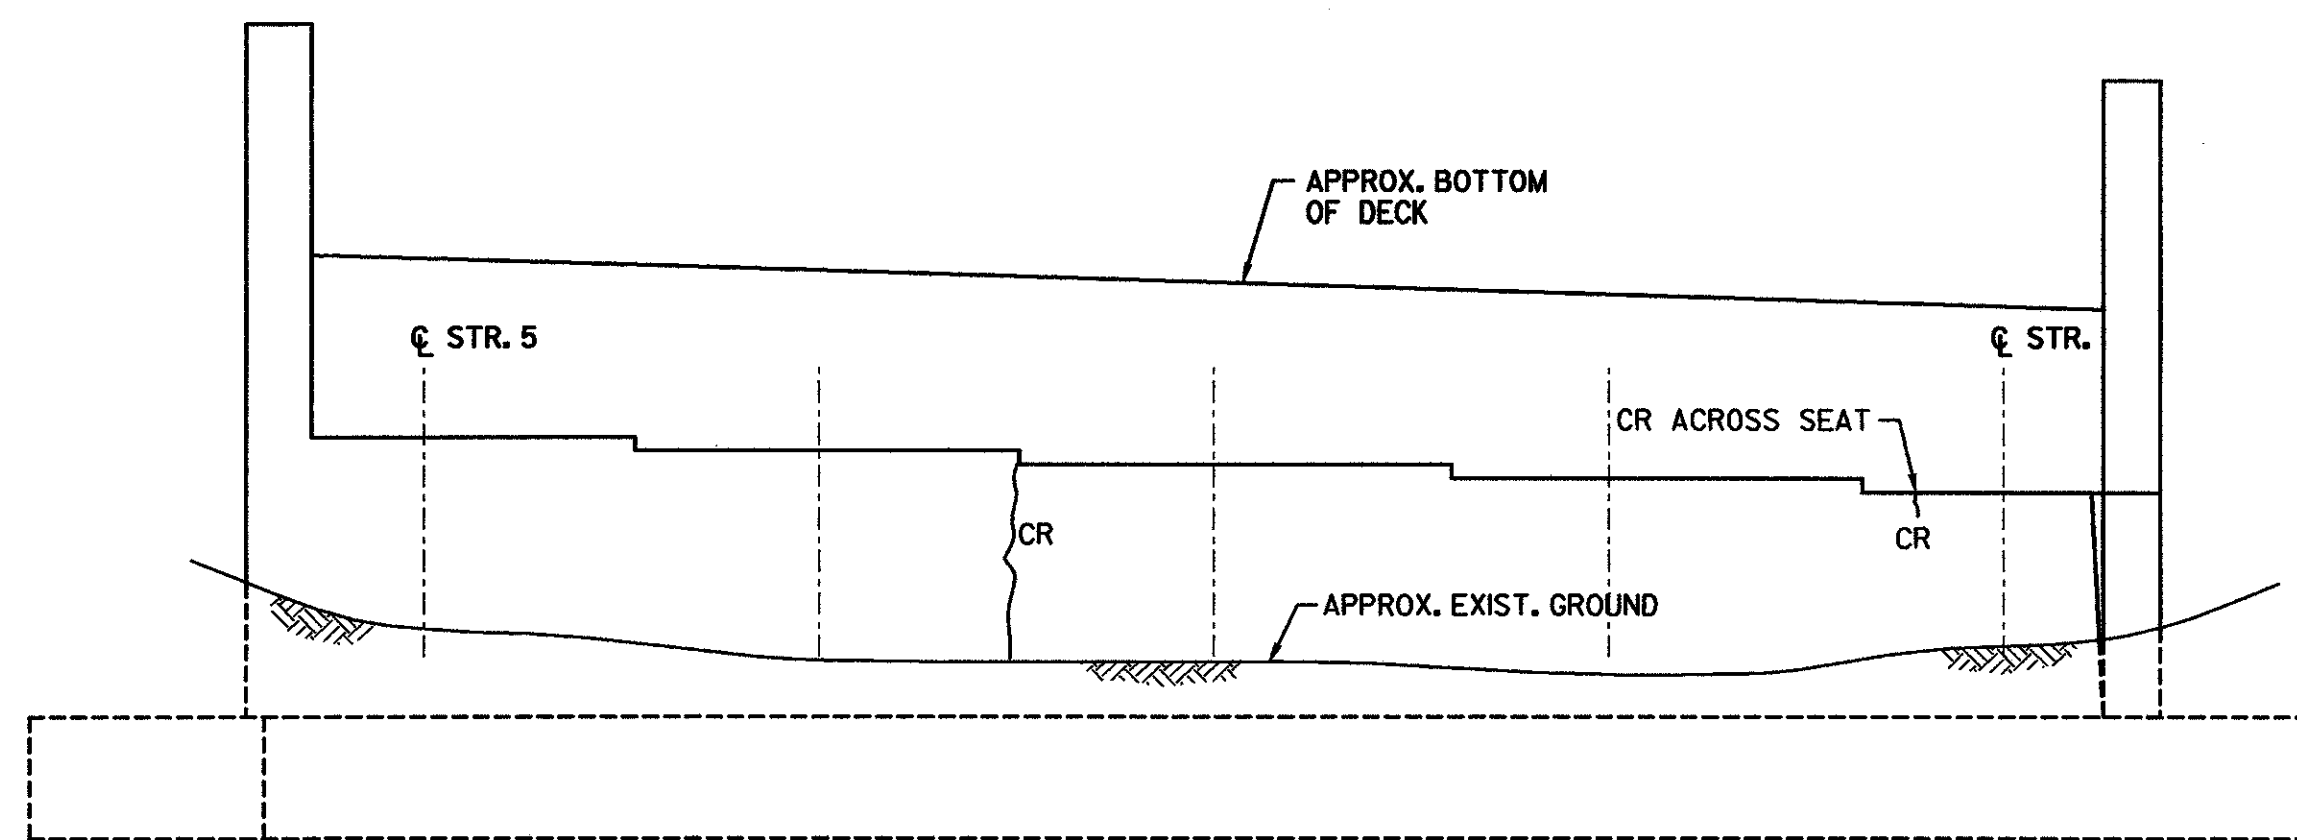

**ABUT 1 ELEVATION**  
SCALE: 1/4"=1'-0"

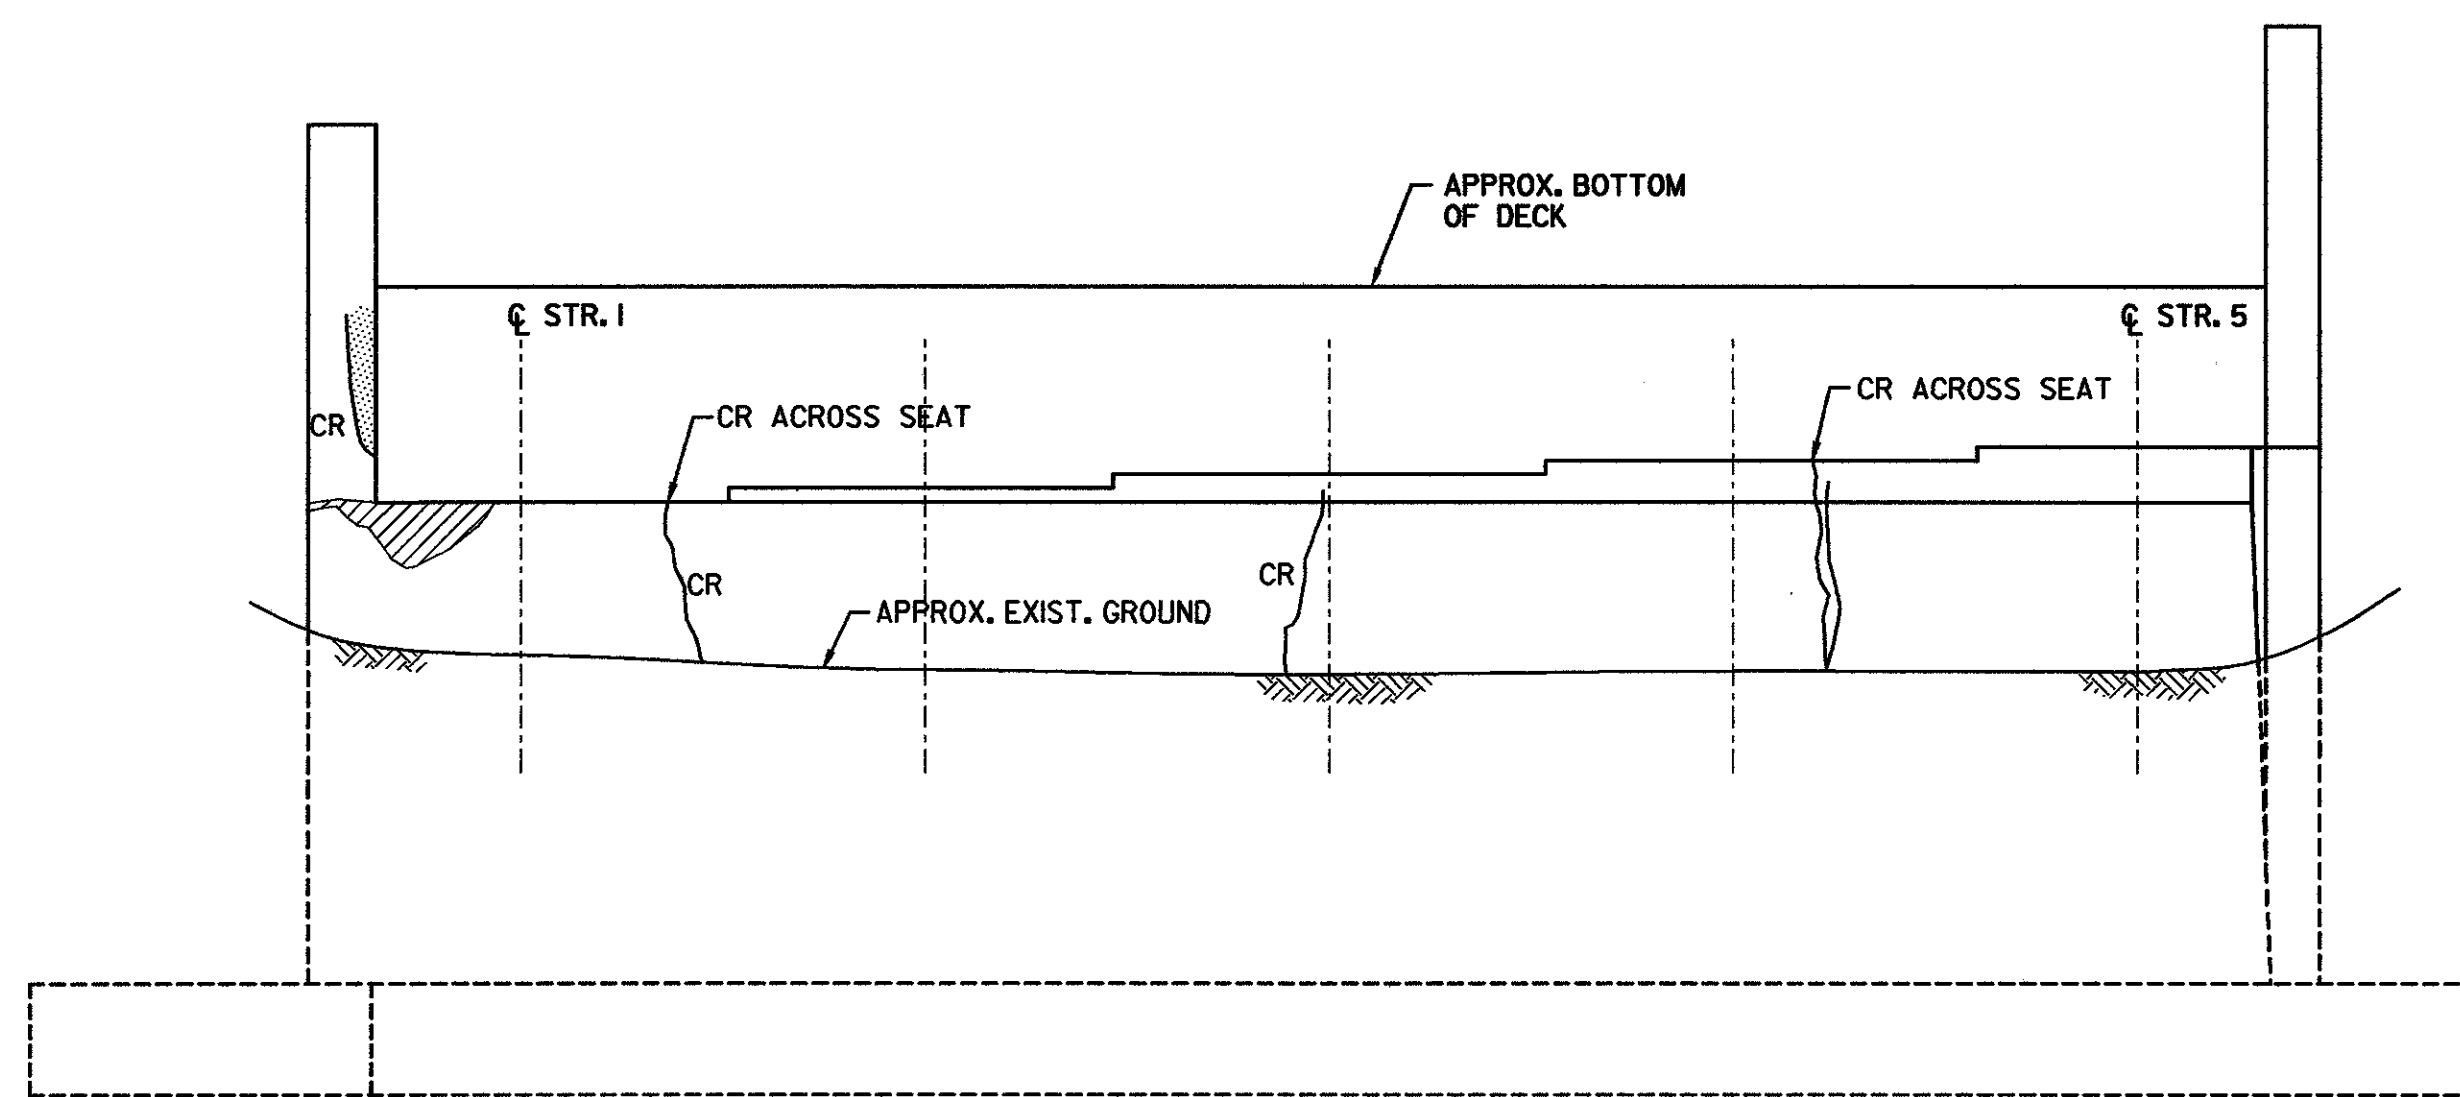

**ABUT 2 ELEVATION**  
SCALE: 1/4"=1'-0"

**ABBREVIATIONS**  
CR CRACK  
PA PREVIOUSLY PATCHED AREA

**LEGEND**  
CRACK  
DELAMINATED AREA  
SPALLED AREA  
DEEPLY SPALLED WITH EXPOSED REBAR  
EXISTING GROUND

**STATE OF VERMONT  
AGENCY OF TRANSPORTATION**

Town Of	MIDDLESEX-BOLTON	Bridge No.	48N
Highway No.	I-89	Log Sta.	
		Surv. Sta.	

I-89 NB OVER LITTLE RIVER


**EXIST. SUBSTR. CONDITION (48N) (3 OF 3)**

Designed By	P.W. SZUSTAK	Drawn By	R.A. BOTZENHART
Checked By	Date	Bridge Design Supervisor	Date
J.P. HALSTEAD	10/99	J.P. HALSTEAD	10/99


PROJECT	MIDDLESEX-BOLTON	PROJECT NO.	IM-089-2(26)
---------	------------------	-------------	--------------

TVGA CAD Drawing No.	48abut	Date	10/99
----------------------	--------	------	-------


Bridge Sheet No.	SC-7	Sheet	141 of 307
------------------	------	-------	------------

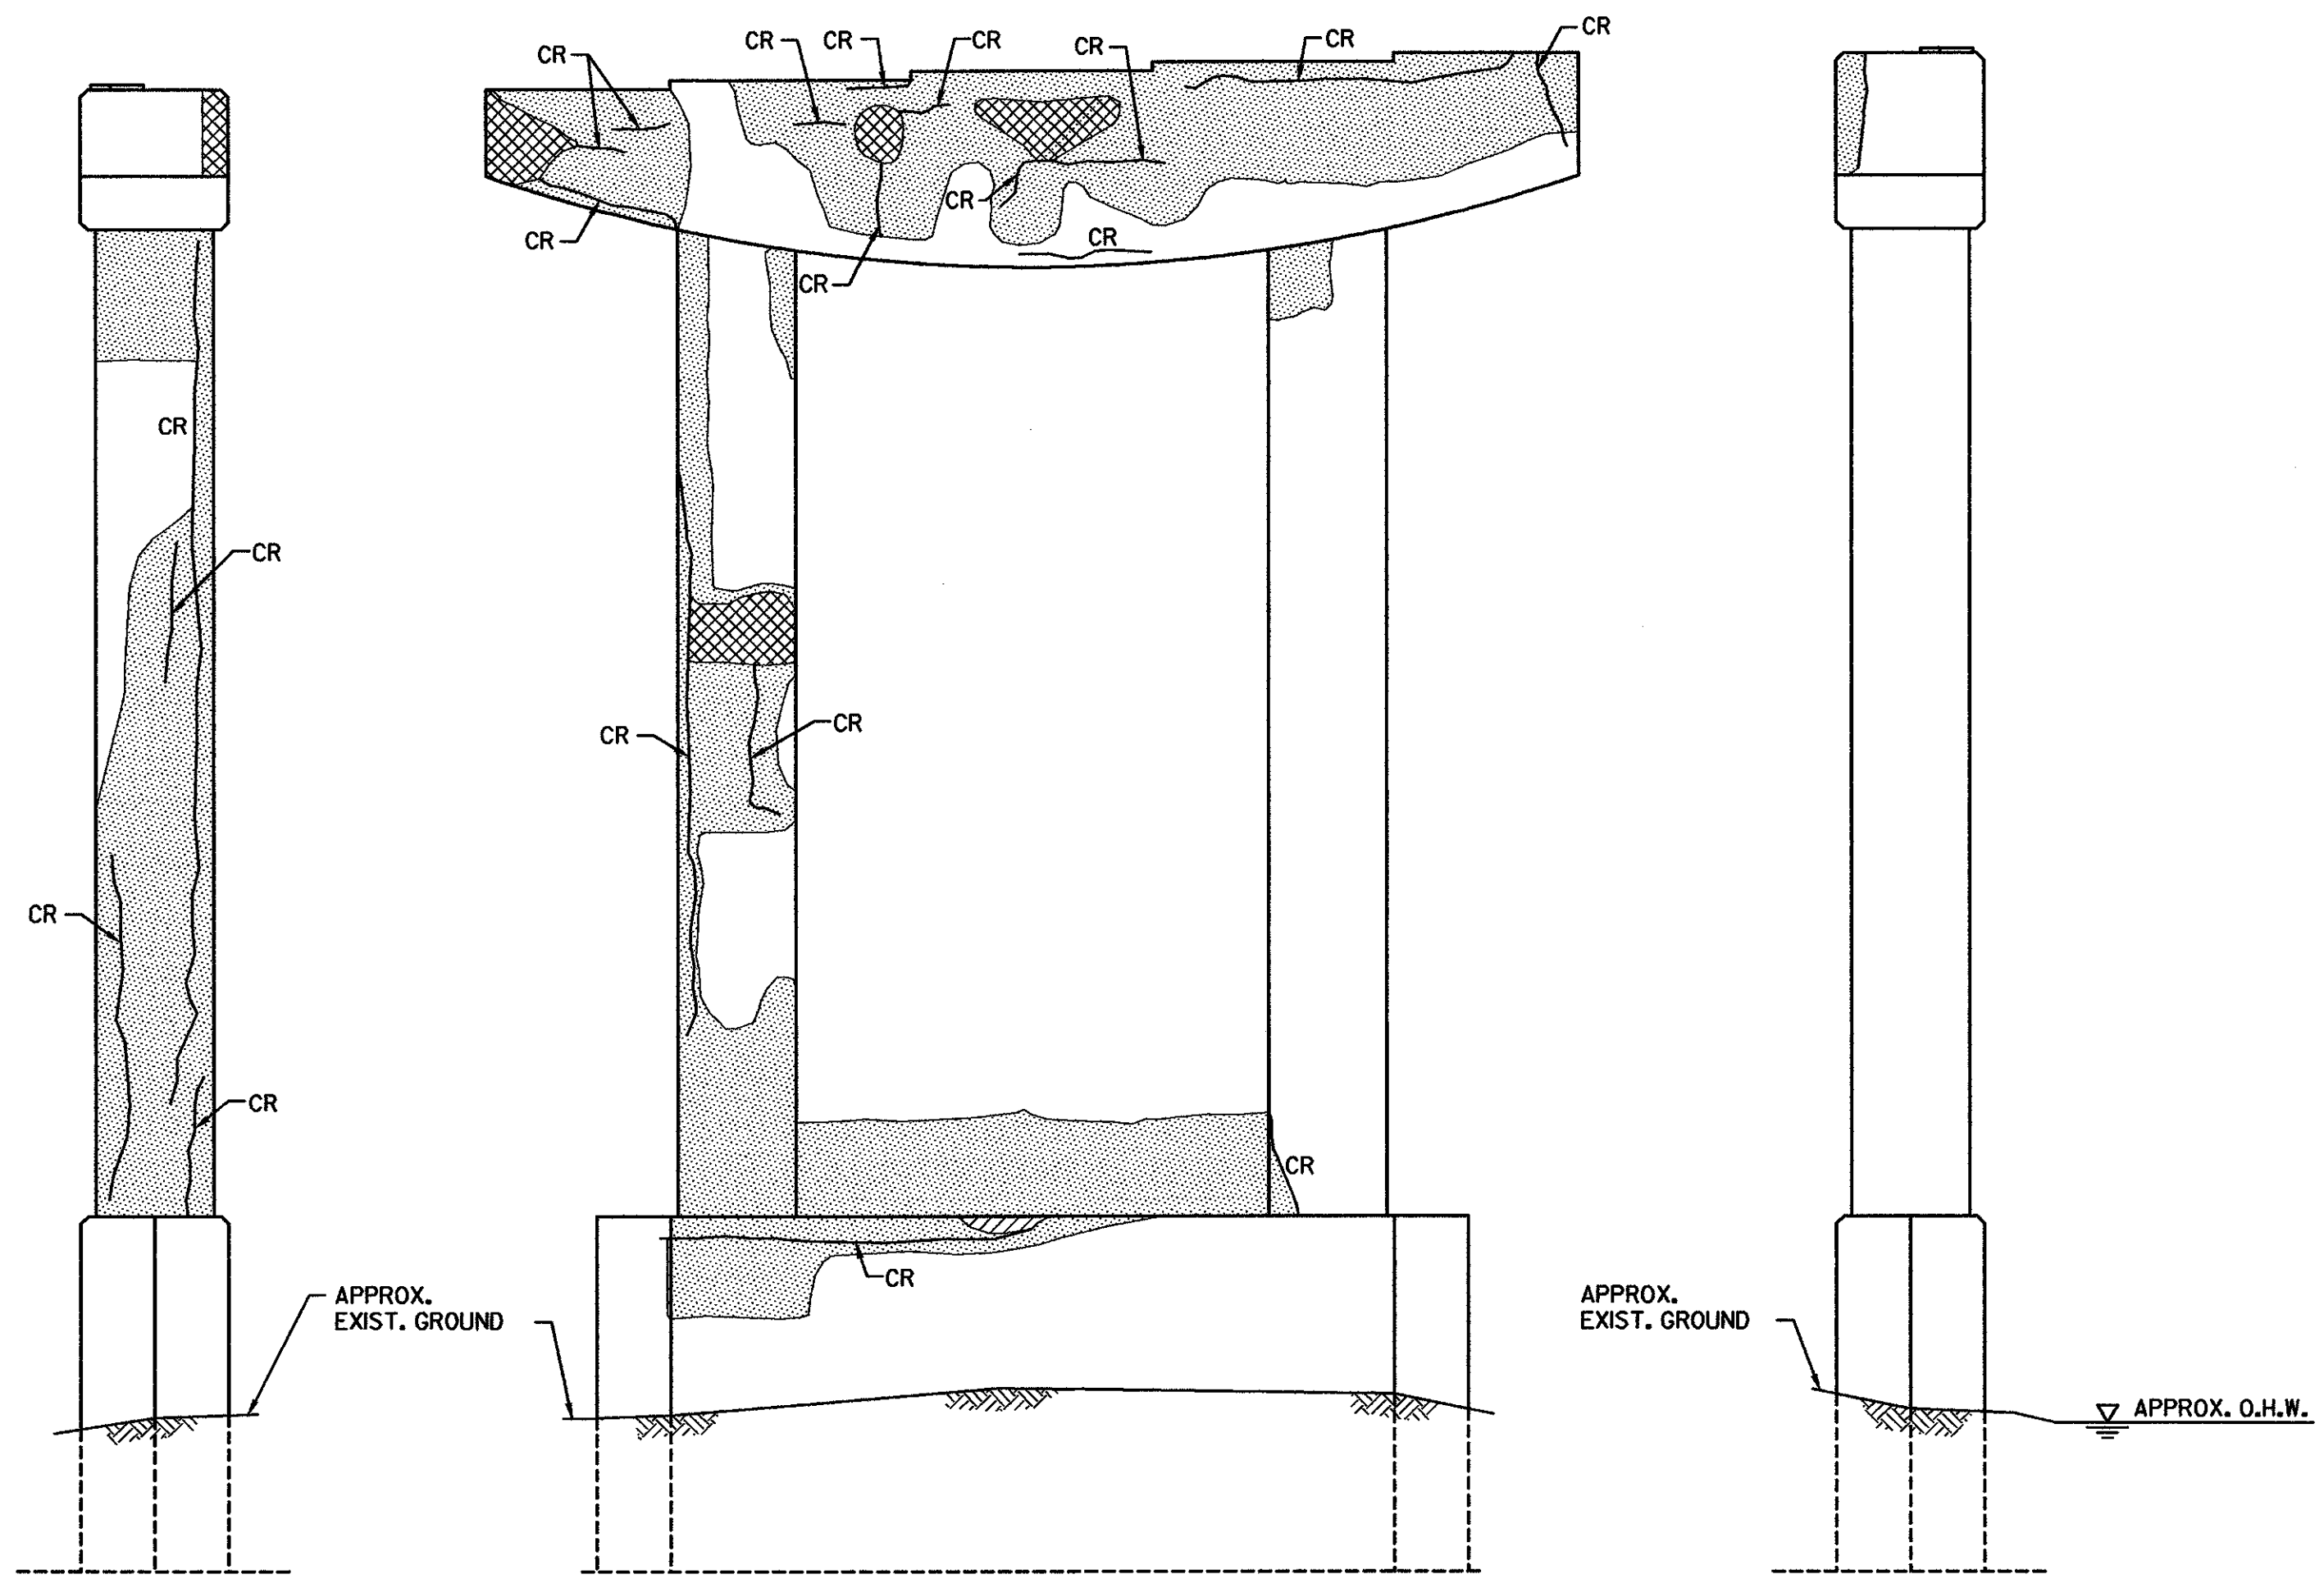


(ABUT. 1 SIDE)  
**PIER 1 ELEVATION**  
 SCALE: 3/16"=1'-0"

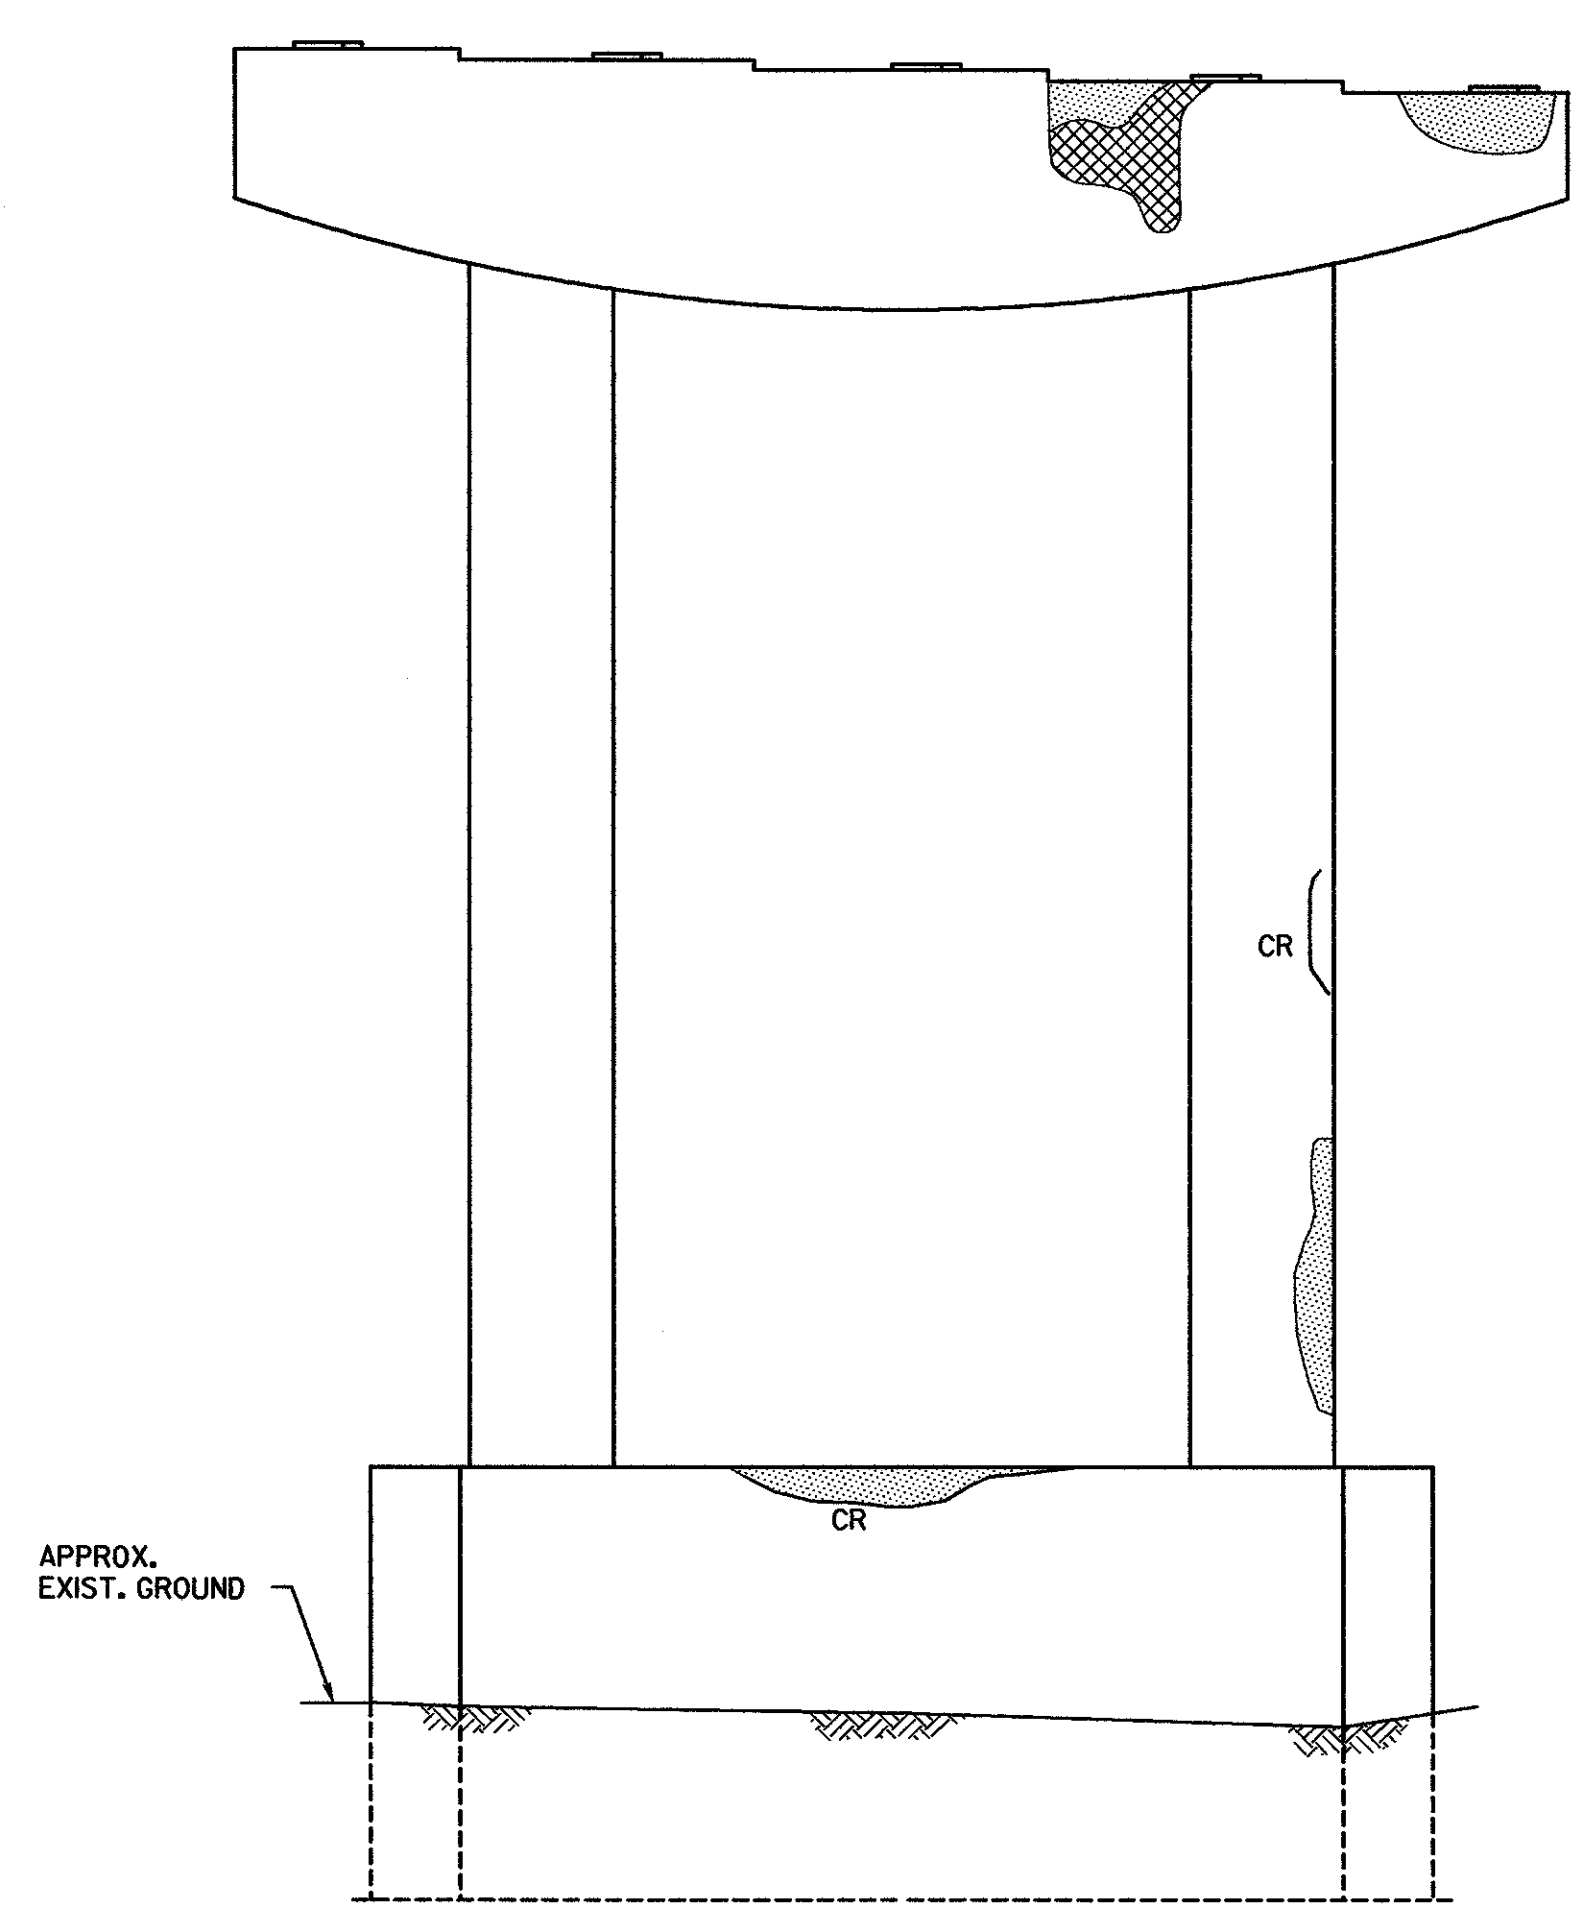

(PIER 2 SIDE)  
**PIER 1 ELEVATION**  
 SCALE: 3/16"=1'-0"

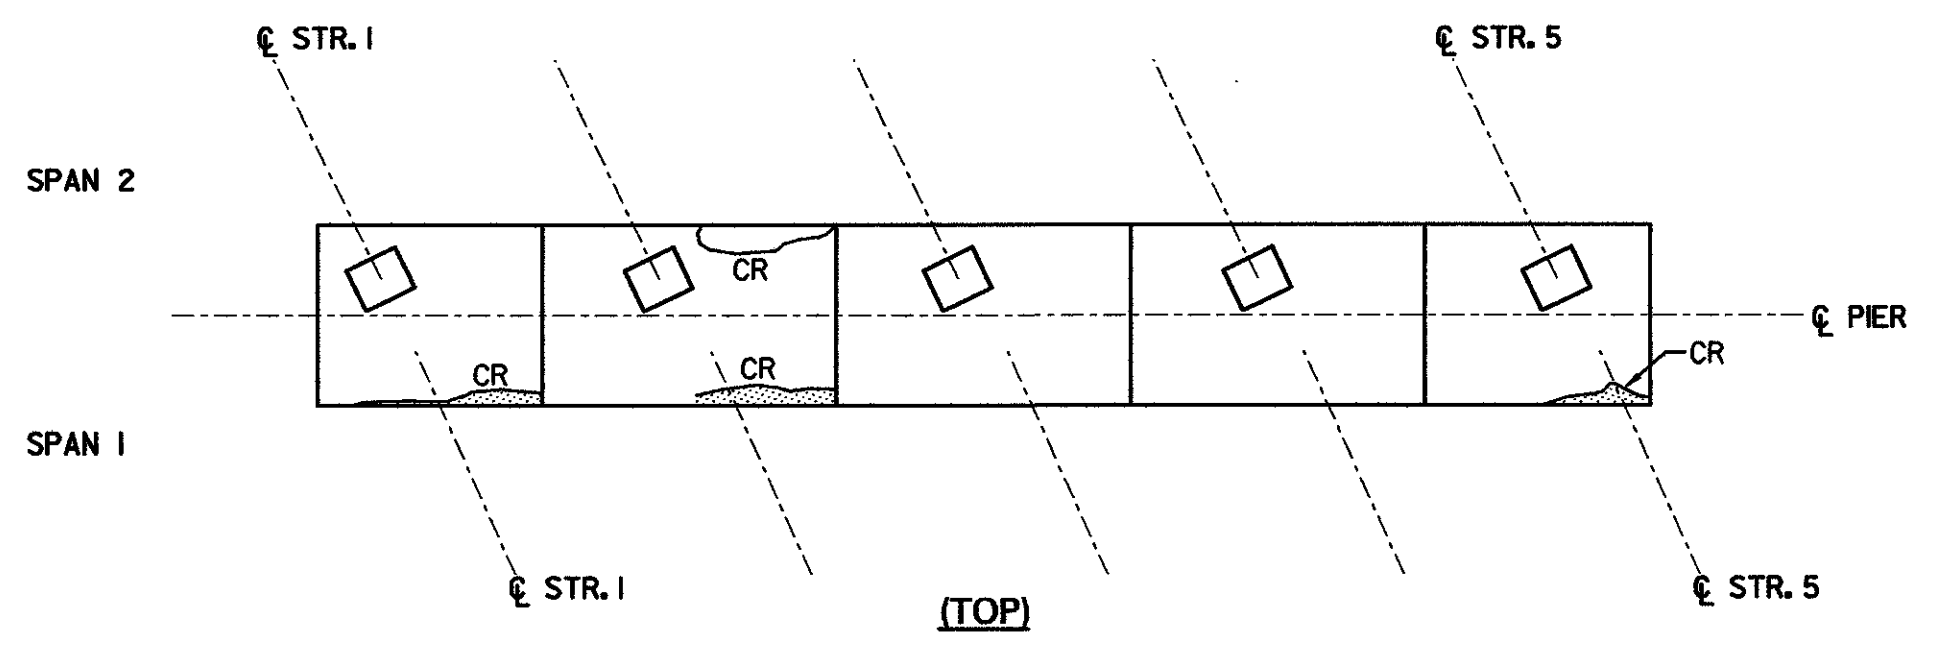


(TOP)

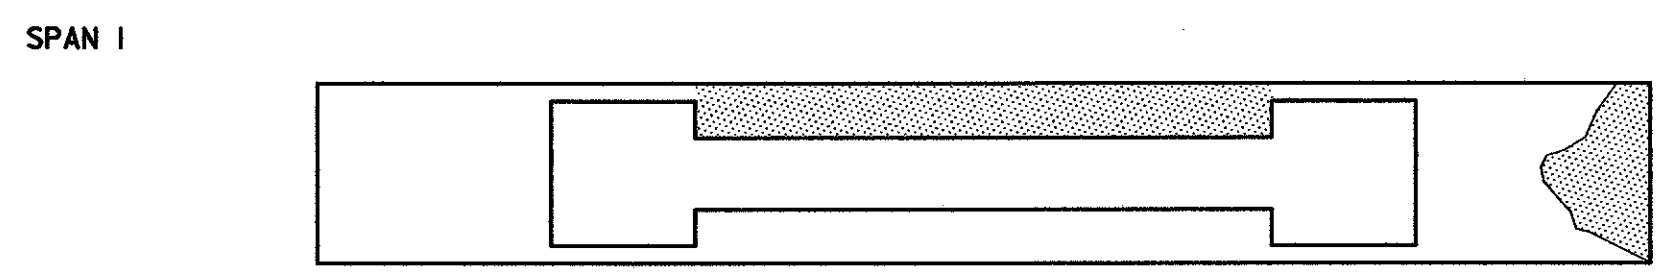

(BOTTOM)

**PIER 1 CAP**  
 SCALE: 3/16"=1'-0"

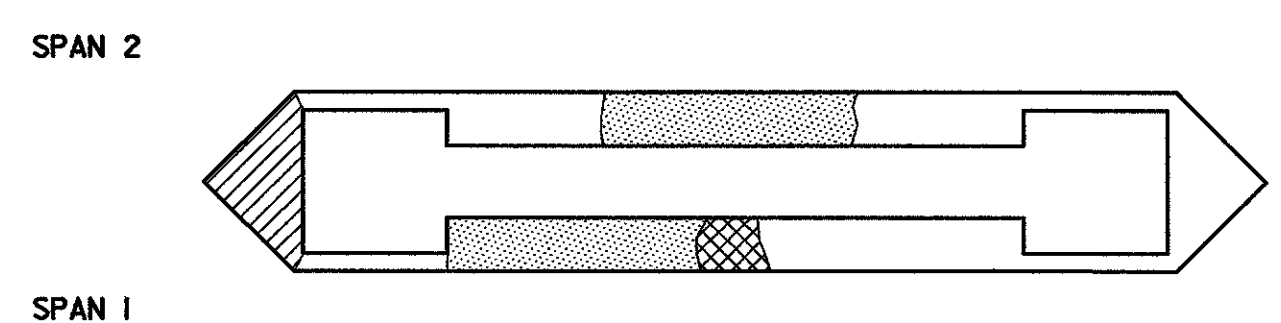


(TOP)

**PIER 1 BASE**  
 SCALE: 3/16"=1'-0"


- ABBREVIATIONS**
- CR CRACK
  - PA PREVIOUSLY PATCHED AREA
- LEGEND**
- CRACK
  - DELAMINATED AREA
  - SPALLED AREA
  - DEEPLY SPALLED WITH EXPOSED REBAR
  - EXISTING GROUND

**STATE OF VERMONT  
 AGENCY OF TRANSPORTATION**


Town Of	MIDDLESEX-BOLTON	Bridge No.	<b>485</b>
Highway No.	I-89	Log Sta.	
		Surv. Sta.	
I-89 SB OVER LITTLE RIVER			
<b>EXIST. SUBSTR. CONDITION (485) (1 OF 3)</b>			
Designed By	P.W. SZUSTAK	Drawn By	R.A. BOTZENHART
Checked By	J.P. HALSTEAD	Date	10/99
		Bridge Design Supervisor	J.P. HALSTEAD Date 10/99
PROJECT	MIDDLESEX-BOLTON	PROJECT NO.	IM-089-2(26)
TVGA CAD Drawing No.	48piers	Date	10/99
Bridge Sheet No.	SC-8	Sheet	142 of 307

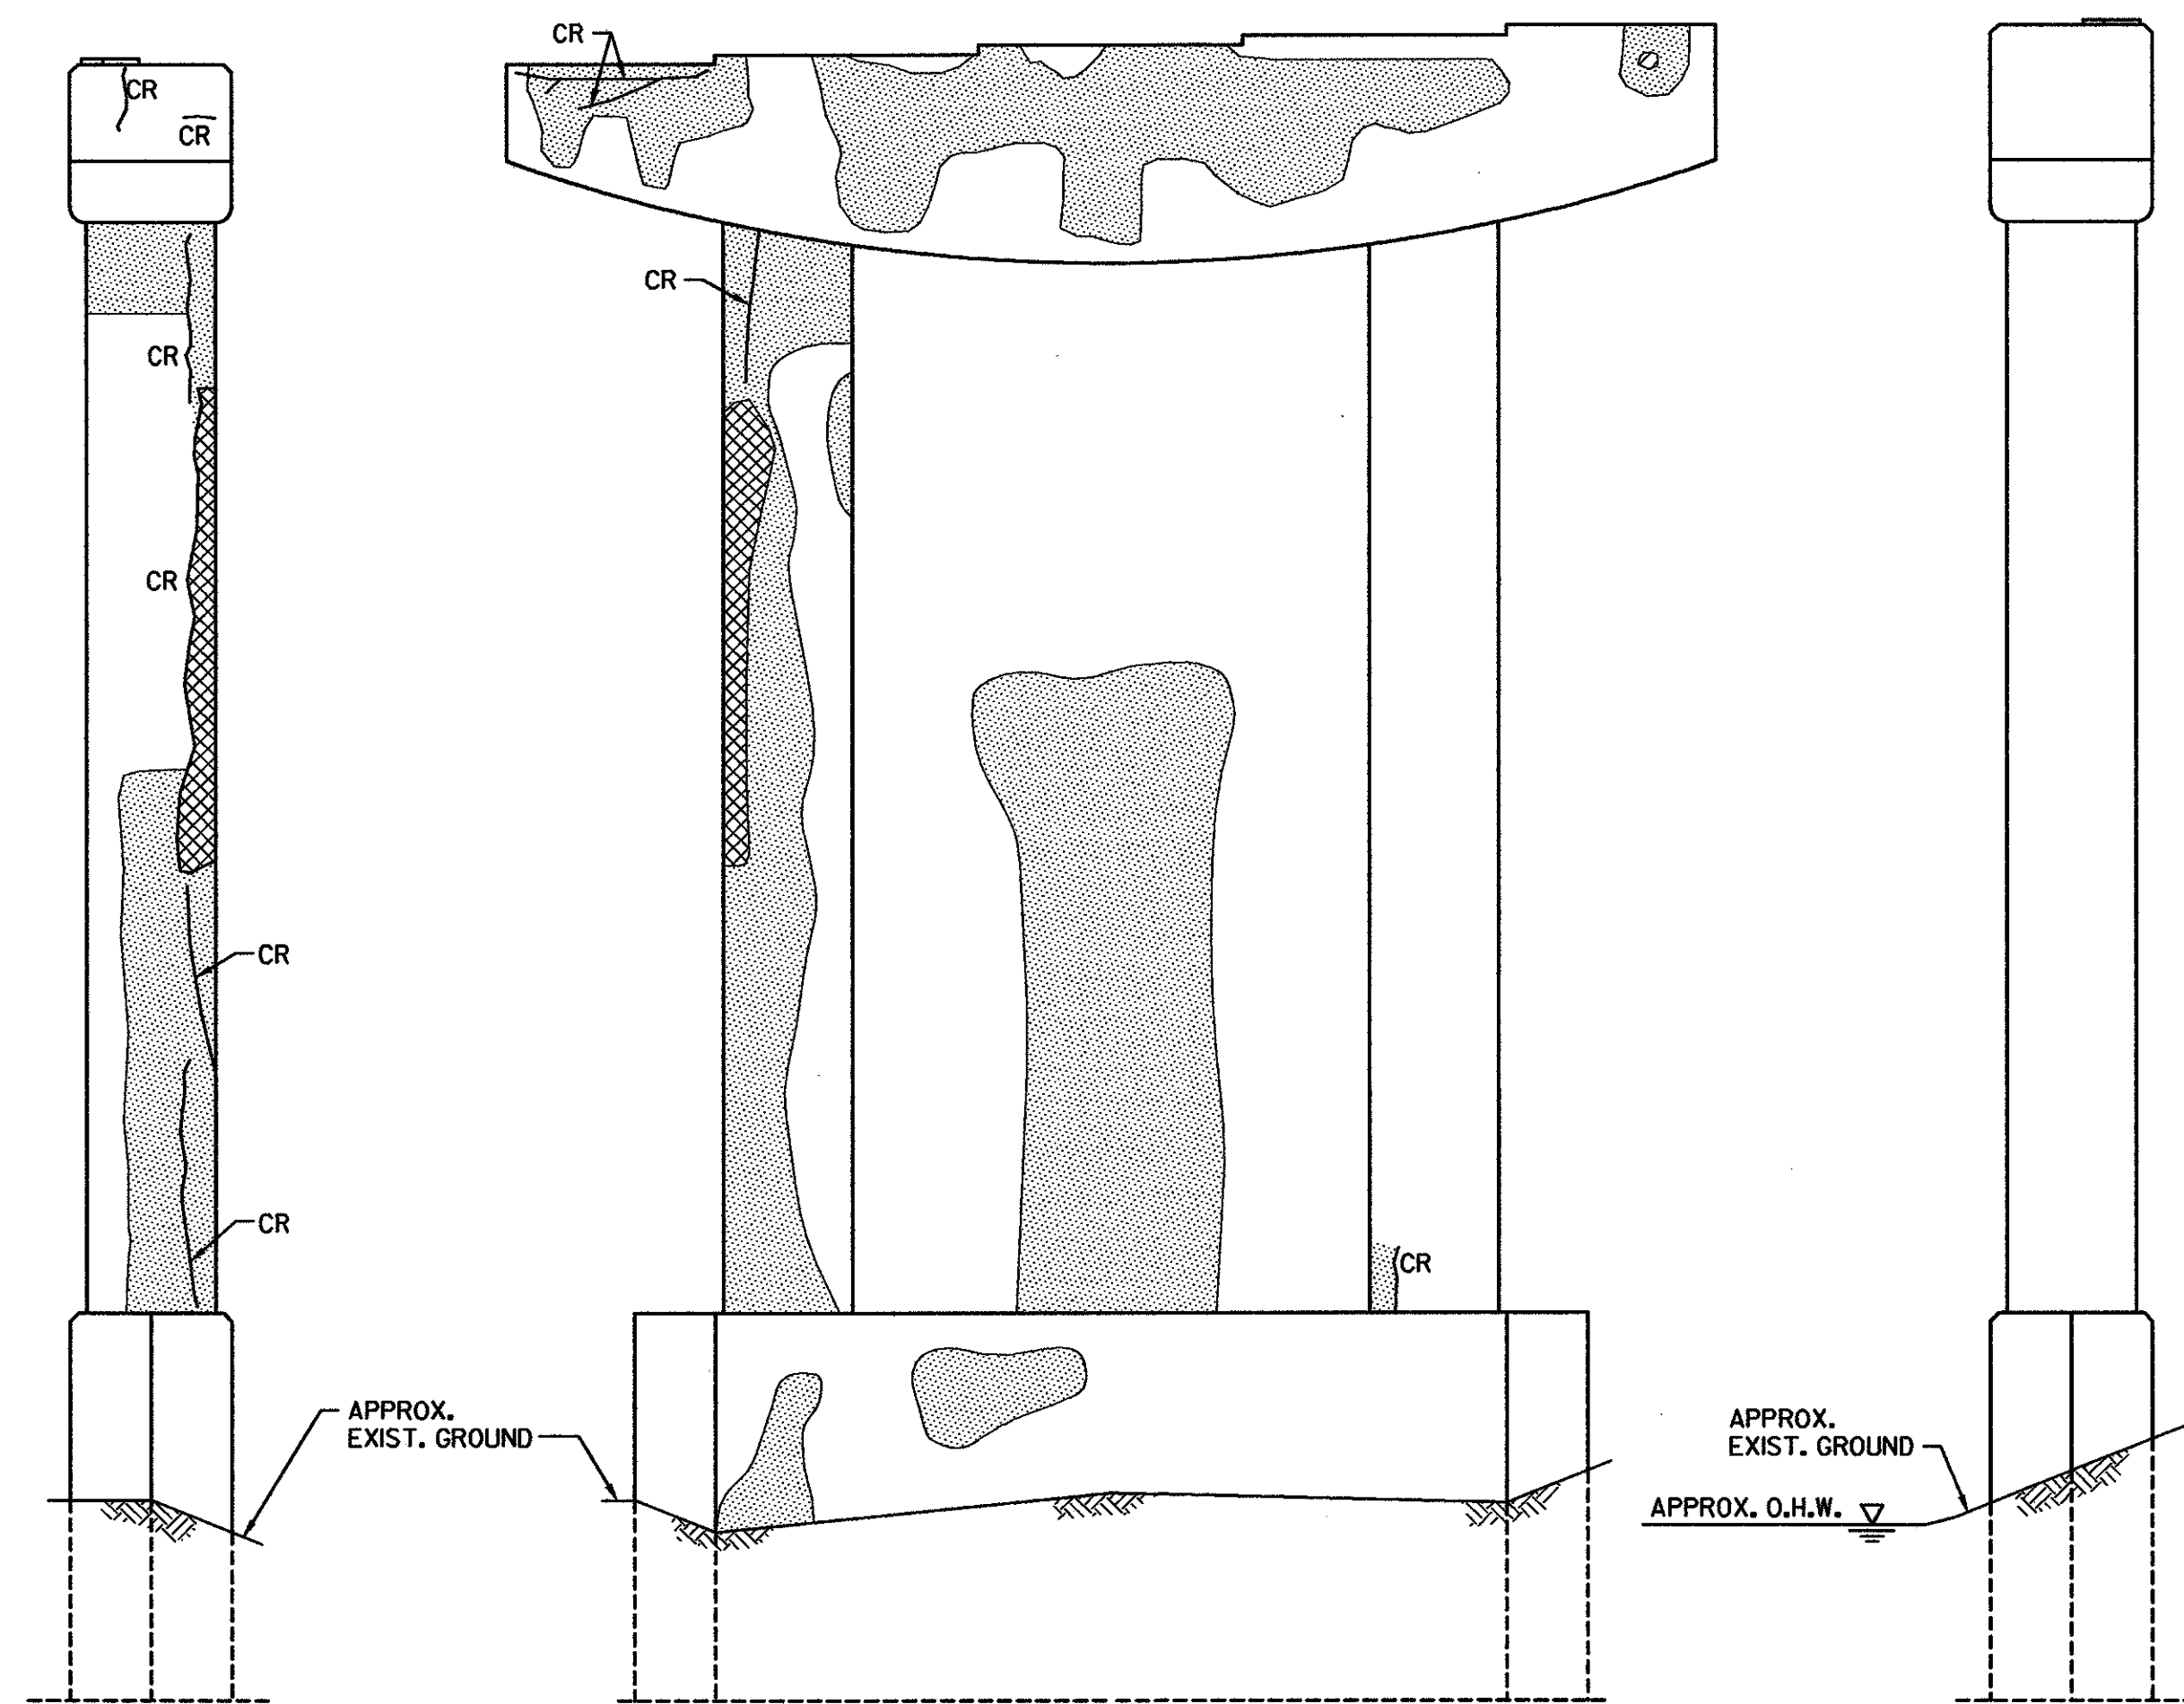


(PIER 1 SIDE)  
**PIER 2 ELEVATION**  
 SCALE: 3/16"=1'-0"

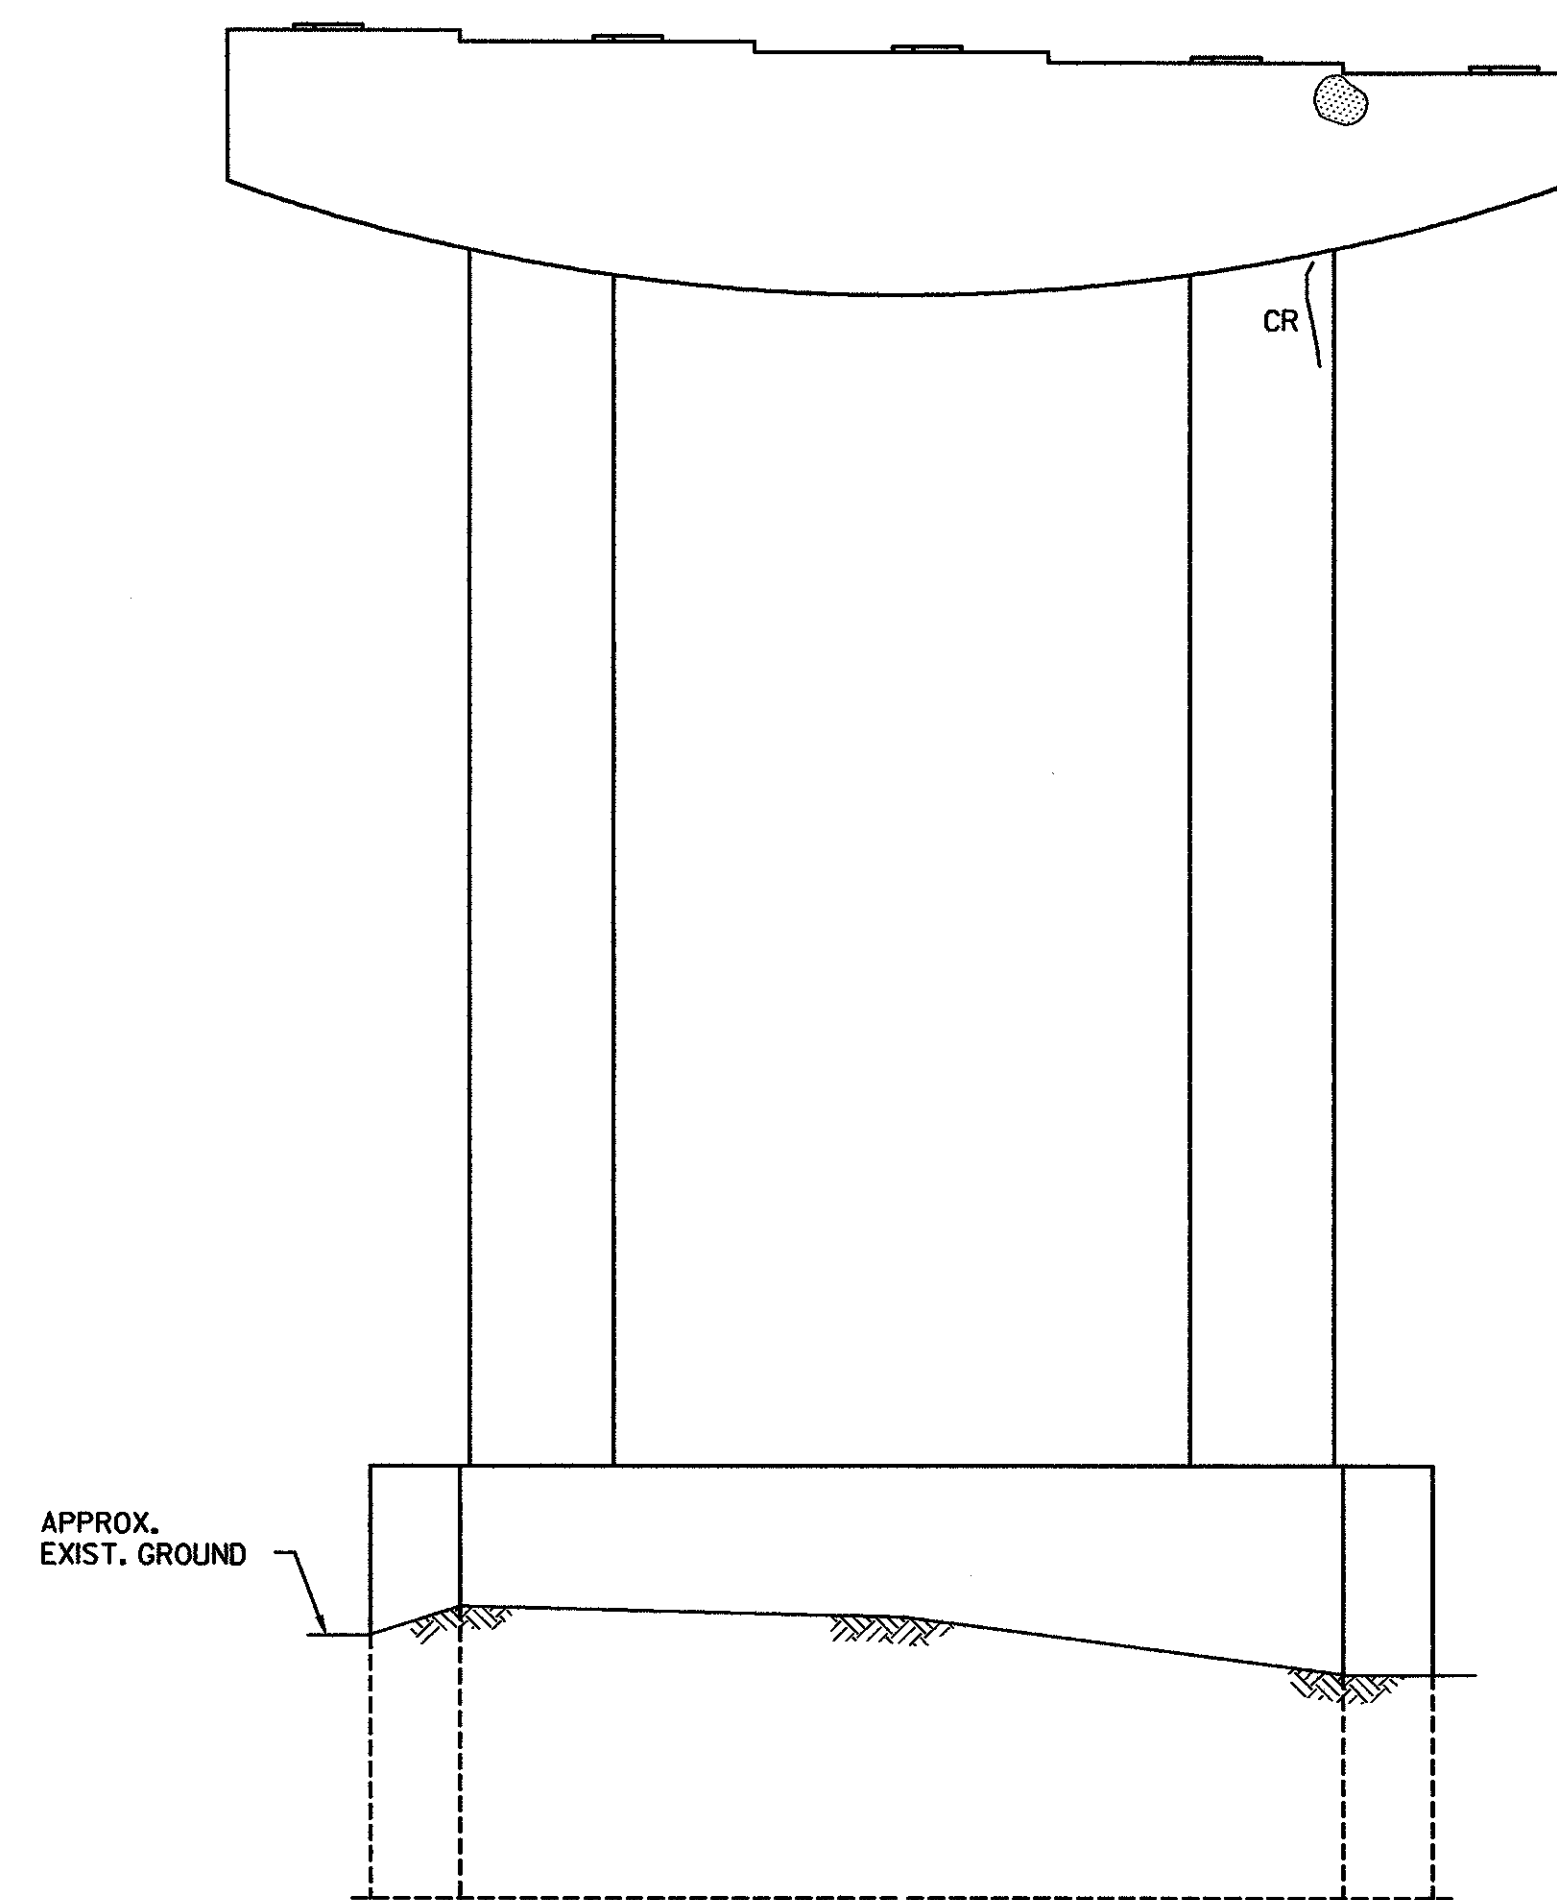

(ABUT. 2 SIDE)  
**PIER 2 ELEVATION**  
 SCALE: 3/16"=1'-0"

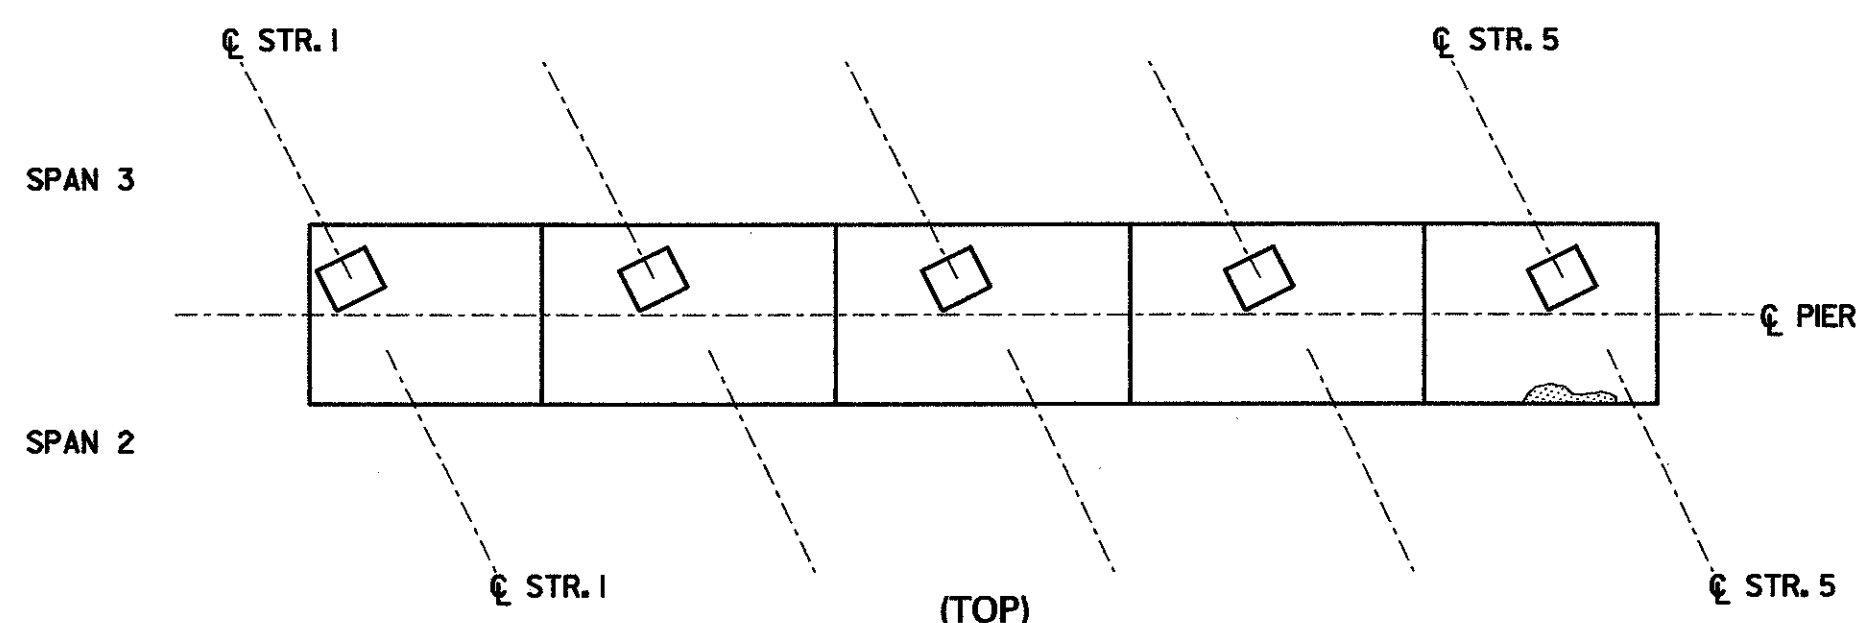


(TOP)

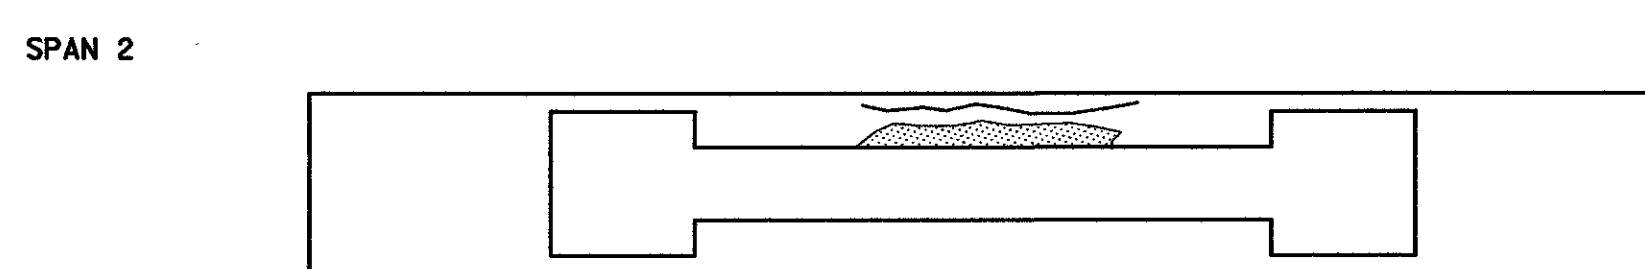

(BOTTOM)

**PIER 2 PLAN**  
 SCALE: 3/16"=1'-0"

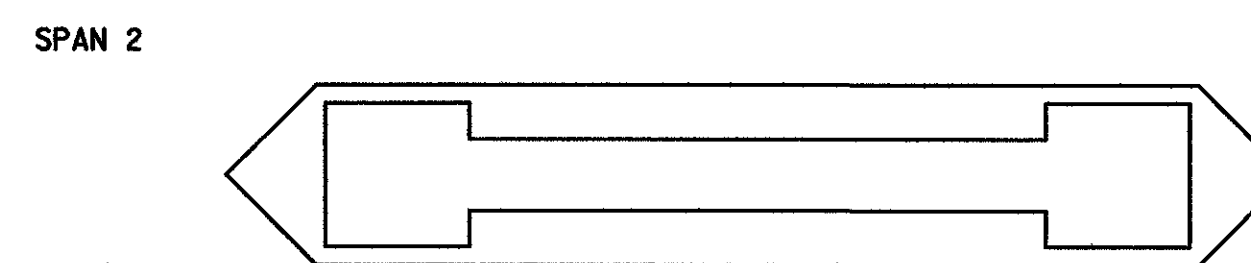

(TOP)

**PIER 2 BASE**  
 SCALE: 3/16"=1'-0"

**ABBREVIATIONS**  
 CR CRACK  
 PA PREVIOUSLY PATCHED AREA

**LEGEND**  
 CRACK  
 DELAMINATED AREA  
 SPALLED AREA  
 DEEPLY SPALLED WITH EXPOSED REBAR  
 EXISTING GROUND

**STATE OF VERMONT  
 AGENCY OF TRANSPORTATION**


Town Of	MIDDLESEX-BOLTON	Bridge No.	<b>48S</b>
Highway No.	I-89	Log Sta.	
		Surv. Sta.	
I-89 SB OVER LITTLE RIVER			

**EXIST. SUBSTR. CONDITION (48S) (2 OF 3)**


Designed By	P.W. SZUSTAK	Drawn By	R.A. BOTZENHART
Checked By	J.P. HALSTEAD	Date	10/99
		Bridge Design Supervisor	J.P. HALSTEAD Date 10/99

PROJECT	MIDDLESEX-BOLTON	PROJECT NO.	IM-089-2(26)
TVGA CAD Drawing No.	48piers	Date	10/99

Bridge Sheet No.	<b>SC-9</b>	Sheet	143 of 307
------------------	-------------	-------	------------

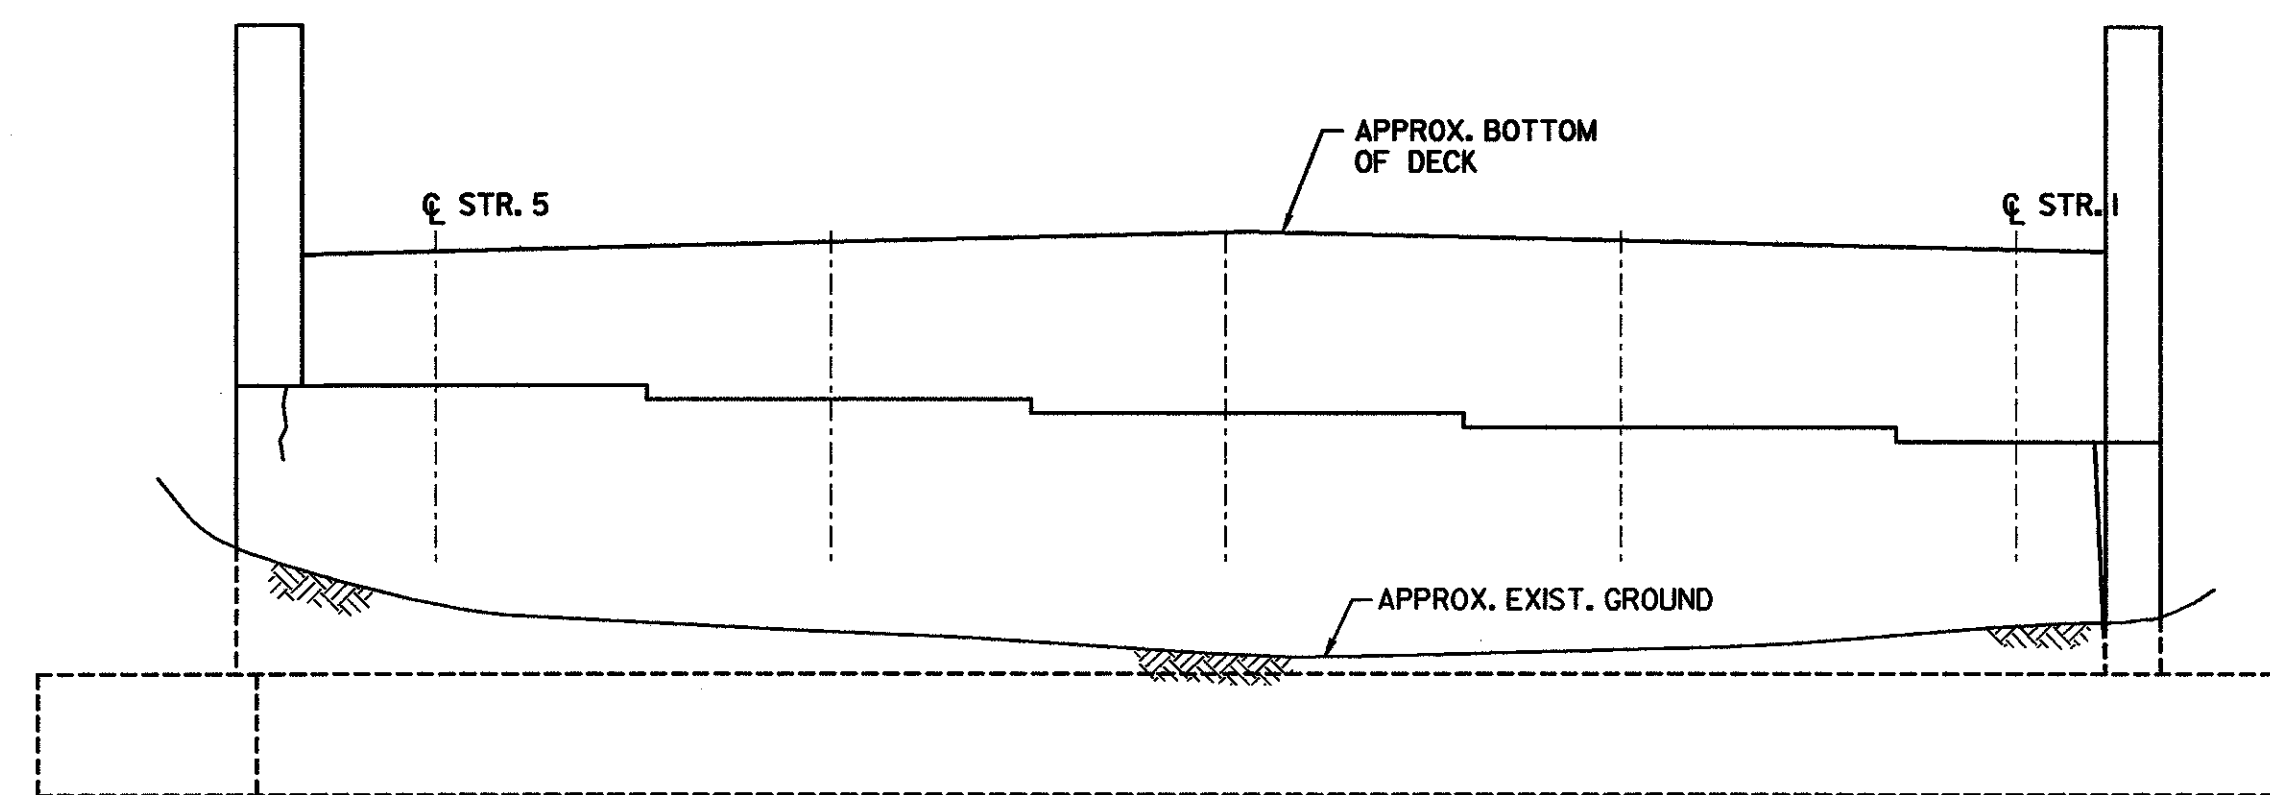

**ABUT 1 ELEVATION**  
SCALE: 1/4"=1'-0"

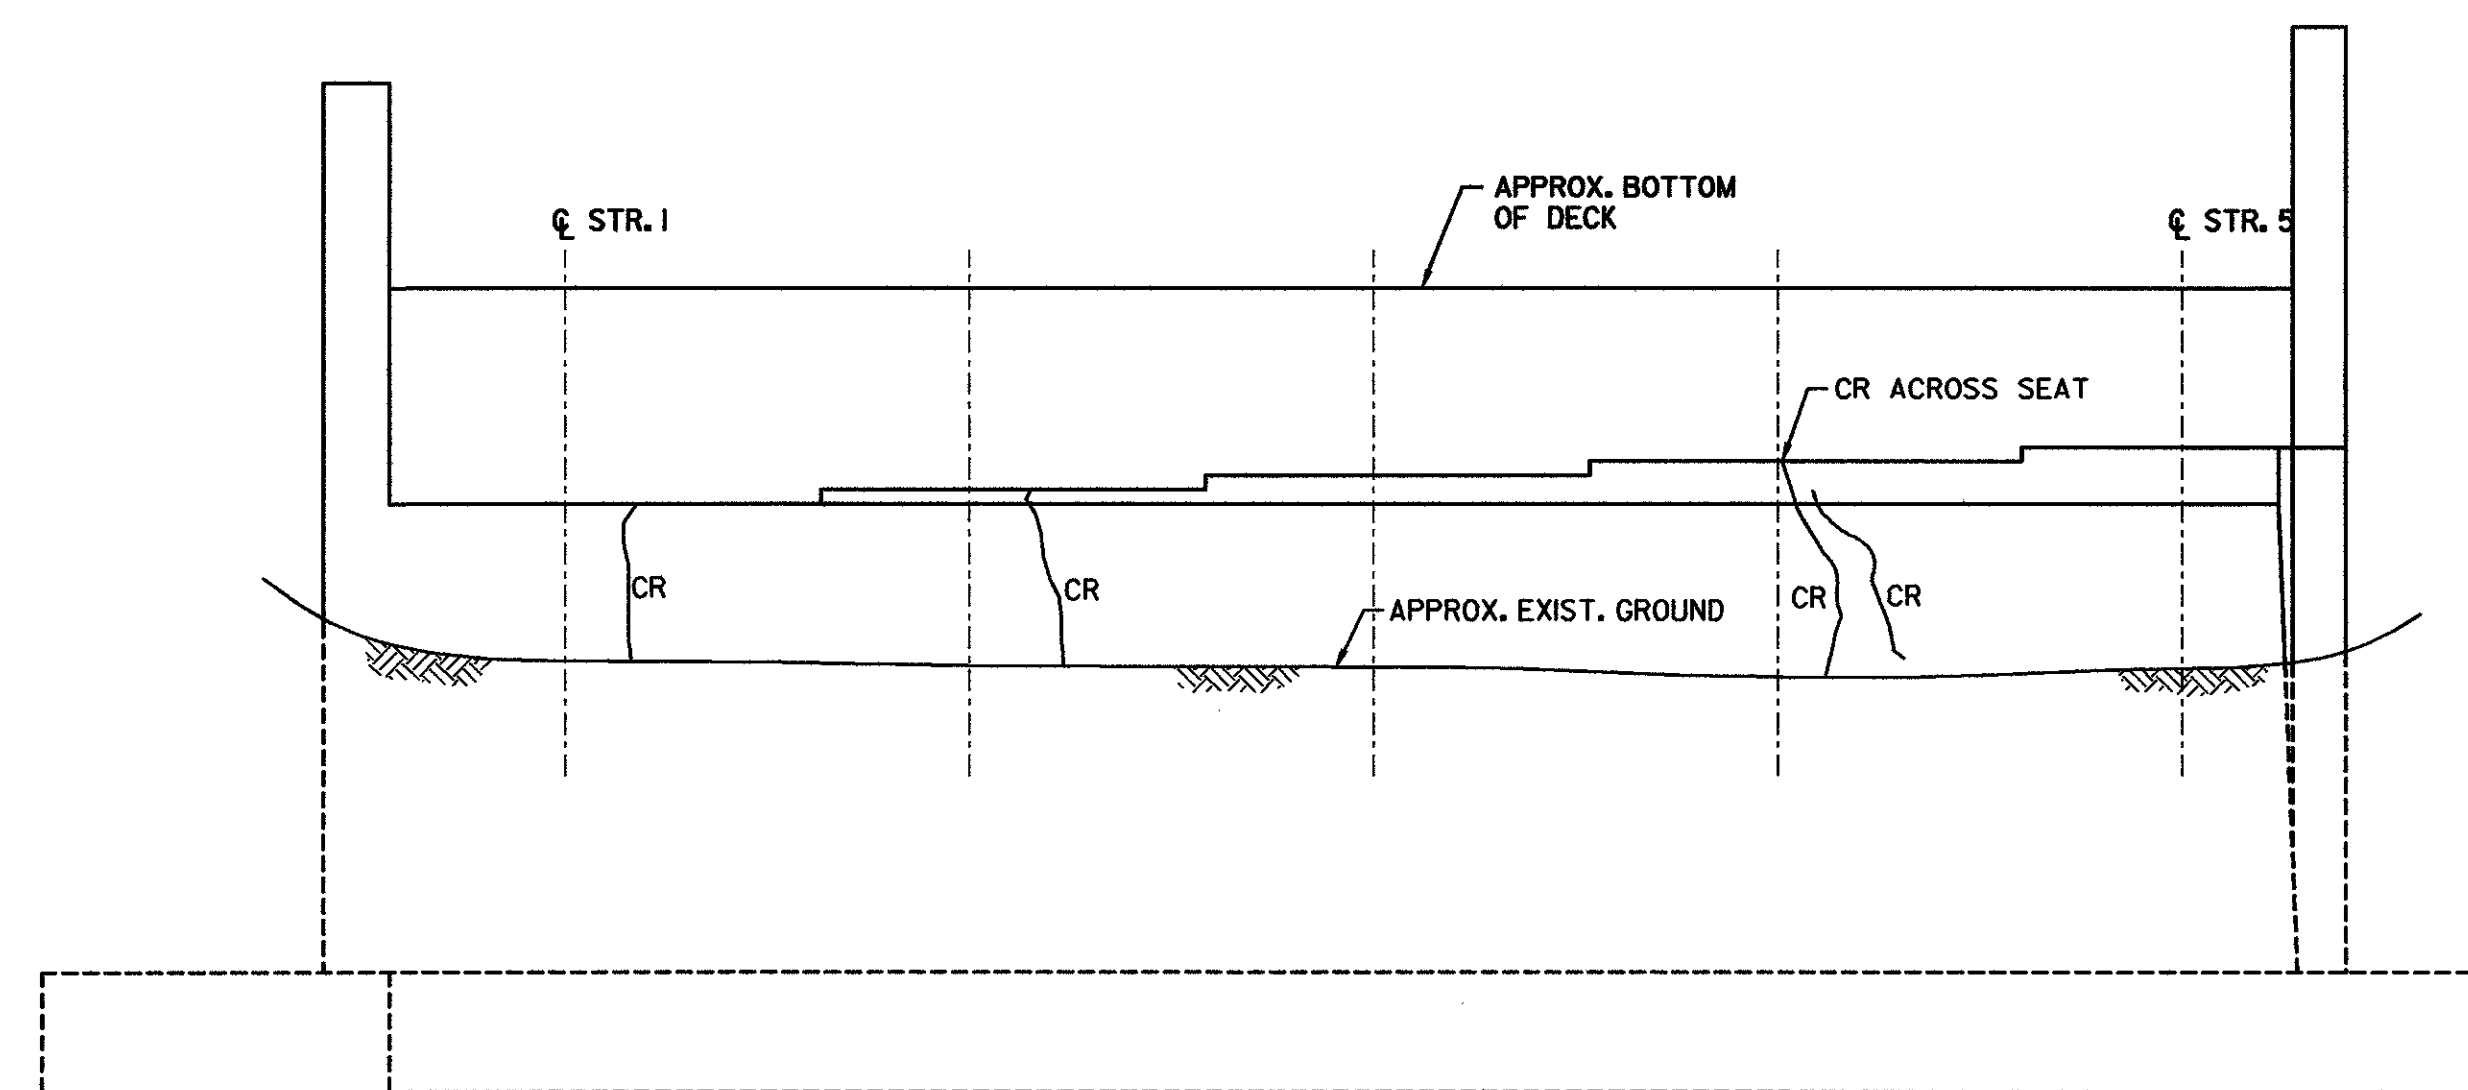


**ABUT 2 ELEVATION**  
SCALE: 1/4"=1'-0"

**ABBREVIATIONS**  
CR CRACK  
PA PREVIOUSLY PATCHED AREA


**LEGEND**  
CRACK  
DELAMINATED AREA  
SPALLED AREA  
DEEPLY SPALLED WITH EXPOSED REBAR  
EXISTING GROUND

**STATE OF VERMONT  
AGENCY OF TRANSPORTATION**

Town Of	MIDDLESEX-BOLTON	Bridge No.	<b>485</b>
Highway No.	I-89	Log Sta.	
		Surv. Sta.	
I-89 SB OVER LITTLE RIVER			
<b>EXIST. SUBSTR. CONDITION (485) (3 OF 3)</b>			
Designed By	P.W. SZUSTAK	Drawn By	R.A. BOTZENHART
Checked By	Date	Bridge Design Supervisor	
J.P. HALSTEAD	10/99	J.P. HALSTEAD	Date 10/99
PROJECT	MIDDLESEX-BOLTON	PROJECT NO.	IM-089-2(26)
TVGA CAD Drawing No.	48abut	Date	10/99
Bridge Sheet No.	<b>SC-10</b>	Sheet	144 of 307

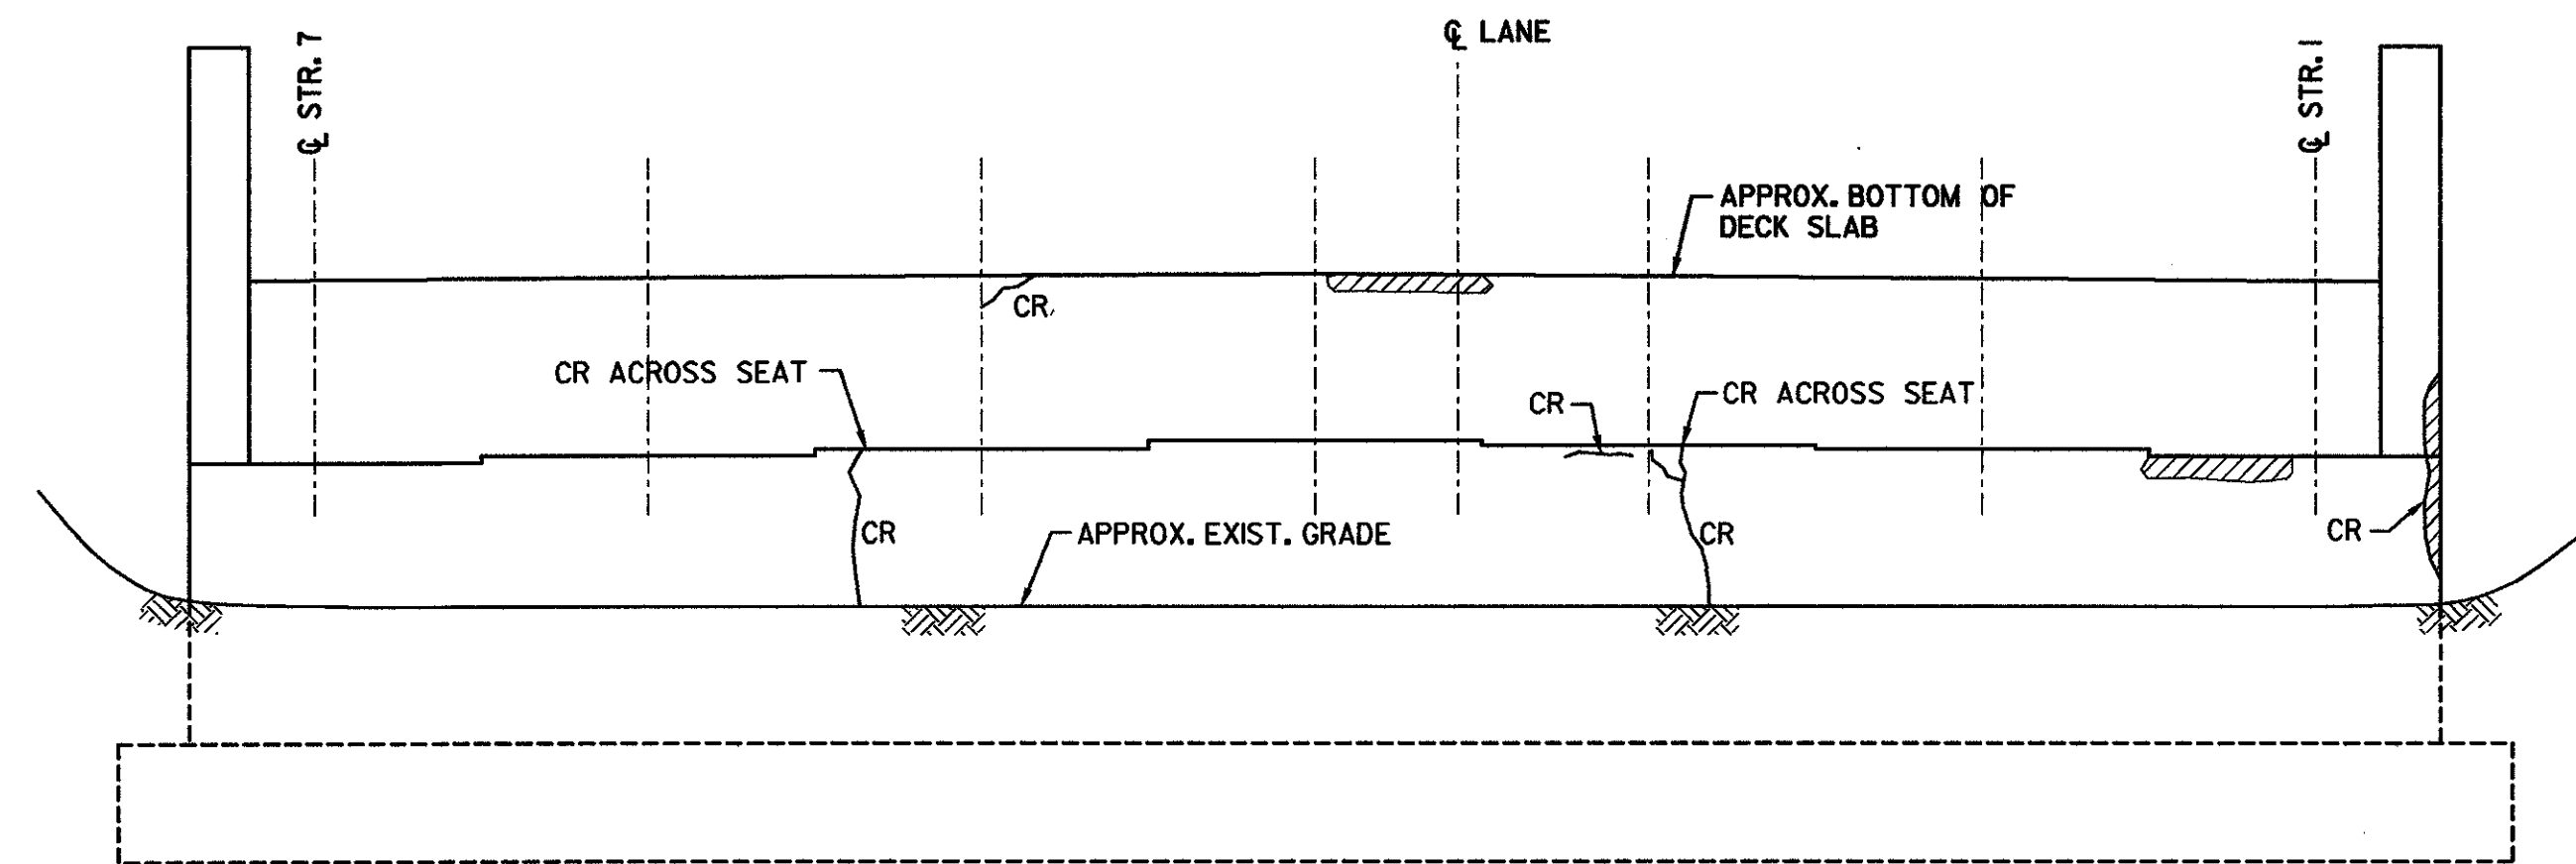

**ABUT. 1 ELEVATION**  
SCALE: 1/4"=1'-0"

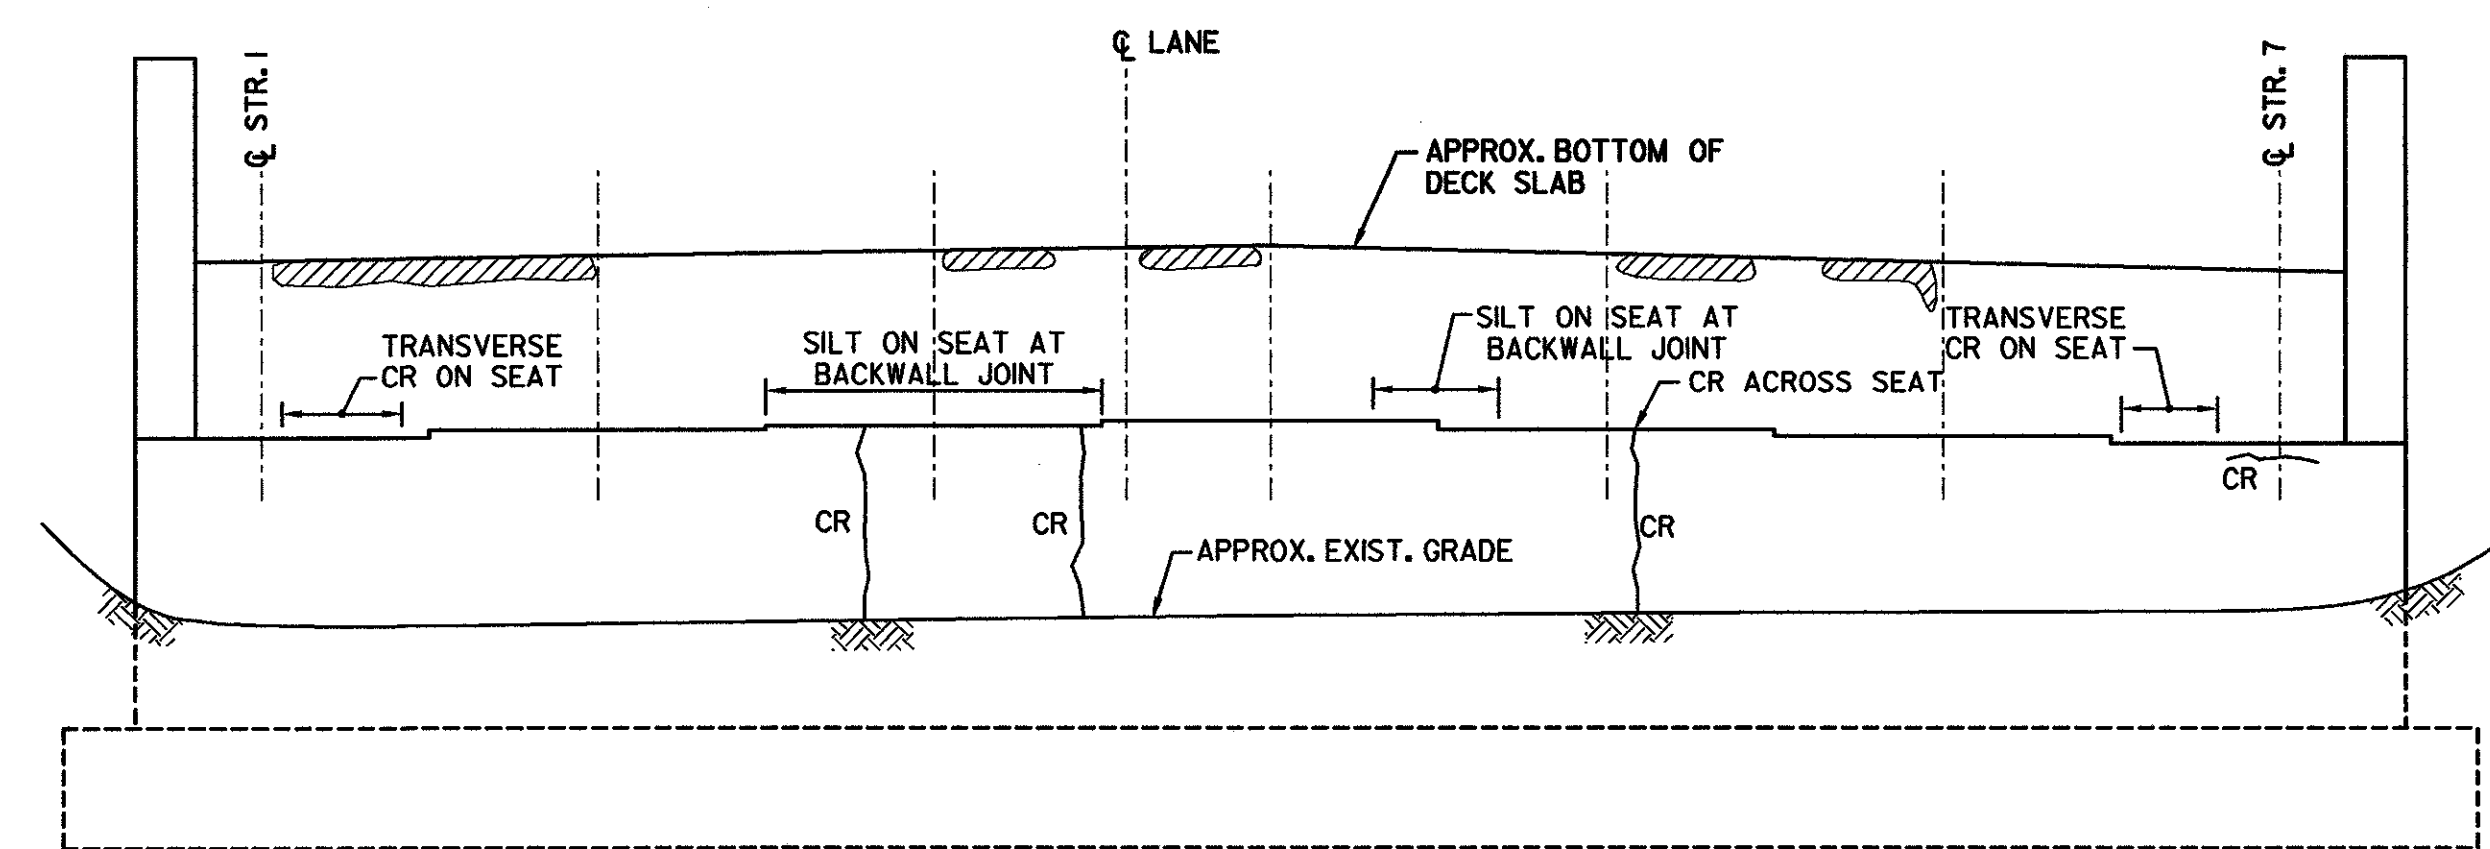

**ABUT. 2 ELEVATION**  
SCALE: 1/4"=1'-0"

- ABBREVIATIONS**
- CR CRACK
  - PA PREVIOUSLY PATCHED AREA
- LEGEND**
- CRACK
  - DELAMINATED AREA
  - SPALLED AREA
  - DEEPLY SPALLED WITH EXPOSED REBAR

**STATE OF VERMONT  
AGENCY OF TRANSPORTATION**


Town Of	MIDDLESEX-BOLTON	Bridge No.	<b>49N</b>
Highway No.	I-89	Log Sta.	
		Surv. Sta.	

I-89 NB OVER TH 7


**EXIST. SUBSTR. CONDITION (49N)**

Designed By	P.W. SZUSTAK	Drawn By	R.A. BOTZENHART
Checked By	J.P. HALSTEAD	Date	10/99
		Bridge Design Supervisor	J.P. HALSTEAD Date 10/99
PROJECT	MIDDLESEX-BOLTON	PROJECT NO.	IM-089-2(26)

TVGA CAD Drawing No.	49abut	Date	10/99
Bridge Sheet No.	SC-11	Sheet	145 of 307

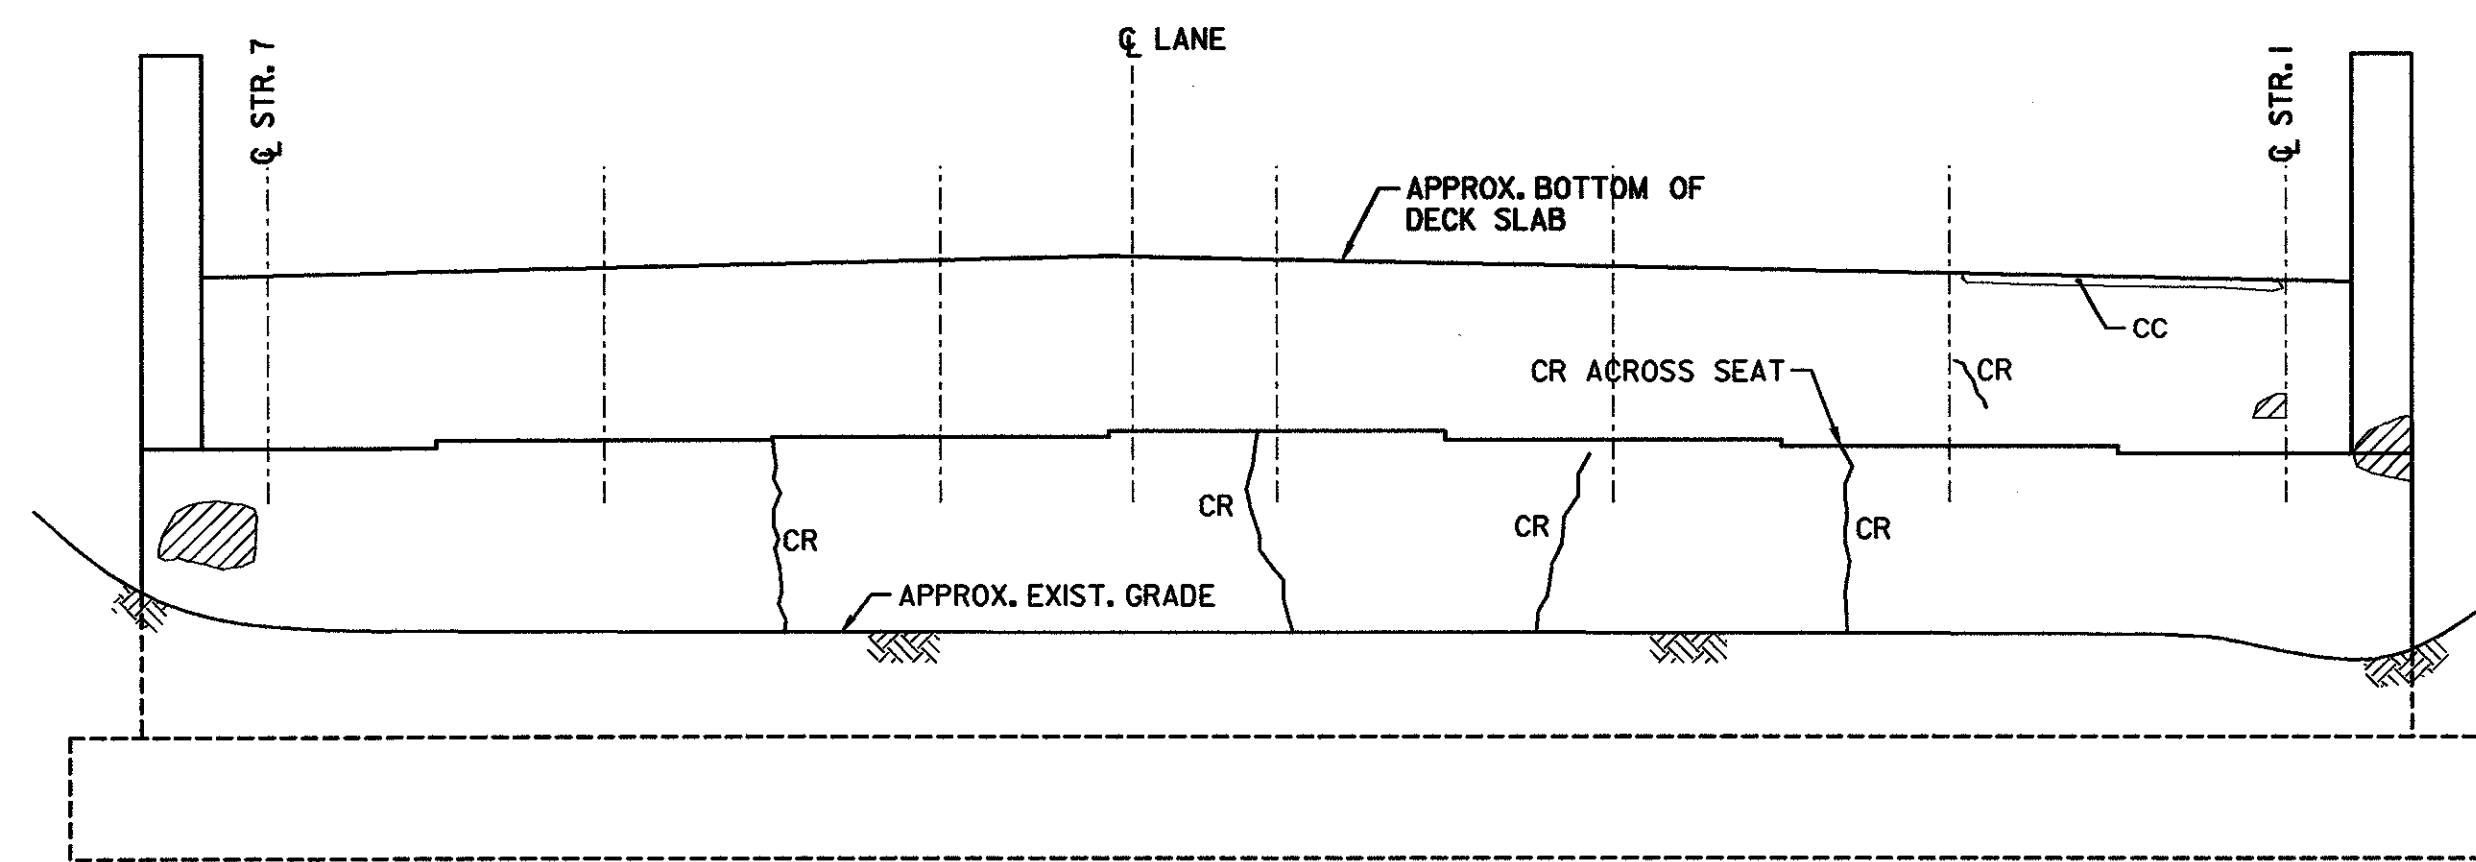

**ABUT. 1 ELEVATION**  
SCALE: 1/4"=1'-0"

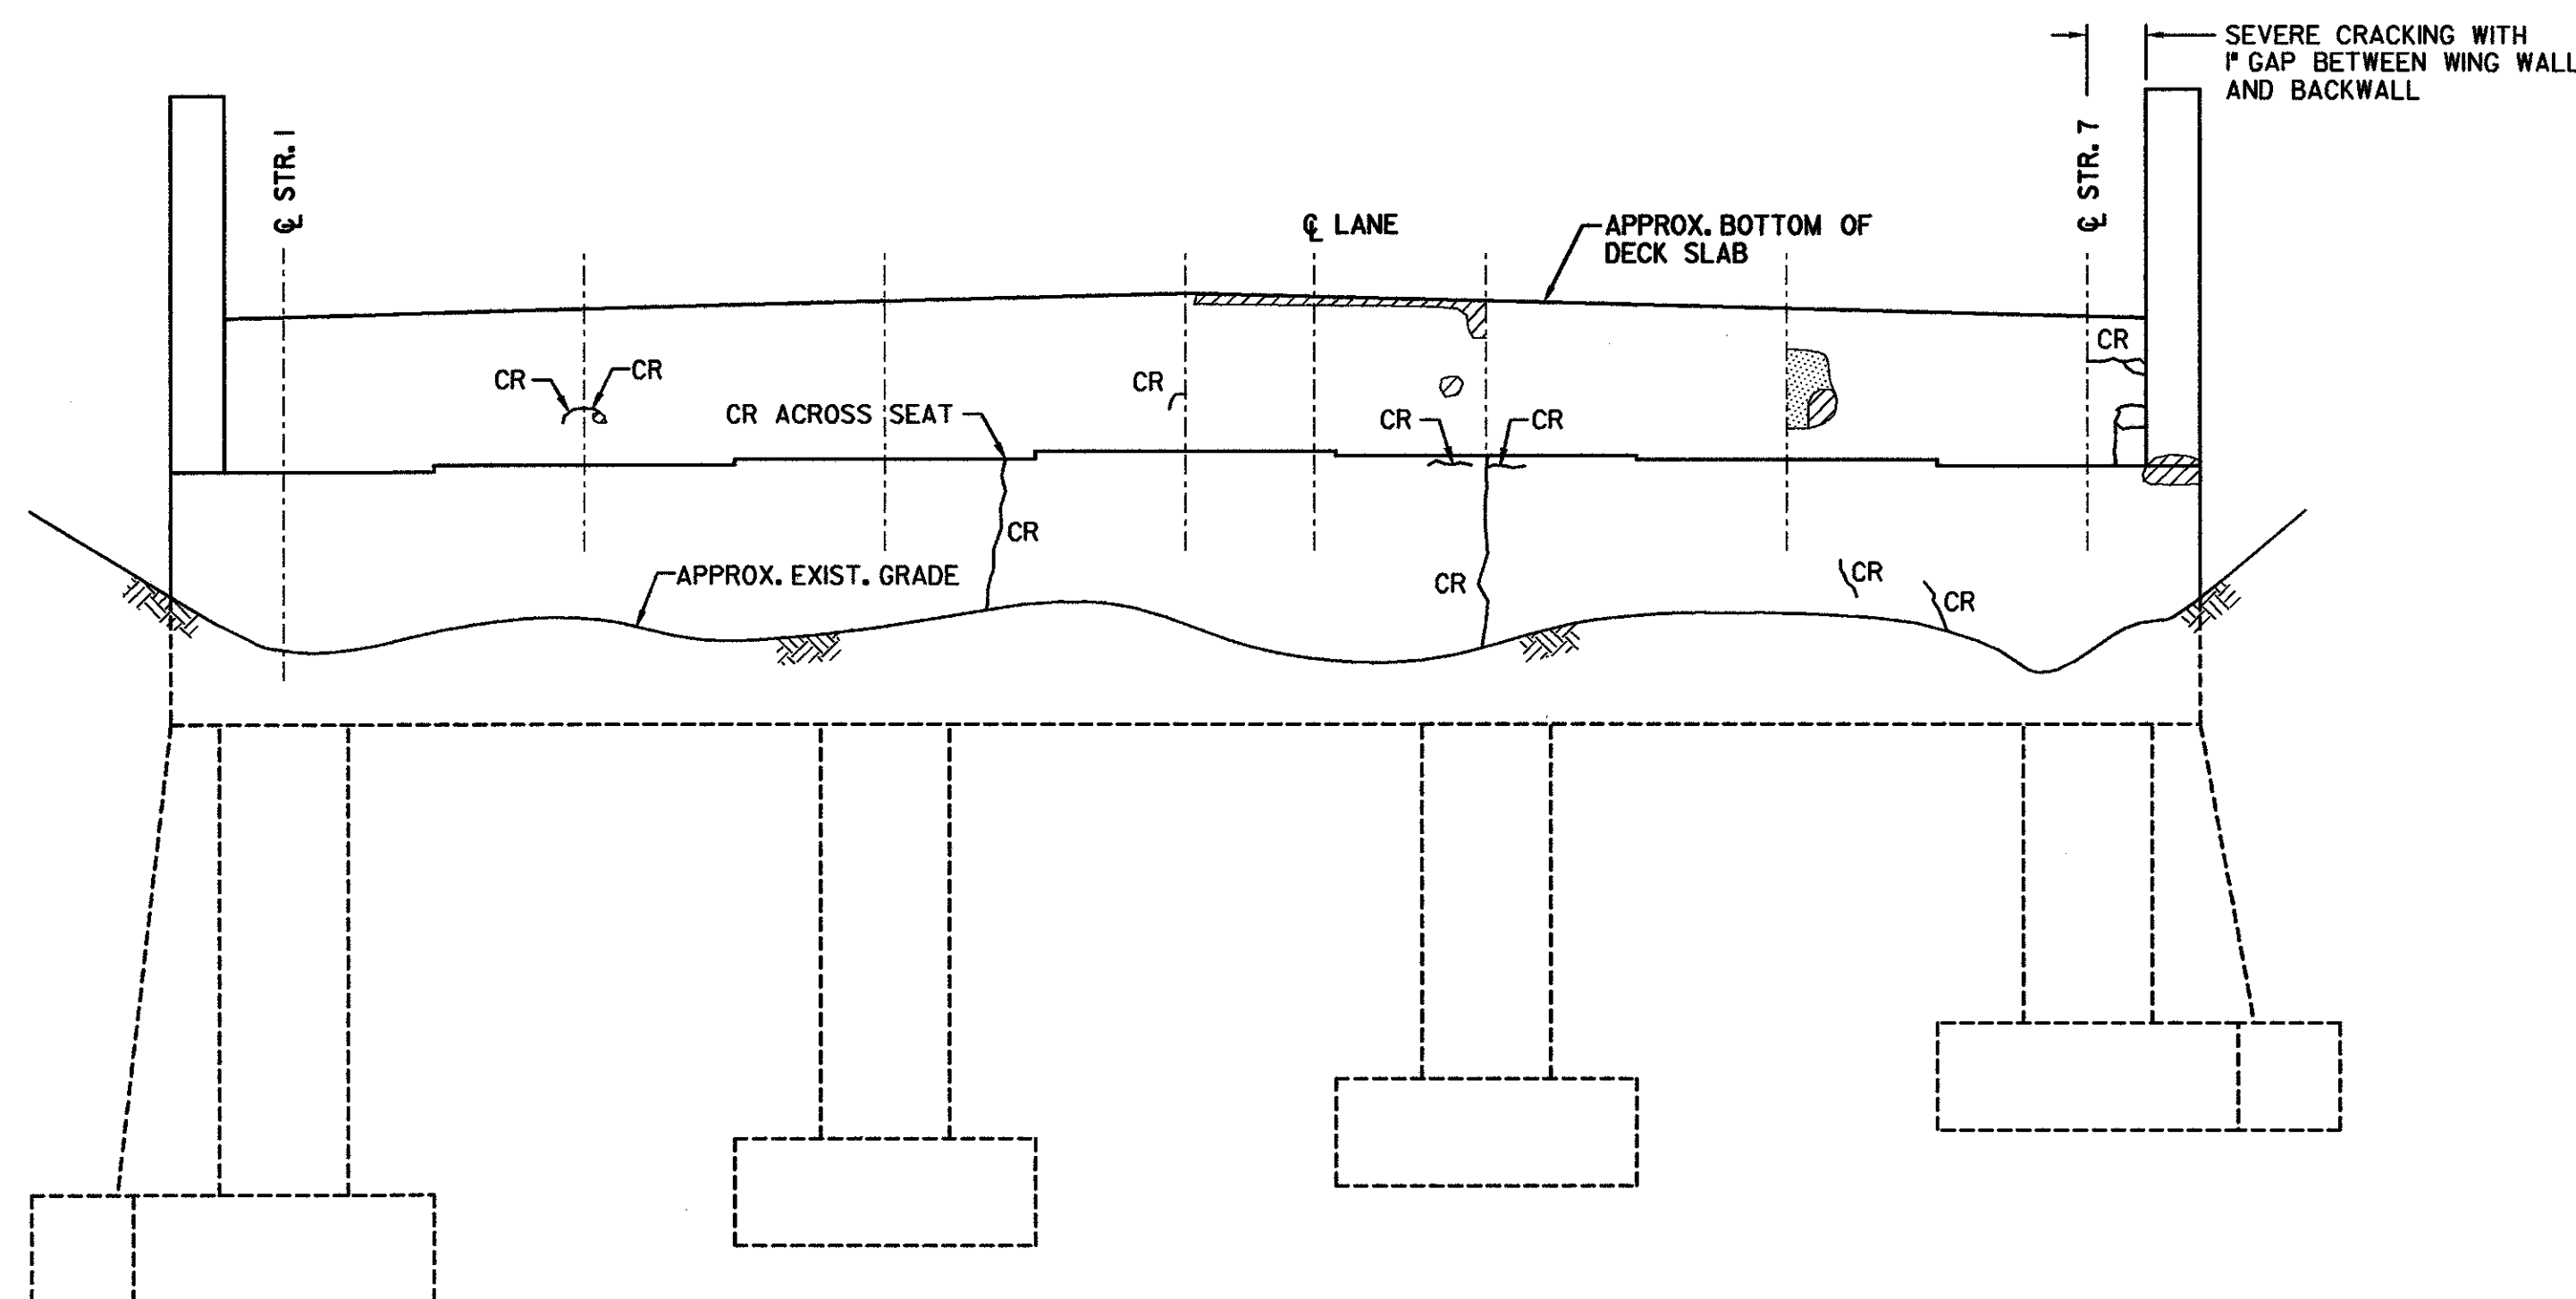

**ABUT. 2 ELEVATION**  
SCALE: 1/4"=1'-0"

**ABBREVIATIONS**  
CR CRACK  
PA PREVIOUSLY PATCHED AREA

**LEGEND**  
CRACK  
DELAMINATED AREA  
SPALLED AREA  
DEEPLY SPALLED WITH EXPOSED REBAR

**STATE OF VERMONT  
AGENCY OF TRANSPORTATION**

Town Of	MIDDLESEX-BOLTON	Bridge No.	<b>495</b>
Highway No.	I-89	Log Sta.	
		Surv. Sta.	


I-89 SB OVER TH 7

**EXIST. SUBSTR. CONDITION (495)**


Designed By	P.W. SZUSTAK	Drawn By	R.A. BOTZENHART
Checked By	J.P. HALSTEAD	Date	10/99
		Bridge Design Supervisor	J.P. HALSTEAD Date 10/99

PROJECT	MIDDLESEX-BOLTON	PROJECT NO.	IM-089-2(26)
---------	------------------	-------------	--------------


TVGA CAD Drawing No.	49abut	Date	10/99
Bridge Sheet No.	<b>SC-12</b>	Sheet	146 of 307

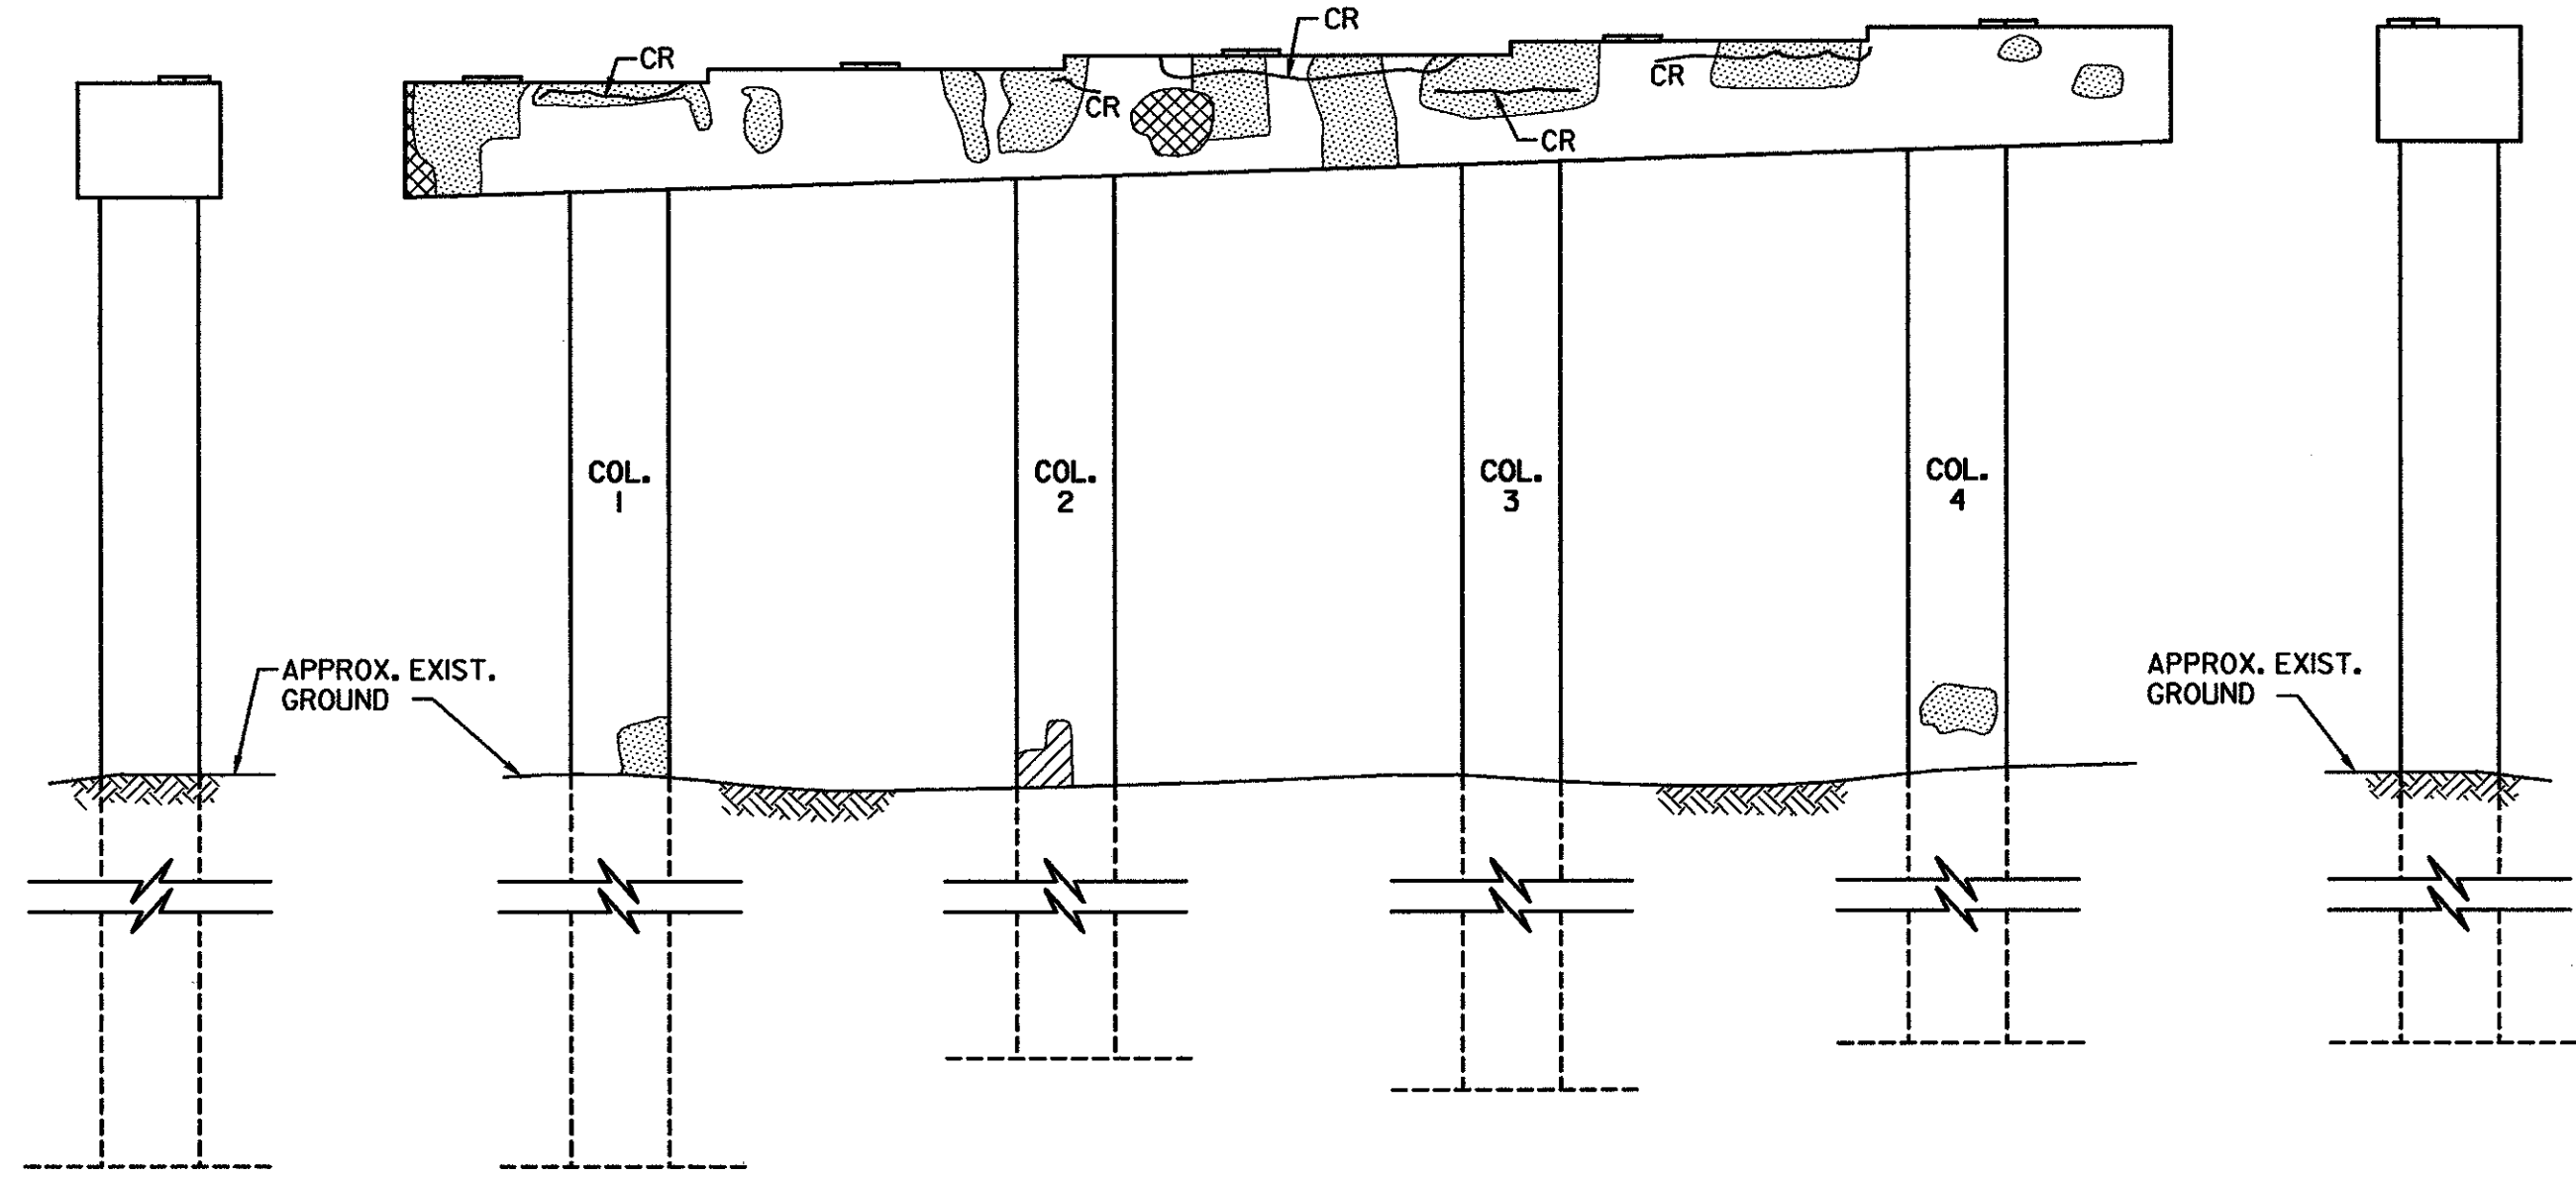


(ABUT. 1 SIDE)

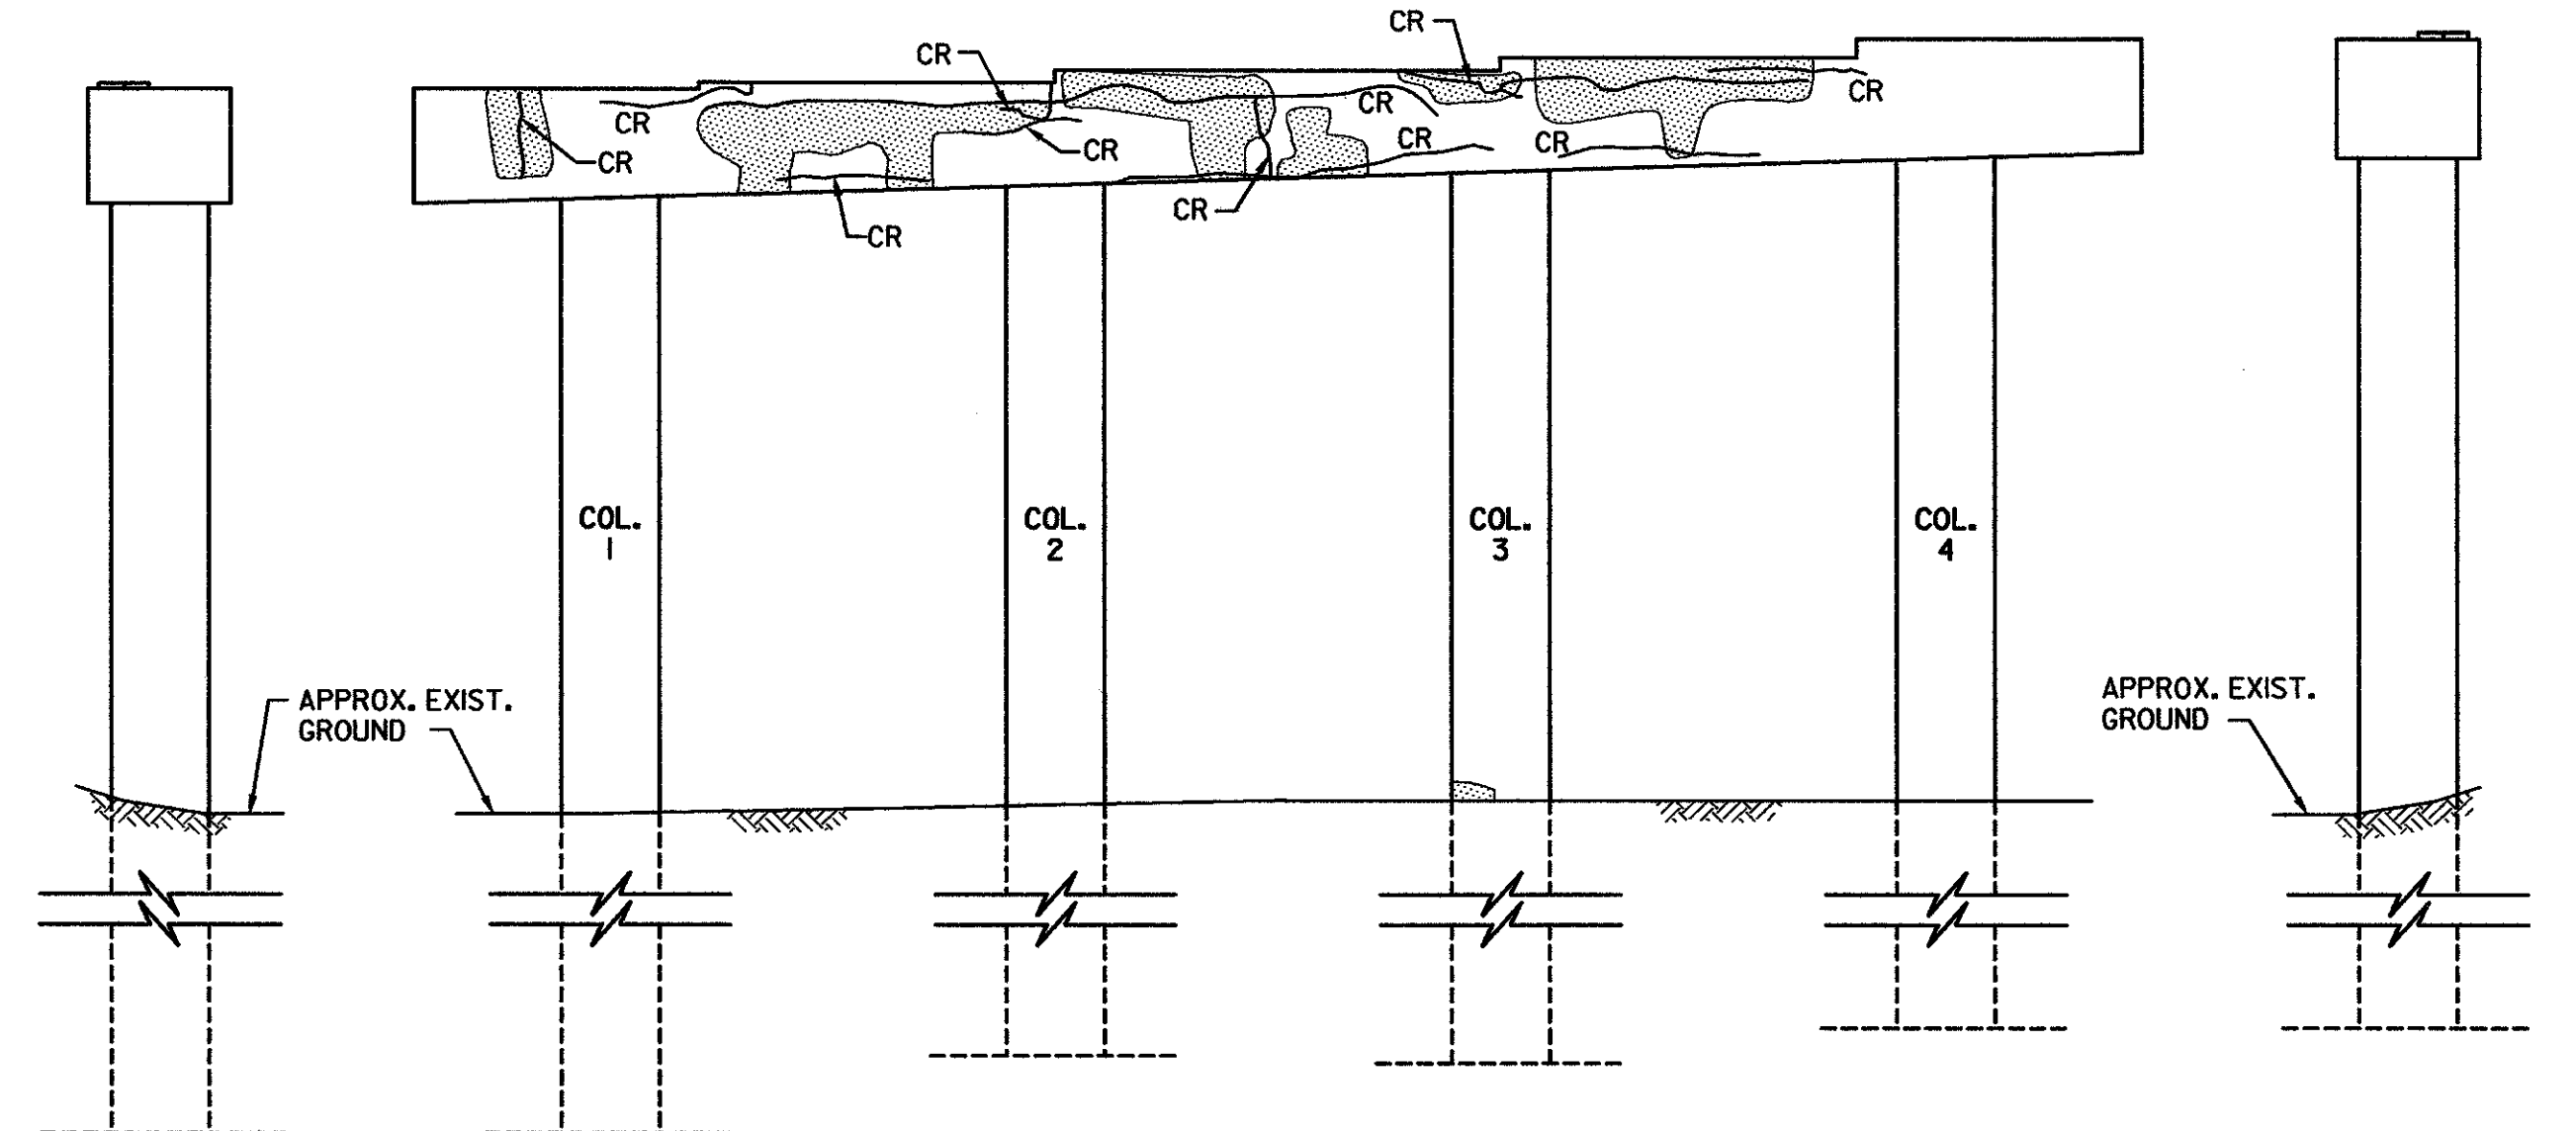

(PIER 1 SIDE)

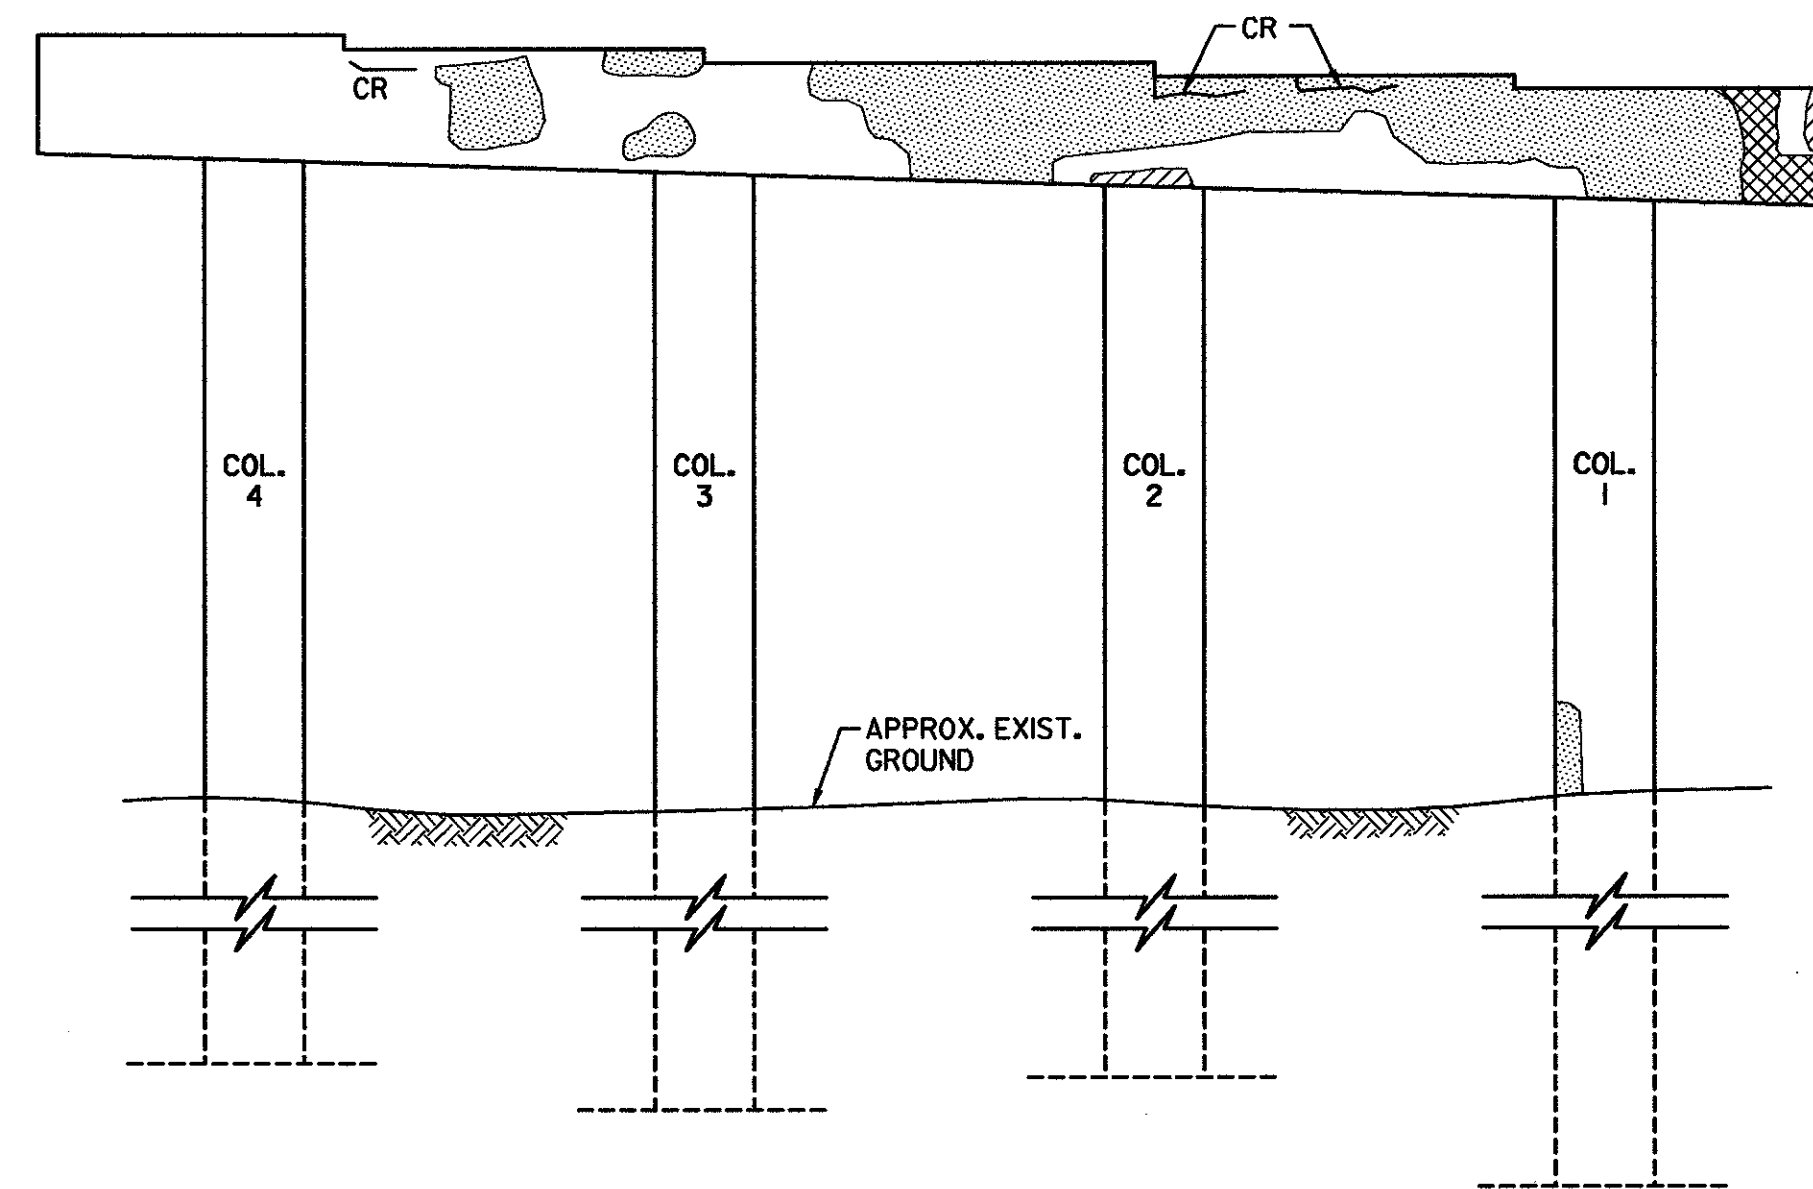

(PIER 2 SIDE)

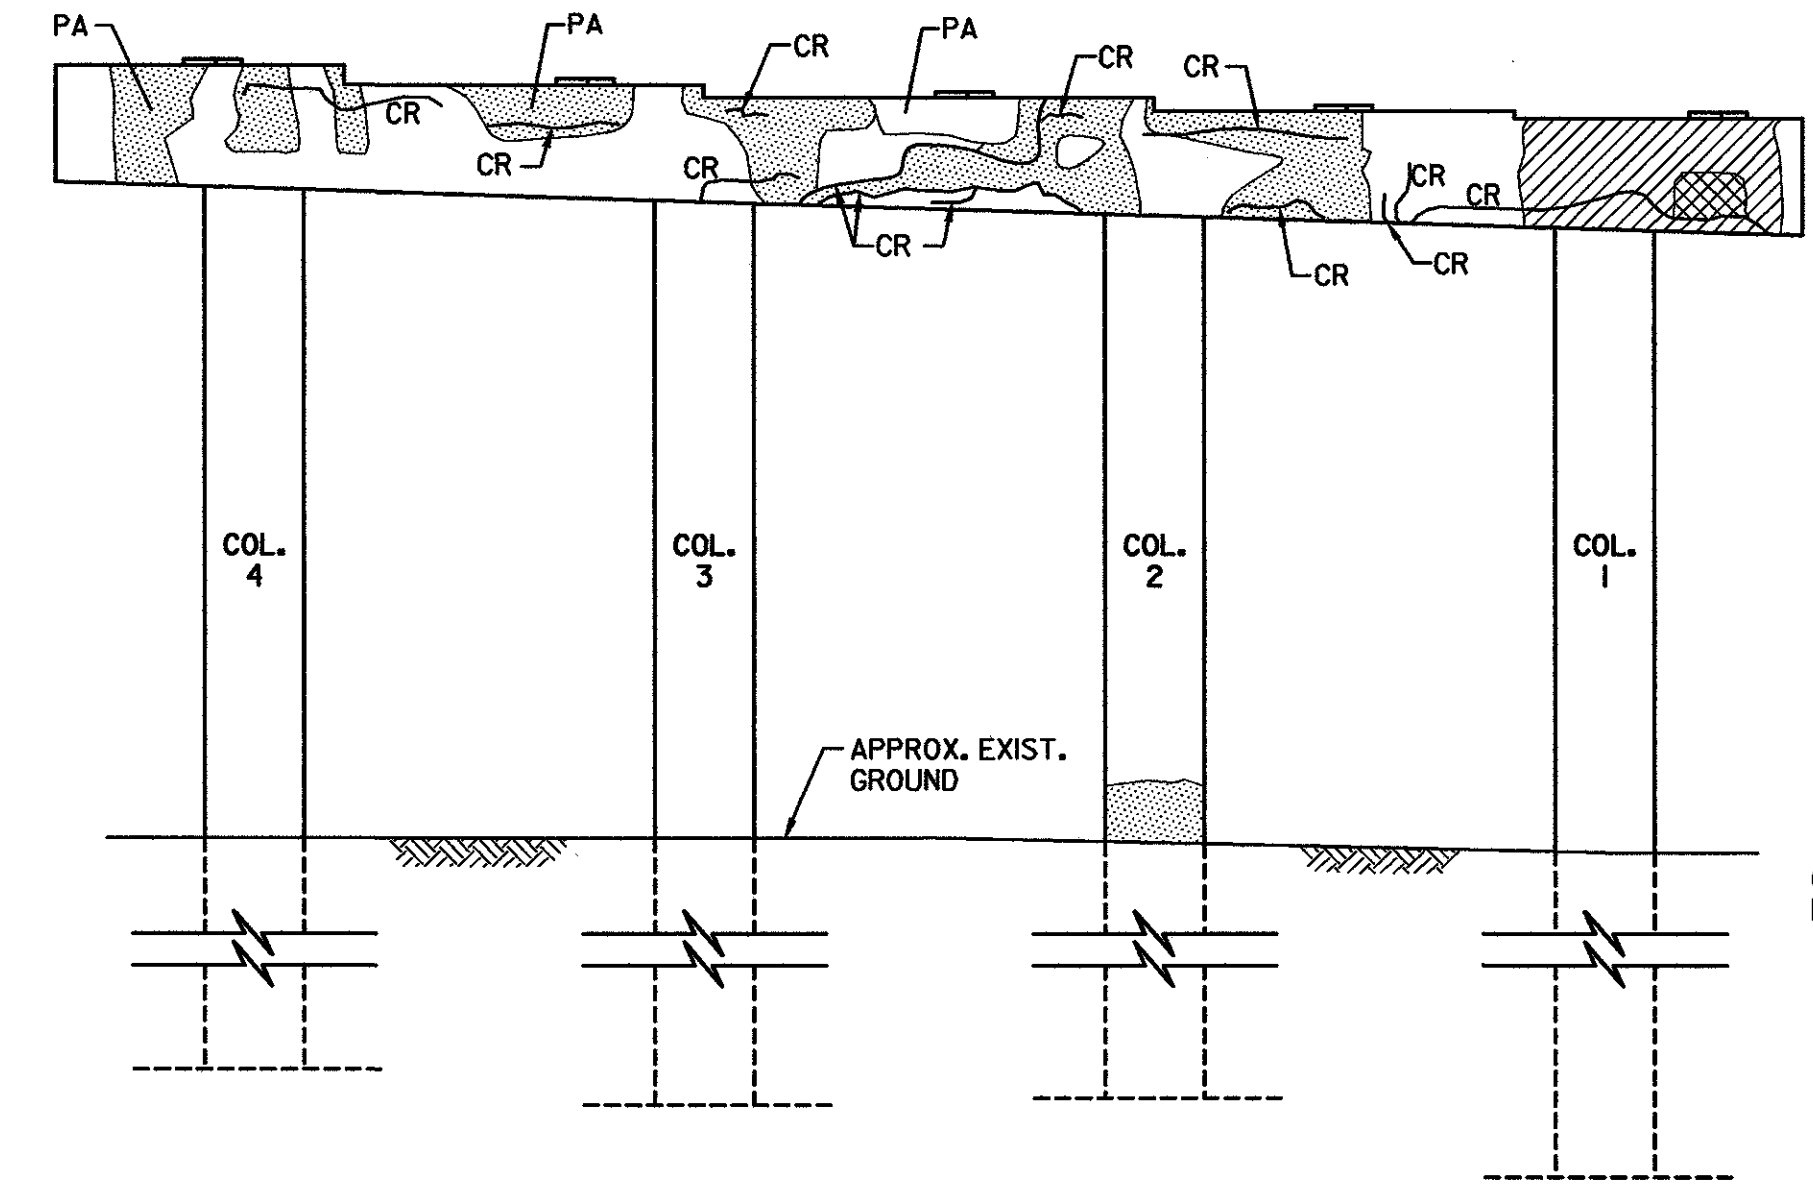

(ABUT. 2 SIDE)

**PIER 1 ELEVATIONS**  
SCALE: 3/16"=1'-0"


**PIER 2 ELEVATIONS**  
SCALE: 3/16"=1'-0"

**ABBREVIATIONS**

CR CRACK  
PA PREVIOUSLY PATCHED AREA

**LEGEND**


CRACK  
DELAMINATED AREA  
SPALLED AREA  
DEEPLY SPALLED WITH EXPOSED REBAR  
UNDERGROUND TELEPHONE — UT —  
UNDERGROUND ELECTRIC — UE —  
EXISTING GROUND

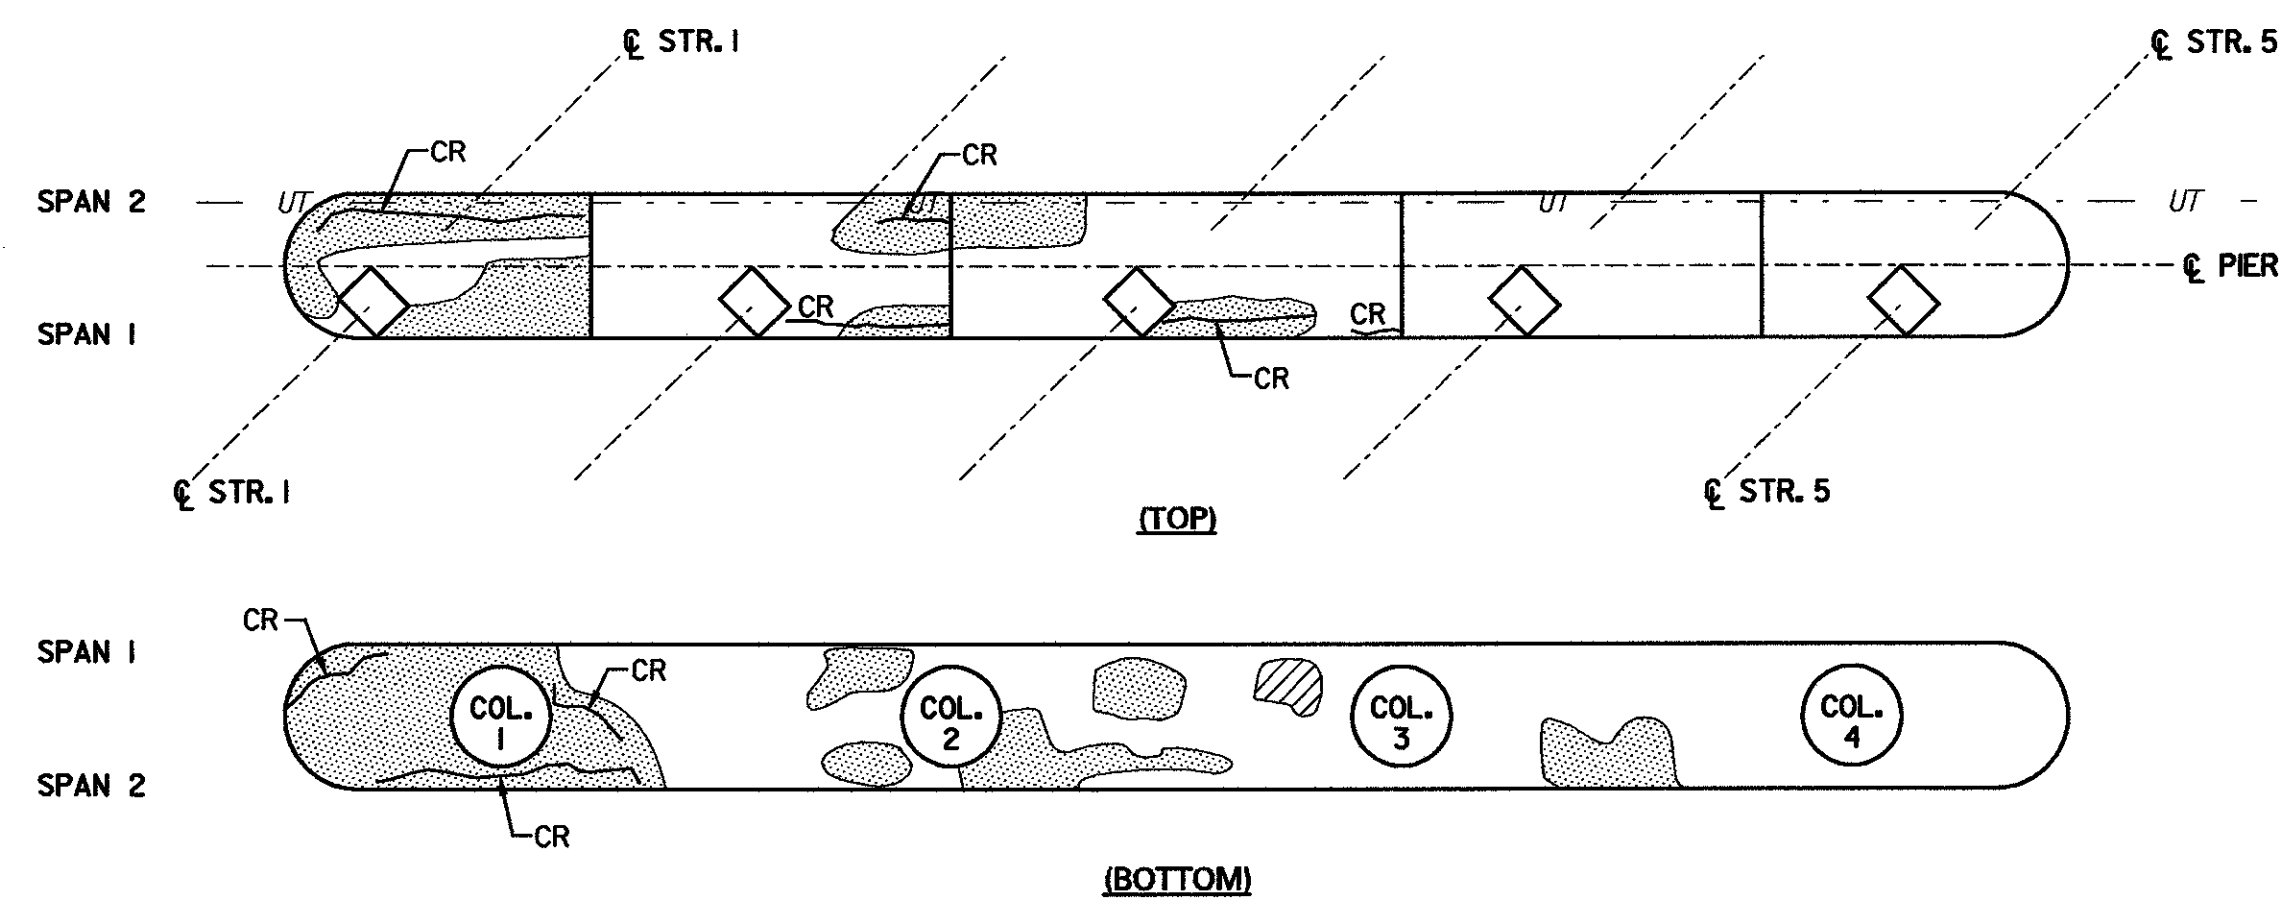

(TOP)

(BOTTOM)

**PIER 1 CAP**  
SCALE: 3/16"=1'-0"

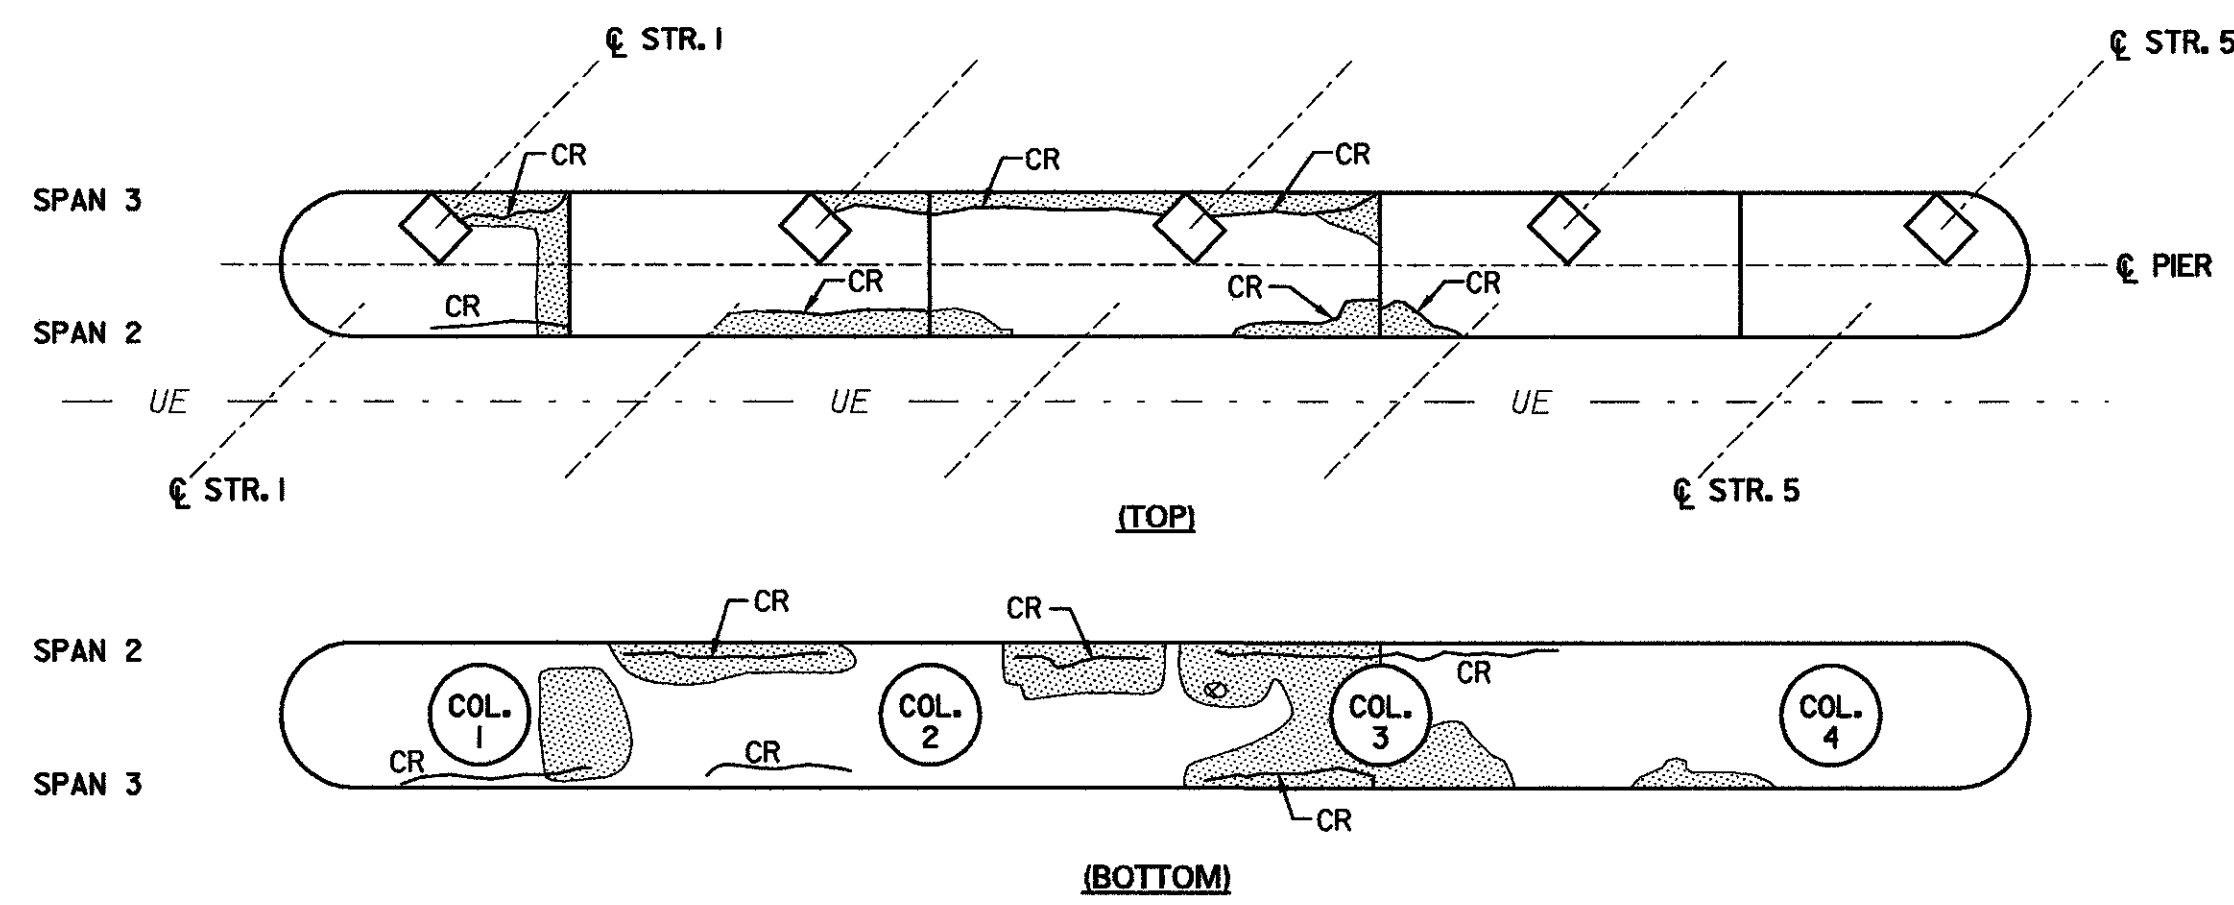


(TOP)

(BOTTOM)


**PIER 2 CAP**  
SCALE: 3/16"=1'-0"

**STATE OF VERMONT  
AGENCY OF TRANSPORTATION**

Town Of	MIDDLESEX-BOLTON	Bridge No.	50N
Highway No.	I-89	Log Sta.	
		Surv. Sta.	
I-89 NB OVER U.S. ROUTE 2			
<b>EXIST. SUBSTR. CONDITION (50N) (1 OF 2)</b>			
Designed By	P.W. SZUSTAK	Drawn By	R.A. BÖTZENHART
Checked By	Date	Bridge Design Supervisor	Date
J.P. HALSTEAD	10/99	J.P. HALSTEAD	10/99
PROJECT	MIDDLESEX-BOLTON	PROJECT NO.	IM-089-2(26)
TVGA CAD Drawing No.	50plers	Date	10/99
Bridge Sheet No.	SC-13	Sheet	147 of 307

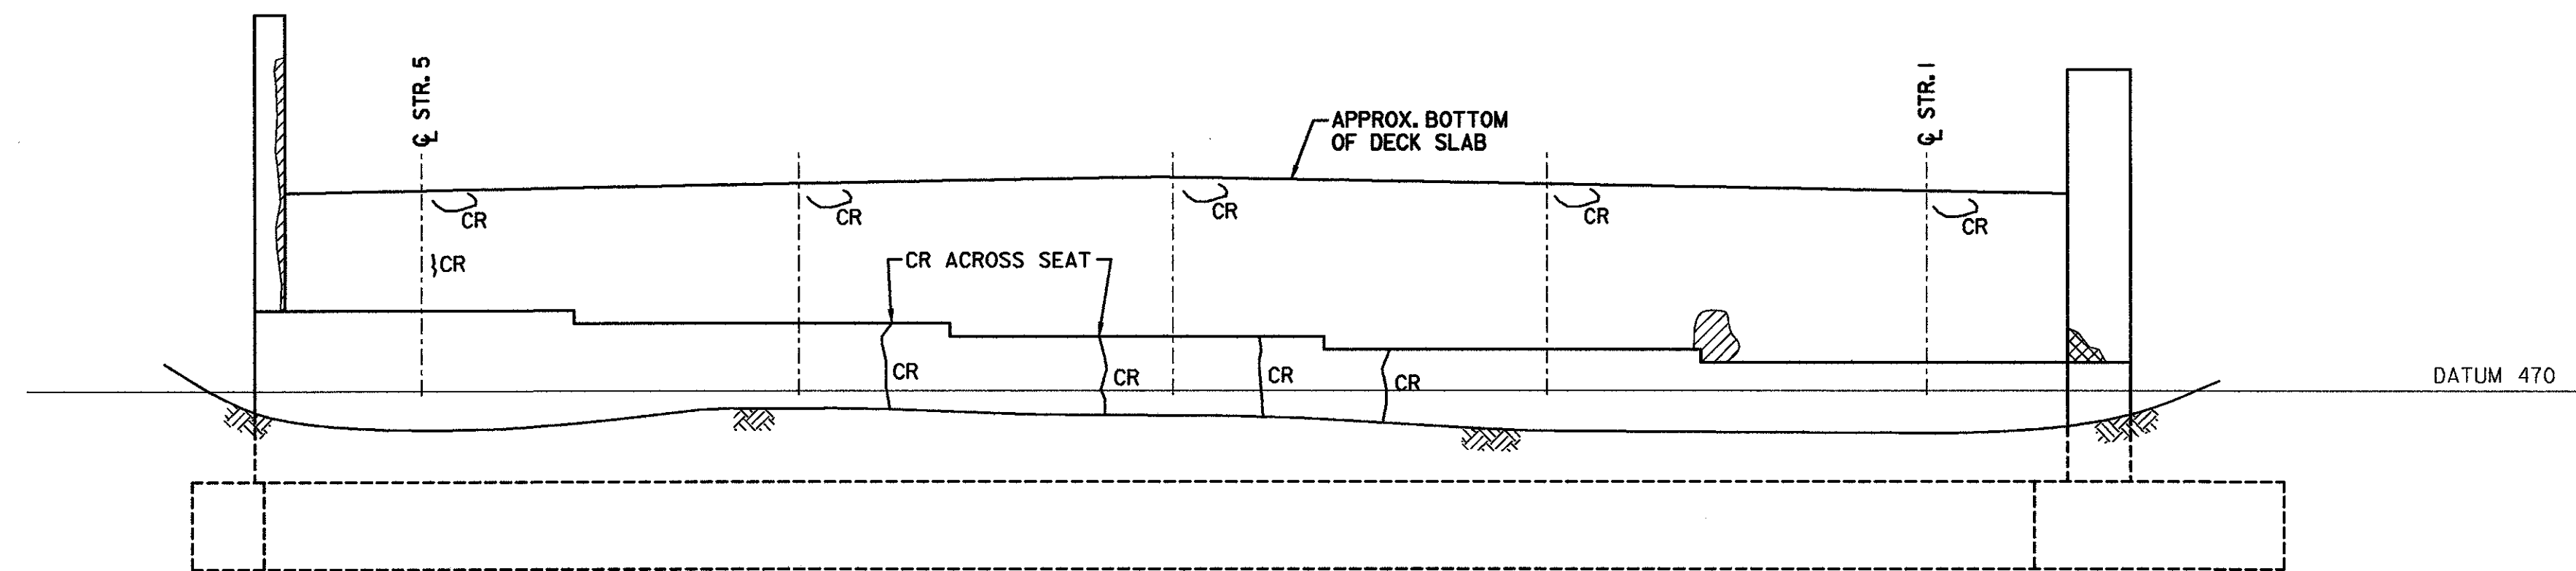

**ABUT. 1 ELEVATION**  
SCALE: 1/4"=1'-0"

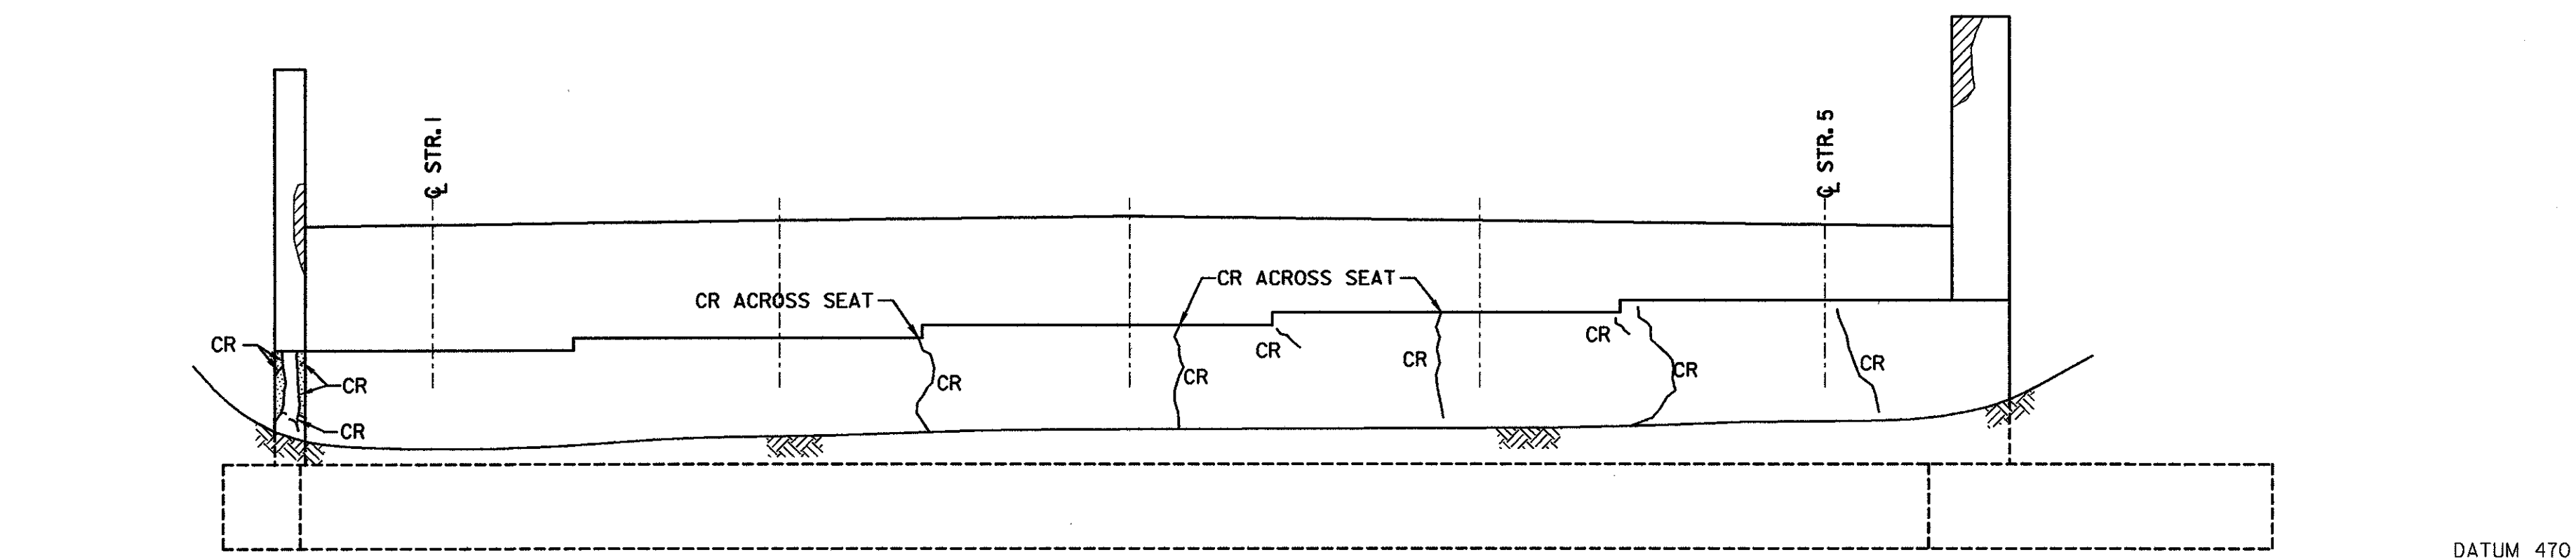


**ABUT. 2 ELEVATION**  
SCALE: 1/4"=1'-0"

**ABBREVIATIONS**  
CR CRACK  
PA PREVIOUSLY PATCHED AREA


**LEGEND**  
CRACK  
DELAMINATED AREA  
SPALLED AREA  
DEEPLY SPALLED WITH EXPOSED REBAR  
EXISTING GROUND

**STATE OF VERMONT  
AGENCY OF TRANSPORTATION**


Town Of	MIDDLESEX-BOLTON	Bridge No.	50N
Highway No.	I-89	Log Sta.	
		Surv. Sta.	
I-89 NB OVER U.S. ROUTE 2			
<b>EXIST. SUBSTR. CONDITION (50N) (2 OF 2)</b>			
Designed By	P.W. SZUSTAK	Drawn By	R.A. BOTZENHART
Checked By	J.P. HALSTEAD	Bridge Design Supervisor	J.P. HALSTEAD
Date	10/99	Date	10/99
PROJECT	MIDDLESEX-BOLTON	PROJECT NO.	IM-089-2(26)
TVGA CAD Drawing No.	50abut	Date	10/99
Bridge Sheet No.	SC-14	Sheet	148 of 307

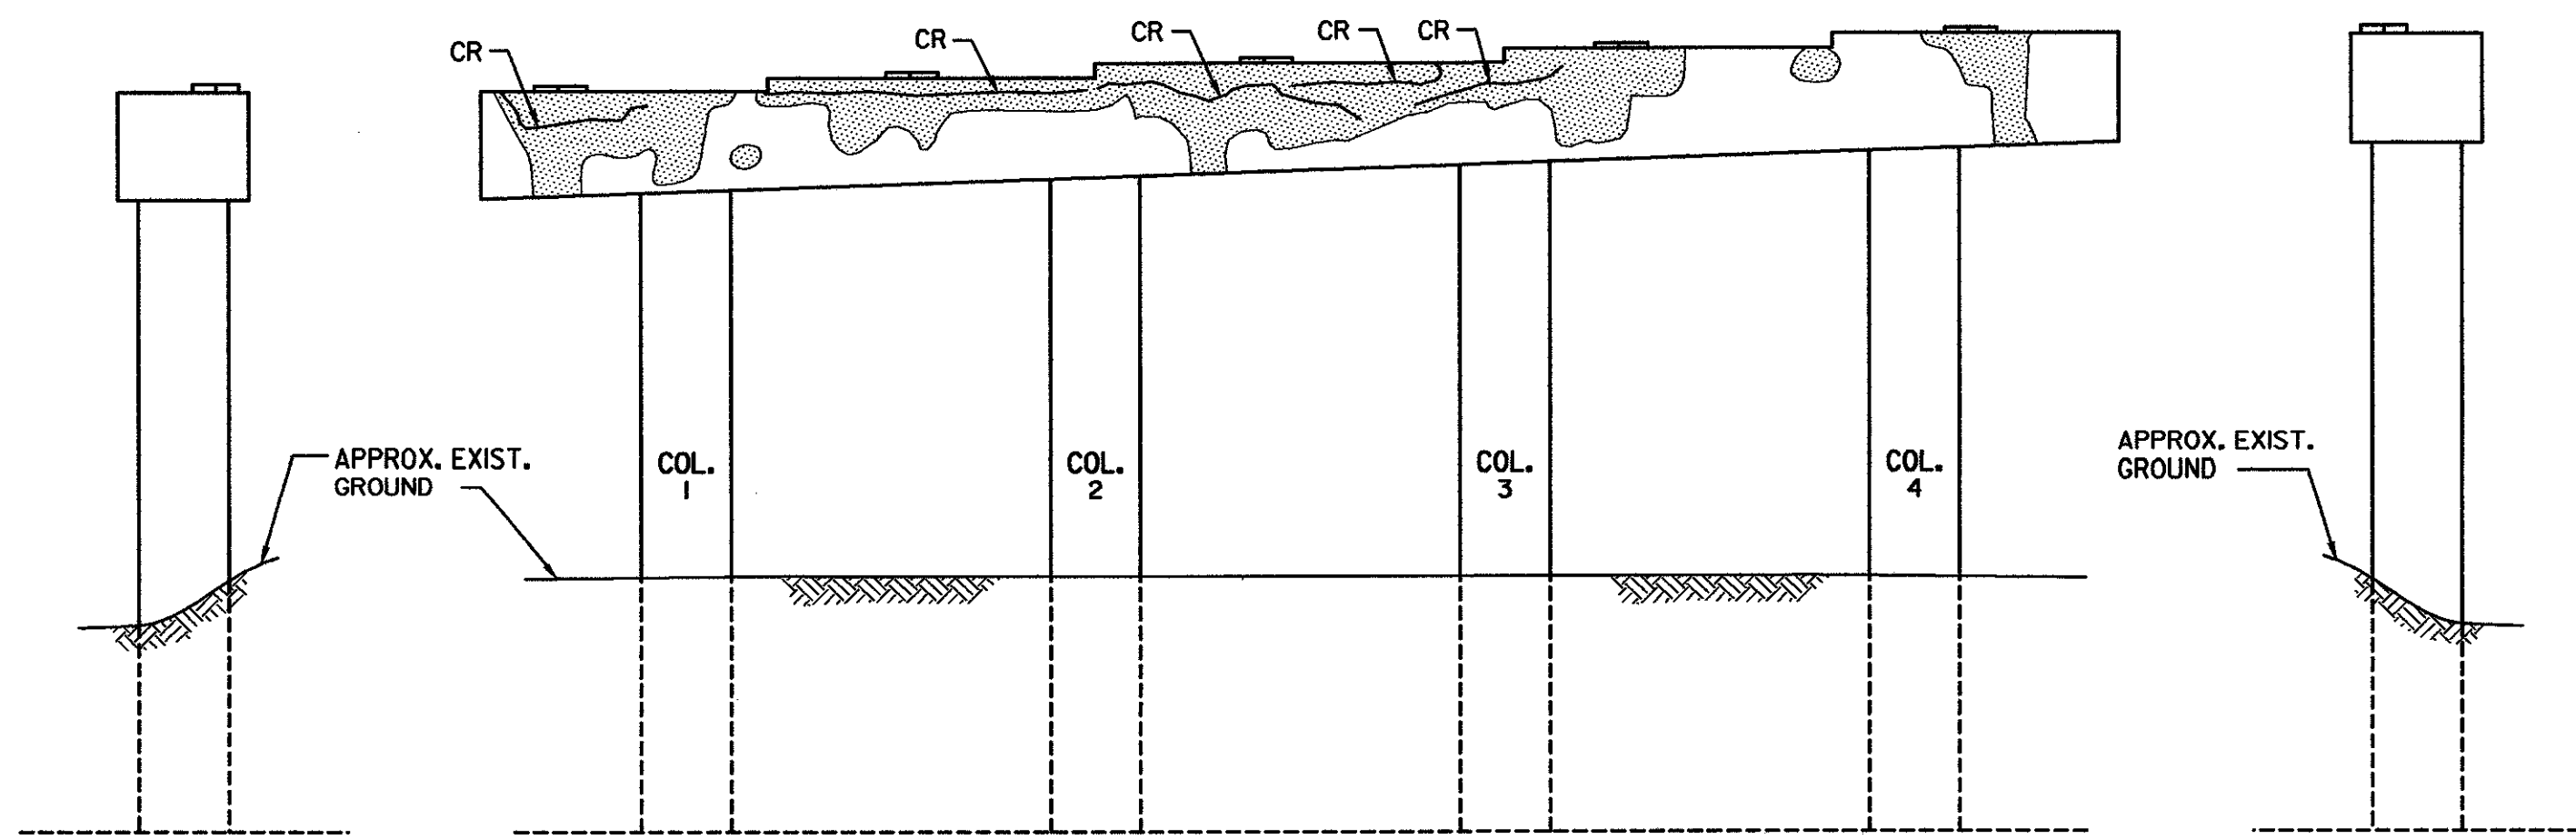

(ABUT. 1 SIDE)

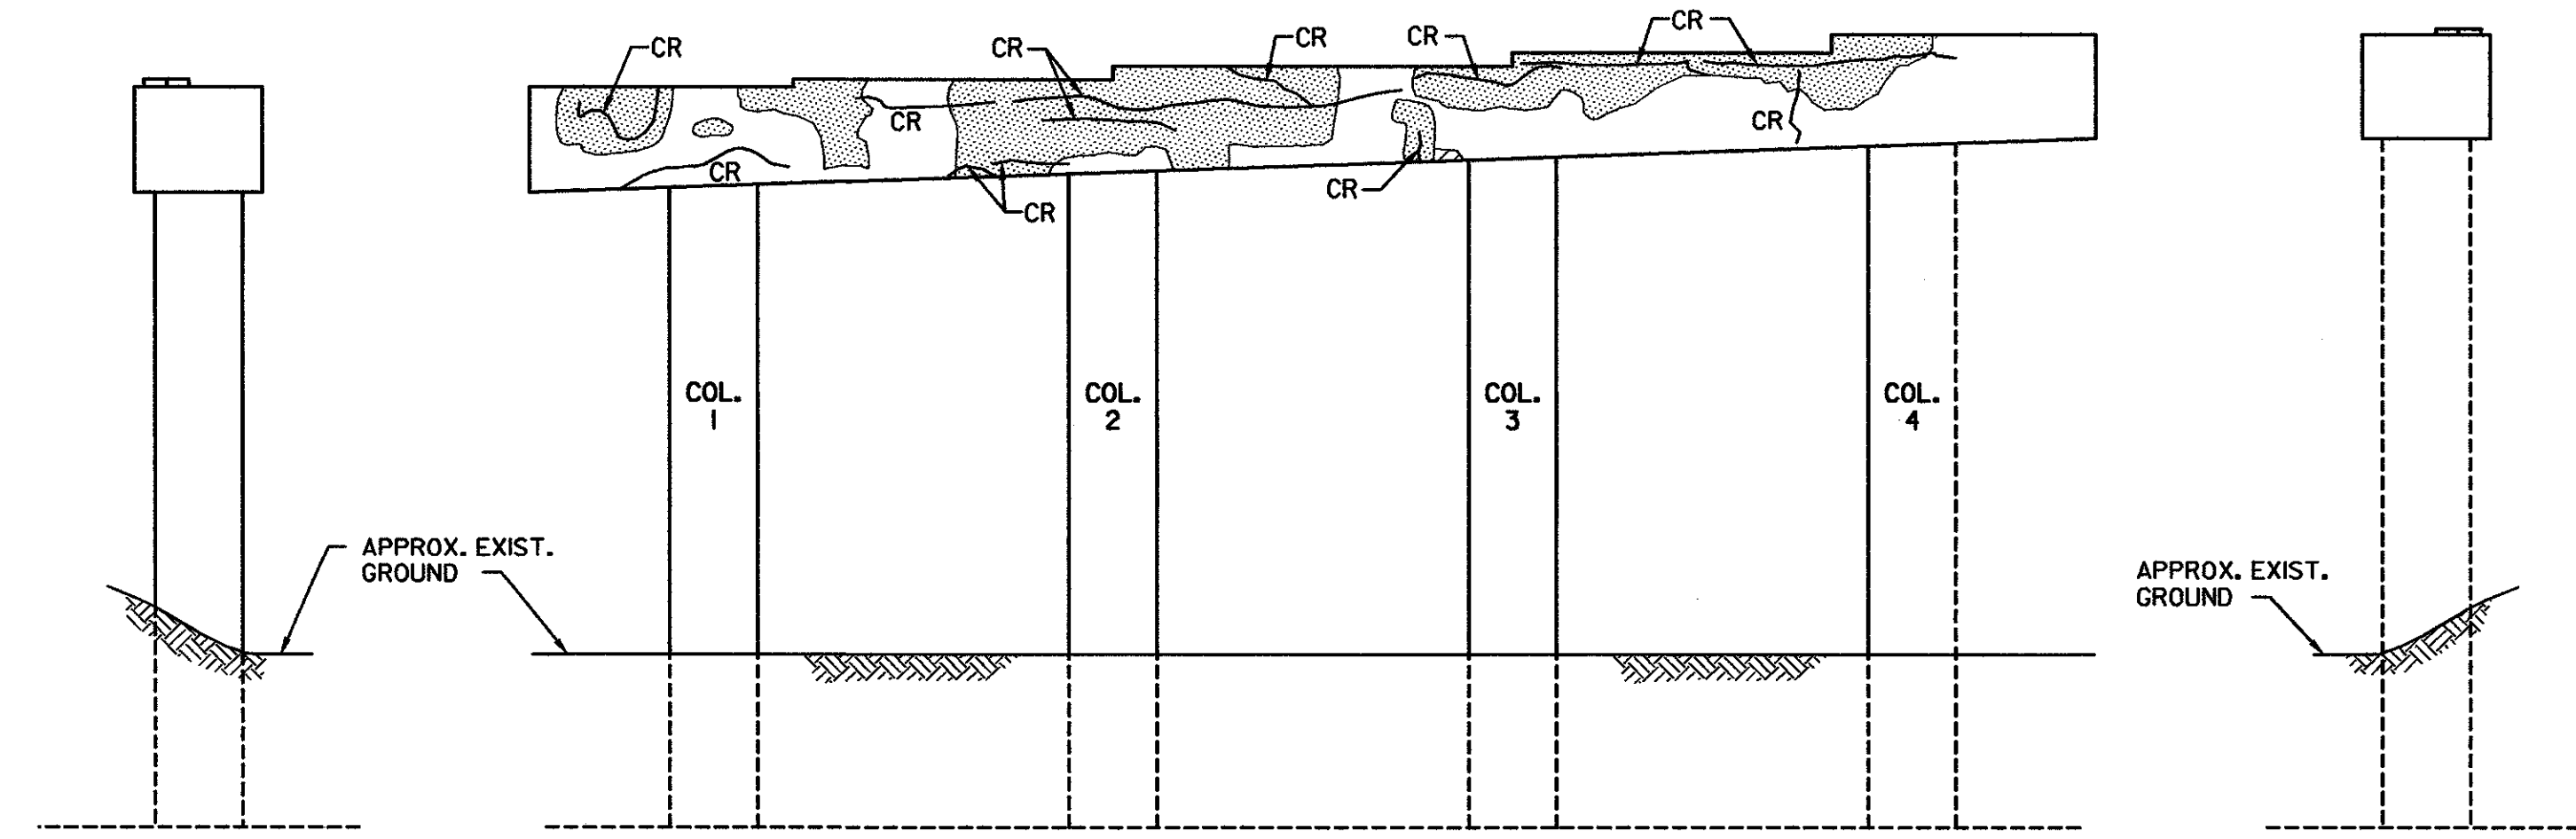


(PIER 1 SIDE)

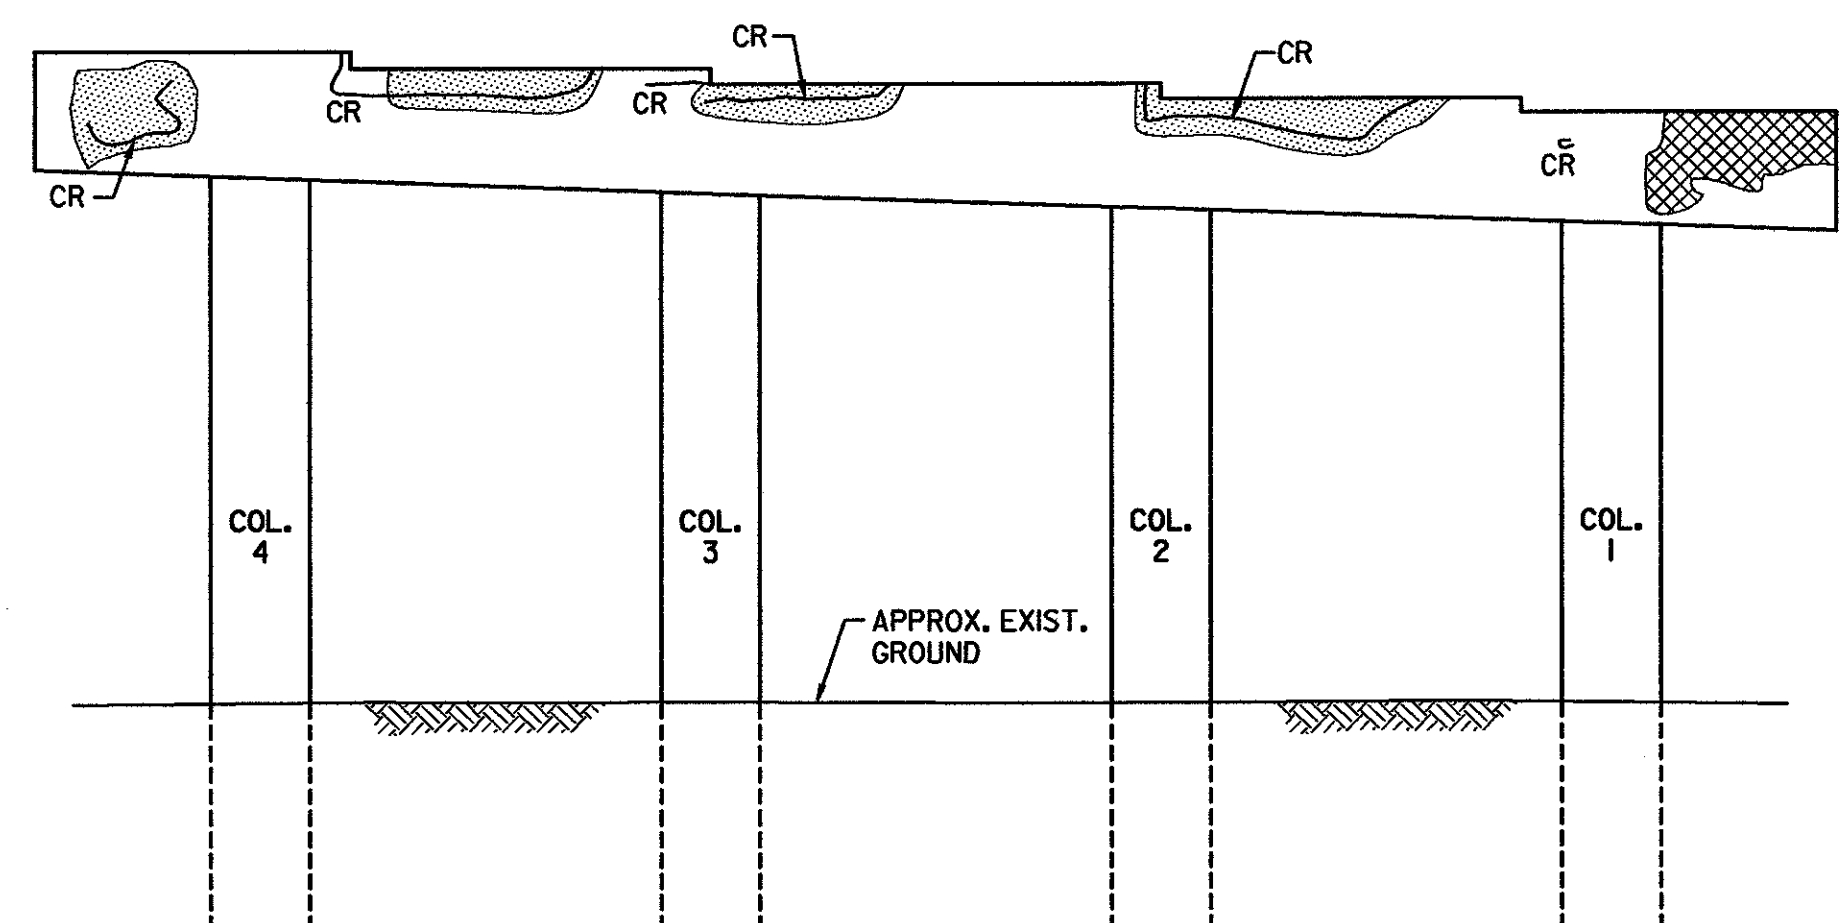

(PIER 2 SIDE)

**PIER 1 ELEVATIONS**

SCALE: 3/16"=1'-0"

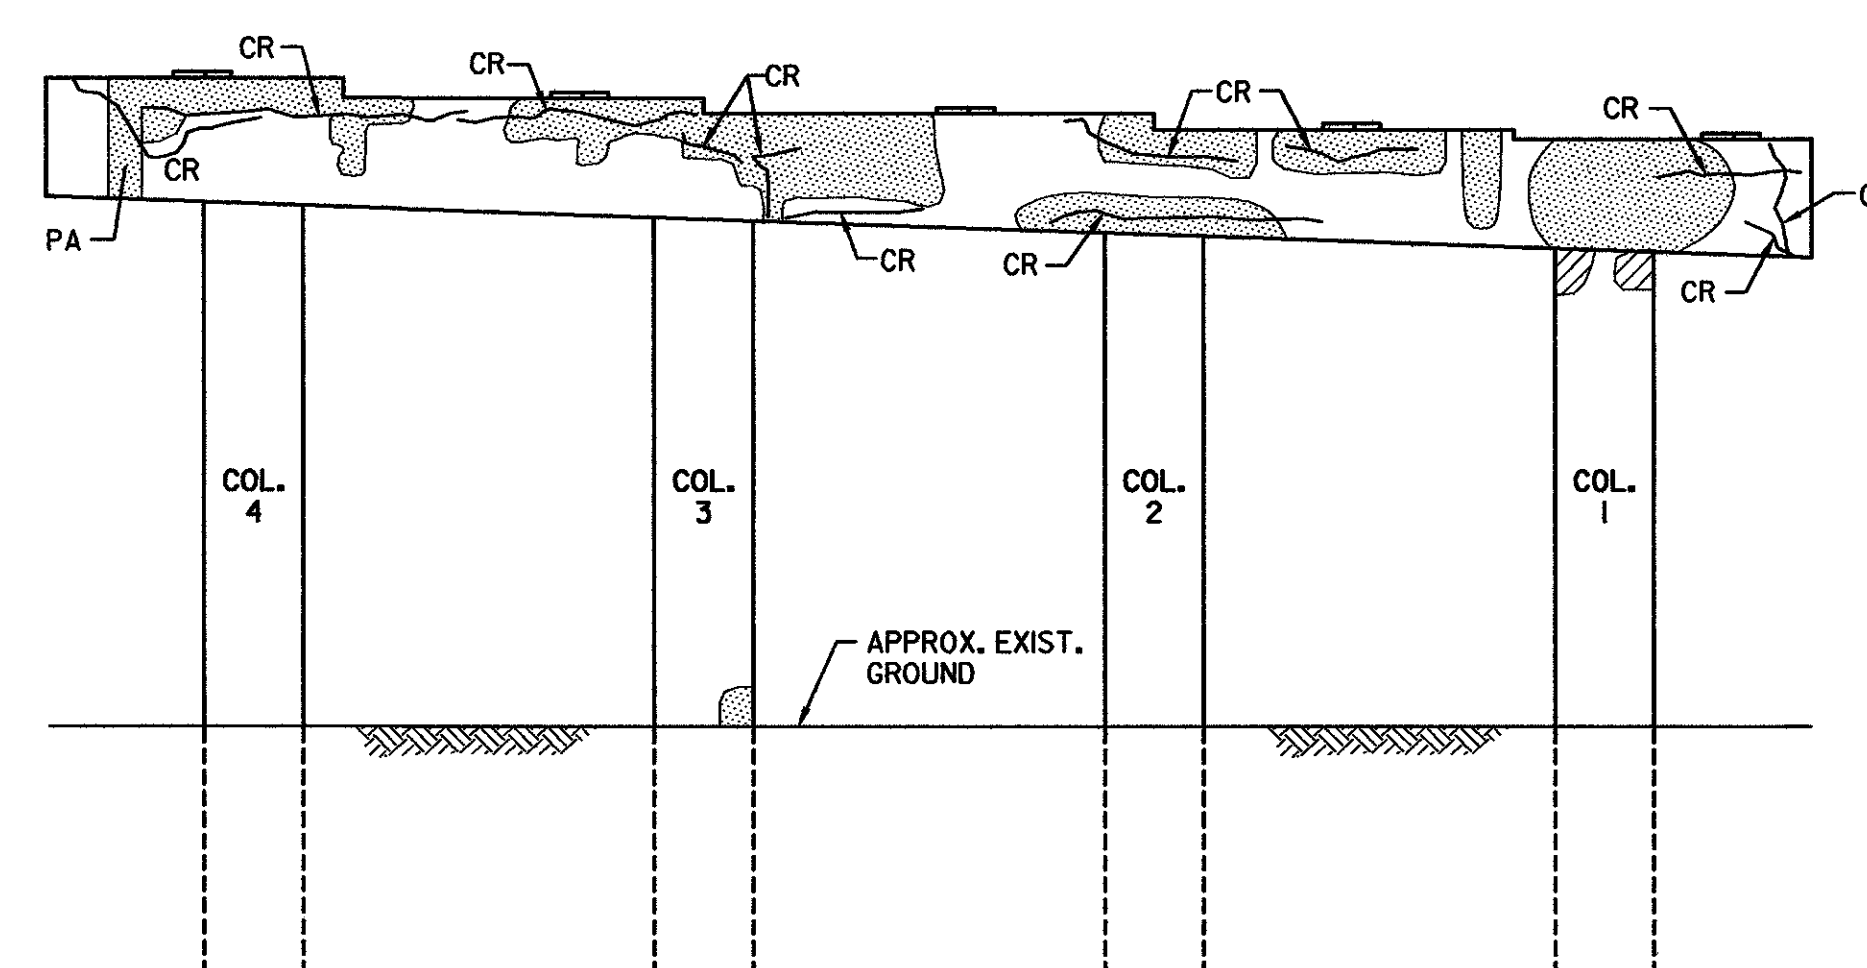

(ABUT. 2 SIDE)

**PIER 2 ELEVATIONS**


SCALE: 3/16"=1'-0"

**ABBREVIATIONS**


CR CRACK  
PA CRACK PREVIOUSLY PATCHED AREA

**LEGEND**

CRACK  
 DELAMINATED AREA  
 SPALLED AREA  
 DEEPLY SPALLED WITH EXPOSED REBAR  
 UNDERGROUND TELEPHONE — UT —  
 UNDERGROUND ELECTRIC — UE —  
 EXISTING GROUND

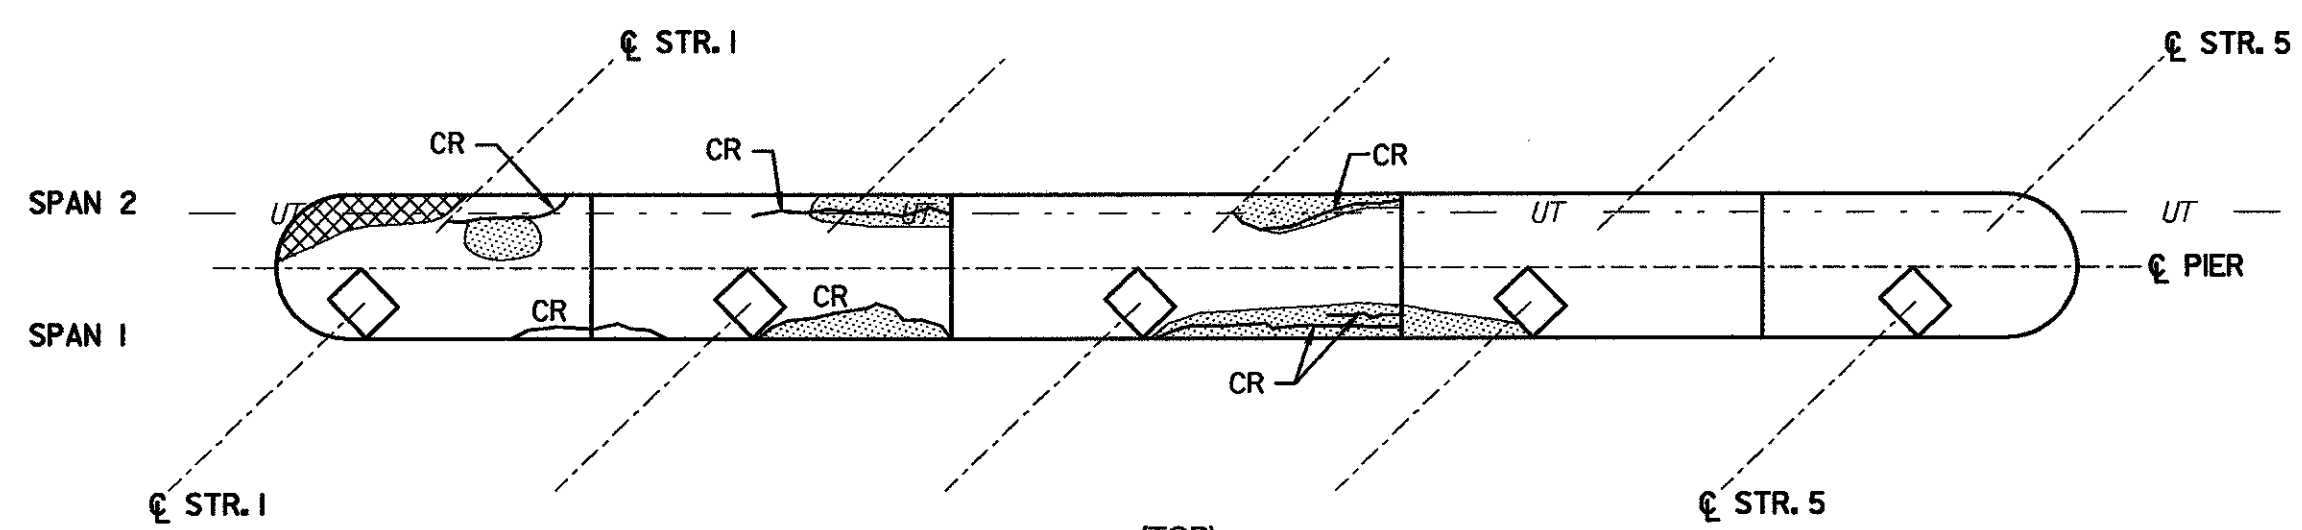


(TOP)

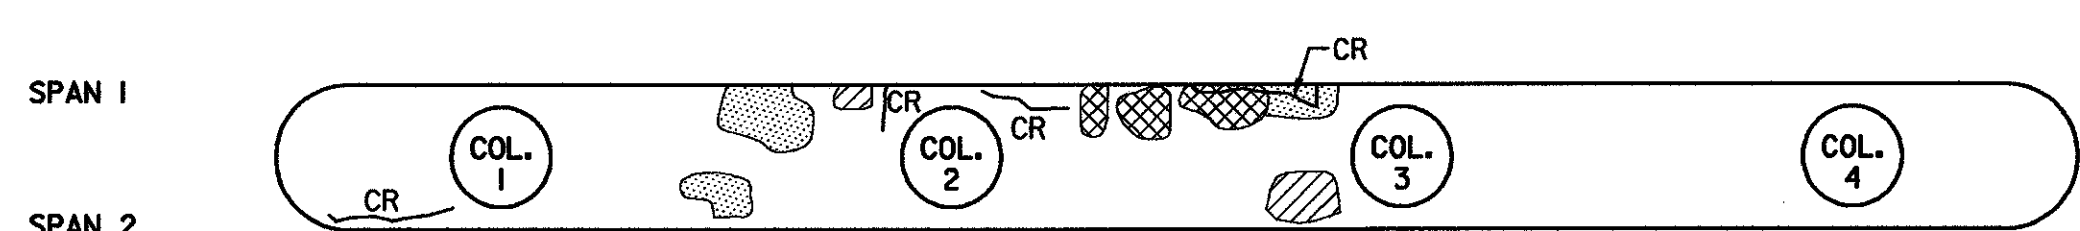


(BOTTOM)

**PIER 1 CAP**

SCALE: 3/16"=1'-0"

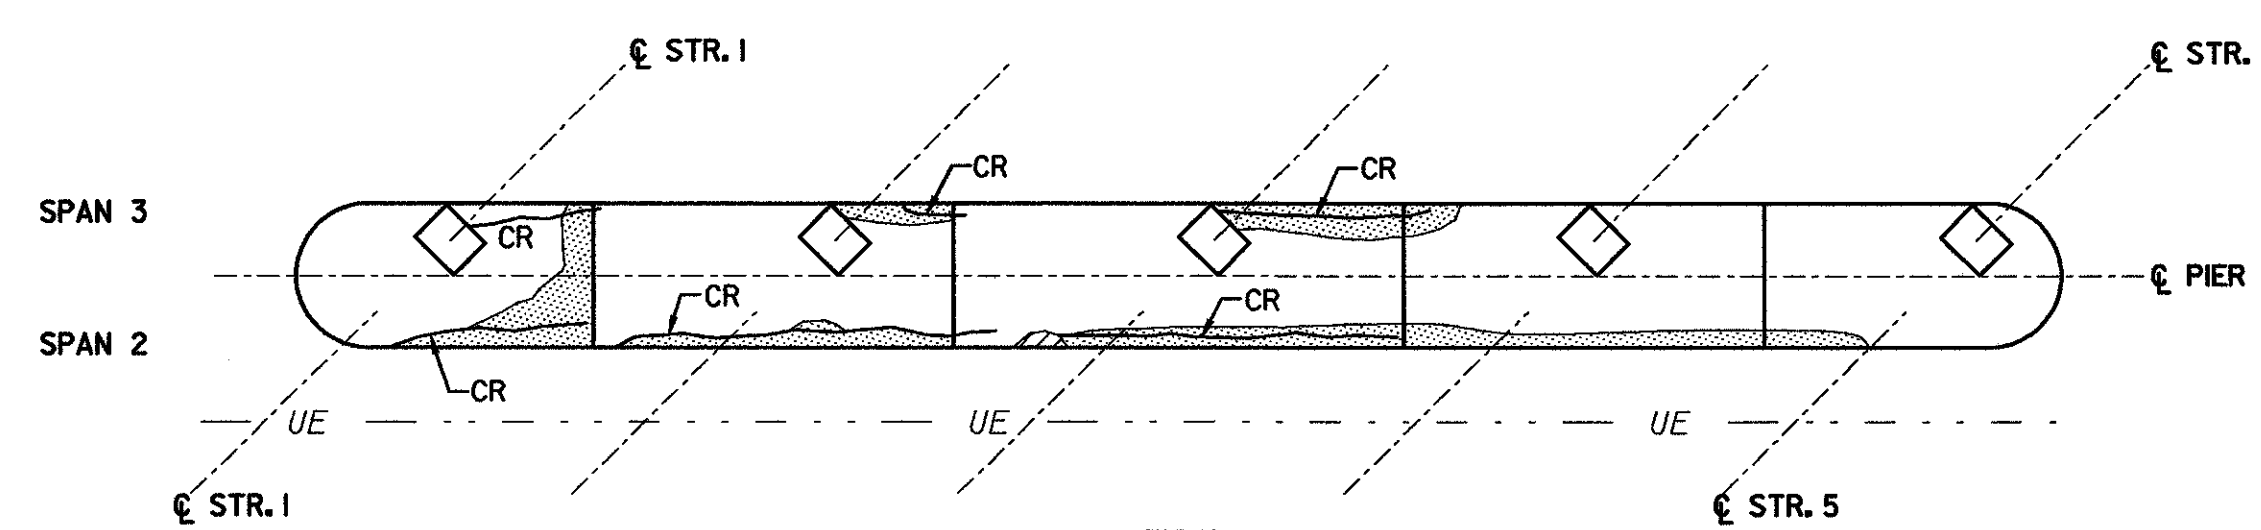

(TOP)

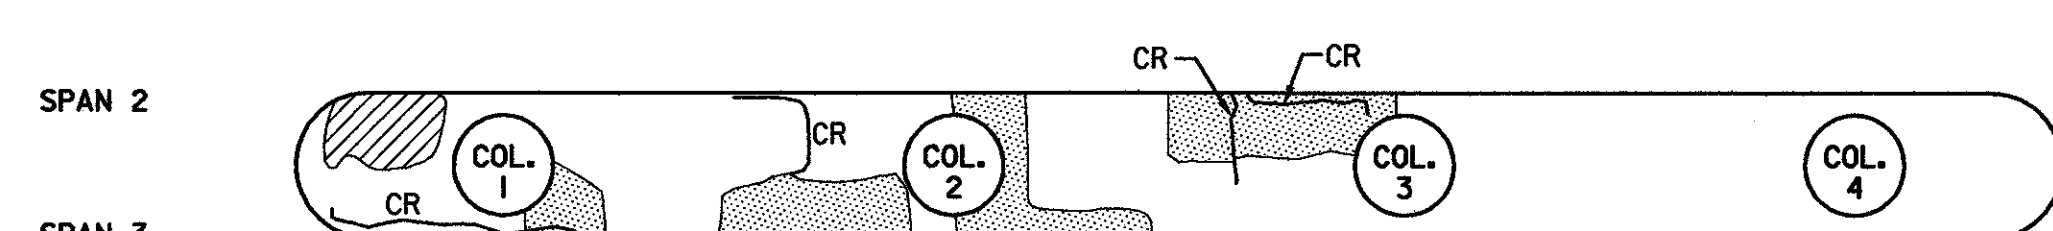


(BOTTOM)

**PIER 2 CAP**


SCALE: 3/16"=1'-0"

**STATE OF VERMONT  
AGENCY OF TRANSPORTATION**

Town Of	MIDDLESEX-BOLTON	Bridge No.	50S
Highway No.	I-89	Log Sta.	
		Surv. Sta.	
I-89 SB OVER U.S. ROUTE 2			
<b>EXIST. SUBSTR. CONDITION (50S) (1 OF 2)</b>			
Designed By	P.W. SZUSTAK	Drawn By	R.A. BOTZENHART
Checked By	J.P. HALSTEAD	Date	10/99
		Bridge Design Supervisor	J.P. HALSTEAD Date 10/99
PROJECT	MIDDLESEX-BOLTON	PROJECT NO.	IM-089-2(26)
TVGA CAD Drawing No.	50plers	Date	10/99
Bridge Sheet No.	SC-15	Sheet	149 of 307

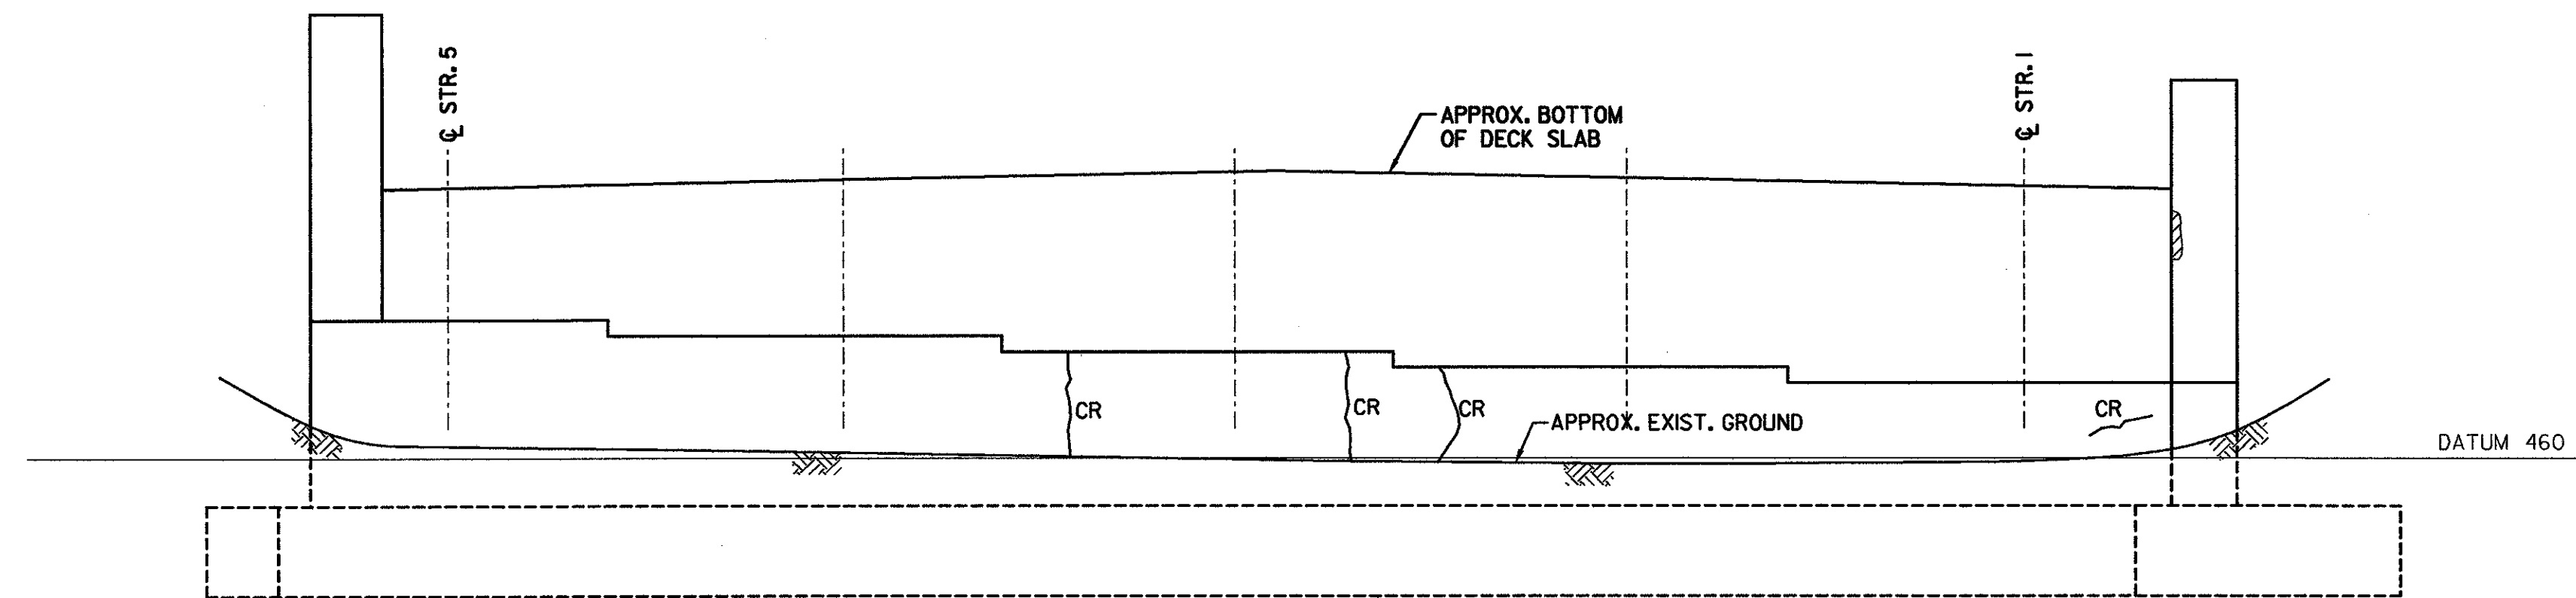

**ABUT. 1 ELEVATION**  
SCALE: 1/4"=1'-0"

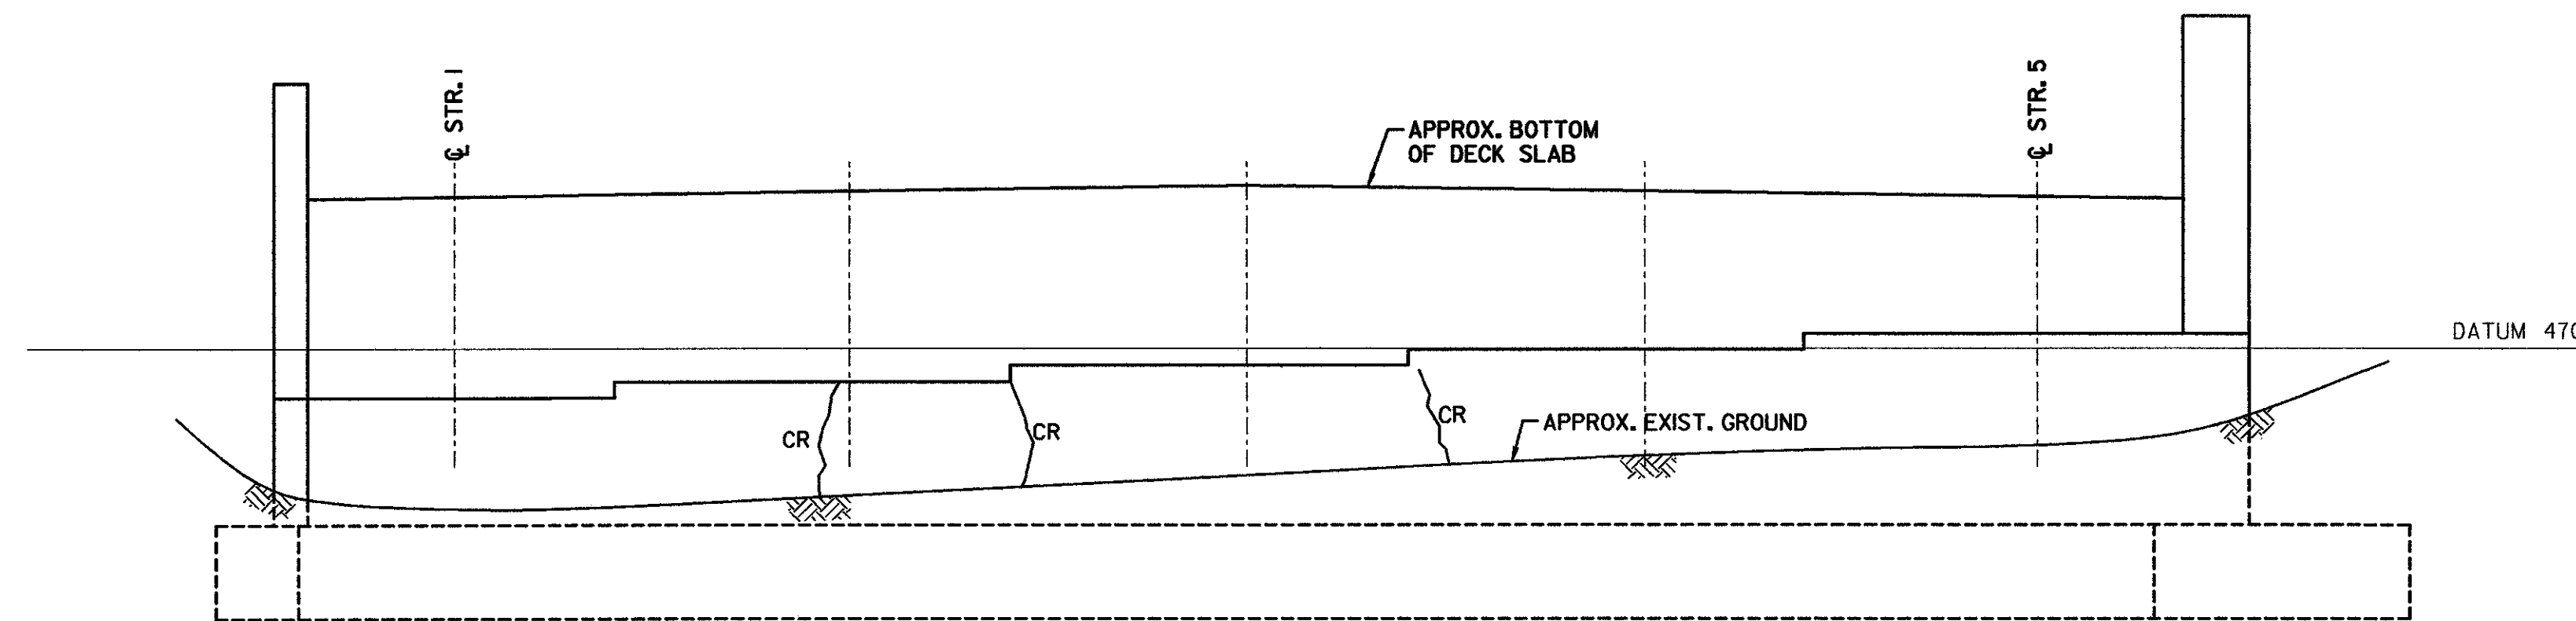

**ABUT. 2 ELEVATION**  
SCALE: 1/4"=1'-0"

**ABBREVIATIONS**  
CR CRACK  
PA PREVIOUSLY PATCHED AREA

**LEGEND**  
CRACK  
DELAMINATED AREA  
SPALLED AREA  
DEEPLY SPALLED WITH EXPOSED REBAR  
EXISTING GROUND

**STATE OF VERMONT  
AGENCY OF TRANSPORTATION**

Town Of	MIDDLESEX-BOLTON	Bridge No.	50S
Highway No.	I-89	Log Sta.	
		Surv. Sta.	
I-89 SB OVER U.S. ROUTE 2			
<b>EXIST. SUBSTR. CONDITION (50S) (2 OF 2)</b>			
Designed By	P.W. SZUSTAK	Drawn By	R.A. BOTZENHART
Checked By	J.P. HALSTEAD	Date	10/99
		Bridge Design Supervisor	J.P. HALSTEAD Date 10/99
PROJECT	MIDDLESEX-BOLTON	PROJECT NO.	IM-089-2(26)
TVGA CAD Drawing No.	50abut	Date	10/99
Bridge Sheet No.	SC-16	Sheet	150 of 307


**TRAFFIC CONTROL NOTES**

1. ALL TRAFFIC CONTROL DEVICES AND PLANS SHALL CONFORM TO THE AMERICAN ASSOCIATION OF STATE HIGHWAY AND TRANSPORTATION OFFICIALS (AASHTO) "GREEN BOOK", THE MANUAL ON UNIFORM TRAFFIC CONTROL DEVICES (MUTCD) AND VERMONT AGENCY OF TRANSPORTATION (VAOT) STANDARD SPECIFICATIONS FOR CONSTRUCTION 1990. THE RESIDENT ENGINEER SHALL HAVE THE AUTHORITY TO ALTER ALL TRAFFIC CONTROL PLANS IN THE FIELD AS NECESSARY.
2. THE CONTRACTOR IS NOTIFIED THAT AN EMERGENCY ACCESS GATE IS LOCATED AT APPROXIMATELY STATION #32+50 (MM 70.25) NORTHBOUND. THE CONTRACTOR SHALL NOT AT ANY TIME THROUGHOUT THE CONSTRUCTION PERIOD USE OR BLOCK THE EXISTING EMERGENCY ACCESS GATE. A NEW PERMANENT U-TURN IS TO BE CONSTRUCTED DIRECTLY ACROSS FROM THE EMERGENCY ACCESS PRIOR TO ANY CONSTRUCTION ACTIVITY. ONCE CONSTRUCTED, THE NEW U-TURN AND THE EMERGENCY ACCESS GATE SHALL NOT BE OBSTRUCTED AT ANY TIME. THE CONTRACTOR SHALL NOTIFY AND COORDINATE ALL CONSTRUCTION ACTIVITIES ASSOCIATED WITH THE EMERGENCY ACCESS GATE AND U-TURN WITH ALL ASSOCIATED EMERGENCY SERVICES PRIOR TO ANY CONSTRUCTION ACTIVITY.  
~~BRIDGE 5IN AND 5IS WERE NOT A PART OF THIS PROJECT~~
3. THE NEW PERMANENT U-TURN SHALL BE CONSTRUCTED IN ACCORDANCE WITH STANDARD B-17. THE EXISTING SLOPES SHALL BE STRIPPED OF ALL EXISTING TOPSOIL PRIOR TO PLACEMENT OF ITEM 304.28 "SUBBASE OF CRUSHED GRAVEL (FINE GRADED)". SUBBASE OF CRUSHED GRAVEL SHALL BE PLACED TO A MINIMUM DEPTH OF 24 INCHES AND THE FINISH SURFACE SHALL BE 2 INCHES OF ITEM 406.25 "BITUMINOUS CONCRETE PAVEMENT". A NEW 18 INCH CPEP SHALL BE PLACED IN THE NEW U-TURN TO MAINTAIN POSITIVE DRAINAGE TO EXISTING DRAINAGE STRUCTURES. PAYMENT FOR THE NEW PIPE SHALL BE UNDER ITEM 604.0915 "18 INCH CPEP". ANY WORK NECESSARY TO REMOVE THE EXISTING TOPSOIL AND LOAM AND SEED THE FINISHED SLOPES SHALL BE CONSIDERED SUBSIDIARY TO ITEM 641.0 "TRAFFIC CONTROL". THE EXISTING U-TURN SIGNS SHALL BE REMOVED AND SALVAGED TO NEW POSTS IN THE NEW PERMANENT U-TURN. PAYMENT FOR THIS WORK SHALL BE UNDER ITEMS 675.50 "REMOVING SIGNS", 675.60 "ERECTING SALVAGED SIGNS", AND 675.35 "SQUARE STEEL SIGN POSTS", RESPECTIVELY.
4. TRAFFIC SHALL BE CONTROLLED AND MAINTAINED AT ALL TIMES THROUGHOUT ALL PHASES OF THIS PROJECT IN ACCORDANCE WITH THE TRAFFIC CONTROL PLANS OR AS DIRECTED BY THE RESIDENT ENGINEER.
5. THE CONTRACTOR WILL BE RESPONSIBLE FOR PROVIDING AND MAINTAINING TRAFFIC CONTROL FOR ALL SIDELINES WHICH WILL REQUIRE LANE CLOSURES ASSOCIATED WITH THIS PROJECT IN ACCORDANCE WITH APPLICABLE STANDARDS. THE CONTRACTOR SHALL DEVELOP A PLAN TO CONTROL TRAFFIC FOR EACH SIDELINE WHICH WILL REQUIRE A LANE CLOSURE AND SUBMIT THIS PLAN TO THE RESIDENT ENGINEER FOR APPROVAL. THE CONTRACTOR SHALL RE-ESTABLISH TWO WAY TRAFFIC ON SIDELINE ROADS PRIOR TO LEAVING THE SITE ON A DAILY BASIS. LANE CLOSURES WILL NOT BE ALLOWED AT NIGHT OR ON WEEKENDS UNLESS APPROVED BY THE RESIDENT ENGINEER. ALL WORK ASSOCIATED WITH SIDELINE TRAFFIC CONTROL SHALL BE SUBSIDIARY TO ITEM 641.0, "TRAFFIC CONTROL".
6. TRAFFIC CONTROL MEASURES WILL NOT BE PERMITTED BETWEEN THE DATES OF NOVEMBER 15 AND APRIL 15 UNLESS OTHERWISE APPROVED BY THE RESIDENT ENGINEER. IN ADDITION, ONCE TRAFFIC CONTROL DEVICES HAVE BEEN INSTALLED, THE CONTRACTOR SHALL BEGIN ASSOCIATED BRIDGE WORK IMMEDIATELY AND PROCEED IN A TIMELY MANNER THROUGH COMPLETION IN ORDER TO MINIMIZE INCONVENIENCE TO THE TRAVELING PUBLIC.

7. THE CONTRACTOR SHALL SUBMIT TRAFFIC CONTROL PLANS AND SCHEDULES FOR ALL WORK ASSOCIATED WITH THIS PROJECT TO THE RESIDENT ENGINEER FOR APPROVAL PRIOR TO ANY CONSTRUCTION ACTIVITY.
8. THE NUMBER AND LOCATION OF REFLECTORIZED PLASTIC DRUMS, TYPE III BARRICADES AND DELINEATORS SHOWN ON THESE PLANS ARE FOR ILLUSTRATIVE PURPOSES ONLY. THE CONTRACTOR SHALL FIELD VERIFY ALL LOCATIONS IN ACCORDANCE WITH THE APPLICABLE STANDARDS PRIOR TO PLACEMENT.
9. MILE MARKERS REFERENCED IN THE DRAWINGS SHALL NOT BE USED FOR LAYOUT PURPOSES; THEY ARE INTENDED FOR REFERENCE ONLY. THE CONTRACTOR SHALL BE RESPONSIBLE FOR VERIFYING ALL MILE MARKERS AND STATIONING NECESSARY TO DESIGN AND CONSTRUCT ALL TRAFFIC CONTROL RELATED ITEMS.
10. NO PRIVATE VEHICLES BELONGING TO THE CONTRACTOR'S EMPLOYEES SHALL BE PARKED ON THE INTERSTATE RIGHT-OF-WAY AND/OR THE TRAVELED WAY OF ANY PUBLIC THOROUGHFARE AT ANY TIME THROUGHOUT THE CONSTRUCTION PERIOD.
11. ANY CLEARING AND GRUBBING DEEMED NECESSARY TO CONSTRUCT CROSSOVERS SHALL BE SUBSIDIARY TO ITEM 635.10, "MOBILIZATION".
12. ALL EXISTING PAVEMENT MARKINGS IN CONFLICT WITH TEMPORARY PAVEMENT MARKINGS AS SHOWN IN THE STANDARD E-103, E-104 AND E-104A, SHALL BE COVERED WITH ITEM 646.86 "BLACK PAVEMENT MARKING MASKING TAPE." WHEN APPLIED, THE BLACK PAVEMENT MARKING MASKING TAPE SHALL BE CUT AT 100' INTERVALS TO PREVENT UNRAVELING.
13. TEMPORARY PAVEMENT MARKINGS ON THE CROSSOVERS IN THE MEDIAN SHALL BE PAID AS ITEMS 646.60 "TEMPORARY 4" WHITE LINE" AND 646.61 "TEMPORARY 4" YELLOW LINE". TEMPORARY PAVEMENT MARKINGS THROUGHOUT THE REST OF THE TRAFFIC CONTROL PACKAGE SHALL BE PAID AS ITEMS 646.40 "TEMPORARY 4" WHITE LINE (TAPE, TYPE II) AND 646.41 "TEMPORARY 4" YELLOW LINE (TAPE, TYPE II).
14. IN ACCORDANCE WITH STD E-103, ITEM 646.81 "RAISED PAVEMENT MARKERS, TYPE II" SHALL BE PLACED AT 20 FOOT INTERVALS.
15. PAYMENT FOR PORTABLE CHANGEABLE MESSAGE SIGNS SHALL BE UNDER ITEM 641.15 "PORTABLE CHANGEABLE MESSAGE SIGN" AND PAYMENT FOR FLASHING ARROW PANELS SHALL BE UNDER ITEM 641.16 "PORTABLE ARROW BOARD." PAYMENT FOR TRAFFIC CONTROL SIGNS, PLASTIC DRUMS, DELINEATORS, FLEXIBLE TUBULAR MARKERS, TYPE II BARRICADES AND TYPE III (MOD.) BARRICADES SHALL BE UNDER ITEM 641.0 "TRAFFIC CONTROL". PAYMENT SHALL INCLUDE ALL NECESSARY MAINTENANCE AND REPAIRS TO THESE TRAFFIC CONTROL DEVICES ON A DAILY BASIS. THE ENGINEER MAY ADD TRAFFIC CONTROL SIGNS AS NECESSARY. ADDITIONAL SIGNS, INCLUDING POSTS AND FOUNDATIONS, SHALL BE PAID FOR AS ITEM 675.20, "TRAFFIC SIGNS, TYPE A (MOD.)" IN ACCORDANCE WITH THE SPECIAL PROVISIONS.
16. THE CONTRACTOR SHALL KEEP AN EXTRA PORTABLE CHANGEABLE MESSAGE BOARD AND A PORTABLE ARROW BOARD ON SITE TO BE USE AS A "BACK-UP" IN THE EVENT THAT A PORTABLE CHANGEABLE MESSAGE BOARD OR A PORTABLE ARROW BOARD IS RENDERED INOPERATIVE. PAYMENT FOR ADDITIONAL PORTABLE CHANGEABLE MESSAGE BOARD AND PORTABLE ARROW BOARD SHALL BE PAID FOR UNDER ITEMS 641.15 AND 641.16 RESPECTIVELY.
17. FOR CLARITY, NOT ALL EXISTING SIGNS ARE SHOWN ON THE PLANS. CONTRACTOR SHALL VERIFY LOCATION OF ALL EXISTING SIGNS IN THE FIELD. PLACEMENT OF CONSTRUCTION SIGNS SHALL BE DIRECTED BY THE RESIDENT ENGINEER WHERE CONFLICTS WITH EXISTING SIGNS OCCUR.

18. THE CONTRACTOR SHALL COVER OR REMOVE ANY SIGNS THAT CONTRADICT TEMPORARY TRAFFIC CONTROL SIGNS. ALL SIGNS REMOVED OR COVERED BY THE CONTRACTOR SHALL BE REPLACED OR UNCOVERED BY THE CONTRACTOR WHEN THE TRAFFIC CONTROL PLAN IS DISASSEMBLED. A TEMPORARY OVERLAY "CLOSED" SIGN SHALL BE PLACED ON THE "REST AREA NEXT RIGHT" SIGN AT STA 876+50 NORTHBOUND AND STA 964+80 SOUTHBOUND DURING CONSTRUCTION. THE CONTRACTOR SHALL SUBMIT A SIGN DETAIL AND ATTACHMENT PROCEDURES TO THE RESIDENT ENGINEER FOR APPROVAL PRIOR TO INSTALLATION. PAYMENT FOR REMOVAL AND REPLACEMENT, COVERING AND UNCOVERING OF SIGNS AND PLACEMENT AND REMOVAL OF TEMPORARY OVERLAYS SHALL BE SUBSIDIARY TO ITEM 641.0, "TRAFFIC CONTROL". ANY DAMAGE TO EXISTING SIGNS BY THE CONTRACTOR SHALL BE REPLACED BY THE CONTRACTOR WITH NO EXTRA COMPENSATION.
19. DURING BRIDGE REHABILITATION OPERATIONS, TRAVEL LANES UNDER THE BRIDGE SHALL BE PROTECTED BY ENCLOSING THE AREA BELOW THE DECK (WITHOUT REDUCING OVERHEAD CLEARANCE). THE CONTRACTOR SHALL SUBMIT DETAILS OF PROTECTIVE ENCLOSURES TO THE RESIDENT ENGINEER FOR APPROVAL. COSTS FOR PROVIDING PROTECTIVE ENCLOSURES SHALL BE PAID FOR UNDER ITEM 527.11 "TRAFFIC PROTECTION FOR BRIDGE PROJECT".
20. WHERE CROSSOVERS ARE TO BE PLACED, EXISTING SLOPES SHALL BE STRIPPED OF TOPSOIL AND BENCHED AS DIRECTED BY THE ENGINEER. FILL MATERIAL SHALL BE APPROVED BY THE ENGINEER PRIOR TO PLACEMENT AND SHALL BE FREE OF EXCESSIVE AMOUNTS OF MOISTURE, ORGANICS, AND SILTS. SUBBASE MATERIAL SHALL BE APPROVED BY THE RESIDENT ENGINEER PRIOR TO PLACEMENT AND SHALL BE PLACED TO A MAXIMUM DEPTH OF 12 INCHES. PAVING OF CROSSOVER DETOURS SHALL BE PAID FOR AS ITEM 406.25, "BITUMINOUS PAVEMENT, TYPE III". THE PAVEMENT SHALL BE PLACED IN A SINGLE COURSE OF 2 INCHES OF DEPTH. THE COST OF ALL OTHER WORK REQUIRED FOR THE DESIGN, CONSTRUCTION AND REMOVAL OF CROSSOVERS SHALL BE SUBSIDIARY TO ITEM 641.0 "TRAFFIC CONTROL".
21. THE CONTRACTOR SHALL BE RESPONSIBLE FOR INSTALLING, MAINTAINING AND REMOVING TEMPORARY DRAINAGE STRUCTURES AS NECESSARY TO MAINTAIN POSITIVE DRAINAGE TO EXISTING DRAINAGE STRUCTURES (IE: CATCH BASINS, CULVERTS) WHICH COULD BECOME BLOCKED FROM INSTALLATION OF THE CROSSOVERS. THE CONTRACTOR SHALL VERIFY THE LOCATION OF EXISTING DRAINAGE STRUCTURES AND SUBMIT A TEMPORARY DRAINAGE PLAN FOR EACH CROSS OVER TO THE RESIDENT ENGINEER FOR APPROVAL. PAYMENT FOR DEVELOPMENT OF THIS PLAN AND ALL CONSTRUCTION ACTIVITIES ASSOCIATED WITH TEMPORARY DRAINAGE SHALL BE CONSIDERED SUBSIDIARY TO ITEM 641.0, "TRAFFIC CONTROL".

NOTE: THIS PROJECT ORIGINALLY INCLUDED BRIDGES 5IN&S, WHICH HAVE BEEN SUBSEQUENTLY REMOVED TO FORM A NEW CONSTRUCTION CONTRACT FOR BRIDGES 43N&S, 48N&S, 49N&S, AND 50N&S ONLY. ANY REFERENCE IN THESE PLANS OR IN THE SPECIFICATIONS TO BRIDGES 5IN&S SHALL BE IGNORED.

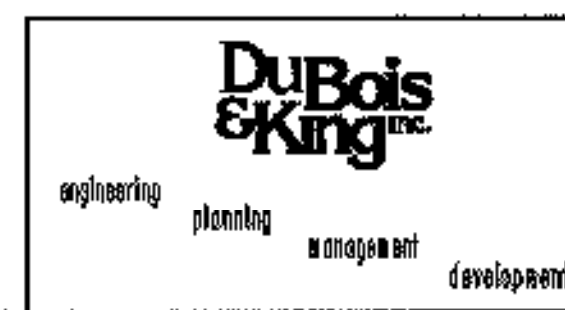


<b>STATE OF VERMONT AGENCY OF TRANSPORTATION</b>			
Town Of	MIDDLESEX-BOLTON	Bridge No.	-
Highway No.	1-89	Log Sta.	
		Surv. Sta.	
1-89 PHASE I & PHASE II CONSTRUCTION			
<b>TRAFFIC CONTROL NOTES</b>			
Designed By	J.M. SMYRSKI/K.S. MARSH	Drawn By	S. E. SCHMITT
Checked By	J. W. TUCKER	Date	10/99
		Bridge Design Supervisor	J. P. HALSTEAD
		Date	10/99
PROJECT	MIDDLESEX-BOLTON	PROJECT NO.	IM-089-2(26)
Drawing No.	... \TRAFFICO.DGN	Date	OCT 1999
Bridge Sheet No.	TC-1A	Sheet	160 of 307

**TRAFFIC CONTROL NOTES (CONT.)**


22. THE CONTRACTOR WILL BE REQUIRED TO INSTALL, MAINTAIN AND REMOVE TEMPORARY EROSION CONTROL MEASURES TO PREVENT EROSION OF FILL MATERIAL ASSOCIATED WITH THE CROSSOVERS AND FOR AREAS WHICH ARE DISTURBED DURING CONSTRUCTION. THE CONTRACTOR SHALL DEVELOP A TEMPORARY EROSION CONTROL PLAN IN ACCORDANCE WITH STANDARDS T-1 AND T-2 AND SUBMIT IT TO THE RESIDENT ENGINEER FOR APPROVAL PRIOR TO CONSTRUCTION. PAYMENT FOR TEMPORARY EROSION CONTROL MEASURES SHALL BE FOR AS ITEM 651.26 "HAY BALES FOR EROSION CONTROL" AND ITEM 649.51 "GEOTEXTILE FOR SILT FENCE".
23. WHERE CROSSOVERS TRAVERSE AN EXISTING U-TURN, THE CONTRACTOR SHALL MAINTAIN A SMOOTH TRANSITION THROUGHOUT THE CROSSOVER. ANY EXCAVATION OR FILL NECESSARY TO PROVIDE A SMOOTH TRANSITION DURING CONSTRUCTION AND RETURN THE U-TURN TO ORIGINAL CONDITION AS DIRECTED BY THE RESIDENT ENGINEER SHALL BE SUBSIDIARY TO ITEM 641.10 "TRAFFIC CONTROL".
24. ALL GUARDRAIL, BRIDGE APPROACH RAIL OR BRIDGE RAIL THAT IS LAPPED IN THE OPPOSITE DIRECTION OF TRAVEL SHALL BE TEMPORARILY RESET TO PROVIDE LAPS IN THE DIRECTION OF TRAVEL. ANY WORK REQUIRED TO CHANGE DIRECTION OF THE LAPS DURING CONSTRUCTION AND RESTORE TO ORIGINAL CONDITION AFTER CONSTRUCTION OR RESET RAILING SHALL BE SUBSIDIARY TO ITEM 641.10 "TRAFFIC CONTROL".
25. WHERE END TERMINALS DO NOT MEET APPLICABLE STANDARDS FOR APPROACHING TRAFFIC WITHIN THE CROSSOVERS, THE EXISTING END TERMINALS WILL BE REMOVED AND A MANUFACTURED TERMINAL SECTION (MTS) SHALL BE INSTALLED AND PAID AS ITEM 621.505 "MANUFACTURED TERMINAL SECTION". UPON REMOVAL OF THE CROSSOVER, THE MANUFACTURED TERMINAL SECTION SHALL BE REMOVED, DELIVERED TO THE VAOT MIDDLESEX MAINTENANCE FACILITY AND THE ORIGINAL END TERMINAL INSTALLED. PAYMENT FOR REMOVAL OF THE MANUFACTURED TERMINAL SECTION AND INSTALLATION OF THE EXISTING END TERMINAL SHALL BE SUBSIDIARY TO ITEM 641.10 "TRAFFIC CONTROL".
26. THE CONTRACTOR SHALL REPLACE ALL DELINEATOR POSTS, DELINEATORS, GUARDRAIL, APPROACH RAIL AND BRIDGE RAIL THAT IS DAMAGED OR DESTROYED BY THE CONTRACTOR WITH NO ADDITIONAL COMPENSATION.
27. THE CONTRACTOR SHALL BE RESPONSIBLE FOR REMOVAL OF THE CROSSOVERS AND RE-ESTABLISHMENT OF TURF AND VEGETATION ON ALL PORTIONS OF THE SITE THAT HAVE BEEN DISTURBED DURING CONSTRUCTION. ALL COSTS FOR THIS WORK SHALL BE CONSIDERED SUBSIDIARY TO ITEM 641.10, "TRAFFIC CONTROL."
28. THE CONTRACTOR SHALL MAINTAIN POSITIVE DRAINAGE FOR ALL EXISTING DRAINAGE STRUCTURES AND SYSTEMS. NO STAGNATION OF OR EROSION FROM STORMWATER SHALL BE PERMITTED ON ACCOUNT OF TEMPORARILY CONSTRUCTED TRAFFIC CONTROL STRUCTURES OR DEVICES. PAYMENT FOR THIS WORK WILL BE CONSIDERED SUBSIDIARY TO ITEM 641.10, "TRAFFIC CONTROL."
29. THROUGHOUT THE BRIDGE 48, 49 AND 50 CROSSOVER TEMPORARY EMERGENCY REFUGES SHALL BE CONSTRUCTED FOR DISABLED VEHICLES TRAVELLING IN THE OPPOSING LANES OF THE HIGHWAY (I.E. NORTHBOUND TRAFFIC IN THE SOUTHBOUND BARREL). THE REFUGES SHALL HAVE 50ft ENTRANCE AND EXIT TAPERS WITH A TANGENT SECTION 10 FEET WIDE AND 100 FEET IN LENGTH. THESE REFUGES SHALL BE CONSTRUCTED APPROXIMATELY EVERY 1/2 MILE THROUGHOUT THE CROSSOVER AS DIRECTED BY THE RESIDENT ENGINEER. THE SURFACE OF THE REFUGES SHALL BE SUBBASE OF CRUSHED GRAVEL. PAYMENT FOR ALL WORK NECESSARY TO CONSTRUCT AND REMOVE THE TEMPORARY EMERGENCY REFUGES SHALL BE SUBSIDIARY TO ITEM 641.10 "TRAFFIC CONTROL".

30. ALL EXISTING 65 MILE PER HOUR SPEED LIMIT SIGNS LOCATED WITHIN THE LIMITS OF THE TRAFFIC CONTROL SHOWN ON THESE SHEETS SHALL BE COVERED DURING CONSTRUCTION. PAYMENT FOR COVERING AND UNCOVERING OF SIGN SHALL BE SUBSIDIARY TO ITEM 641.10 "TRAFFIC CONTROL".

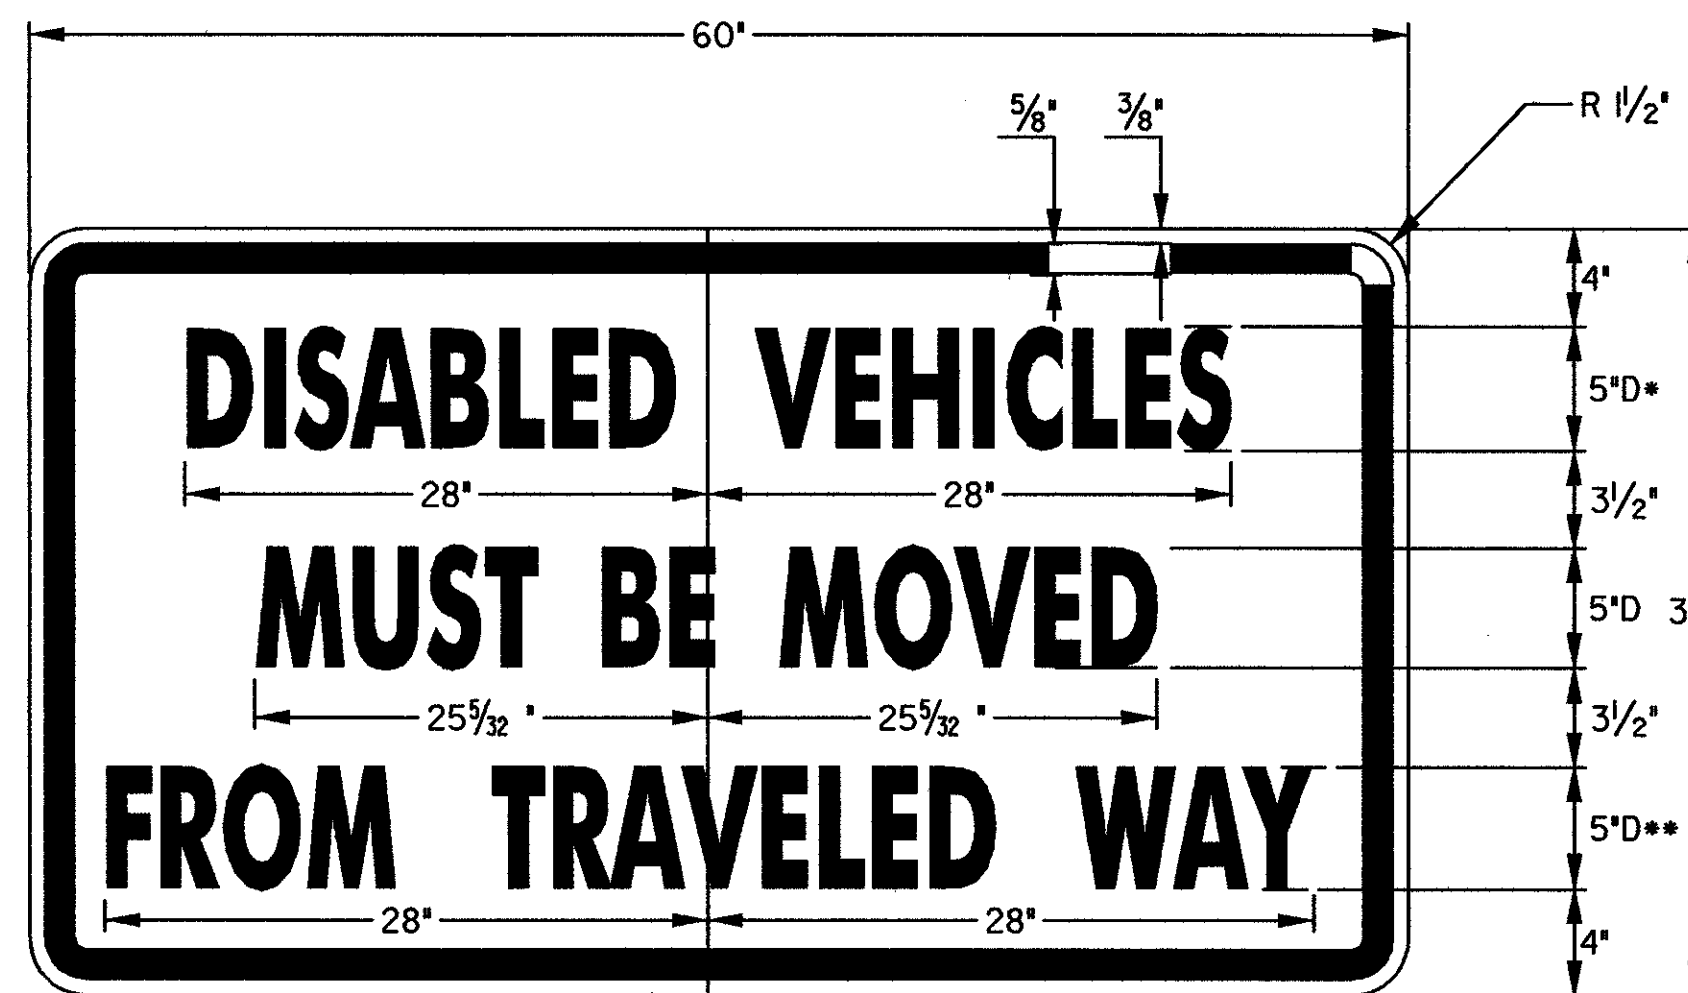

**VC-838**

\* REDUCE SPACING BY 5%  
 \*\* REDUCE SPACING BY 13%  
 COLORS: BLACK TEXT AND BORDER  
 WITH REFLECTORIZED ORANGE BACKGROUND

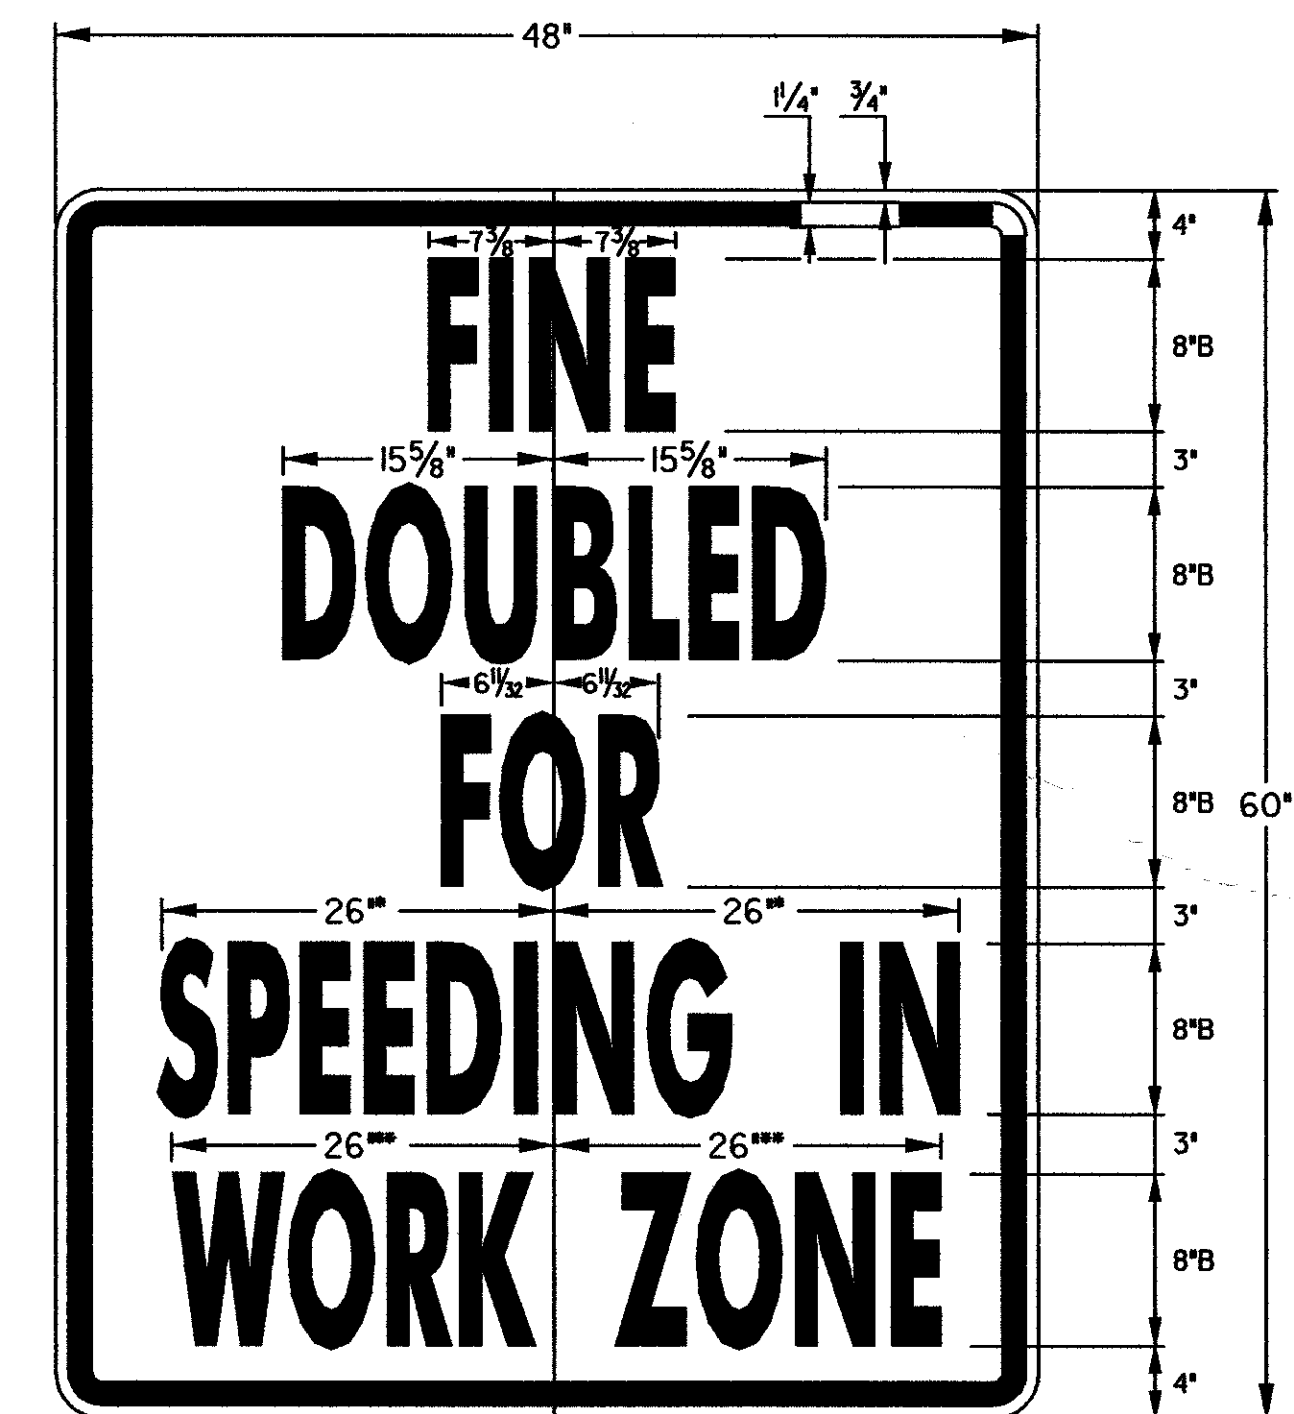


**VR-355**




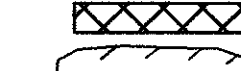
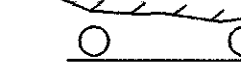


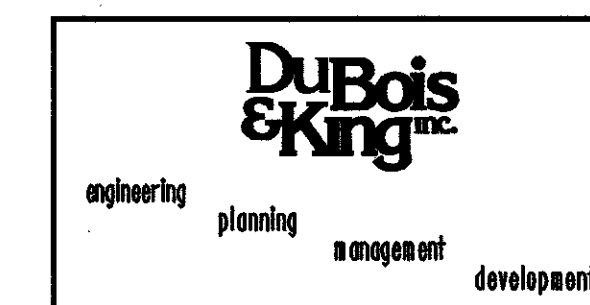



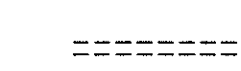



EXPWY FWY 26\*\* REDUCE SPACING BY 12%  
 EXPWY FWY 26\*\*\* REDUCE SPACING BY 7.7%  
 COLORS: BLACK TEXT AND BORDER  
 WITH WHITE REFLECTORIZED BACKGROUND


**STATE OF VERMONT  
 AGENCY OF TRANSPORTATION**

Town Of	MIDDLESEX-BOLTON	Bridge No.	-
Highway No.	I-89	Log Sta.	
		Surv. Sta.	
I-89 PHASE I & PHASE II CONSTRUCTION			
<b>TRAFFIC CONTROL NOTES</b>			
Designed By	J.M.SMYRSKI/K.S.MARSHA	Drawn By	S. E. SCHMITT
Checked By	J. W. TUCKER	Date	10/99
		Bridge Design Supervisor	J. P. HALSTEAD Date 10/99
PROJECT	MIDDLESEX-BOLTON	PROJECT NO.	IM-089-2(26)
Drawing No.	...TRAFFICO.DGN	Date	OCT 1999
Bridge Sheet No.	TC-1B	Sheet	161 of 307

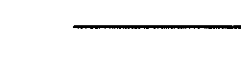


**LEGEND**

-  CONCRETE BARRIER
-  DIRECTION OF TRAFFIC FLOW WITH DETOUR IN PLACE
-  CROSSOVER ALIGNMENT
-  BRIDGE WORK AREA
-  LEDGE OUTCROPPING
-  GUARDRAIL
-  EXISTING DROP INLET
-  PORTABLE ARROW BOARD
-  TYPE I DELINEATOR (YELLOW)
-  TYPE I DELINEATOR (WHITE)
-  REFLECTORIZED PLASTIC DRUM
-  4' TEMPORARY PAVEMENT MARKINGS
-  TYPE III BARRICADE
-  TYPE III (MOD) BARRICADE
-  APPROXIMATE CULVERT LOCATION

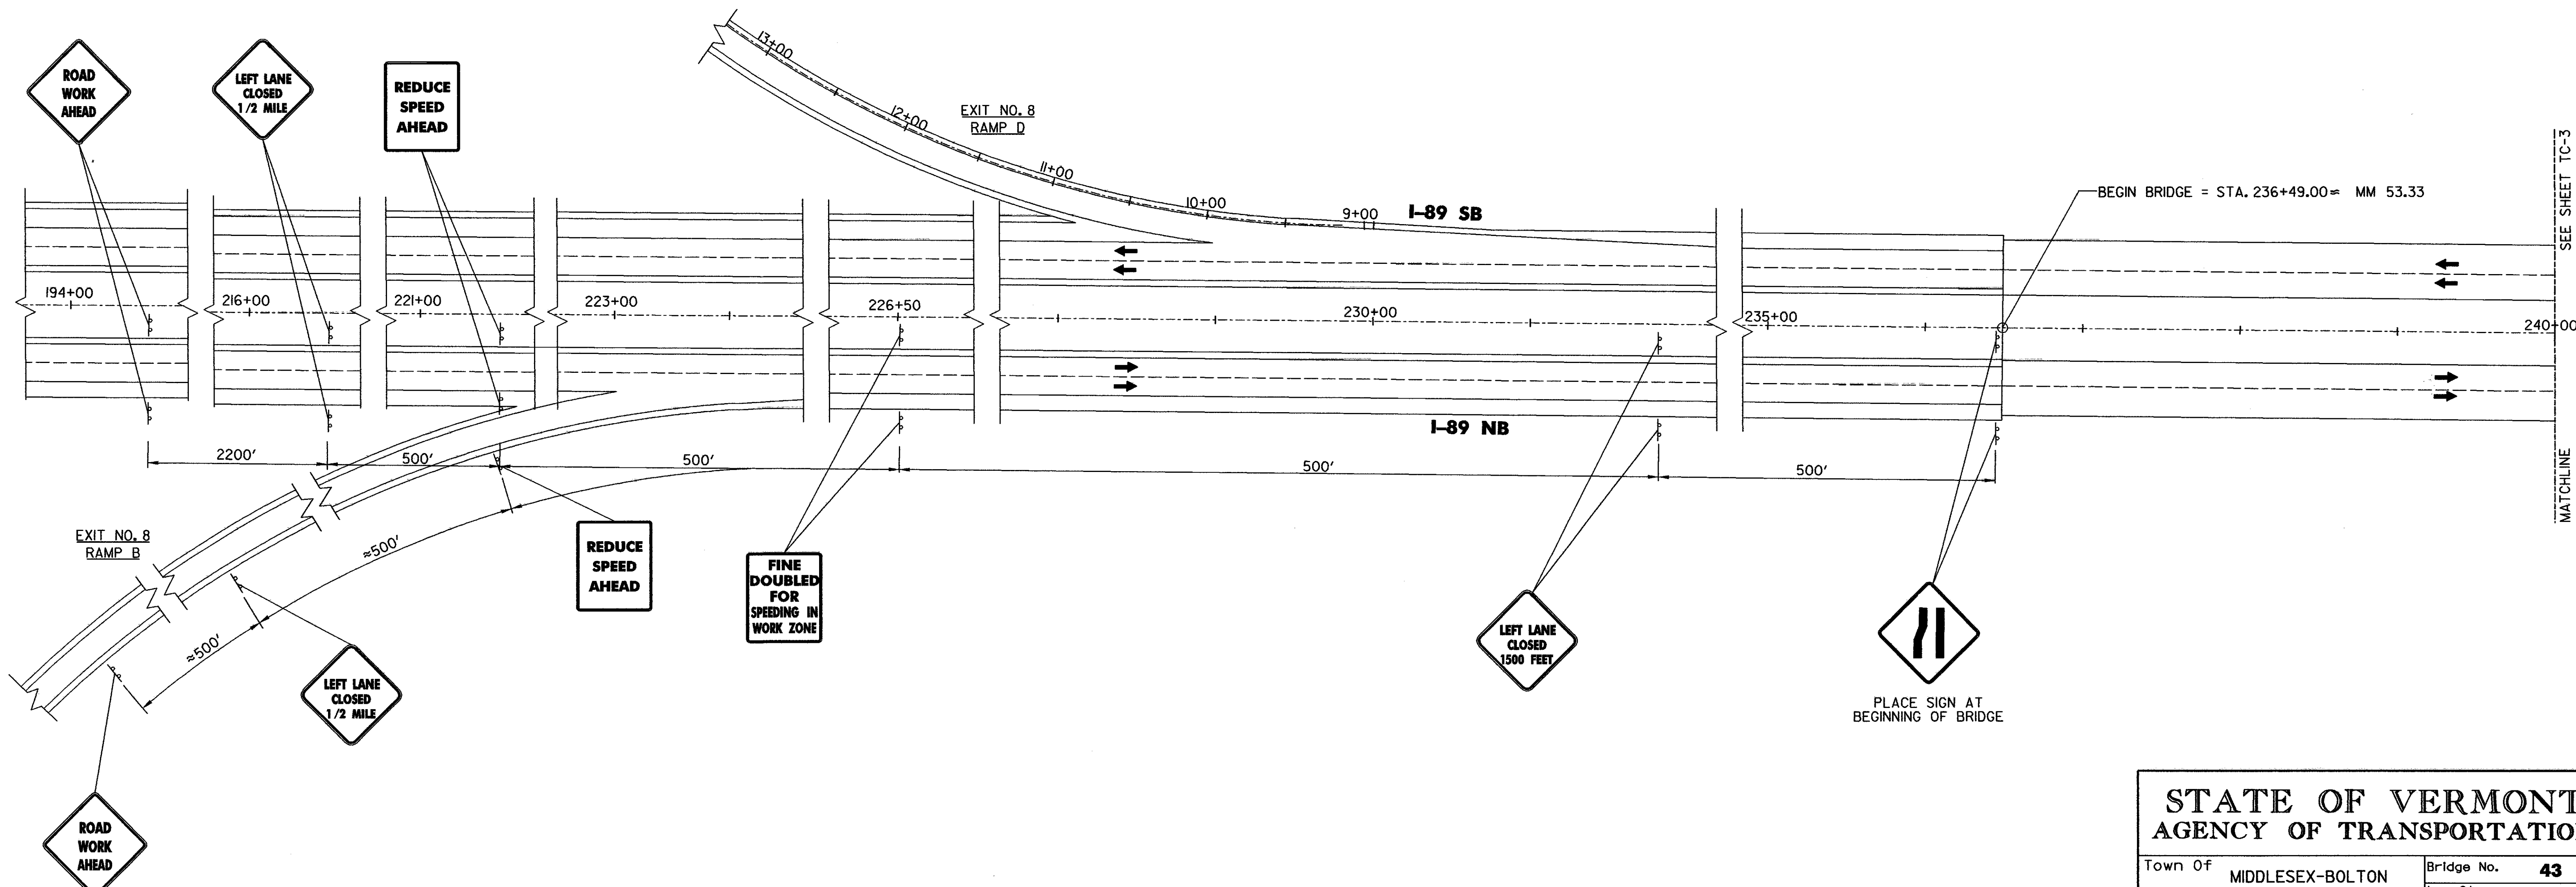


NOTE:  
DISTANCES FOUND ON RAMP B ARE APPROXIMATE. "ROAD WORK AHEAD" SIGN SHALL BE PLACED AT THE ENTRANCE TO RAMP B.

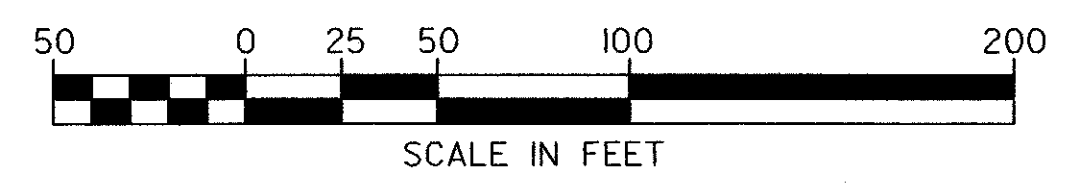










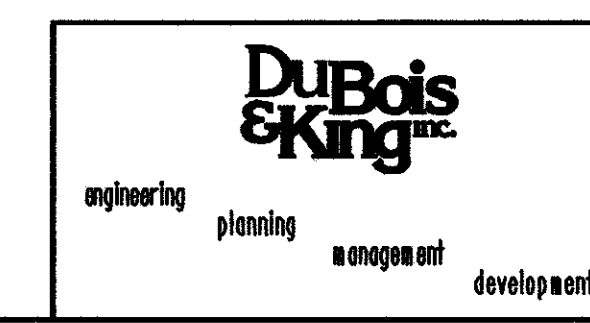





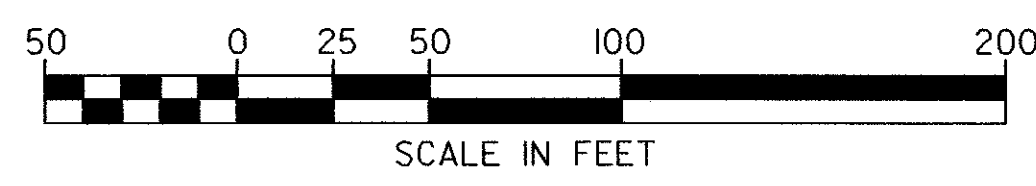
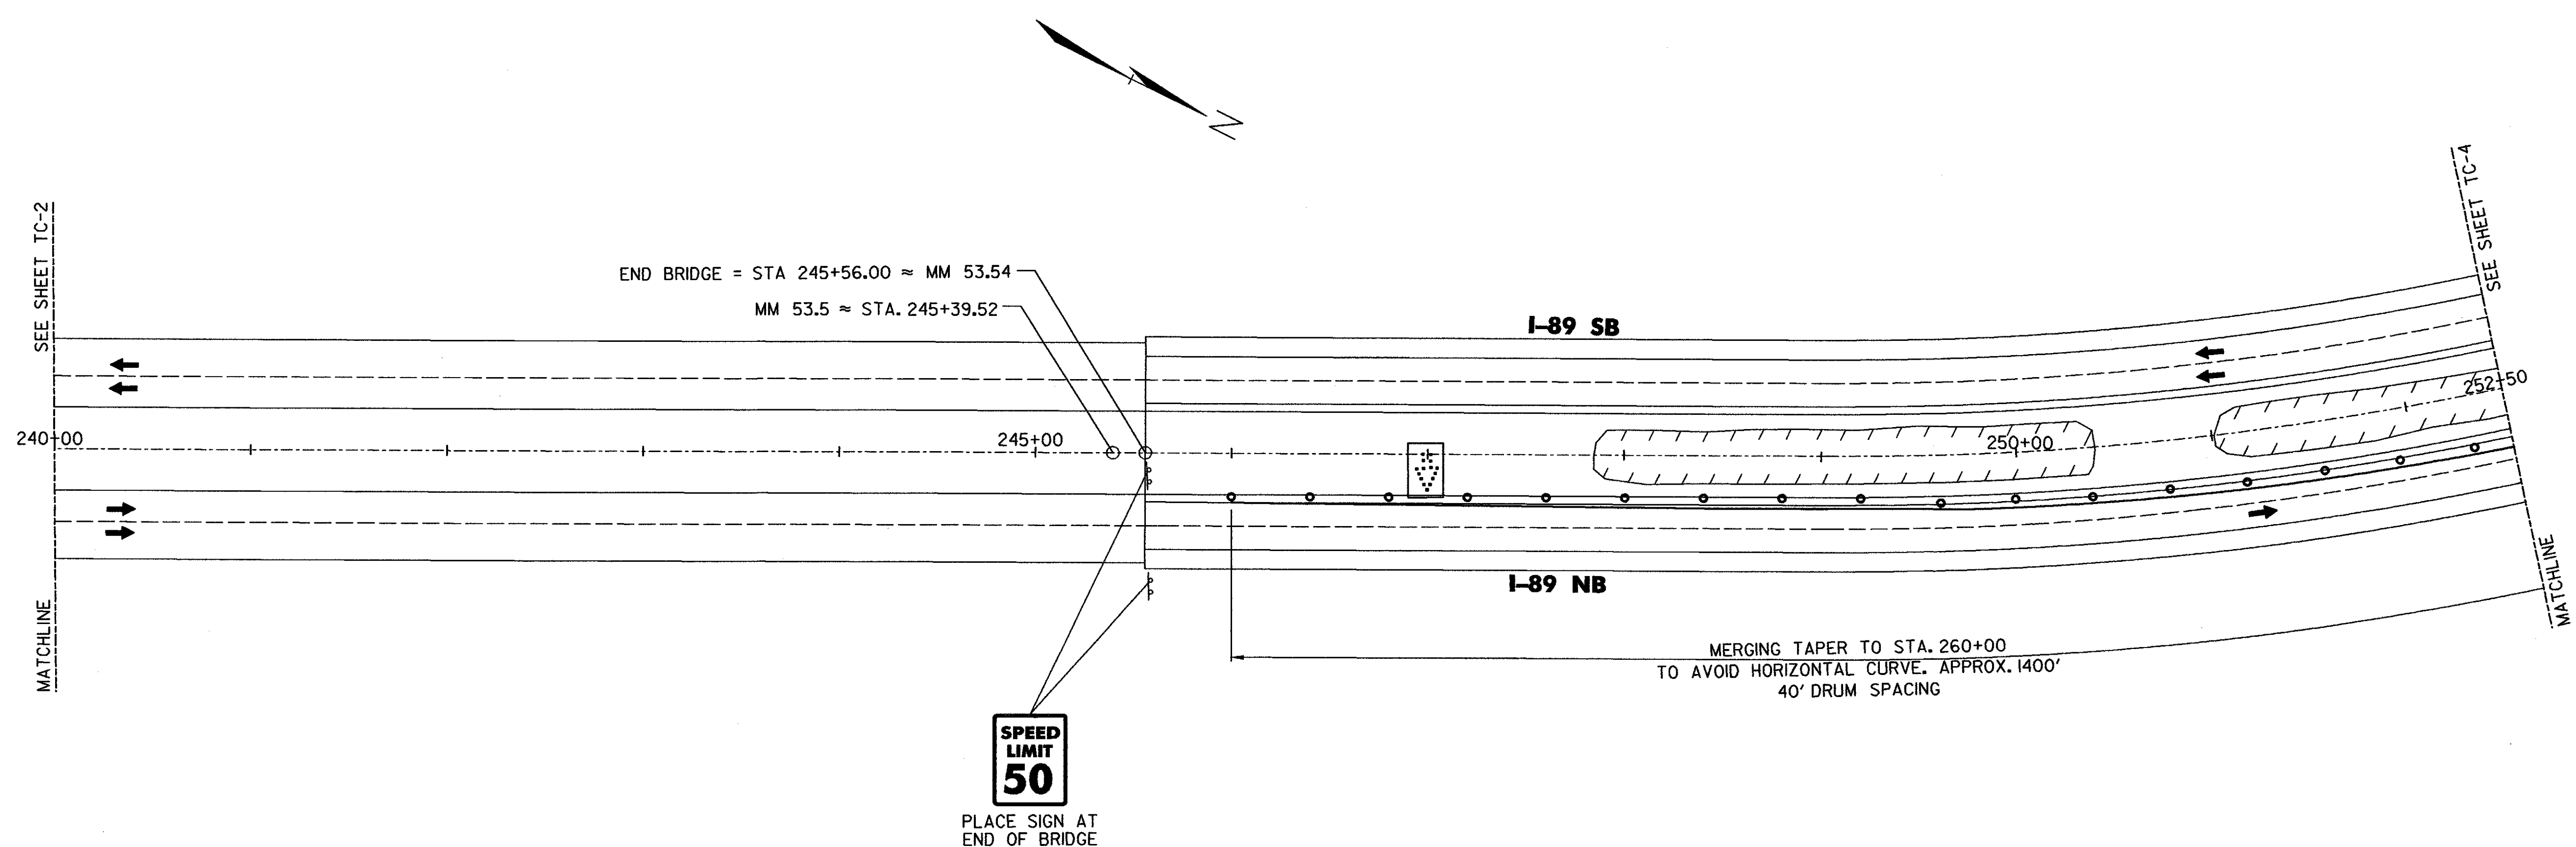
**STATE OF VERMONT  
AGENCY OF TRANSPORTATION**

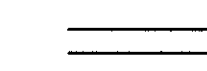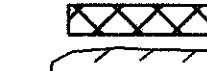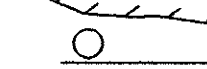Town Of	MIDDLESEX-BOLTON	Bridge No.	<b>43</b>
Highway No.	I-89	Log Sta.	
		Surv. Sta.	
<b>PHASE I CONSTRUCTION I-89 SOUTHBOUND CROSSOVER</b>			
<b>BRIDGE 43</b>			
Designed By	J.M.SMYRSKI/K.S.MARSHIA	Drawn By	S. E. SCHMITT
Checked By	J. W. TUCKER	Date	10/99
		Bridge Design Supervisor	J. P. HALSTEAD Date 10/99
PROJECT	MIDDLESEX-BOLTON	PROJECT NO.	IM-089-2(26)
Drawing No.	...43-sb.dgn	Date	OCT 1999
Bridge Sheet No.	TC-2	Sheet	162 of 307

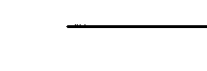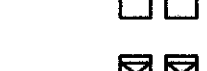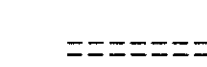


**LEGEND**

-  CONCRETE BARRIER
-  DIRECTION OF TRAFFIC FLOW WITH DETOUR IN PLACE
-  CROSSOVER ALIGNMENT
-  BRIDGE WORK AREA
-  LEDGE OUTCROPPING
-  GUARDRAIL
-  EXISTING DROP INLET
-  PORTABLE ARROW BOARD
-  TYPE I DELINEATOR (YELLOW)
-  TYPE I DELINEATOR (WHITE)
-  REFLECTORIZED PLASTIC DRUM
-  4' TEMPORARY PAVEMENT MARKINGS
-  TYPE III BARRICADE
-  TYPE III (MOD) BARRICADE
-  APPROXIMATE CULVERT LOCATION









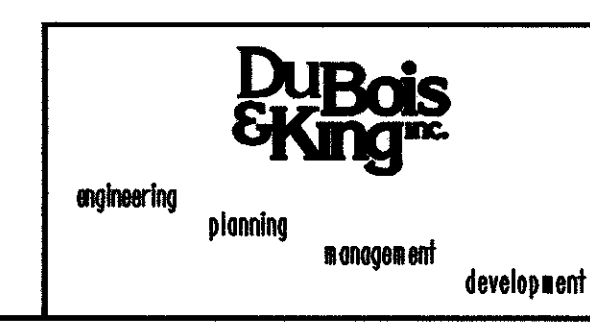


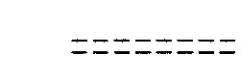





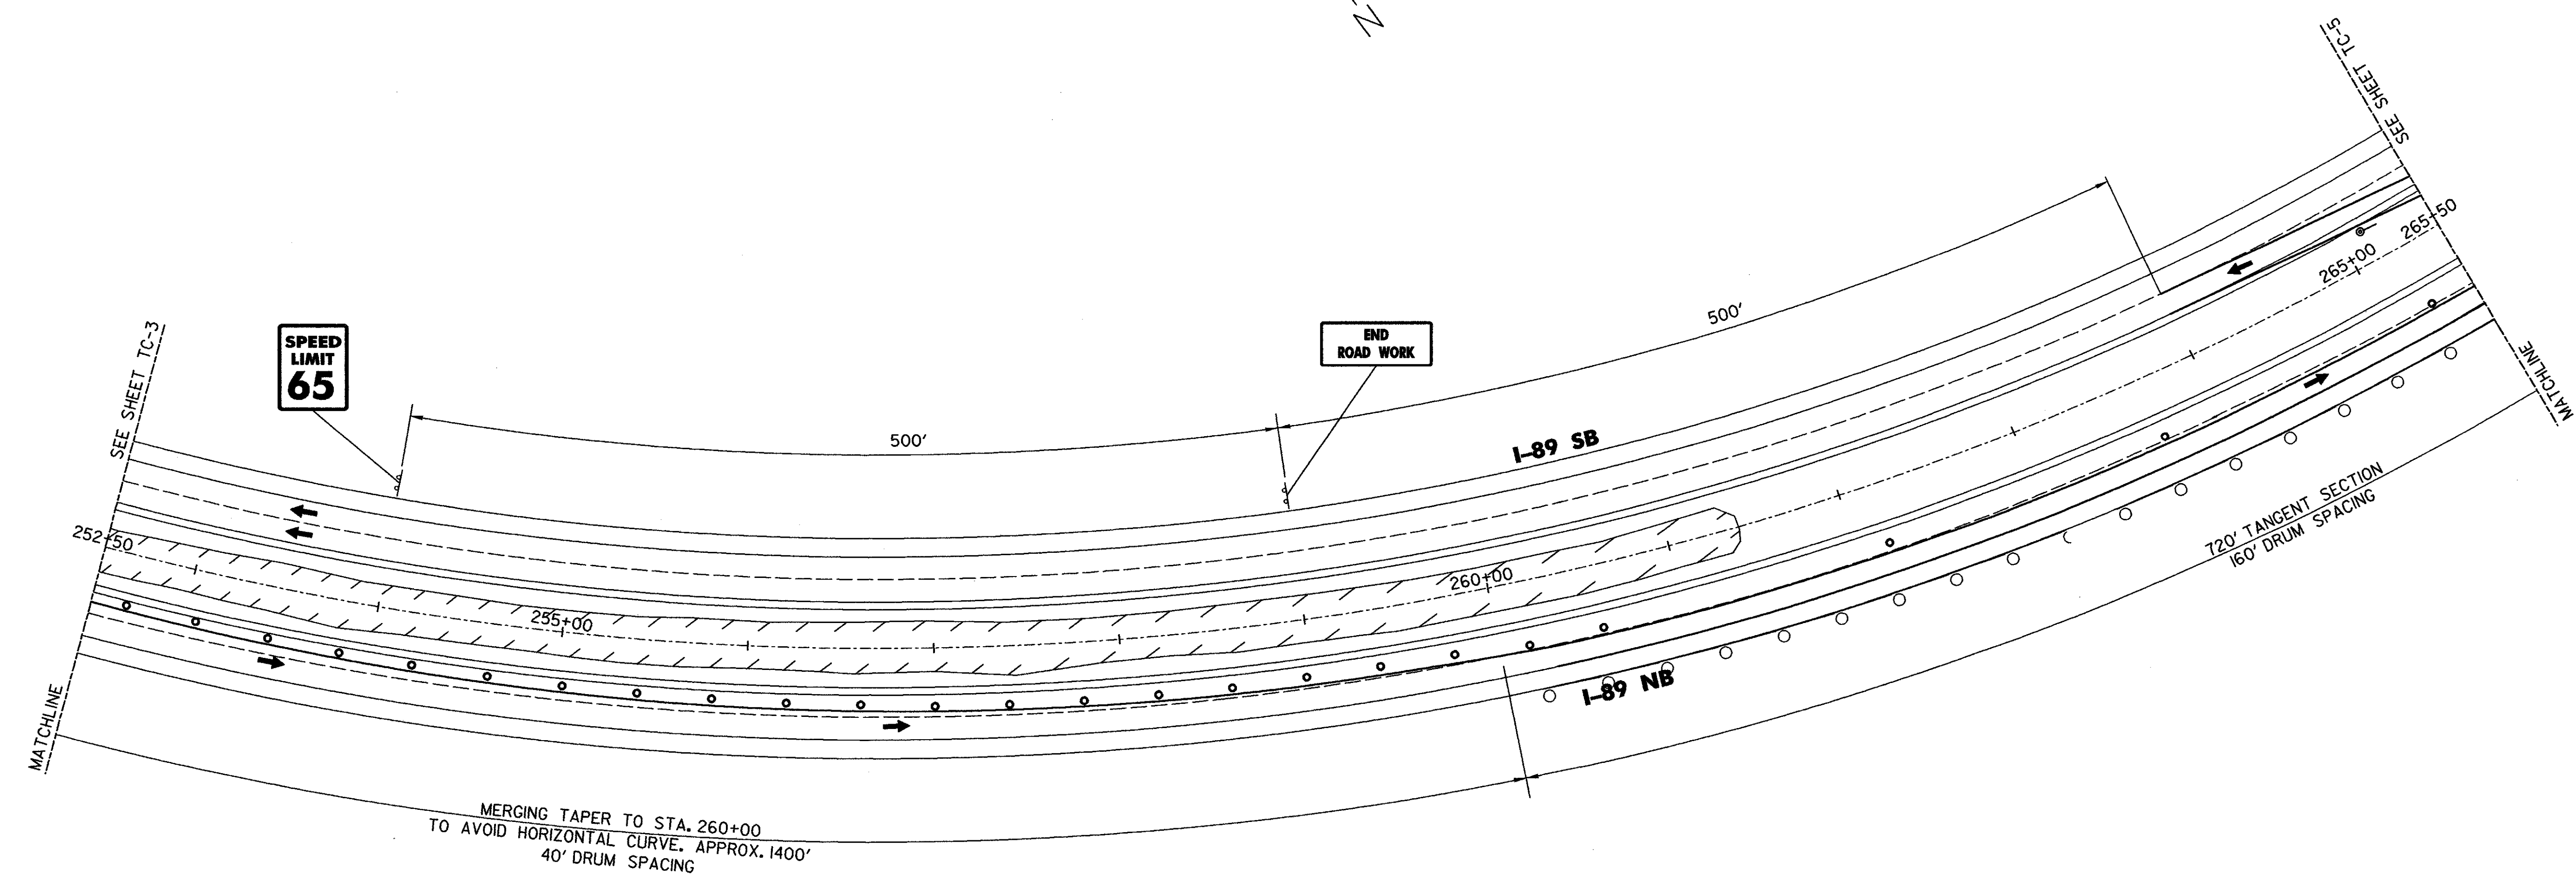
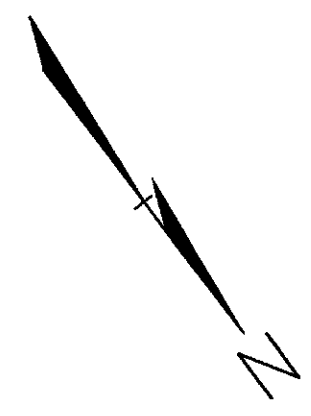
**STATE OF VERMONT  
AGENCY OF TRANSPORTATION**

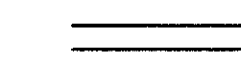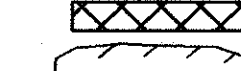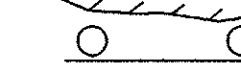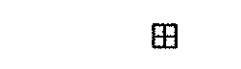Town Of	MIDDLESEX-BOLTON	Bridge No.	<b>43</b>
Highway No.	I-89	Log Sta.	
		Surv. Sta.	
<b>PHASE I CONSTRUCTION I-89 SOUTHBOUND CROSSOVER</b>			
<b>BRIDGE 43</b>			
Designed By	J.M.SMYRSKI/K.S.MARSHA	Drawn By	S. E. SCHMITT
Checked By	J. W. TUCKER	Date	10/99
		Bridge Design Supervisor	J. P. HALSTEAD Date 10/99
PROJECT	MIDDLESEX-BOLTON	PROJECT NO.	IM-089-2(26)
Drawing No.	...43-sb.dgn	Date	OCT 1999
Bridge Sheet No.	TC-3	Sheet	163 of 307





**LEGEND**

-  CONCRETE BARRIER
-  DIRECTION OF TRAFFIC FLOW WITH DETOUR IN PLACE
-  CROSSOVER ALIGNMENT
-  BRIDGE WORK AREA
-  LEDGE OUTCROPPING
-  GUARDRAIL
-  EXISTING DROP INLET
-  PORTABLE ARROW BOARD
-  TYPE I DELINEATOR (YELLOW)
-  TYPE I DELINEATOR (WHITE)
-  REFLECTORIZED PLASTIC DRUM
-  4" TEMPORARY PAVEMENT MARKINGS
-  TYPE III BARRICADE
-  TYPE III (MOD) BARRICADE
-  APPROXIMATE CULVERT LOCATION





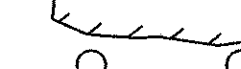
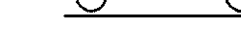


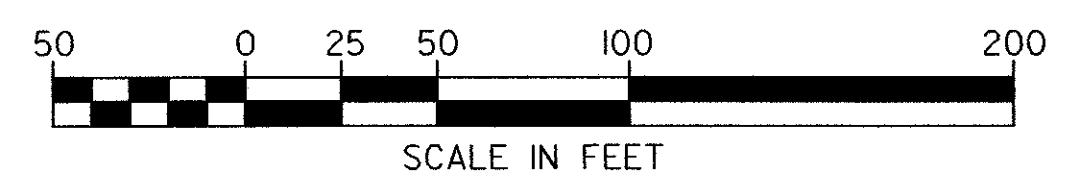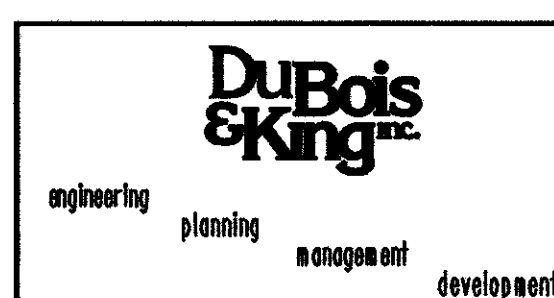


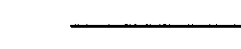







**STATE OF VERMONT  
AGENCY OF TRANSPORTATION**

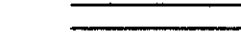Town Of <b>MIDDLESEX-BOLTON</b>		Bridge No. <b>43</b>
Highway No. <b>I-89</b>	Log Sta.	
		Surv. Sta.
<b>PHASE I CONSTRUCTION I-89 SOUTHBOUND CROSSOVER</b>		
<b>BRIDGE 43</b>		
Designed By <b>J.M.SMYRSKI/K.S.MARSH</b>	Drawn By <b>S. E. SCHMITT</b>	
Checked By <b>J. W. TUCKER</b>	Date <b>10/99</b>	Bridge Design Supervisor <b>J. P. HALSTEAD</b> Date <b>10/99</b>
PROJECT <b>MIDDLESEX-BOLTON</b>		PROJECT NO. <b>IM-089-2(26)</b>
Drawing No. <b>...43-sb.dgn</b>	Date <b>OCT 1999</b>	
Bridge Sheet No. <b>TC-4</b>	Sheet <b>164</b> of <b>307</b>	




**LEGEND**

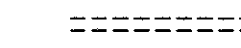-  CONCRETE BARRIER
-  DIRECTION OF TRAFFIC FLOW WITH DETOUR IN PLACE
-  CROSSOVER ALIGNMENT
-  BRIDGE WORK AREA
-  LEDGE OUTCROPPING
-  GUARDRAIL
-  EXISTING DROP INLET
-  PORTABLE ARROW BOARD
-  TYPE I DELINEATOR (YELLOW)
-  TYPE I DELINEATOR (WHITE)
-  REFLECTORIZED PLASTIC DRUM
-  4" TEMPORARY PAVEMENT MARKINGS
-  TYPE III BARRICADE
-  TYPE III (MOD) BARRICADE
-  APPROXIMATE CULVERT LOCATION


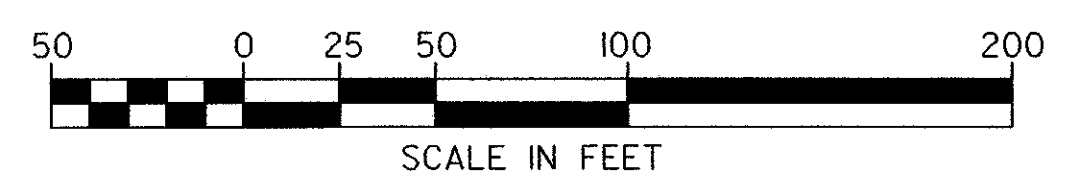
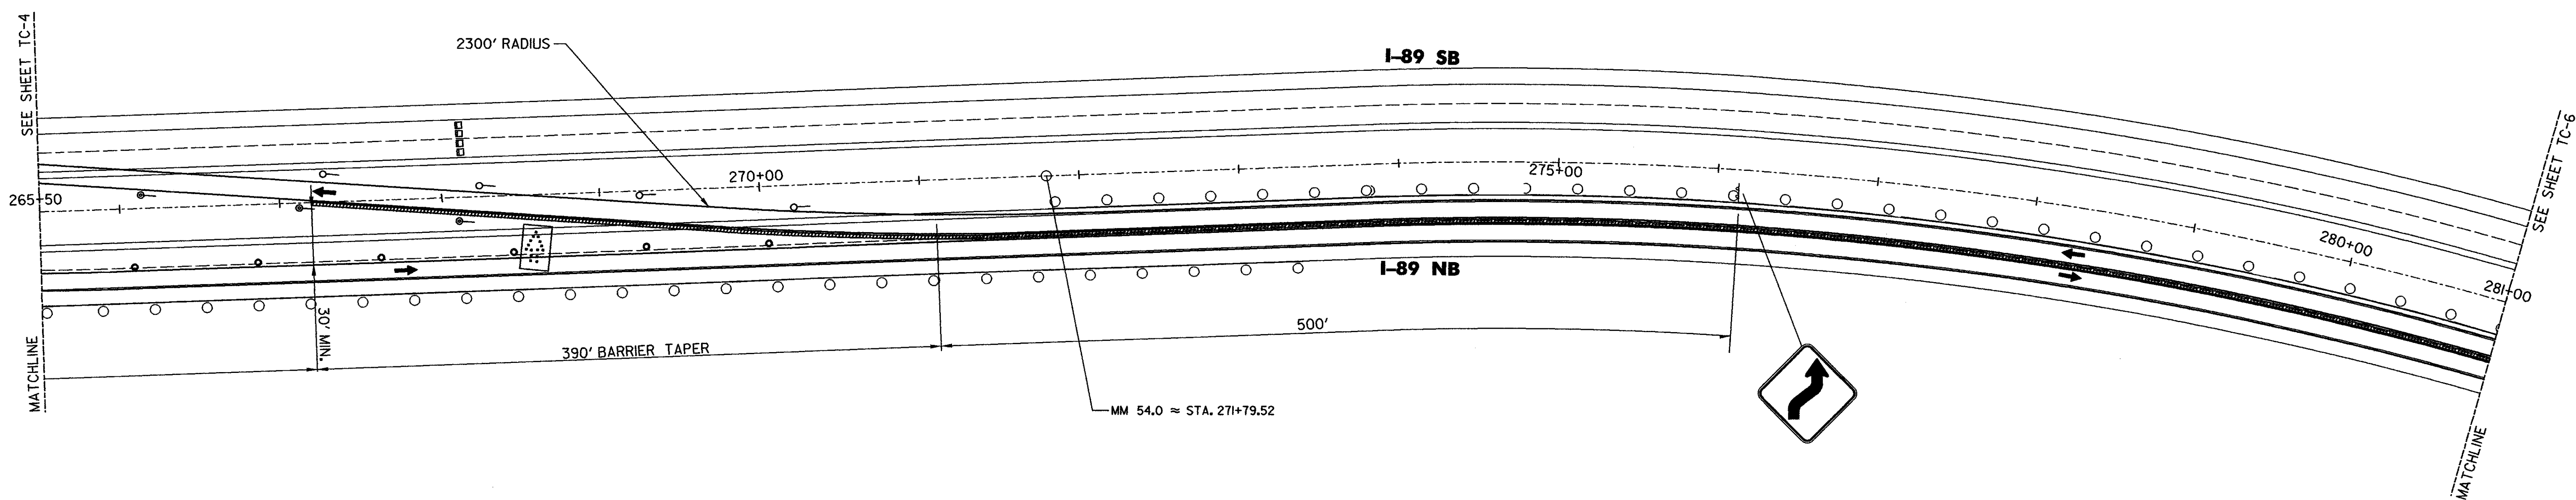


<b>STATE OF VERMONT AGENCY OF TRANSPORTATION</b>			
Town Of	MIDDLESEX-BOLTON	Bridge No.	<b>43</b>
Highway No.	I-89	Log Sta.	
		Surv. Sta.	
PHASE I CONSTRUCTION I-89 SOUTHBOUND CROSSOVER			
<b>BRIDGE 43</b>			
Designed By	J.M.SMYRSKI/K.S.MARSHIA	Drawn By	S. E. SCHMITT
Checked By	J. W. TUCKER	Bridge Design Supervisor	J. P. HALSTEAD
Date	10/99	Date	10/99
PROJECT	MIDDLESEX-BOLTON	PROJECT NO.	IM-089-2(26)
Drawing No.	...43-sb.dgn	Date	OCT 1999
Bridge Sheet No.	TC-5	Sheet	165 of 307

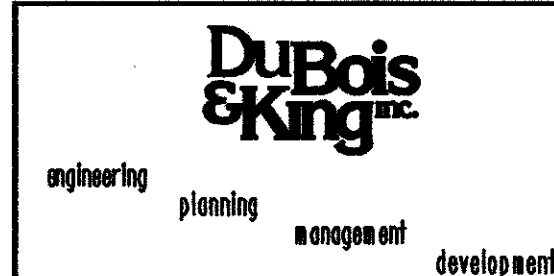


**LEGEND**

- CONCRETE BARRIER
- ➔ DIRECTION OF TRAFFIC FLOW WITH DETOUR IN PLACE
- ==== CROSSOVER ALIGNMENT
- ▨ BRIDGE WORK AREA
- ⬭ LEDGE OUTCROPPING
- GUARDRAIL
- ⊞ EXISTING DROP INLET
- ⊞ PORTABLE ARROW BOARD
- TYPE I DELINEATOR (YELLOW)
- TYPE I DELINEATOR (WHITE)
- REFLECTORIZED PLASTIC DRUM
- 4' TEMPORARY PAVEMENT MARKINGS
- TYPE III BARRICADE
- ▣ TYPE III (MOD) BARRICADE
- APPROXIMATE CULVERT LOCATION

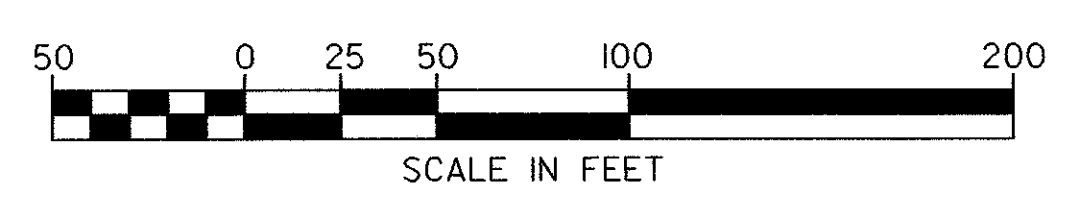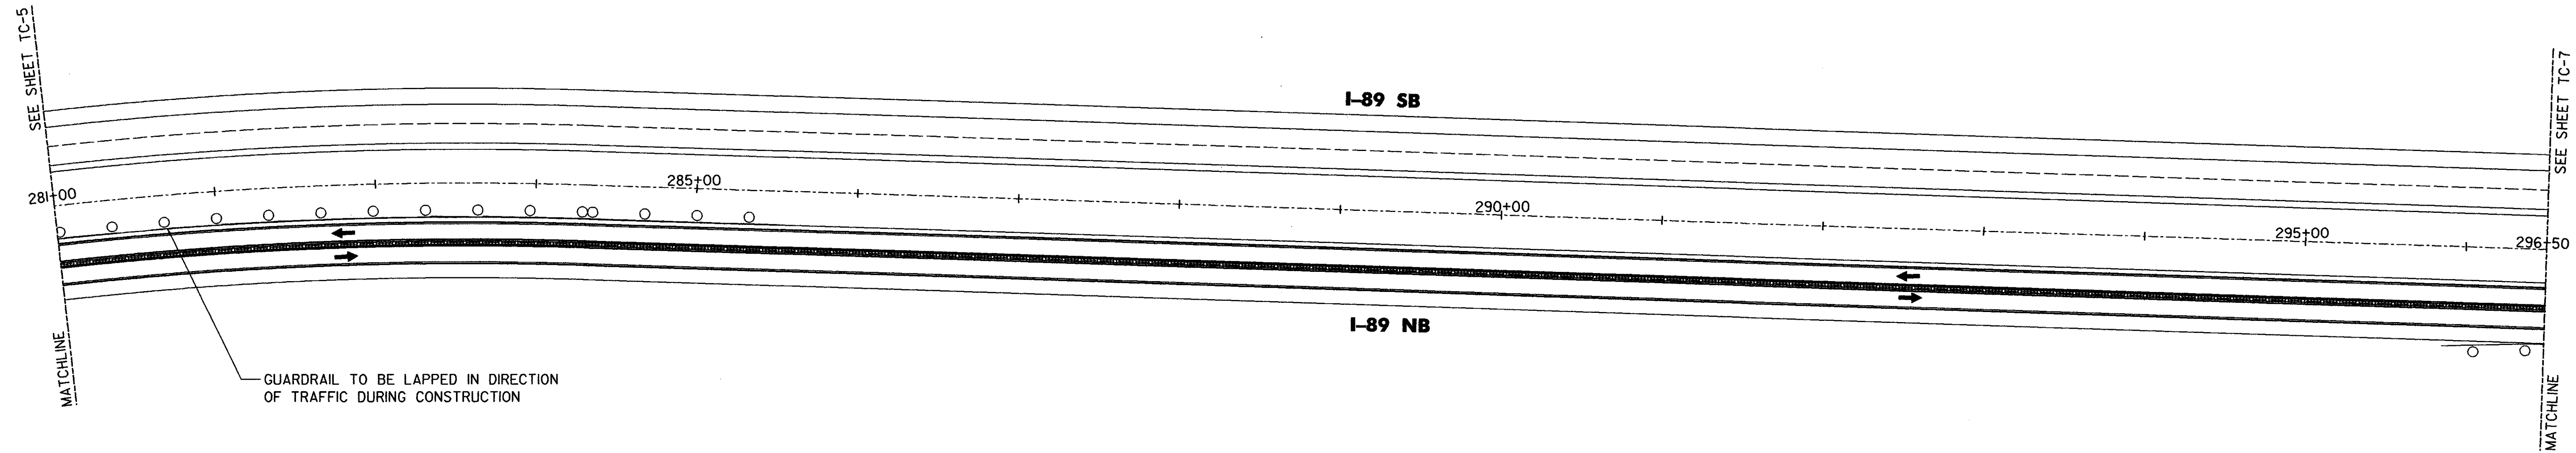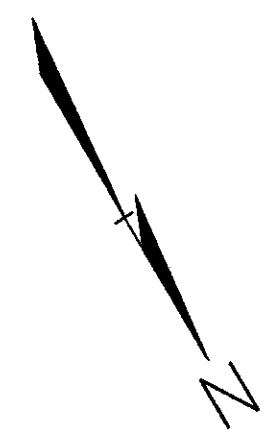








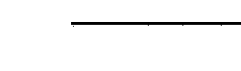


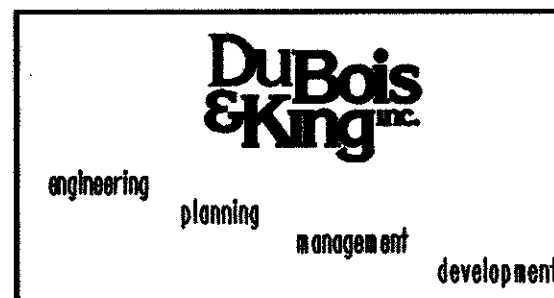




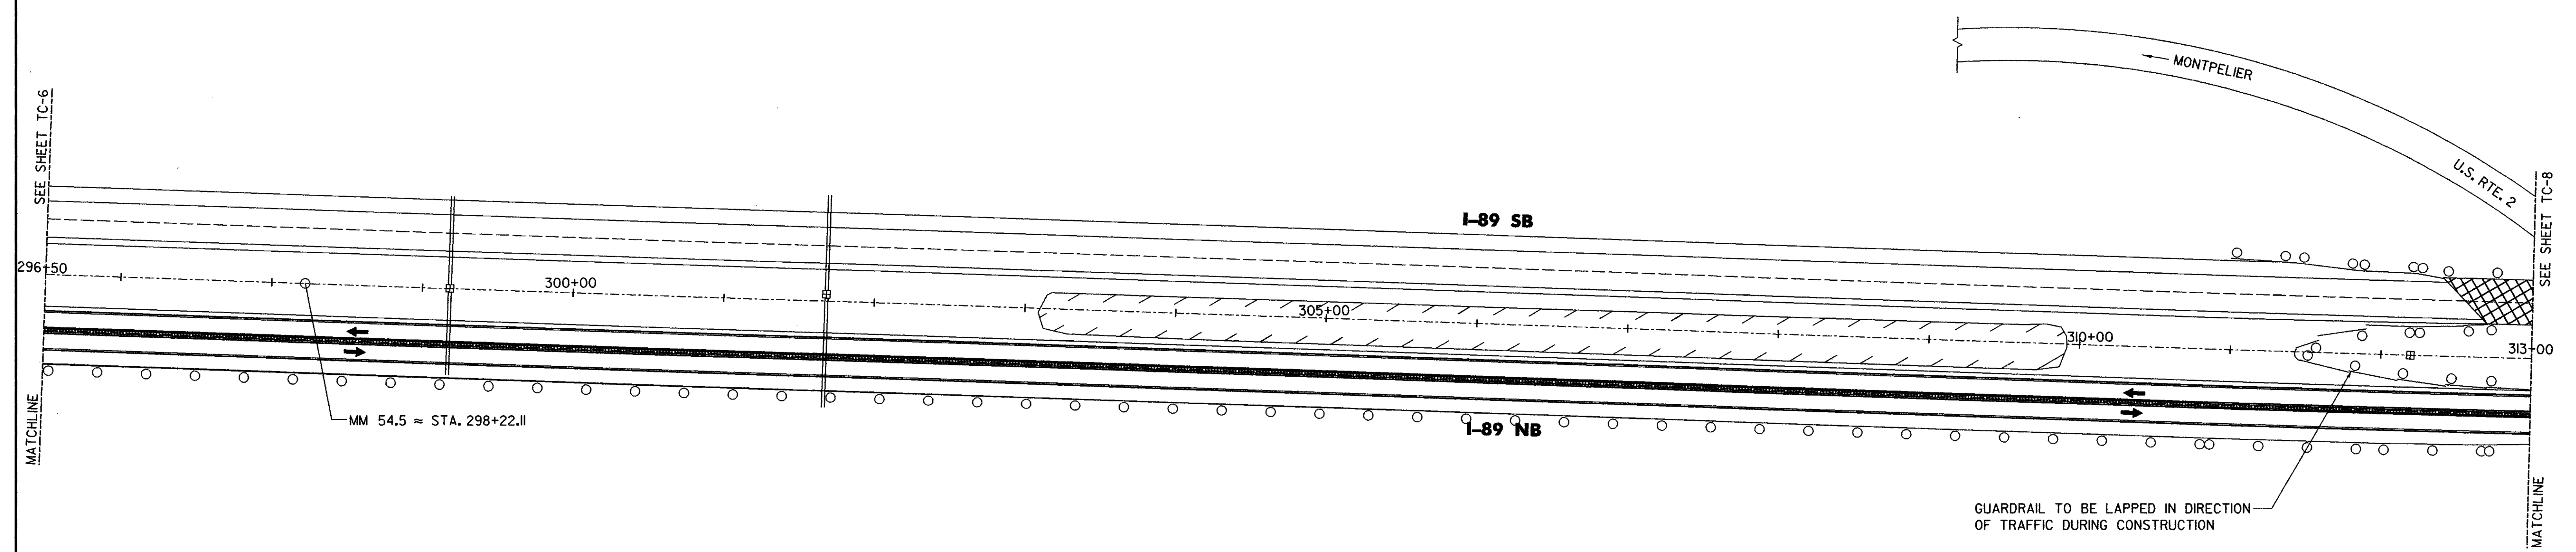
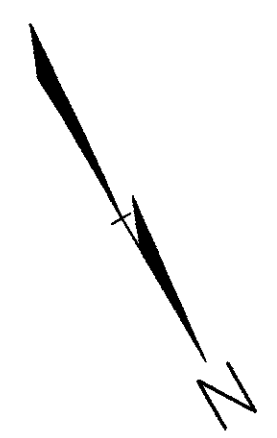
**STATE OF VERMONT  
AGENCY OF TRANSPORTATION**

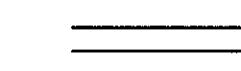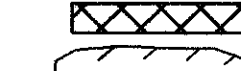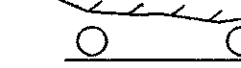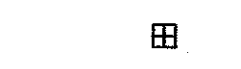Town Of MIDDLESEX-BOLTON		Bridge No. <b>43</b>
Highway No. I-89		Log Sta. Surv. Sta.
<b>PHASE I CONSTRUCTION I-89 SOUTHBOUND CROSSOVER</b>		
<b>BRIDGE 43</b>		
Designed By J.M.SMYRSKI/K.S.MARSHA	Drawn By S. E. SCHMITT	
Checked By J. W. TUCKER	Date 10/99	Bridge Design Supervisor J. P. HALSTEAD Date 10/99
PROJECT MIDDLESEX-BOLTON		PROJECT NO. IM-089-2(26)
Drawing No. ...43-sb.dgn		Date OCT 1999
Bridge Sheet No. TC-6		Sheet 166 of 307





**LEGEND**

-  CONCRETE BARRIER
-  DIRECTION OF TRAFFIC FLOW WITH DETOUR IN PLACE
-  CROSSOVER ALIGNMENT
-  BRIDGE WORK AREA
-  LEDGE OUTCROPPING
-  GUARDRAIL
-  EXISTING DROP INLET
-  PORTABLE ARROW BOARD
-  TYPE I DELINEATOR (YELLOW)
-  TYPE I DELINEATOR (WHITE)
-  REFLECTORIZED PLASTIC DRUM
-  4" TEMPORARY PAVEMENT MARKINGS
-  TYPE III BARRICADE
-  TYPE III (MOD) BARRICADE
-  APPROXIMATE CULVERT LOCATION








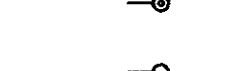



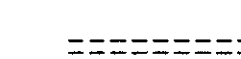


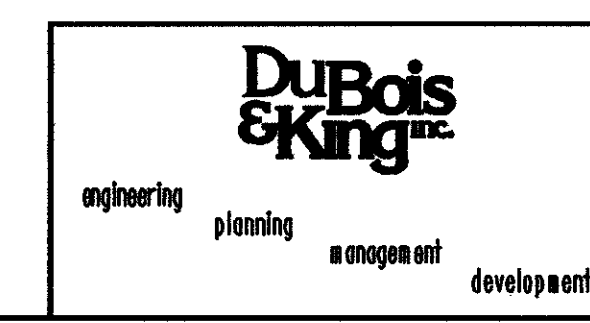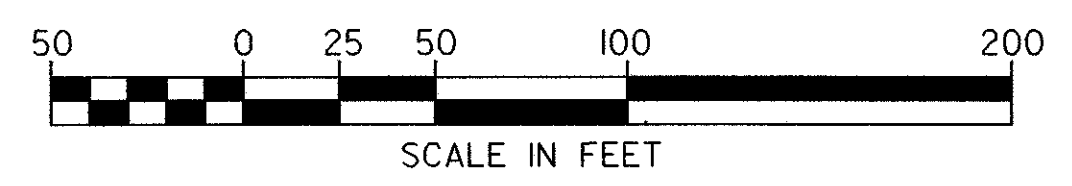


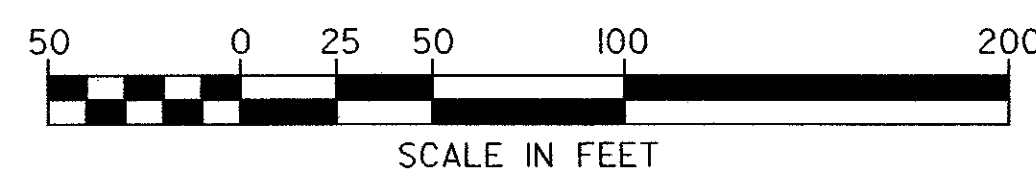
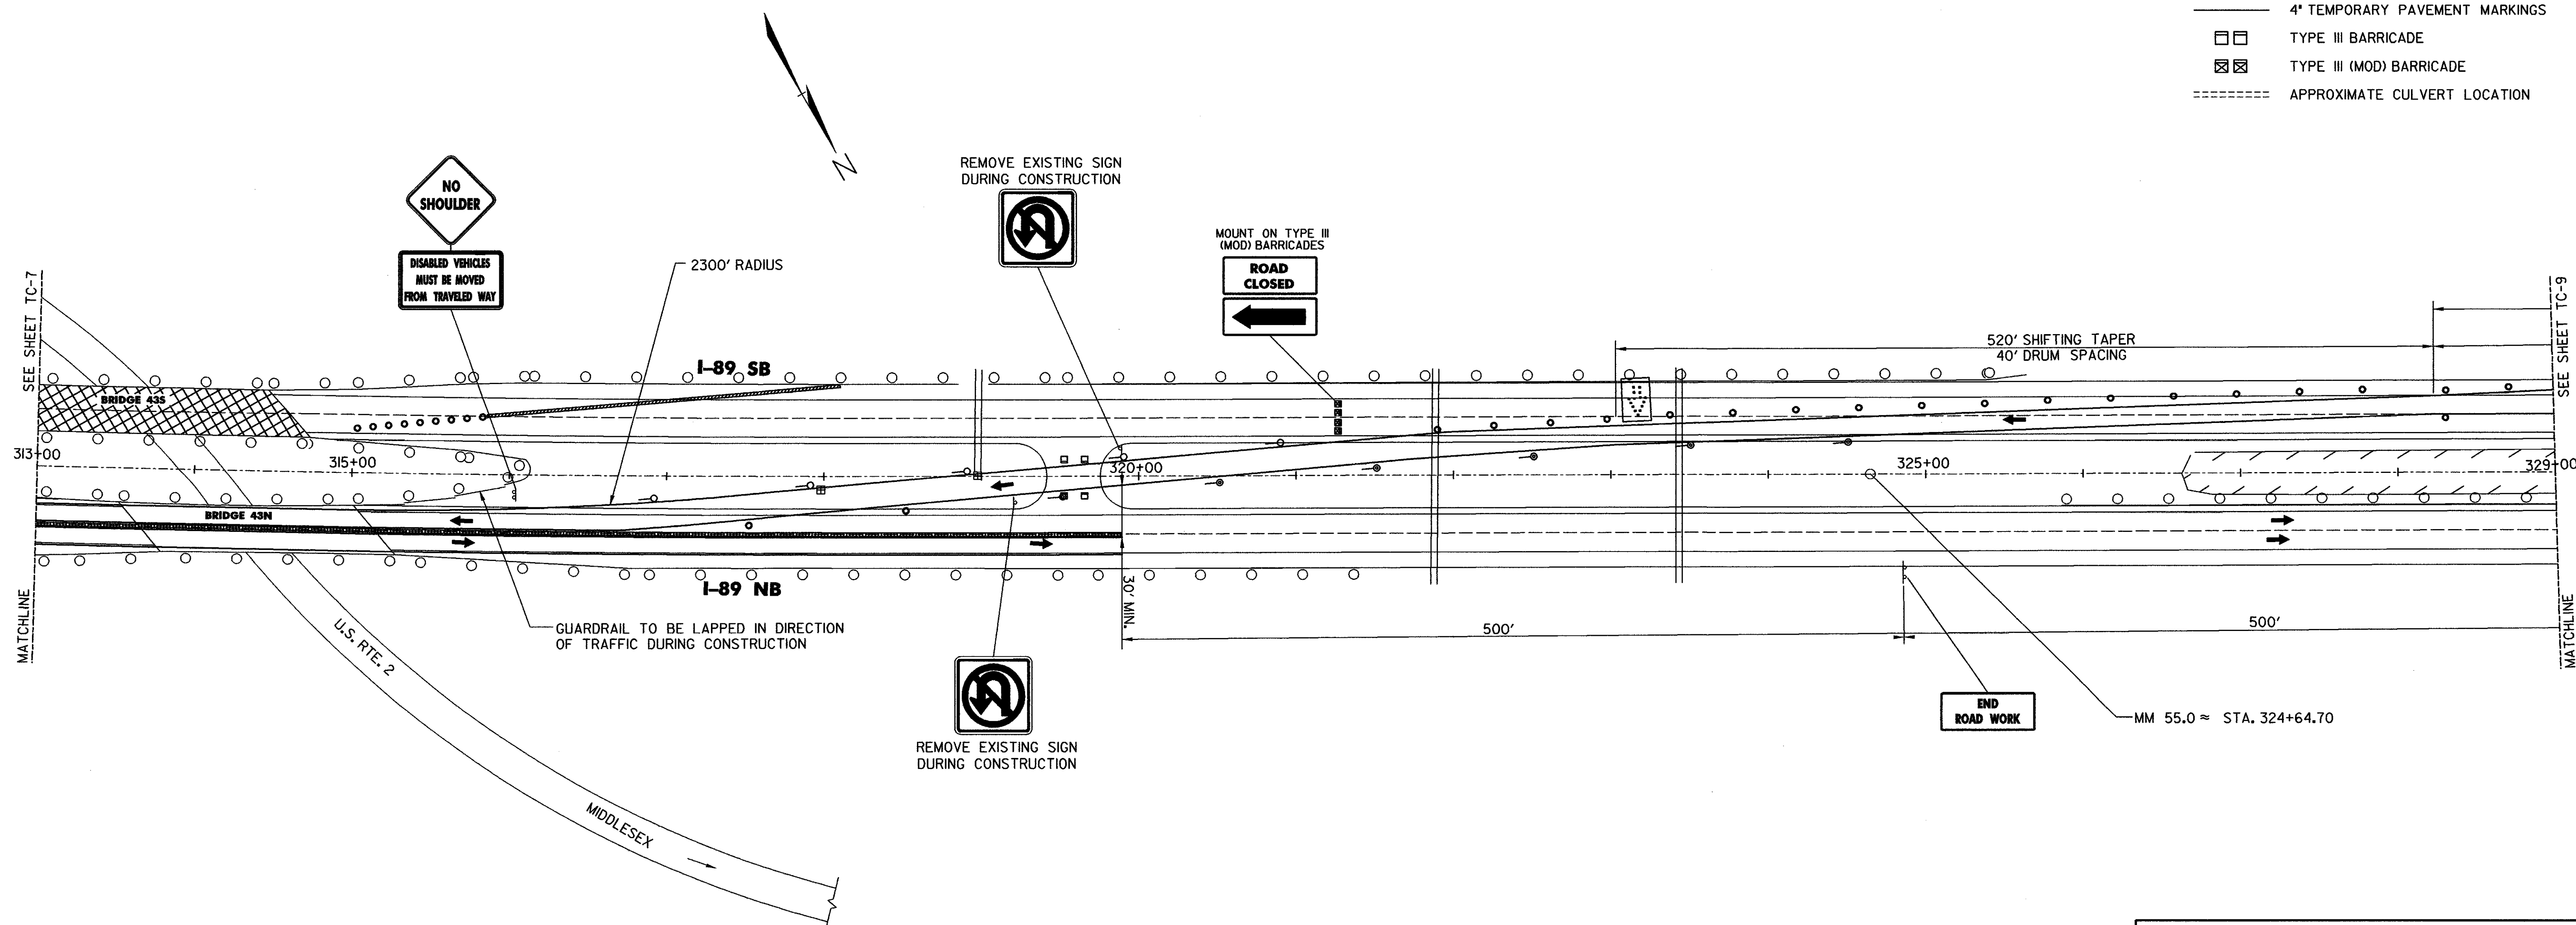
**STATE OF VERMONT  
AGENCY OF TRANSPORTATION**

Town Of	MIDDLESEX-BOLTON	Bridge No.	<b>43</b>
Highway No.	I-89	Log Sta.	
		Surv. Sta.	
<b>PHASE I CONSTRUCTION I-89 SOUTHBOUND CROSSOVER</b>			
<b>BRIDGE 43</b>			
Designed By	J.M.SMYRSKI/K.S.MARSHA	Drawn By	S. E. SCHMITT
Checked By	J. W. TUCKER	Date	10/99
		Bridge Design Supervisor	J. P. HALSTEAD Date 10/99
PROJECT	MIDDLESEX-BOLTON	PROJECT NO.	IM-089-2(26)
Drawing No.	...43-sb.dgn	Date	OCT 1999
Bridge Sheet No.	TC-7	Sheet	167 of 307

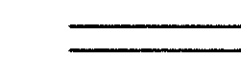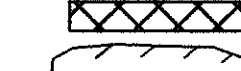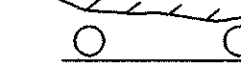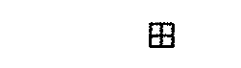


**LEGEND**

-  CONCRETE BARRIER
-  DIRECTION OF TRAFFIC FLOW WITH DETOUR IN PLACE
-  CROSSOVER ALIGNMENT
-  BRIDGE WORK AREA
-  LEDGE OUTCROPPING
-  GUARDRAIL
-  EXISTING DROP INLET
-  PORTABLE ARROW BOARD
-  TYPE I DELINEATOR (YELLOW)
-  TYPE I DELINEATOR (WHITE)
-  REFLECTORIZED PLASTIC DRUM
-  4' TEMPORARY PAVEMENT MARKINGS
-  TYPE III BARRICADE
-  TYPE III (MOD) BARRICADE
-  APPROXIMATE CULVERT LOCATION





**STATE OF VERMONT  
AGENCY OF TRANSPORTATION**

Town Of <b>MIDDLESEX-BOLTON</b>		Bridge No. <b>43</b>
Highway No. <b>I-89</b>		Log Sta.
		Surv. Sta.
<b>PHASE I CONSTRUCTION I-89 SOUTHBOUND CROSSOVER</b>		
<b>BRIDGE 43</b>		
Designed By <b>J.M.SMYRSKI/K.S.MARSHA</b>	Drawn By <b>S.E.SCHMITT</b>	
Checked By <b>J.W.TUCKER</b>	Date <b>10/99</b>	Bridge Design Supervisor <b>J.P.HALSTEAD</b> Date <b>10/99</b>
PROJECT <b>MIDDLESEX-BOLTON</b>		PROJECT NO. <b>IM-089-2(26)</b>
Drawing No. <b>...43-sb.dgn</b>		Date <b>OCT 1999</b>
Bridge Sheet No. <b>TC-8</b>		Sheet <b>168</b> of <b>307</b>

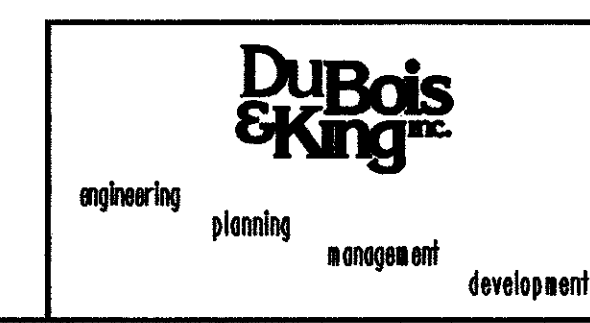



**LEGEND**

- CONCRETE BARRIER
- ➔ DIRECTION OF TRAFFIC FLOW WITH DETOUR IN PLACE
- ==== CROSSOVER ALIGNMENT
- ▨ BRIDGE WORK AREA
- ⬭ LEDGE OUTCROPPING
- ⬭ GUARDRAIL
- ⊞ EXISTING DROP INLET
- ⊞ PORTABLE ARROW BOARD
- TYPE I DELINEATOR (YELLOW)
- TYPE I DELINEATOR (WHITE)
- REFLECTORIZED PLASTIC DRUM
- 4' TEMPORARY PAVEMENT MARKINGS
- ⊞ TYPE III BARRICADE
- ⊞ TYPE III (MOD) BARRICADE
- APPROXIMATE CULVERT LOCATION

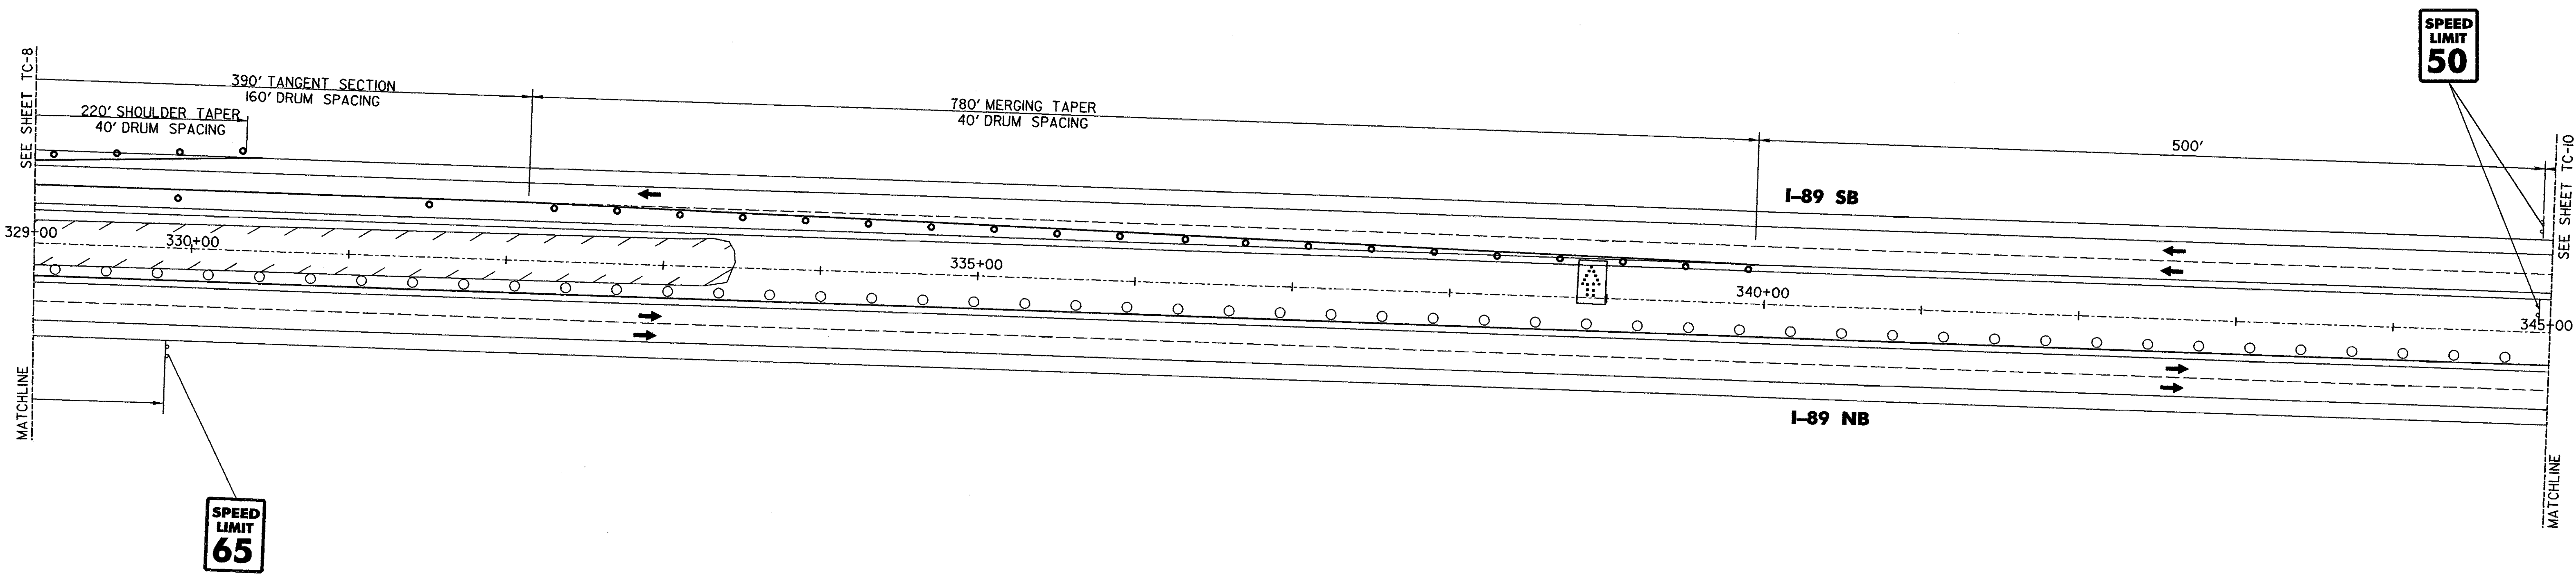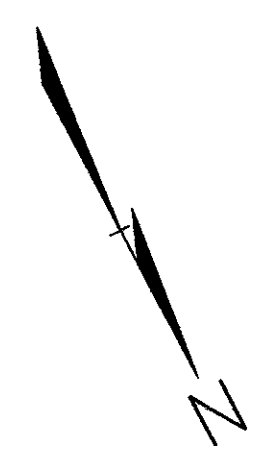








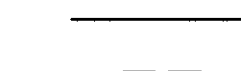

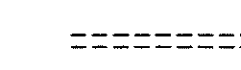


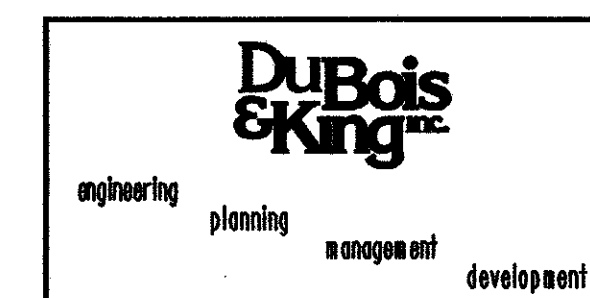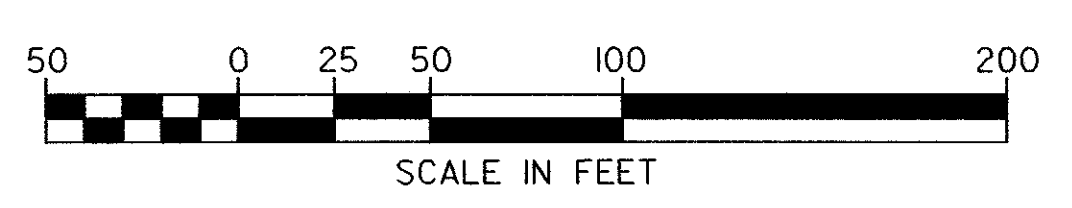


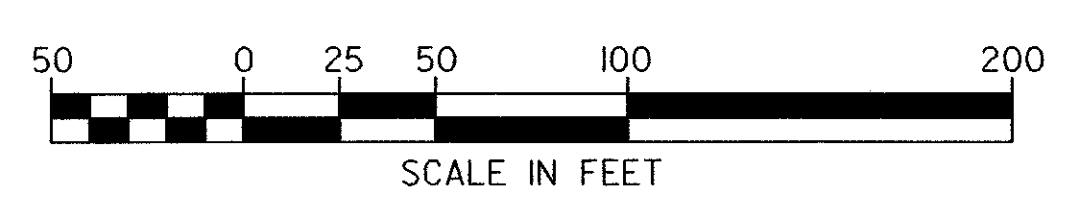
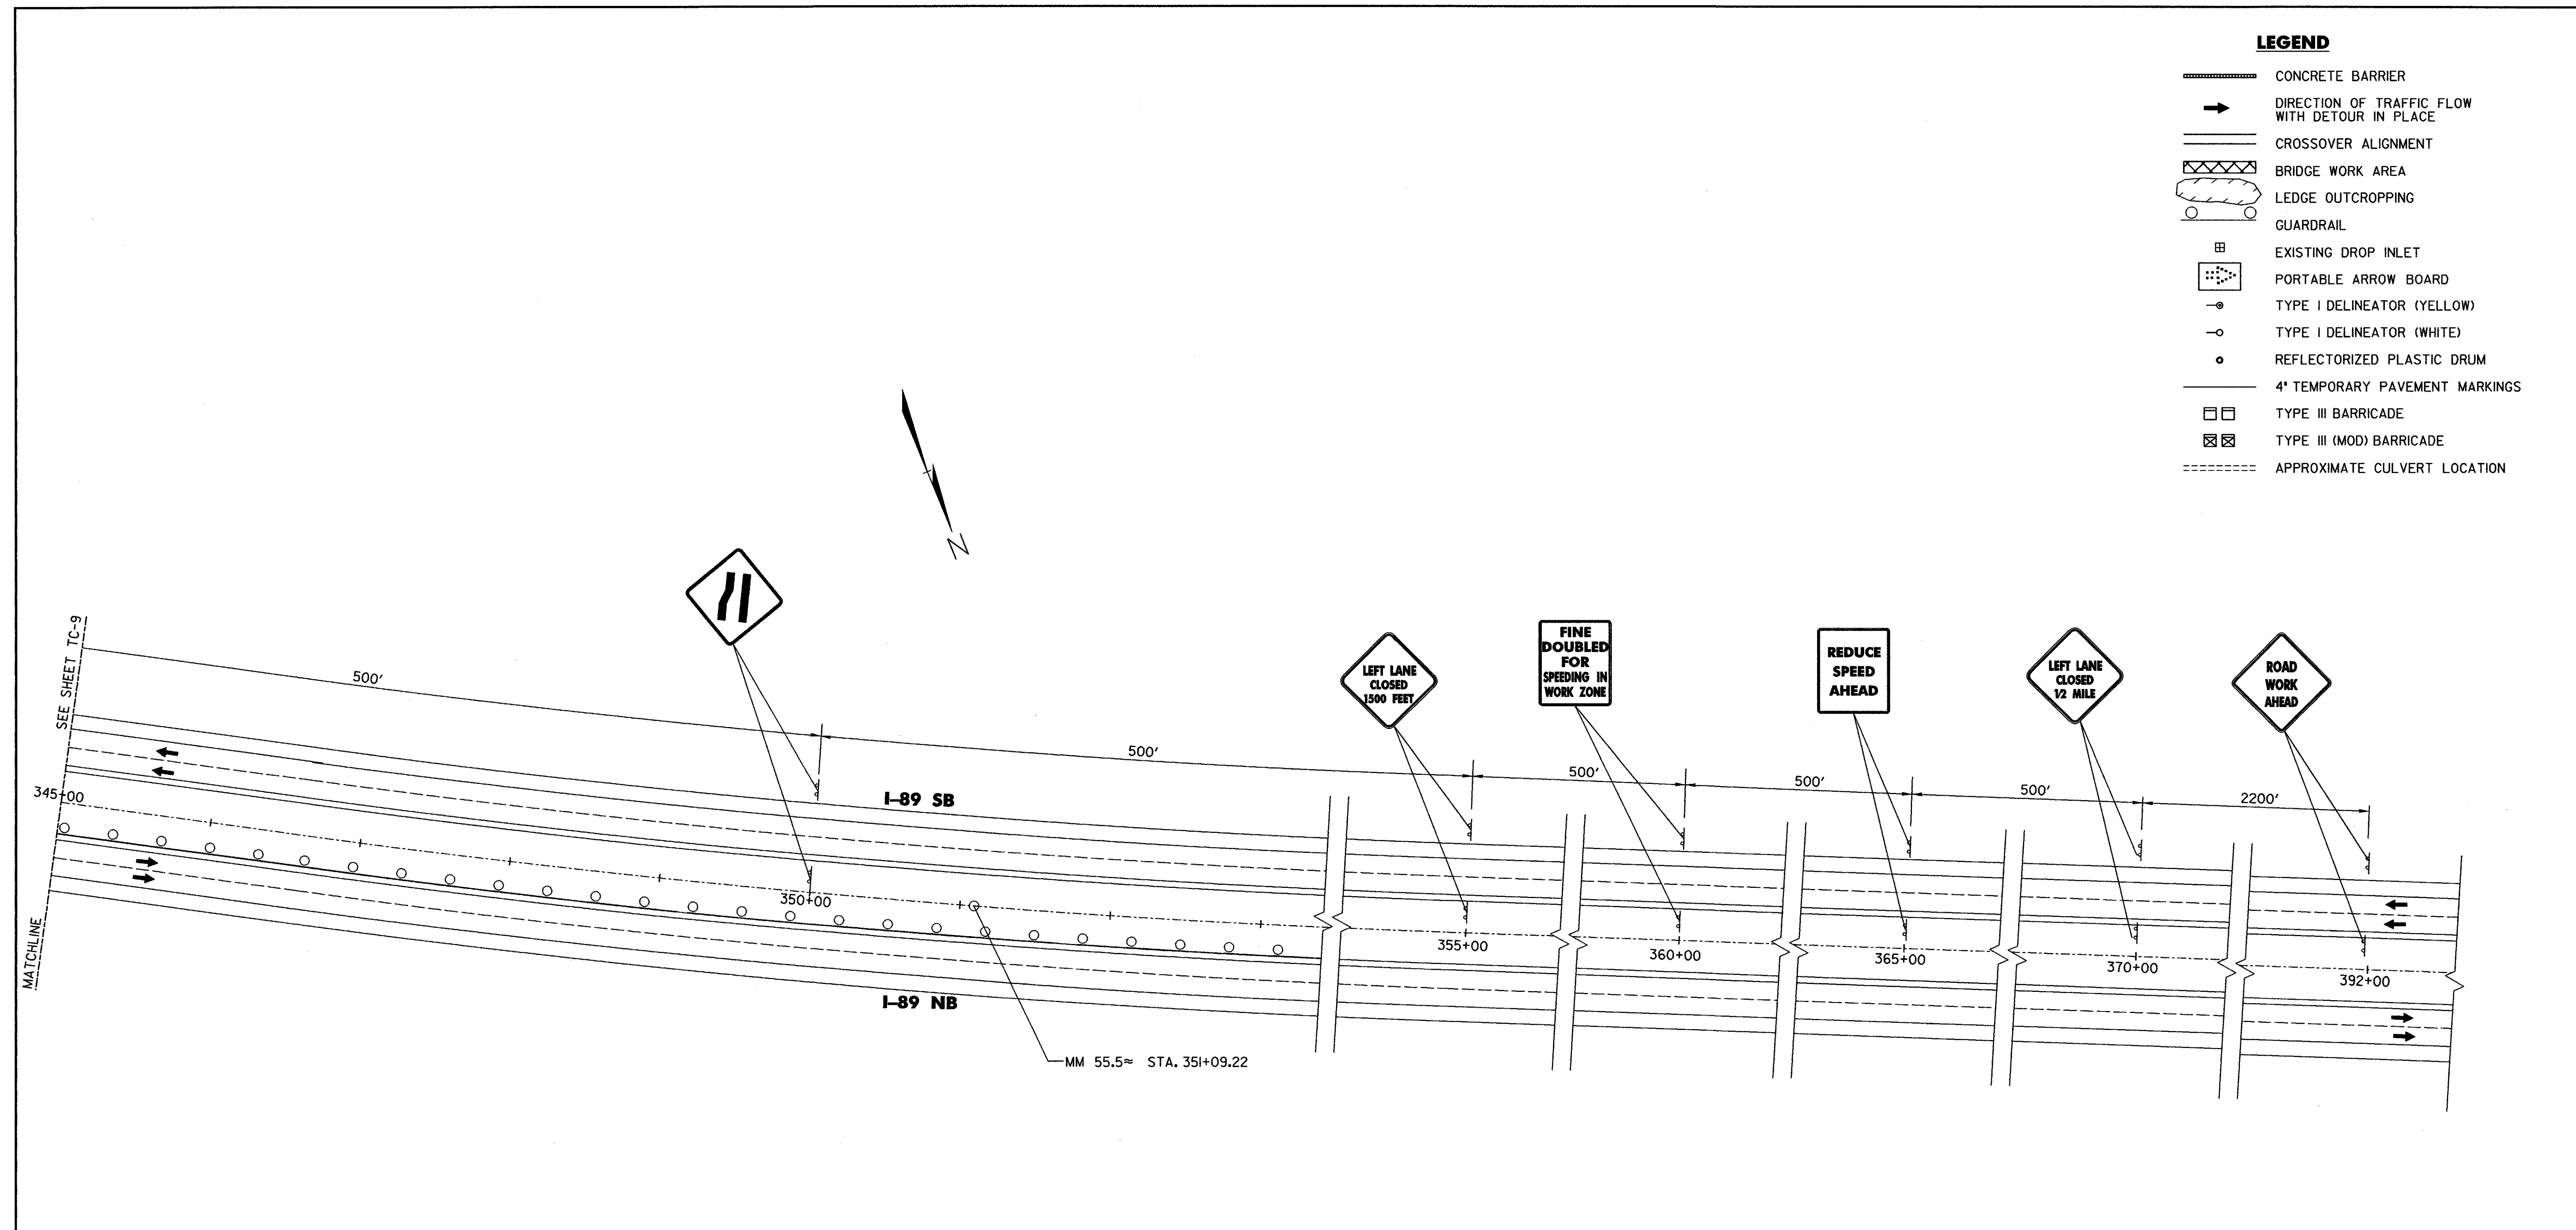
**STATE OF VERMONT  
AGENCY OF TRANSPORTATION**

Town Of MIDDLESEX-BOLTON		Bridge No. <b>43</b>
Highway No. I-89		Log Sta.
		Surv. Sta.
<b>PHASE I CONSTRUCTION I-89 SOUTHBOUND CROSSOVER</b>		
<b>BRIDGE 43</b>		
Designed By J.M.SMYRSKI/K.S.MARSHA	Drawn By S.E.SCHMITT	
Checked By J.W.TUCKER	Date 10/99	Bridge Design Supervisor J.P.HALSTEAD Date 10/99
PROJECT MIDDLESEX-BOLTON		PROJECT NO. IM-089-2(26)
Drawing No. ...43-sb.dgn		Date OCT 1999
Bridge Sheet No. TC-9		Sheet 169 of 307

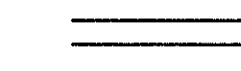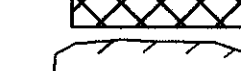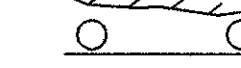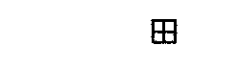


**LEGEND**

-  CONCRETE BARRIER
-  DIRECTION OF TRAFFIC FLOW WITH DETOUR IN PLACE
-  CROSSOVER ALIGNMENT
-  BRIDGE WORK AREA
-  LEDGE OUTCROPPING
-  GUARDRAIL
-  EXISTING DROP INLET
-  PORTABLE ARROW BOARD
-  TYPE I DELINEATOR (YELLOW)
-  TYPE I DELINEATOR (WHITE)
-  REFLECTORIZED PLASTIC DRUM
-  4' TEMPORARY PAVEMENT MARKINGS
-  TYPE III BARRICADE
-  TYPE III (MOD) BARRICADE
-  APPROXIMATE CULVERT LOCATION






**STATE OF VERMONT  
AGENCY OF TRANSPORTATION**

Town Of	MIDDLESEX-BOLTON	Bridge No.	<b>43</b>
Highway No.	I-89	Log Sta.	
		Surv. Sta.	
<b>PHASE I CONSTRUCTION I-89 SOUTHBOUND CROSSOVER</b>			
<b>BRIDGE 43</b>			
Designed By	J.M.SMYRSKI/K.S.MARSHA	Drawn By	S. E. SCHMITT
Checked By	Date	Bridge Design Supervisor	Date
J. W. TUCKER	10/99	J. P. HALSTEAD	10/99
PROJECT	MIDDLESEX-BOLTON	PROJECT NO.	IM-089-2(26)
Drawing No.	...43-sb.dgn	Date	OCT 1999
Bridge Sheet No.	TC-10	Sheet	170 of 307

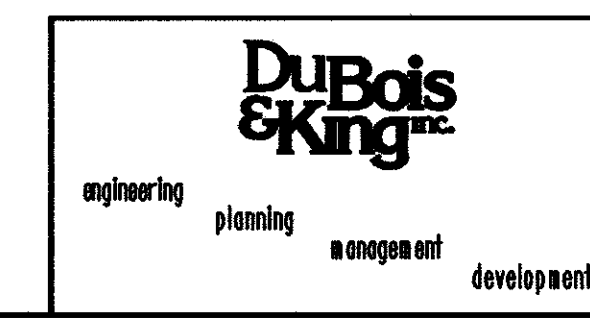


**LEGEND**

- CONCRETE BARRIER
- DIRECTION OF TRAFFIC FLOW WITH DETOUR IN PLACE
- ==== CROSSOVER ALIGNMENT
- ▨ BRIDGE WORK AREA
- LEDGE OUTCROPPING
- GUARDRAIL
- ⊕ EXISTING DROP INLET
- ⊞ PORTABLE ARROW BOARD
- TYPE I DELINEATOR (YELLOW)
- TYPE I DELINEATOR (WHITE)
- REFLECTORIZED PLASTIC DRUM
- 4" TEMPORARY PAVEMENT MARKINGS
- TYPE III BARRICADE
- ▣ TYPE III (MOD) BARRICADE
- APPROXIMATE CULVERT LOCATION

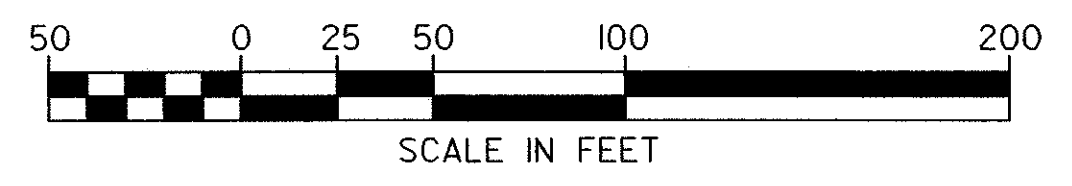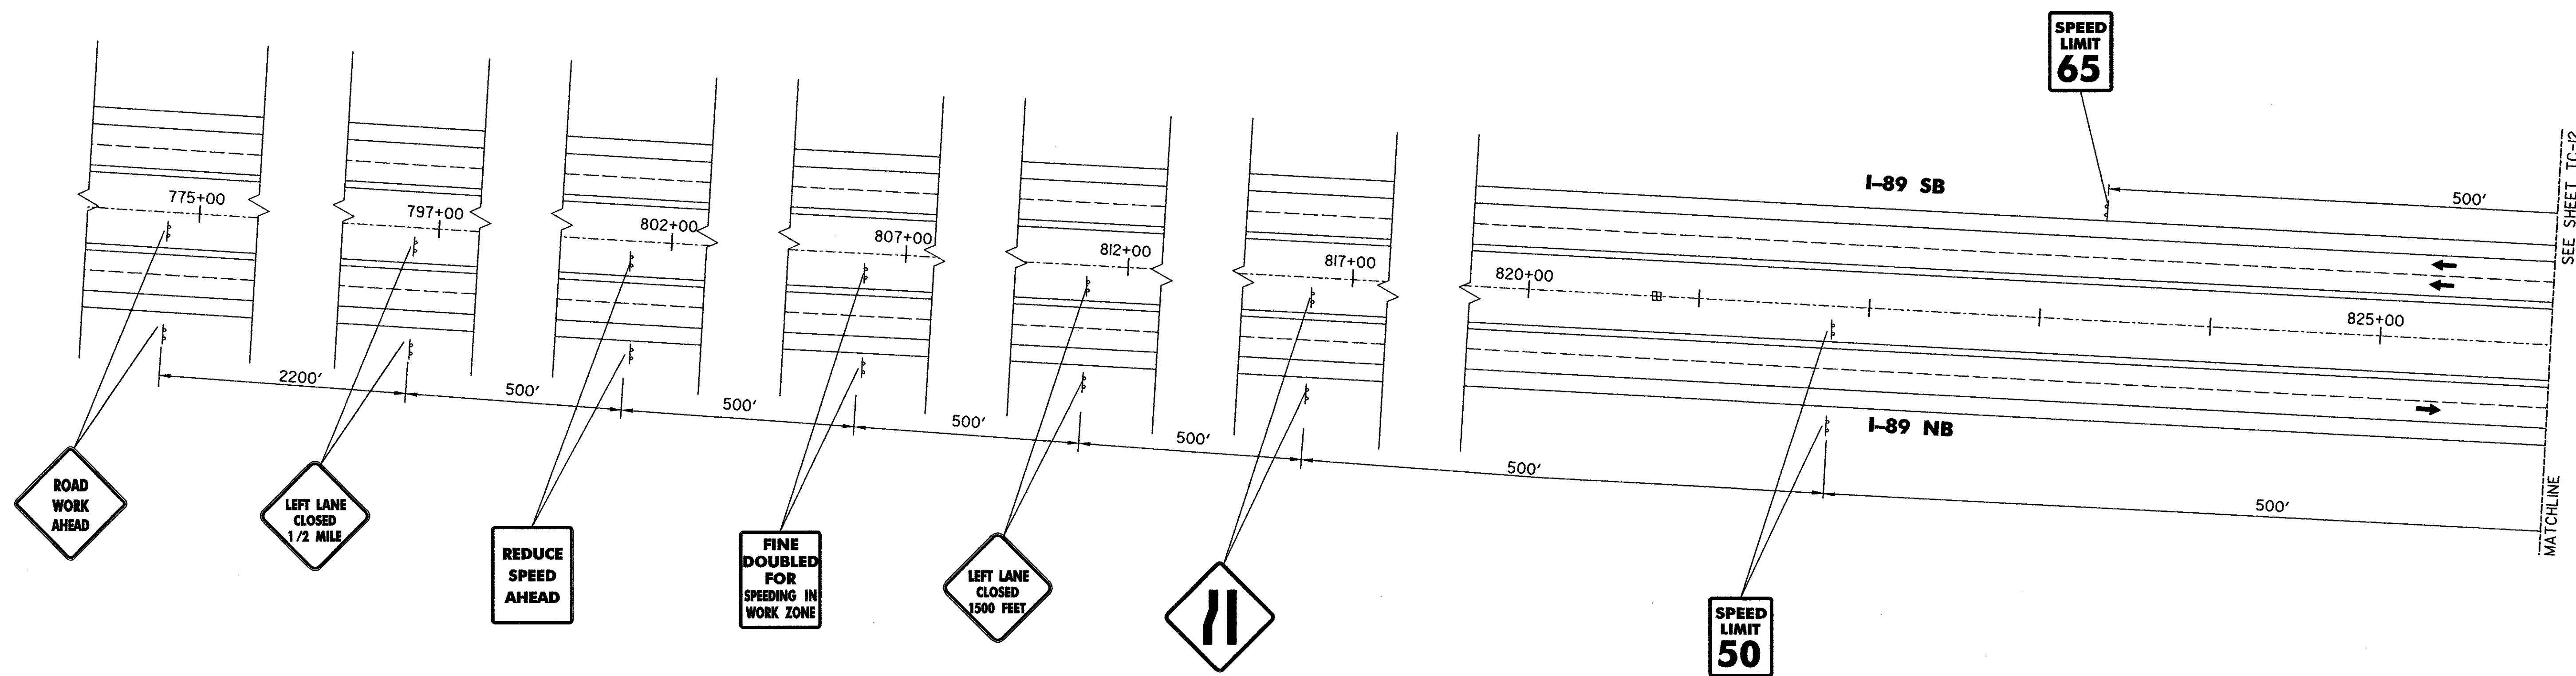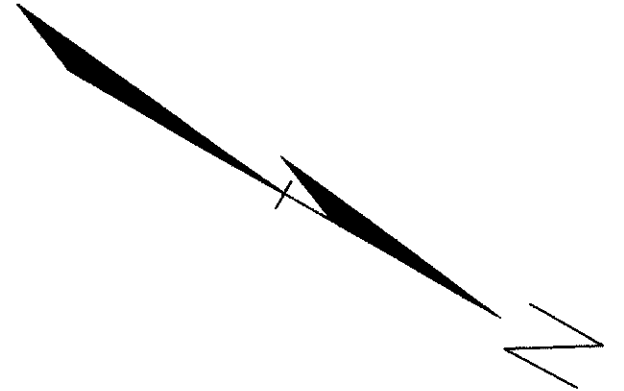




**STATE OF VERMONT  
AGENCY OF TRANSPORTATION**

Town Of	MIDDLESEX-BOLTON	Bridge No.	<b>48, 49, 50</b>
Highway No.	I-89	Log Sta.	
		Surv. Sta.	
<b>PHASE I CONSTRUCTION I-89 SOUTHBOUND CROSSOVER</b>			
<b>BRIDGES 48, 49, 50</b>			
Designed By	J.M.SMYRSKI/K.S.MARSHA	Drawn By	S. E. SCHMITT
Checked By	Date	Bridge Design Supervisor	Date
J. W. TUCKER	10/99	J. P. HALSTEAD	Date 10/99
PROJECT	MIDDLESEX-BOLTON	PROJECT NO.	IM-089-2(26)
Drawing No.	...48-49-50-sb.dgn	Date	OCT 1999
Bridge Sheet No.	TC-II	Sheet	171 of 307

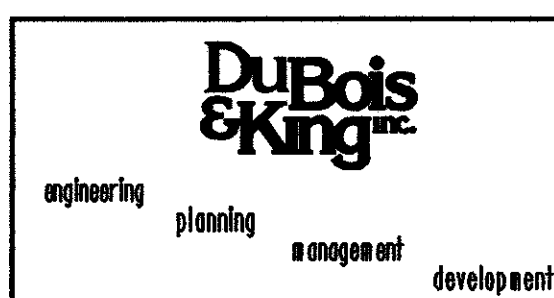


**LEGEND**

- CONCRETE BARRIER
- DIRECTION OF TRAFFIC FLOW WITH DETOUR IN PLACE
- ==== CROSSOVER ALIGNMENT
- ▨ BRIDGE WORK AREA
- ▧ LEDGE OUTCROPPING
- GUARDRAIL
- ⊞ EXISTING DROP INLET
- ⊞ PORTABLE ARROW BOARD
- TYPE I DELINEATOR (YELLOW)
- TYPE I DELINEATOR (WHITE)
- REFLECTORIZED PLASTIC DRUM
- 4" TEMPORARY PAVEMENT MARKINGS
- TYPE III BARRICADE
- ▣ TYPE III (MOD) BARRICADE
- ===== APPROXIMATE CULVERT LOCATION

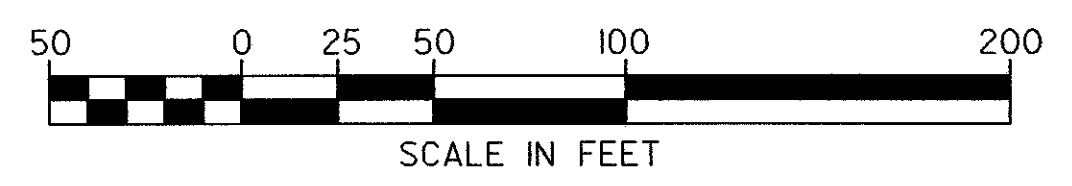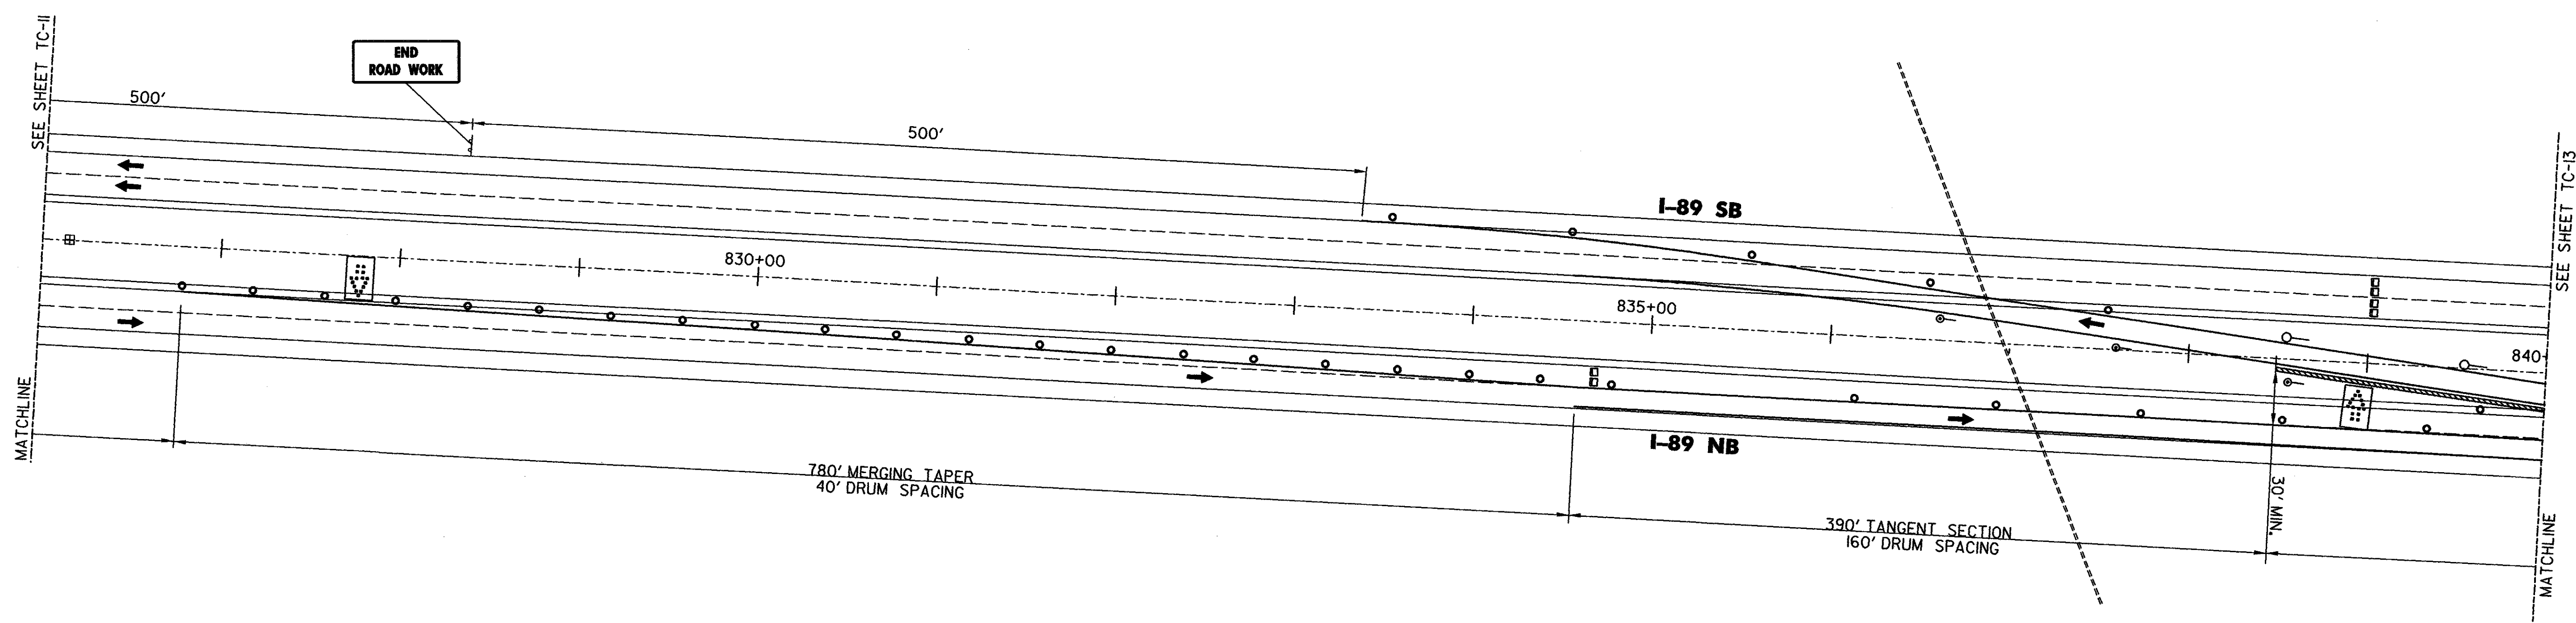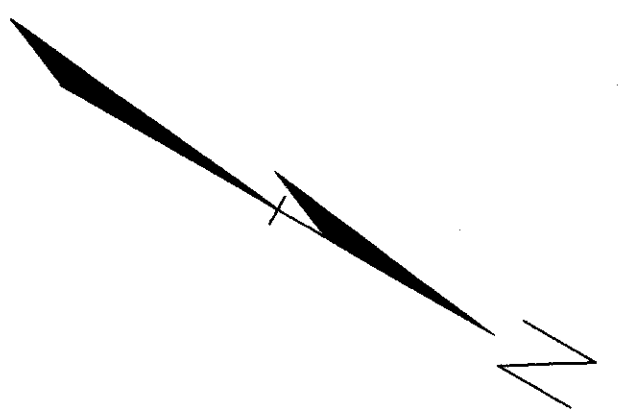








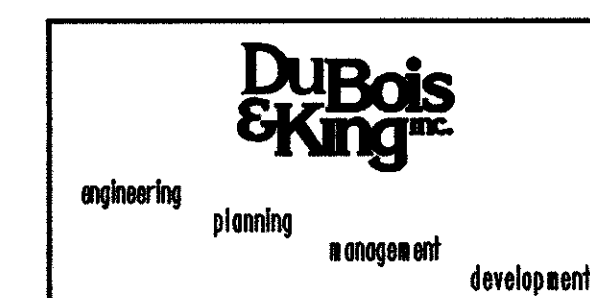








**STATE OF VERMONT  
AGENCY OF TRANSPORTATION**

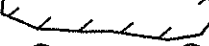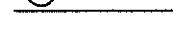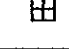Town Of	MIDDLESEX-BOLTON	Bridge No.	<b>48, 49, 50</b>
Highway No.	I-89	Log Sta.	
		Surv. Sta.	
<b>PHASE I CONSTRUCTION I-89 SOUTHBOUND CROSSOVER</b>			
<b>BRIDGES 48, 49, 50</b>			
Designed By	J.M.SMYRSKI/K.S.MARSHA	Drawn By	S. E. SCHMITT
Checked By	Date	Bridge Design Supervisor	Date
J. W. TUCKER	10/99	J. P. HALSTEAD	10/99
PROJECT	MIDDLESEX-BOLTON	PROJECT NO.	IM-089-2(26)
Drawing No.	...148-49-50-sb.dgn	Date	OCT 1999
Bridge Sheet No.	TC-12	Sheet	172 of 307

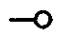


**LEGEND**

-  CONCRETE BARRIER
-  DIRECTION OF TRAFFIC FLOW WITH DETOUR IN PLACE
-  CROSSOVER ALIGNMENT
-  BRIDGE WORK AREA
-  LEDGE OUTCROPPING
-  GUARDRAIL
-  EXISTING DROP INLET
-  PORTABLE ARROW BOARD
-  TYPE I DELINEATOR (YELLOW)
-  TYPE I DELINEATOR (WHITE)
-  REFLECTORIZED PLASTIC DRUM
-  4" TEMPORARY PAVEMENT MARKINGS
-  TYPE III BARRICADE
-  TYPE III (MOD) BARRICADE
-  APPROXIMATE CULVERT LOCATION

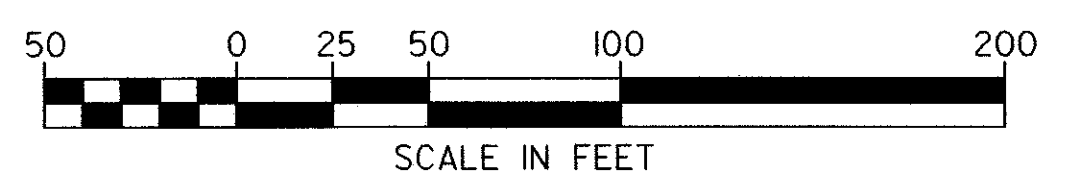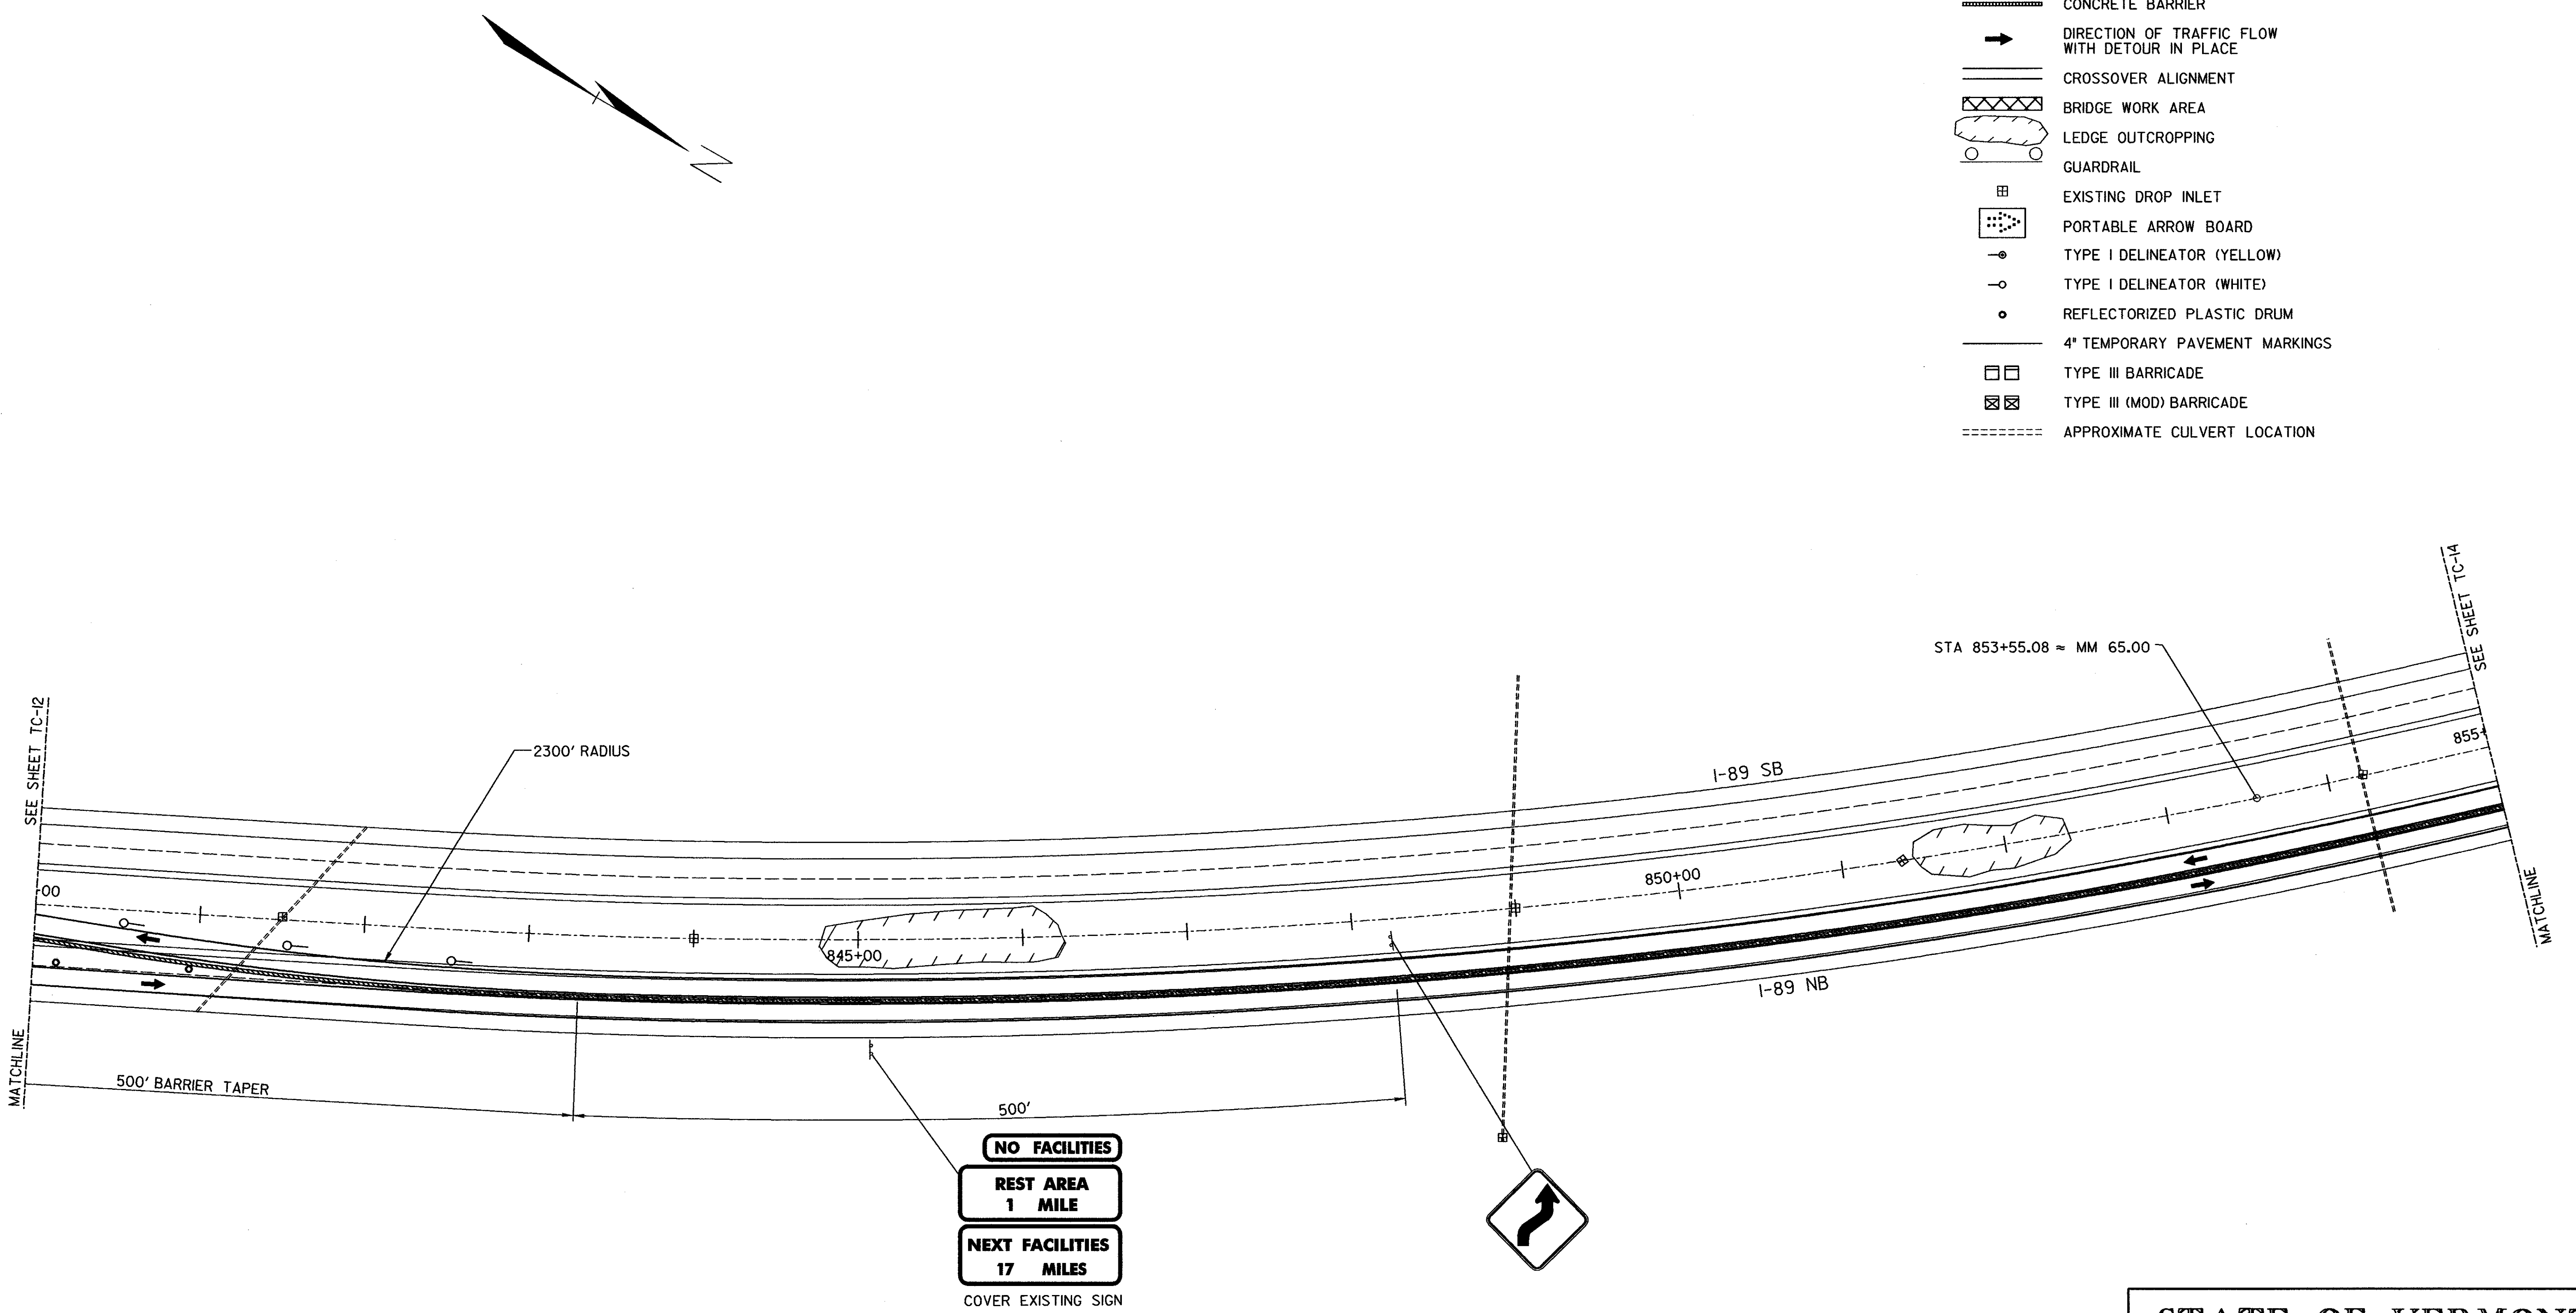






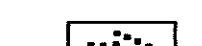


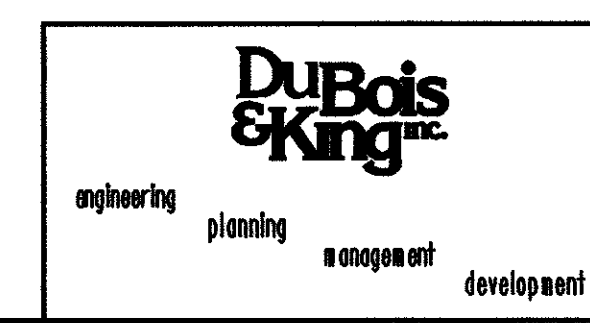






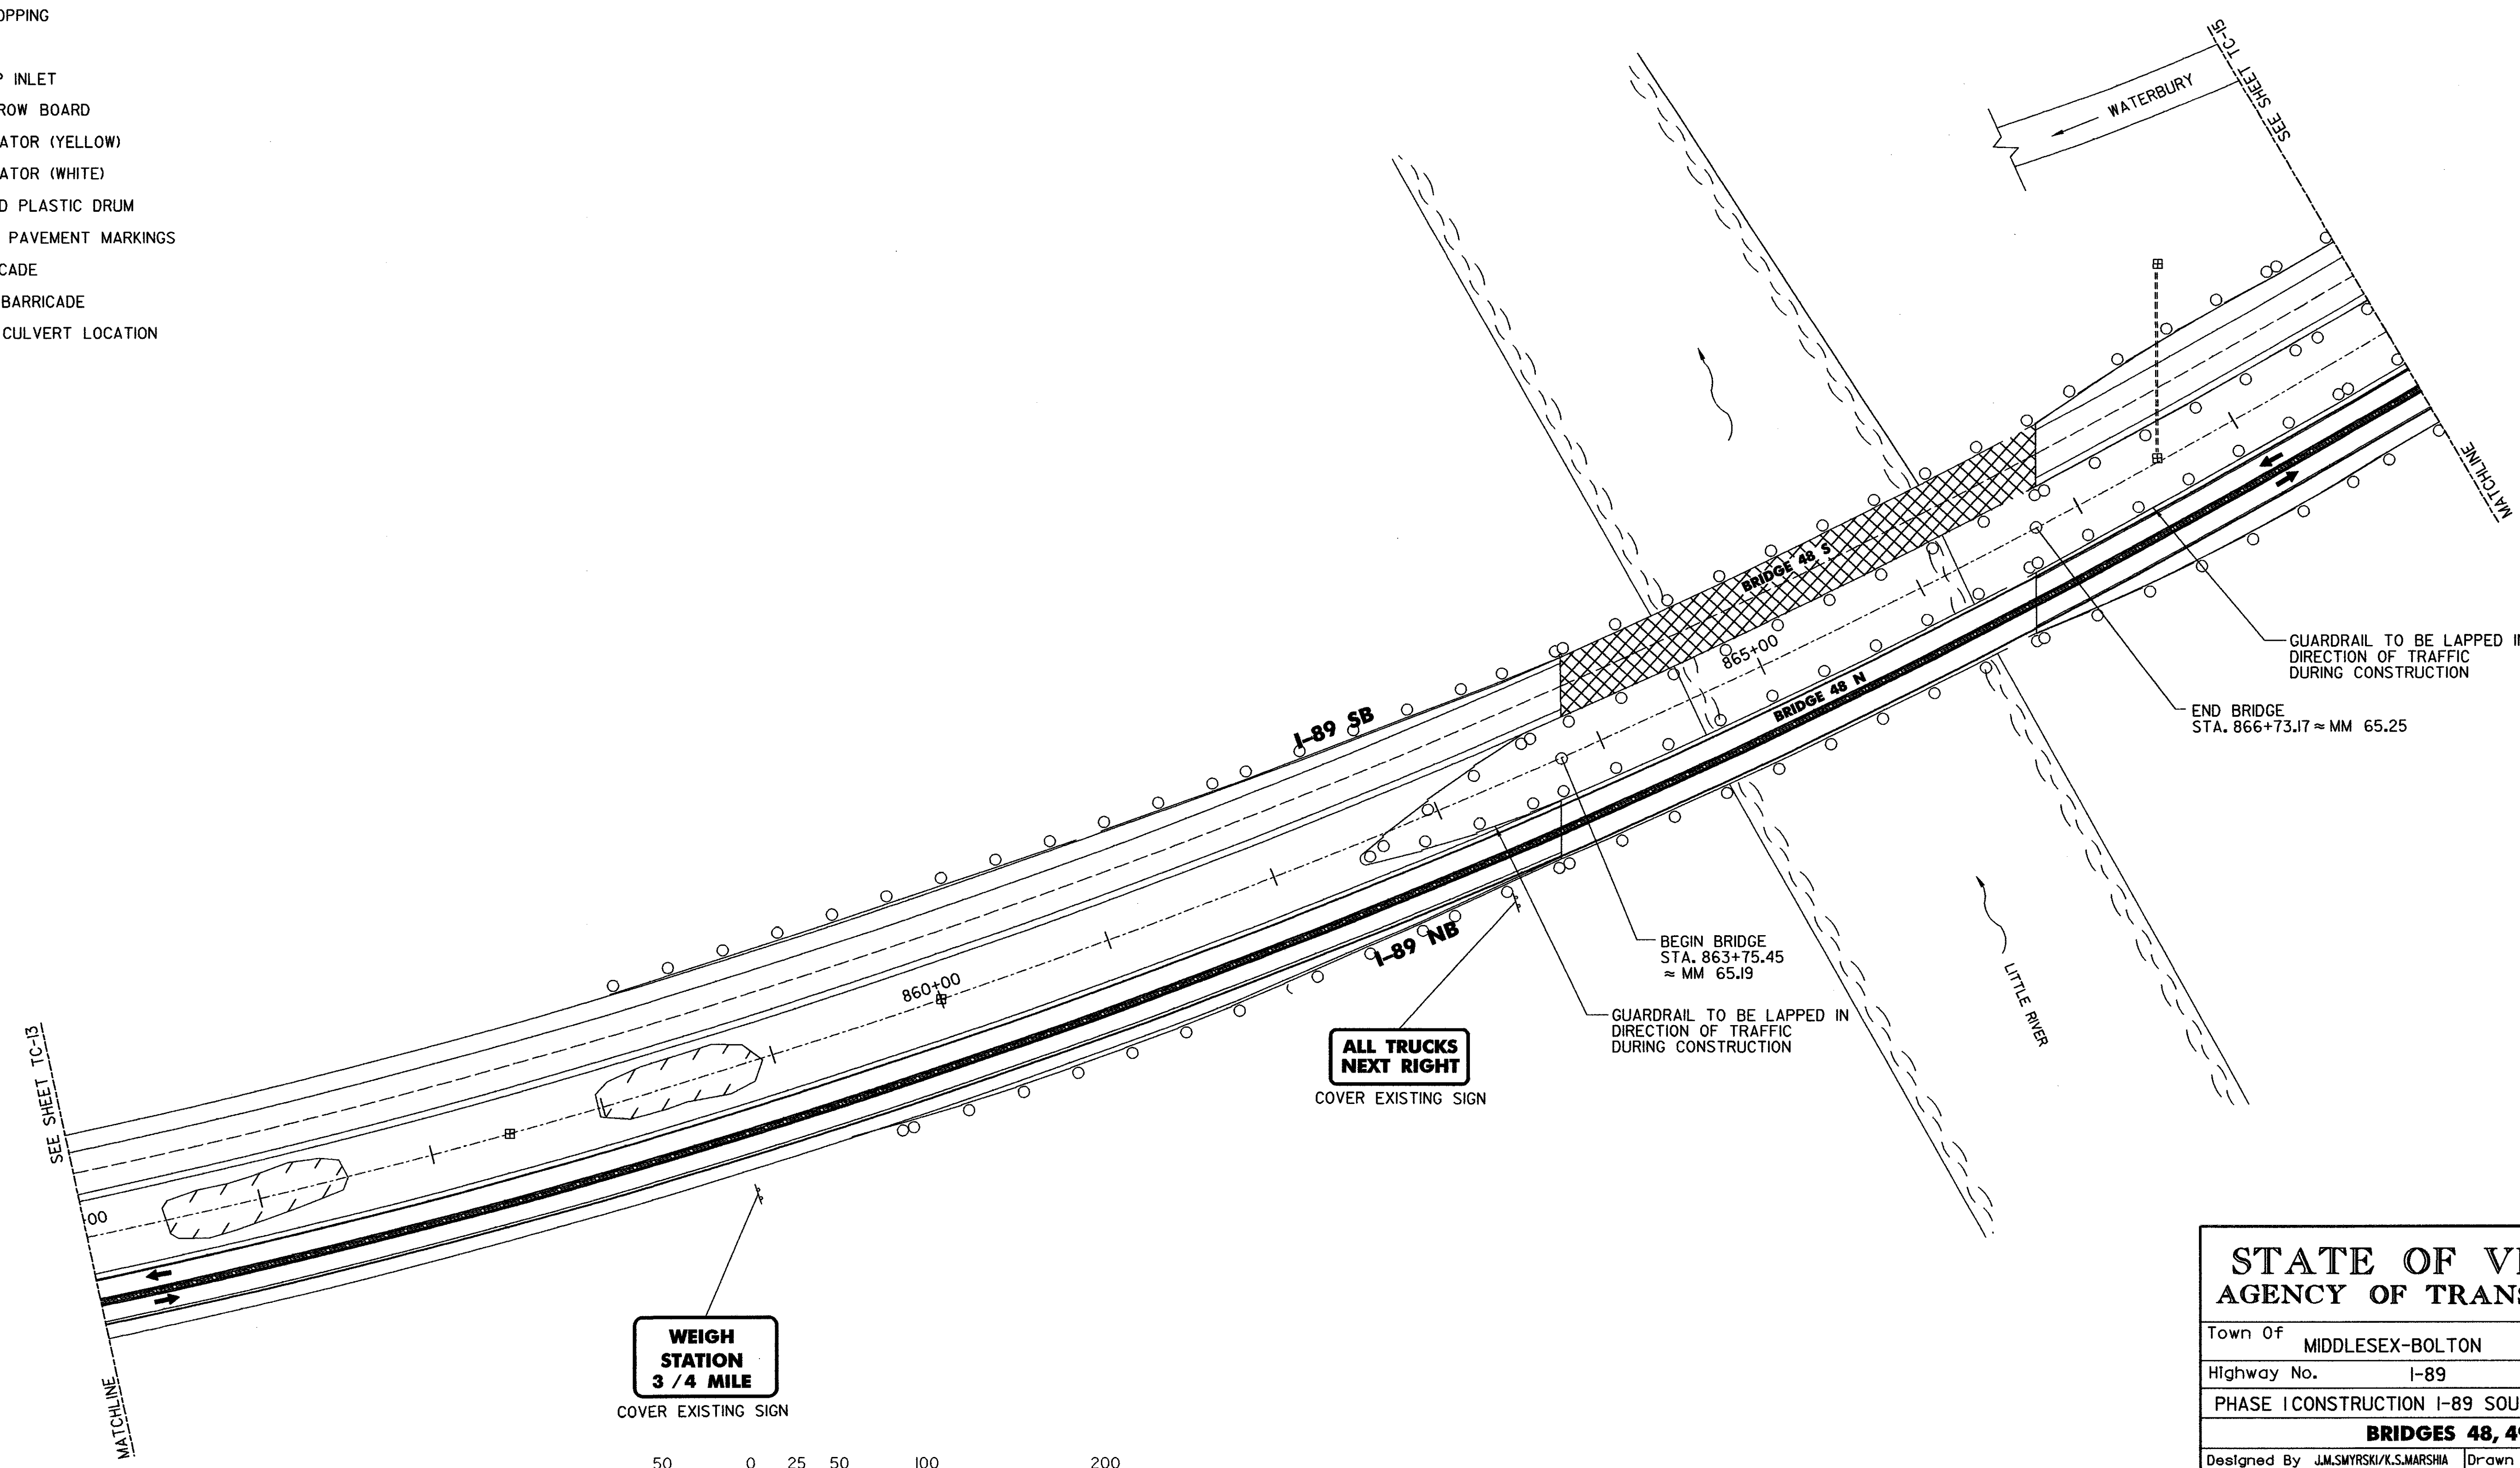
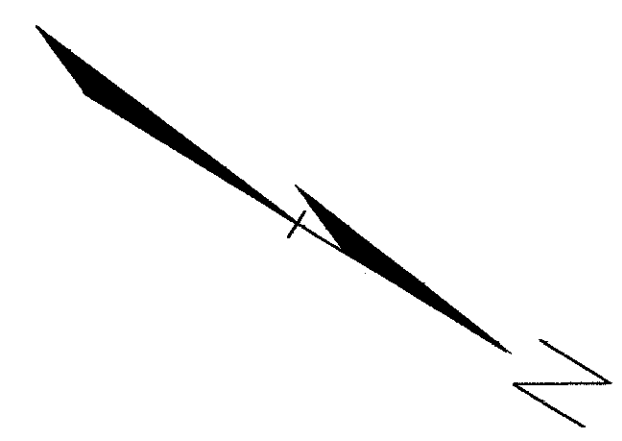
**STATE OF VERMONT  
AGENCY OF TRANSPORTATION**

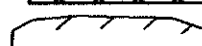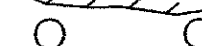Town Of	MIDDLESEX-BOLTON	Bridge No.	<b>48, 49, 50</b>
Highway No.	I-89	Log Sta.	
		Surv. Sta.	
PHASE I CONSTRUCTION I-89 SOUTHBOUND CROSSOVER			
<b>BRIDGES 48, 49, 50</b>			
Designed By	J.M.SMYRSKI/K.S.MARSHA	Drawn By	S. E. SCHMITT
Checked By	Date	Bridge Design Supervisor	Date
J. W. TUCKER	10/99	J. P. HALSTEAD	Date 10/99
PROJECT	MIDDLESEX-BOLTON	PROJECT NO.	IM-089-2(26)
Drawing No.	...48-49-50-sb.dgn	Date	OCT 1999
Bridge Sheet No.	TC-13	Sheet	173 of 307




**LEGEND**

-  CONCRETE BARRIER
-  DIRECTION OF TRAFFIC FLOW WITH DETOUR IN PLACE
-  CROSSOVER ALIGNMENT
-  BRIDGE WORK AREA
-  LEDGE OUTCROPPING
-  GUARDRAIL
-  EXISTING DROP INLET
-  PORTABLE ARROW BOARD
-  TYPE I DELINEATOR (YELLOW)
-  TYPE I DELINEATOR (WHITE)
-  REFLECTORIZED PLASTIC DRUM
-  4" TEMPORARY PAVEMENT MARKINGS
-  TYPE III BARRICADE
-  TYPE III (MOD) BARRICADE
-  APPROXIMATE CULVERT LOCATION




**WEIGH STATION**  
3 / 4 MILE  
COVER EXISTING SIGN

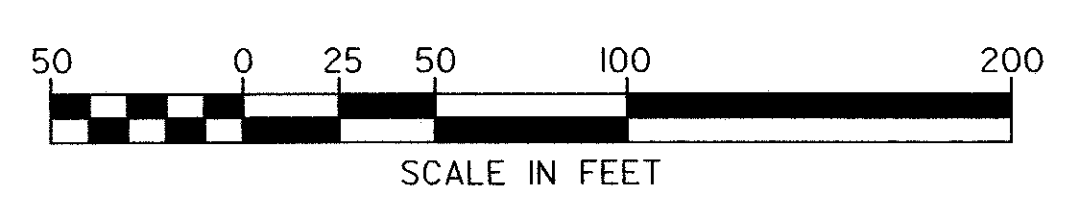



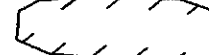
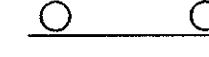
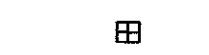





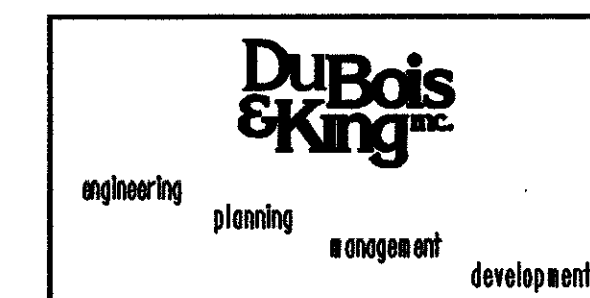





**STATE OF VERMONT  
AGENCY OF TRANSPORTATION**

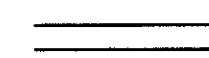Town Of	MIDDLESEX-BOLTON	Bridge No.	<b>48, 49, 50</b>
Highway No.	I-89	Log Sta.	
		Surv. Sta.	
<b>PHASE I CONSTRUCTION I-89 SOUTHBOUND CROSSOVER BRIDGES 48, 49, 50</b>			
Designed By	J.M.SMYRSKI/K.S.MARSHIA	Drawn By	S. E. SCHMITT
Checked By	Date	Bridge Design Supervisor	
J. W. TUCKER	10/99	J. P. HALSTEAD	Date 10/99
PROJECT	MIDDLESEX-BOLTON	PROJECT NO.	IM-089-2(26)
Drawing No.	...148-49-50-sb.dgn	Date	OCT 1999
Bridge Sheet No.	TC-14	Sheet	174 of 307

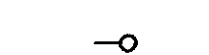

**LEGEND**

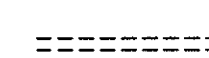-  CONCRETE BARRIER
-  DIRECTION OF TRAFFIC FLOW WITH DETOUR IN PLACE
-  CROSSOVER ALIGNMENT
-  BRIDGE WORK AREA
-  LEDGE OUTCROPPING
-  GUARDRAIL
-  EXISTING DROP INLET
-  PORTABLE ARROW BOARD
-  TYPE I DELINEATOR (YELLOW)
-  TYPE I DELINEATOR (WHITE)
-  REFLECTORIZED PLASTIC DRUM
-  4' TEMPORARY PAVEMENT MARKINGS
-  TYPE III BARRICADE
-  TYPE III (MOD) BARRICADE
-  APPROXIMATE CULVERT LOCATION

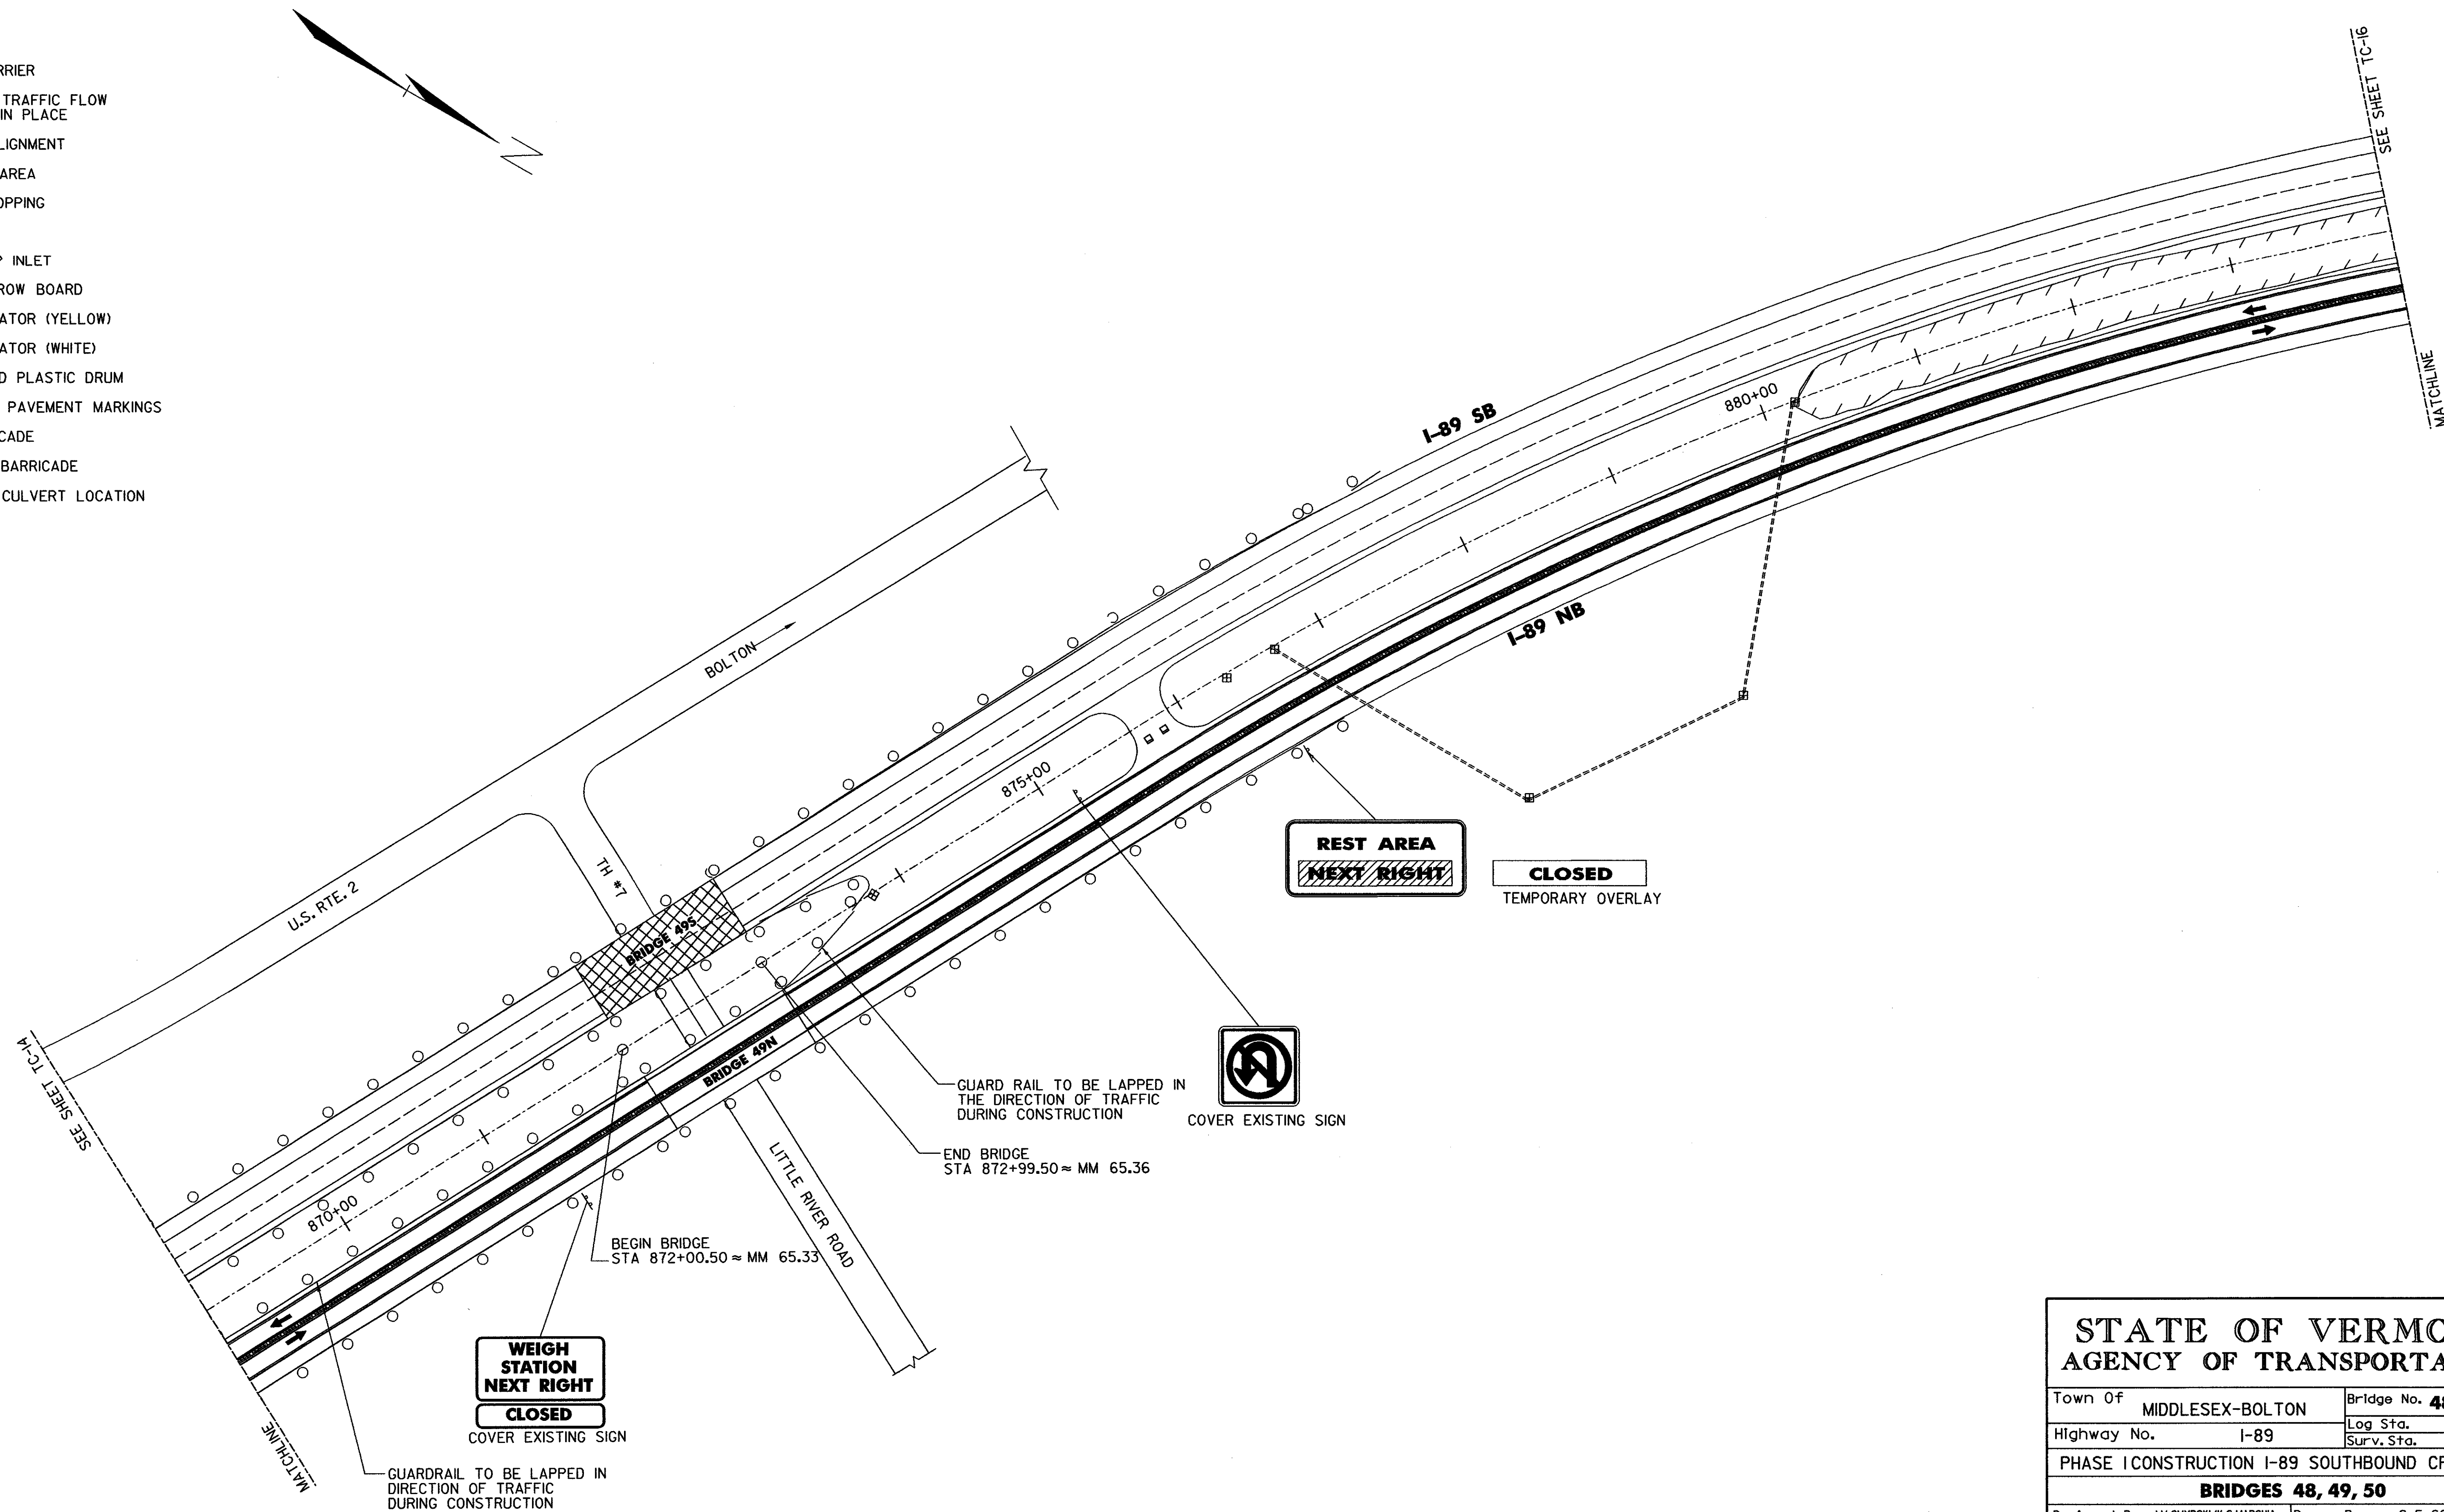

**WEIGH STATION  
NEXT RIGHT  
CLOSED**  
COVER EXISTING SIGN

**REST AREA  
NEXT RIGHT**


**CLOSED**  
TEMPORARY OVERLAY

 COVER EXISTING SIGN

GUARD RAIL TO BE LAPPED IN THE DIRECTION OF TRAFFIC DURING CONSTRUCTION  
END BRIDGE STA 872+99.50 ≈ MM 65.36


BEGIN BRIDGE STA 872+00.50 ≈ MM 65.33

GUARDRAIL TO BE LAPPED IN DIRECTION OF TRAFFIC DURING CONSTRUCTION

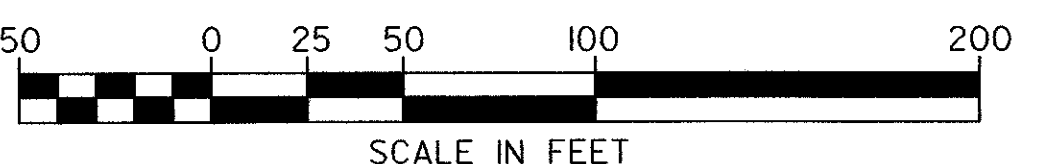








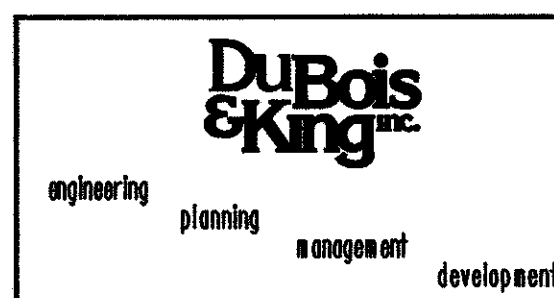




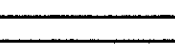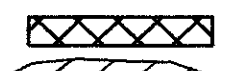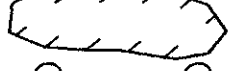





**STATE OF VERMONT  
AGENCY OF TRANSPORTATION**

Town Of	MIDDLESEX-BOLTON	Bridge No.	<b>48, 49, 50</b>
Highway No.	I-89	Log Sta.	
		Surv. Sta.	
<b>PHASE I CONSTRUCTION I-89 SOUTHBOUND CROSSOVER BRIDGES 48, 49, 50</b>			
Designed By	J.M.SMYRSKI/K.S.MARSHA	Drawn By	S. E. SCHMITT
Checked By	Date	Bridge Design Supervisor	Date
J. W. TUCKER	10/99	J. P. HALSTEAD	10/99
PROJECT	MIDDLESEX-BOLTON	PROJECT NO.	IM-089-2(26)
Drawing No.	...48-49-50-sb.dgn	Date	OCT 1999
Bridge Sheet No.	TC-15	Sheet	175 of 307

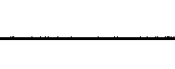

**LEGEND**

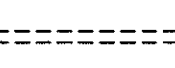-  CONCRETE BARRIER
-  DIRECTION OF TRAFFIC FLOW WITH DETOUR IN PLACE
-  CROSSOVER ALIGNMENT
-  BRIDGE WORK AREA
-  LEDGE OUTCROPPING
-  GUARDRAIL
-  EXISTING DROP INLET
-  PORTABLE ARROW BOARD
-  TYPE I DELINEATOR (YELLOW)
-  TYPE I DELINEATOR (WHITE)
-  REFLECTORIZED PLASTIC DRUM
-  4" TEMPORARY PAVEMENT MARKINGS
-  TYPE III BARRICADE
-  TYPE III (MOD) BARRICADE
-  APPROXIMATE CULVERT LOCATION

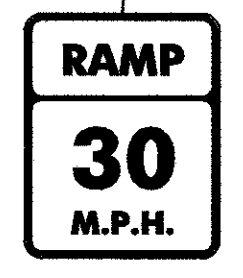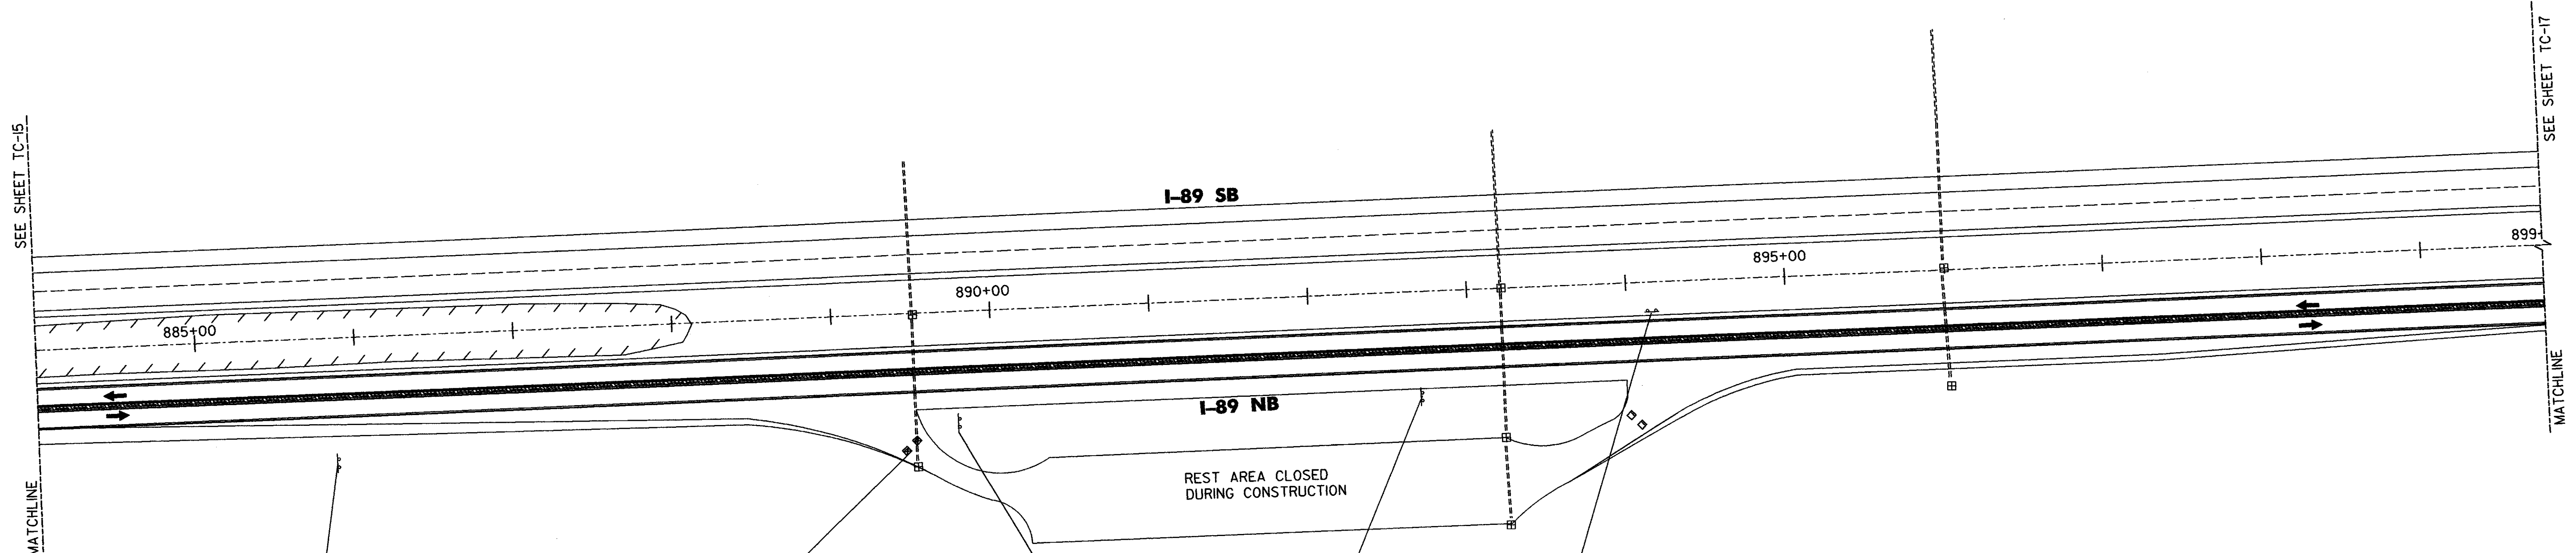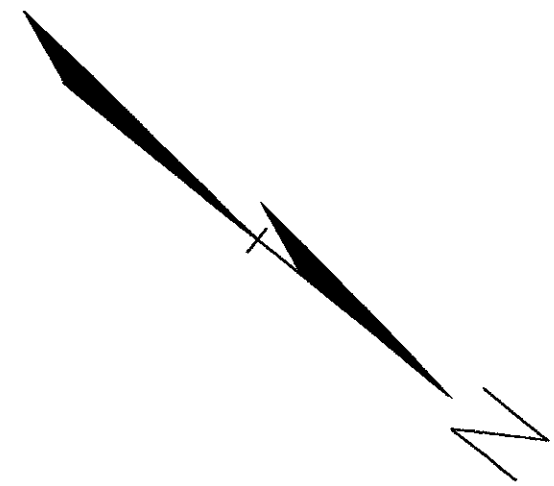

COVER EXISTING SIGN



MOUNT ON TYPE III (MOD.) BARRICADES




COVER EXISTING SIGN



COVER EXISTING SIGN




COVER EXISTING SIGN

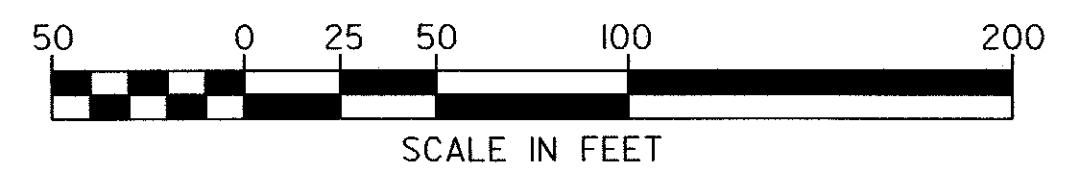



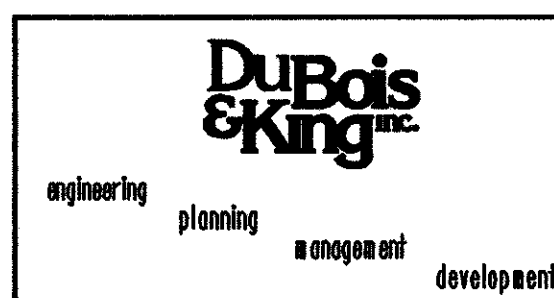




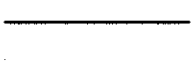







**STATE OF VERMONT  
AGENCY OF TRANSPORTATION**


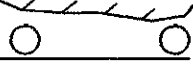
Town Of	MIDDLESEX-BOLTON	Bridge No.	<b>48, 49, 50</b>
Highway No.	I-89	Log Sta.	
		Surv. Sta.	
<b>PHASE I CONSTRUCTION I-89 SOUTHBOUND CROSSOVER</b>			
<b>BRIDGES 48, 49, 50</b>			
Designed By	J.M.SMYRSKI/K.S.MARSHA	Drawn By	S. E. SCHMITT
Checked By	Date	Bridge Design Supervisor	Date
J. W. TUCKER	10/99	J. P. HALSTEAD	10/99
PROJECT	MIDDLESEX-BOLTON	PROJECT NO.	IM-089-2(26)
Drawing No.	...148-49-50-sb.dgn	Date	OCT 1999
Bridge Sheet No.	TC-16	Sheet	176 of 307

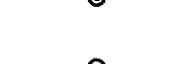

**LEGEND**


-  CONCRETE BARRIER
-  DIRECTION OF TRAFFIC FLOW WITH DETOUR IN PLACE
-  CROSSOVER ALIGNMENT
-  BRIDGE WORK AREA
-  LEDGE OUTCROPPING
-  GUARDRAIL
-  EXISTING DROP INLET
-  PORTABLE ARROW BOARD
-  TYPE I DELINEATOR (YELLOW)
-  TYPE I DELINEATOR (WHITE)
-  REFLECTORIZED PLASTIC DRUM
-  4" TEMPORARY PAVEMENT MARKINGS
-  TYPE III BARRICADE
-  TYPE III (MOD) BARRICADE
-  APPROXIMATE CULVERT LOCATION


CONTINUE  
DETOUR TO  
STA. 899+76.69  
COVER/REMOVE  
SIGNS THAT  
CONFLICT

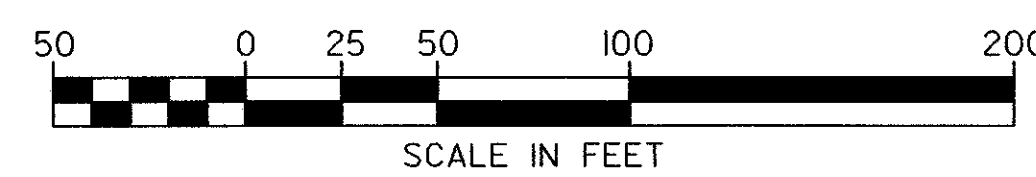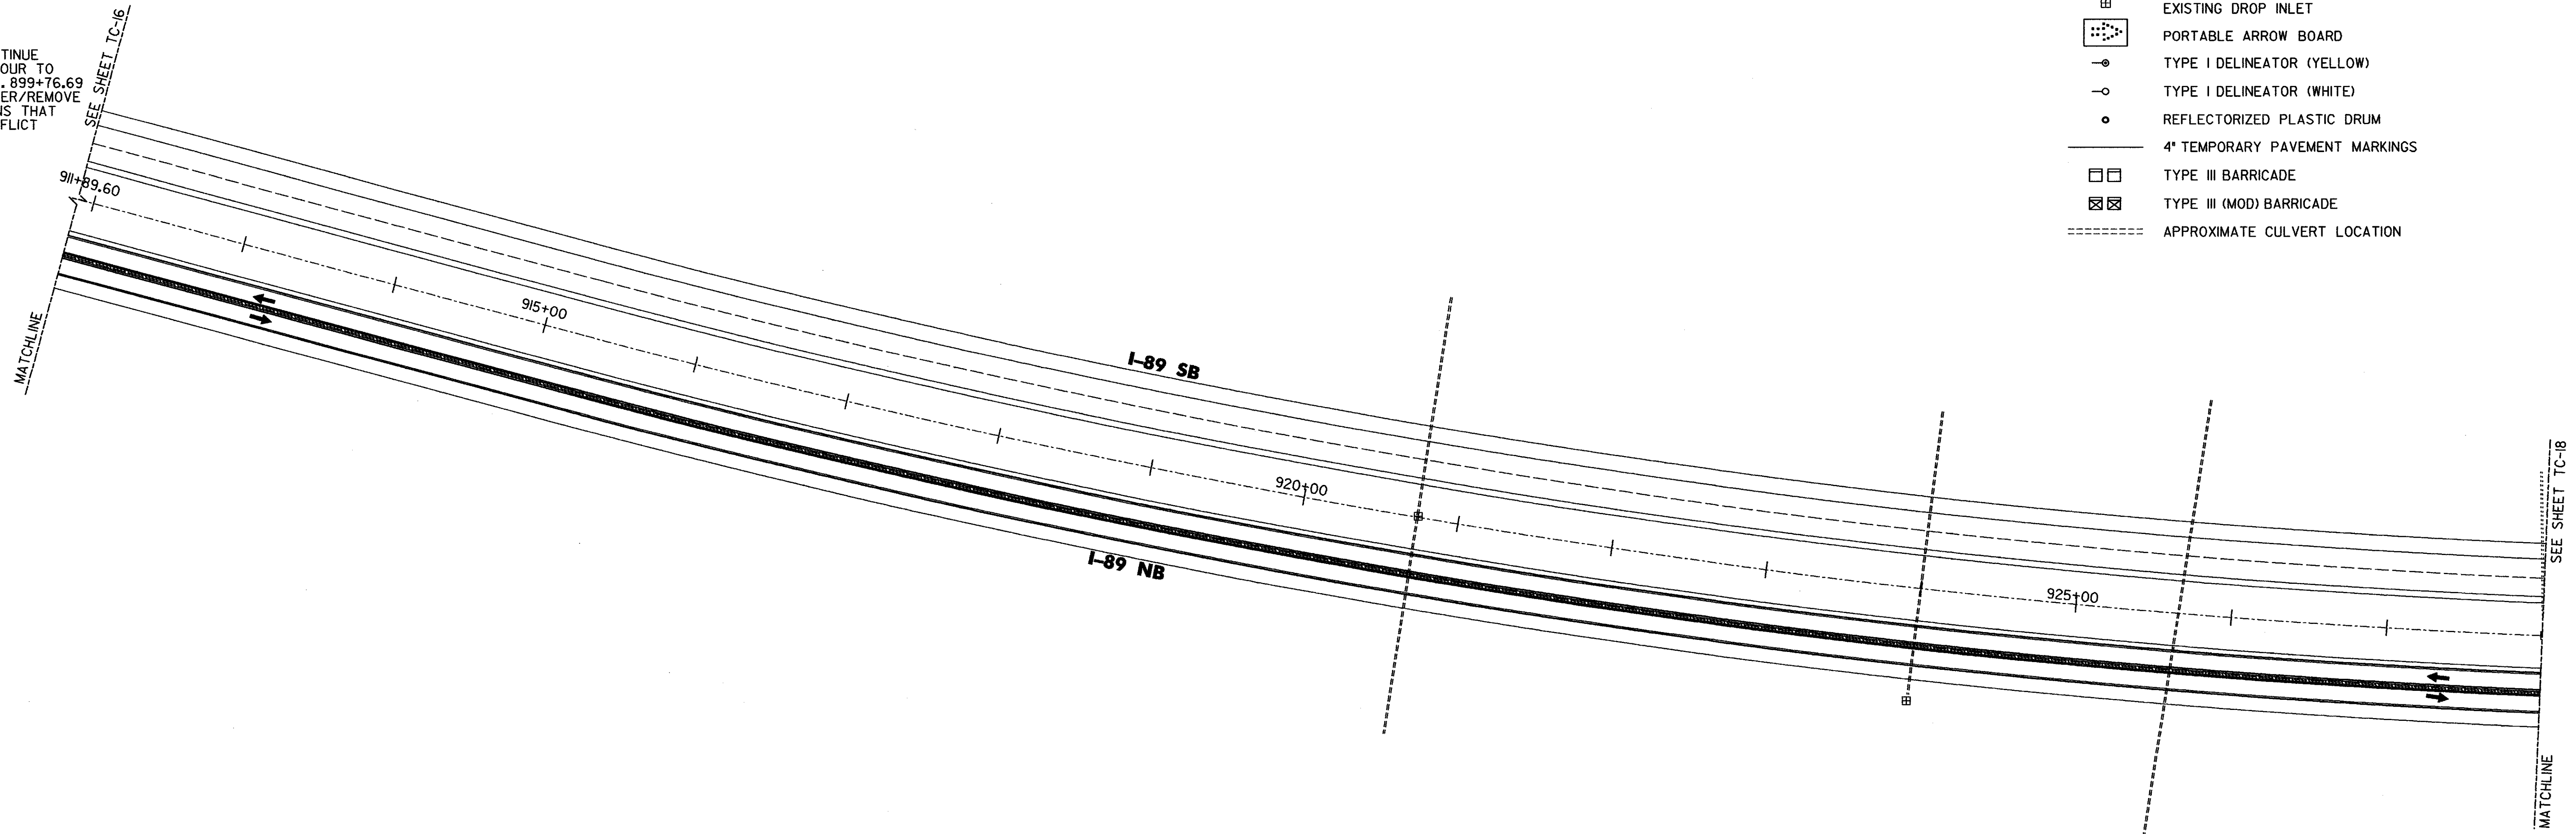

**STATE OF VERMONT  
AGENCY OF TRANSPORTATION**


Town Of	MIDDLESEX-BOLTON	Bridge No.	<b>48, 49, 50</b>
Highway No.	I-89	Log Sta.	
		Surv. Sta.	
PHASE I CONSTRUCTION I-89 SOUTHBOUND CROSSOVER			
<b>BRIDGES 48, 49, 50</b>			
Designed By	J.M.SMYRSKI/K.S.MARSHA	Drawn By	S. E. SCHMITT
Checked By	J. W. TUCKER	Date	10/99
		Bridge Design Supervisor	J. P. HALSTEAD Date 10/99
PROJECT	MIDDLESEX-BOLTON	PROJECT NO.	IM-089-2(26)
Drawing No.	...48-49-50-sb.dgn	Date	OCT 1999
Bridge Sheet No.	TC-17	Sheet	177 of 307

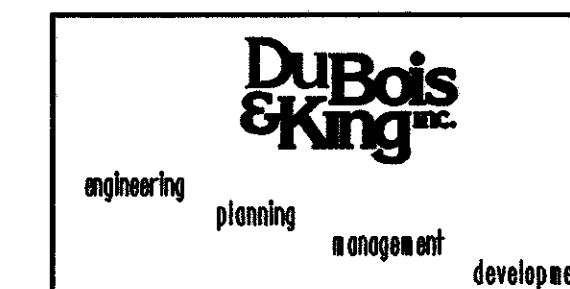

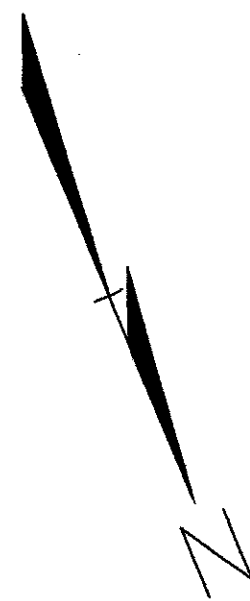

**LEGEND**

- CONCRETE BARRIER
- DIRECTION OF TRAFFIC FLOW WITH DETOUR IN PLACE
- CROSSOVER ALIGNMENT
- ▨ BRIDGE WORK AREA
- ▨ LEDGE OUTCROPPING
- GUARDRAIL
- ⊠ EXISTING DROP INLET
- ⊠ PORTABLE ARROW BOARD
- TYPE I DELINEATOR (YELLOW)
- TYPE I DELINEATOR (WHITE)
- REFLECTORIZED PLASTIC DRUM
- 4" TEMPORARY PAVEMENT MARKINGS
- ▢ TYPE III BARRICADE
- ▣ TYPE III (MOD) BARRICADE
- ⋯ APPROXIMATE CULVERT LOCATION

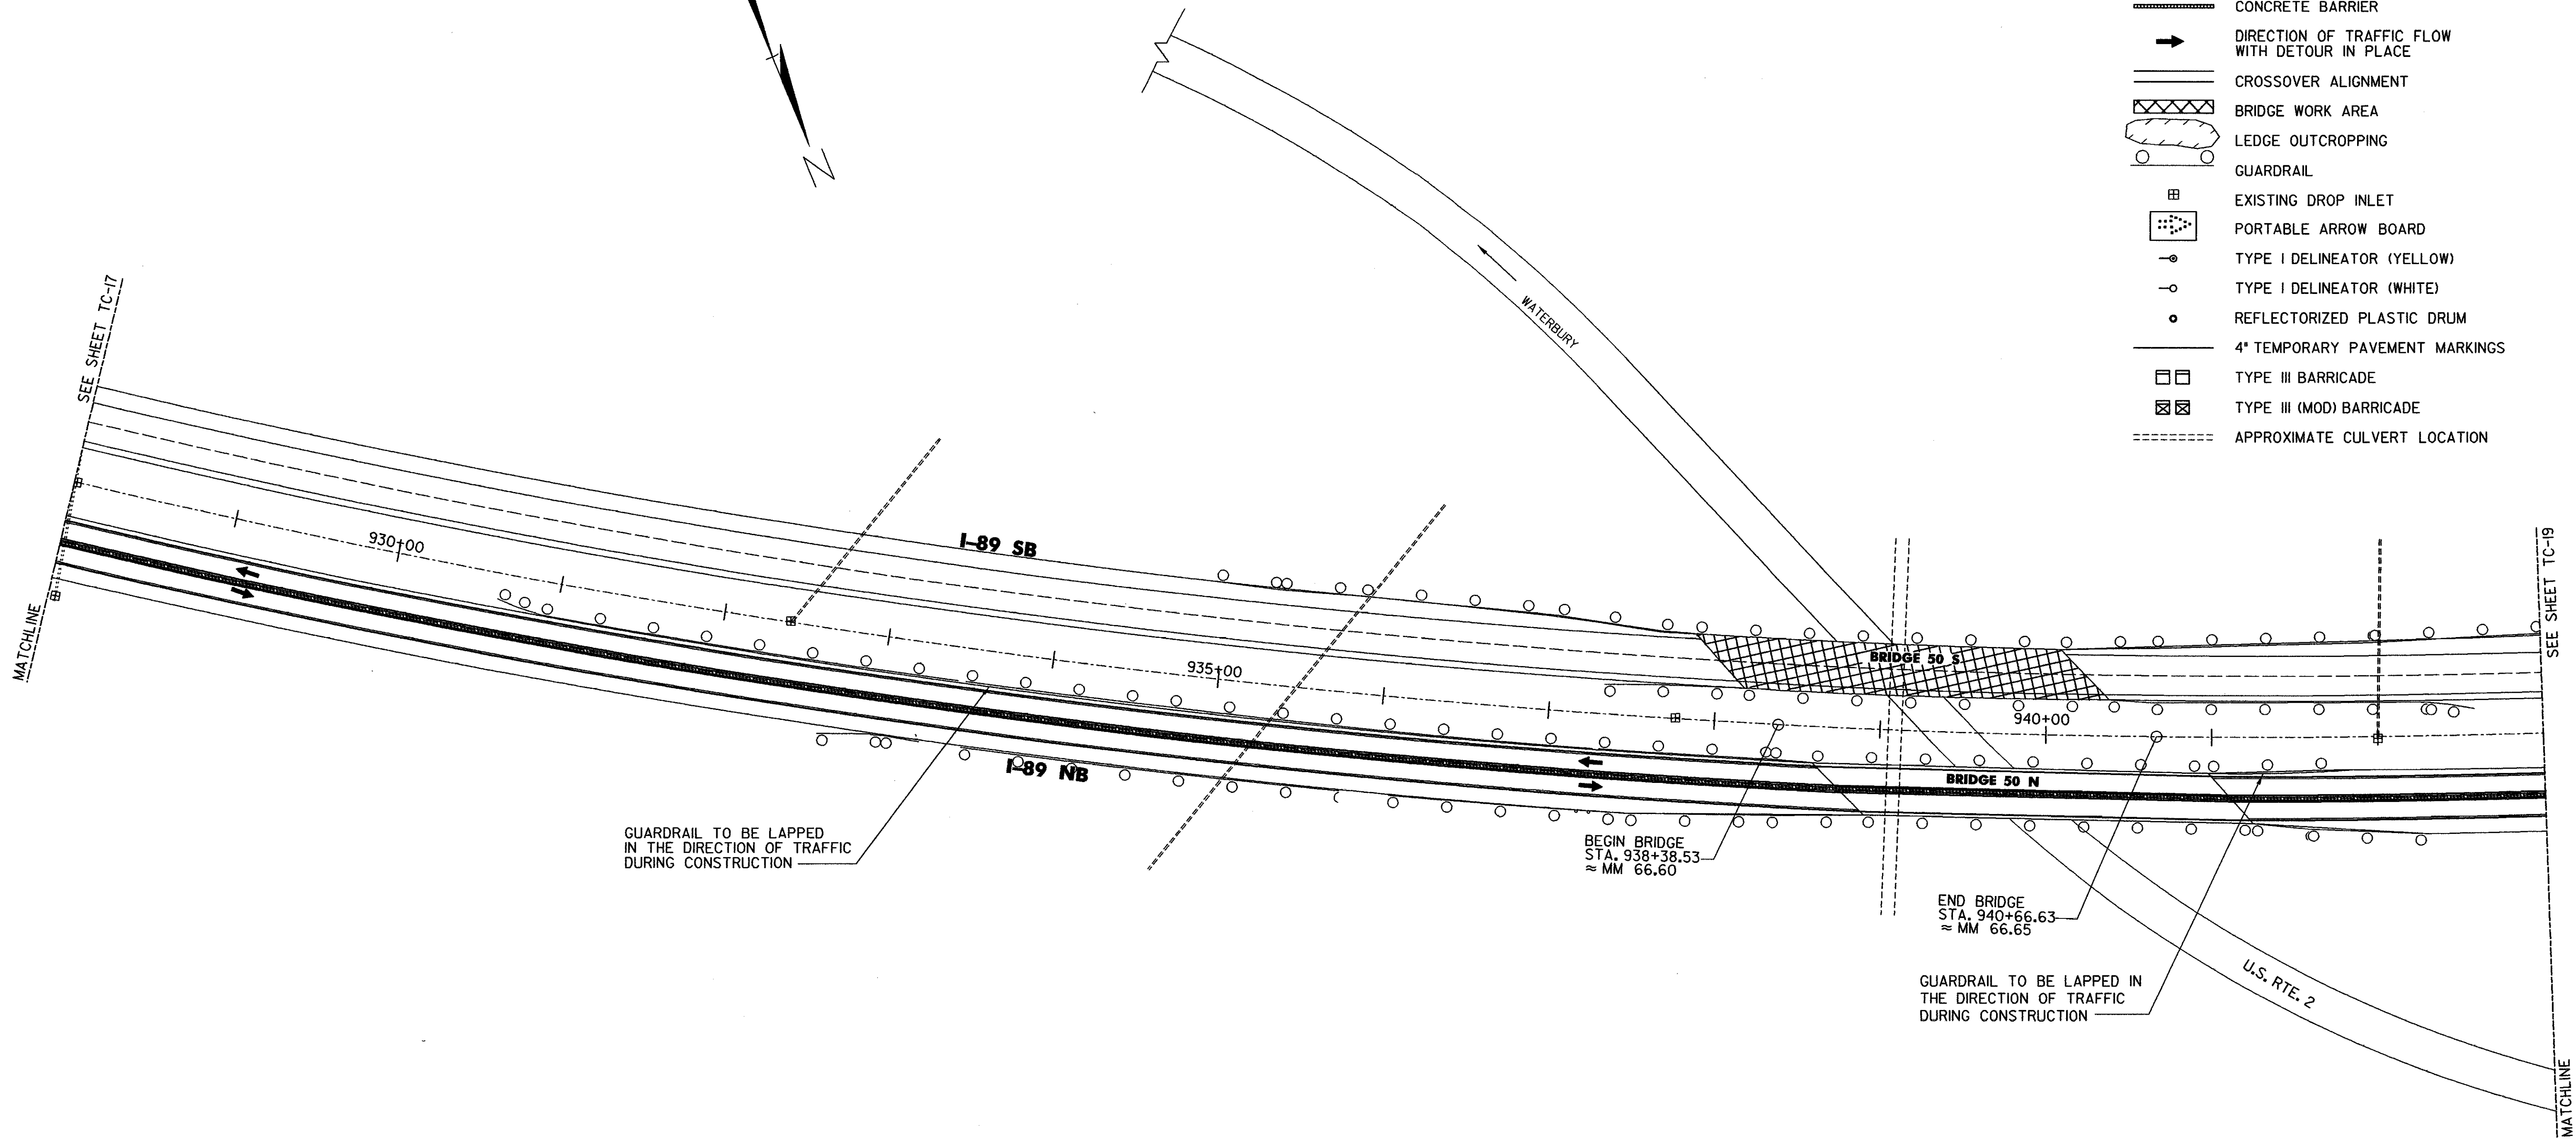


GUARDRAIL TO BE LAPPED IN THE DIRECTION OF TRAFFIC DURING CONSTRUCTION

BEGIN BRIDGE  
STA. 938+38.53  
≈ MM 66.60


END BRIDGE  
STA. 940+66.63  
≈ MM 66.65

GUARDRAIL TO BE LAPPED IN THE DIRECTION OF TRAFFIC DURING CONSTRUCTION

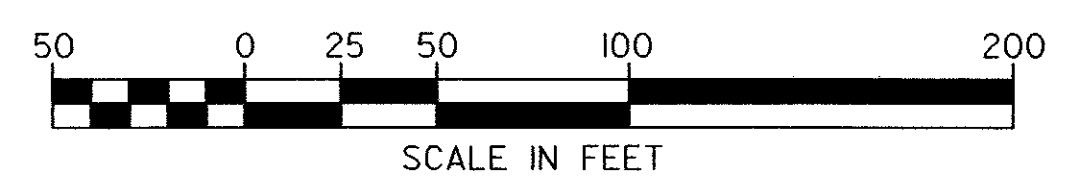







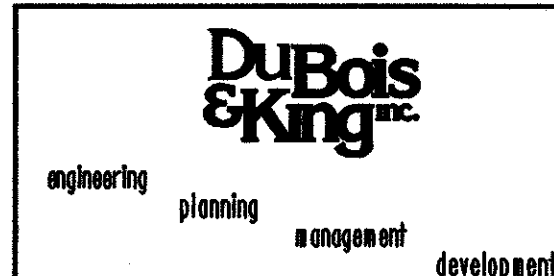




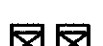



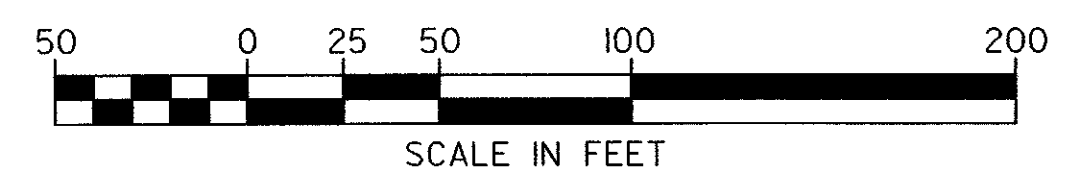
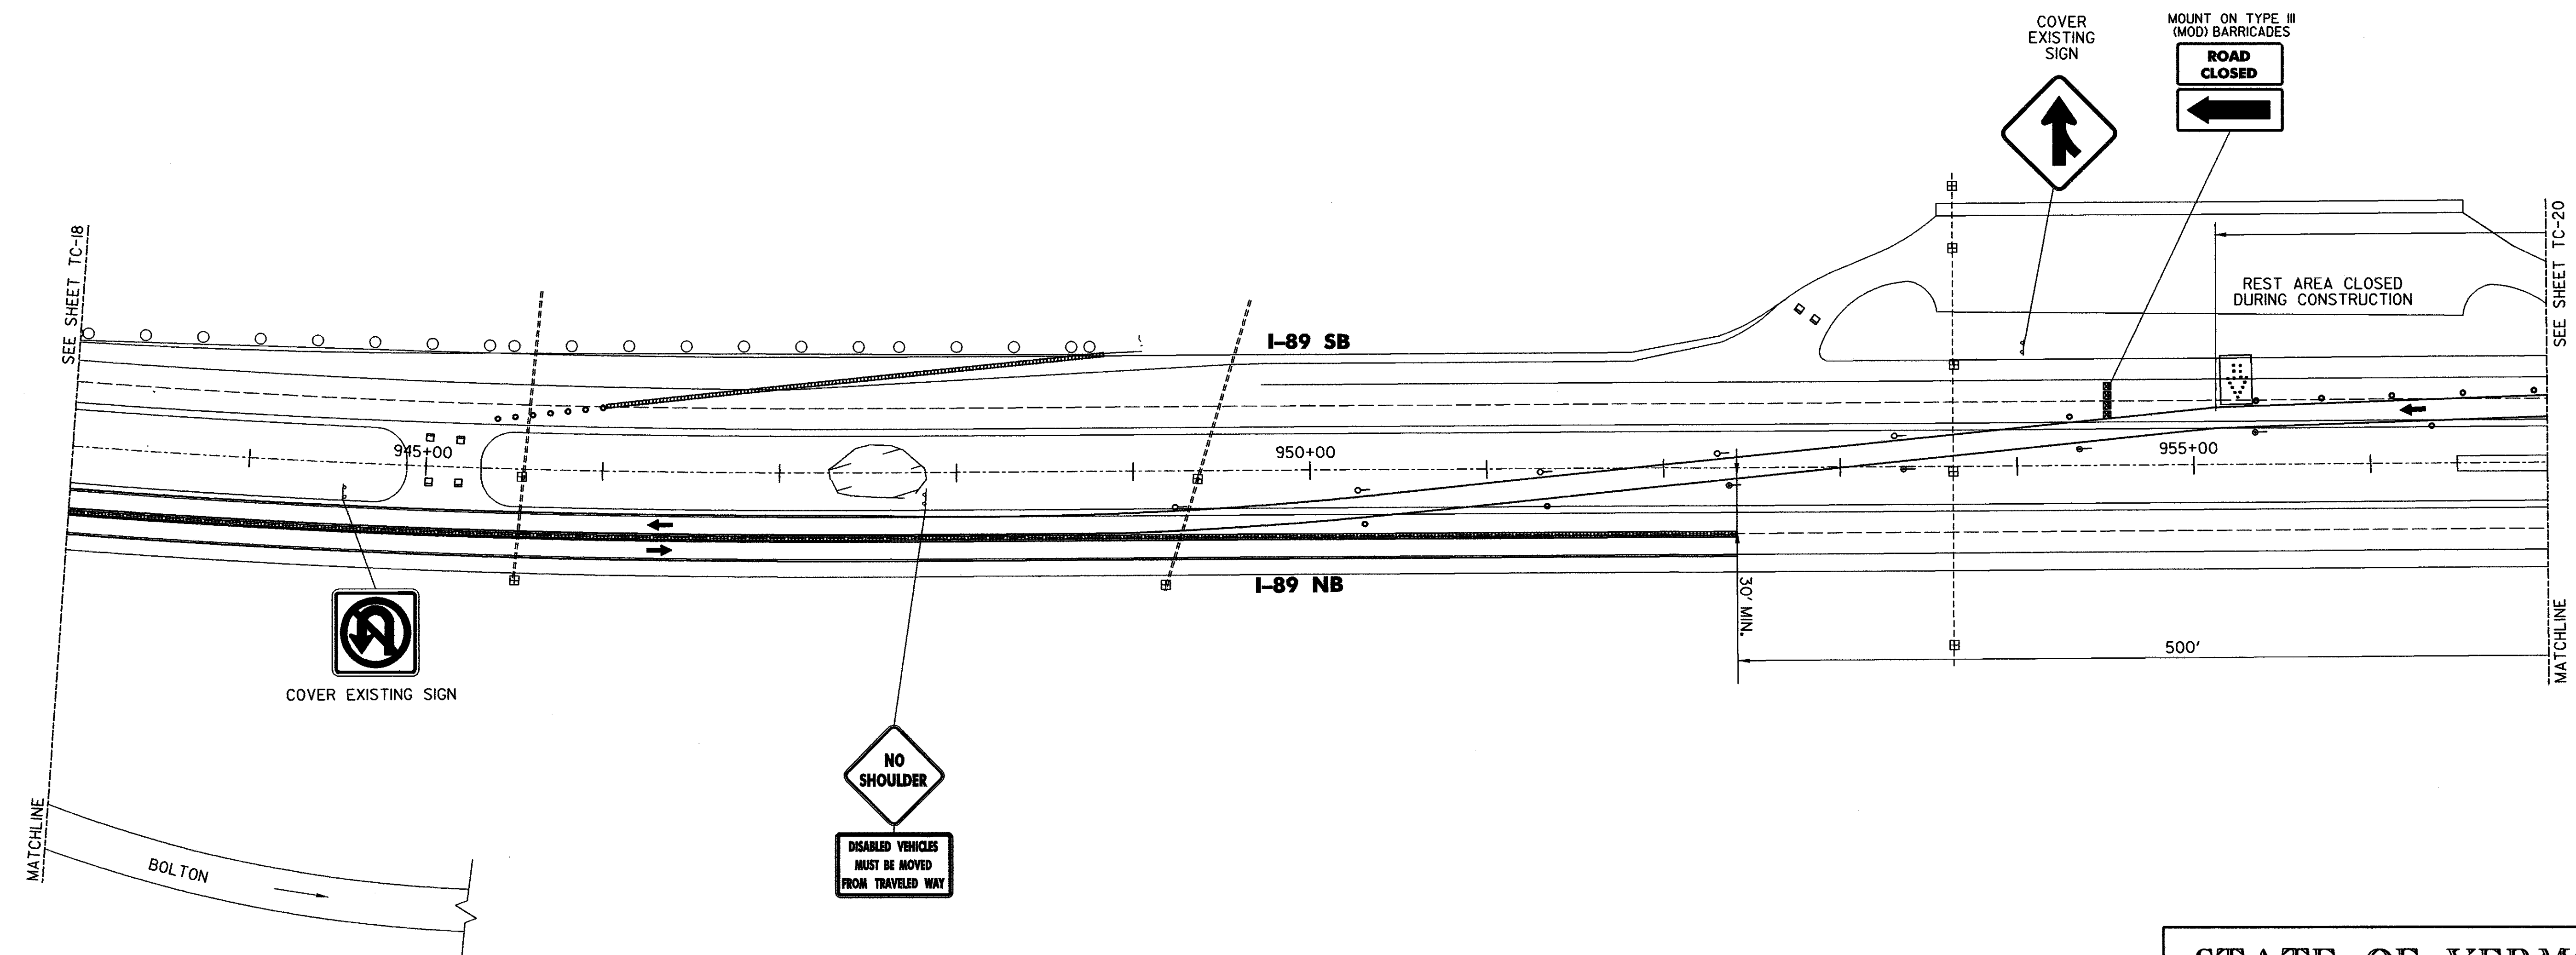
**STATE OF VERMONT  
AGENCY OF TRANSPORTATION**

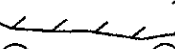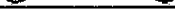Town Of	MIDDLESEX-BOLTON	Bridge No.	<b>48, 49, 50</b>
Highway No.	I-89	Log Sta.	
		Surv. Sta.	
PHASE I CONSTRUCTION I-89 SOUTHBOUND CROSSOVER			
<b>BRIDGES 48, 49, 50</b>			
Designed By	J.M.SMYRSKI/K.S.MARSHA	Drawn By	S. E. SCHMITT
Checked By	J. W. TUCKER	Date	10/99
		Bridge Design Supervisor	J. P. HALSTEAD Date 10/99
PROJECT	MIDDLESEX-BOLTON	PROJECT NO.	IM-089-2(26)
Drawing No.	...48-49-50-sb.dgn	Date	OCT 1999
Bridge Sheet No.	TC-18	Sheet	178 of 307




**LEGEND**

-  CONCRETE BARRIER
-  DIRECTION OF TRAFFIC FLOW WITH DETOUR IN PLACE
-  CROSSOVER ALIGNMENT
-  BRIDGE WORK AREA
-  LEDGE OUTCROPPING
-  GUARDRAIL
-  EXISTING DROP INLET
-  PORTABLE ARROW BOARD
-  TYPE I DELINEATOR (YELLOW)
-  TYPE I DELINEATOR (WHITE)
-  REFLECTORIZED PLASTIC DRUM
-  4" TEMPORARY PAVEMENT MARKINGS
-  TYPE III BARRICADE
-  TYPE III (MOD) BARRICADE
-  APPROXIMATE CULVERT LOCATION










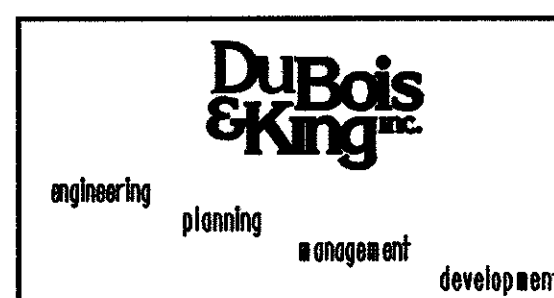



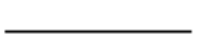
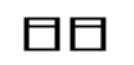
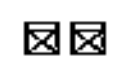
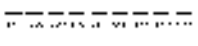
**STATE OF VERMONT  
AGENCY OF TRANSPORTATION**

Town Of	MIDDLESEX-BOLTON	Bridge No.	<b>48, 49, 50</b>
Highway No.	I-89	Log Sta.	
		Surv. Sta.	
<b>PHASE I CONSTRUCTION I-89 SOUTHBOUND CROSSOVER</b>			
<b>BRIDGES 48, 49, 50</b>			
Designed By	J.M.SMYRSKI/K.S.MARSHA	Drawn By	S.E. SCHMITT
Checked By	Date	Bridge Design Supervisor	Date
J. W. TUCKER	10/99	J. P. HALSTEAD	10/99
PROJECT	MIDDLESEX-BOLTON	PROJECT NO.	IM-089-2(26)
Drawing No.	...148-49-50-sb.dgn	Date	OCT 1999
Bridge Sheet No.	TC-19	Sheet	179 of 307





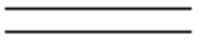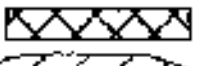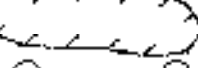

**LEGEND**

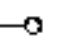-  CONCRETE BARRIER
-  DIRECTION OF TRAFFIC FLOW WITH DETOUR IN PLACE
-  CROSSOVER ALIGNMENT
-  BRIDGE WORK AREA
-  LEDGE OUTCROPPING
-  GUARDRAIL
-  EXISTING DROP INLET
-  PORTABLE ARROW BOARD
-  TYPE I DELINEATOR (YELLOW)
-  TYPE I DELINEATOR (WHITE)
-  REFLECTORIZED PLASTIC DRUM
-  4" TEMPORARY PAVEMENT MARKINGS
-  TYPE III BARRICADE
-  TYPE III (MOD) BARRICADE
-  APPROXIMATE CULVERT LOCATION

• NOT ALL SOUTH BOUND REST AREA SIGNS THAT NEEDED TO BE COVERED WERE INDICATED ON THE PLANS ON SHEET 180 AND 181


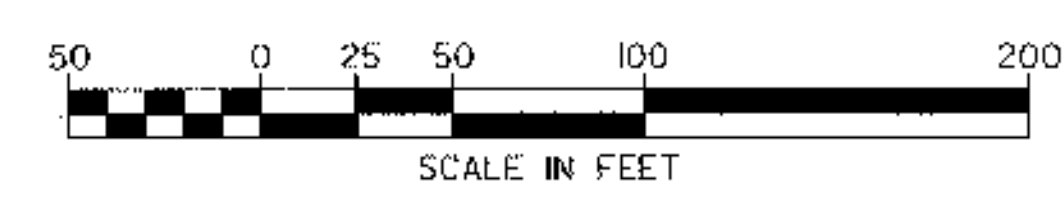
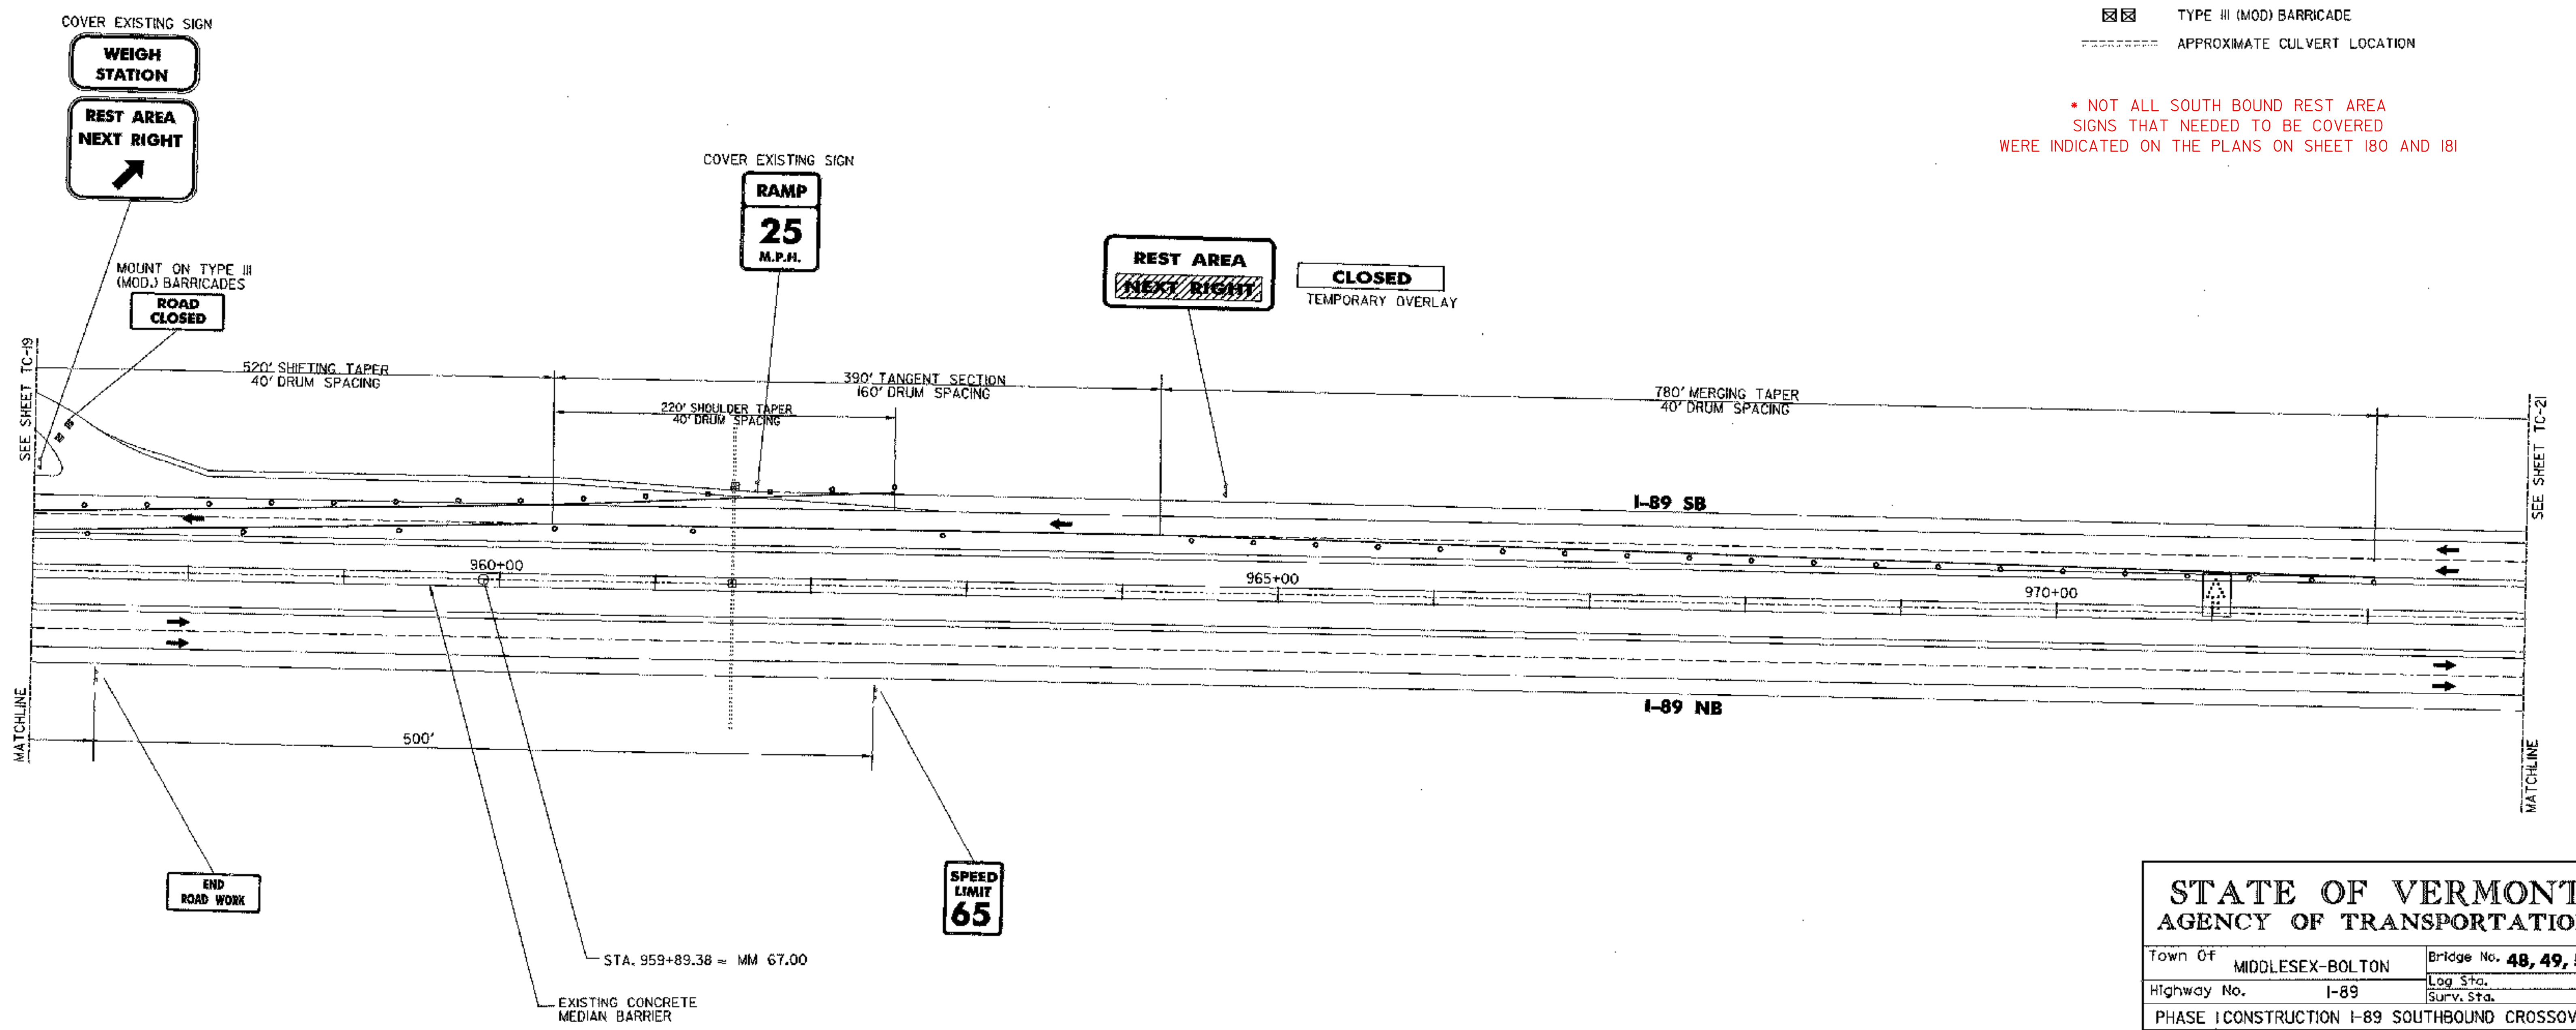


<b>STATE OF VERMONT AGENCY OF TRANSPORTATION</b>			
Town Of	MIDDLESEX-BOLTON	Bridge No.	<b>48, 49, 50</b>
Highway No.	I-89	Log Sta.	
		Surv. Sta.	
PHASE I CONSTRUCTION I-89 SOUTHBOUND CROSSOVER			
<b>BRIDGES 48, 49, 50</b>			
Designed By	J.M.SMYRSKI/K.S.MARSHIA	Drawn By	S. E. SCHMITT
Checked By	J. W. TUCKER	Bridge Design Supervisor	J. P. HALSTEAD
Date	10/99	Date	10/99
PROJECT	MIDDLESEX-BOLTON	PROJECT NO.	IM-089-2(26)
Drawing No.	...48-49-50-sb.dgn	Date	OCT 1999
Bridge Sheet No.	TC-20	Sheet	180 of 307




**LEGEND**

- CONCRETE BARRIER
- ➔ DIRECTION OF TRAFFIC FLOW WITH DETOUR IN PLACE
- ==== CROSSOVER ALIGNMENT
- ▨ BRIDGE WORK AREA
- ⬭ LEDGE OUTCROPPING
- GUARDRAIL
- ⊞ EXISTING DROP INLET
- ⊞ PORTABLE ARROW BOARD
- TYPE I DELINEATOR (YELLOW)
- TYPE I DELINEATOR (WHITE)
- REFLECTORIZED PLASTIC DRUM
- 4" TEMPORARY PAVEMENT MARKINGS
- TYPE III BARRICADE
- ▣ TYPE III (MOD) BARRICADE
- APPROXIMATE CULVERT LOCATION

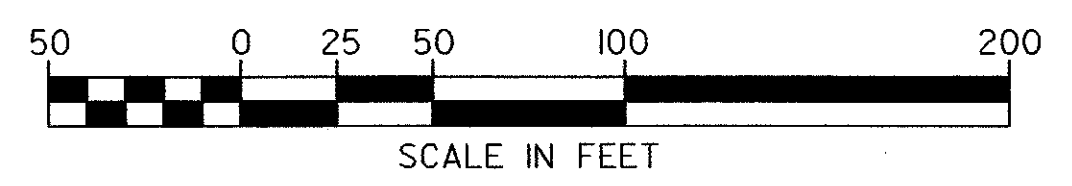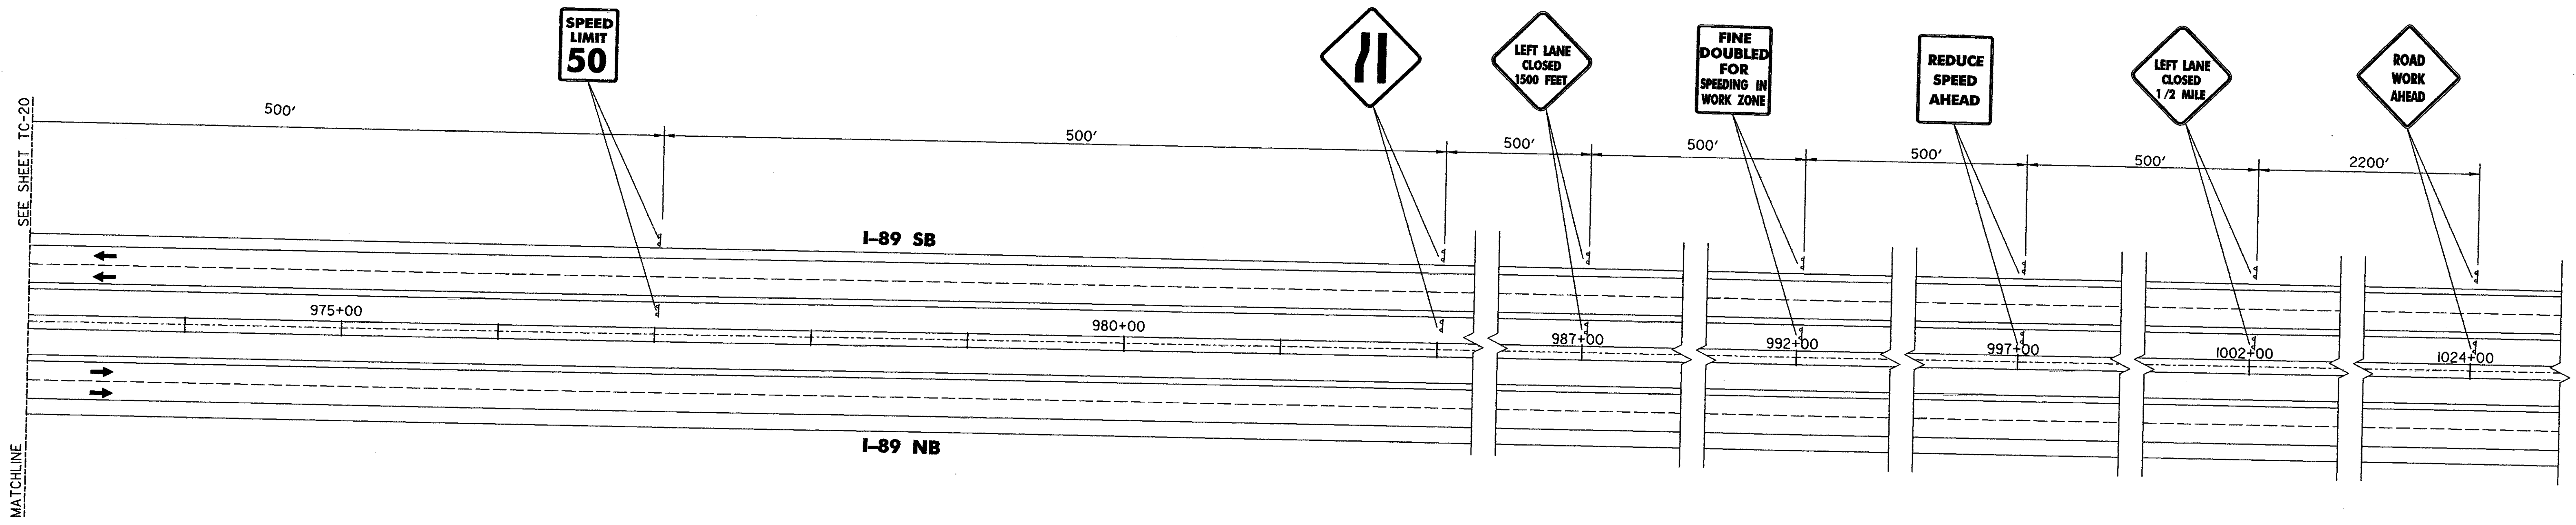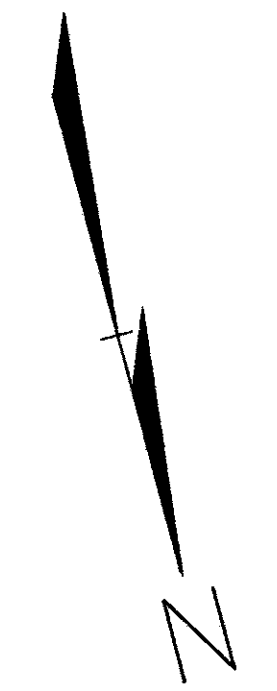







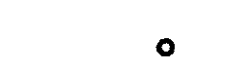
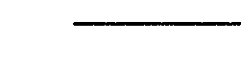

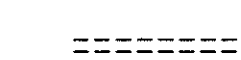


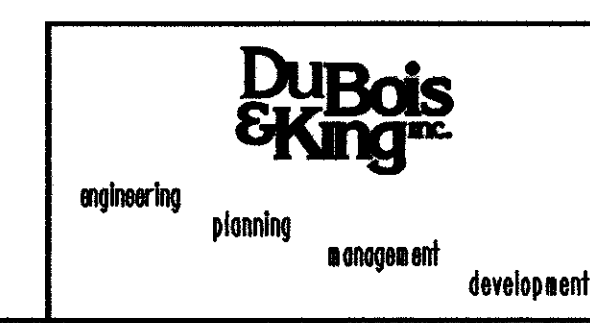


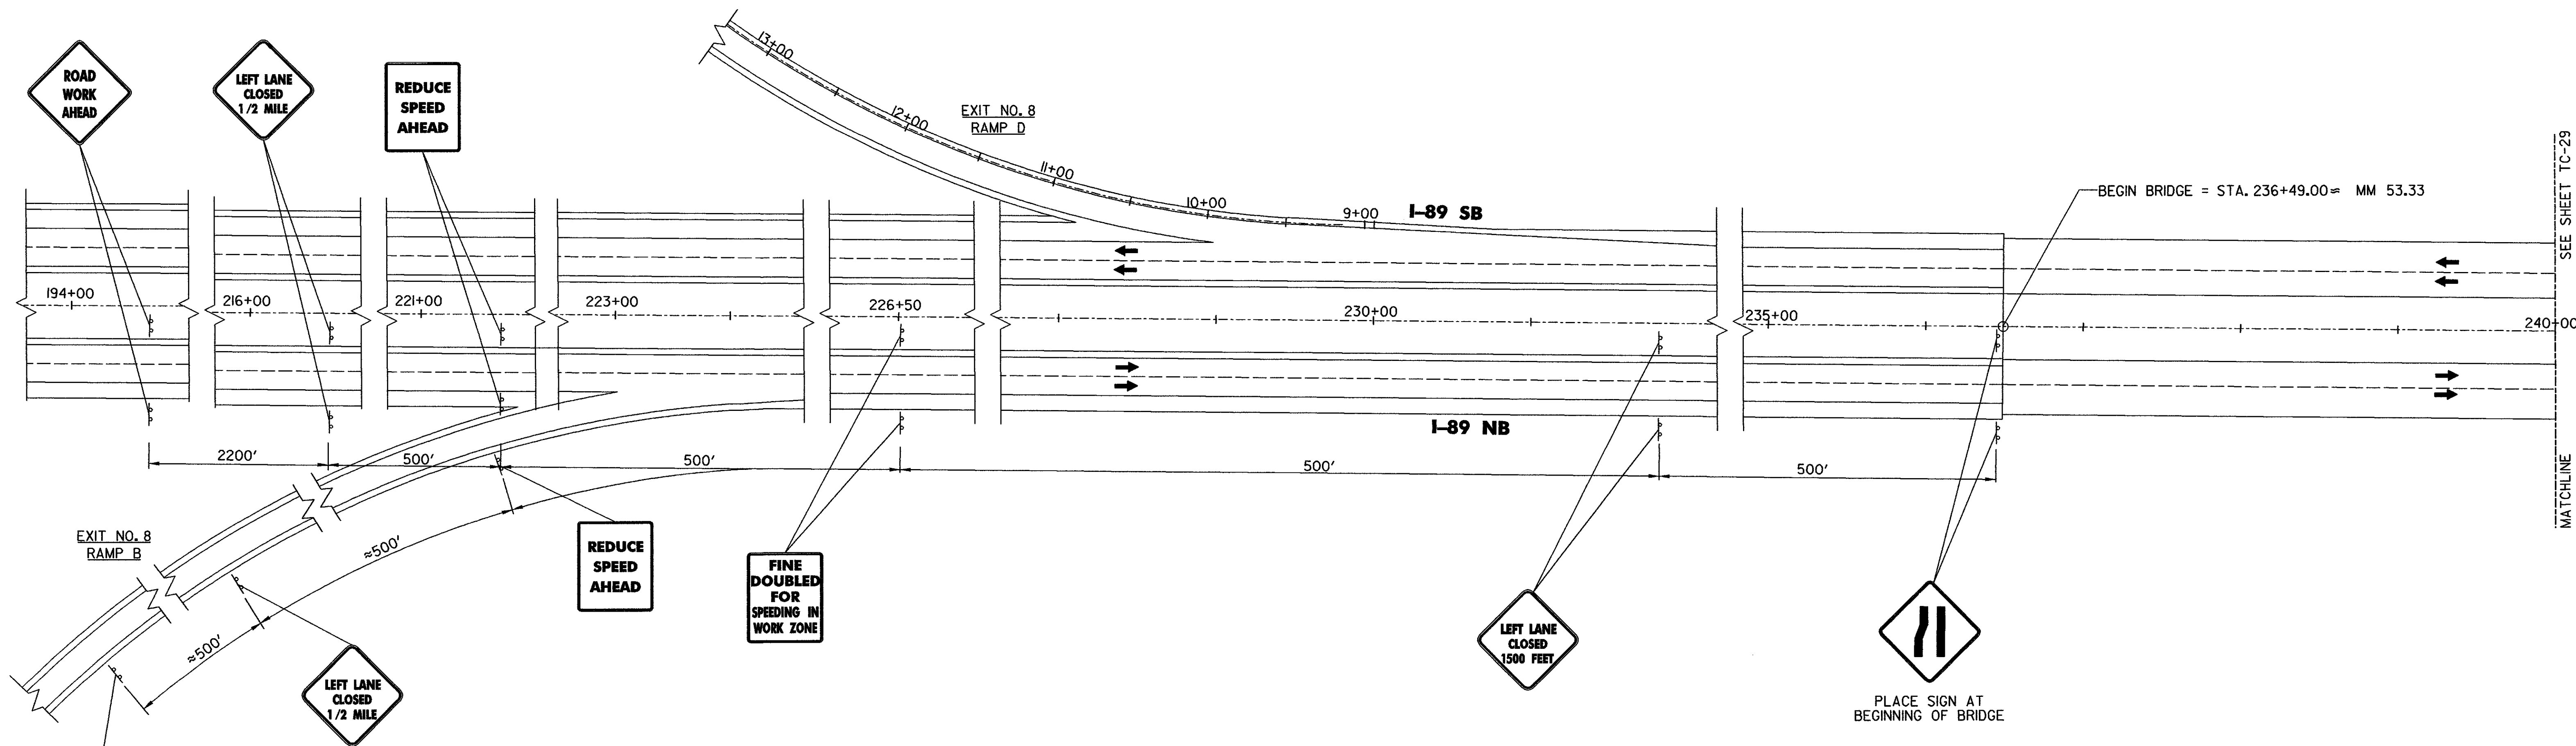
**STATE OF VERMONT  
AGENCY OF TRANSPORTATION**

Town Of <b>MIDDLESEX-BOLTON</b>		Bridge No. <b>48, 49, 50</b>
Highway No. <b>I-89</b>		Log Sta.
		Surv. Sta.
<b>PHASE I CONSTRUCTION I-89 SOUTHBOUND CROSSOVER</b>		
<b>BRIDGES 48, 49, 50</b>		
Designed By <b>J.M.SMYRSKI/K.S.MARSHA</b>	Drawn By <b>S. E. SCHMITT</b>	
Checked By <b>J. W. TUCKER</b>	Date <b>10/99</b>	Bridge Design Supervisor <b>J. P. HALSTEAD</b> Date <b>10/99</b>
PROJECT <b>MIDDLESEX-BOLTON</b>		PROJECT NO. <b>IM-089-2(26)</b>
Drawing No. <b>...48-49-50-sb.dgn</b>		Date <b>OCT 1999</b>
Bridge Sheet No. <b>TC-21</b>		Sheet <b>181</b> of <b>307</b>

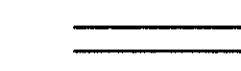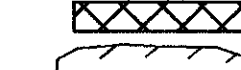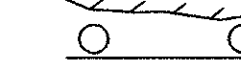


**LEGEND**


-  CONCRETE BARRIER
-  DIRECTION OF TRAFFIC FLOW WITH DETOUR IN PLACE
-  CROSSOVER ALIGNMENT
-  BRIDGE WORK AREA
-  LEDGE OUTCROPPING
-  GUARDRAIL
-  EXISTING DROP INLET
-  PORTABLE ARROW BOARD
-  TYPE I DELINEATOR (YELLOW)
-  TYPE I DELINEATOR (WHITE)
-  REFLECTORIZED PLASTIC DRUM
-  4" TEMPORARY PAVEMENT MARKINGS
-  TYPE III BARRICADE
-  TYPE III (MOD) BARRICADE
-  APPROXIMATE CULVERT LOCATION



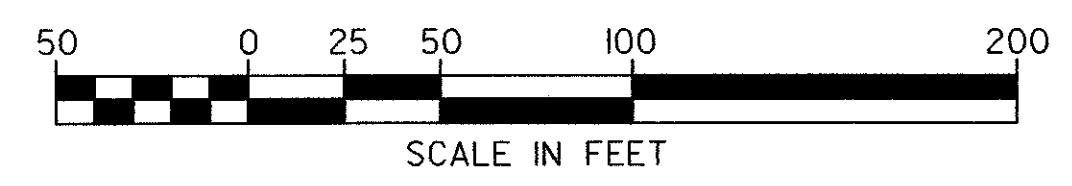



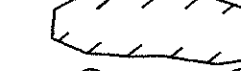
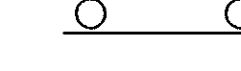





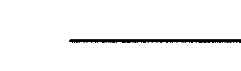


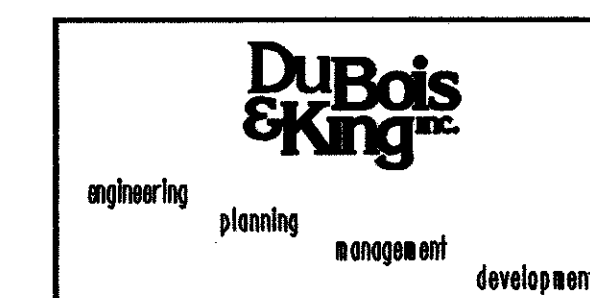
NOTE:  
DISTANCES FOUND ON RAMP B ARE APPROXIMATE. "ROAD WORK AHEAD" SIGN SHALL BE PLACED AT THE ENTRANCE TO RAMP B.





<b>STATE OF VERMONT AGENCY OF TRANSPORTATION</b>			
Town Of	MIDDLESEX-BOLTON	Bridge No.	<b>43</b>
Highway No.	I-89	Log Sta.	
		Surv. Sta.	
<b>PHASE II CONSTRUCTION I-89 NORTHBOUND CROSSOVER</b>			
<b>BRIDGE 43</b>			
Designed By	J.M.SMYRSKI/K.S.MARSHIA	Drawn By	S.E. SCHMITT
Checked By	Date	Bridge Design Supervisor	
J.W. TUCKER	10/99	J.P. HALSTEAD	Date 10/99
PROJECT	MIDDLESEX-BOLTON	PROJECT NO.	IM-089-2(26)
Drawing No.	...43-nb.dgn	Date	OCT 1999
Bridge Sheet No.	TC-28	Sheet	188 of 307

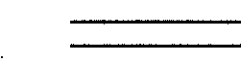

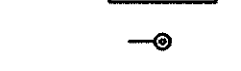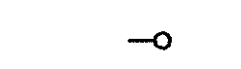
**LEGEND**

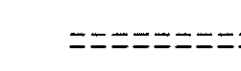-  CONCRETE BARRIER
-  DIRECTION OF TRAFFIC FLOW WITH DETOUR IN PLACE
-  CROSSOVER ALIGNMENT
-  BRIDGE WORK AREA
-  LEDGE OUTCROPPING
-  GUARDRAIL
-  EXISTING DROP INLET
-  PORTABLE ARROW BOARD
-  TYPE I DELINEATOR (YELLOW)
-  TYPE I DELINEATOR (WHITE)
-  REFLECTORIZED PLASTIC DRUM
-  4' TEMPORARY PAVEMENT MARKINGS
-  TYPE III BARRICADE
-  TYPE III (MOD) BARRICADE
-  APPROXIMATE CULVERT LOCATION

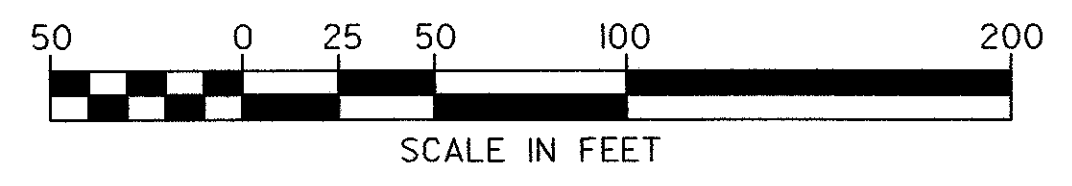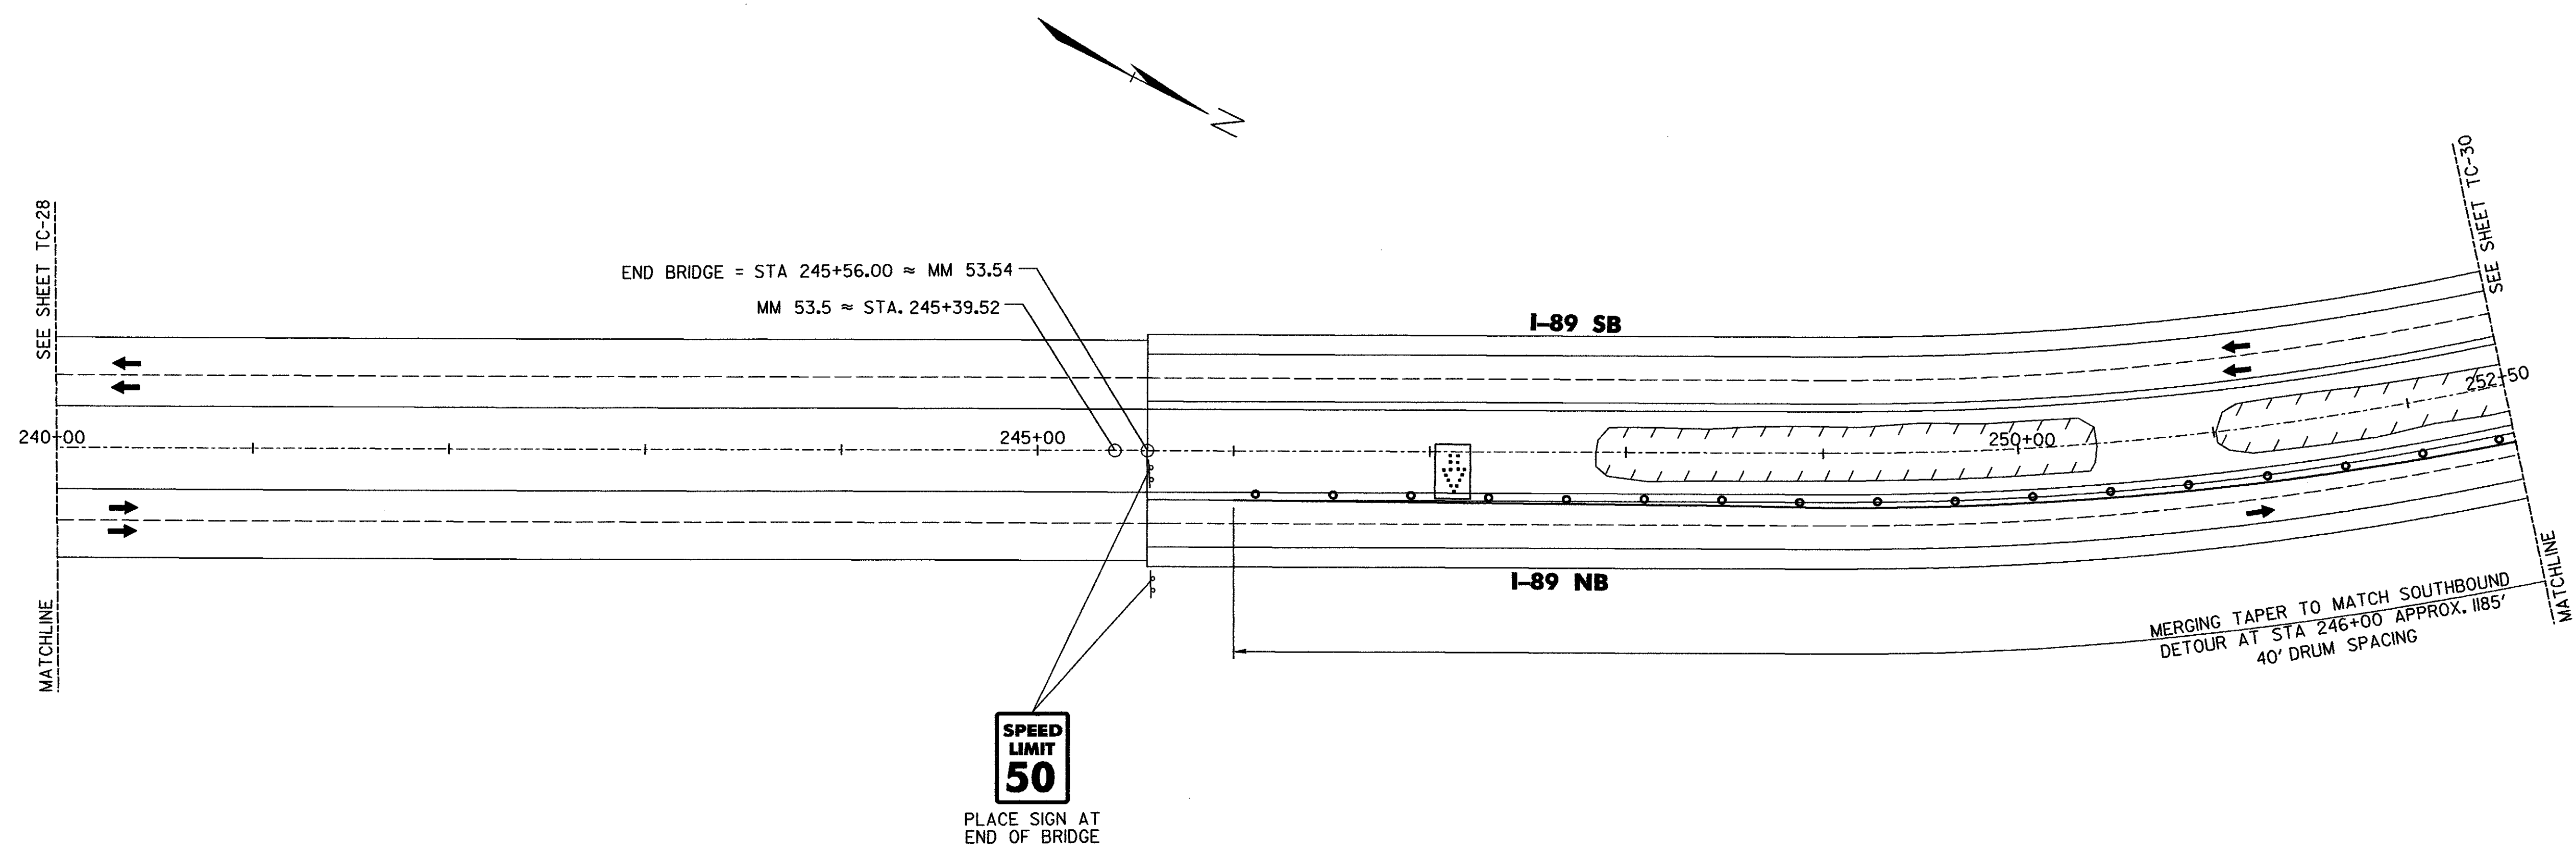



**STATE OF VERMONT  
AGENCY OF TRANSPORTATION**

Town Of	MIDDLESEX-BOLTON	Bridge No.	<b>43</b>
Highway No.	I-89	Log Sta.	
		Surv. Sta.	
<b>PHASE II CONSTRUCTION I-89 NORTHBOUND CROSSOVER</b>			
<b>BRIDGE 43</b>			
Designed By	J.M.SMYRSKI/K.S.MARSHA	Drawn By	S. E. SCHMITT
Checked By	Date	Bridge Design Supervisor	Date
J. W. TUCKER	10/99	J. P. HALSTEAD	Date 10/99
PROJECT	MIDDLESEX-BOLTON	PROJECT NO.	IM-089-2(26)
Drawing No.	...43-nb.dgn	Date	OCT 1999
Bridge Sheet No.	TC-29	Sheet	189 of 307

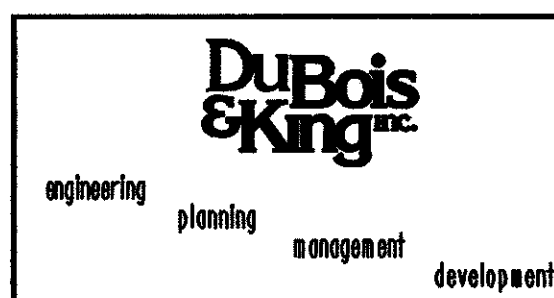

**LEGEND**

- CONCRETE BARRIER
- ➔ DIRECTION OF TRAFFIC FLOW WITH DETOUR IN PLACE
- ==== CROSSOVER ALIGNMENT
- ▨ BRIDGE WORK AREA
- ⬭ LEDGE OUTCROPPING
- ⬭ GUARDRAIL
- ⊞ EXISTING DROP INLET
- ⊞ PORTABLE ARROW BOARD
- TYPE I DELINEATOR (YELLOW)
- TYPE I DELINEATOR (WHITE)
- REFLECTORIZED PLASTIC DRUM
- 4' TEMPORARY PAVEMENT MARKINGS
- ▣ TYPE III BARRICADE
- ▣ TYPE III (MOD) BARRICADE
- APPROXIMATE CULVERT LOCATION

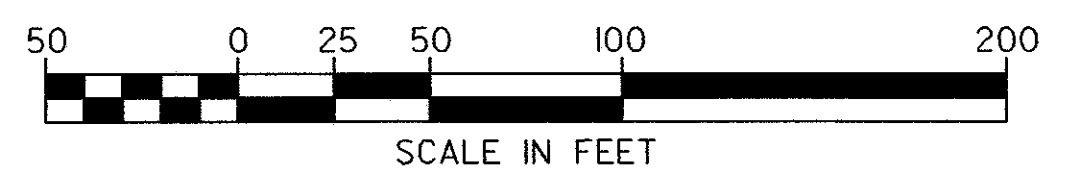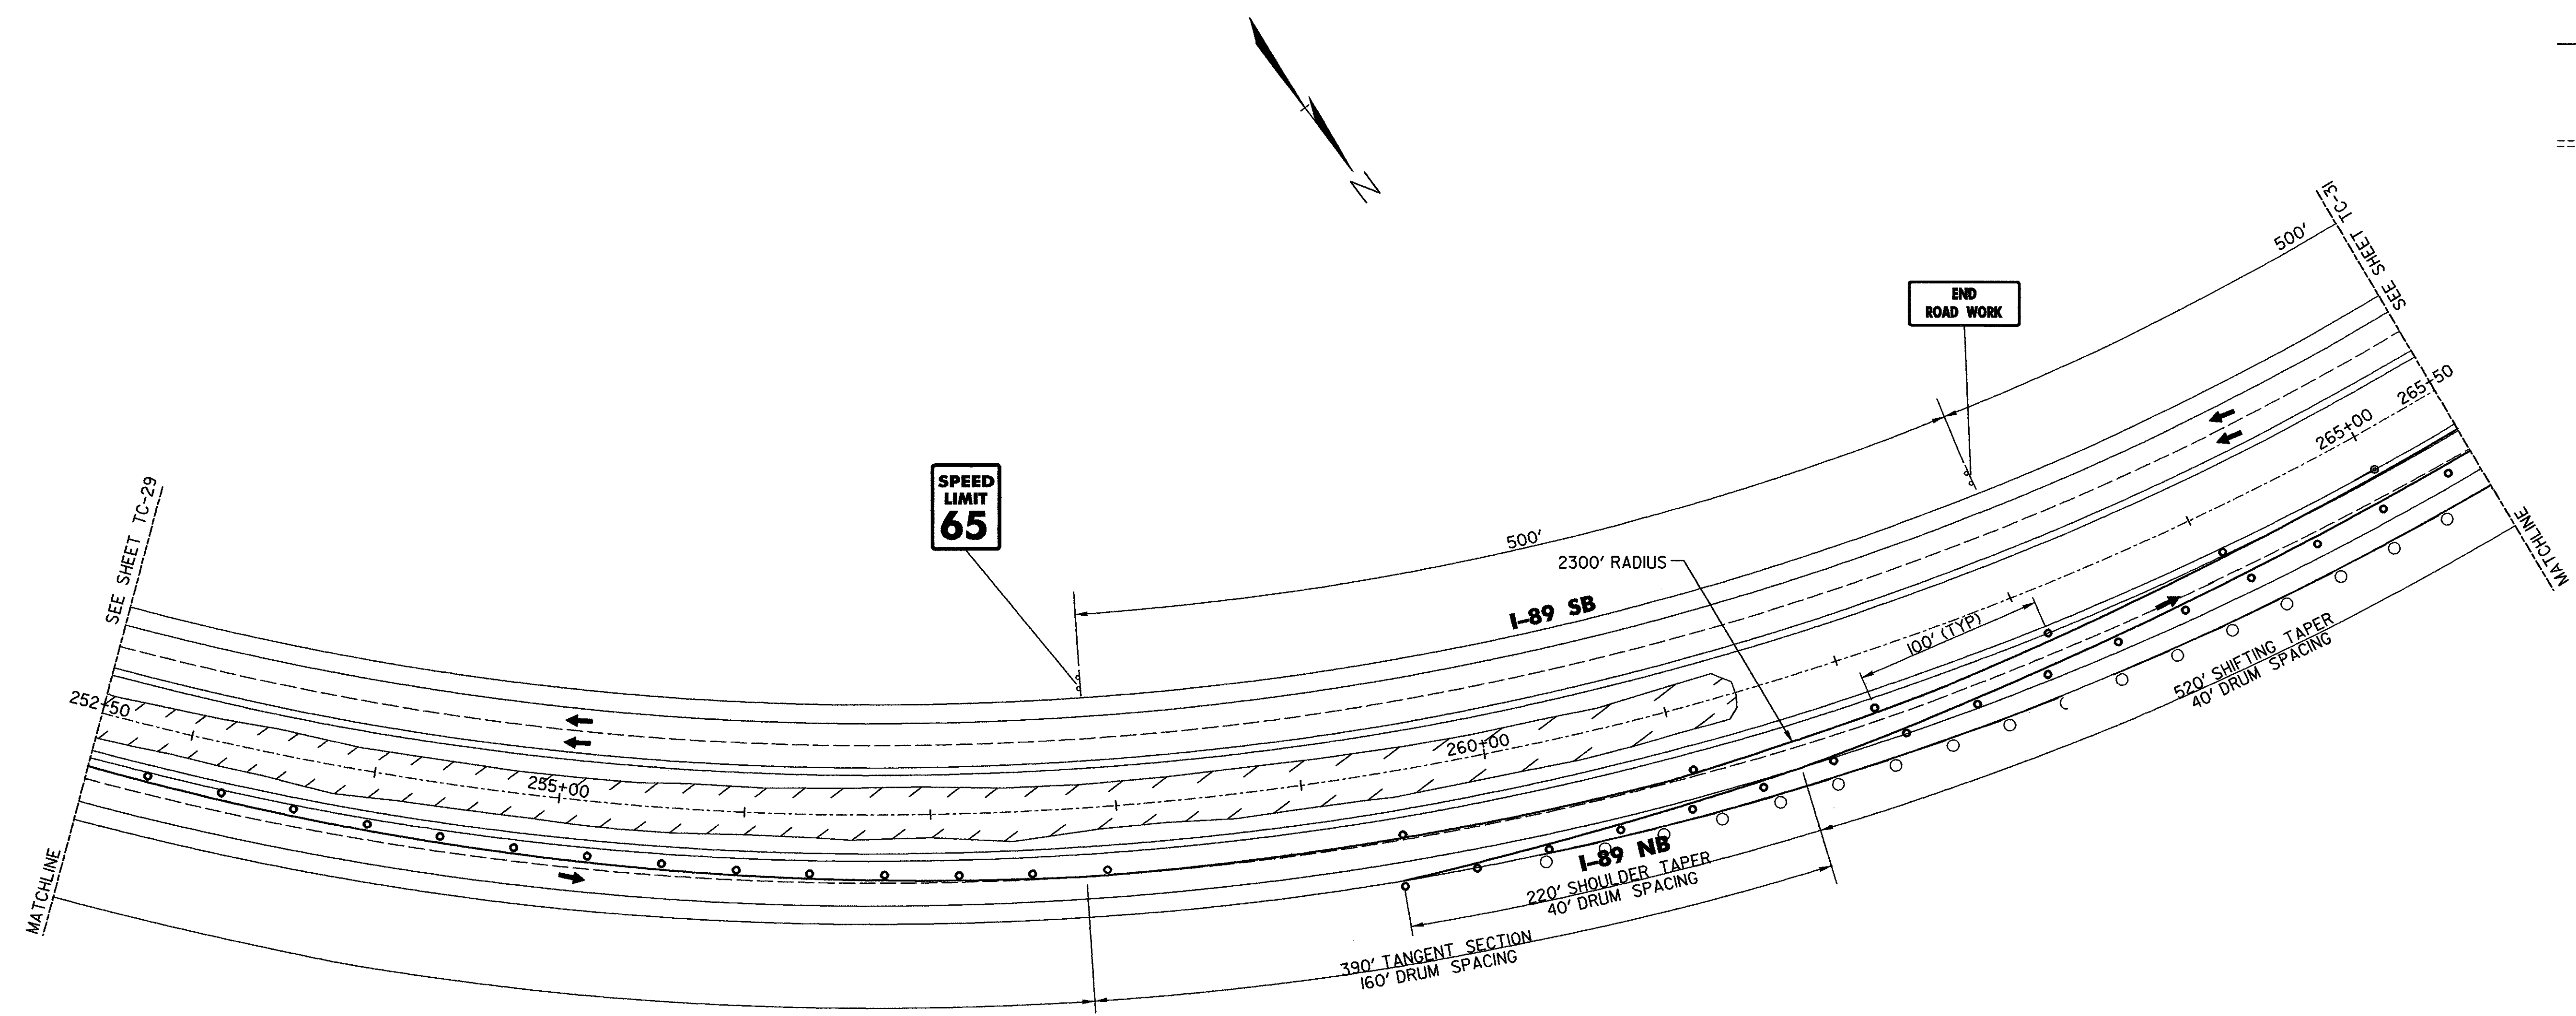

**STATE OF VERMONT  
AGENCY OF TRANSPORTATION**

Town Of	MIDDLESEX-BOLTON	Bridge No.	<b>43</b>
Highway No.	I-89	Log Sta.	
		Surv. Sta.	


PHASE II CONSTRUCTION I-89 NORTHBOUND CROSSOVER

**BRIDGE 43**

Designed By	J.M.SMYRSKI/K.S.MARSHA	Drawn By	S.E.SCHMITT
Checked By	Date	Bridge Design Supervisor	Date
J.W.TUCKER	10/99	J.P.HALSTEAD	Date 10/99


PROJECT	MIDDLESEX-BOLTON	PROJECT NO.	IM-089-2(26)
---------	------------------	-------------	--------------

Drawing No.	...43-nb.dgn	Date	OCT 1999
Bridge Sheet No.	TC-30	Sheet	190 of 307

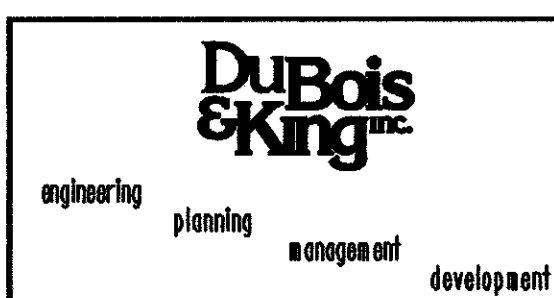


**LEGEND**

- CONCRETE BARRIER
- ➔ DIRECTION OF TRAFFIC FLOW WITH DETOUR IN PLACE
- ===== CROSSOVER ALIGNMENT
- ▨ BRIDGE WORK AREA
- ⬭ LEDGE OUTCROPPING
- GUARDRAIL
- ⊞ EXISTING DROP INLET
- ⊞ PORTABLE ARROW BOARD
- TYPE I DELINEATOR (YELLOW)
- TYPE I DELINEATOR (WHITE)
- REFLECTORIZED PLASTIC DRUM
- 4" TEMPORARY PAVEMENT MARKINGS
- ▣ TYPE III BARRICADE
- ▣ TYPE III (MOD) BARRICADE
- APPROXIMATE CULVERT LOCATION

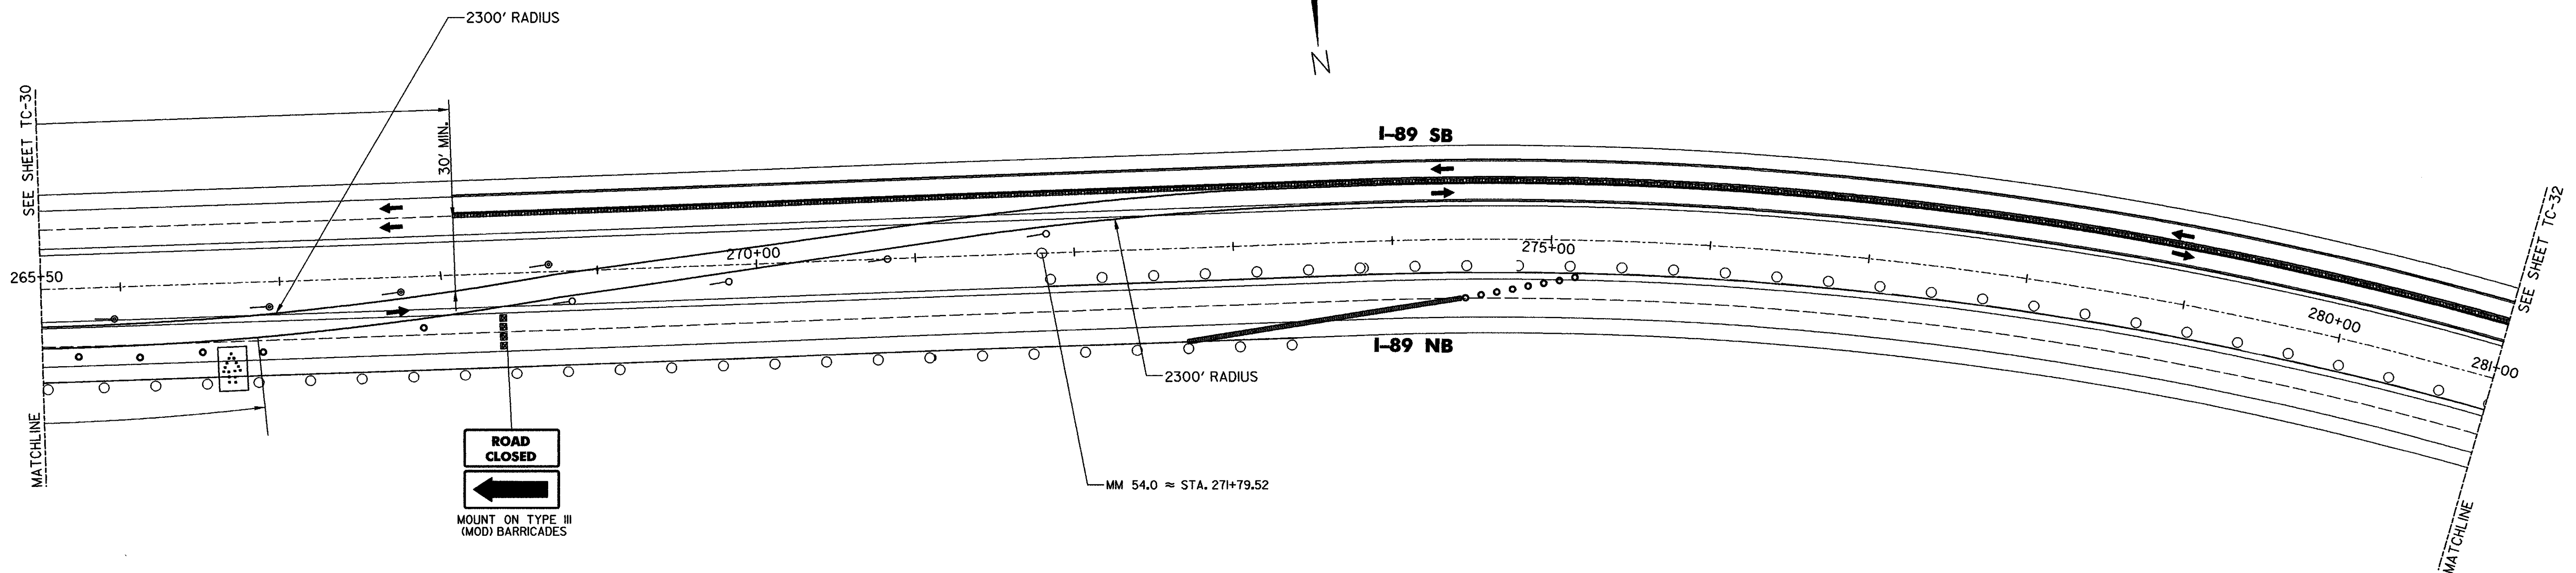


**ROAD CLOSED**  
  
 MOUNT ON TYPE III (MOD) BARRICADES

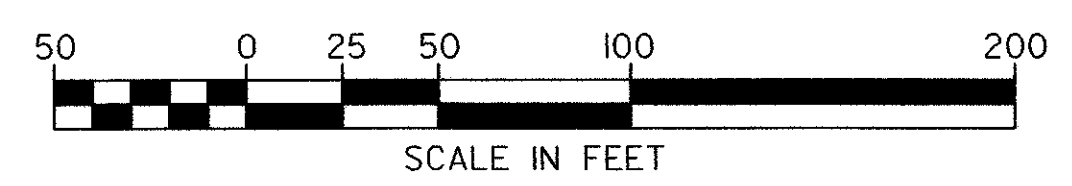




**STATE OF VERMONT  
 AGENCY OF TRANSPORTATION**

Town Of <b>MIDDLESEX-BOLTON</b>		Bridge No. <b>43</b>
Highway No. <b>I-89</b>	Log Sta.	Surv. Sta.
<b>PHASE II CONSTRUCTION I-89 NORTHBOUND CROSSOVER</b>		
<b>BRIDGE 43</b>		
Designed By <b>J.M.SMYRSKI/K.S.MARSHIA</b>	Drawn By <b>S. E. SCHMITT</b>	
Checked By <b>J. W. TUCKER</b>	Date <b>10/99</b>	Bridge Design Supervisor <b>J. P. HALSTEAD</b> Date <b>10/99</b>
PROJECT <b>MIDDLESEX-BOLTON</b>		PROJECT NO. <b>IM-089-2(26)</b>
Drawing No. <b>...43-nb.dgn</b>	Date <b>OCT 1999</b>	
Bridge Sheet No. <b>TC-31</b>	Sheet <b>191</b> of <b>307</b>	

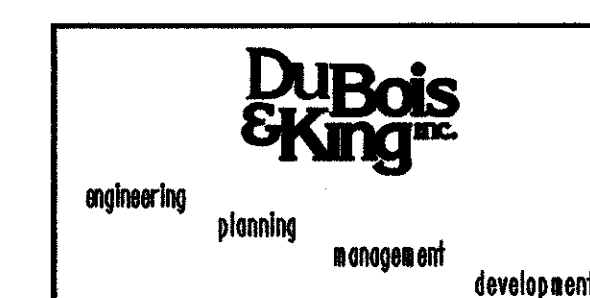


**LEGEND**

- CONCRETE BARRIER
- ➔ DIRECTION OF TRAFFIC FLOW WITH DETOUR IN PLACE
- ==== CROSSOVER ALIGNMENT
- ▨ BRIDGE WORK AREA
- ⬭ LEDGE OUTCROPPING
- GUARDRAIL
- ⊞ EXISTING DROP INLET
- ⊞ PORTABLE ARROW BOARD
- TYPE I DELINEATOR (YELLOW)
- TYPE I DELINEATOR (WHITE)
- REFLECTORIZED PLASTIC DRUM
- 4' TEMPORARY PAVEMENT MARKINGS
- TYPE III BARRICADE
- ▣ TYPE III (MOD) BARRICADE
- APPROXIMATE CULVERT LOCATION

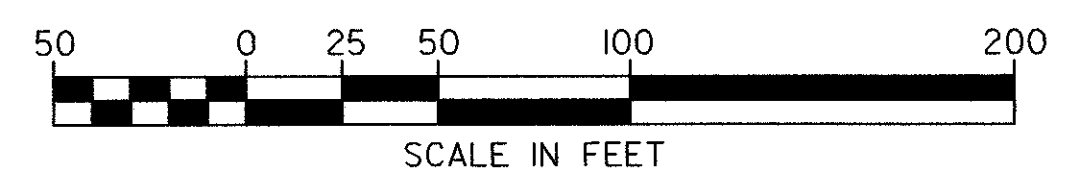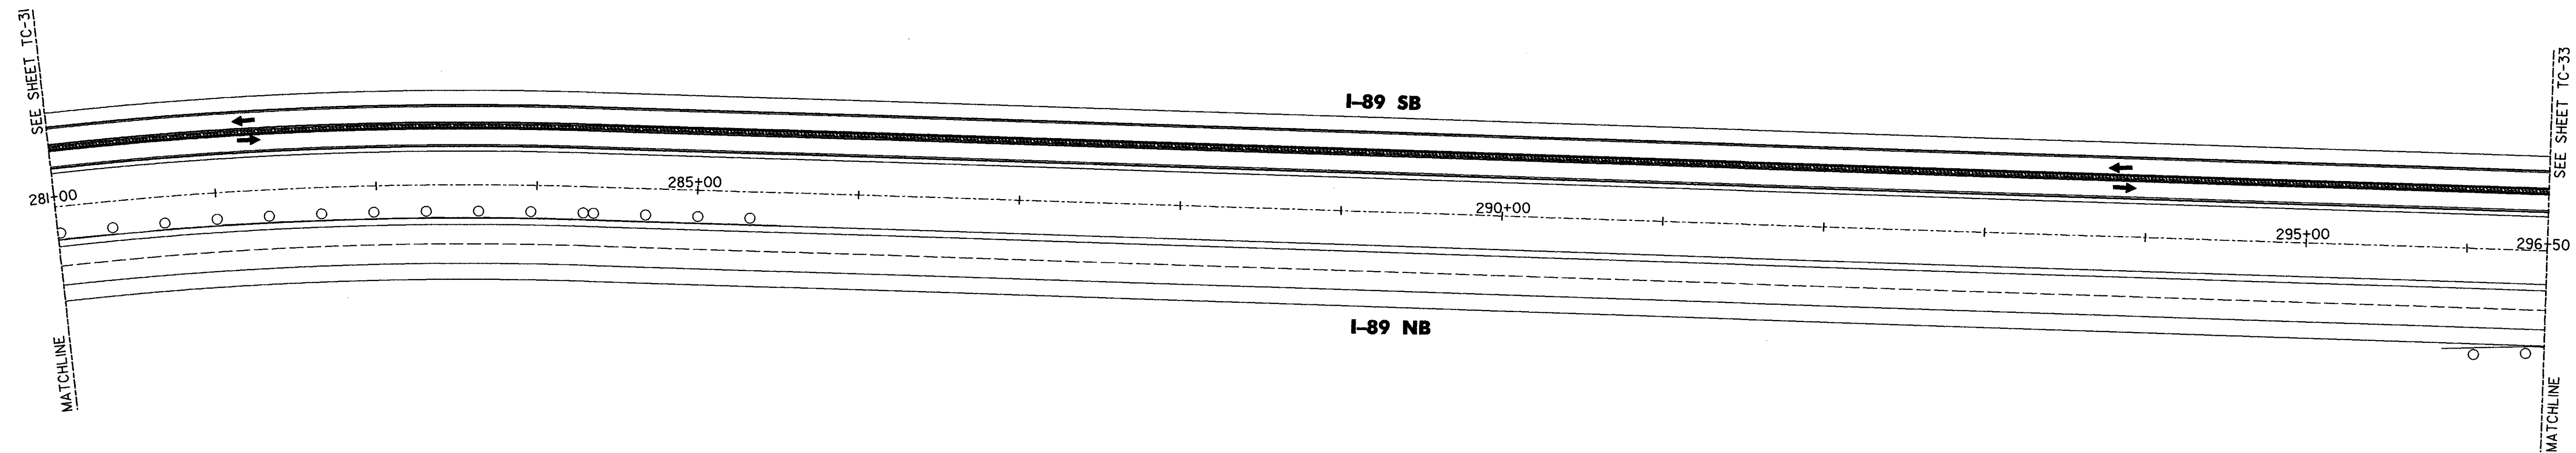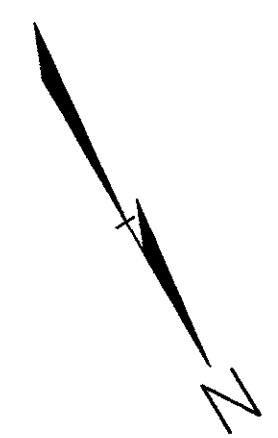




**STATE OF VERMONT  
AGENCY OF TRANSPORTATION**

Town Of	MIDDLESEX-BOLTON	Bridge No.	<b>43</b>
Highway No.	I-89	Log Sta.	
		Surv. Sta.	
<b>PHASE II CONSTRUCTION I-89 NORTHBOUND CROSSOVER</b>			
<b>BRIDGE 43</b>			
Designed By	J.M.SMYRSKI/K.S.MARSHA	Drawn By	S. E. SCHMITT
Checked By	J. W. TUCKER	Date	10/99
		Bridge Design Supervisor	J. P. HALSTEAD Date 10/99
PROJECT	MIDDLESEX-BOLTON	PROJECT NO.	IM-089-2(26)
Drawing No.	...43-nb.dgn	Date	OCT 1999
Bridge Sheet No.	TC-32	Sheet	192 of 307

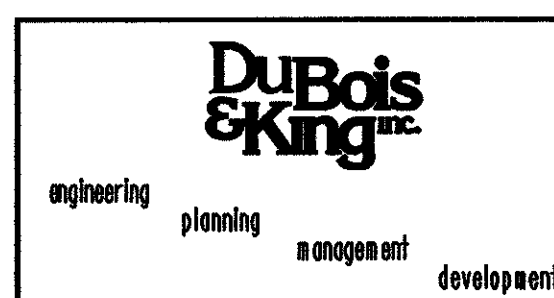


**LEGEND**

- CONCRETE BARRIER
- ➔ DIRECTION OF TRAFFIC FLOW WITH DETOUR IN PLACE
- ==== CROSSOVER ALIGNMENT
- ▨ BRIDGE WORK AREA
- ⬭ LEDGE OUTCROPPING
- GUARDRAIL
- ⊞ EXISTING DROP INLET
- ⊞ PORTABLE ARROW BOARD
- TYPE I DELINEATOR (YELLOW)
- TYPE I DELINEATOR (WHITE)
- REFLECTORIZED PLASTIC DRUM
- 4' TEMPORARY PAVEMENT MARKINGS
- TYPE III BARRICADE
- ▣ TYPE III (MOD) BARRICADE
- - - - - APPROXIMATE CULVERT LOCATION

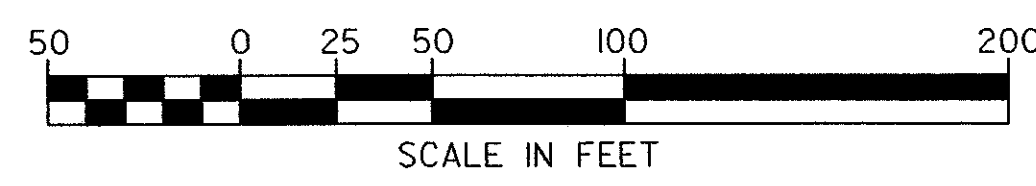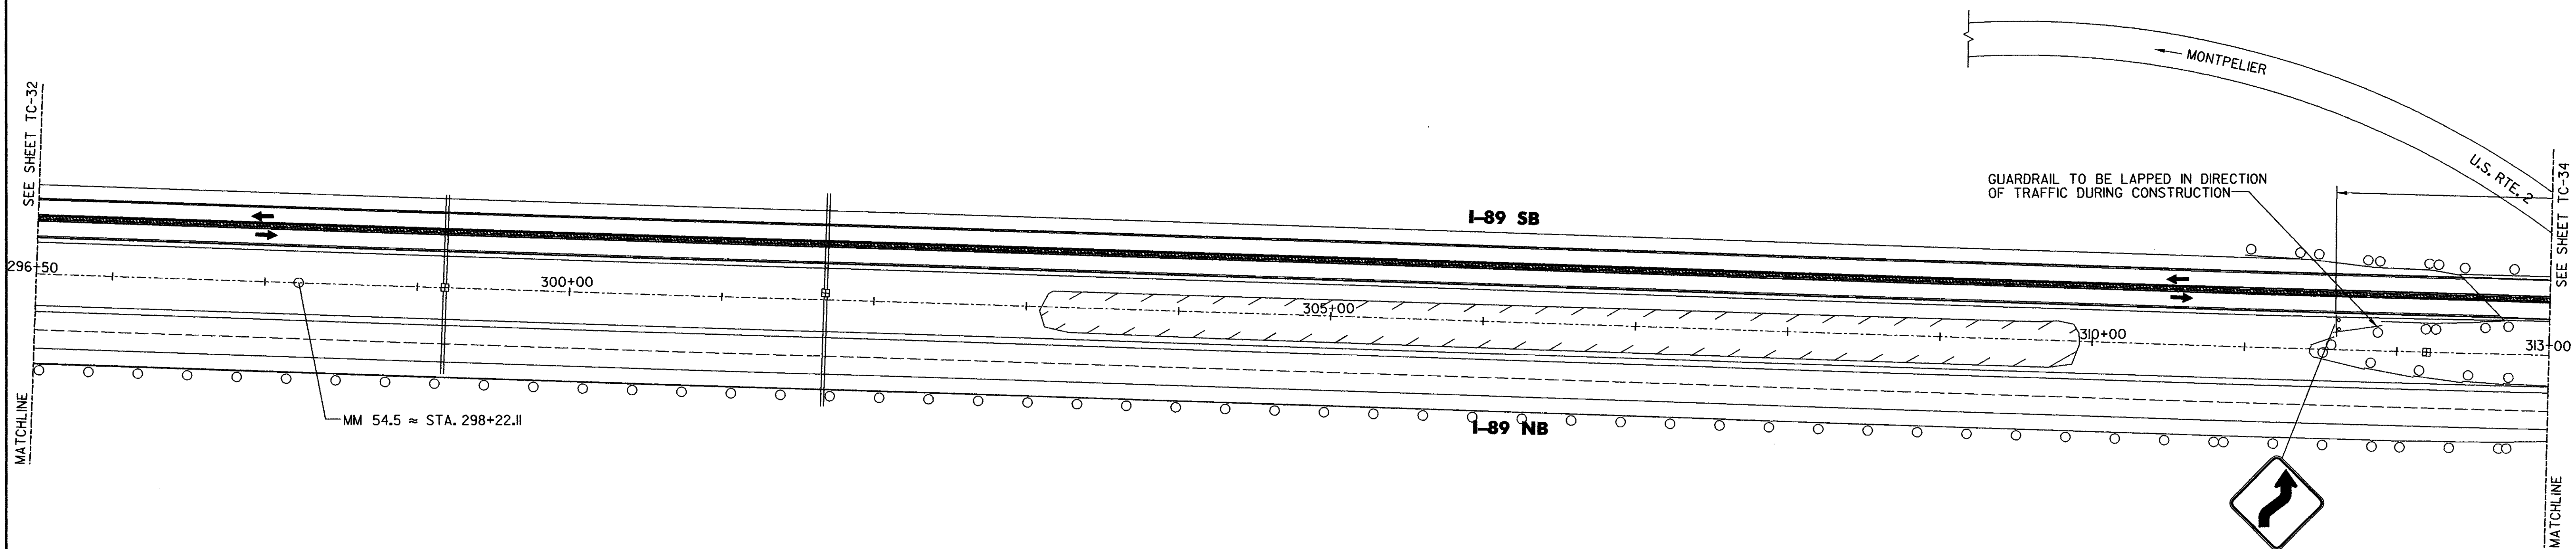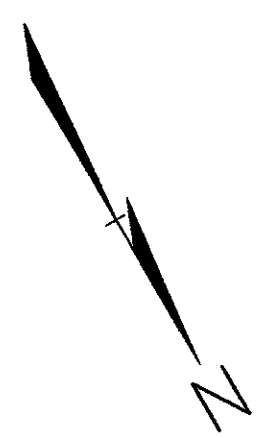


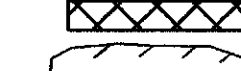
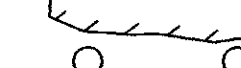

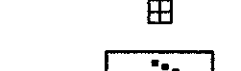

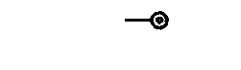
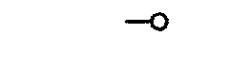

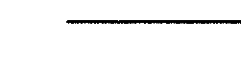


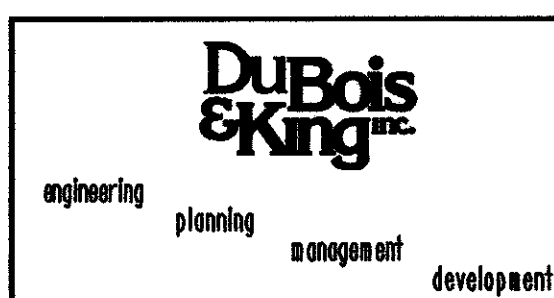




**STATE OF VERMONT  
AGENCY OF TRANSPORTATION**

Town Of	MIDDLESEX-BOLTON	Bridge No.	<b>43</b>
Highway No.	I-89	Log Sta.	
		Surv. Sta.	
<b>PHASE II CONSTRUCTION I-89 NORTHBOUND CROSSOVER</b>			
<b>BRIDGE 43</b>			
Designed By	J.M.SMYRSKI/K.S.MARSHA	Drawn By	S.E. SCHMITT
Checked By	Date	Bridge Design Supervisor	Date
J. W. TUCKER	10/99	J. P. HALSTEAD	10/99
PROJECT	MIDDLESEX-BOLTON	PROJECT NO.	IM-089-2(26)
Drawing No.	...43-nb.dgn	Date	OCT 1999
Bridge Sheet No.	TC-33	Sheet	193 of 307



**LEGEND**

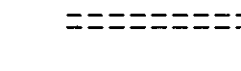-  CONCRETE BARRIER
-  DIRECTION OF TRAFFIC FLOW WITH DETOUR IN PLACE
-  CROSSOVER ALIGNMENT
-  BRIDGE WORK AREA
-  LEDGE OUTCROPPING
-  GUARDRAIL
-  EXISTING DROP INLET
-  PORTABLE ARROW BOARD
-  TYPE I DELINEATOR (YELLOW)
-  TYPE I DELINEATOR (WHITE)
-  REFLECTORIZED PLASTIC DRUM
-  4' TEMPORARY PAVEMENT MARKINGS
-  TYPE III BARRICADE
-  TYPE III (MOD) BARRICADE
-  APPROXIMATE CULVERT LOCATION

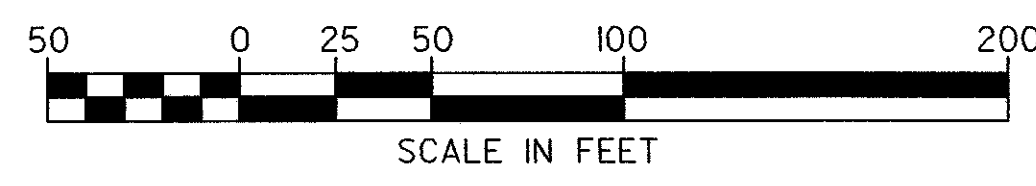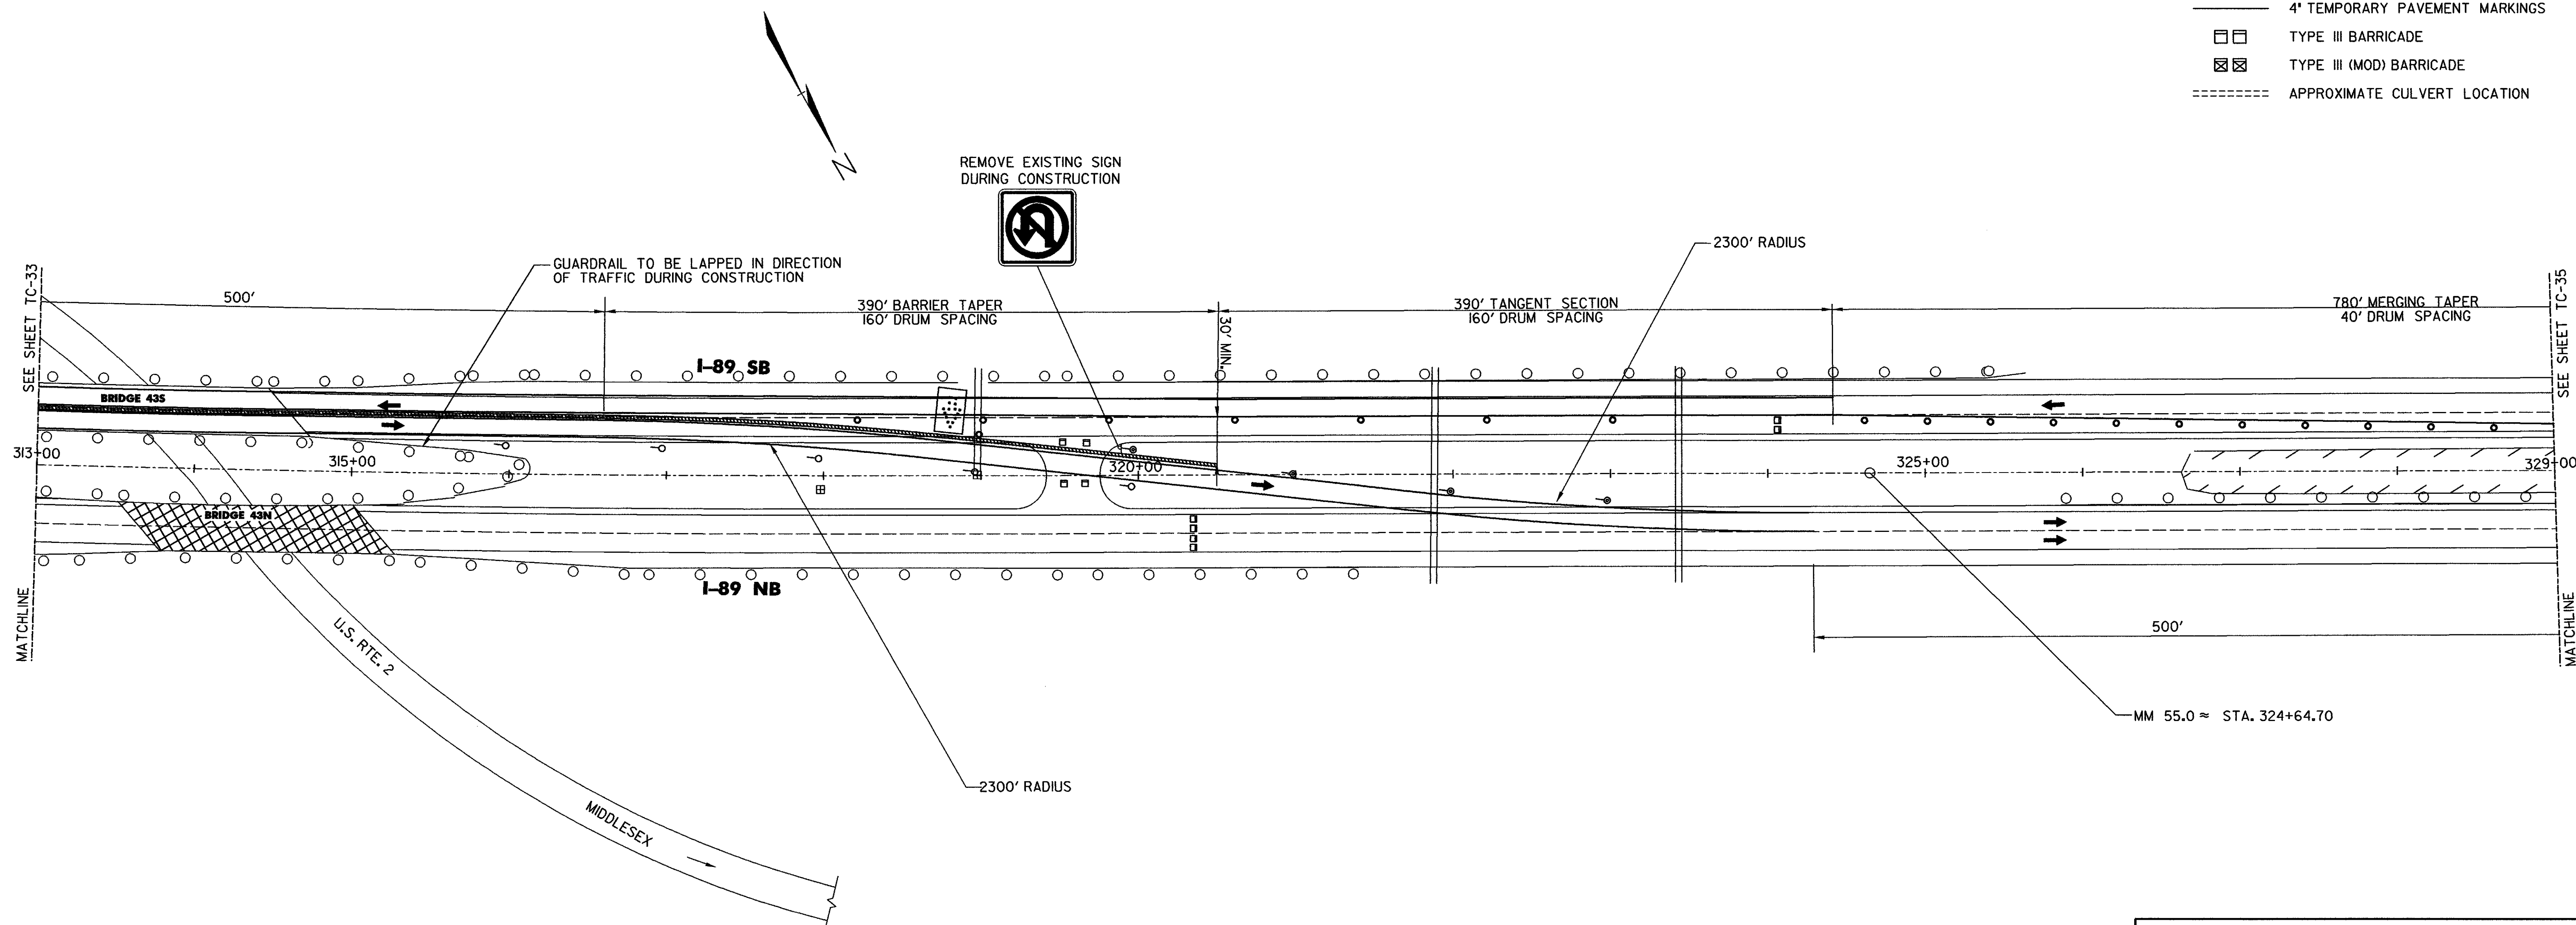


**STATE OF VERMONT  
AGENCY OF TRANSPORTATION**



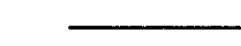
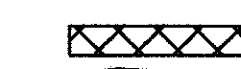
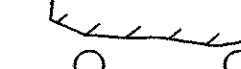






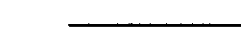


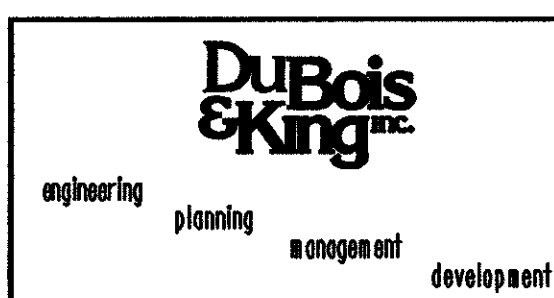
Town Of	MIDDLESEX-BOLTON	Bridge No.	<b>43</b>
Highway No.	I-89	Log Sta.	
		Surv. Sta.	



PHASE II CONSTRUCTION I-89 NORTHBOUND CROSSOVER
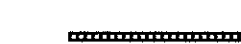
<b>BRIDGE 43</b>			
Designed By	J.M.SMYRSKI/K.S.MARSHA	Drawn By	S. E. SCHMITT
Checked By	Date	Bridge Design Supervisor	Date
J. W. TUCKER	10/99	J. P. HALSTEAD	Date 10/99
PROJECT	MIDDLESEX-BOLTON	PROJECT NO.	IM-089-2(26)
Drawing No.	... \43-nb.dgn	Date	OCT 1999
Bridge Sheet No.	TC-34	Sheet	194 of 307

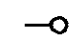



**LEGEND**

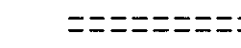-  CONCRETE BARRIER
-  DIRECTION OF TRAFFIC FLOW WITH DETOUR IN PLACE
-  CROSSOVER ALIGNMENT
-  BRIDGE WORK AREA
-  LEDGE OUTCROPPING
-  GUARDRAIL
-  EXISTING DROP INLET
-  PORTABLE ARROW BOARD
-  TYPE I DELINEATOR (YELLOW)
-  TYPE I DELINEATOR (WHITE)
-  REFLECTORIZED PLASTIC DRUM
-  4' TEMPORARY PAVEMENT MARKINGS
-  TYPE III BARRICADE
-  TYPE III (MOD) BARRICADE
-  APPROXIMATE CULVERT LOCATION

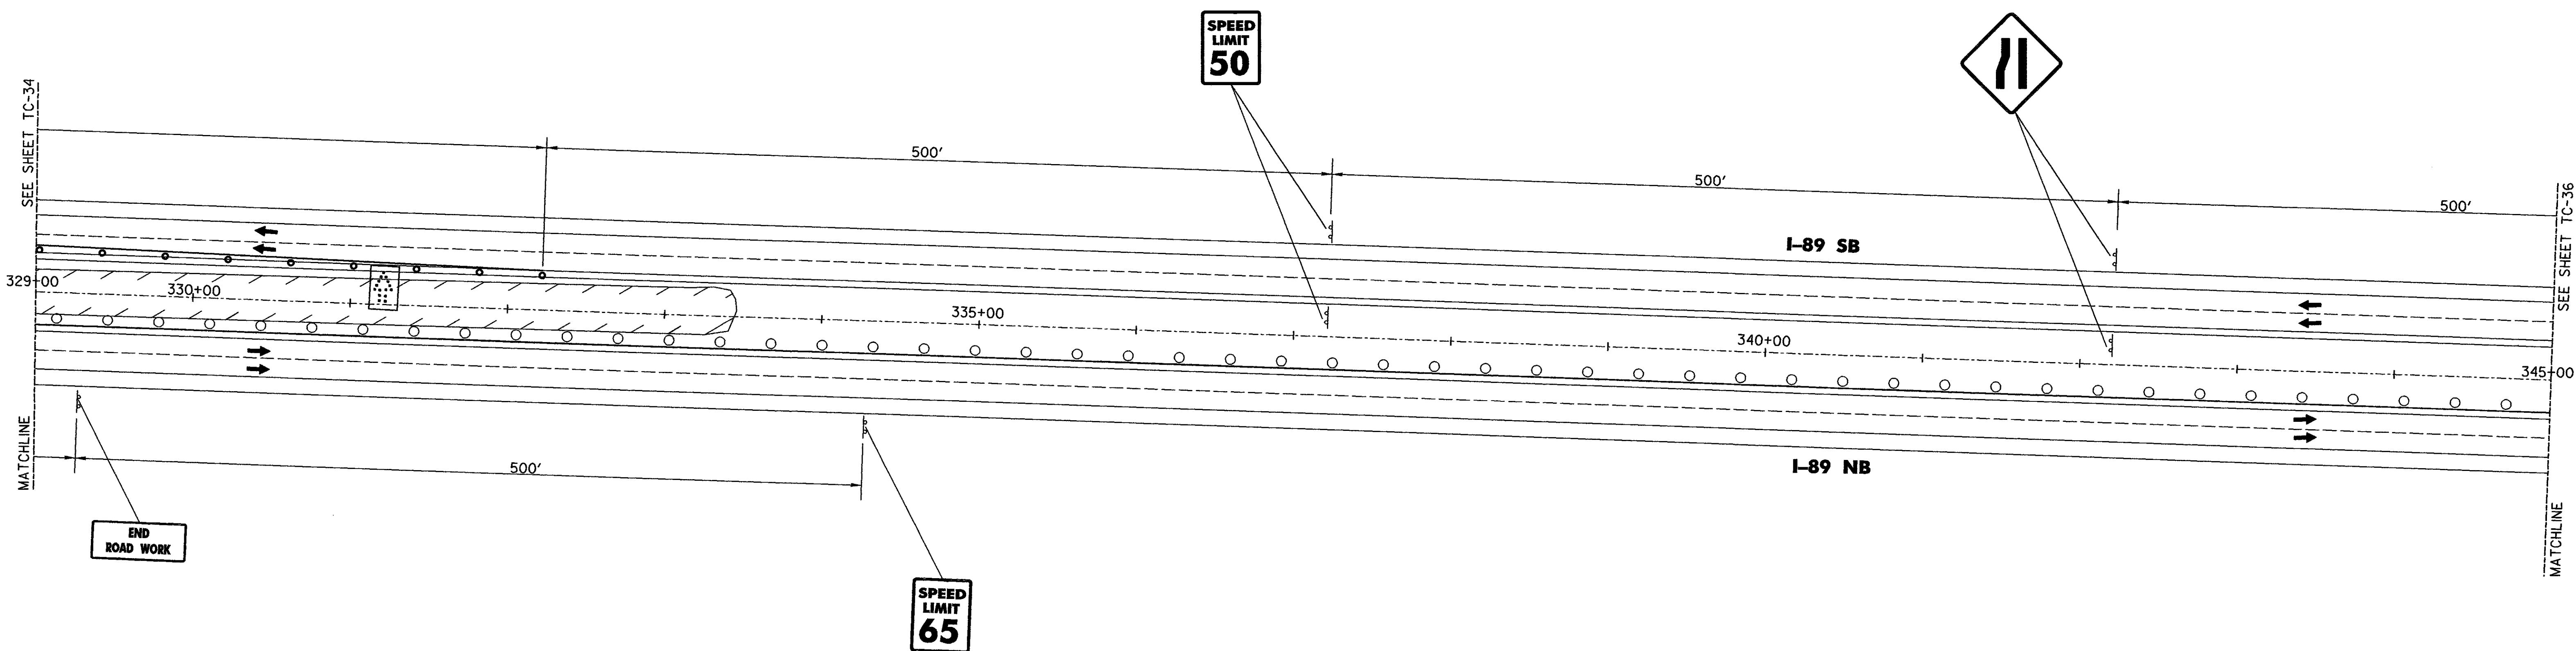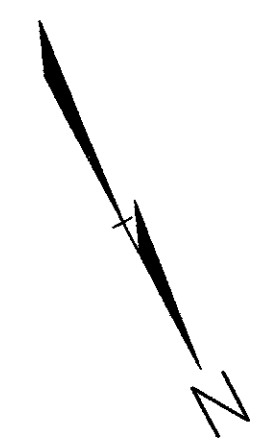



**STATE OF VERMONT  
AGENCY OF TRANSPORTATION**

Town Of <b>MIDDLESEX-BOLTON</b>		Bridge No. <b>43</b>
Highway No. <b>I-89</b>		Log Sta.
		Surv. Sta.
<b>PHASE II CONSTRUCTION I-89 NORTHBOUND CROSSOVER</b>		
<b>BRIDGE 43</b>		
Designed By <b>J.M.SMYRSKI/K.S.MARSHA</b>	Drawn By <b>S. E. SCHMITT</b>	
Checked By <b>J. W. TUCKER</b>	Date <b>10/99</b>	Bridge Design Supervisor <b>J. P. HALSTEAD</b> Date <b>10/99</b>
PROJECT <b>MIDDLESEX-BOLTON</b>		PROJECT NO. <b>IM-089-2(26)</b>
Drawing No. <b>...43-nb.dgn</b>	Date <b>OCT 1999</b>	
Bridge Sheet No. <b>TC-35</b>	Sheet <b>195</b> of <b>307</b>	

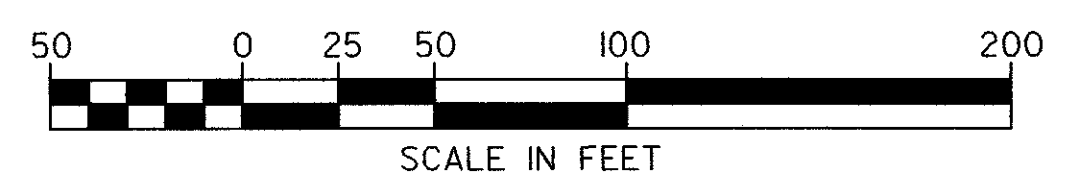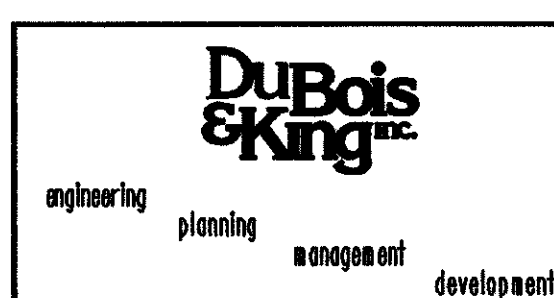



**LEGEND**

- CONCRETE BARRIER
- ➔ DIRECTION OF TRAFFIC FLOW WITH DETOUR IN PLACE
- ==== CROSSOVER ALIGNMENT
- ▨ BRIDGE WORK AREA
- ⬭ LEDGE OUTCROPPING
- ⬭ GUARDRAIL
- ⊞ EXISTING DROP INLET
- ⊞ PORTABLE ARROW BOARD
- TYPE I DELINEATOR (YELLOW)
- TYPE I DELINEATOR (WHITE)
- REFLECTORIZED PLASTIC DRUM
- 4' TEMPORARY PAVEMENT MARKINGS
- TYPE III BARRICADE
- ▣ TYPE III (MOD) BARRICADE
- APPROXIMATE CULVERT LOCATION

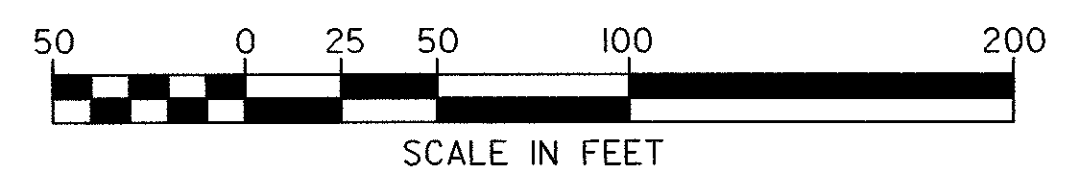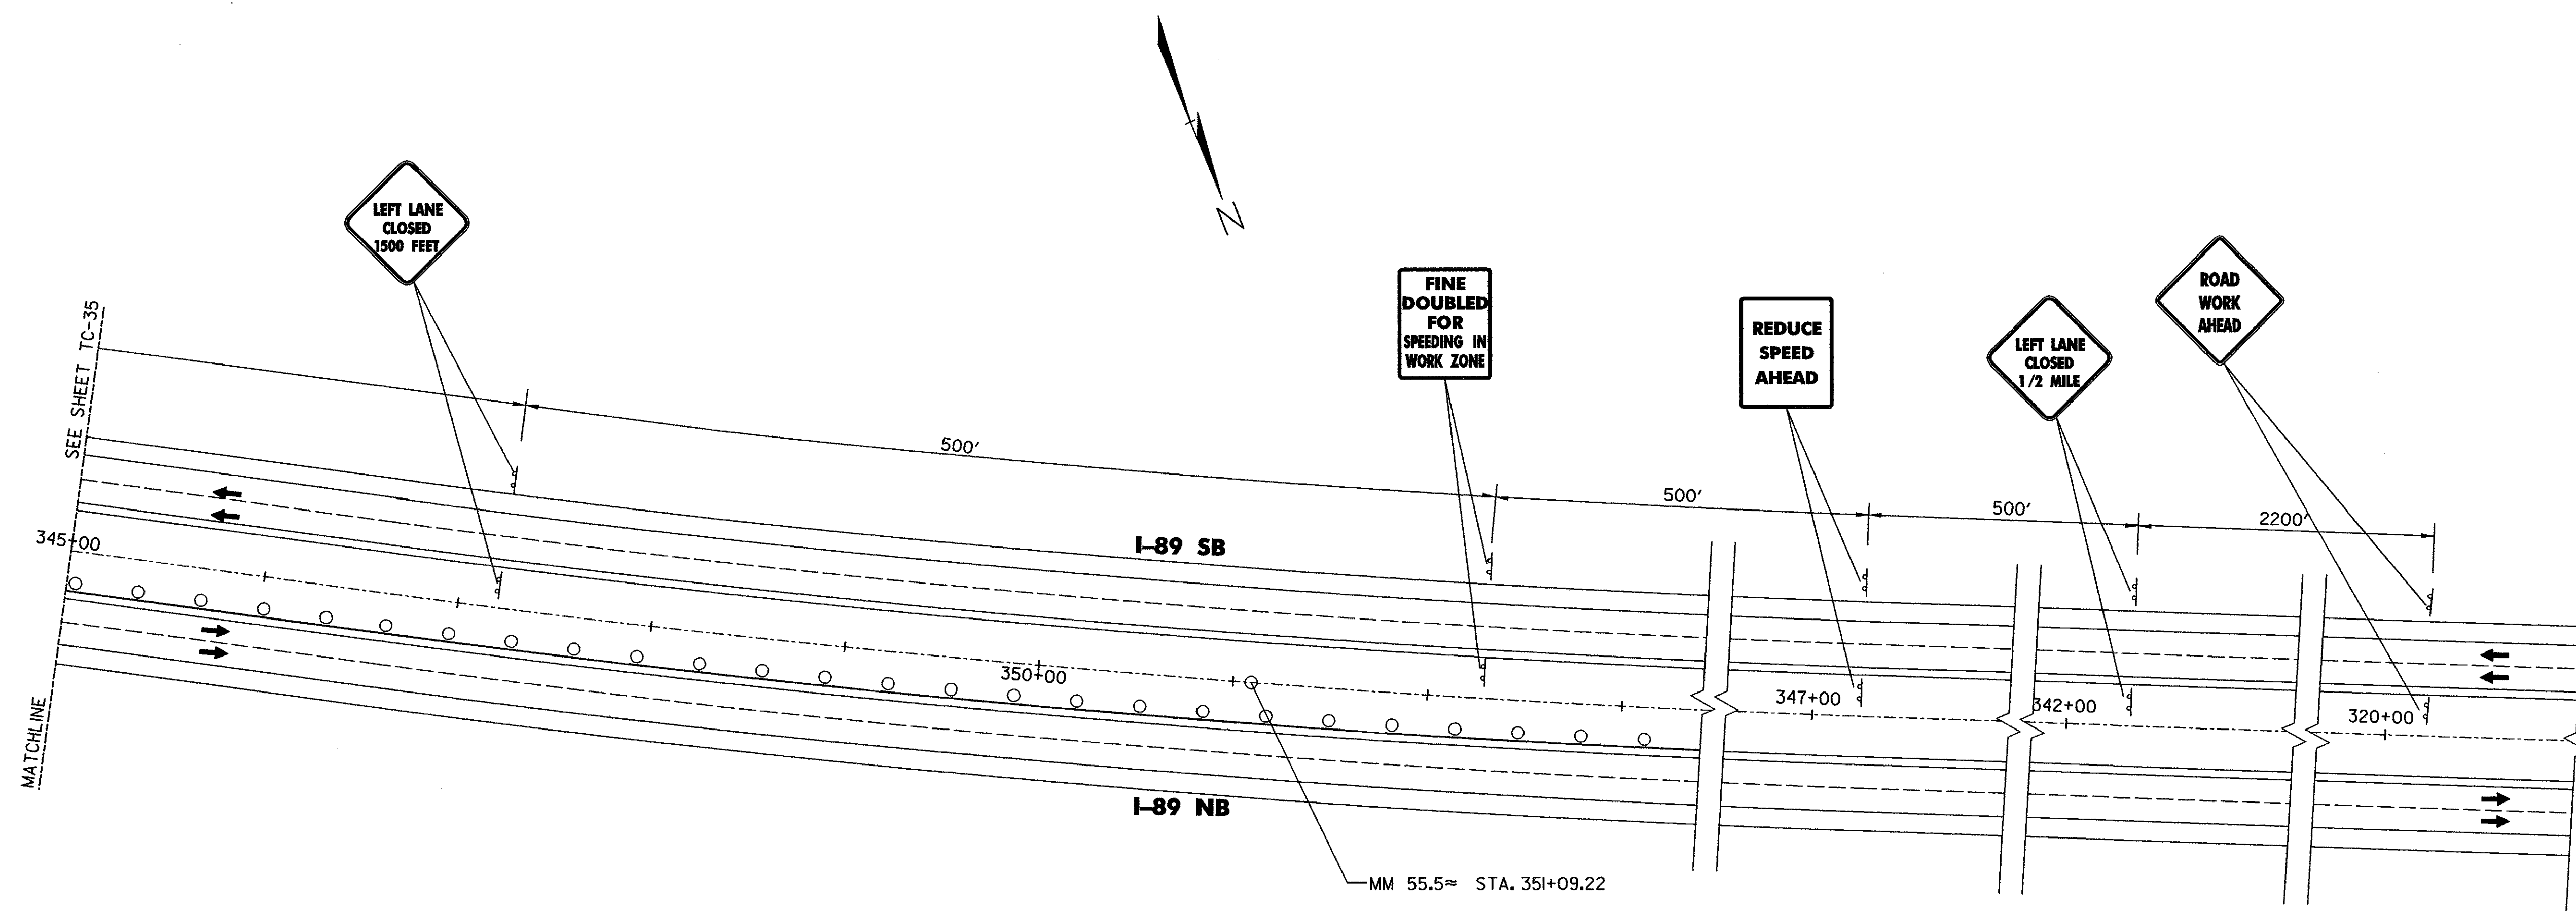




<b>STATE OF VERMONT AGENCY OF TRANSPORTATION</b>			
Town Of	MIDDLESEX-BOLTON	Bridge No.	<b>43</b>
Highway No.	I-89	Log Sta.	
		Surv. Sta.	
<b>PHASE II CONSTRUCTION I-89 NORTHBOUND CROSSOVER</b>			
<b>BRIDGE 43</b>			
Designed By	J.M.SMYRSKI/K.S.MARSHA	Drawn By	S. E. SCHMITT
Checked By	Date	Bridge Design Supervisor	Date
J. W. TUCKER	10/99	J. P. HALSTEAD	Date 10/99
PROJECT	MIDDLESEX-BOLTON	PROJECT NO.	IM-089-2(26)
Drawing No.	...43-nb.dgn	Date	OCT 1999
Bridge Sheet No.	TC-36	Sheet	196 of 307

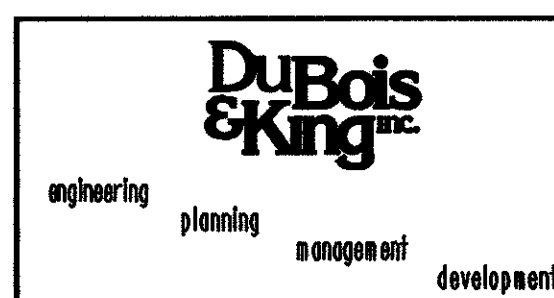

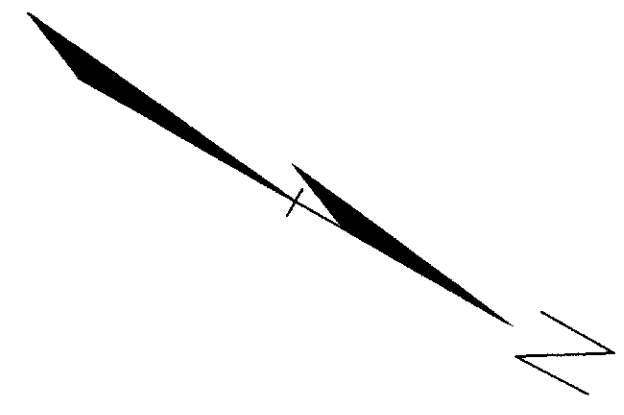


**LEGEND**

- CONCRETE BARRIER
- DIRECTION OF TRAFFIC FLOW WITH DETOUR IN PLACE
- CROSSOVER ALIGNMENT
- BRIDGE WORK AREA
- LEDGE OUTCROPPING
- GUARDRAIL
- EXISTING DROP INLET
- PORTABLE ARROW BOARD
- TYPE I DELINEATOR (YELLOW)
- TYPE I DELINEATOR (WHITE)
- REFLECTORIZED PLASTIC DRUM
- 4" TEMPORARY PAVEMENT MARKINGS
- TYPE III BARRICADE
- TYPE III (MOD) BARRICADE
- APPROXIMATE CULVERT LOCATION

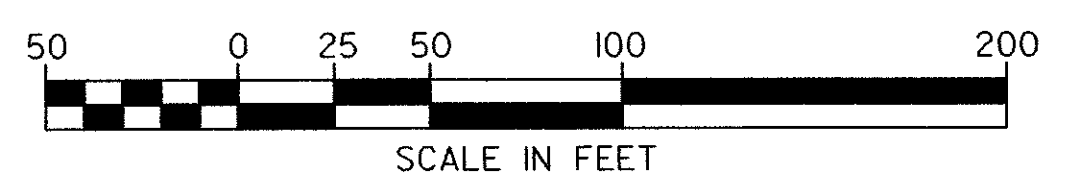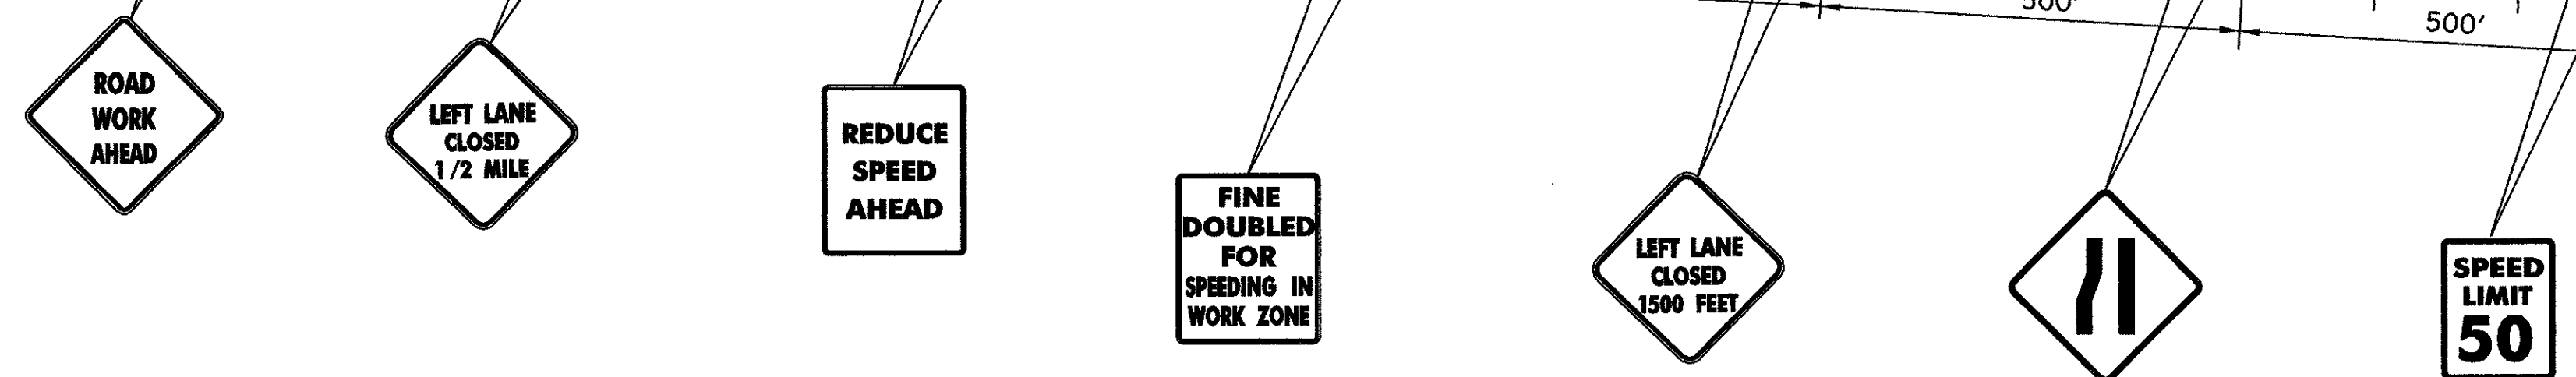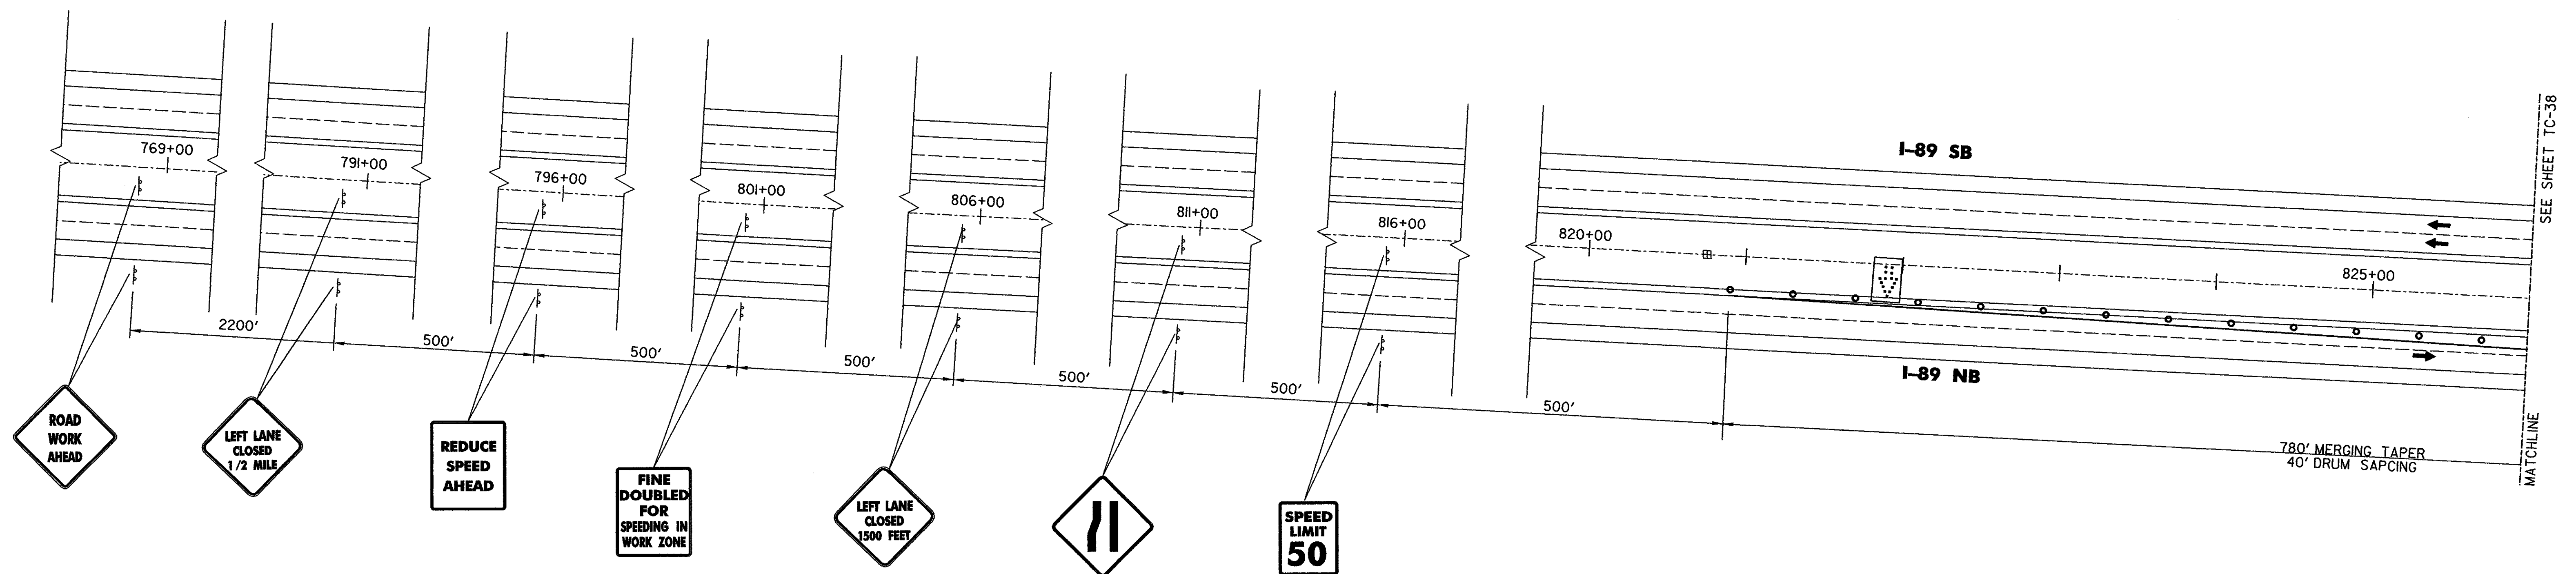

**STATE OF VERMONT  
AGENCY OF TRANSPORTATION**



Town Of	MIDDLESEX-BOLTON	Bridge No.	<b>48, 49, 50</b>
Highway No.	I-89	Log Sta.	
		Surv. Sta.	
PHASE II CONSTRUCTION I-89 NORTHBOUND CROSSOVER			
<b>BRIDGES 48, 49, 50</b>			
Designed By	J.M.SMYRSKI/K.S.MARSHA	Drawn By	S.E. SCHMITT
Checked By	Date	Bridge Design Supervisor	
J. W. TUCKER	10/99	J. P. HALSTEAD	Date 10/99
PROJECT	MIDDLESEX-BOLTON	PROJECT NO.	IM-089-2(26)
Drawing No.	...148-49-50-nb.dgn	Date	OCT 1999
Bridge Sheet No.	TC-37	Sheet	197 of 307

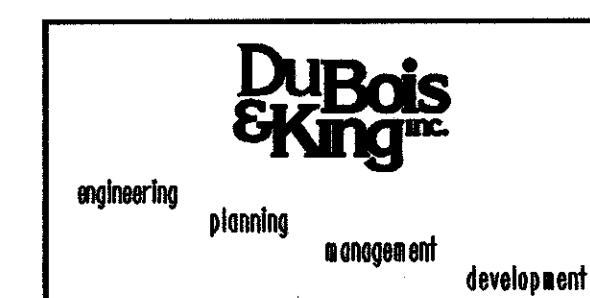

SEE SHEET TC-38  
MATCHLINE


**LEGEND**


- CONCRETE BARRIER
- DIRECTION OF TRAFFIC FLOW WITH DETOUR IN PLACE
- ==== CROSSOVER ALIGNMENT
- ▨ BRIDGE WORK AREA
- LEDGE OUTCROPPING
- GUARDRAIL
- ⊞ EXISTING DROP INLET
- ⊞ PORTABLE ARROW BOARD
- TYPE I DELINEATOR (YELLOW)
- TYPE I DELINEATOR (WHITE)
- REFLECTORIZED PLASTIC DRUM
- 4" TEMPORARY PAVEMENT MARKINGS
- TYPE III BARRICADE
- ⊞ TYPE III (MOD) BARRICADE
- APPROXIMATE CULVERT LOCATION

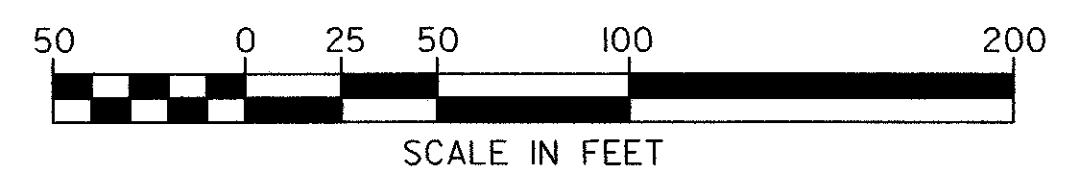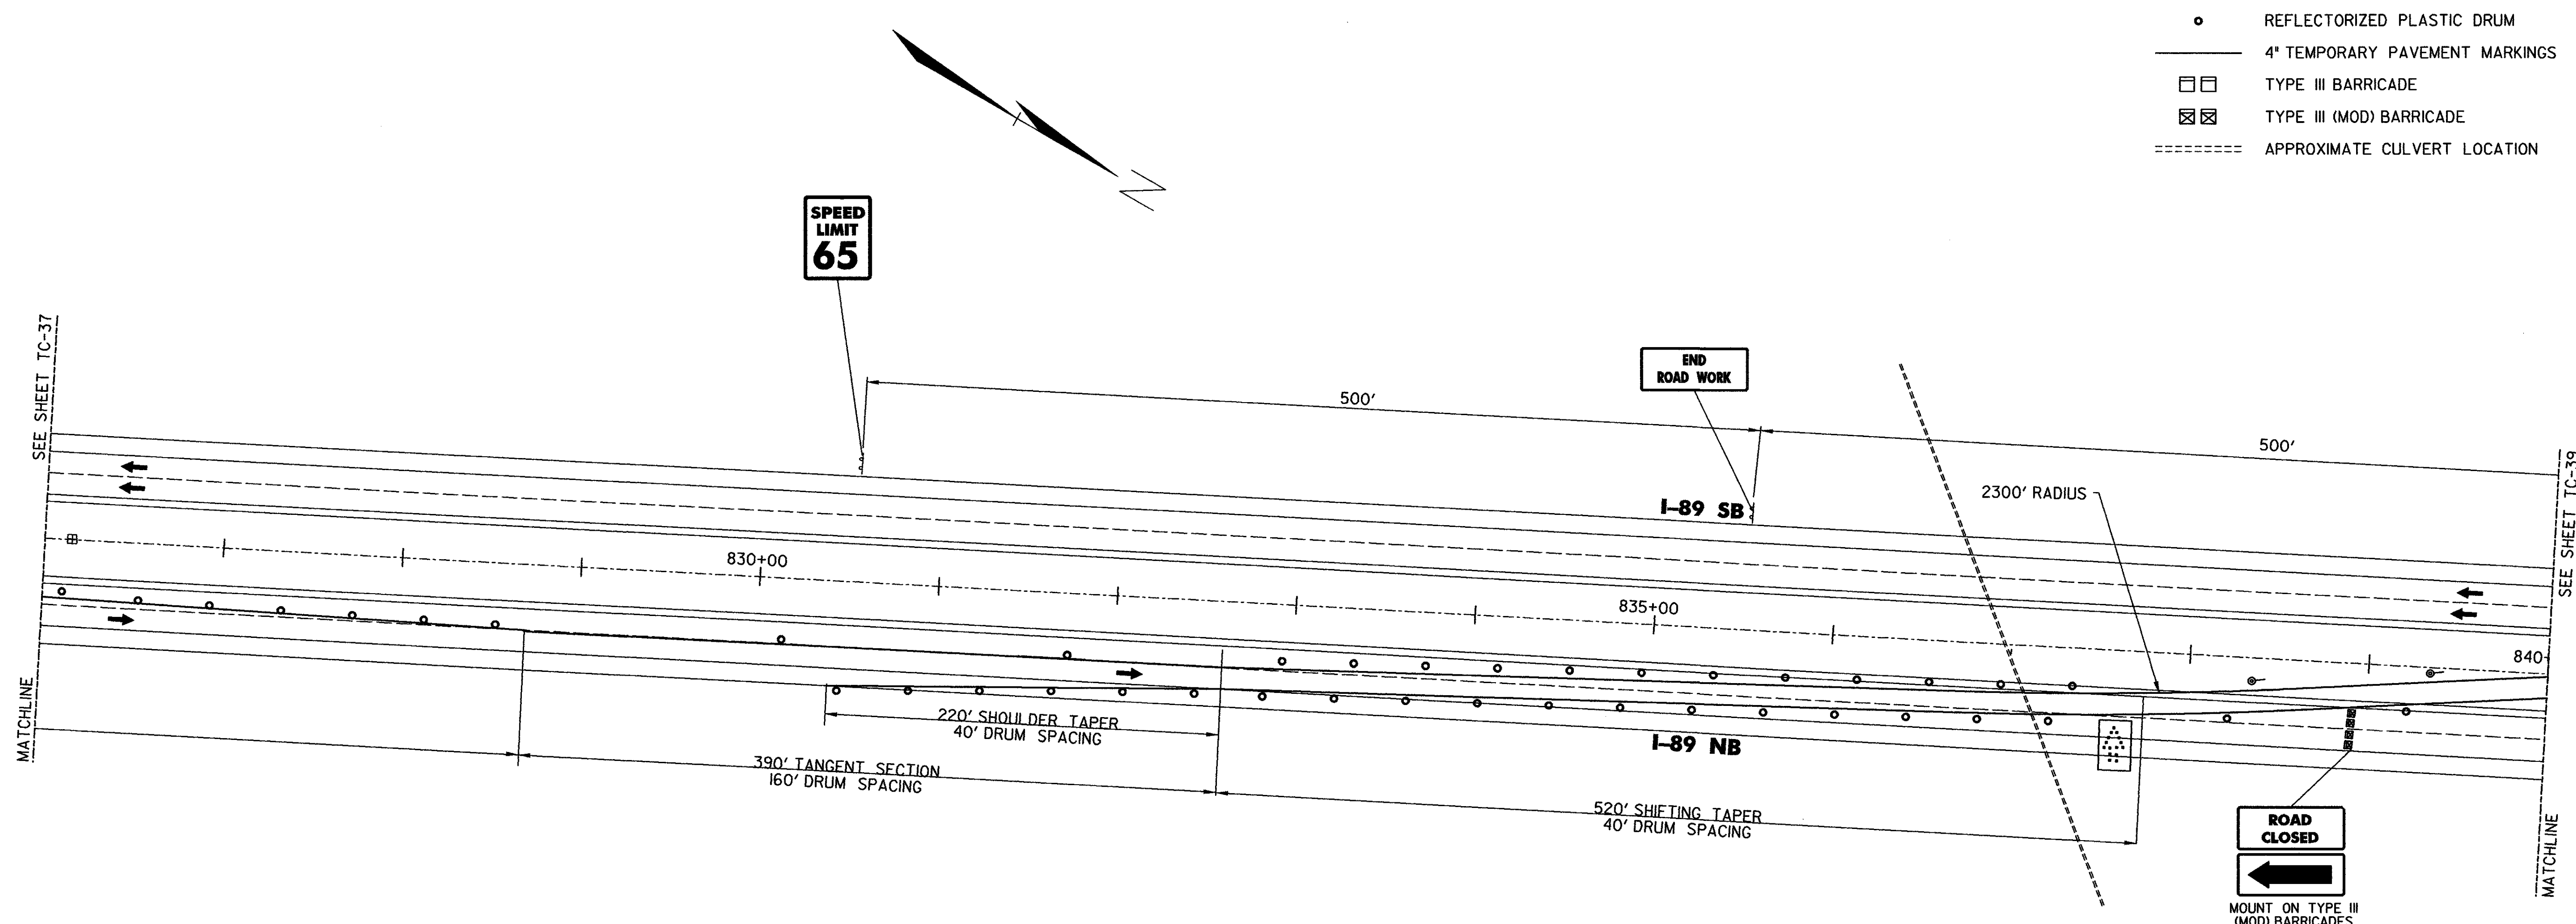




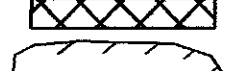
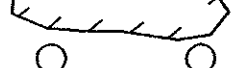


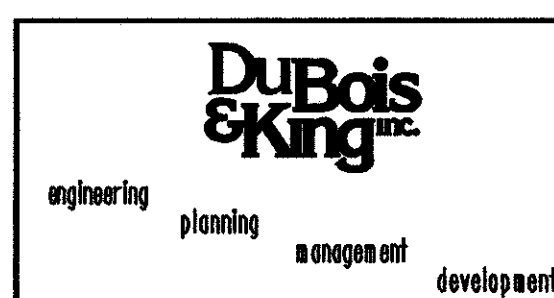

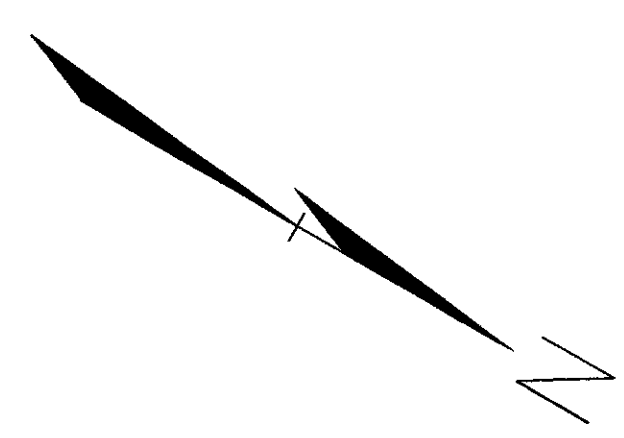




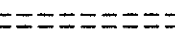
**STATE OF VERMONT  
AGENCY OF TRANSPORTATION**



Town Of MIDDLESEX-BOLTON		Bridge No. <b>48, 49, 50</b>
Highway No. I-89	Log Sta.	Surv. Sta.
<b>PHASE II CONSTRUCTION I-89 NORTHBOUND CROSSOVER BRIDGES 48, 49, 50</b>		
Designed By J.M.SMYRSKI/K.S.MARSHA	Drawn By S. E. SCHMITT	
Checked By J. W. TUCKER	Date 10/99	Bridge Design Supervisor J. P. HALSTEAD Date 10/99
PROJECT MIDDLESEX-BOLTON		PROJECT NO. IM-089-2(26)
Drawing No. ...48-49-50-nb.dgn	Date OCT 1999	
Bridge Sheet No. TC-38	Sheet 198 of 307	





**LEGEND**

-  CONCRETE BARRIER
-  DIRECTION OF TRAFFIC FLOW WITH DETOUR IN PLACE
-  CROSSOVER ALIGNMENT
-  BRIDGE WORK AREA
-  LEDGE OUTCROPPING
-  GUARDRAIL
-  EXISTING DROP INLET
-  PORTABLE ARROW BOARD
-  TYPE I DELINEATOR (YELLOW)
-  TYPE I DELINEATOR (WHITE)
-  REFLECTORIZED PLASTIC DRUM
-  4" TEMPORARY PAVEMENT MARKINGS
-  TYPE III BARRICADE
-  TYPE III (MOD) BARRICADE
-  APPROXIMATE CULVERT LOCATION

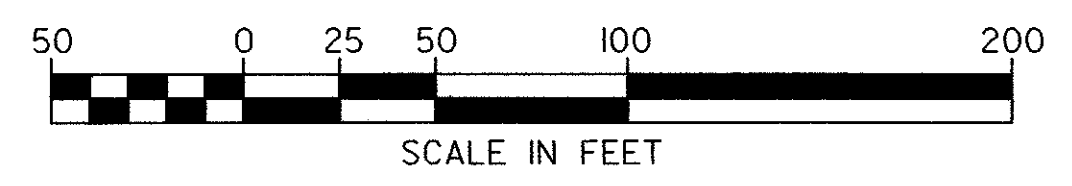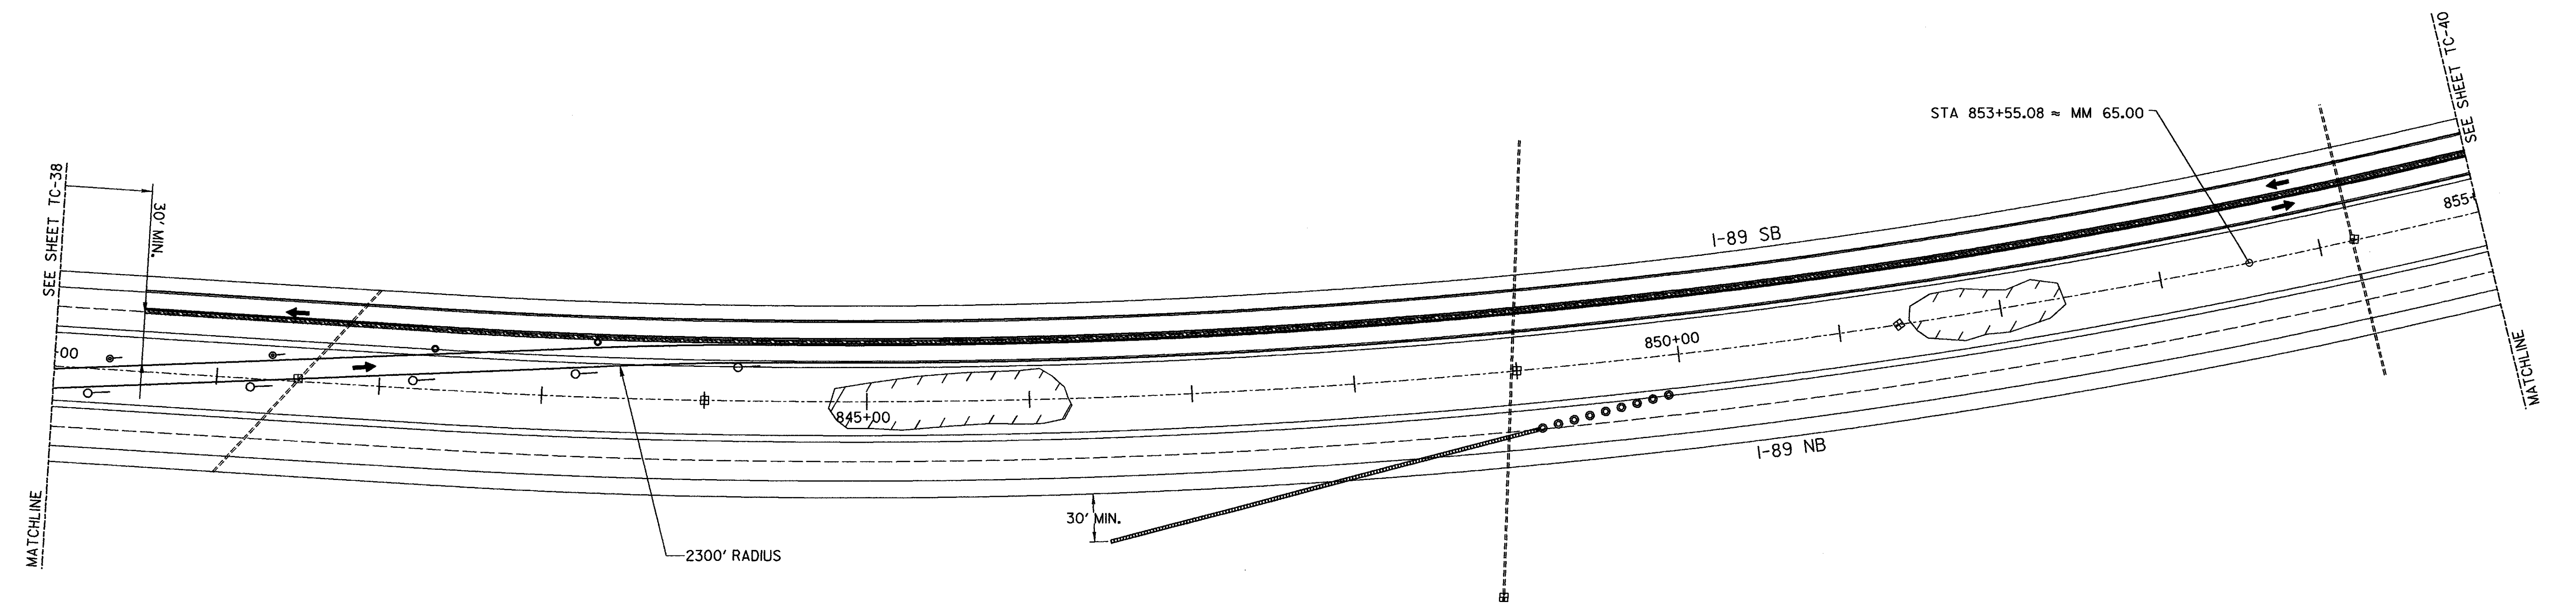

**STATE OF VERMONT  
AGENCY OF TRANSPORTATION**


Town Of	MIDDLESEX-BOLTON	Bridge No.	<b>48, 49, 50</b>
Highway No.	I-89	Log Sta.	
		Surv. Sta.	

PHASE II CONSTRUCTION I-89 NORTHBOUND CROSSOVER  
**BRIDGES 48, 49, 50**










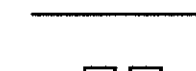
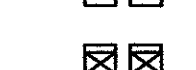
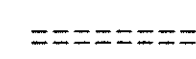


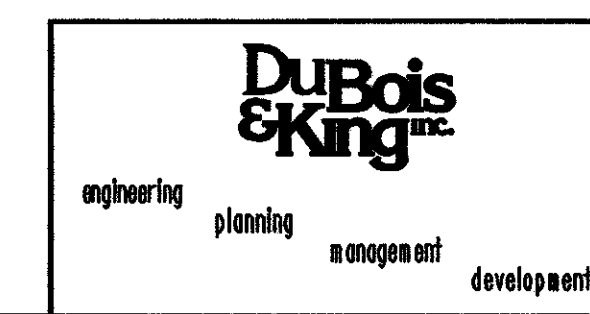
Designed By	J.M.SMYRSKI/K.S.MARSHA	Drawn By	S. E. SCHMITT
Checked By	J. W. TUCKER	Bridge Design Supervisor	J. P. HALSTEAD
Date	10/99	Date	10/99




PROJECT	MIDDLESEX-BOLTON	PROJECT NO.	IM-089-2(26)
---------	------------------	-------------	--------------

Drawing No.	...148-49-50-nb.dgn	Date	OCT 1999
Bridge Sheet No.	TC-39	Sheet	199 of 307

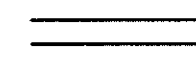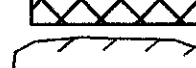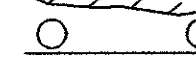

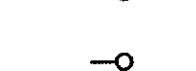
**LEGEND**

-  CONCRETE BARRIER
-  DIRECTION OF TRAFFIC FLOW WITH DETOUR IN PLACE
-  CROSSOVER ALIGNMENT
-  BRIDGE WORK AREA
-  LEDGE OUTCROPPING
-  GUARDRAIL
-  EXISTING DROP INLET
-  PORTABLE ARROW BOARD
-  TYPE I DELINEATOR (YELLOW)
-  TYPE I DELINEATOR (WHITE)
-  REFLECTORIZED PLASTIC DRUM
-  4" TEMPORARY PAVEMENT MARKINGS
-  TYPE III BARRICADE
-  TYPE III (MOD) BARRICADE
-  APPROXIMATE CULVERT LOCATION

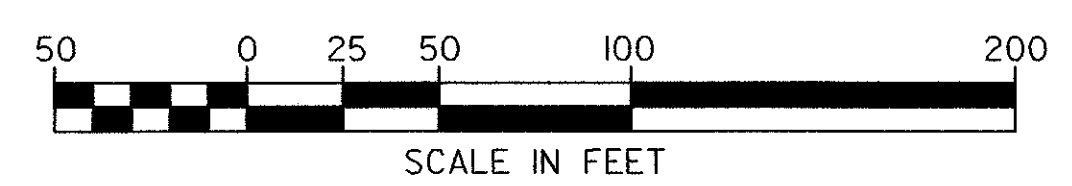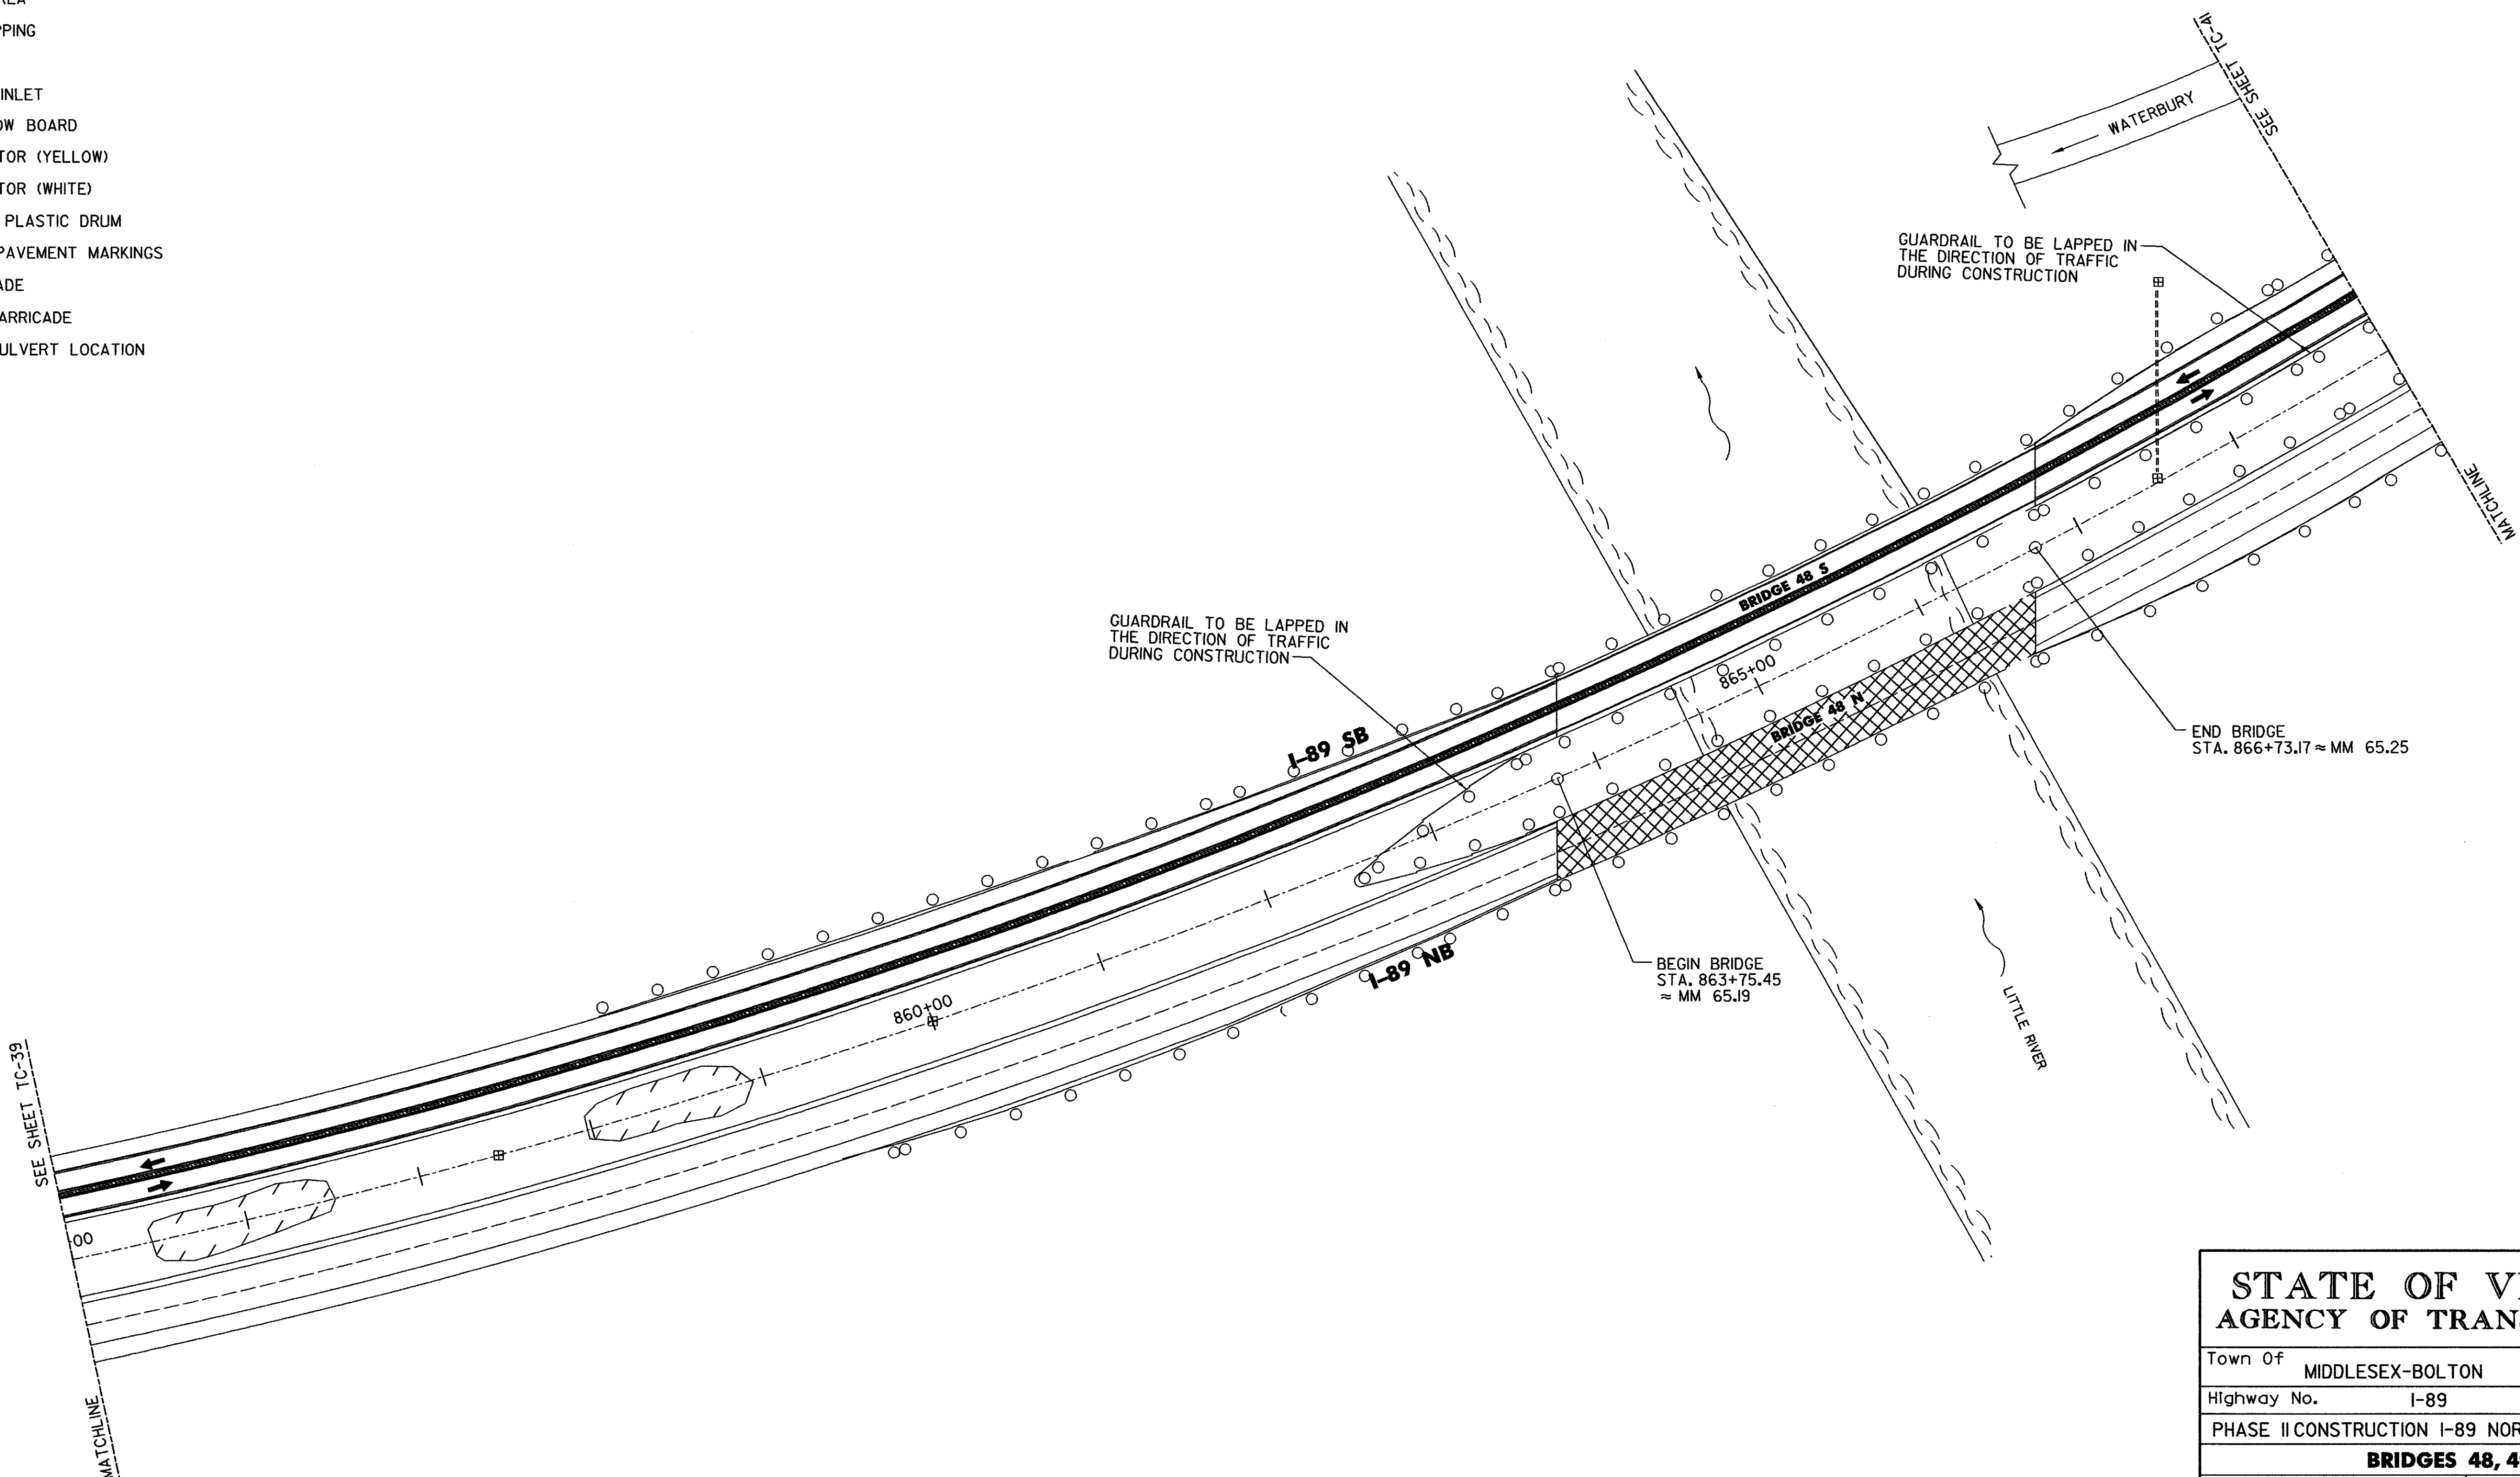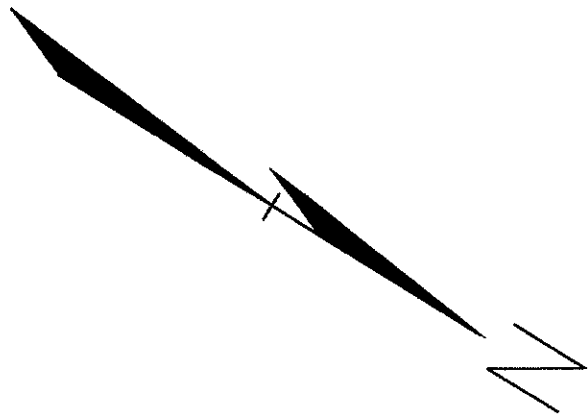






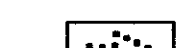


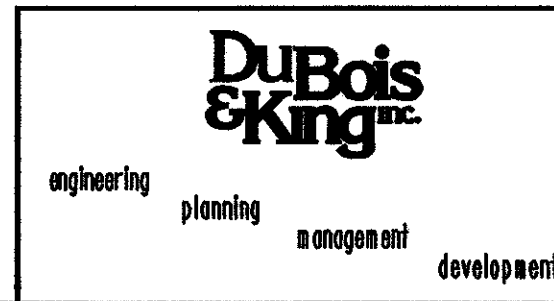


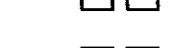



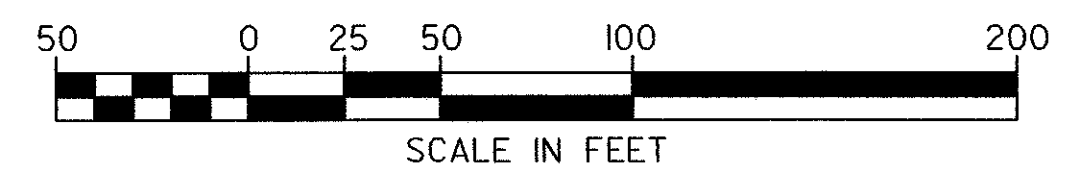
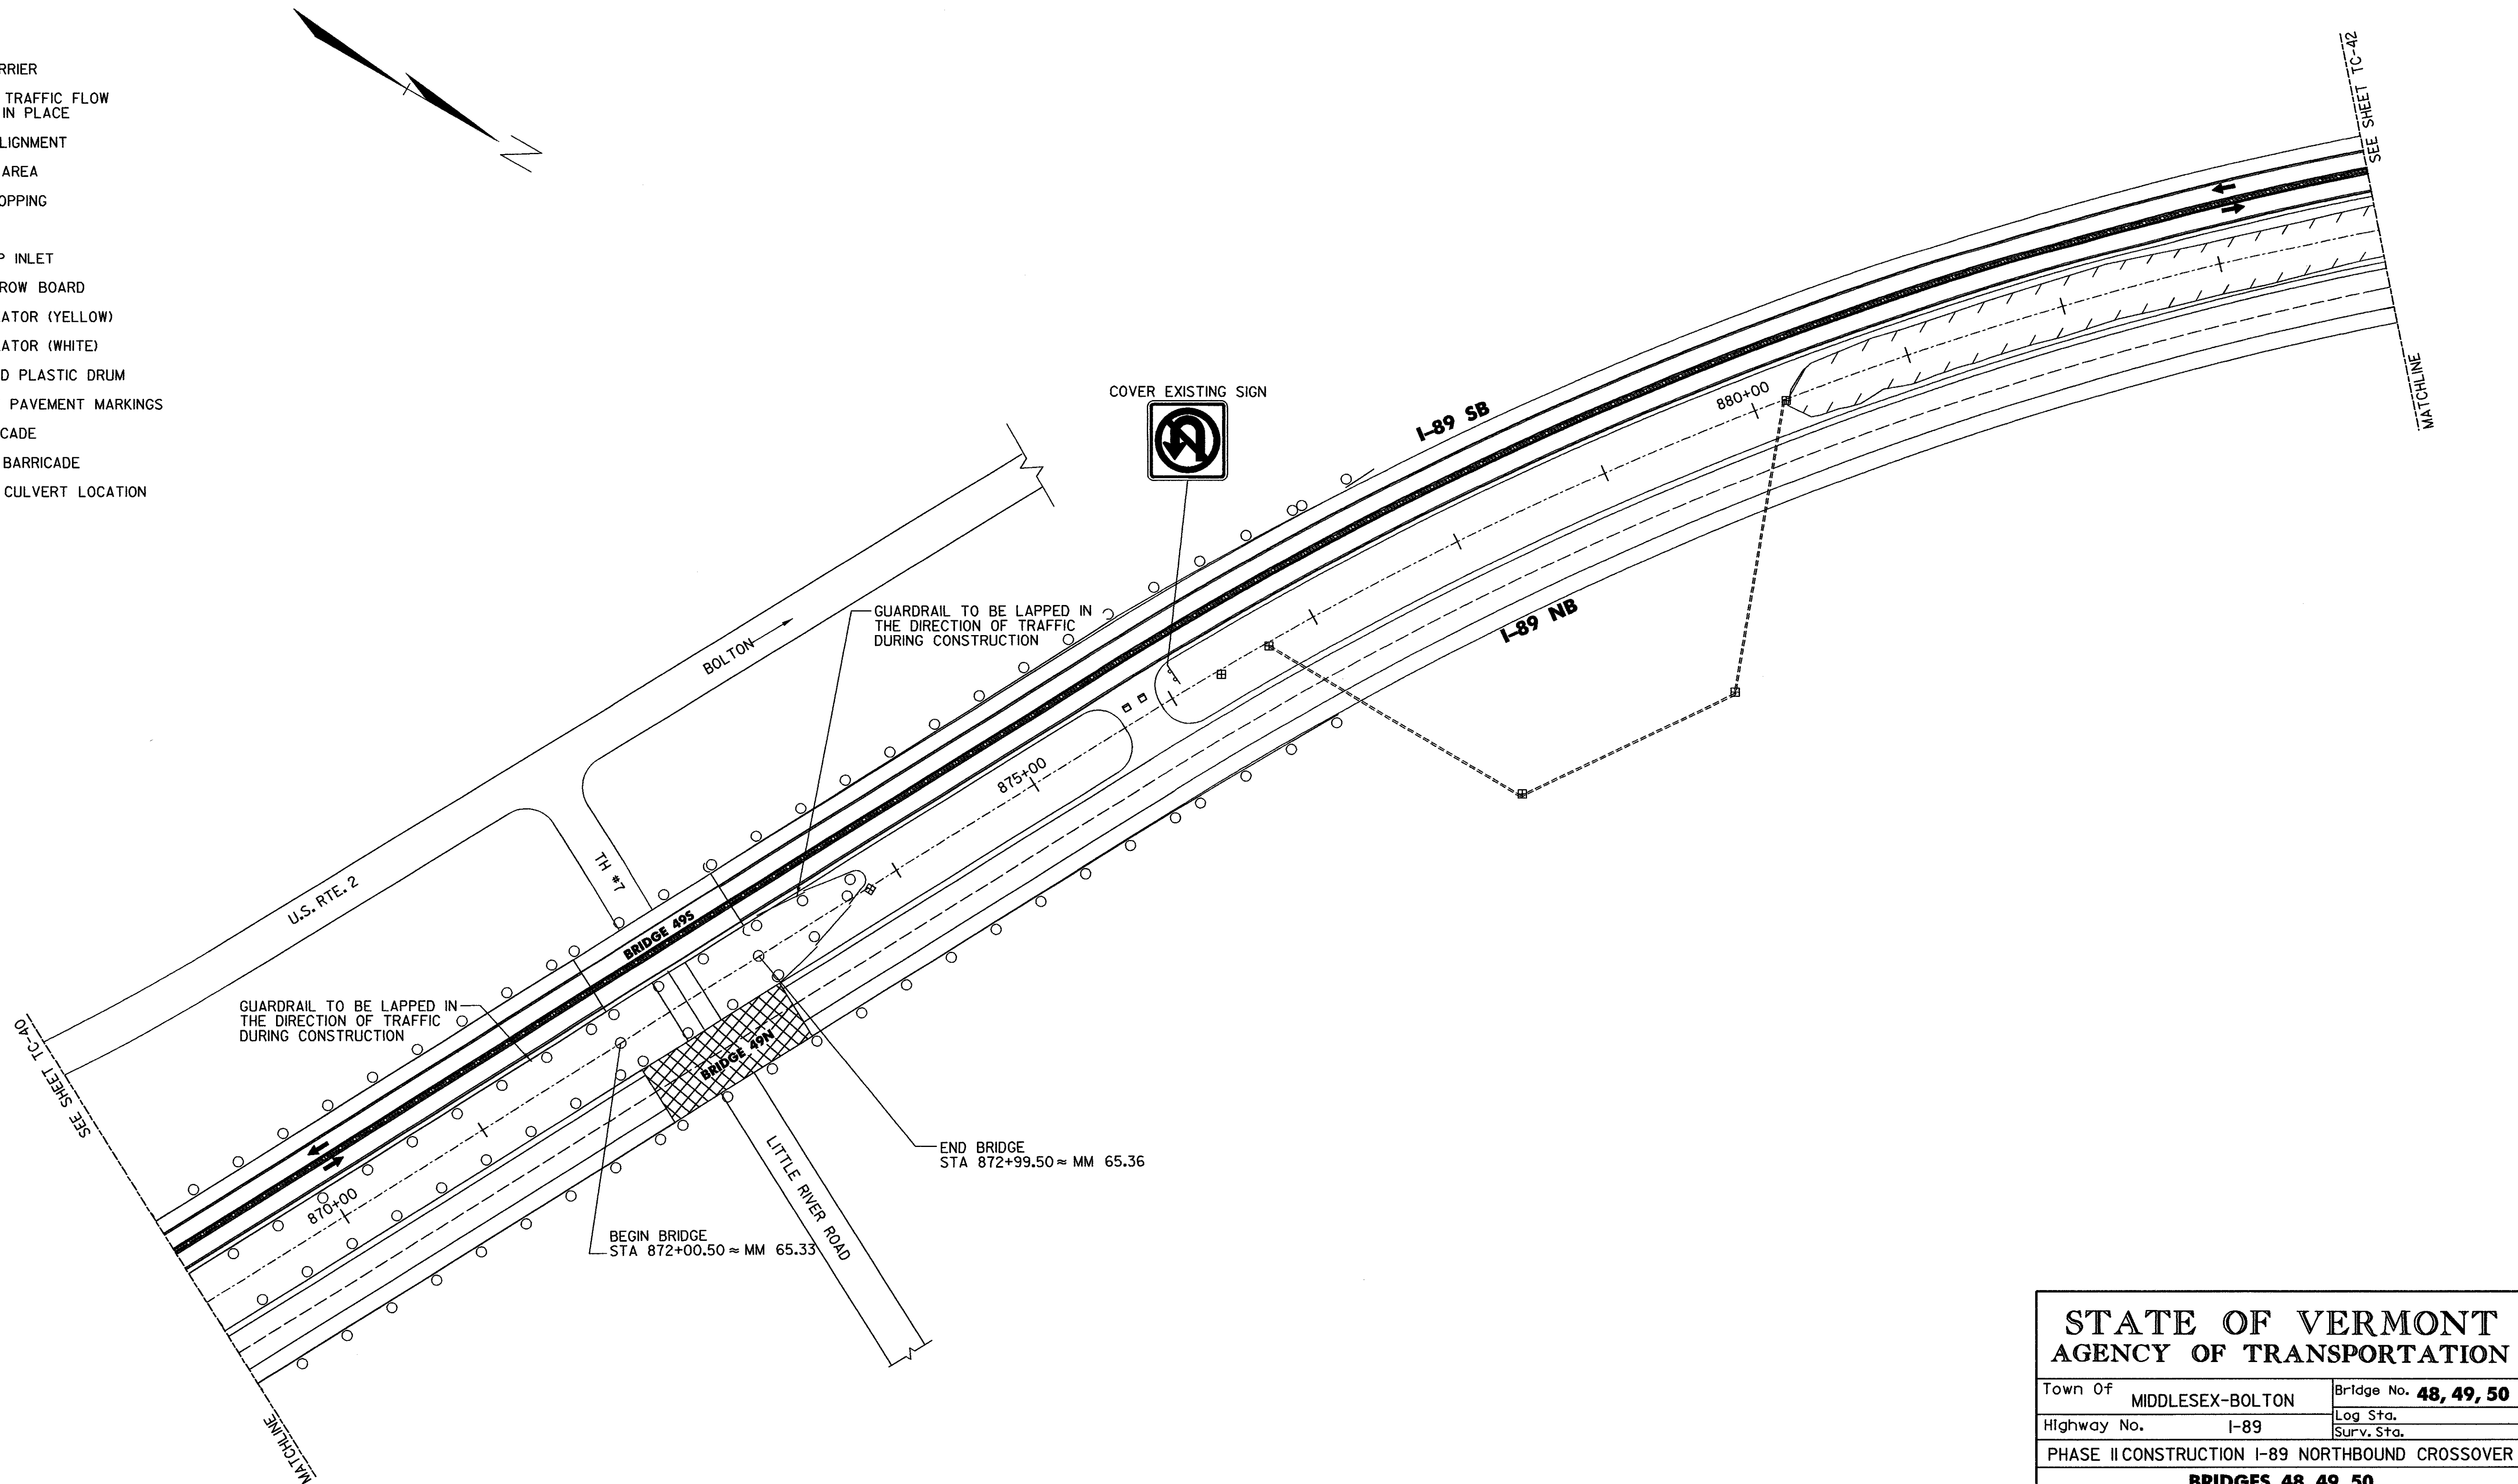
**STATE OF VERMONT  
AGENCY OF TRANSPORTATION**

Town Of	MIDDLESEX-BOLTON	Bridge No.	<b>48, 49, 50</b>
Highway No.	I-89	Log Sta.	
		Surv. Sta.	
PHASE II CONSTRUCTION I-89 NORTHBOUND CROSSOVER			
<b>BRIDGES 48, 49, 50</b>			
Designed By	J.M.SMYRSKI/K.S.MARSHA	Drawn By	S. E. SCHMITT
Checked By	J. W. TUCKER	Date	10/99
		Bridge Design Supervisor	J. P. HALSTEAD Date 10/99
PROJECT	MIDDLESEX-BOLTON	PROJECT NO.	IM-089-2(26)
Drawing No.	...48-49-50-nb.dgn	Date	OCT 1999
Bridge Sheet No.	TC-40	Sheet	200 of 307

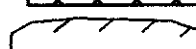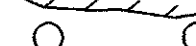



**LEGEND**

-  CONCRETE BARRIER
-  DIRECTION OF TRAFFIC FLOW WITH DETOUR IN PLACE
-  CROSSOVER ALIGNMENT
-  BRIDGE WORK AREA
-  LEDGE OUTCROPPING
-  GUARDRAIL
-  EXISTING DROP INLET
-  PORTABLE ARROW BOARD
-  TYPE I DELINEATOR (YELLOW)
-  TYPE I DELINEATOR (WHITE)
-  REFLECTORIZED PLASTIC DRUM
-  4" TEMPORARY PAVEMENT MARKINGS
-  TYPE III BARRICADE
-  TYPE III (MOD) BARRICADE
-  APPROXIMATE CULVERT LOCATION





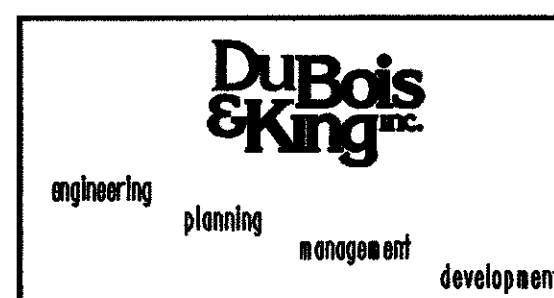


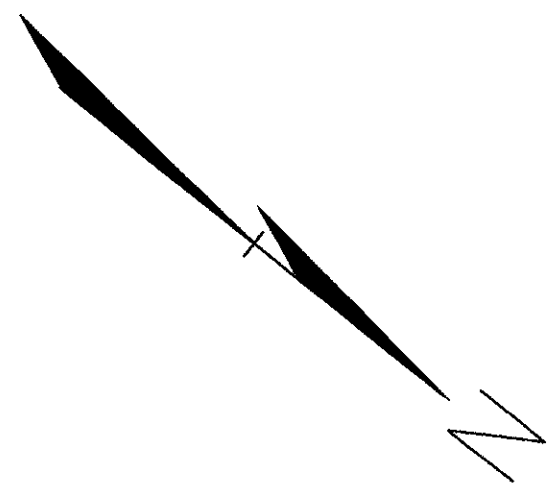







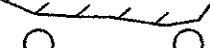



<b>STATE OF VERMONT AGENCY OF TRANSPORTATION</b>			
Town Of	MIDDLESEX-BOLTON	Bridge No.	<b>48, 49, 50</b>
Highway No.	I-89	Log Sta.	
		Surv. Sta.	
<b>PHASE II CONSTRUCTION I-89 NORTHBOUND CROSSOVER BRIDGES 48, 49, 50</b>			
Designed By	J.M.SMYRSKI/K.S.MARSH	Drawn By	S. E. SCHMITT
Checked By	Date	Bridge Design Supervisor	
J. W. TUCKER	10/99	J. P. HALSTEAD	Date 10/99
PROJECT	MIDDLESEX-BOLTON	PROJECT NO.	IM-089-2(26)
Drawing No.	... \48-49-50-nb.dgn	Date	OCT 1999
Bridge Sheet No.	TC-4I	Sheet	20I of 307



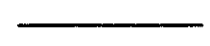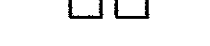


**LEGEND**

-  CONCRETE BARRIER
-  DIRECTION OF TRAFFIC FLOW WITH DETOUR IN PLACE
-  CROSSOVER ALIGNMENT
-  BRIDGE WORK AREA
-  LEDGE OUTCROPPING
-  GUARDRAIL
-  EXISTING DROP INLET
-  PORTABLE ARROW BOARD
-  TYPE I DELINEATOR (YELLOW)
-  TYPE I DELINEATOR (WHITE)
-  REFLECTORIZED PLASTIC DRUM
-  4' TEMPORARY PAVEMENT MARKINGS
-  TYPE III BARRICADE
-  TYPE III (MOD) BARRICADE
-  APPROXIMATE CULVERT LOCATION

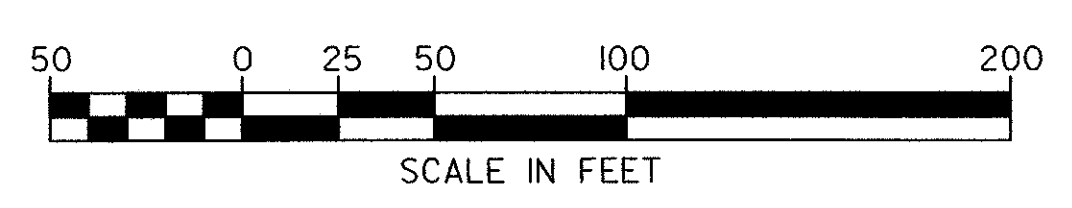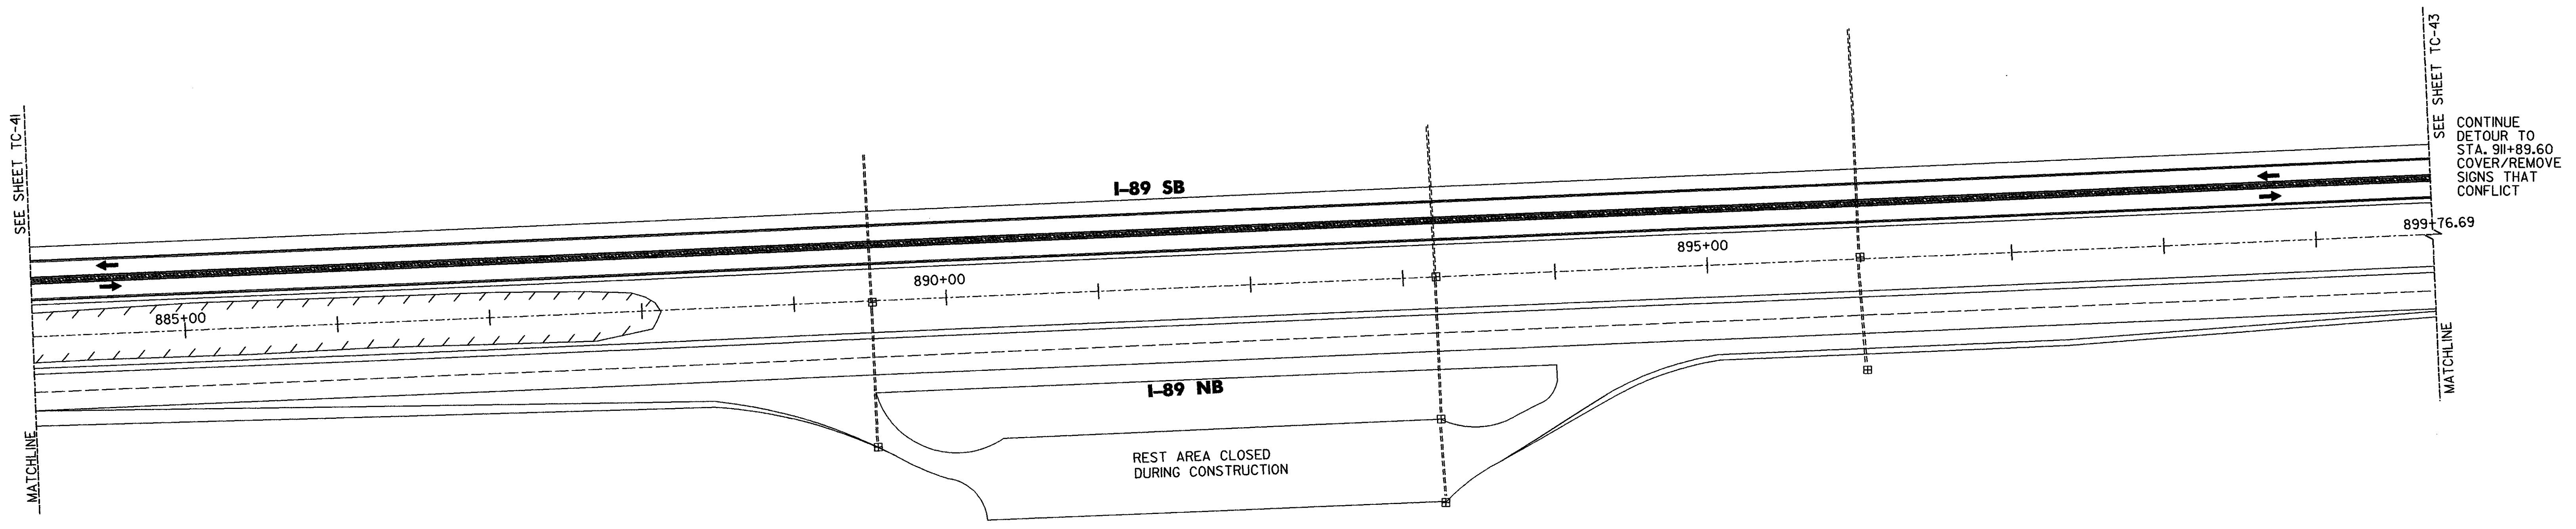






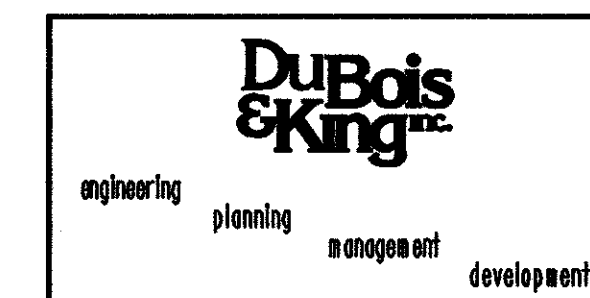






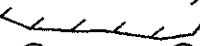


**STATE OF VERMONT  
AGENCY OF TRANSPORTATION**

Town Of MIDDLESEX-BOLTON	Bridge No. <b>48, 49, 50</b>
Highway No. I-89	Log Sta. Surv. Sta.
<b>PHASE II CONSTRUCTION I-89 NORTHBOUND CROSSOVER</b>	
<b>BRIDGES 48, 49, 50</b>	
Designed By J.M.SMYRSKI/K.S.MARSHIA	Drawn By S.E. SCHMITT
Checked By J.W. TUCKER	Bridge Design Supervisor J.P. HALSTEAD
Date 10/99	Date 10/99
PROJECT MIDDLESEX-BOLTON	PROJECT NO. IM-089-2(26)
Drawing No. ...148-49-50-nb.dgn	Date OCT 1999
Bridge Sheet No. TC-42	Sheet 202 of 307

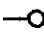




**LEGEND**

-  CONCRETE BARRIER
-  DIRECTION OF TRAFFIC FLOW WITH DETOUR IN PLACE
-  CROSSOVER ALIGNMENT
-  BRIDGE WORK AREA
-  LEDGE OUTCROPPING
-  GUARDRAIL
-  EXISTING DROP INLET
-  PORTABLE ARROW BOARD
-  TYPE I DELINEATOR (YELLOW)
-  TYPE I DELINEATOR (WHITE)
-  REFLECTORIZED PLASTIC DRUM
-  4" TEMPORARY PAVEMENT MARKINGS
-  TYPE III BARRICADE
-  TYPE III (MOD) BARRICADE
-  APPROXIMATE CULVERT LOCATION

CONTINUE  
DETOUR TO  
STA. 899+76.69  
COVER/REMOVE  
SIGNS THAT  
CONFLICT


SEE SHEET TC-42  
MATCHLINE

SEE SHEET TC-44  
MATCHLINE

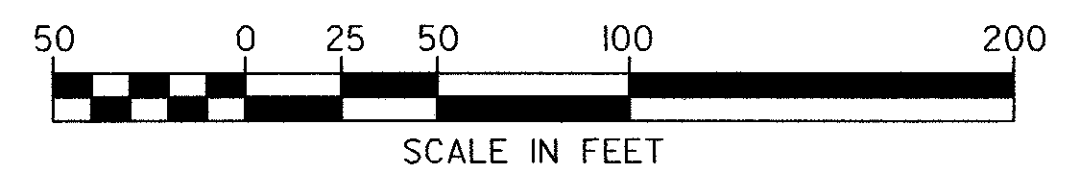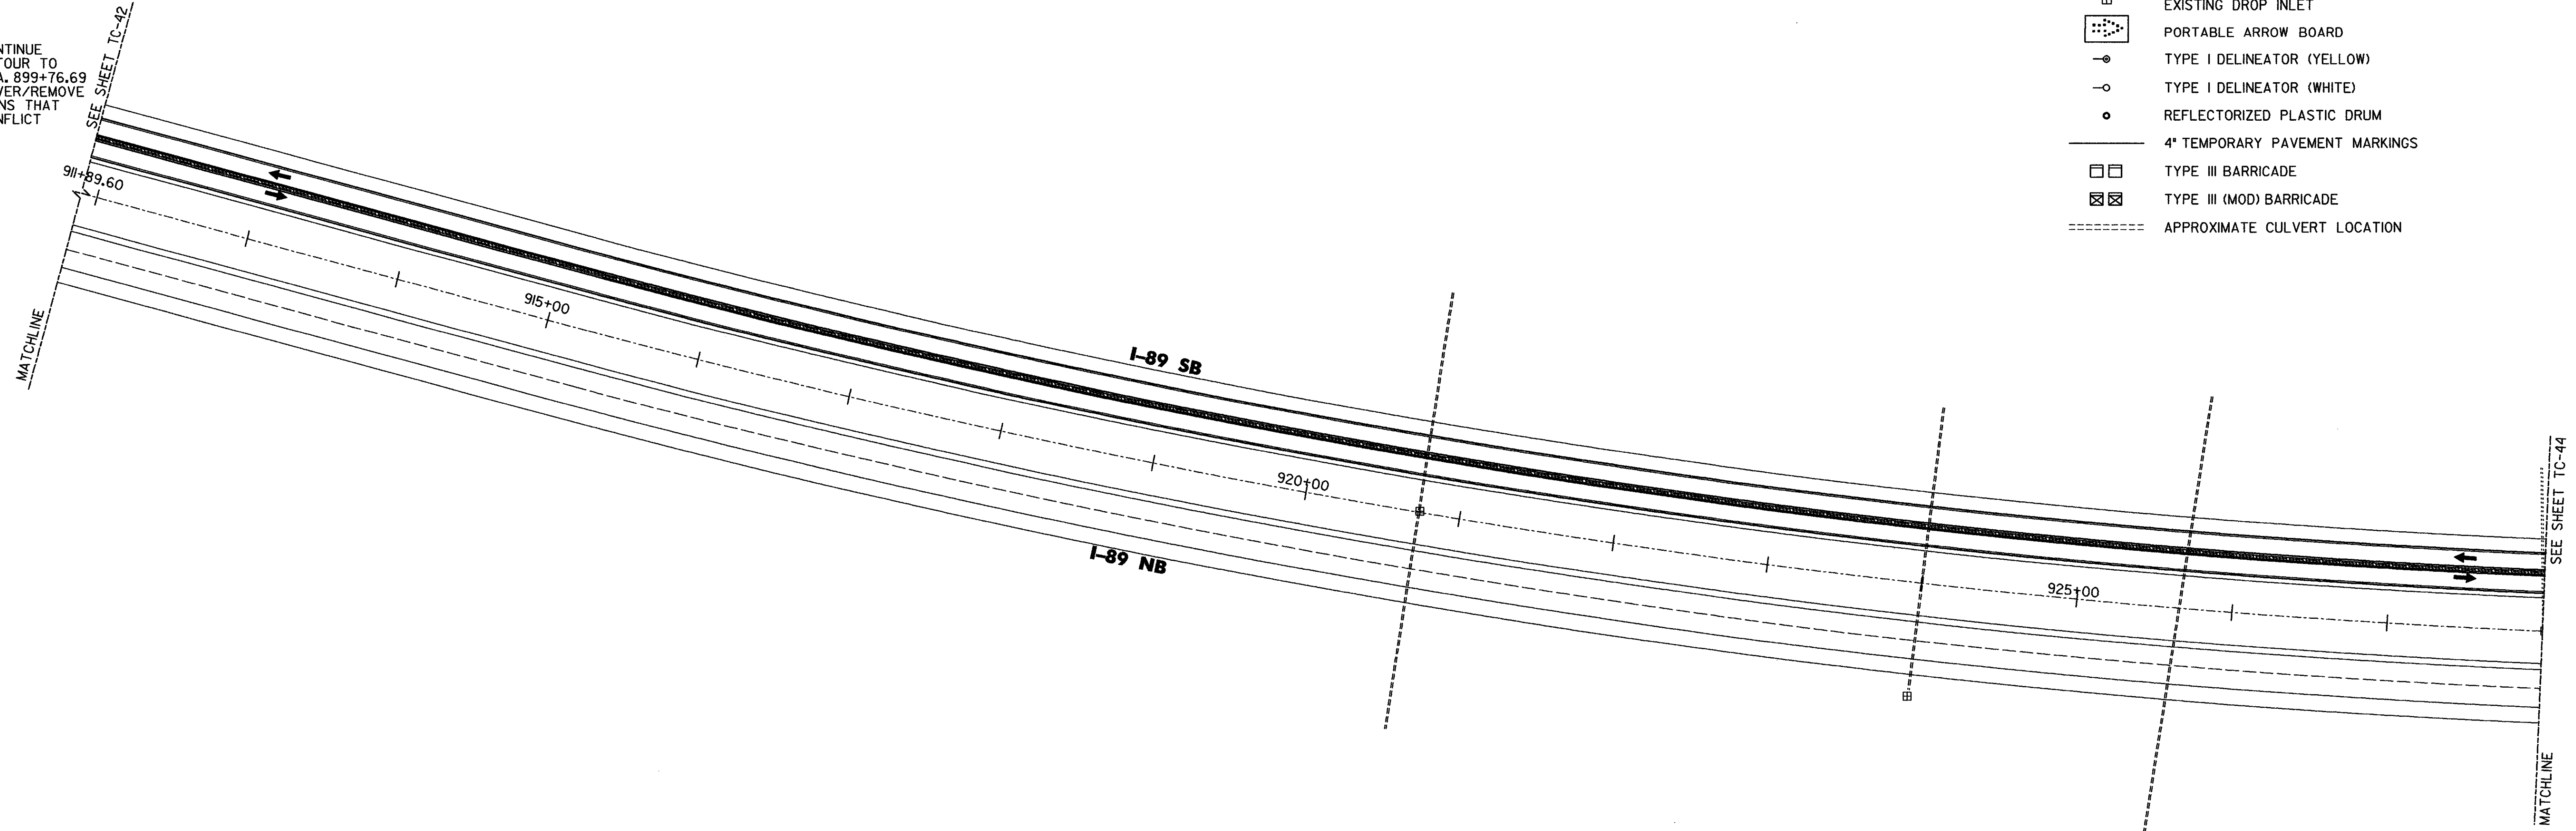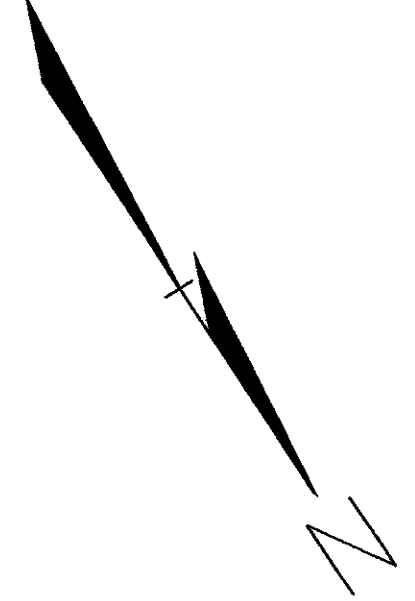


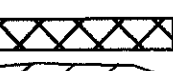
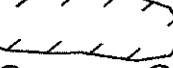



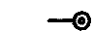
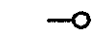

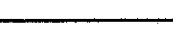


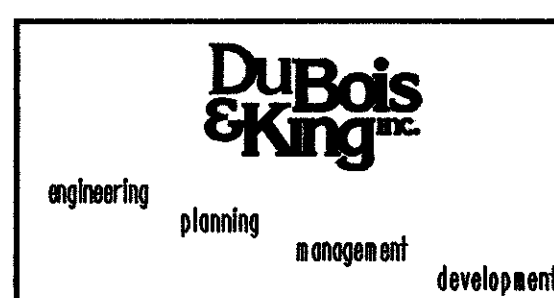


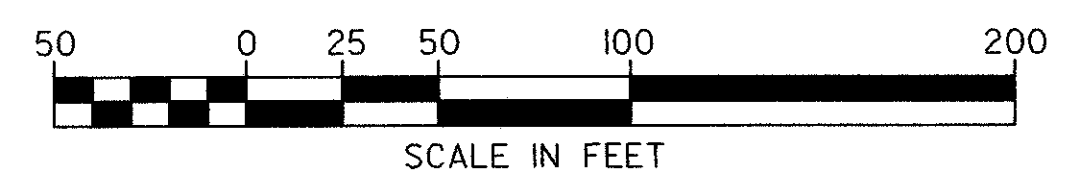
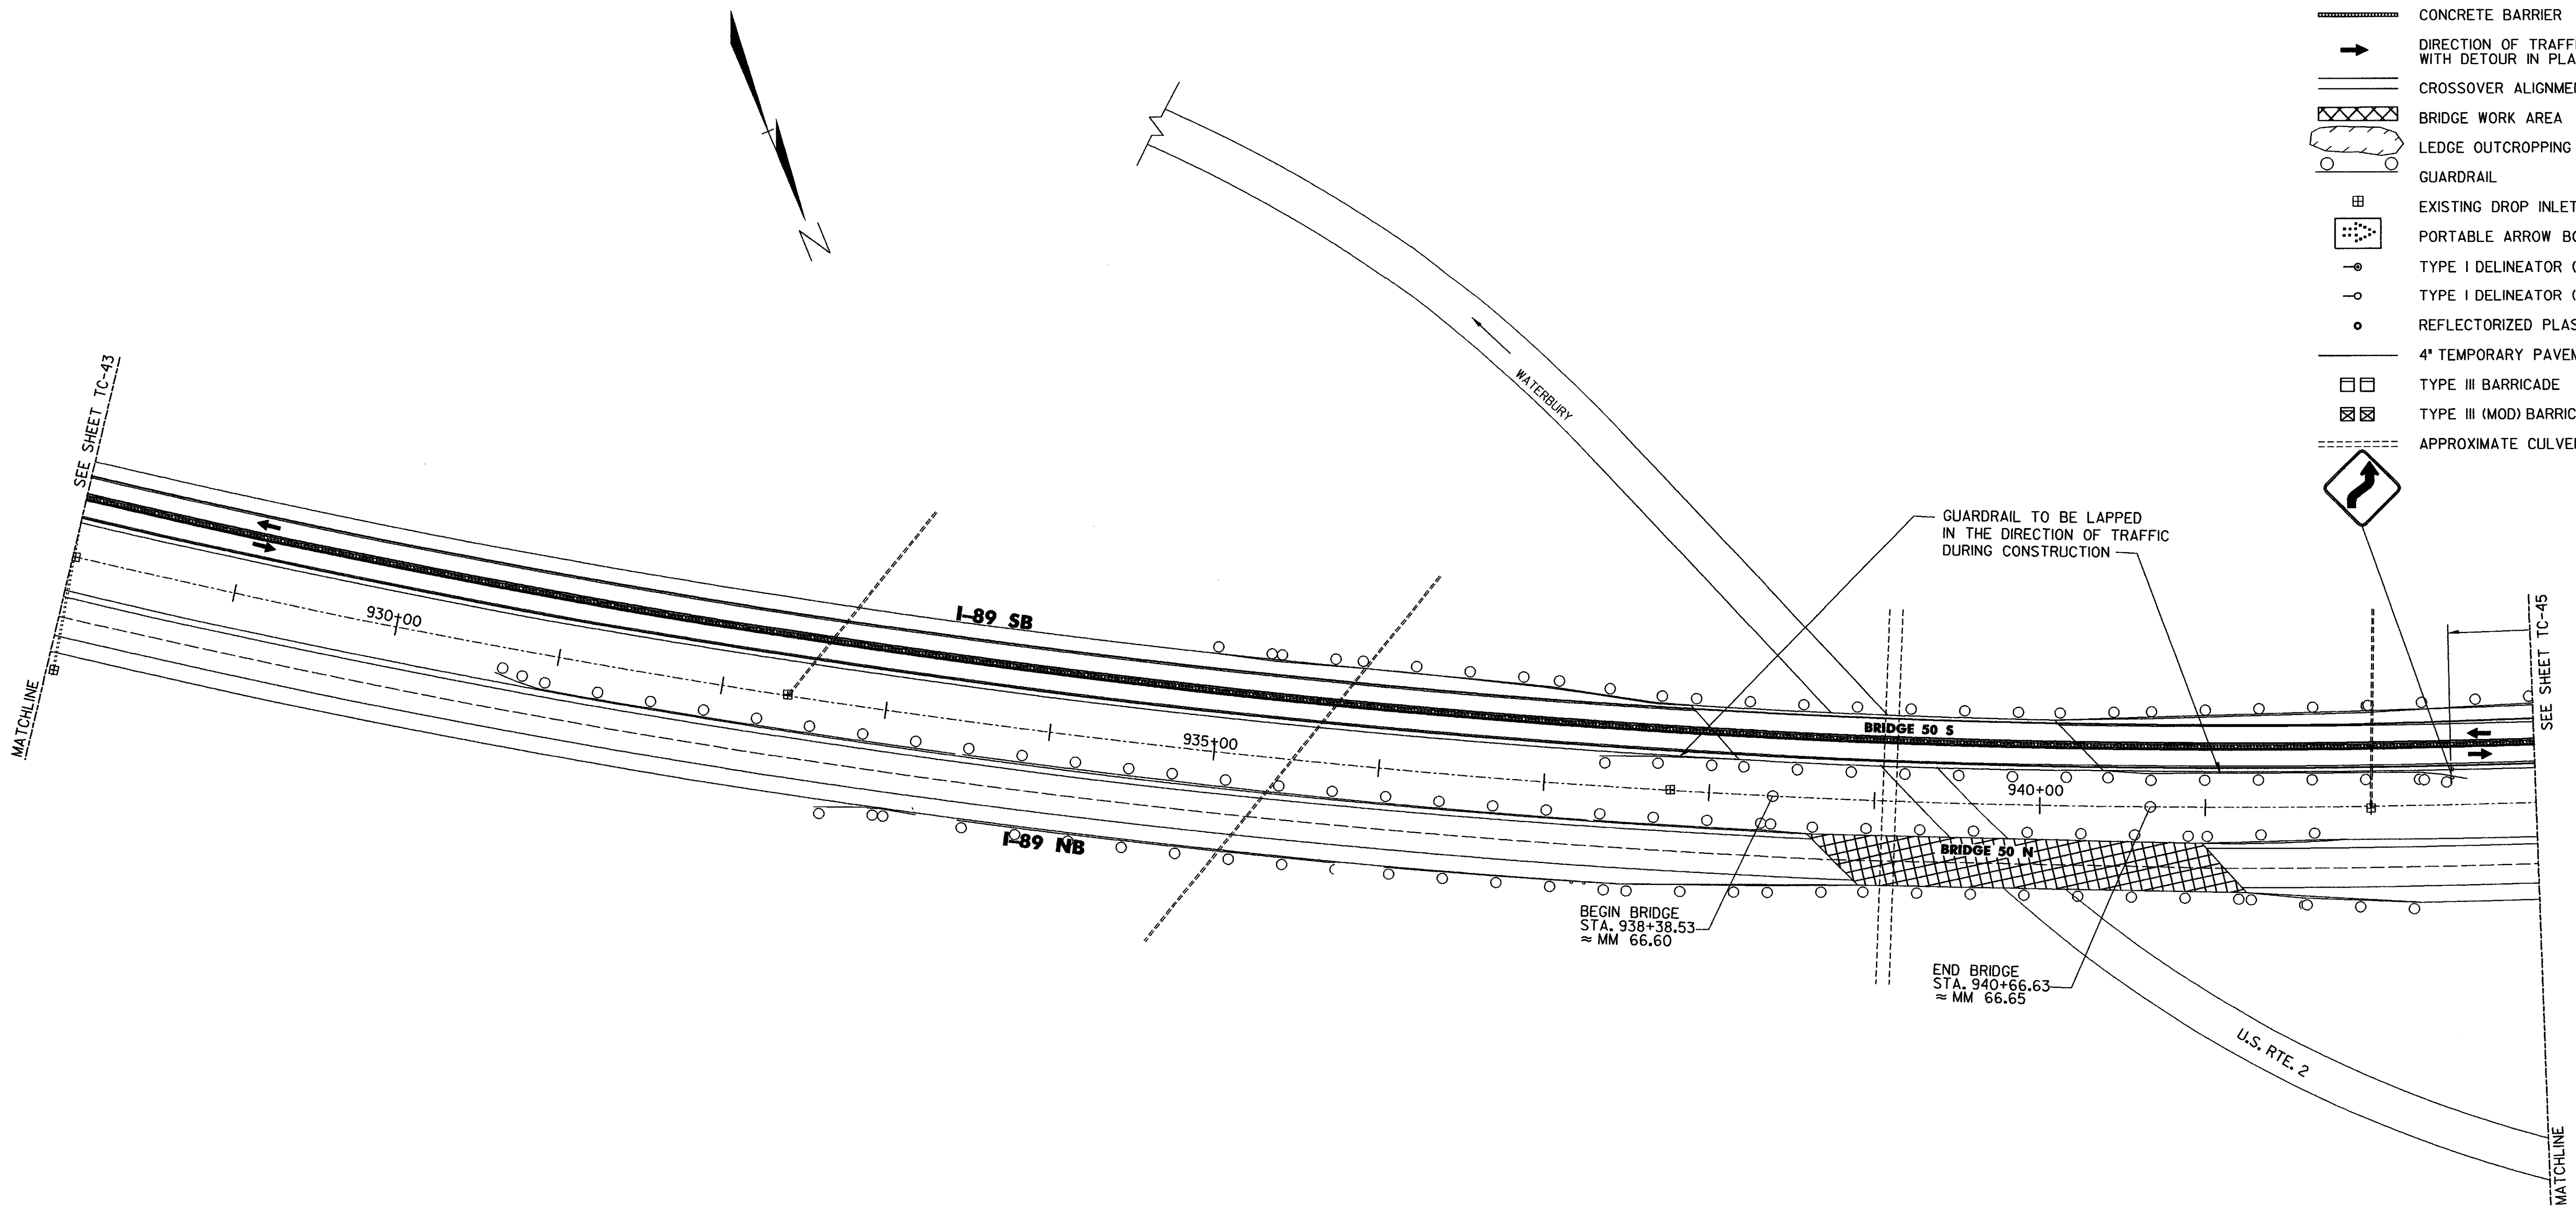
**STATE OF VERMONT  
AGENCY OF TRANSPORTATION**

Town Of MIDDLESEX-BOLTON		Bridge No. <b>48, 49, 50</b>
Highway No. I-89	Log Sta.	Surv. Sta.
<b>PHASE II CONSTRUCTION I-89 NORTHBOUND CROSSOVER BRIDGES 48, 49, 50</b>		
Designed By J.M.SMYRSKI/K.S.MARSHA	Drawn By S. E. SCHMITT	
Checked By J. W. TUCKER	Date 10/99	Bridge Design Supervisor J. P. HALSTEAD Date 10/99
PROJECT MIDDLESEX-BOLTON		PROJECT NO. IM-089-2(26)
Drawing No. ...148-49-50-nb.dgn	Date OCT 1999	
Bridge Sheet No. TC-43	Sheet 203 of 307	




**LEGEND**

-  CONCRETE BARRIER
-  DIRECTION OF TRAFFIC FLOW WITH DETOUR IN PLACE
-  CROSSOVER ALIGNMENT
-  BRIDGE WORK AREA
-  LEDGE OUTCROPPING
-  GUARDRAIL
-  EXISTING DROP INLET
-  PORTABLE ARROW BOARD
-  TYPE I DELINEATOR (YELLOW)
-  TYPE I DELINEATOR (WHITE)
-  REFLECTORIZED PLASTIC DRUM
-  4" TEMPORARY PAVEMENT MARKINGS
-  TYPE III BARRICADE
-  TYPE III (MOD) BARRICADE
-  APPROXIMATE CULVERT LOCATION







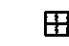

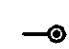
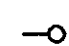


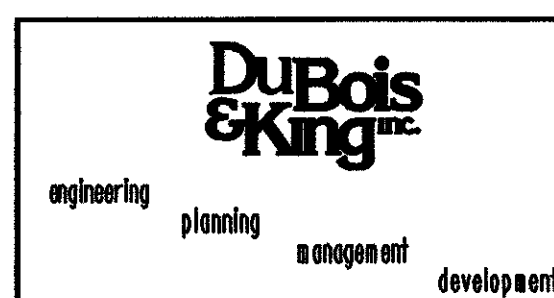




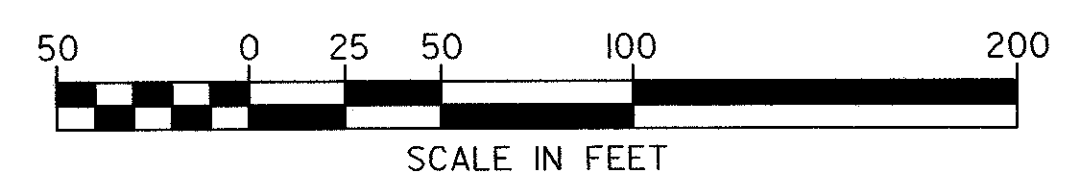
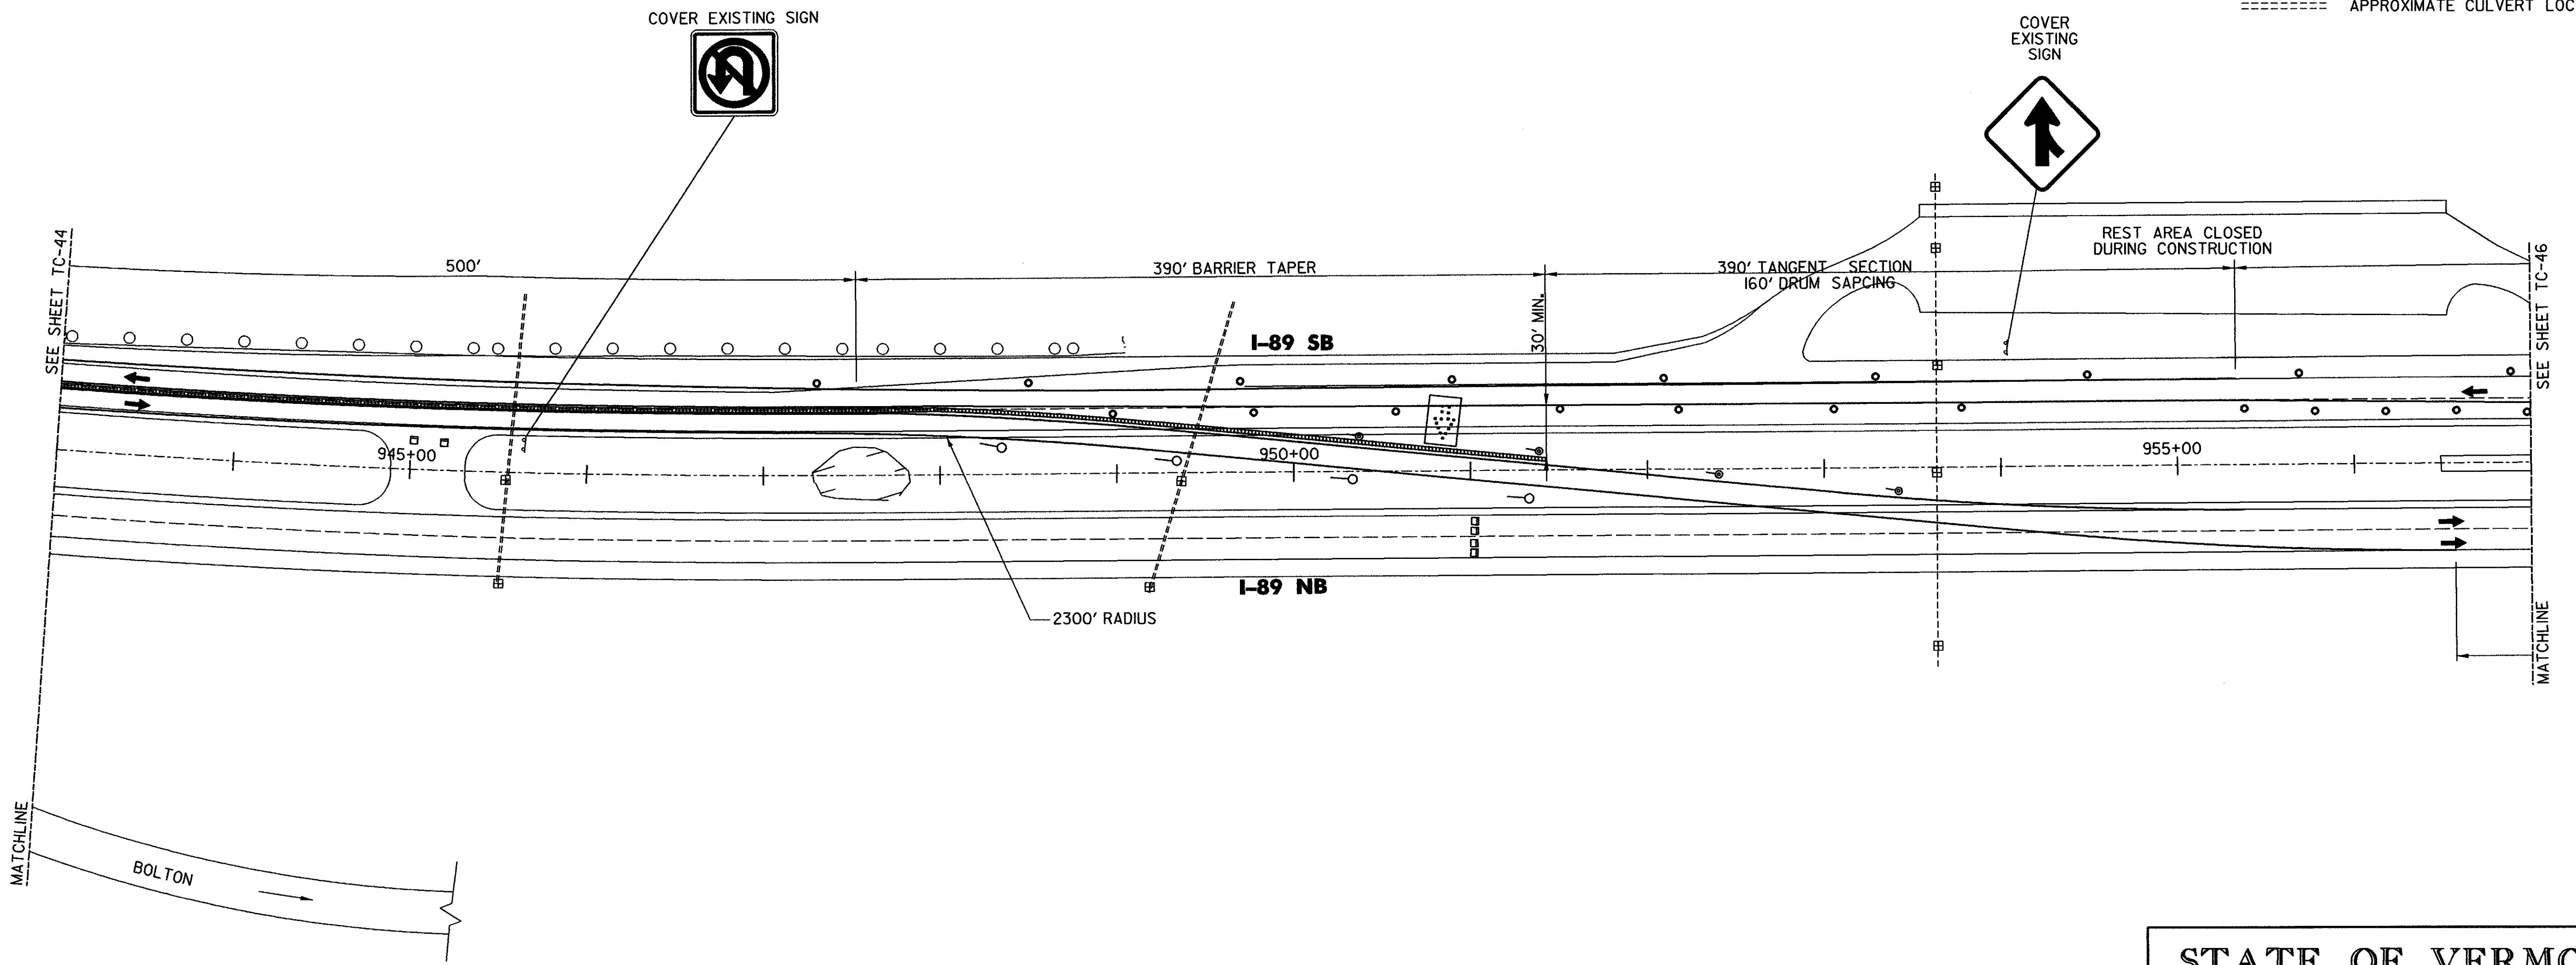
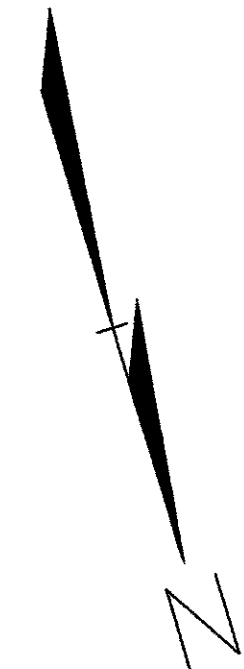
**STATE OF VERMONT  
AGENCY OF TRANSPORTATION**

Town Of <b>MIDDLESEX-BOLTON</b>		Bridge No. <b>48, 49, 50</b>
Highway No. <b>I-89</b>	Log Sta.	Surv. Sta.
<b>PHASE II CONSTRUCTION I-89 NORTHBOUND CROSSOVER BRIDGES 48, 49, 50</b>		
Designed By <b>J.M. SMYRSKI/K.S. MARSH</b>	Drawn By <b>S. E. SCHMITT</b>	
Checked By <b>J. W. TUCKER</b>	Date <b>10/99</b>	Bridge Design Supervisor <b>J. P. HALSTEAD</b> Date <b>10/99</b>
PROJECT <b>MIDDLESEX-BOLTON</b>		PROJECT NO. <b>IM-089-2(26)</b>
Drawing No. <b>...48-49-50-nb.dgn</b>	Date <b>OCT 1999</b>	
Bridge Sheet No. <b>TC-44</b>	Sheet <b>204</b> of <b>307</b>	

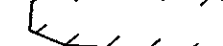


**LEGEND**

-  CONCRETE BARRIER
-  DIRECTION OF TRAFFIC FLOW WITH DETOUR IN PLACE
-  CROSSOVER ALIGNMENT
-  BRIDGE WORK AREA
-  LEDGE OUTCROPPING
-  GUARDRAIL
-  EXISTING DROP INLET
-  PORTABLE ARROW BOARD
-  TYPE I DELINEATOR (YELLOW)
-  TYPE I DELINEATOR (WHITE)
-  REFLECTORIZED PLASTIC DRUM
-  4' TEMPORARY PAVEMENT MARKINGS
-  TYPE III BARRICADE
-  TYPE III (MOD) BARRICADE
-  APPROXIMATE CULVERT LOCATION









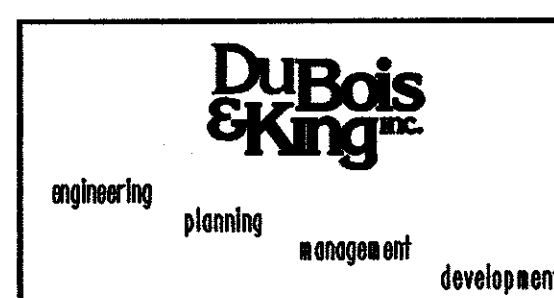








<b>STATE OF VERMONT AGENCY OF TRANSPORTATION</b>			
Town Of	MIDDLESEX-BOLTON	Bridge No.	48, 49, 50
Highway No.	I-89	Log Sta.	
		Surv. Sta.	
PHASE II CONSTRUCTION I-89 NORTHBOUND CROSSOVER			
<b>BRIDGES 48, 49, 50</b>			
Designed By	J.M.SMYRSKI/K.S.MARSHA	Drawn By	S. E. SCHMITT
Checked By	Date	Bridge Design Supervisor	
J. W. TUCKER	10/99	J. P. HALSTEAD	Date 10/99
PROJECT	MIDDLESEX-BOLTON	PROJECT NO.	IM-089-2(26)
Drawing No.	...48-49-50-nb.dgn	Date	OCT 1999
Bridge Sheet No.	TC-45	Sheet	205 of 307

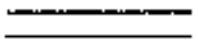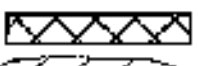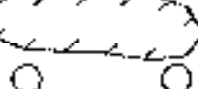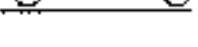


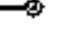

**LEGEND**

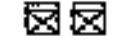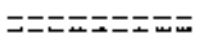
-  CONCRETE BARRIER
-  DIRECTION OF TRAFFIC FLOW WITH DETOUR IN PLACE
-  CROSSOVER ALIGNMENT
-  BRIDGE WORK AREA
-  LEDGE OUTCROPPING
-  GUARDRAIL
-  EXISTING DROP INLET
-  PORTABLE ARROW BOARD
-  TYPE I DELINEATOR (YELLOW)
-  TYPE I DELINEATOR (WHITE)
-  REFLECTORIZED PLASTIC DRUM
-  4" TEMPORARY PAVEMENT MARKINGS
-  TYPE III BARRICADE
-  TYPE III (MOD) BARRICADE
-  APPROXIMATE CULVERT LOCATION

• NOT ALL SOUTH BOUND REST AREA SIGNS THAT NEEDED TO BE COVERED WERE INDICATED ON THE PLANS ON SHEETS 206 AND 207.

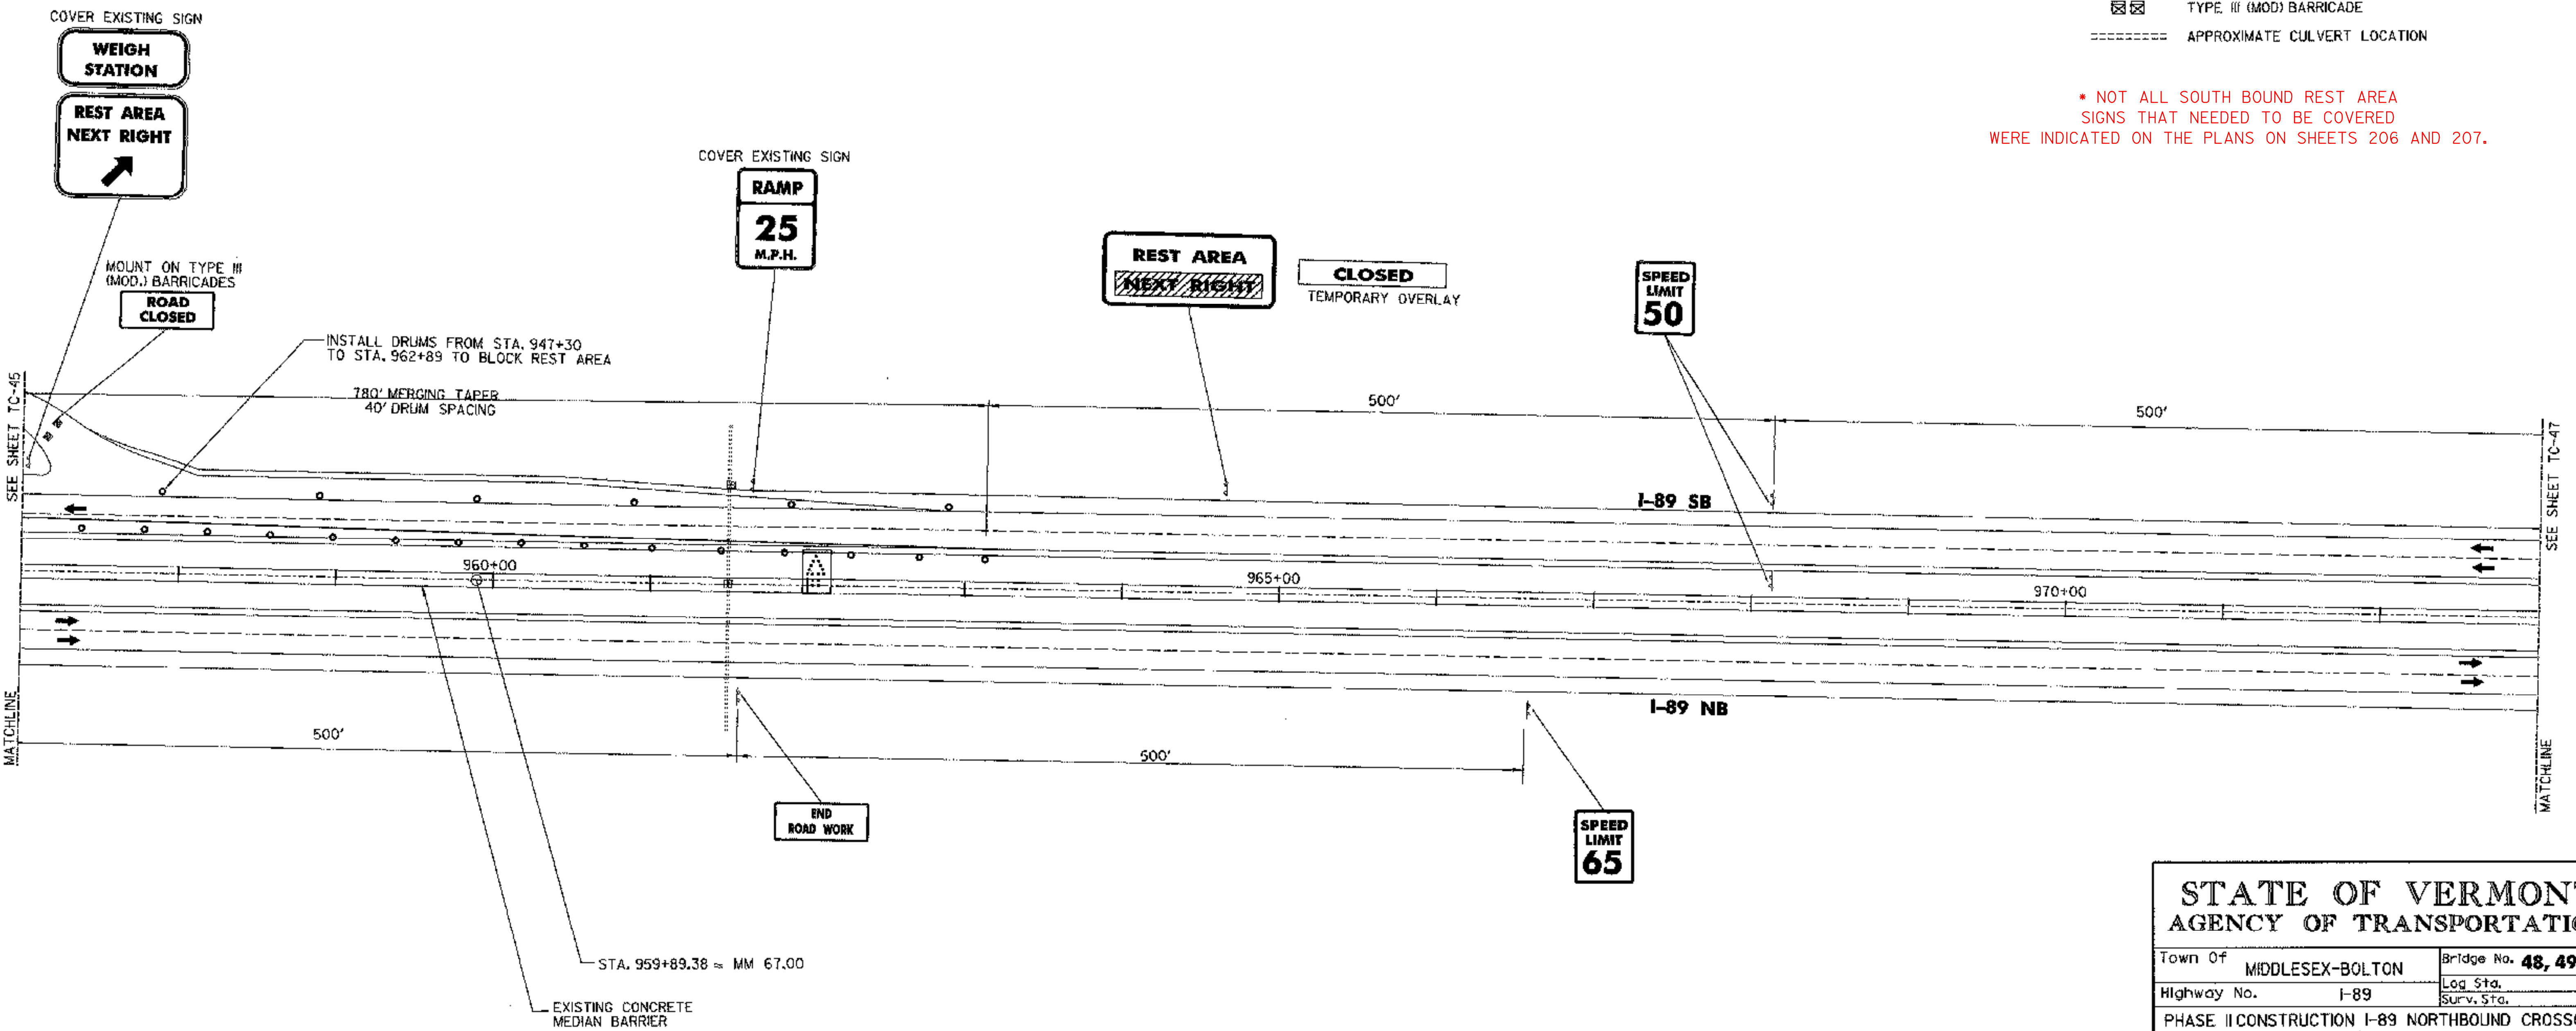


SEE SHEET TC-45

SEE SHEET TC-47

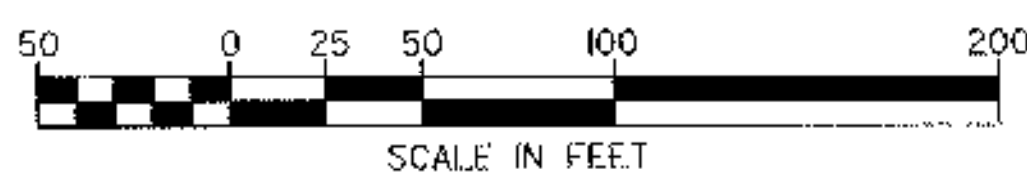


**STATE OF VERMONT  
AGENCY OF TRANSPORTATION**

Town Of	MIDDLESEX-BOLTON	Bridge No.	48, 49, 50
Highway No.	I-89	Log Sta.	
		Surv. Sta.	
PHASE II CONSTRUCTION I-89 NORTHBOUND CROSSOVER			
<b>BRIDGES 48, 49, 50</b>			
Designed By	J.M.SMYRSKI/K.S.MARSHIA	Drawn By	S.E.SCHMITT
Checked By	J.W.TUCKER	Date	10/99
		Bridge Design Supervisor	J.P.HALSTEAD
		Date	10/99
PROJECT	MIDDLESEX-BOLTON	PROJECT NO.	IM-089-2(26)
Drawing No.	...48-49-50-nb.dgn	Date	OCT 1999
Bridge Sheet No.	TC-46	Sheet	206 of 307

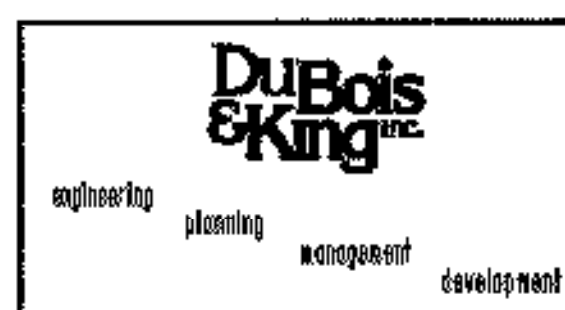


**LEGEND**

- CONCRETE BARRIER
- DIRECTION OF TRAFFIC FLOW WITH DETOUR IN PLACE
- CROSSOVER ALIGNMENT
- ▨ BRIDGE WORK AREA
- LEDGE OUTCROPPING
- GUARDRAIL
- ⊞ EXISTING DROP INLET
- ⊞ PORTABLE ARROW BOARD
- TYPE I DELINEATOR (YELLOW)
- TYPE I DELINEATOR (WHITE)
- REFLECTORIZED PLASTIC DRUM
- 4' TEMPORARY PAVEMENT MARKINGS
- ⊞ TYPE III BARRICADE
- ⊞ TYPE III (MOD) BARRICADE
- APPROXIMATE CULVERT LOCATION

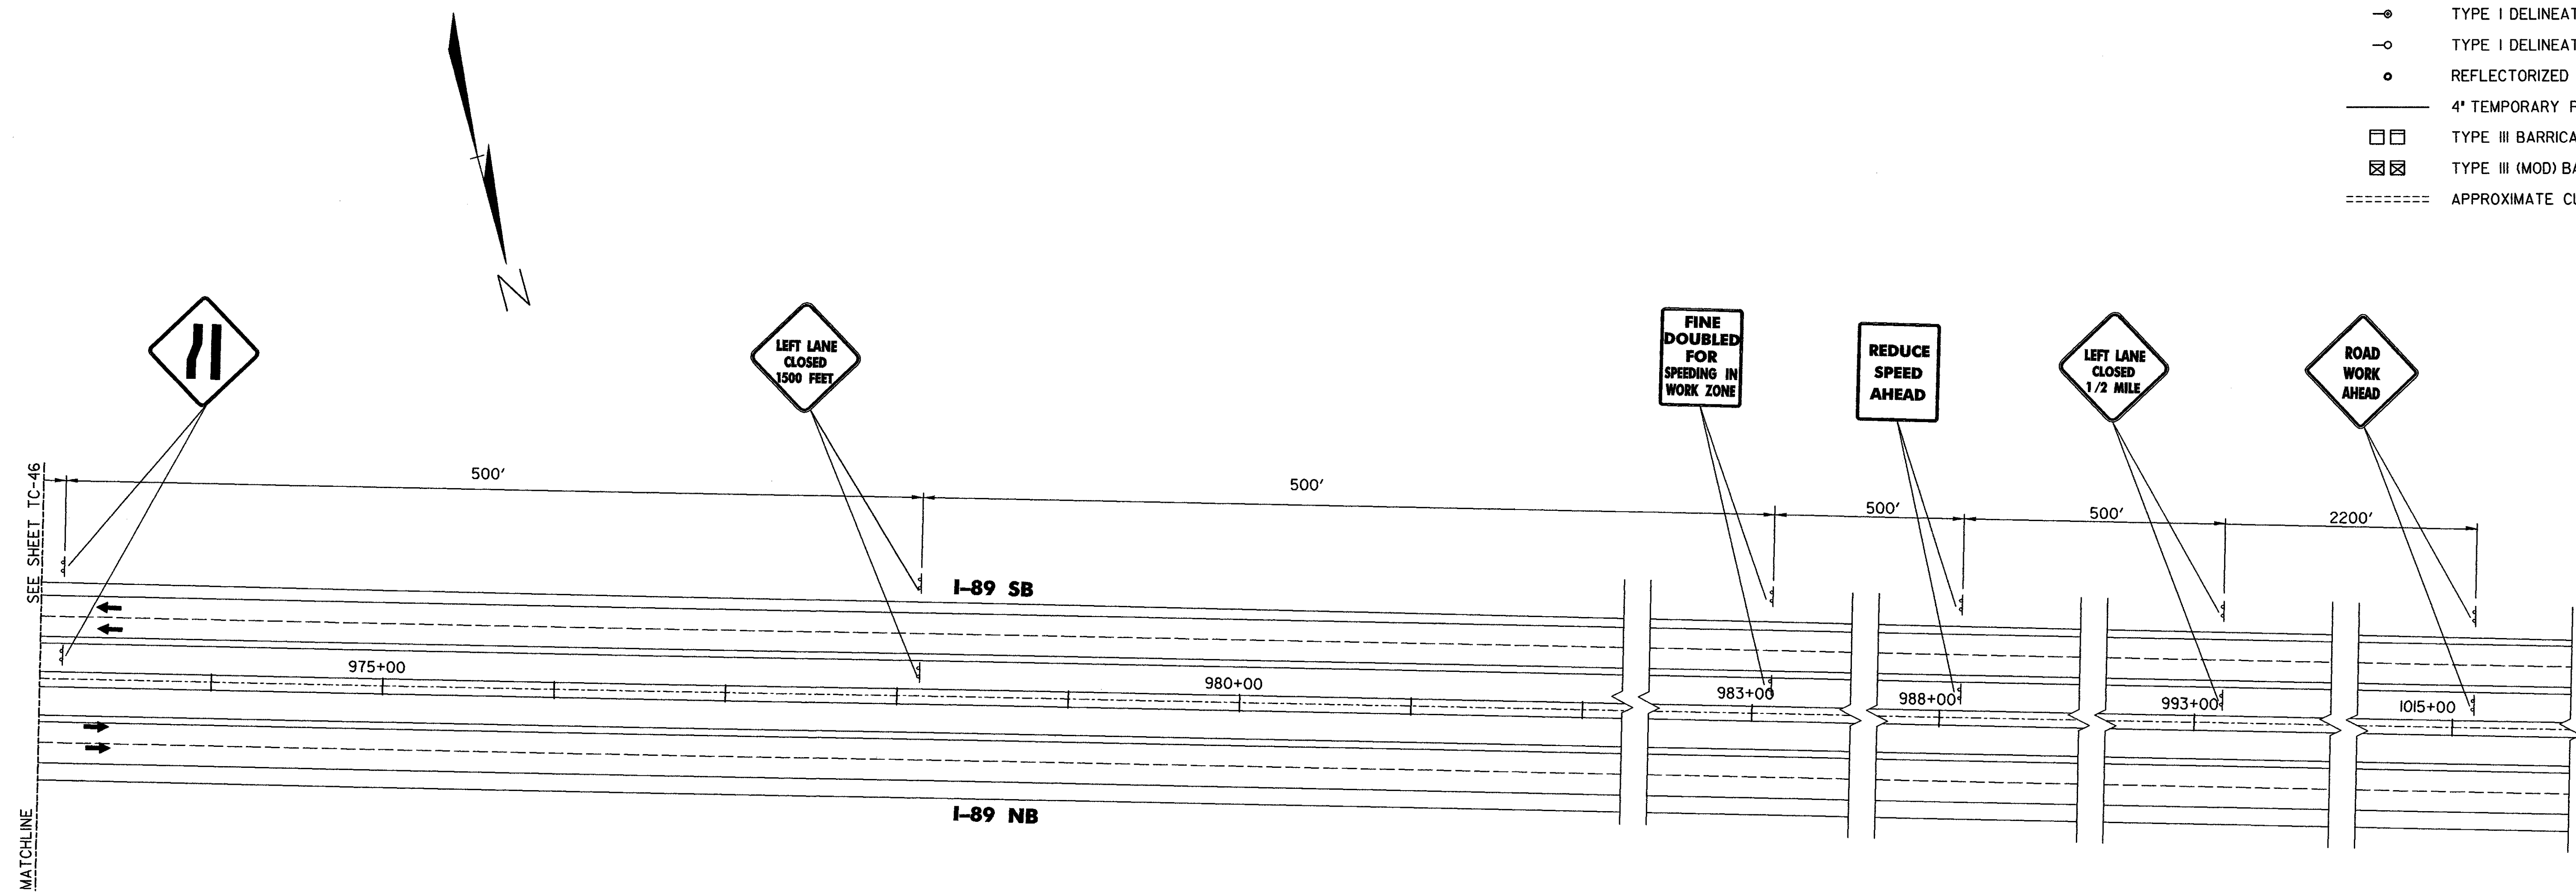






SEE SHEET TC-46  
MATCHLINE

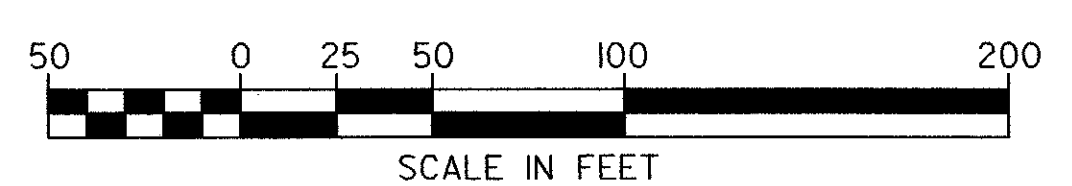

**STATE OF VERMONT  
AGENCY OF TRANSPORTATION**

Town Of	MIDDLESEX-BOLTON	Bridge No.	<b>48, 49, 50</b>
Highway No.	I-89	Log Sta.	
		Surv. Sta.	
<b>PHASE II CONSTRUCTION I-89 NORTHBOUND CROSSOVER</b>			
<b>BRIDGES 48, 49, 50</b>			
Designed By	J.M.SMYRSKI/K.S.MARSHIA	Drawn By	S.E.SCHMITT
Checked By	Date	Bridge Design Supervisor	
J.W.TUCKER	10/99	J.P.HALSTEAD	Date 10/99
PROJECT	MIDDLESEX-BOLTON	PROJECT NO.	IM-089-2(26)
Drawing No.	...48-49-50-nb.dgn	Date	OCT 1999
Bridge Sheet No.	TC-47	Sheet	207 of 307

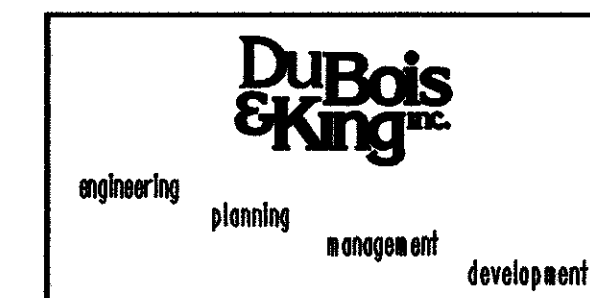

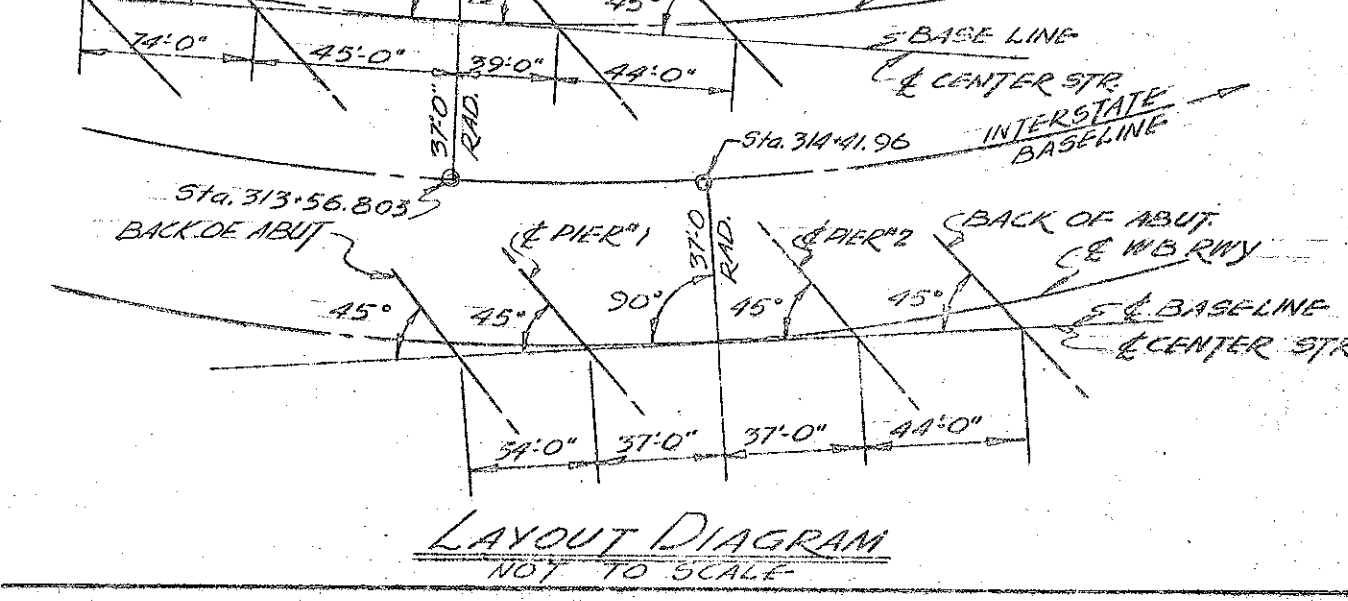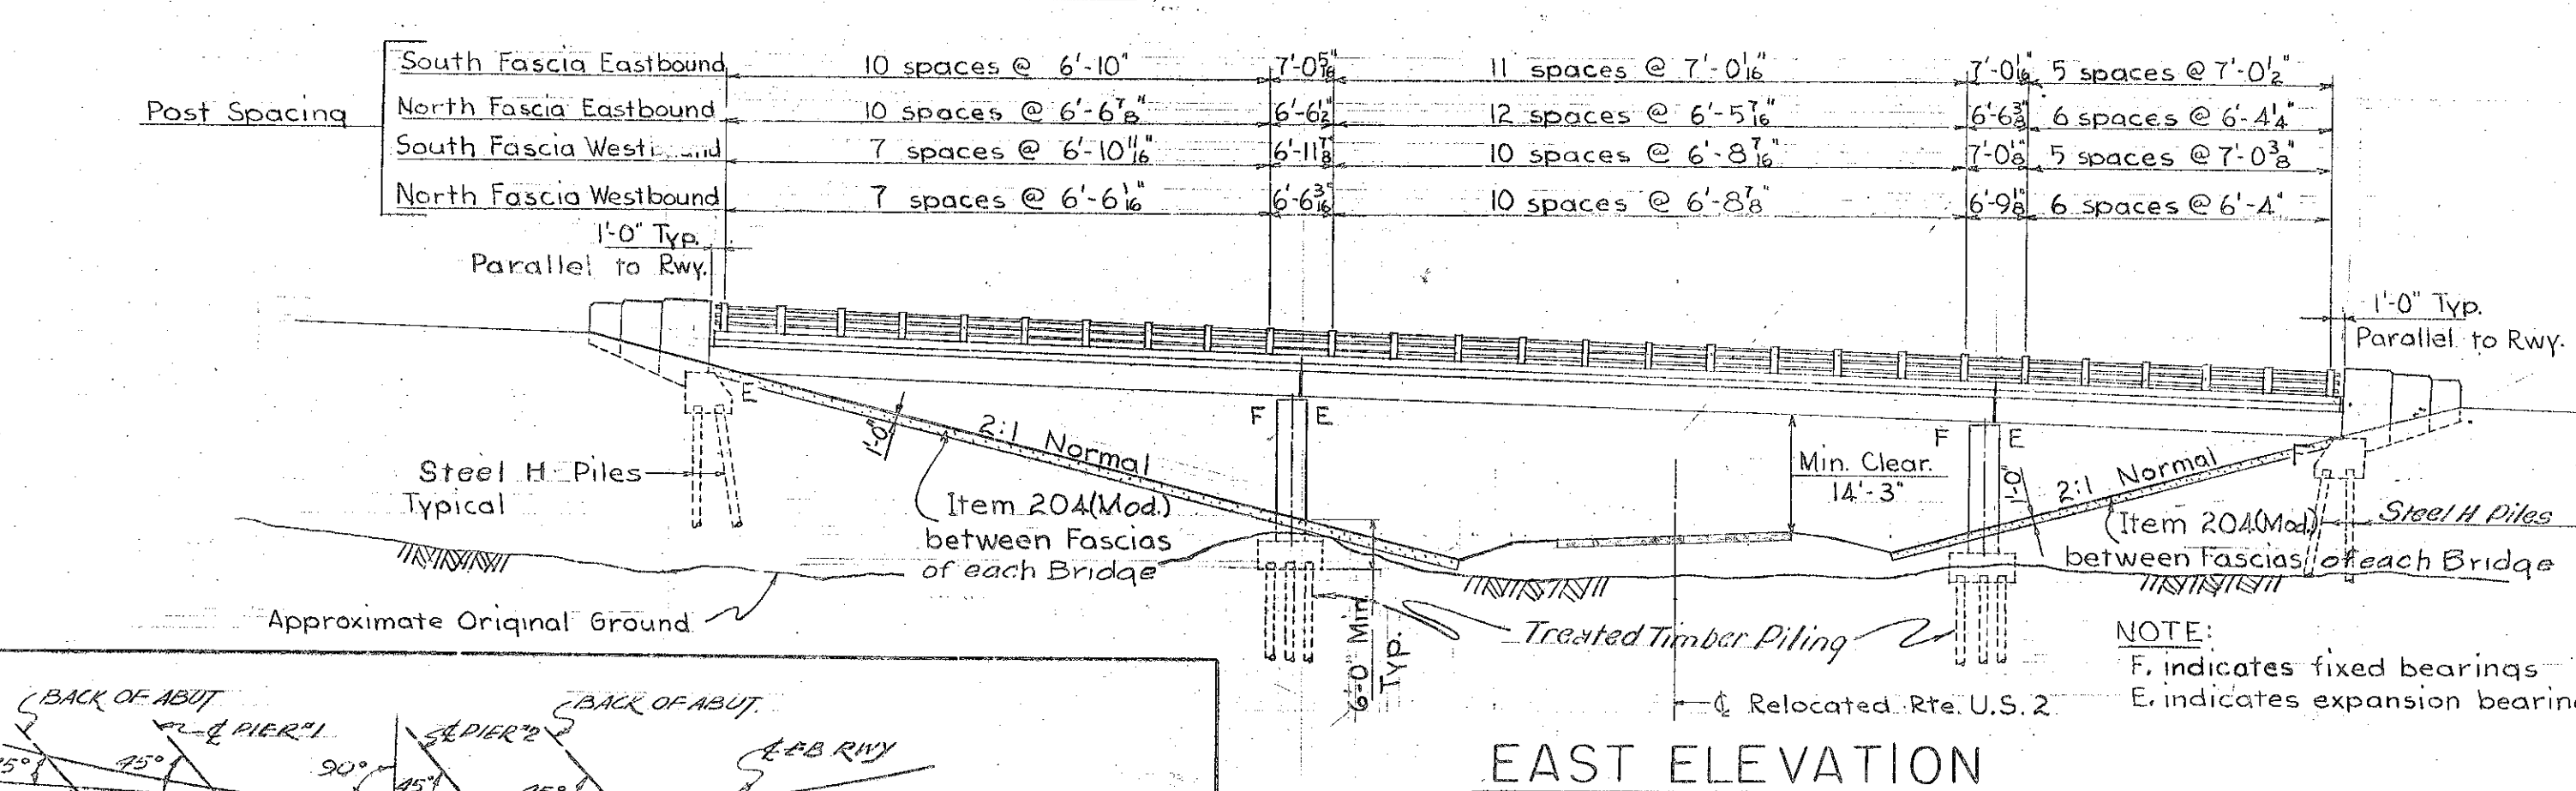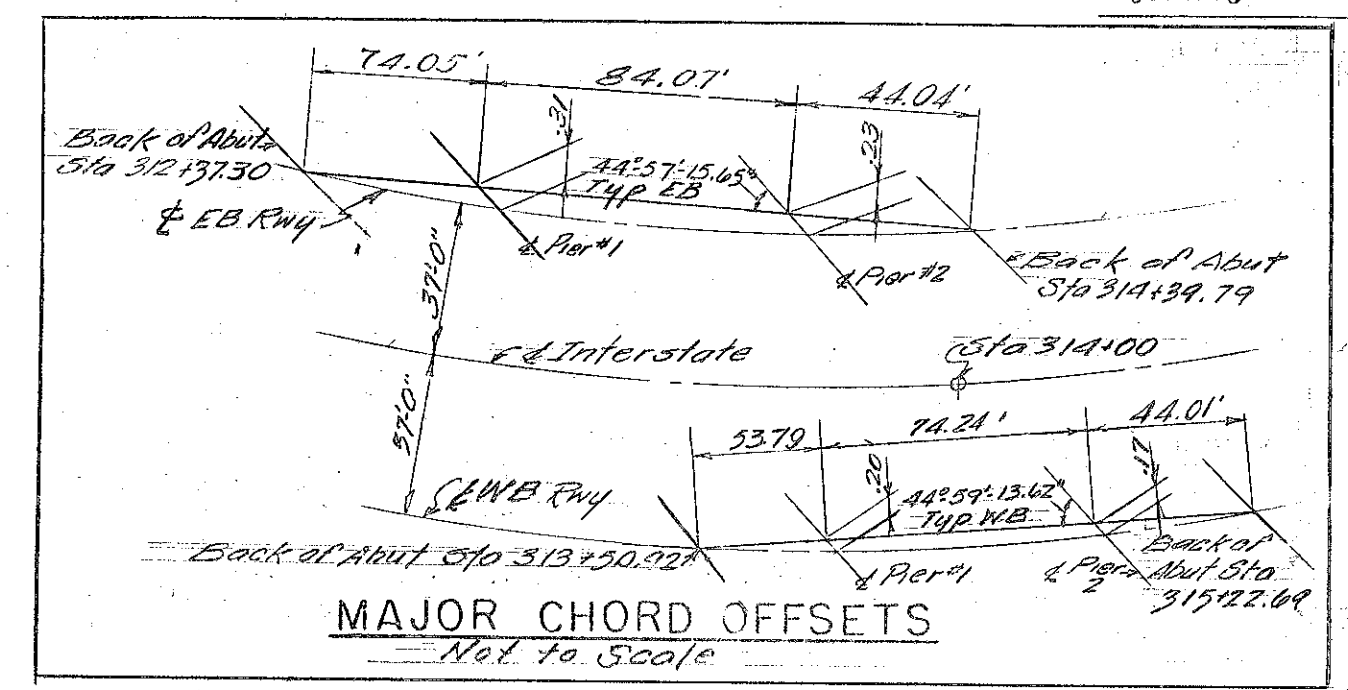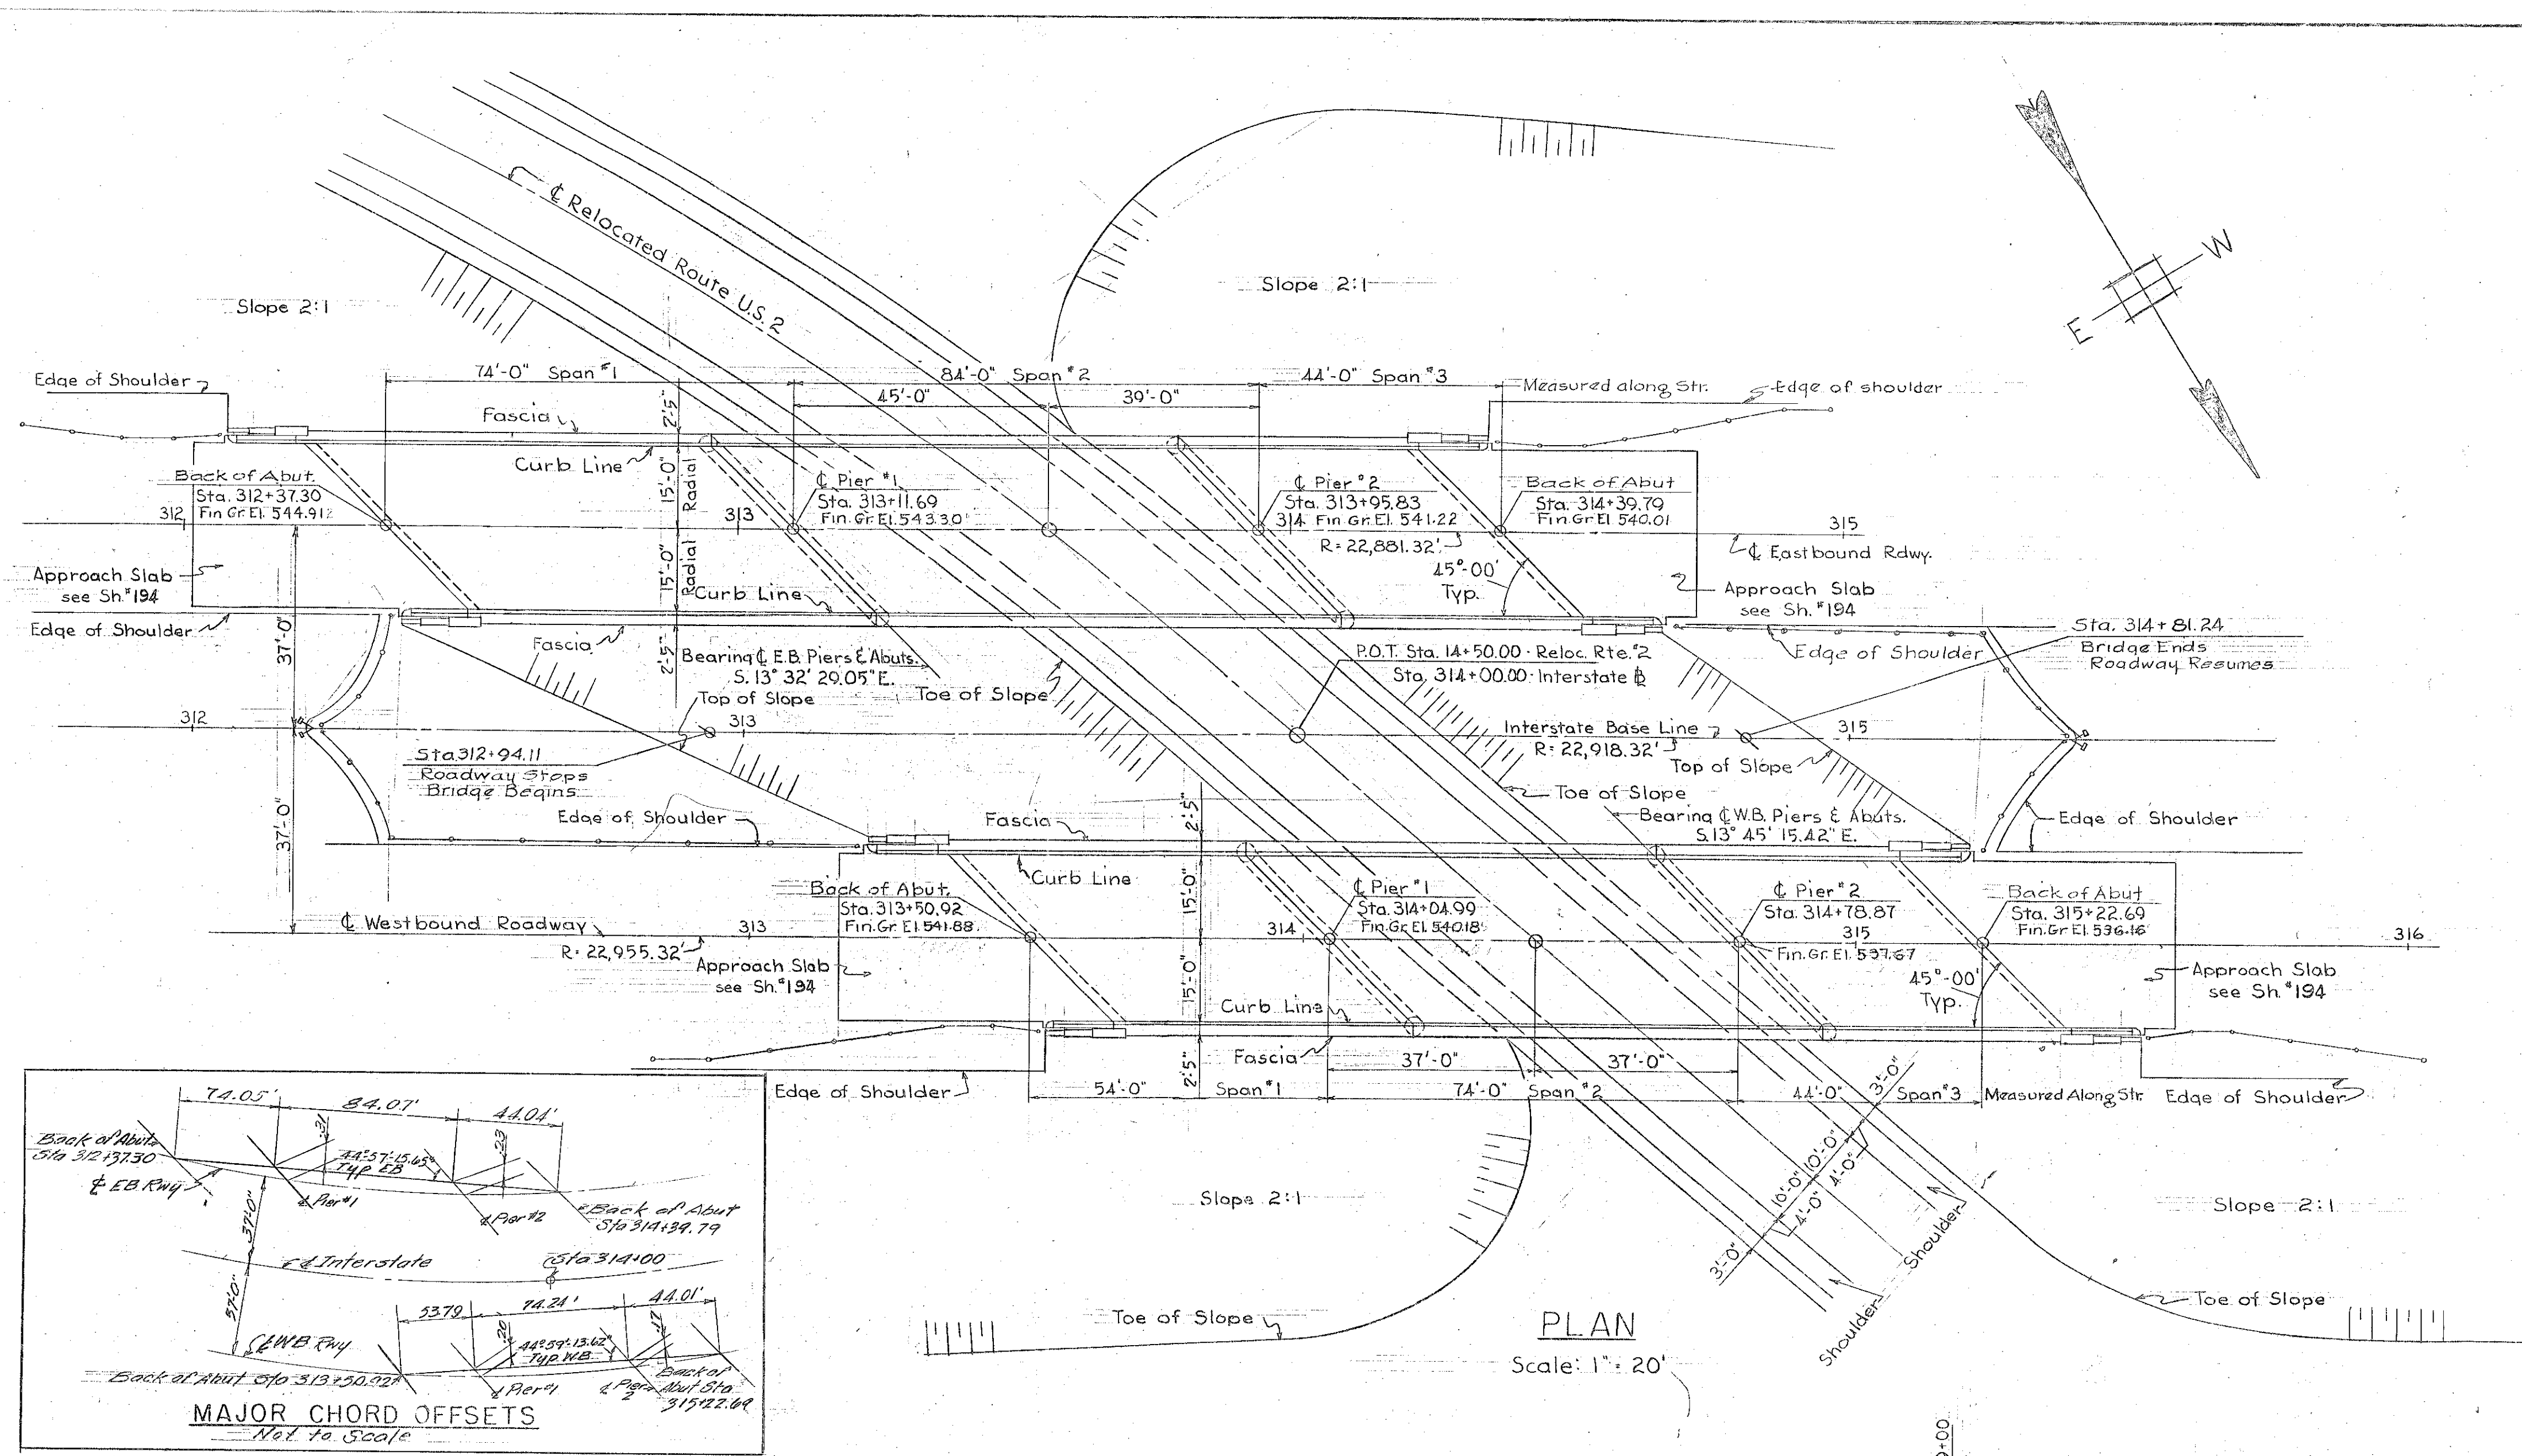

ESTIMATE OF QUANTITIES					
ITEM	DESCRIPTION	UNIT	QUANTITY		
			EASTBOUND	WESTBOUND	
107	STRUCTURE EXCAVATION	C.Y.	70	108	
204	SUB-BASE OF CRUSHED ROCK (MOD)	C.Y.	195	156	
361B	BIT. CONCRETE PAV'T. (incl. Approach Slab) Mod Ten	Sq Yd	101	104	
401B	CLASS "B" CONC. (MOD) (incl. Approach Slab)	C.Y.	626	624	
402	REINFORCING STEEL (incl. Approach Slab)	LB.	99,190	92,721	
403	SPIRAL REINFORCEMENT (6300 LBS)	L.S.			
404A	STRUCTURAL STEEL	LB.	242,513	168,200	
502B	TREATED TIMBER PILING	L.F.	3040	2800	
556C	GRANITE BRIDGE CURB (incl. Approach Slab)	L.F.	447	387	
572	BRIDGE RAILING	L.F.	391	330	
407	ASPHALTIC ASBESTOS COATING	S.Y.	100	104	
1504	STEEL PILING (10 BP 42)	L.F.	1875	2550	
501	Furnishing Equip. for Driving Piles	L.S.			
576	Preparing Existing Pav. for New Wearing Surf.	S.Y.	2700	2700	

**GENERAL NOTES**

- All materials and construction shall conform to the State of Vermont Dept. of Highways, Standard Specifications for Road and Bridge Construction dated Jan. 1956 and the AASHTO Std. Specifications dated 1953. Designed for H20-516-44 loading modified for National System of Interstate Highways applied in accordance with the provisions of the AASHTO Standard Specifications, Art. 3.2.8.
- All beams shall be rolled to a true circular camber, full length, and the middle ordinate to be as shown on contract plans.
- Final coat of field paint shall be black unless otherwise directed by the Engineer.
- All stations referred to Interstate Base Line between the two Roadways.
- All dimensions given are measured horizontally or vertically unless noted.
- All reinforcing to have a clear cover of 3" unless noted.
- All exposed edges of concrete shall be chamfered 1"x1" unless noted.
- Borings indicated on the drawings have been made for design purposes only and are not warranted to show actual subsurface conditions.
- Elevation Datum Sea Level based on Bench Line U.S.C.G.S. Survey Level Line Vermont 25 (Second Order).
- Where piles are driven in fill, the material shall be such as to have no stones large enough to interfere with the driving of piles.
- Cross slope of approach slab to conform with cross slope of roadway.
- Piles shall not be spliced without the written approval of the engineer.
- The top surfaces of all piers and abutments shall be sloped 1/4" per foot from the back edge of abutments or the centerline of piers except for bearing pads projecting 1" or more above the general area; which surfaces shall be level. These sloping surfaces shall be coated with asphaltic asbestos coating, 1/2" thick as per Item 407 of Specifications, and rounded up against the pads.
- Where rock is encountered, no footings shall be poured until all blasting in the adjacent area has been completed.
- All bearing elevations, of abutments and piers, have been lowered 1/2" to compensate for excessive camber rolled in beams at the mill.

**LIST OF DRAWINGS**

General Plan & Elevation	Sh. #136
Eastbound Framing & Reinf. Plan	Sh. #137
Westbound Framing & Reinf. Plan	Sh. #138
Eastbound Pier Details	Sh. #139
Westbound Pier Details	Sh. #140
Eastbound Abutment Details	Sh. #141
Westbound Abutment Details	Sh. #142
Bar Schedule	Sh. #143
Boring Logs	Sh. #144
Approach Slab (SB:RS-45-47) Mod. to fit	Sh. #194
Structure Details 'A'	Sh. #197
Structure Details 'B'	Sh. #198
Structure Details 'C'	Sh. #199

**REFERENCE DRAWINGS**

Plan & Profile	Sh. #37 & 38
Plan & Profile - U.S. #2 Relocation	Sh. #62 & 63


IM 089-2(26)  
This sheet for information only  
**BR 43 N & S**

STATE OF VERMONT  
DEPARTMENT OF HIGHWAYS

INTERSTATE PROJECT in the towns of  
BERLIN - MONTPELIER - MIDDLESEX  
**OVERPASS STA. 314+00 STRUCTURE #4**  
**GENERAL PLAN & ELEVATION**

BOSWELL ENGINEERING CO.  
CONSULTING ENGINEERS  
RIDGEFIELD PARK, N.J.


SUBMITTED BY: Y.T. CHECKED BY: R.G.C.  
DRAWN BY: A.B. IN CHARGE: R.G.C.  
PROJECT NO. 189-2-131 SHEET 215 OF 307

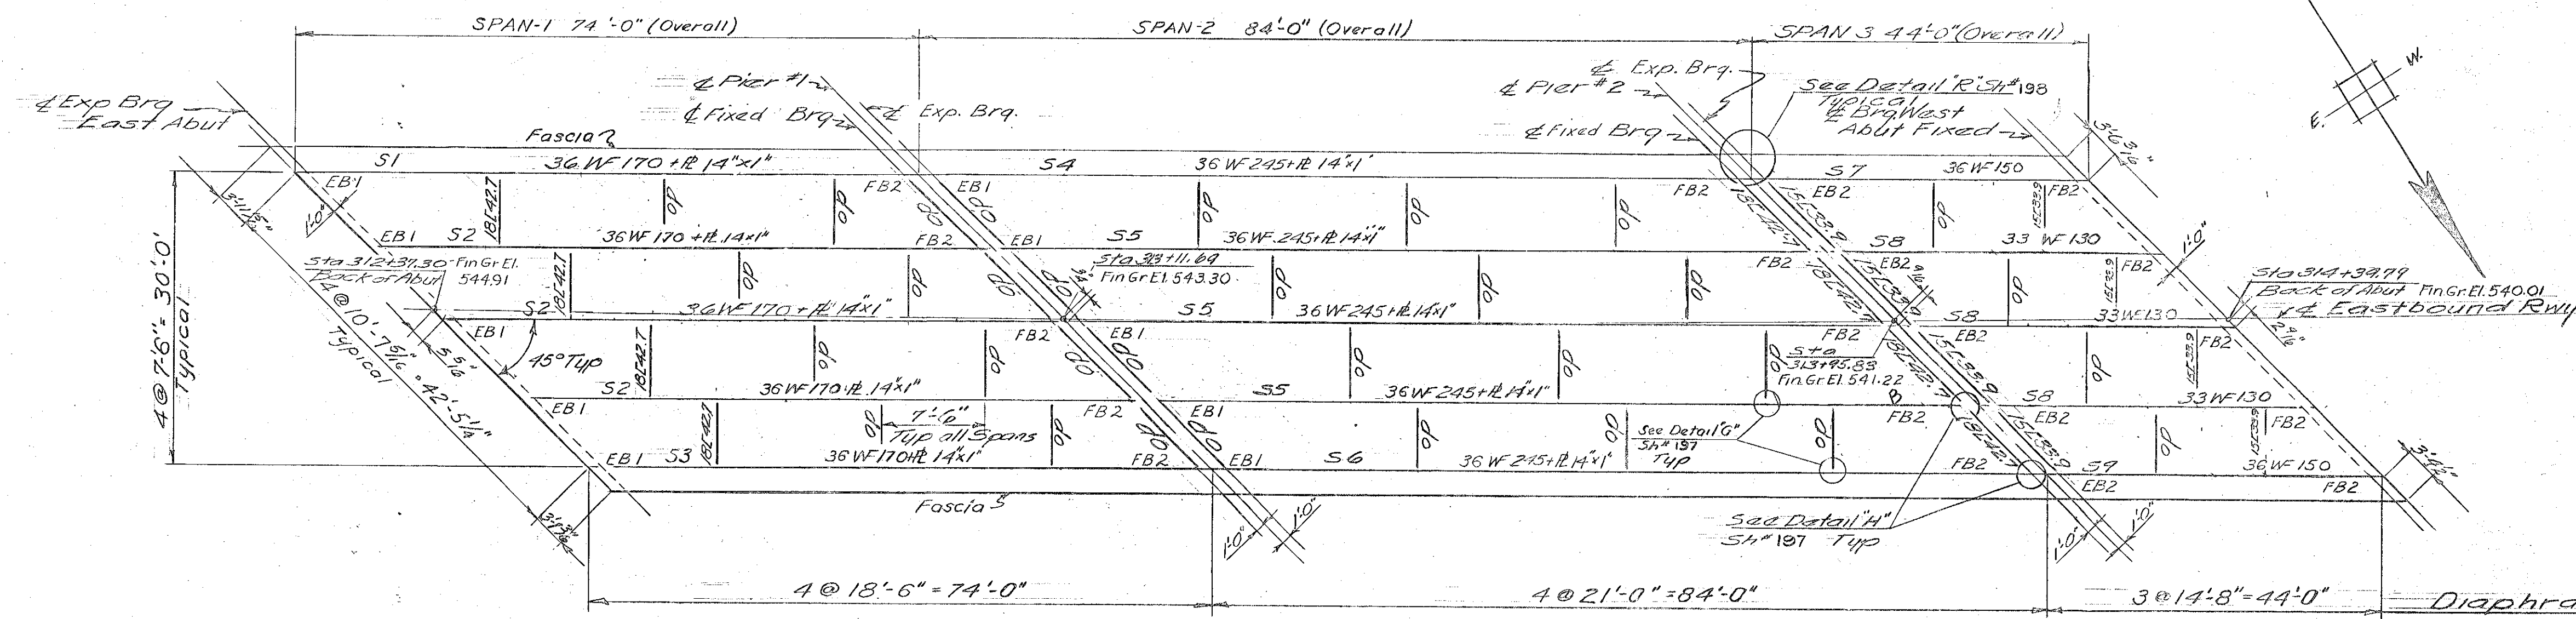

FRAMING PLAN  
 Scale 3/32" = 1'-0"

ESTIMATE of QUANTITIES

ITEM	DESCRIPTION	UNIT	NEAT	ROUND
401B	Class B Concrete (Mod)	CY	222	233
402	Reinforcing Steel	LB	42,223	42,269
403	Spiral Reinforcement (3950 LB)	LB		
404A	Structural Steel	LB	242,543	247,100
361B	Bit. Concrete Part	T	75	87
556C	Granite Bridge Curb	LF	407	
572	Bridge Railing	LF	341	

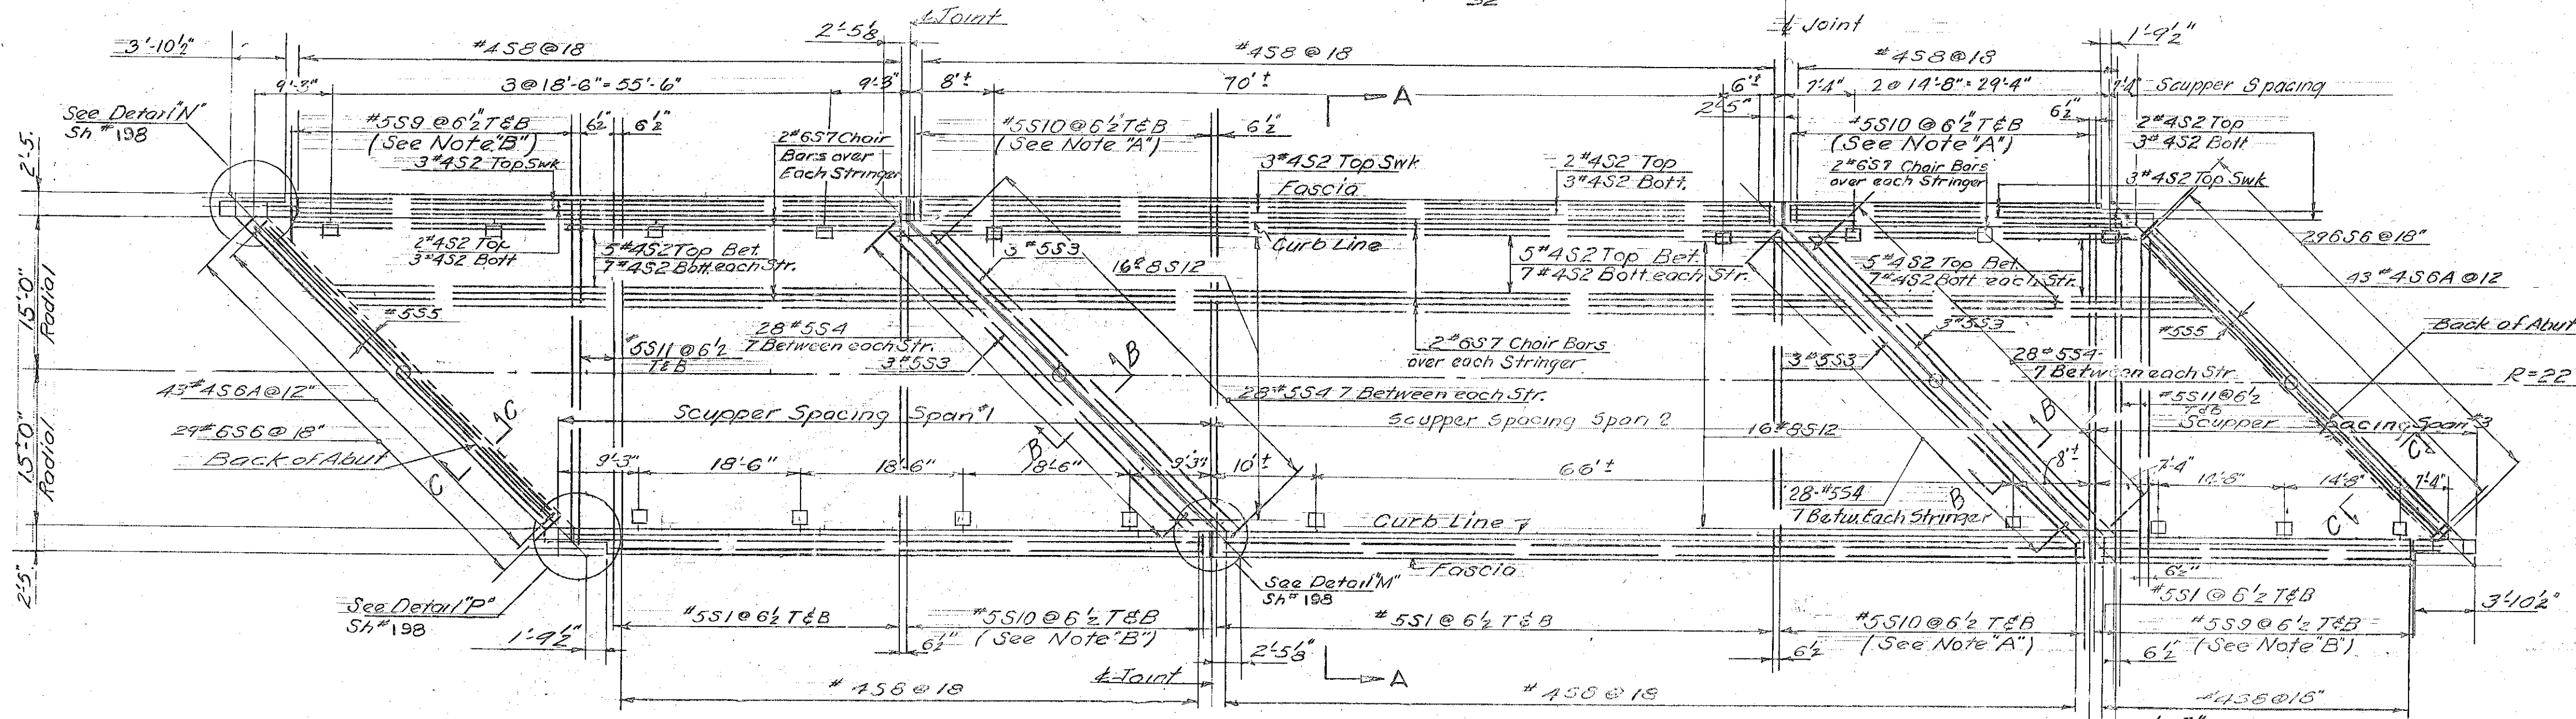


REINFORCING PLAN  
 Scale 3/32" = 1'-0"

- NOTE:
1. For General Notes see Sh. #136
  2. For Bearing Devices see Detail S Sh. #197
  3. For Cover Plates see Detail A Sh. #197
  4. For Scuppers see Detail B Sh. #197
  5. For Spiral Welds see Detail L Sh. #197
  6. For Curb see Detail S Sh. #198
  7. For Section A-A see Sh. #198
  8. For Section B-B see Sh. #198
  9. For Section C-C see Sh. #198
  10. For Bridge Railing see Detail S Sh. #198
  11. Scupper Spacing may be changed in field by the Engineer
  12. For Alternate Bridge Railings See Sh. #199

STRINGER SCHEDULE

STRINGER MARK	NO. REQD	DIST G-C BEARINGS	LENGTH OF BEAM	LENGTH BOTTOM COVER #	D.L. Δ	SPIRALS				
						P1	P2	P3	P4	P5
S1	1	71'-2"	73'-3"	51'-9"	1 1/2"	2 3/4"	4"	5 1/2"	8"	13"
S2	3	71'-2"	72'-3"	51'-9"	1 1/2"	2 3/4"	4"	5 1/2"	8"	13"
S3	1	71'-2"	73'-3"	51'-9"	1 1/2"	2 3/4"	4"	5 1/2"	8"	13"
S4	1	81'-2"	83'-10"	51'-10"	2 1/4"	3 1/2"	4"	5"	7"	10" 16"
S5	3	81'-2"	82'-8"	51'-10"	2 1/4"	3 1/2"	4"	5"	7"	10" 18"
S6	1	81'-2"	83'-10"	51'-10"	2 1/4"	3 1/2"	4"	5"	7"	10" 16"
S7	1	41'-2"	43'-3"		3/8"	3/8"	5"	8"		8"
S8	3	41'-2"	42'-8"		3/8"	3/8"	5"	8"		8"
S9	1	41'-2"	43'-3"		3/8"	3/8"	5"	8"		8"

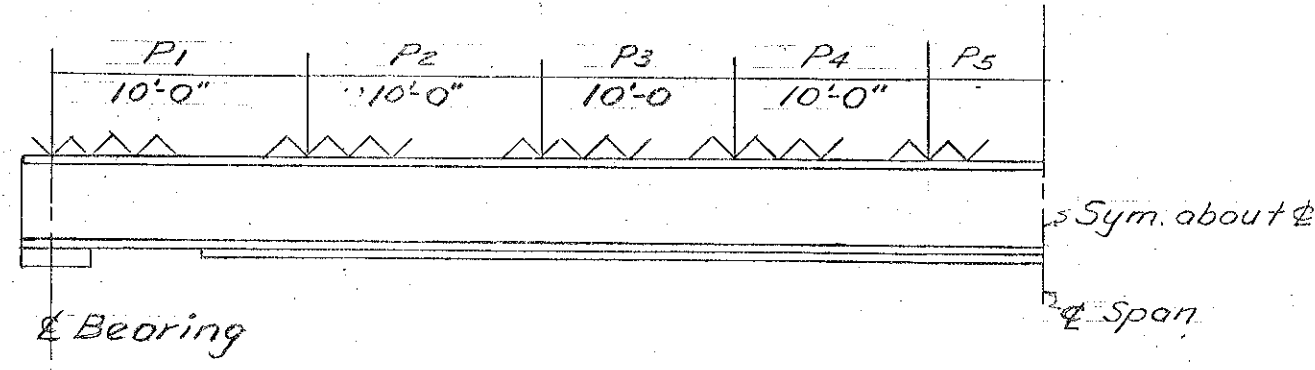

SPIRAL PITCH

NOTE A - S10 Bars vary from 2'-3" to 32'-3" in 6'-2" increments (5 of each size req'd)  
 NOTE B - S9 Bars vary from 3'-9" to 32'-2" in 6'-2" increments (4 of each size req'd)

IM 089-2(26)  
 This sheet for information only  
**BR 43 N & S**

STATE OF VERMONT  
 DEPARTMENT OF HIGHWAYS


INTERSTATE PROJECT in the towns of  
 BERLIN - MONTPELIER - MIDDLESEX

OVERPASS STA. 314+00 STRUCT. #4  
**EASTBOUND FRAMING & REINFORCING PLAN**


NOSWELL ENGINEERING CO.  
 CONSULTING ENGINEERS  
 RIDGEFIELD PARK, N.J.

SURVISED BY: VIT  
 DRAWN BY: RAB  
 CHECKED BY: A.J.L.  
 IN CHARGE: RA  
 SCALE: AS SHOWN  
 DATE: AUG. 1957

PROJECT NO. 199-2(3) SHEET 216 OF 307

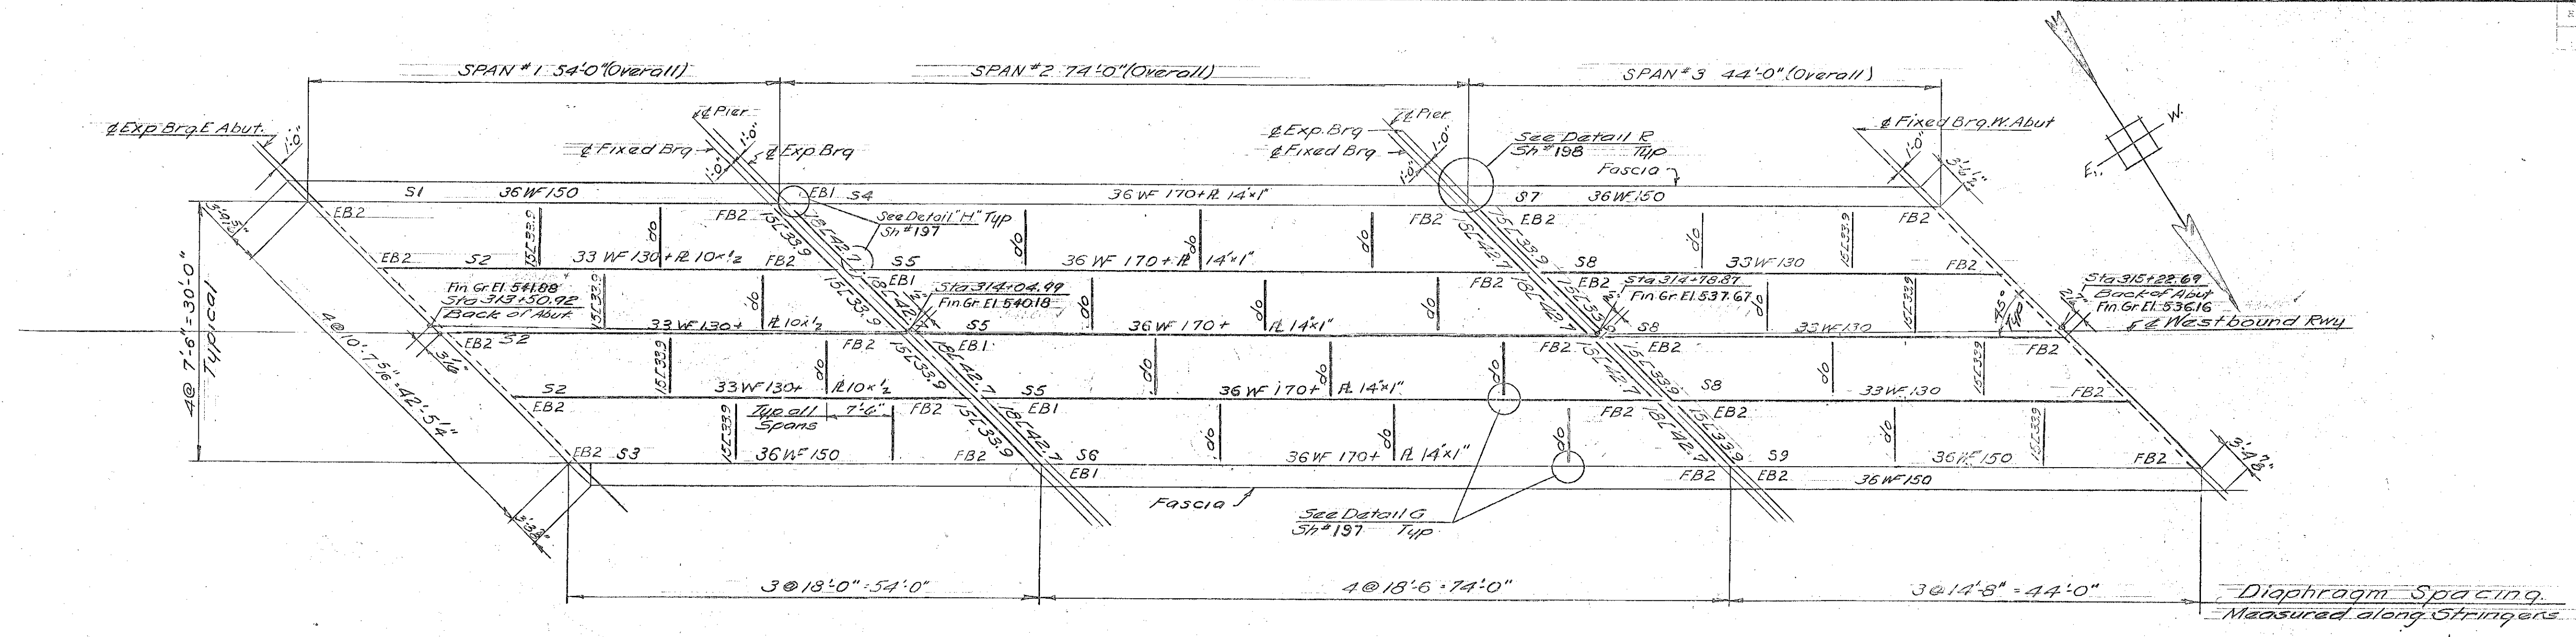


FRAMING PLAN  
Scale 3/32" = 1'-0"

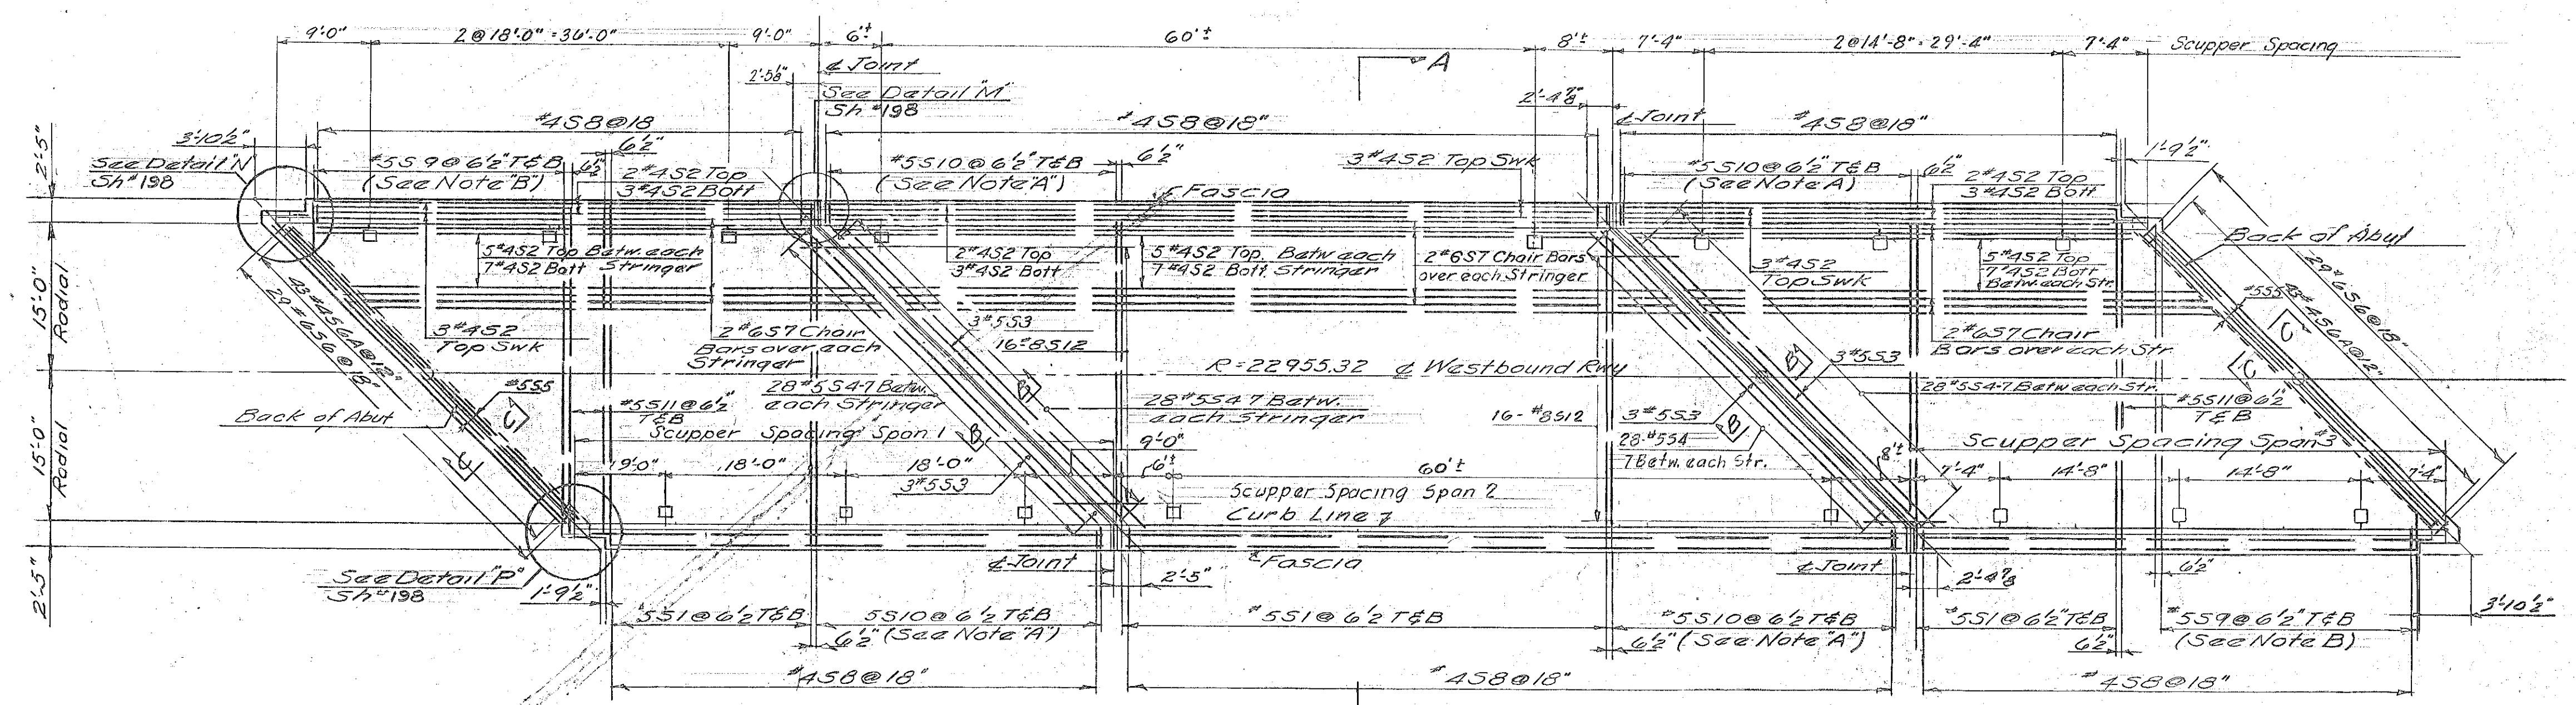

REINFORCING PLAN  
Scale 3/32" = 1'-0"

- NOTE:**
1. For General Notes see Sh.#136
  2. For Bearing Devices and Anchor Bolts see Detail 'E' Sh.#197
  3. For Cover Plates see Detail 'A' Sh.#197
  4. For Scuppers see Detail 'B' Sh.#197
  5. For Spiral Welds see Detail 'S' Sh.#197
  6. For Curbs see Details '5' Sh.#198
  7. For Section 'AA' see Sh.#198
  8. For Section 'BB' see Sh.#198
  9. For Section 'CC' see Sh.#198
  10. For Bridge Railing see Details '5' & 'T' Sh.#198
  11. Scupper Spacing may be changed in the field by the Engineer.
  12. For Alternate Bridge Railing see Sh.#199

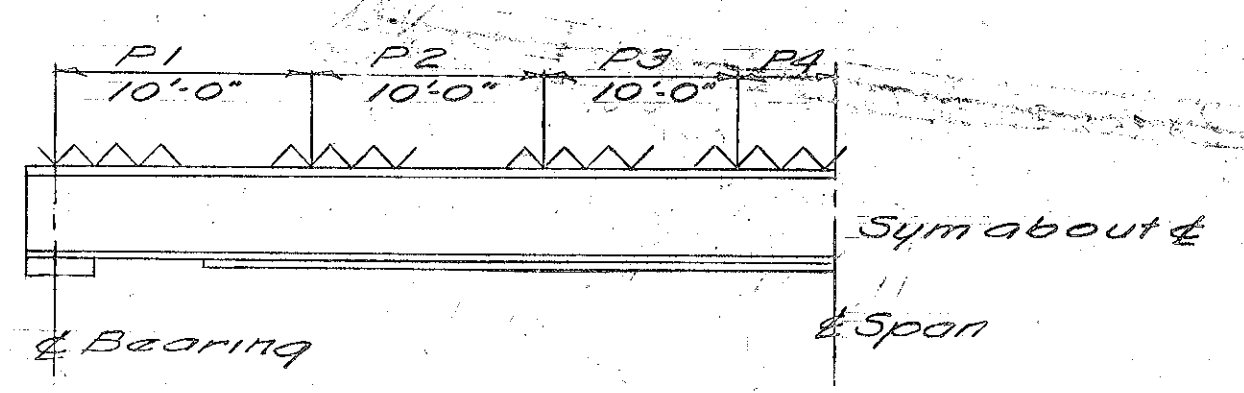

SPIRAL PITCH

STRINGER SCHEDULE									
Stringer Mark	No. Req'd	Dist. C-C Bearings	Length of Beam	Length of Bottom Cover Pl.	D.L. Δ	Spiral Pitch			
						P1	P2	P3	P4
S1	1	51'-2"	53'-3"	—	3"	1 1/2"	4"	6"	11 1/2"
S2	3	51'-2"	52'-5"	29'-3"	3"	1 1/2"	4"	6"	11 1/2"
S3	1	51'-2"	53'-3"	—	3"	1 1/2"	4"	6"	11 1/2"
S4	1	71'-2"	73'-10"	51'-9"	1 1/2"	2 1/2"	4"	5"	8"
S5	3	71'-2"	72'-8"	51'-9"	1 1/2"	2 1/2"	4"	5"	8"
S6	1	71'-2"	73'-10"	51'-9"	1 1/2"	2 1/2"	4"	5"	8"
S7	1	41'-2"	43'-3"	—	3"	1"	5"	8"	—
S8	3	41'-2"	42'-8"	—	3"	1 1/2"	5"	8"	—
S9	1	41'-2"	43'-3"	—	3"	1"	5"	8"	—

- NOTE:**
- A. S10 bars vary from 2'-3" to 32'-0" in 6'-0" increments (8 of each size req'd)
  - B. S9 bars vary from 3'-9" to 32'-0" in 6'-0" increments (4 of each size req'd)

**ESTIMATE OF QUANTITIES**

ITEM	DESCRIPTION	UNIT	NEAT	ROUND
401B	Class B Concrete (Mod)	CY	190	199
402	Reinforcing Steel	LB	36,866	36,555
403	Spiral Reinforcement (2950LB)	LB	—	—
401A	Structural Steel	LB	16,431	16,820
361B	Bit Concrete Pavement	T	64	74
596L	Granite Bridge curb	LF	347	—
912	Bridge Railing	LB	330	—

IM 089-2(26)  
This sheet for information only  
**BR 43 N & S**

STATE OF VERMONT  
DEPARTMENT OF HIGHWAYS

INTERSTATE PROJECT in the Towns of  
BERLIN - MONTPELIER - MIDDLESEX







**OVERPASS - STA 314+00 - STRUCT. #4**  
**WESTBOUND FRAMING & REINFORCING PLAN**

REG'N. ENGINEERING CO.  
CONSULTING ENGINEERS  
REGISTERED PROFESSIONAL ENGINEERS

SURVEYED BY: YIT  
DRAWN BY: RAE  
PROJECT NO.: 89-2-131

CHECKED BY: A.J.I.  
IN CHARGE: KA  
SHEET 217 OF 307


AS SHOWN  
AUG. 1957

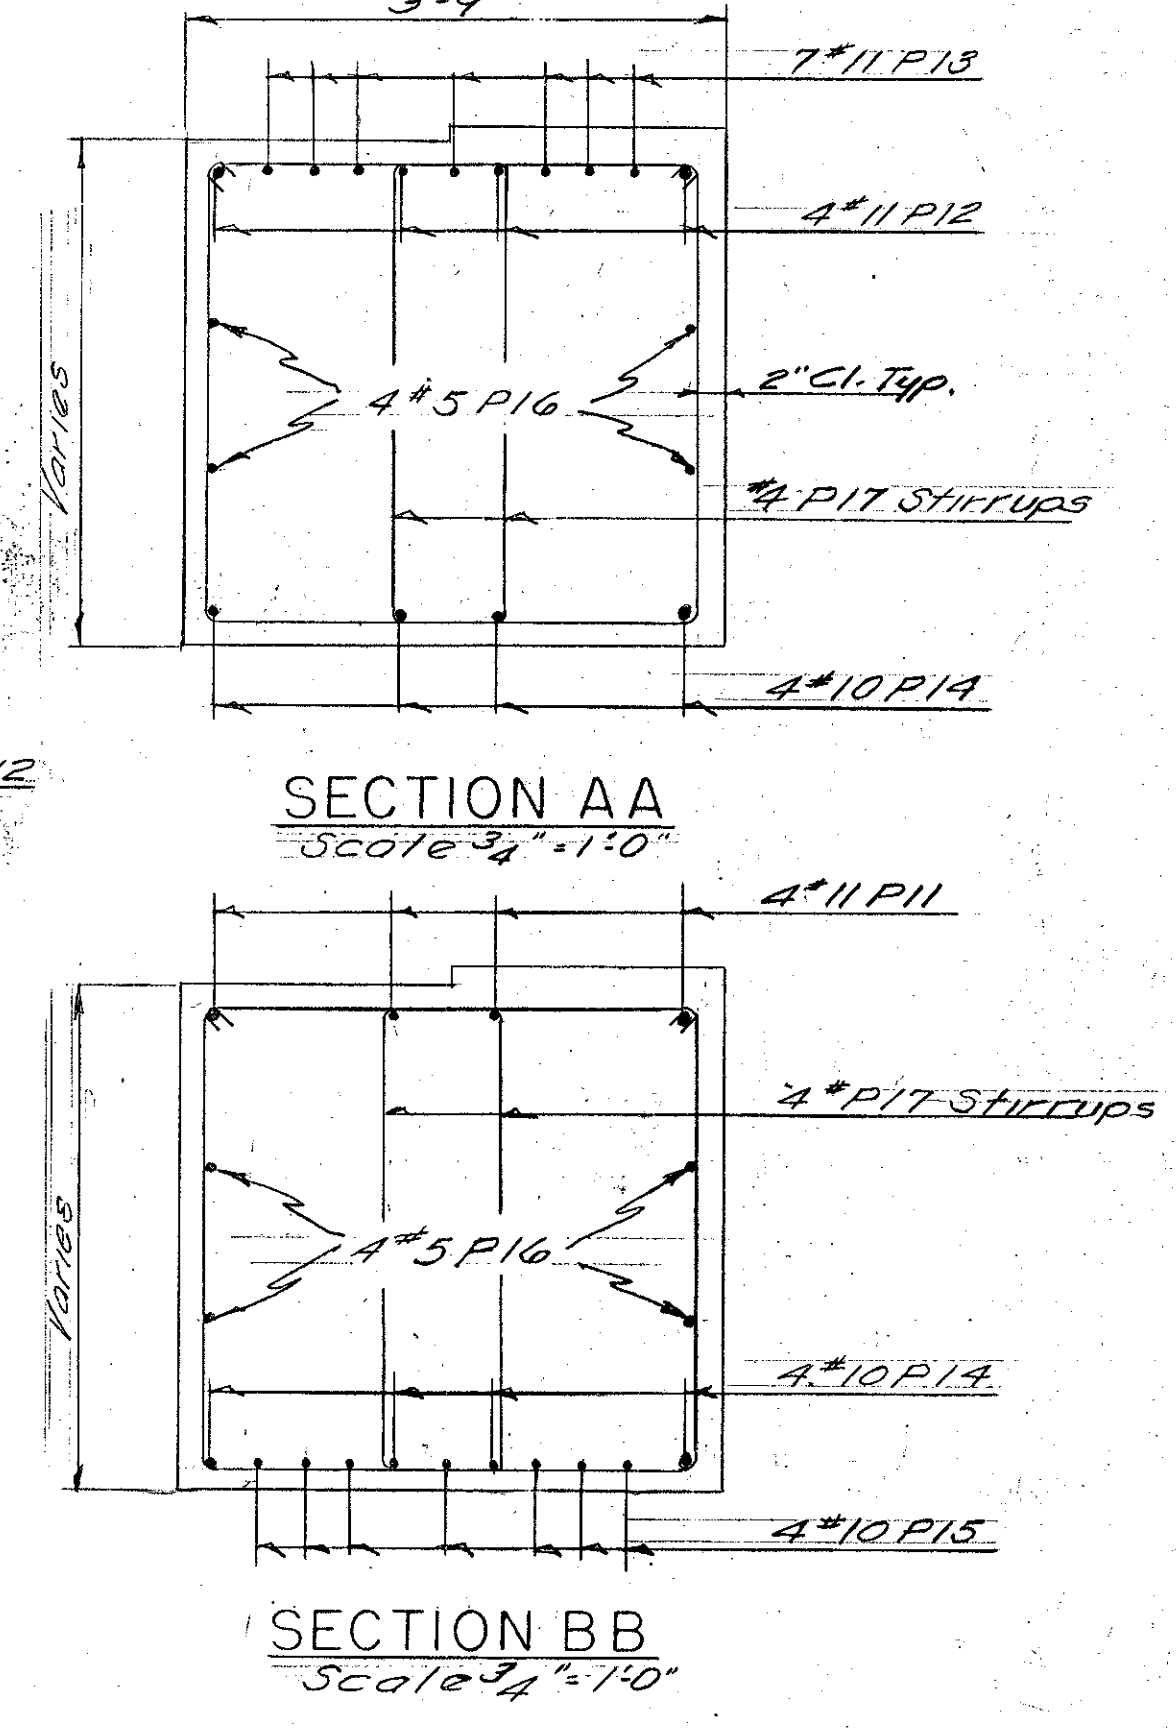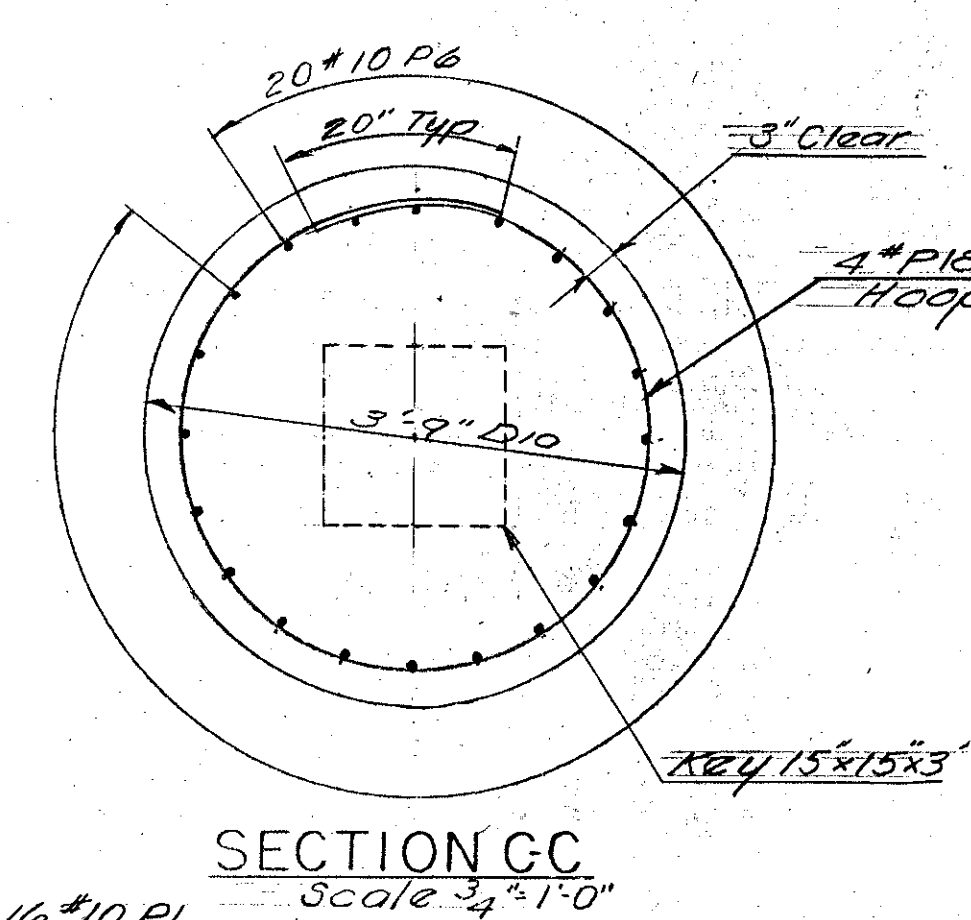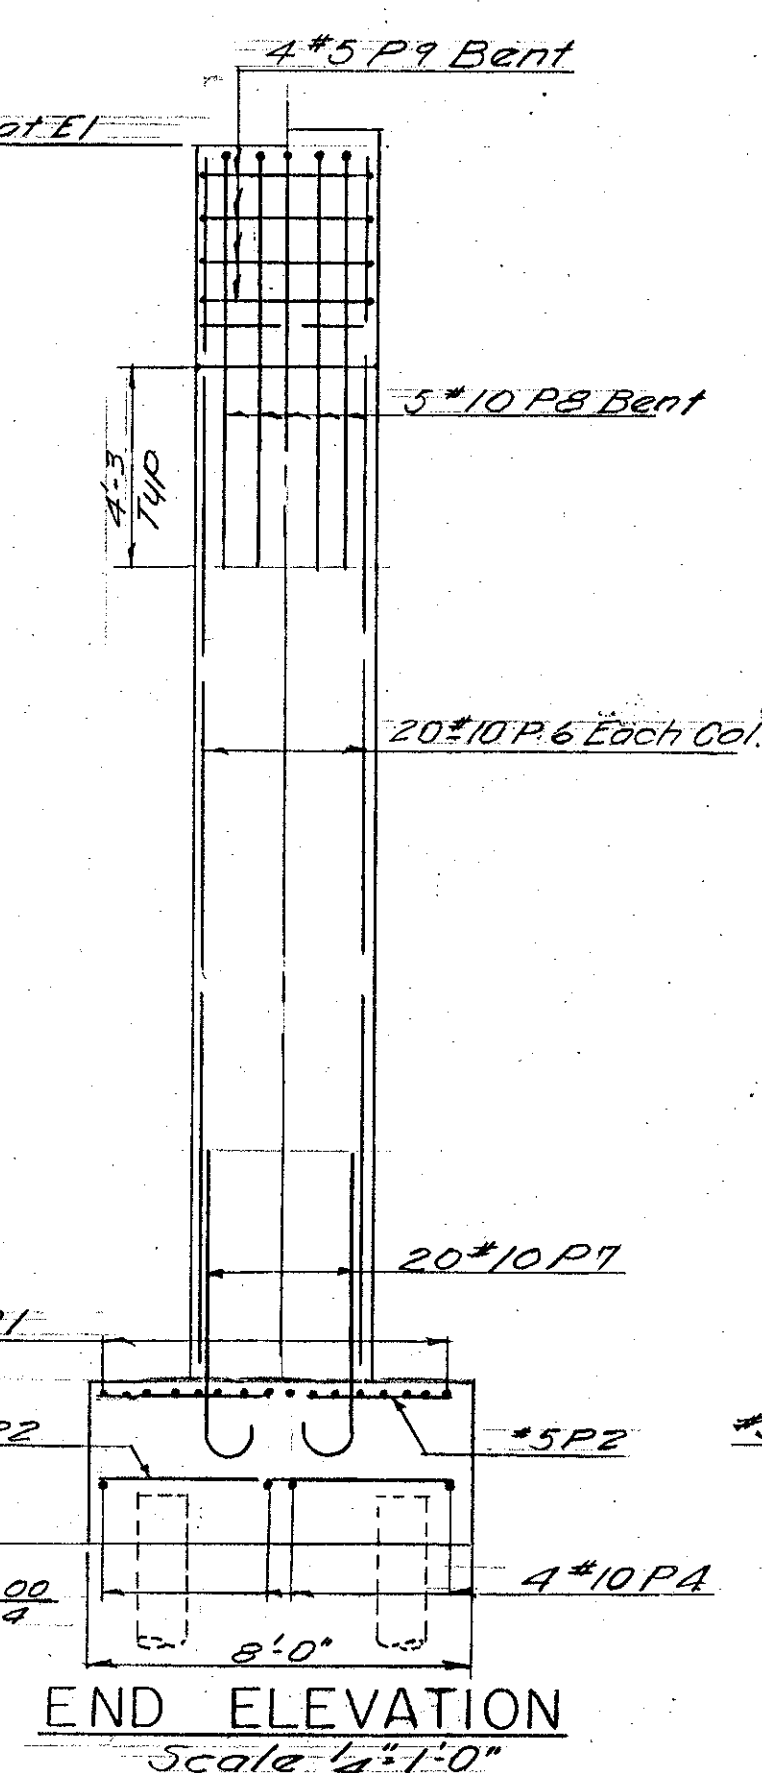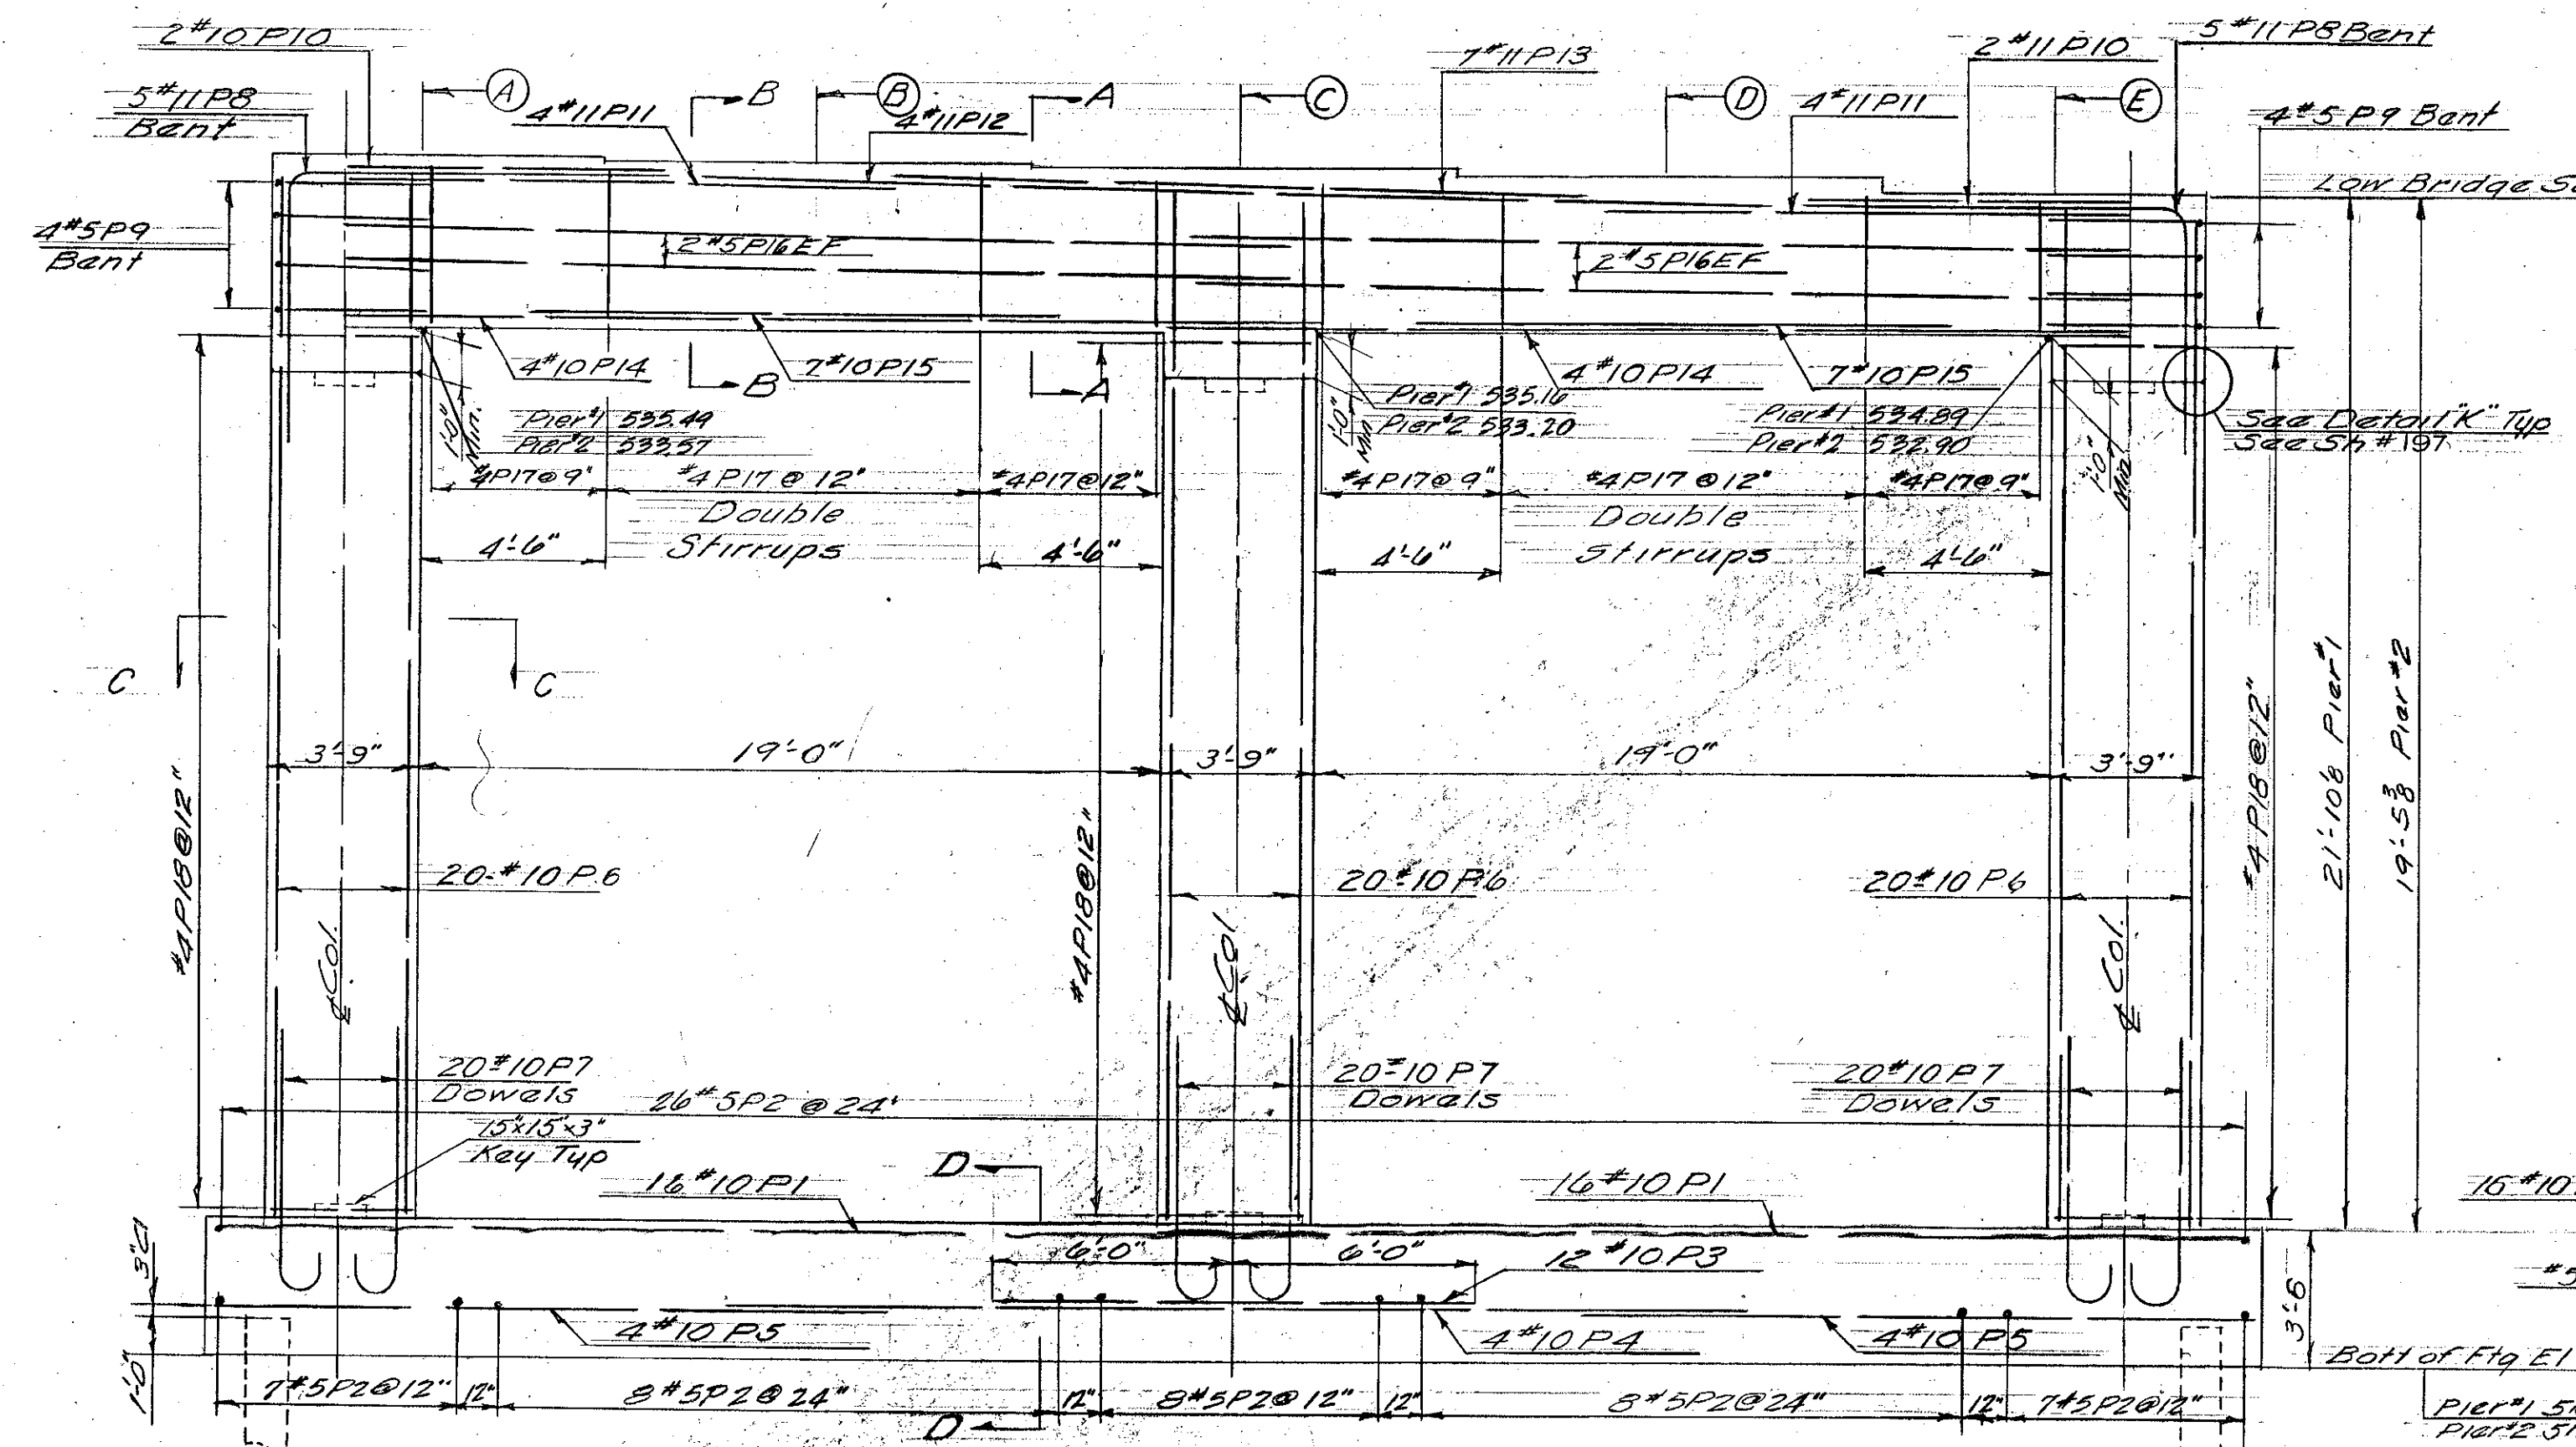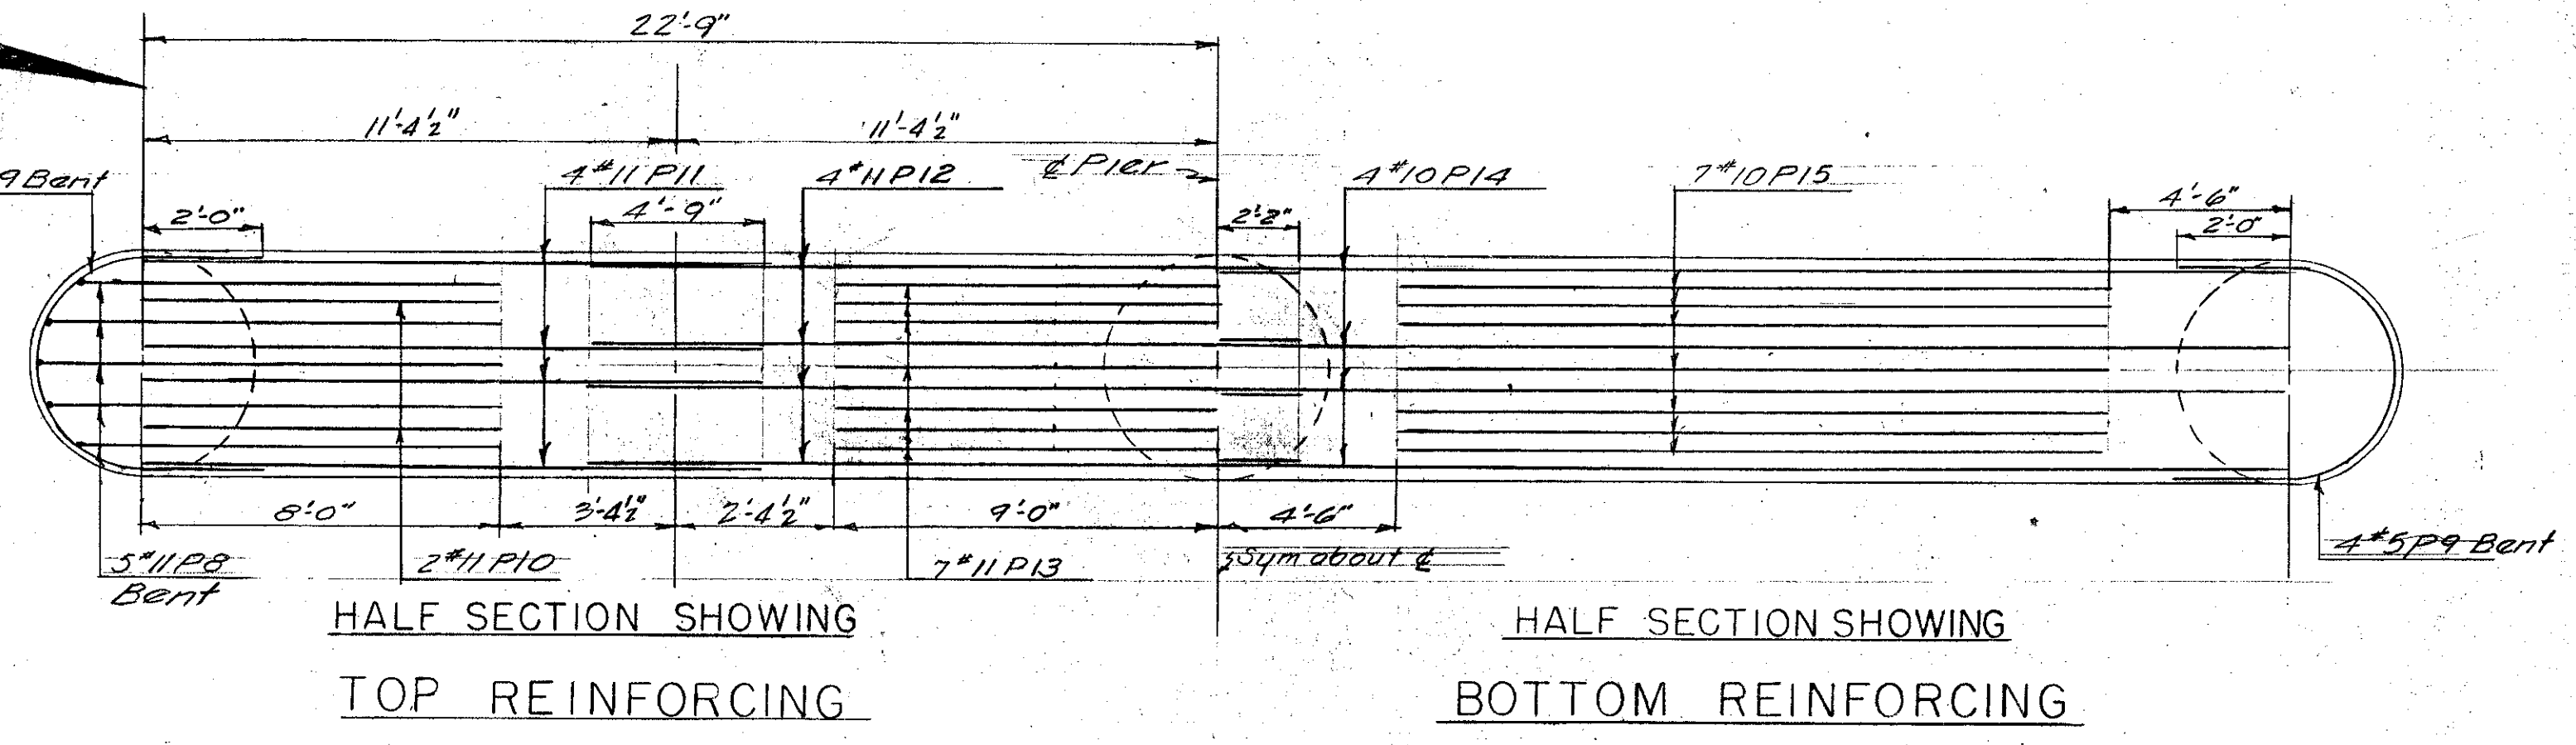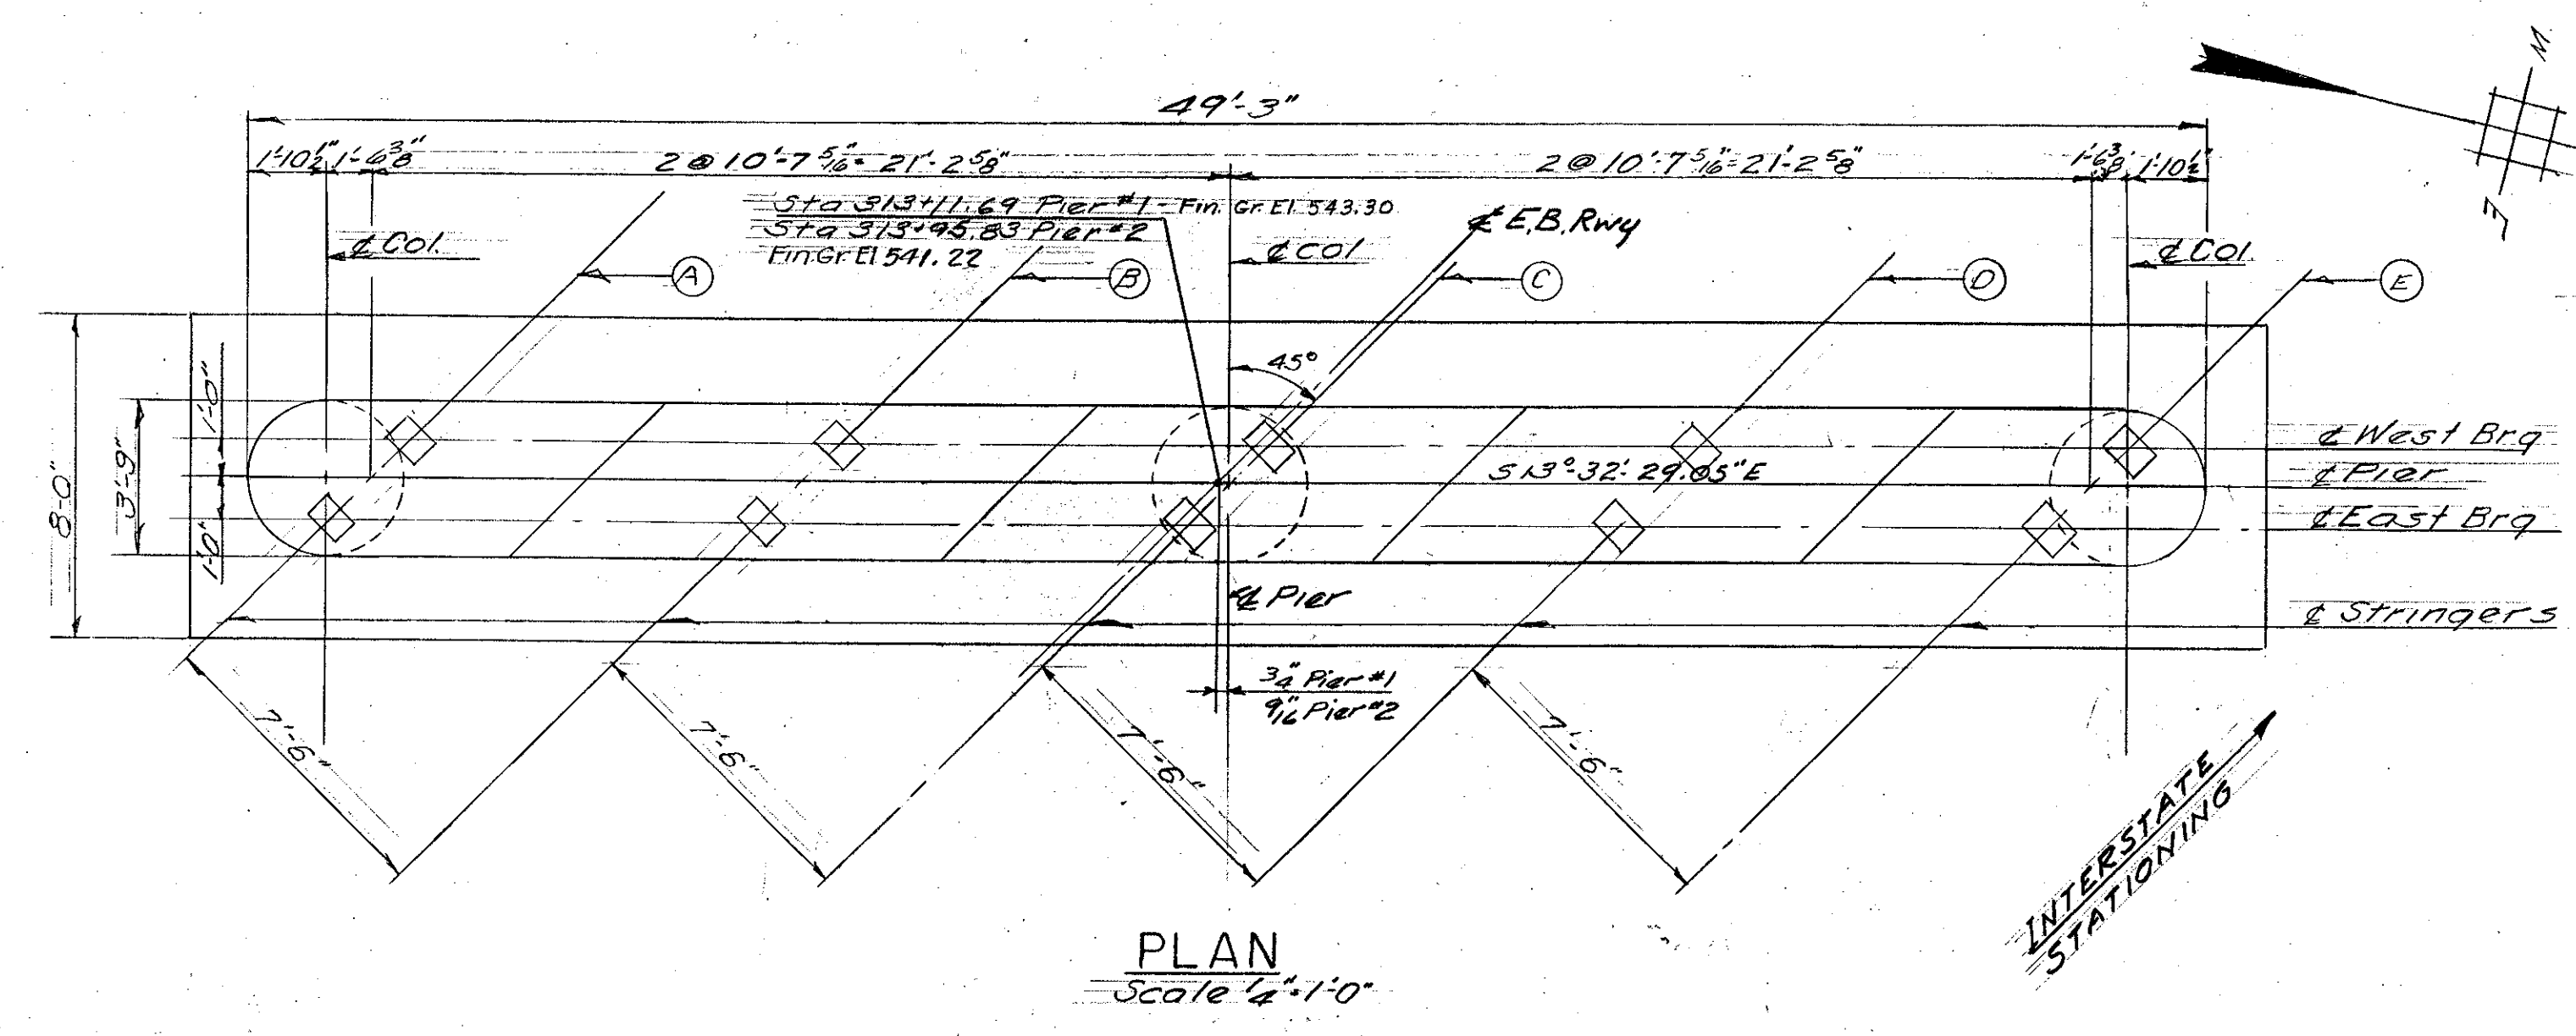

**NOTE:**  
 1. For General Notes see Sh #136  
 2. For Bearing Devices and Anchor Bolts see Detail "E" Sh #197  
 3. For Pile Shoes see Detail "F" Sh #197  
 4. Reinforcing in top of pier cap shall be spaced to pass Anchor Bolts maintaining minimum spacing requirements.

IM 089-2(26)  
 This sheet for information only  
**BR 43 N & S**

		BEARING ELEVATIONS				
EB	BEARING	A	B	C	D	E
PIER #1	EAST	539.22	539.19	539.06	538.84	538.52
	WEST	539.04	539.01	538.88	538.66	538.34
PIER #2	EAST	537.20	537.14	536.99	536.74	536.40
	WEST	537.13	537.08	536.93	536.68	536.34

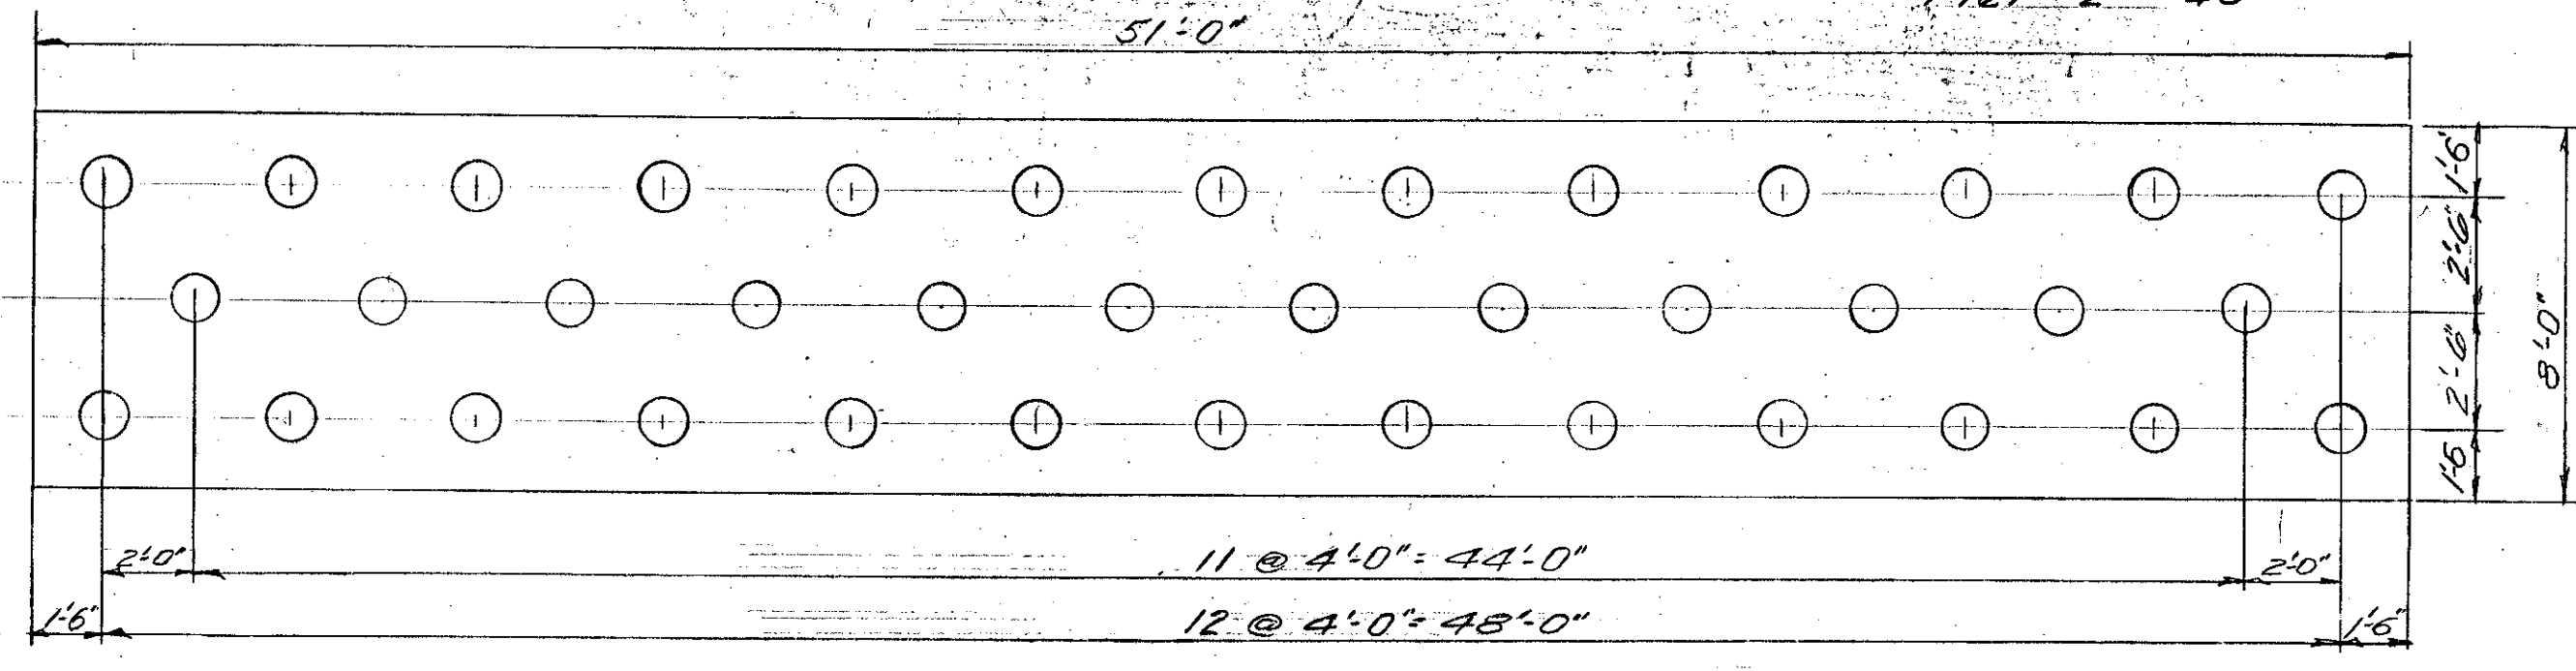

**PILE PLAN**  
 Scale 1/4"=1'-0"

ITEM	DESCRIPTION	QUANTITY	UNIT
107	Structure Exc. Pier #1	19	CY
107	Structure Exc. Pier #2	21	CY

ITEM	DESCRIPTION	QUANTITY	UNIT
407	Asphaltic Asbestos Coating #1	22	SY
407	" " " #2	22	SY
401B	Class "B" Conc. (Mod) Pier #1	100	CY
401B	" " " Pier #2	103	CY
502B	Treated Timber Piles Pier #1	1520	LF
502B	" " " Pier #2	1520	LF
402	Rein. Steel Pier #1	14,827	LB
402	" " " Pier #2	13,943	LB

STATE OF VERMONT  
 DEPARTMENT OF HIGHWAYS







INTERSTATE PROJECT in the towns of  
 BERLIN - MONTPELIER - MIDDLESEX

**OVERPASS STA 314+00 STRUCTURE #4  
 EASTBOUND PIER DETAILS**


POSWELL ENGINEERING CO.  
 CONSULTING ENGINEERS  
 RIDGEBURY PARK, N.J.

SURVEYED BY VT  
 DRAWN BY RAB  
 PROJECT NO. 189-2(13) SHEET 218 OF 307

CHECKED BY A.J.J.  
 IN CHARGE KA  
 SCALE AS SHOWN  
 DATE AUG. 1957

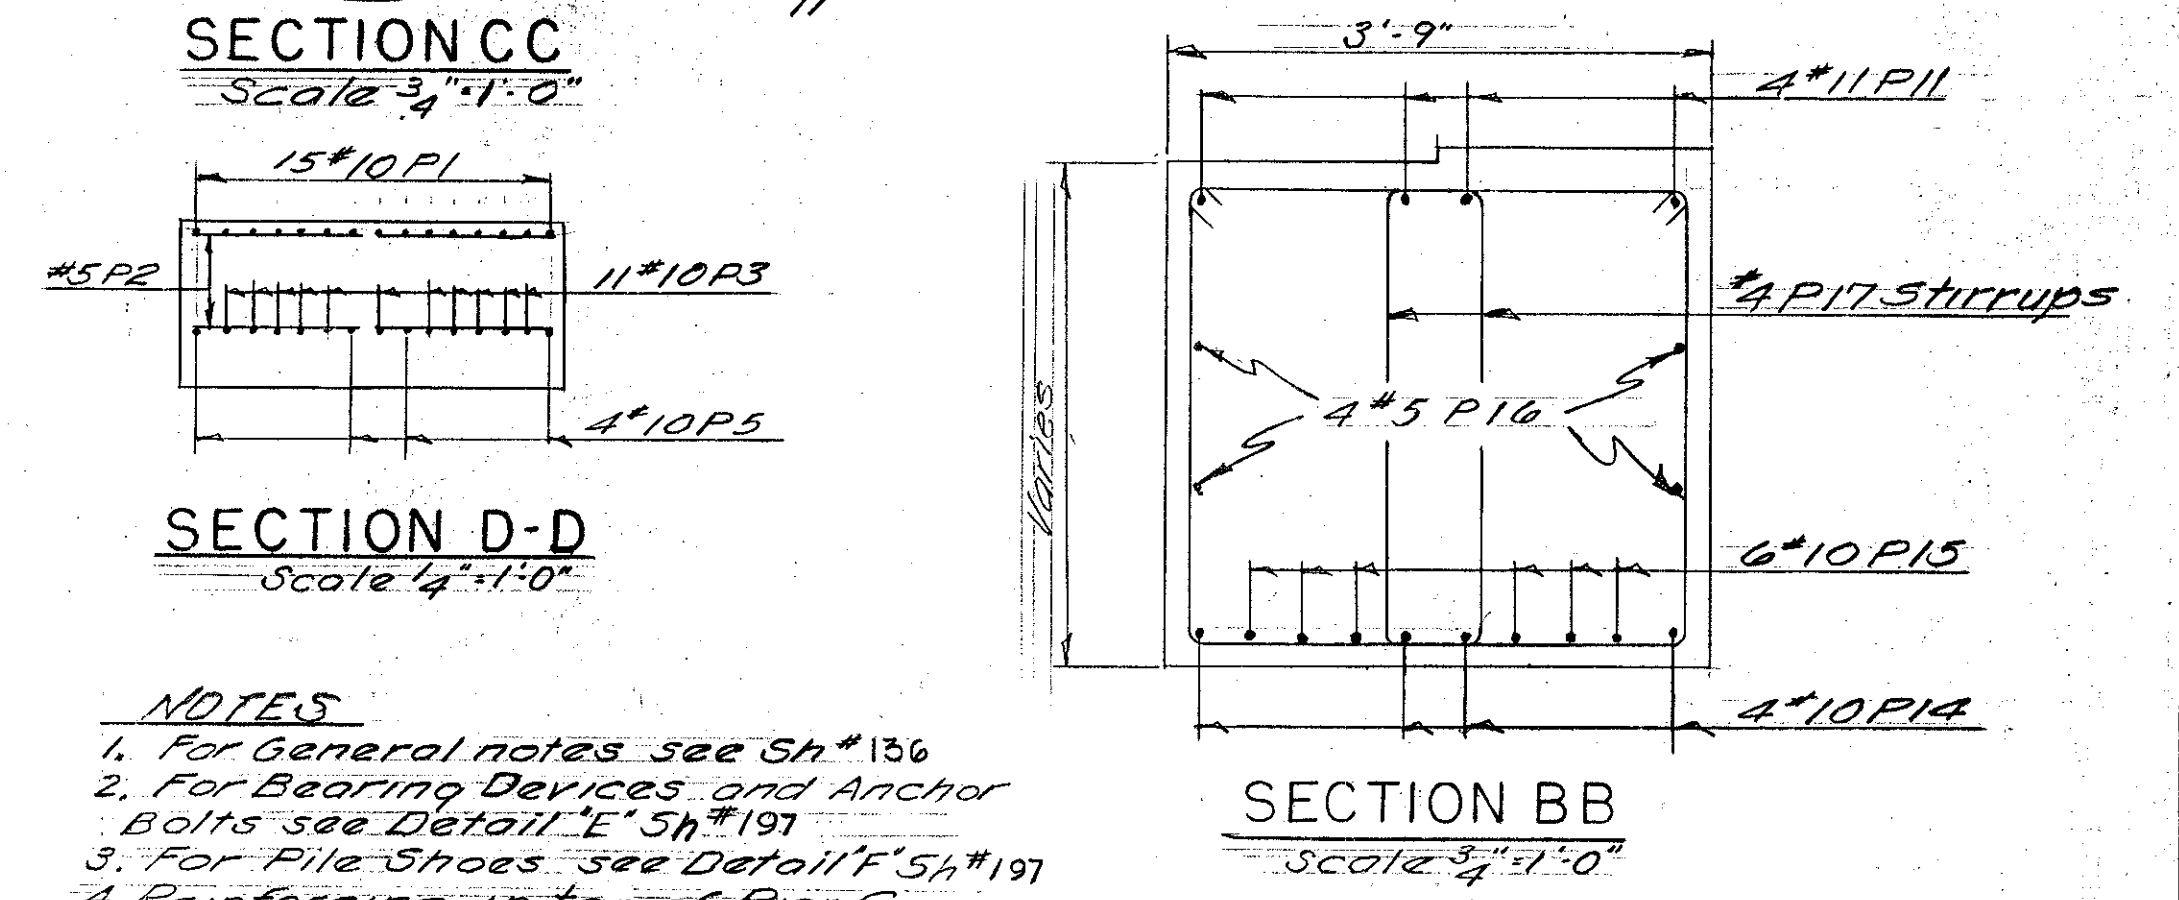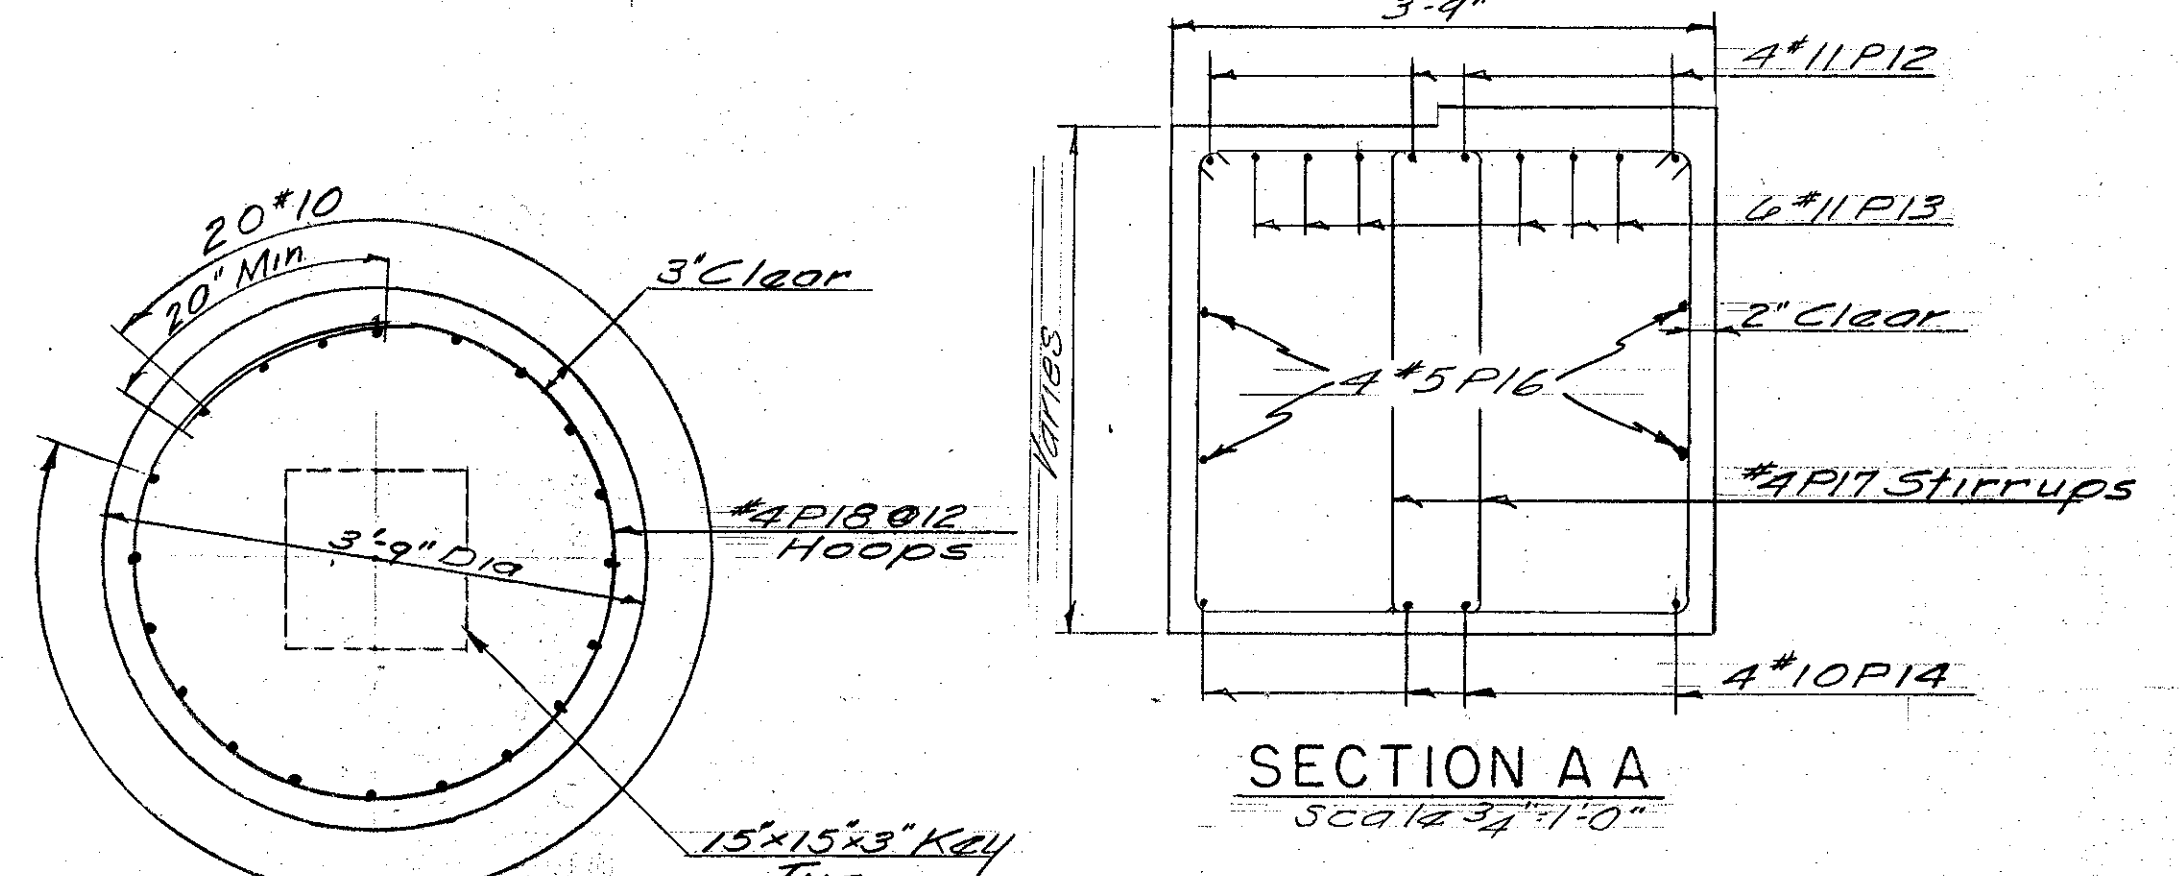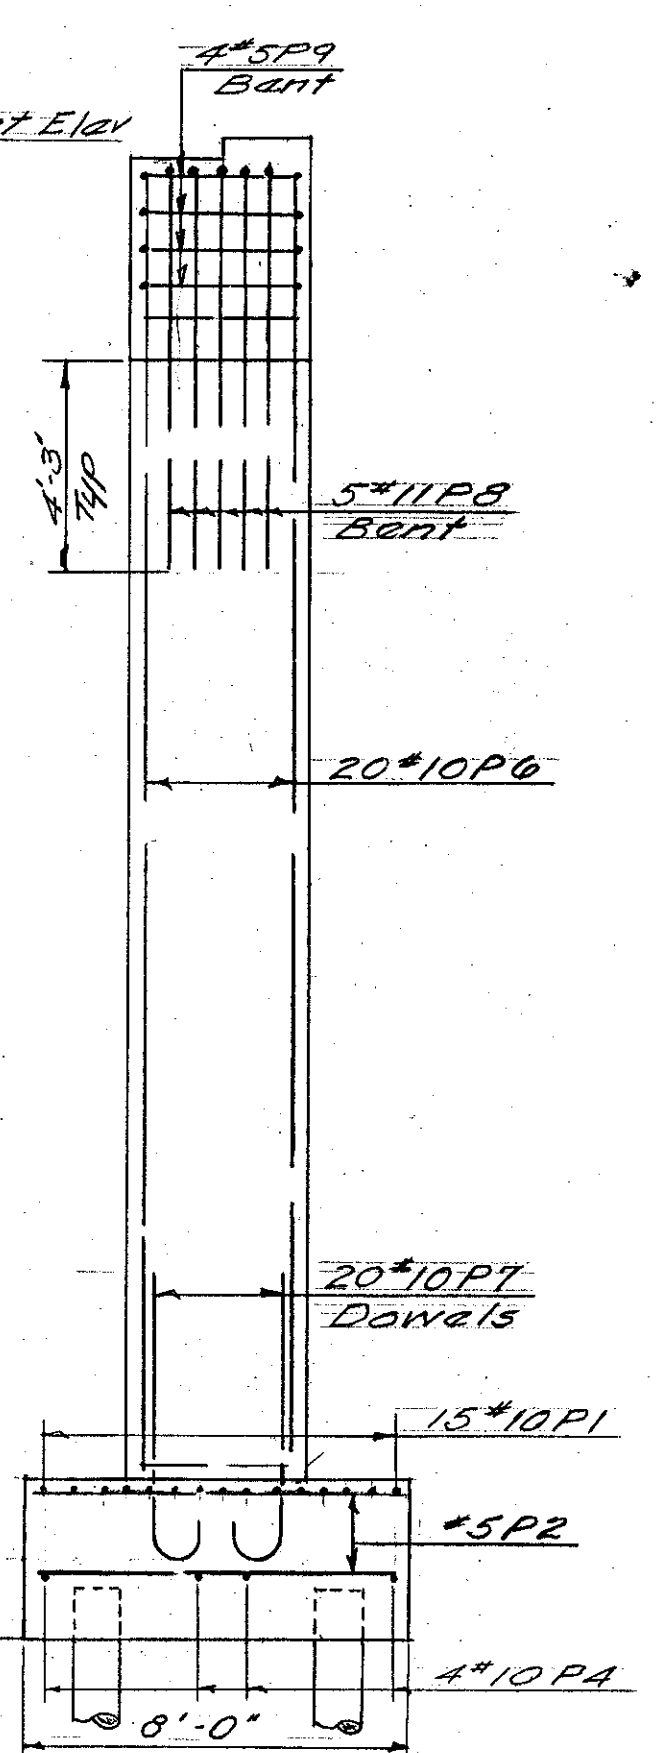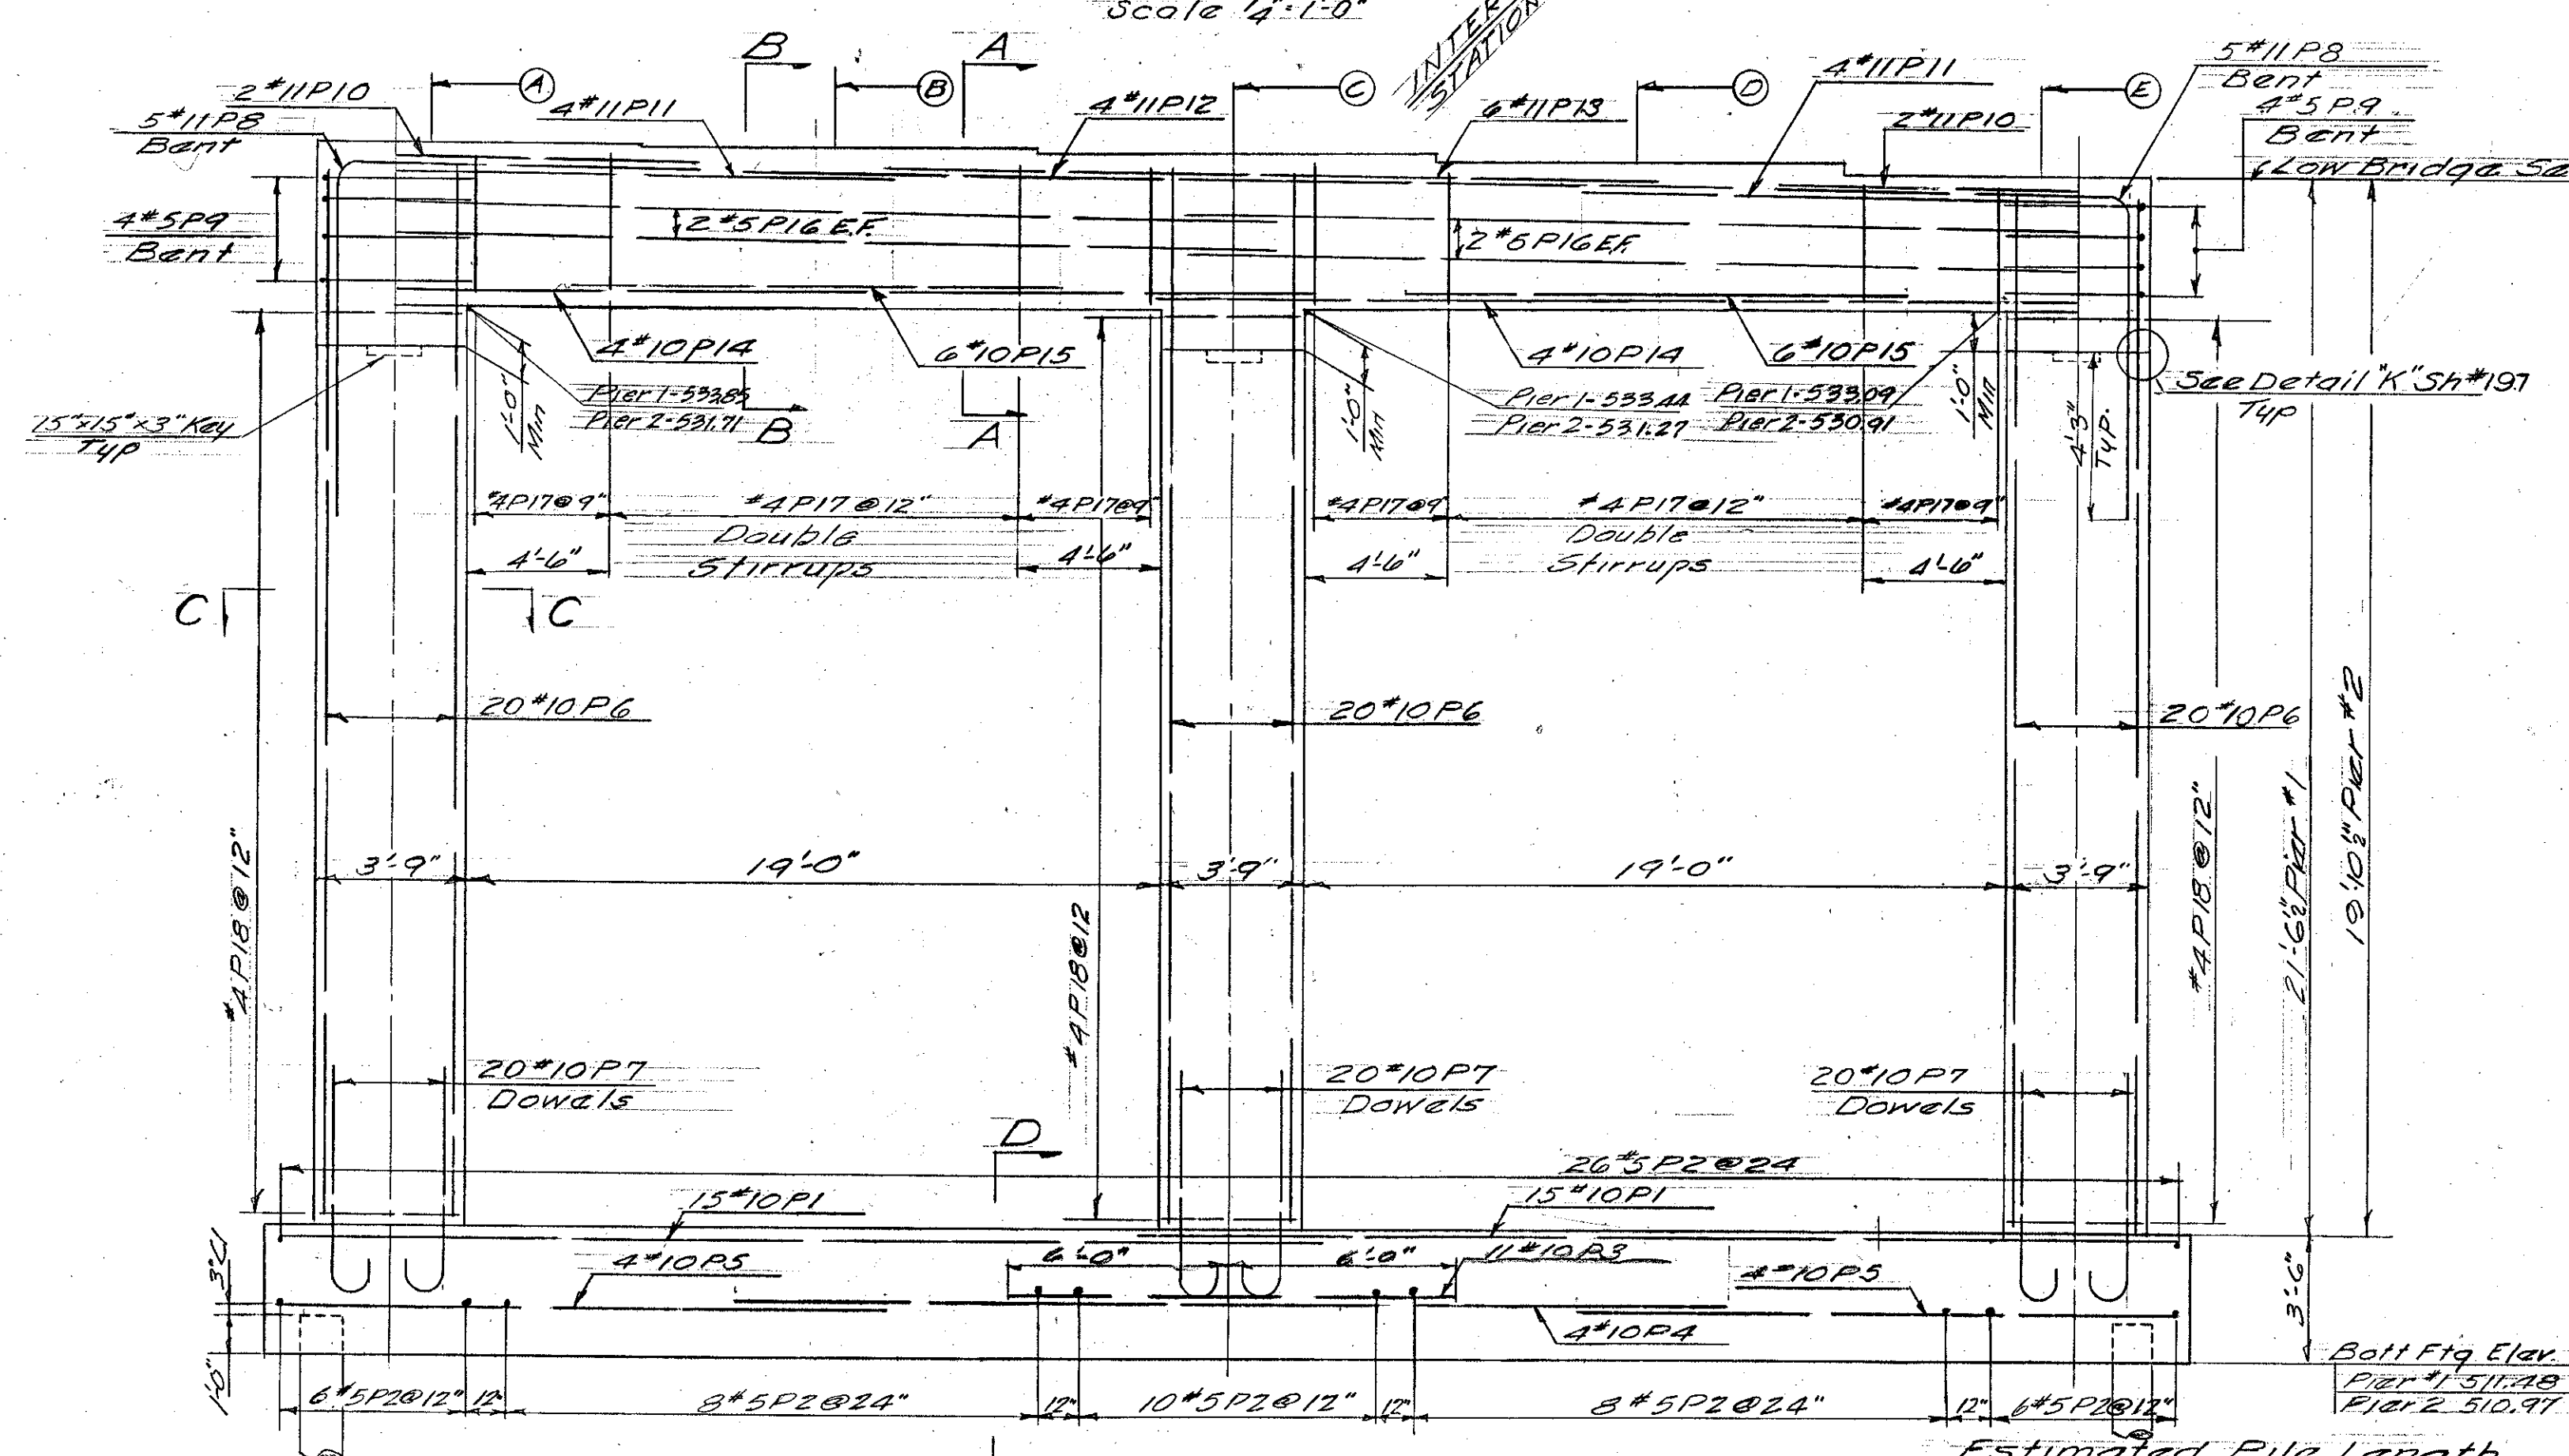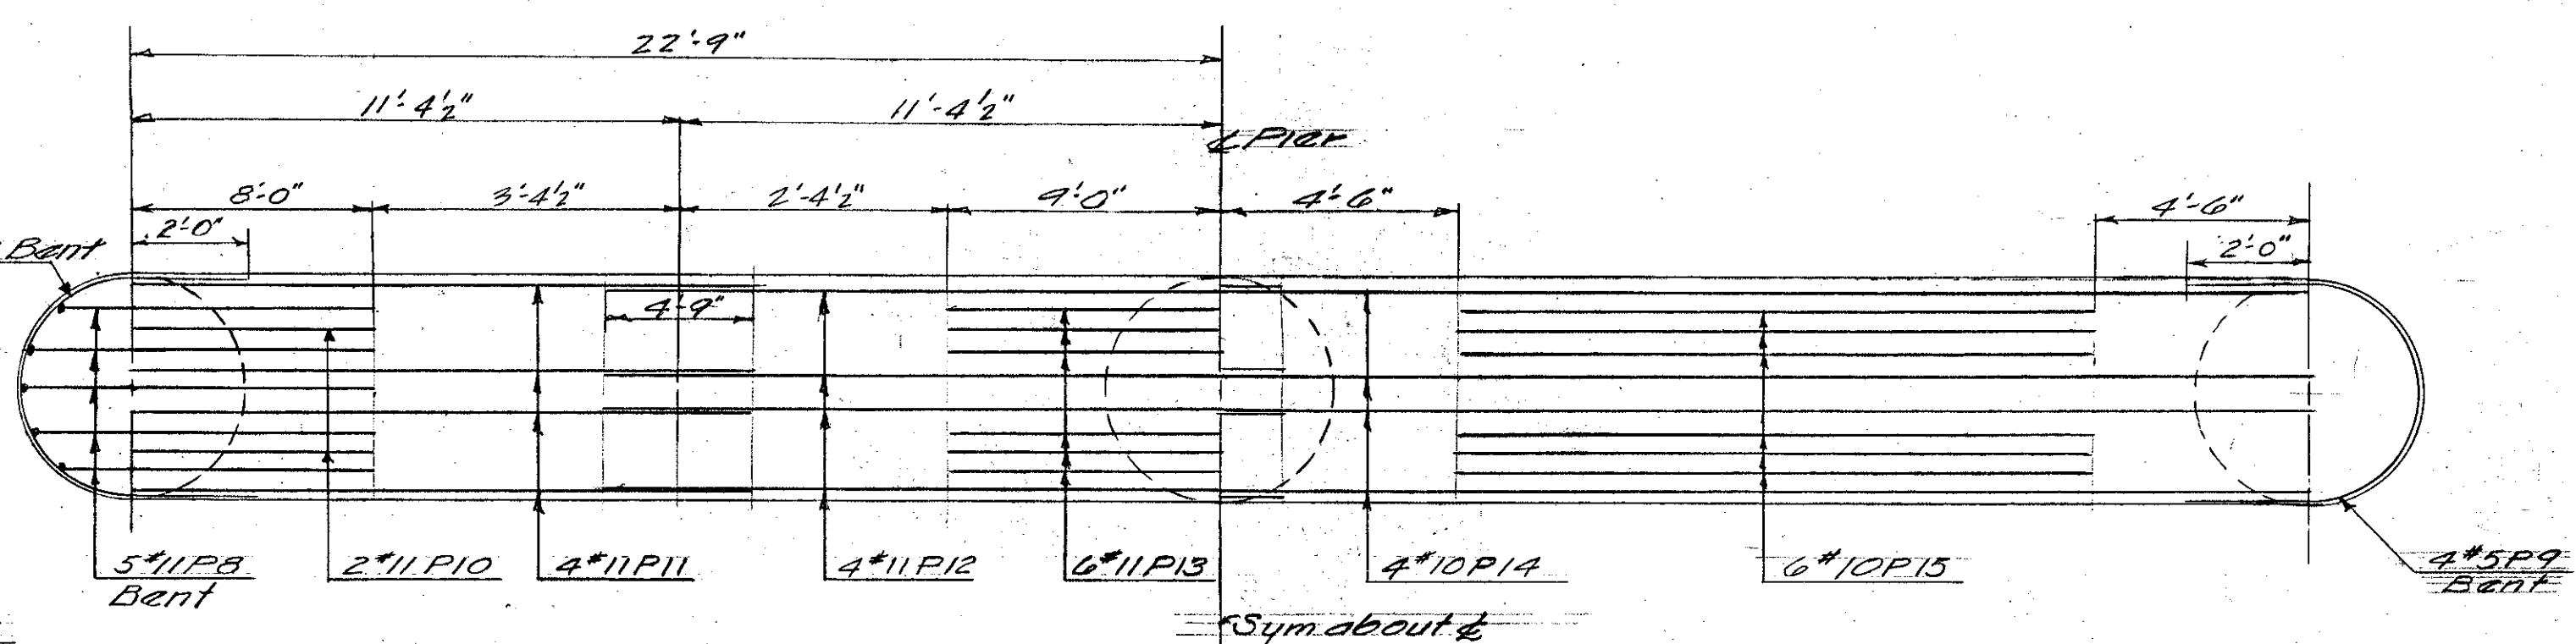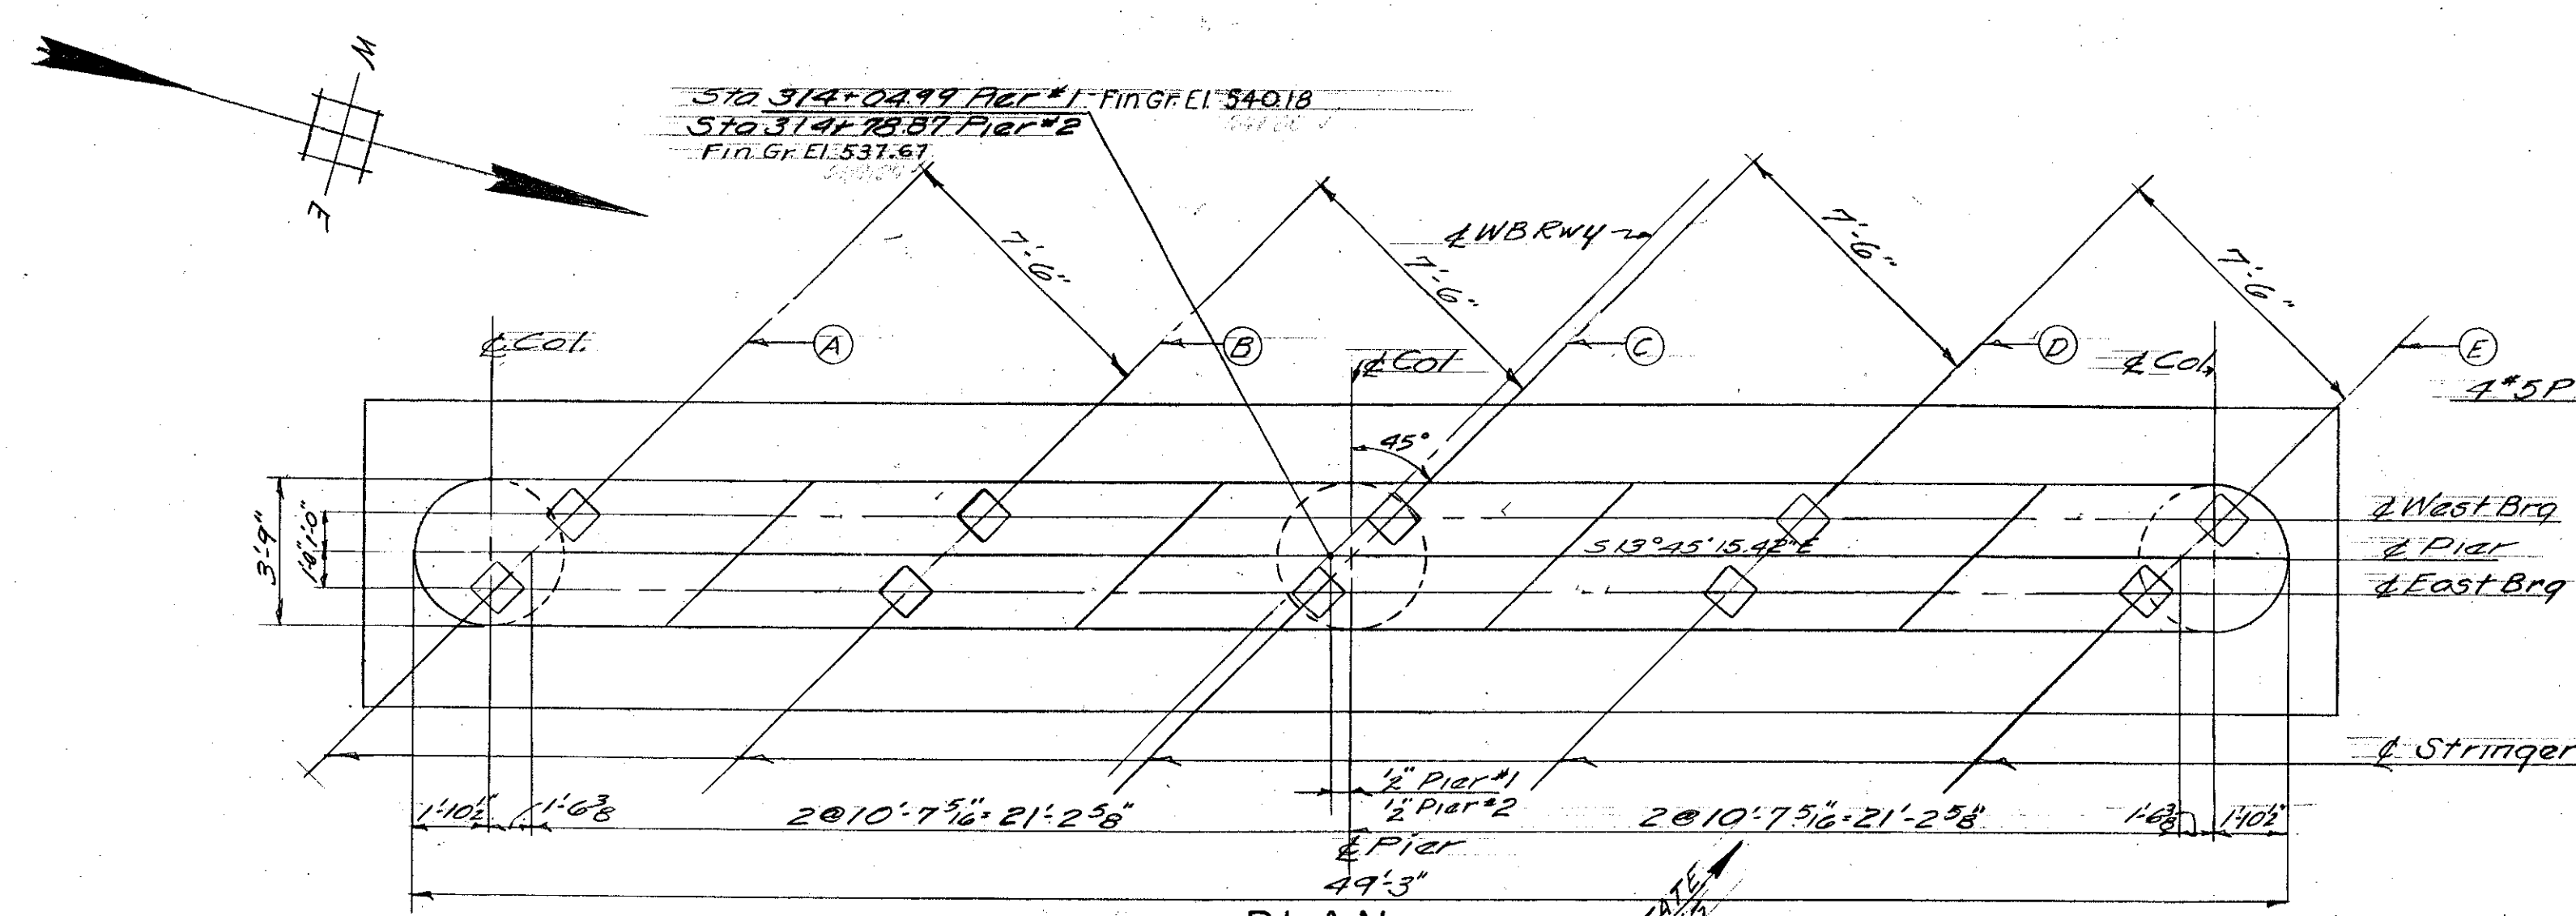

- NOTES
1. For General notes see Sh #136
  2. For Bearing Devices and Anchor Bolts see Detail 'E' Sh #197
  3. For Pile Shoes see Detail 'F' Sh #197
  4. Reinforcing in top of Pier Cap shall be spaced to pass anchor bolts, maintaining minimum spacing requirements

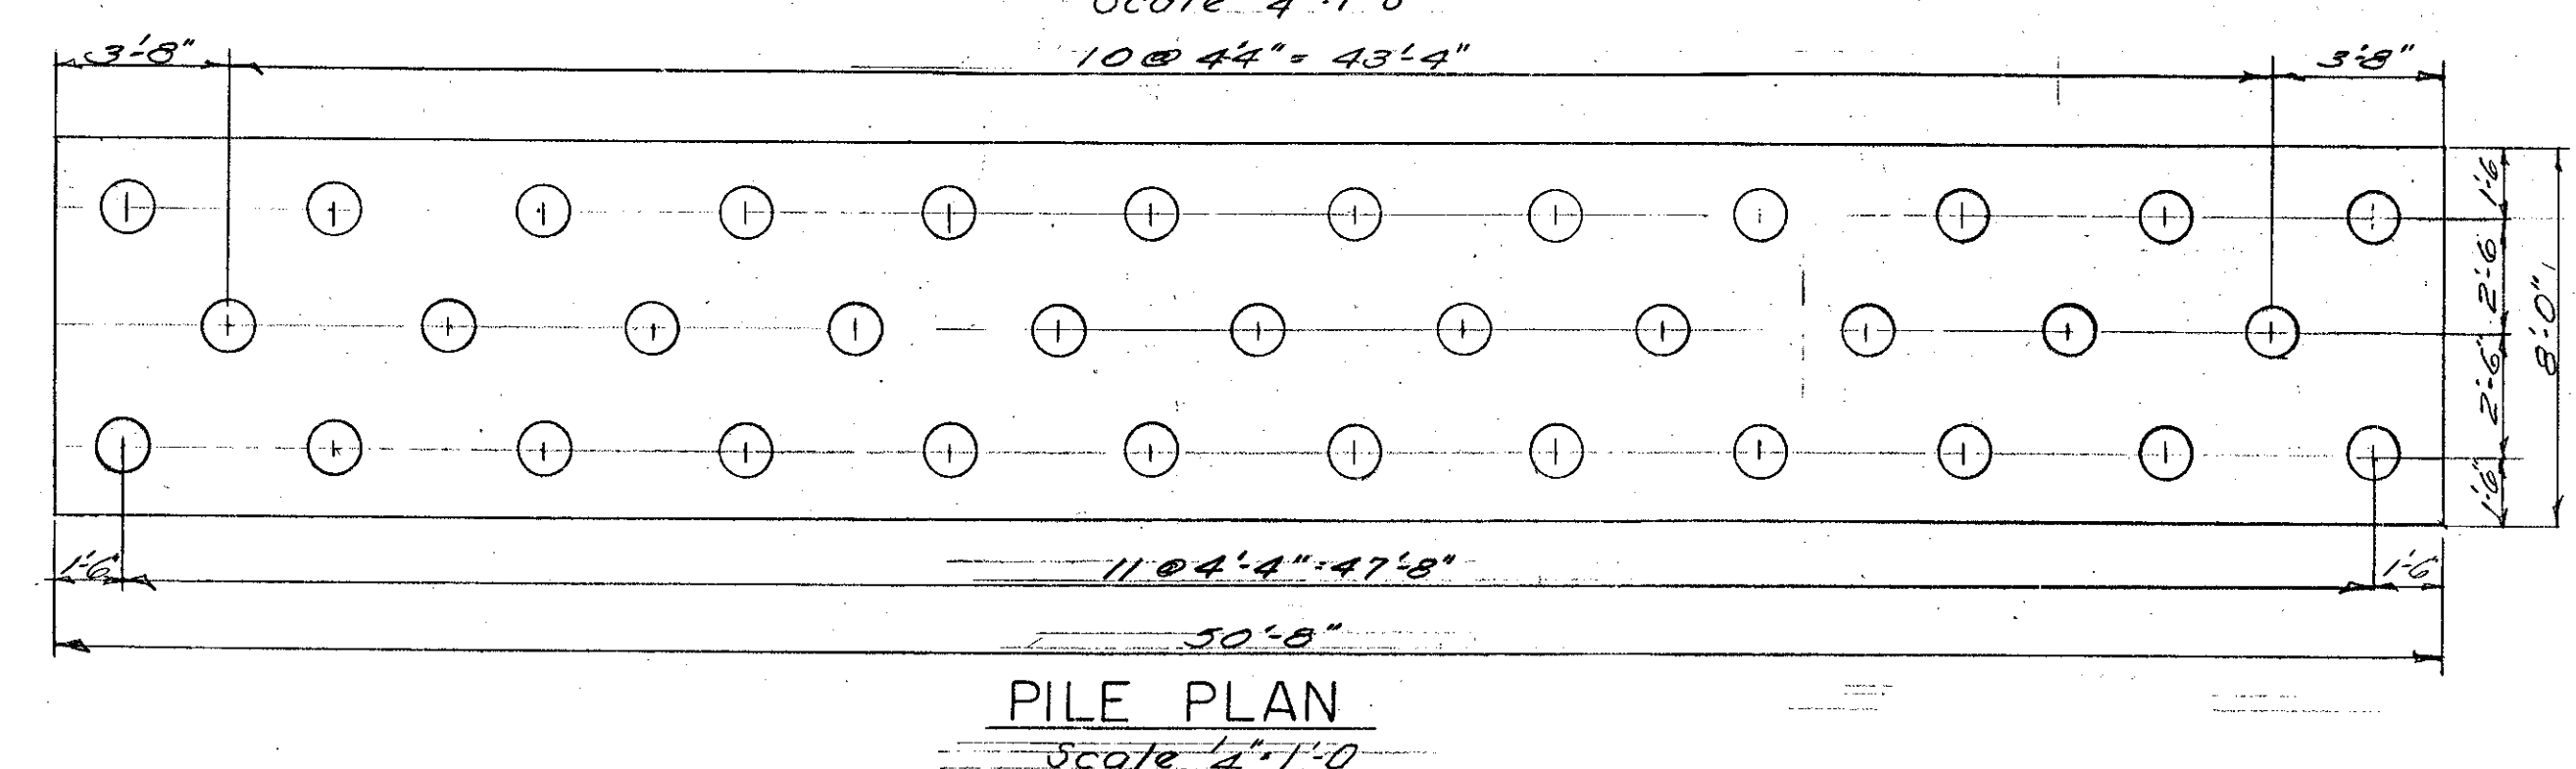

BEARING ELEVATIONS						
W.B.	BEARING	A	B	C	D	E
PIER #1	EAST	537.64	537.56	537.39	537.11	536.75
	WEST	537.42	537.33	537.16	536.88	536.52
PIER #2	EAST	535.35	535.26	535.07	534.78	534.41
	WEST	535.28	535.19	535.00	534.71	534.34

		NEAR	ROUND
407	Asphaltic Asbestos Coating #1 SY	22	
407	" " " #2 SY	22	
401B	Class 'B' Conc. (Mod) #1 CY	100	105
401B	" " " #2 CY	99	104
502B	Treated Timber Piles #1 LF	1400	
502B	" " " #2 LF	1400	
402	Reinf. Steel #1 LB	19,101	
402	" " " #2 LB	18,600	

IM 089-2(26)  
This sheet for information only  
**BR 43 N & S**

STATE OF VERMONT  
DEPARTMENT OF HIGHWAYS


INTERSTATE PROJECT in the towns of  
BERLIN - MONTPELIER - MIDDLESEX  
**OVERPASS STA. 314+00. STRUCTURE #4  
WEST BOUND PIER DETAILS.**

BOSWELL ENGINEERING CO.  
CONSULTING ENGINEERS  
RICHFIELD PARK, N.J.

SUPPLIED BY: VT  
DRAWN BY: RAB  
PROJECT NO.: 89-2-131



CHECKED BY: MJC  
IN CHARGE: KA  
DATE: AUG. 1987

SCALE: AS SHOWN  
SHEET 219 OF 307




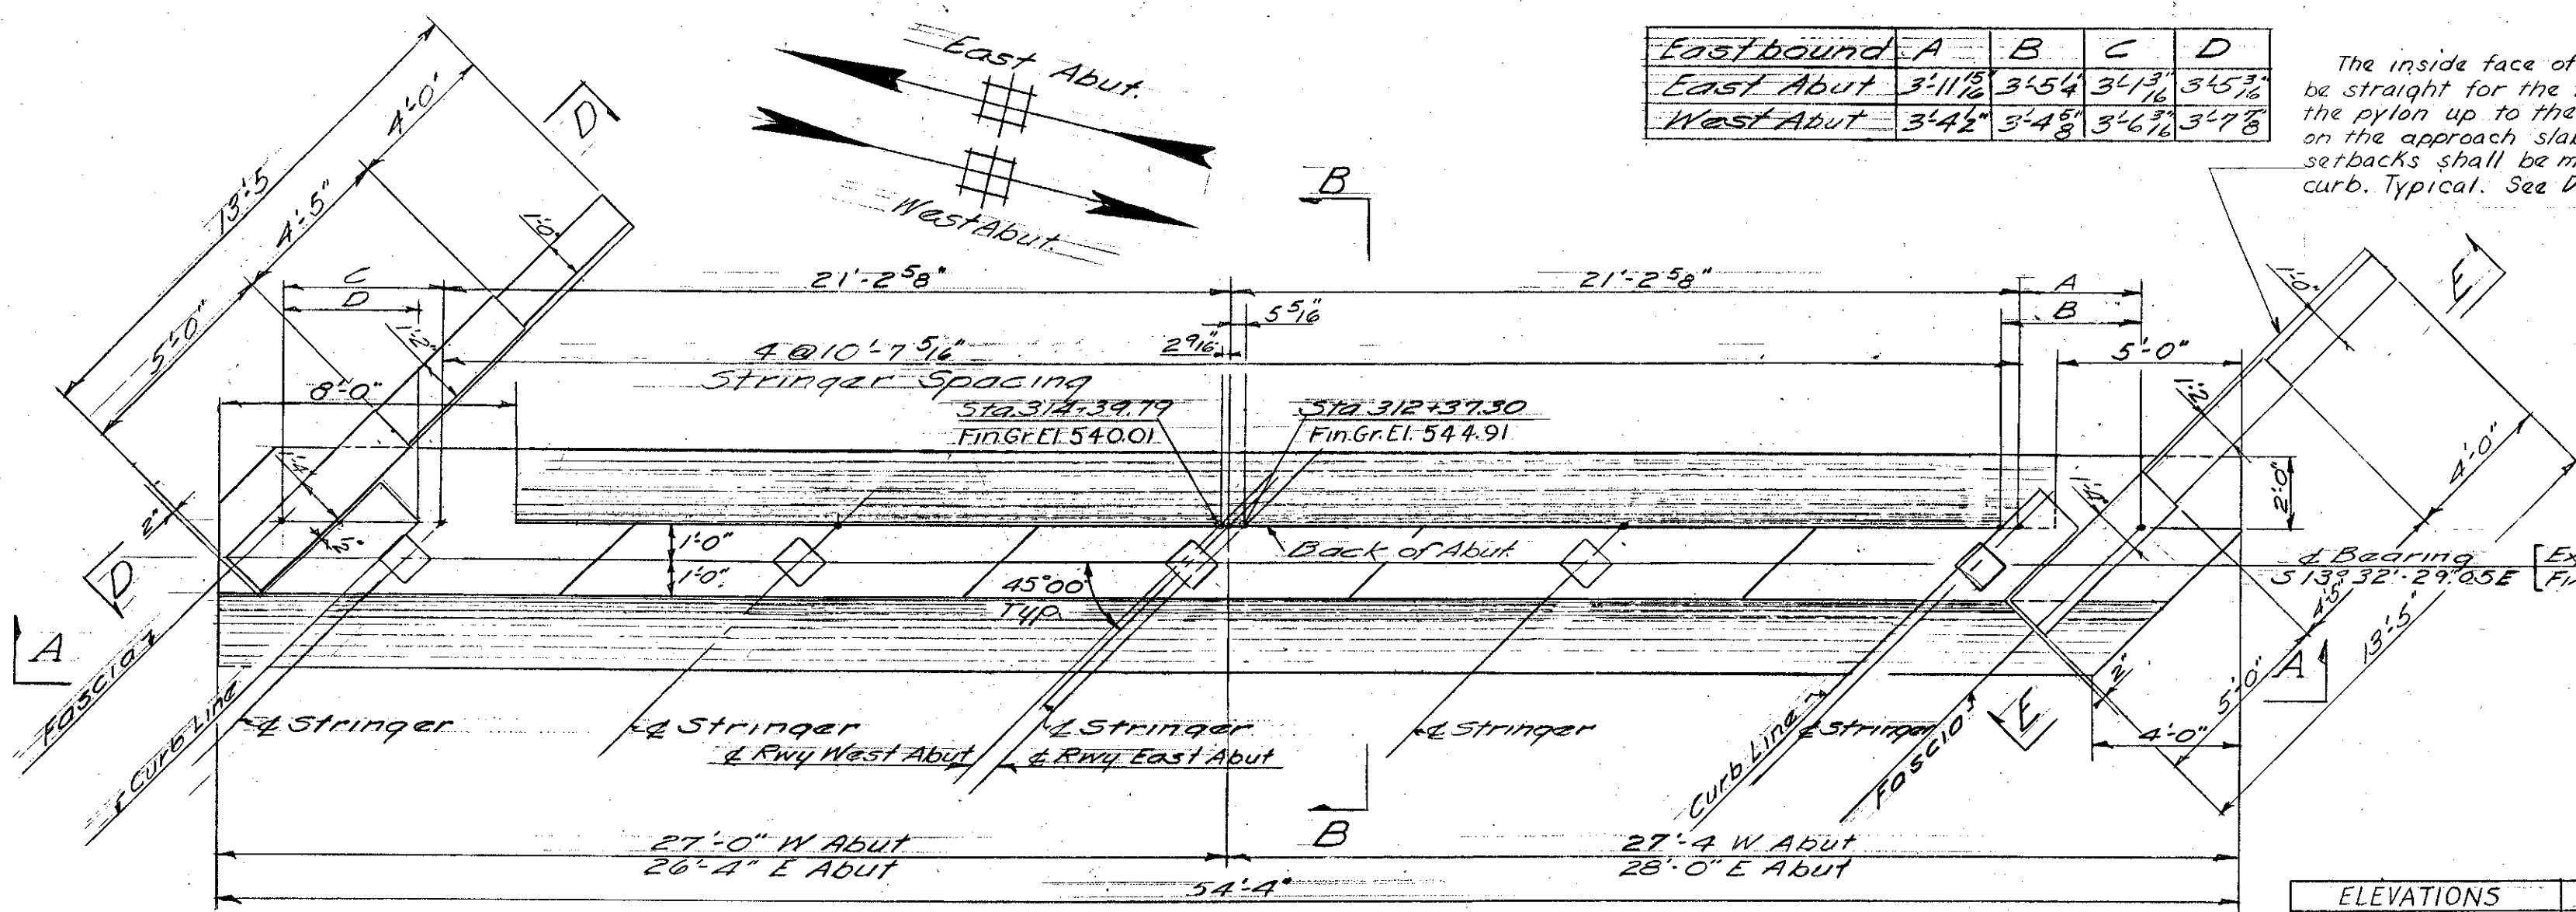


Eastbound	A	B	C	D
East Abut	3'11 1/2"	3'5 1/4"	3'6 1/2"	3'5 1/2"
West Abut	3'4 1/2"	3'4 3/8"	3'6 1/2"	3'7 3/8"




The inside face of the pylon shall be straight for the full length of the pylon up to the top of the curb on the approach slab and the setbacks shall be made above the G curb. Typical. See Detail "D" Sh#197.

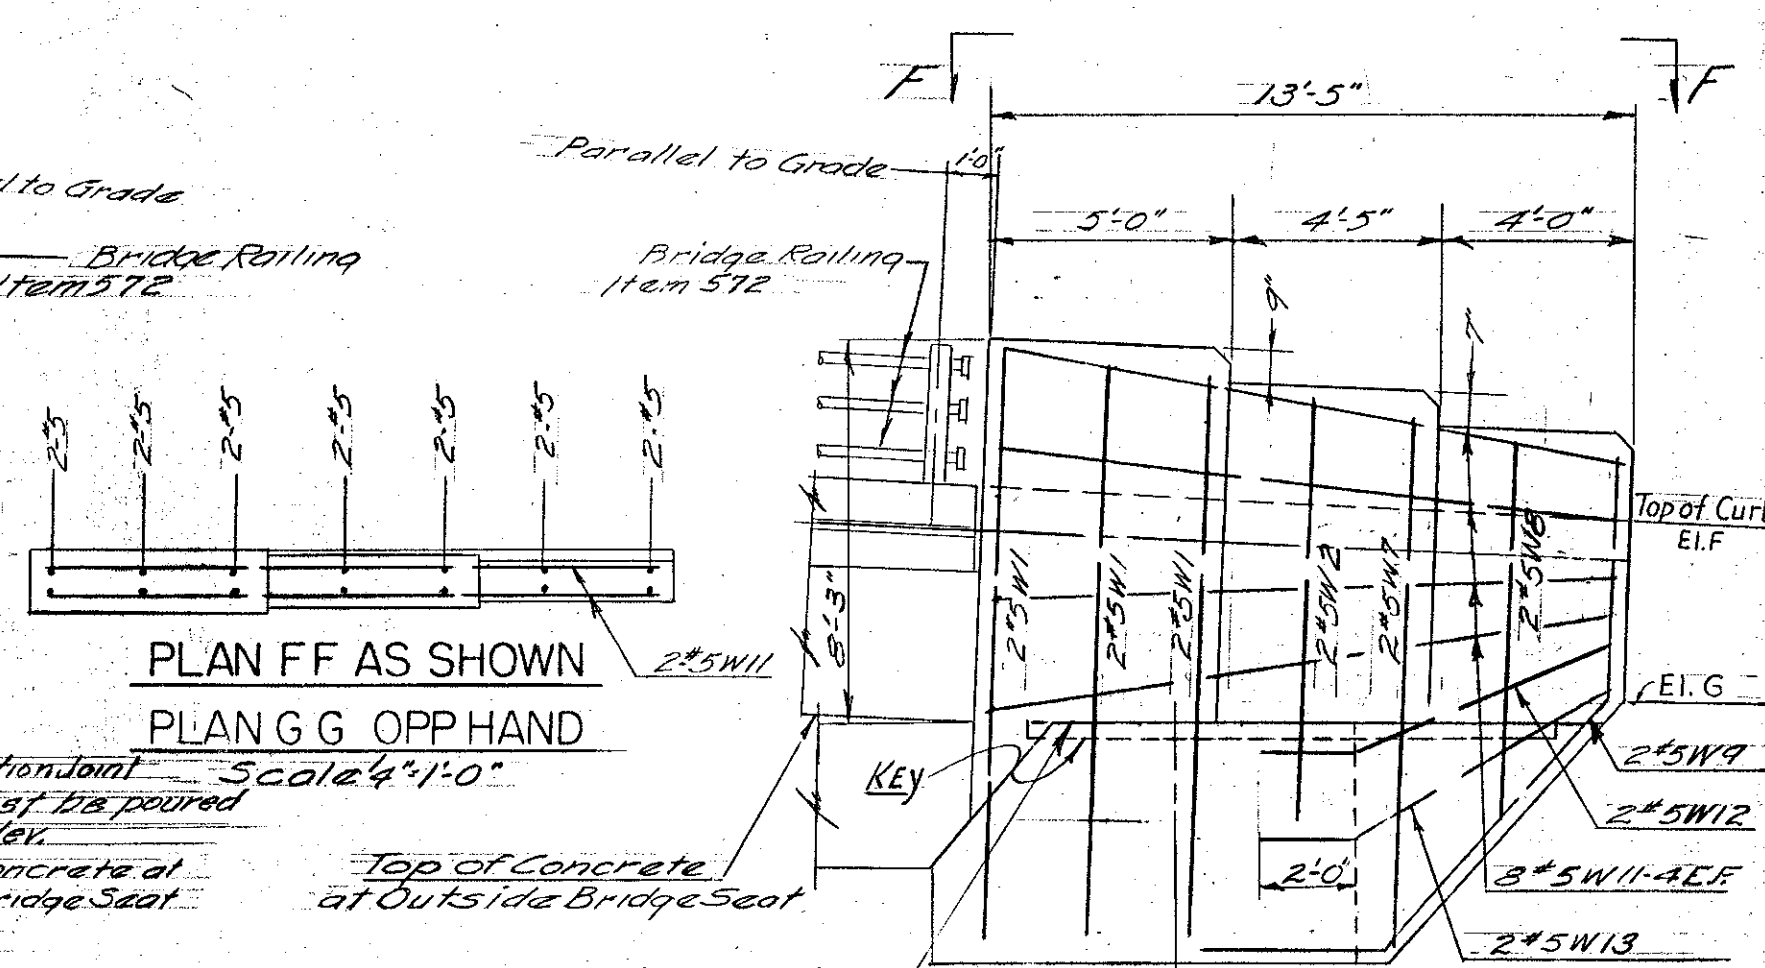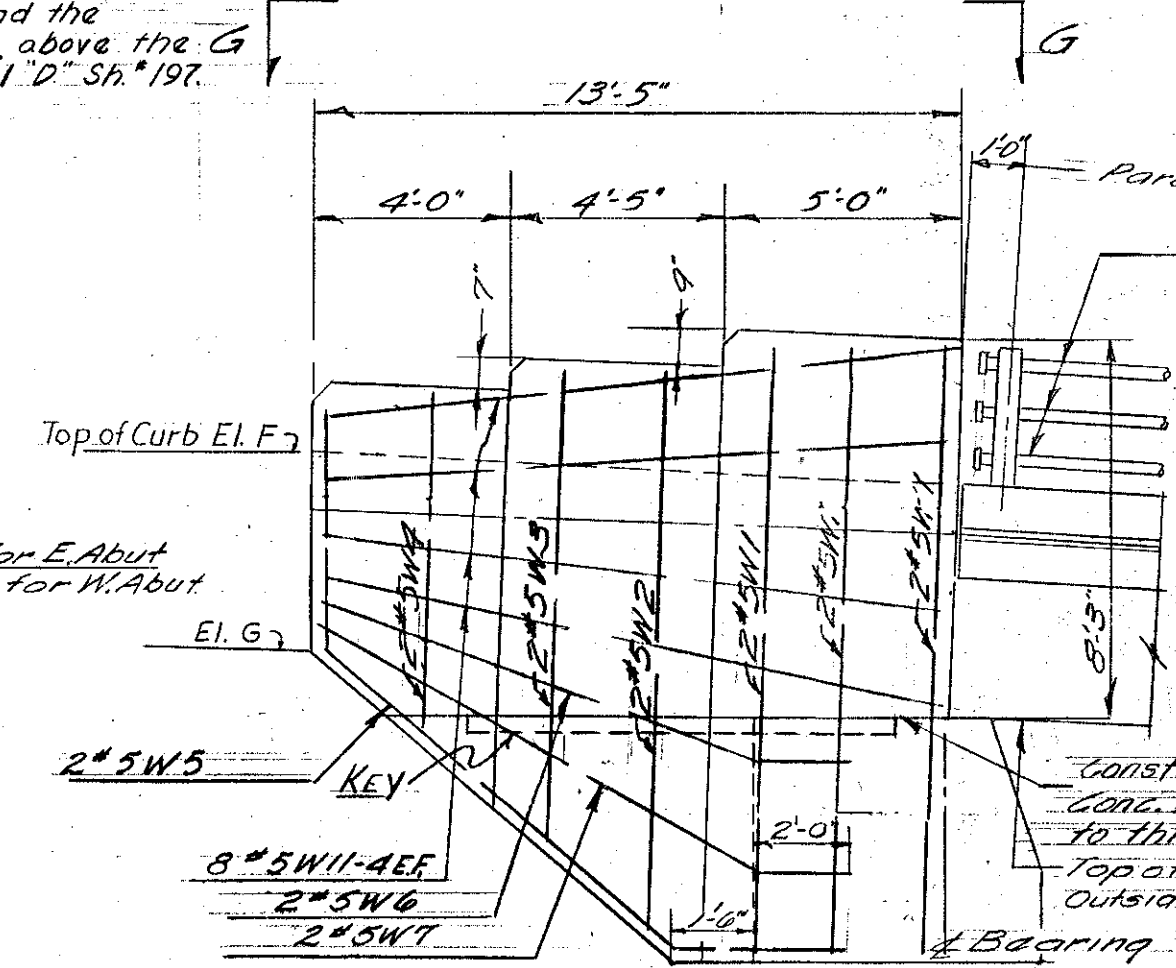

ELEVATIONS		F	G
East Abut.	Southside	546.00	542.00
	Northside	545.44	541.44
West Abut.	Southside	540.82	536.82
	Northside	539.97	535.97

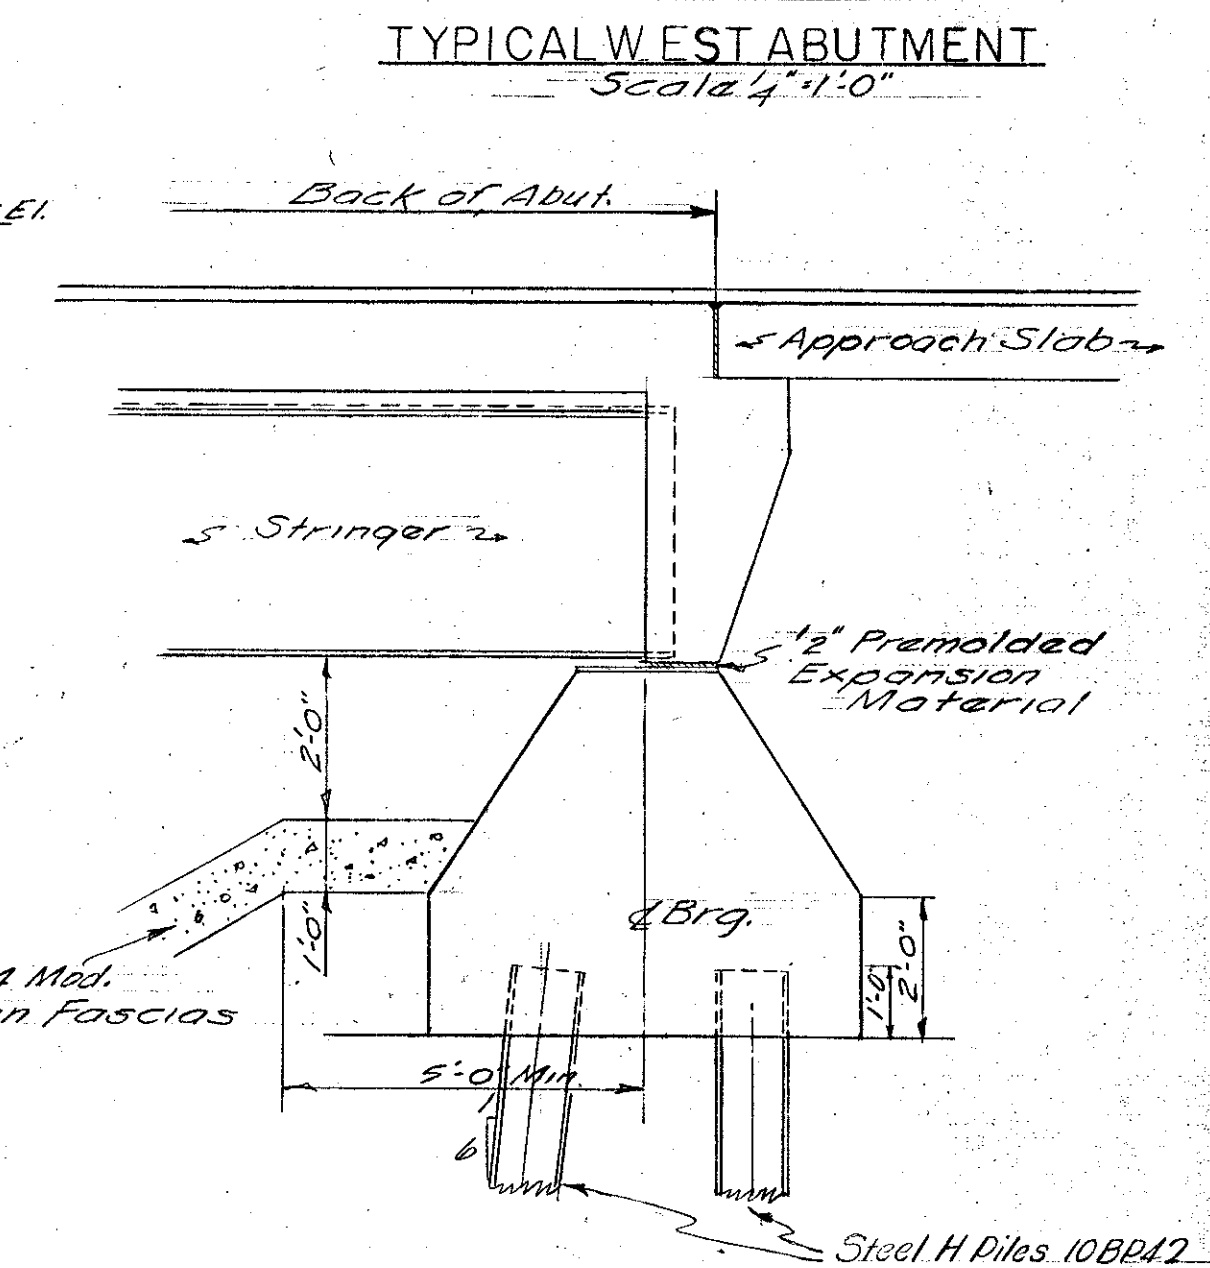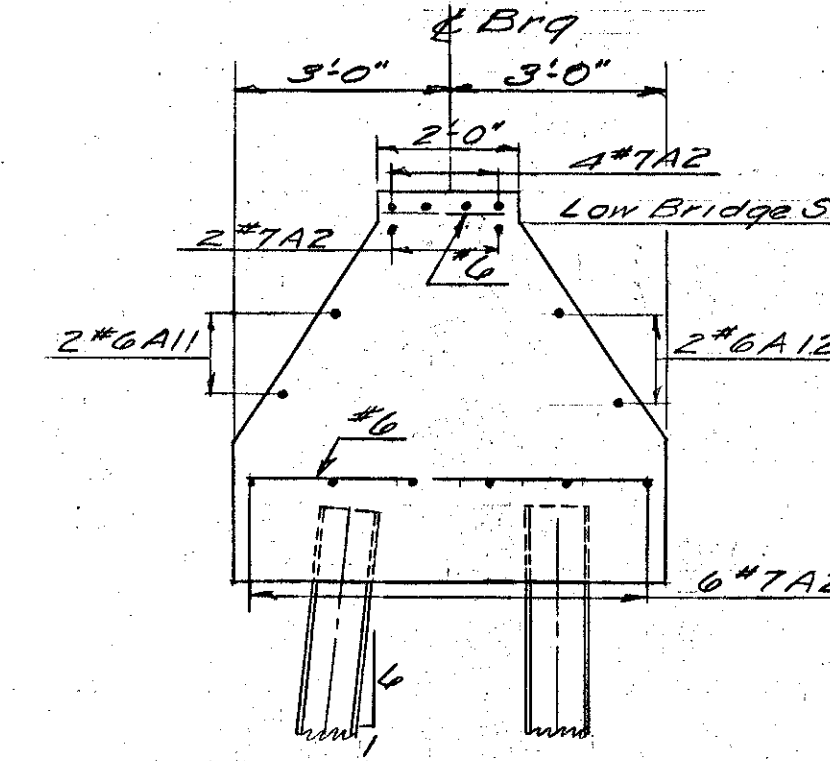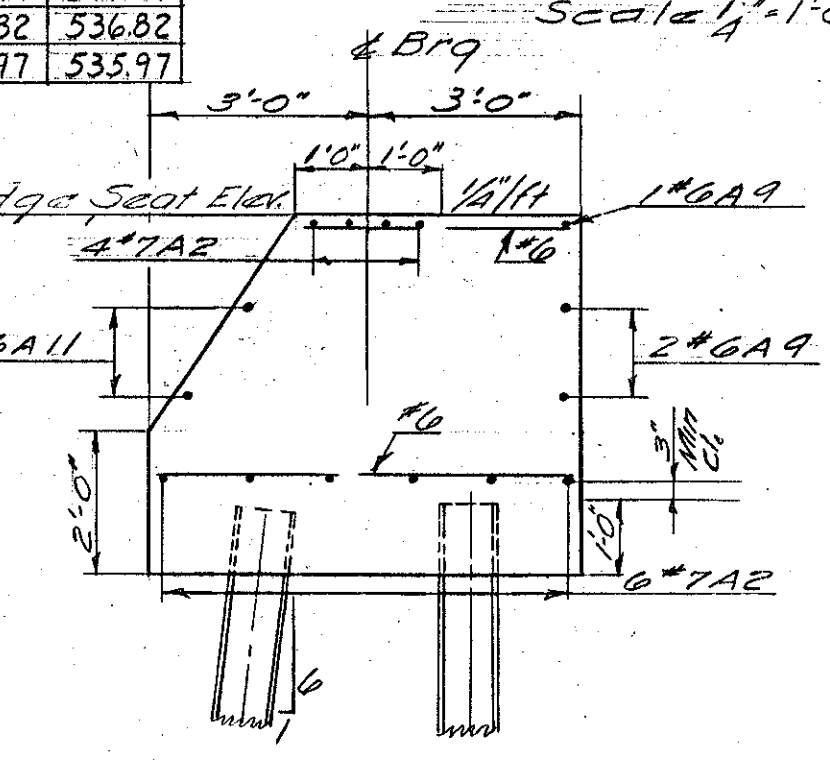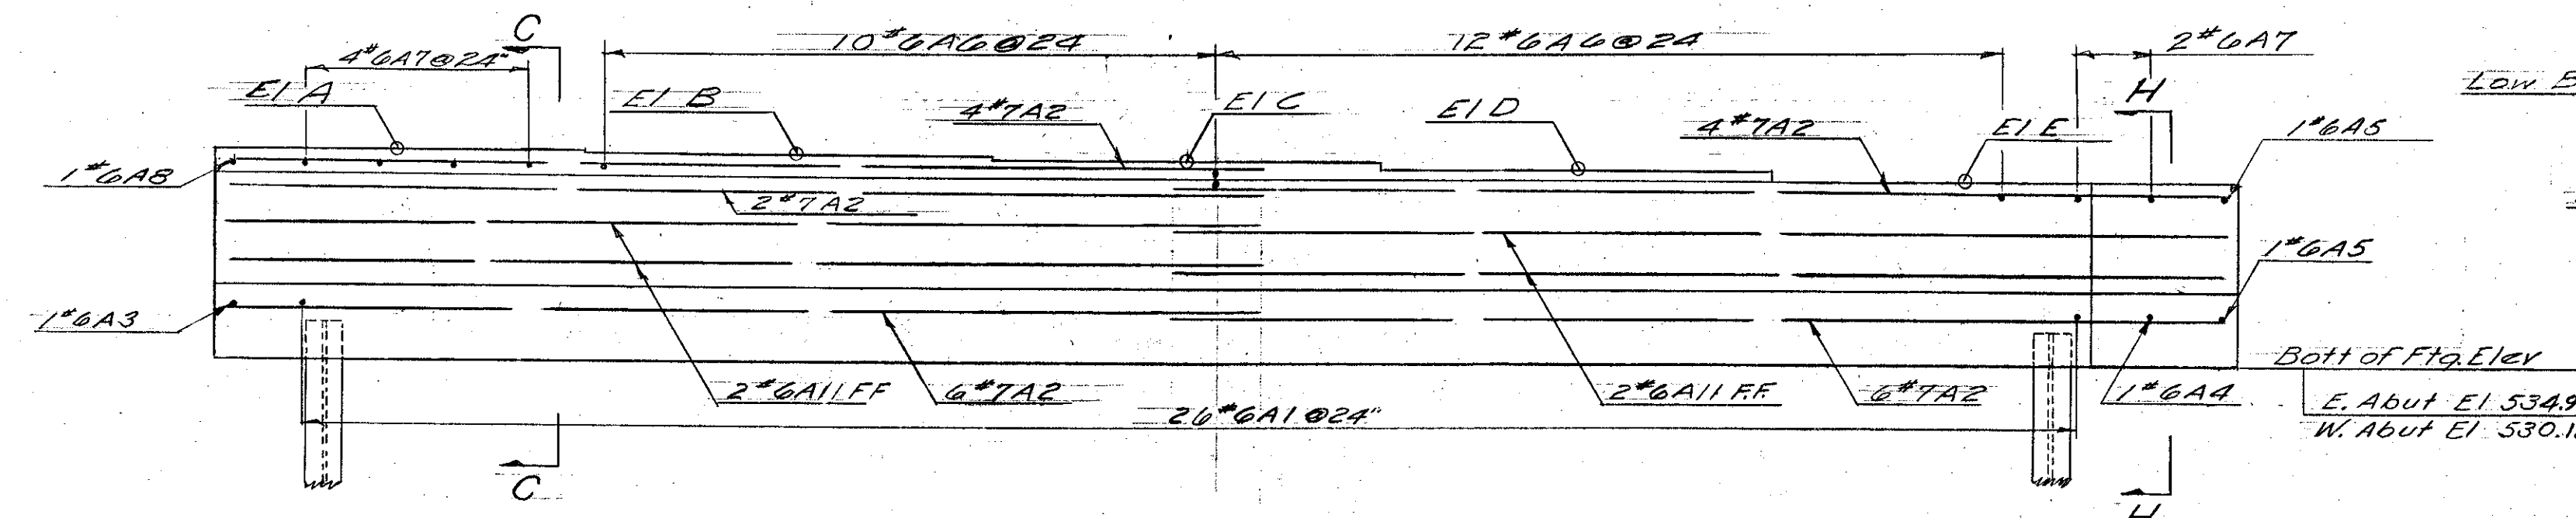

BEARING ELEVATIONS					
EAST BOUND	A	B	C	D	E
EAST ABUT	540.60	540.59	540.58	540.28	539.98
WEST ABUT	536.05	535.96	535.80	535.34	535.18

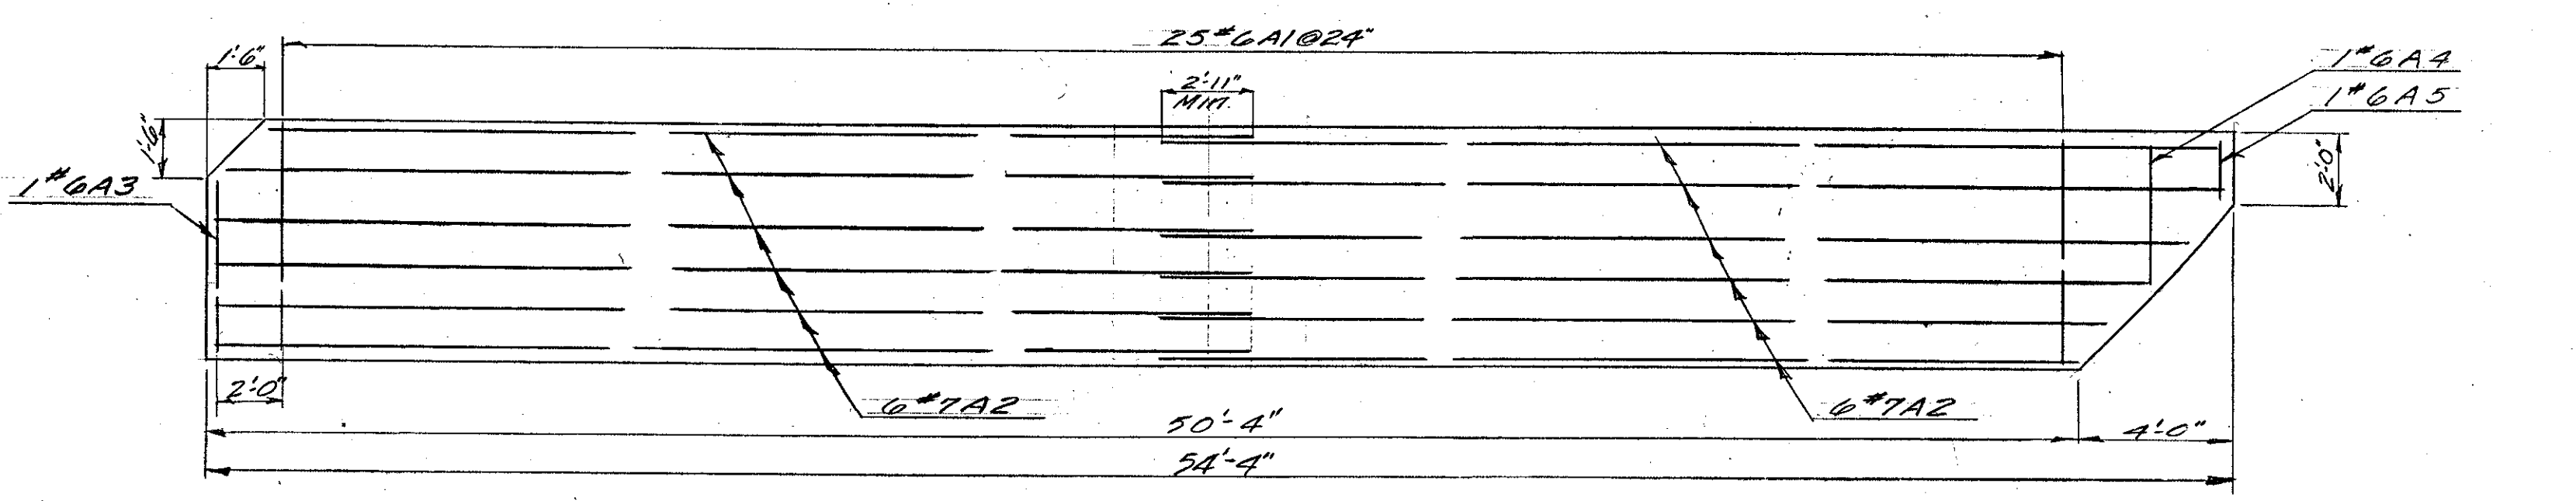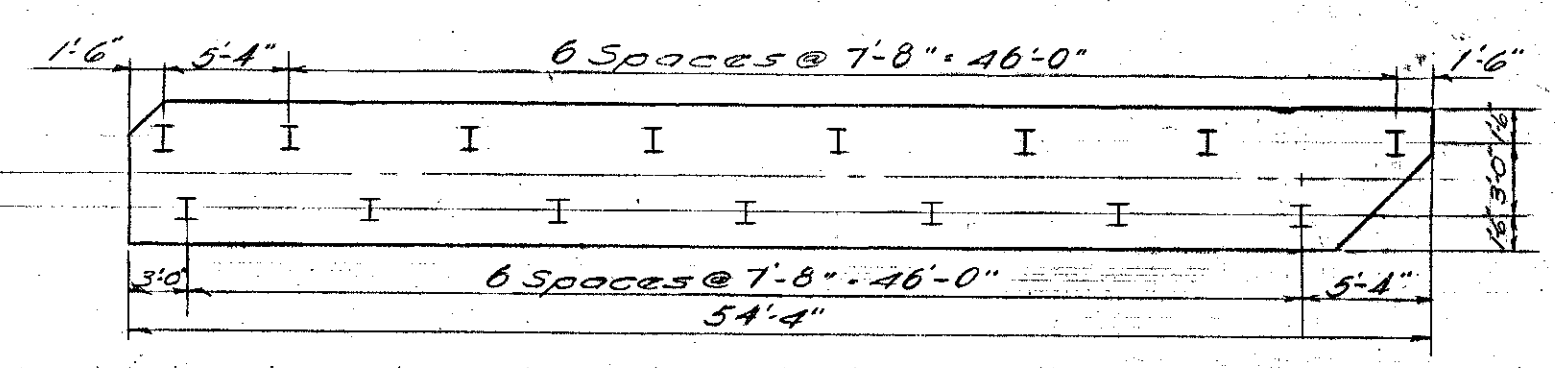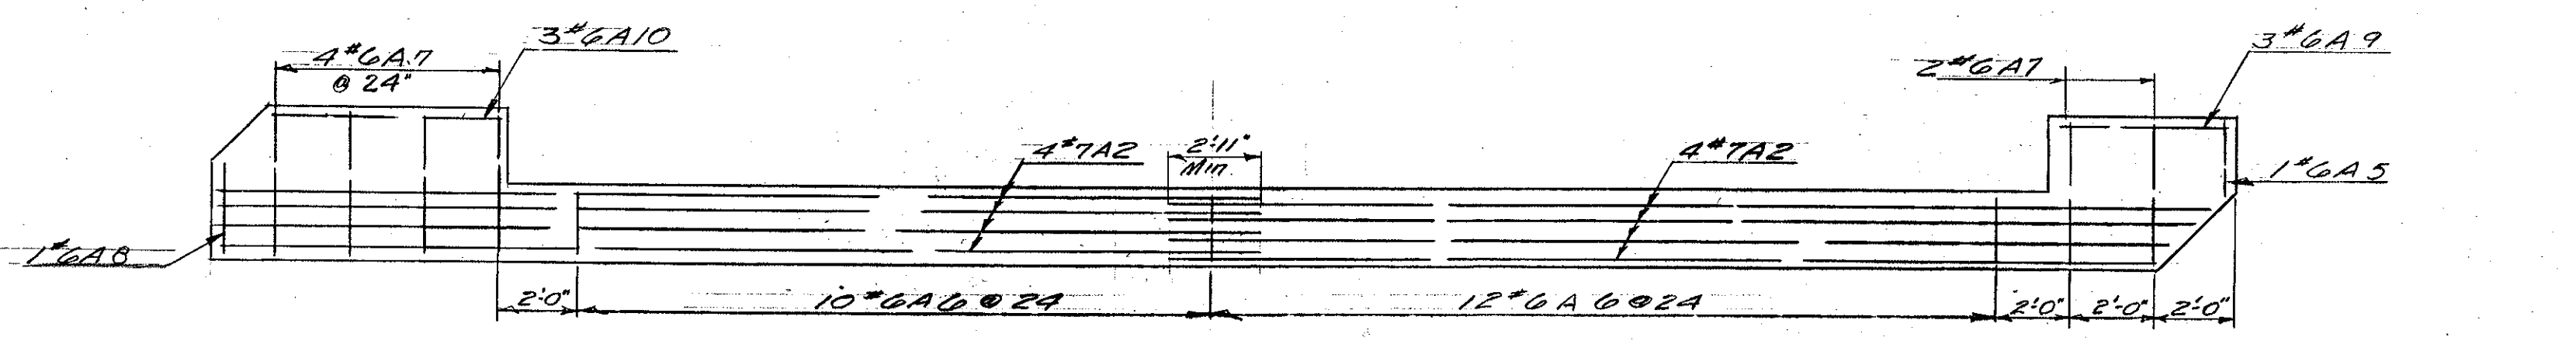

- NOTES:**
- For General Notes see Sh#136
  - For Bearing Devices and Anchor Bolts see Detail E Sh#197
  - For Bridge Marker see Detail W Sh#198
  - Reinforcing in top of Abutment shall be spaced to pass anchor bolts maintaining minimum spacing requirements
  - Steel H Piles to be driven to a minimum Bearing capacity of 35 tons & to Elevation directed by the Engineer.


IM 089-2(26)  
 This sheet for information only  
**BR 43 N & S**

STATE OF VERMONT  
 DEPARTMENT OF HIGHWAYS  
 INTERSTATE PROJECT in the towns of  
 BERLIN - MONTPELIER - MIDDLESEX  
**OVERPASS STA 314+00. STRUCTURE #4  
 EASTBOUND ABUTMENT DETAILS**


BOSWELL ENGINEERING CO.  
 CONSULTING ENGINEERS  
 RIDGEFIELD PARK, N.J.

SURVEYED BY: [Signature] CHECKED BY: [Signature]  
 DRAWN BY: [Signature] IN CHARGE: [Signature]  
 PROJECT NO.: 89-2(3) SHEET 220 OF 307










Item	Description	Unit	Quantity	Notes
407	Asphaltic Asbestos Coating	E. Abut	25	
"	"	W. Abut	28	
408	Reinforcing Steel	E. Abut	25.69	
"	"	W. Abut	25.26	
409	Class B Concrete (Mod)	E. Abut	61	
"	"	W. Abut	61	
504	Steel Piling 10BPA2	E. Abut	575	
"	"	W. Abut	1350	

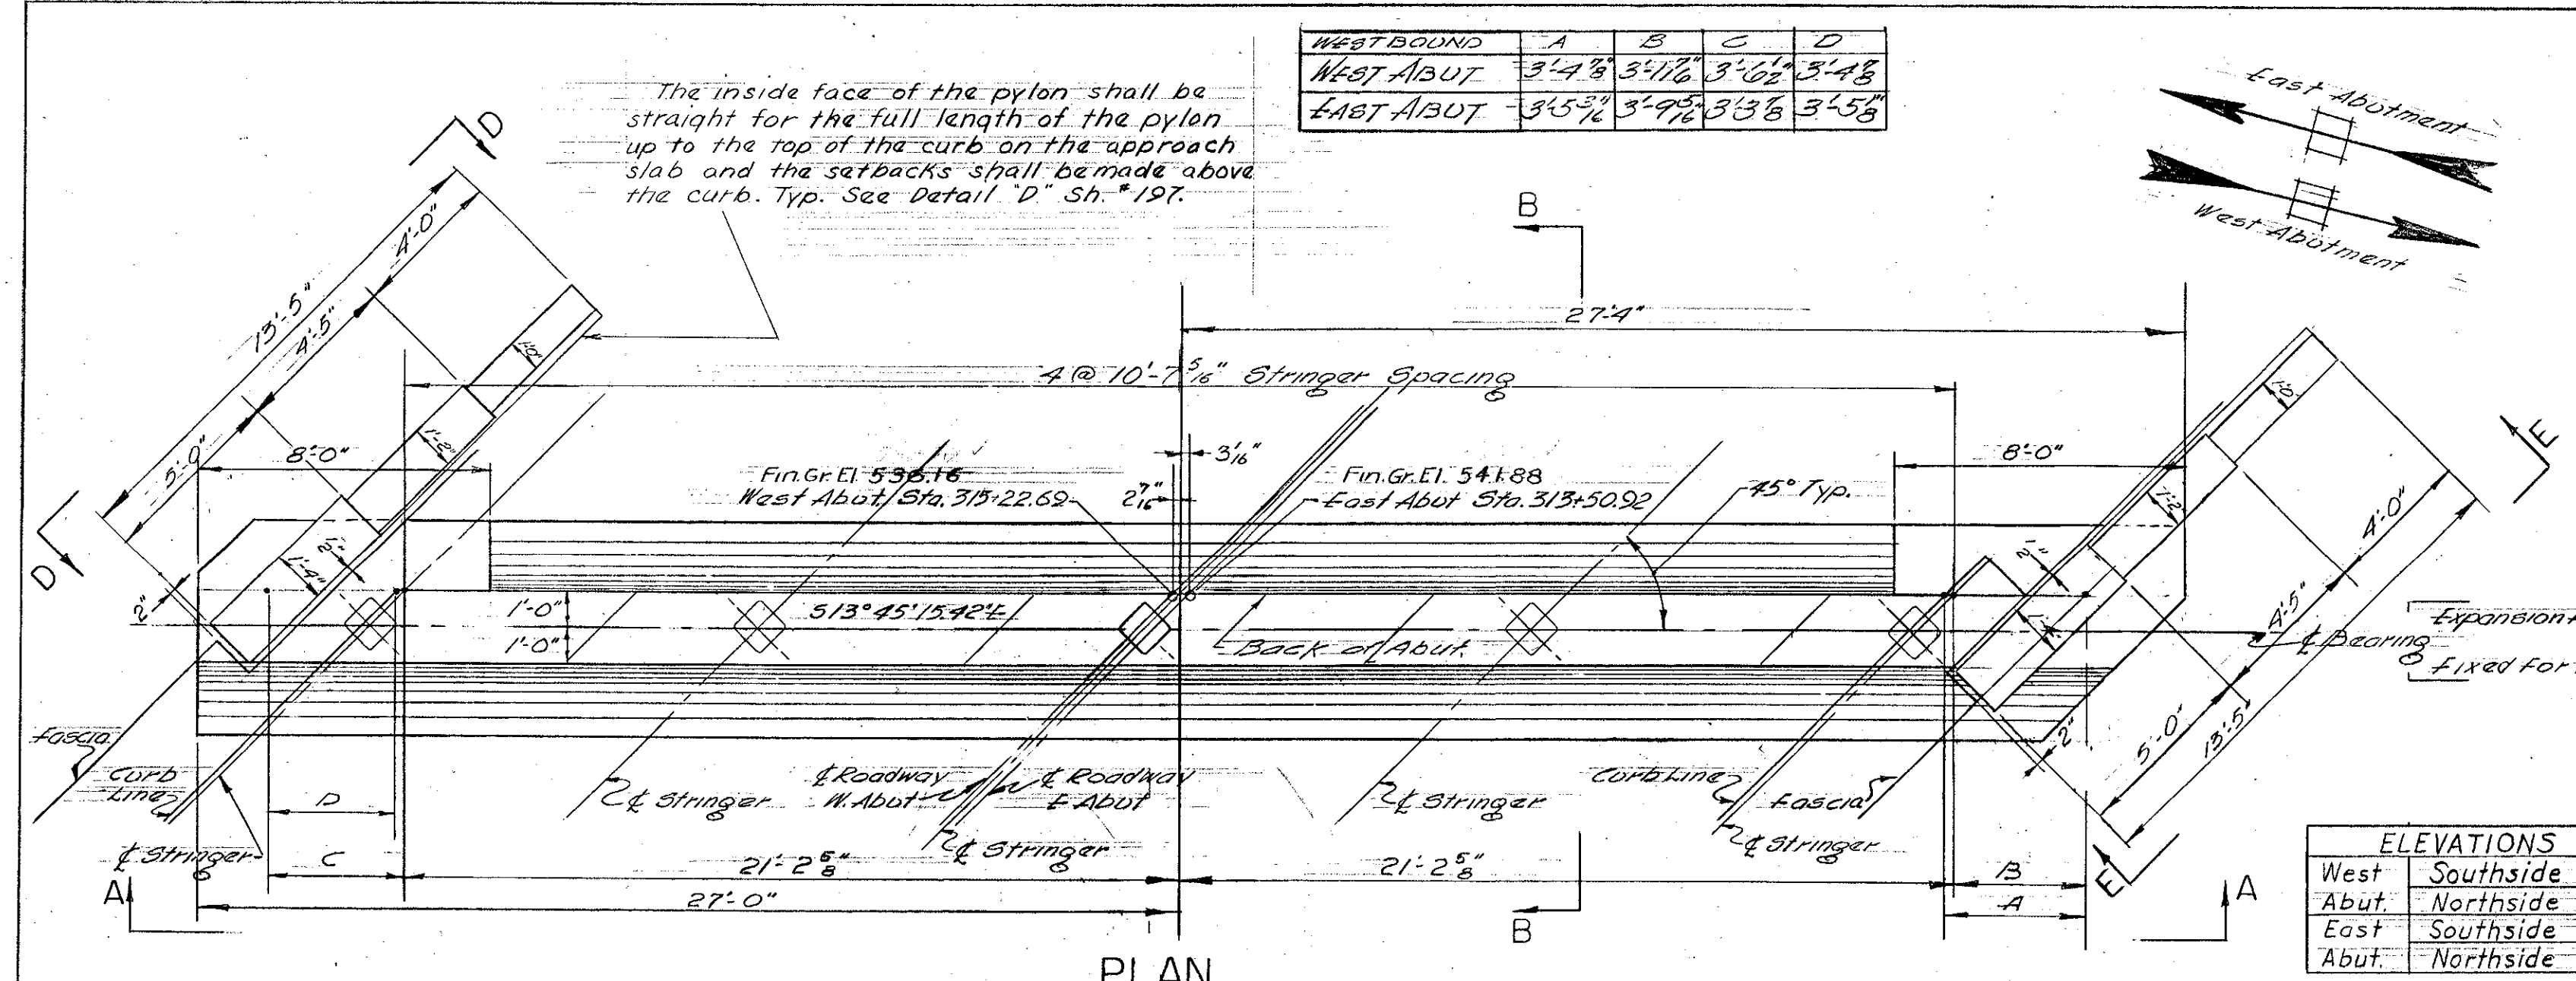

WEST BOUND	A	B	C	D
West Abut	3'-4 1/2"	3'-11 1/2"	3'-0 1/2"	3'-4 1/2"
East Abut	3'-5 1/2"	3'-9 1/2"	3'-3 1/2"	3'-5 1/2"

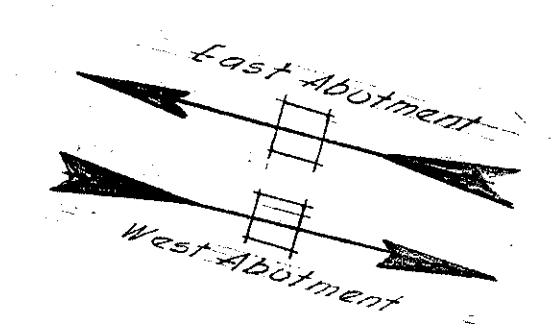

ELEVATIONS		F	G
West	Southside	537.00	533.00
Abut.	Northside	535.96	531.96
East	Southside	543.23	539.23
Abut.	Northside	542.34	538.34

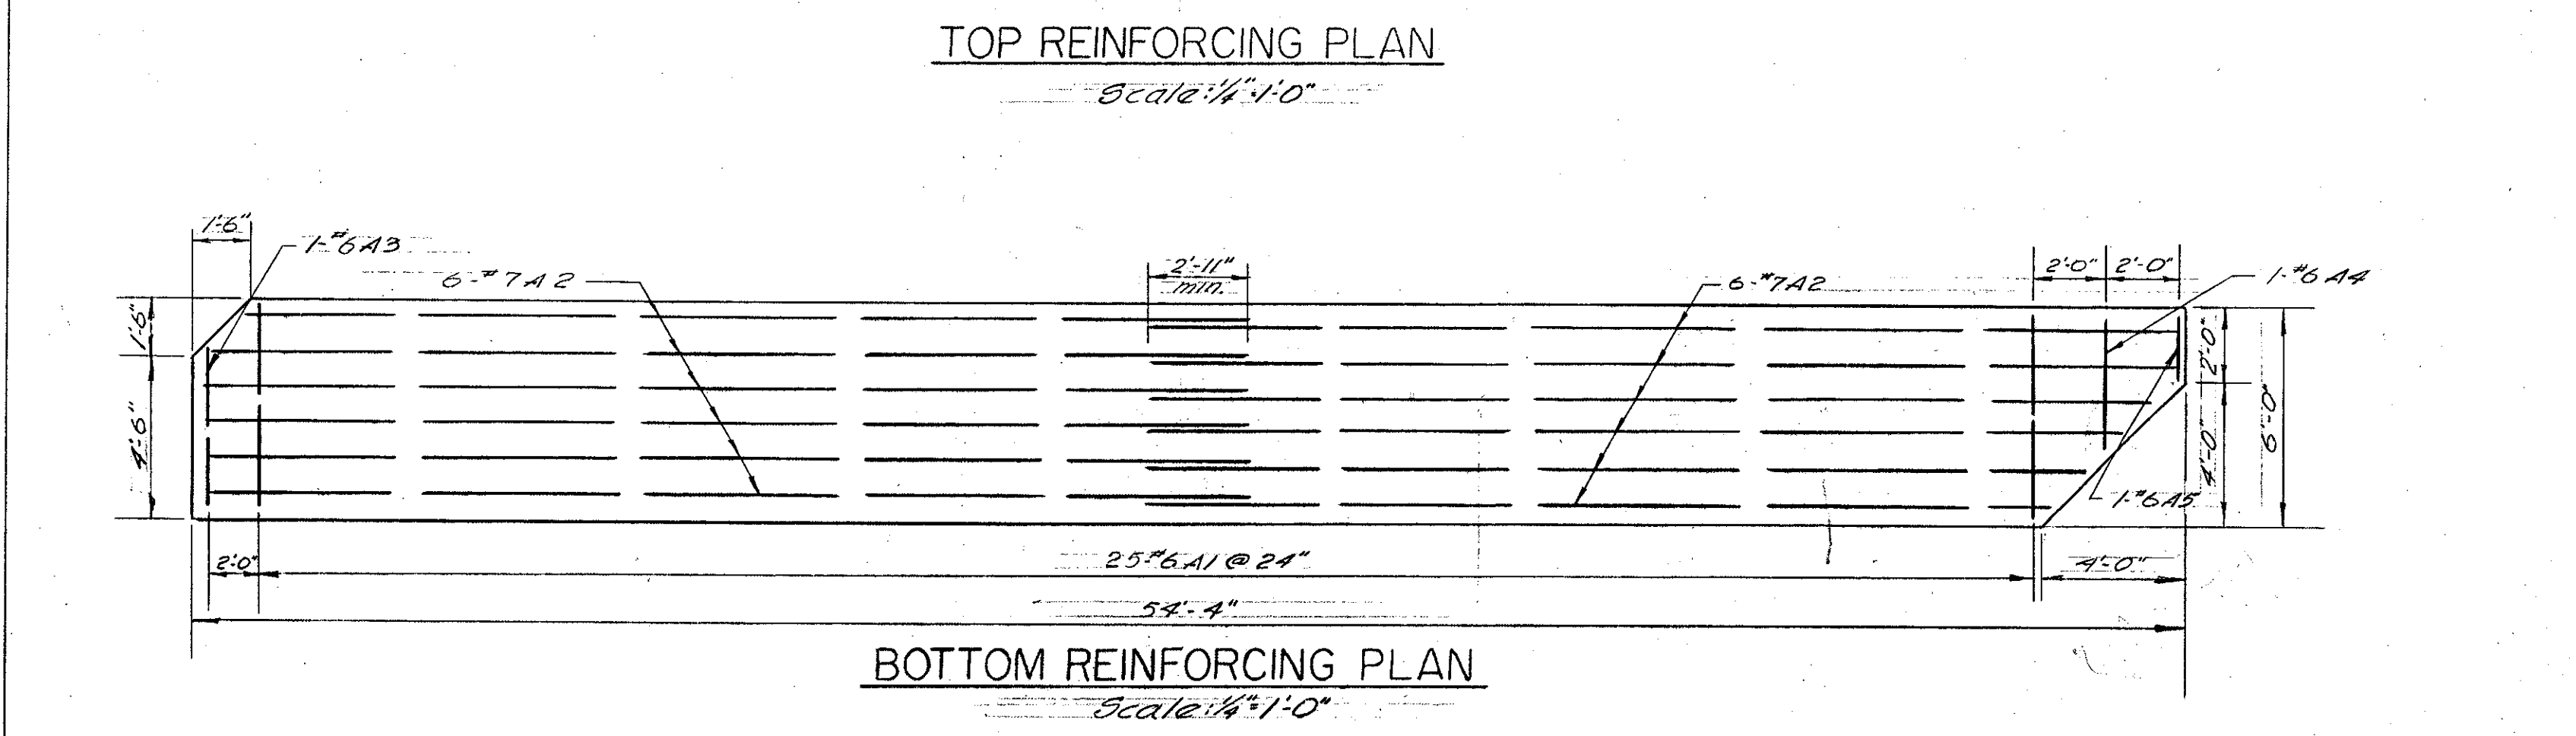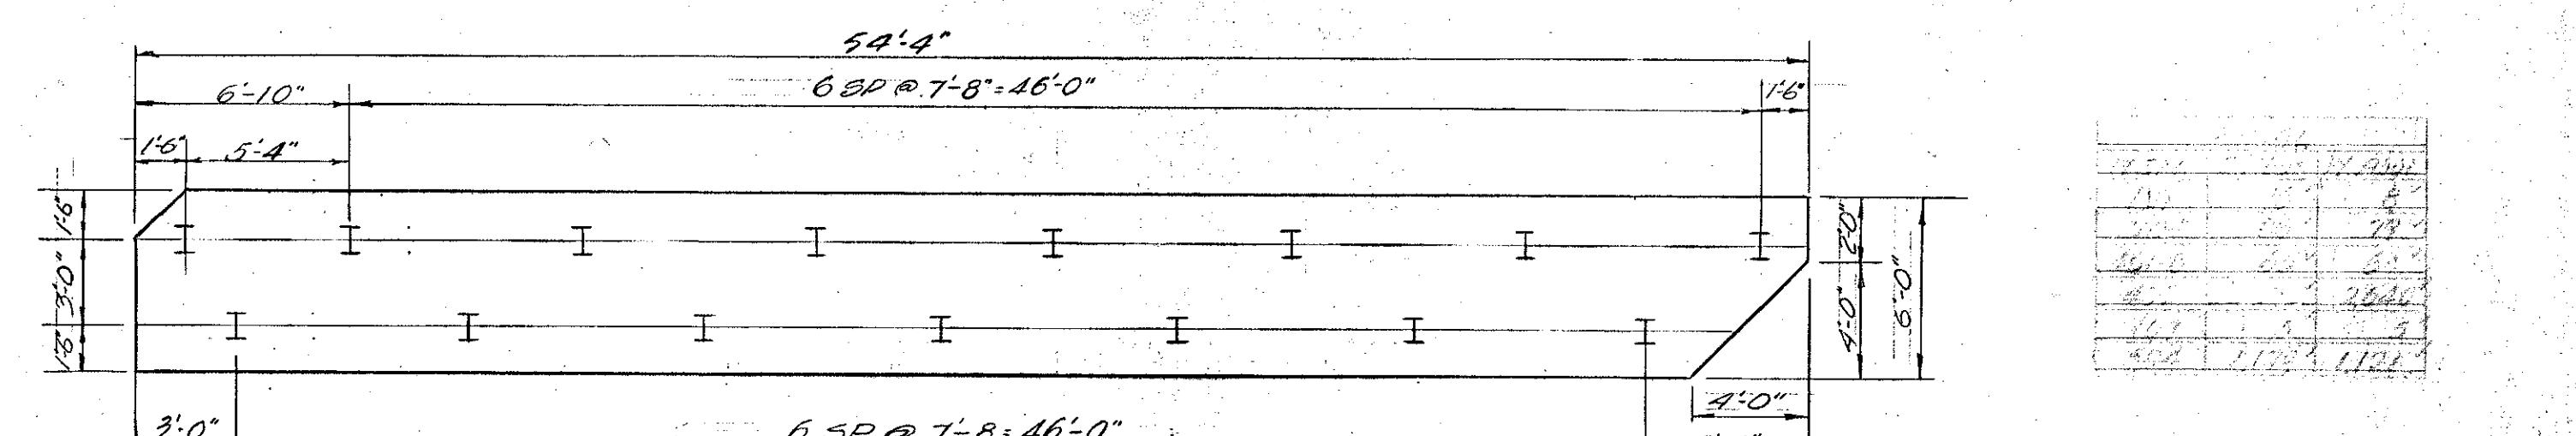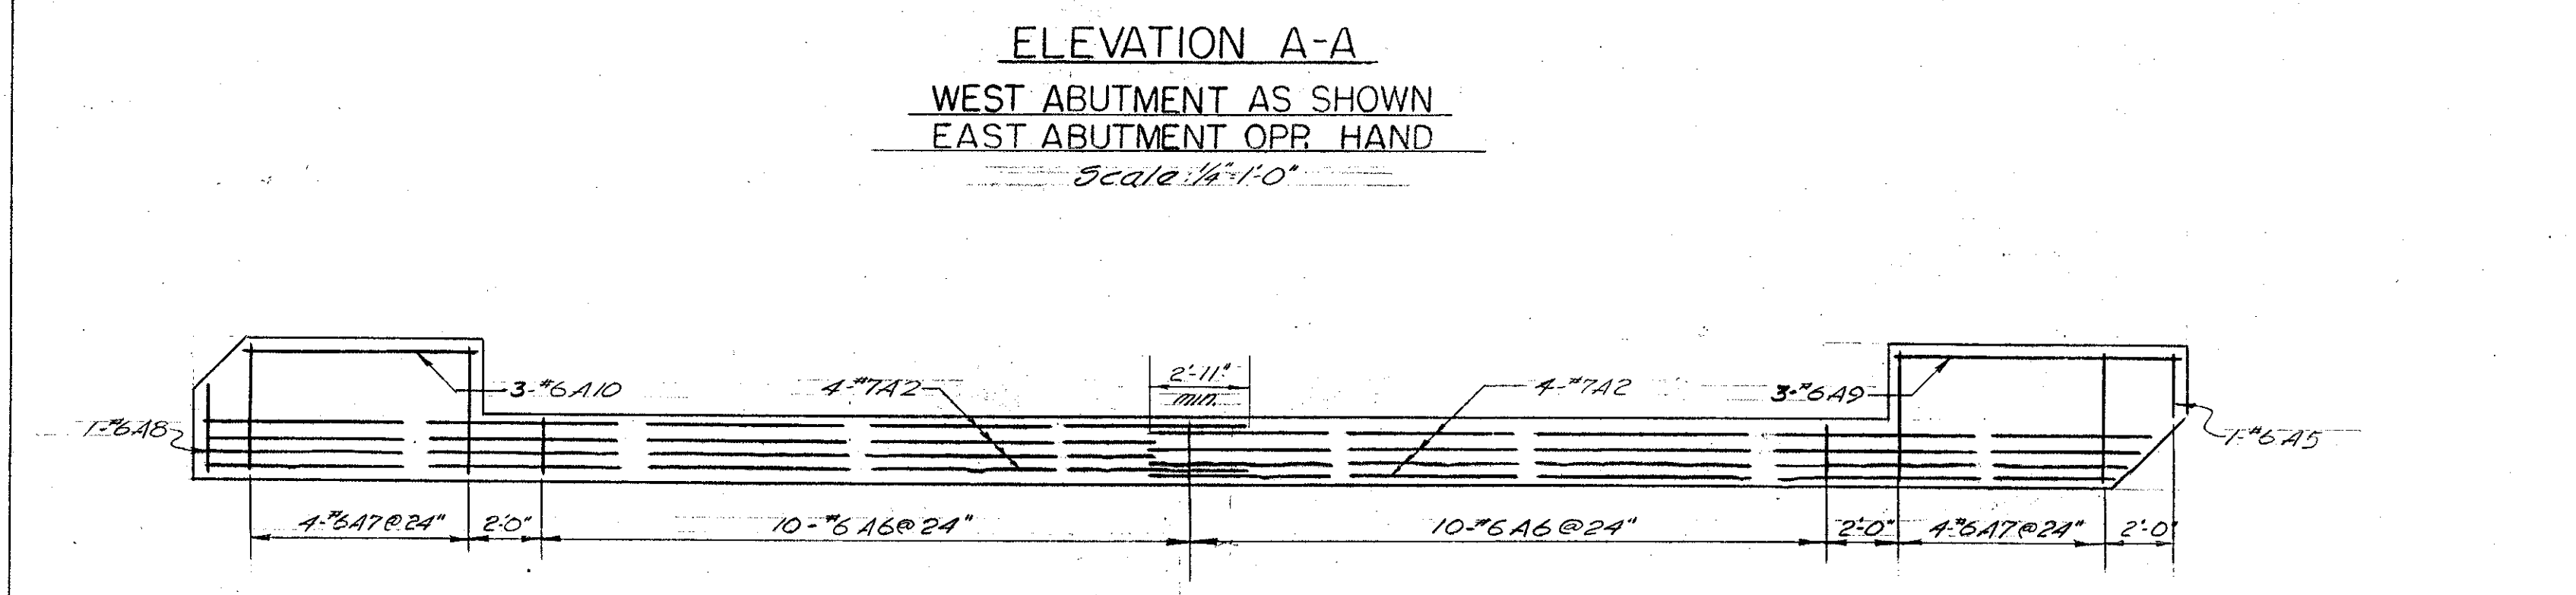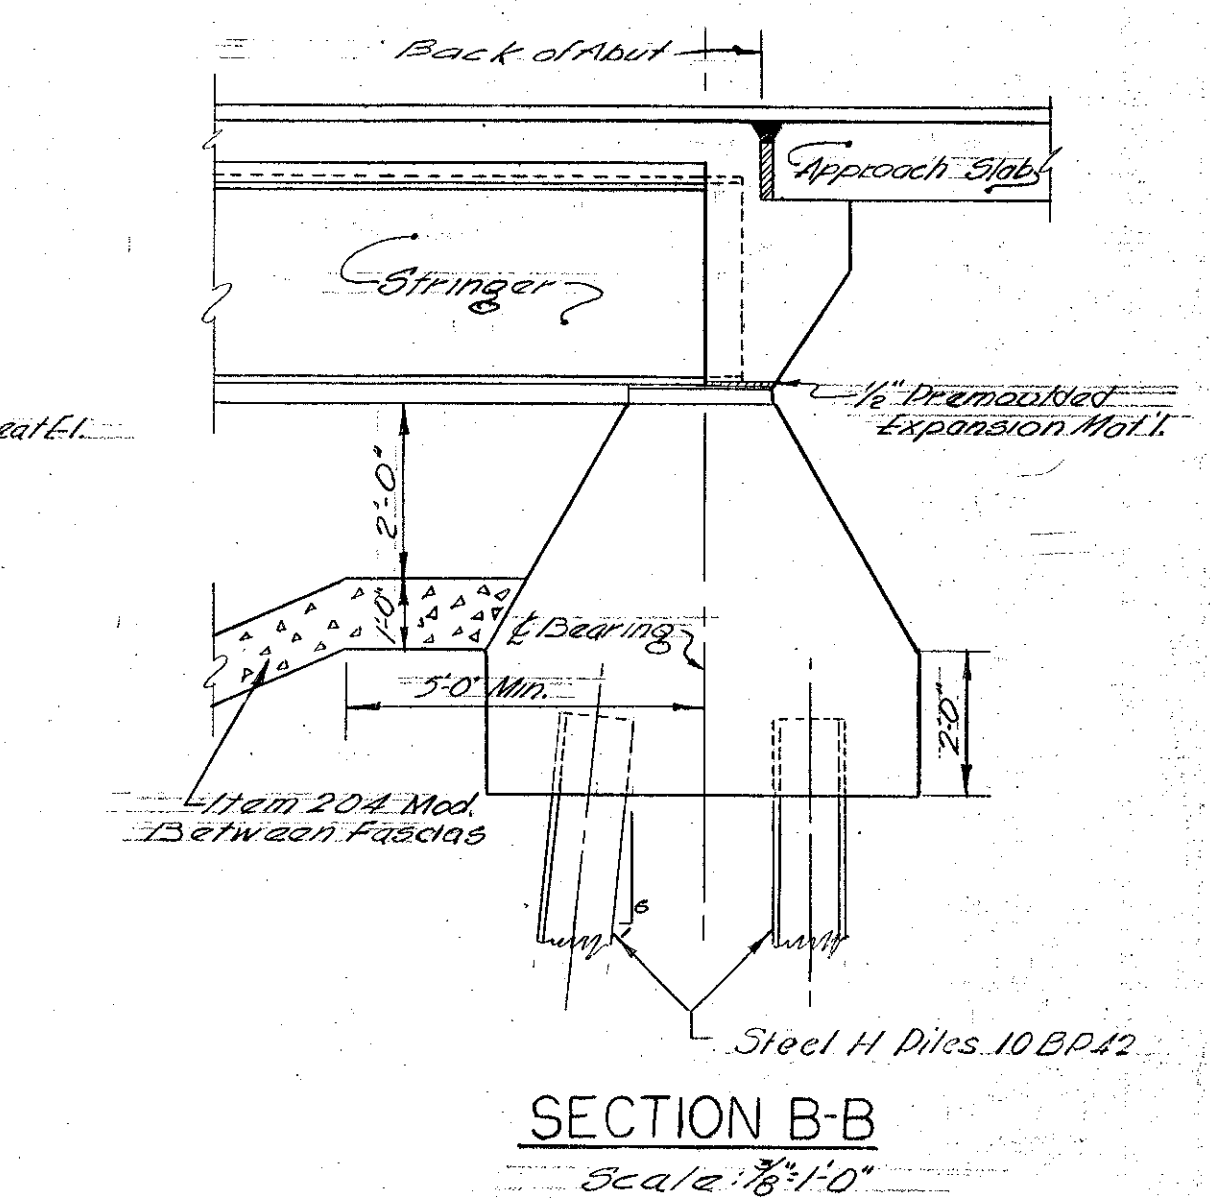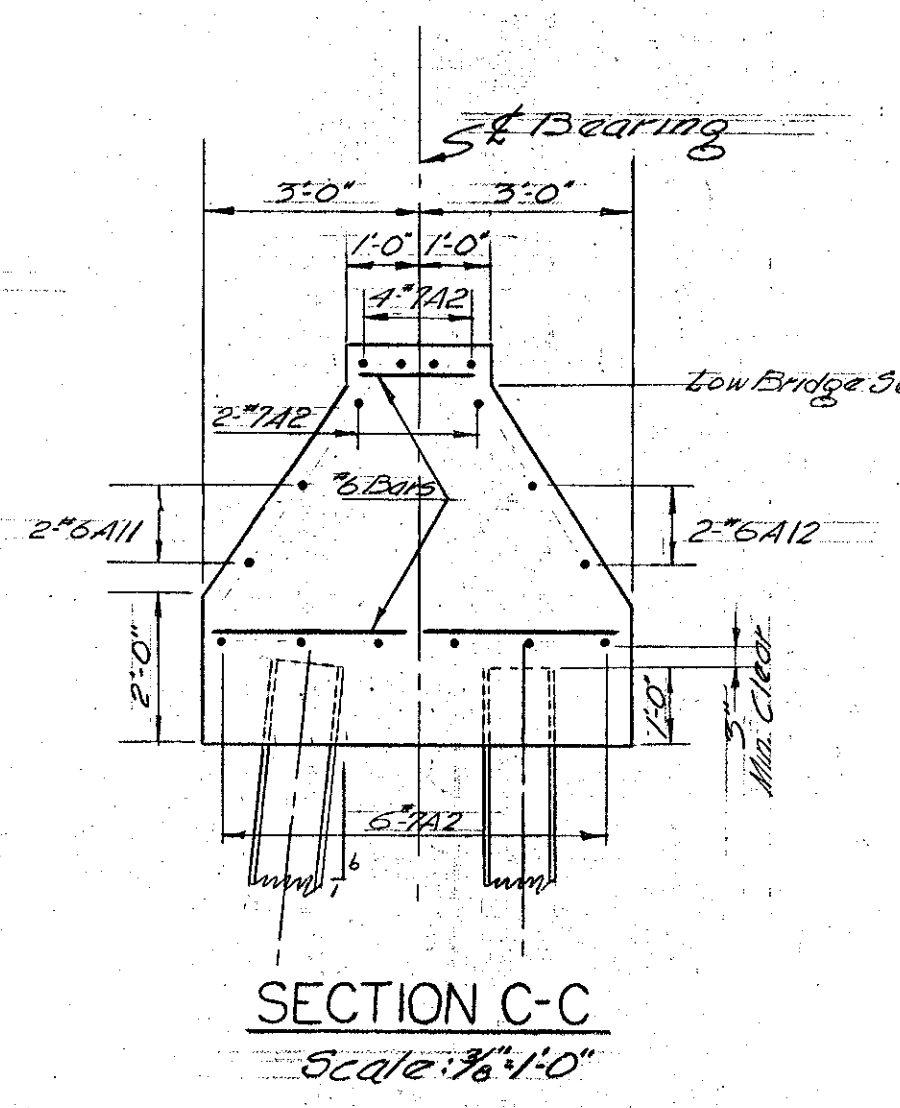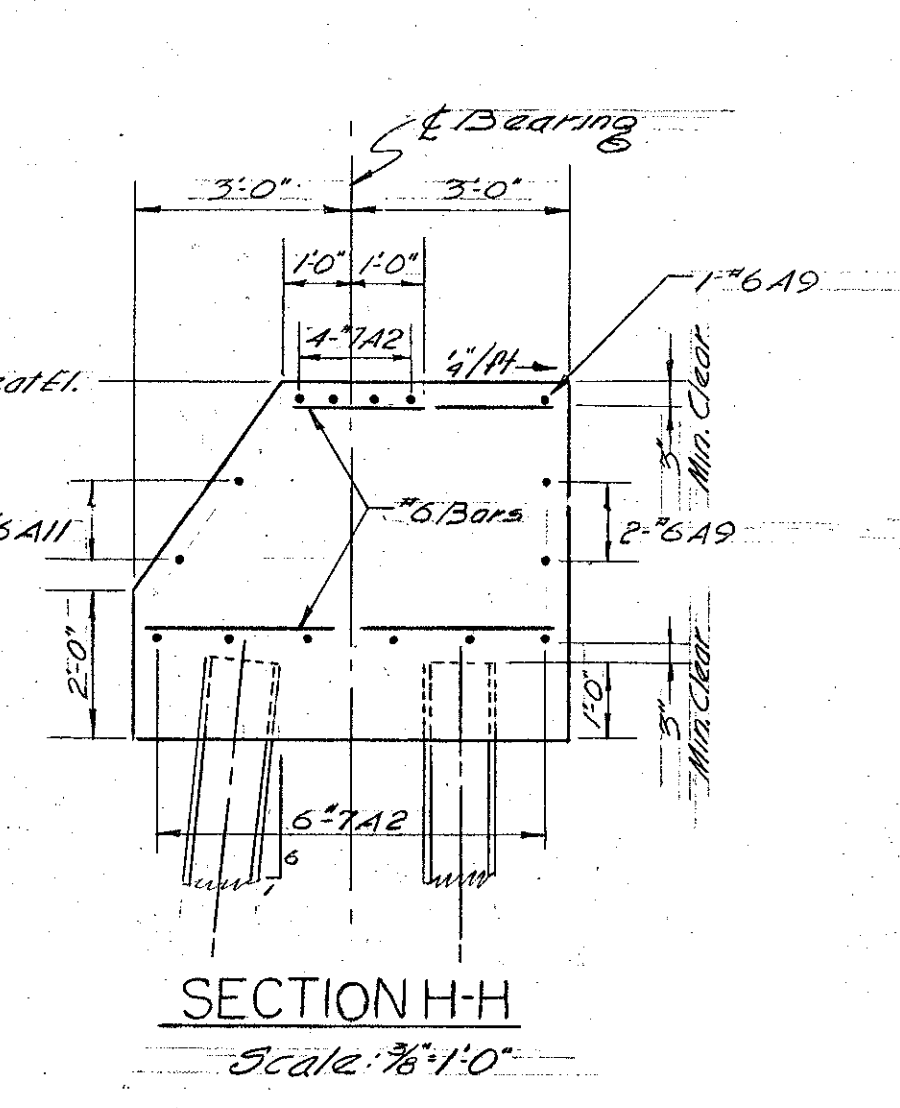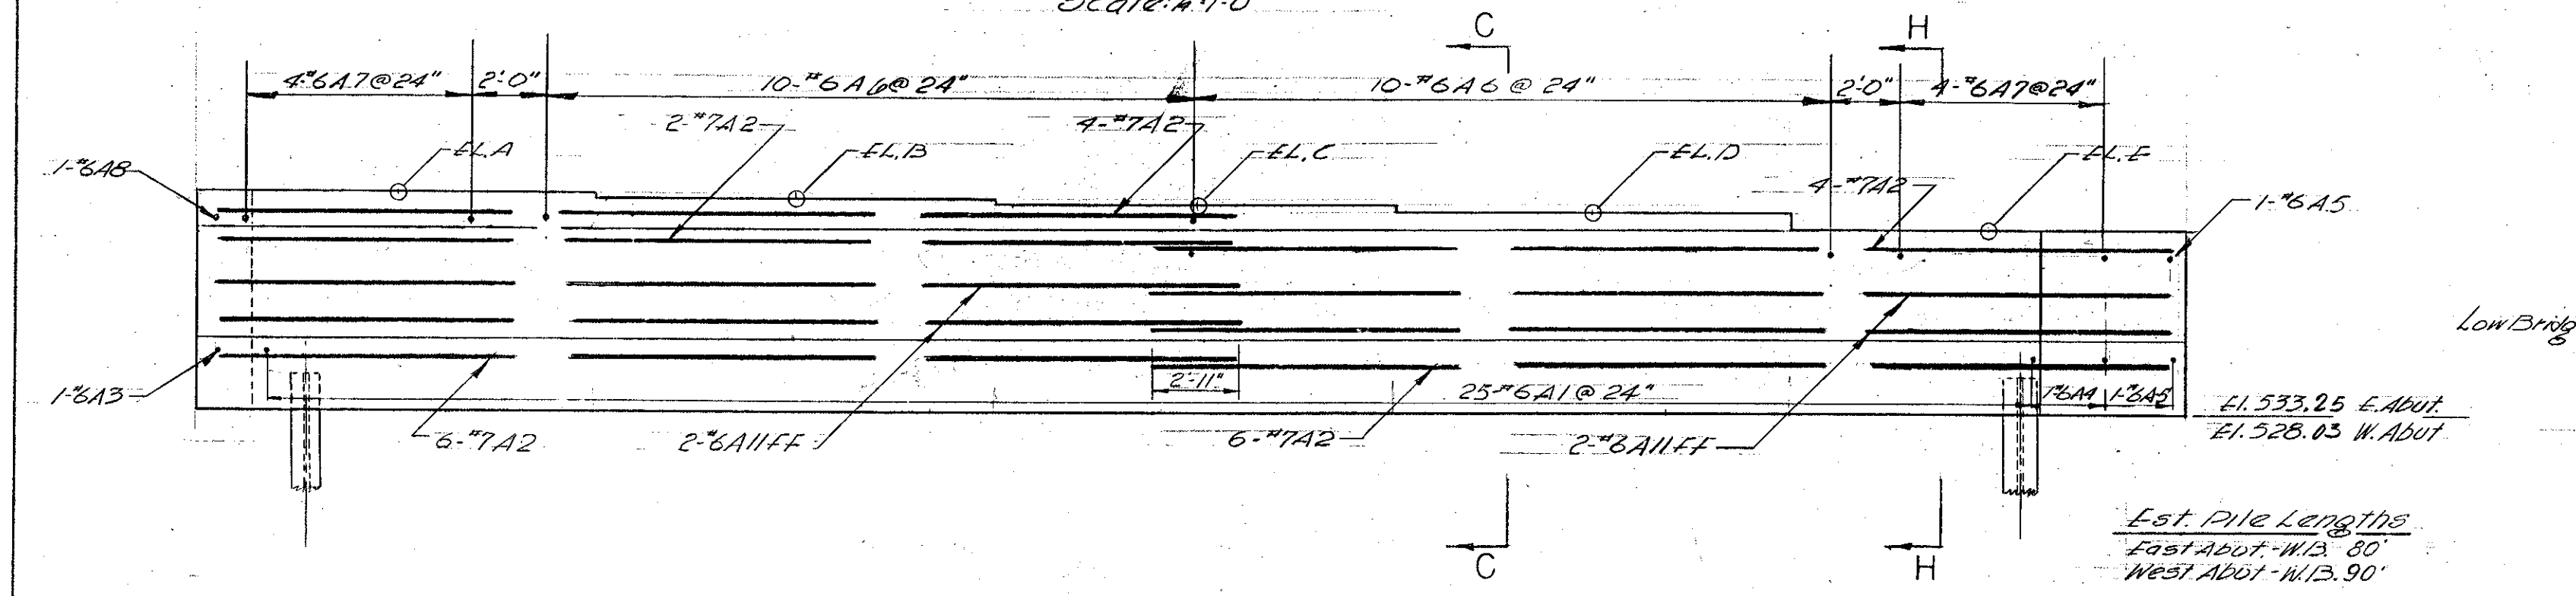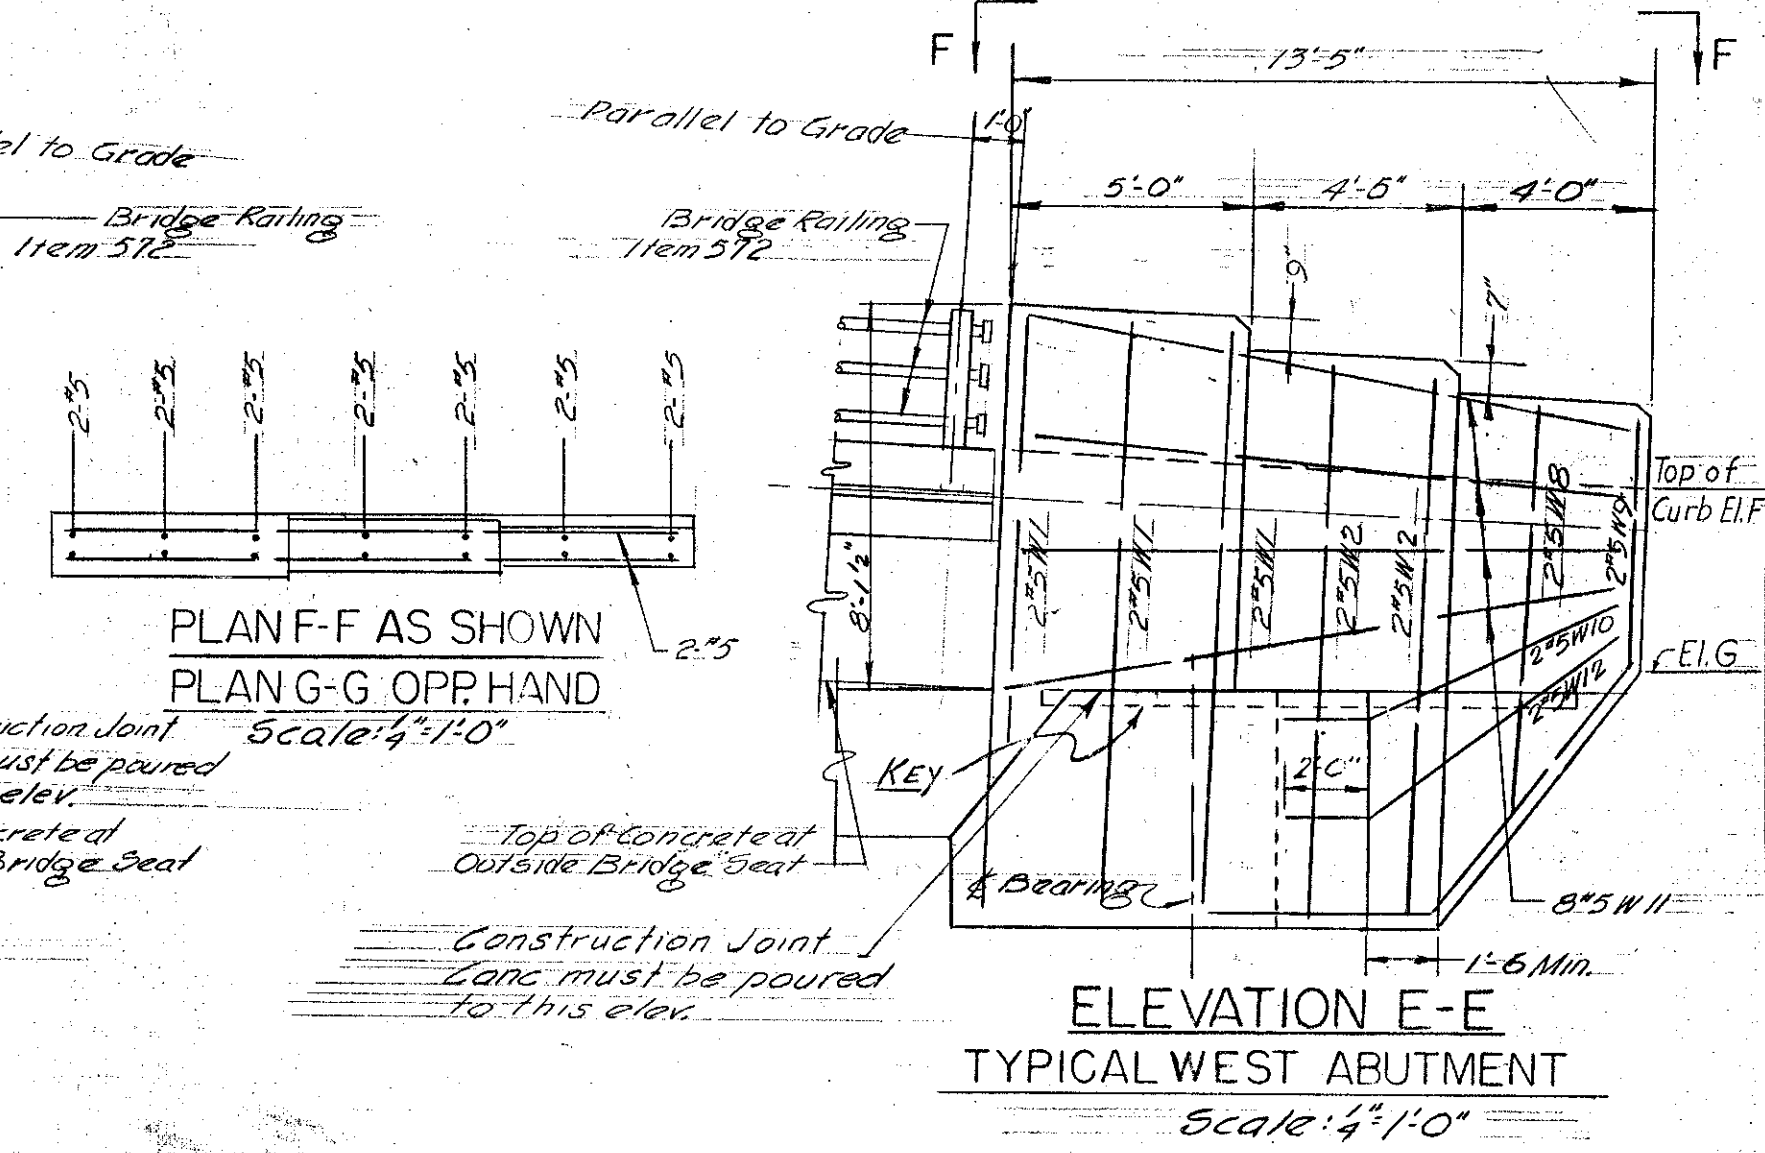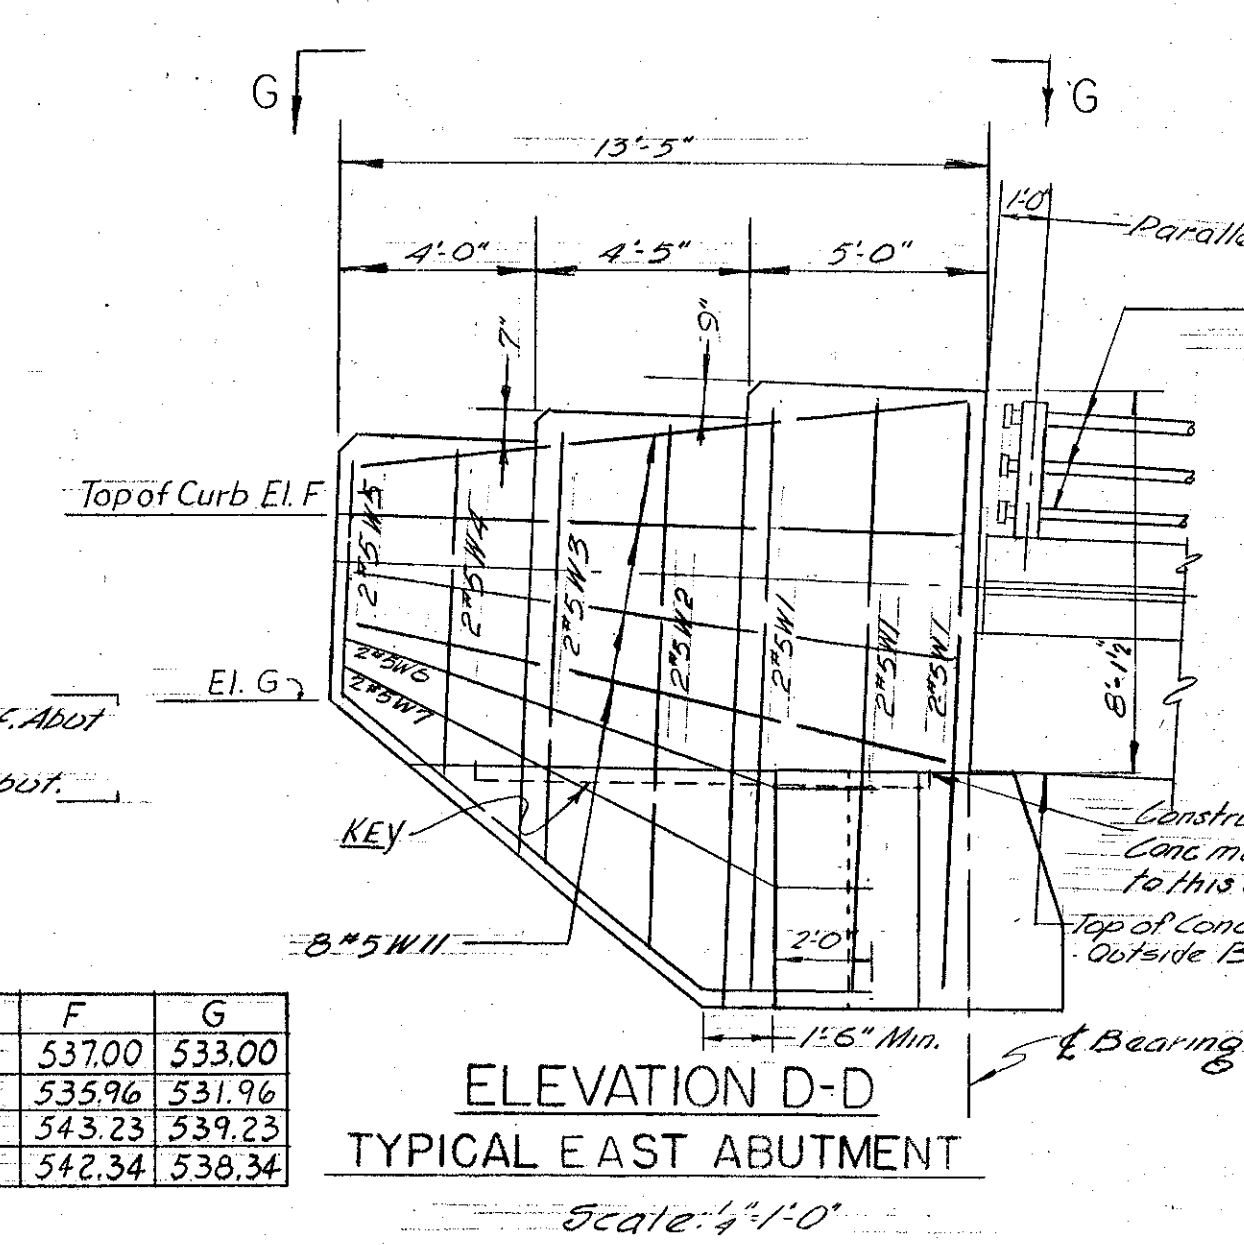

BEARING ELEVATIONS

	ELEV. A	ELEV. B	ELEV. C	ELEV. D	ELEV. E
WEST BOUND					
EAST ABUTMENT	539.09	539.02	538.86	538.60	538.25
WEST ABUTMENT	533.98	533.88	533.50	533.41	533.03

			NEAR	ROUND	
107	Structure Excavation	E Abut	CY	16	13
107	Structure Excavation	W Abut	CY	14	13
204	Sub-Base of Crushed Rock (Mod.)	E Abut	CY	86	90
"	"	W Abut	CY	70	74
407	Asphaltic Asbestos Cool. Mix	E Abut	SY	60	
402	Reinforcing Steel	W Abut	LB	2647	2652
"	"	E Abut	LB	2408	2413
408	Class B Concrete (Mod.)	E Abut	CY	41	44
"	"	W Abut	CY	41	44
504	Steel Piling 10BP42	E Abut	LF	1200	
504	"	W Abut	LF	1350	

IM 089-2(26)  
 This sheet for information only  
**BR 43 N & S**

STATE OF VERMONT  
 DEPARTMENT OF HIGHWAYS

INTERSTATE PROJECT in the towns of  
 BERLIN - MONTPELIER - MIDDLESEX  
 OVERPASS STA. 314+00 STRUCTURE #4  
**WESTBOUND ABUTMENT DETAILS**

BOSWELL ENGINEERING CO.  
 CONSULTING ENGINEERS  
 RIDGEBURY PARK, N.J.



SURVEYED BY **Y.T.** CHECKED BY **M.J.C.** SCALE AS SHOWN  
 DRAWN BY **D.R.F.** IN CHARGE **K.A.** DATE **AUG. 1957**

PROJECT NO. **I 89-2(3)** SHEET **221** OF **307**


**NOTE:**

- For General Notes See Sh. 196
- For Bearing Devices & Anchor Bolts See Detail E Sh. 197
- For Bridge Marker See Detail W Sh. 198
- Reinforcing in top of Abutment shall be spaced to pass Anchor Bolts maintaining minimum spacing requirements
- Steel H Piles to be driven to a Minimum Bearing capacity of 35 tons & to Elevation directed by the Engineer.

Item	No. Pieces	Size	Length	Mark	Type	A	B	C	D	E	F	G	H	J	K	R	O
SPAN #1 WESTBOUND																	
1	74	#5	34'6"	151	STR.												
2	128	#4	27'9"	152	STR.												1'6" 8'6"
3	6	#5	22'1"	153	STR.												1'6" 3'0"
4	29*	#5	4'2"	154	17		2'6"	8"	1'0"								
5	16	#5	24'2"	155	STR.												
6	29	#6	3'0"	156	1	8"	1'8"						8"				6"
7	43	#4	6'6"	156A	52	4 1/2"	2'6"	9"	2'6"				4 1/2"	2 1/2"			
8	20	#6	28'0"	157	STR.												
9	70	#4	4'0"	158	53	4 1/2"	1'4"	1'5"	1'4"				4 1/2"	2 1/2"			
10	20	#5	3'9"	159	STR.												
11			32'0"	@ 6 1/2"	Increments Total 106 Bars												
12	20	#5	2'9"	1510	STR.												
13			32'0"	@ 6 1/2"	Increments Total 112 Bars												
14	12	#5	33'6"	1511	STR.												
15	17*	#8	4'0"	1512	STR.												(SMOOTH)
SPAN #2 WESTBOUND																	
18	124	#5	34'6"	251	STR.												
19	128	#4	37'9"	252	STR.												
20	12	#5	22'1"	253	STR.												
21	56	#5	4'2"	254	17		2'6"	8"	1'0"								
22	20	#6	38'0"	257	STR.												
23	100	#4	4'0"	258	53	4 1/2"	1'4"	1'5"	1'4"				4 1/2"	2 1/2"			
24	20	#5	2'9"	2510	STR.												
25			32'0"	@ 6 1/2"	Increments Total 224 Bars												
26	16	#8	4'0"	2512	STR.												(SMOOTH)
SPAN #3 WESTBOUND																	
29	37	#5	34'6"	351	STR.												
30	129*	#4	22'9"	352	STR.												
31	6	#5	22'4"	353	STR.												
32	28	#5	4'2"	354	17		2'6"	8"	1'0"								
33	16	#5	24'2"	355	STR.												
34	29	#6	3'0"	356	1	8"	1'8"						8"				6"
35	43	#4	6'6"	356A	52	4 1/2"	2'6"	9"	2'6"				4 1/2"	2 1/2"			
36	21*	#6	23'0"	357	STR.												
37	56	#4	4'0"	358	53	4 1/2"	1'4"	1'5"	1'4"				4 1/2"	2 1/2"			
38	20	#5	3'9"	359	STR.												
39			32'0"	@ 6 1/2"	Increments Total 104 Bars												
40	20	#5	2'9"	3510	STR.												
41			32'0"	@ 6 1/2"	Increments Total 112 Bars												
42	12	#5	33'6"	3511	STR.												
SPAN #1 EASTBOUND																	
44	124	#5	34'6"	151	STR.												
45	128	#4	37'9"	152	STR.												
46	6	#5	22'1"	153	STR.												
47	28	#5	4'2"	154	17		2'6"	8"	1'0"								
48	16	#5	24'2"	155	STR.												
49	29	#6	3'0"	156	1	8"	1'8"						8"				6"
50	43	#4	6'6"	156A	52	4 1/2"	2'6"	9"	2'6"				4 1/2"	2 1/2"			
51	20	#6	38'0"	157	STR.												
52	100	#4	4'0"	158	53	4 1/2"	1'4"	1'5"	1'4"				4 1/2"	2 1/2"			
53	20	#5	2'9"	159	STR.												
54			32'0"	@ 6 1/2"	Increments Total 106 Bars												
55	20	#5	2'9"	1510	STR.												
56			32'0"	@ 6 1/2"	Increments Total 112 Bars												
57	12	#5	33'6"	1511	STR.												
58	16	#8	4'0"	1512	STR.												(SMOOTH)
SPAN #2 EASTBOUND																	
62	200	#5	34'6"	251	STR.												
63	128	#4	37'9"	252	STR.												
64	12	#5	22'1"	253	STR.												
65	56	#5	4'2"	254	17		2'6"	8"	1'0"								
66	20	#6	38'0"	257	STR.												
67	100	#4	4'0"	258	53	4 1/2"	1'4"	1'5"	1'4"				4 1/2"	2 1/2"			
68	20	#5	2'9"	2510	STR.												
69			32'0"	@ 6 1/2"	Increments Total 224 Bars												
70	16	#8	4'0"	2512	STR.												(SMOOTH)
SPAN #3 EASTBOUND																	
73	Same as Span #3 Westbound																
PIER #1 WESTBOUND																	
76	30	#10	27'2"	P1	STR.												
77	64	#5	7'6"	P2	STR.												
78	12*	#10	12'0"	P3	STR.												
79	4	#10	26'0"	P4	STR.												
80	8	#10	16'2"	P5	STR.												
81	60	#10	21'2"	P6	STR.												
PIER #1 EASTBOUND																	
101	32	#10	27'5"	P1	STR.												
102	65*	#5	7'6"	P2	STR.												
103	12	#10	12'0"	P3	STR.												
104	4	#10	26'0"	P4	STR.												
105	8	#10	16'2"	P5	STR.												
106	60	#10	21'2"	P6	STR.												
107	60	#10	8'2"	P7	1	1'5"	6'9"										
108	10	#11	17'4"	P8	11	0	8'0"	2'4"	7'0"								1'6" 8'6"
109	8	#5	8'9"	P9	10	2'0"	4'9"	2'0"									1'6" 3'0"
110	4	#11	8'0"	P10	STR.												
111	8	#11	13'11"	P11	STR.												
112	4	#11	27'4"	P12	STR.												
113	7	#11	18'0"	P13	STR.												
114	8	#10	27'4"	P14	STR.												
115	14	#10	18'9"	P15	STR.												
116	8	#5	23'4"	P16	STR.												
117	92	#4	10'5"	P17	7	4 1/2"	1'4"	3'0"	1'4"	3'0"			4 1/2"				
118	59	#4	11'4"	P18	7												
119																	
PIER #2 EASTBOUND																	
121	Same as Pier #1 Eastbound Except as Noted																
122	60	#10	8'2"	P6	STR.												
123	54	#4	11'11"	P18	7												
124																	
125	EAST ABUTMENT WESTBOUND																
126	25	#6	5'6"	A1	STR.												
127	23*	#7	28'5"	A2	STR.												
128	2*	#2	4'3"	A3	STR.												
129	1	#6	3'9"	A4	STR.												
130	2	#6	1'9"	A5	STR.												
131	20	#6	1'6"	A6	STR.												
132	8	#6	3'6"	A7	STR.												
133	1	#6	2'3"	A8	STR.												
134	3	#6	7'6"	A9	STR.												
135	3	#6	6'3"	A10	STR.												
136	4	#6	26'11"	A11	STR.												
137	4	#6	20'5"	A12	STR.												
138	12	#5	12'3"	W1	STR.		</										

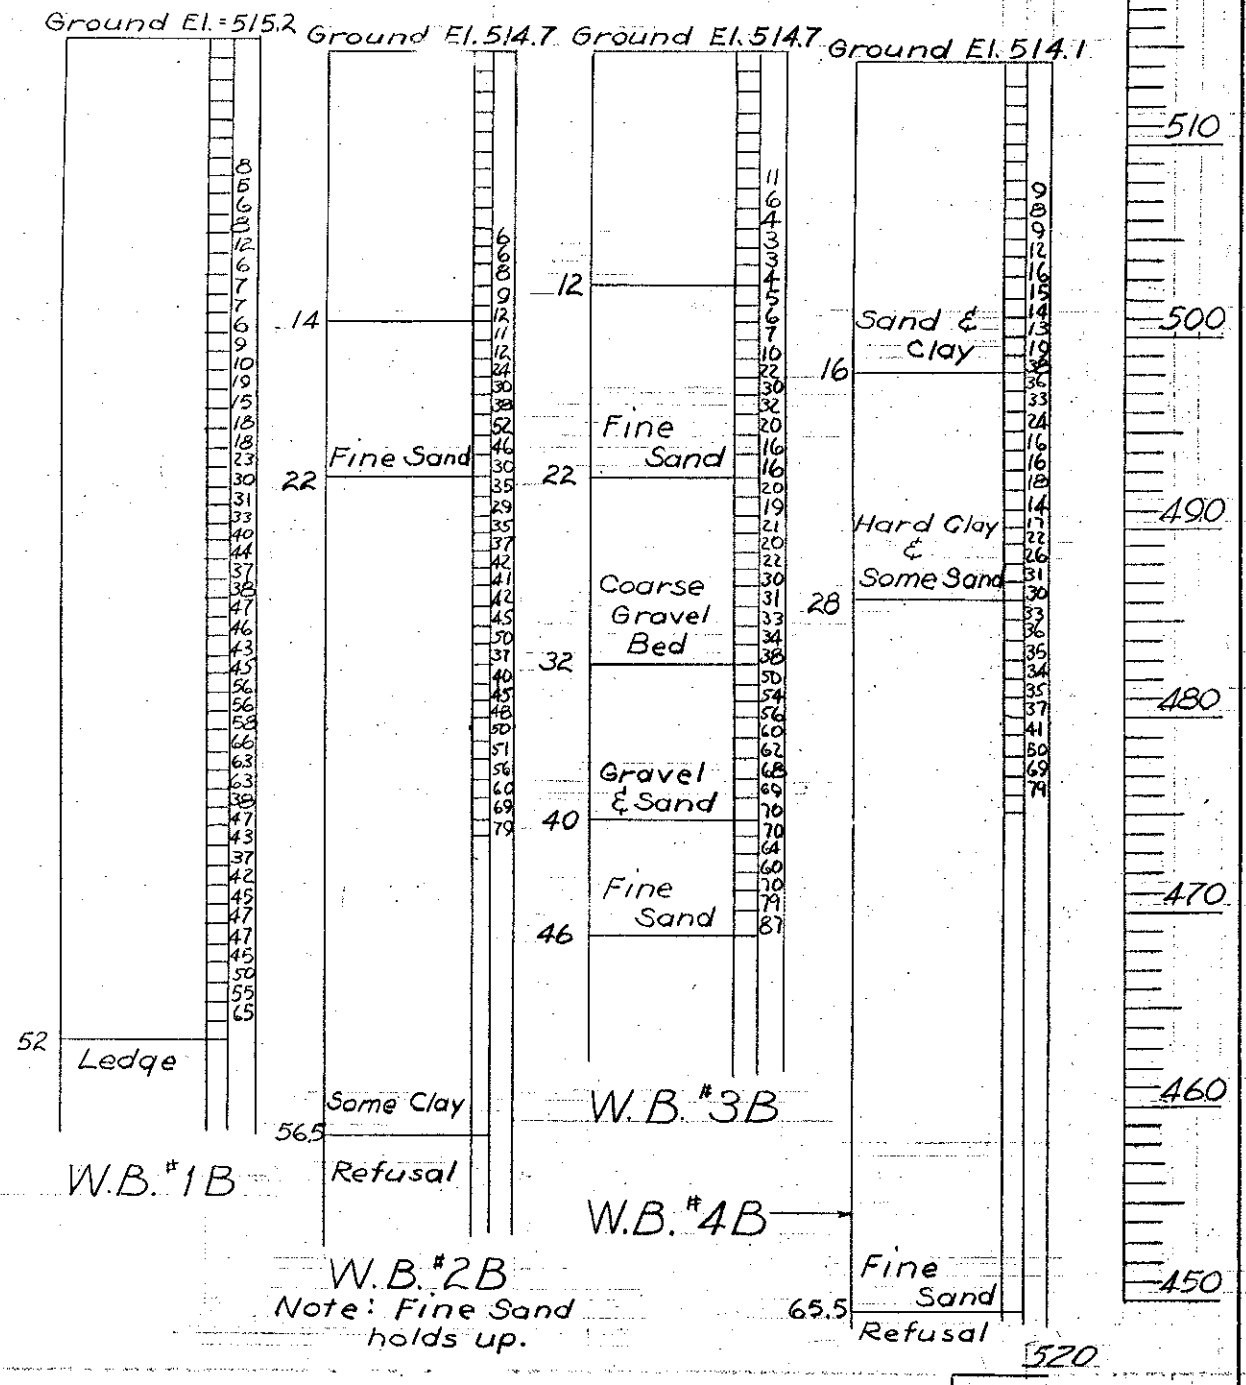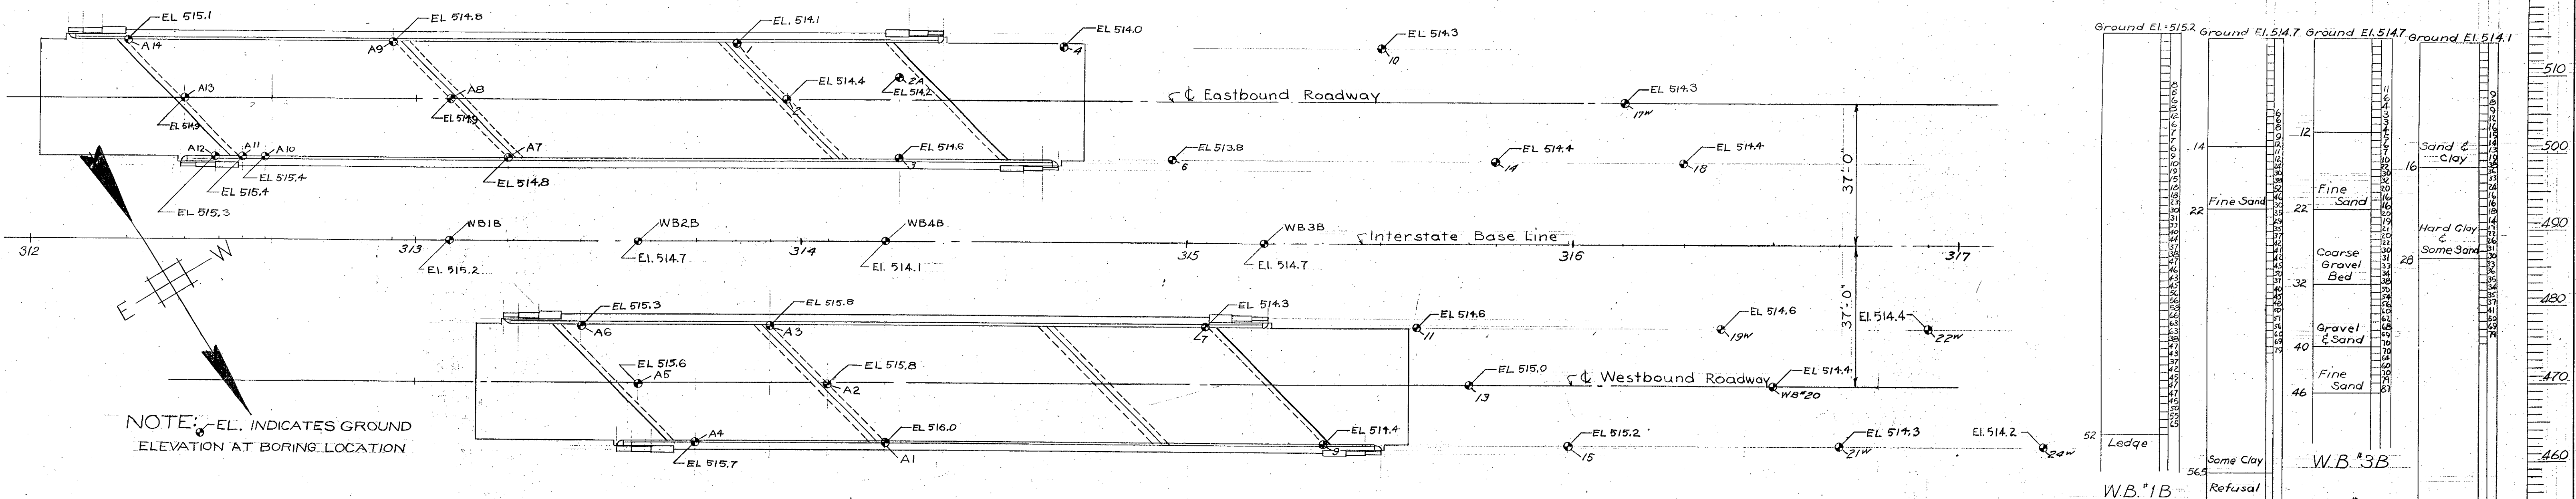

BORING LOCATION PLAN  
 SCALE 1" = 20'

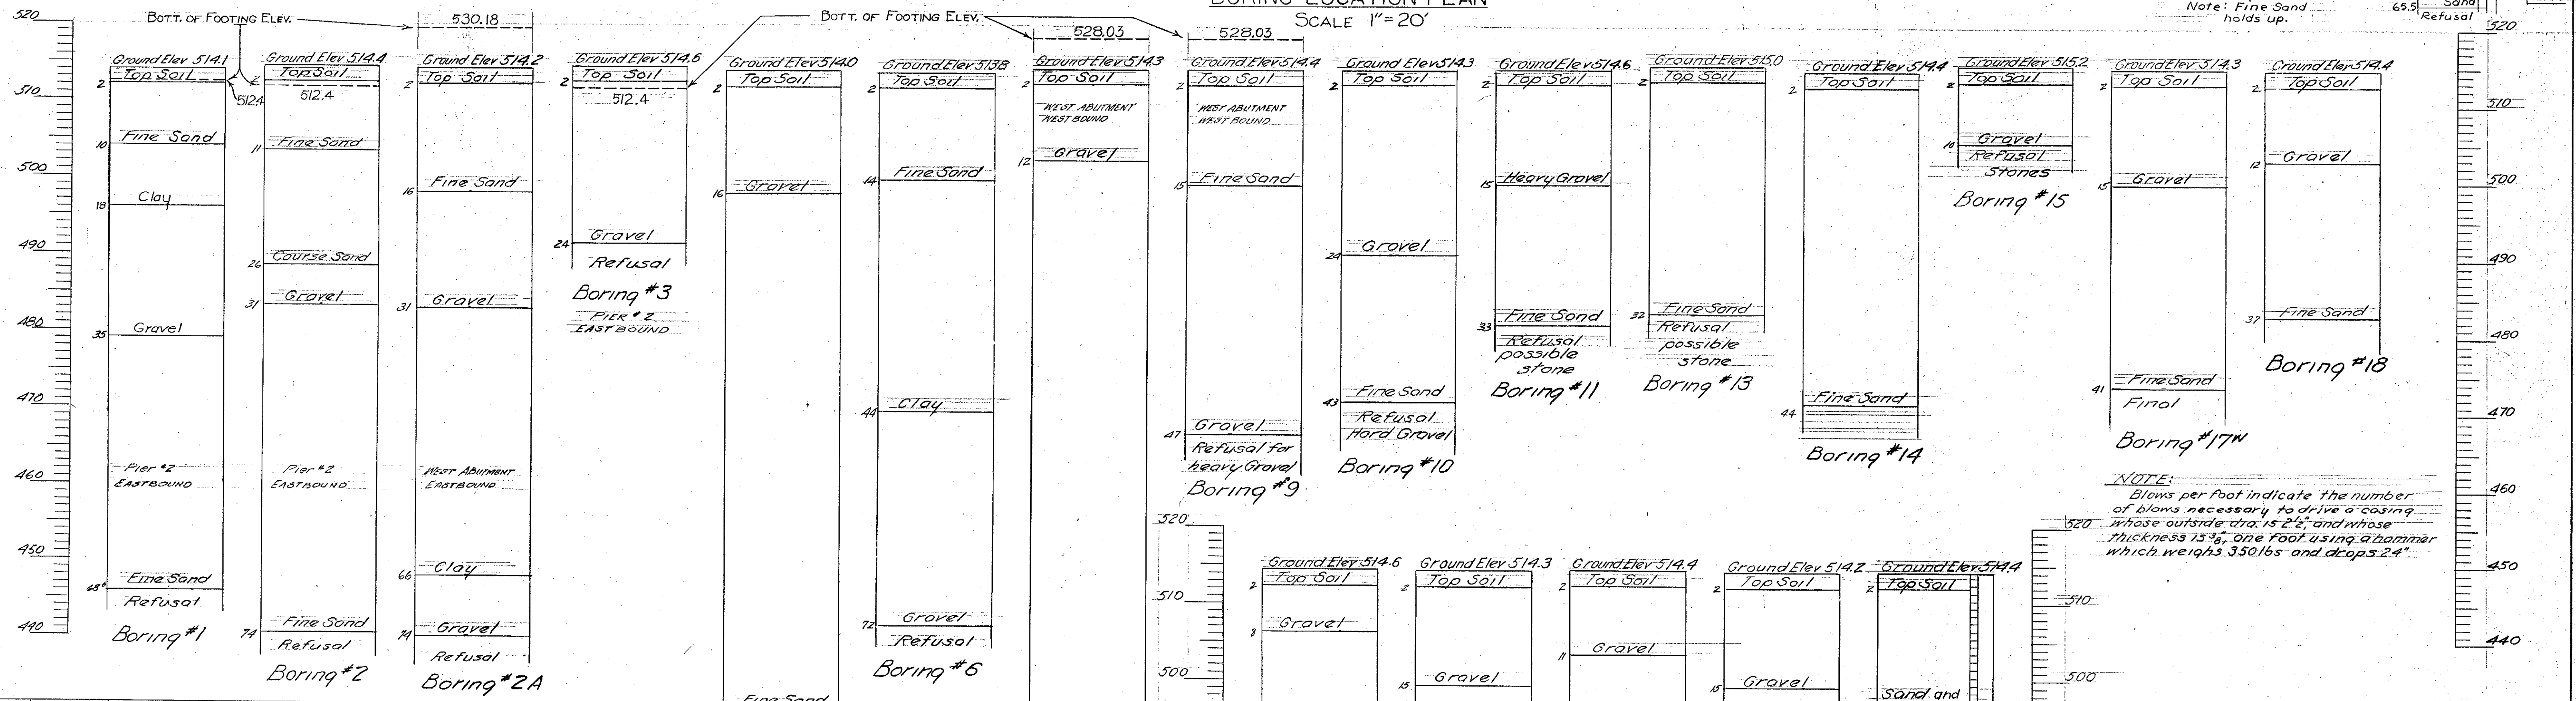

NOTE:  
 Blows per foot indicate the number of blows necessary to drive a casing whose outside diameter is 2 1/2" and whose thickness is 3/8". One foot using a hammer which weighs 350 lbs and drops 24".

BORING No.	STATION	OFFSET	ELEVATION	BORING DEPTH	MATERIAL AT BOTTOM OF BORING	BOTT. OF FTG. EL.	LOCATION
A1	314 + 22	RT 52	516.0	55	FINE SAND	511.48	PIER #1 W.B.
A2	314 + 07	RT 37	515.8	55	FINE SAND	511.48	PIER #1 W.B.
A3	313 + 92	RT 22	515.8	55	FINE SAND	511.48	PIER #1 W.B.
A4	313 + 73	RT 52	515.7	55	FINE SAND	533.25	EAST ABUT. W.B.
A5	313 + 58	RT 37	515.6	55	FINE SAND	533.25	EAST ABUT. W.B.
A6	313 + 43	RT 22	515.3	55	FINE SAND	533.25	EAST ABUT. W.B.
A7	313 + 24	LT 22	514.8	55	FINE SAND	513.00	PIER #1 E.B.
A8	313 + 09	LT 37	514.9	65	FINE SAND	513.00	PIER #1 E.B.
A9	312 + 94	LT 52	514.8	55	FINE SAND	513.00	PIER #1 E.B.
A10	312 + 61	LT 22	515.4	7	LEDGE	535.11	EAST ABUT. E.B.
A11	312 + 55	LT 22	515.4	8	LEDGE	535.11	EAST ABUT. E.B.
A12	312 + 49	LT 22	515.3	9	LEDGE	535.11	EAST ABUT. E.B.
A13	312 + 40	LT 37	514.9	10	LEDGE	535.11	EAST ABUT. E.B.
A14	312 + 25	LT 52	515.1	7	LEDGE	535.11	EAST ABUT. E.B.

Note: West side of dirt roadway

IM 089-2(26)  
 This sheet for information only  
**BR 43 N & S**

STATE OF VERMONT  
 DEPARTMENT OF HIGHWAYS


INTERSTATE PROJECT in the towns of  
 BERLIN - MONTPELIER - MIDDLESEX  
**OVERPASS STA. 314+00 STRUCTURE 2**  
**BORING LOGS**

BOSWELL ENGINEERING CO.  
 CONSULTING ENGINEERS  
 RINGFIELD PARK, N. J.

SURVEYED BY: *RAE* CHECKED BY: *A.J.L.* SCALE: *AS SHOWN*  
 DRAWN BY: *RAE* IN CHARGE: *RAE* DATE: *AUG. 1957*  
 PROJECT NO. 1089-2(13) SHEET 223 OF 307



B. P. R. DIV. NO.	STATE	PROJECT NO.	SHEET NO.	TOTAL SHEETS
1	VT.	1-89-2(7)	80	220

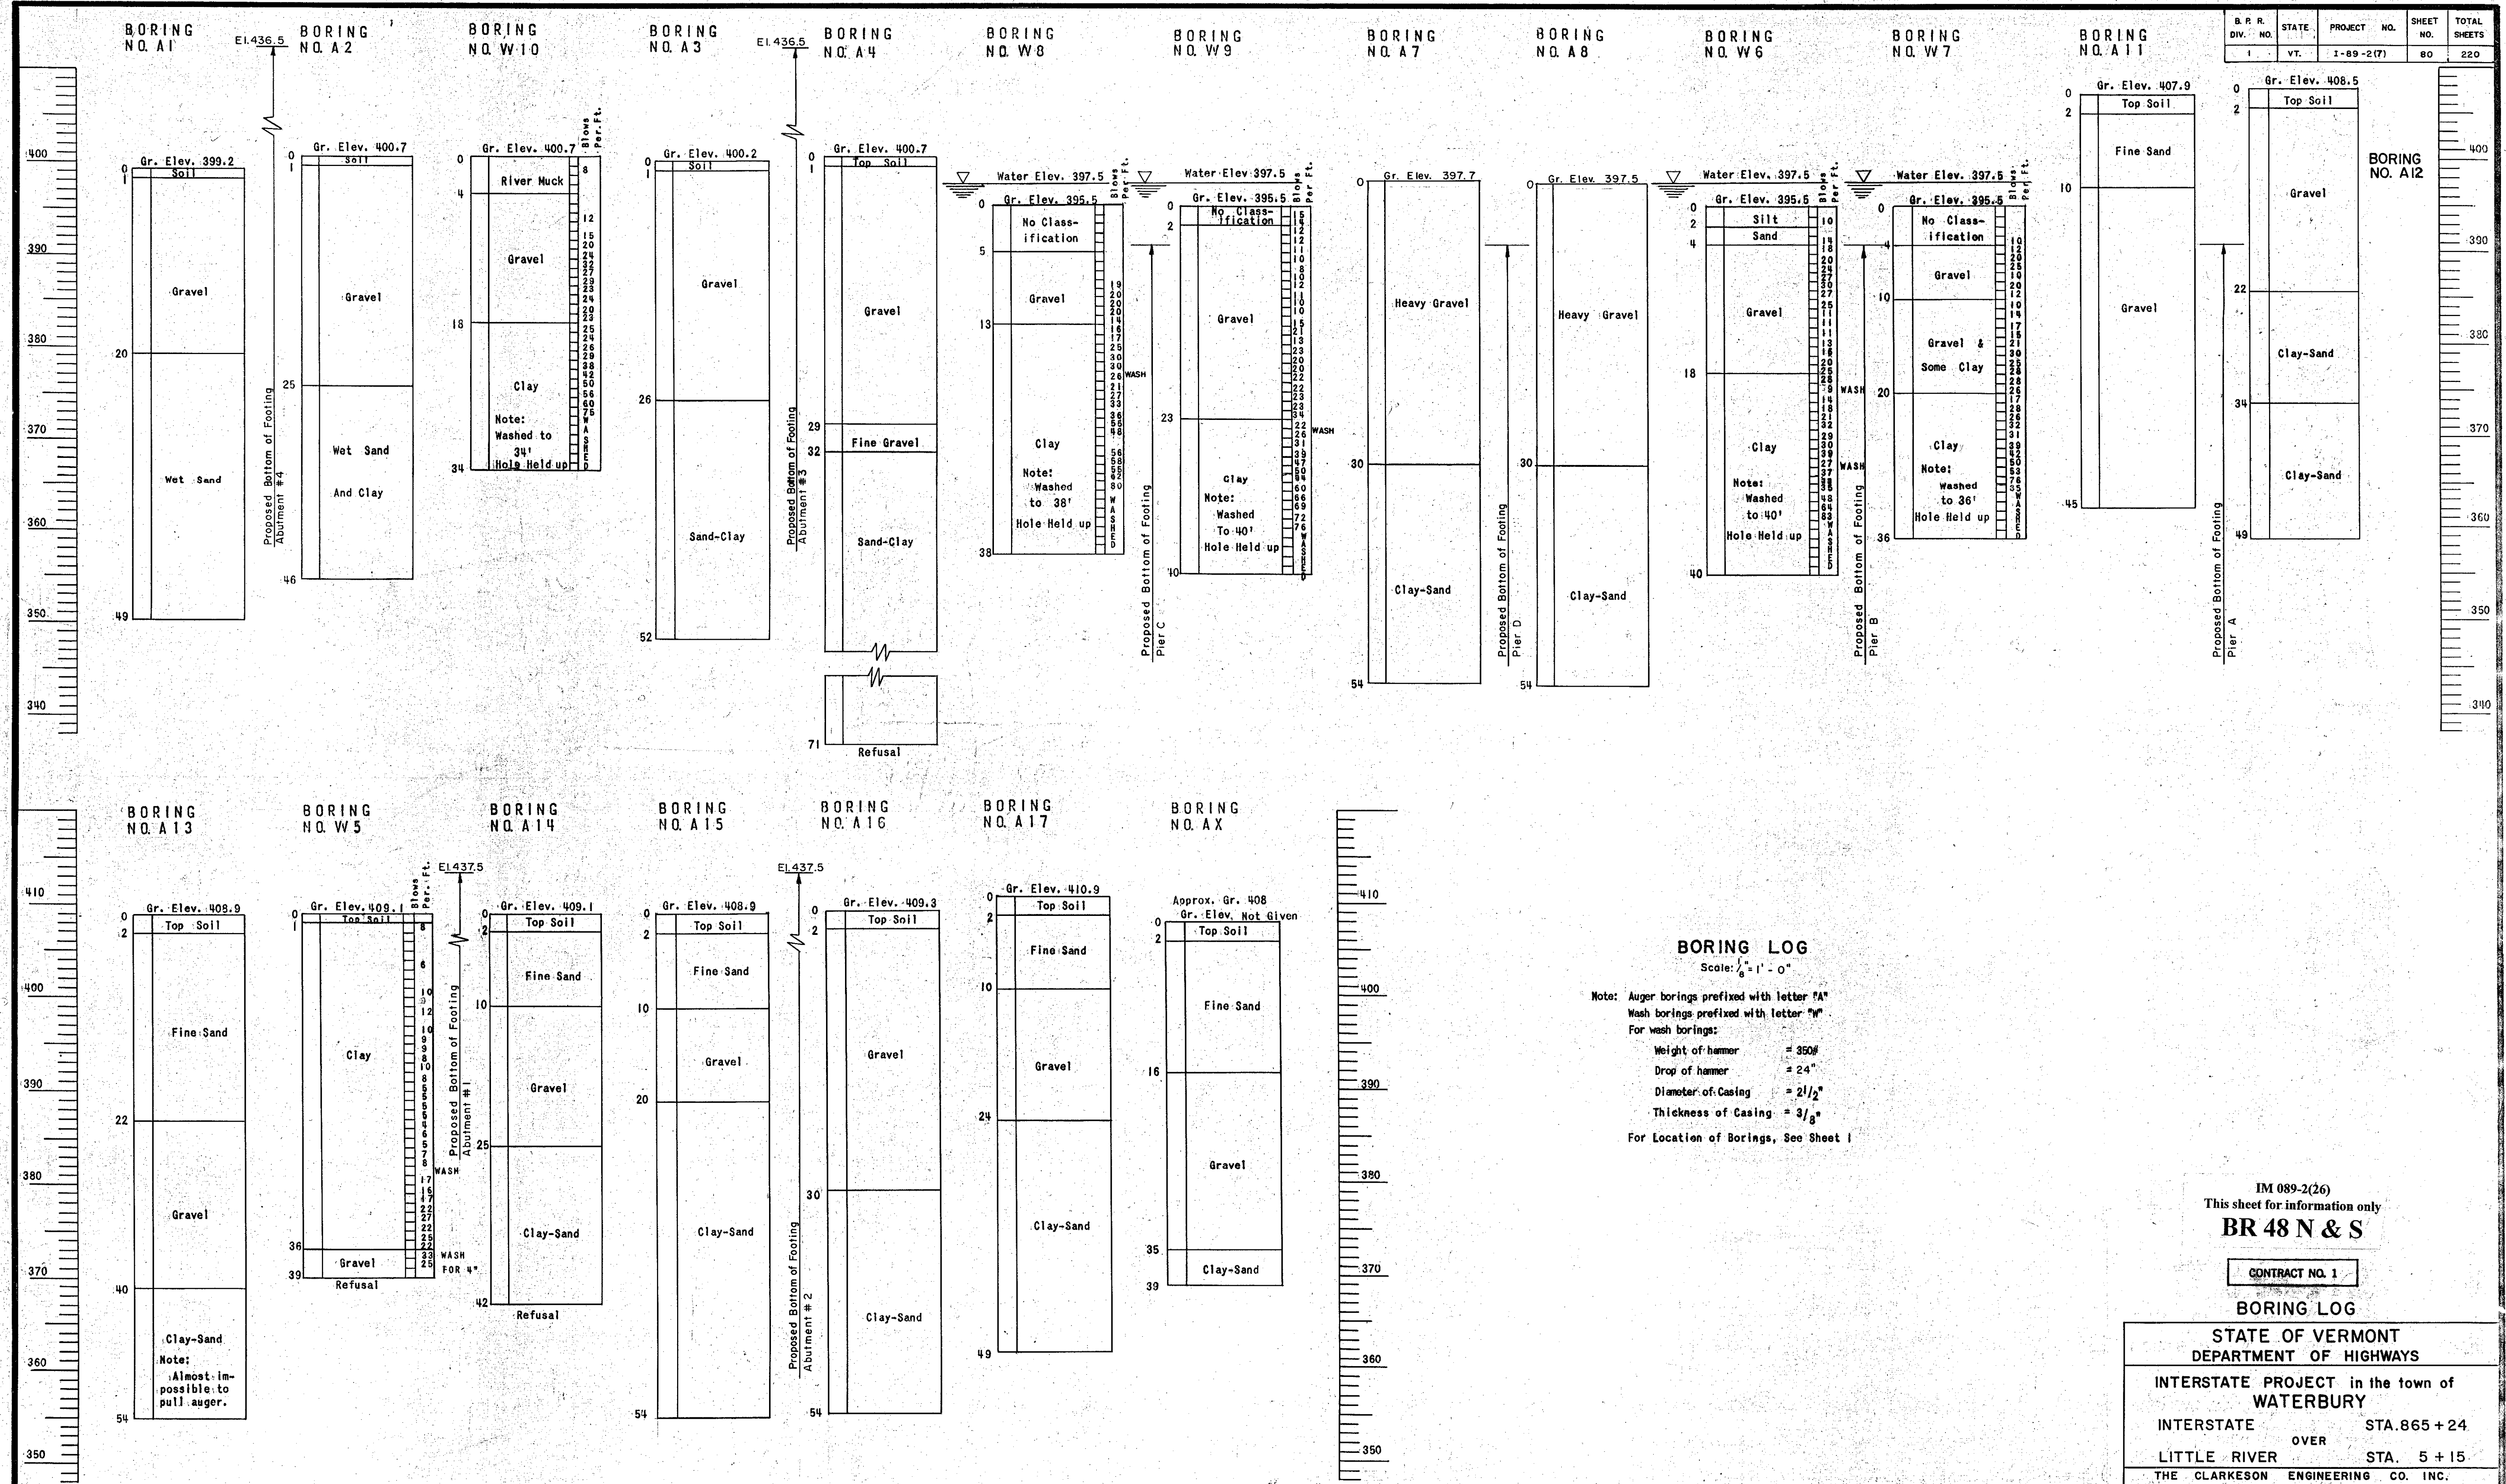

**BORING LOG**  
Scale: 1/8" = 1' - 0"

Note: Auger borings prefixed with letter "A"  
Wash borings prefixed with letter "W"  
For wash borings:  
Weight of hammer = 350#  
Drop of hammer = 24"  
Diameter of Casing = 2 1/2"  
Thickness of Casing = 3/8"  
For Location of Borings, See Sheet 1

IM 089-2(26)  
This sheet for information only  
**BR 48 N & S**



CONTRACT NO. 1

**BORING LOG**

STATE OF VERMONT  
DEPARTMENT OF HIGHWAYS  
INTERSTATE PROJECT in the town of  
**WATERBURY**  
INTERSTATE OVER STA. 865 + 24  
LITTLE RIVER OVER STA. 5 + 15.  
THE CLARKESON ENGINEERING CO. INC.  
CONSULTING ENGINEERS  
BOSTON MASS.  
SURVEYED BY: R.J.F. CHECKED BY: B.K.B. DATE: 8-20-57  
DRAWN BY: R.J.F. IN CHARGE: J.V.B. DATE: 8-20-57  
PROJECT NO. 1-89-2(7) SHEET 225 OF 307

B. P. R.	STATE	PROJECT NO.	SHEET NO.	TOTAL SHEETS
1	VT.	1-89-2(7)	81	226

**CURVE DATA**  
 $\Delta = 35^{\circ}-04'-00''$  L.I.  
 $D = 1^{\circ}-20'-00''$   
 $R = 4297.28'$   
 $T = 1357.7'$   
 $L = 2630.0'$   
 $E = 209.4'$   
 Bank  $\frac{1}{2}''$  Per Ft.

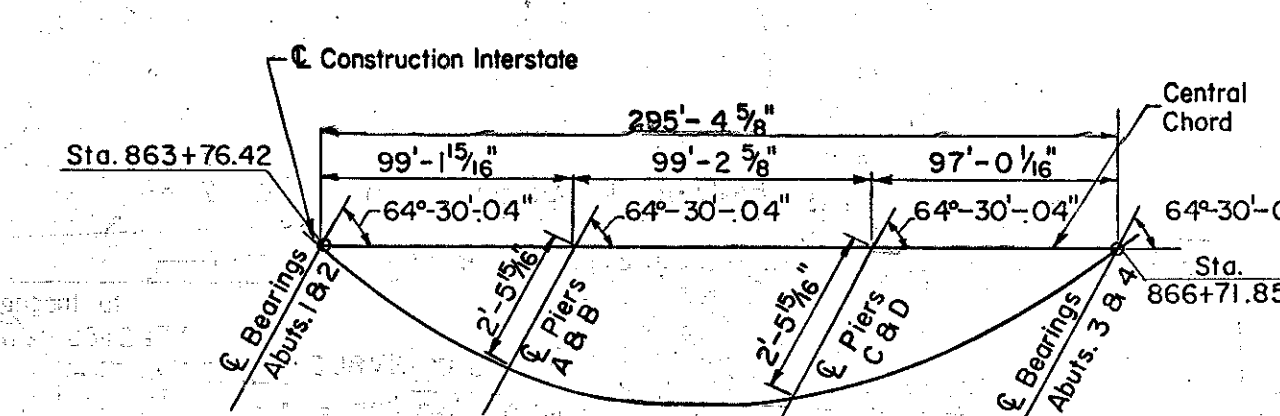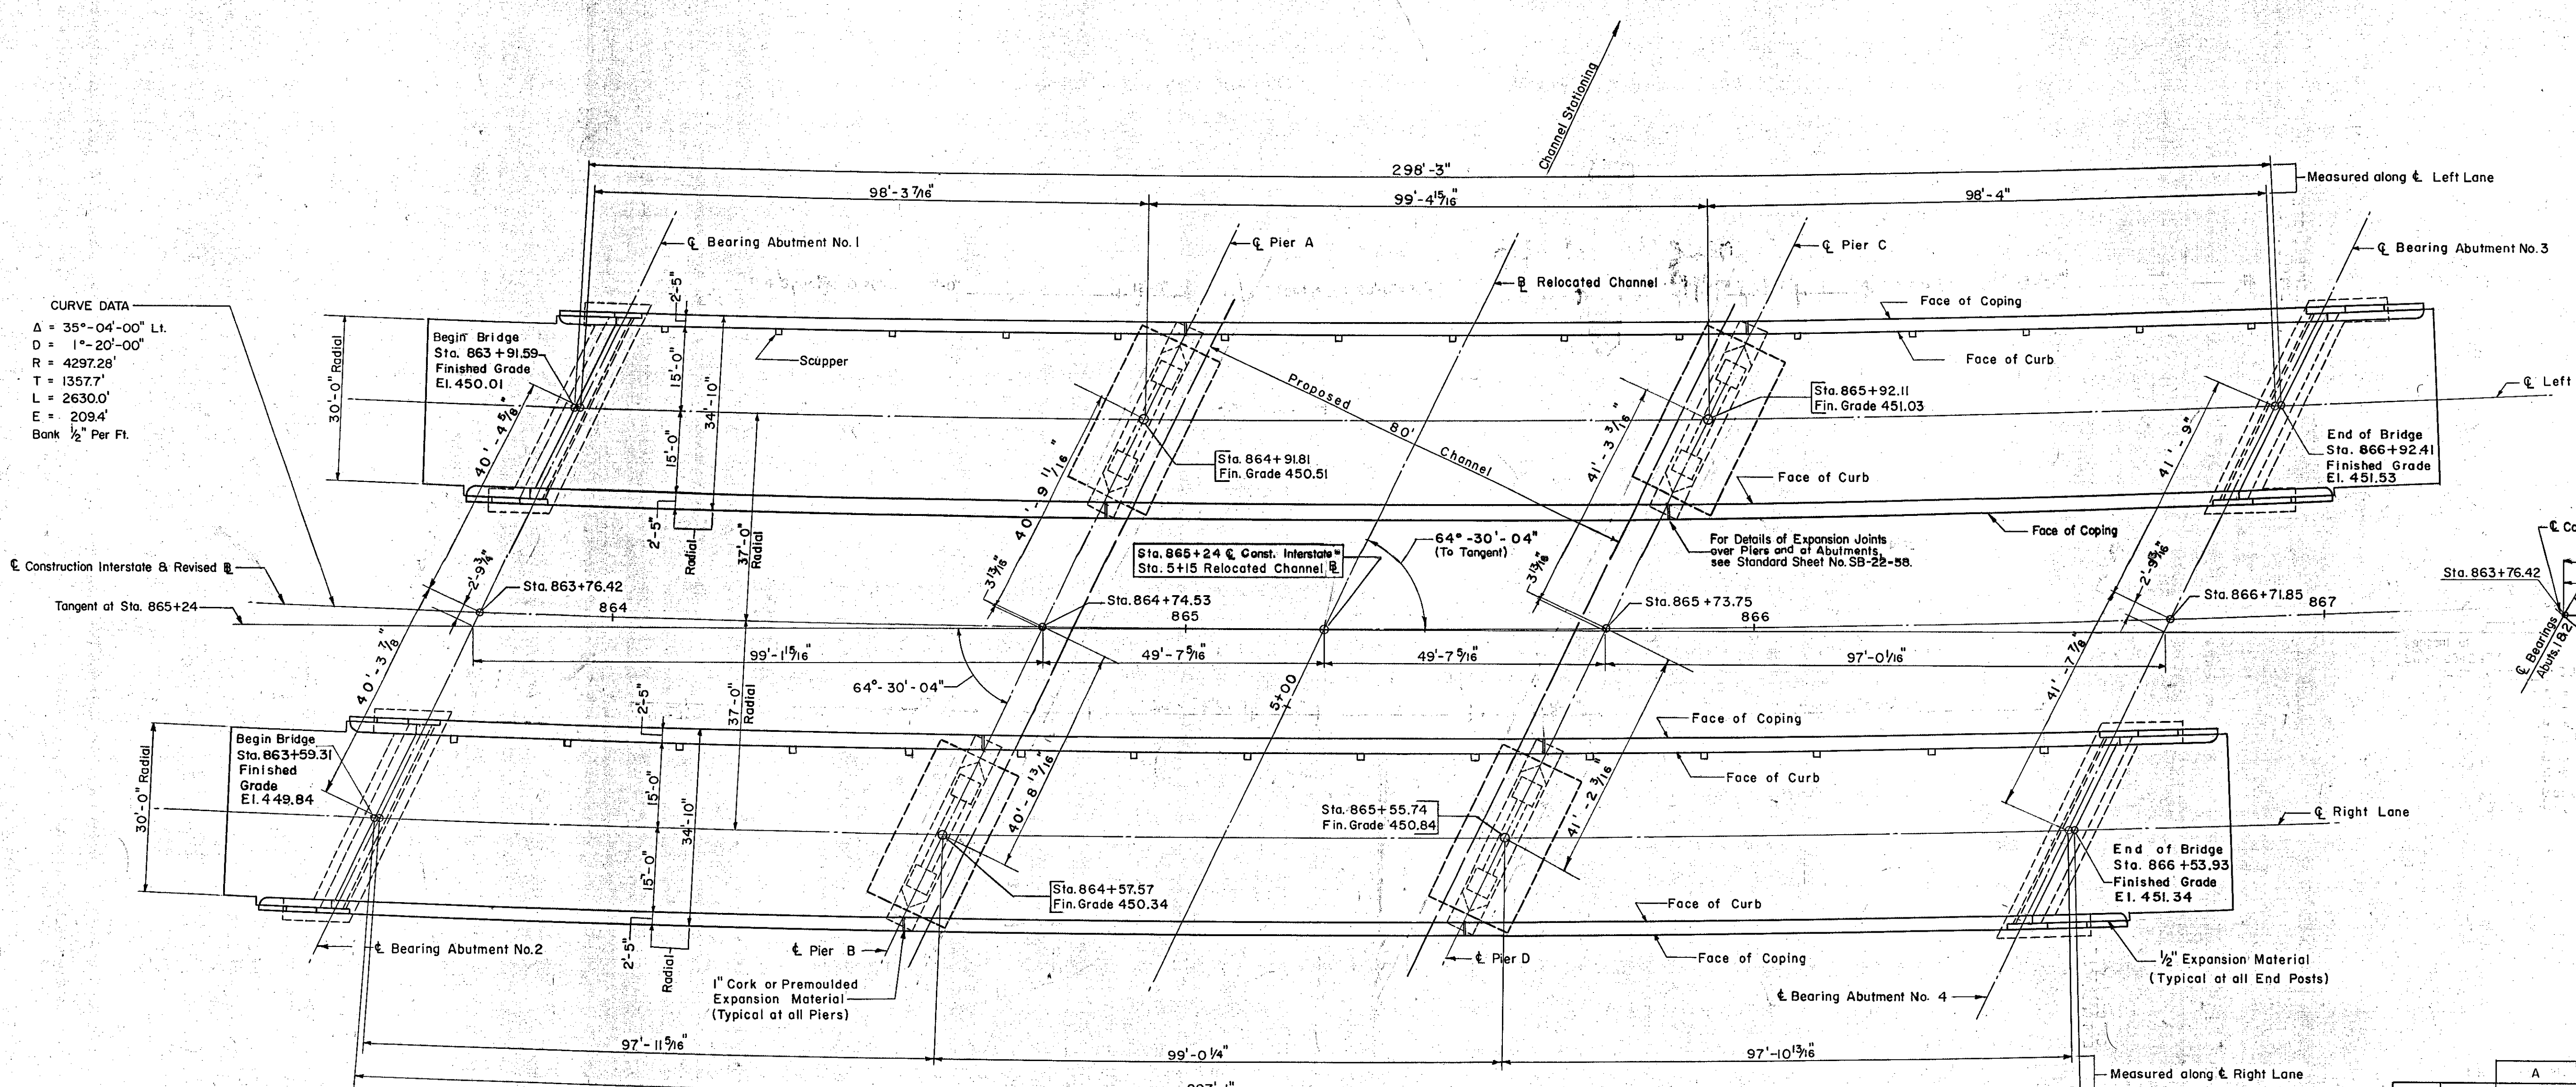


**CHORD LAYOUT**  
Not To Scale

**PLAN**  
Scale:  $\frac{1}{16}'' = 1'-0''$   
Note: All stationing refers to  $\bar{C}$  Construction Interstate

		A	B	C	D
Left	South	6'-9 1/16"	39 @ 7'-1 1/2" = 277'-10 1/2"	6'-9 9/16"	291'-5 7/8"
Lane	North	6'-11 1/4"	39 @ 7'-1 1/4" = 277'-0 3/4"	6'-11 1/8"	290'-11 1/8"
Right	South	7'-0 7/16"	39 @ 7'-1" = 276'-3"	7'-0 9/16"	290'-4"
Lane	North	6'-9 3/8"	39 @ 7'-1" = 276'-3"	6'-9 3/8"	289'-9 3/4"

**RAILING POST SPACING SCHEDULE**

- Note: All dimensions are horizontal dimensions.  
 2. Railing Posts to be set normal to grade, Omit set screw at upgrade end of panel over Pier Expansion Joints.  
 3. For Bridge Marker, see Std. Sheet SB-20-56 (Detail A)  
 4. For Scupper Layout See Framing Plan, Sheet No. 10

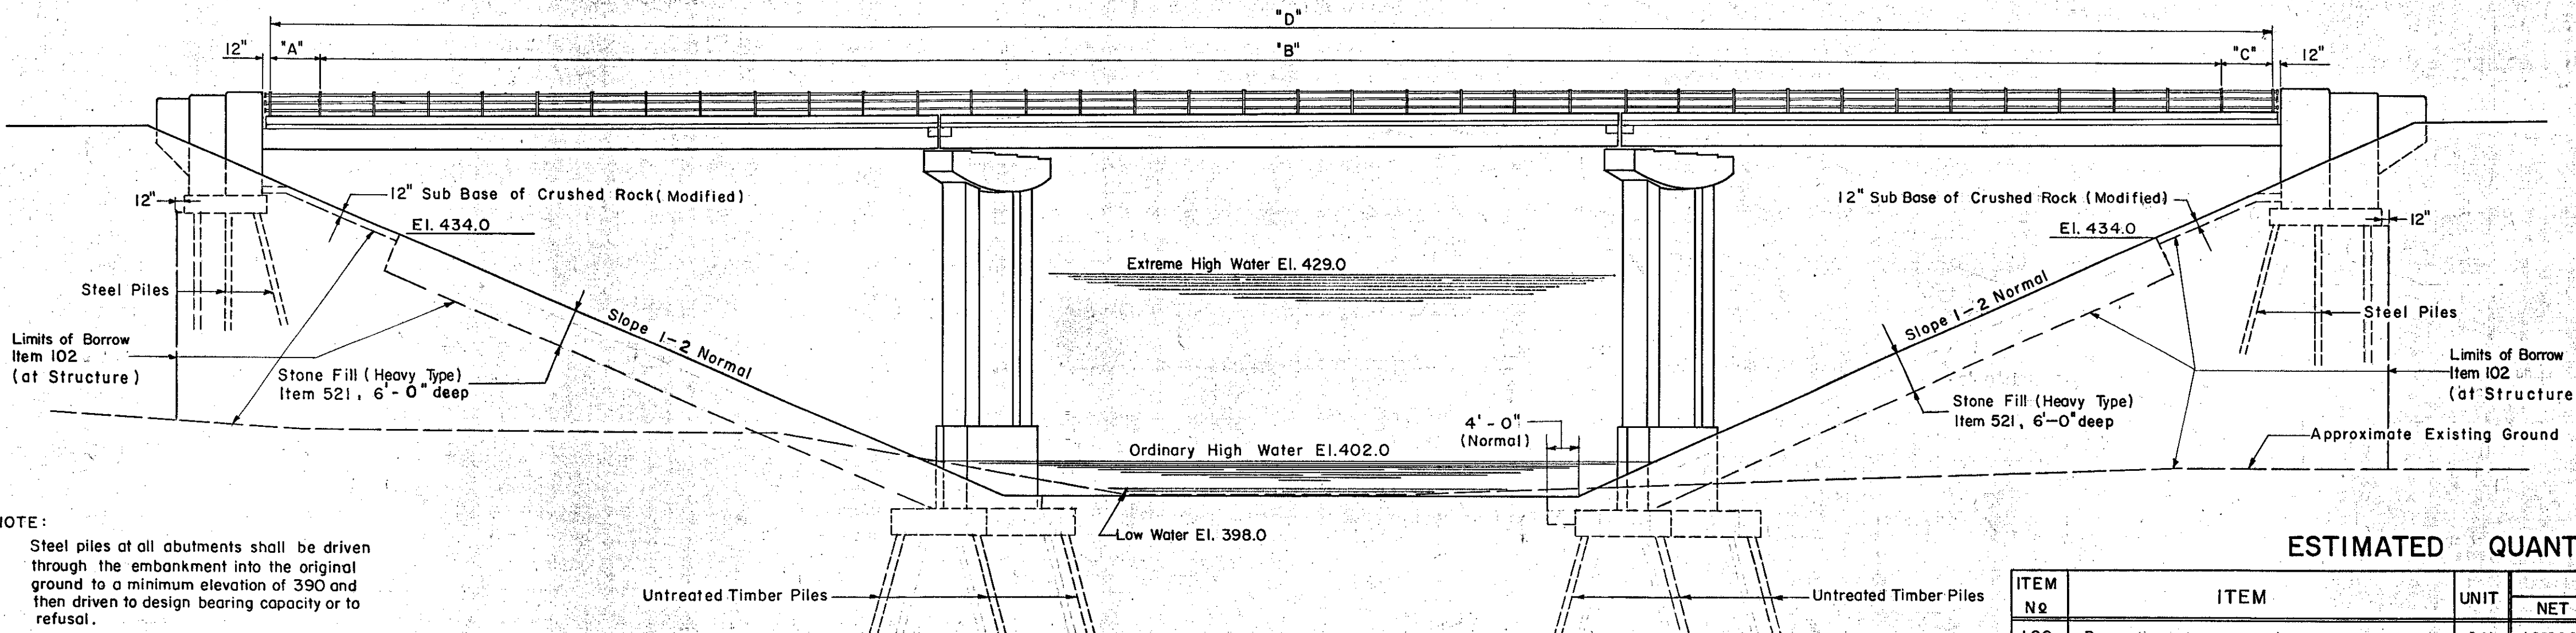

**NORTHERLY ELEVATION**  
**SOUTHERLY ELEVATION (SIMILAR)**  
Scale:  $\frac{1}{16}'' = 1'-0''$

**ESTIMATED QUANTITIES**

ITEM No	ITEM	UNIT	ESTIMATED QUANTITIES		
			NET	OVER-RUN	TOTAL FINAL
102	Borrow	C.Y.	16,000	+600	17,600
521	Stone Fill (Heavy Type)	C.Y.	9945	+1485	11,430
556-C	Granite Bridge Curb (Type I)	L.F.	1307	V	1,307
572	Bridge Railing	L.F.	1169	V	1,169

**NOTE:**  
Steel piles at all abutments shall be driven through the embankment into the original ground to a minimum elevation of 390 and then driven to design bearing capacity or to refusal.

IM 089-2(26)  
This sheet for information only  
**BR 48 N & S**

CONTRACT NO. 1

**PLAN AND ELEVATION**

STATE OF VERMONT  
DEPARTMENT OF HIGHWAYS


**INTERSTATE PROJECT in the town of WATERBURY**

INTERSTATE OVER STA. 865 + 24  
LITTLE RIVER OVER STA. 5 + 15

THE CLARKESON ENGINEERING CO. INC.  
CONSULTING ENGINEERS


BOSTON MASSACHUSETTS  
SURVEYED BY: REM/JRW CHECKED BY: BK & JB SCALE: AS NOTED  
DRAWN BY: REM/JRW IN CHARGE: J.V.B. DATE: 8-20-91

PROJECT NO. 1-89-2(7) SHEET 226 OF 307

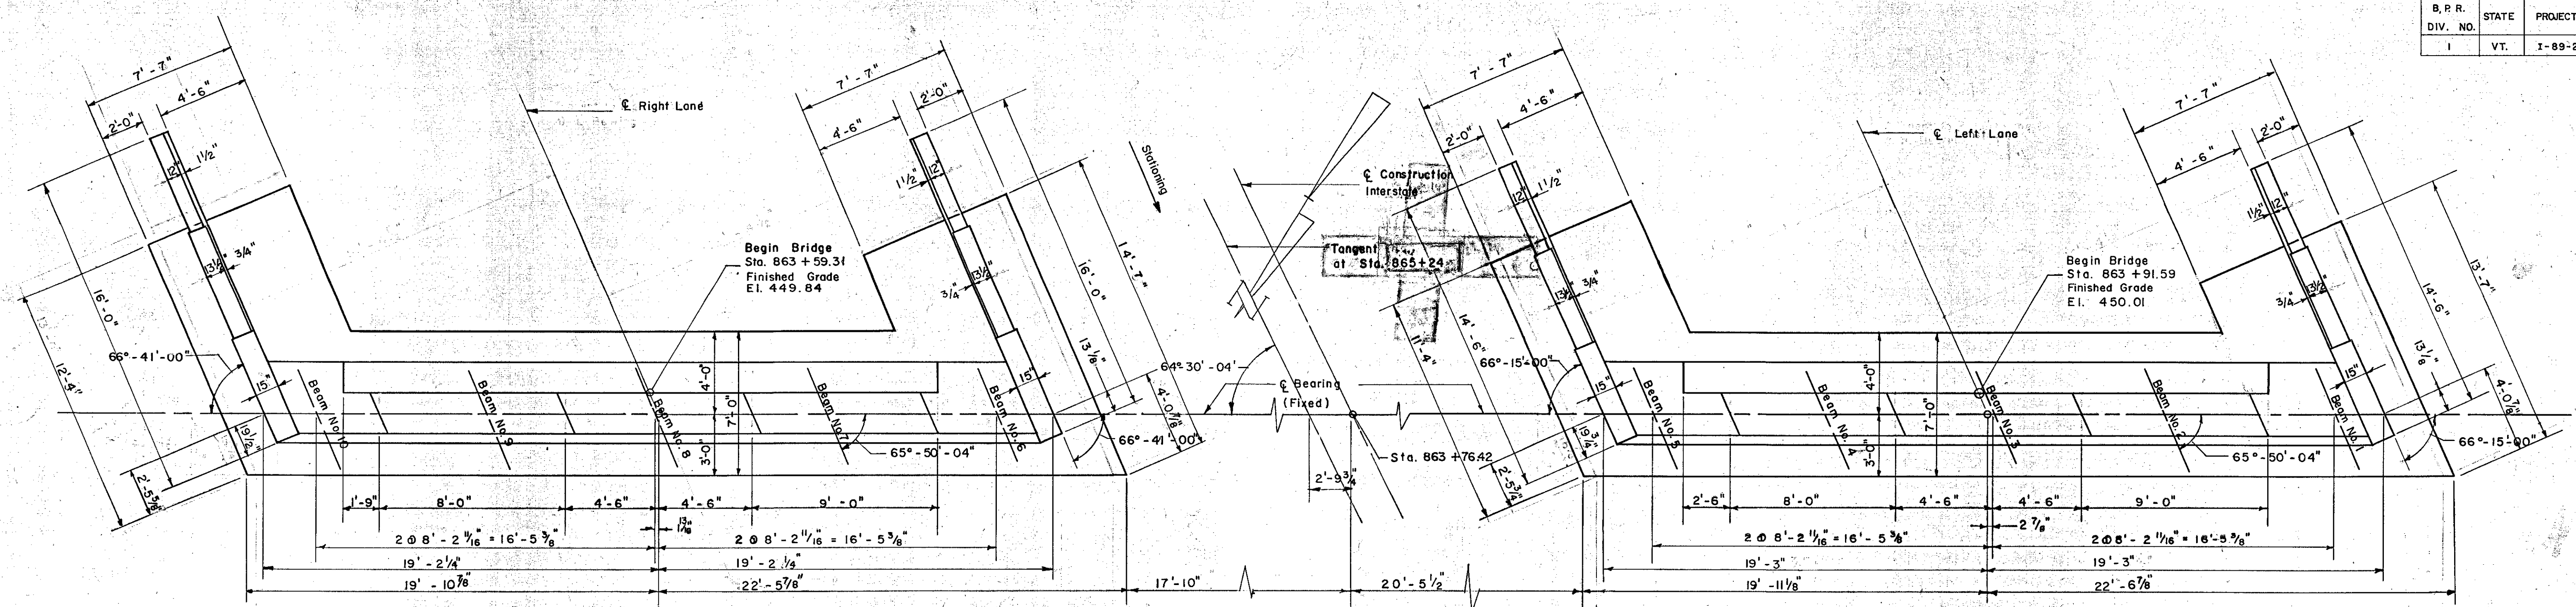

**ABUTMENT NO. 2**  
Scale: 1/4" = 1'-0"

**ABUTMENT NO. 1**  
Scale: 1/4" = 1'-0"

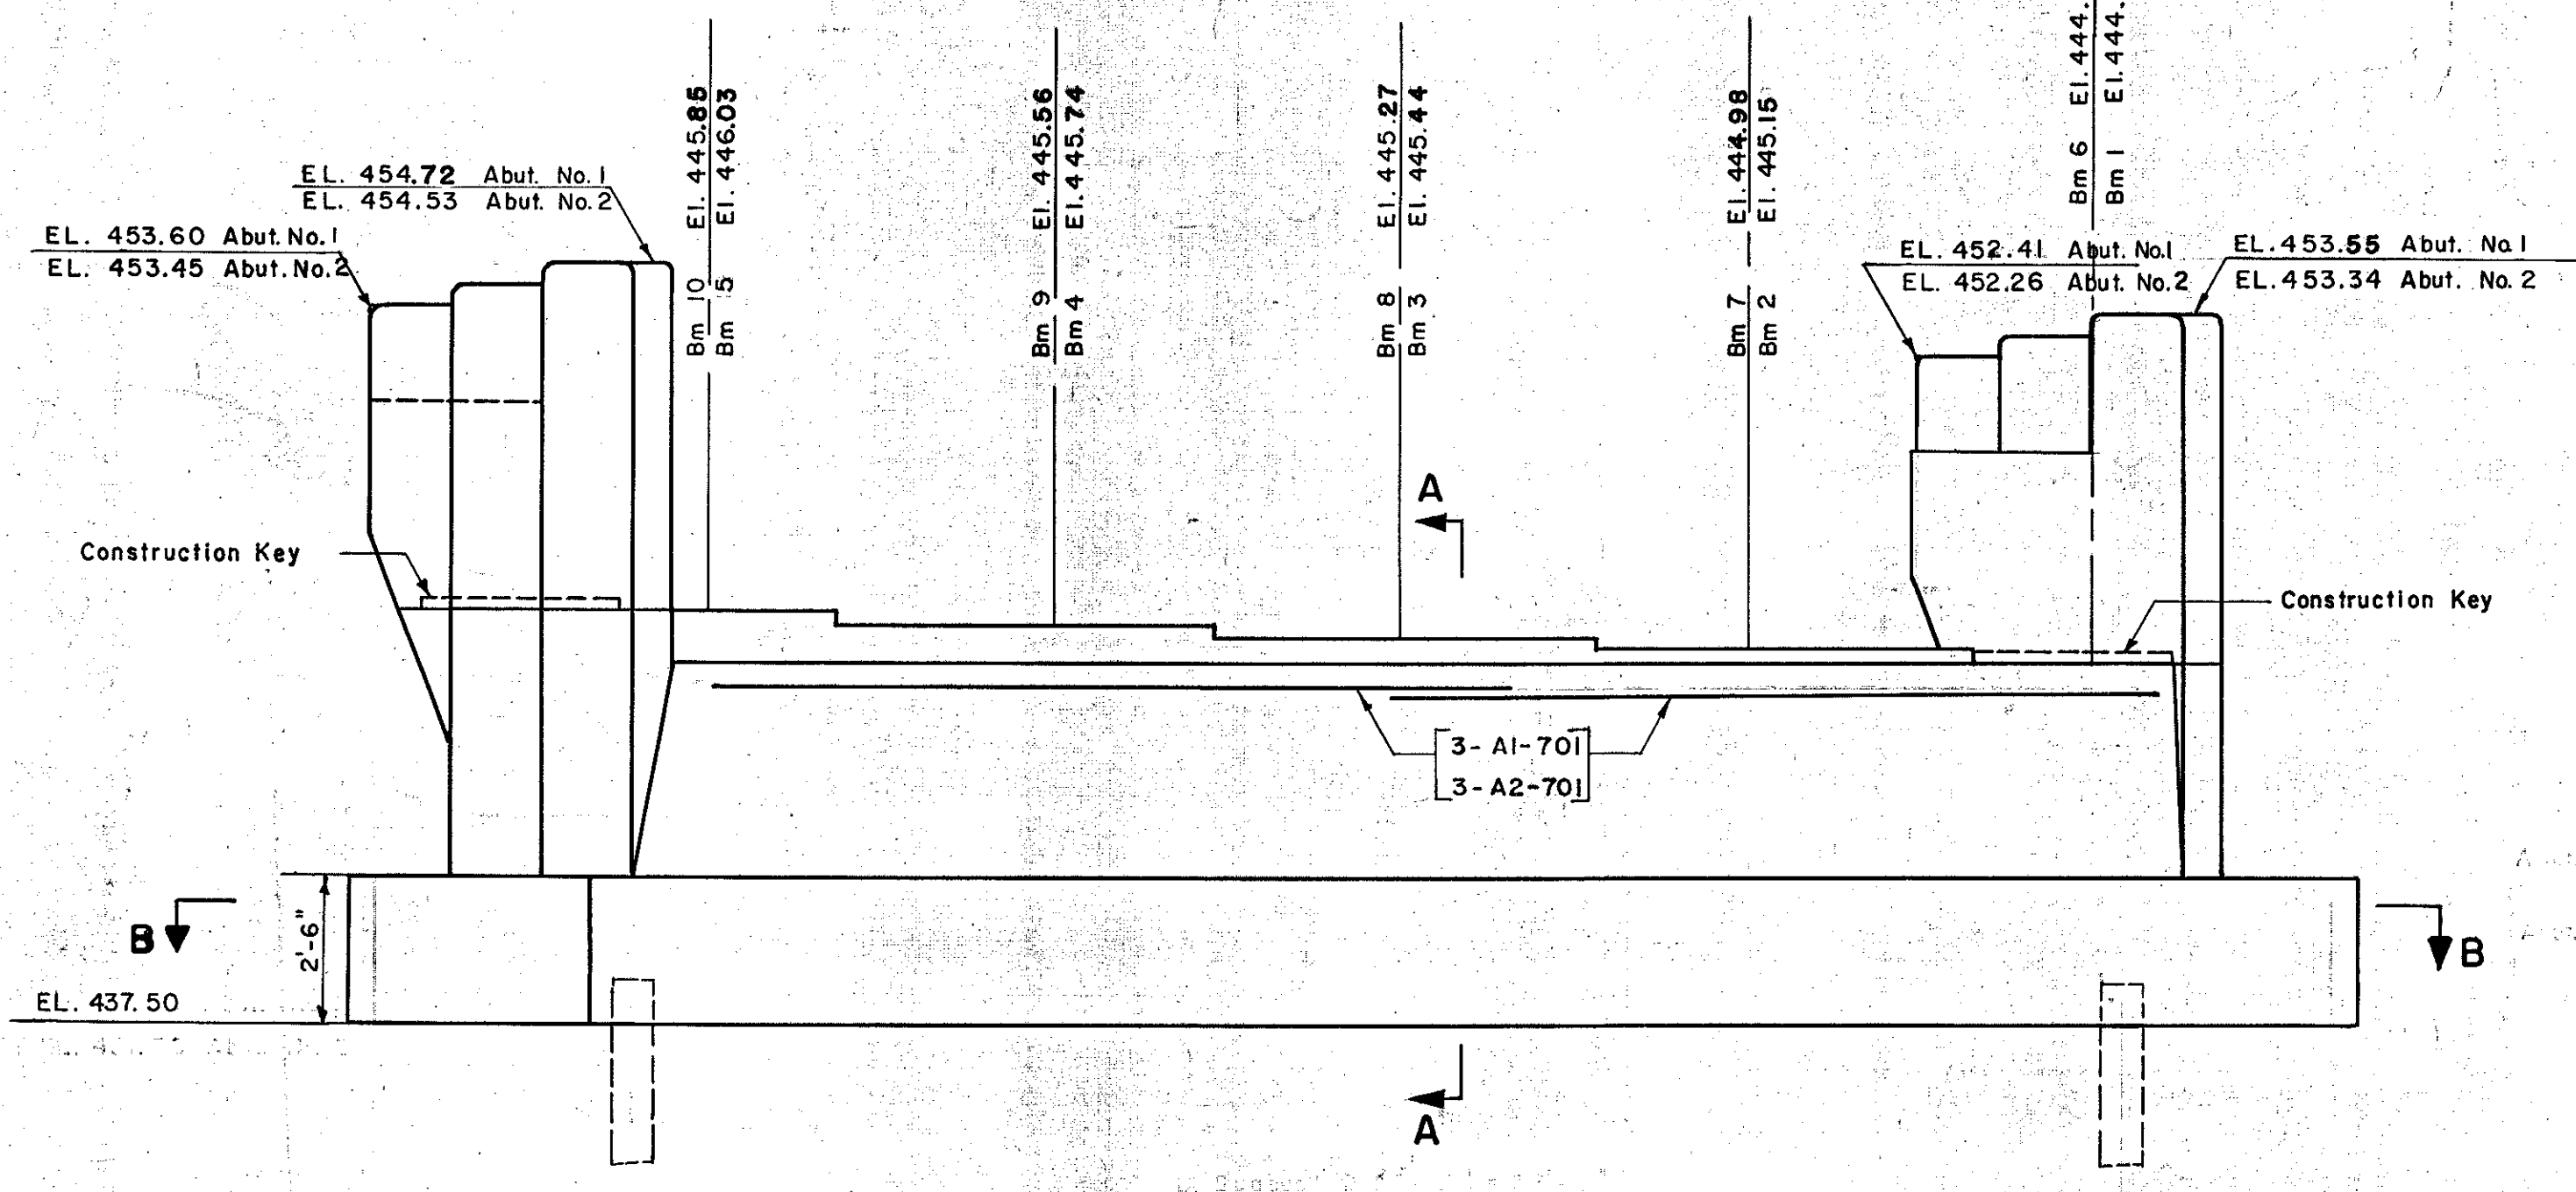


**ELEVATION ABUTMENT NO. 2**  
**ELEVATION ABUTMENT NO. 1 (SIMILAR EXCEPT AS NOTED)**  
Scale: 1/4" = 1'-0"

NOTE: See Sheet No. 6 For Wingwall Section  
Bars in Abutment No. 1 to be marked A1  
Bars in Abutment No. 2 to be marked A2


**ESTIMATED QUANTITIES**

ITEM NO.	DESCRIPTION	UNIT	ABUTMENT NO. 1				ABUTMENT NO. 2			
			NET	OVER-RUN	TOTAL	FINAL	NET	OVER-RUN	TOTAL	FINAL
107	Structure Excavation	C.Y.	19	2	21	18	19	2	21	19
204	Sub-base of Crushed Rock (Mod.)	C.Y.	32	5	37	52	32	5	37	53
222	Gravel Backfill	C.Y.	37	4	41	30	37	4	41	30
402B	Concrete Class B (Mod.)	C.Y.	70	4	74	72	73	4	77	74
402	Reinforcing Steel	LBS	See Reinforcing Steel Schedule Sheet No. 12							
407	Asphaltic-Asbestos Coating	S.Y.	8	0	8	8	8	0	8	8
504	Steel Piling	L.F.	190	0	190	858	190	0	190	886

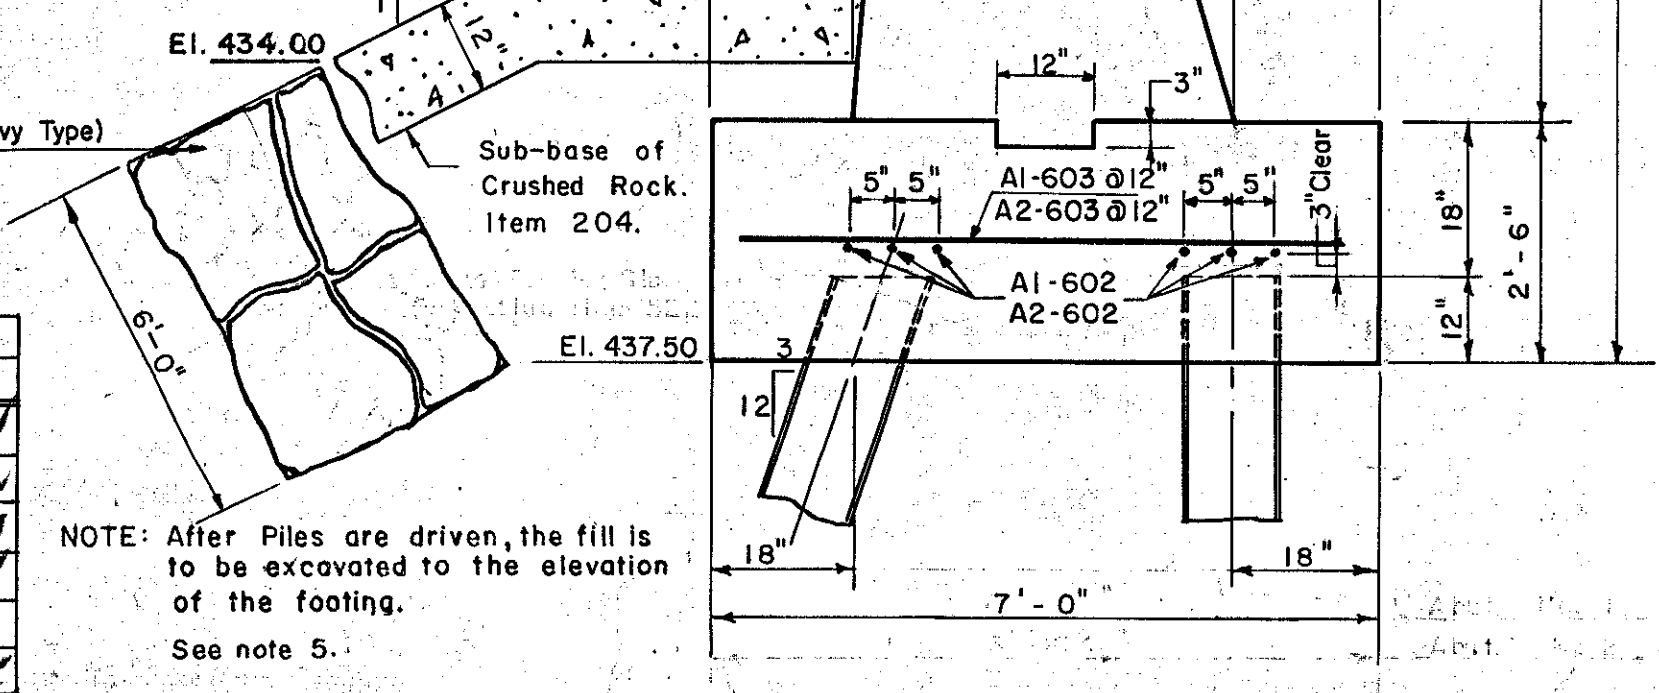


**SECTION A-A**  
Scale: 1/2" = 1'-0"

Note: See Sheet No. 6 for Limits of Gravel Backfill

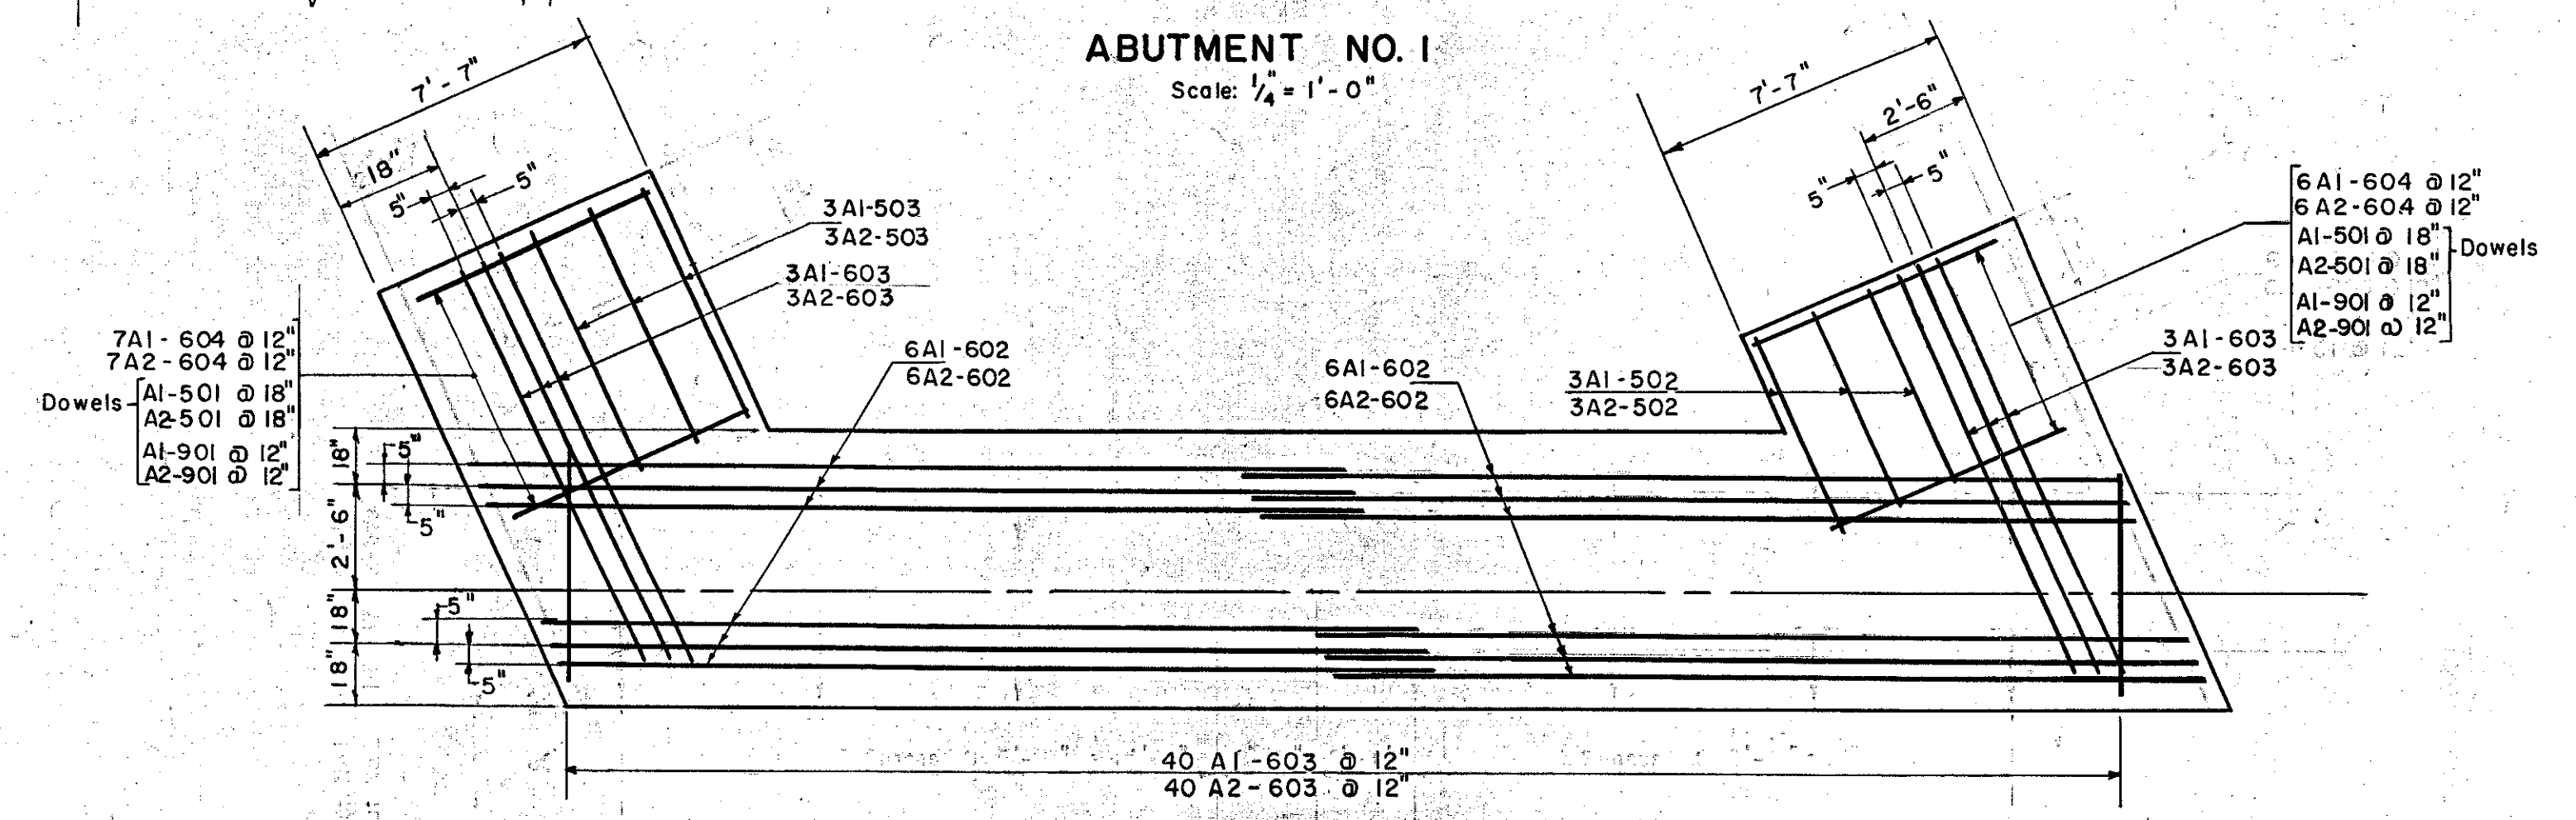

**SECTION B-B**  
Scale: 1/4" = 1'-0"

NOTE: See Sheet No. 6 For Dowels in Wingwall Footings

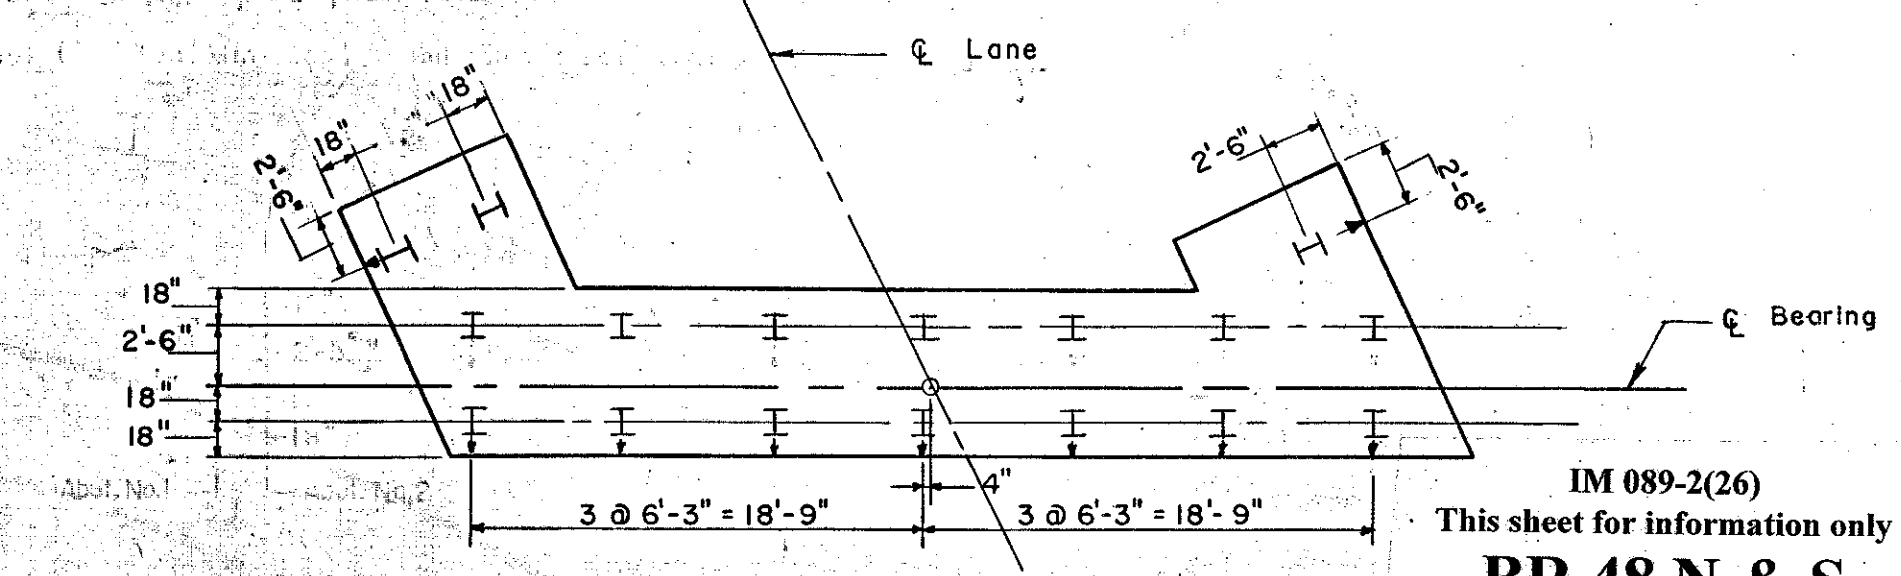

**PILE PLAN ABUTMENT NO. 1 & NO. 2**  
Scale: 1/8" = 1'-0"

- NOTES:
- Steel Piles to be 10BP42, 35 Ton Design Load. Indicated "thus, Vertical", "Battered".
  - For Estimating purposes, the Length of Steel Piles is assumed to be 70' using 1/2" diameter, 1" battered.
  - Slope all bridge seats 1/2" per ft.
  - Entire exposed surface of the Bridge Seat to be covered with 1/2" Asphaltic-Asbestos coating after superstructure is in place.
  - Prior to driving the piles, rock-free fill shall be placed under the abutment area to approximately the level of the pile cutoff elevation, and with a surface area at least (2) two feet outside the abutment.
  - A layer of Sub-base of Crushed Rock (Mod.) Item 204 one (1) foot thick shall be placed 21 feet in front of the Abutments. The edges of the area to be in line with the outside of the end posts and parallel to the centerline of the roadway.
  - Stone Fill (Heavy Type) Item 521 shall be placed 96 feet in front of the Abutments to the limits shown on the Plan of Sheet No. 1.

**CONTRACT NO. 1**

**ABUTMENTS NO. 1 AND NO. 2**

**STATE OF VERMONT**  
**DEPARTMENT OF HIGHWAYS**

**INTERSTATE PROJECT** in the town of  
**WATERBURY**

**INTERSTATE** OVER **STA. 865+24**


**LITTLE RIVER** OVER **STA. 5+15**

**THE CLARKSON ENGINEERING CO. INC.**  
BOSTON MASSACHUSETTS

SURVEYED BY B.S.S. CHECKED BY B.K.B.J.B. SCALE AS NOTED  
DRAWN BY B.S.S. IN CHARGE J.V.B. DATE 9-20-57


PROJECT NO. I-89-2(7) SHEET 227 OF 307

B. R. R.	STATE	PROJECT NO.	SHEET NO.	TOTAL SHEETS
1	VT.	I-89-2(7)	23	23

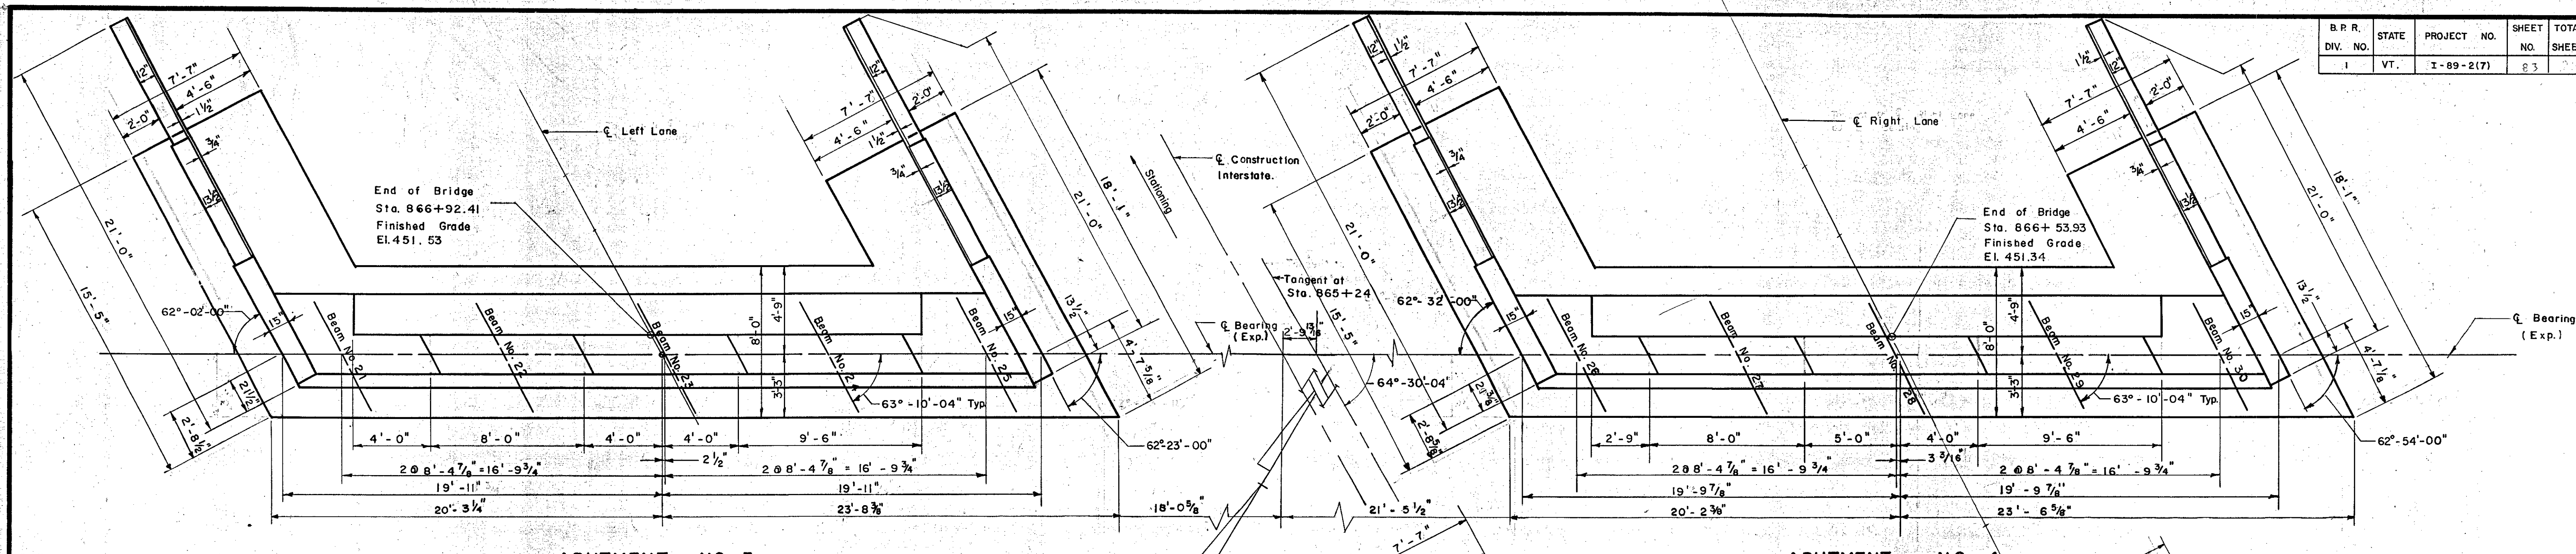


**ABUTMENT NO. 3**  
Scale: 1/4" = 1'-0"


**ABUTMENT NO. 4**  
Scale: 1/4" = 1'-0"

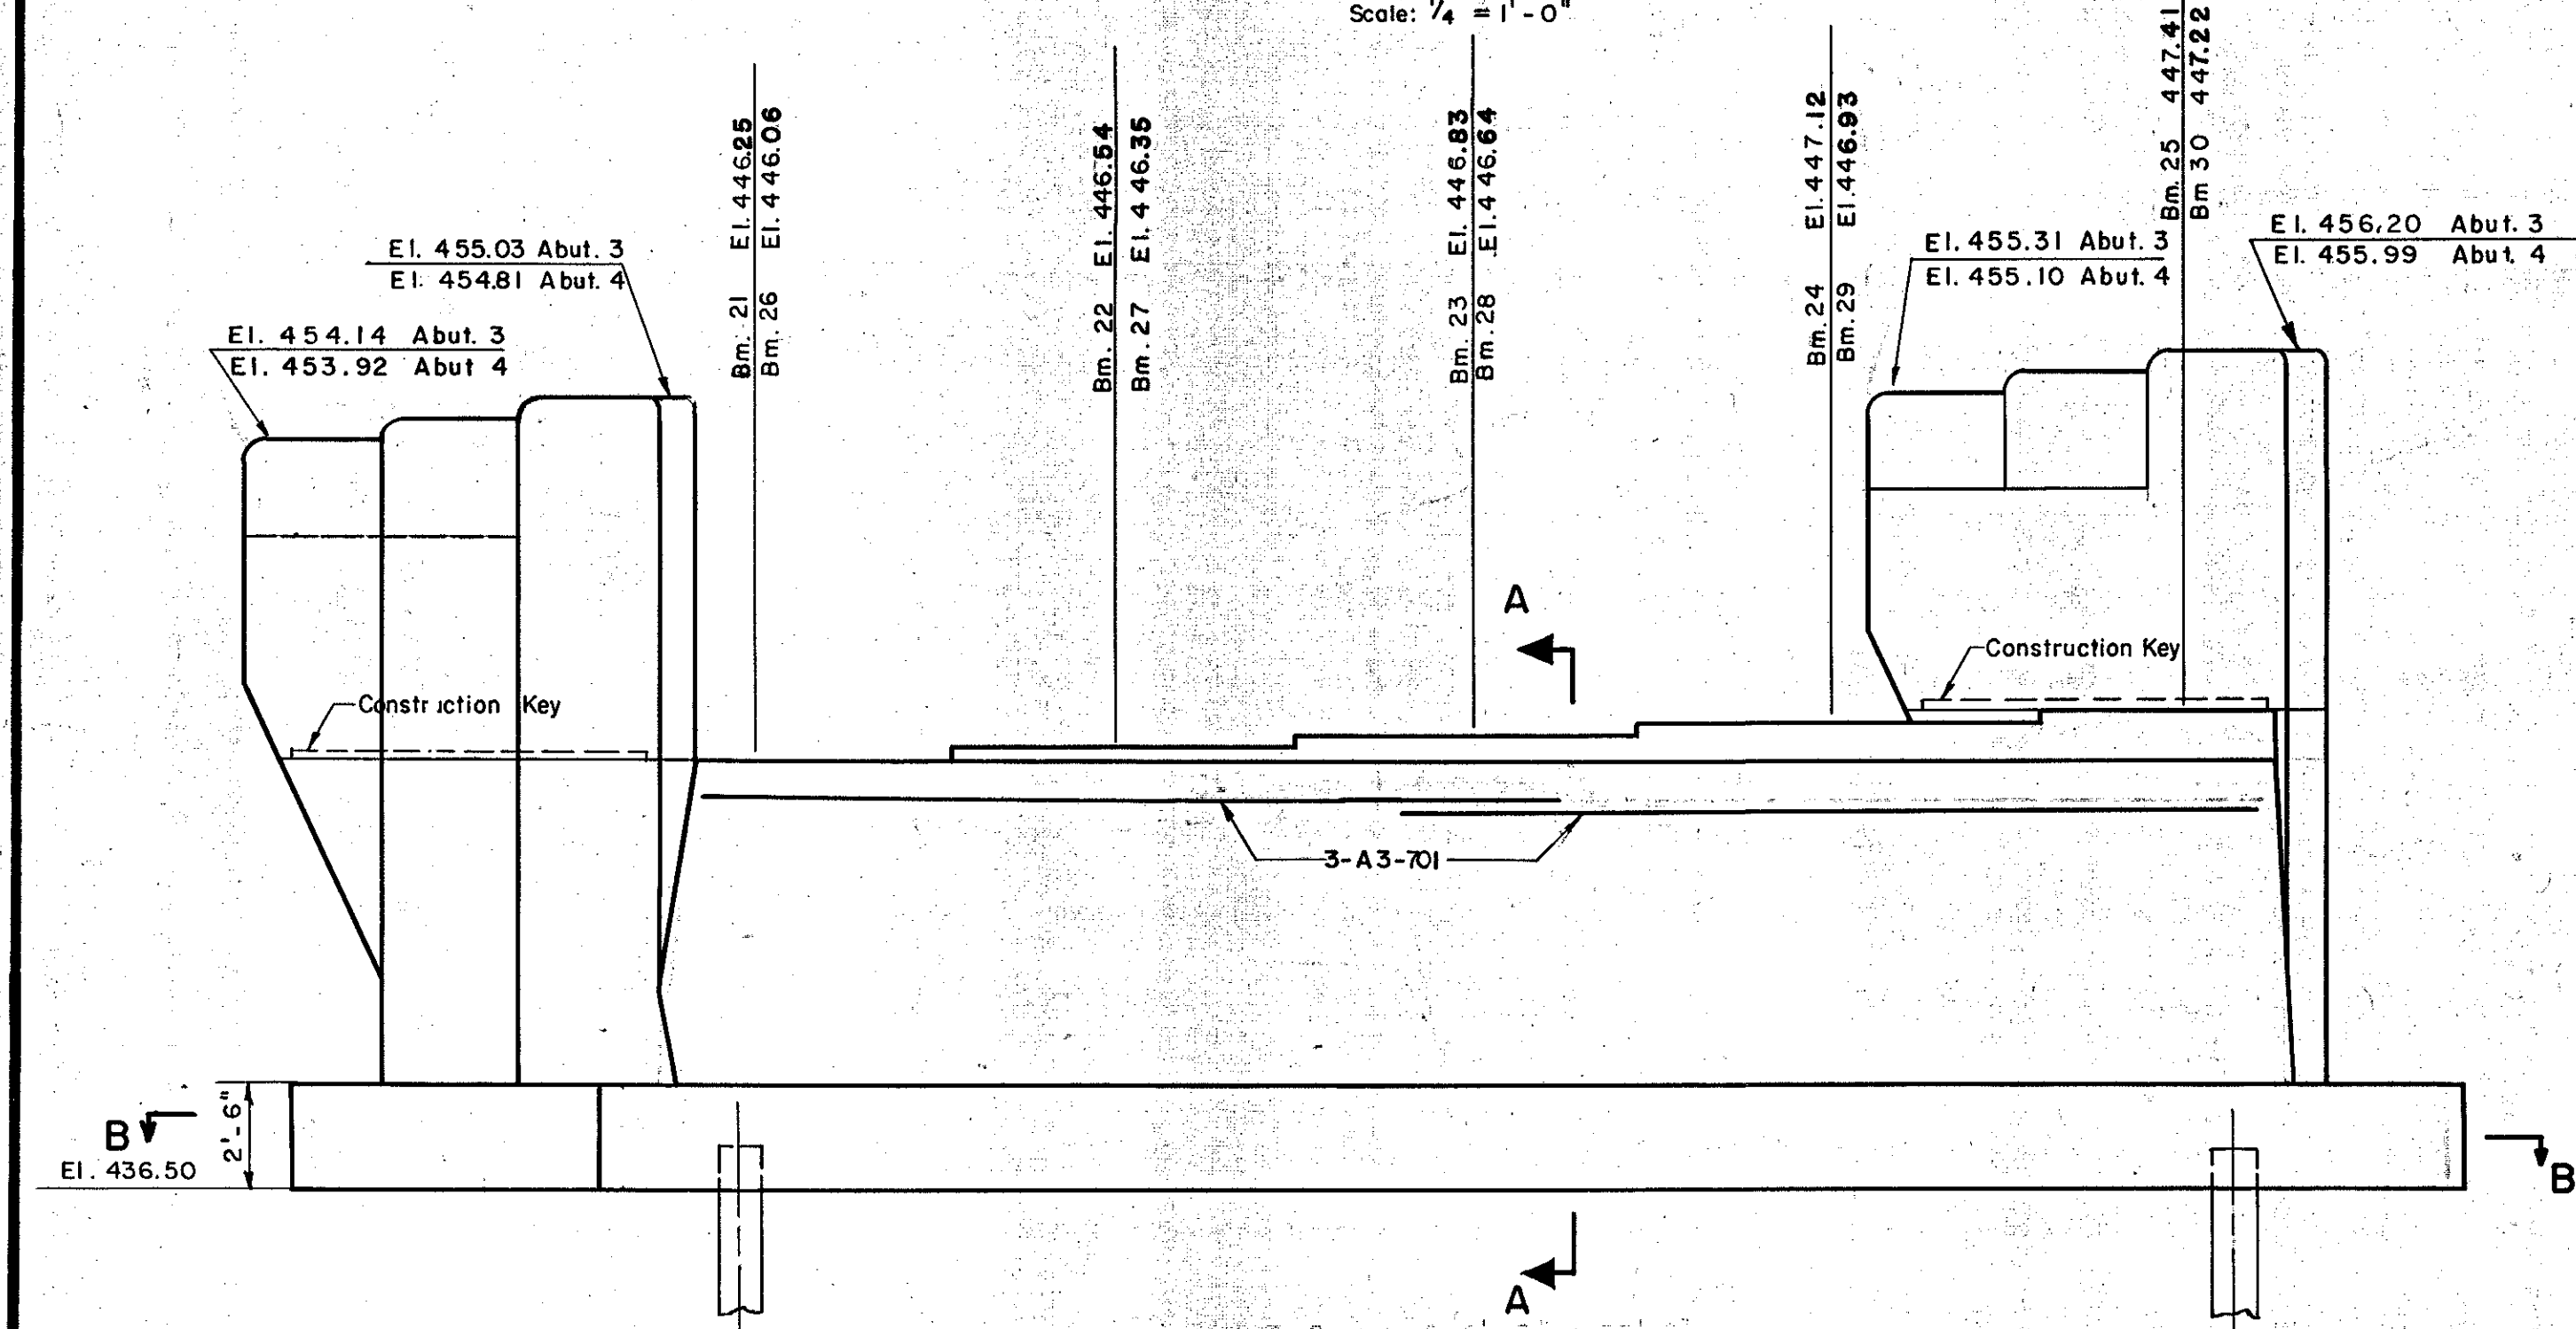


**ELEVATION ABUTMENT NO. 3**  
**ELEVATION ABUTMENT NO. 4 (SIMILAR, EXCEPT AS NOTED)**  
Scale: 1/4" = 1'-0"  
Note: See Sheet No. 6 for Wingwall Section.

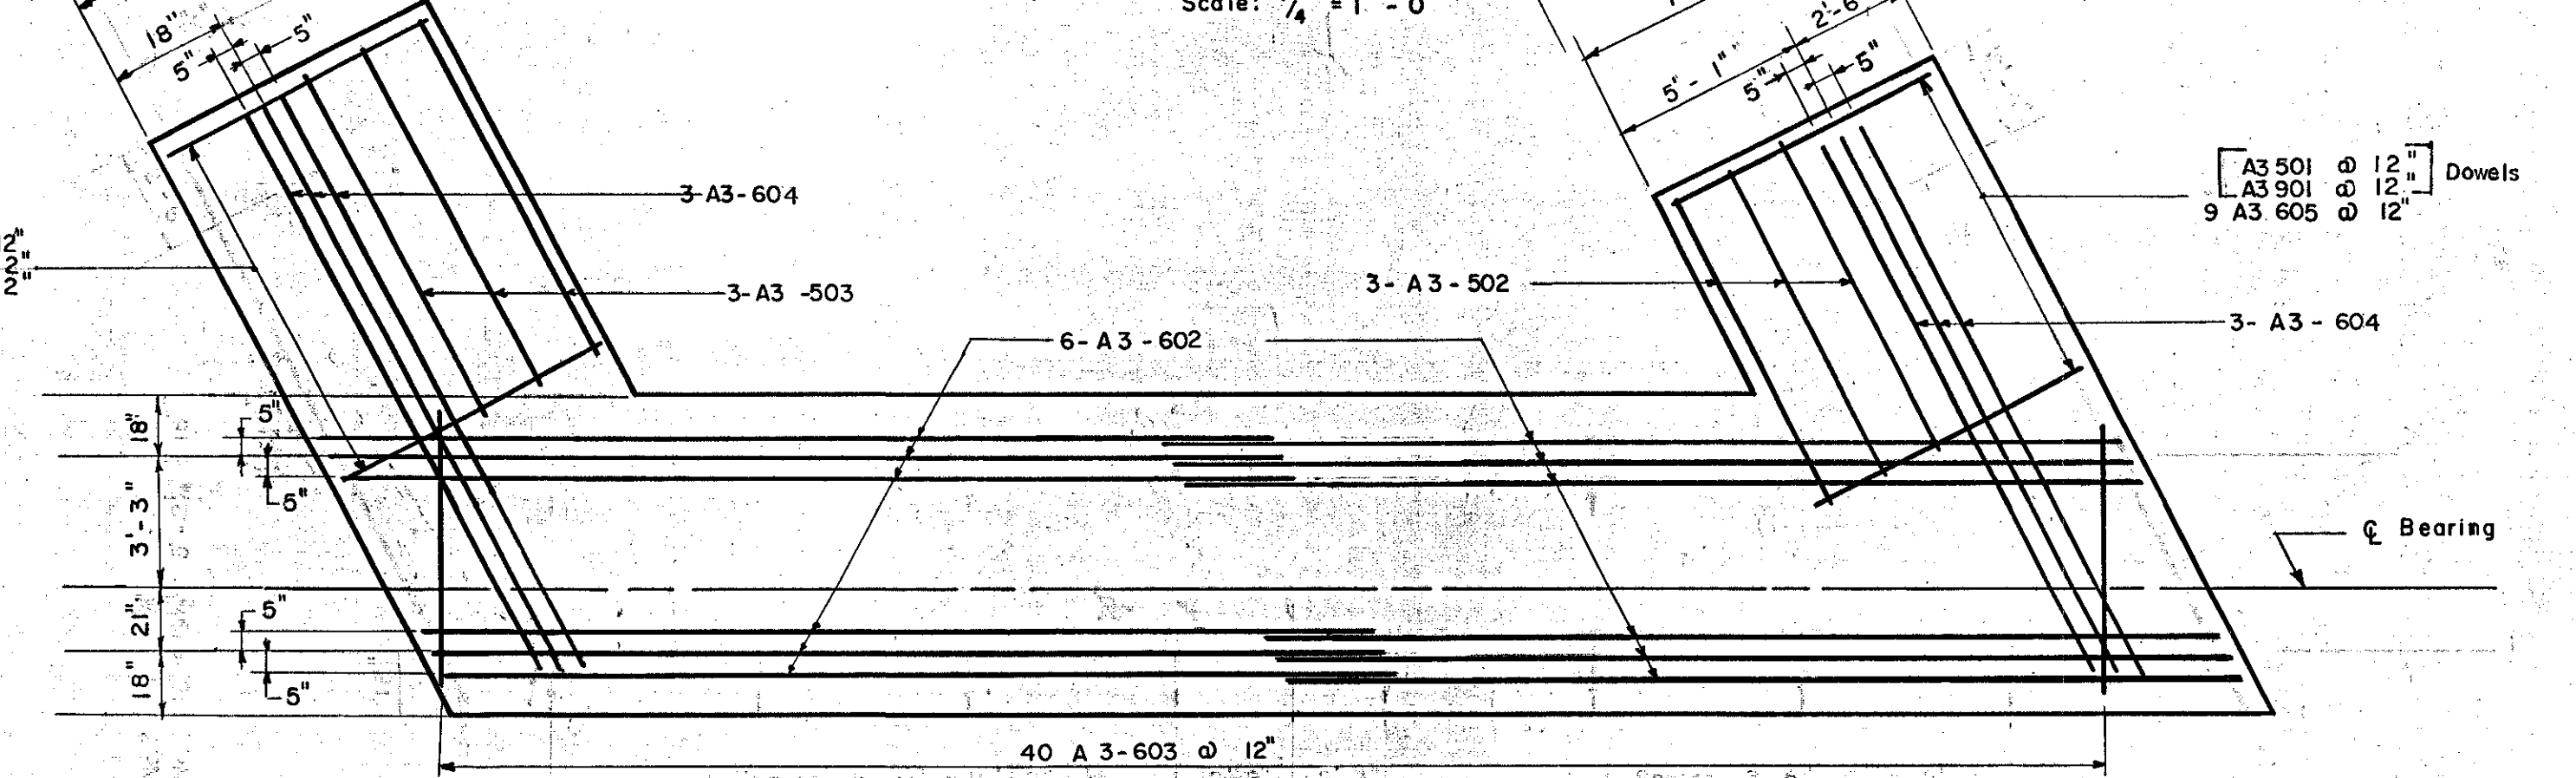


**SECTION B-B**  
Scale: 1/4" = 1'-0"  
Note: See Sheet No. 6 for dowels in Wingwall Section.

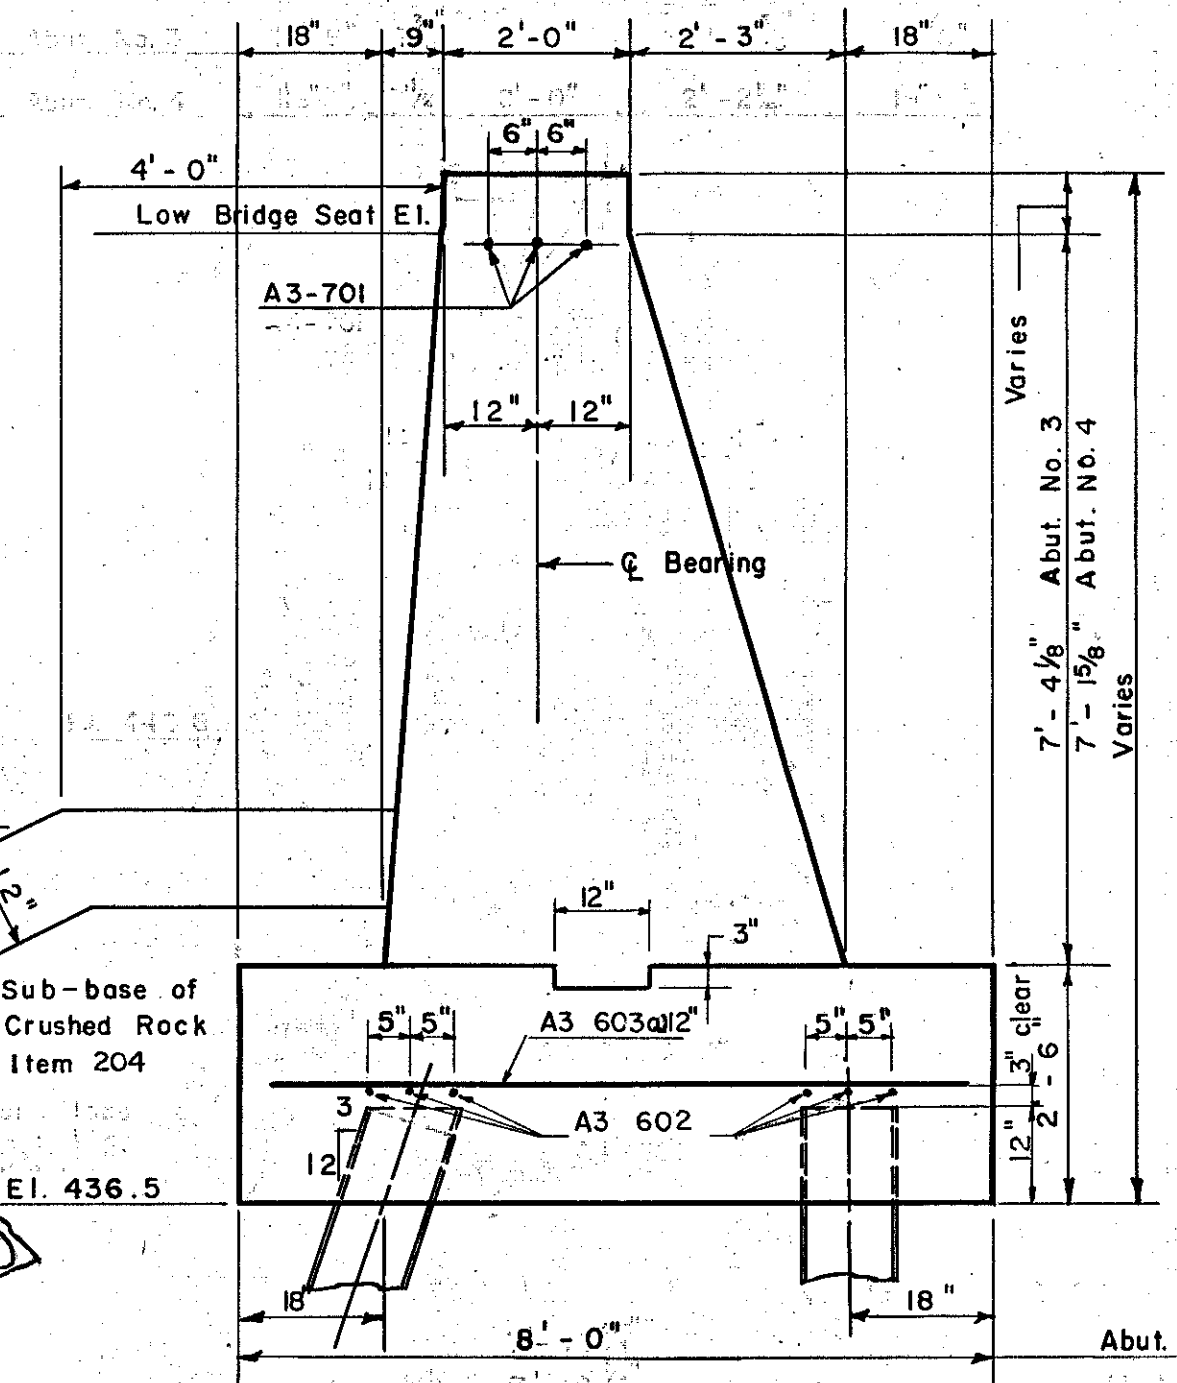

**SECTION A-A**  
Scale: 1/2" = 1'-0"

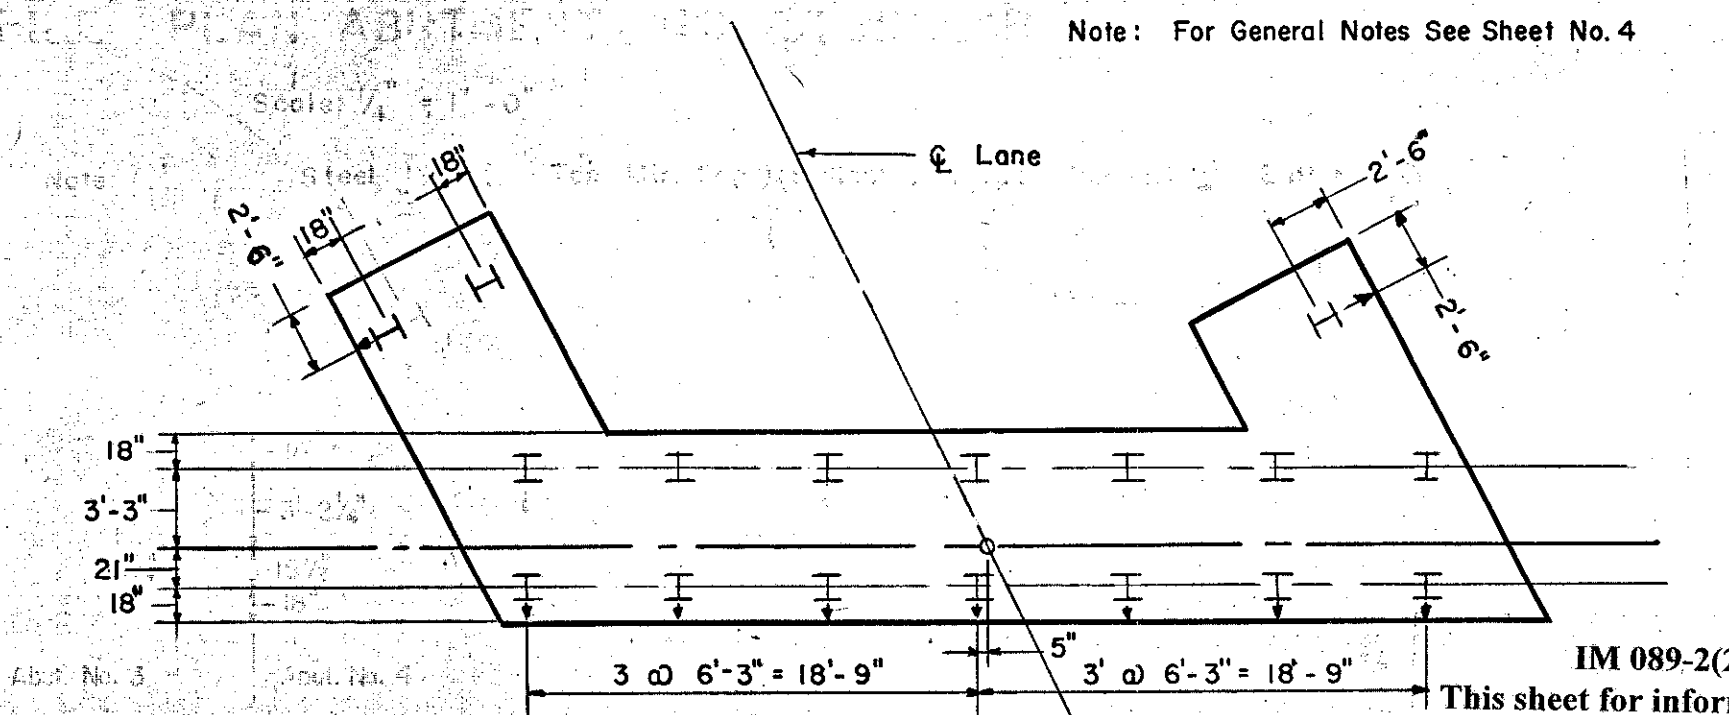

**PILE PLAN ABUTMENT NO. 4**  
**PILE PLAN ABUTMENT NO. 3 (SIMILAR, EXCEPT AS NOTED)**  
Scale: 1/8" = 1'-0"

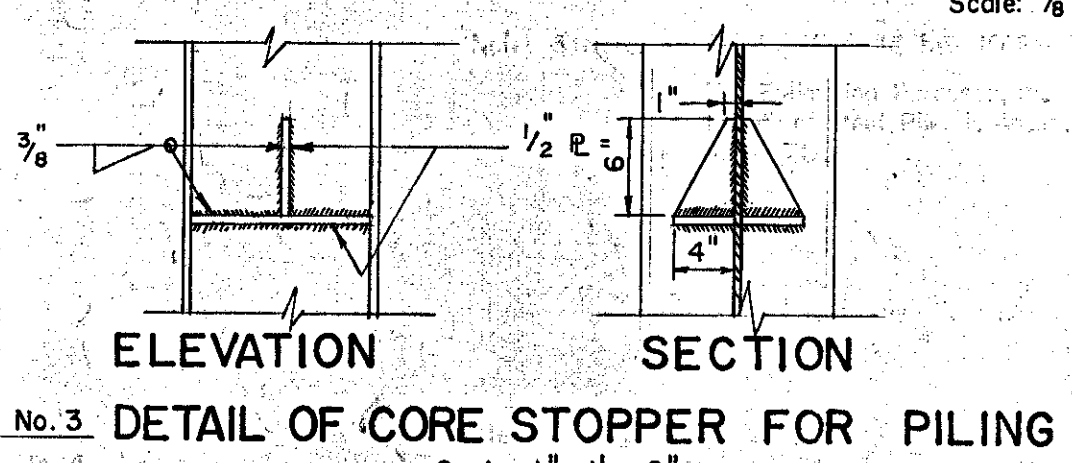


**ELEVATION SECTION**  
Scale: 1" = 1'-0"  
Note: Core Stoppers to be used if so designated by the Engineer at the time of driving the piling. Payment for Core Stoppers, if used, shall be included under Item No. 504, 'Steel Piling'.

**ESTIMATED QUANTITIES**


ITEM NO.	DESCRIPTION	UNIT	ABUTMENT NO. 3				ABUTMENT NO. 4			
			NET	OVER-RUN	TOTAL	FINAL	NET	OVER-RUN	TOTAL	FINAL
107	Structural Excavation	C.Y.	23	2	25	23	2	25	23	
2C4	Sub-base of Crushed Rock (Mod.)	C.Y.	29	4	33	38	29	4	33	
2	Gravel Backfill	C.Y.	66	14	80	48	53	101	107	
40-B	Concrete, Class 'B' (Mod.)	C.Y.	107	5	112	109	104	5	109	
4C2	Reinforcing Steel	LBS	See Reinforcing Schedule, Sheet No. 12							
407	Asphaltic-Asbestos Coating	SY	8	0	8	8	8	0	8	
504	Steel Piling	LF	190	0	190	859	190	0	190	

IM 089-2(26)  
This sheet for information only  
**BR 48 N & S**  
CONTRACT NO. 1  
**ABUTMENTS NO. 3 AND NO. 4**  
STATE OF VERMONT  
DEPARTMENT OF HIGHWAYS  
INTERSTATE PROJECT in the town of  
**WATERBURY**  
INTERSTATE OVER STA. 865+24  
LITTLE RIVER OVER STA. 5+15  
THE CLARKESON ENGINEERING CO. INC.  
BOSTON, MASSACHUSETTS  
SURVEYED BY B.S.S. CHECKED BY B.K.A.J.B. SCALE AS NOTED  
DRAWN BY B.S.S. IN CHARGE J.V.B. DATE 8-20-57  
PROJECT NO. I-89-2(7) SHEET 228 OF 307


B. P. R. DIV. NO.	STATE	PROJECT NO.	SHEET NO.	TOTAL SHEETS
1	VT.	1-89-2(7)	64	229

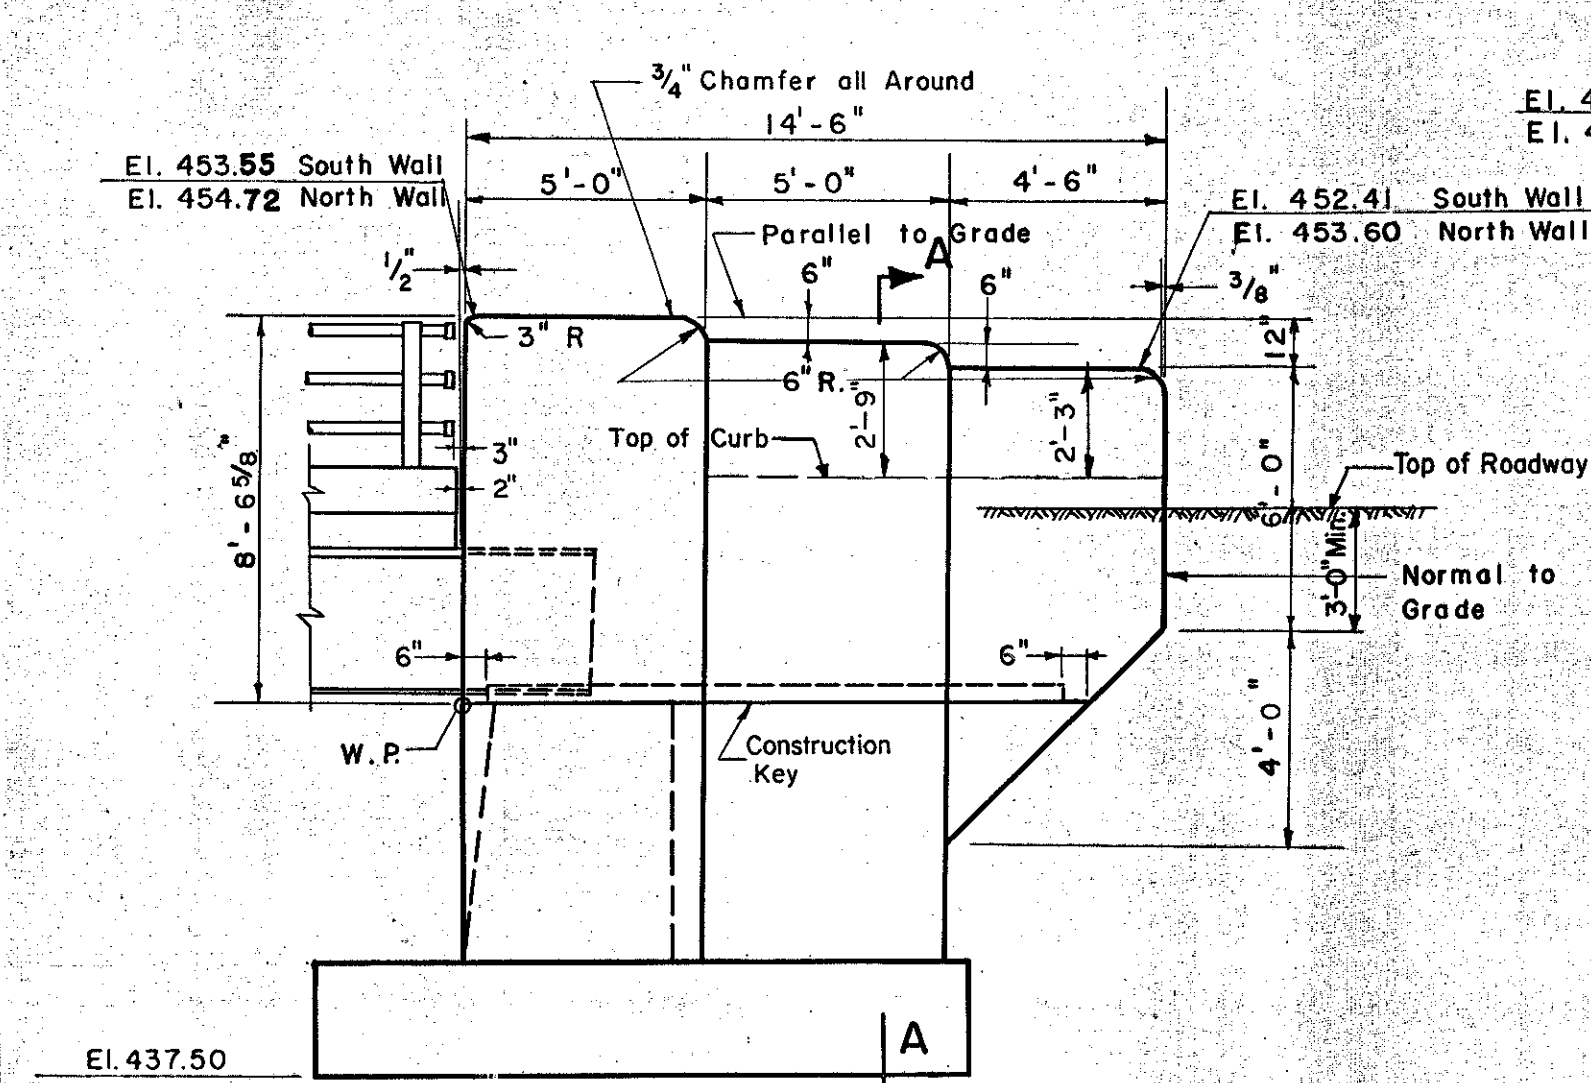


**ABUTMENT NO. 1 SOUTH WALL**  
**ABUTMENT NO. 1 NORTH WALL (SIMILAR)**

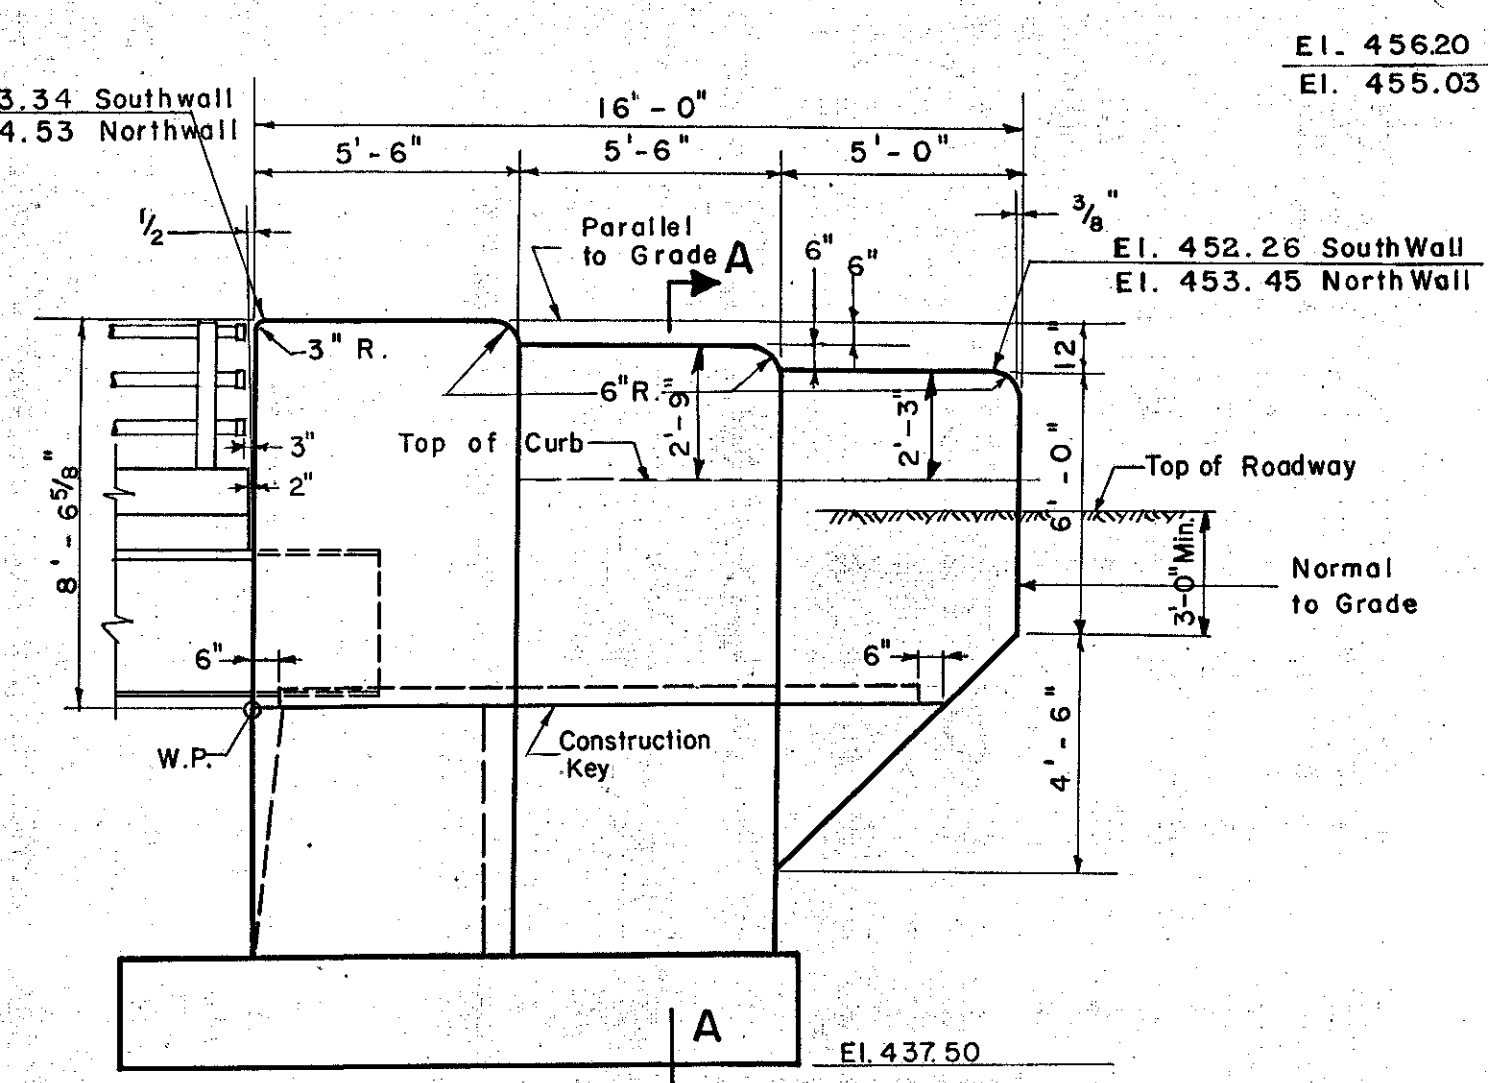


**ABUTMENT NO. 2 SOUTH WALL**  
**ABUTMENT NO. 2 NORTH WALL (SIMILAR)**

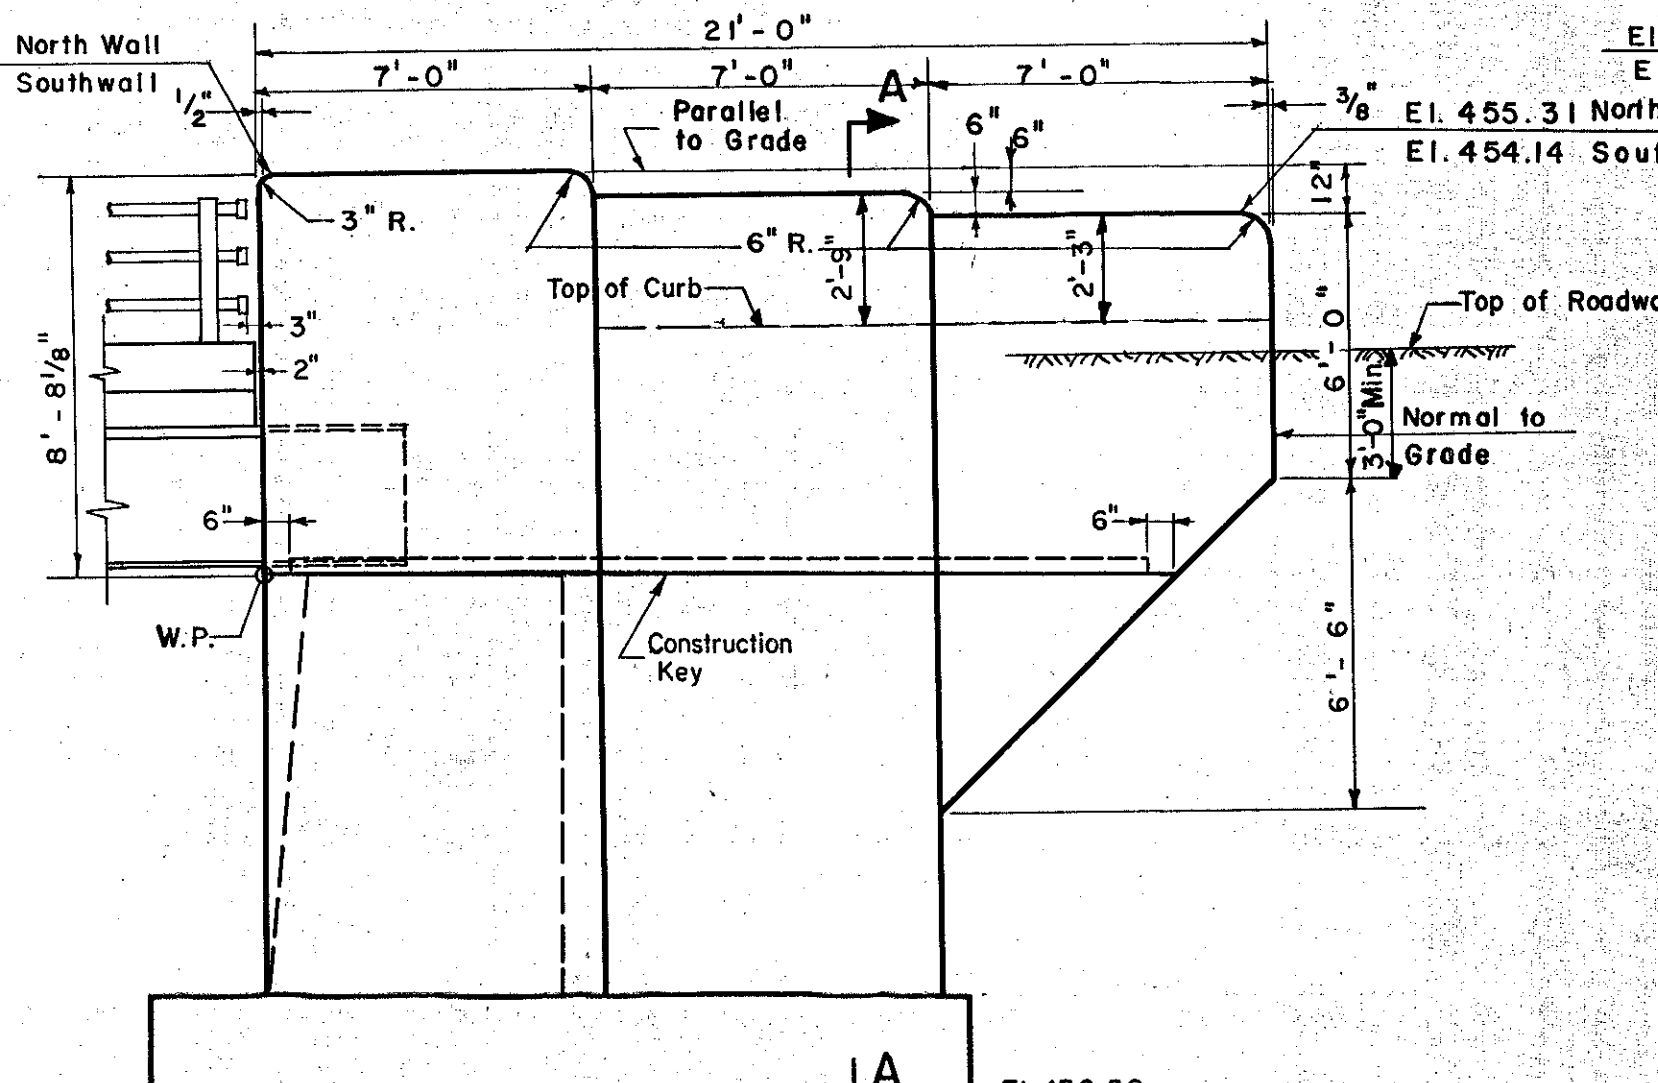

**ABUTMENT NO. 3 NORTH WALL**  
**ABUTMENT NO. 3 SOUTH WALL (SIMILAR)**

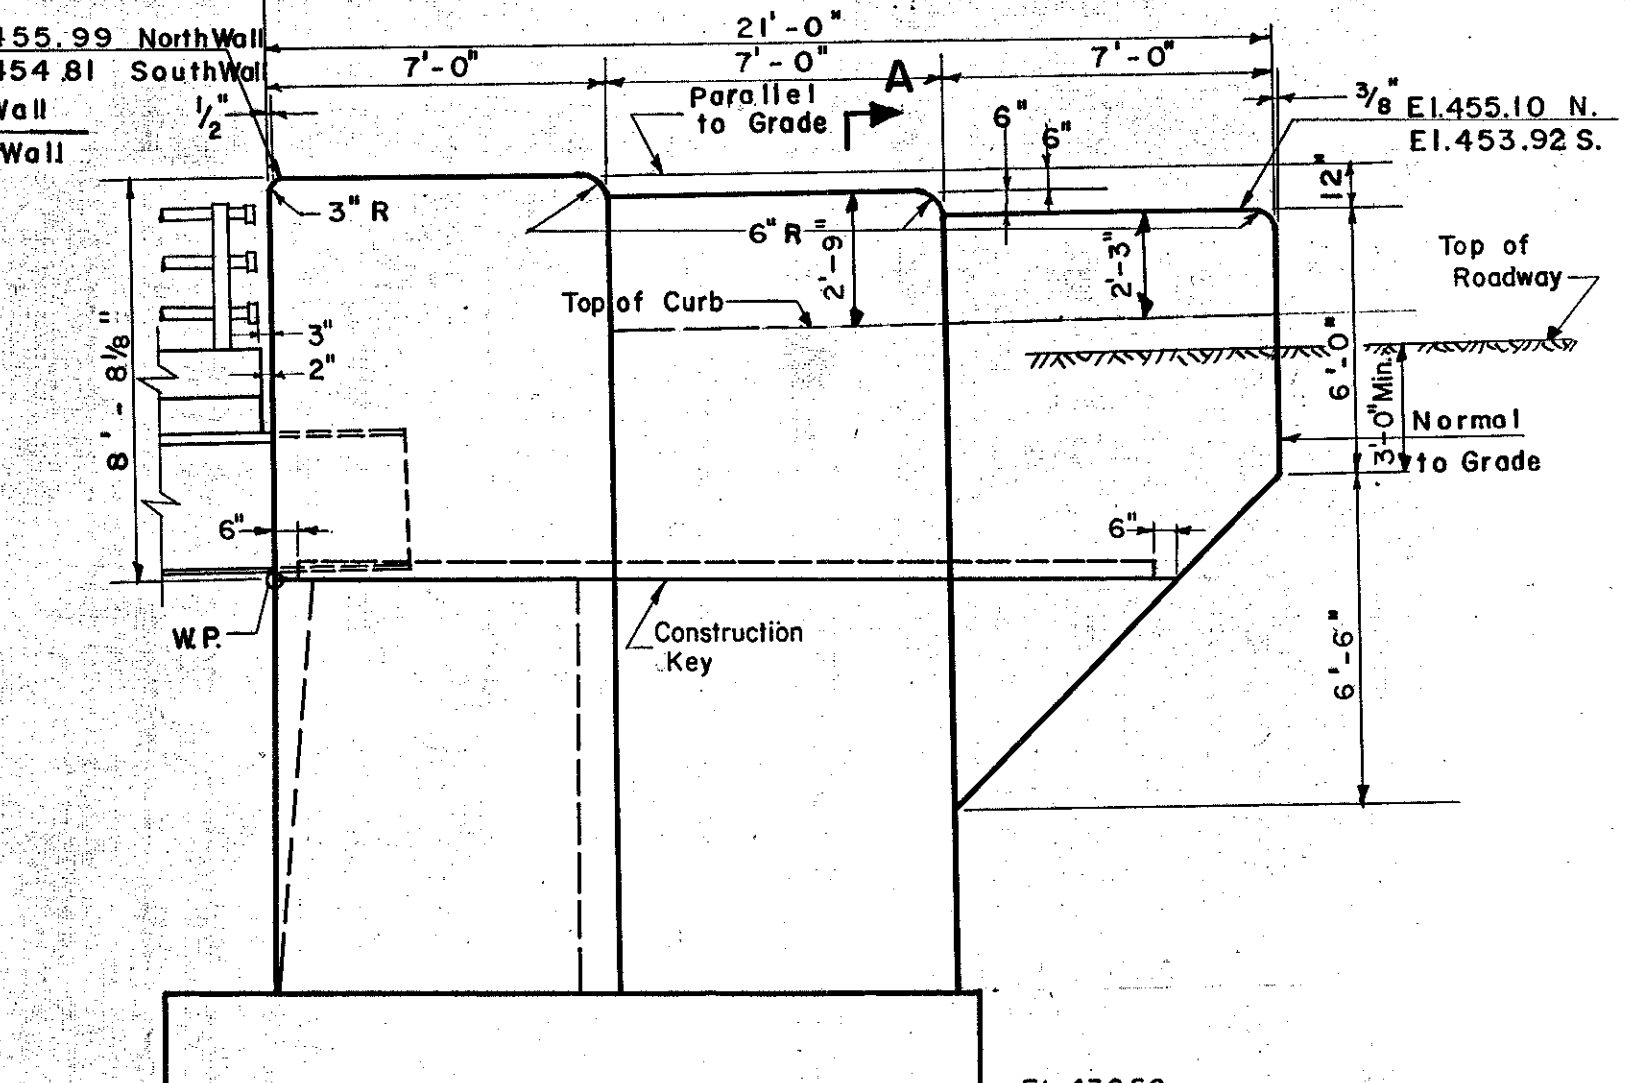


**ABUTMENT NO. 4 NORTH WALL**  
**ABUTMENT NO. 4 SOUTH WALL (SIMILAR)**

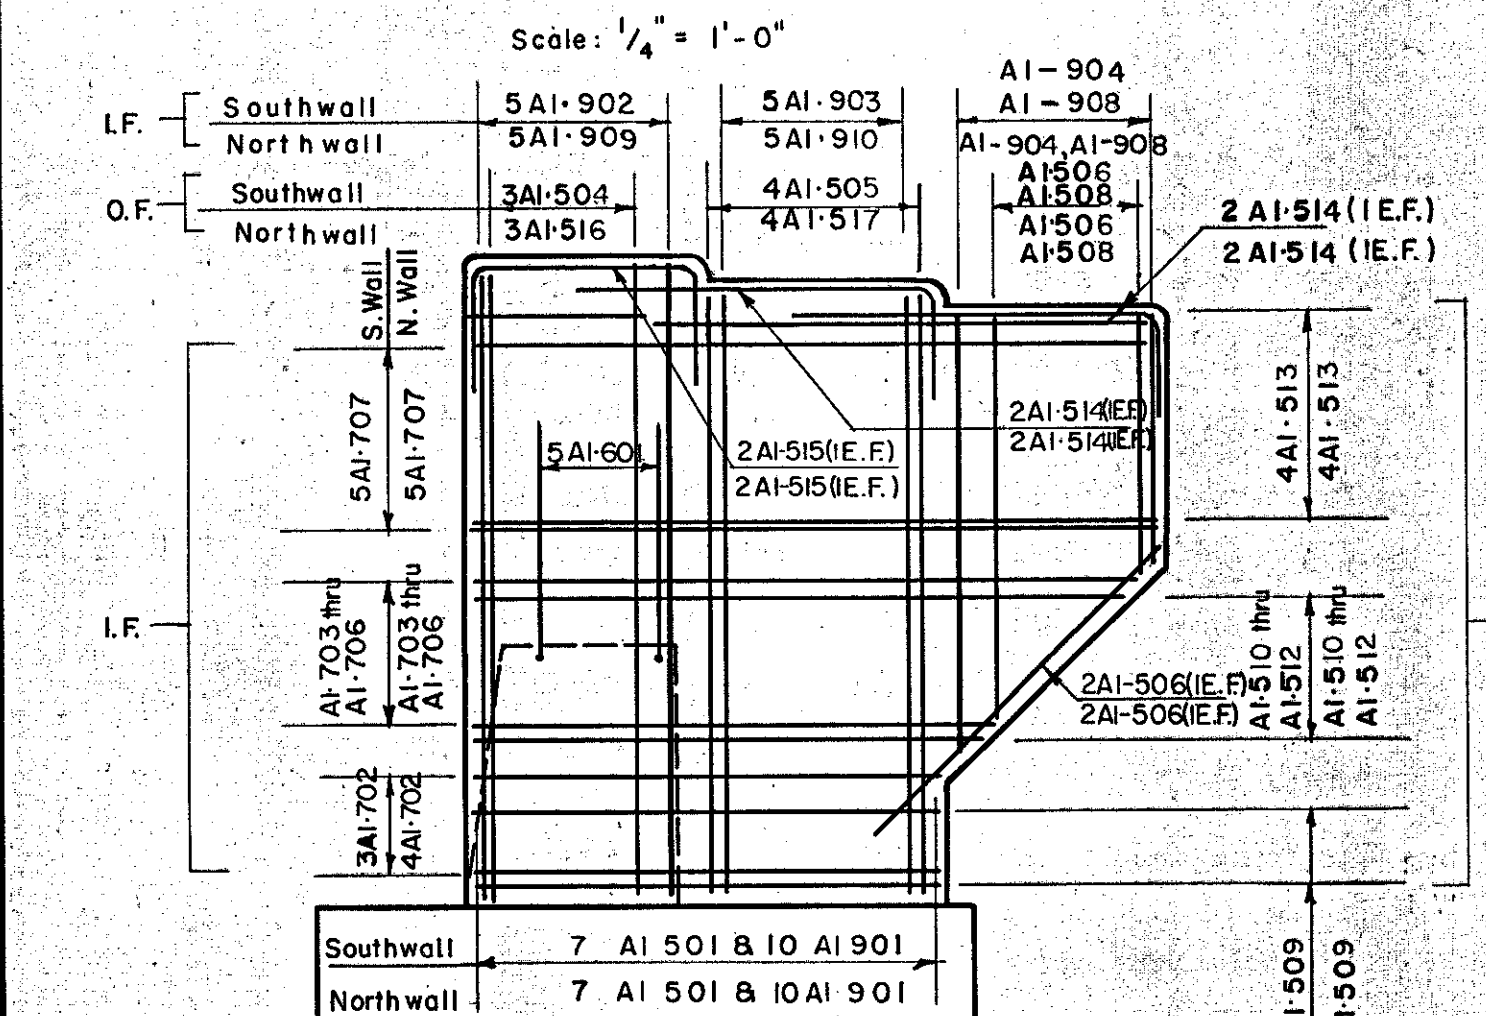


**WINGWALL REINFORCING**  
**ABUTMENT NO. 1**

Scale: 1/4" = 1'-0"

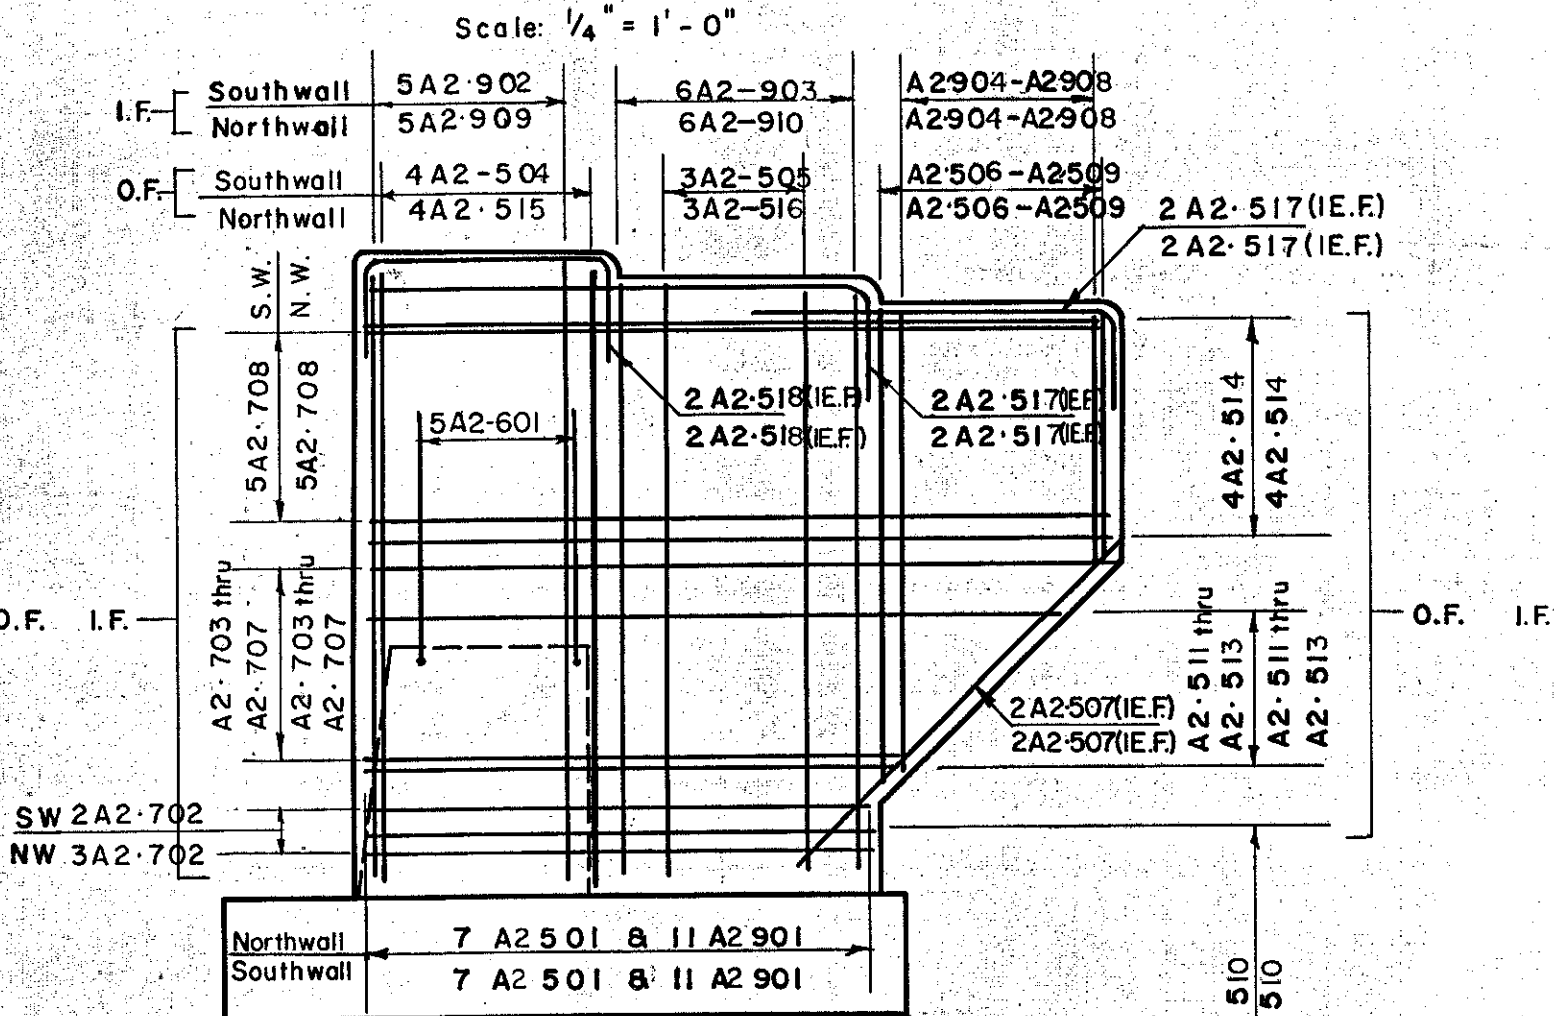

**WINGWALL REINFORCING**  
**ABUTMENT NO. 2**


Scale: 1/4" = 1'-0"

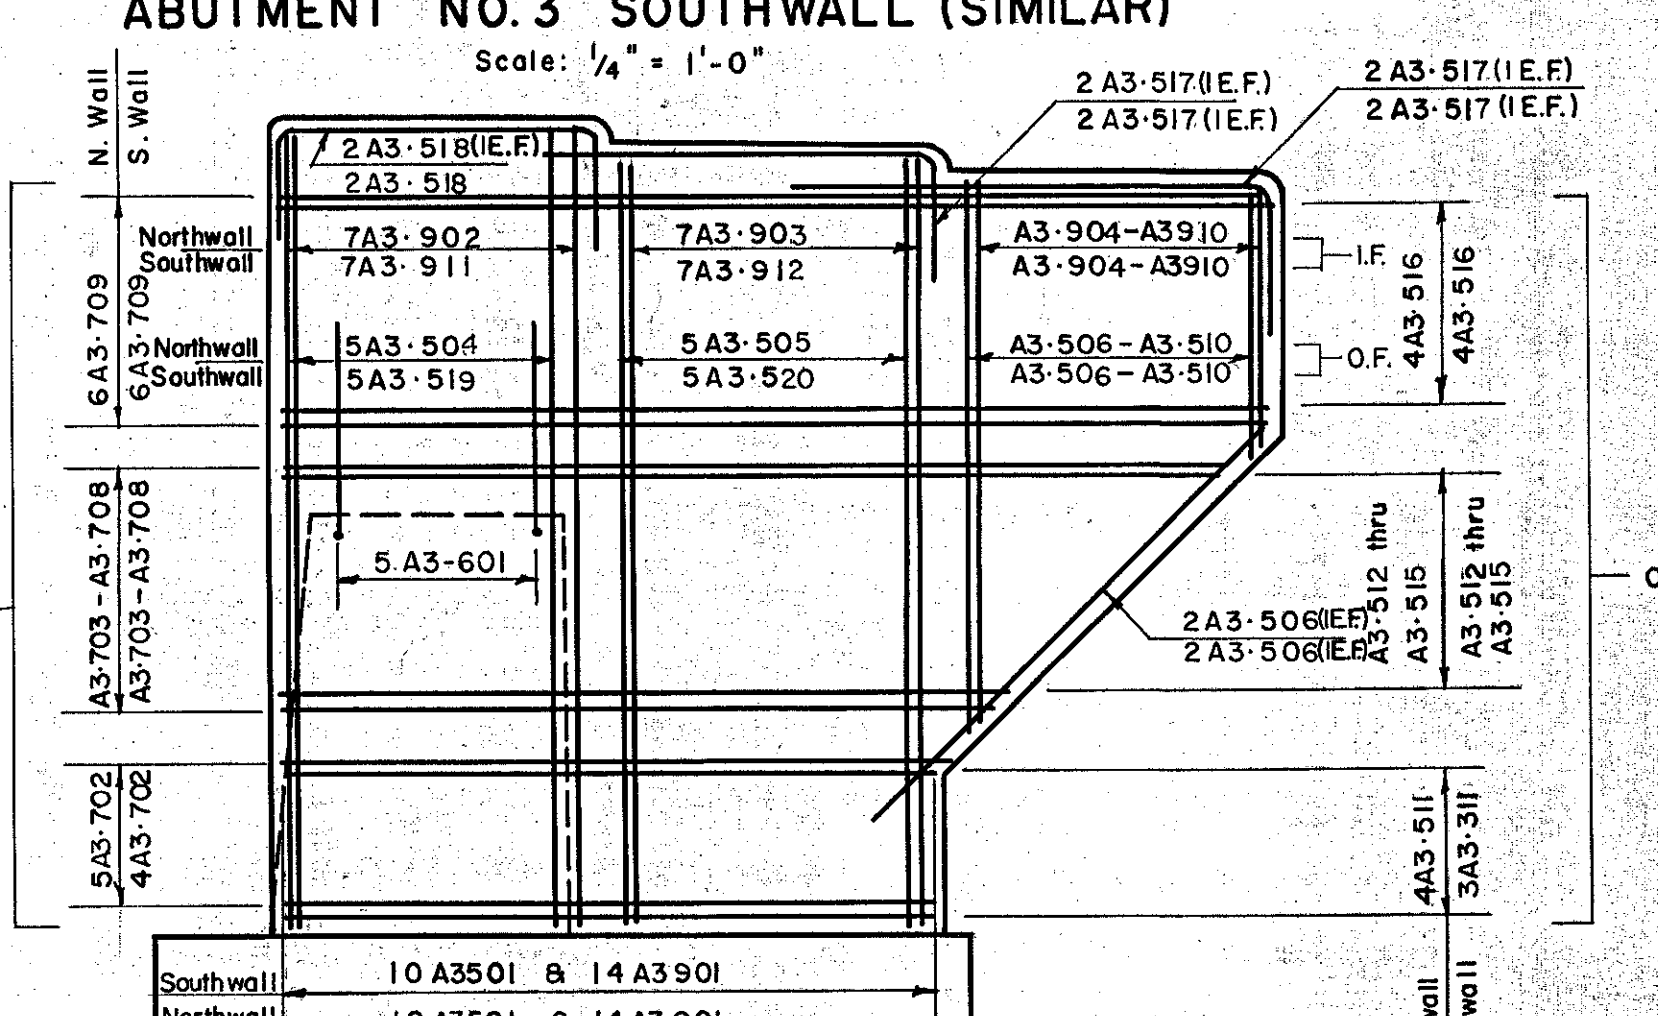

**WINGWALL REINFORCING**  
**ABUTMENTS NO. 3 & NO. 4**


Scale: 1/4" = 1'-0"

NOTE: Reinforcement indicated is for Abutment No. 3, Abutment No. 4 similar except prefixed A4

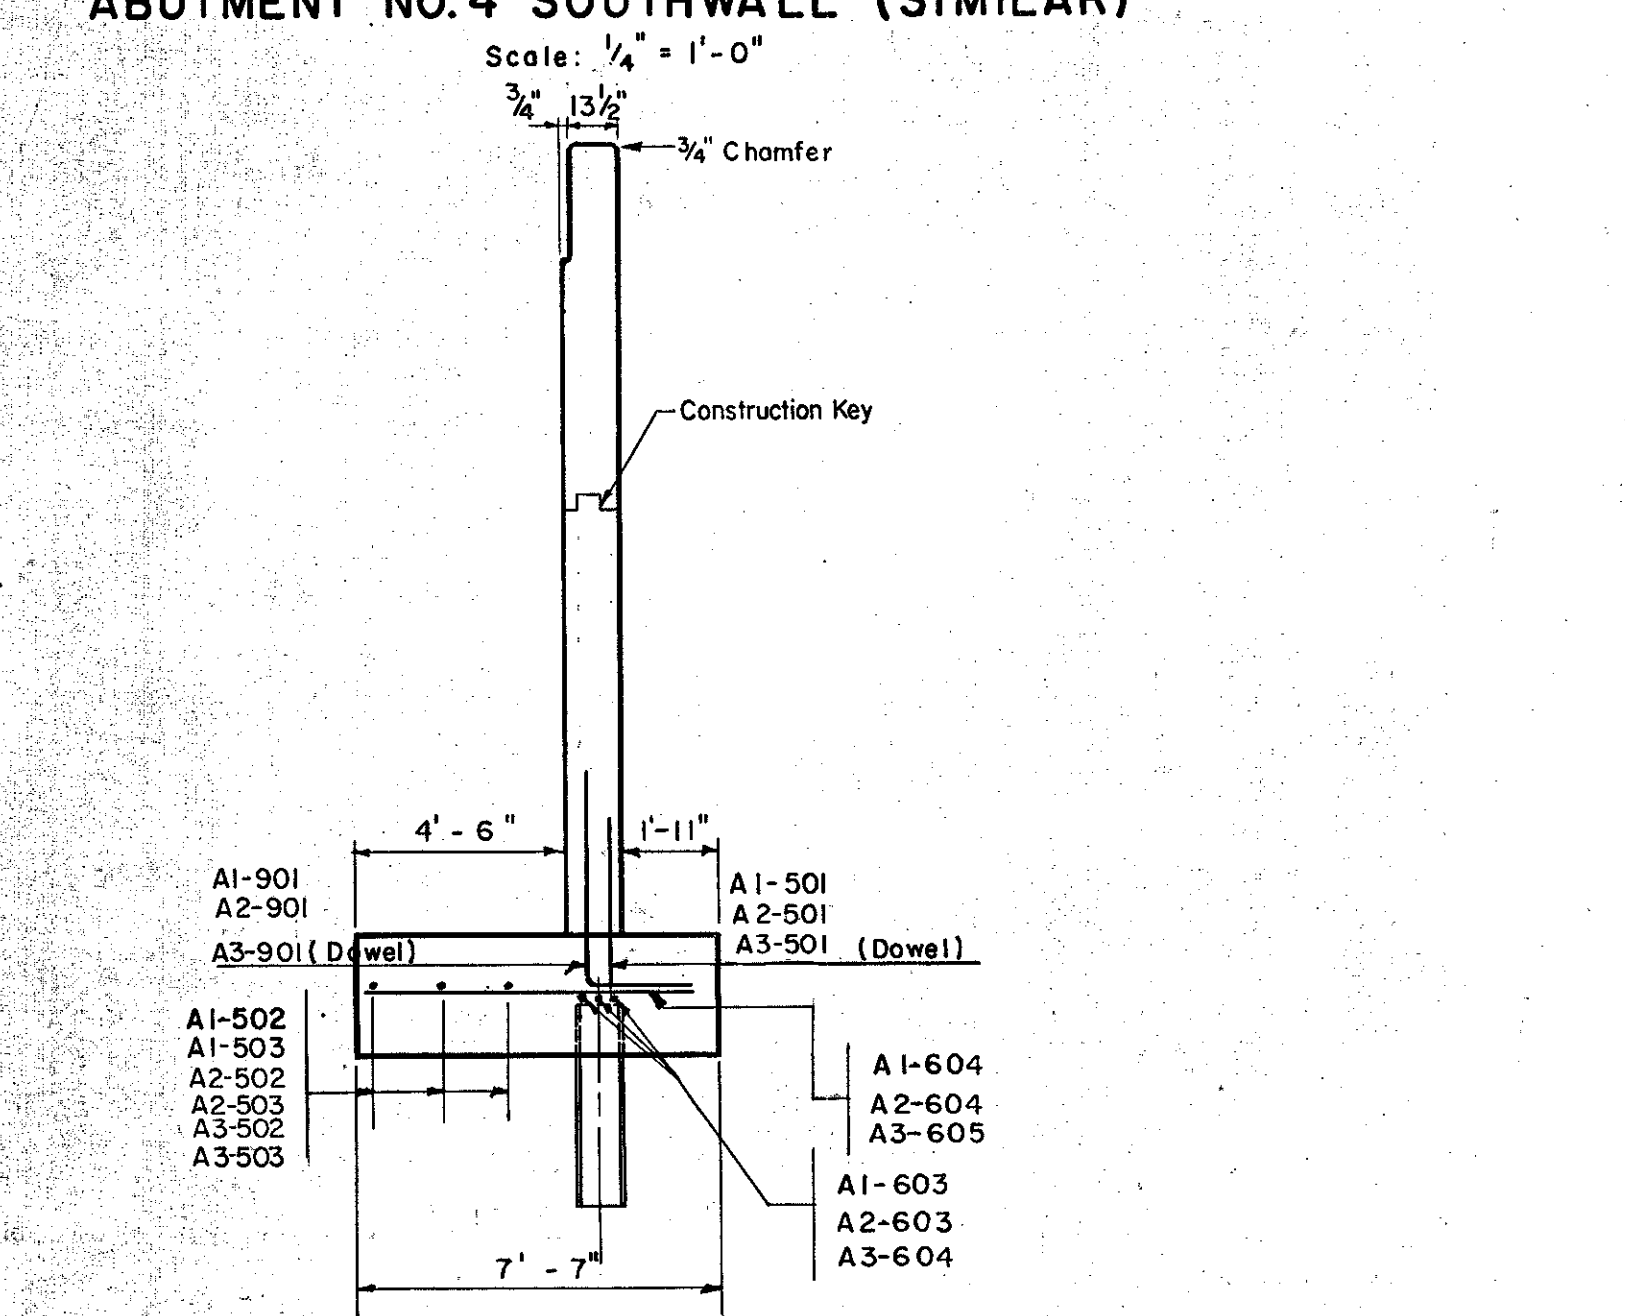


**SECTION A-A**

Scale: 1/4" = 1'-0"

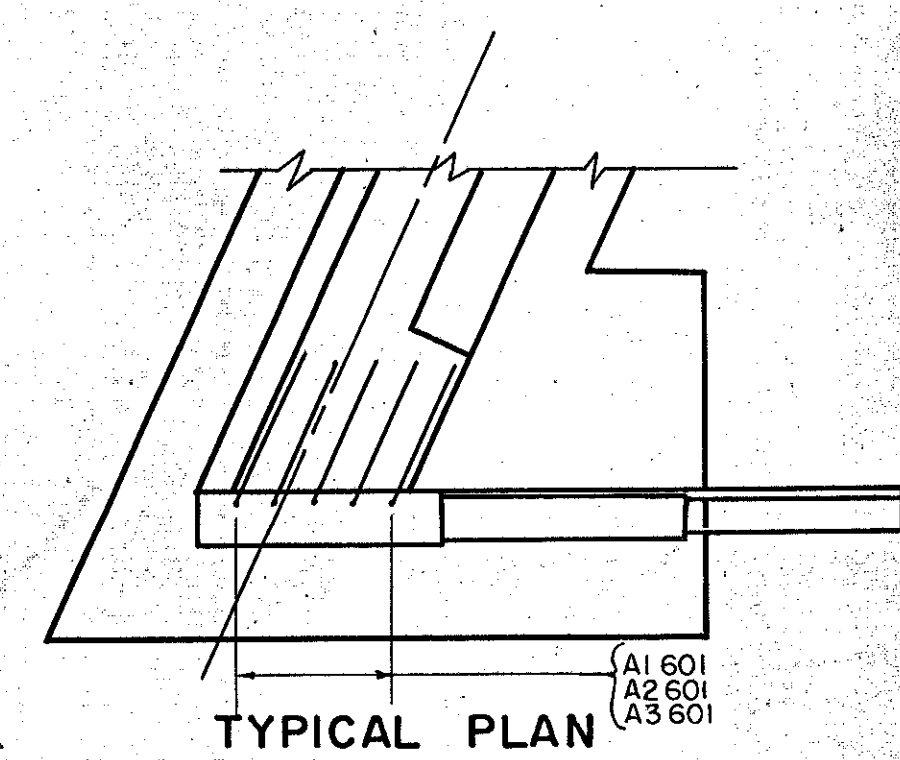

**WINGWALL REINFORCING**


Scale: 1/4" = 1'-0"

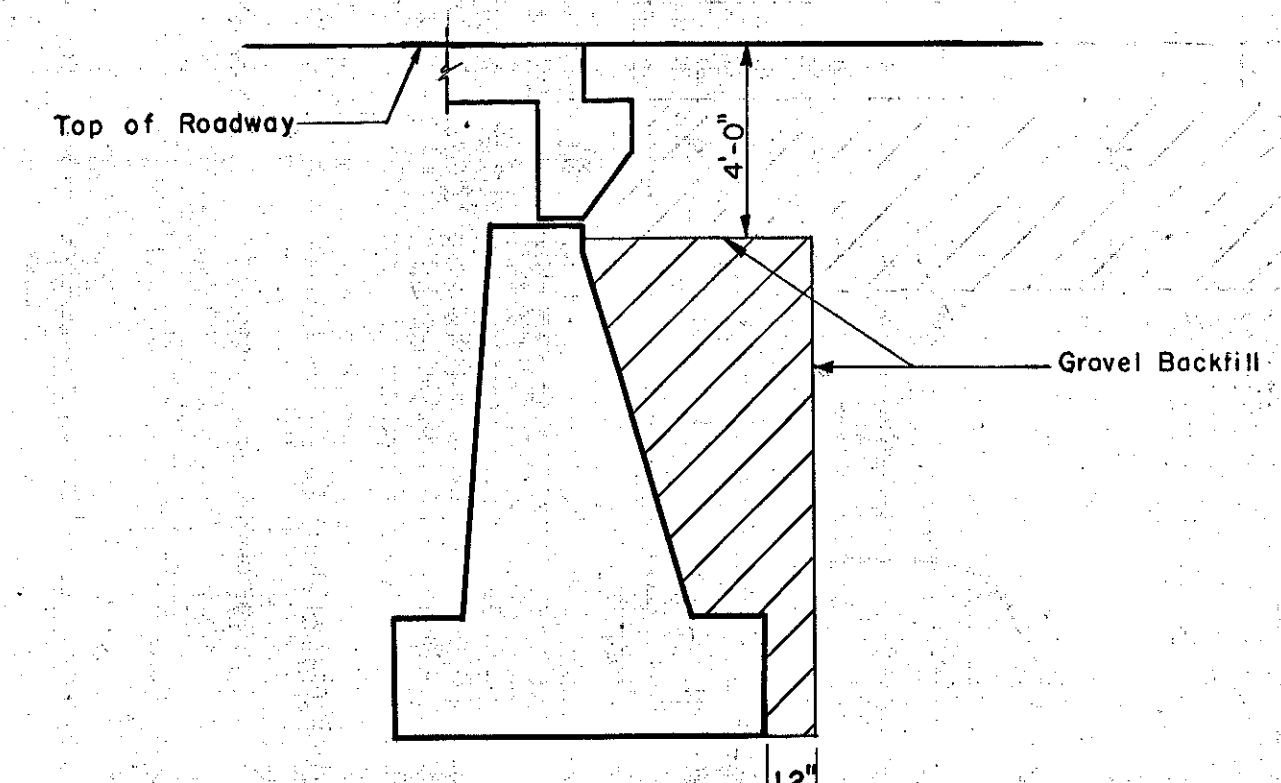

**LIMITS OF GRAVEL BACKFILL**

Scale: 1/4" = 1'-0"

FOR PILE SPLICE DETAIL, SEE STANDARD SHEET SB-20-56

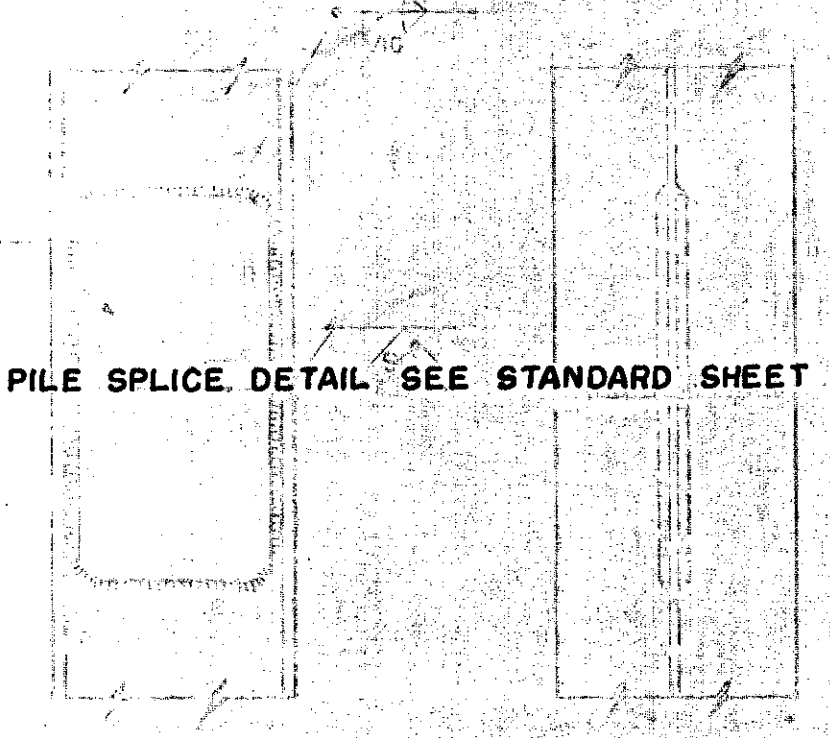

**PILE SPLICE DETAILS**


IM 089-2(26)  
 This sheet for information only  
**BR 48 N & S**

CONTRACT NO. 1


**WINGWALLS**

STATE OF VERMONT DEPARTMENT OF HIGHWAYS	
INTERSTATE PROJECT in the town of WATERBURY	
INTERSTATE	STA. 865 + 24
LITTLE RIVER	OVER STA. 5 + 15
THE CLARKESON ENGINEERING CO. INC. CONSULTING ENGINEERS	
BOSTON	MASSACHUSETTS
SUPPLIED BY	CHECKED BY
DRAWN BY B.S.S.	IN CHARGE J.V.B.
PROJECT NO. 1-89-2(7)	SHEET 229 OF 307


B. P. R. DIV. NO.	STATE	PROJECT NO.	SHEET NO.	TOTAL SHEETS
1	VT.	1-89-2(7)	25	30

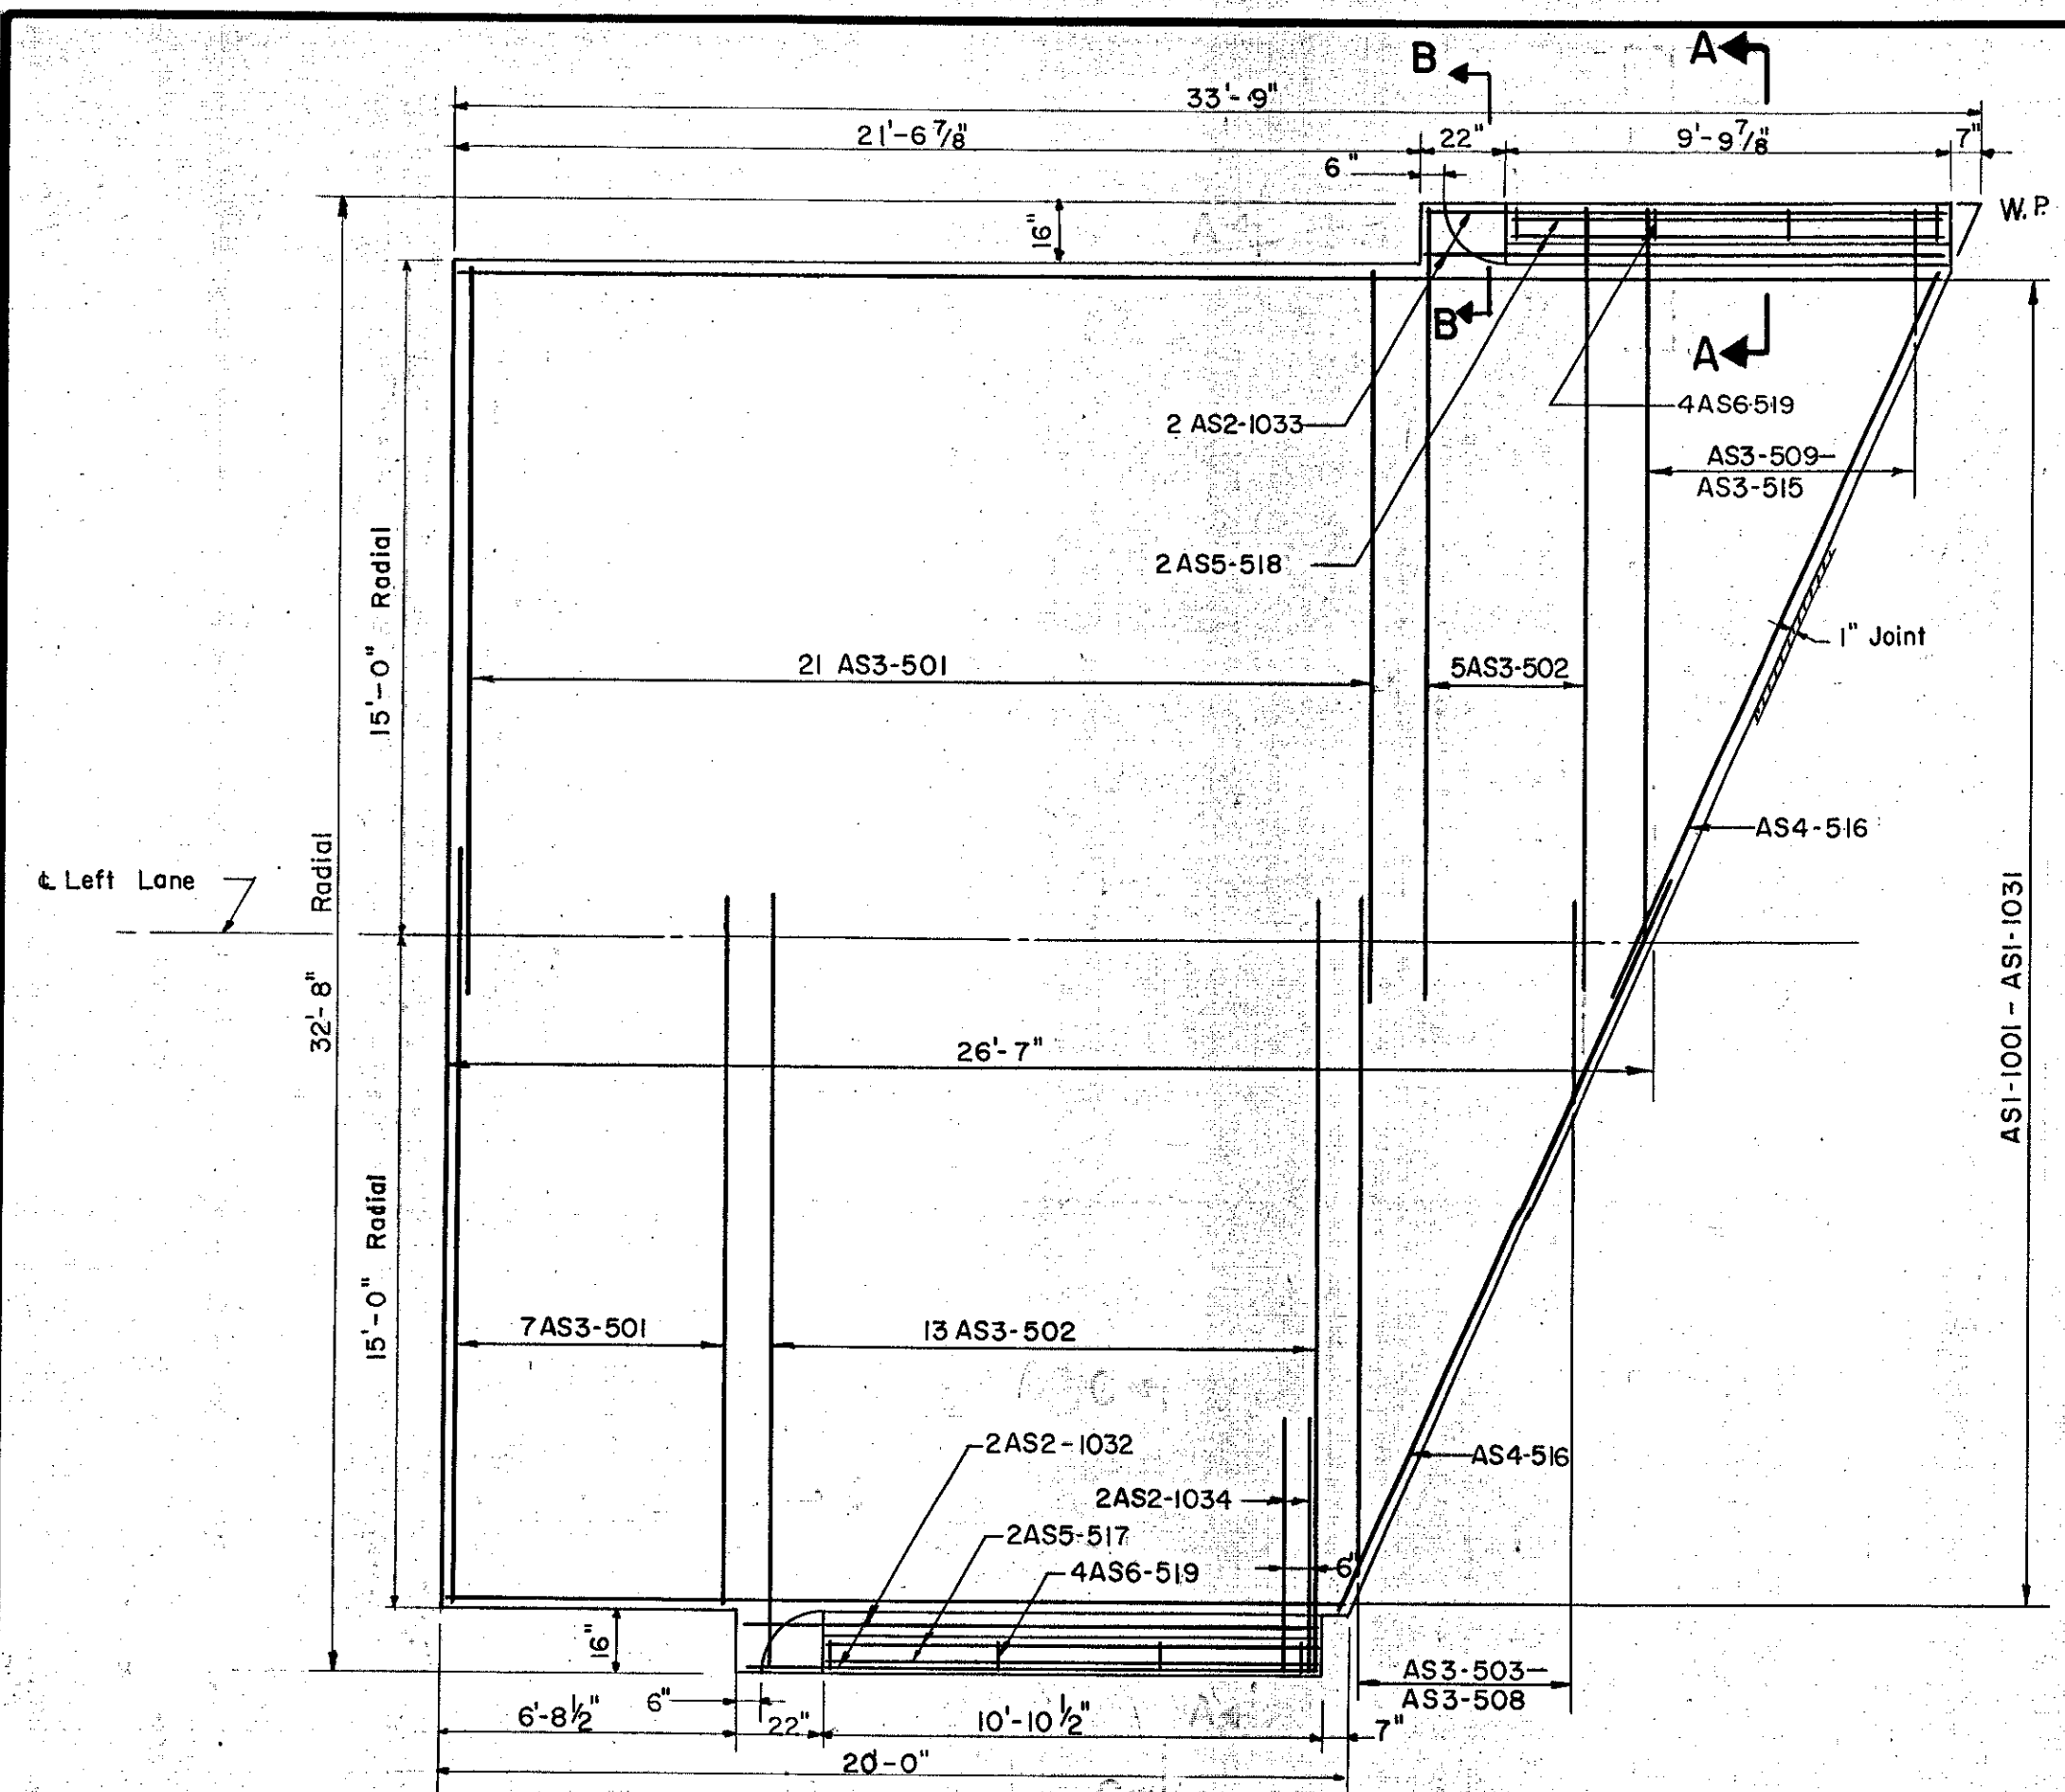


**APPROACH SLAB ABUTMENT NO. 1**  
Scale: 1/4" = 1'-0"

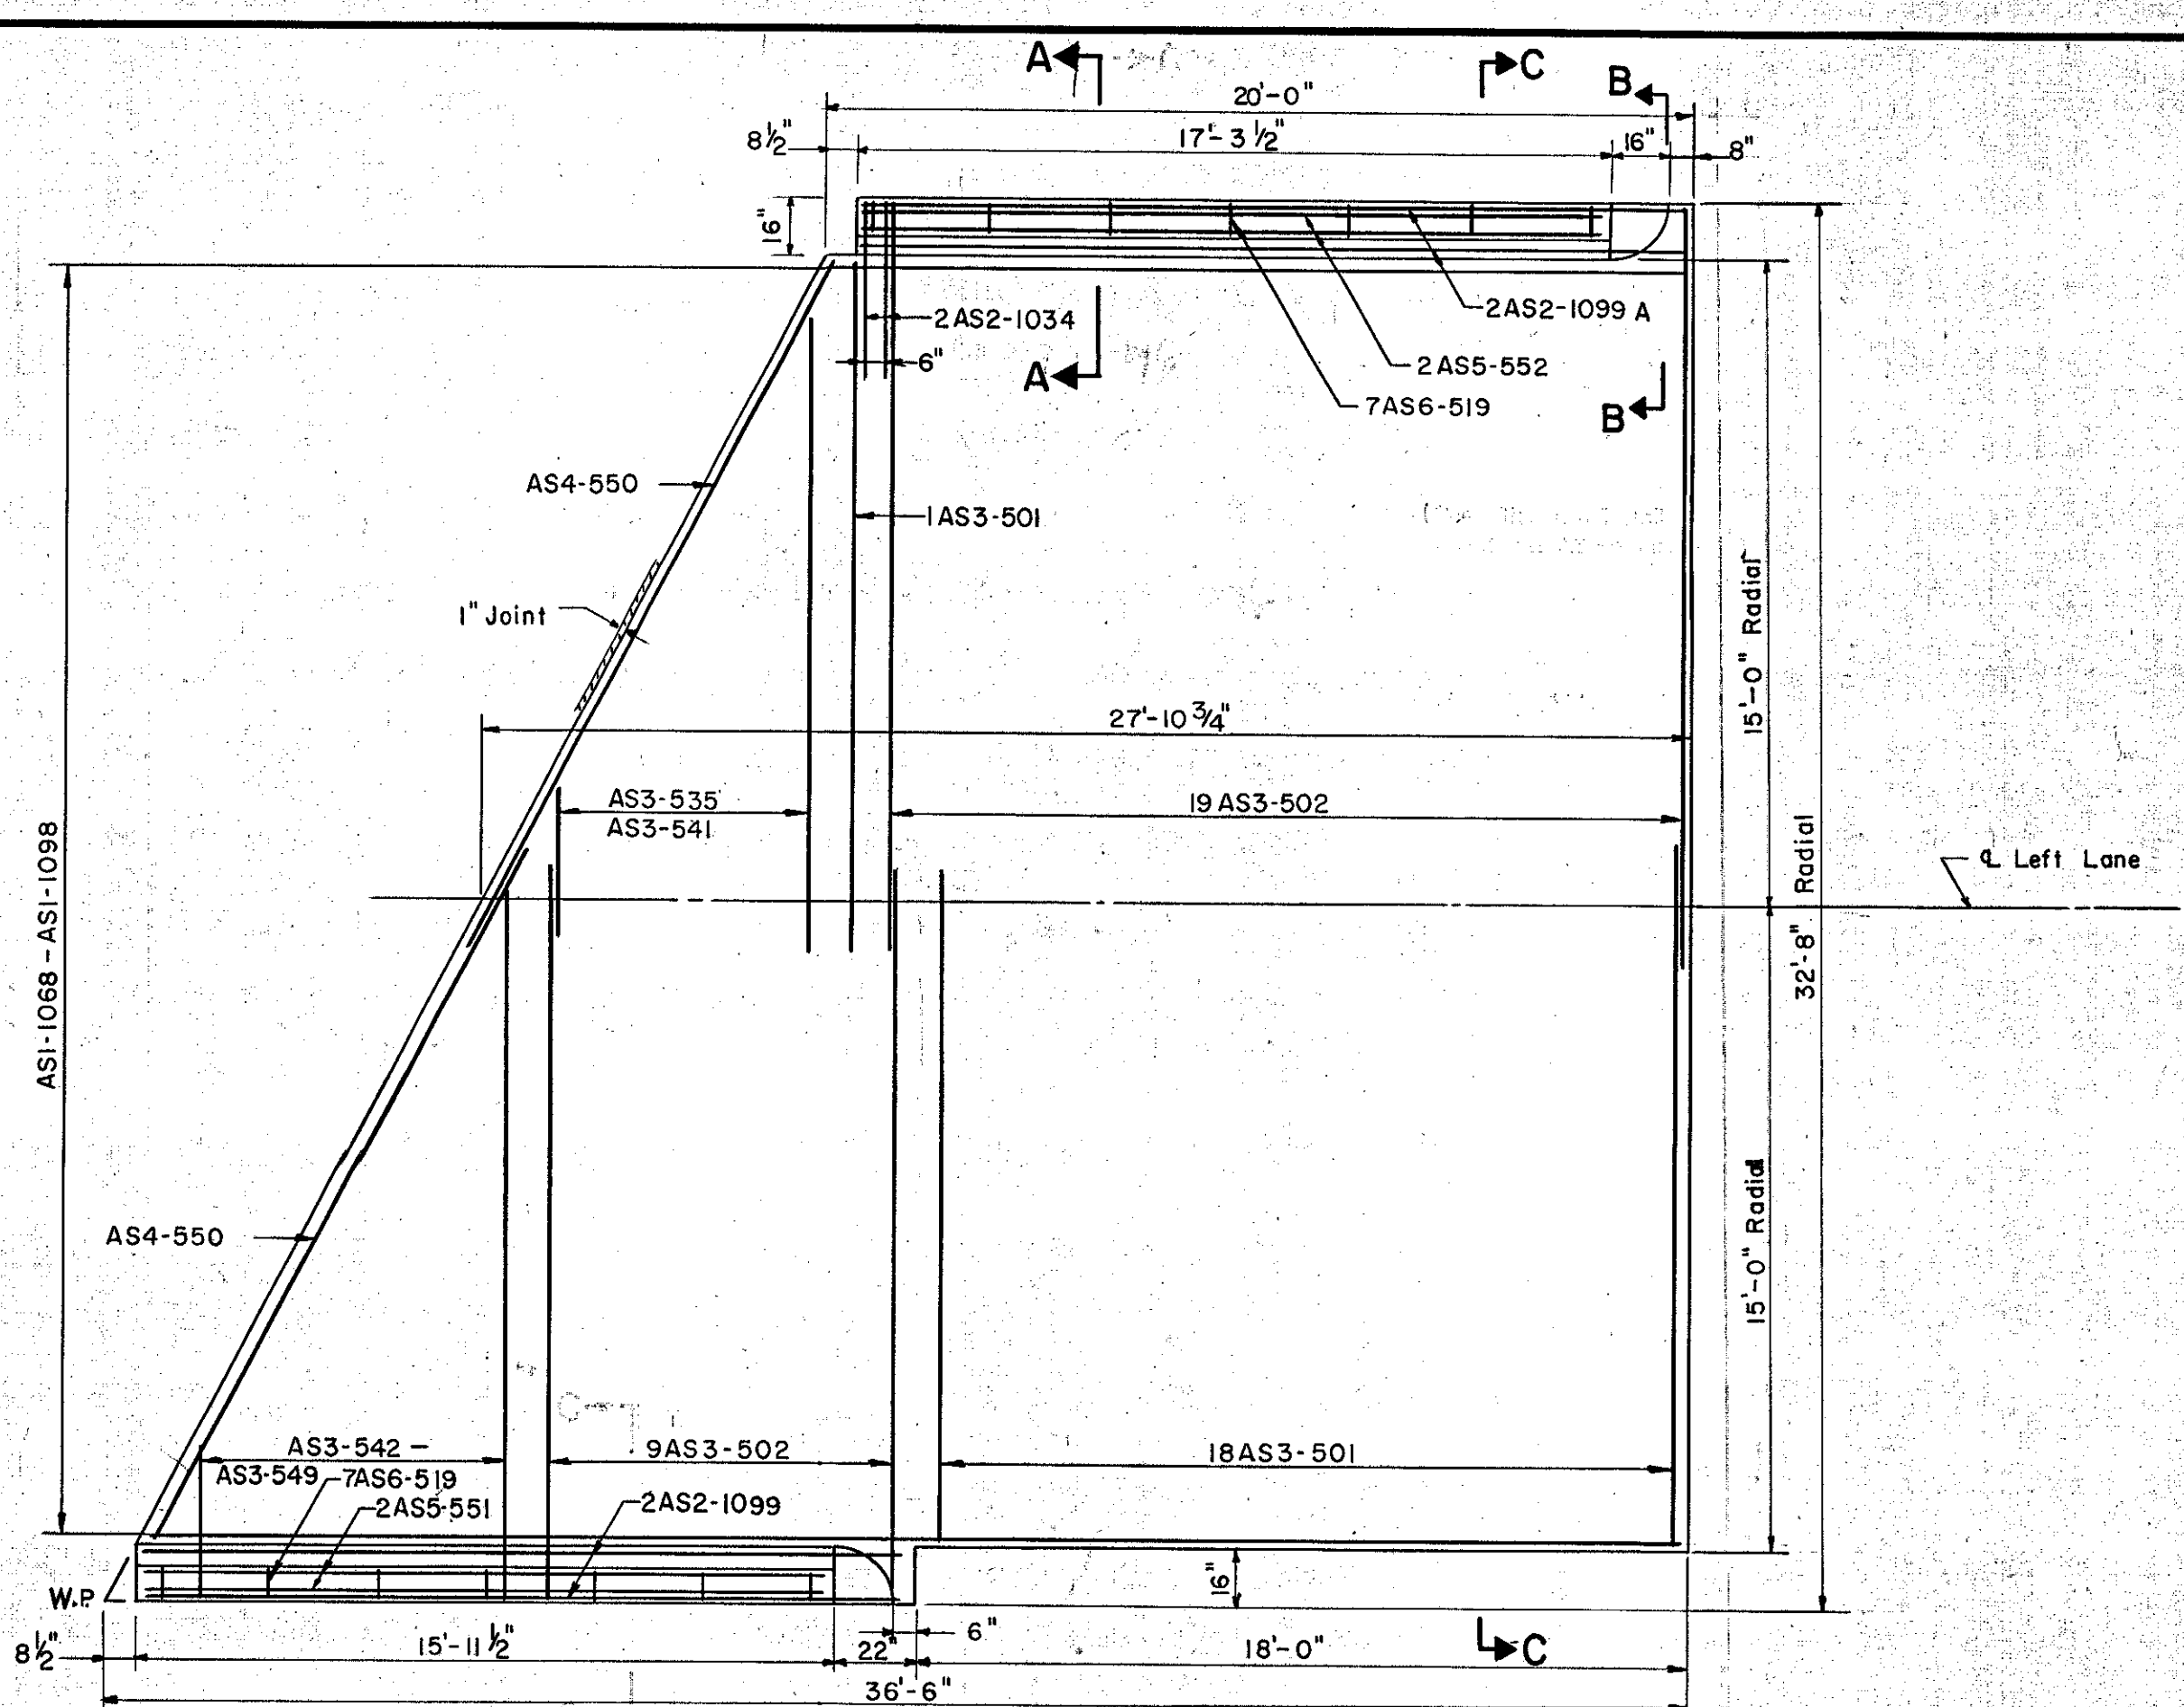

**APPROACH SLAB ABUTMENT NO. 3**  
Scale: 1/4" = 1'-0"

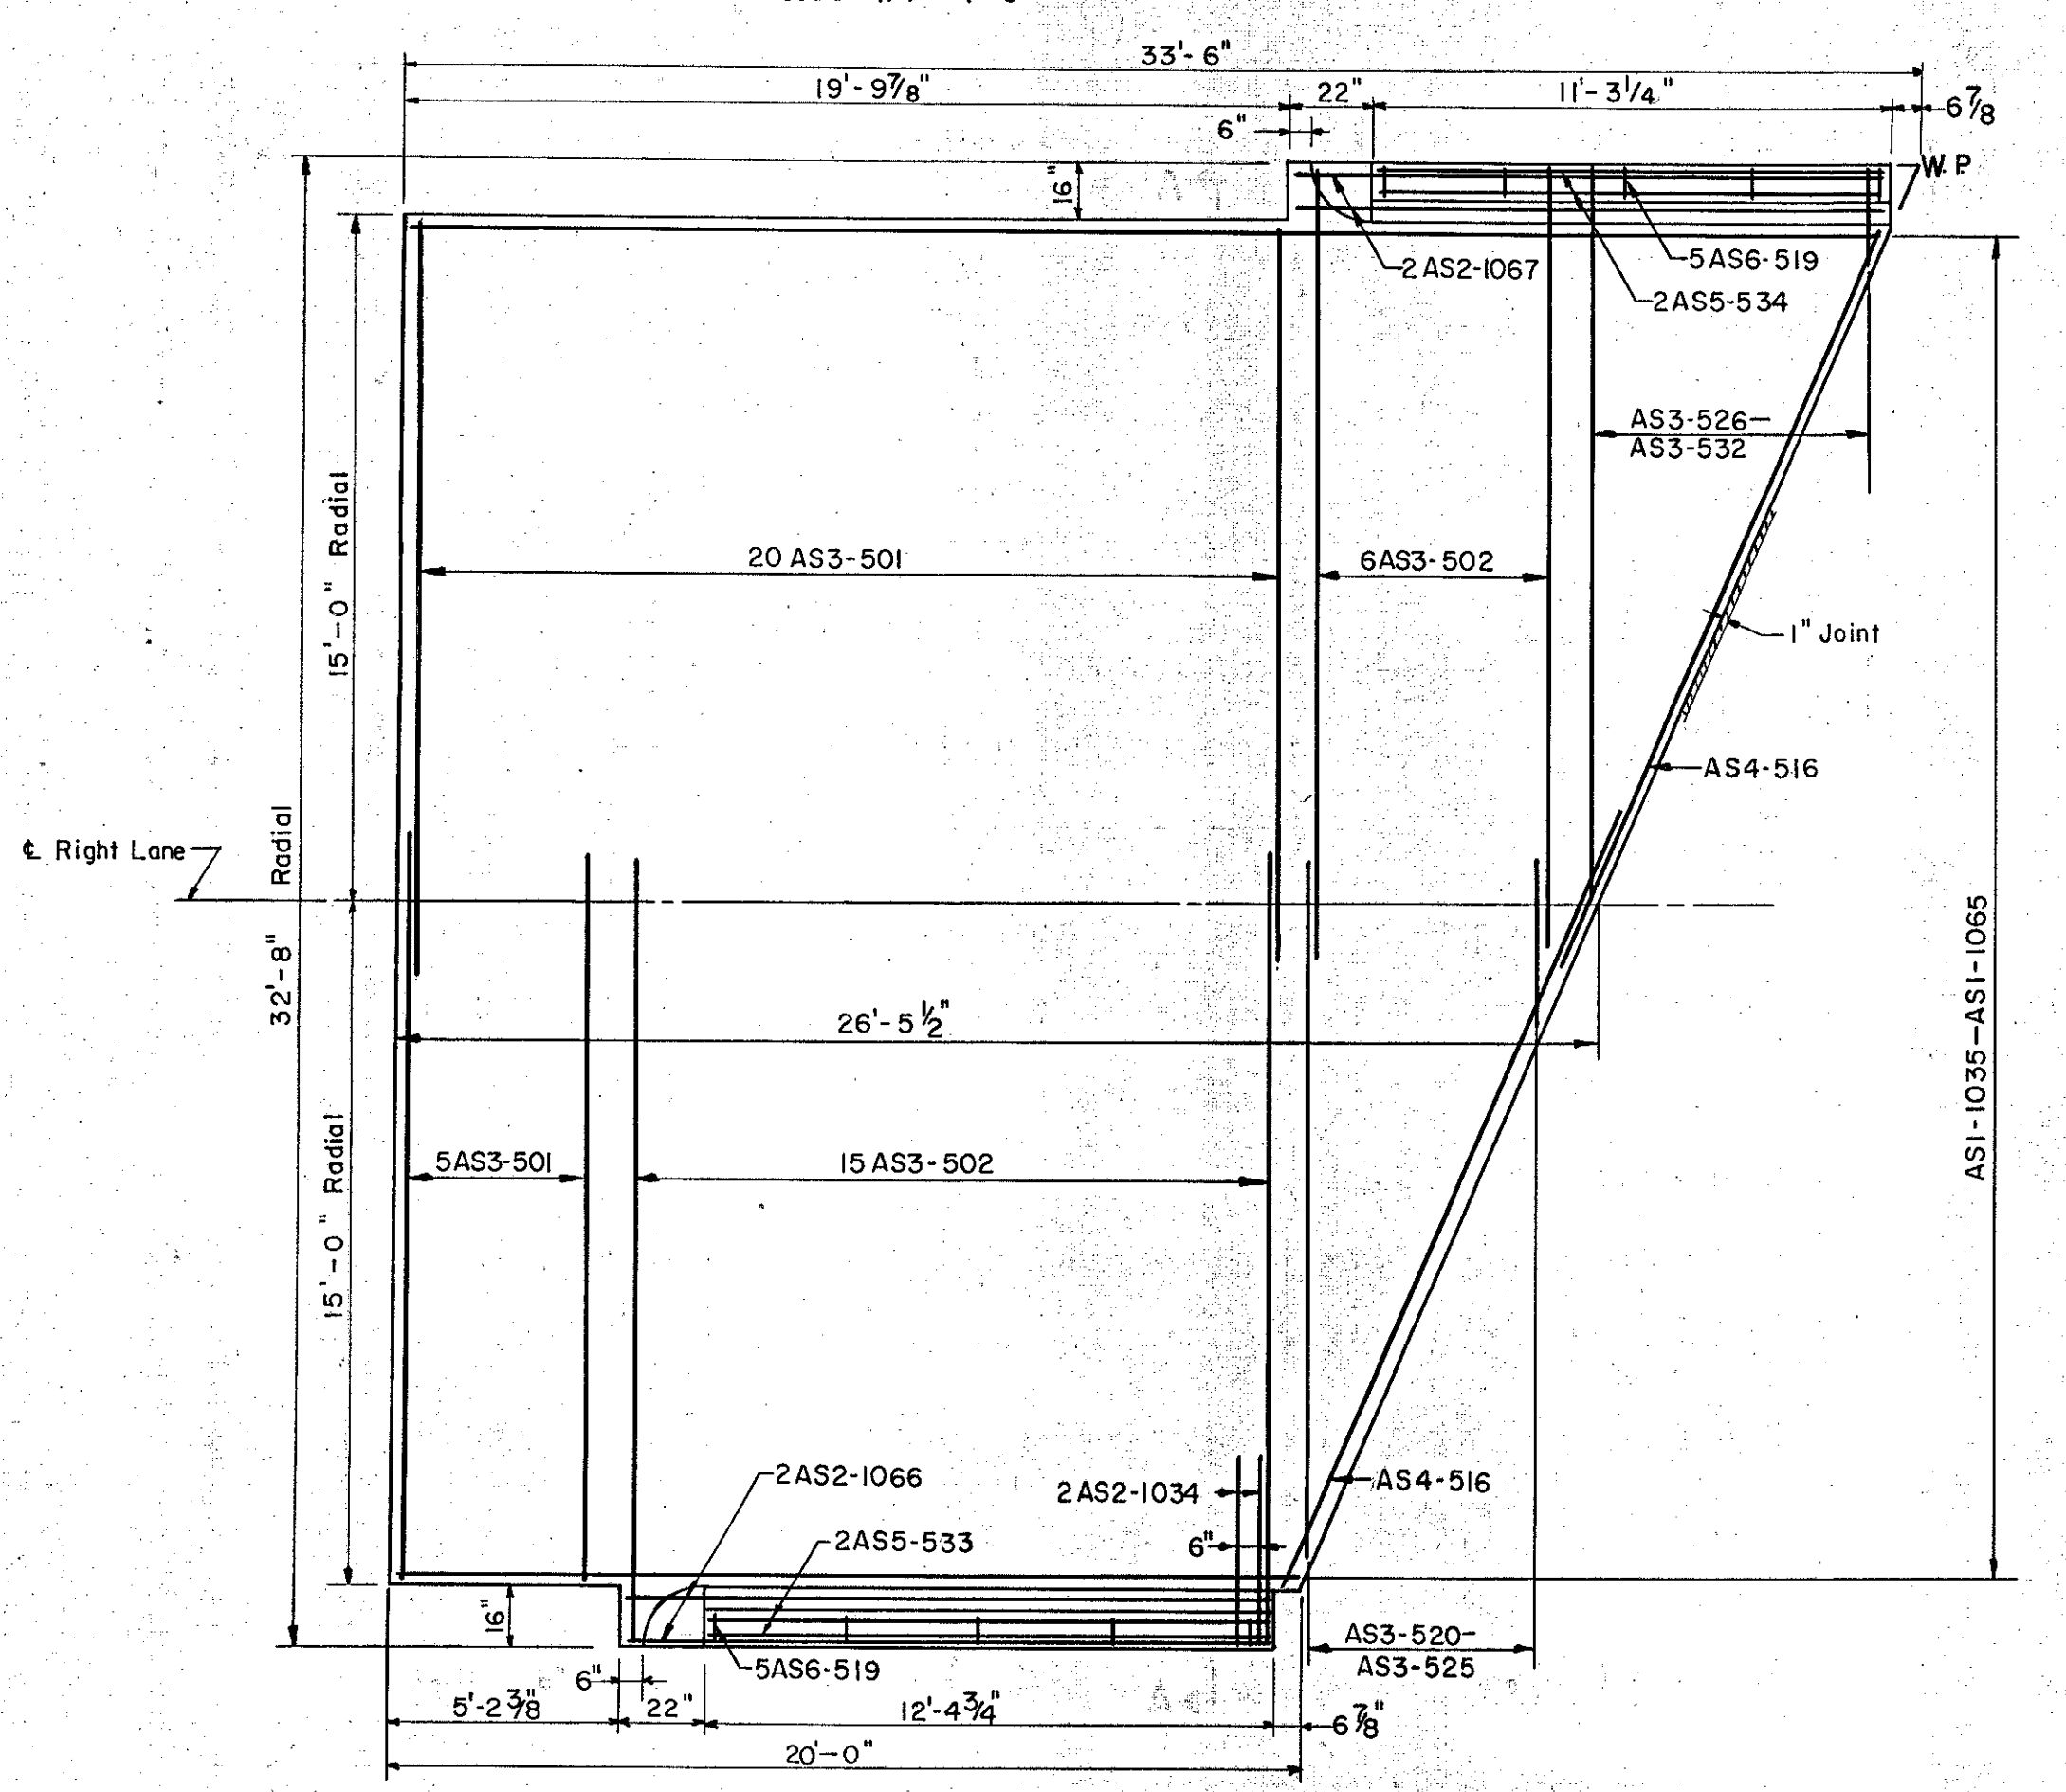


**APPROACH SLAB ABUTMENT NO. 2**  
Scale: 1/4" = 1'-0"

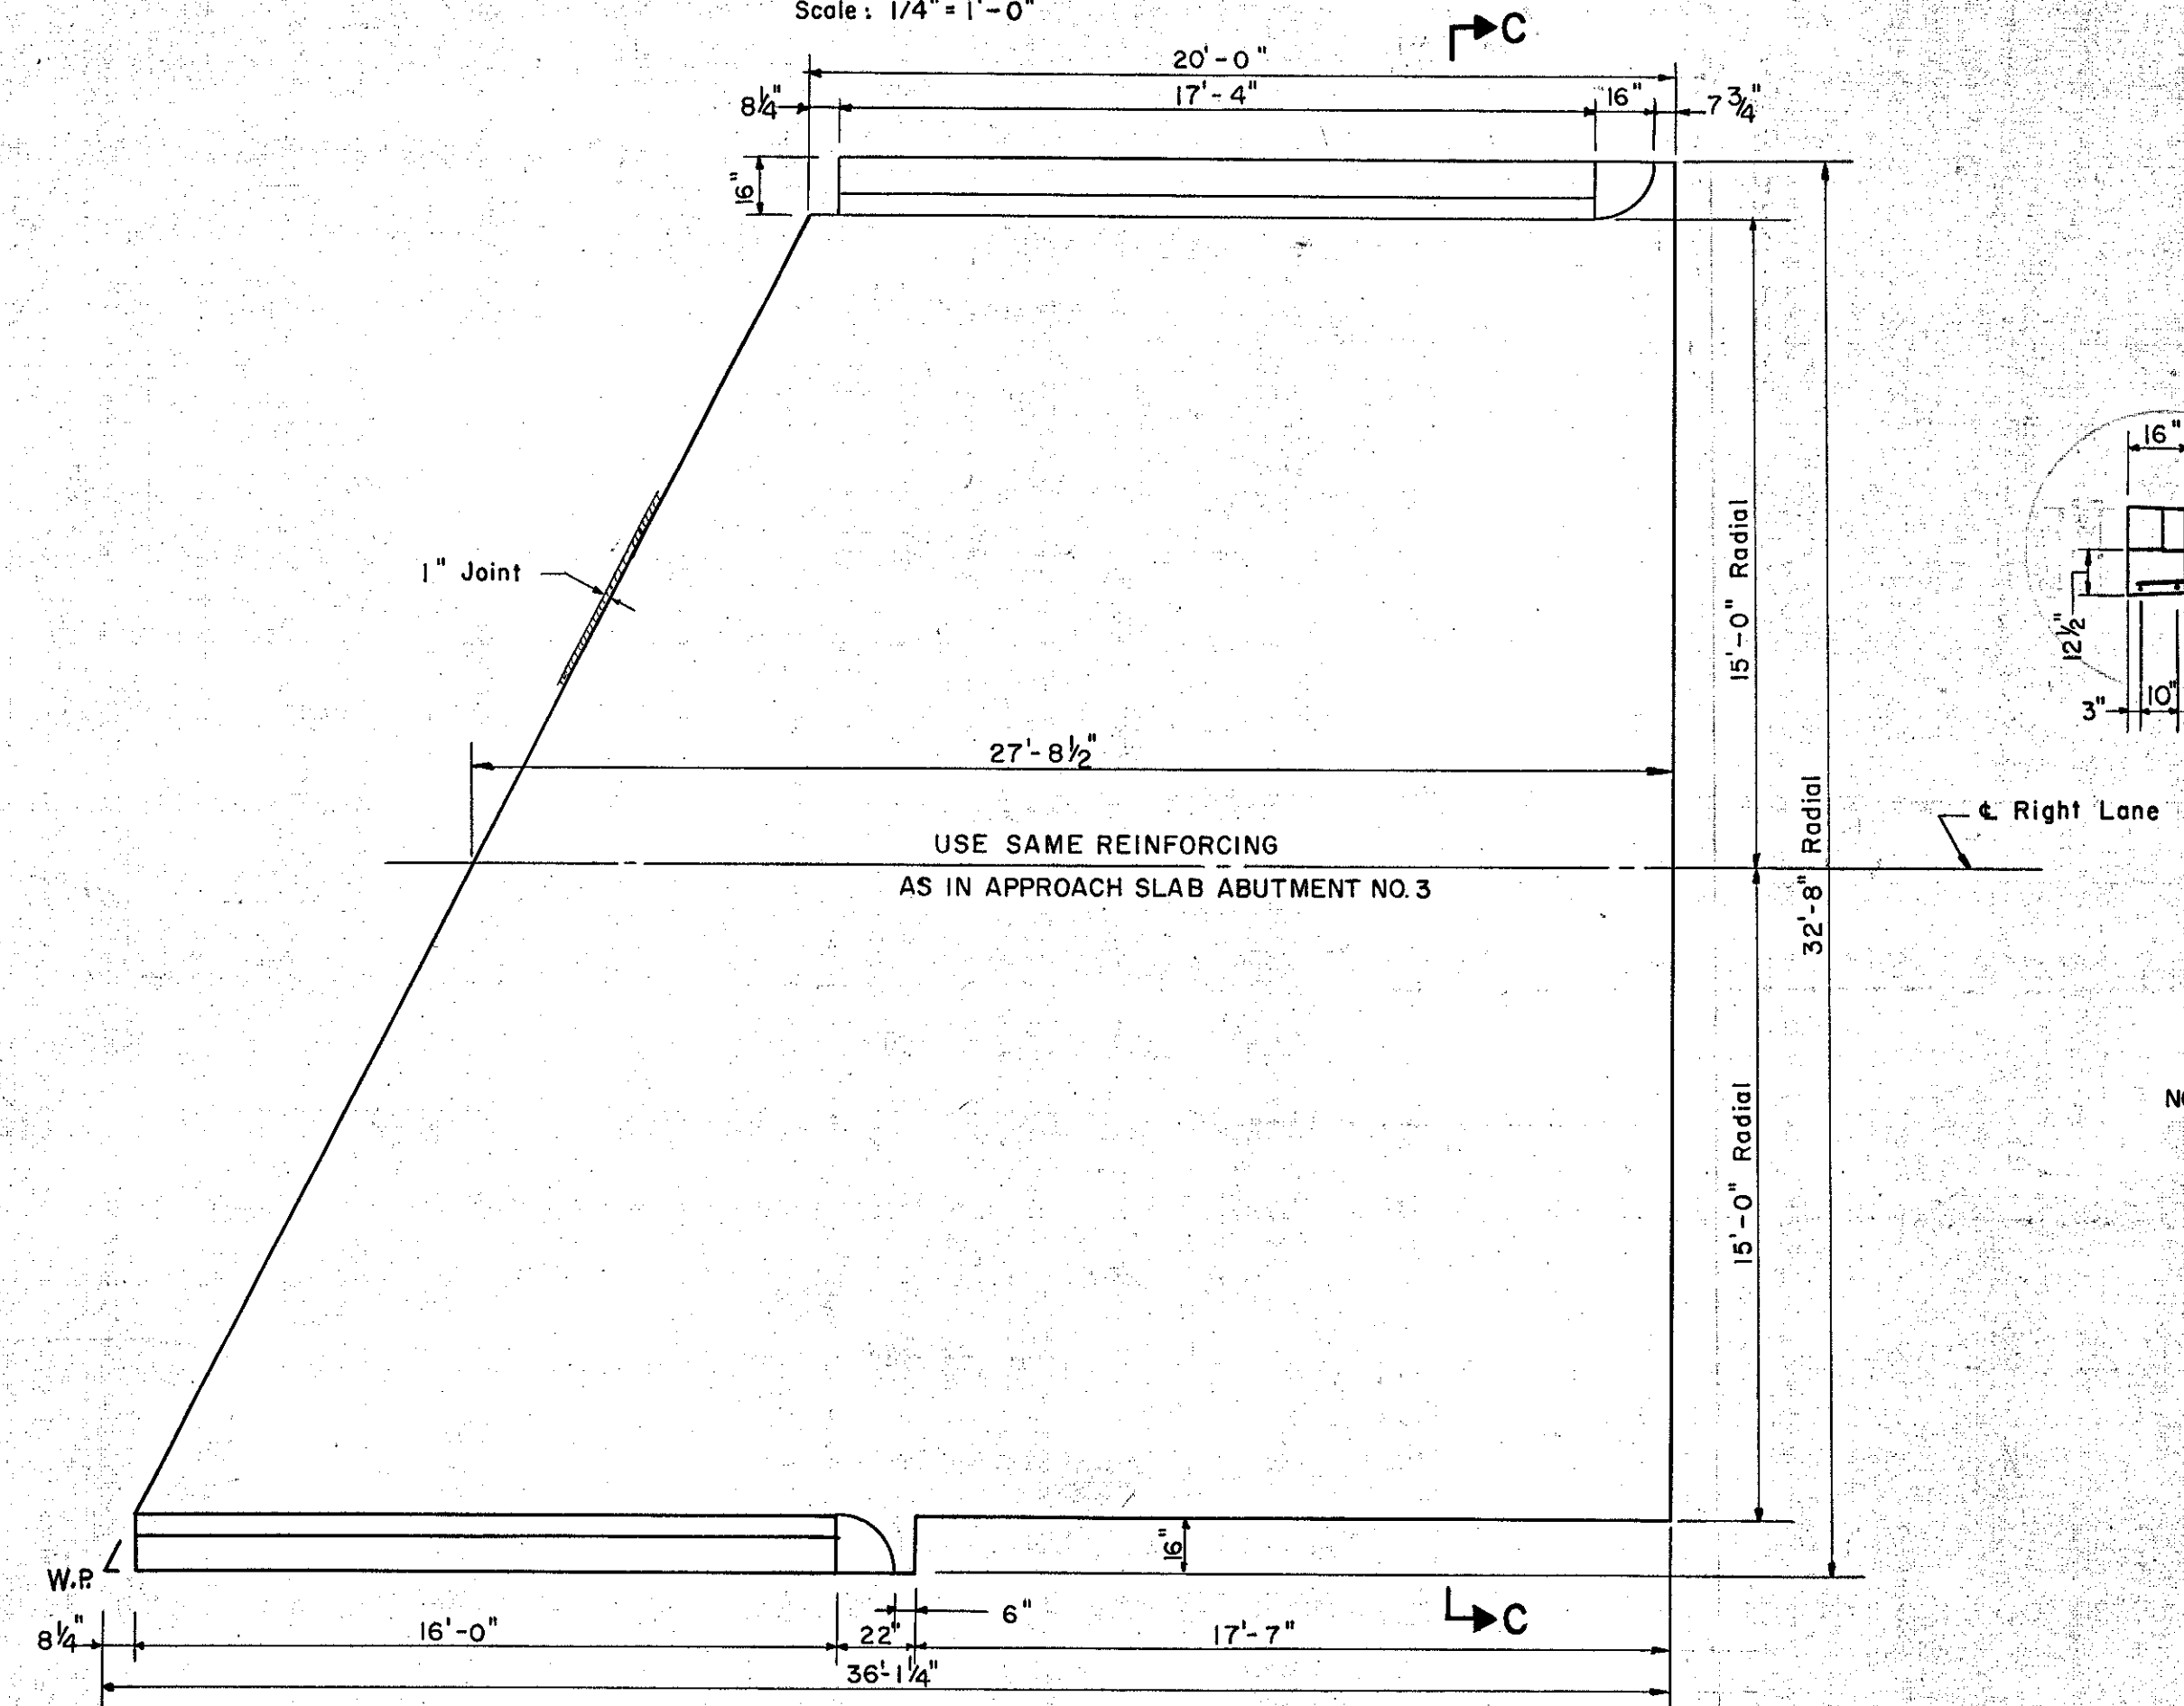

**APPROACH SLAB ABUTMENT NO. 4**  
Scale: 1/4" = 1'-0"

ITEM NO.	DESCRIPTION	UNIT	APPROACH SLABS			
			NET	OVERRUN	TOTAL	FINAL
361-B	Bit. Conc. Pavement	Ton	-41=	-6=	-47=	51 ✓
401-B	Concrete, Class 'B' (Mod.)	CY	137 ✓	-7=	-144=	137 ✓
402	Reinforcing Steel	LBS	See Reinforcing Steel Schedule			
556-C	Granite Bridge Curb (Type 1)	L.F.	See General Plan & Elevation Sheet No. 3			

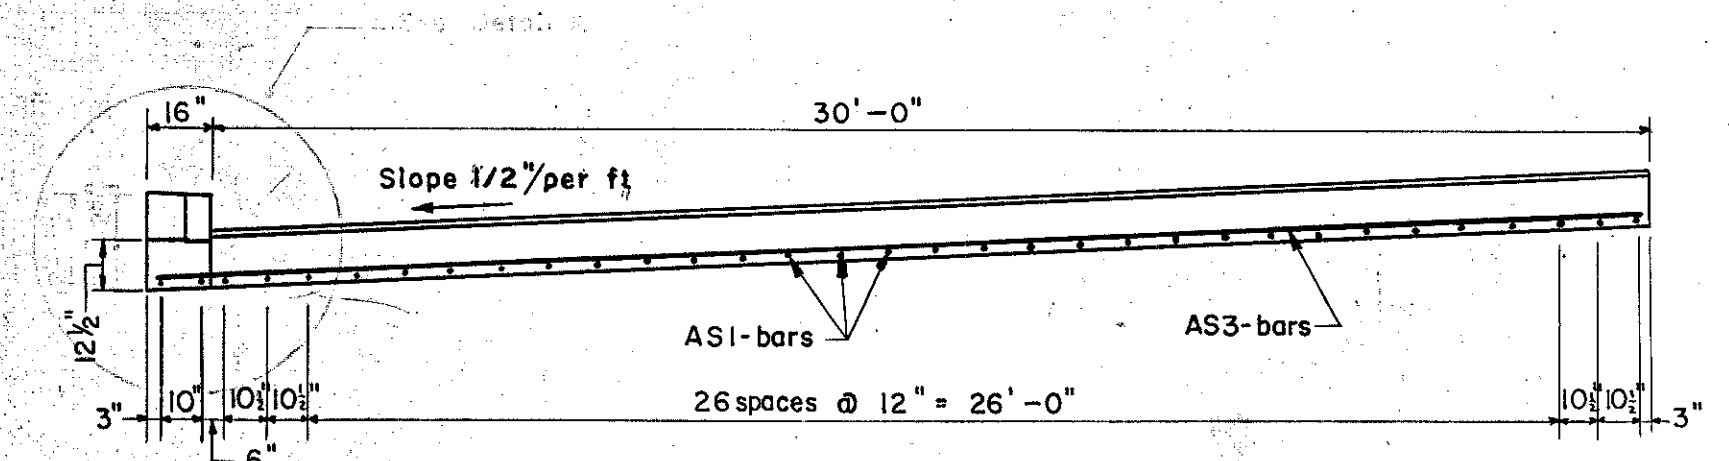

**SECTION C-C**  
Scale: 1/4" = 1'-0"


NOTE: For Sections A-A & B-B See Standard Detail Sheet SB-AS-30° Skew-57.

IM 089-2(26)  
This sheet for information only  
**BR 48 N & S**

CONTRACT NO. 1

**APPROACH SLABS**  
**STATE OF VERMONT**  
**DEPARTMENT OF HIGHWAYS**  
INTERSTATE PROJECT in the town of  
**WATERBURY**  
INTERSTATE OVER STA. 865+24  
**LITTLE RIVER** STA. 5+15  
THE CLARKESON ENGINEERING CO. INC.  
CONSULTING ENGINEERS  
BOSTON MASSACHUSETTS  
SURVEYED BY: [ ] CHECKED BY B.K. & J.B. SCALE AS SHOWN  
DRAWN BY J.K. IN CHARGE J.V.B. DATE 8-20-57  
PROJECT NO. 1-89-2(7) SHEET 230 OF 307

B. R. R. DIV. NO.	STATE	PROJECT NO.	SHEET NO.	TOTAL SHEETS
1	VT.	I-89-2(7)	8	13






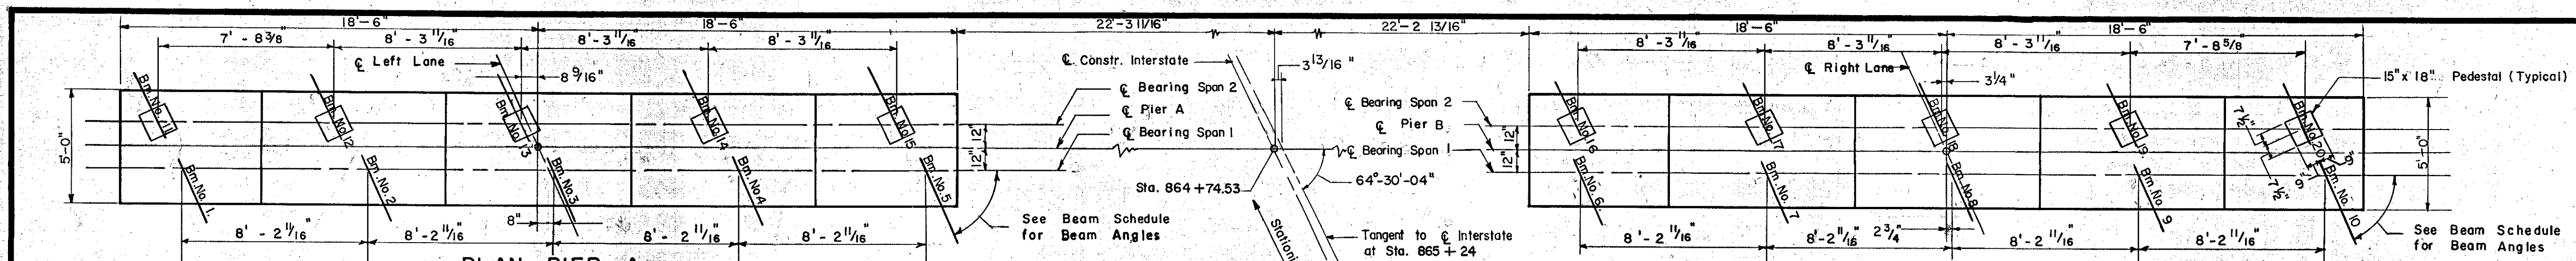


**BEAM SCHEDULE**

PIER A			
Beam No.	Beam Seat El.	Beam Angle	
1	445.24	65°-50'-04"	
2	445.53	65°-50'-04"	
3	445.82	65°-50'-04"	
4	446.11	65°-50'-04"	
5	446.41	65°-50'-04"	
11	445.38	64°-30'-04"	
12	445.66	64°-30'-04"	
13	445.95	64°-30'-04"	
14	446.24	64°-30'-04"	
15	446.54	64°-30'-04"	

PIER B			
Beam No.	Beam Seat El.	Beam Angle	
6	448.05	65°-50'-04"	
7	445.34	65°-50'-04"	
8	445.64	65°-50'-04"	
9	445.93	65°-50'-04"	
10	446.22	65°-50'-04"	
16	445.18	64°-30'-04"	
17	445.48	64°-30'-04"	
18	445.77	64°-30'-04"	
19	446.06	64°-30'-04"	
20	446.35	65°-10'-03"	

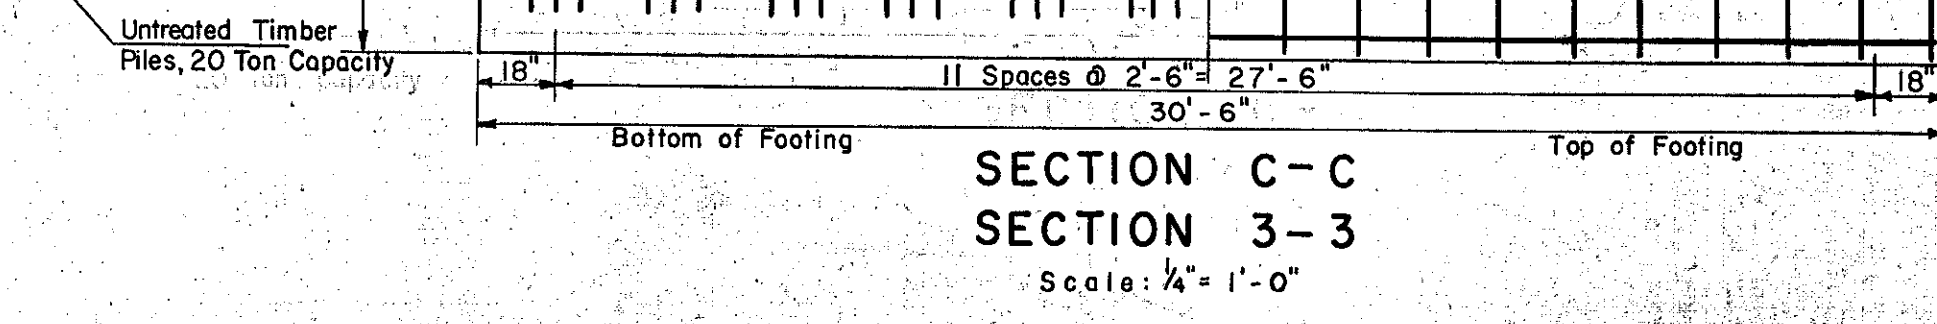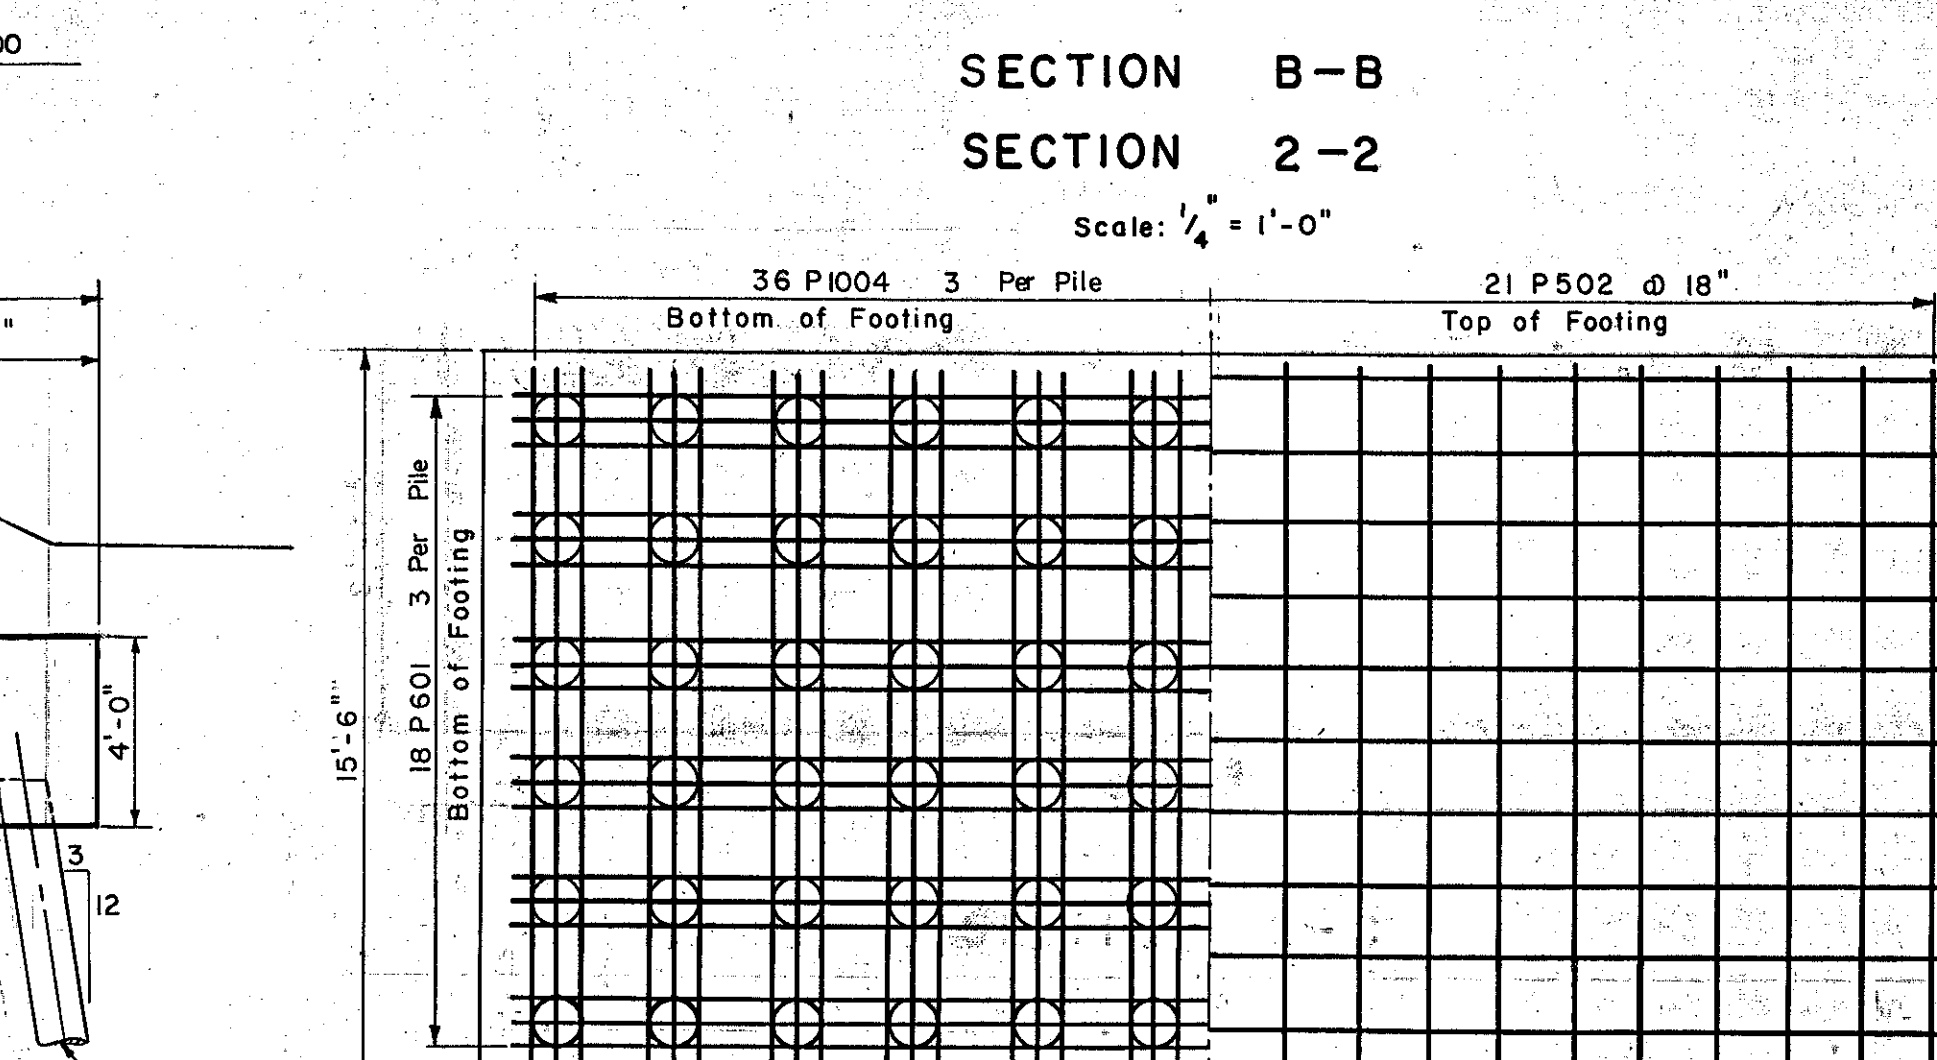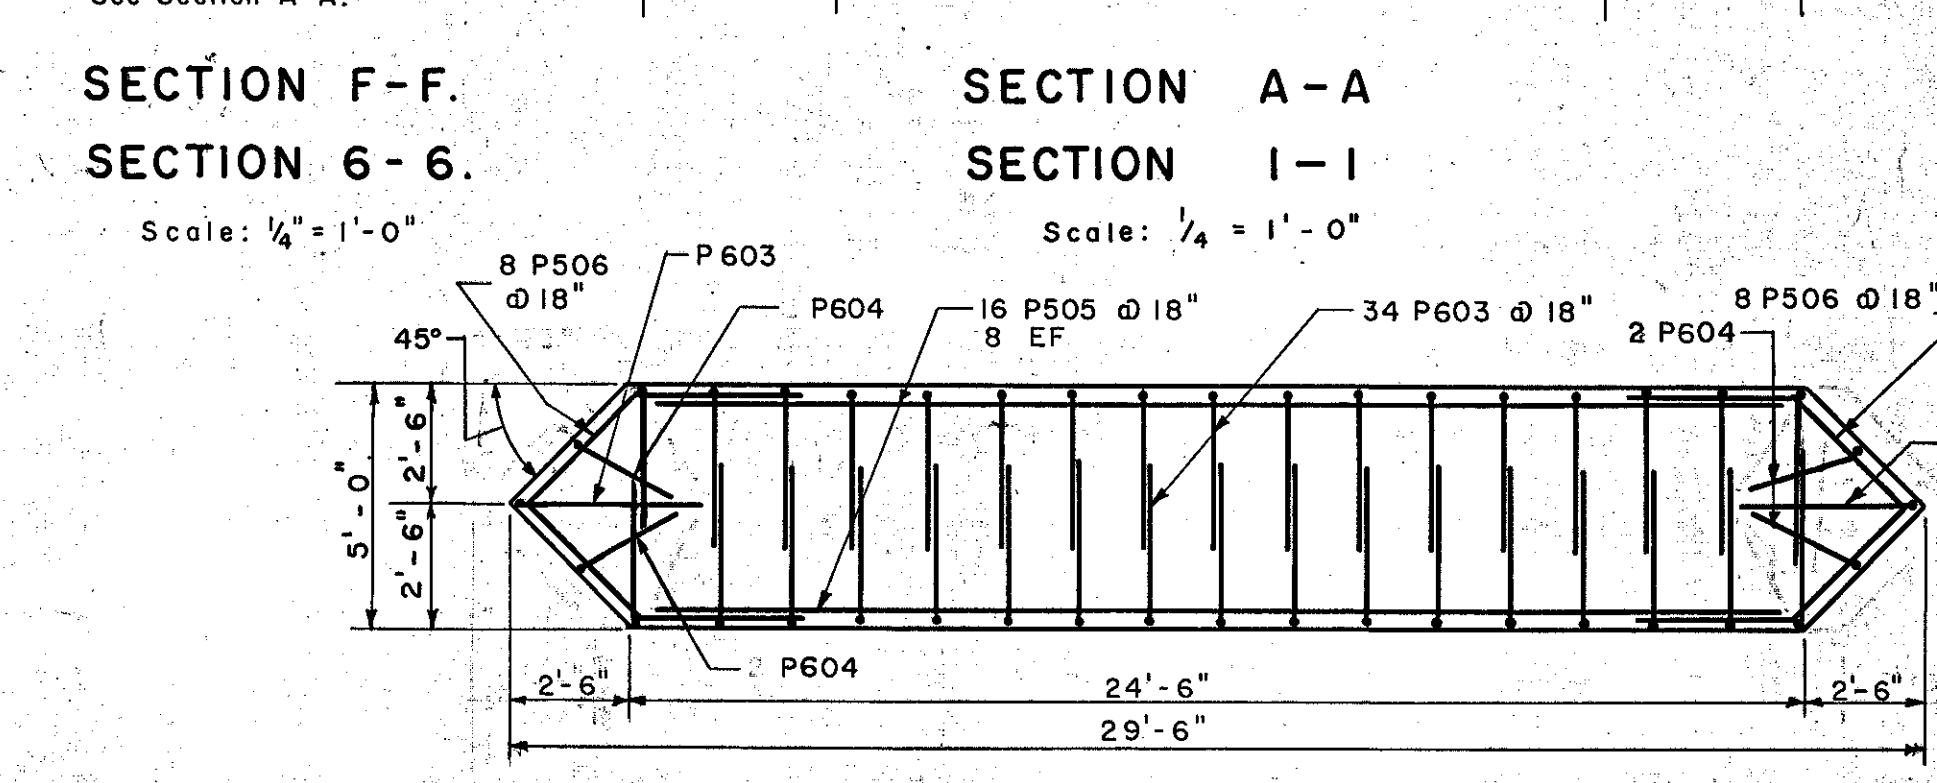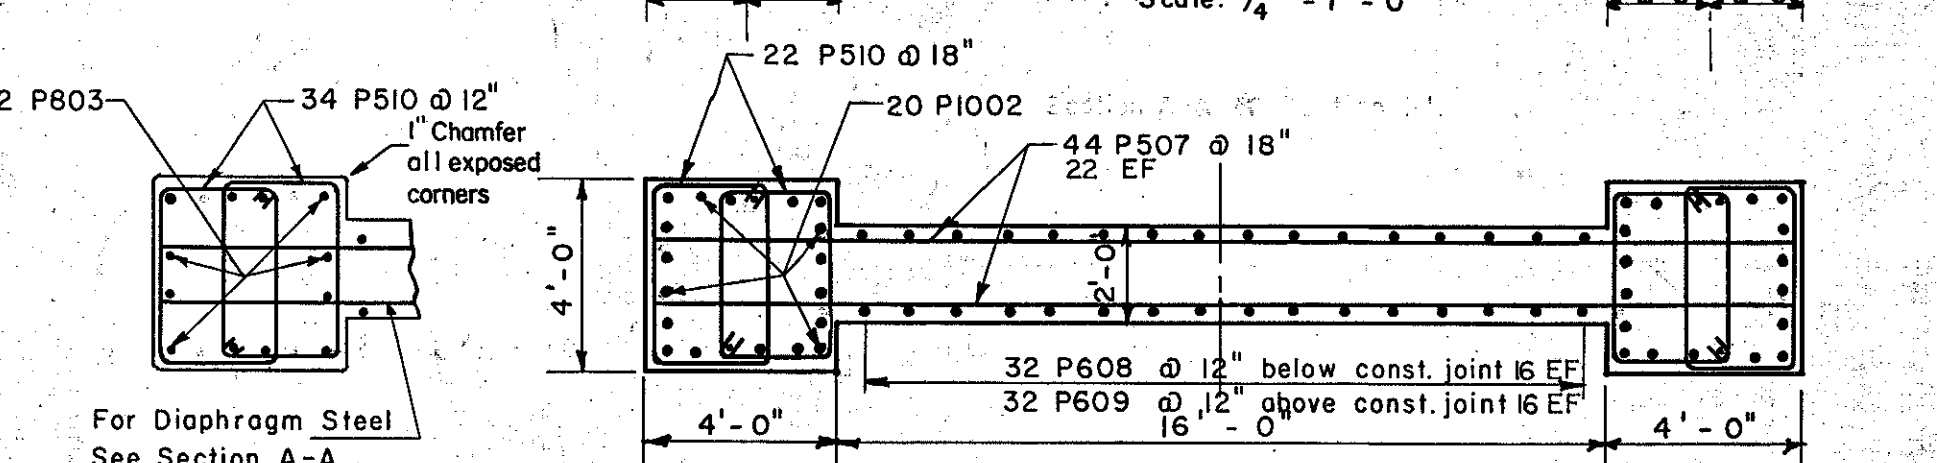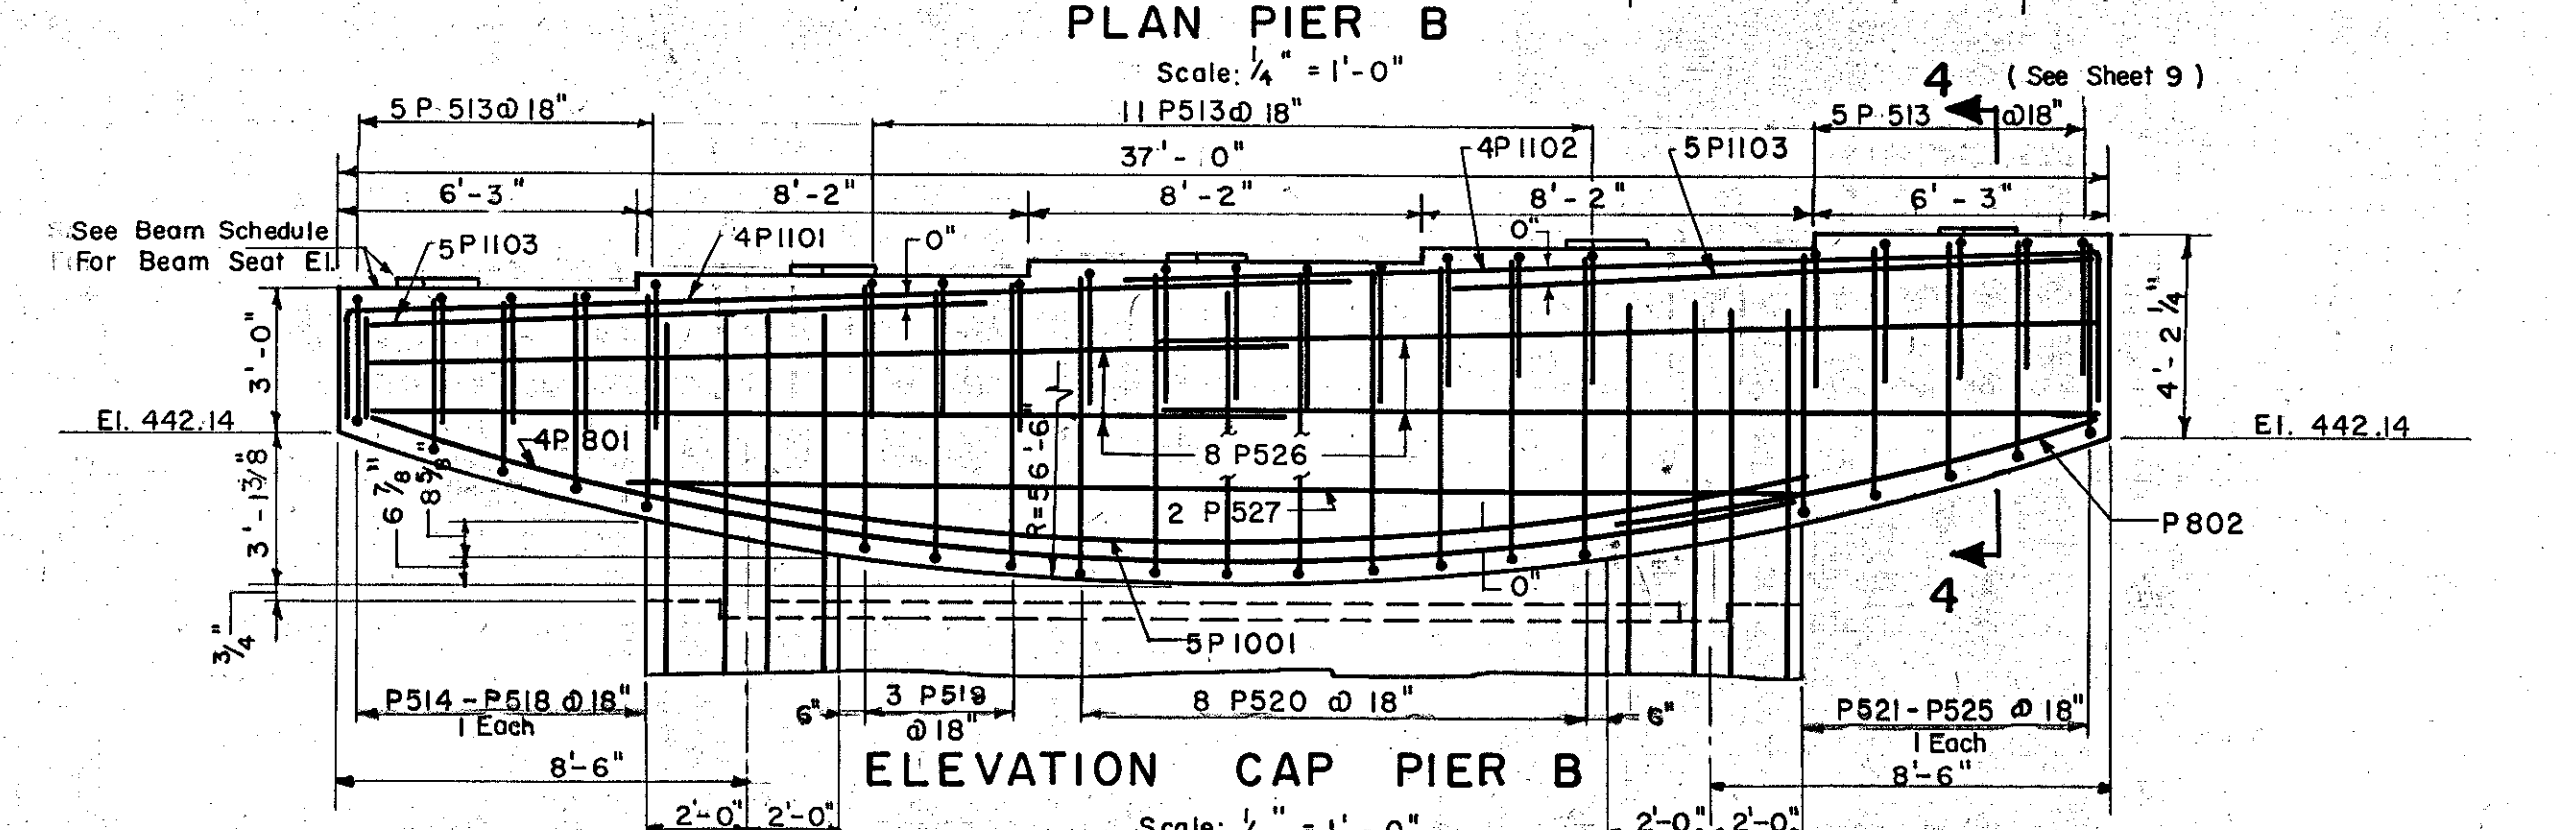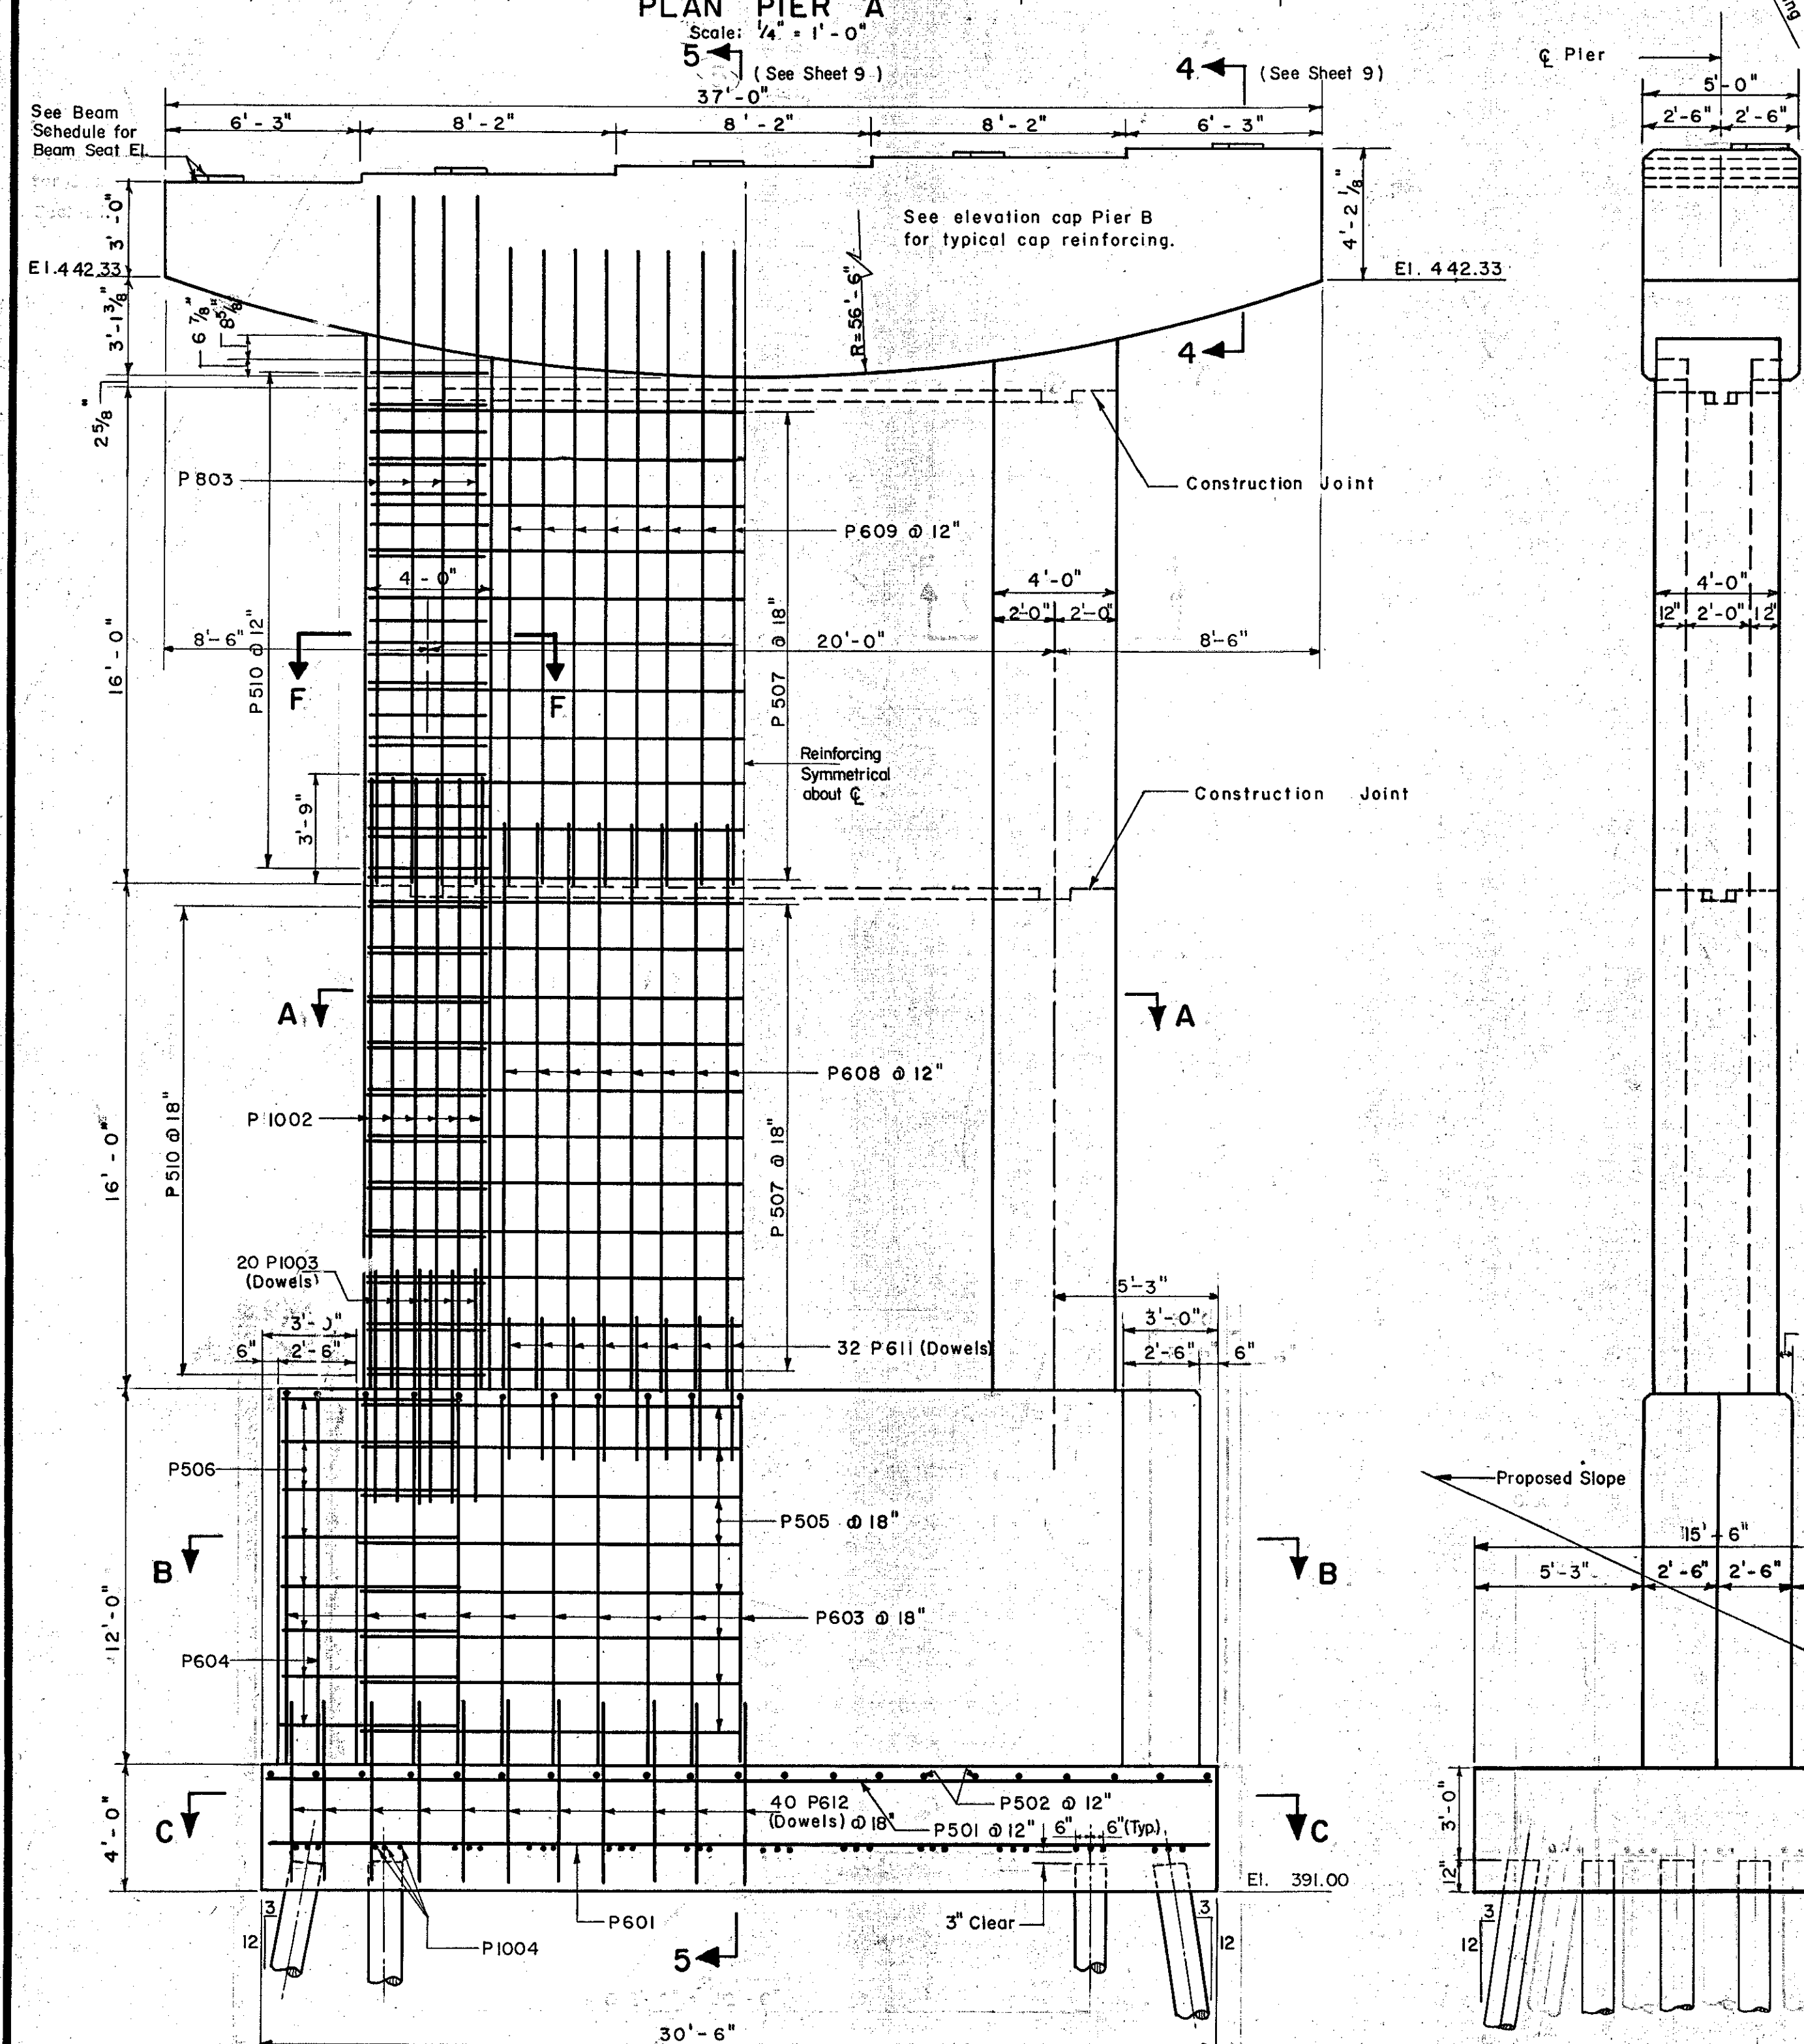

**ESTIMATED QUANTITIES**

ITEM NO.	DESCRIPTION	UNIT	PIER A			
			NET	OVER-RUN	TOTAL	FINAL
107	Structure Excavation	CY	+34	+3	+47	63
401-B	Concrete Class B (Mod.)	CY	247	+2	+259	247
402	Reinforcing Steel	LBS	See Reinforcing Steel Schedule			
407	Asphaltic - Asbestos Coating	SY	+21	-	+21	20
502-A	Untreated Timber Piling	LF	+2520	-	+2520	2219

ITEM NO.	DESCRIPTION	UNIT	PIER B			
			NET	OVER-RUN	TOTAL	FINAL
107	Structure Excavation	CY	+34	+3	+47	65
401-B	Concrete Class B (Mod.)	CY	+247	+2	+259	246
402	Reinforcing Steel	LBS	See Reinforcing Steel Schedule			
407	Asphaltic - Asbestos Coating	SY	20	-	20	20
502-A	Untreated Timber Piling	LF	+2520	-	+2520	2328


IM 089-2(26)  
This sheet for information only  
**BR 48 N & S**

CONTRACT NO. 1

**PIERS A AND B**  
STATE OF VERMONT  
DEPARTMENT OF HIGHWAYS  
INTERSTATE PROJECT in the town of  
**WATERBURY**  
INTERSTATE OVER STA. 865+24  
LITTLE RIVER OVER STA. 5+15  
THE CLARKSON ENGINEERING CO. INC.  
CONSULTING ENGINEERS  
BOSTON MASSACHUSETTS  
SURVEYED BY: [ ] CHECKED BY: [ ] SCALE: AS NOTED  
DRAWN BY: [ ] IN CHARGE: [ ] DATE: 8-20-57  
PROJECT NO. I-89-2(7) SHEET 231 OF 307

Note: See Sheet No. 9 for Pier A Plan B Numbered sections  
All reinforcing cover to be 2" except as otherwise noted.

B. P. R. DIV. NO.	STATE	PROJECT NO.	SHEET NO.	TOTAL SHEETS
1	VT.	I-89-2 (7)	27	37

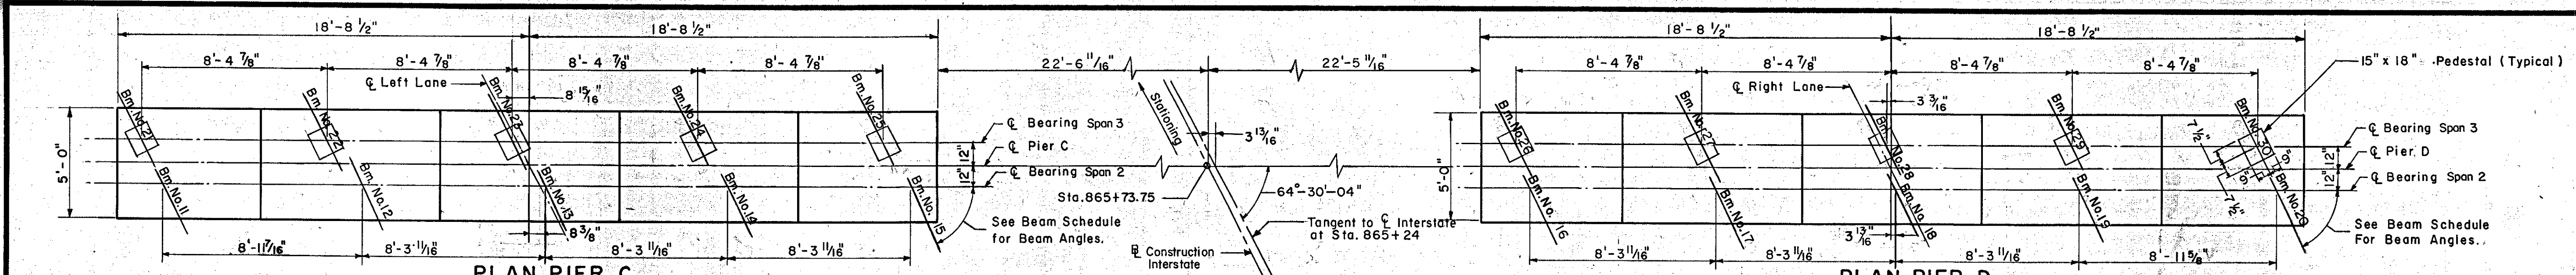


**BEAM SCHEDULE**


PIER C		
Beam No.	Beam Seat Elev.	Beam Angle
11	445.73	63° 50' - 03"
12	446.03	64° 30' - 04"
13	446.33	64° 30' - 04"
14	446.62	64° 30' - 04"
15	446.91	64° 30' - 04"
21	445.87	63° 10' - 04"
22	446.16	63° 10' - 04"
23	446.46	63° 10' - 04"
24	446.75	63° 10' - 04"
25	447.04	63° 10' - 04"


PIER D		
Beam No.	Beam Seat Elev.	Beam Angle
16	445.55	64° 30' - 04"
17	445.85	64° 30' - 04"
18	446.14	64° 30' - 04"
19	446.43	64° 30' - 04"
20	446.72	65° 10' - 03"
26	445.69	63° 10' - 04"
27	445.98	63° 10' - 04"
28	446.27	63° 10' - 04"
29	446.56	63° 10' - 04"
30	446.85	63° 10' - 04"

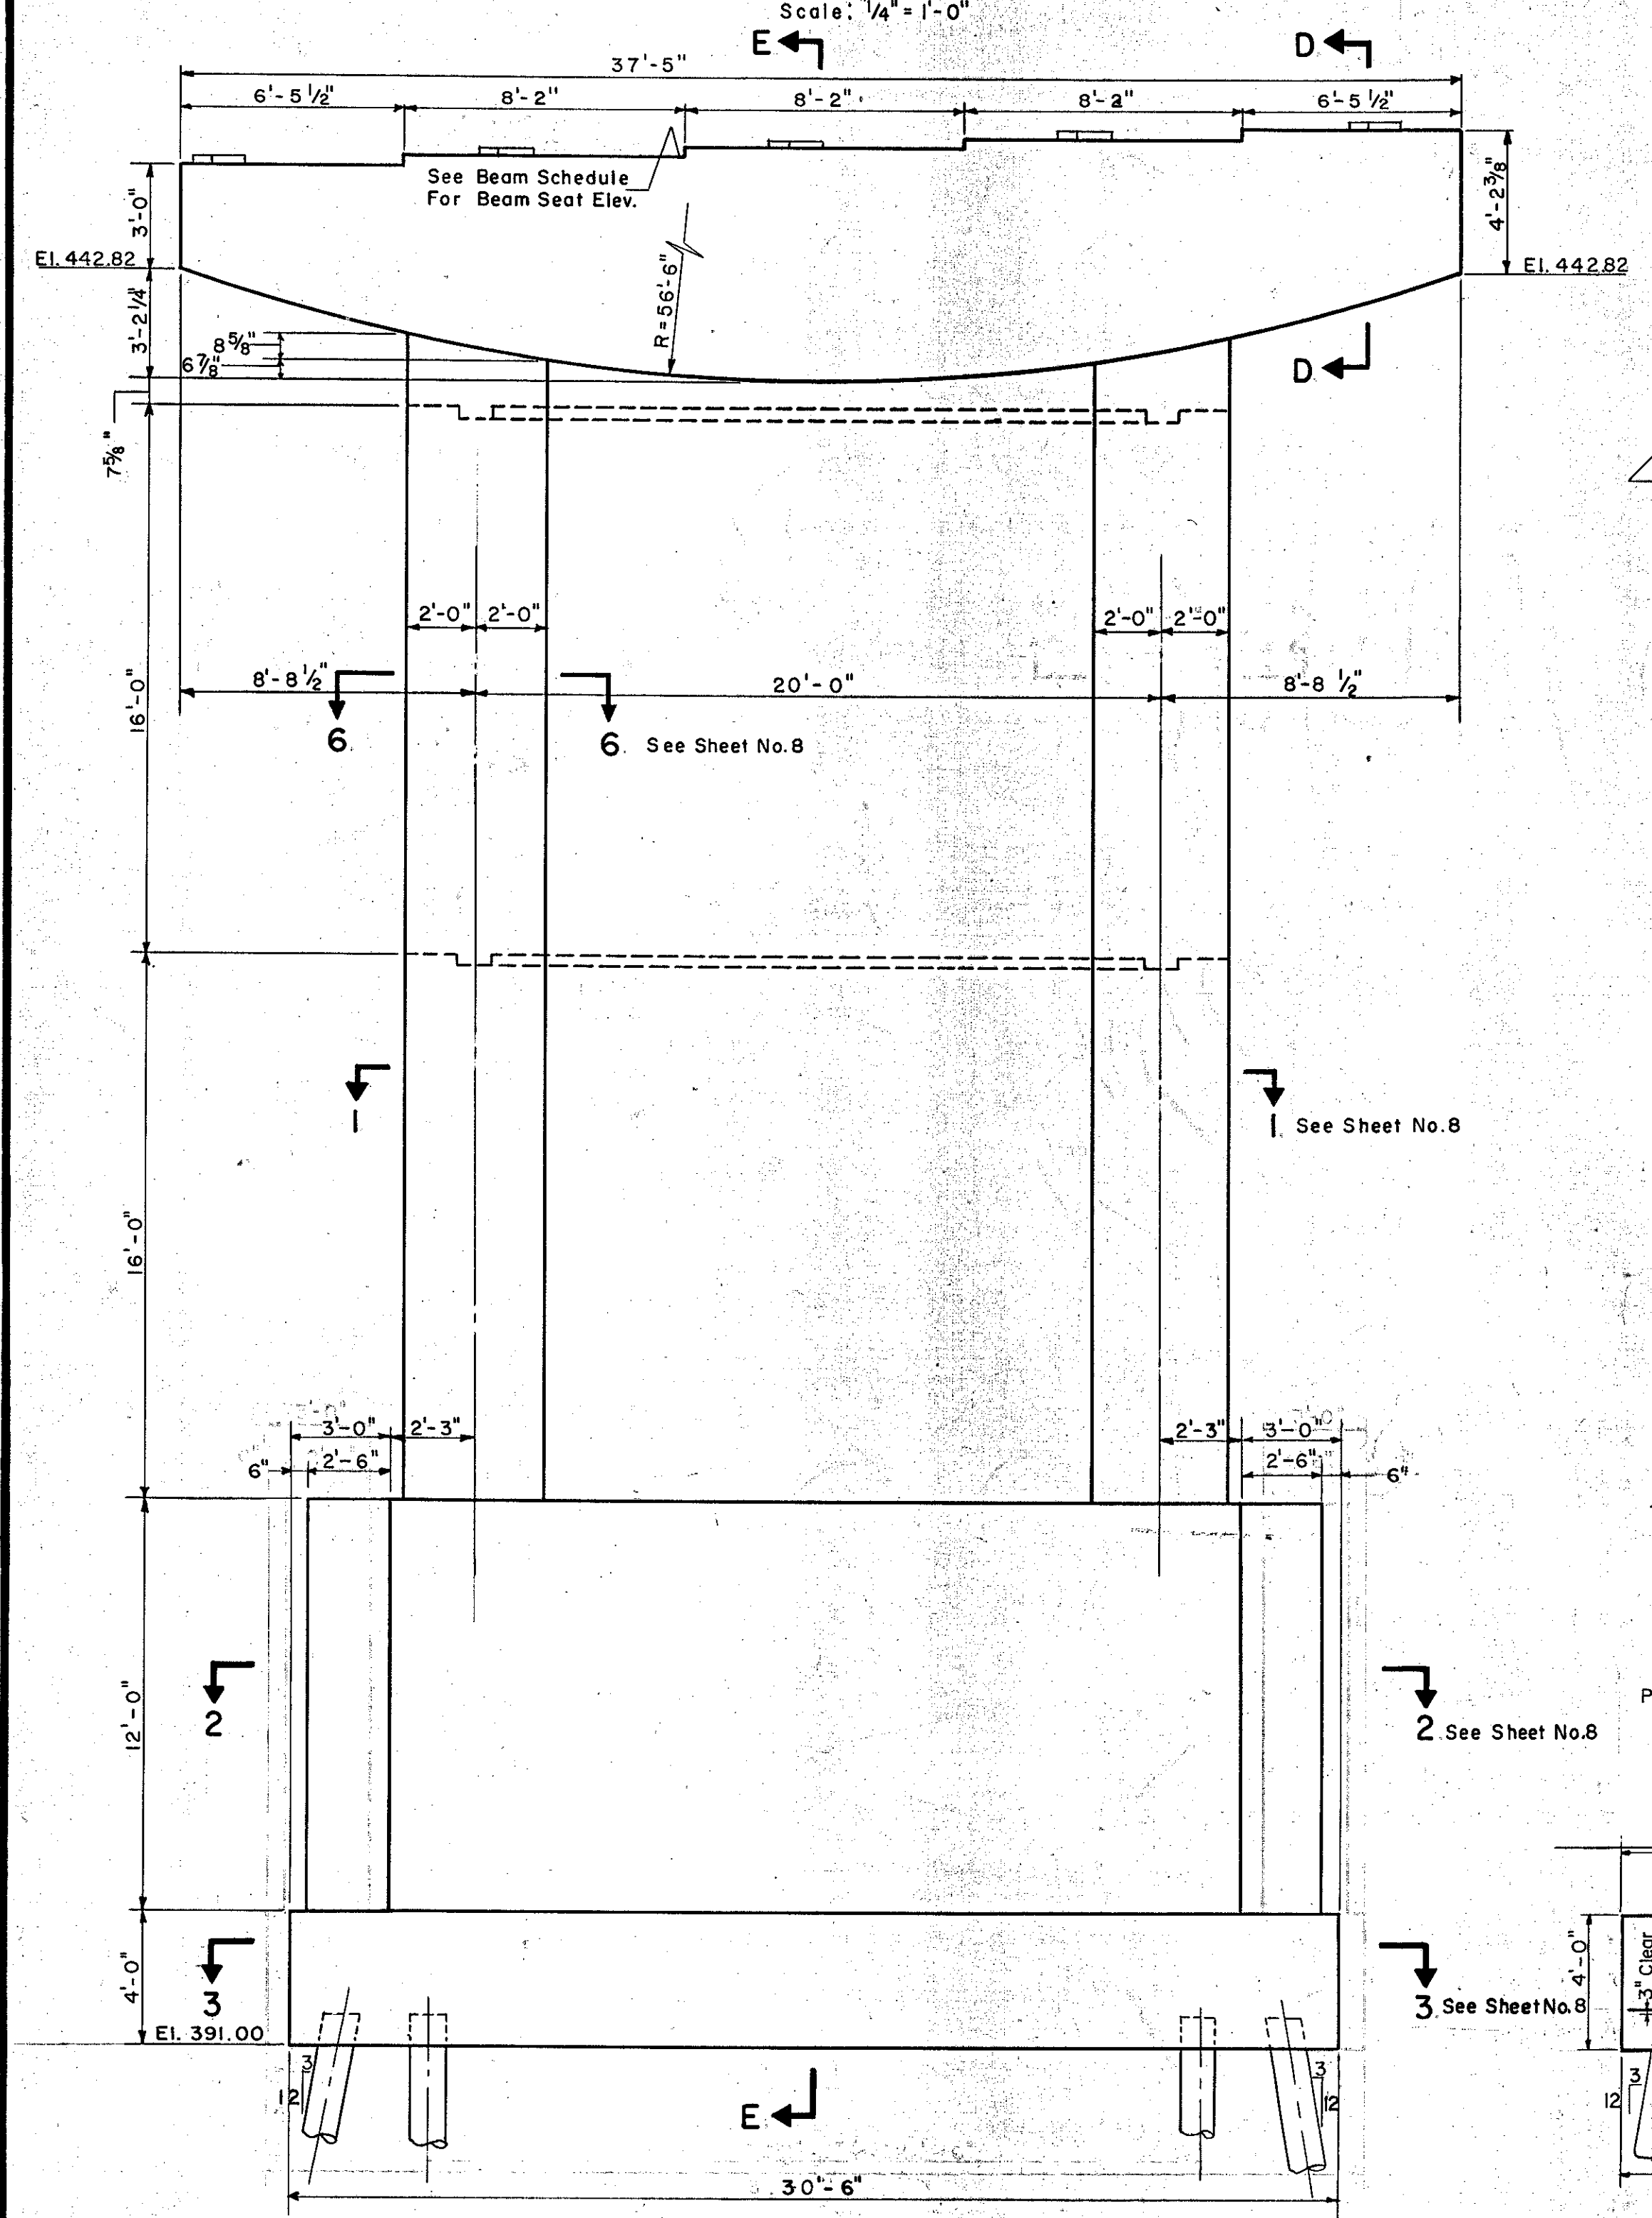


**ELEVATION PIER C**  
Scale: 1/4" = 1'-0"

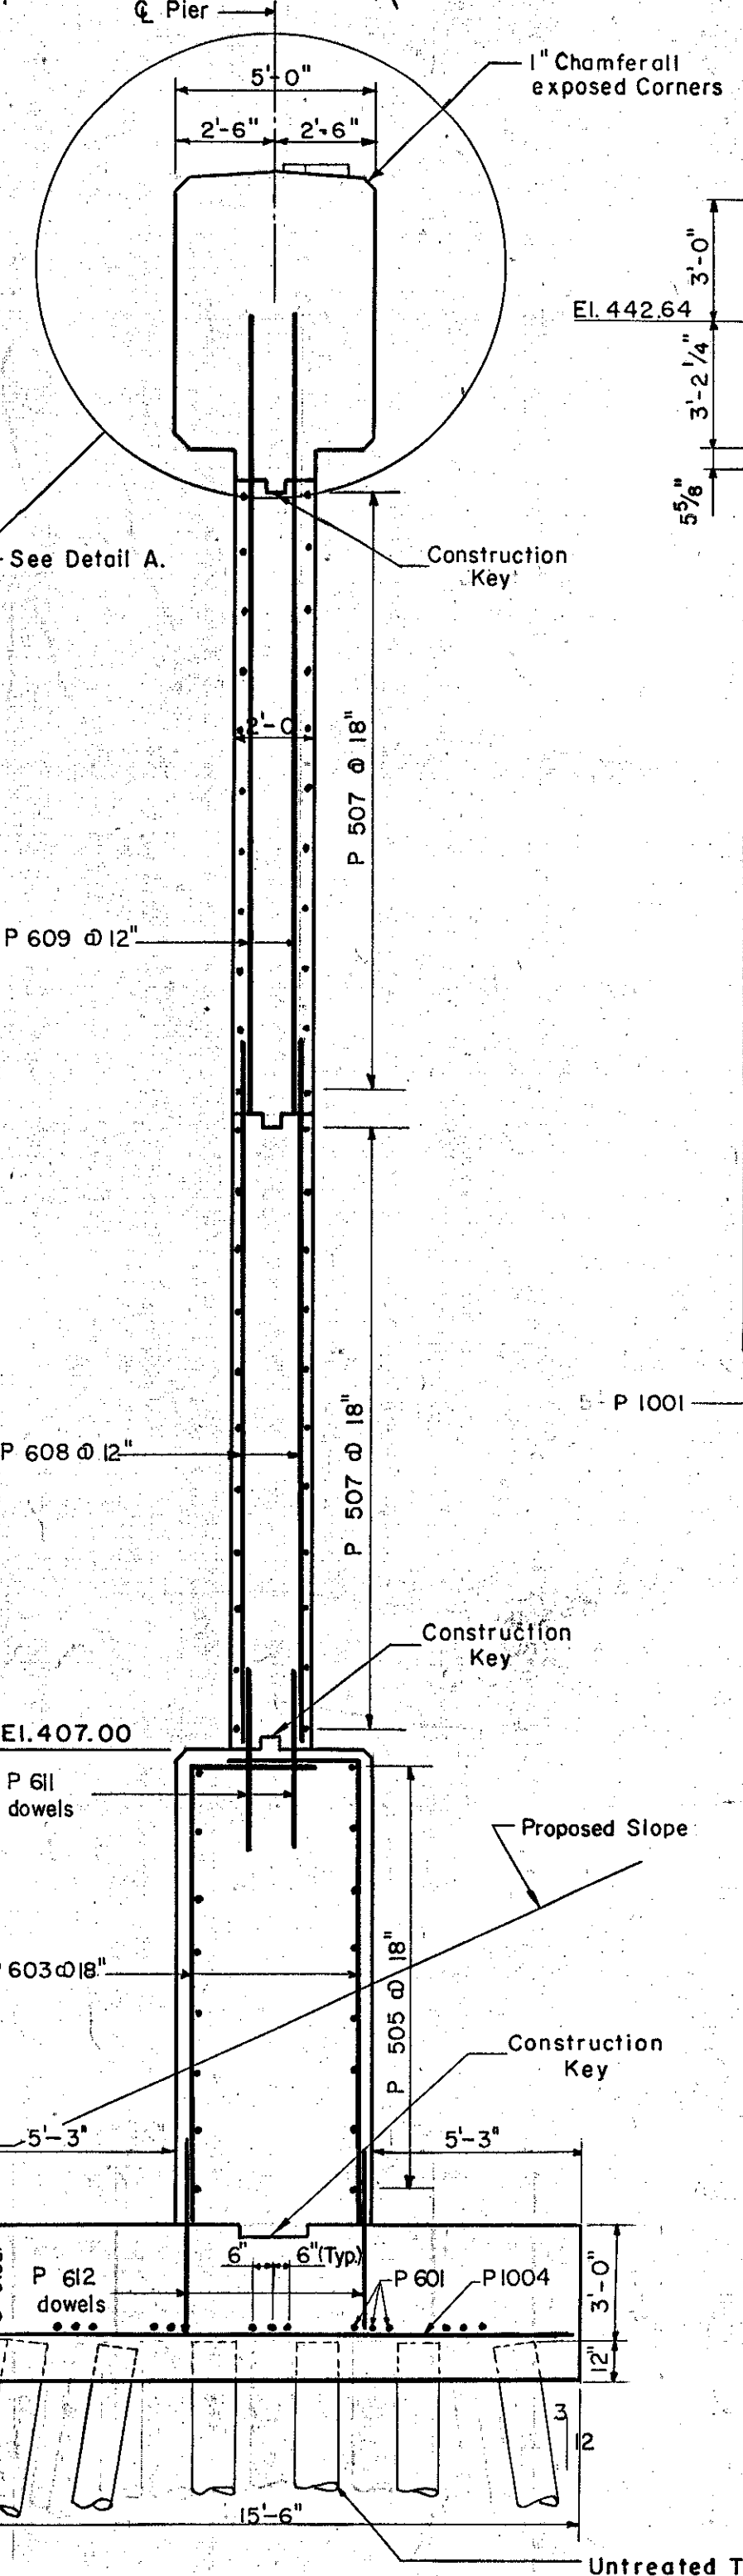


**TYPICAL SECTION E-E**  
Scale: 1/4" = 1'-0"

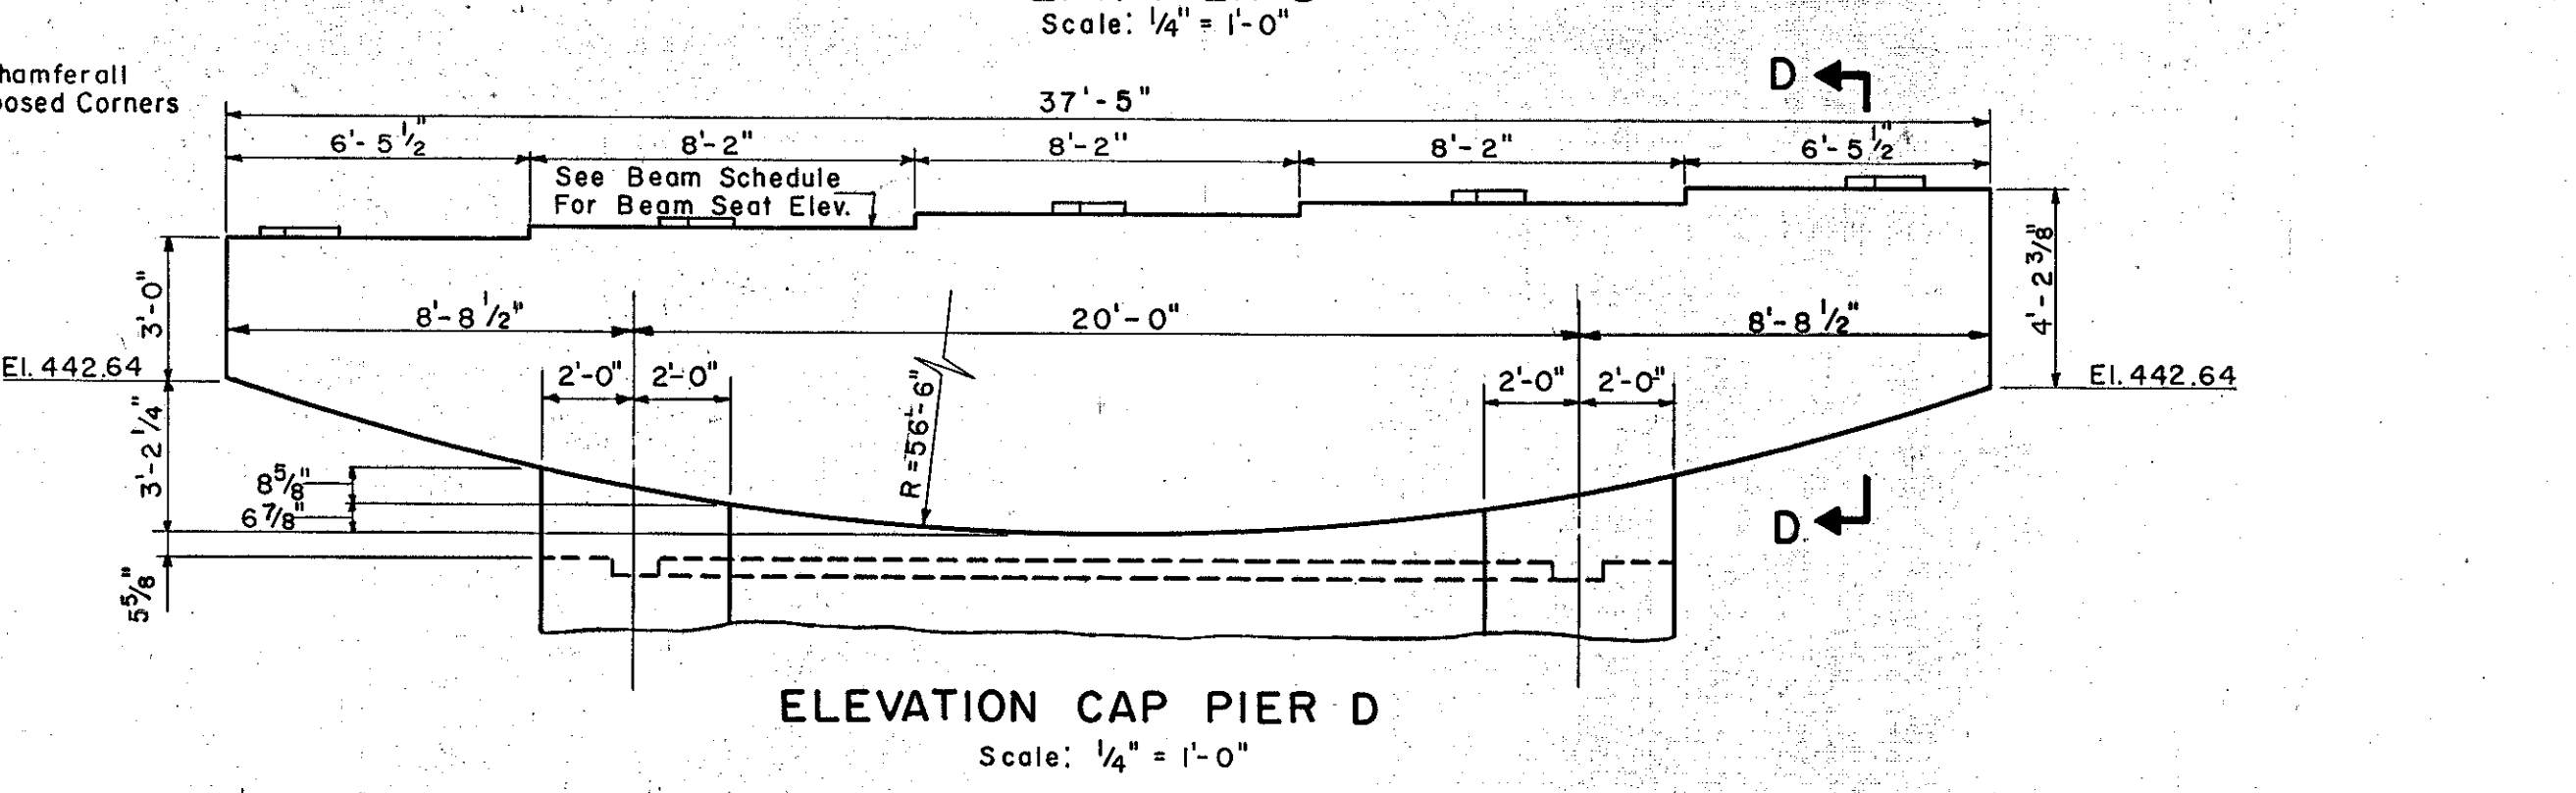

**ELEVATION CAP PIER D**  
Scale: 1/4" = 1'-0"

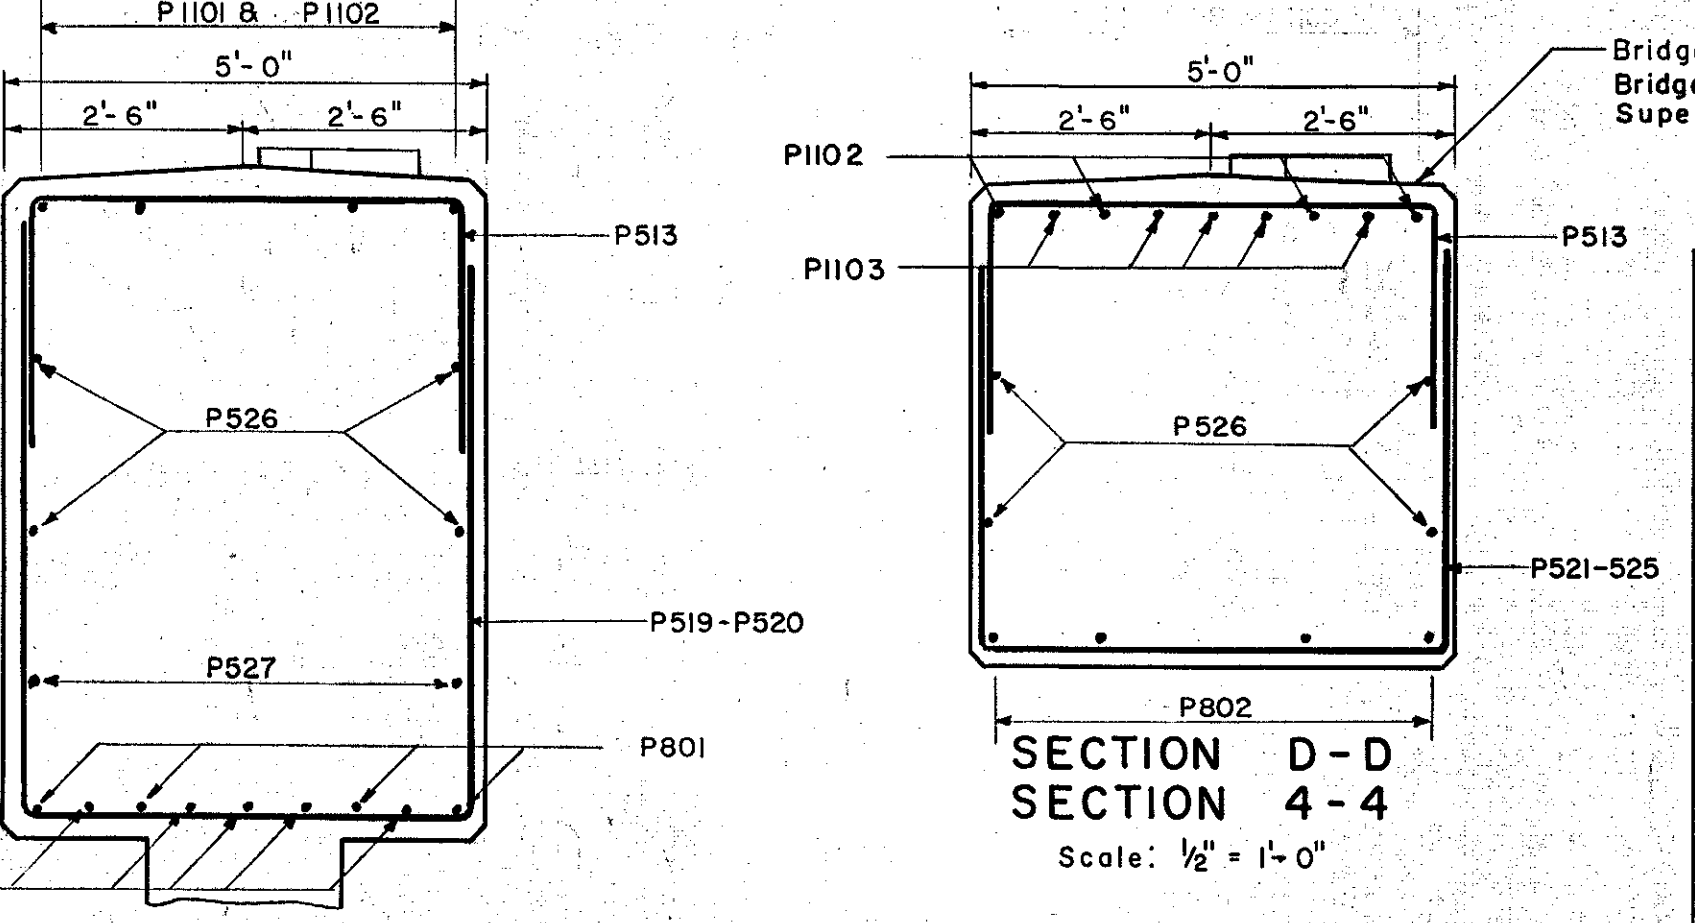

**DETAIL A**  
Scale: 1/2" = 1'-0"

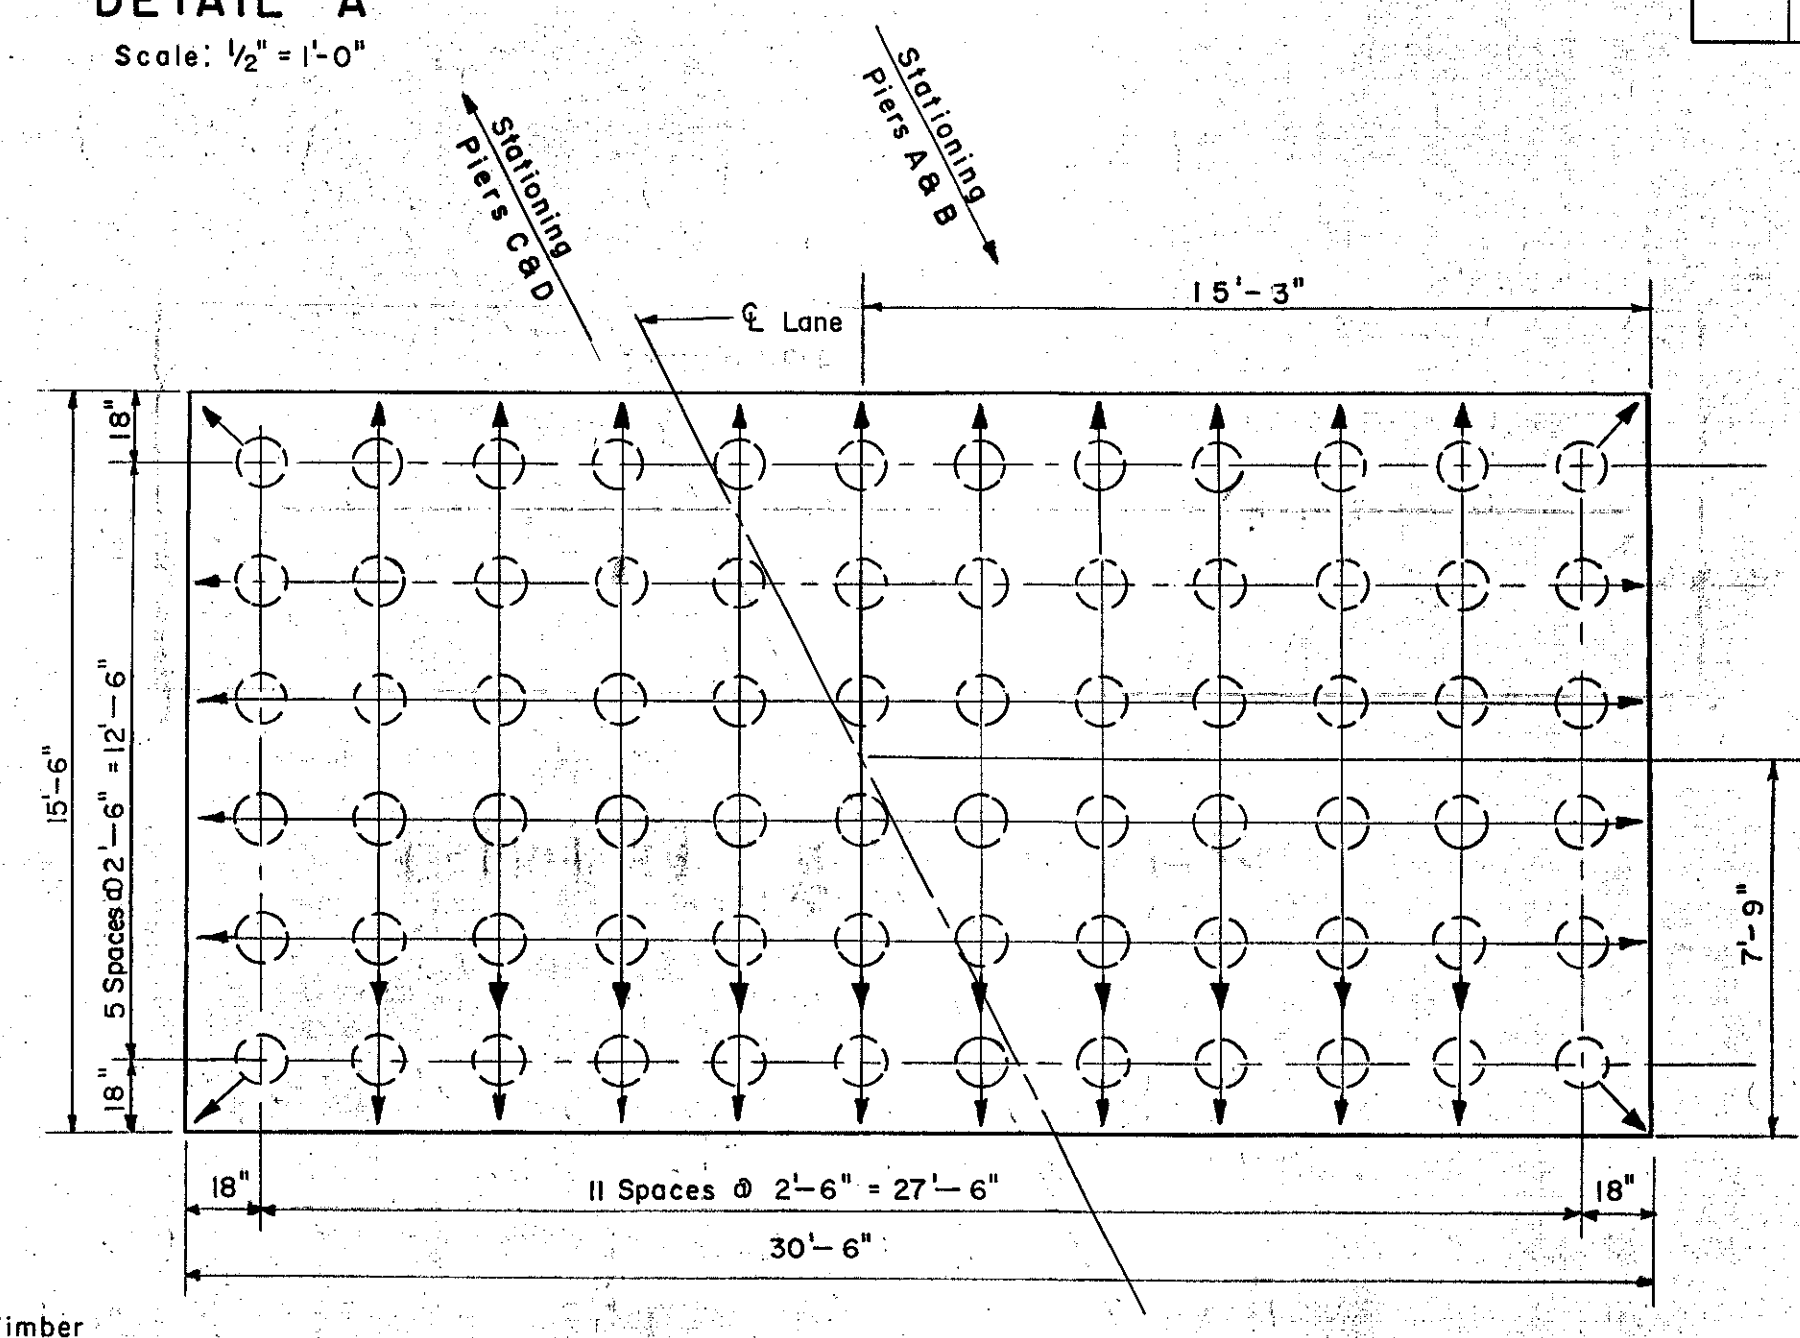

**TYPICAL PILE PLAN FOR PIERS**  
Scale: 1/4" = 1'-0"

Note: For estimating purposes, the length of Untreated Timber Piles is assumed to be 35'.  
Battered indicated thus, Vertical ○ Battered ○ 20 T Design Load

ITEM NO.	DESCRIPTION	UNIT	PIER C			
			NET	OVER-RUN	TOTAL	FINAL
107	Structure Excavation	C.Y.	+134	+13	+147	60
401-B	Concrete, Class B (Mod.)	C.Y.	+249	+2	+261	252
402	Reinforcing Steel	LBS.	See Reinforcing Steel Schedule			
407	Asphaltic-Asbestos Coating	S.Y.	+21	-	+21	20
502A	Untreated Timber Piling	L.F.	+2520	-	+2520	2531
222	Gravel Backfill	C.Y.	0	-	0	11

ITEM NO.	DESCRIPTION	UNIT	PIER D			
			NET	OVER-RUN	TOTAL	FINAL
107	Structure Excavation	C.Y.	+134	+13	+147	63
401-B	Concrete, Class B (Mod.)	C.Y.	248	+12	+260	249
402	Reinforcing Steel	LBS.	See Reinforcing Steel Schedule			
407	Asphaltic-Asbestos Coating	S.Y.	+21	-	+21	20
502A	Untreated Timber Piling	L.F.	+2520	-	+2520	2611

IM 089-2(26)  
This sheet for information only  
**BR 48 N & S**

CONTRACT NO. 1

**PIERS C AND D**

STATE OF VERMONT  
DEPARTMENT OF HIGHWAYS

INTERSTATE PROJECT in the town of  
**WATERBURY**


INTERSTATE OVER STA. 865 + 24  
LITTLE RIVER OVER STA. 5 + 15

THE CLARKSON ENGINEERING CO. INC.  
CONSULTING ENGINEERS  
BOSTON MASSACHUSETTS

SURVEYED BY: CHECKED BY: B.K.B.J.B. SCALE: AS SHOWN  
DRAWN BY: R.E.M./J.R.W. DATE: 8-20-57

PROJECT NO. I-89-2(7) SHEET 232 OF 307


B. P. R. DIV. NO.	STATE	PROJECT NO.	SHEET NO.	TOTAL SHEETS
1	VT.	I-89-2(7)		

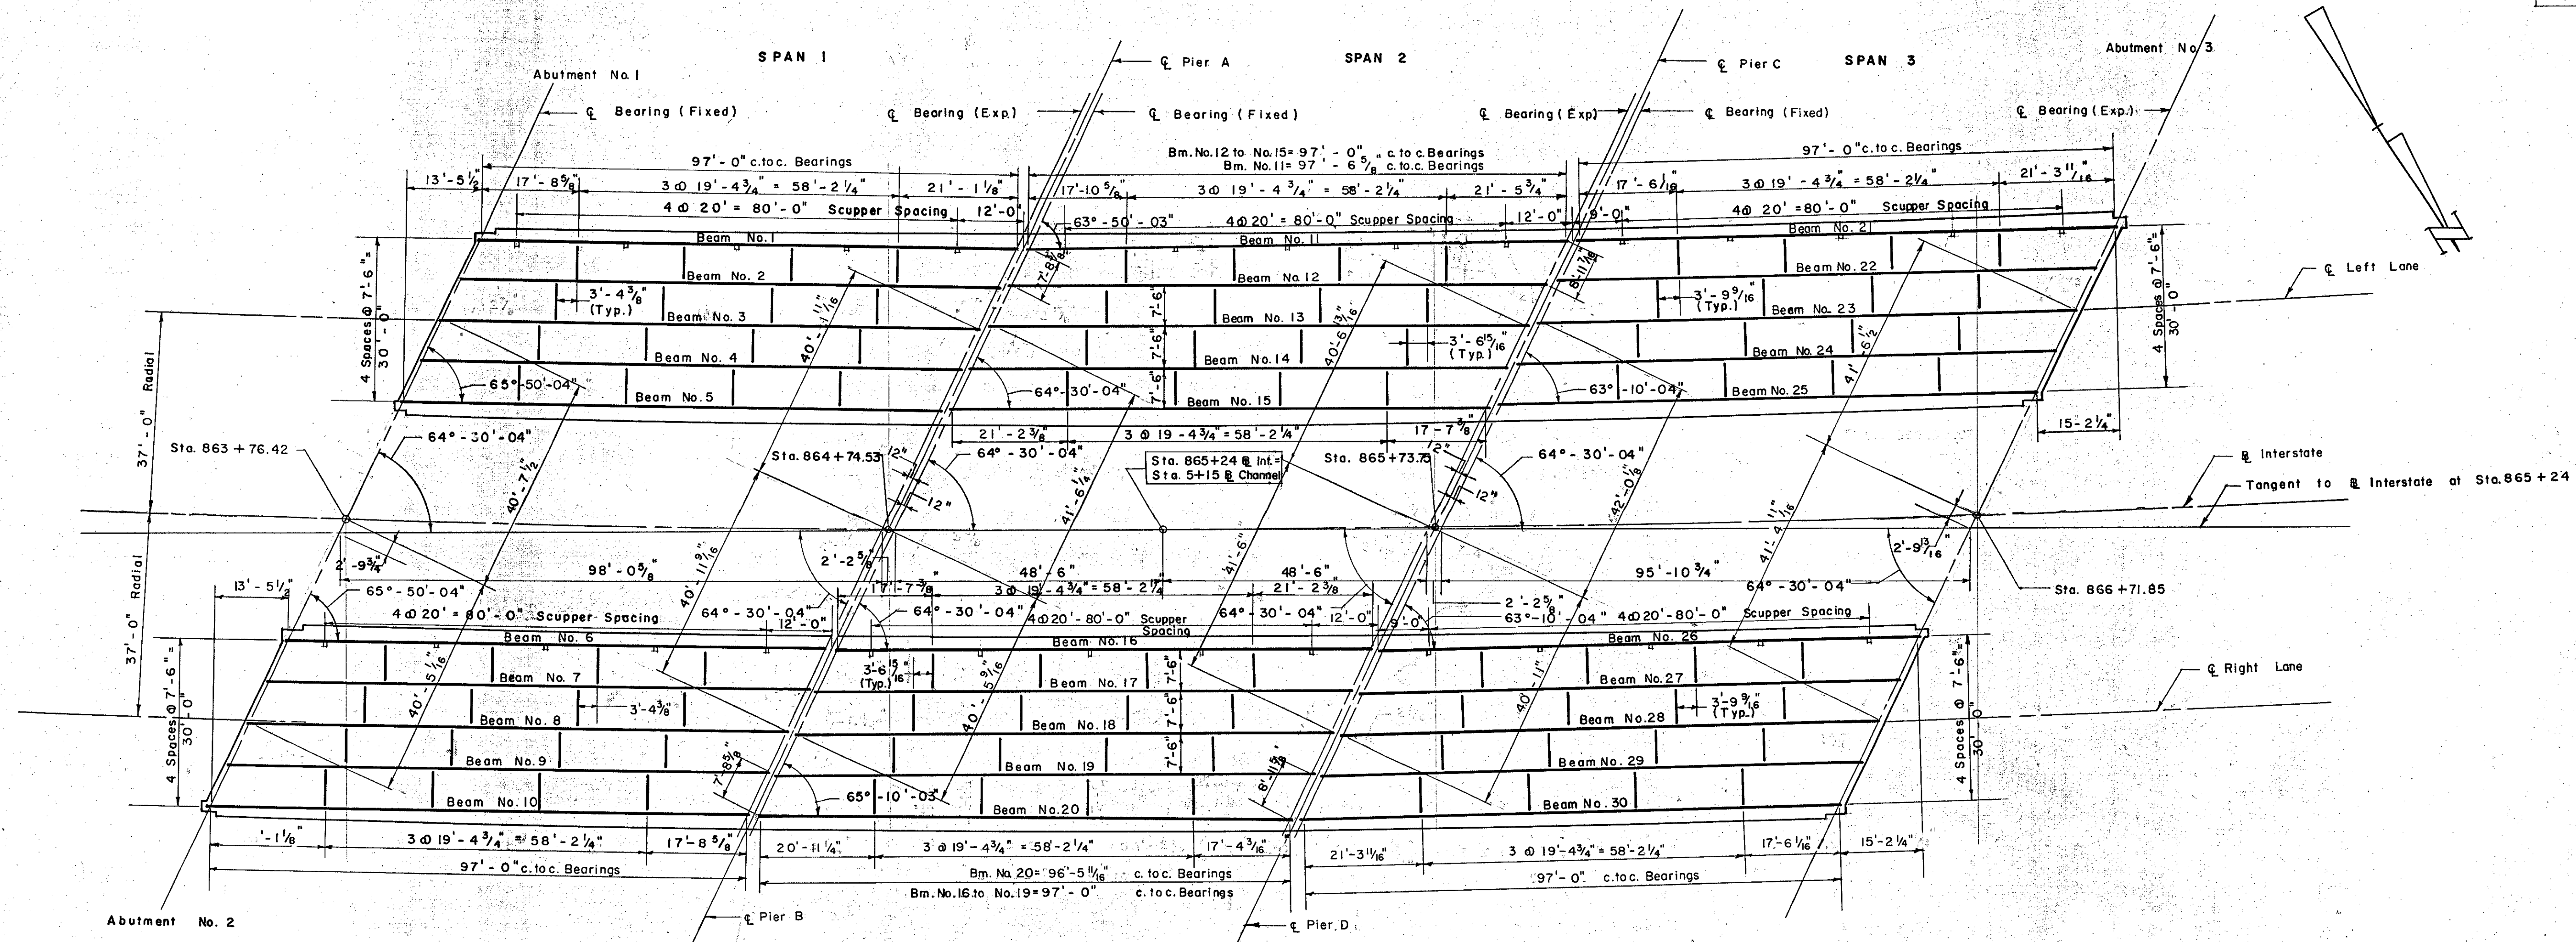

**FRAMING PLAN**

Scale: 1/16" = 1'-0"

- NOTES: 1. All beams 36 W<sup>F</sup> 300 with 18" x 11/16" x 66'-9" long R bottom and 12" x 1/2" x 63'-6" long R top. All diaphragms to be 18" x 42" x 7".  
 2. All beams shall be rolled to true circular camber with the middle ordinate as shown on Sheet No. 11.  
 3. Cut flanges @ 4" bearings as per Standard Sheet No. SB-22-58.  
 4. See sheet No. 11 for cover plate details.  
 5. All dimensions are horizontal distances.  
 6. The steel for all beams and cover plates shall conform to A.S.T.M. Designation A373. All other structural steel shall conform to either A 7 or A373.

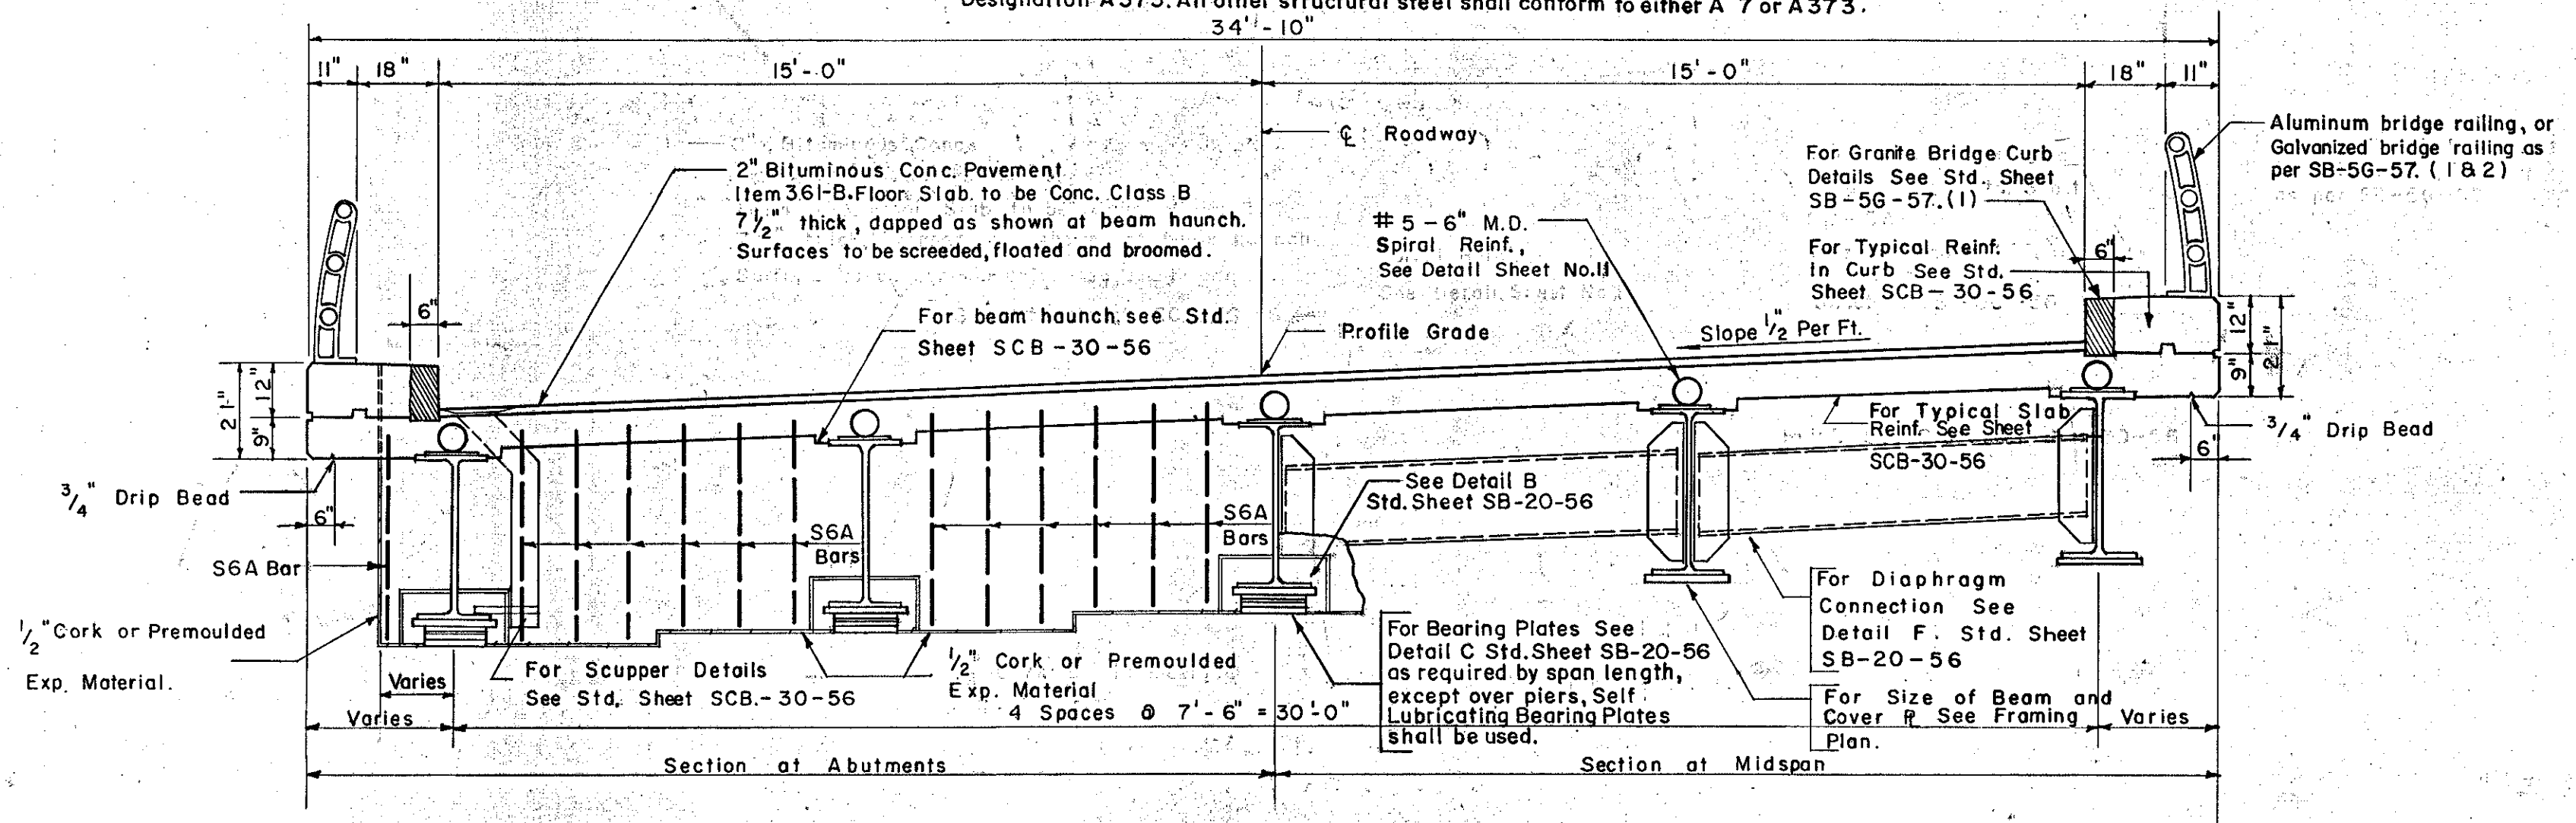

**TYPICAL CROSS SECTION**

Scale: 3/8" = 1'-0"

IM 089-2(26)  
This sheet for information only  
**BR 48 N & S**

CONTRACT NO. 1

STRUCTURAL STEEL PLAN	
STATE OF VERMONT DEPARTMENT OF HIGHWAYS	
INTERSTATE PROJECT in the town of <b>WATERBURY</b>	
INTERSTATE	STA. 865 + 24
LITTLE RIVER	OVER STA. 5 + 15
THE CLARKSON ENGINEERING CO., INC. BOSTON CONSULTING ENGINEERS MASS.	
SURVEYED BY	CHECKED BY B.K.B.J.B. SCALE AS NOTED
DRAWN BY B.S.S.	IN CHARGE J.V.B. DATE 8-20-57
PROJECT NO. I-89-2(7)	SHEET 233 OF 307


Item	No. Pieces	Size	Length	Mark	Type	A	B	C	D	E	F	G	H	J	K	R	O
ABUTMENT NO. 1																	
1	15	#5	4'-2"	A1-501	STR.												
2	3		5'-6"	A1-502													
3	3		7'-0"	A1-503													
4	3		13'-3"	A1-504													
5	4		12'-9"	A1-505													
6	6		8'-8"	A1-506													
7	2		7'-3"	A1-507													
8	2		5'-10"	A1-508													
9	5		9'-8"	A1-509													
10	2		10'-7"	A1-510													
11	2		12'-4"	A1-511													
12	2		13'-11"	A1-512													
13	8		14'-2"	A1-513	STR.												
14	8		9'-8"	A1-514	17	2'-9"	7'-0"										
15	4		10'-0"	A1-515	17	2'-8"	4'-8"	2'-8"									
16	3		14'-5"	A1-516	STR.												
17	4	#5	13'-11"	A1-517	STR.												
18	10	#6	8'-0"	A1-601	17	3'-0"	5'-0"										
19	12		22'-0"	A1-602	STR.												
20	*47		11'-6"	A1-603	STR.												
21	13	#6	7'-1"	A1-604	STR.												
22	6	#7	21'-3"	A1-701	I	0'-10"	20'-5"							0'-7"			
23	*8		9'-8"	A1-702	STR.												
24	2		10'-10"	A1-703													
25	1		11'-11"	A1-704													
26	1		13'-0"	A1-705													
27	2		13'-11"	A1-706													
28	10	#7	14'-2"	A1-707	STR.												
29	20	#9	7'-9"	A1-901	17	2'-9"	5'-0"										
30	5		13'-3"	A1-902	STR.												
31	5		12'-9"	A1-903													
32	2		9'-3"	A1-904													
33	1		8'-5"	A1-905													
34	1		7'-6"	A1-906													
35	2		6'-7"	A1-907													
36	*3		5'-3"	A1-908													
37	5		14'-5"	A1-909													
38	5	#9	13'-11"	A1-910	STR.												
39																	
40																	
ABUTMENT NO. 2																	
42	14	#5	4'-2"	A2-501	STR.												
43	3		6'-6"	A2-502													
44	3		8'-0"	A2-503													
45	4		13'-0"	A2-504													
46	3		12'-6"	A2-505													
47	2		10'-0"	A2-506													
48	6		8'-8"	A2-507													
49	2		7'-4"	A2-508													
50	2		6'-0"	A2-509													
51	3		10'-8"	A2-510													
52	2		11'-7"	A2-511													
53	2		13'-4"	A2-512													
54	2		15'-0"	A2-513													
55	8		15'-8"	A2-514													
56	4		14'-3"	A2-515													
57	3		13'-9"	A2-516	STR.												
58	8		10'-2"	A2-517	17	2'-8"	7'-6"										
59	4	#5	10'-6"	A2-518	17	2'-8"	5'-2"	2'-8"									
60	10	#6	8'-0"	A2-601	17	3'-0"	5'-0"										
61	12		22'-4"	A2-602	STR.												
62	46		11'-6"	A2-603	STR.												
63	13	#6	7'-1"	A2-604	STR.												
64	6	#7	21'-3"	A2-701	I	0'-10"	20'-5"							0'-7"			
65	5		10'-8"	A2-702	STR.												
66	2		11'-5"	A2-703													
67	1		12'-7"	A2-704													
68	1		13'-8"	A2-705													
69	1		14'-10"	A2-706													
70	2		15'-4"	A2-707													
71	10	#7	15'-8"	A2-708	STR.												
72	22	#9	7'-9"	A2-901	17	2'-9"	5'-0"										
73	5		13'-0"	A2-902	STR.												
74	6		12'-6"	A2-903													
75	2		9'-7"	A2-904													
76	1		8'-8"	A2-905													
77	1		7'-9"	A2-906													
78	1		6'-10"	A2-907													
79	2		5'-11"	A2-908													
80	5		14'-2"	A2-909													
81	6	#9	13'-8"	A2-910	STR.												

Item	No. Pieces	Size	Length	Mark	Type	A	B	C	D	E	F	G	H	J	K	R	O
82	11	#5	30'-0"	P-501	STR.												
83	21	#5	15'-0"	P-502	STR.												
84	36	#6	15'-2"	P-603	17			3'-4"	11'-10"								
85	4	#6	14'-1"	P-604	17			2'-3"	11'-10"								
86	16	#5	24'-2"	P-505	STR.												
87	16	#5	10'-8"	P-506	14	2'-1"	3'-3"		3'-3"	2'-1"			2'-4"				4'-6"
88	44	#5	23'-6"	P-507	STR.												
89	32	#6	18'-6"	P-608	STR.												
90	32	#6	20'-4"	P-609	STR.												
91	112	#5	13'-8"	P-510	TI	0'-9"	2'-5"	3'-8"	2'-5"	3'-8"			0'-9"				
92	32	#6	5'-0"	P-611	STR.												
93	40	#6	6'-3"	P-612	STR.												
94	21	#5	9'-8"	P-513	17			2'-6"	4'-8"	2'-6"							
95	1		10'-0"	P-514				2'-8"		2'-8"							
96	1		11'-0"	P-515				3'-2"		3'-2"							
97	1		11'-10"	P-516				3'-7"		3'-7"							
98	1		12'-8"	P-517				4'-0"		4'-0"							
99	1		14'-0"	P-518				4'-8"		4'-8"							
100	3		15'-8"	P-519				5'-6"		5'-6"							
101	8		17'-0"	P-520				6'-2"		6'-2"							
102	1		15'-4"	P-521				5'-4"		5'-4"							
103	1		15'-0"	P-522				5'-2"		5'-2"			</				


B.P.R. DIV. NO.	STATE	PROJECT NO.	SHEET NO.	TOTAL SHEETS
1	VT.	I-89-2(7)	57	307

SPIRAL SCHEDULE	
SPIRAL PITCH 0' - 10' FROM BRNG.	DOUBLE @ 5 1/2"
" " 10' - 20' OR @ SPAN	DOUBLE @ 6 1/2"
" " 20' - 30' OR @ SPAN	4 1/2"
" " 30' - 40' OR @ SPAN	5 1/2"
" " 40' @ SPAN	7"


NOTE: WHERE A DOUBLE SPIRAL IS CALLED FOR IN THE SCHEDULE (4) FOUR 6 1/2" LONG STUDS ARE REQUIRED PER PITCH.

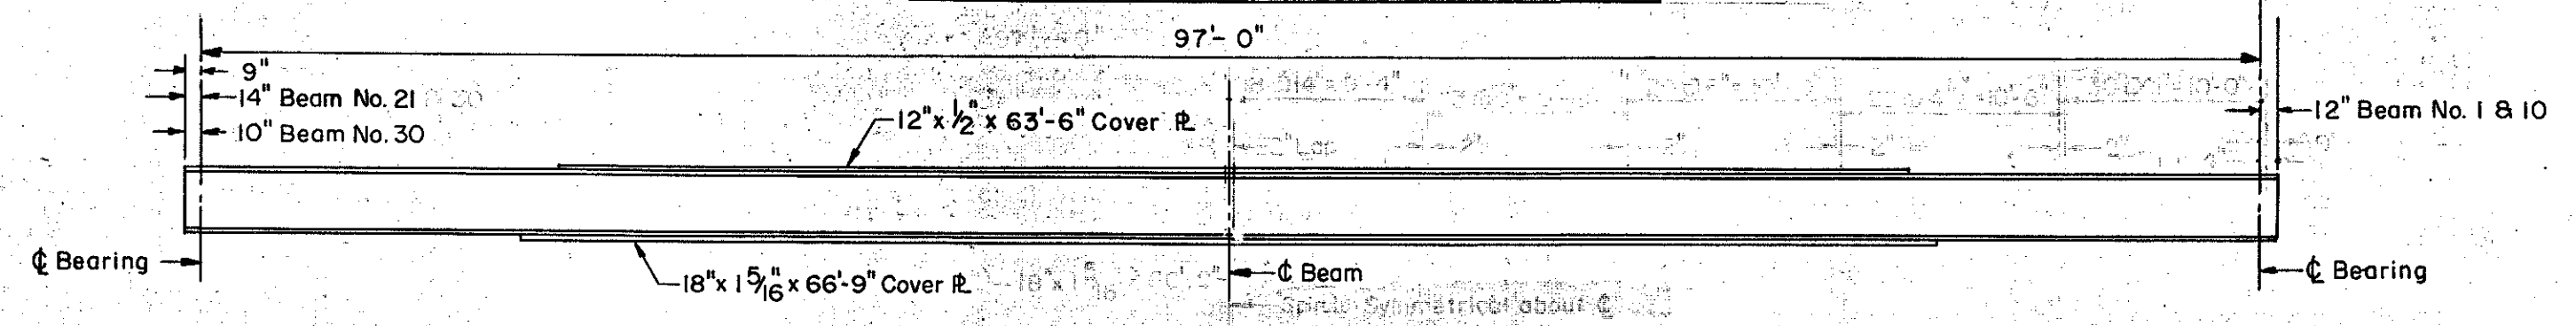


ELEVATION BEAMS 1 THRU 10, 12 THRU 19, & 21 THRU 30  
No Scale

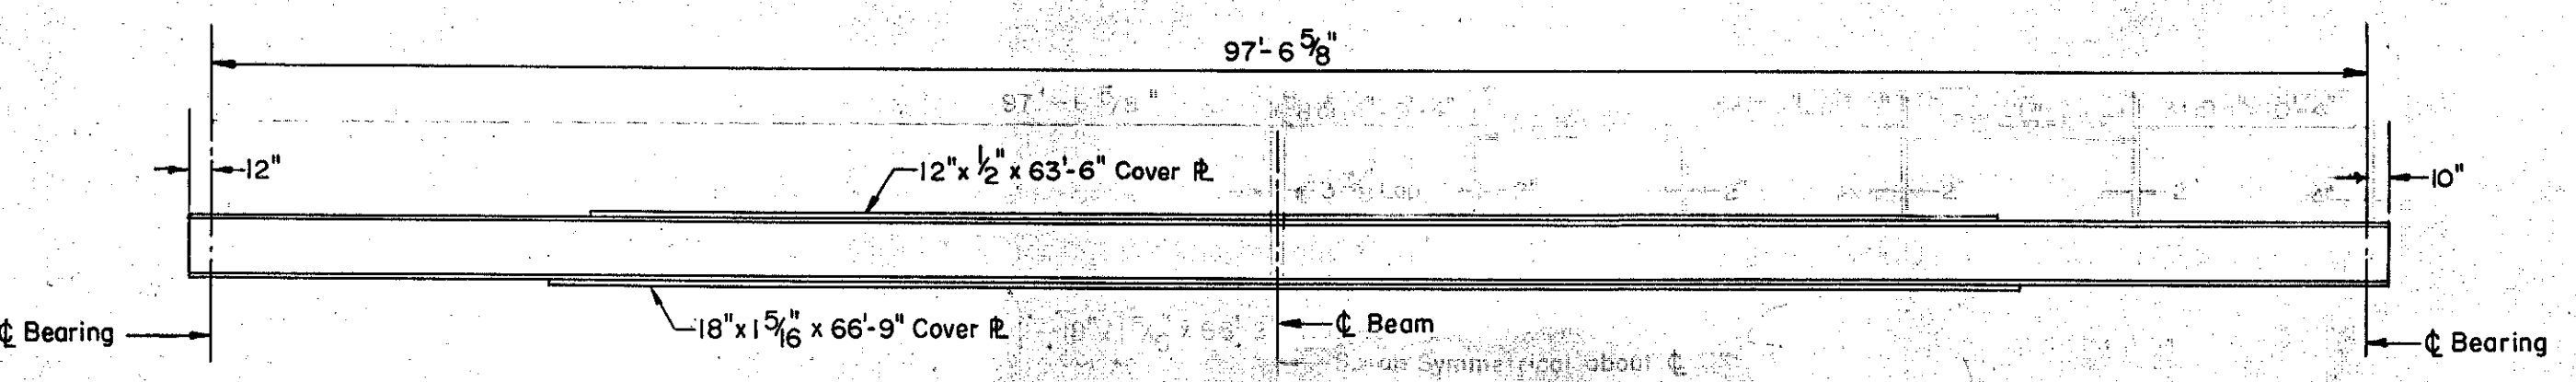


ELEVATION BEAM NO. 11  
No Scale

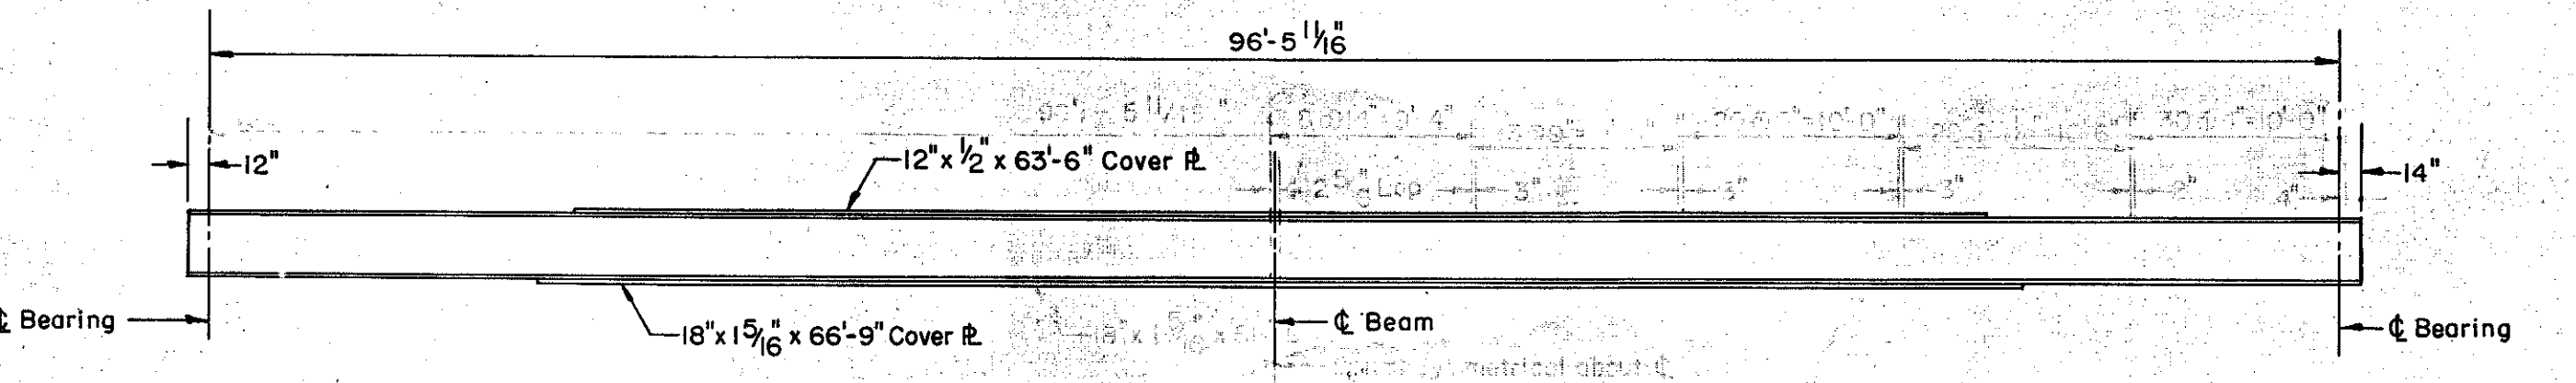


ELEVATION BEAM NO. 20  
No Scale

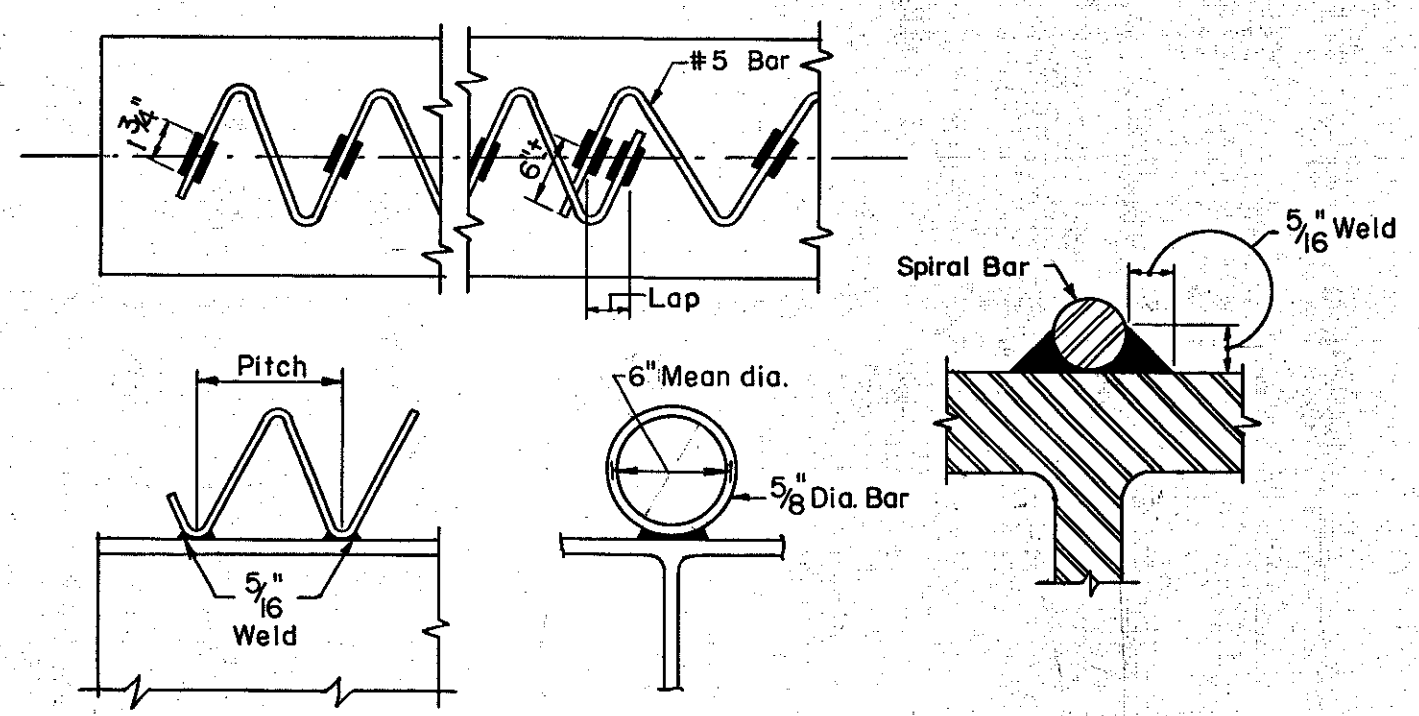


SPIRAL WELDING DETAILS  
No Scale

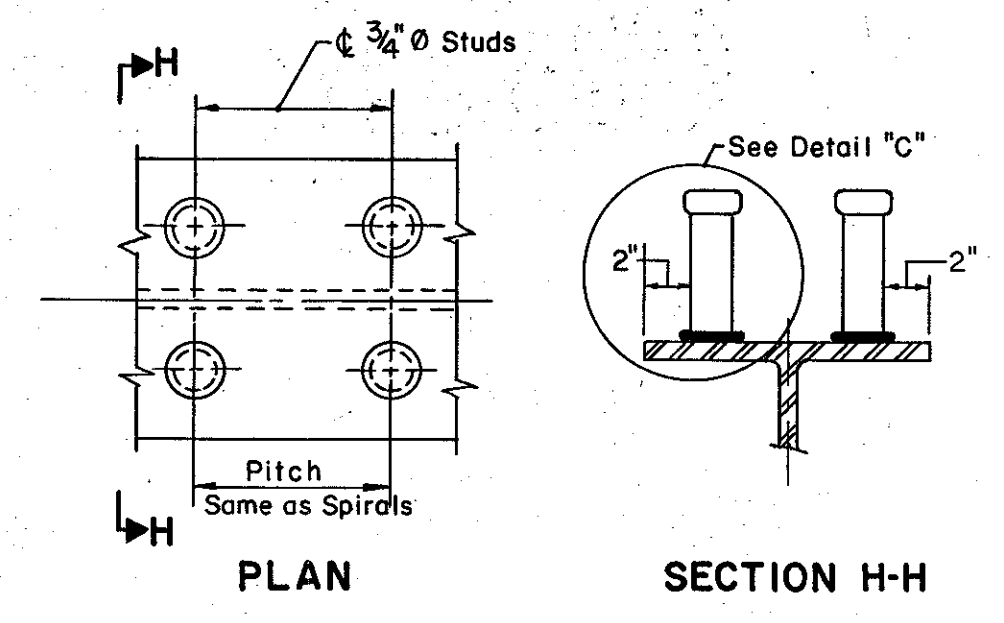

PLAN SECTION H-H

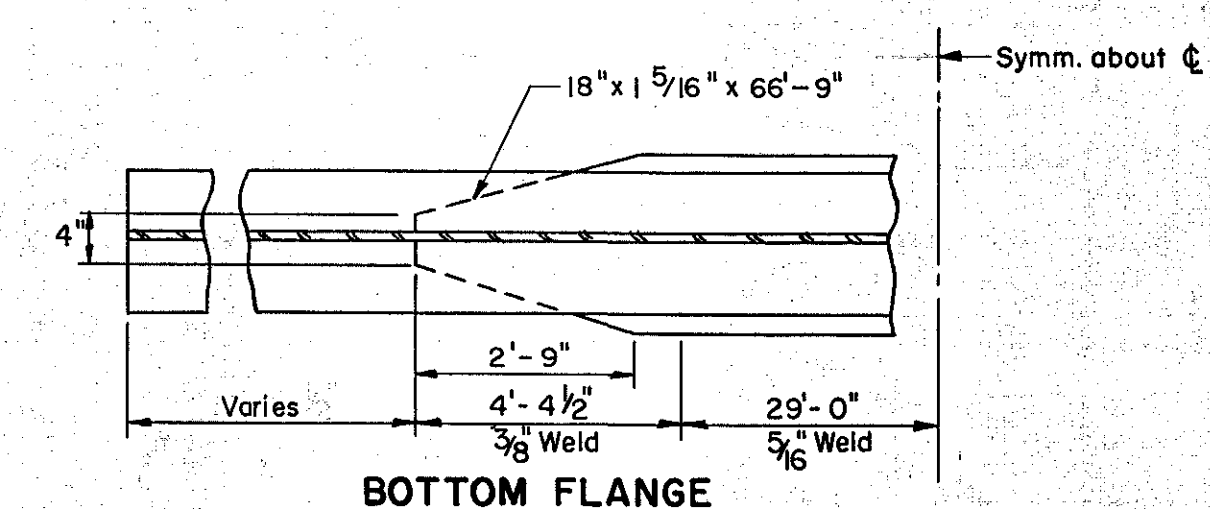


BOTTOM FLANGE

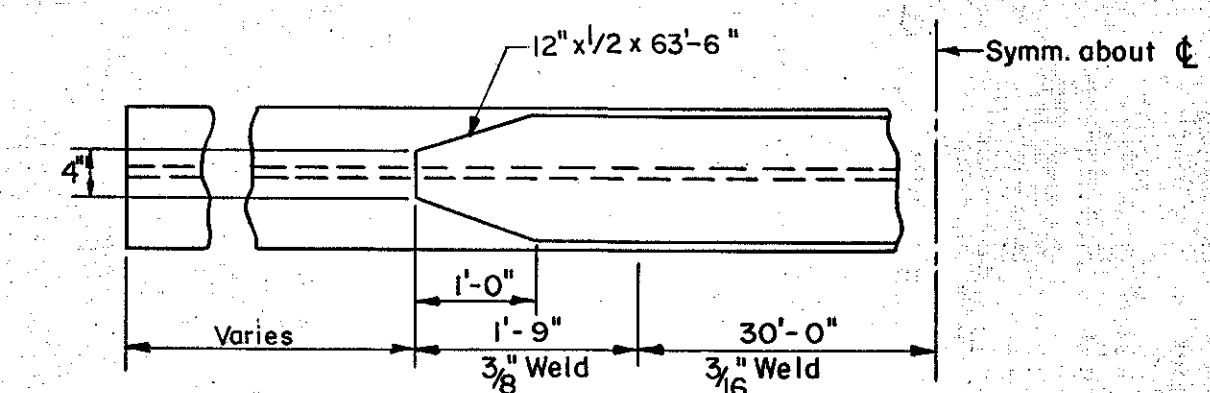


TOP FLANGE


DETAILS OF COVER PLATES  
No Scale

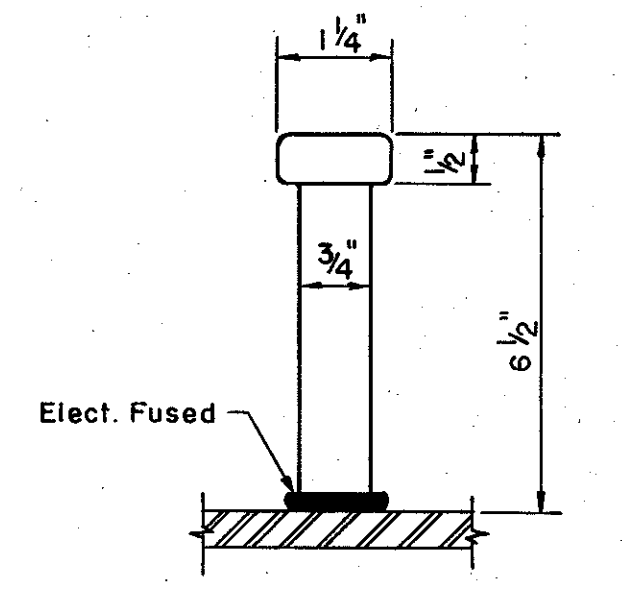


DETAIL "C"  
ALTERNATE SHEAR CONNECTOR  
No Scale

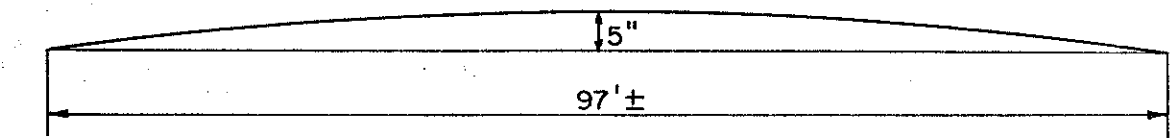

CAMBER DIAGRAM (ALL BEAMS)  
No Scale

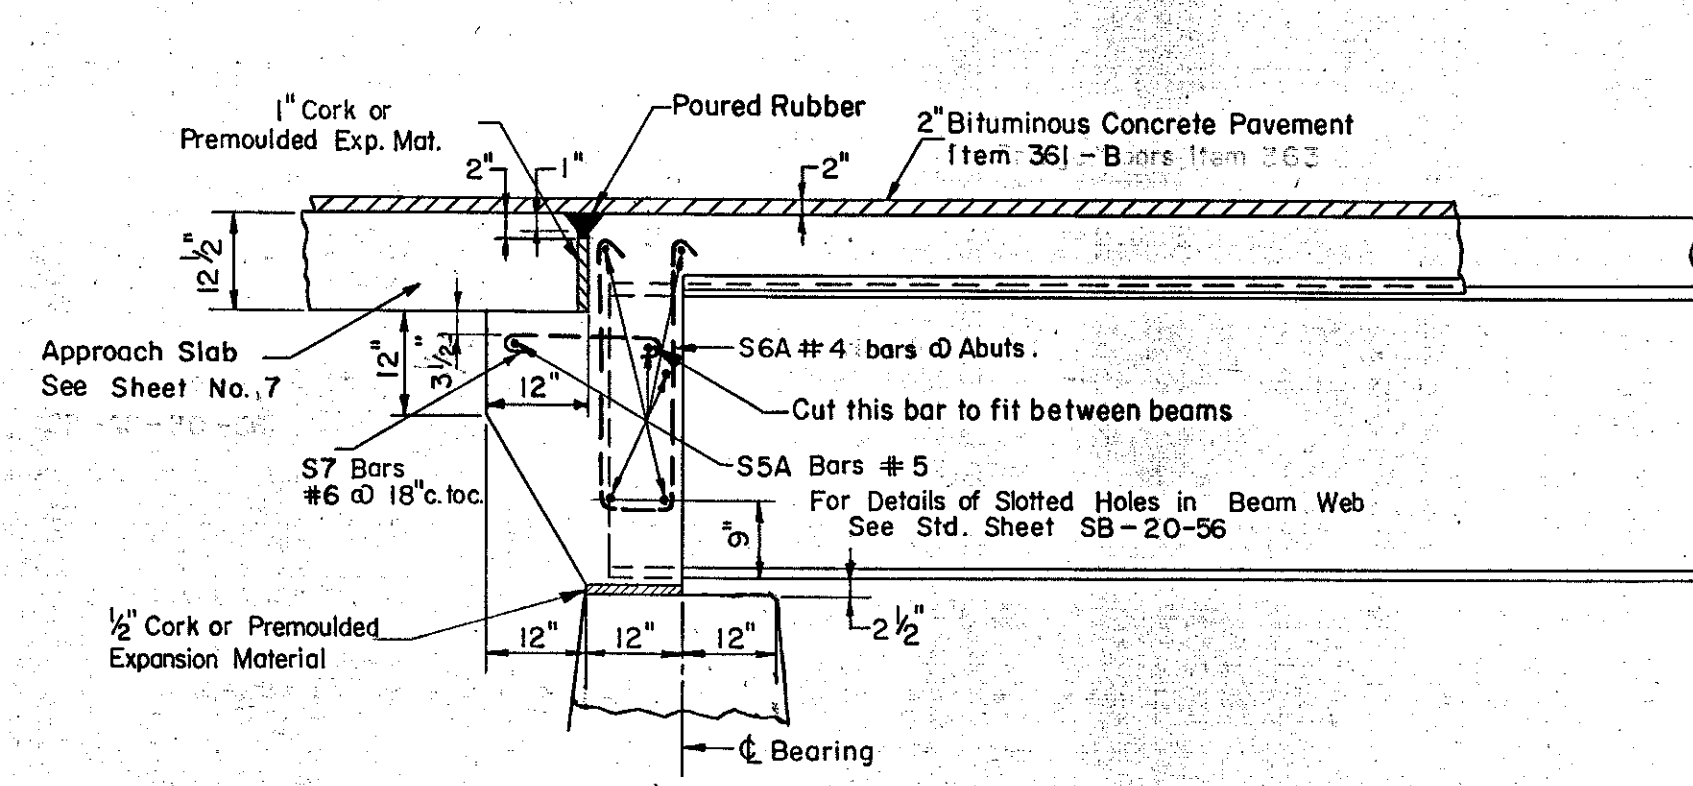

ELEVATION AT ABUTMENTS

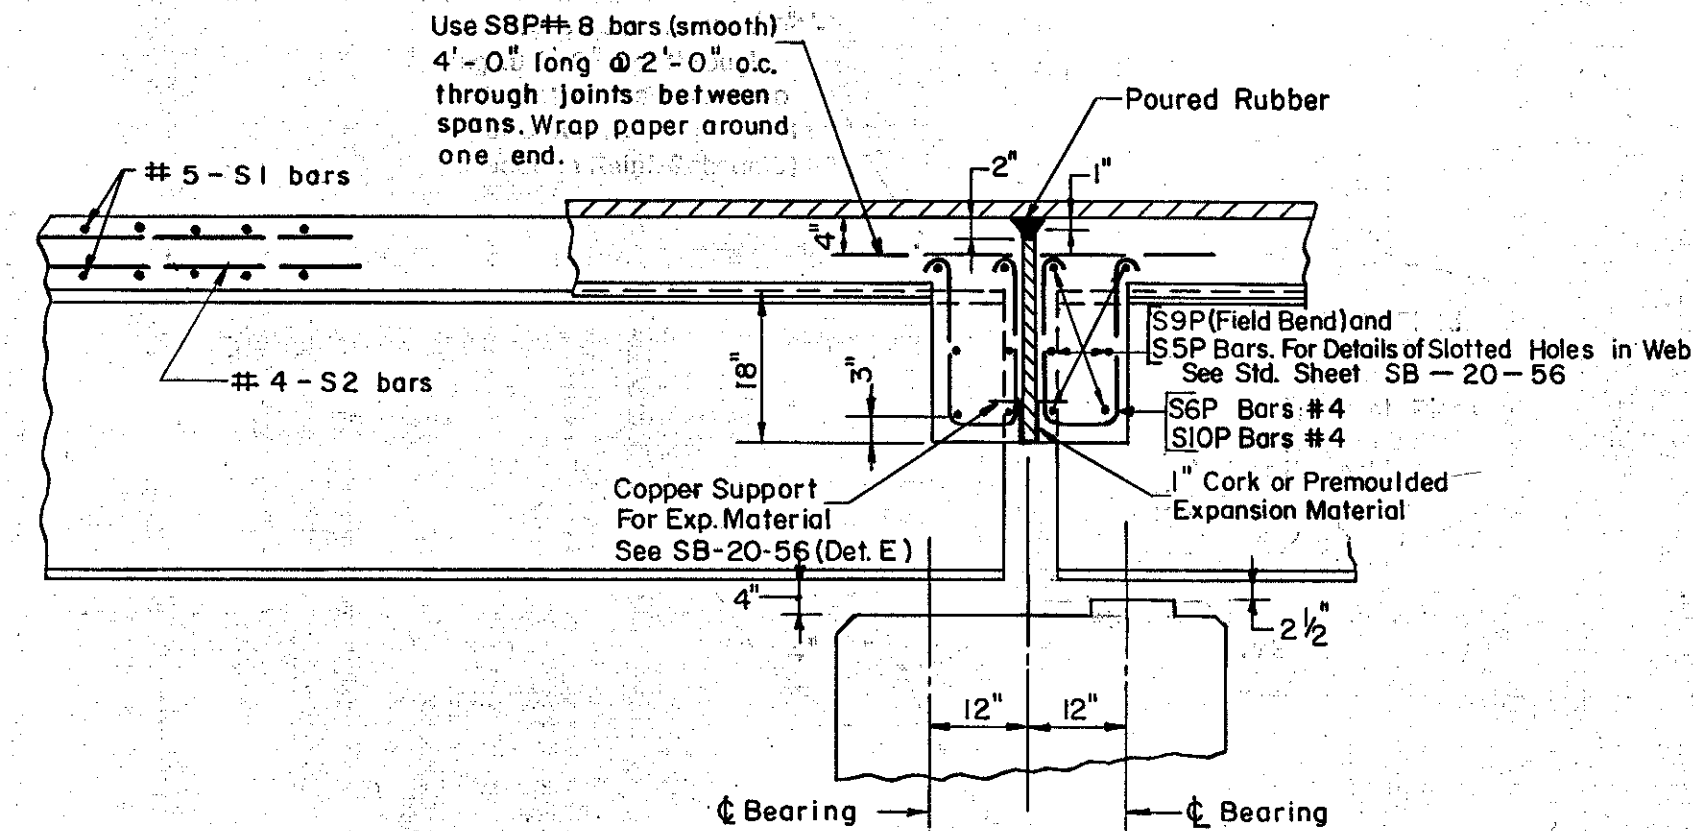

ELEVATION AT PIERS

TYPICAL ELEVATIONS OF BEAMS (SQUARE)

Scale: 1/2" = 1'-0"

ESTIMATED QUANTITIES

ITEM NO.	DESCRIPTION	UNIT	ESTIMATED QUANTITIES		
			NET	OVER-RUN	TOTAL
361-B	Bituminous Concrete Pavement	Tons	224	34	258
401-B	Concrete Class B (Mod.)	C.Y.	630	32	662
402	Reinforcing Steel	L.S.	1	1	1
403-a	Spiral Reinforcement (15,300 LBS)	L.S.	1	1	1
404-A	Structural Steel	Lbs.	136,500	22,730	159,230

IM 089-2(26)  
This sheet for information only  
**BR 48 N & S**

CONTRACT NO. 1

STRUCTURAL DETAILS

STATE OF VERMONT  
DEPARTMENT OF HIGHWAYS

INTERSTATE PROJECT in the town of  
**WATERBURY**



INTERSTATE OVER STA. 865 + 24  
LITTLE RIVER OVER STA. 5 + 15

THE CLARKESON ENGINEERING CO. INC.  
CONSULTING ENGINEERS

BOSTON MASSACHUSETTS  
SURVEYED BY H.C. CHECKED BY B.K. & J.B. SCALE AS NOTED  
DRAWN BY H.C. IN CHARGE J.V.B. DATE 8-20-57

PROJECT NO. I-89-2(7) SHEET 234 OF 307



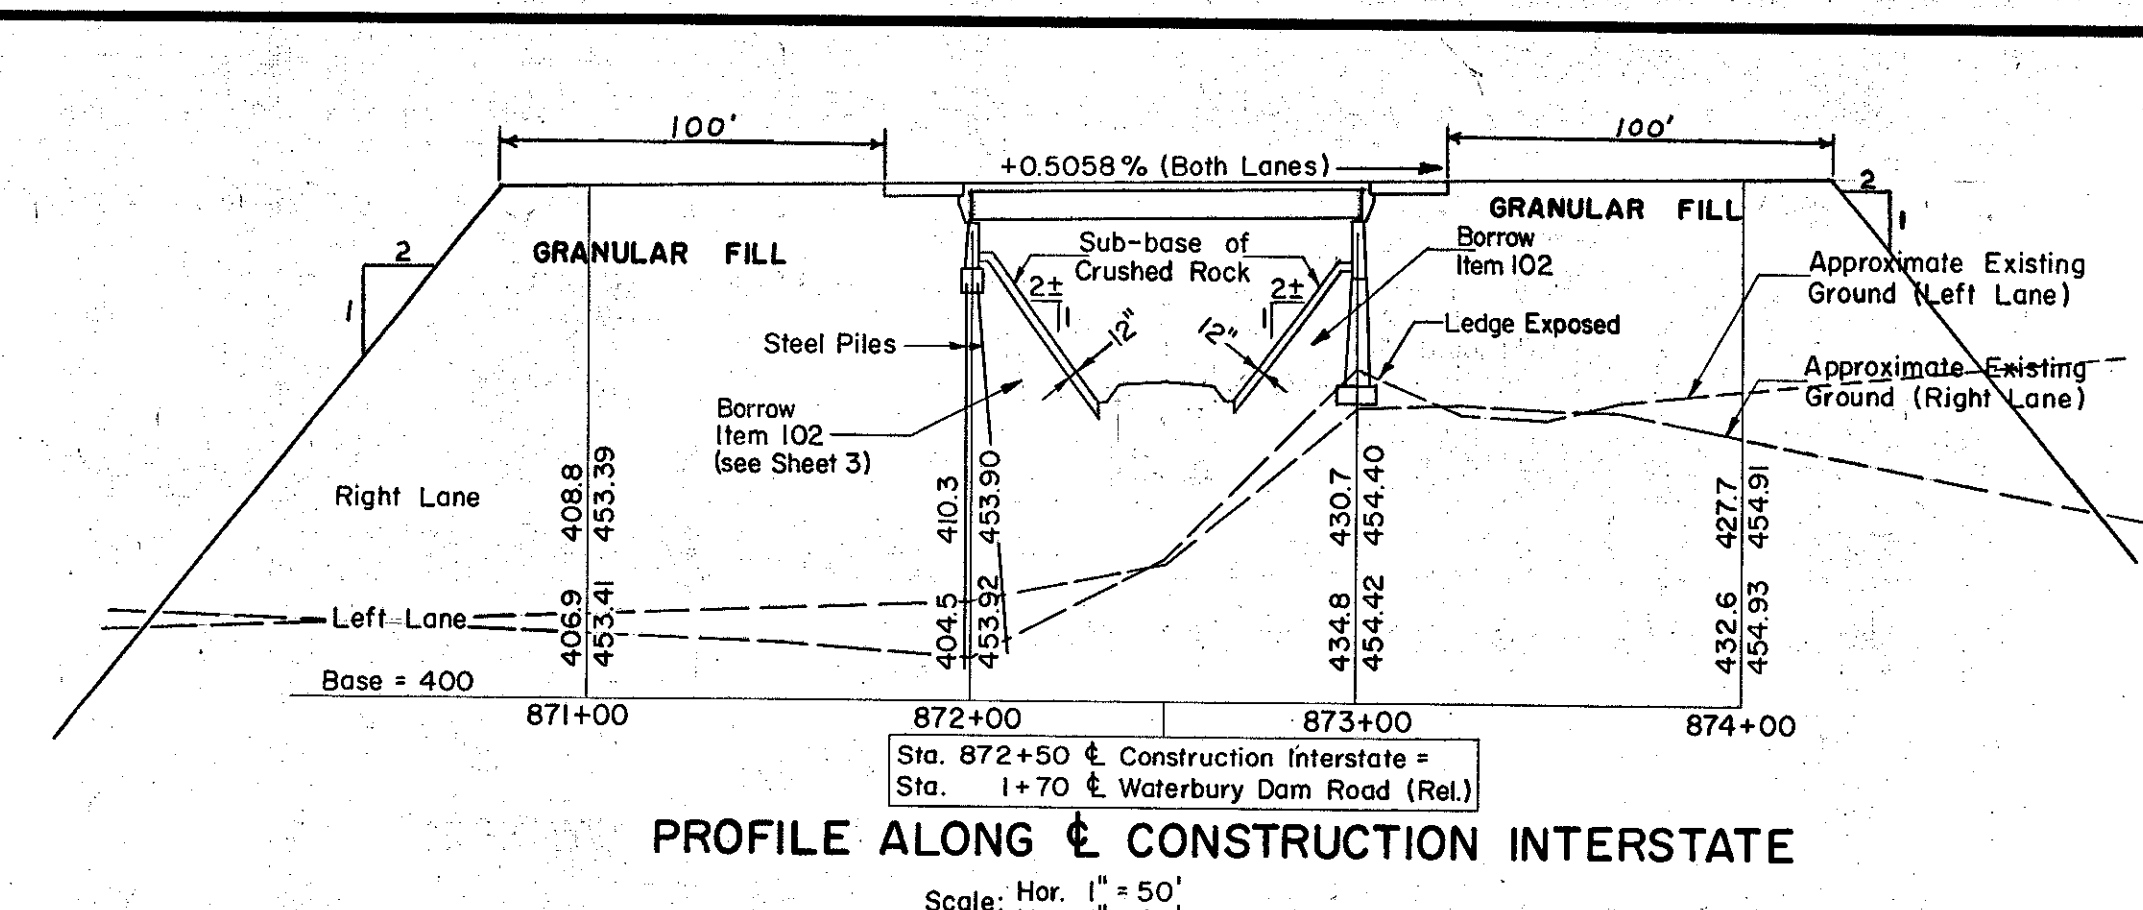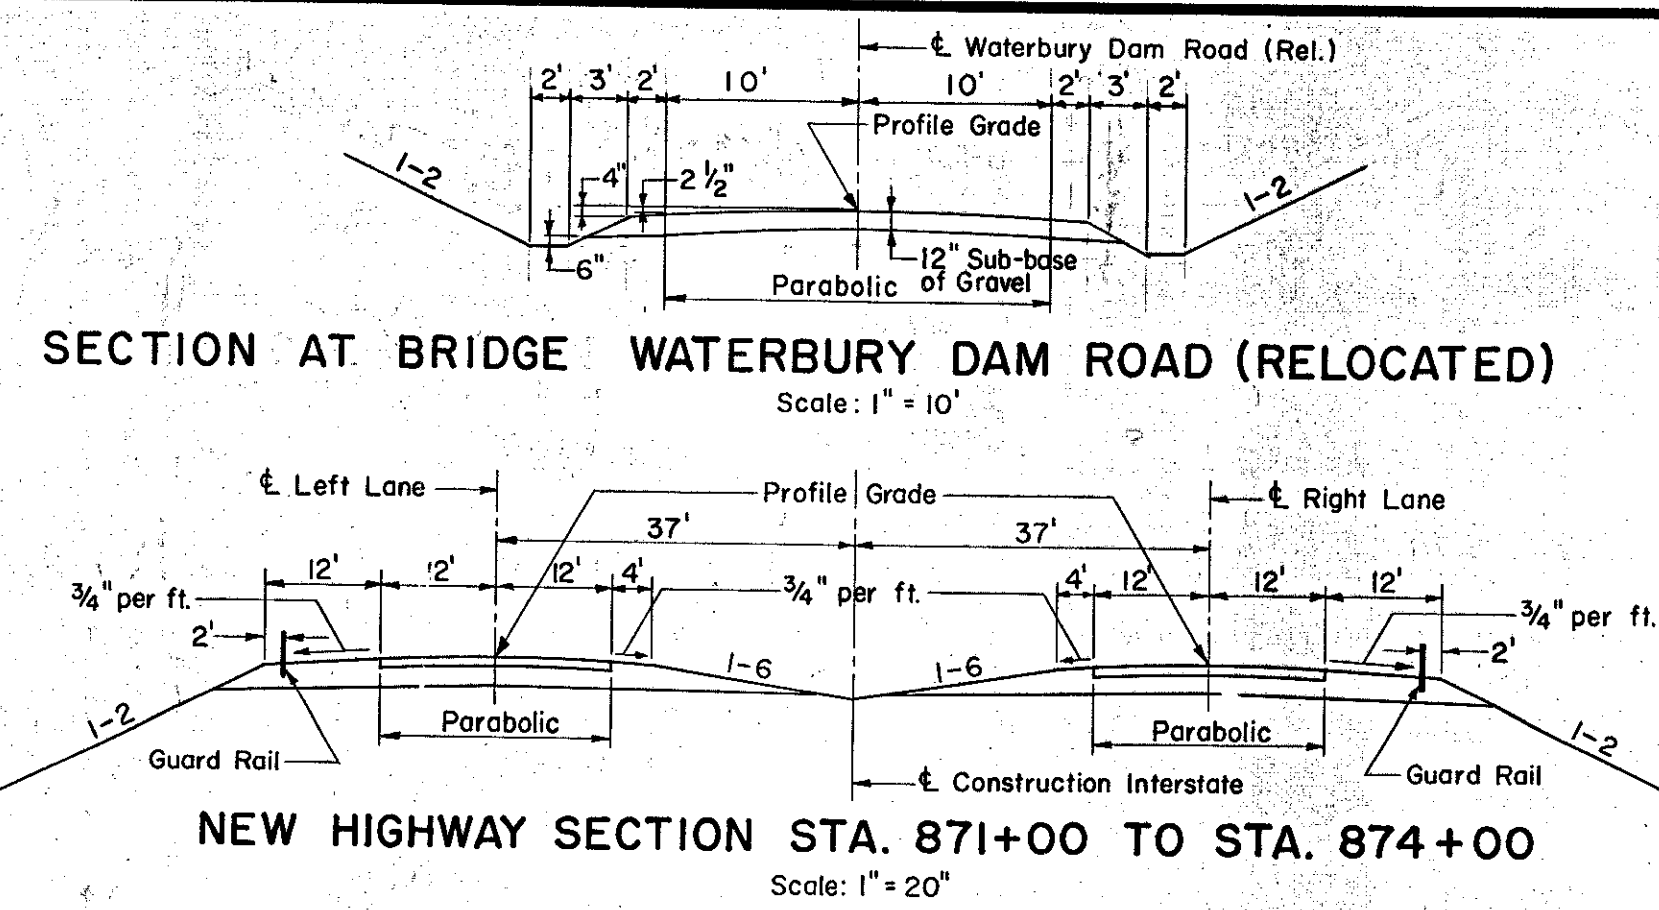

HIGHWAY NO.	I-89	NAME OF HIGHWAY	Interstate	B. P. R. DIV. NO.	STATE	PROJECT NO.	I-89-2(7)	SHEET NO.	237	TOTAL SHEETS	307
STRUCTURE NO.	17	COUNTY	Washington	TOWN	Waterbury						
PROJECT NO.	I-89-2(7)	LOCATION	Sta. 872+50								

**EXISTING STRUCTURE**

- RATED LOADING OF EXISTING STRUCTURE \_\_\_\_\_
- TYPE OF EXISTING STRUCTURE Under Existing Route 2 6.3' x 5' Concrete Box Bridge
- UNDERCLEARANCE ELEVATION OF EXISTING STRUCTURE \_\_\_\_\_
- WHAT DISPOSITION SHOULD BE MADE OF EXISTING STRUCTURE \_\_\_\_\_ COST OF REMOVAL \_\_\_\_\_
- SHOULD EXISTING STRUCTURE BE USED TO MAINTAIN TRAFFIC DURING CONSTRUCTION OF NEW STRUCTURE \_\_\_\_\_
- SHOULD NEW TEMPORARY STRUCTURE BE BUILT \_\_\_\_\_
- ORDINARY HIGH WATER SURFACE ELEV. AT EXISTING STRUCTURE 428.0 WATERWAY TO ORDINARY H.W. \_\_\_\_\_
- EXTREME HIGH WATER AT EXISTING STRUCTURE 429.0 WATERWAY TO EXTREME H.W. \_\_\_\_\_
- SPAN OF EXISTING BRIDGE UPSTREAM 6.3 WATERWAY TO EXTREME H.W. \_\_\_\_\_
- SPAN OF EXISTING BRIDGE DOWNSTREAM \_\_\_\_\_ WATERWAY TO EXTREME H.W. \_\_\_\_\_
- TYPE OF FOUNDATION UNDER EXISTING ABUTMENTS \_\_\_\_\_
- DOES ALL WATER AT FLOOD ELEVATION PASS THROUGH EXISTING STRUCTURE \_\_\_\_\_
- IF NOT AT WHAT ELEVATION IS RELIEF AFFORDED \_\_\_\_\_
- ADDITIONAL WATERWAY AREA PROVIDED \_\_\_\_\_

**NEW STRUCTURE**

- RECOMMENDED TYPE OF STRUCTURE 1 Span Composite Steel Stringer Bridge & 1-48" C.M.P.
- RECOMMENDED CLEAR SPAN OR SPANS 97' (Both Lanes)  
MEASURED PARALLEL TO NEW HIGHWAY \_\_\_\_\_  
MEASURED AT RIGHT ANGLES TO STREAM \_\_\_\_\_
- ARE THERE OBJECTIONS TO A PIER IN THE STREAM ANSWER YES OR NO \_\_\_\_\_
- ORDINARY HIGH WATER ELEVATION AT NEW STRUCTURE 415.0
- EXTREME HIGH WATER ELEVATION AT NEW STRUCTURE 429.0 SOURCE OF INFORMATION \_\_\_\_\_
- IS ALL WATER INTENDED TO PASS THROUGH NEW STRUCTURE \_\_\_\_\_
- DOES STREAM REACH ITS MAXIMUM HIGHWATER ELEVATION RAPIDLY Yes IS ORDINARY RISE RAPID Yes
- LOW WATER ELEVATION AT NEW STRUCTURE 414.0
- DRAINAGE AREA IN ACRES ABOVE STRUCTURE 77 CHARACTER OF TERRAIN Mountainous
- IS STREAM EVER DRY Yes
- VELOCITY OF STREAM AT HIGH WATER STAGE Varies 7 to 18 f.p.s. ESTIMATED DISCHARGE \_\_\_\_\_
- AREA FULL OPENING \_\_\_\_\_ AREA BELOW ORDINARY H.W. \_\_\_\_\_
- CHARACTER OF SCOUR \_\_\_\_\_ DRIFT \_\_\_\_\_ ICE \_\_\_\_\_
- ESTIMATED DRAINAGE AREA ABOVE NATURAL OR ARTIFICIAL STORAGE \_\_\_\_\_
- VERTICAL CLEARANCE ABOVE FLOOD ELEVATION \_\_\_\_\_
- ARE SIDEWALKS REQUIRED IF SO ON WHAT SIDE \_\_\_\_\_ BOTH SIDES \_\_\_\_\_
- RECOMMENDED TYPE OF PAVEMENT Bituminous Concrete Pavement
- TRAFFIC TO BE MAINTAINED UNDER ITEM NO. \_\_\_\_\_ ONE OR TWO WAYS \_\_\_\_\_ PROBABLE COST \_\_\_\_\_
- PROBABLE COST OF CLEARING AND GRUBBING STREAM CHANNEL AT STRUCTURE SITE \_\_\_\_\_
- SHOULD PROVISIONS BE MADE FOR PUBLIC UTILITIES \_\_\_\_\_
- ESTIMATED ALLOWABLE LOAD ON FOUNDATIONS \_\_\_\_\_ SHOULD PILES BE USED \_\_\_\_\_ EST. LGTH. \_\_\_\_\_

**FOUNDATION INFORMATION**

OBTAINED FOR DESIGN PURPOSES ONLY, AND THE STATE ASSUMES NO RESPONSIBILITY WHATSOEVER FOR THE SUFFICIENCY OR ACCURACY OF THE INFORMATION SHOWN. BOULDERS MAY BE ENCOUNTERED AT ANY PIER OR ABUTMENT LOCATION. FOR BORING LOGS, SEE SHEET NO. 2.

**GENERAL NOTES**

DESIGN SPECIFICATIONS: AASHTO 1957 Edition and as modified by Vermont Dept. of Highways

LIVE LOAD: H20-S16-44 and Military Loading

DESIGN STRESSES: Structural Steel  $f_s = 18,000$  p.s.i. Reinforcing Steel  $f_s = 20,000$  p.s.i. Concrete  $f_c = 1,200$  p.s.i.  $f_c = 3,000$  p.s.i.


CLEARANCE: Horizontal: as shown on drawings. Vertical: 15'-5"

SUPERSTRUCTURE: Separate structure for each lane. 42" Roadway, 1'-6" Safety Walks, as per SCB-42-56 1 Simple span, rolled beams, composite design, as per SCB-42-56 (97' Span). Aluminum bridge railing, or galvanized bridge railing, and granite bridge curb as per SB-56-57 (1 & 2).

BEARING AND DIAPHRAGM CONNECTIONS AS PER SB-20-56. APPROACH SLABS AS PER SB-AS-Square-57.

SUBSTRUCTURE: Sub abutments

FOUNDATIONS: Sub abutments # 1, 2 & 4 Steel Piles. Open abutment # 3 Footing to ledge.

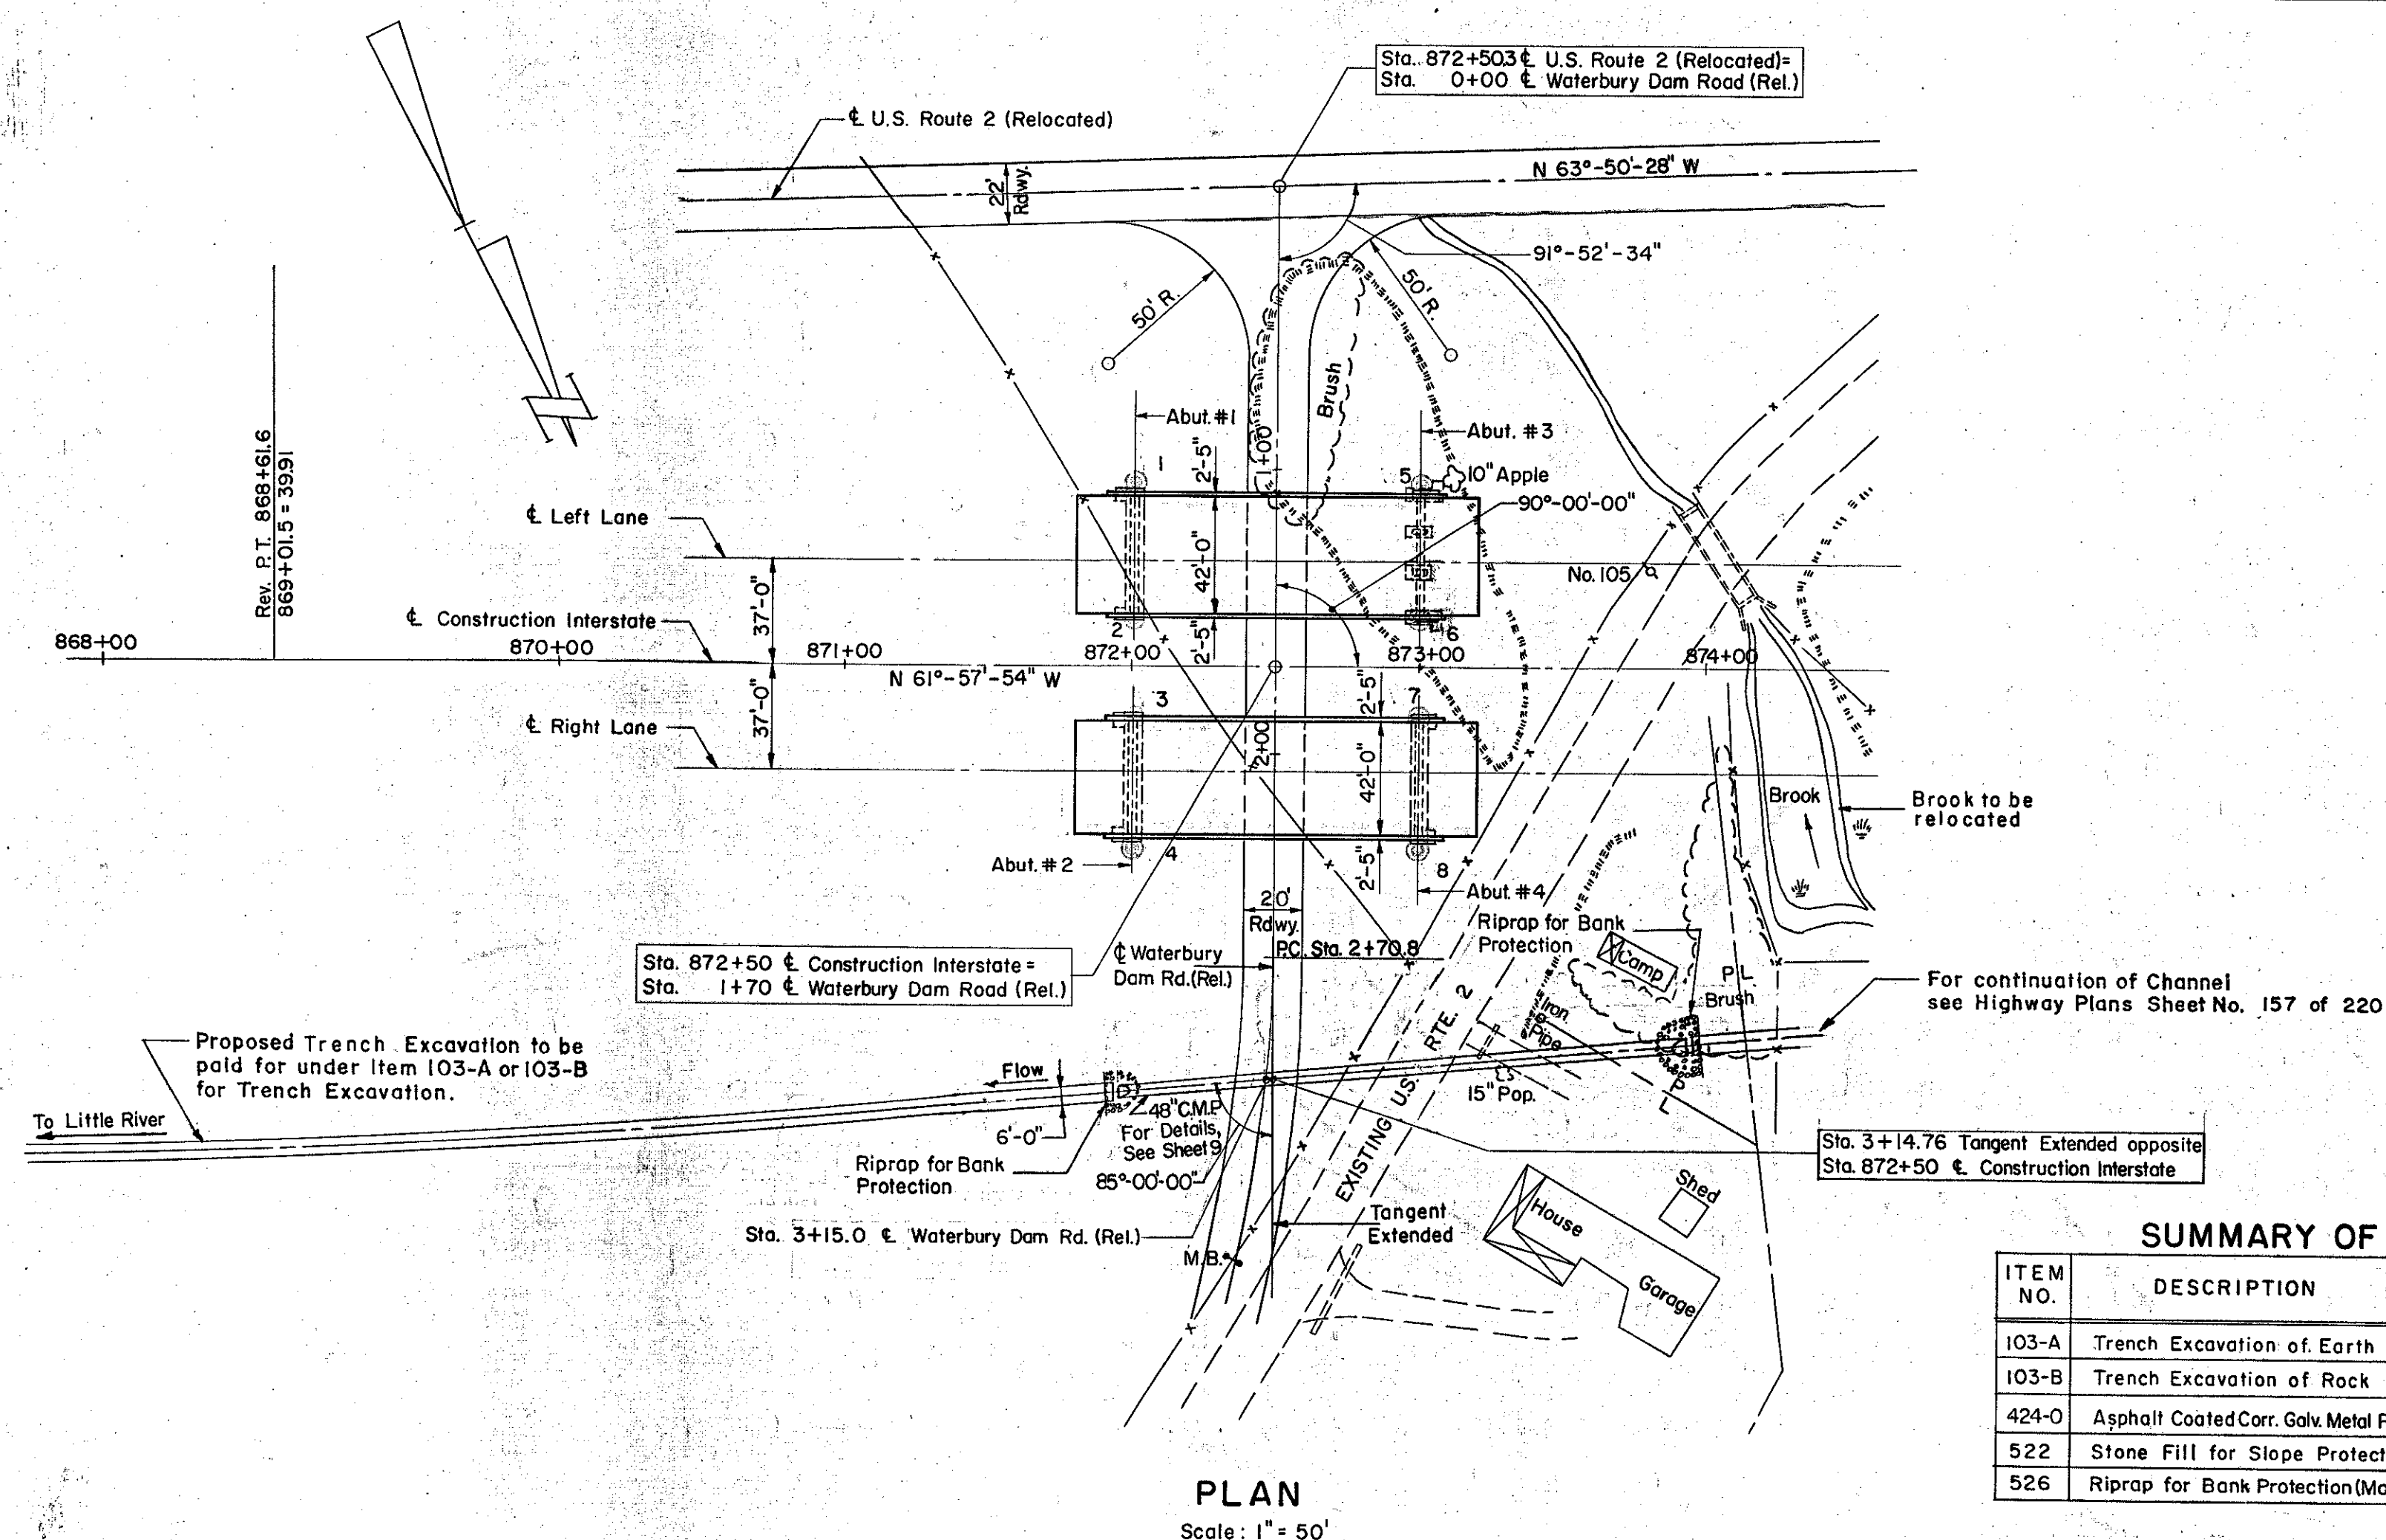


**SUMMARY OF QUANTITIES FOR PIPE**

ITEM NO.	DESCRIPTION	UNIT	NET	OVER-RUN	TOTAL	FINAL
103-A	Trench Excavation of Earth	C.Y.	1910	190	2100	
103-B	Trench Excavation of Rock	C.Y.	73	7	80	
424-O	Asphalt Coated Corr. Galv. Metal Pipe	L.F.	200	-	200	
522	Stone Fill for Slope Protection	C.Y.	20	3	23	
526	Riprap for Bank Protection (Mod.)	C.Y.	46	6	52	

**SUMMARY OF QUANTITIES FOR BRIDGE**

ITEM NO.	DESCRIPTION	UNIT	NET	OVER-RUN	TOTAL	FINAL
102	Borrow	C.Y.	10,500	-1,050	9,450	10,500
107	Structure Excavation	C.Y.	113	11	124	131
204	Sub-base of Crushed Rock (Mod.)	C.Y.	264	40	304	240
222	Gravel Backfill	C.Y.	130	35	165	130
361-B	Bit. Conc. Pavement	TONS	146	22	168	181
401-B	Concrete Class B (Mod.)	C.Y.	705	40	745	845
402	Reinforcing Steel	LBS.	101,280	-	101,280	101,280
403-c	Spiral Reinforcement (5,100 LBS)	L.S.	1	-	1	1
404-A	Structural Steel	LBS.	228,484	10,590	239,074	526,310
407	Asphaltic-Asbestos Coating	S.Y.	20	-	20	40
504	Steel Piling	L.F.	3000	-	3000	3,308
556-C	Granite Bridge Curb (Type 1)	L.F.	500	-	500	500
572	Bridge Railing (Sup. Apr. 11-3-60)	L.F.	378	-	378	378
501	Furnishing Equipment for Driving Piles	Required				1/3 L.S.
503	Splices for Steel Piling	Each	14	-	14	
310	For Emulsion for Bridge Floors (Sup. Apr. 6-1-61)					25.4 gal.
372	Joint Sealer, Hot Poured Elastic Type (Sup. Apr. 6-22-61)					108 L.F.
	Epoxy Resin Sealer for Concrete Joints (Sup. Apr. 8-22-61 Non-Cov.)					306 L.F.

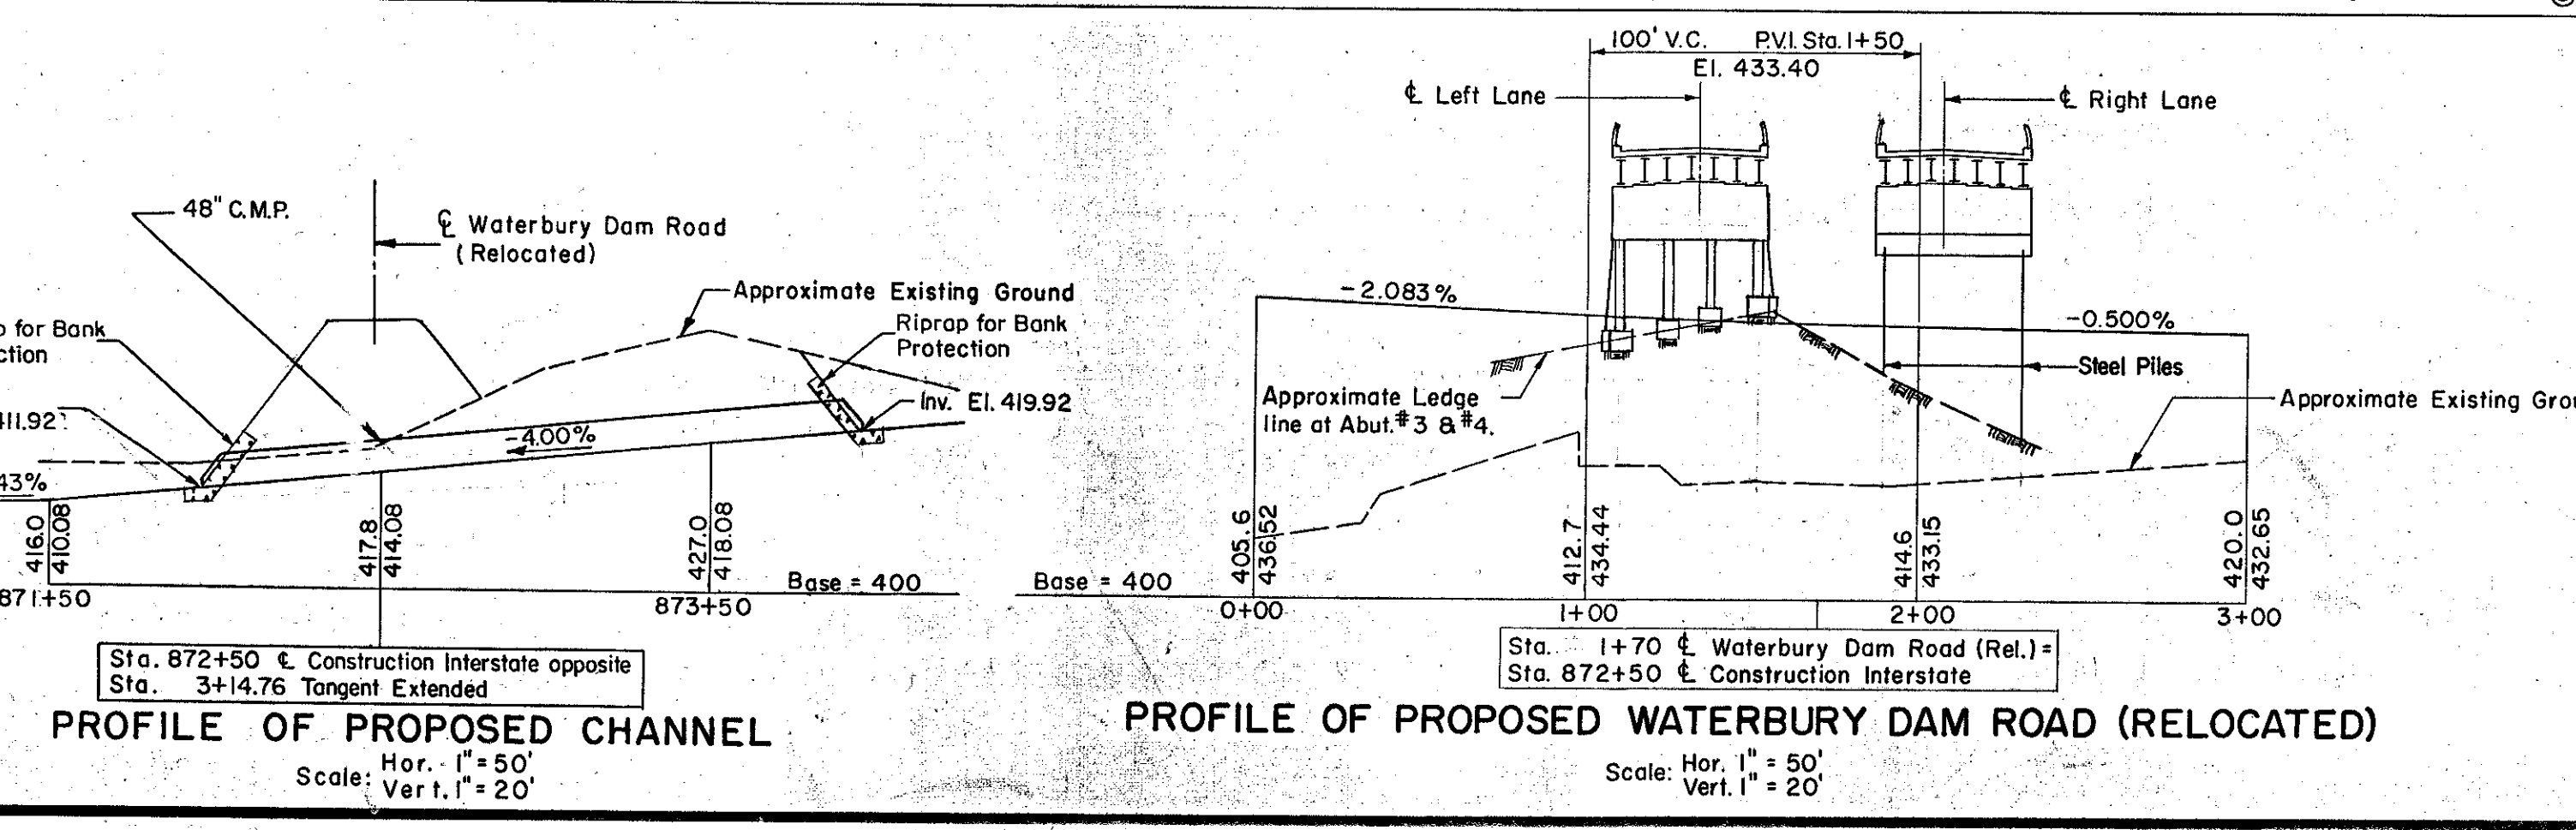


**LIST OF SHEETS** IM 089-2(26) This sheet for information only

SHEET NO.	DESCRIPTION
101	GENERAL PLAN
102	BORINGS
103	PLAN AND ELEVATION
104	ABUTMENTS, NO. 1, 2, & 4
105	ABUTMENT, NO. 3
106	APPROACH SLABS
107	STRUCTURAL STEEL PLAN & DETAILS
108	REINFORCING SCHEDULE
109	48" PIPE PLAN, ELEV. & LONG. SEC.
30	HIGHWAY'S PLANS & PROFILES
154	INTERSTATE CROSS SECTIONS
205-206	WATERBURY DAM RD. CROSS SEC.
71-72	SCB-42-56 (1 & 2)
73-74	SB-56-57 (1 & 2)
77	SB-20-56
79	SB-22-58
75	SB-AS-Square-57

**GENERAL PLAN**  
STATE OF VERMONT  
DEPARTMENT OF HIGHWAYS  
INTERSTATE PROJECT in the town of  
**WATERBURY**  
Sta. 872+50  
OVER  
WATERBURY DAM RD. (REL.) Sta. 1+70

APPROVED BY *Wm. A. Henderson* DATE 12-16-58  
THE CLARKESON ENGINEERING CO., INC.  
CONSULTING ENGINEERS  
BOSTON MASSACHUSETTS  
SURVEYED BY A.L. CHECKED BY G.B. B.S. SCALE AS NOTED  
DRAWN BY A.L. IN CHARGE J.V.B. DATE 6-19-58  
PROJECT NO. I-89-2(7) SHEET 237 OF 307

B.P.R. DIV. NO.	STATE	PROJECT NO.	SHEET NO.	TOTAL SHEETS
1	VT.	I-89-2(7)		

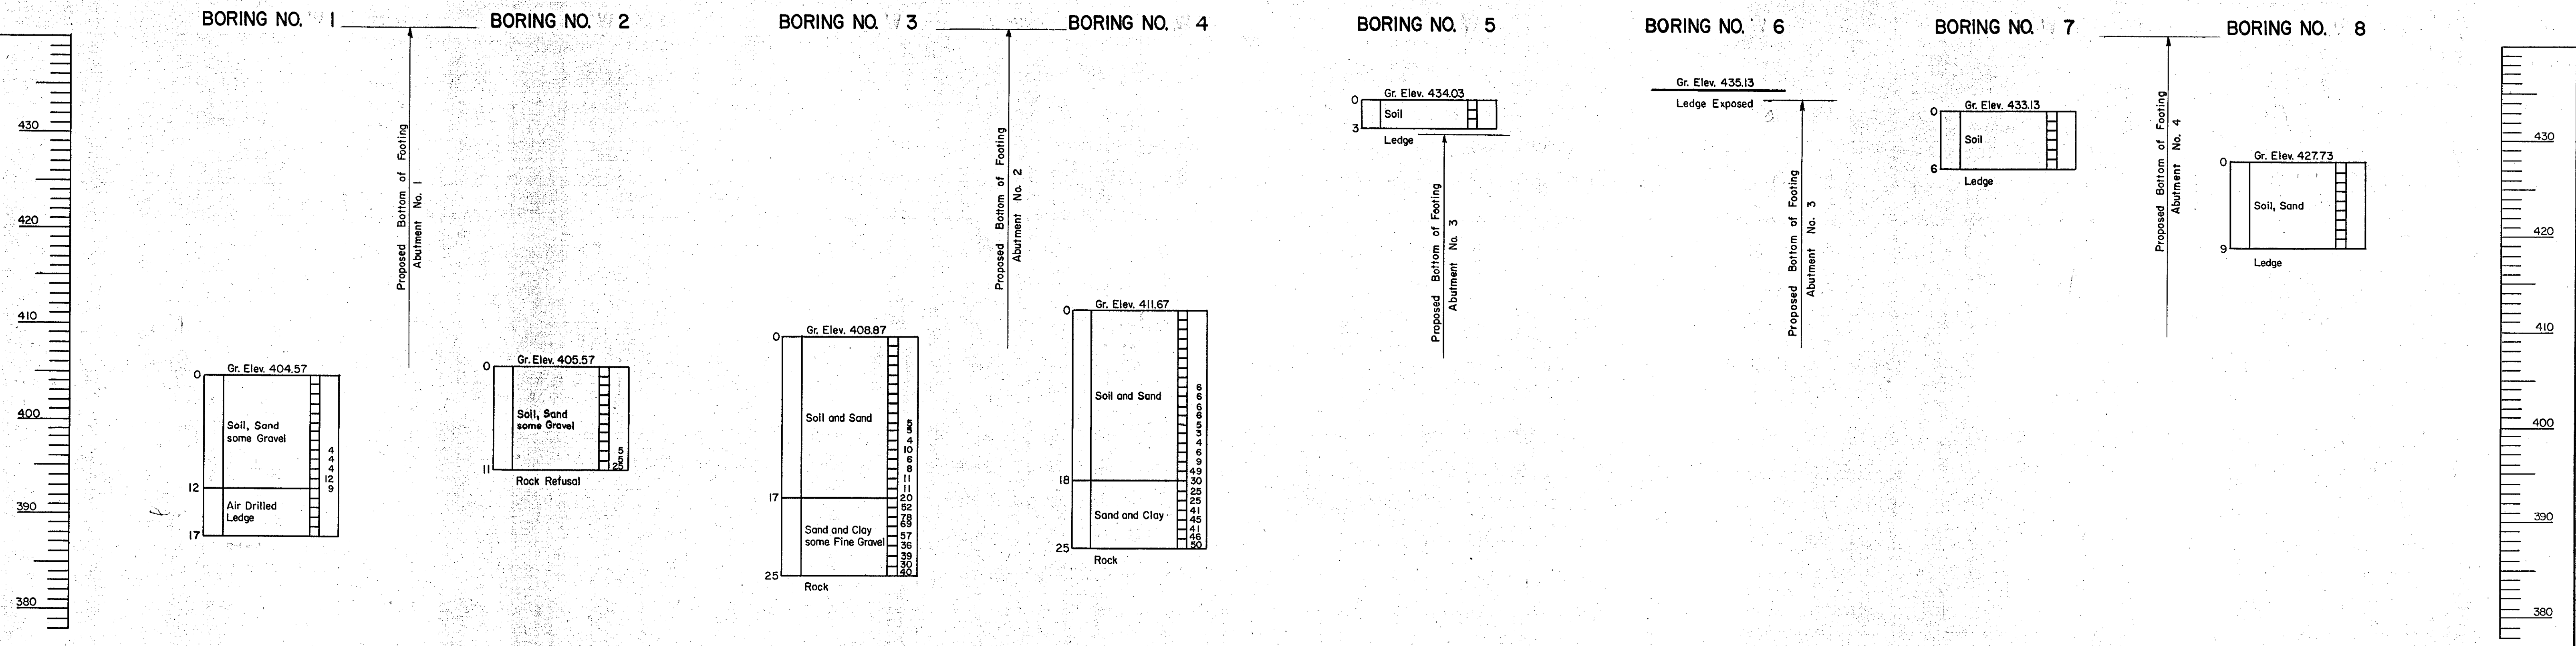

**BORING LOGS**

Scale: 1/8" = 1'-0"

- Notes: 1. For Borings No. 1 thru No. 4:  
 Weight of Hammer = 350#  
 Drop of Hammer = 24"  
 Diameter of Casing = 2 1/2"  
 Thickness of Casing = 3/8"
2. For Locations of Borings, see Sheet No. 1.


IM 089-2(26)  
 This sheet for information only  
**BR 49 N & S**

CONTRACT NO. 1


**BORINGS**

<b>STATE OF VERMONT</b>		
<b>DEPARTMENT OF HIGHWAYS</b>		
INTERSTATE PROJECT in the town of		
<b>WATERBURY</b>		
INTERSTATE	OVER	STA. 872+50
<b>WATERBURY DAM RD. (RELOC.)</b>		<b>STA. 1+70</b>
THE CLARKESON ENGINEERING CO., INC. CONSULTING ENGINEERS		
BOSTON	MASSACHUSETTS	
SURVEYED BY: S.A.L.	CHECKED BY: G.B.	SCALE: AS NOTED
DRAWN BY: S.A.L.	IN CHARGE: J.V.B.	DATE: 6-19-58
PROJECT NO. I-89-2 (7)	SHEET 238	OF 307


B. P. R. DIV. NO.	STATE	PROJECT NO.	SHEET NO.	TOTAL SHEETS
1	VT.	I-89-2 (7)		

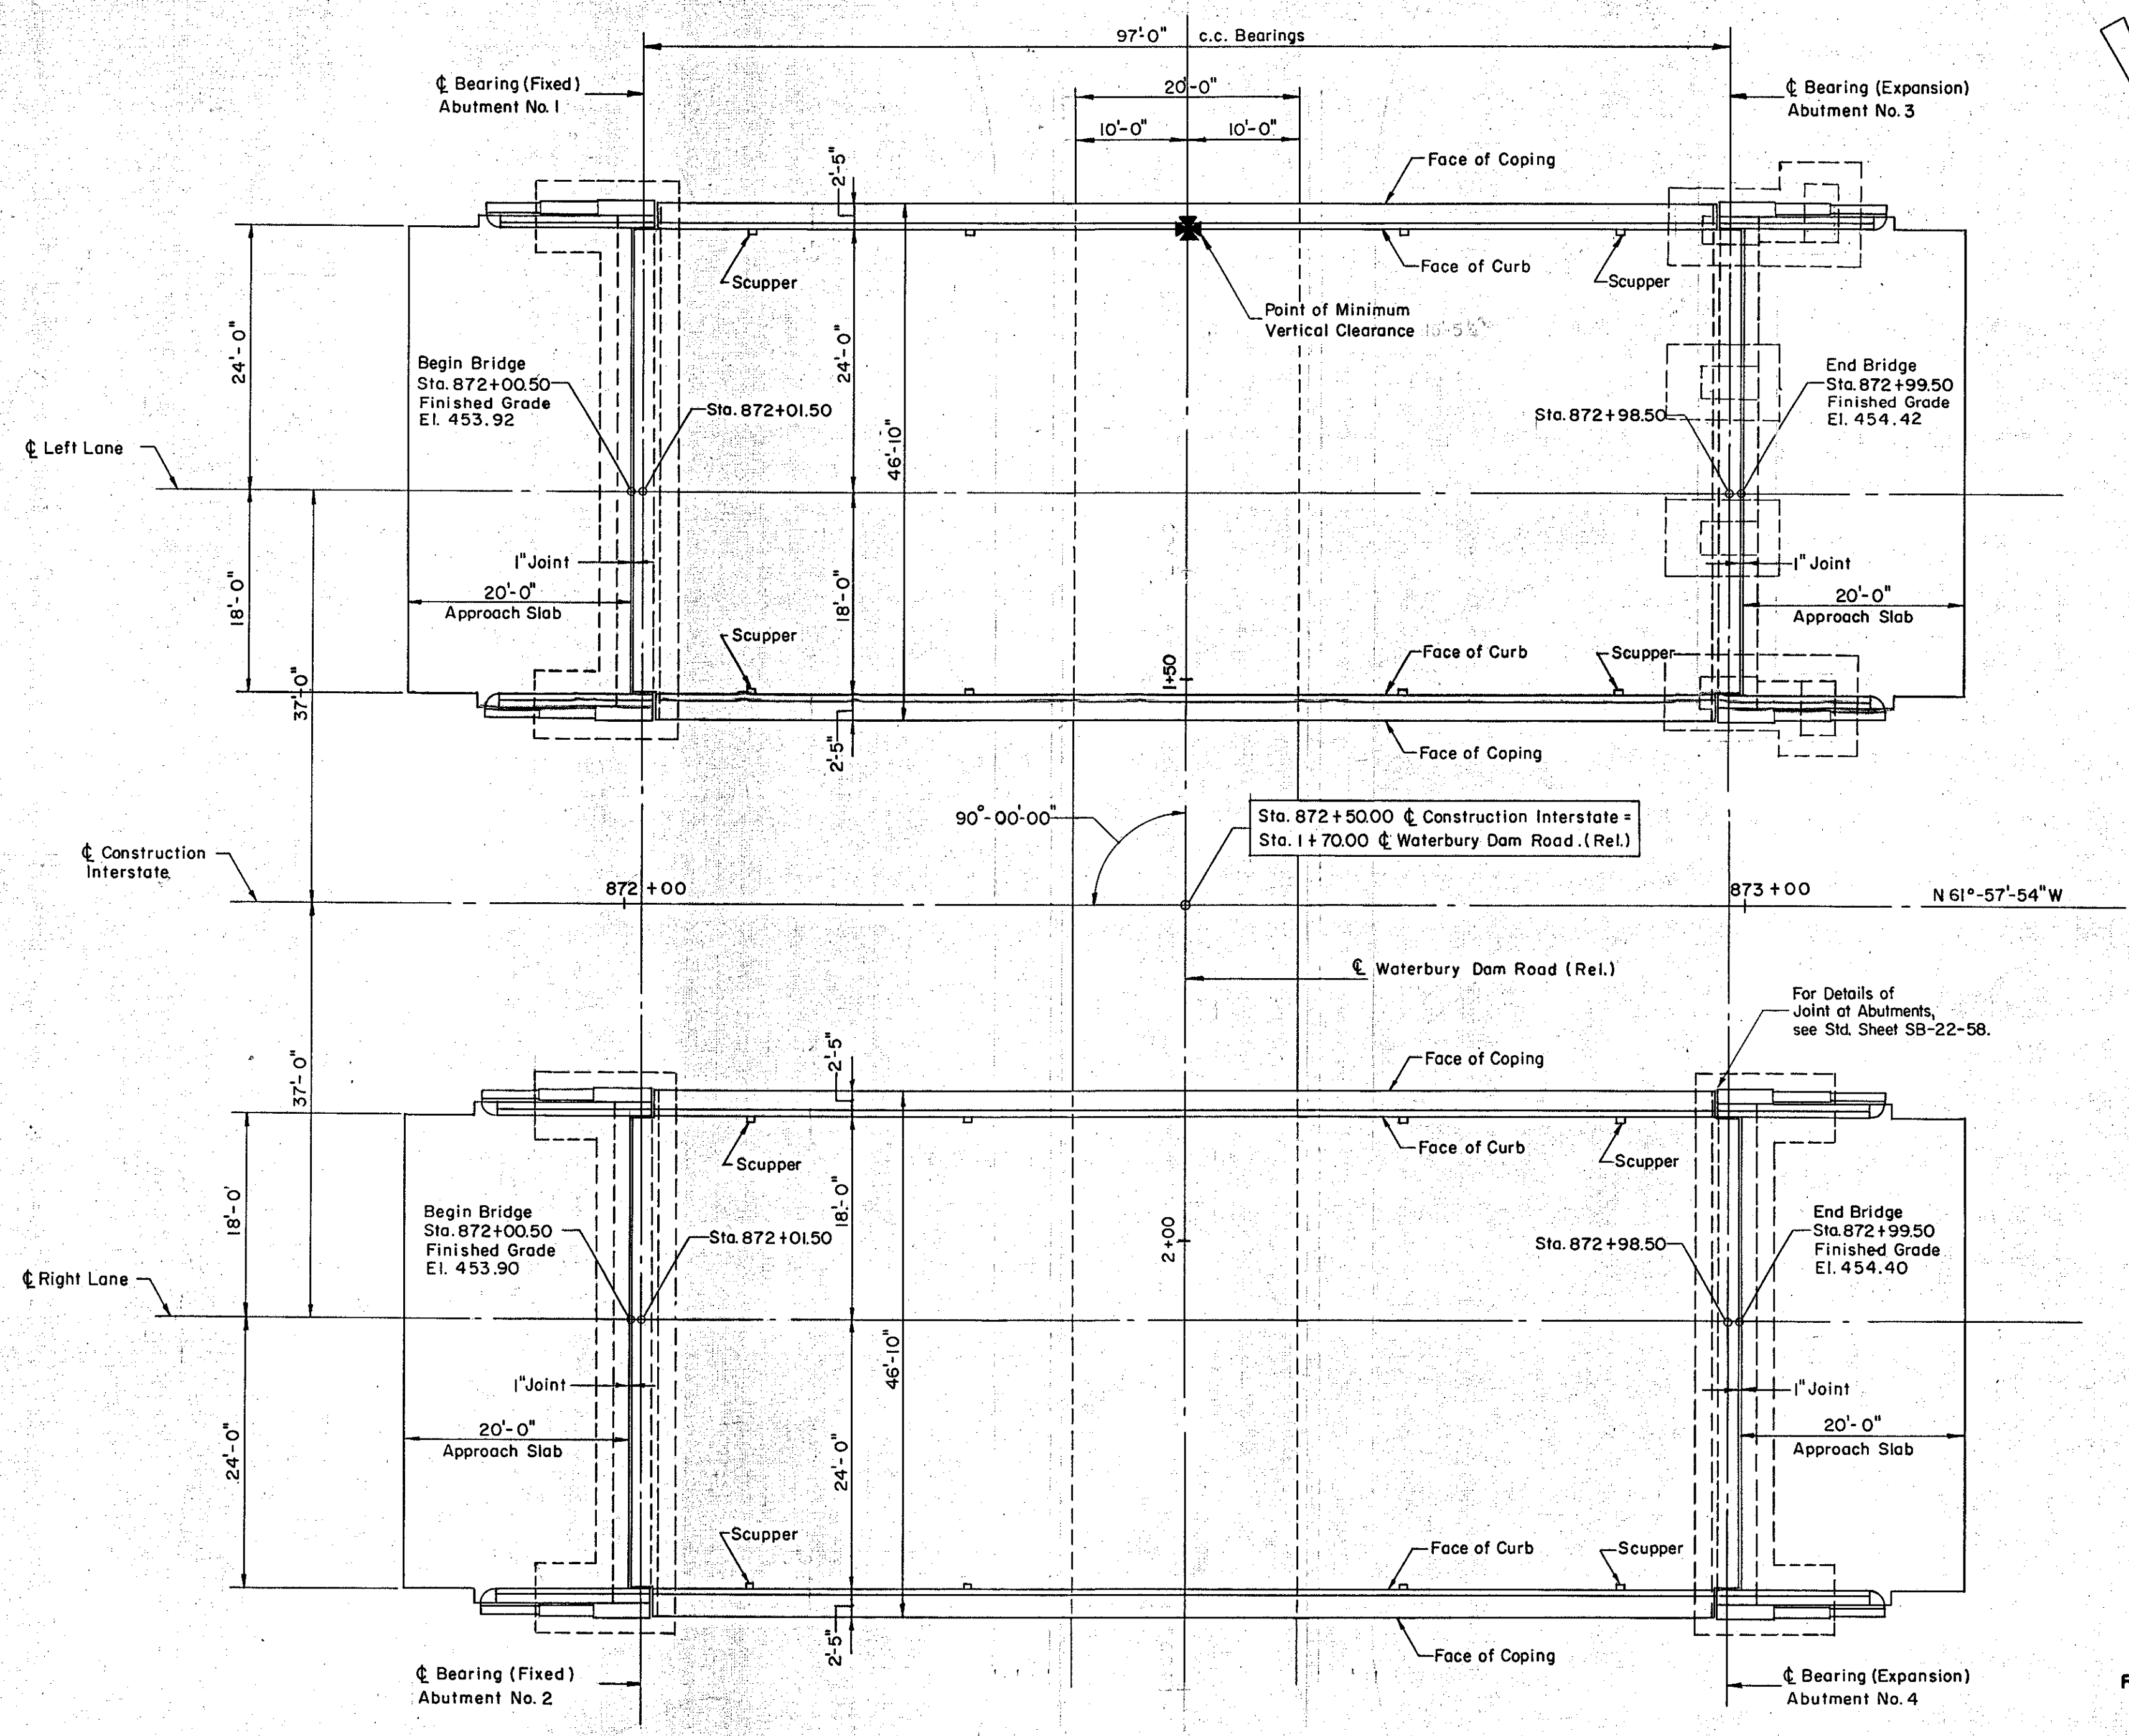

**PLAN**  
Scale:  $\frac{3}{32}'' = 1'-0''$

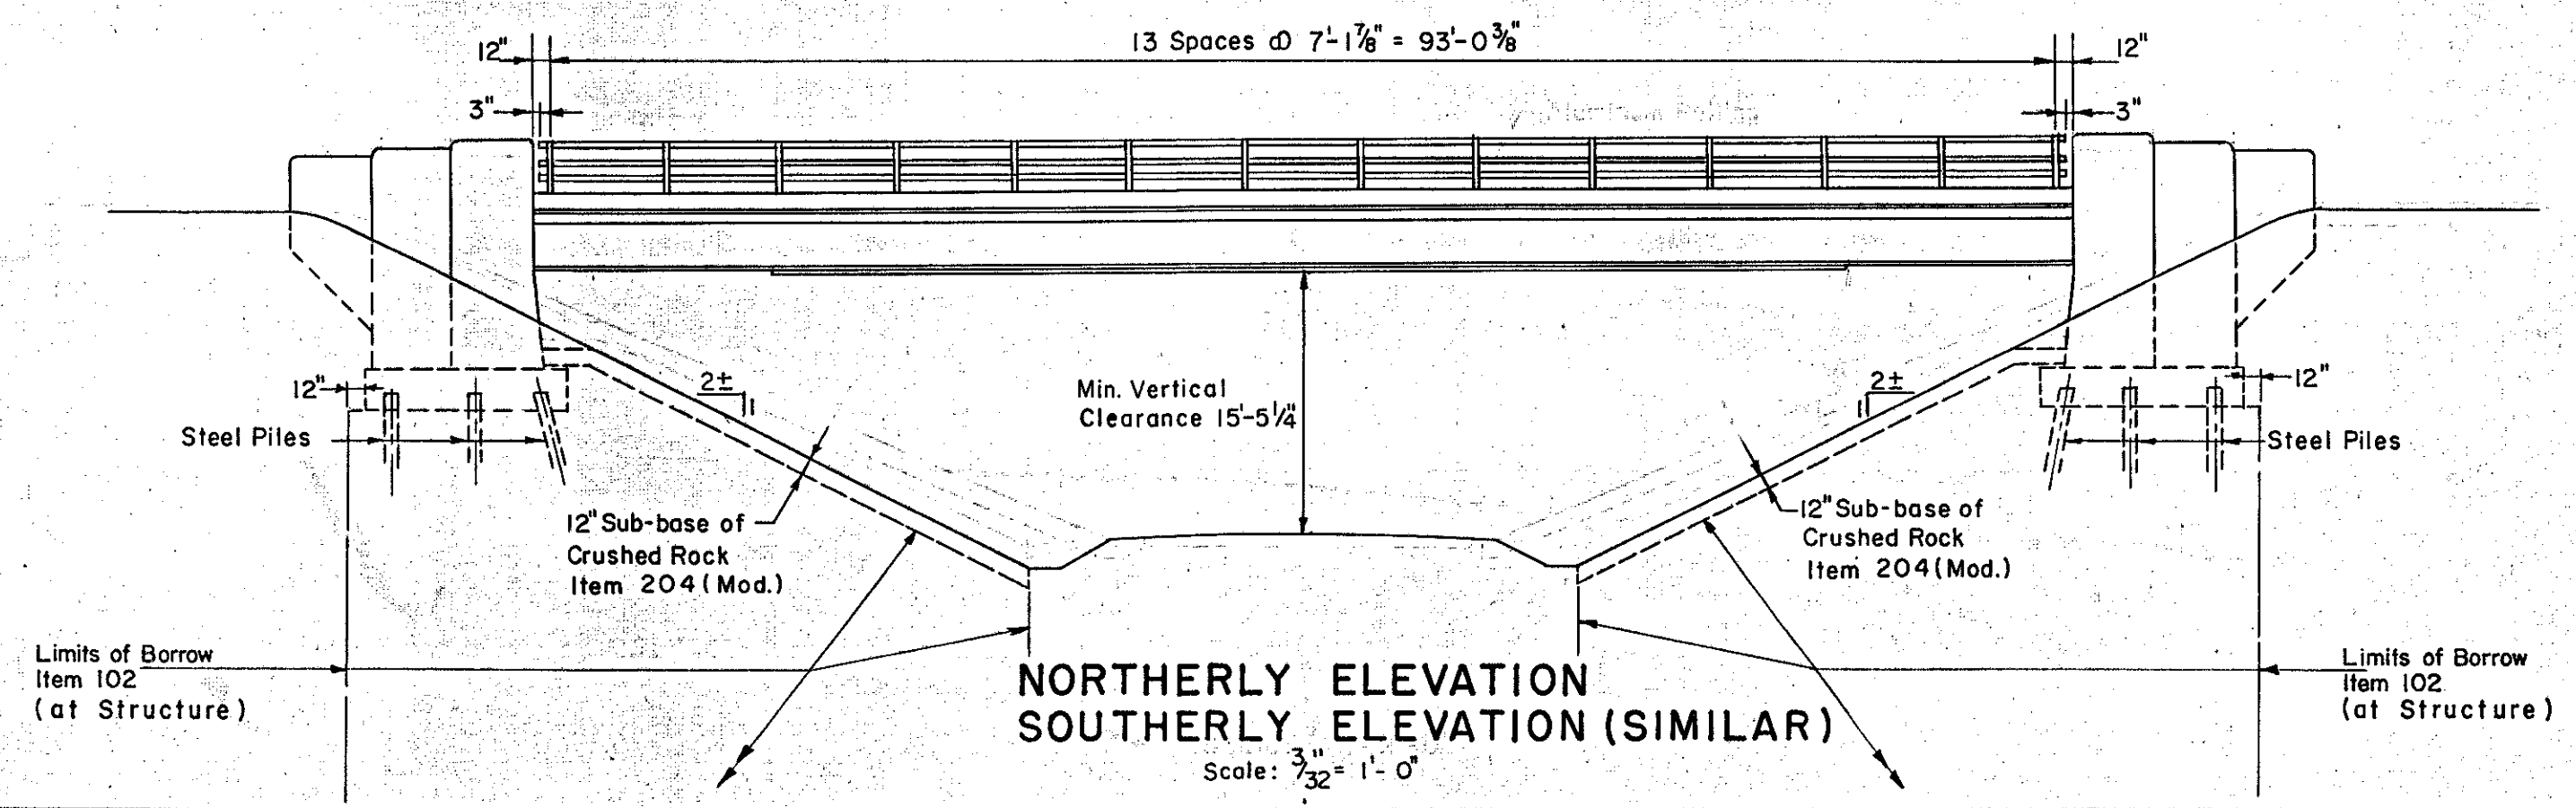

**NORTHERLY ELEVATION**  
**SOUTHERLY ELEVATION (SIMILAR)**  
Scale:  $\frac{3}{32}'' = 1'-0''$

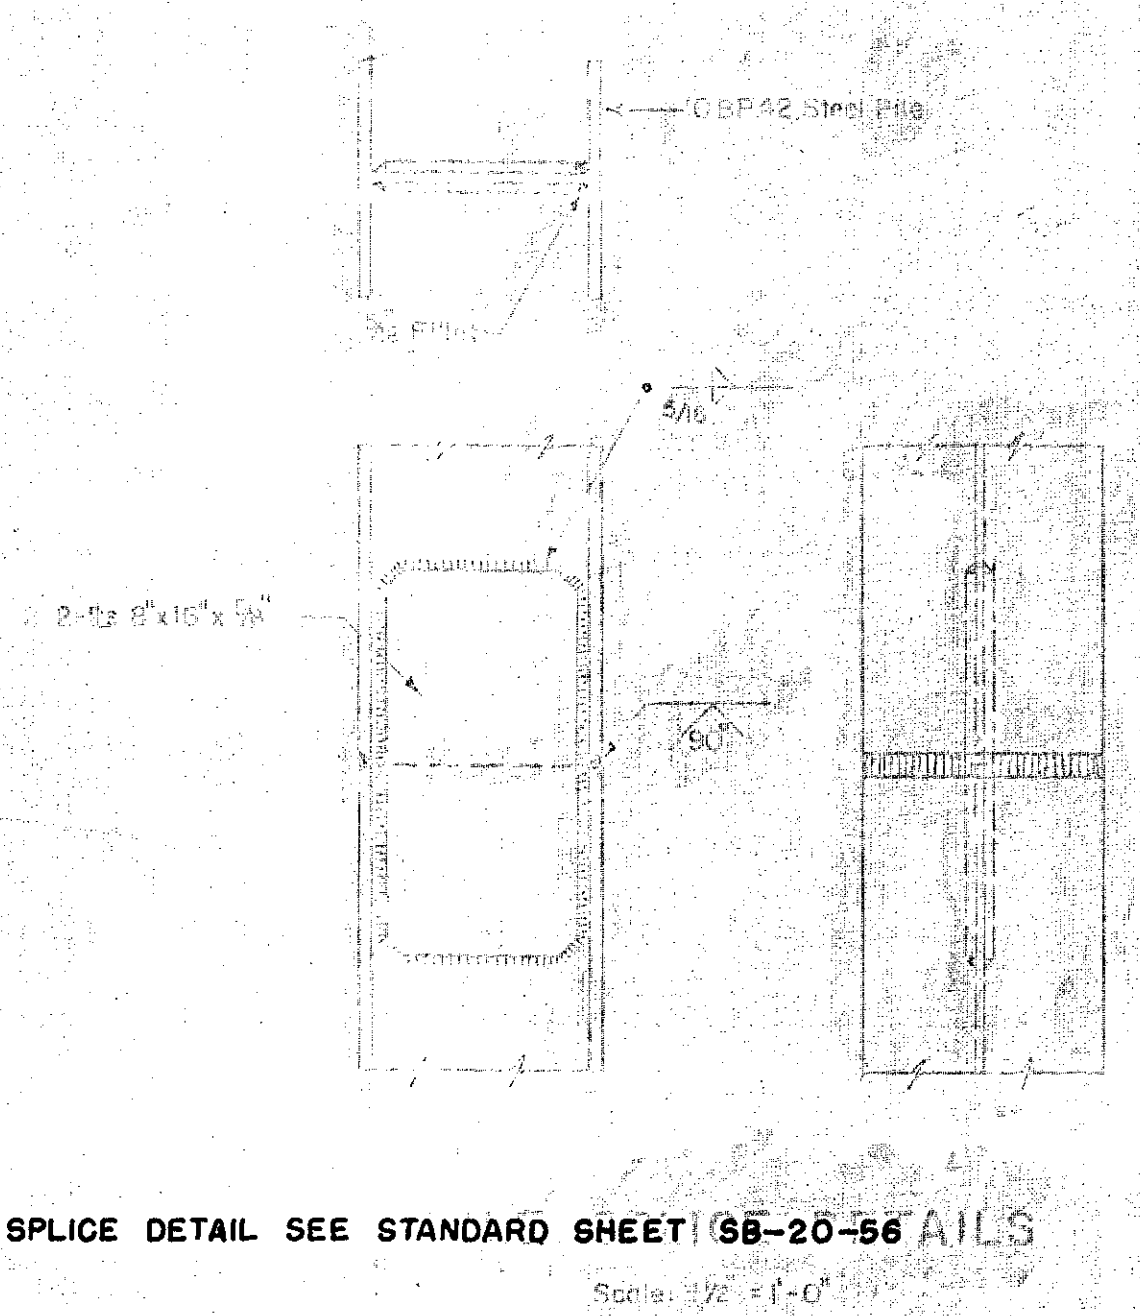

FOR PILE SPLICE DETAIL SEE STANDARD SHEET SB-20-56 A1LS

- Notes:
1. Railing Posts to be set normal to grade.
  2. For Scupper layout see Framing Plan Sheet No. 7
  3. All dimensions are horizontal dimensions.
  4. For Bridge Marker see Dwg. SB-20-56 (Detail "A")

**ESTIMATED QUANTITIES**


ITEM NO.	DESCRIPTION	UNIT	NET	OVER-RUN	TOTAL	FINAL
102	Borrow	C.Y.	10,500	+1,050	11,550	10,500
556-C	Granite Bridge Curb (Type 1)	L.F.	500	-	500	500
572	Bridge Railing	L.F.	378	-	378	378

IM 089-2(26)  
This sheet for information only  
**BR 49 N & S**


CONTRACT NO. 1

**PLAN AND ELEVATION**  
**STATE OF VERMONT**  
**DEPARTMENT OF HIGHWAYS**  
INTERSTATE PROJECT in the town of  
**WATERBURY**  
INTERSTATE OVER STA. 872+50  
WATERBURY DAM RD. (REL.) STA. 1+70  
THE CLARKESON ENGINEERING CO., INC.  
CONSULTING ENGINEERS MASSACHUSETTS  
BOSTON  
SURVEYED BY: DRAWN BY H.B.C. CHECKED BY G.B. B.D.S. IN CHARGE J.V.B. SCALE: AS NOTED DATE 6-19-58  
PROJECT NO. I-89-2(7) SHEET 239 OF 307


B.P.R. DIV. NO.	STATE	PROJECT NO.	SHEET NO.	TOTAL SHEETS
1	VT.	I-89-2 (7)	10	10

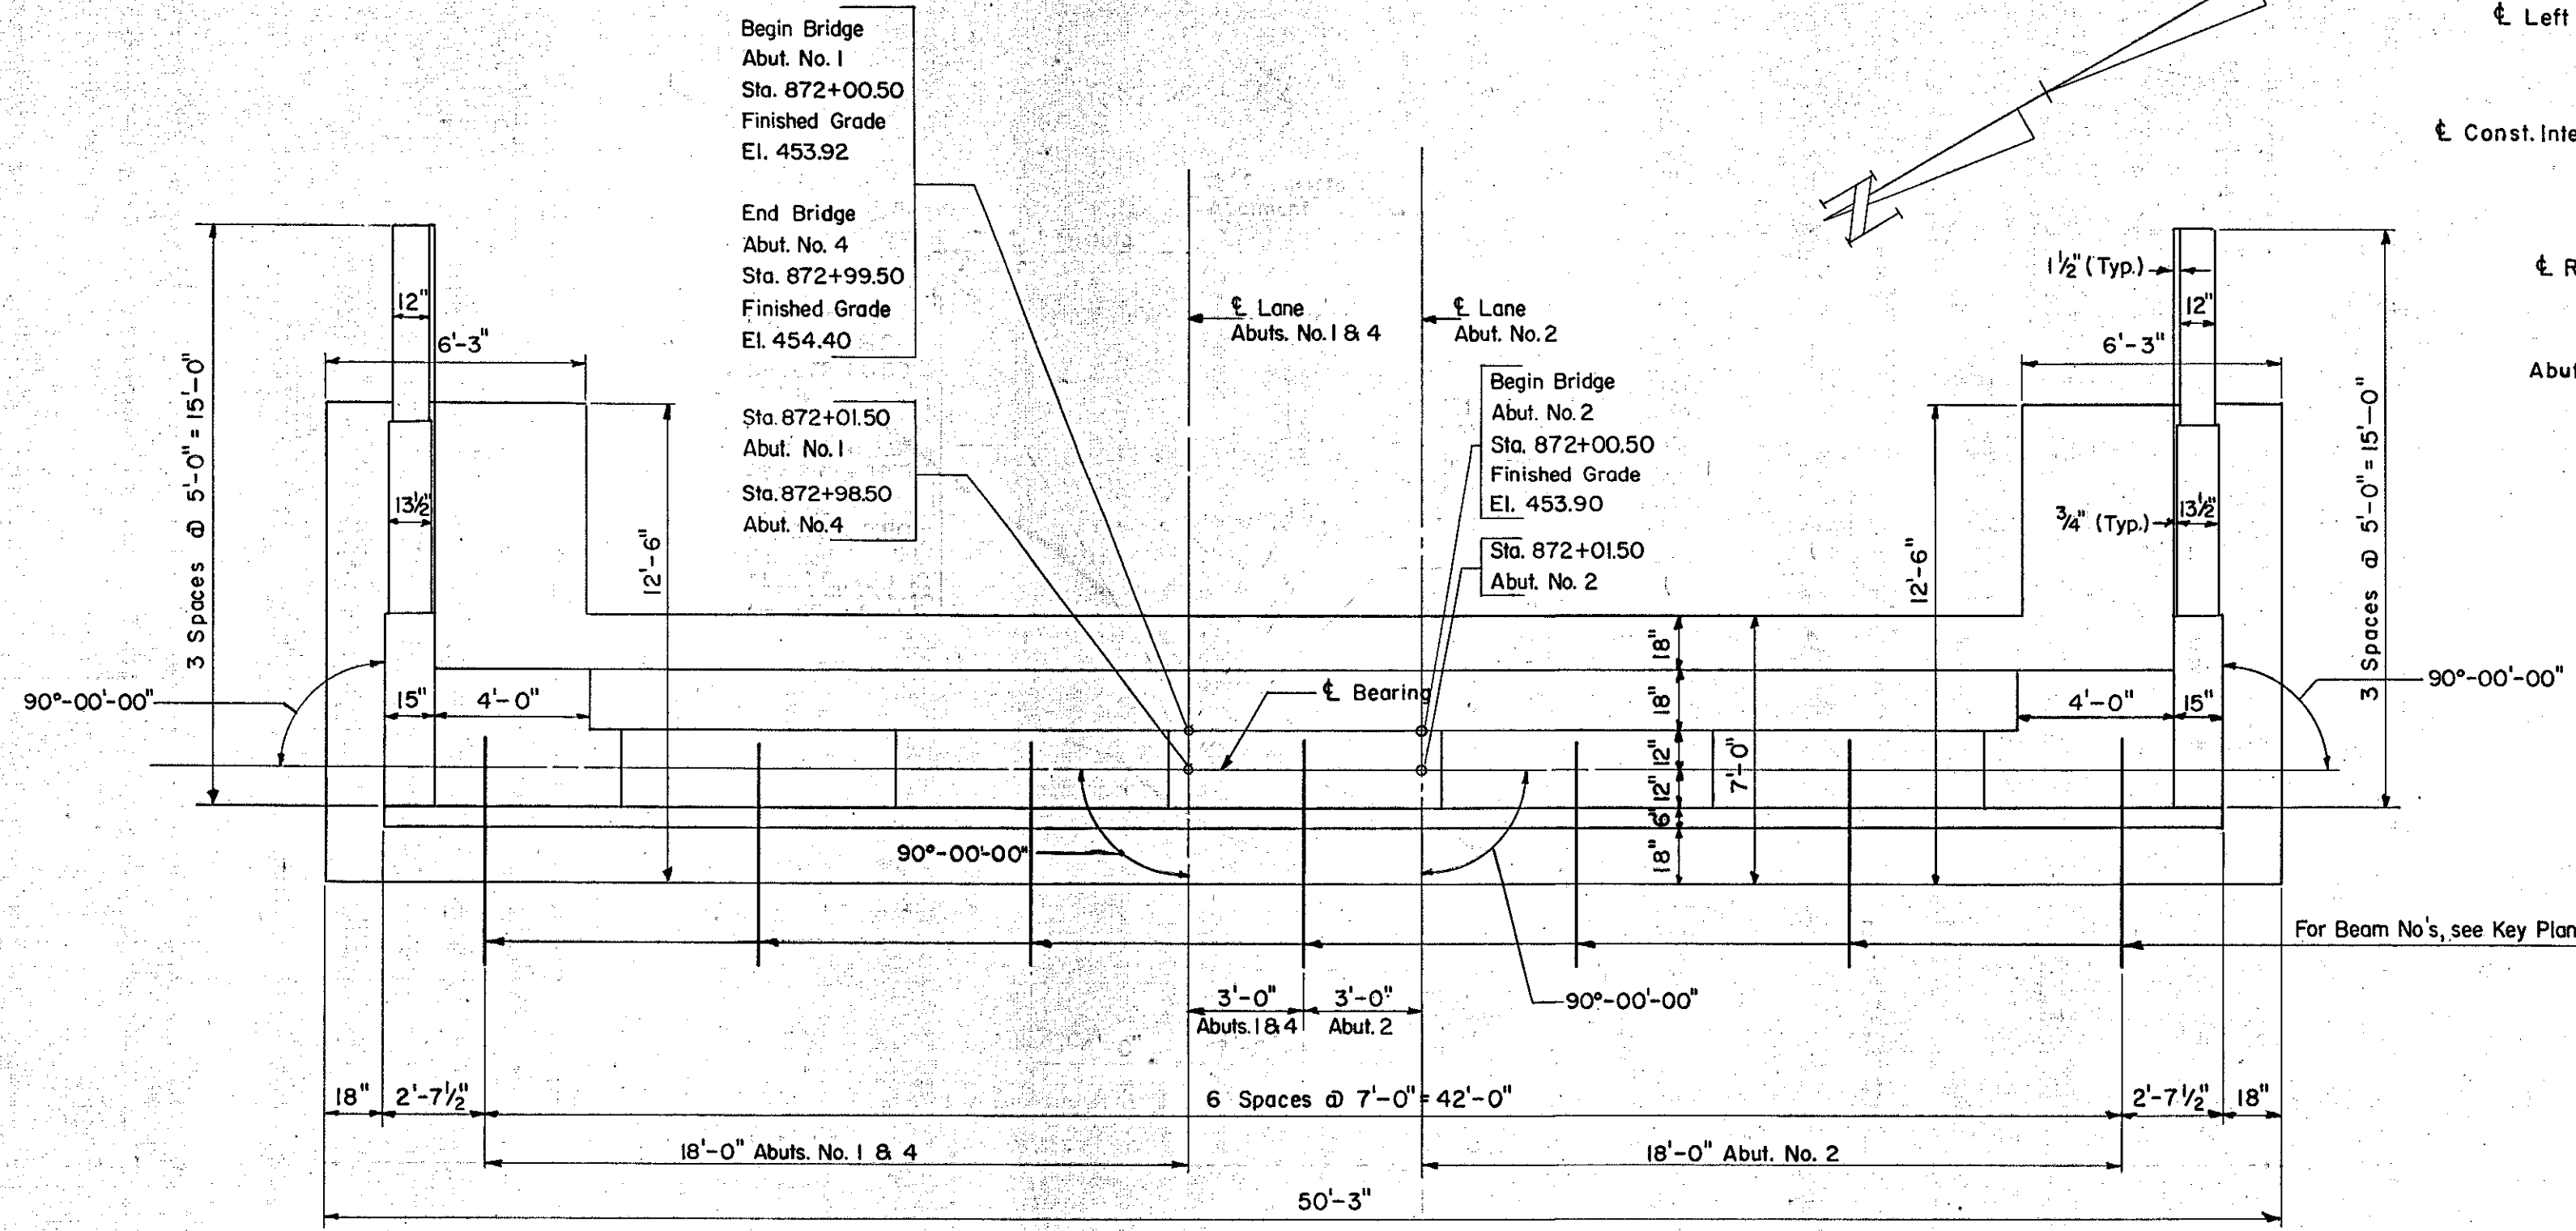


PLAN ABUTMENTS NO. 1 & 4  
ABUTMENT NO. 2 SIMILAR EXCEPT AS NOTED  
Scale: 1/4" = 1'-0"

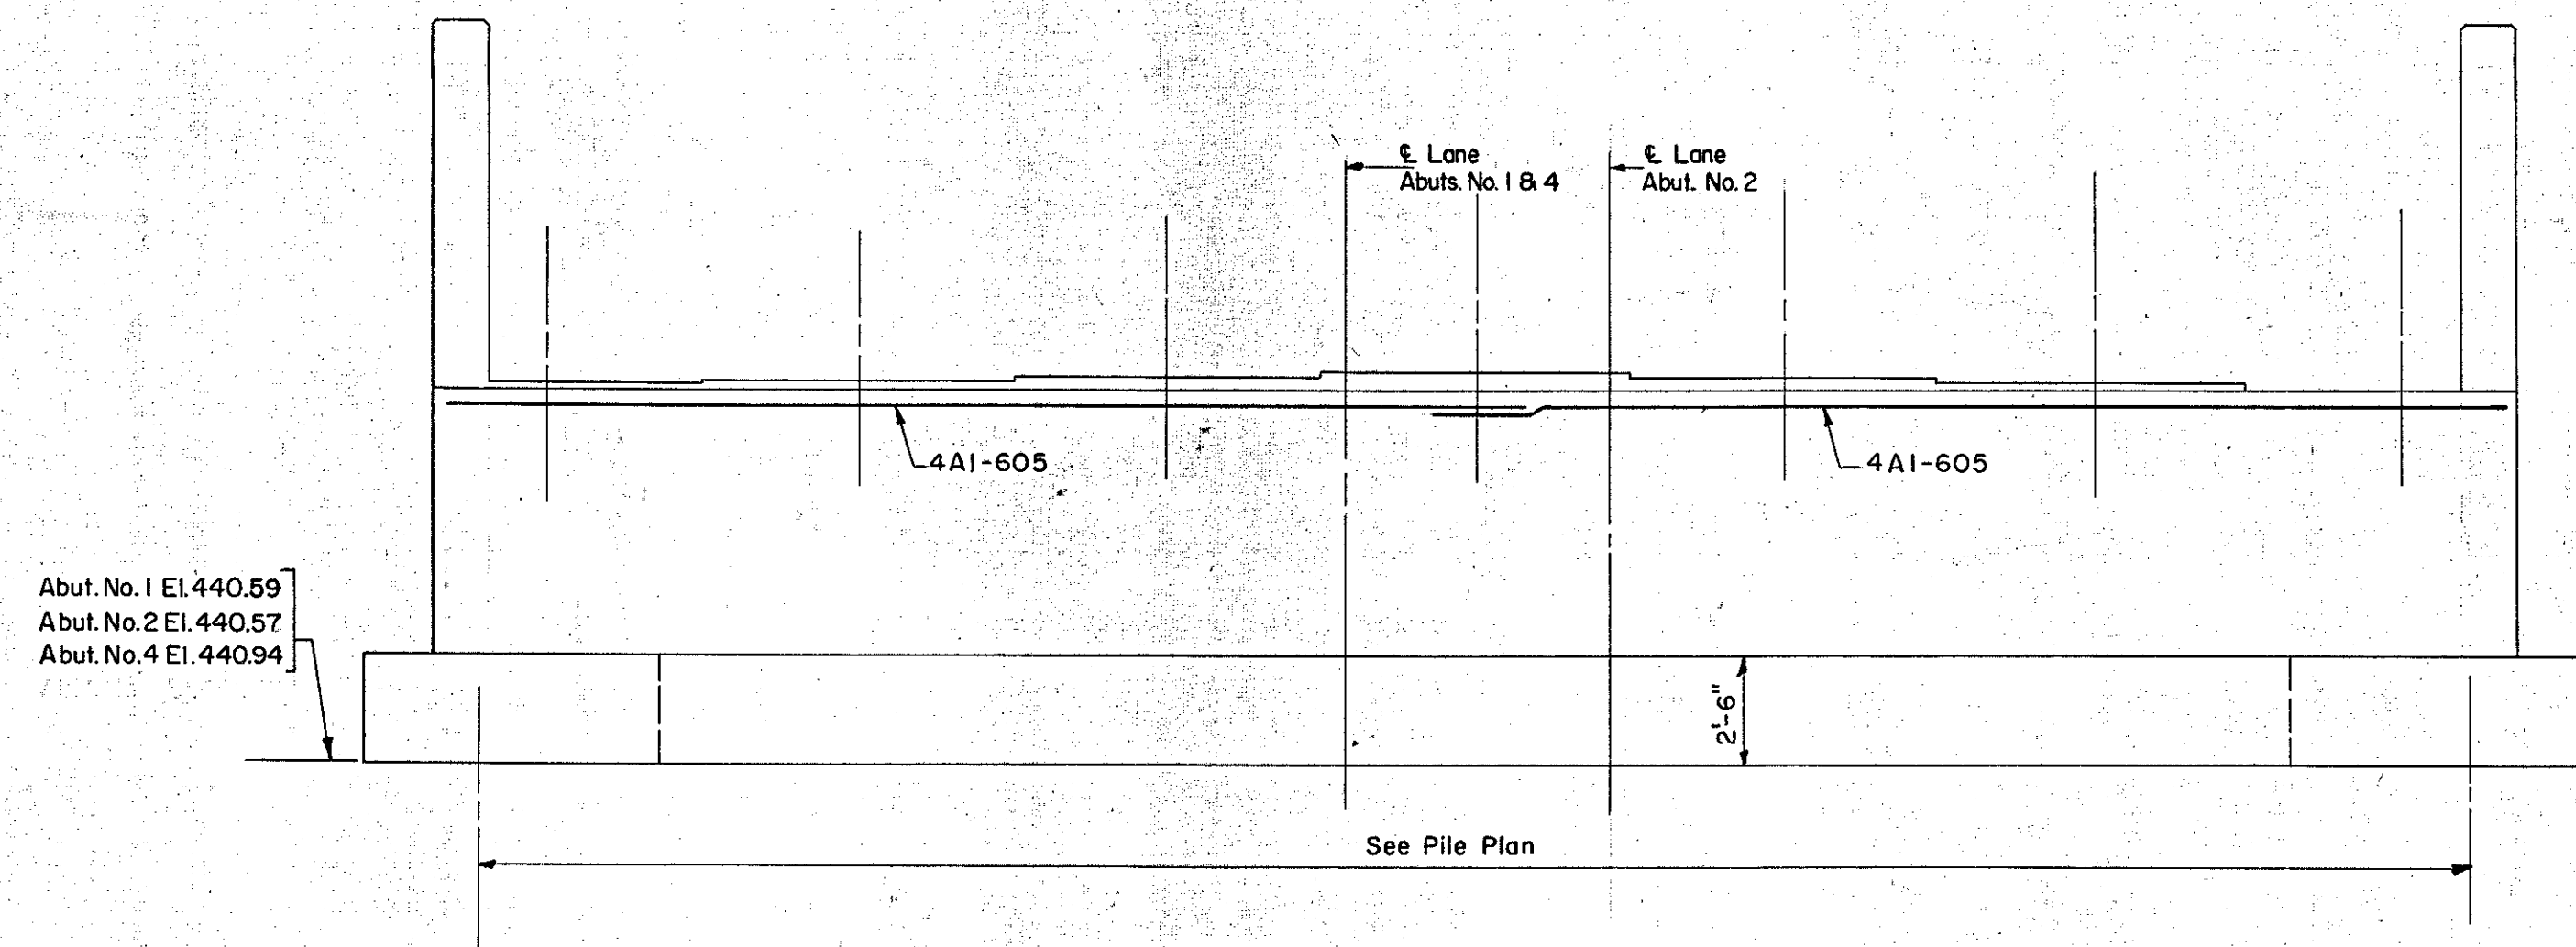

ELEVATION ABUTMENTS NO. 1 & 4  
ABUTMENT NO. 2 SIMILAR EXCEPT AS NOTED  
Scale: 1/4" = 1'-0"

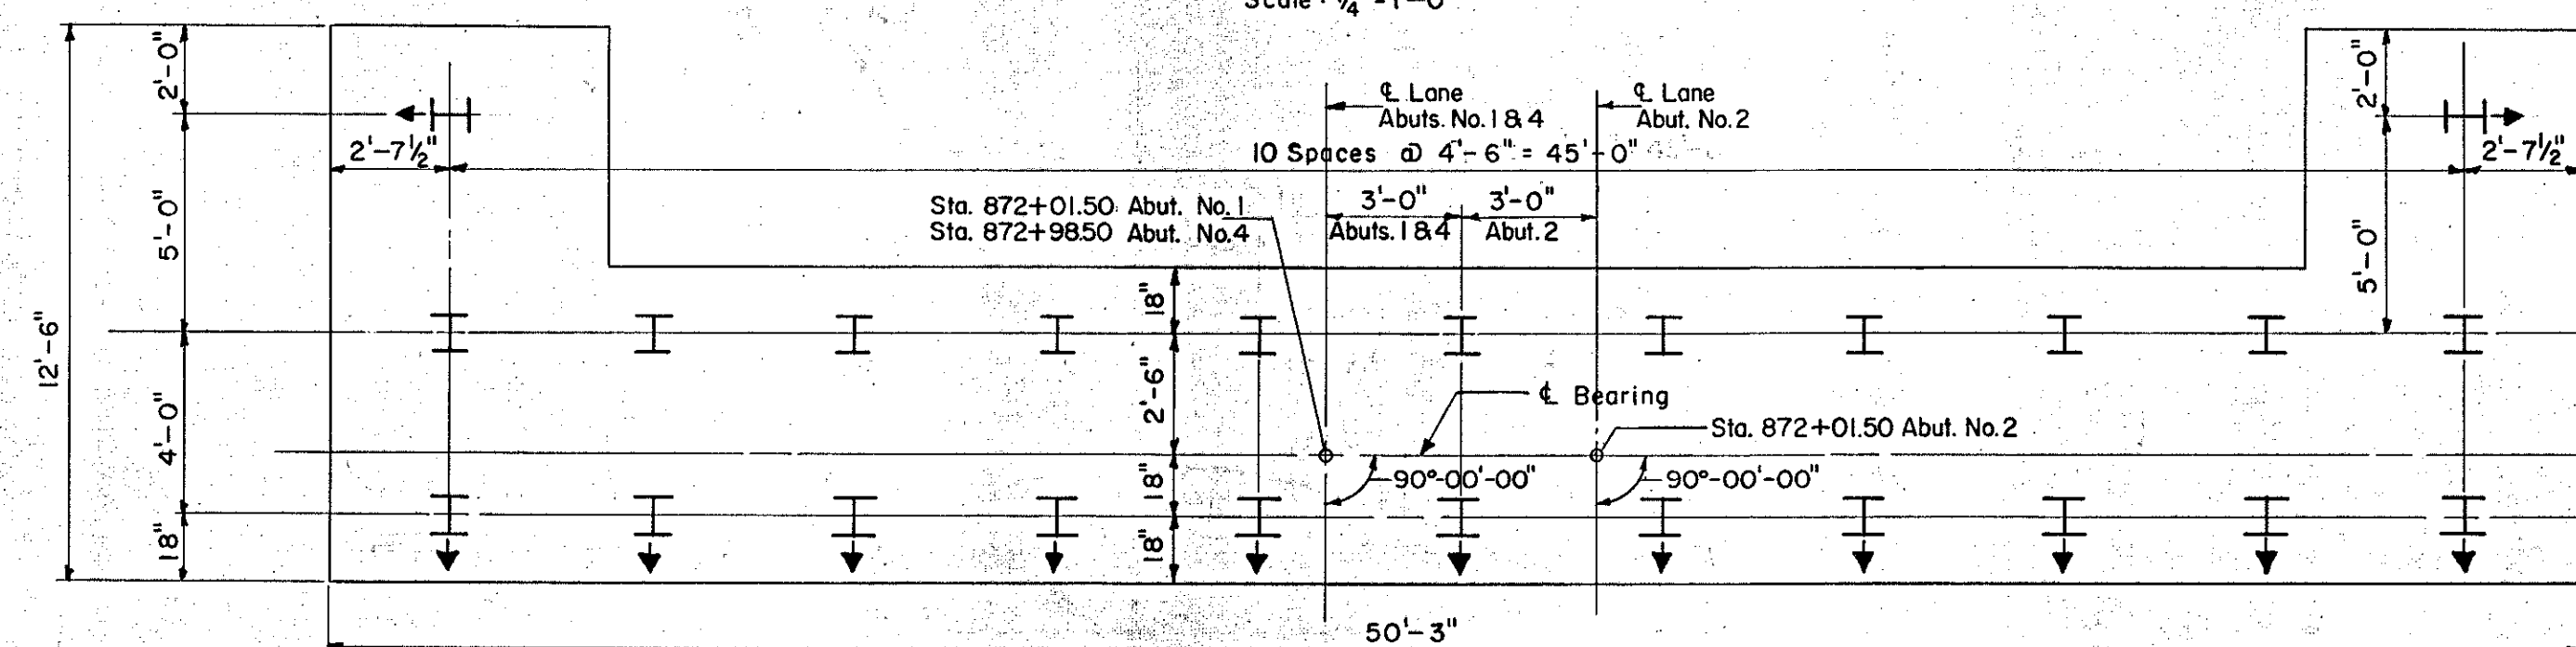


PILE PLAN ABUTMENTS NO. 1 & 4  
ABUTMENT NO. 2 SIMILAR EXCEPT AS NOTED  
Scale: 1/4" = 1'-0"

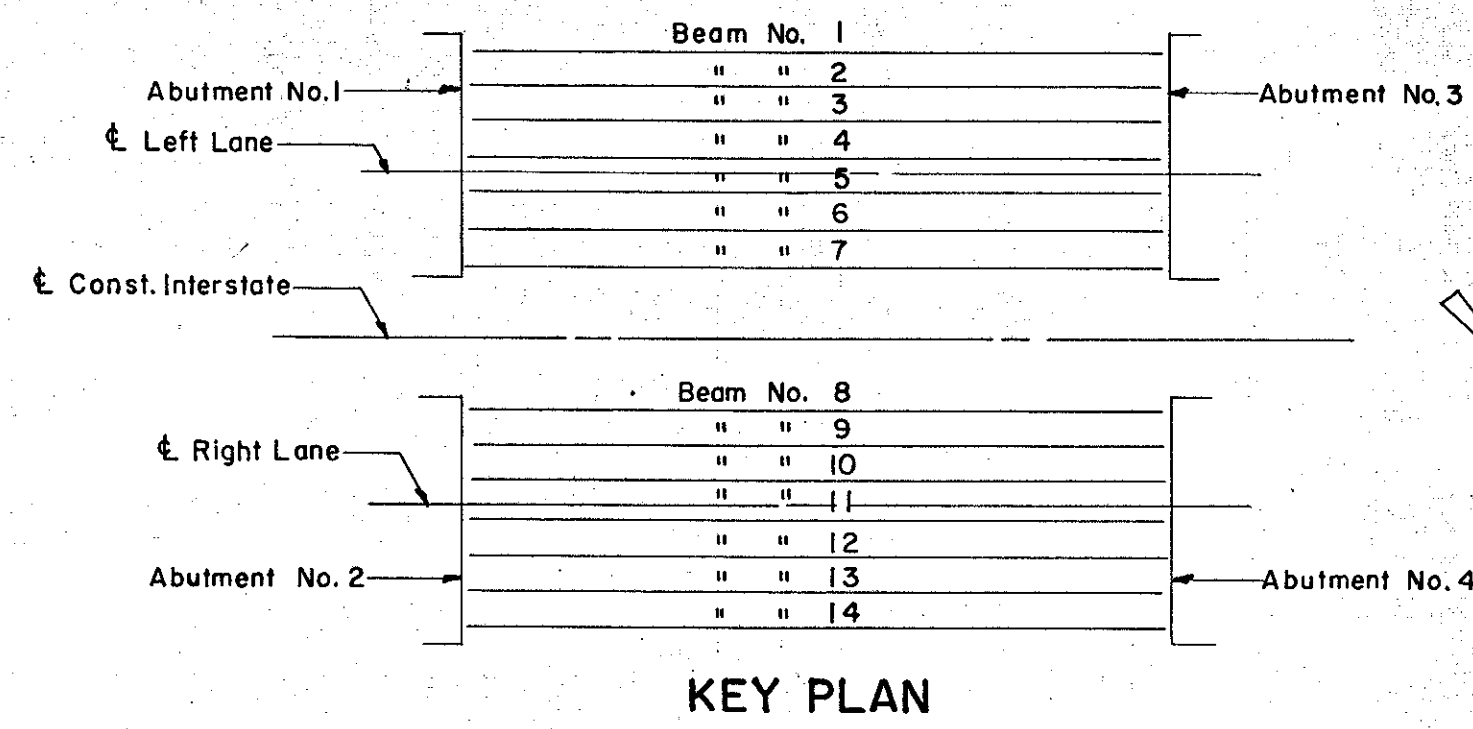

KEY PLAN

ABUTMENT NO. 1		ABUTMENT NO. 3		ABUTMENT NO. 2		ABUTMENT NO. 4	
Beam No.	Elev.	Beam No.	Elev.	Beam No.	Elev.	Beam No.	Elev.
1	448.98	1	449.35	8	449.09	8	449.46
2	449.13	2	449.50	9	449.24	9	449.61
3	449.27	3	449.64	10	449.32	10	449.69
4	449.36	4	449.72	11	449.33	11	449.70
5	449.34	5	449.71	12	449.25	12	449.62
6	449.26	6	449.63	13	449.11	13	449.48
7	449.11	7	449.48	14	448.96	14	449.33

MASONRY SHELF ELEVATIONS

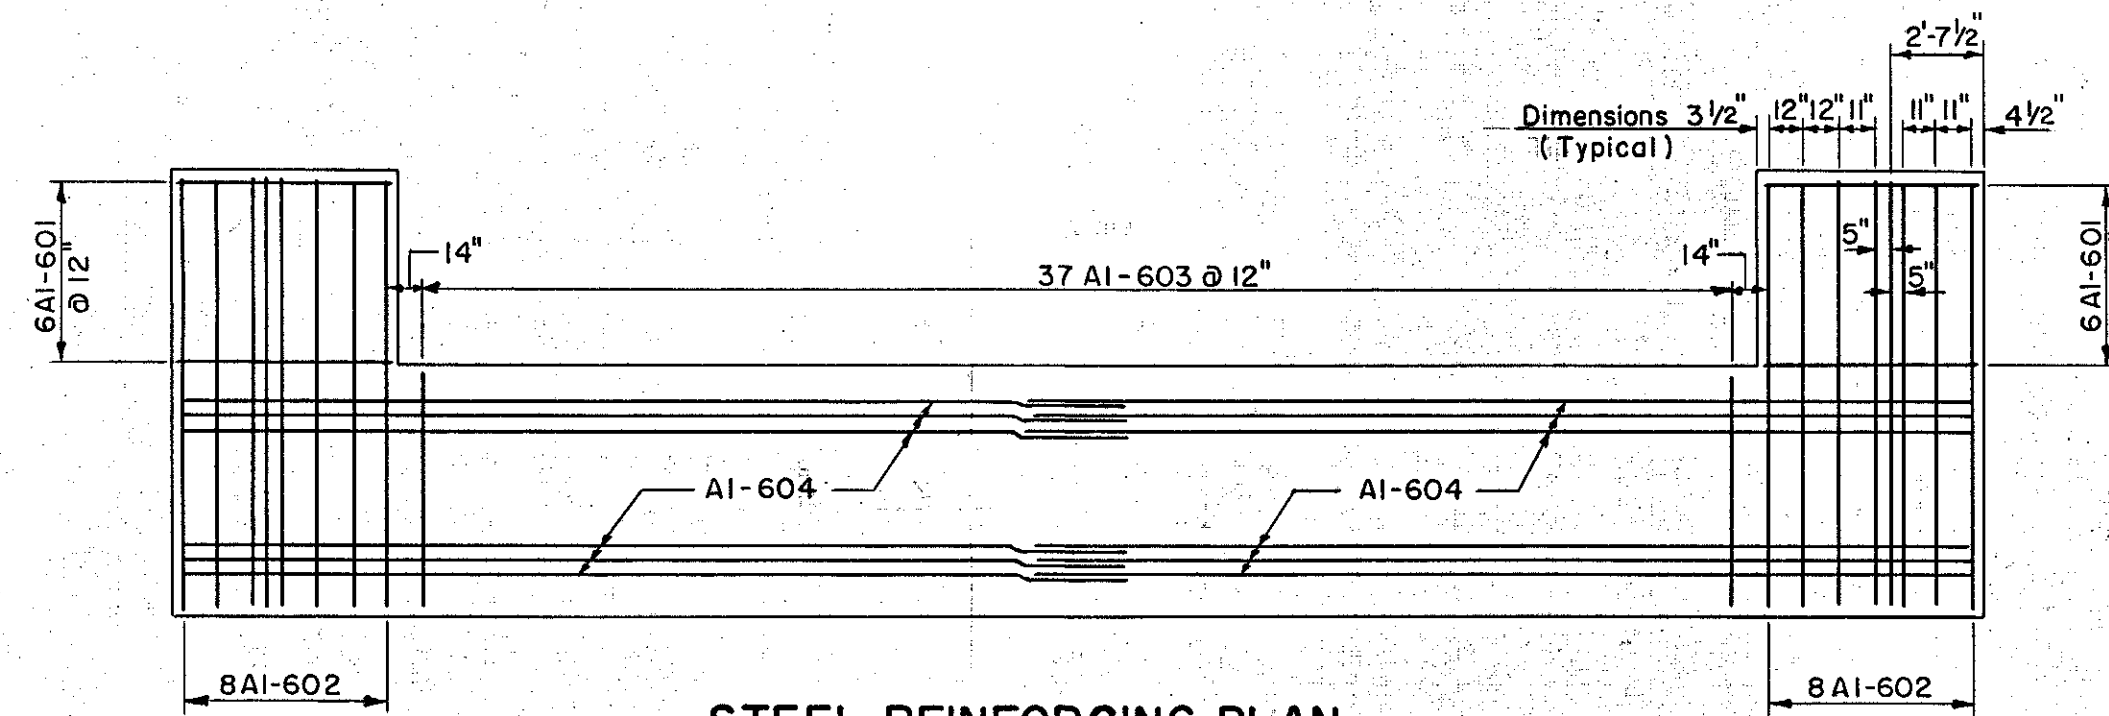

STEEL REINFORCING PLAN  
ABUTMENTS 1, 2 AND 4


Note: Reinforcing in Abutments 2 and 4 to be prefixed A2 and A4 respectively.

ITEM NO.	DESCRIPTION	UNIT	ABUTMENT NO. 1				ABUTMENT NO. 2					
			NET	OVER-RUN	TOTAL	FINAL	NET	OVER-RUN	TOTAL	FINAL		
107	Structure Excavation	C.Y.	21	✓	-2	-23	21	✓	-2	-23	21	✓
204	Sub-base of Crushed Rock (Mod.)	C.Y.	-66	✓	-10	-76	-66	✓	-10	-76	-66	✓
222	Gravel Backfill	C.Y.	37	✓	+0	37	37	✓	+0	37	37	✓
401-B	Concrete Class "B" (Mod.)	C.Y.	87	✓	-4	87	87	✓	-4	87	87	✓
402	Reinforcing Steel	Lbs.	See Reinforcing Schedule Sheet No. 8									
407	Asphaltic-Asbestos Coating	S.Y.	-5	✓	-	-5	-5	✓	-	-5	-5	✓
504	Steel Piling	L.F.	+152	✓	-	152	+368	✓	-	368	368	✓

ESTIMATED QUANTITIES

ITEM NO.	DESCRIPTION	UNIT	ABUTMENT NO. 3				ABUTMENT NO. 4					
			NET	OVER-RUN	TOTAL	FINAL	NET	OVER-RUN	TOTAL	FINAL		
107	Structure Excavation	C.Y.	-50	✓	-5	-55	21	✓	-2	-23	21	✓
204	Sub-base of Crushed Rock (Mod.)	C.Y.	-66	✓	-10	-76	-66	✓	-10	-76	-66	✓
222	Gravel Backfill	C.Y.	19	✓	-5	14	37	✓	+0	37	37	✓
401-B	Concrete Class B (Mod.)	C.Y.	+18	✓	-6	12	87	✓	-4	87	87	✓
402	Reinforcing Steel	Lbs.	See Reinforcing Schedule Sheet No. 8									
407	Asphaltic-Asbestos Coating	S.Y.	-5	✓	-	-5	-5	✓	-	-5	-5	✓
504	Steel Piling	L.F.	+152	✓	-	152	+480	✓	-	480	480	✓

ESTIMATED QUANTITIES

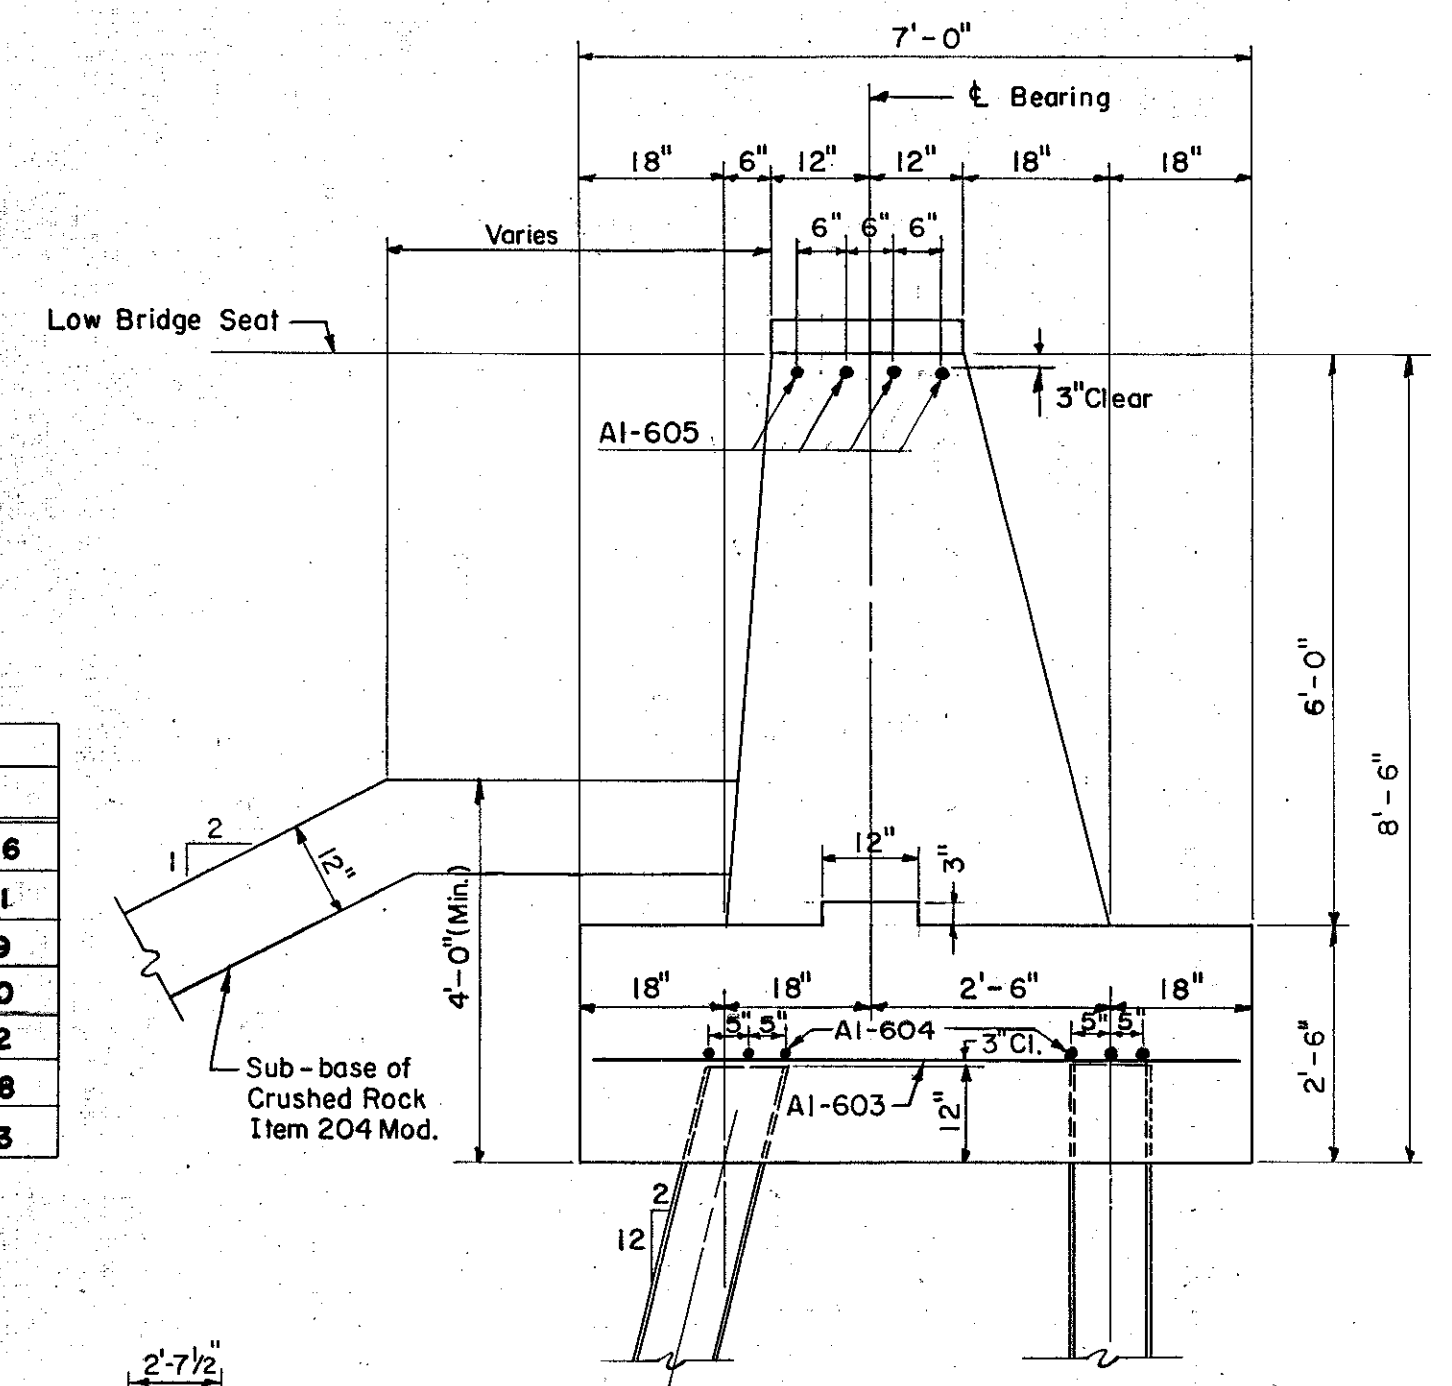

TYPICAL SECTION ABUTMENTS 1, 2 & 4  
Scale: 1/2" = 1'-0"

- Beam seat elevations are to top of concrete.
- For Typical Elevation of Wing walls, see Sheet No. 6.
- Steel piles to be IOBP-42, 35 Ton design Load. Vertical piles indicated thus  $\perp$ . Battered piles indicated thus  $\perp$ .
- For Limits of Gravel Backfill see Sheet No. 6.
- Prior to driving piles, rock free fill shall be placed, under the abutment to approximately the pile cut-off elevation and with a surface area of at least 2 (two) feet outside the abutment area. After the piles are driven the fill shall be excavated to the elevation of the bottom of footing.
- Slope area between bridge seats 1/4" per ft. Entire exposed surface of the Bridge Seat to be covered with 1/2" Asphaltic-Asbestos Coating after superstructure is in place.
- A layer of Sub-Base of Crushed Rock (Mod.) Item 204, one (1) foot thick, 38 feet long shall be placed on the slope of all abutments. The edges of this area to be in line with the outside of the end posts and parallel to the centerline of roadway.
- For estimating purposes the length of steel piles is assumed to be 48' for Abutment No. 1, 57' for Abutment No. 2 and 20' (average) for Abutment No. 4.
- All piles shall be driven thru the fill, into the original ground and to refusal.

IM 089-2(26)  
This sheet for information only  
**BR 49 N & S**


CONTRACT NO. 1

ABUTMENTS NO. 1, 2 AND 4  
STATE OF VERMONT  
DEPARTMENT OF HIGHWAYS


INTERSTATE PROJECT in the town of  
**WATERBURY**  
INTERSTATE OVER STA. 872+50  
WATERBURY DAM RD. (REL.) STA. 1+70

THE CLARKESON ENGINEERING CO., INC.  
CONSULTING ENGINEERS MASSACHUSETTS  
BOSTON  
SURVEYED BY: J.V.B. CHECKED BY: G.B.D.S. SCALE AS NOTED  
DRAWN BY: A.R.C. IN CHARGE DATE 6-19-58  
PROJECT NO. I-89-2(7) SHEET 1 240 OF 307


B.P.R. DIV. NO.	STATE	PROJECT NO.	SHEET NO.	TOTAL SHEETS
I	VT.	I-89-2(7)	105	220

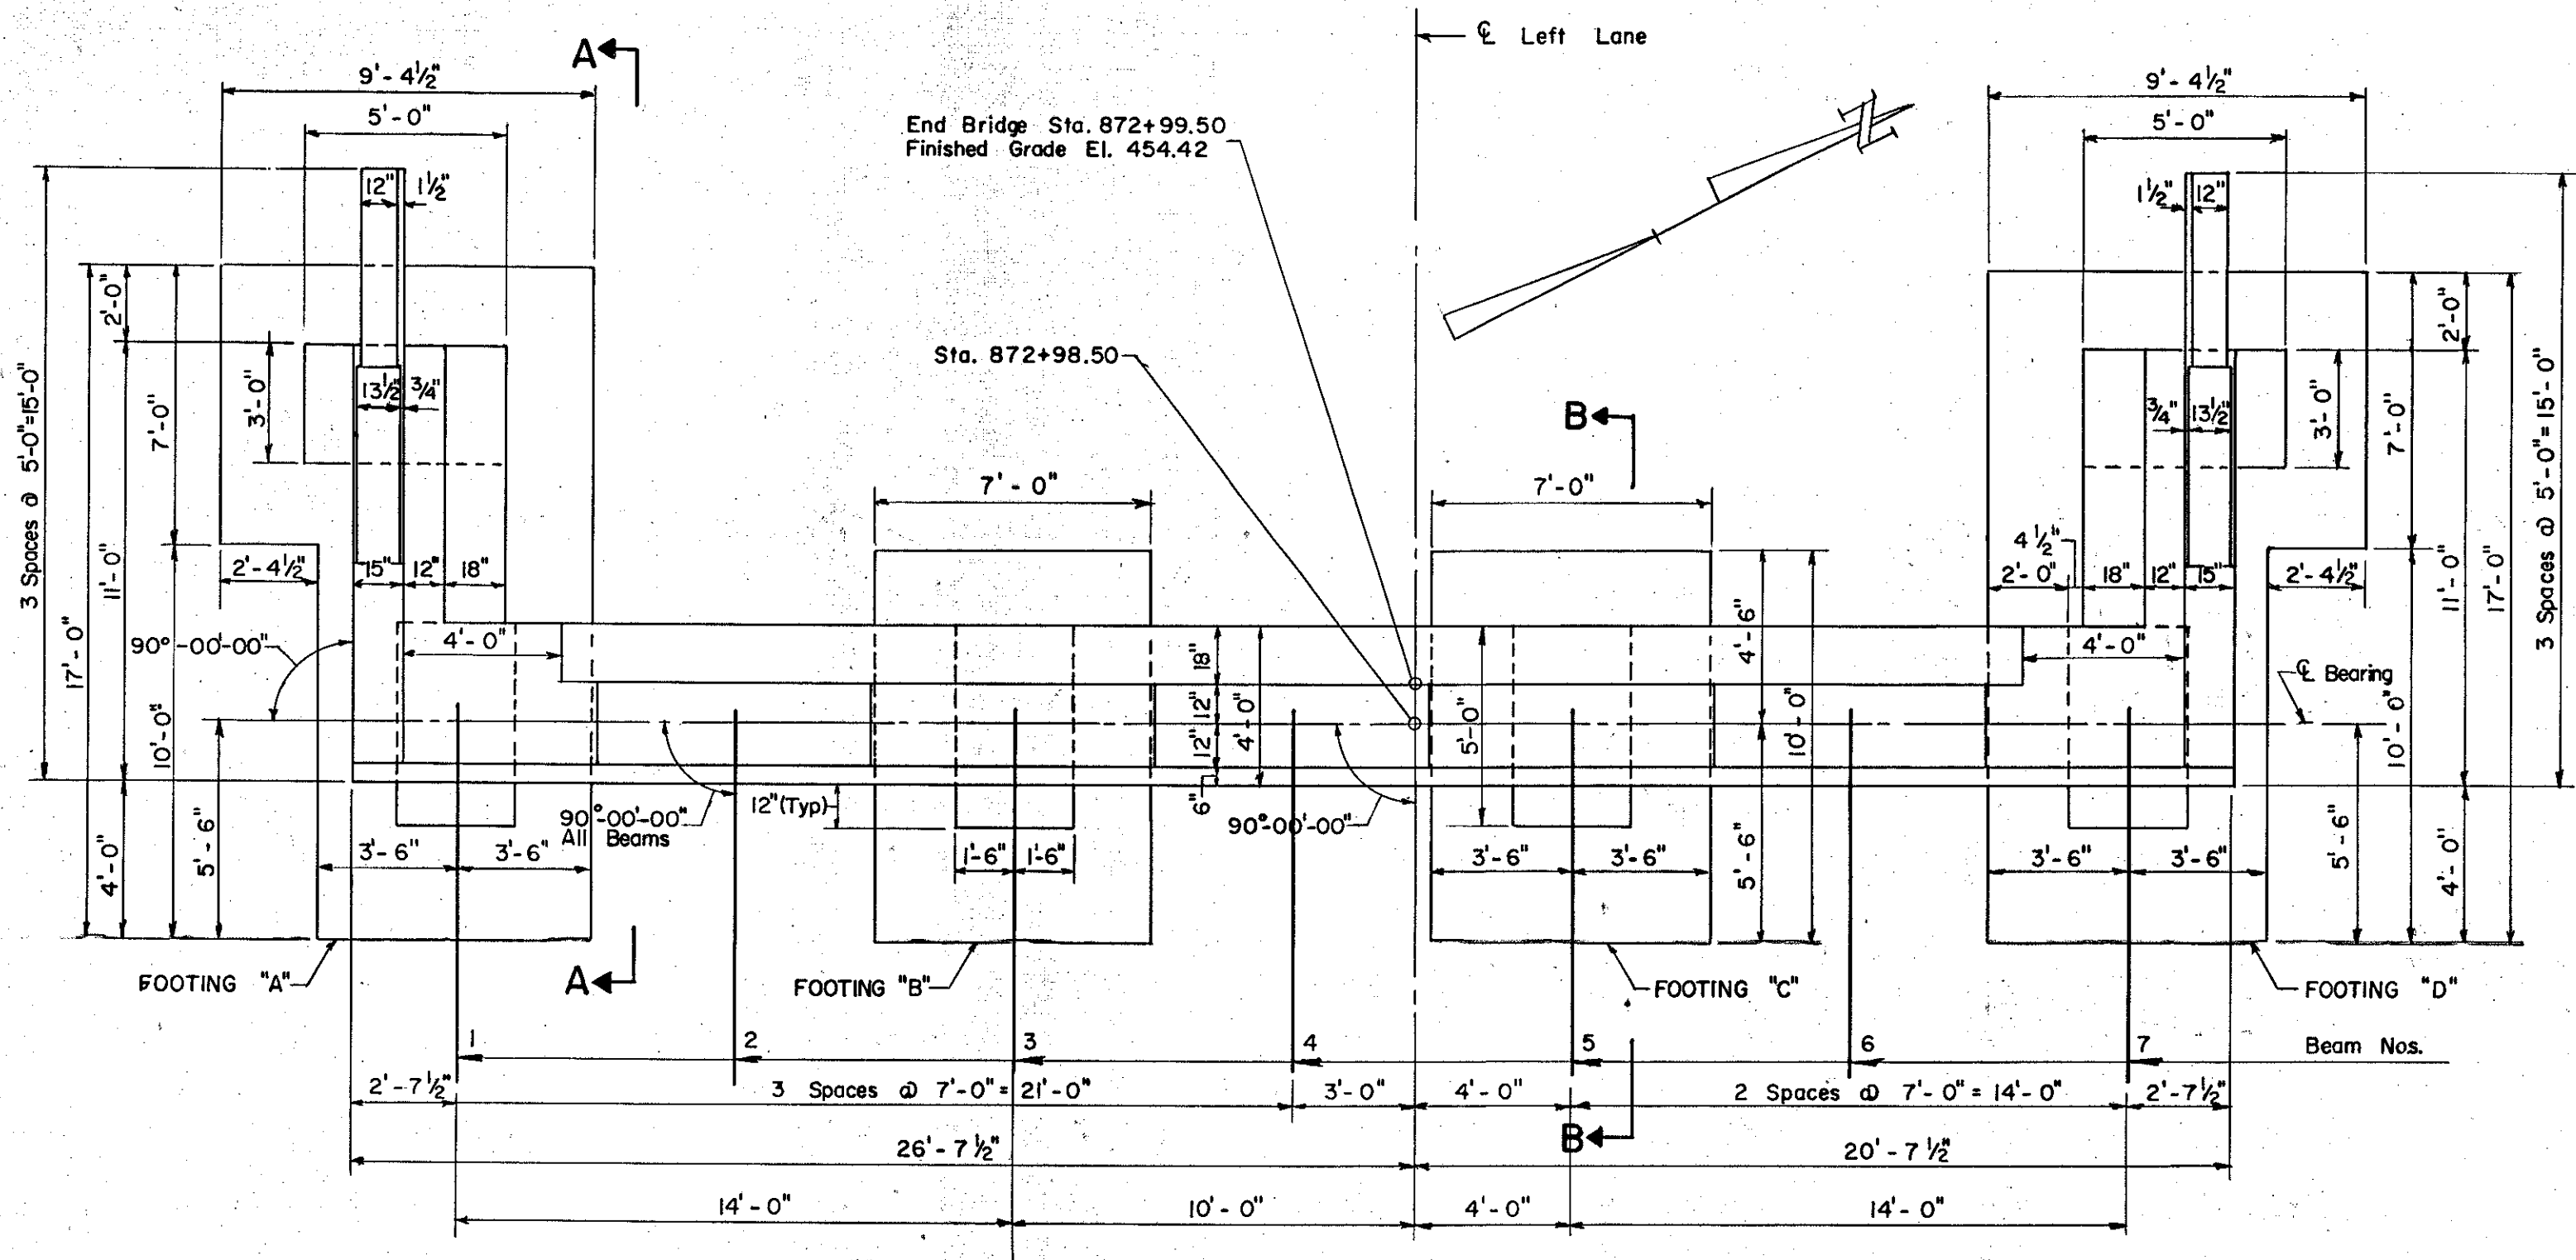


PLAN ABUTMENT NO. 3  
Scale: 1/4" = 1'-0"

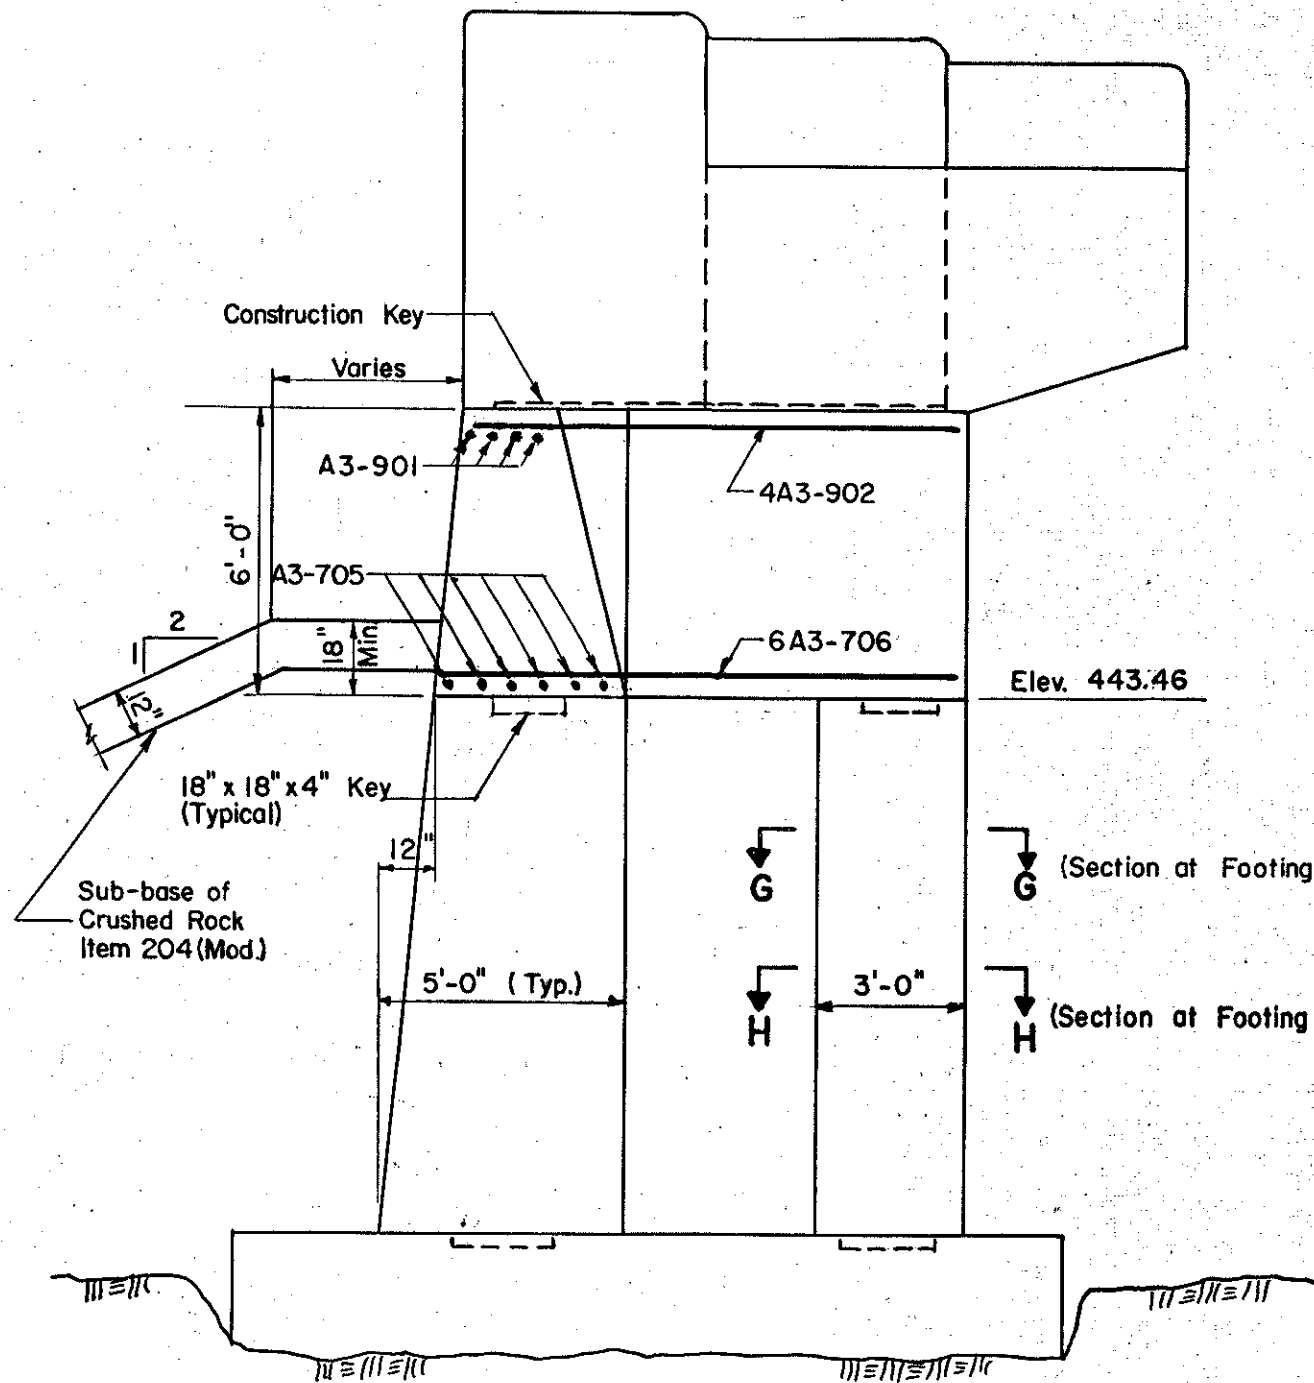


SECTION A-A  
Scale: 1/4" = 1'-0"

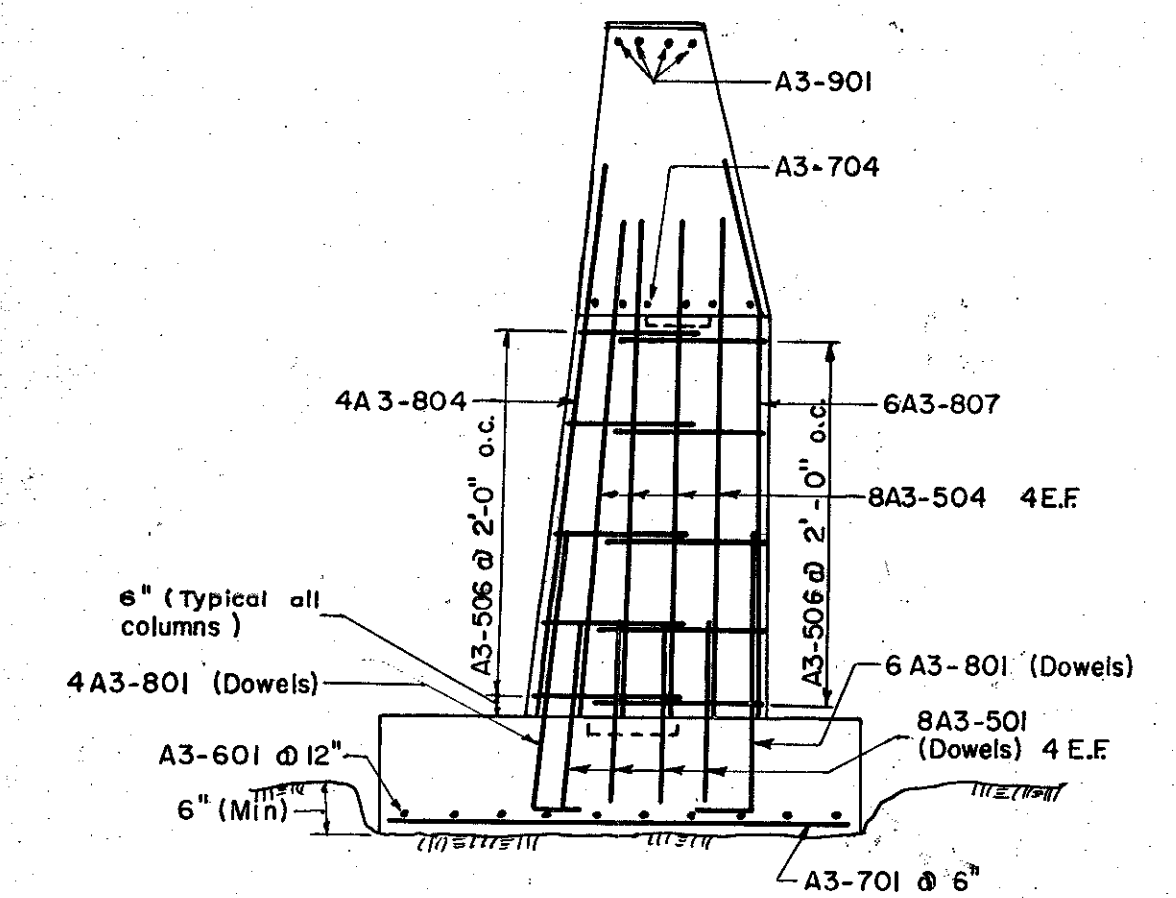


SECTION B-B  
Scale: 1/4" = 1'-0"

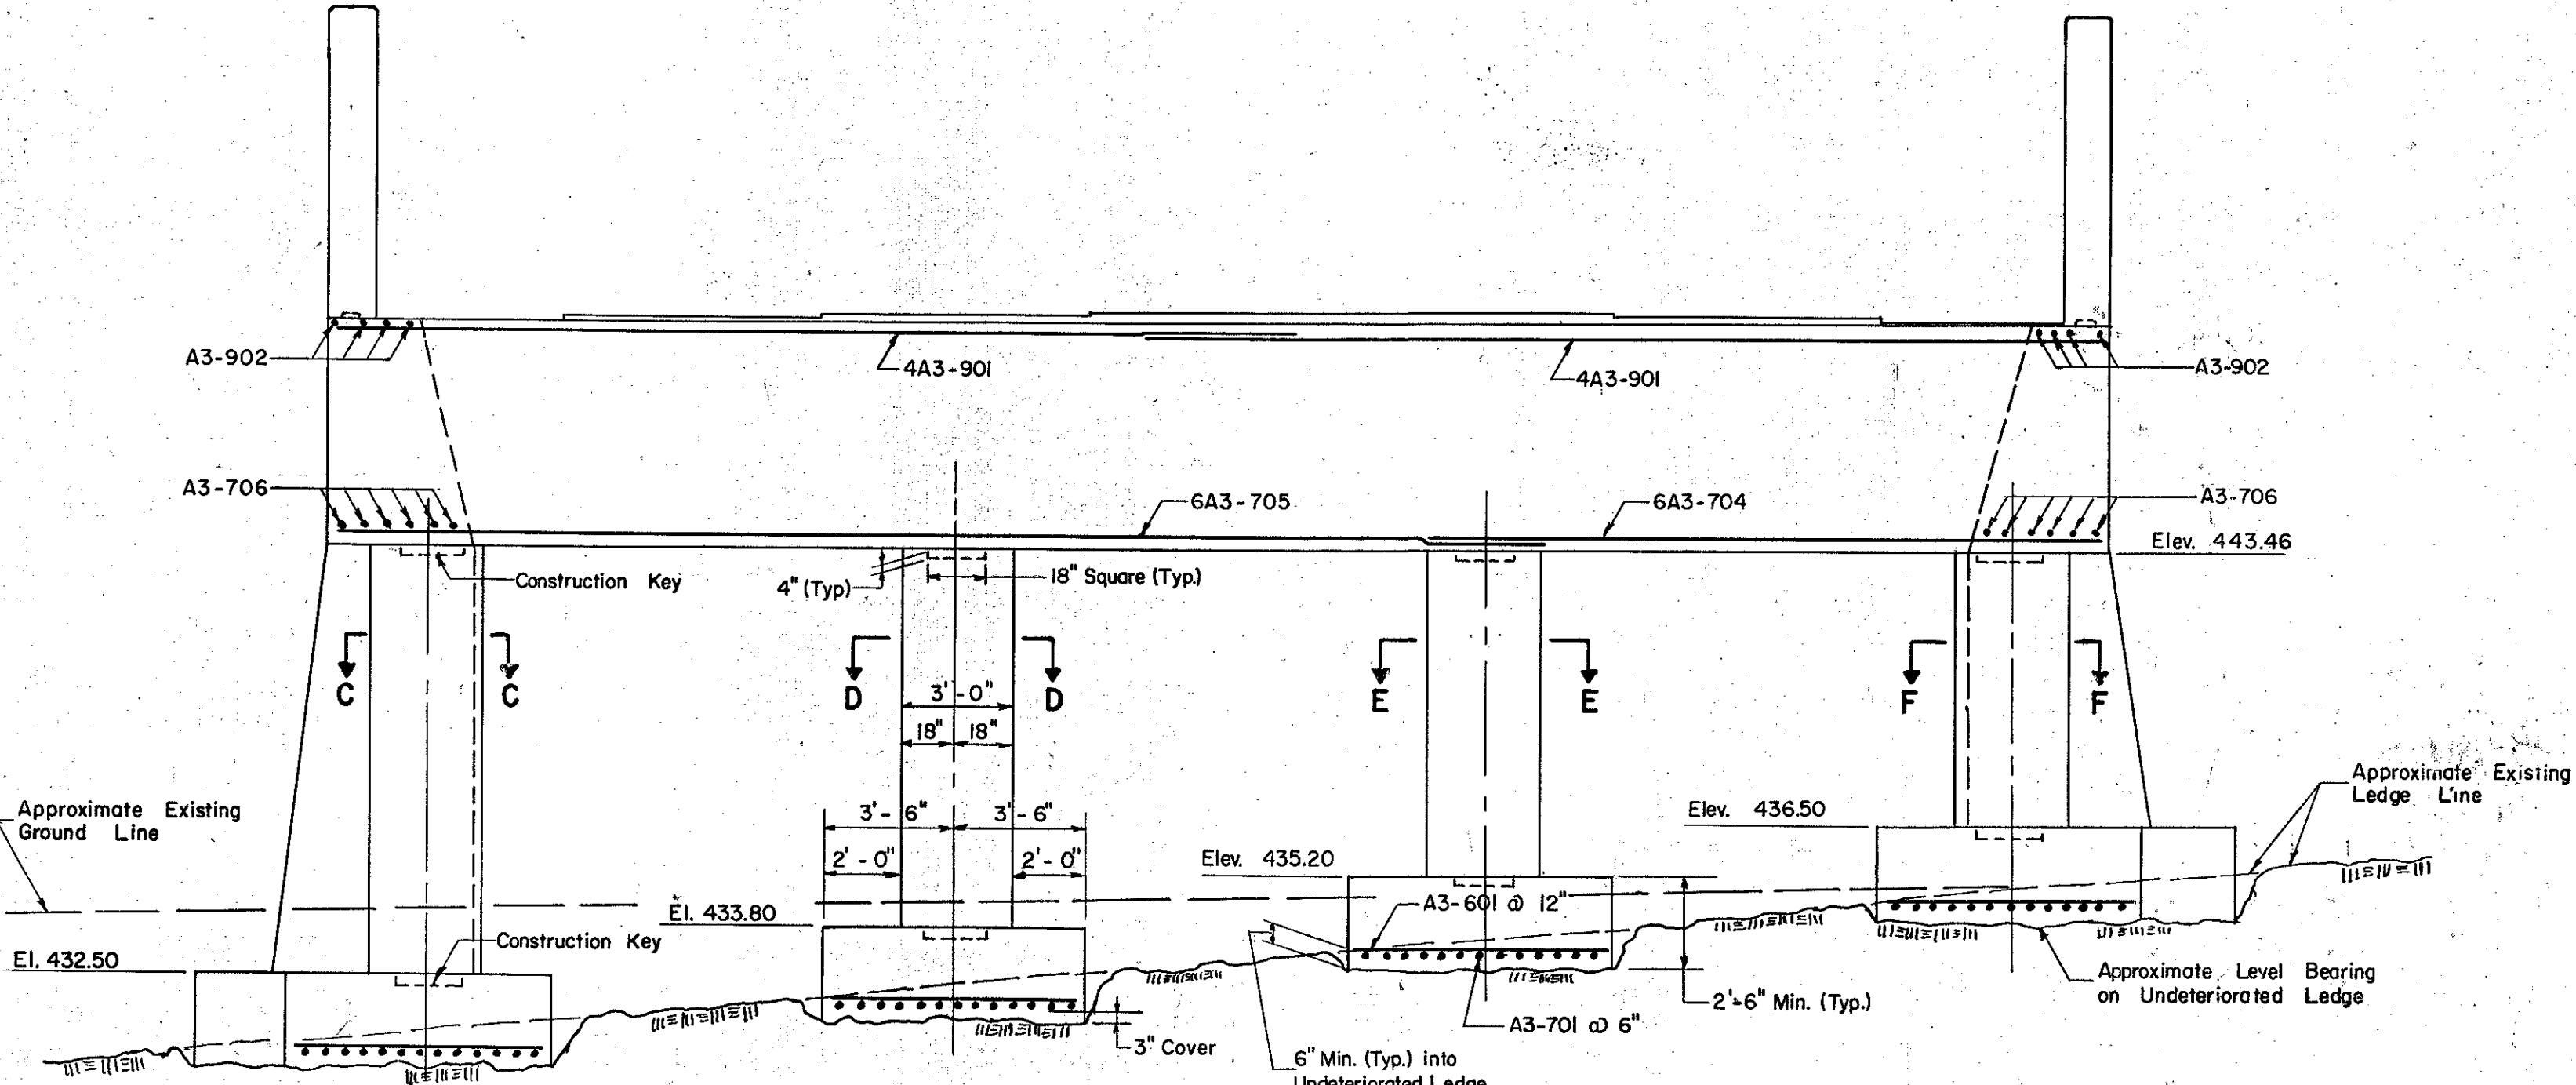


ELEVATION ABUTMENT NO. 3  
Scale: 1/4" = 1'-0"

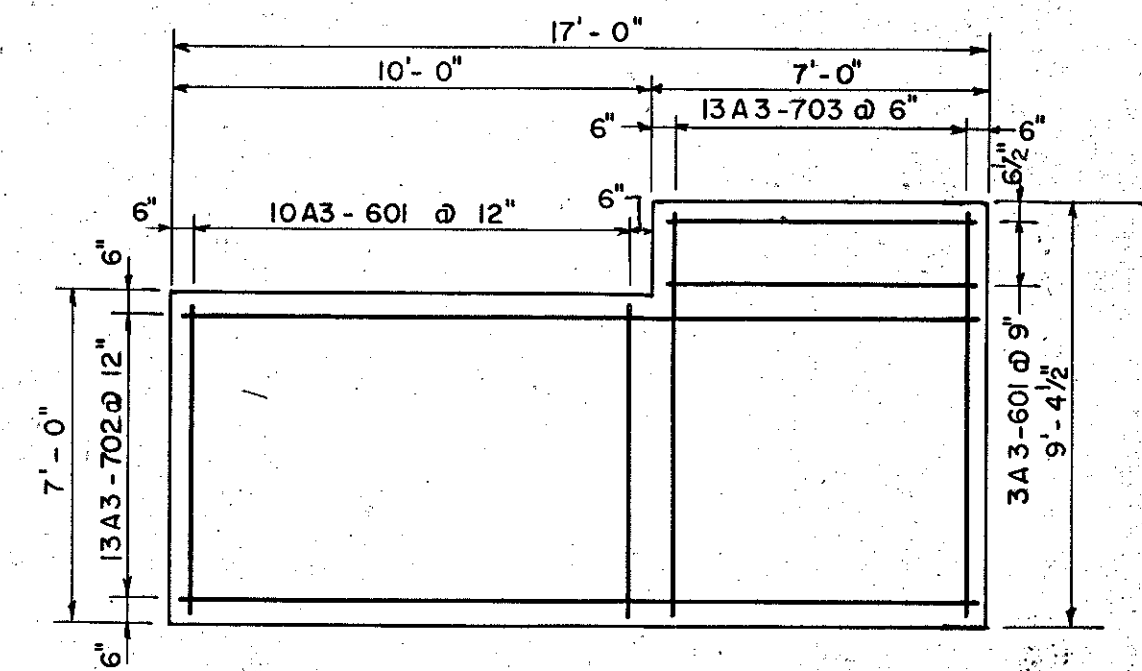


REINFORCING PLAN - FOOTINGS "A" & "D"  
Scale: 1/4" = 1'-0"

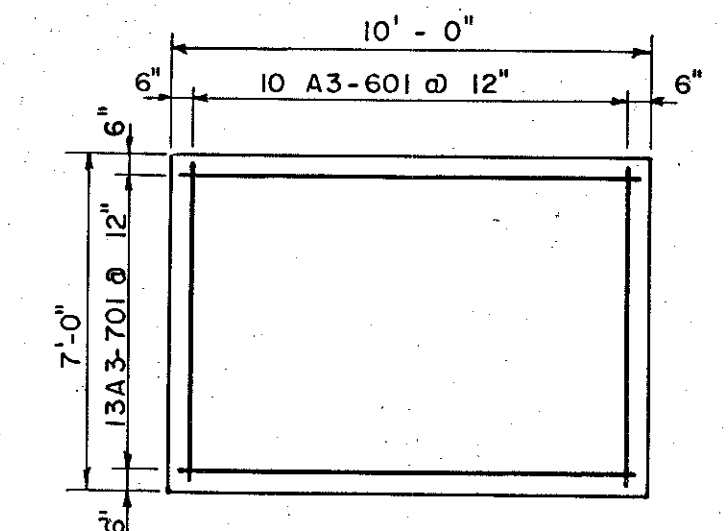

REINFORCING PLAN - FOOTINGS "B" & "C"  
Scale: 1/4" = 1'-0"

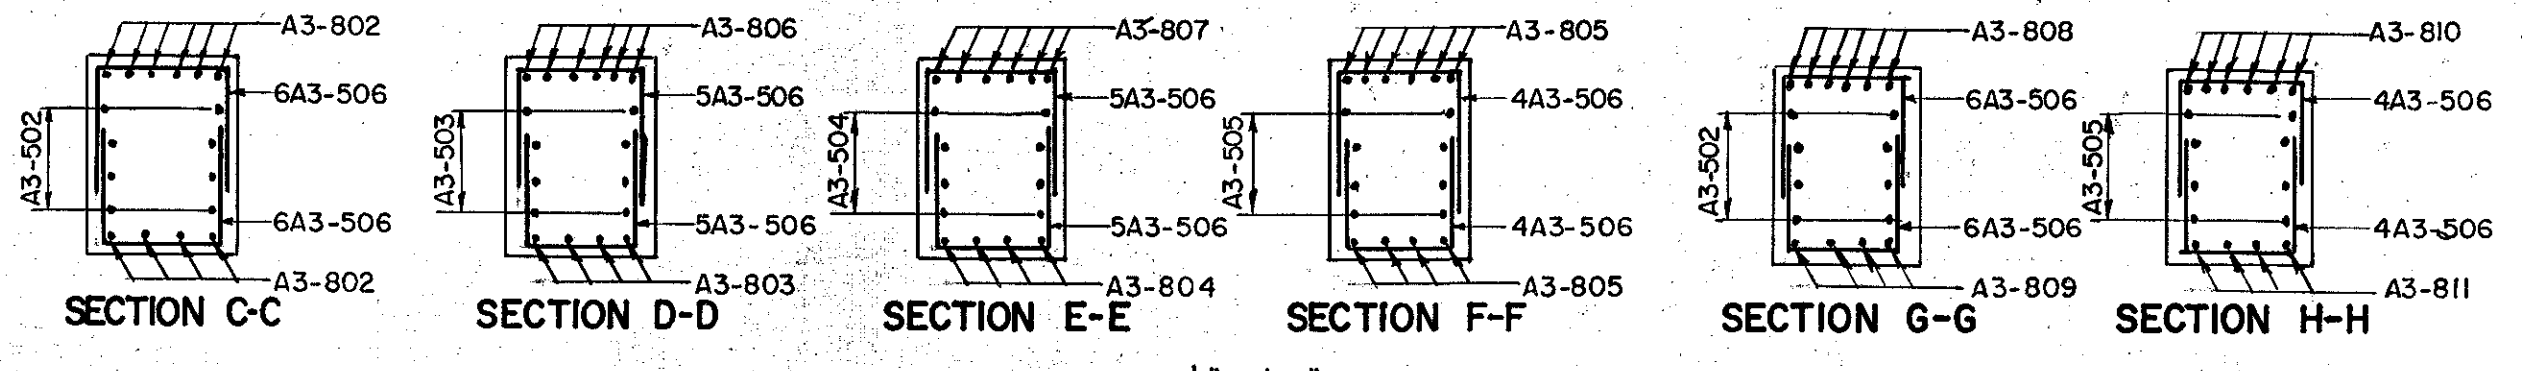

Scale: 1/4" = 1'-0"

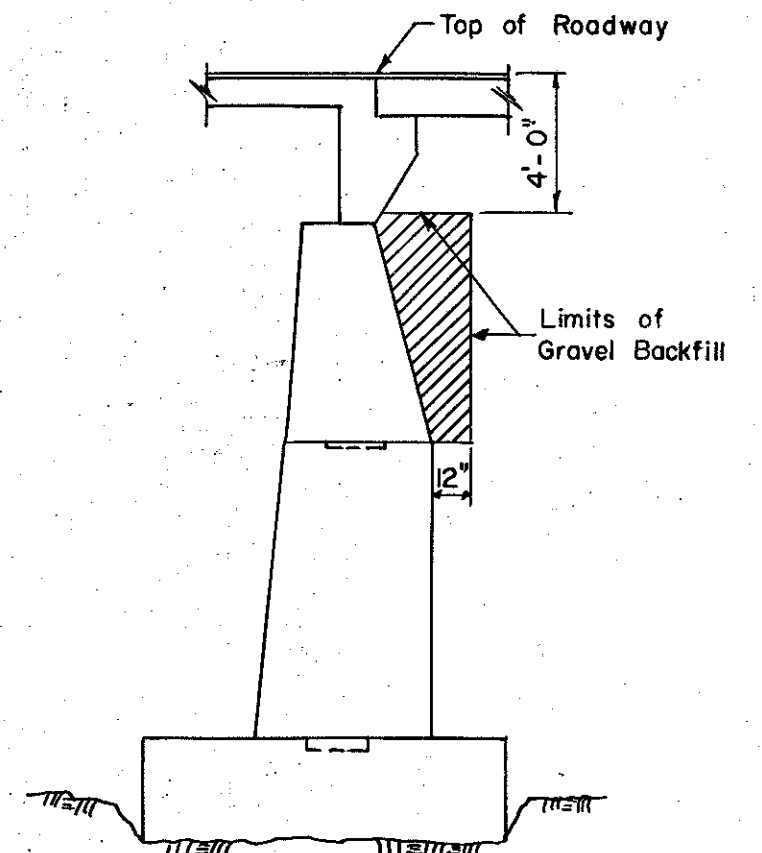

LIMITS OF GRAVEL BACKFILL AT ABUTMENT NO. 3  
Not to Scale

- Notes:
1. For Masonry Shelf Elevations see Sheet No. 4.
  2. For Estimated Quantities see Sheet No. 4.
  3. For Wingwall Reinforcing and Details see Sheet No. 6.
  4. Reinforcing Cover to be 2" except as noted.
  5. See Notes 1, 6 & 7, Sheet No. 4.

IM 089-2(26)  
This sheet for information only  
**BR 49 N & S**

CONTRACT NO. 1

**ABUTMENT NO. 3**  
STATE OF VERMONT  
DEPARTMENT OF HIGHWAYS


INTERSTATE PROJECT in the town of  
**WATERBURY**  
INTERSTATE OVER STA. 872+50  
**WATERBURY DAM RD. (REL.)** STA. 1+70

THE CLARKSON ENGINEERING CO., INC.  
CONSULTING ENGINEERS  
BOSTON MASSACHUSETTS

SURVEYED BY: REM. IN CHARGE: J.V.B. CHECKED BY: G.B. DATE: 6-19-58  
DRAWN BY: J.M.B. SCALE: AS NOTED


PROJECT NO. I-89-2(7) SHEET 241 OF 307

B. P. R. DIV. NO.	STATE	PROJECT NO.	SHEET NO.	TOTAL SHEETS
1	VT.	I-89-2 (7)	106	

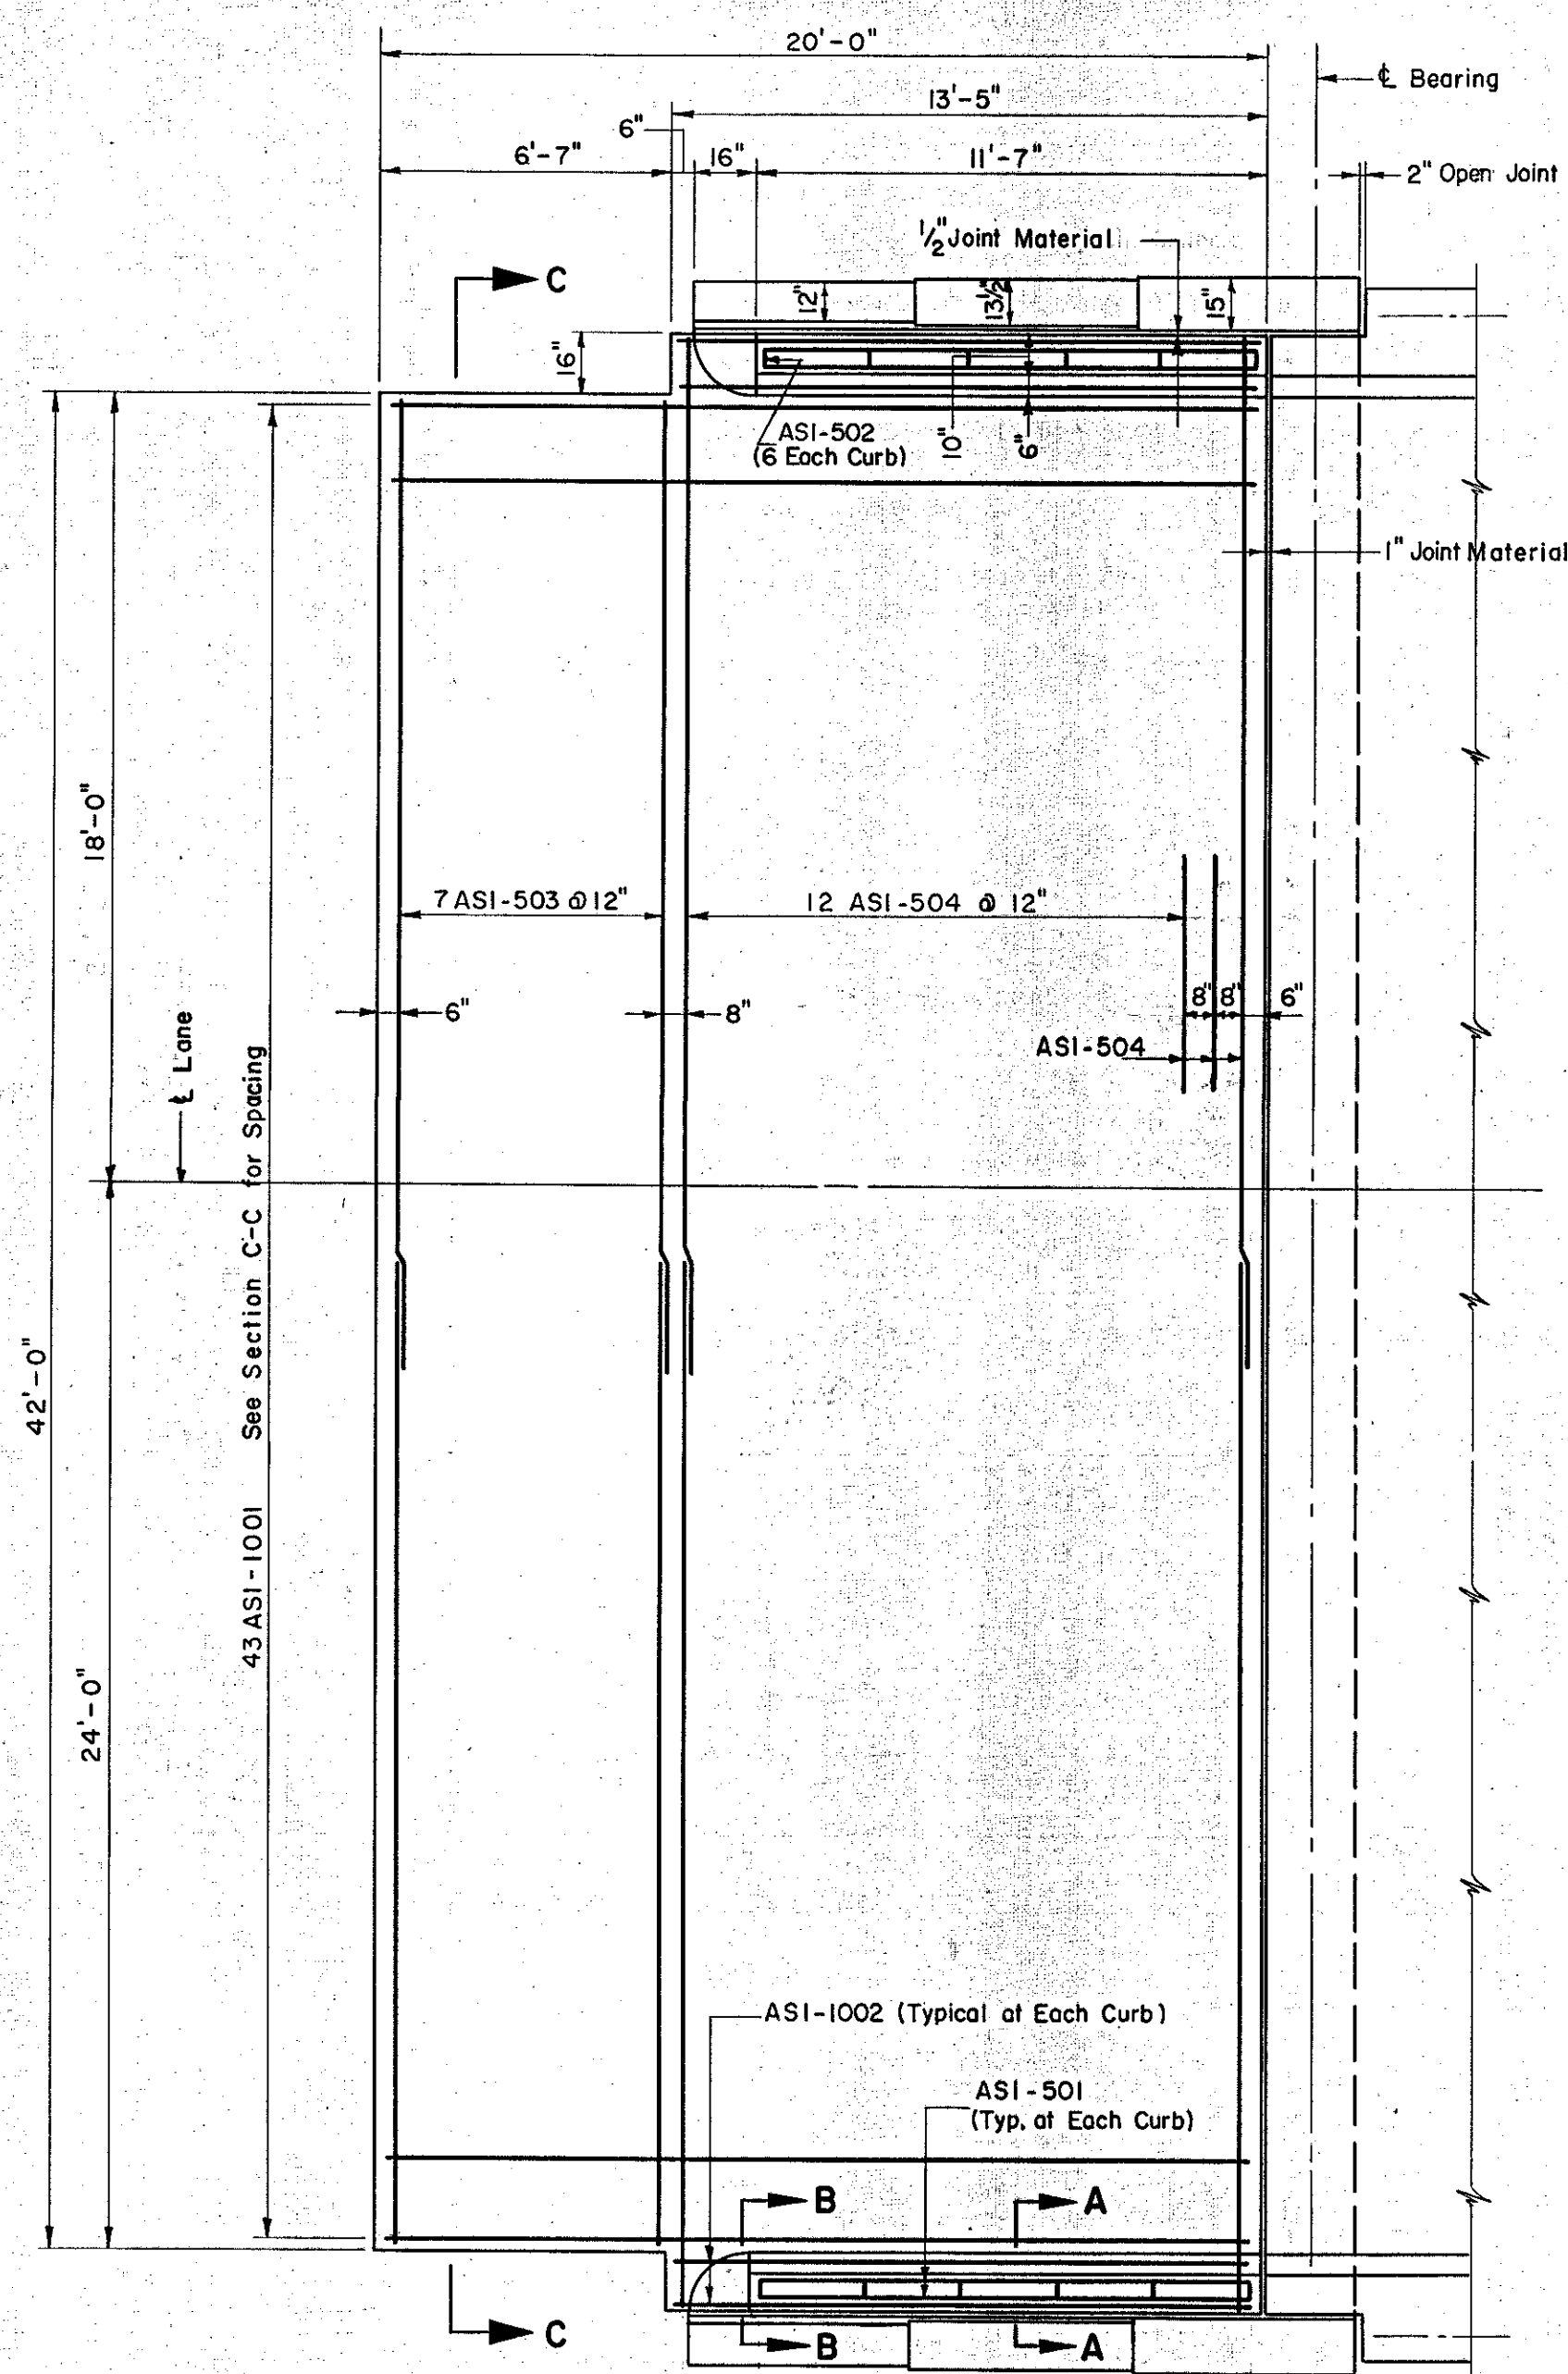


**TYPICAL APPROACH SLAB**  
Scale: 1/4" = 1'-0"

Note: For Sections A-A & B-B See Std. Sheet SB-AS-Sq.57

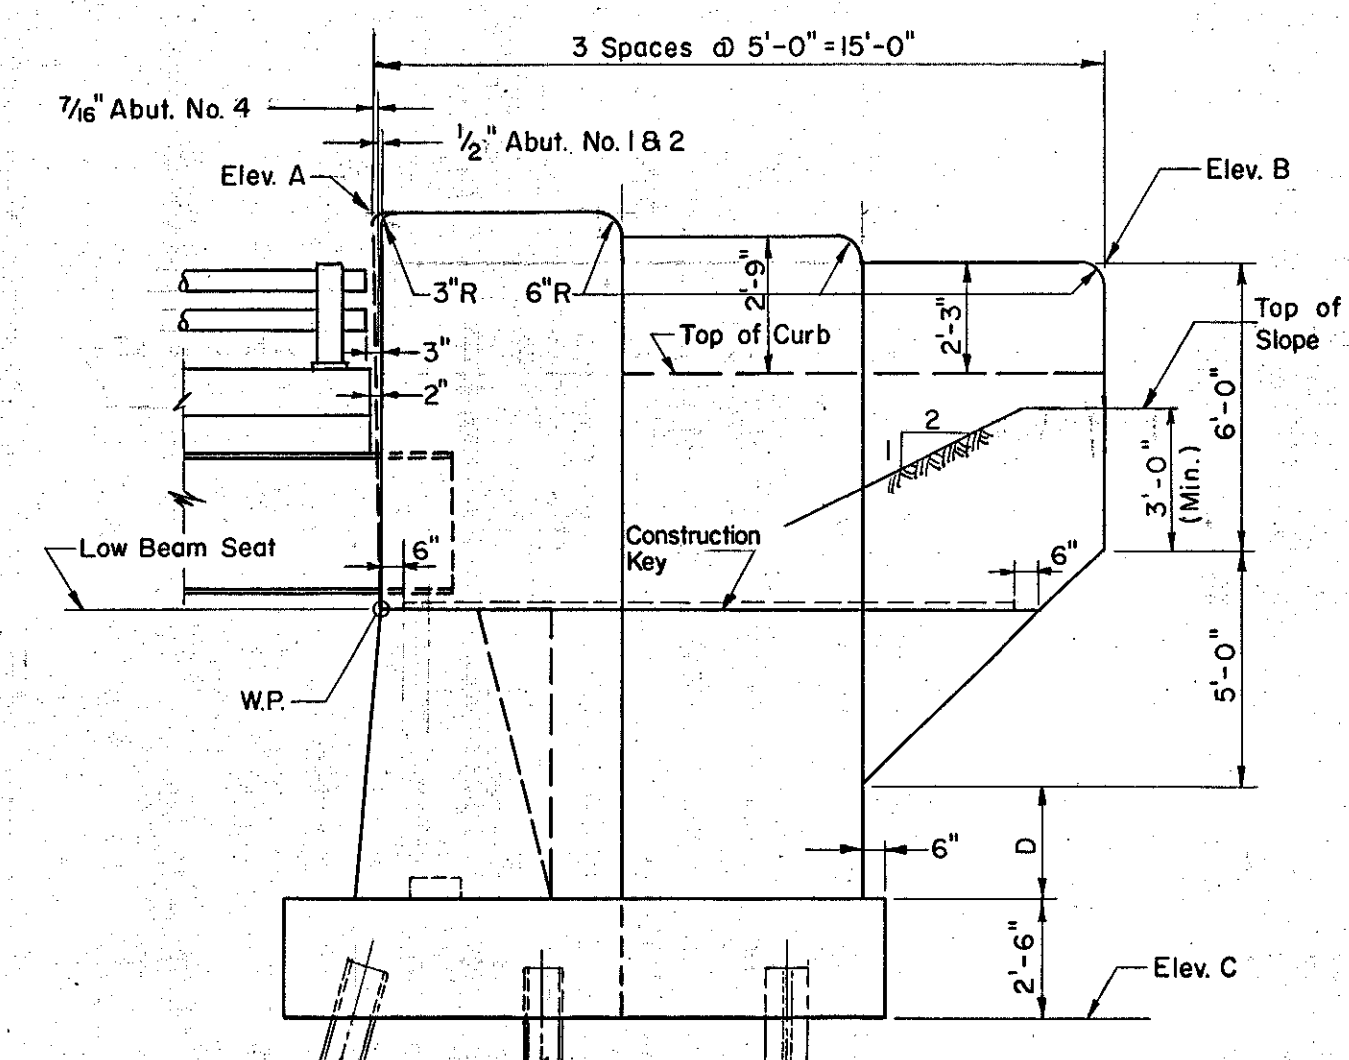

**TYPICAL WINGWALL ELEVATION**  
**ABUTMENTS NO. 1, 2 & 4**  
Scale: 1/4" = 1'-0"

Note: Wingwalls to be built normal and parallel to grade.

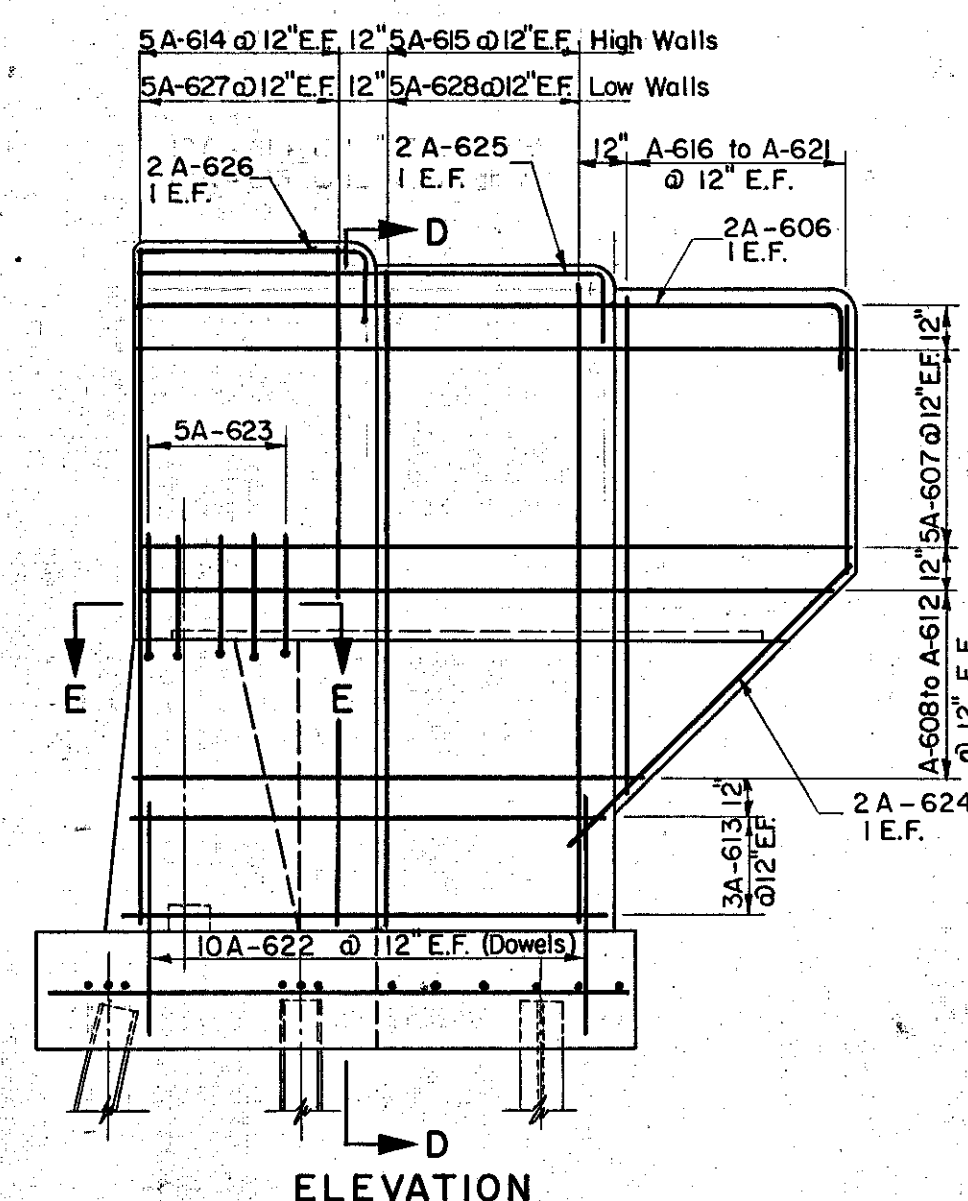


**TYPICAL WINGWALL REINFORCING**  
**ABUTMENTS NO. 1, 2 & 4**  
Scale: 1/4" = 1'-0"

Abutment No. 1	Elev. A	Elev. B	Elev. C	D
South Wingwall	457.63	456.55	440.59	2'-5 1/2"
North Wingwall	457.75	456.67	440.59	2'-7"

Abutment No. 2	Elev. A	Elev. B	Elev. C	D
South Wingwall	457.73	456.65	440.57	2'-7"
North Wingwall	457.61	456.53	440.57	2'-6 1/2"


Abutment No. 3	Elev. A	Elev. B	Elev. C	D
South Wingwall	458.11	457.19	440.94	2'-10 1/8"
North Wingwall	458.23	457.31	440.94	2'-8 3/8"

Abutment No. 4	Elev. A	Elev. B	Elev. C	D
South Wingwall	458.21	457.29	440.94	2'-10 1/8"
North Wingwall	458.09	457.17	440.94	2'-8 3/8"

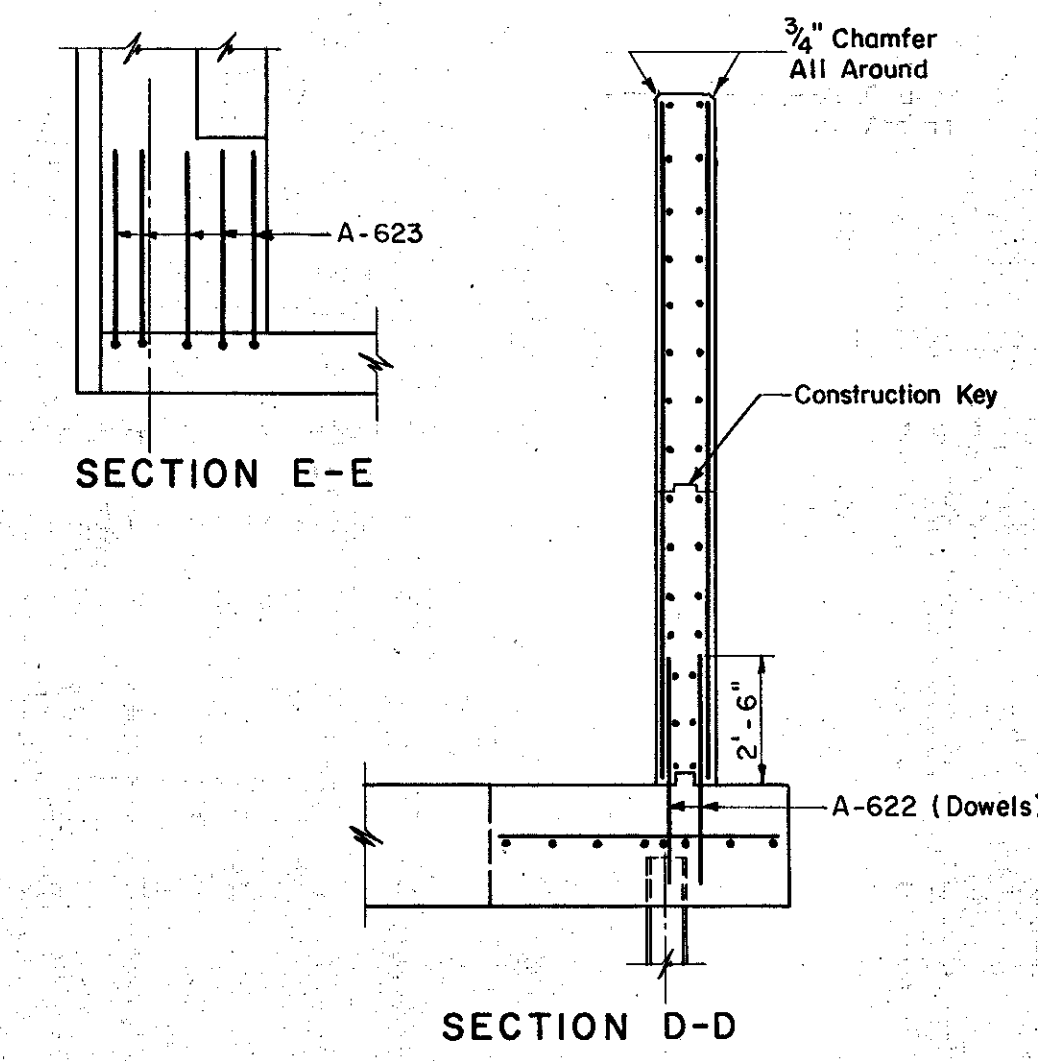


**SECTION E-E**


**SECTION D-D**

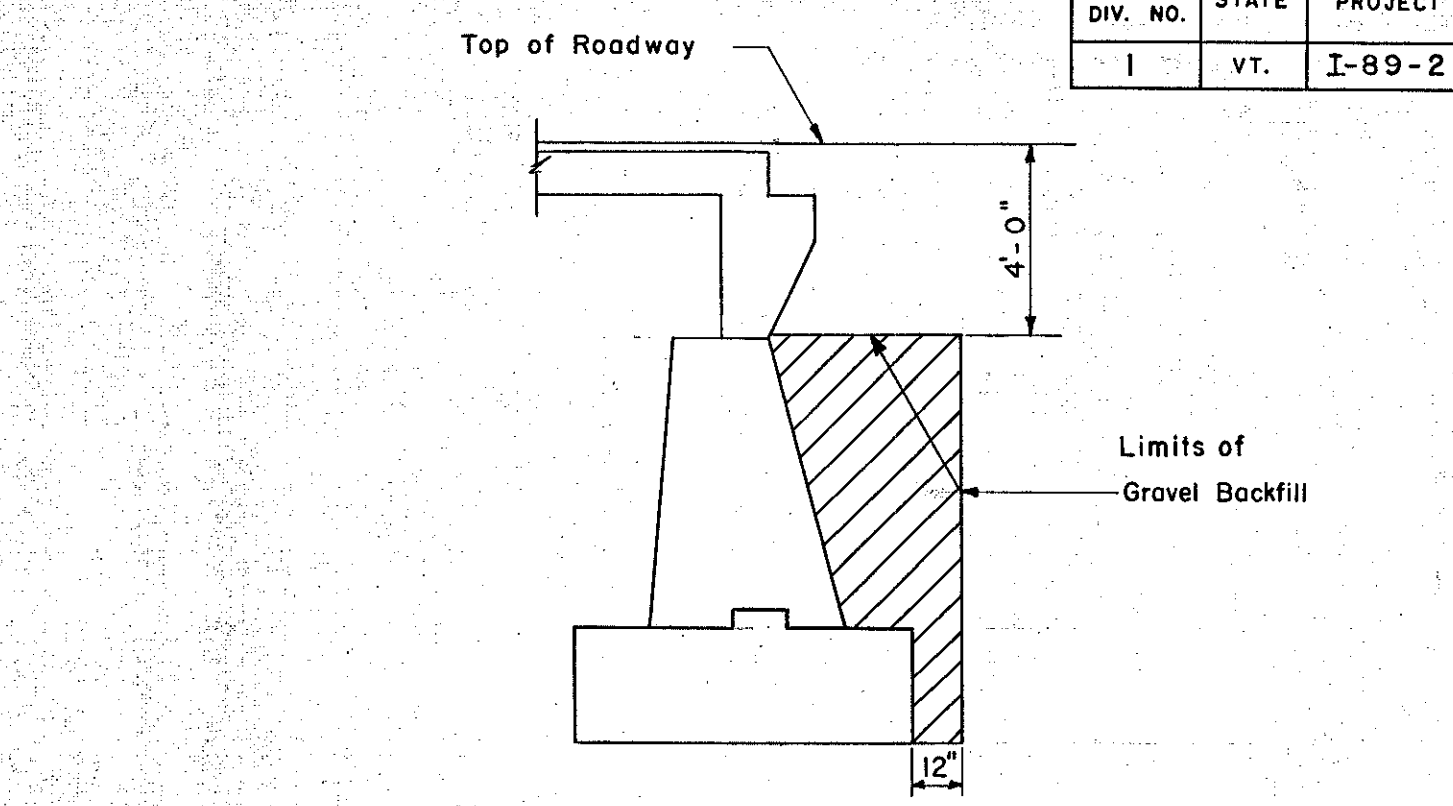


**LIMITS OF GRAVEL BACKFILL ABUTMENTS 1, 2 & 4**  
Scale: 1/4" = 1'-0"

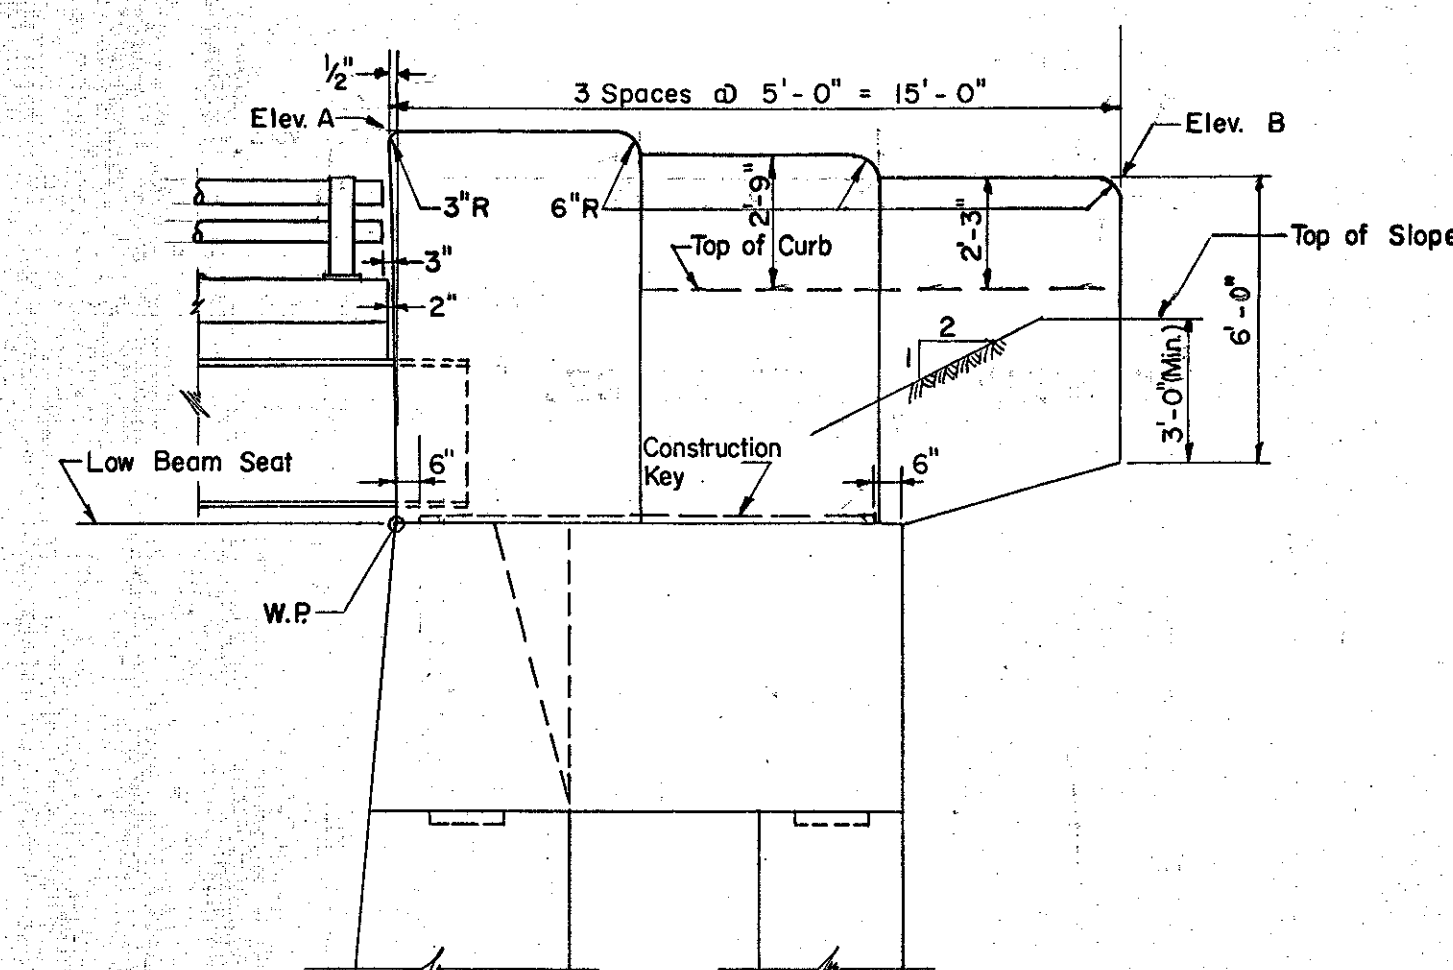

**WINGWALL ELEVATION AT ABUTMENT NO. 3**  
Scale: 1/4" = 1'-0"

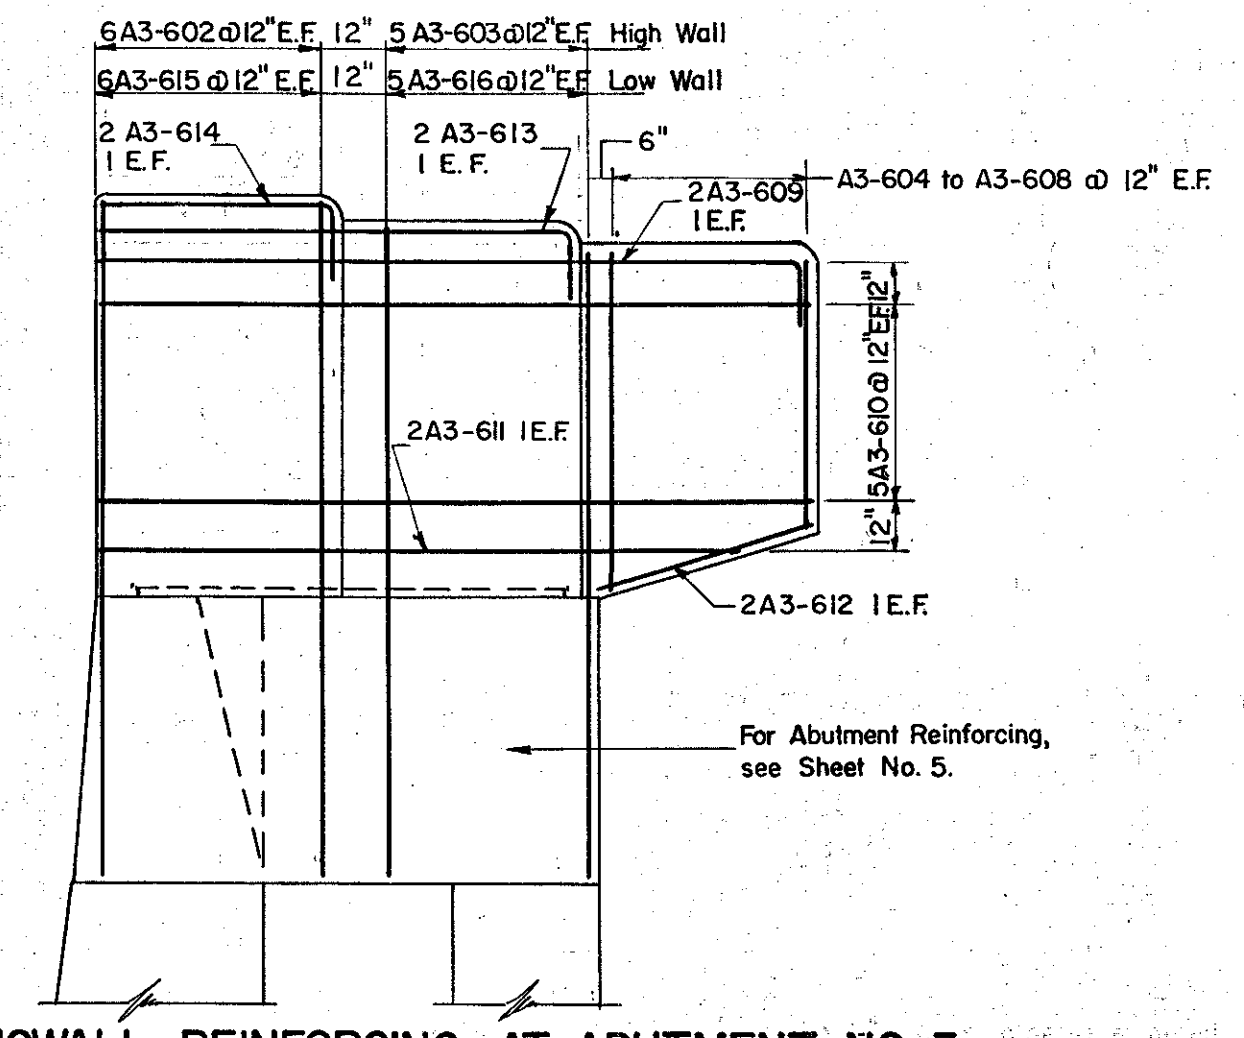

**WINGWALL REINFORCING AT ABUTMENT NO. 3**  
Scale: 1/4" = 1'-0"

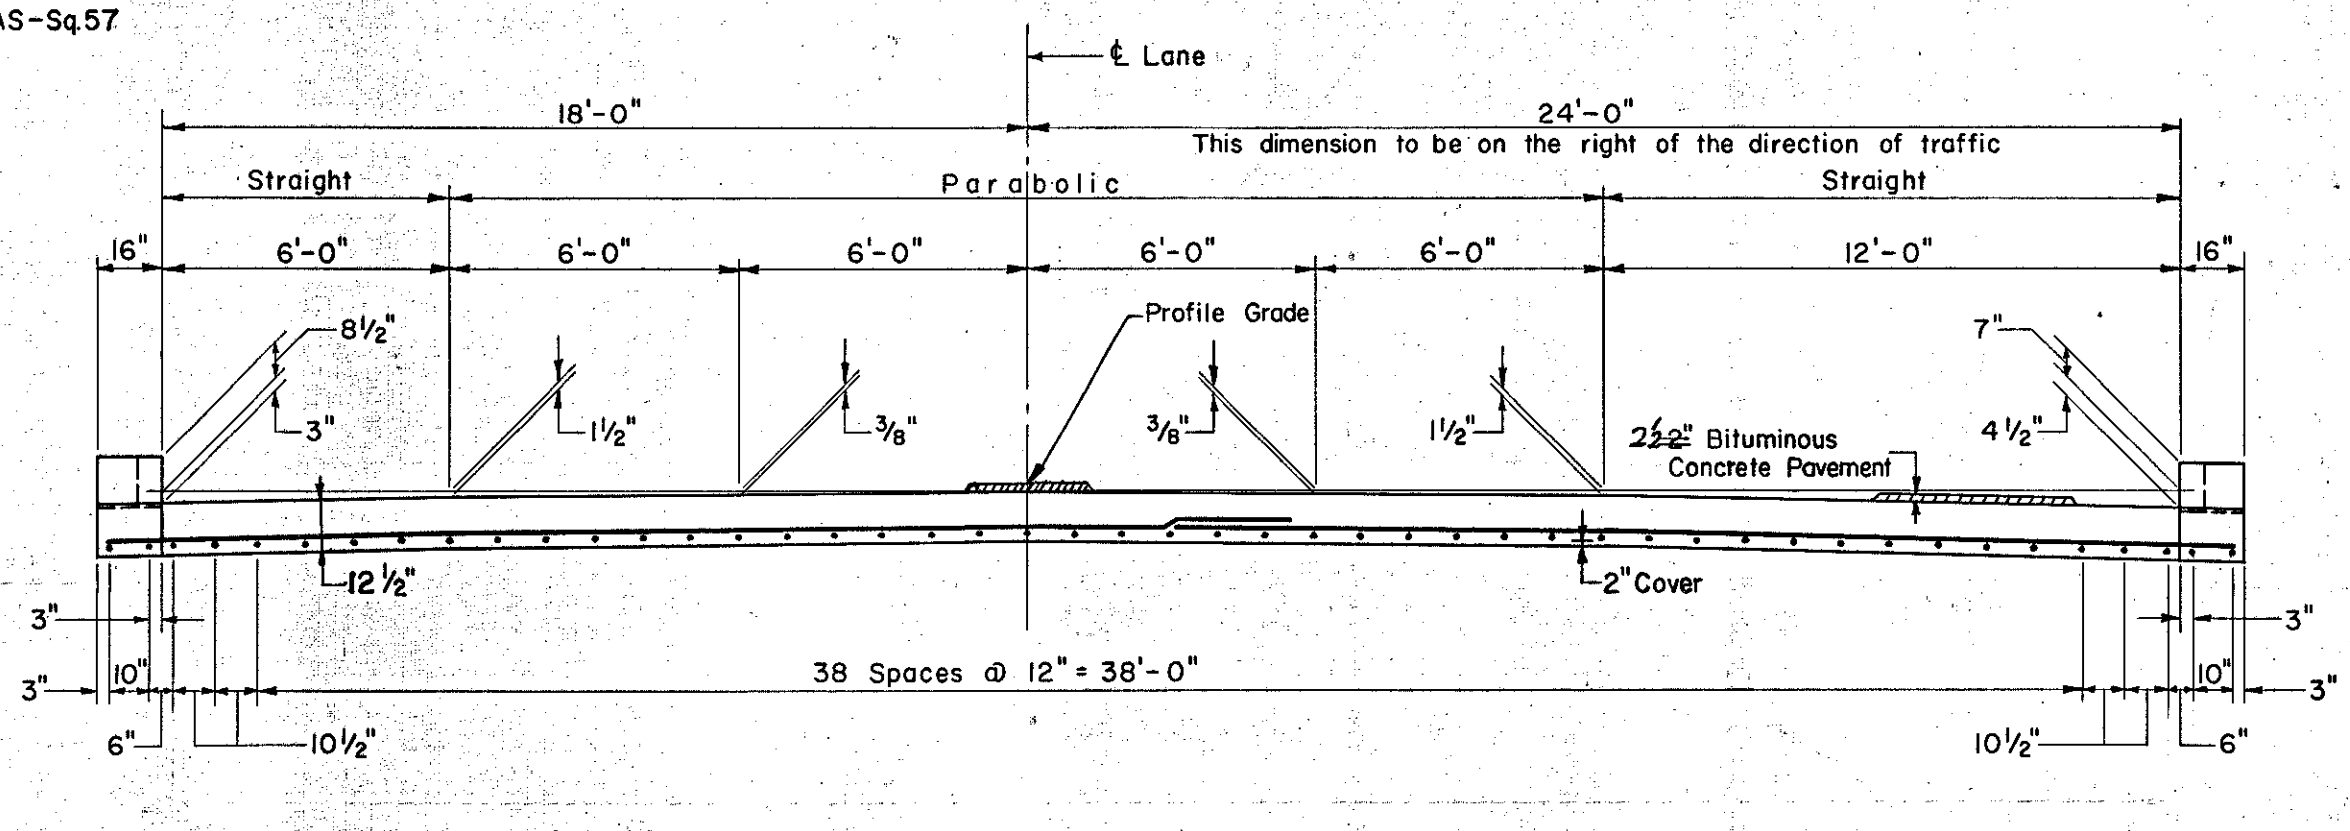

**SECTION C-C**  
Scale: 1/4" = 1'-0"

**ESTIMATED QUANTITIES**

ITEM NO.	DESCRIPTION	UNIT	APPROACH SLABS			
			NET	OVER-RUN	TOTAL	FINAL
361-B	Bituminous Concrete Pavement (Left Lane)	Tons	24	3	27	5cc Total
401-B	Concrete Class B (Mod.) (Left Lane)	C. Y.	68	4	72	68
361-B	Bituminous Concrete Pavement (Right Lane)	Tons	24	3	27	5cc Total
401-B	Concrete Class B (Mod.) (Right Lane)	C. Y.	68	4	72	68
402	Reinforcing Steel	Lbs.	See Reinforcing Schedule Sh. No. 8			
556-C	Granite Bridge Curb (Type 1)	L.F.	See Sheet No. 3			

IM 089-2(26) Note: All cover to be 2" unless otherwise noted.

This sheet for information only  
**BR 49 N & S**


CONTRACT NO. 1

**APPROACH SLABS**  
**STATE OF VERMONT**  
**DEPARTMENT OF HIGHWAYS**


INTERSTATE PROJECT in the town of  
**WATERBURY**  
INTERSTATE OVER STA. 872+50  
WATERBURY DAM RD. (REL.) STA. 1+70

**THE CLARKESON ENGINEERING CO., INC.**  
CONSULTING ENGINEERS  
BOSTON MASSACHUSETTS  
SURVEYED BY: \_\_\_\_\_ CHECKED BY: G.B. & D.S. SCALE: AS NOTED  
DRAWN BY: A.L. IN CHARGE: J.V.B. DATE: 6-19-58  
PROJECT NO. I-89-2(7) SHEET 242 OF 307


B.P.R. DIV. NO.	STATE	PROJECT NO.	SHEET NO.	TOTAL SHEETS
1	VT.	I-89-2(7)	107	

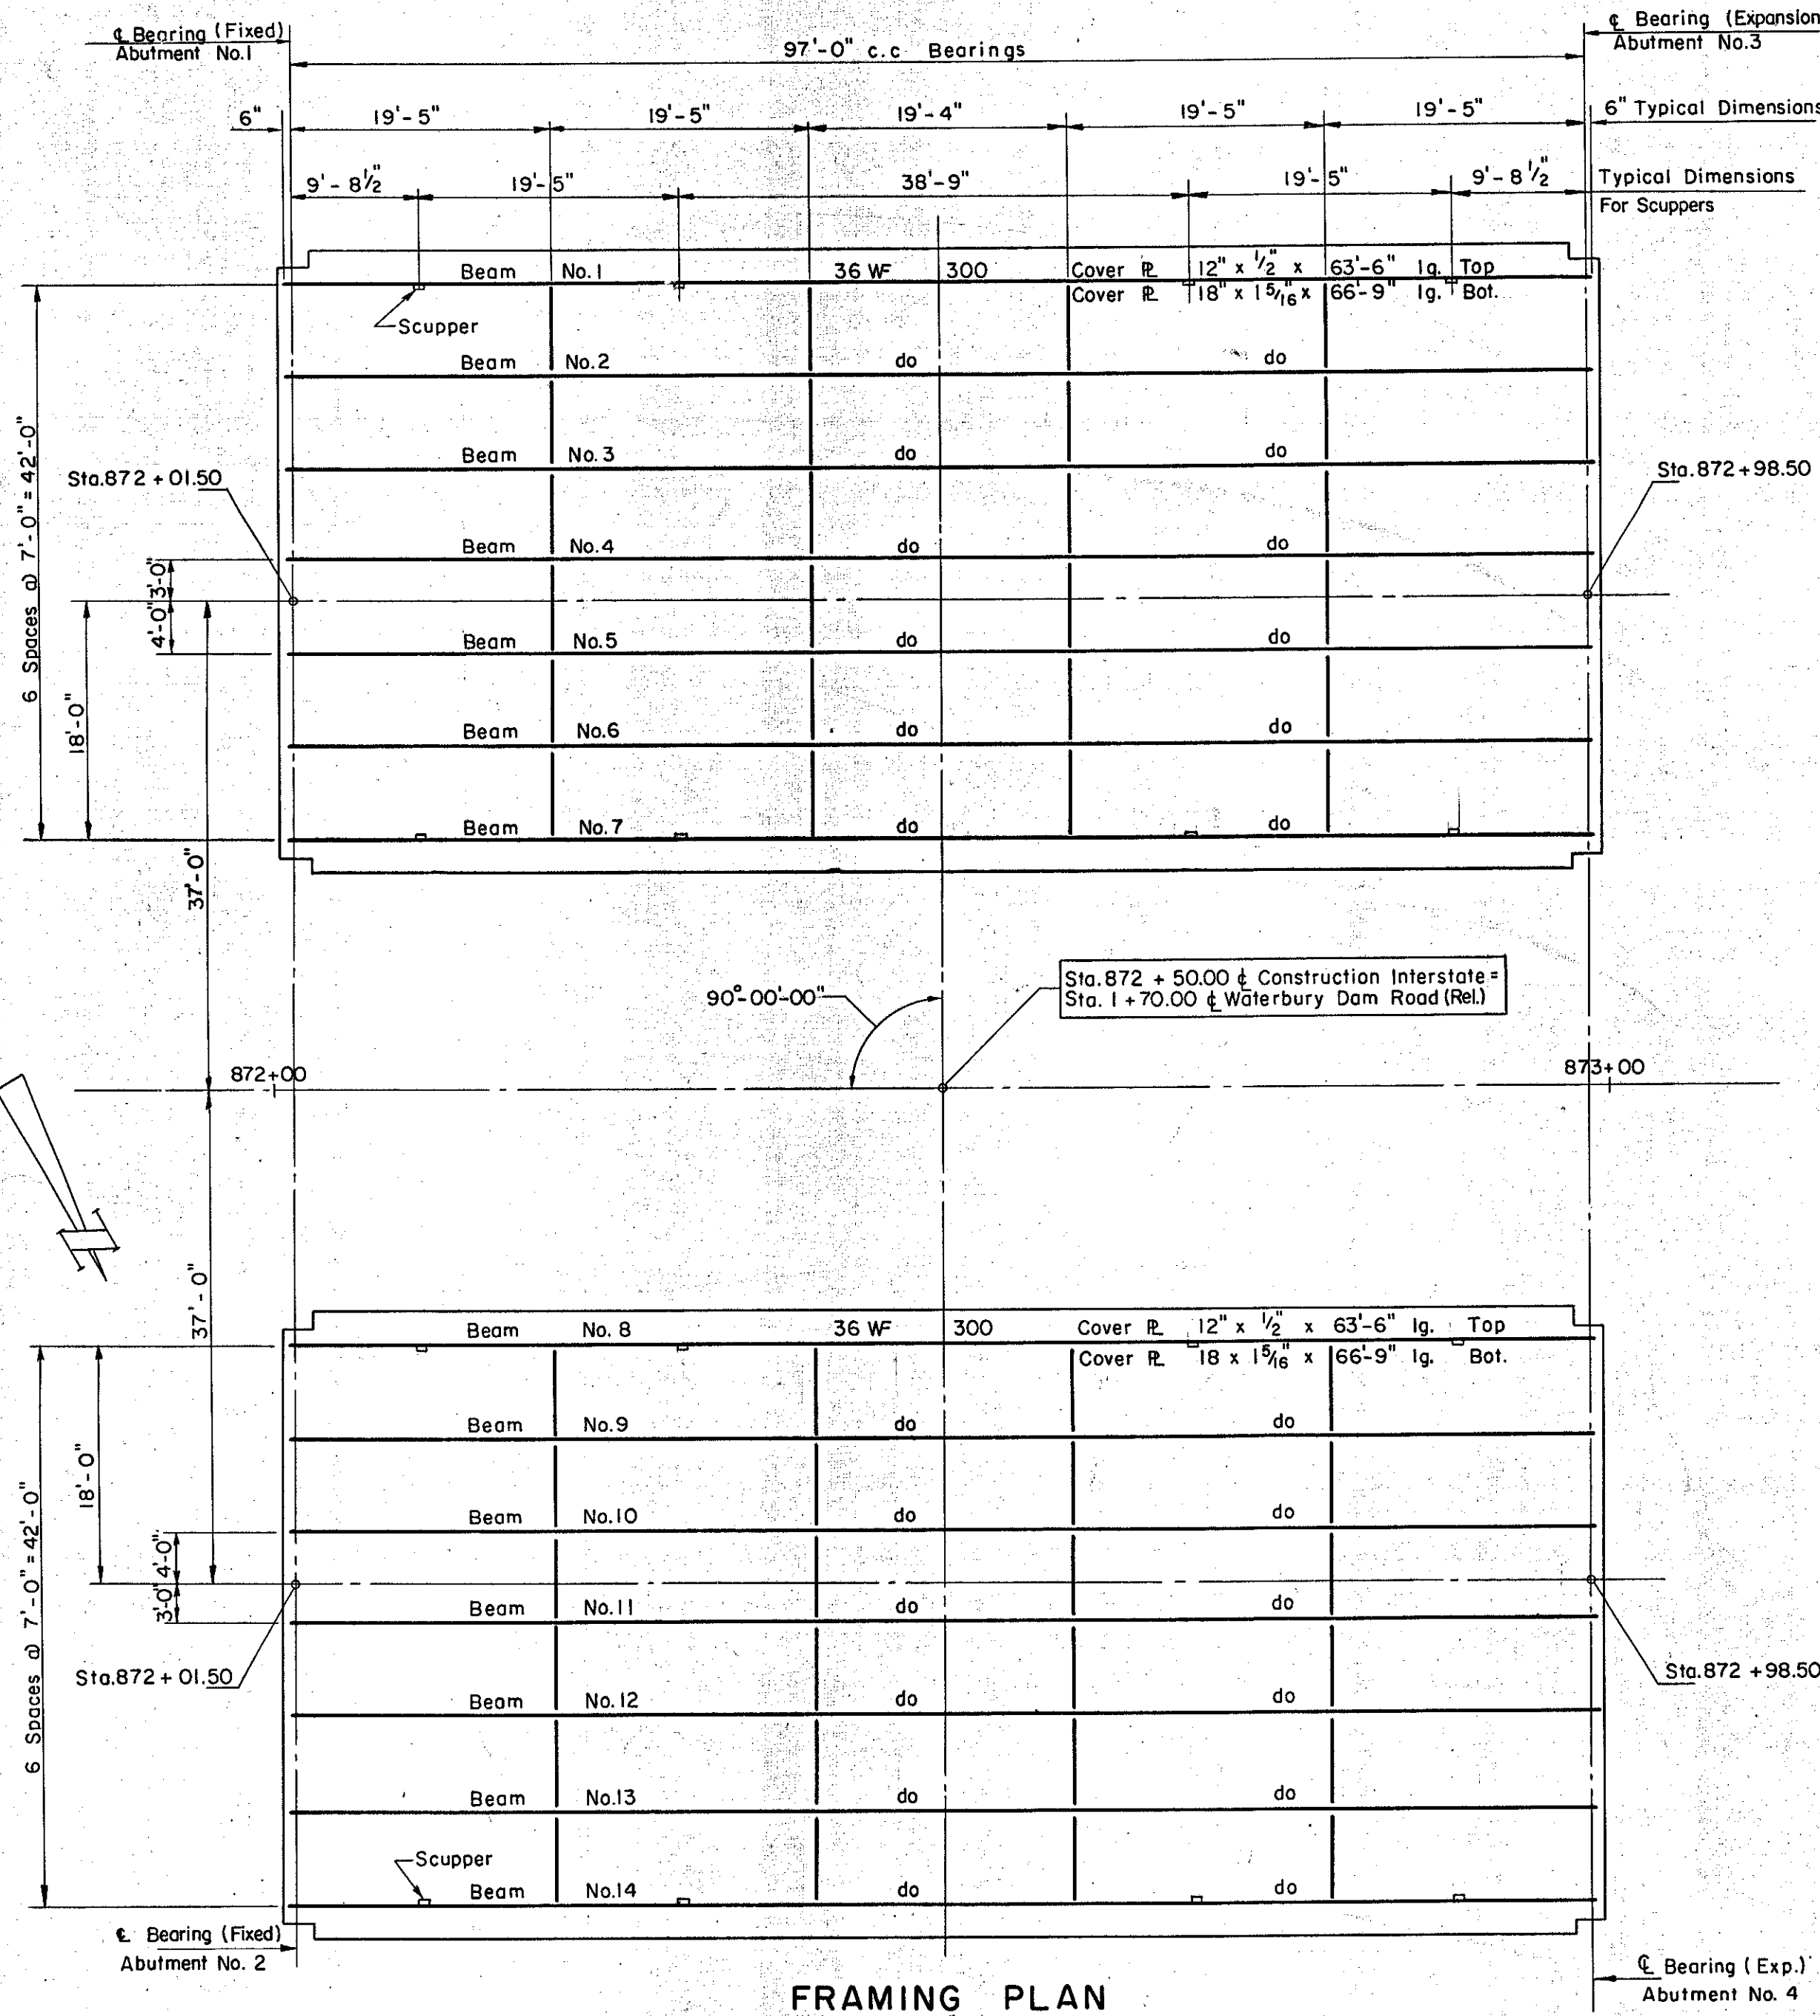


**FRAMING PLAN**  
Scale: 3/32" = 1'-0"

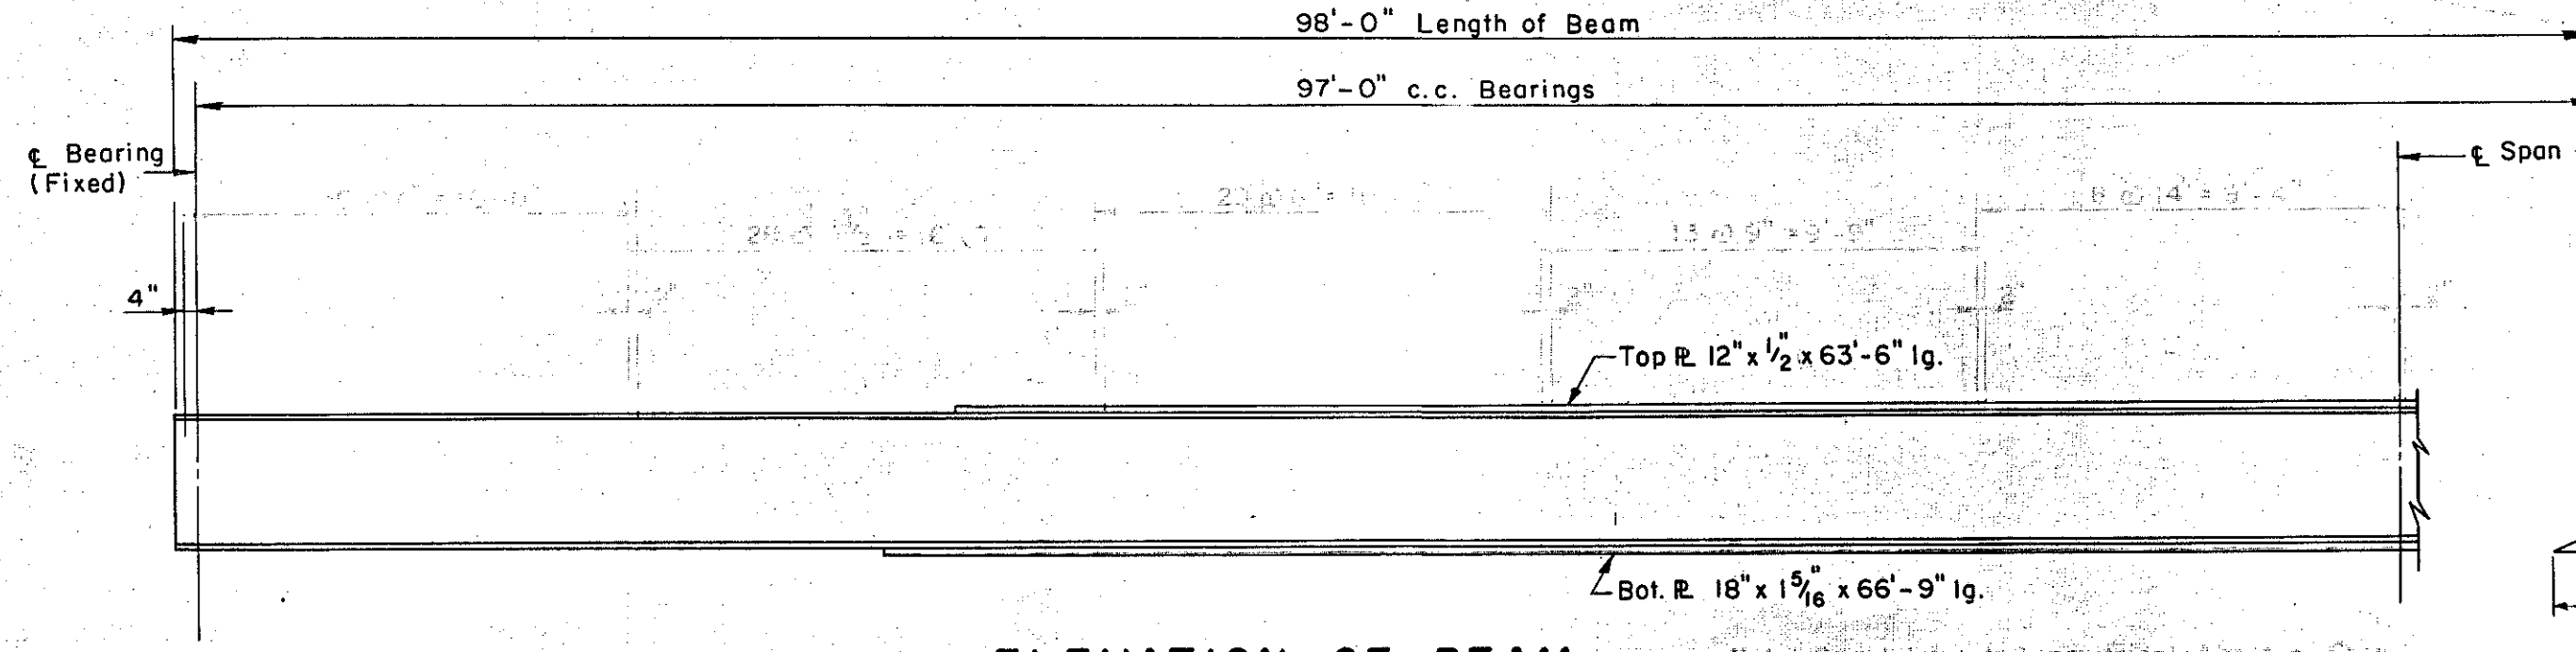


**HALF ELEVATION OF BEAM**  
No Scale

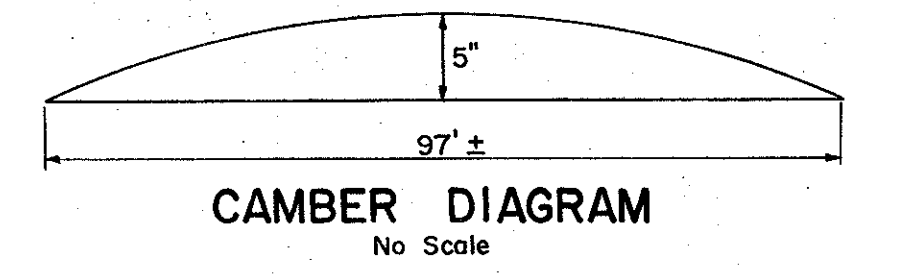

**CAMBER DIAGRAM**  
No Scale

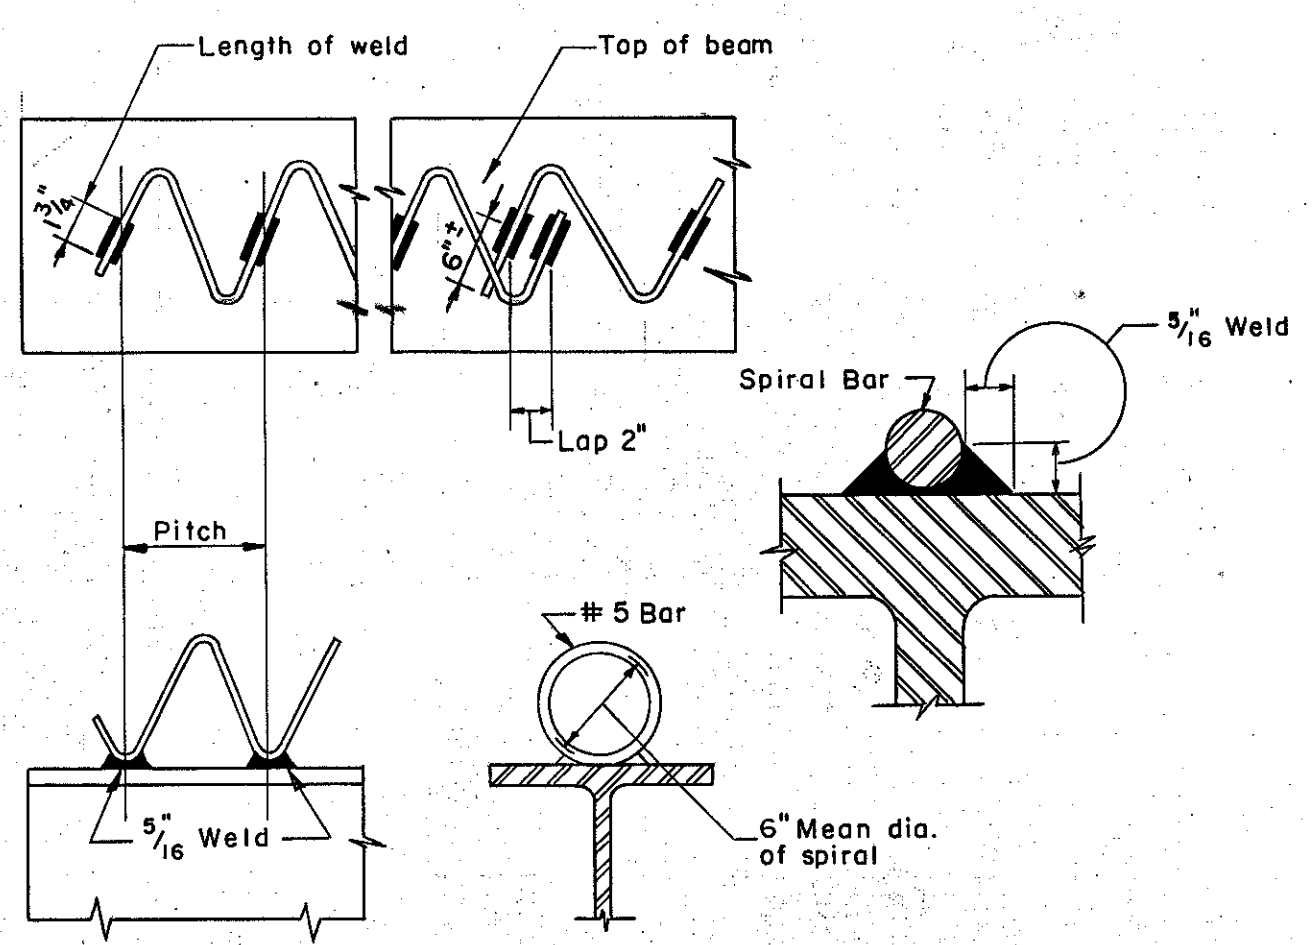

**SPIRAL WELDING DETAILS**  
No Scale

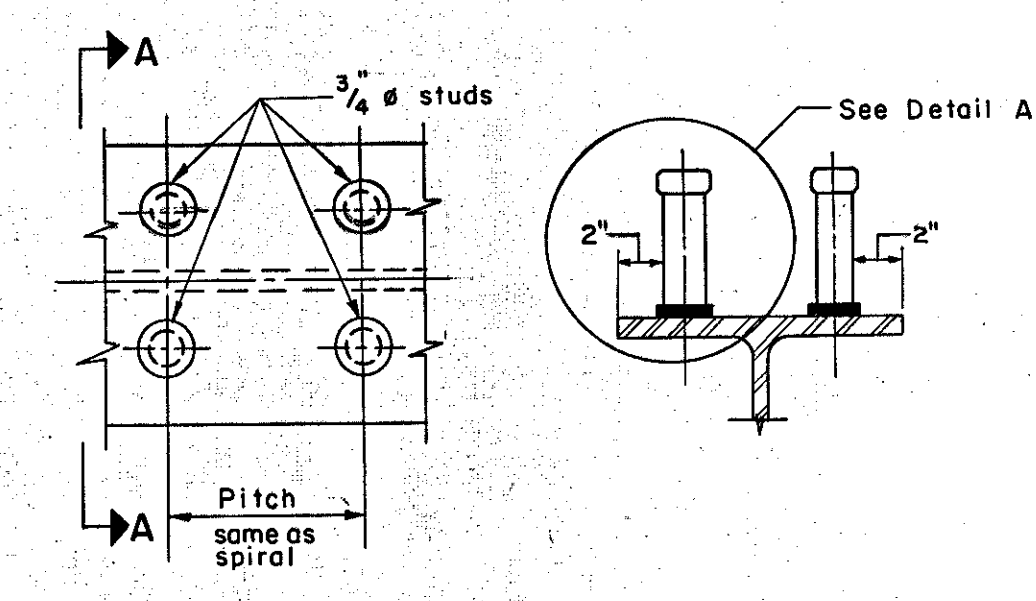

**ALTERNATE SHEAR CONNECTOR**  
No Scale


**ESTIMATED QUANTITIES**

ITEM NO.	DESCRIPTION	UNIT	RIGHT LANE			LEFT LANE				
			NET	OVER-RUN	TOTAL	NET	OVER-RUN	TOTAL		
36-B	Bit. Conc. Pavement	Tons	-62	-8	-60	See Total	-52	-8	-60	See Total
401-B	Concrete Class B (Mod.)	C.Y.	-145	-7	-152	157	-145	-7	-152	157
402	Reinforcing Steel	Lbs.	See Reinforcing Steel Schedule Sheet No. 8							
403-c	Spiral Reinforcement (5,100 LBS.)	L.S.	1	1	1	1	1	1	1	1
404-A	Structural Steel	Lbs.	264,742	-5295	270,037	263,155	264,742	-5295	270,037	263,155


- NOTES:**
- All dimensions are horizontal dimensions.
  - All diaphragms shall be 18C 42.7.
  - All beams shall be rolled to true circular camber with the middle ordinate as shown on this sheet.
  - The steel for all beams and cover plates shall conform to A.S.T.M. Designation A373. All other structural steel shall conform to either A 7 or A 373.

**SPIRAL SCHEDULE**

SPIRAL PITCH	0-10' FROM BRNG	DOUBLE @ 5 1/2"
"	10-20' OR @ SPAN	DOUBLE @ 6 1/2"
"	20-30' OR @ SPAN	4 1/2"
"	30-40' OR @ SPAN	5 1/2"
"	40'-@ SPAN	7"

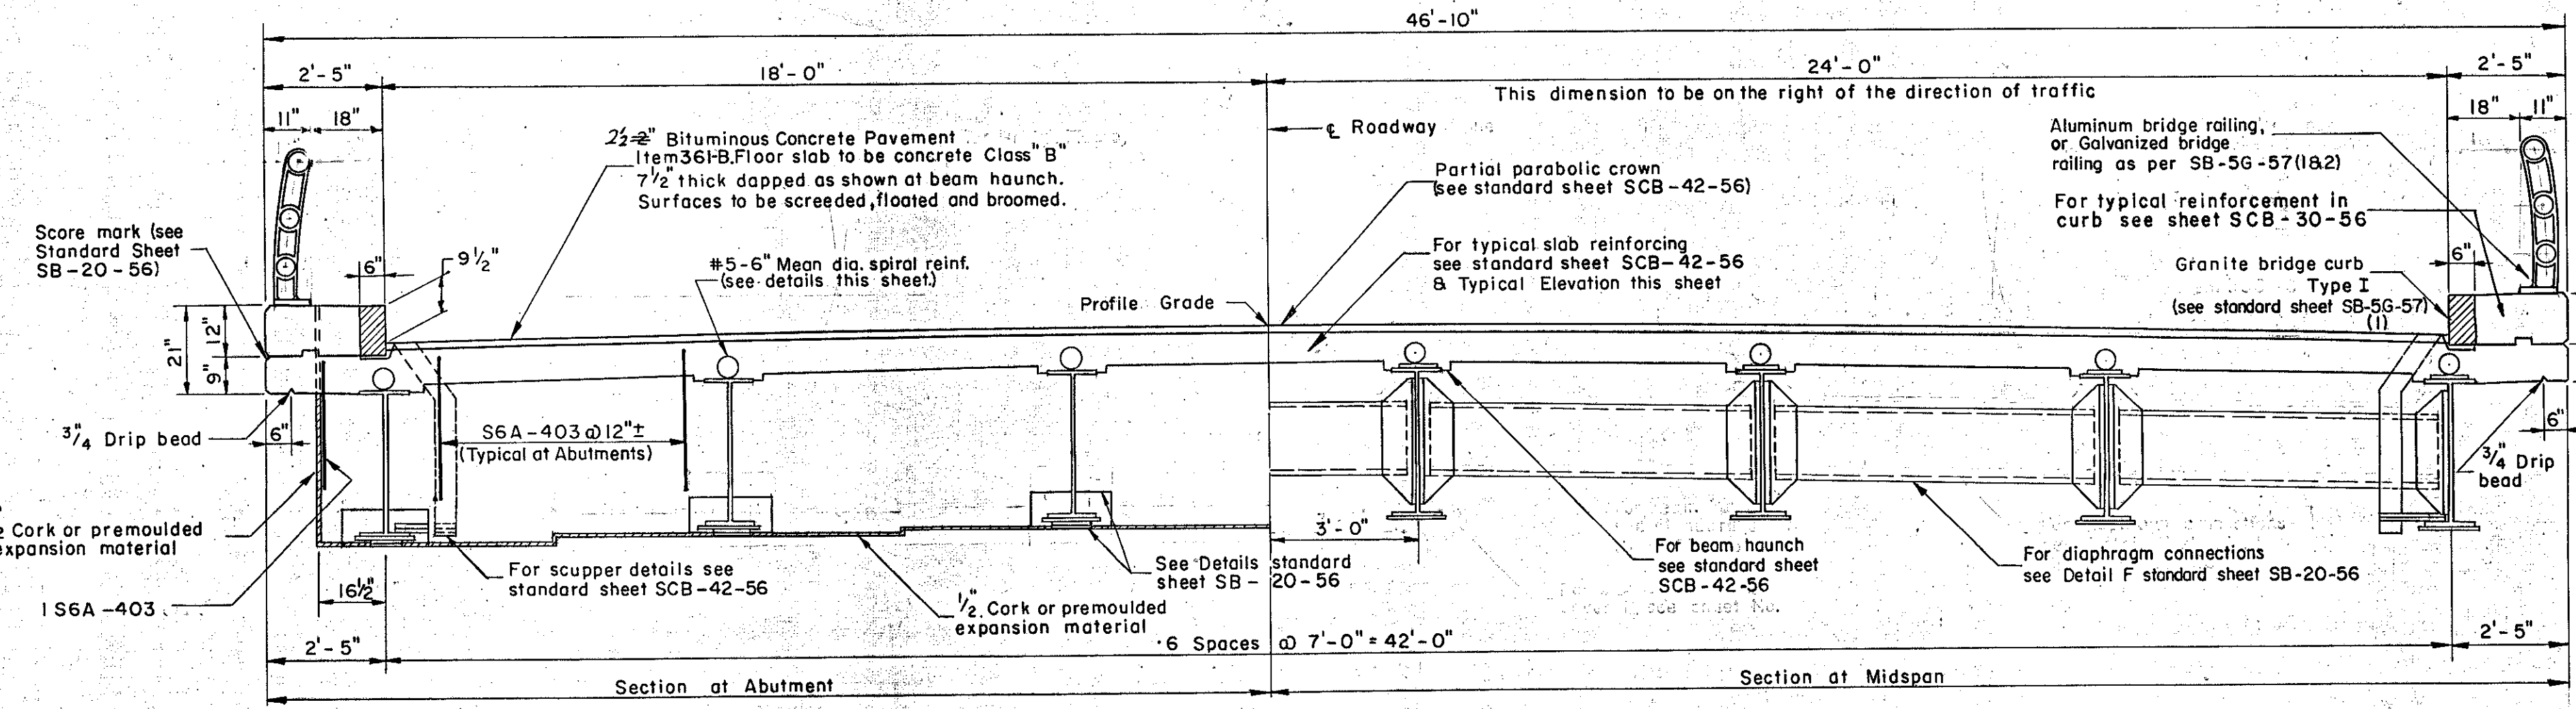

**TYPICAL SECTION**  
Scale: 3/8" = 1'-0"

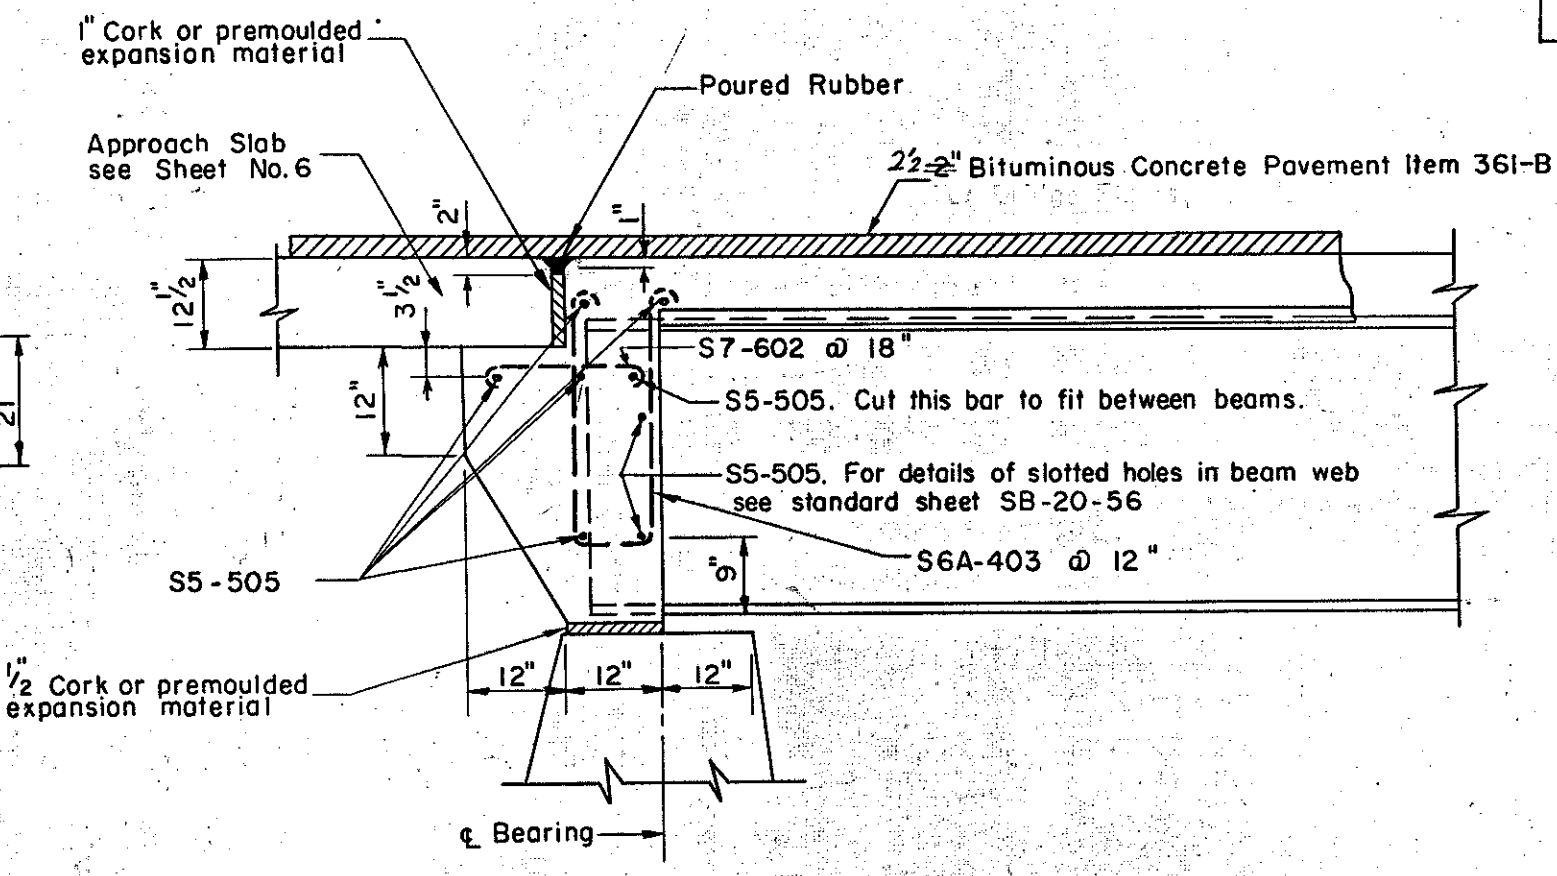

**ELEVATION AT ABUTMENT (SQUARE)**  
Scale: 1/2" = 1'-0"

IM 089-2(26)  
This sheet for information only  
**BR 49 N & S**  
CONTRACT NO. 1

**STRUCTURAL STEEL PLAN AND DETAILS**  
STATE OF VERMONT  
DEPARTMENT OF HIGHWAYS  
INTERSTATE PROJECT in the town of  
**WATERBURY**  
INTERSTATE OVER STA. 872 + 50  
WATERBURY DAM RD. (REL.) STA. 1 + 70

THE CLARKSON ENGINEERING CO., INC.  
CONSULTING ENGINEERS  
BOSTON MASSACHUSETTS

SURVEYED BY V.C.S. CHECKED BY G.B. & D.S. SCALE AS NOTED  
DRAWN BY J.V.B. IN CHARGE DATE 6-19-56

PROJECT NO. I-89-2(7) SHE 243 OF 307



**EXISTING STRUCTURE**

- RATED LOADING OF EXISTING STRUCTURE \_\_\_\_\_
- TYPE OF EXISTING STRUCTURE 8' x 5.4' Box Culvert
- UNDERCLEARANCE ELEVATION OF EXISTING STRUCTURE \_\_\_\_\_
- WHAT DISPOSITION SHOULD BE MADE OF EXISTING STRUCTURE Remove COST OF REMOVAL \_\_\_\_\_
- SHOULD EXISTING STRUCTURE BE USED TO MAINTAIN TRAFFIC DURING CONSTRUCTION OF NEW STRUCTURE \_\_\_\_\_
- SHOULD NEW TEMPORARY STRUCTURE BE BUILT \_\_\_\_\_
- ORDINARY HIGH WATER SURFACE ELEV. AT EXISTING STRUCTURE \_\_\_\_\_ WATERWAY TO ORDINARY H.W. \_\_\_\_\_
- EXTREME HIGH WATER AT EXISTING STRUCTURE 429.0
- SPAN OF EXISTING BRIDGE UPSTREAM \_\_\_\_\_ WATERWAY TO EXTREME H.W. \_\_\_\_\_
- SPAN OF EXISTING BRIDGE DOWNSTREAM \_\_\_\_\_ WATERWAY TO EXTREME H.W. \_\_\_\_\_
- TYPE OF FOUNDATION UNDER EXISTING ABUTMENTS \_\_\_\_\_
- DOES ALL WATER AT FLOOD ELEVATION PASS THROUGH EXISTING STRUCTURE \_\_\_\_\_
- IF NOT AT WHAT ELEVATION IS RELIEF AFFORDED \_\_\_\_\_
- ADDITIONAL WATERWAY AREA PROVIDED \_\_\_\_\_

**NEW STRUCTURE**

- RECOMMENDED TYPE OF STRUCTURE 3 Span Composite Steel Stringer Bridge and 96" C.M.P.
- RECOMMENDED CLEAR SPAN OR SPANS 63±-87±-61± Left Lane 64±-94±-68± Right Lane
- MEASURED PARALLEL TO  $\epsilon$  NEW HIGHWAY \_\_\_\_\_
- MEASURED AT RIGHT ANGLES TO  $\epsilon$  STREAM \_\_\_\_\_
- ARE THERE OBJECTIONS TO A PIER IN THE STREAM ANSWER YES OR NO \_\_\_\_\_ NO
- ORDINARY HIGH WATER ELEVATION AT NEW STRUCTURE 406.2
- EXTREME HIGH WATER ELEVATION AT NEW STRUCTURE 429.0 SOURCE OF INFORMATION \_\_\_\_\_
- IS ALL WATER INTENDED TO PASS THROUGH NEW STRUCTURE \_\_\_\_\_ Yes
- DOES STREAM REACH ITS MAXIMUM HIGH WATER ELEVATION RAPIDLY \_\_\_\_\_ Yes IS ORDINARY RISE RAPID \_\_\_\_\_ Yes
- LOW WATER ELEVATION AT NEW STRUCTURE 401.7
- DRAINAGE AREA IN ACRES ABOVE STRUCTURE 202.0 CHARACTER OF TERRAIN Mountainous
- IS STREAM EVER DRY \_\_\_\_\_ NO
- VELOCITY OF STREAM AT HIGH WATER STAGE 538 ESTIMATED DISCHARGE 232 cfs
- AREA FULL OPENING 43.2 AREA BELOW ORDINARY H.W. 24
- CHARACTER OF SCOUR \_\_\_\_\_ DRIFT \_\_\_\_\_ ICE \_\_\_\_\_
- ESTIMATED DRAINAGE AREA ABOVE NATURAL OR ARTIFICIAL STORAGE \_\_\_\_\_
- VERTICAL CLEARANCE ABOVE FLOOD ELEVATION \_\_\_\_\_
- ARE SIDEWALKS REQUIRED, IF SO ON WHAT SIDE \_\_\_\_\_ BOTH SIDES
- RECOMMENDED TYPE OF PAVEMENT 2" Bituminous Concrete Pavement
- TRAFFIC TO BE MAINTAINED UNDER ITEM NO. \_\_\_\_\_ ONE OR TWO WAYS \_\_\_\_\_ PROBABLE COST \_\_\_\_\_
- PROBABLE COST OF CLEARING AND GRUBBING STREAM CHANNEL AT STRUCTURE SITE \_\_\_\_\_
- SHOULD PROVISIONS BE MADE FOR PUBLIC UTILITIES \_\_\_\_\_
- ESTIMATED ALLOWABLE LOAD ON FOUNDATIONS \_\_\_\_\_ SHOULD PILES BE USED \_\_\_\_\_ EST. LGTH. \_\_\_\_\_

**FOUNDATION INFORMATION**

OBTAINED FOR DESIGN PURPOSES ONLY, THE STATE ASSUMES NO RESPONSIBILITY WHATSOEVER FOR THE SUFFICIENCY OR ACCURACY OF THE INFORMATION SHOWN. BOULDERS MAY BE ENCOUNTERED AT ANY PIER OR ABUTMENT LOCATION. FOR BORING LOGS SEE SHEET NO. 2

**GENERAL NOTES**

DESIGN SPECIFICATION: AASHTO 1957 Edition and as modified by Vermont Dept. of Highways.

LIVE LOAD: H20-S16-44 and Military Loading

DESIGN STRESSES: Structural Steel  $f_s = 18,000$  p.s.i.; Reinforcing Steel  $f_s = 20,000$  p.s.i.; Concrete  $f_c = 1,200$  p.s.i.  $f_c = 3,000$  p.s.i.

CLEARANCE: Horizontal as shown on drawings; Vertical 15'-11 1/2'

SUPERSTRUCTURE: Separate structure for each lane; 30' Roadway, 1'-6" Safety Walk, as per SCB-30-56; 3 Simple span, rolled beams, composite design, as per SCB-30-56; 63±-87±-61± Left Lane 64±-94±-68± Right Lane; Aluminum bridge railing or galvanized bridge railing, and granite bridge curb as per SB-56-57 (1 & 2).





SUBSTRUCTURE: Open piers, round columns spaced 12'-6" o.c.; Stub Abutments

FOUNDATION: Stub abutment: Steel piles; Piers: Piers A & C, steel piles; Piers B & D, individual footings to ledge

**LIST OF SHEETS** IM 089-2(26)

SHEET NO.	DESCRIPTION
109	GENERAL PLAN
110	BORINGS
111	PLAN AND ELEVATION
112	ABUTMENTS NO. 1 AND 2
113	ABUTMENTS NO. 3 AND 4
114	ABUTMENT FOOTING
115	REINFORCING PLANS
116	WINGWALLS
117	PIERS A AND C
118	PIERS B AND D
119	APPROACH SLABS
120	STRUCTURAL STEEL PLAN
121	STRUCTURAL DETAILS
122	REINFORCING SCHEDULE
123	96" PIPE PLAN, ELEV. & SEC.
124	HIGHWAY'S PLANS & PROFILES
125	INTERSTATE CROSS SECTION
285-286	U.S. RTE. 2 (REL.) CROSS SECTION
101-102	SCB-30-58 (1 & 2)
103-104	SB-56-57 (1 & 2)
105	SB-20-56
106	SB-22-58
107	SB-AS-45° Skew-57

APPROVED BY Wm. A. Henderson DATE 12-16-58  
**THE CLARKE ENGINEERING CO., INC.** CONSULTING ENGINEERS  
 BOSTON MASSACHUSETTS  
 SURVEYED BY J.V.B. CHECKED BY D.S. & J.B. SCALE AS NOTED  
 DRAWN BY F.P.D. IN CHARGE J.V.B. DATE 6-19-58  
 PROJECT NO. I-89-2(7) SHEET 245 OF 307

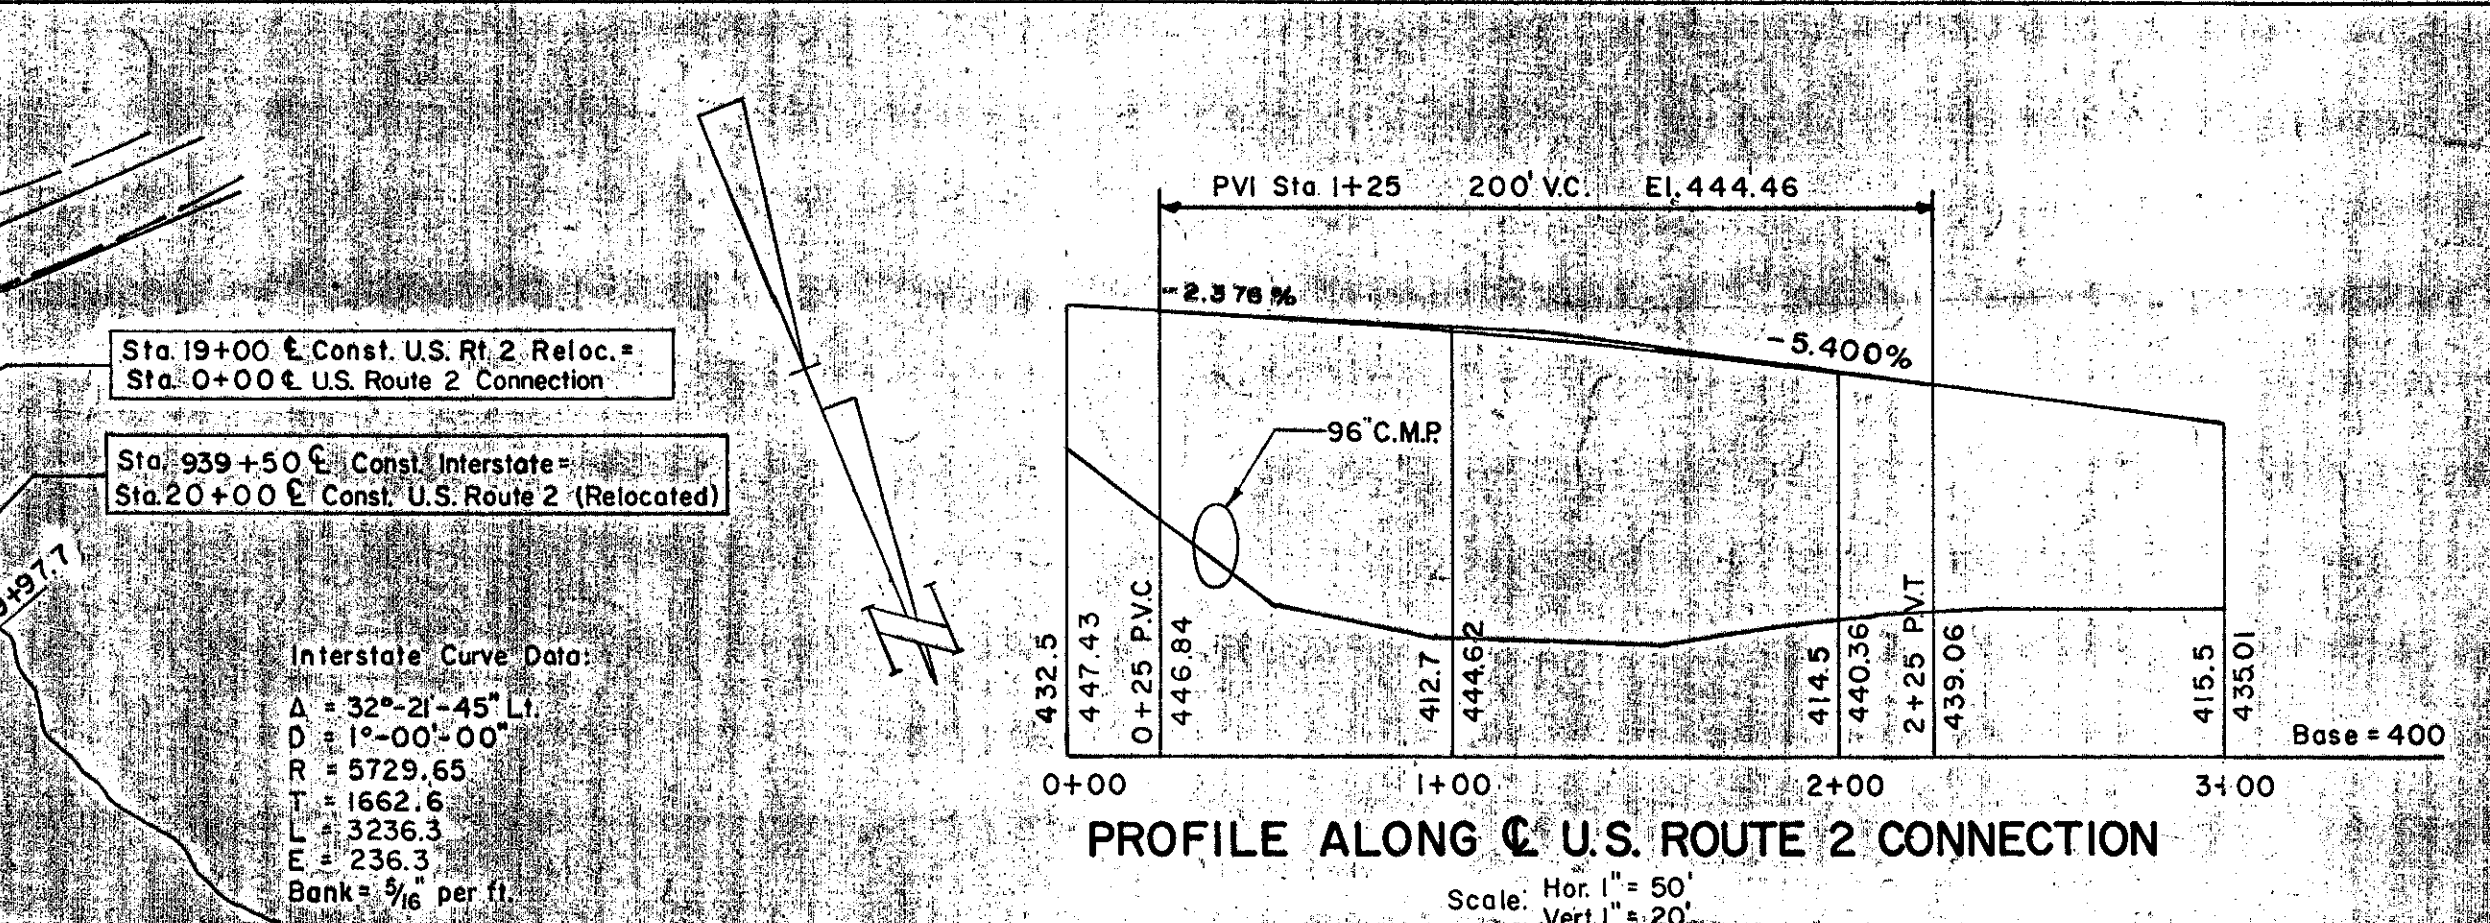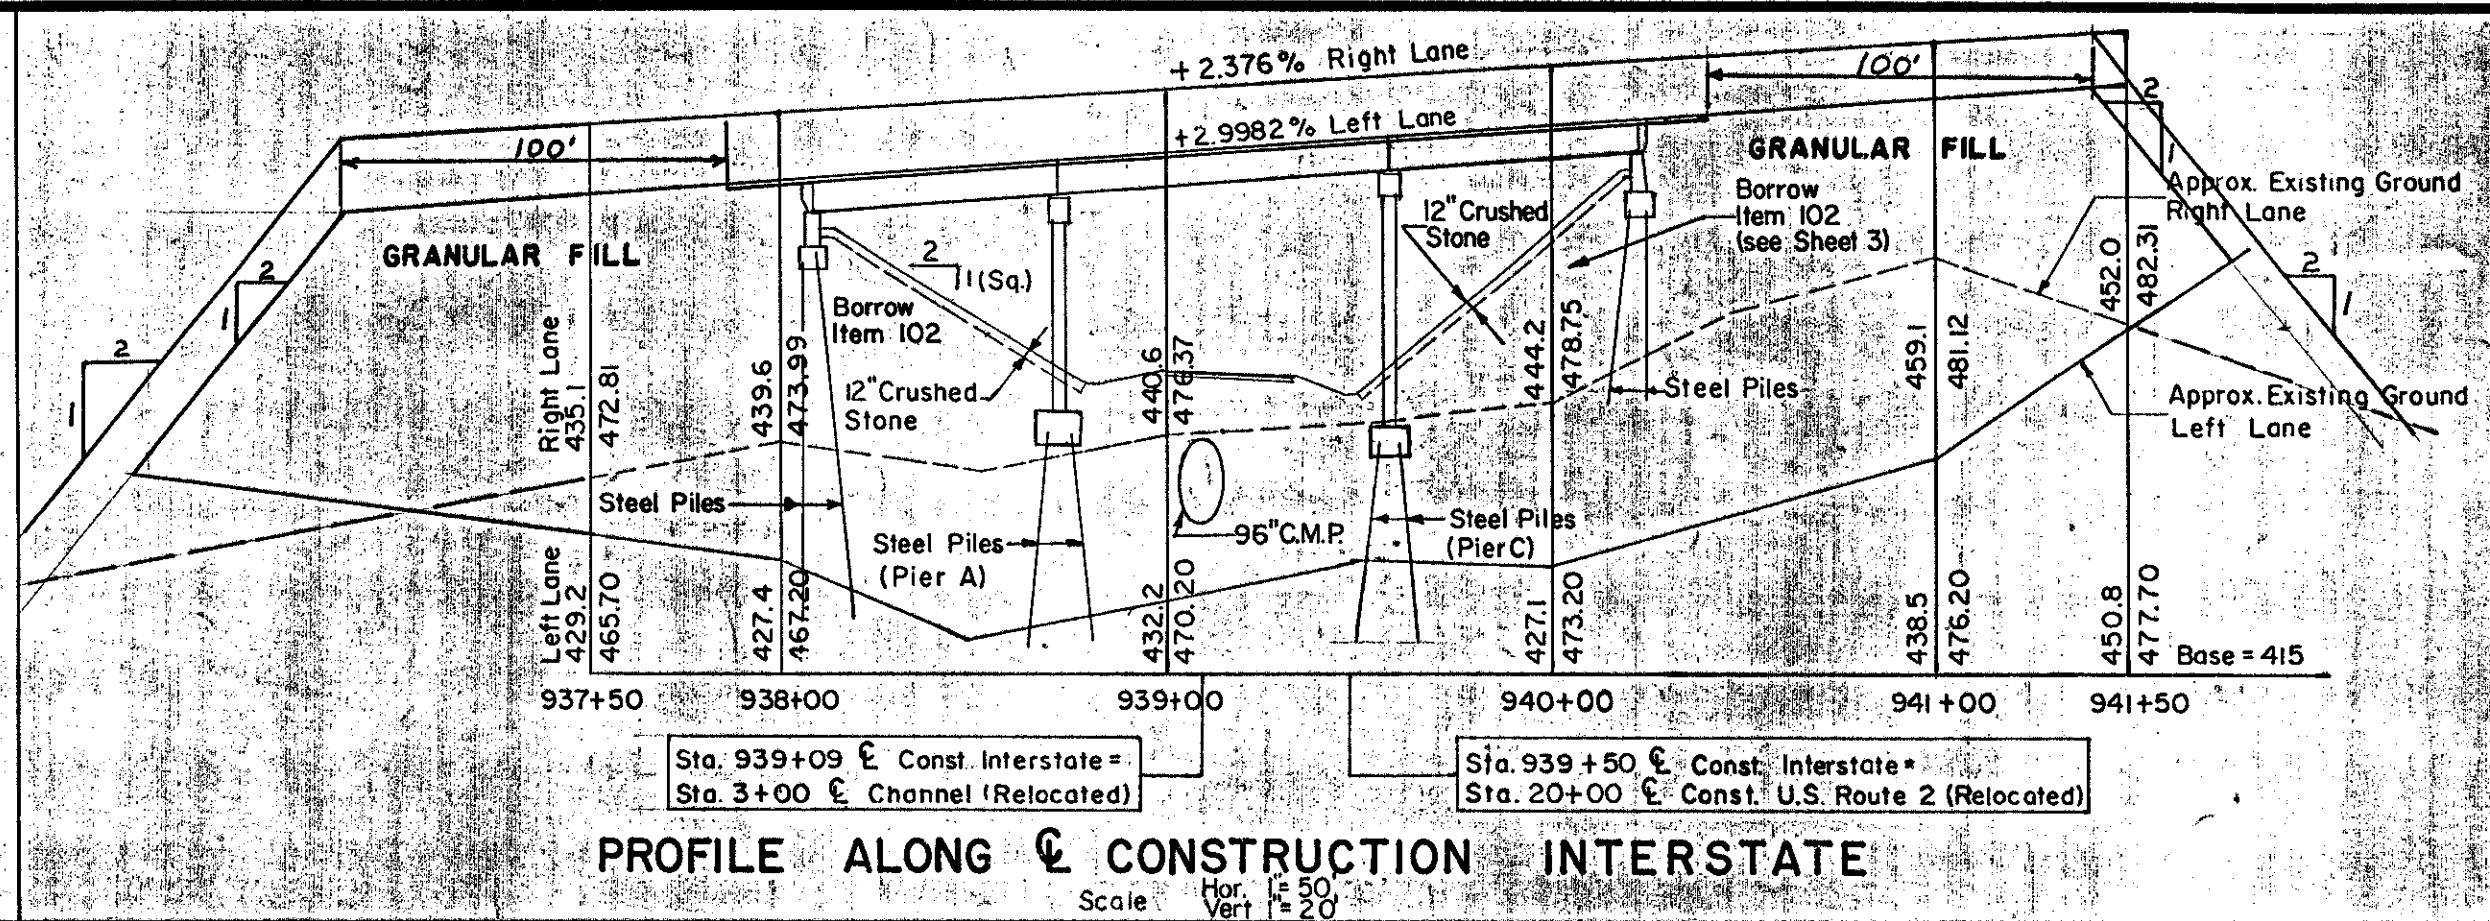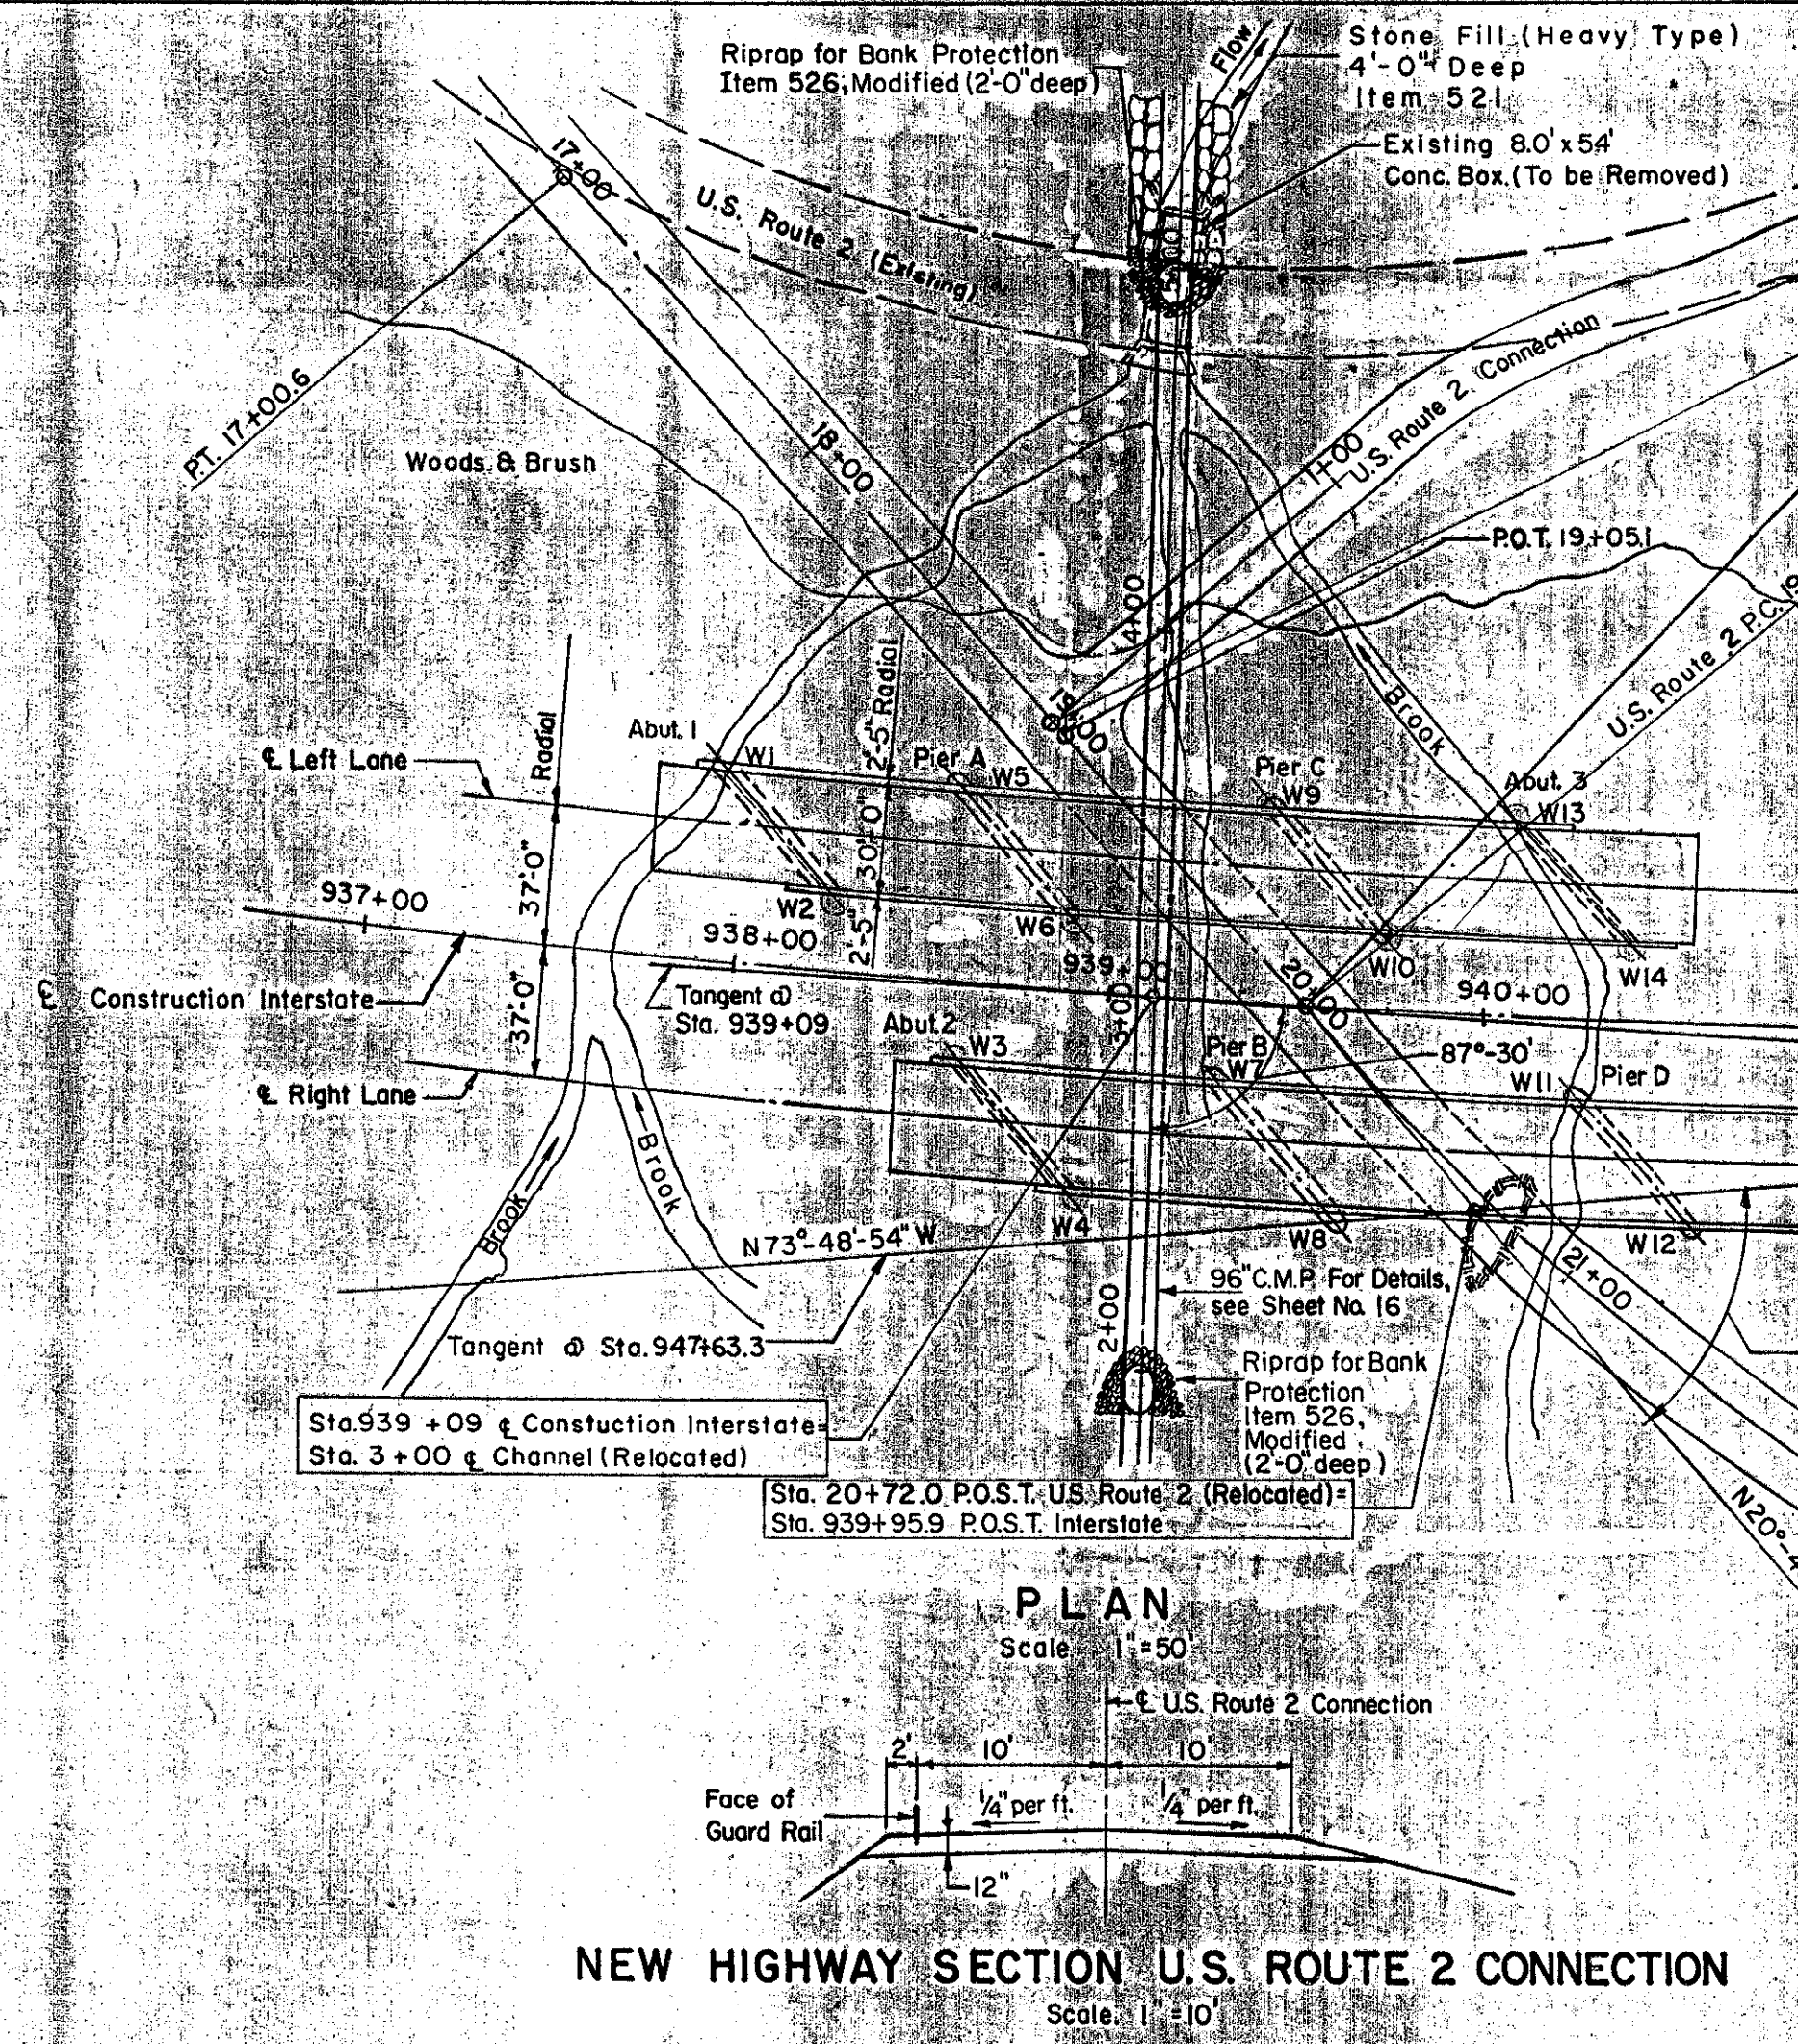
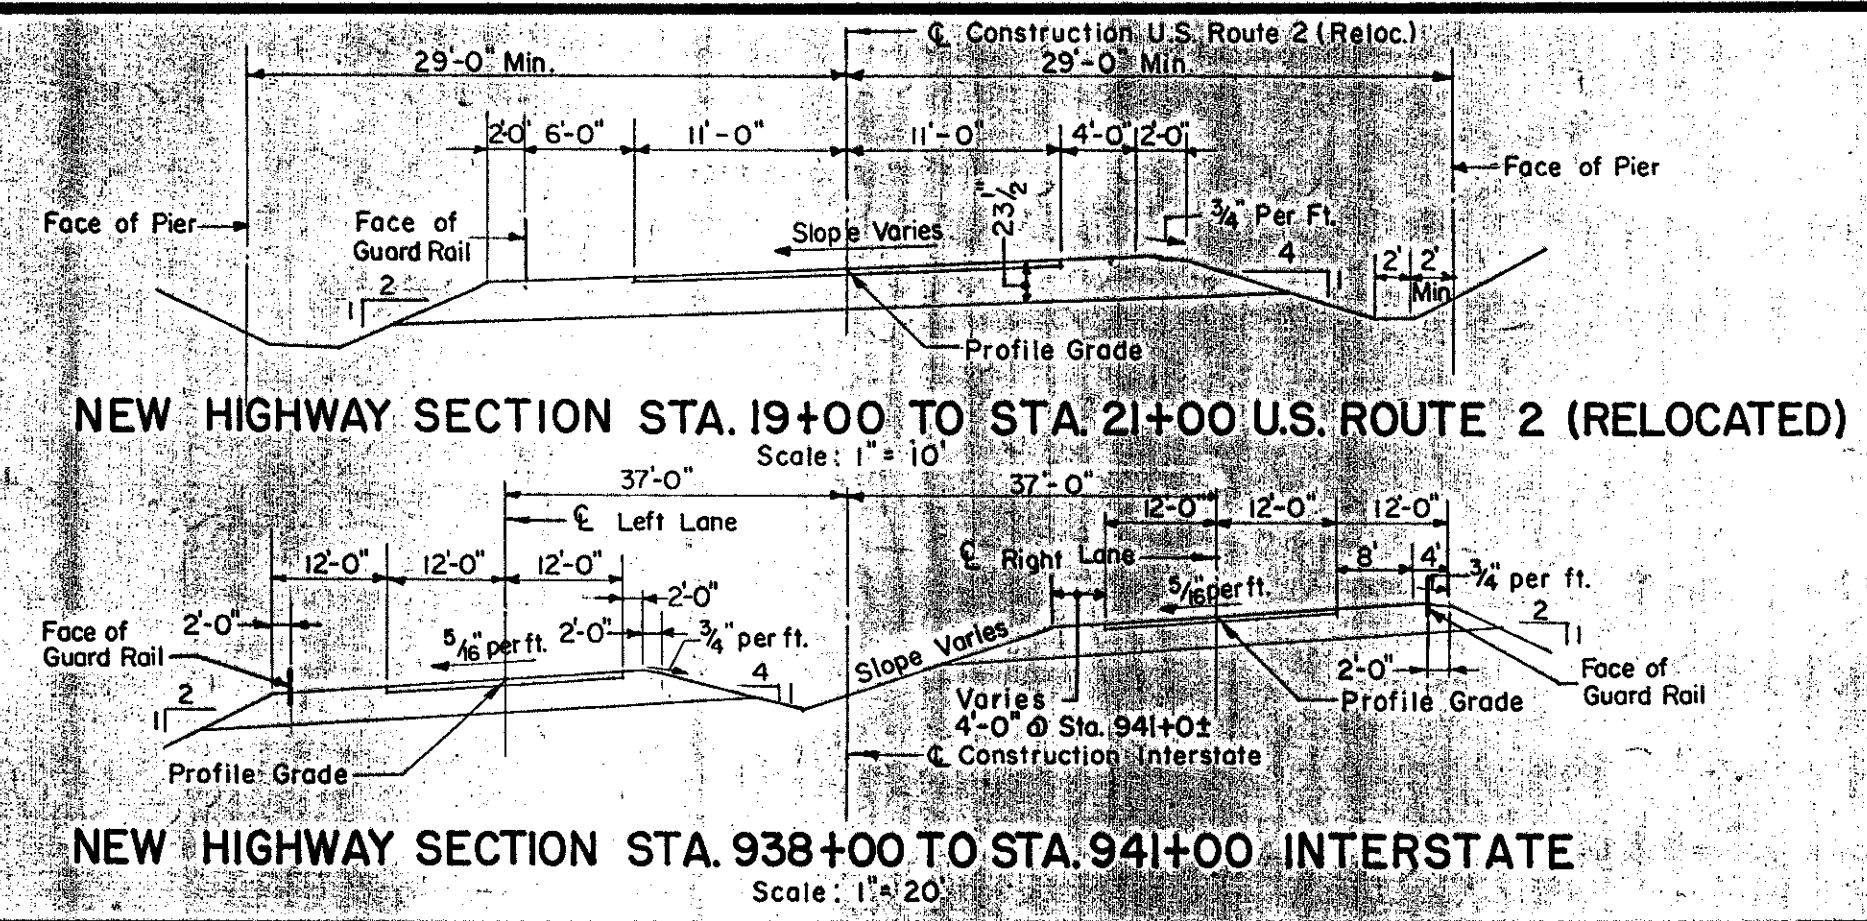


**SUMMARY OF QUANTITIES FOR PIPE**

ITEM NO.	DESCRIPTION	UNIT	NET	OVER-RUN	TOTAL	FINAL
107	Structure Excavation	C.Y.	787	79	866	
222	Gravel Backfill	C.Y.	1950	507	2457	
401-B	Concrete Class B (Mod.)	C.Y.	6	-	6	
402	Reinforcing Steel	LBS.	512	-	512	
429-A	Corrugated Galv. Metal Plate Pipe	L.S.	1	-	1	
526	Riprap for Bank Protection (Mod.)	C.Y.	94	14	108	
521	Stone Fill (Heavy Type)	C.Y.	610	90	700	

**SUMMARY OF QUANTITIES FOR BRIDGE**

ITEM NO.	DESCRIPTION	UNIT	NET	OVER-RUN	TOTAL	FINAL
102	Borrow	C.Y.	21000	2100	23100	21435
107	Structure Excavation	C.Y.	327	35	362	600
204	Sub-Base of Crushed Rock (Mod.)	C.Y.	390	60	450	472
222	Gravel Backfill	C.Y.	123	34	157	123
361-B	Bit. Conc. Pavement (Mod.)	TONS	229	33	262	229
401-B	Concrete Class B (Mod.)	C.Y.	34	68	102	136
402	Reinforcing Steel	LBS.	225,108	-	225,108	234,817
403-d	Spiral Reinforcement (13,300 LB.)	L.S.	1	-	1	1
404-A	Structural Steel	LBS.	571,844	44,366	616,210	575,518
407	Asphaltic-Asbestos Coating	S.Y.	113	-	113	113
504	Steel Piling	L.F.	4508	-	4508	4,634
556-C	Granite Bridge Curb (Type I)	L.F.	1004	-	1004	1,004
572	Bridge Railing	L.F.	885	-	885	883
501	Furnishing Equipment for Driving Piles	Required				

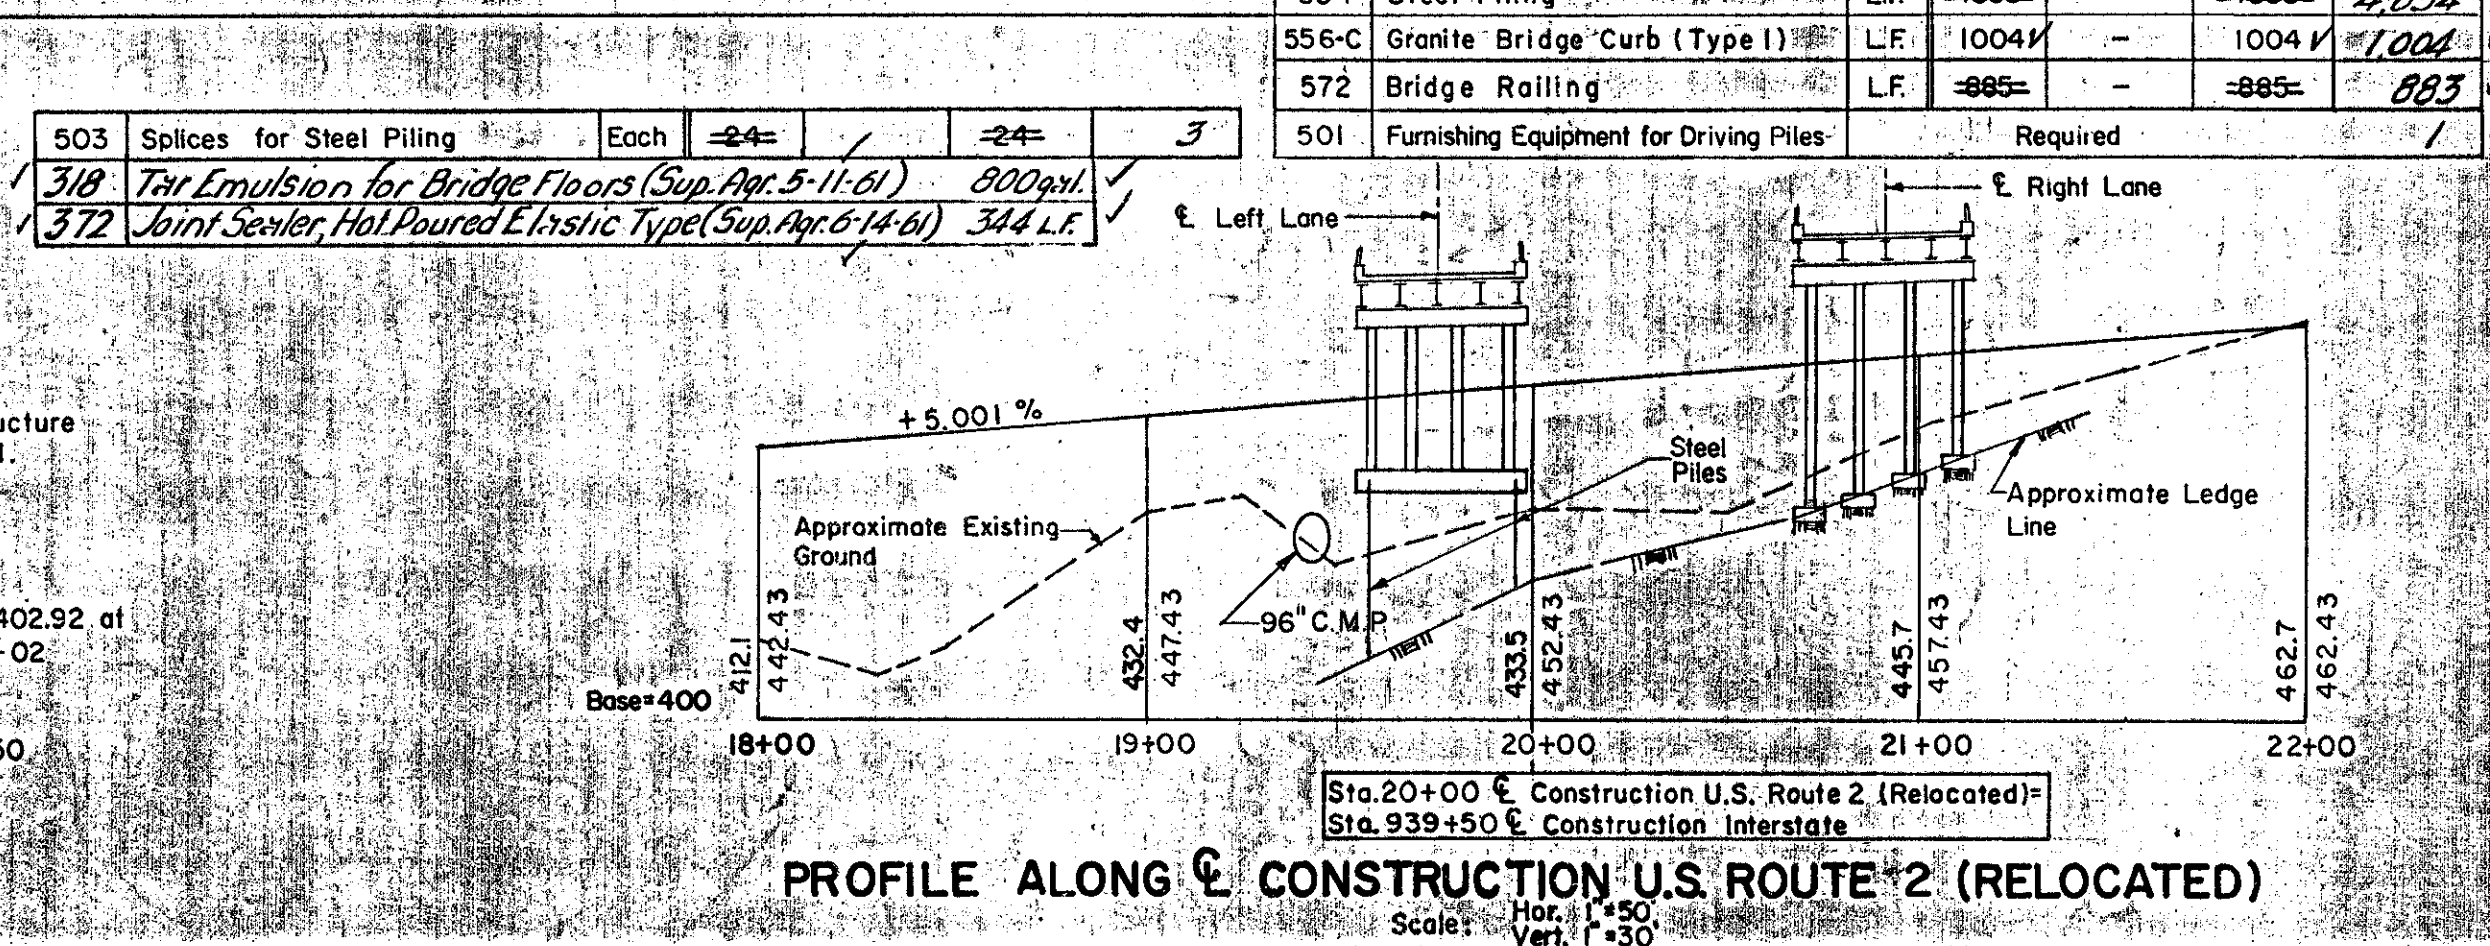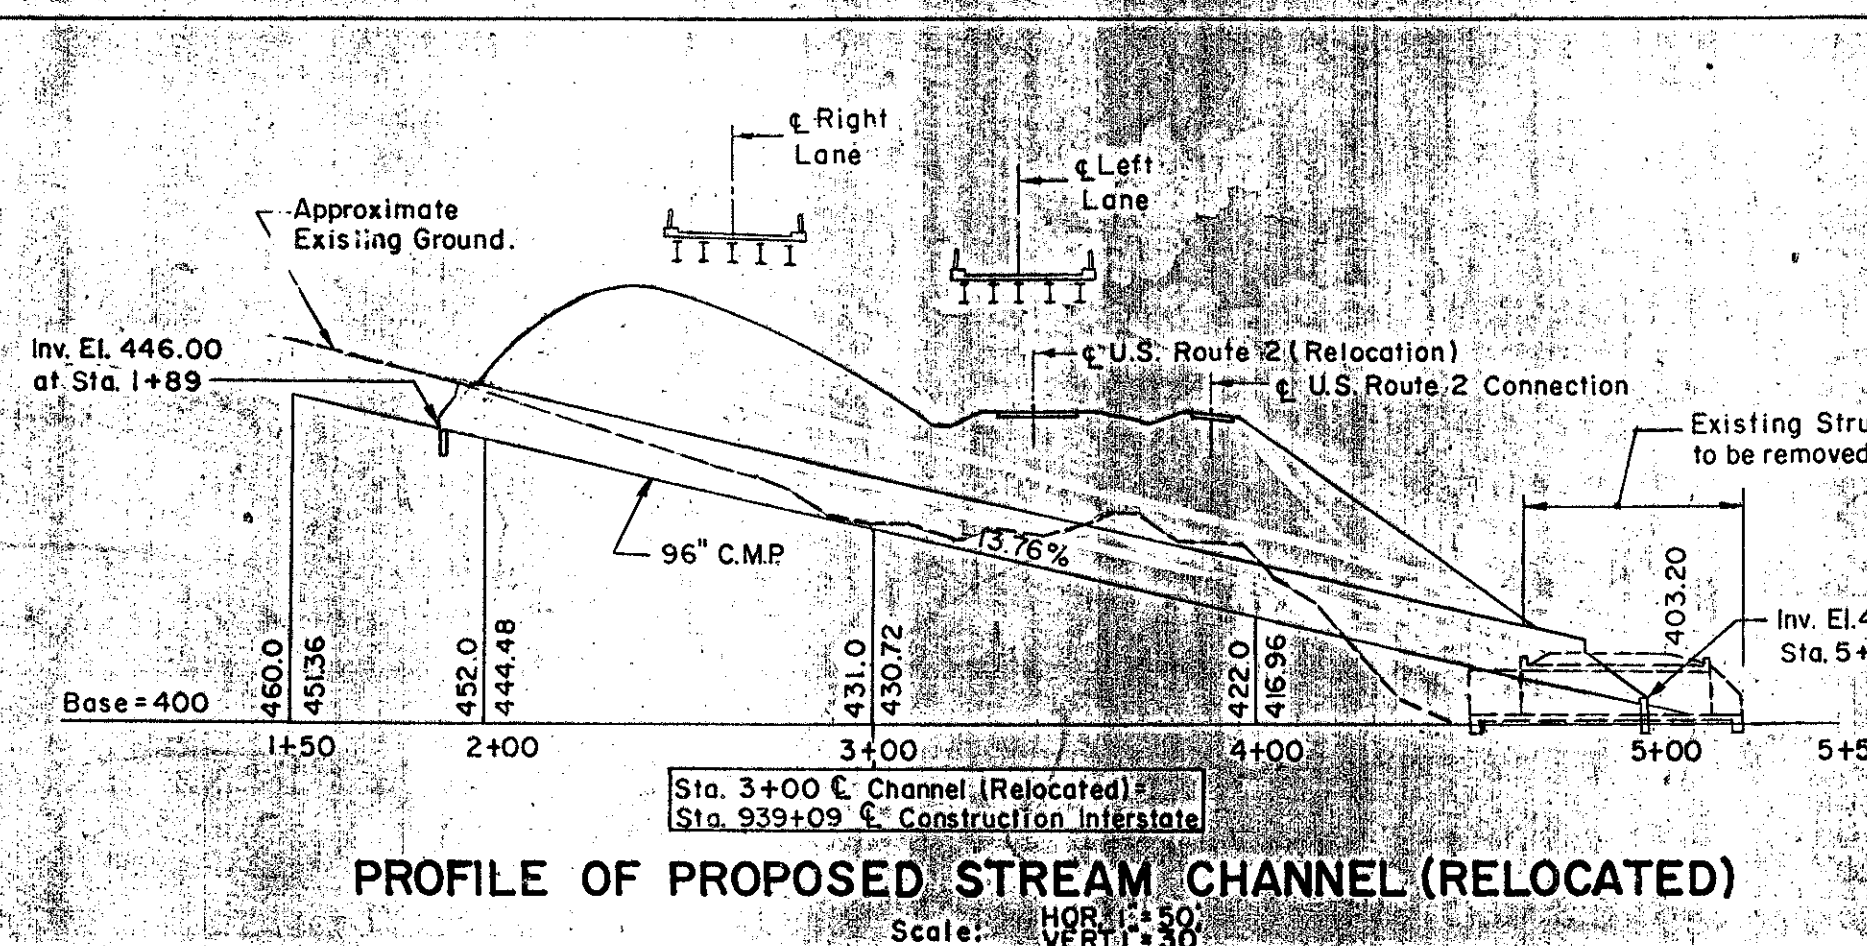

503	Splices for Steel Piling	Each	24	24	3
318	Tar Emulsion for Bridge Floors (Sup. Apr. 5-11-61)	800 gal.			
372	Joint Sealer, Hot Poured Elastic Type (Sup. Apr. 6-14-61)	344 L.F.			


**GENERAL PLAN**

STATE OF VERMONT  
 DEPARTMENT OF HIGHWAYS

INTERSTATE PROJECT in the town of  
**WATERBURY**

INTERSTATE OVER STA. 939+50  
 U.S. ROUTE 2 (RELOC.) OVER STA. 20+00

APPROVED BY Wm. A. Henderson DATE 12-16-58  
**THE CLARKE ENGINEERING CO., INC.** CONSULTING ENGINEERS  
 BOSTON MASSACHUSETTS  
 SURVEYED BY J.V.B. CHECKED BY D.S. & J.B. SCALE AS NOTED  
 DRAWN BY F.P.D. IN CHARGE J.V.B. DATE 6-19-58  
 PROJECT NO. I-89-2(7) SHEET 245 OF 307

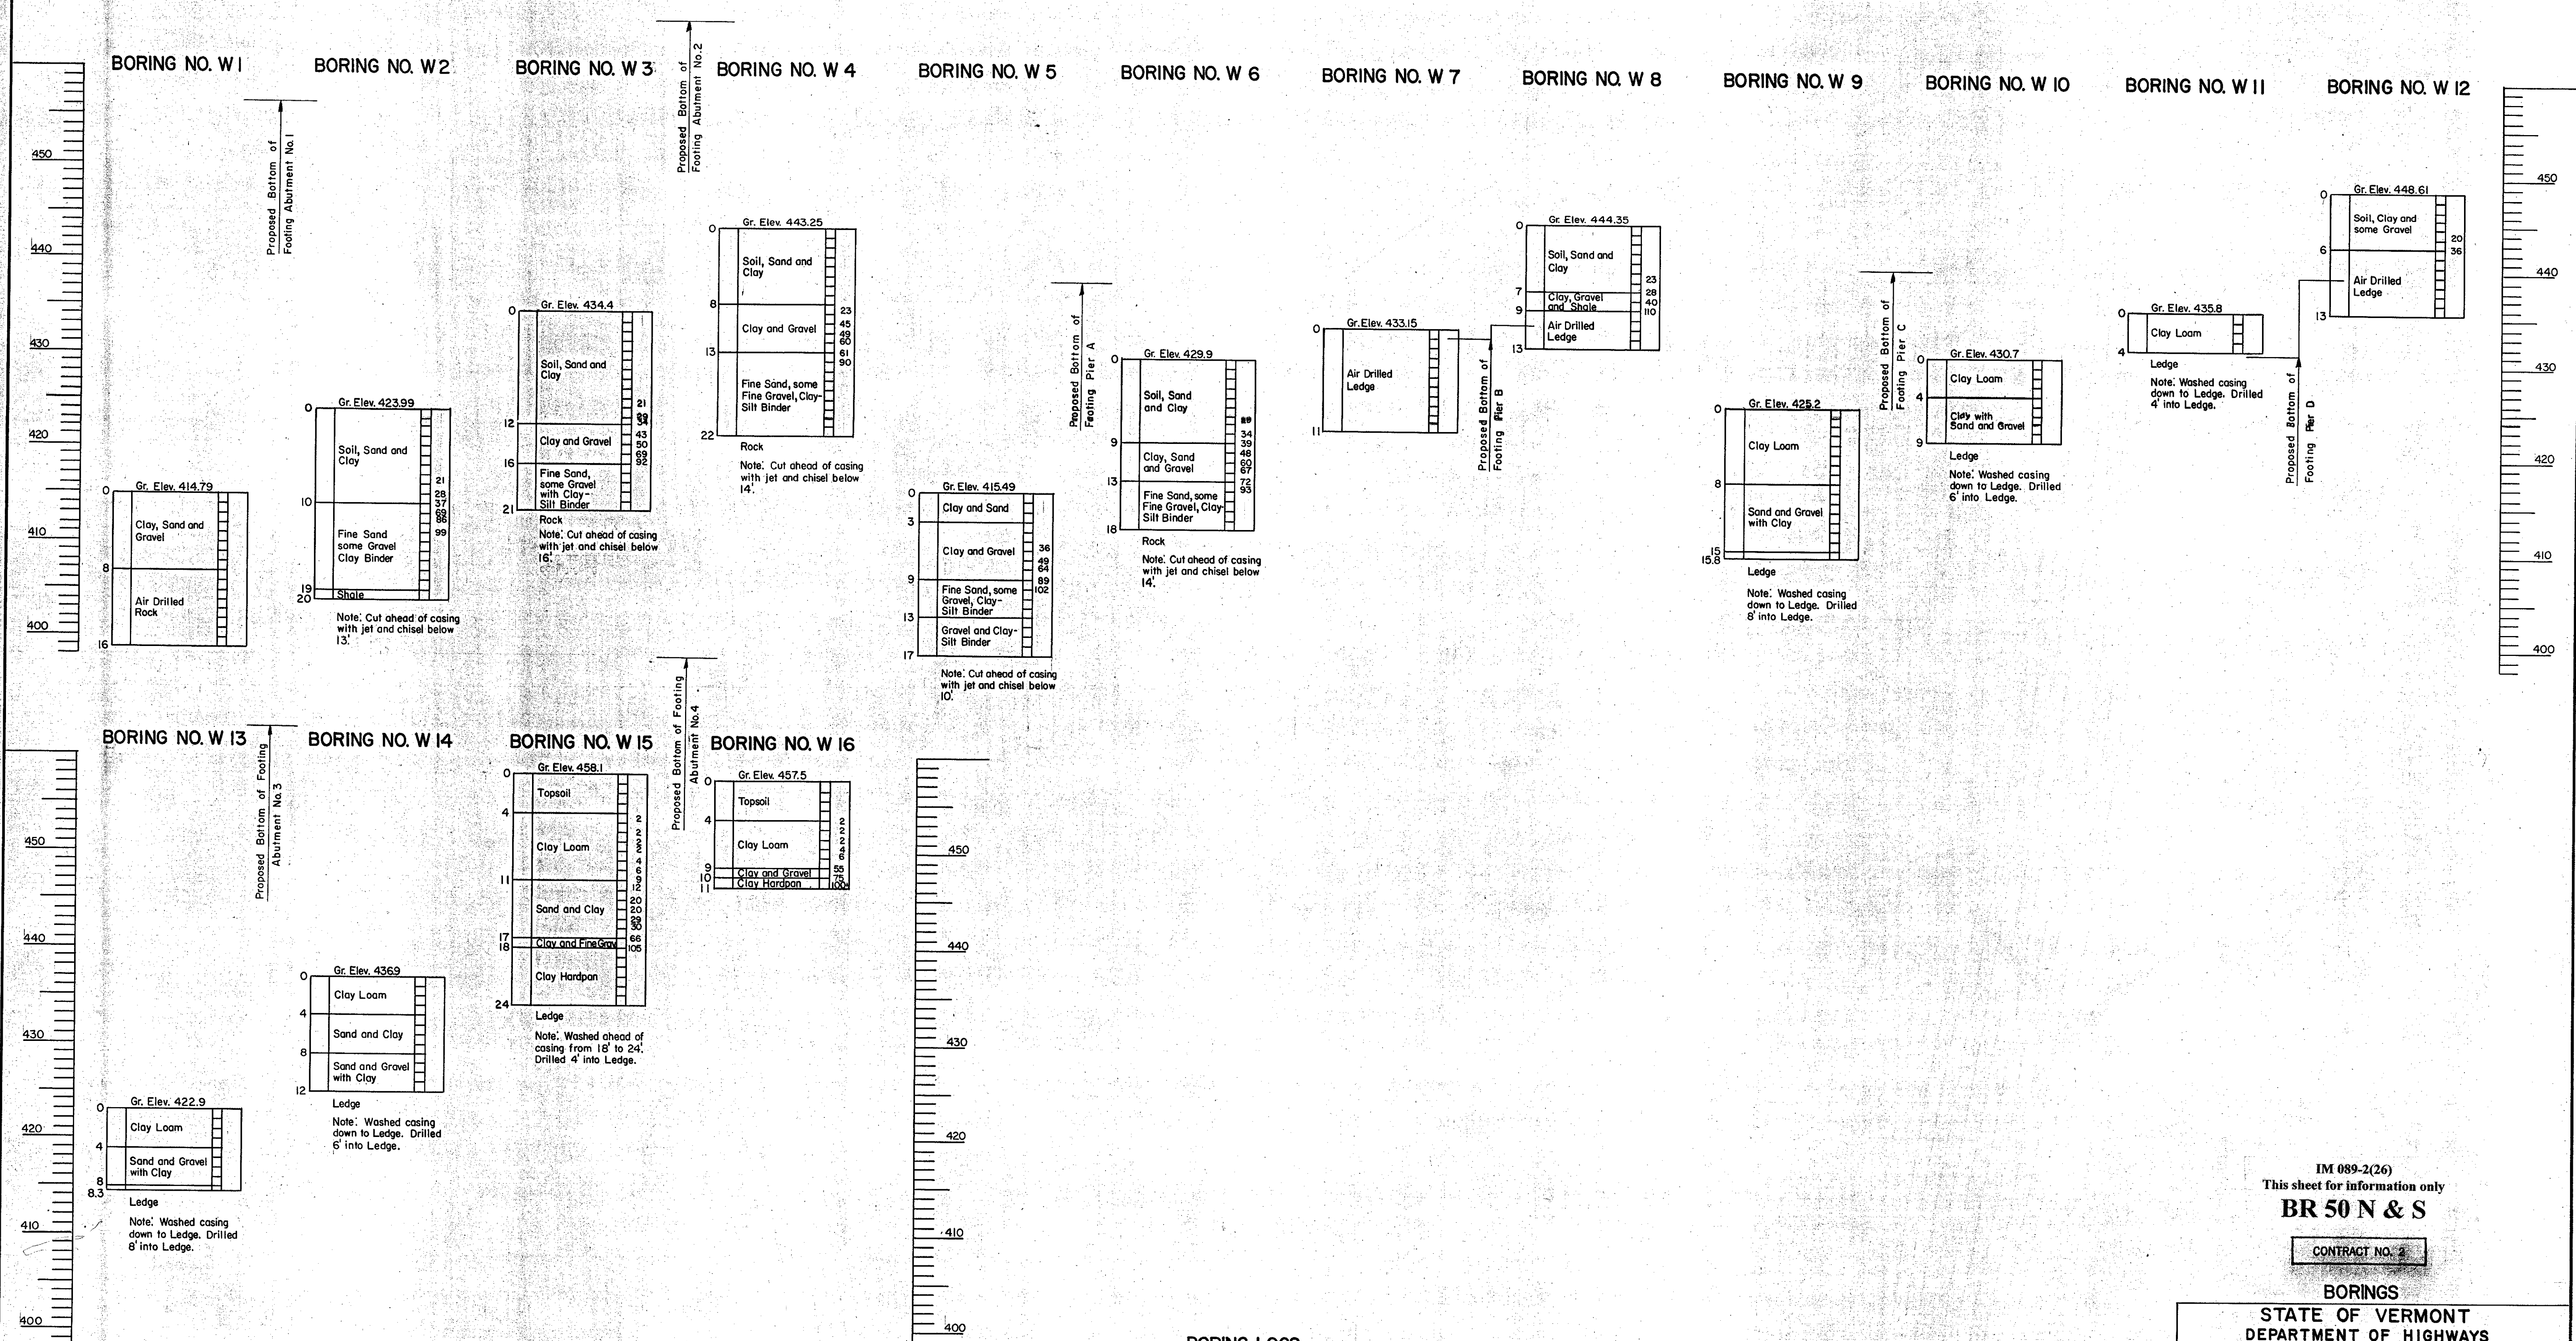

**BORING LOGS**  
Scale: 1/8" = 1'-0"


Note:  
1. For all borings  
Weight of hammer = 350\*  
Drop of hammer = 24"  
Diameter of casing = 2 1/2"  
Thickness of casing 3/8"  
2. For Location of borings see Sheet No. 109  
3. All Borings are Wash Borings

IM 089-2(26)  
This sheet for information only  
**BR 50 N & S**


CONTRACT NO. 2

**BORINGS**  
**STATE OF VERMONT**  
**DEPARTMENT OF HIGHWAYS**  
INTERSTATE PROJECT in the town of  
**WATERBURY**  
INTERSTATE OVER STA. 939+50  
U.S. ROUTE 2 (RELOC.) OVER STA. 20+00  
THE CLARKESON ENGINEERING CO., INC.  
CONSULTING ENGINEERS  
BOSTON MASSACHUSETTS  
SURVEYED BY: S.A.L. CHECKED BY: G.B. SCALE: AS NOTED  
DRAWN BY: S.A.L. IN CHARGE: J.V.B. DATE: 6-19-58  
PROJECT NO. I-89-2 (7) SHEET 246 OF 307

S.P.R. DIV. NO.	STATE	PROJECT NO.	SHEET NO.	TOTAL SHEETS
1	VT.	I-89-2(7)	111	295

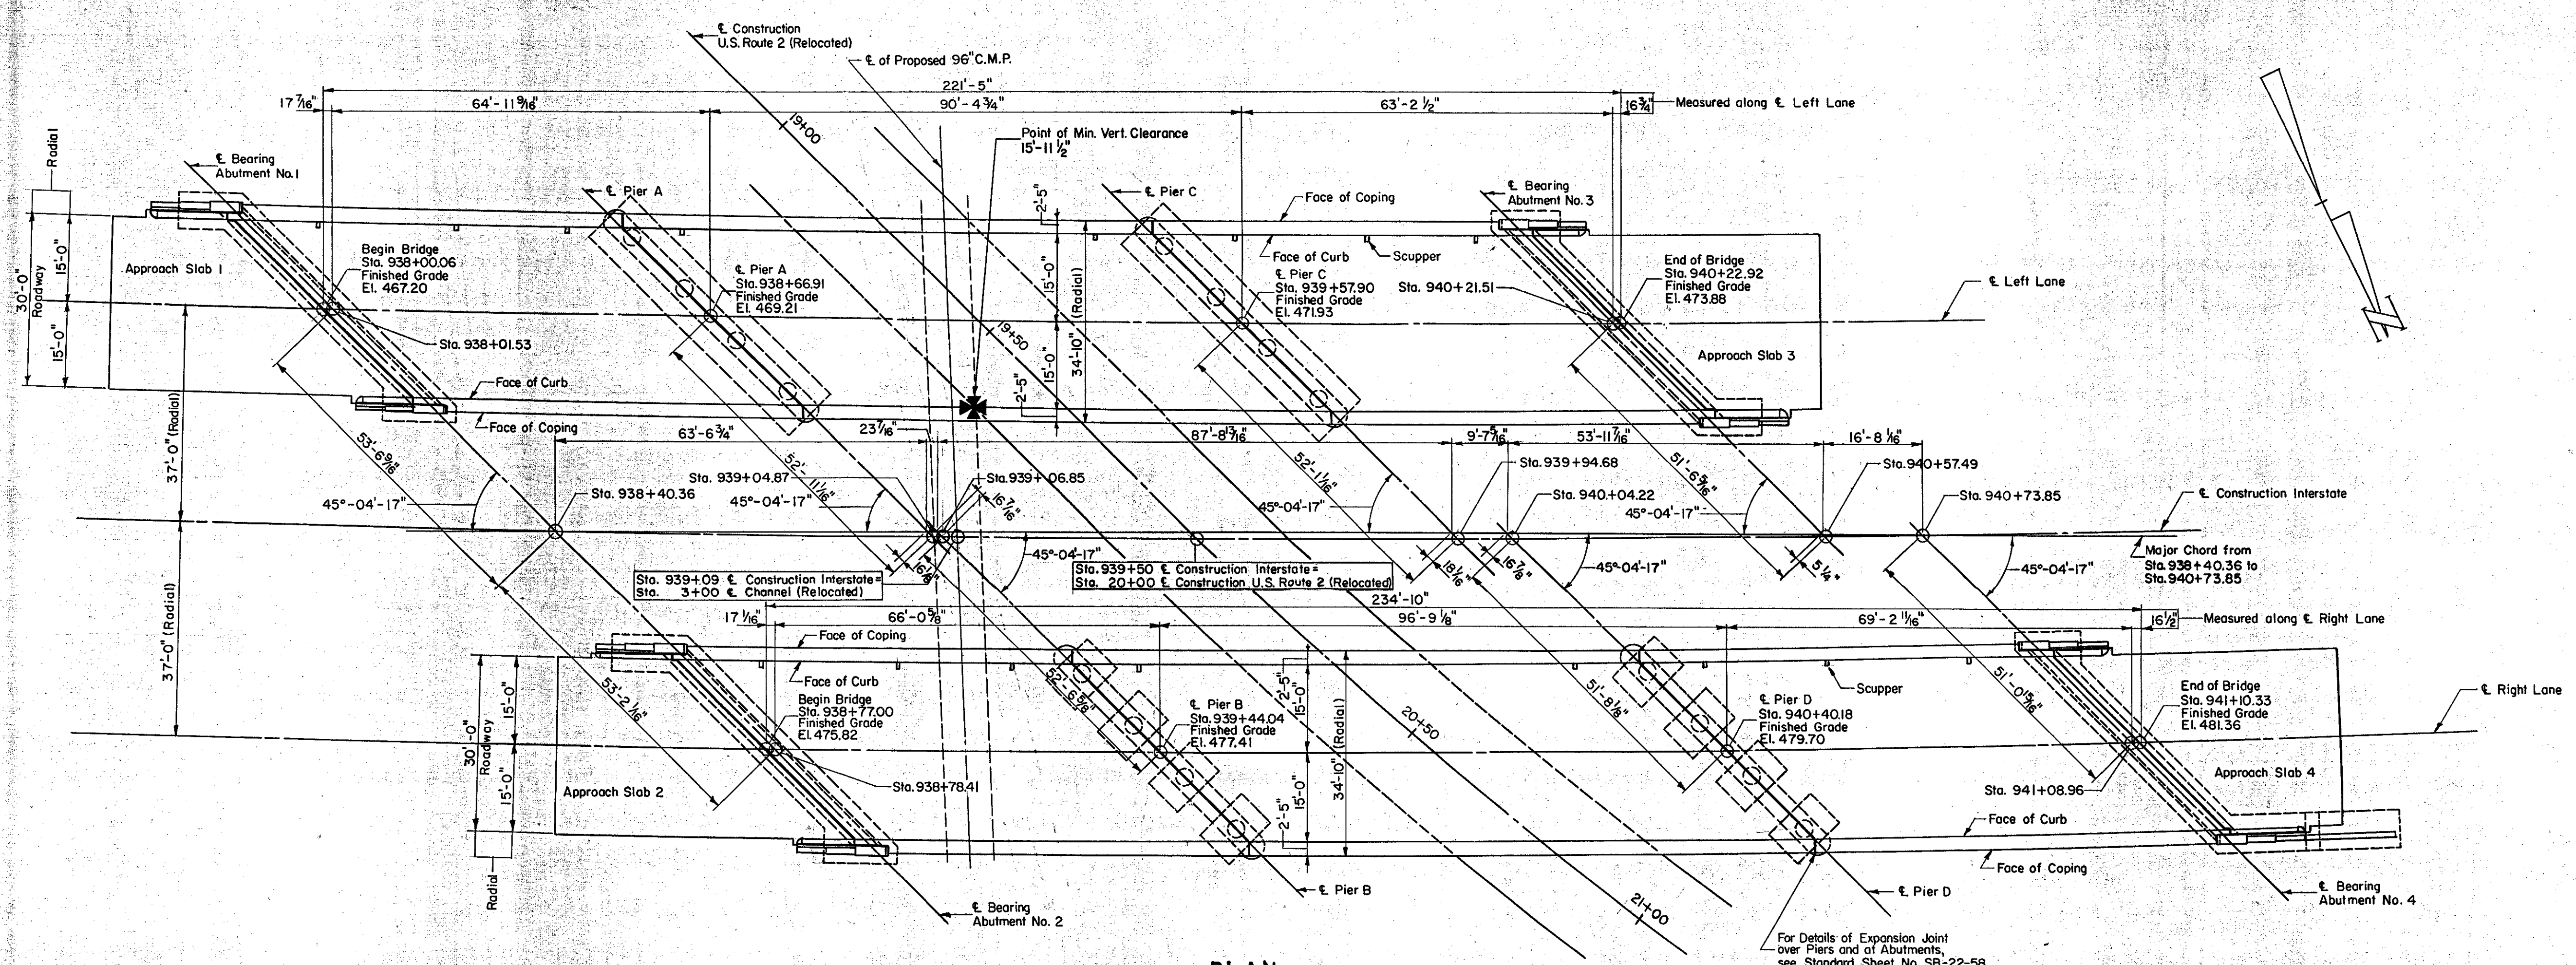

**PLAN**  
Scale: 1/16" = 1'-0"

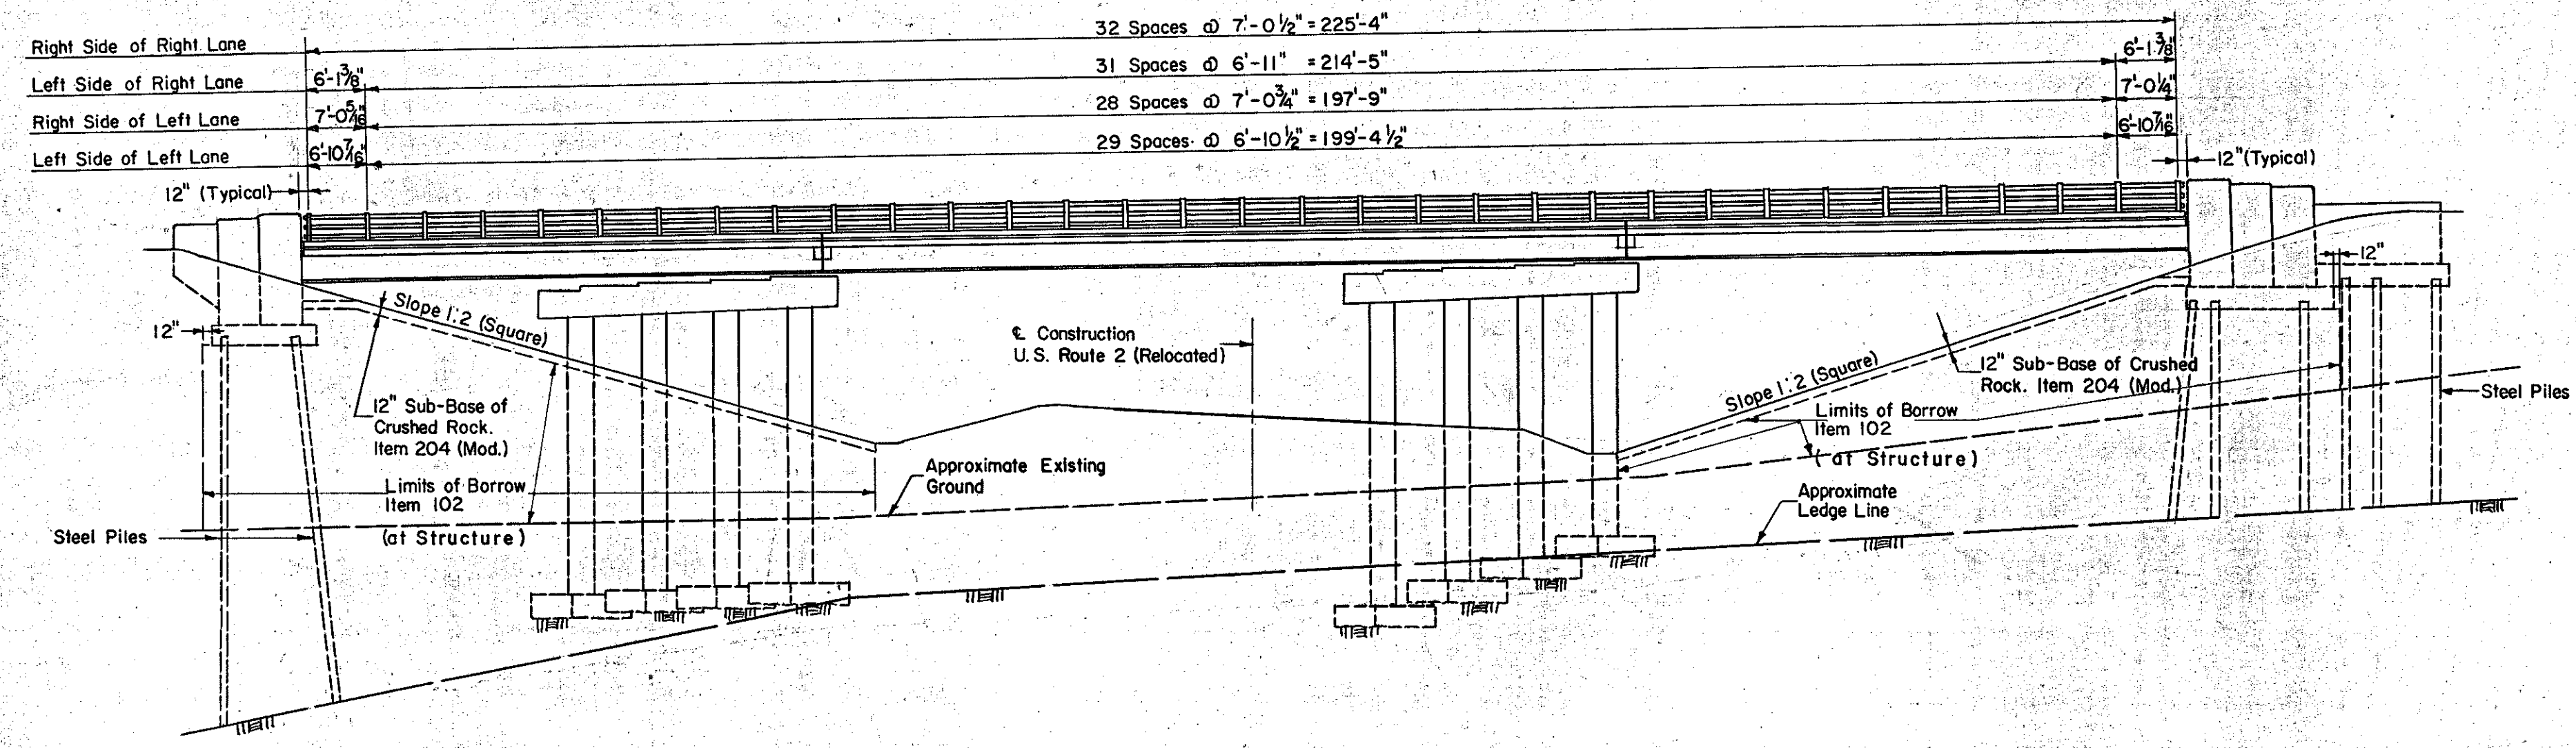

**NORTHERLY ELEVATION**  
Scale: 1/16" = 1'-0"

Right Side of Right Lane	32 Spaces @ 7'-0 1/2" = 225'-4"	6'-1 1/8"
Left Side of Right Lane	31 Spaces @ 6'-11" = 214'-5"	7'-0 1/4"
Right Side of Left Lane	28 Spaces @ 7'-0 3/4" = 197'-9"	6'-10 1/8"
Left Side of Left Lane	29 Spaces @ 6'-10 1/2" = 199'-4 1/2"	12" (Typical)

- Notes:
1. Railing Posts to be set normal to Grade.
  2. Omit set screws at upgrade end of railing panels at Expansion Joints over Piers.
  3. All stations refer to  $\epsilon$  Construction Interstate.
  4. All dimensions are horizontal dimensions.
  5. For Scupper layout, see Framing Plan Sheet No. 119.
  6. For details of railing, see Standard Sheet No. SB-56-57.
  7. For Bridge Railing, see Standard Sheet No. SB-22-58 (Detail A).

**BR 50 N & S**

CONTRACT NO. 2

**PLAN AND ELEVATION**

**STATE OF VERMONT**  
**DEPARTMENT OF HIGHWAYS**  
INTERSTATE PROJECT in the town of  
**WATERBURY**  
INTERSTATE OVER STA. 939+50  
**U.S. ROUTE 2 (RELOC.)** OVER STA. 20+00


THE CLARKESON ENGINEERING CO., INC.  
CONSULTING ENGINEERS  
BOSTON MASSACHUSETTS  
SURVEYED BY: S.A.L. CHECKED BY: J.B. & D.S. SCALE: AS NOTED  
DRAWN BY: S.A.L. IN CHARGE: J.V.B. DATE: 6-19-58

PROJECT NO. I-89-2(7) SHEET 247 OF 307

**ESTIMATED QUANTITIES**


ITEM NO.	DESCRIPTION	UNIT	SUPERSTRUCTURE		
			NET	OVER-RUN	TOTAL FINAL
102	Borrow	C. Y.	2400	2400	21435
556-C	Granite Bridge Curb (Type I)	L. F.	1004	-	1004
572	Bridge Railing	L. F.	885	-	883

B.P.R. DIV. NO.	STATE	PROJECT NO.	SHEET NO.	TOTAL SHEETS
1	VT.	I-89-2(7)	22	295

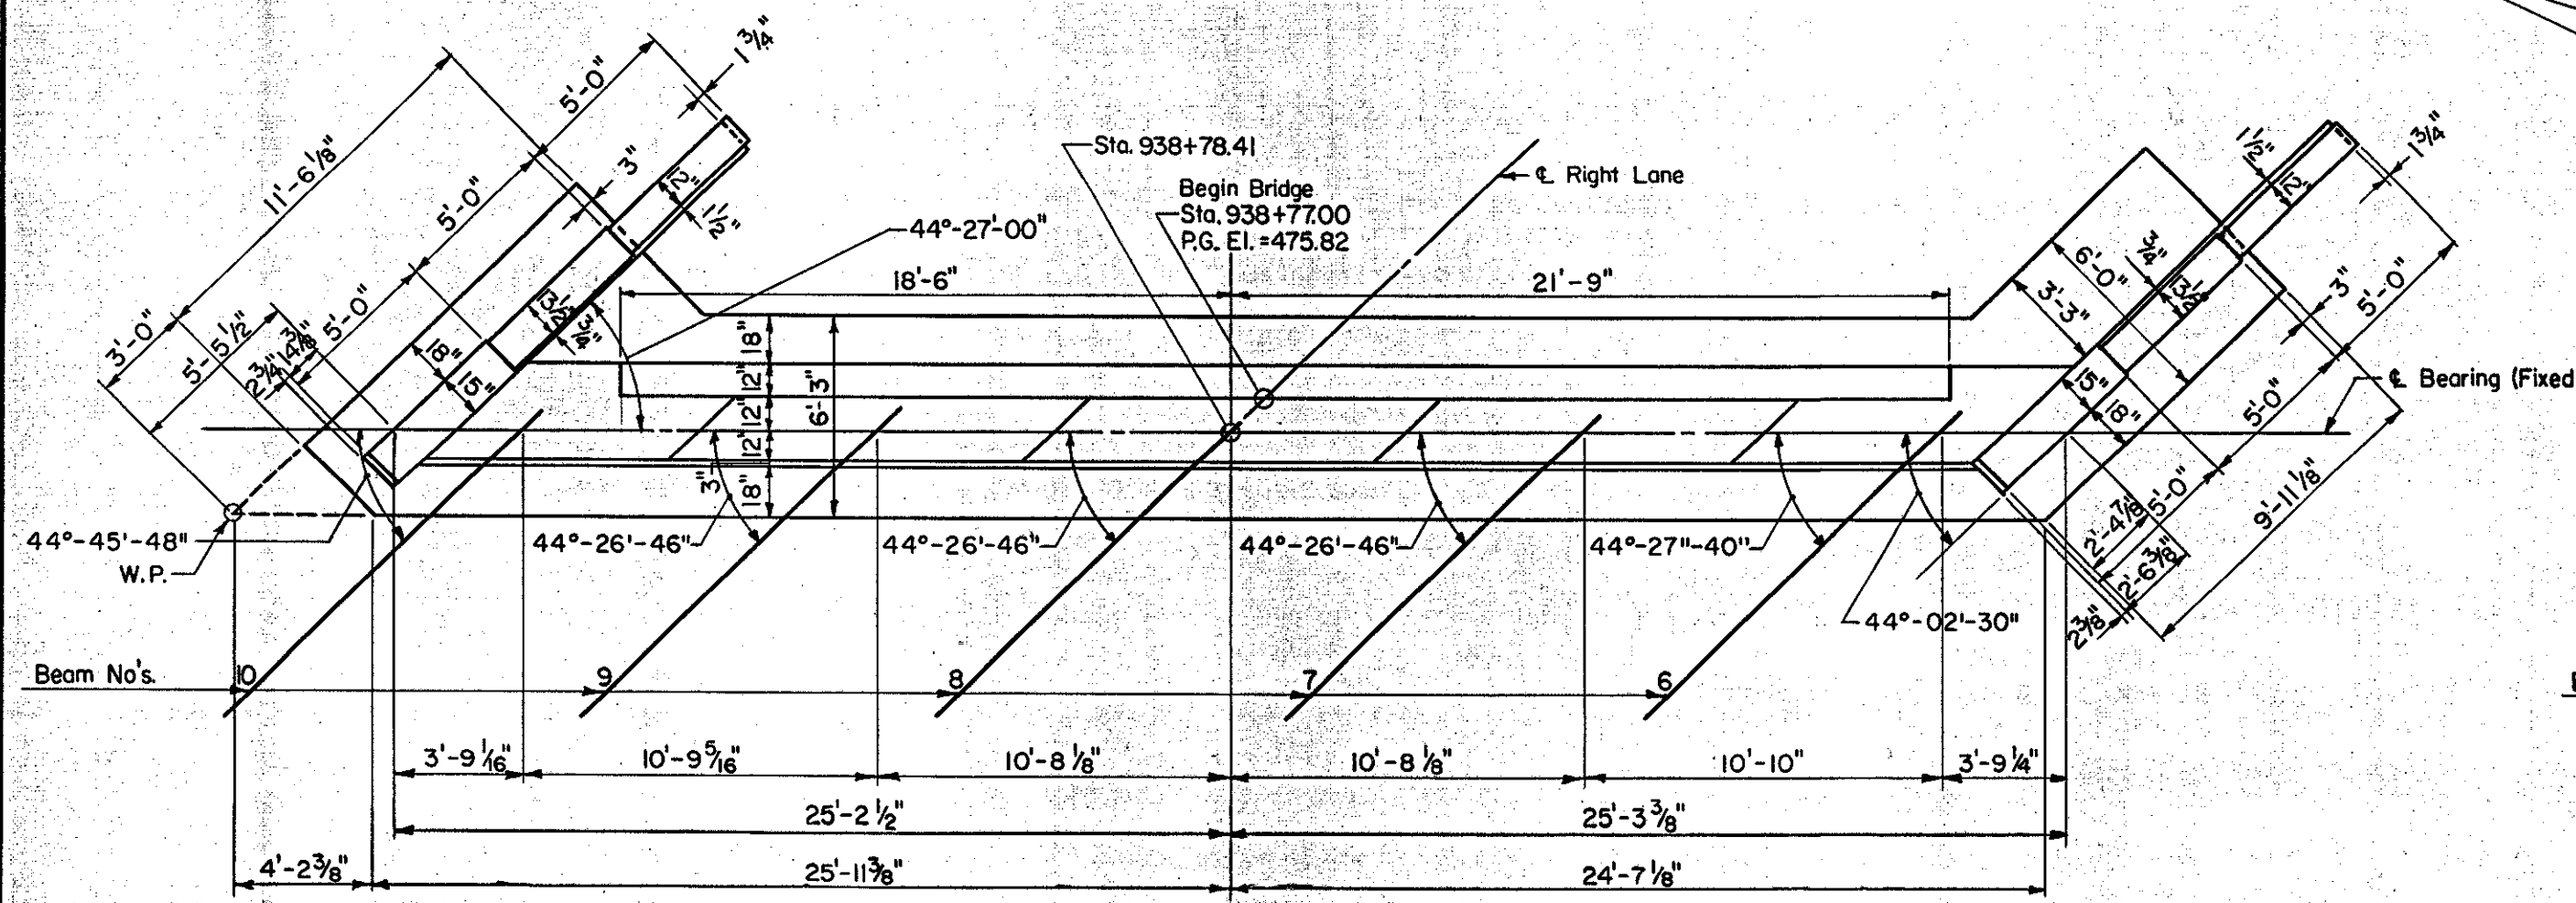


PLAN ABUTMENT NO. 2

Scale:  $\frac{3}{16}'' = 1'-0''$

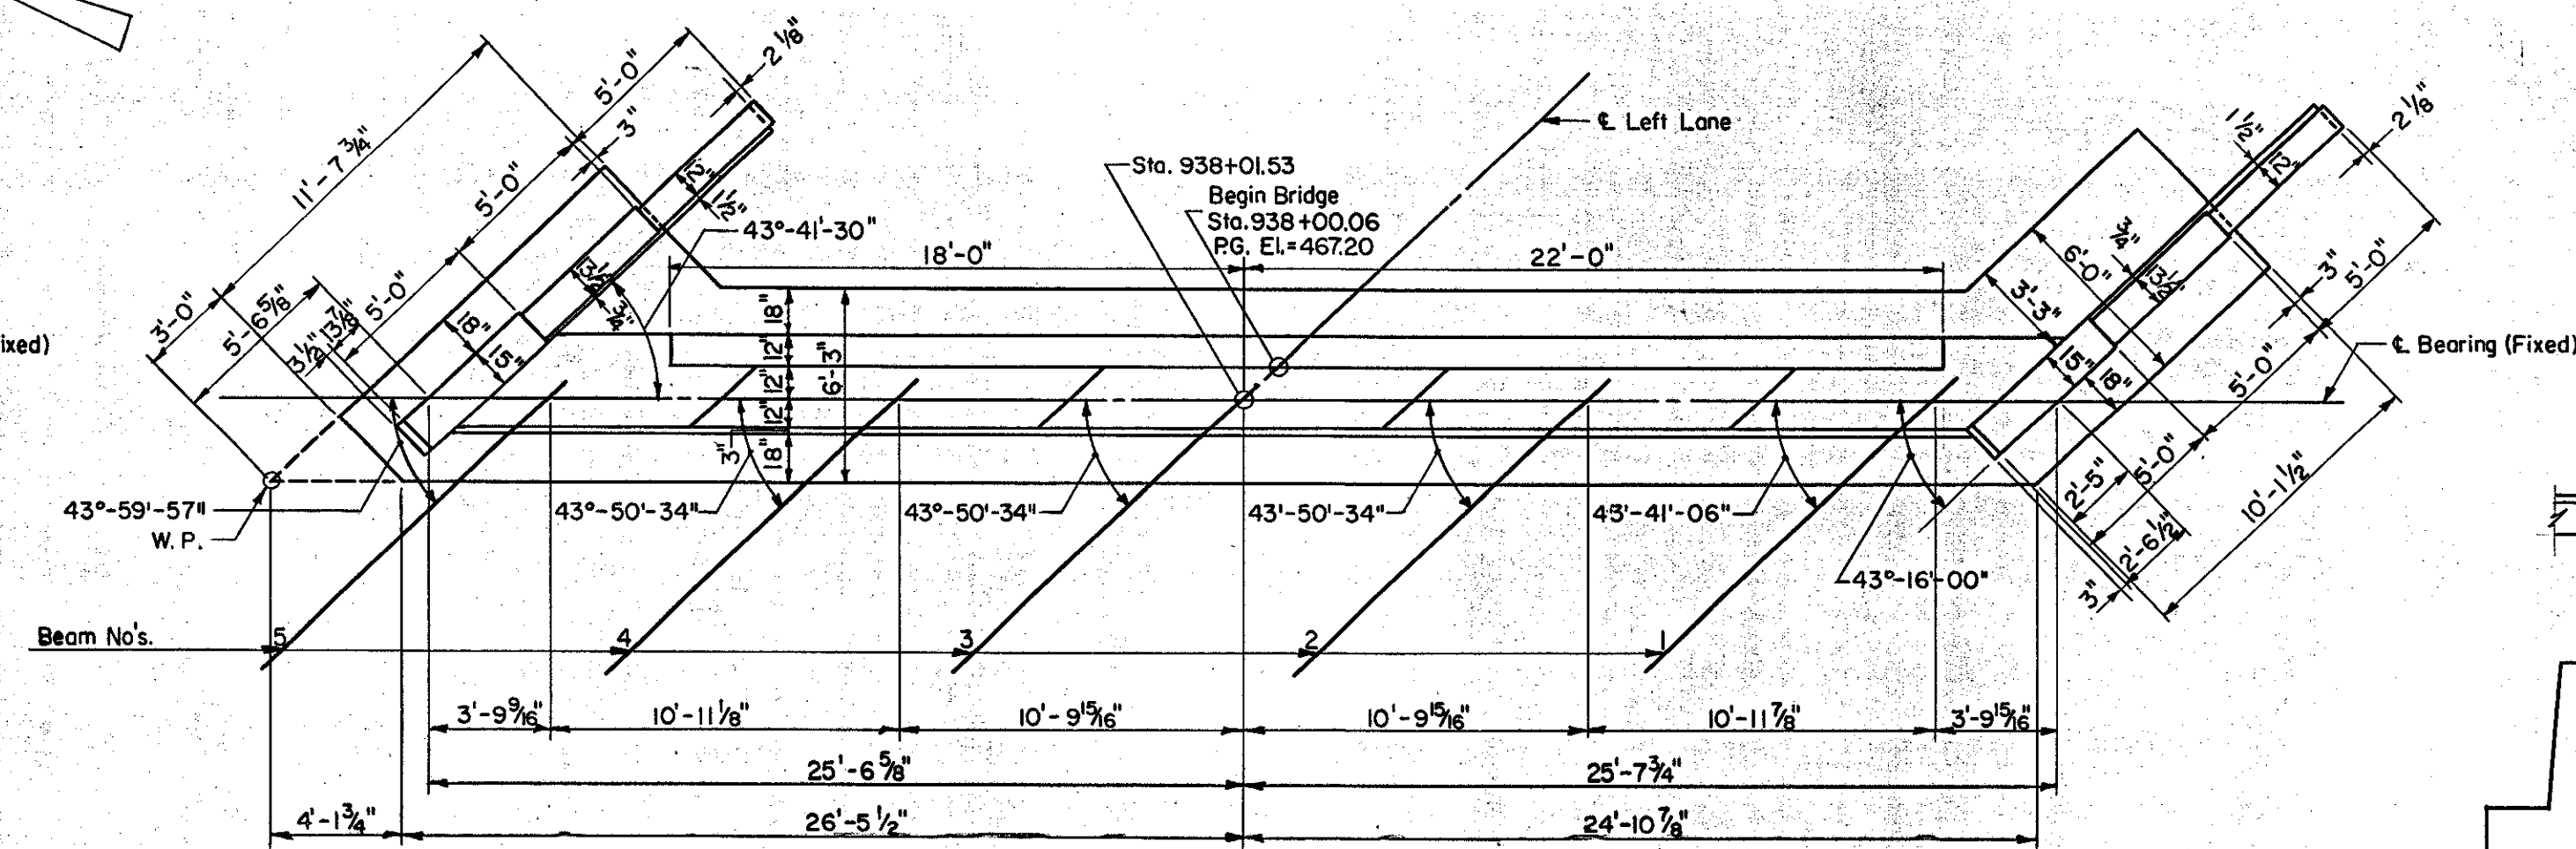


PLAN ABUTMENT NO. 1

Scale:  $\frac{3}{16}'' = 1'-0''$

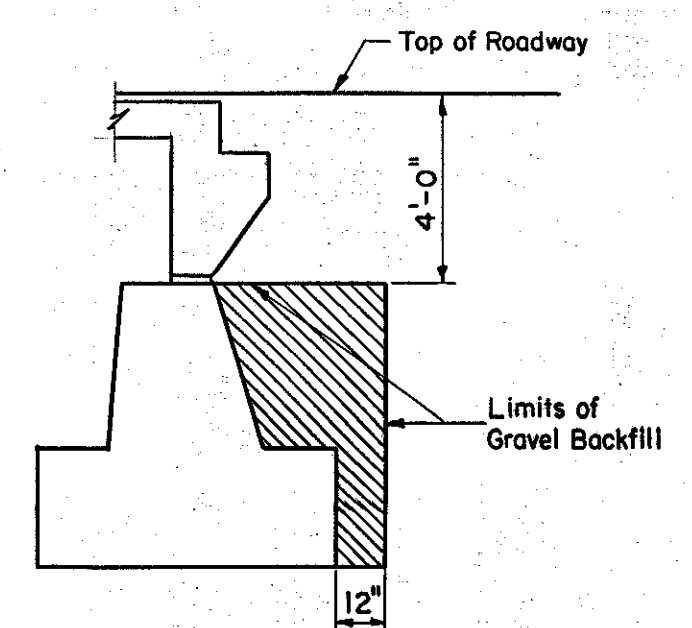


LIMITS OF GRAVEL BACKFILL

Scale:  $\frac{1}{4}'' = 1'-0''$

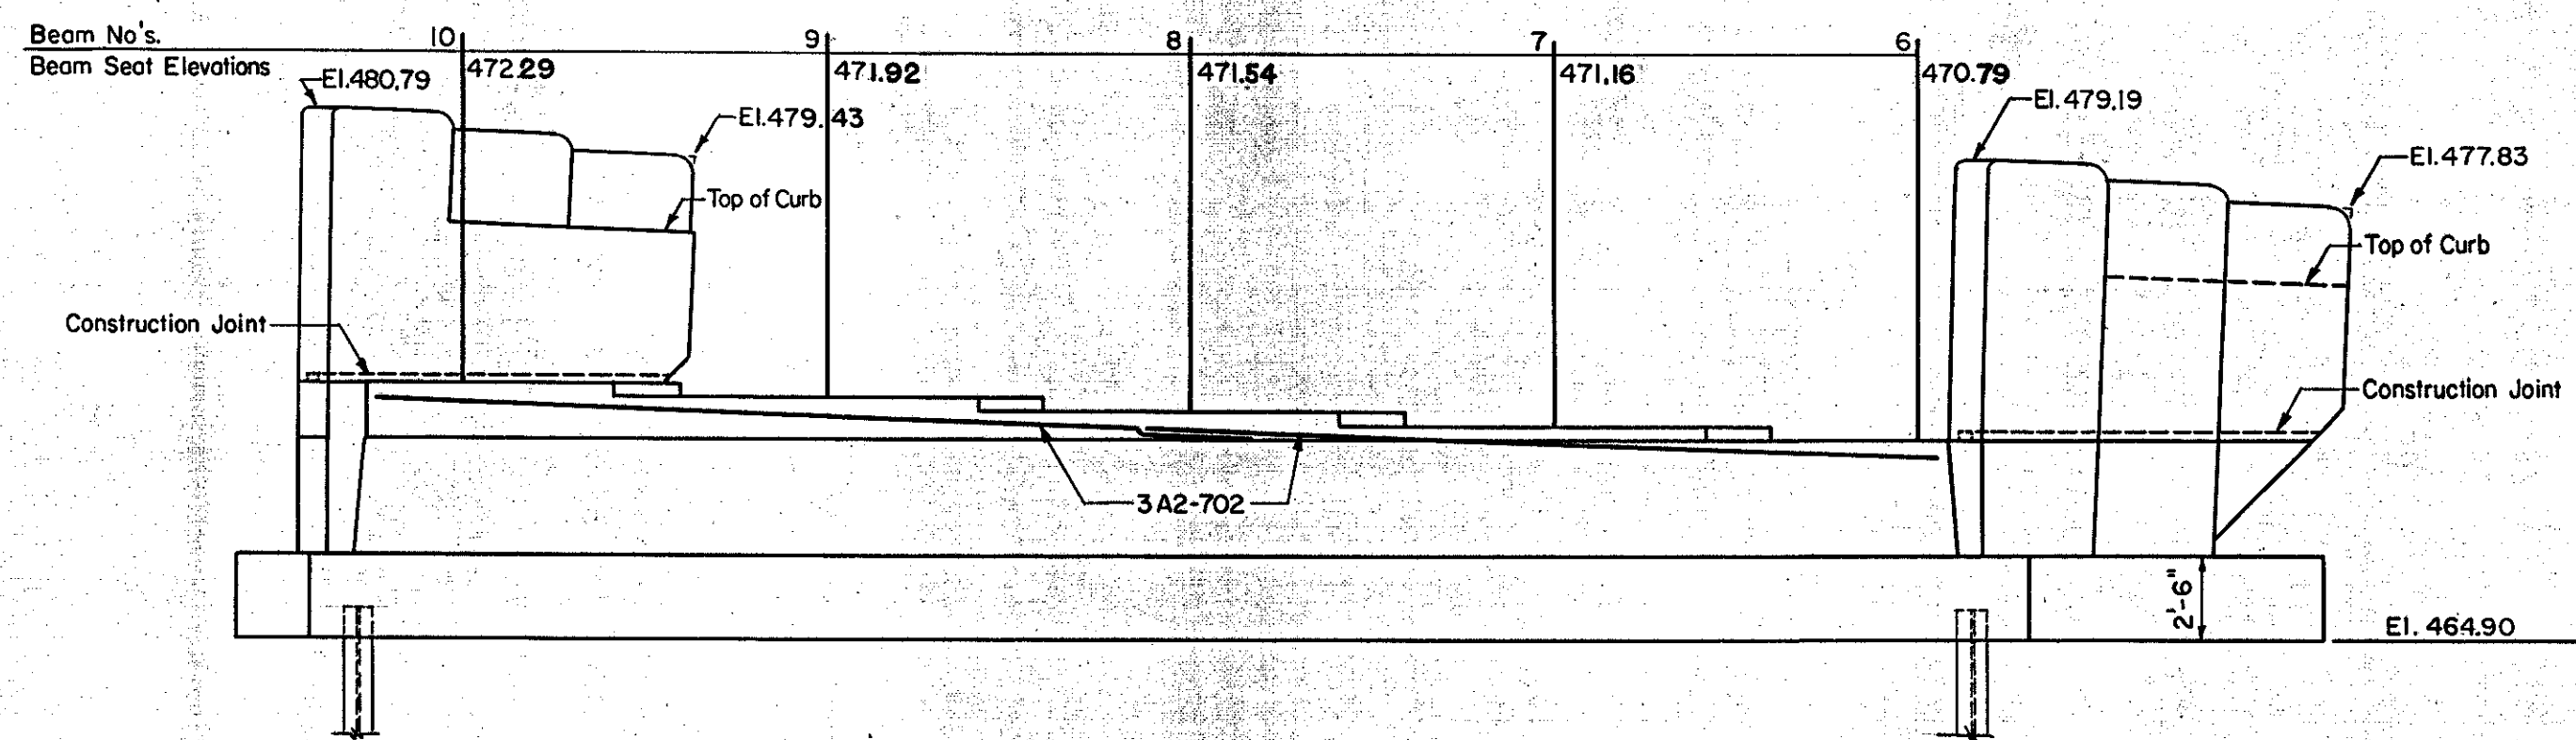

ELEVATION ABUTMENT NO. 2


Scale:  $\frac{3}{16}'' = 1'-0''$

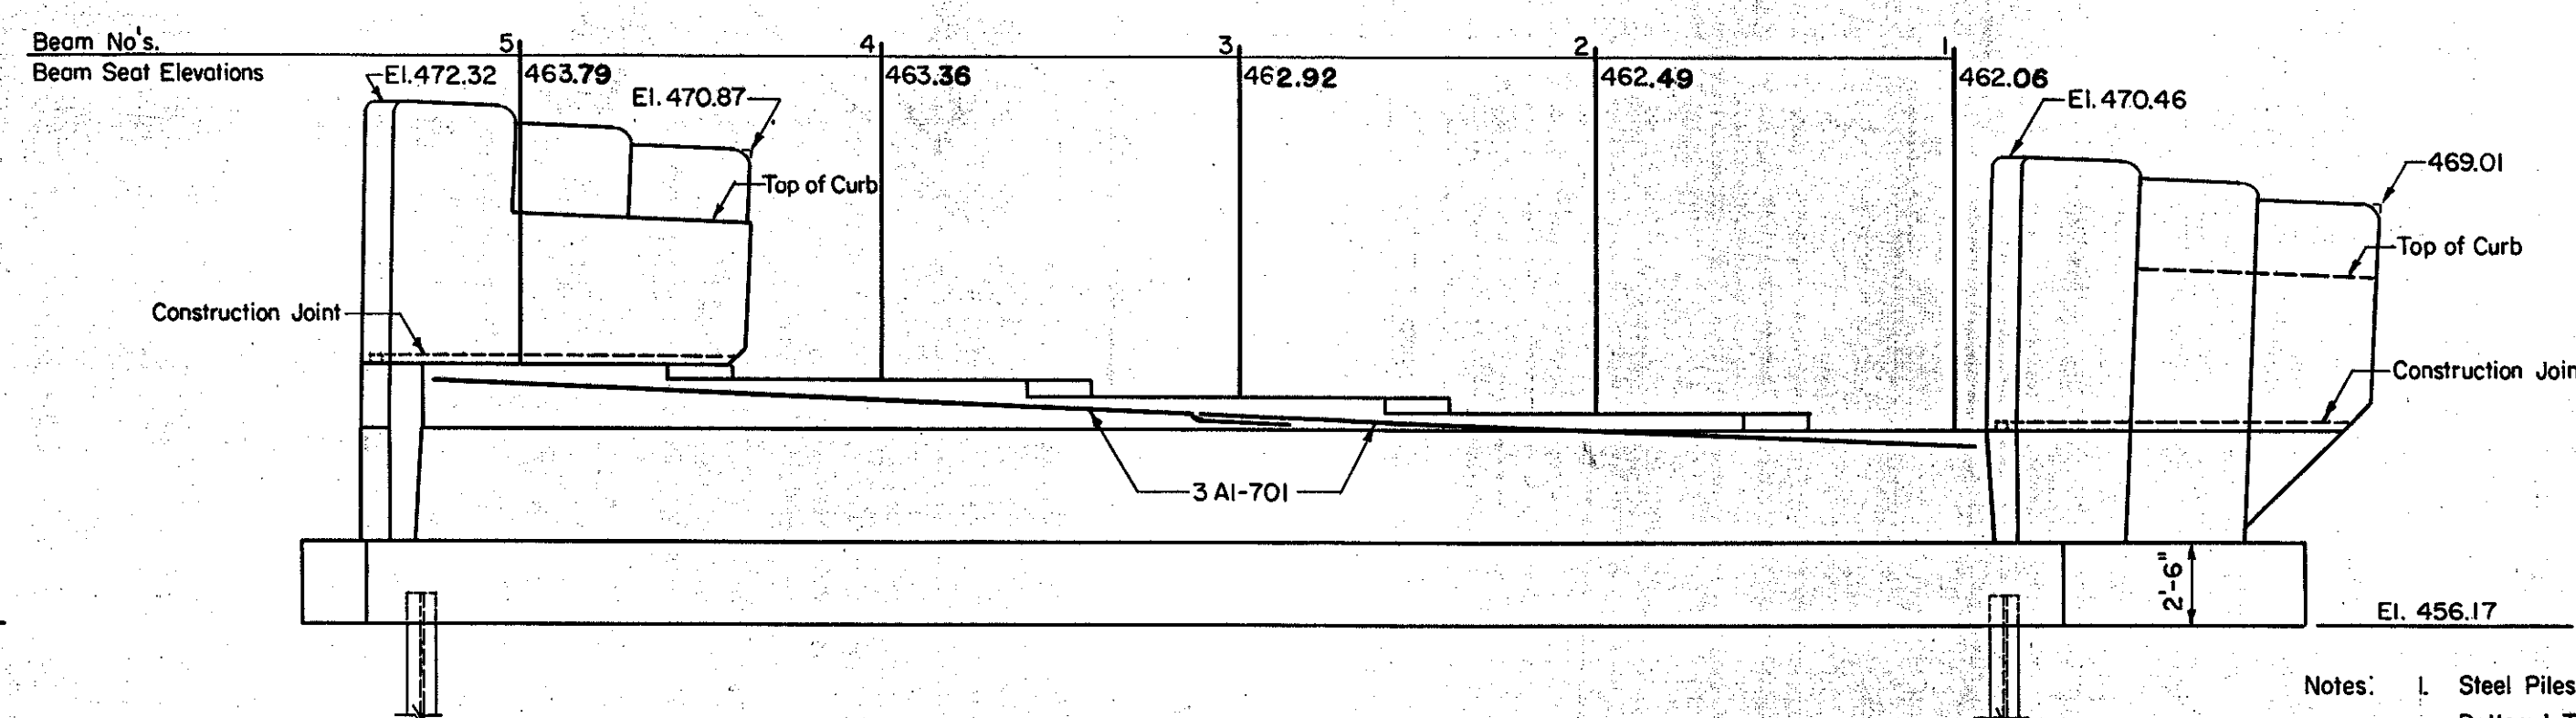

ELEVATION ABUTMENT NO. 1


Scale:  $\frac{3}{16}'' = 1'-0''$

- Notes:
- Steel Piles to be IOBP42, 35 Ton Design Load. Indicated thus: Vertical I, Battered I.
  - For Estimating Purposes, the average length of steel piles is assumed to be 52' Abut. No. 1, 49' Abut. No. 2, 44' Abut. No. 3, and 31' Abut. No. 4.
  - Slope all Bridge Seats  $\frac{1}{4}''$  per ft. between Bearing E's.
  - Entire exposed surface of the Bridge Seat to be covered with  $\frac{1}{2}''$  Asphaltic-Asbestos coating after superstructure is in place.
  - Prior to driving the piles, rock free fill shall be placed under the Abutment area to approximately the level of the pile cut-off elevation and with a surface area at least two (2) feet outside the Abutment. After piles are driven, the fill is to be excavated to the elevation of the bottom of footing.
  - All beam seat elevations shown are to top of concrete.
  - A layer of Sub-Base of Crushed Rock, Item 204 (Mod.), one (1) foot thick shall be placed 7'± along slope Abut. No. 1 & 2, 7'0"± along slope Abut. No. 3 and 7'9"± along slope Abut. No. 4. The edges of the area to be in line with the end posts and parallel to the E. of the Roadway.
  - For Footing Reinforcing, see Sheet No. 114.
  - For Wingwall details and typical Abutment Sections, see Sheet No. 115.

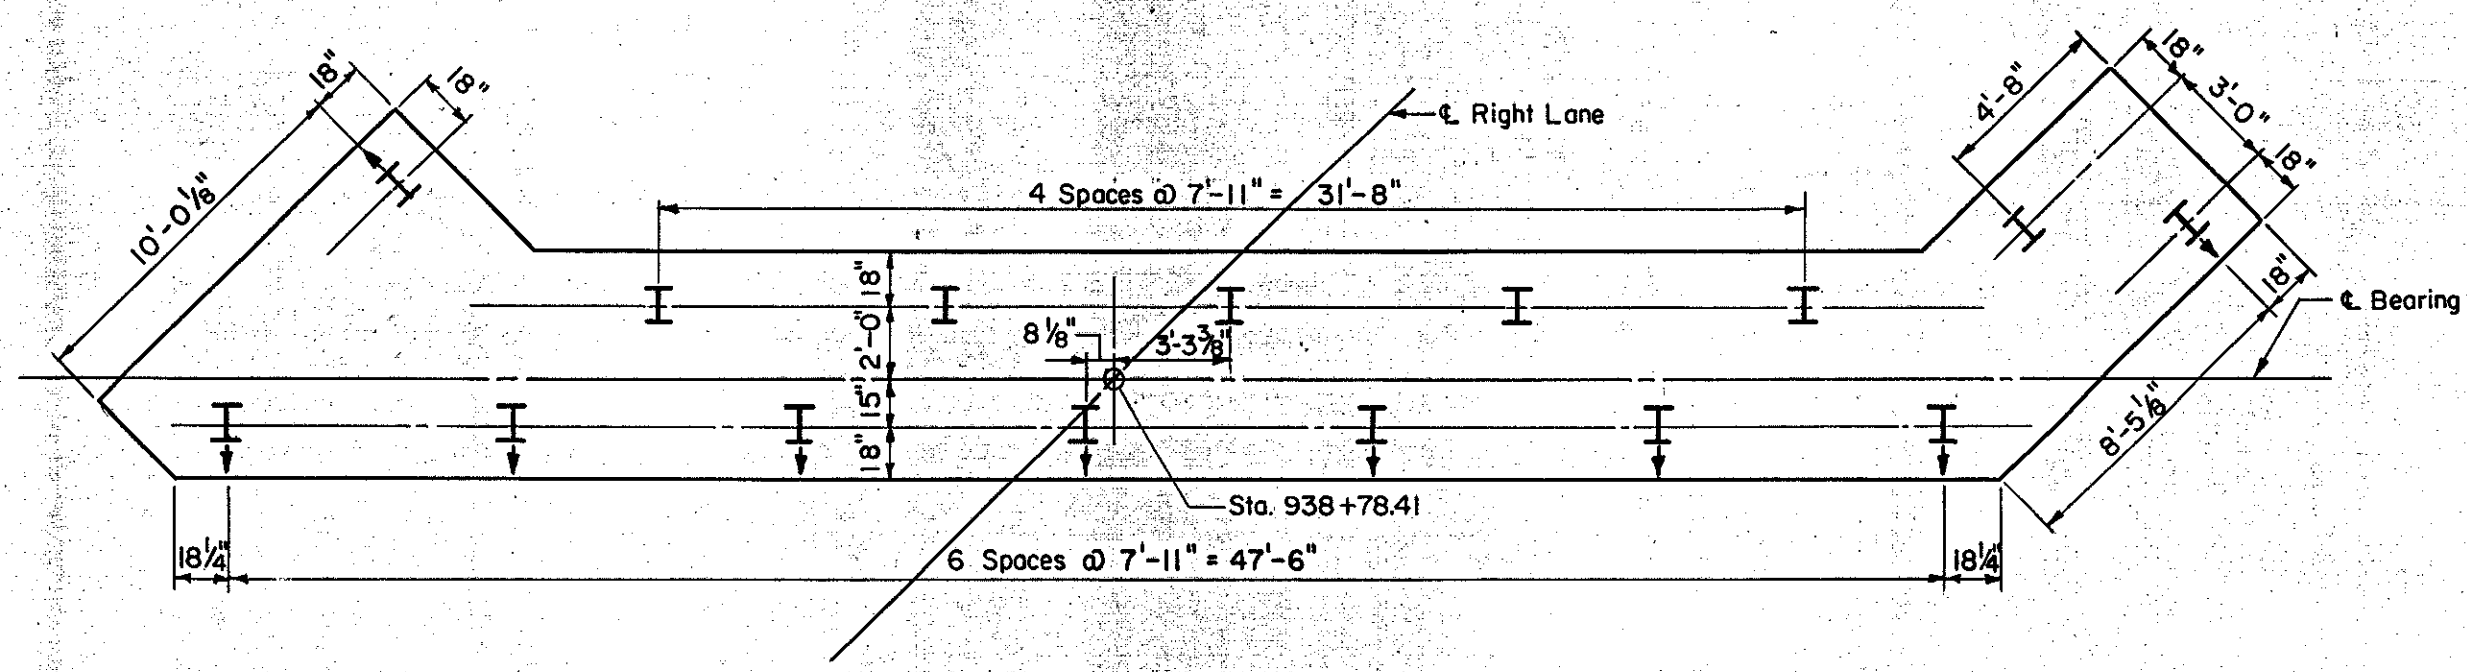

PILE PLAN ABUTMENT NO. 2

Scale:  $\frac{3}{16}'' = 1'-0''$

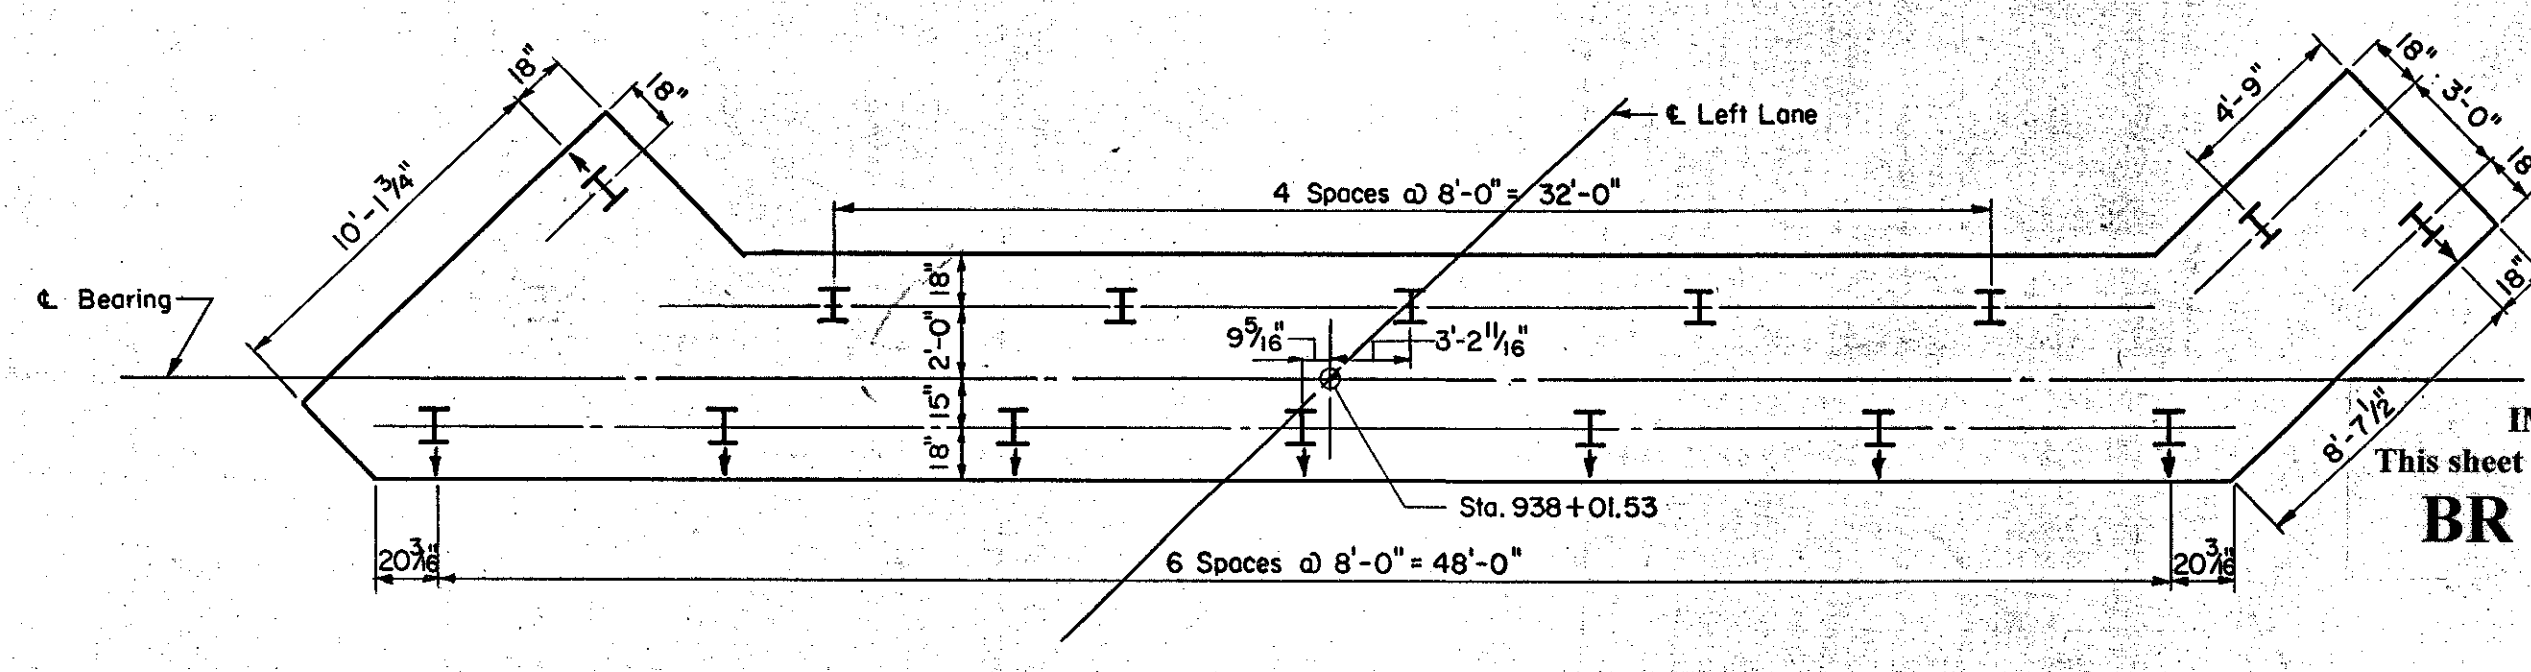

PILE PLAN ABUTMENT NO. 1


Scale:  $\frac{3}{16}'' = 1'-0''$

This sheet for information only  
IM 089-2(26)


**BR 50 N & S** ABUTMENTS NO. 1 AND NO. 2

STATE OF VERMONT DEPARTMENT OF HIGHWAYS	
INTERSTATE PROJECT in the town of <b>WATERBURY</b>	
INTERSTATE	STA. 939+50
OVER	
<b>U.S. ROUTE 2 (RELOC.)</b>	STA. 20+00
THE CLARKESON ENGINEERING CO., INC. CONSULTING ENGINEERS	
BOSTON	MASSACHUSETTS
SURVEYED BY: S.A.L.	CHECKED BY: J.B. O.D.S.
DRAWN BY: S.A.L.	IN CHARGE: J.V.B.
SCALE: AS NOTED DATE: 6-19-58	
PROJECT NO. I-89-2(7)	SHEET 248 OF 307

B.P.R. DIV. NO.	STATE	PROJECT NO.	SHEET NO.	TOTAL SHEETS
1	VT.	I-89-2 (7)	113	296

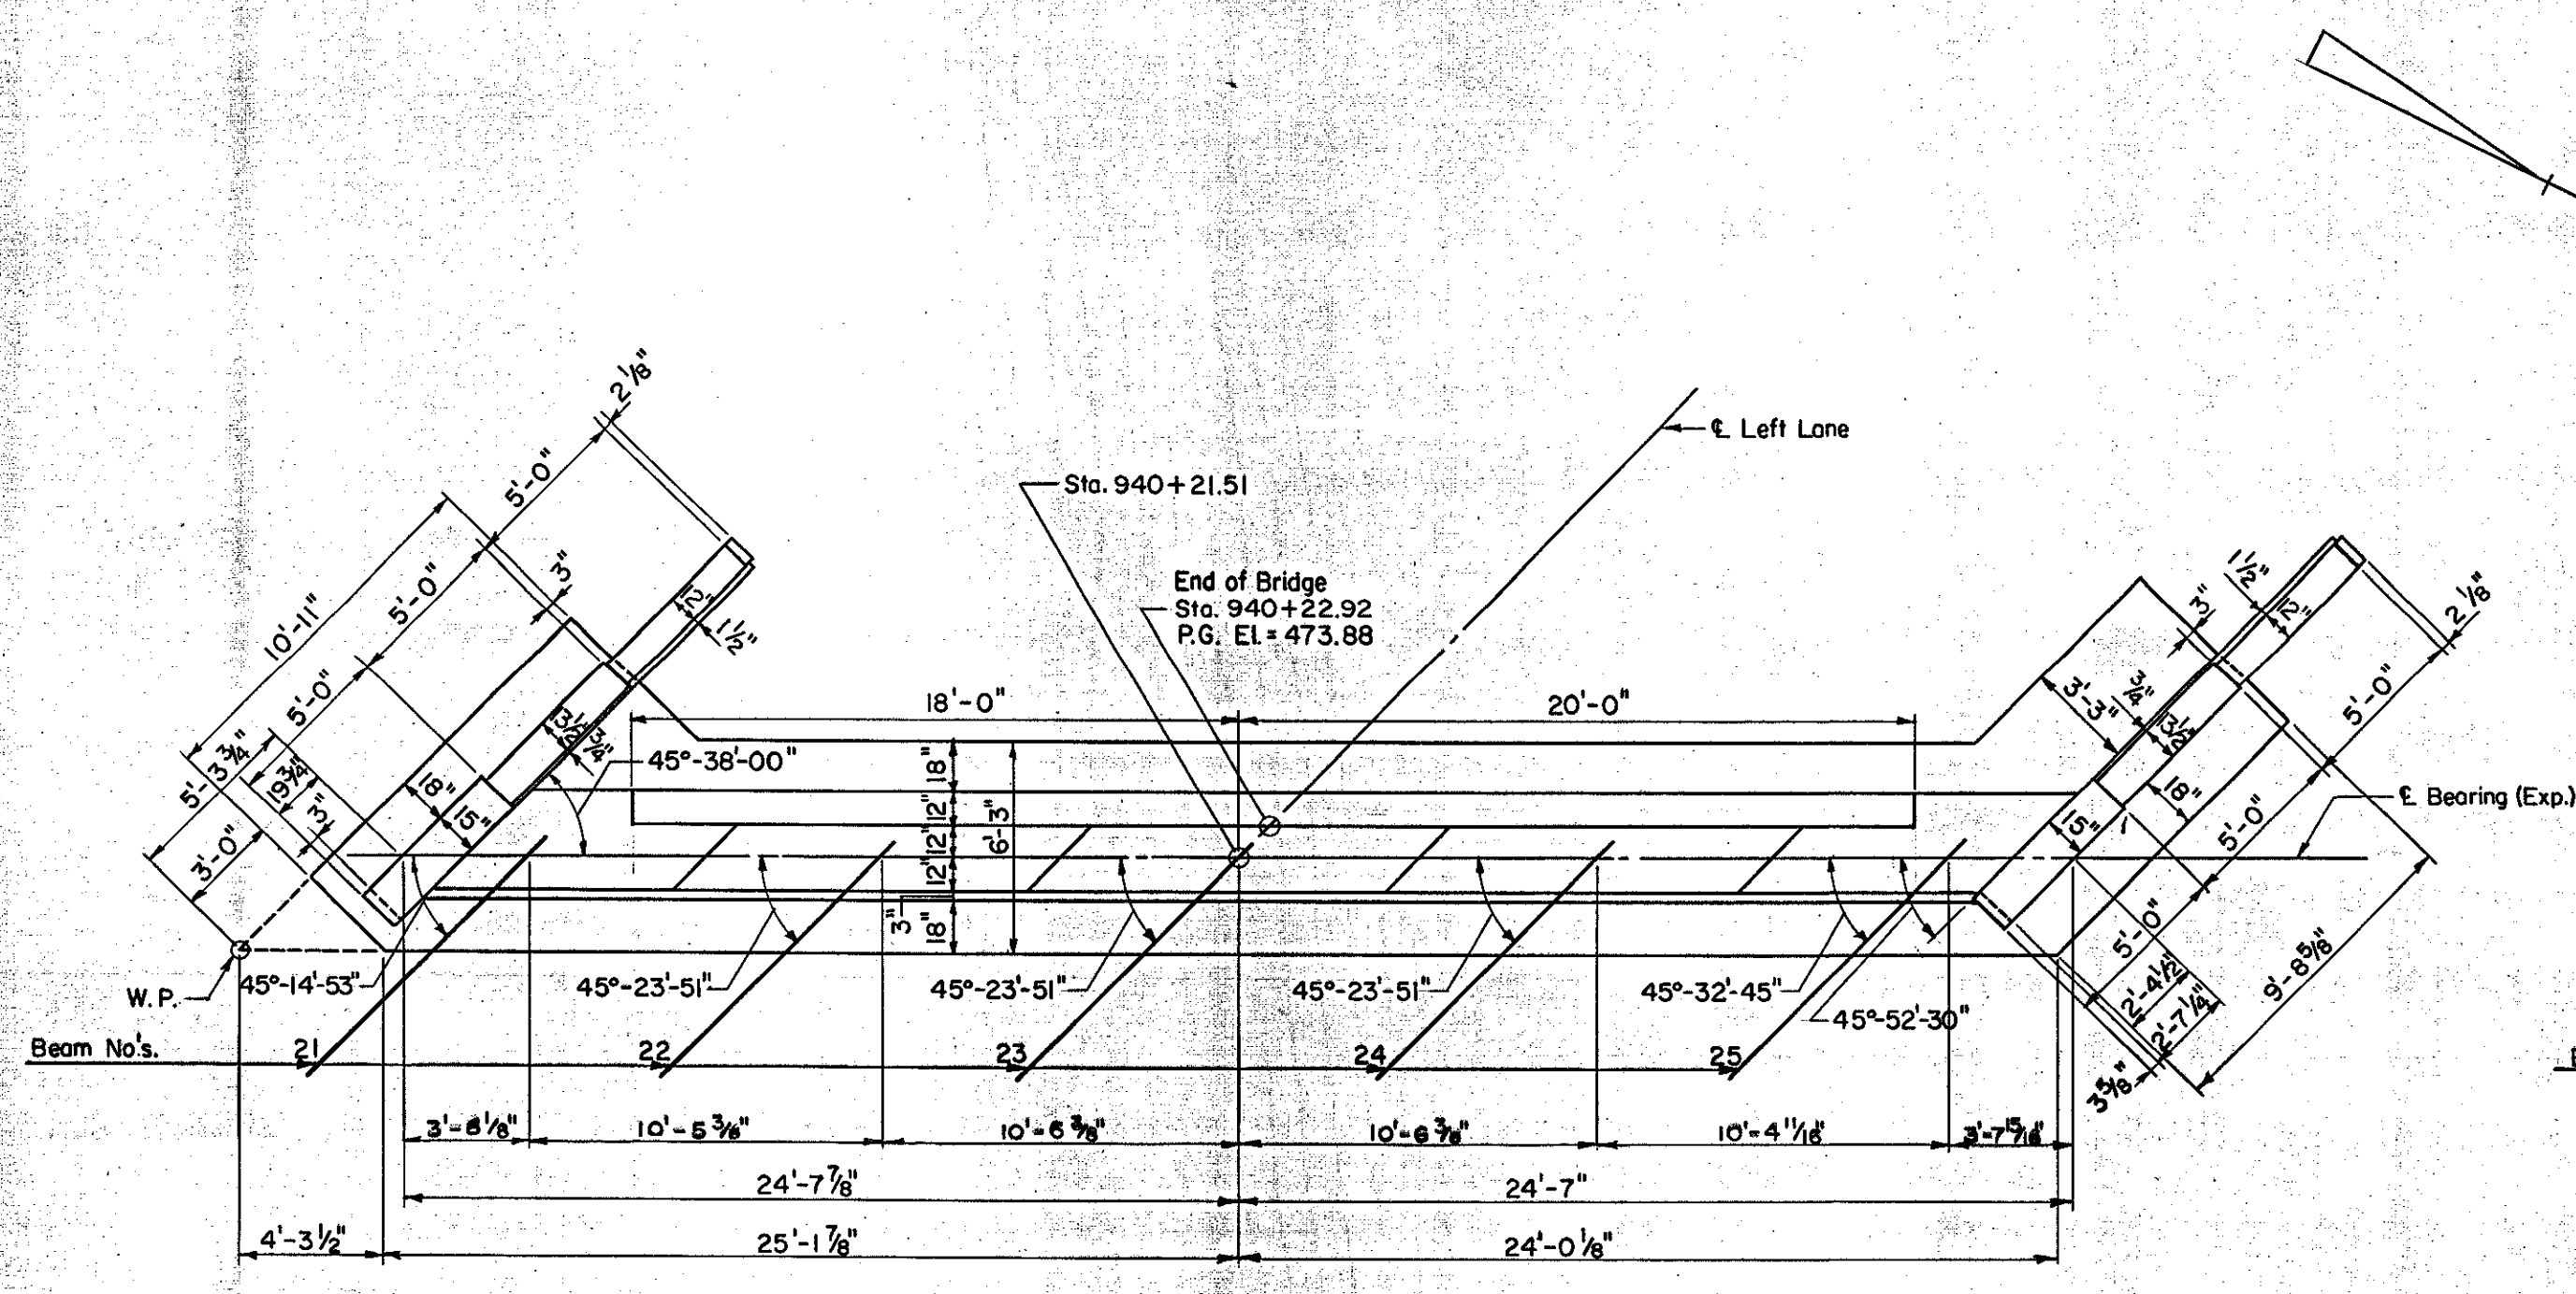


**PLAN ABUTMENT NO. 3**  
Scale: 3/16" = 1'-0"

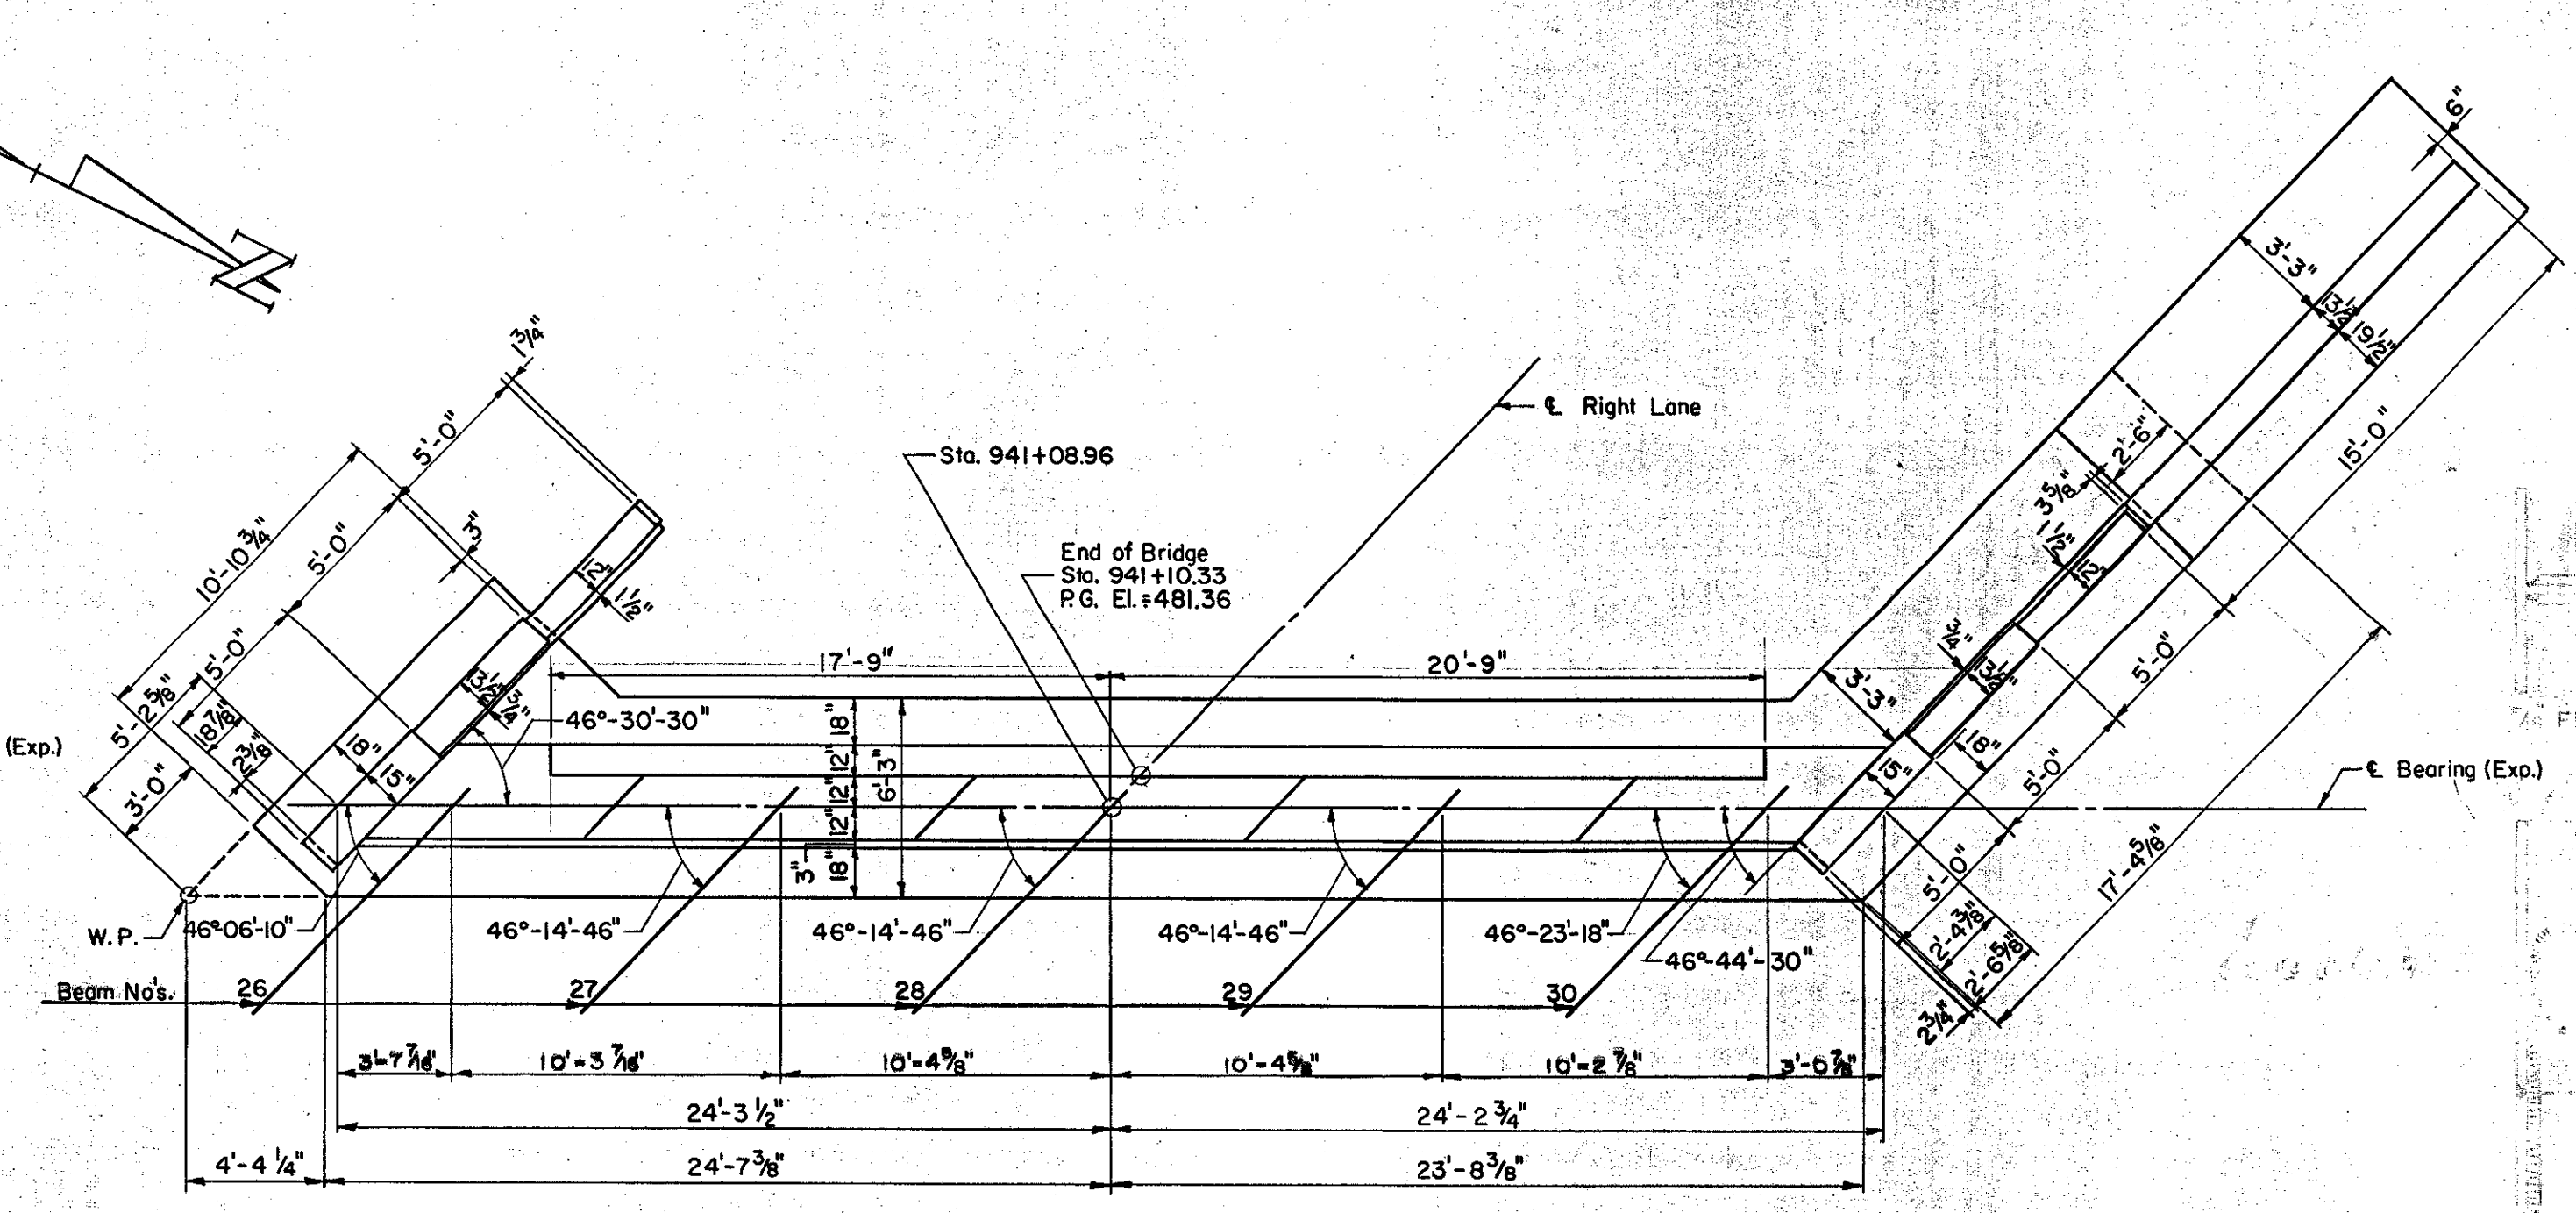


**PLAN ABUTMENT NO. 4**  
Scale: 3/16" = 1'-0"

FOR PILE SPLICE DETAIL SEE STANDARD SHEET SB-20-56

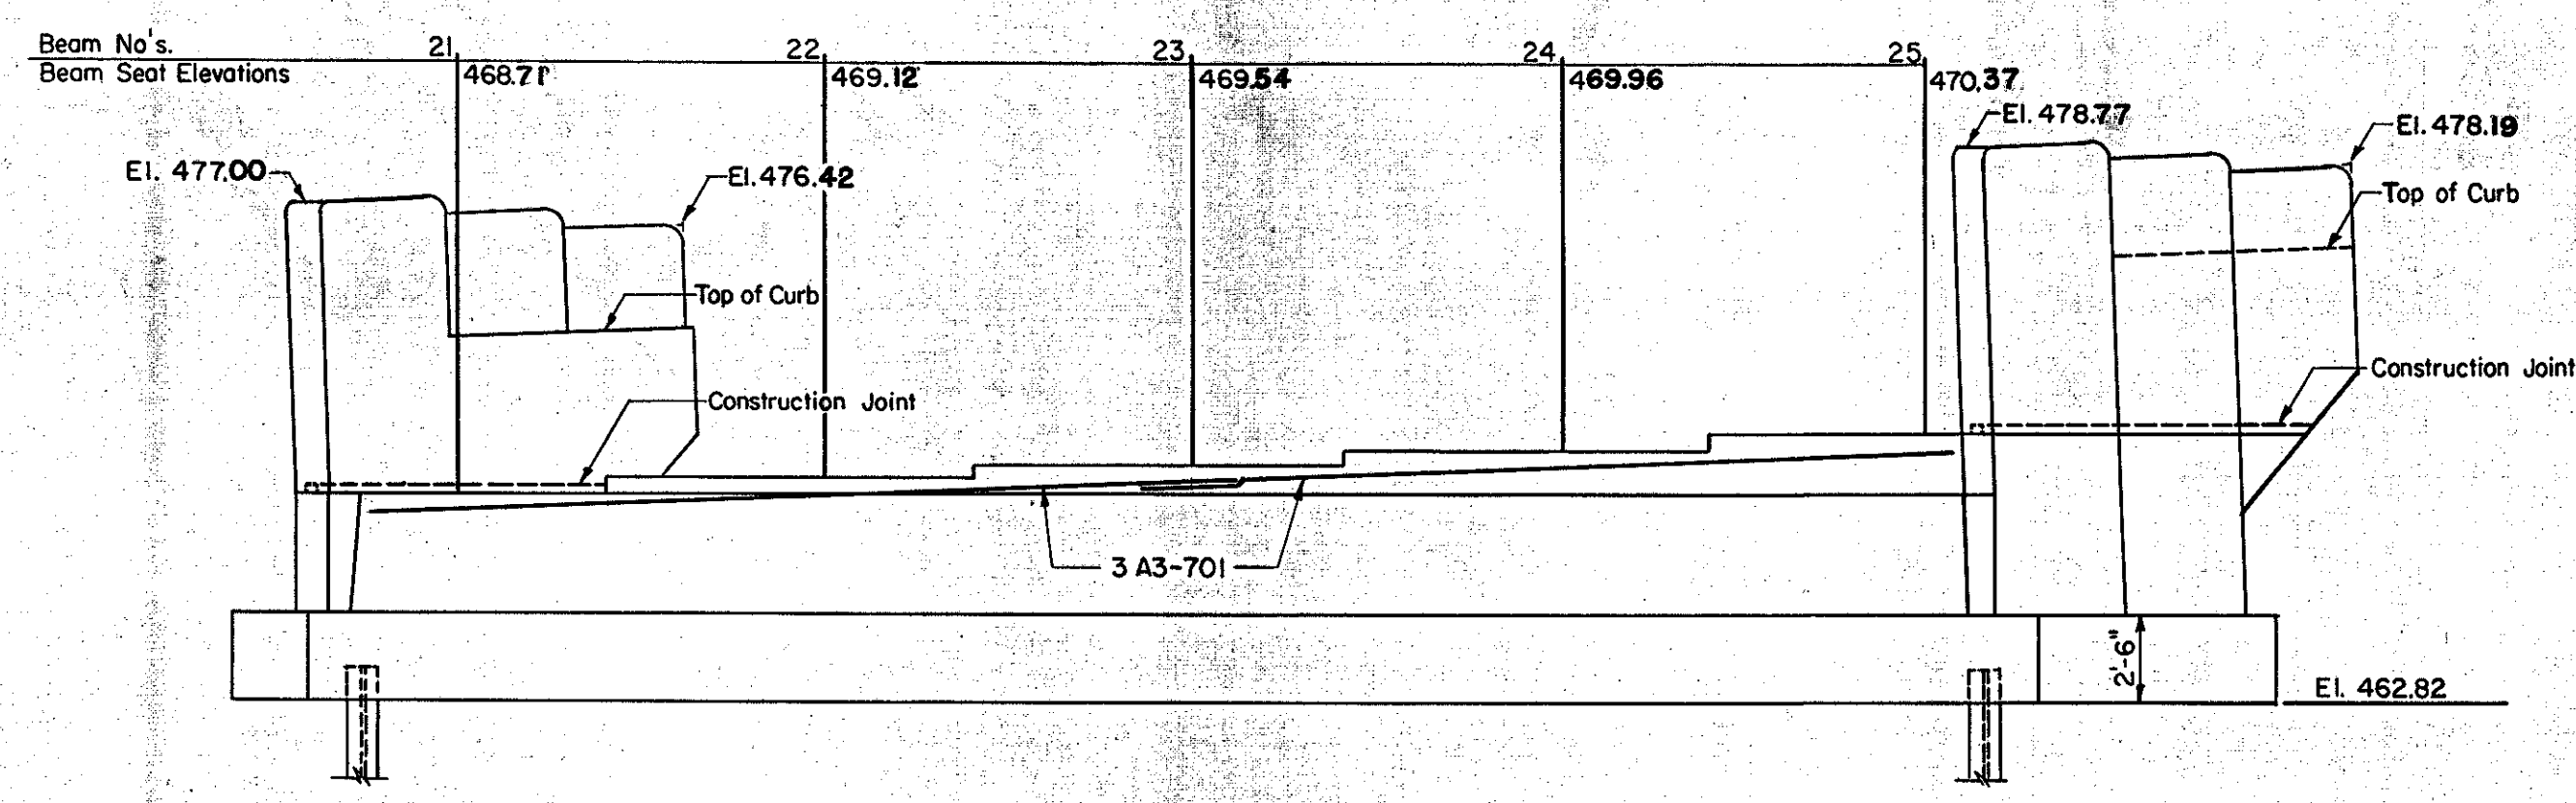


**ELEVATION ABUTMENT NO. 3**  
Scale: 3/16" = 1'-0"

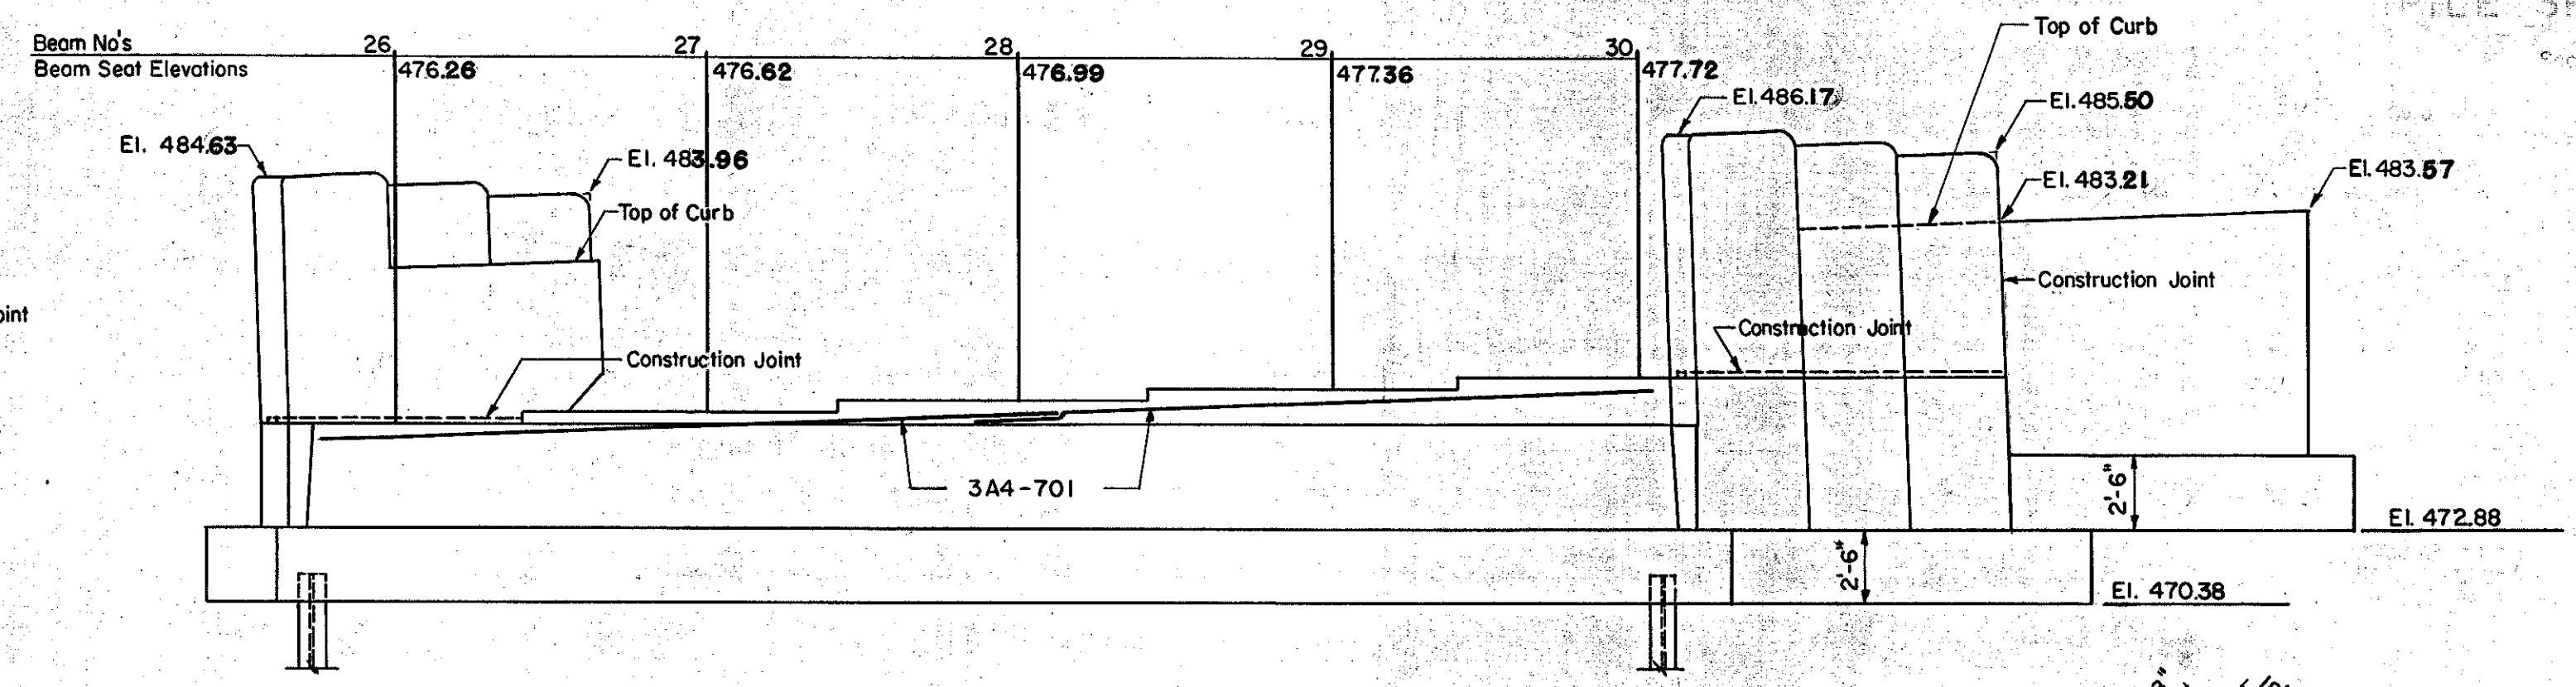


**ELEVATION ABUTMENT NO. 4**  
Scale: 3/16" = 1'-0"

PILE SPLICE DETAILS  
Scale: 1/2" = 1'-0"

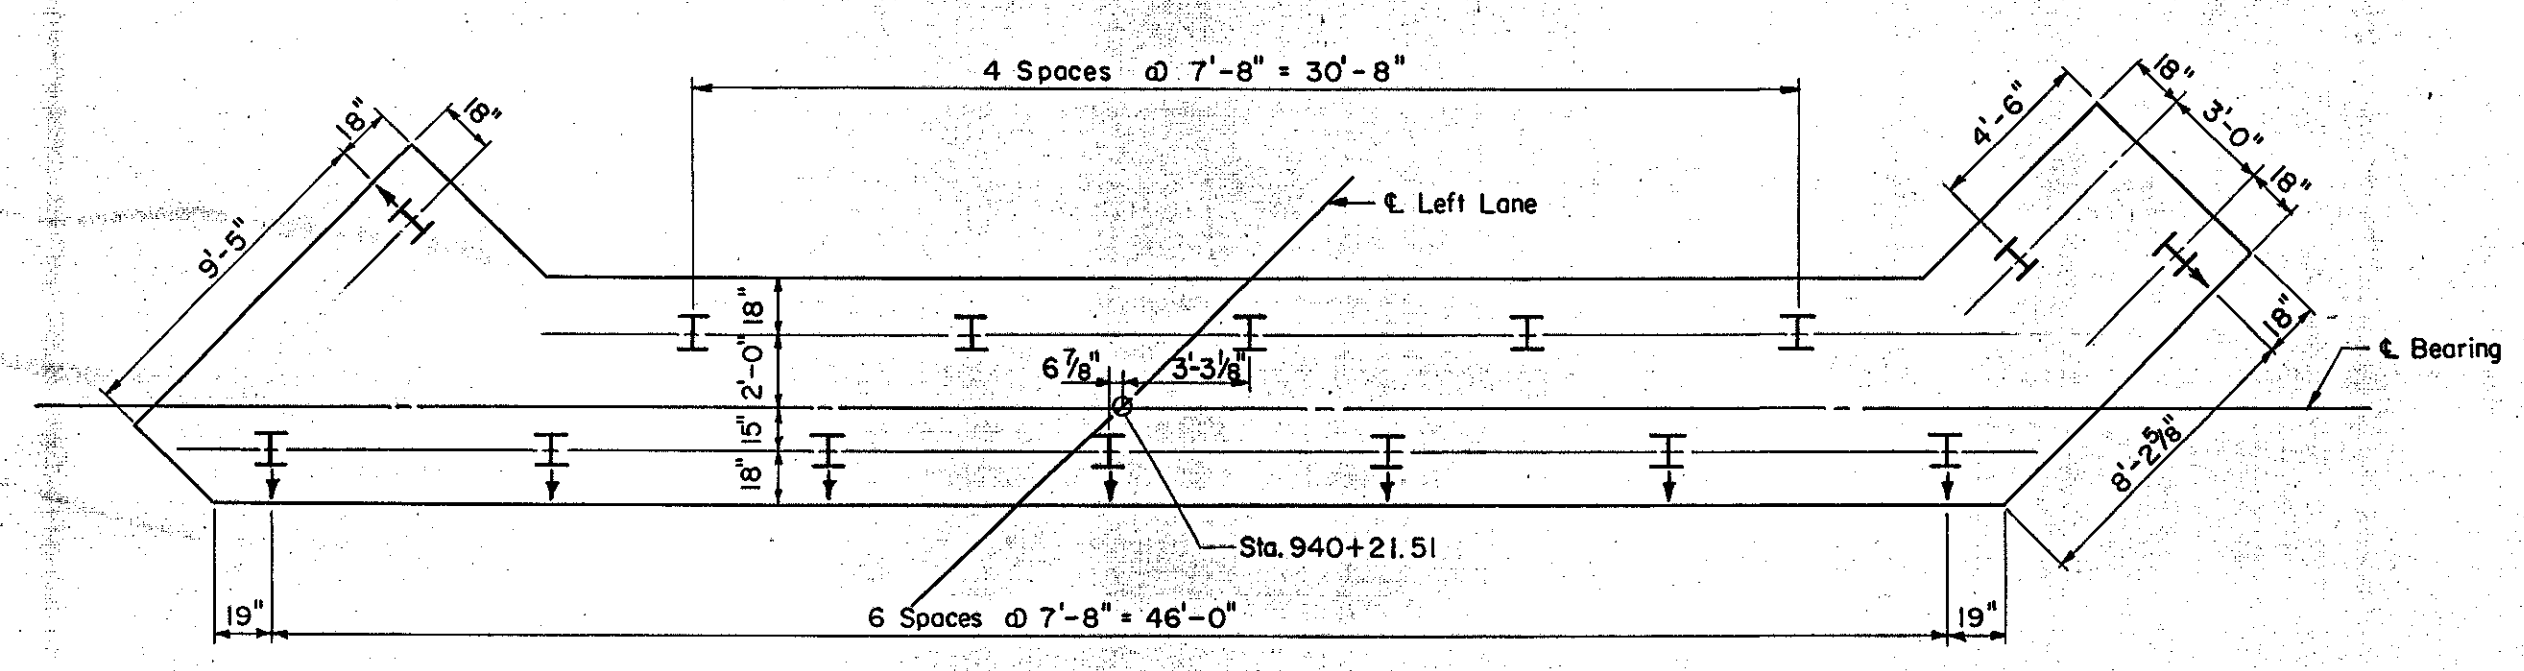

**PILE PLAN ABUTMENT NO. 3**  
Scale: 3/16" = 1'-0"

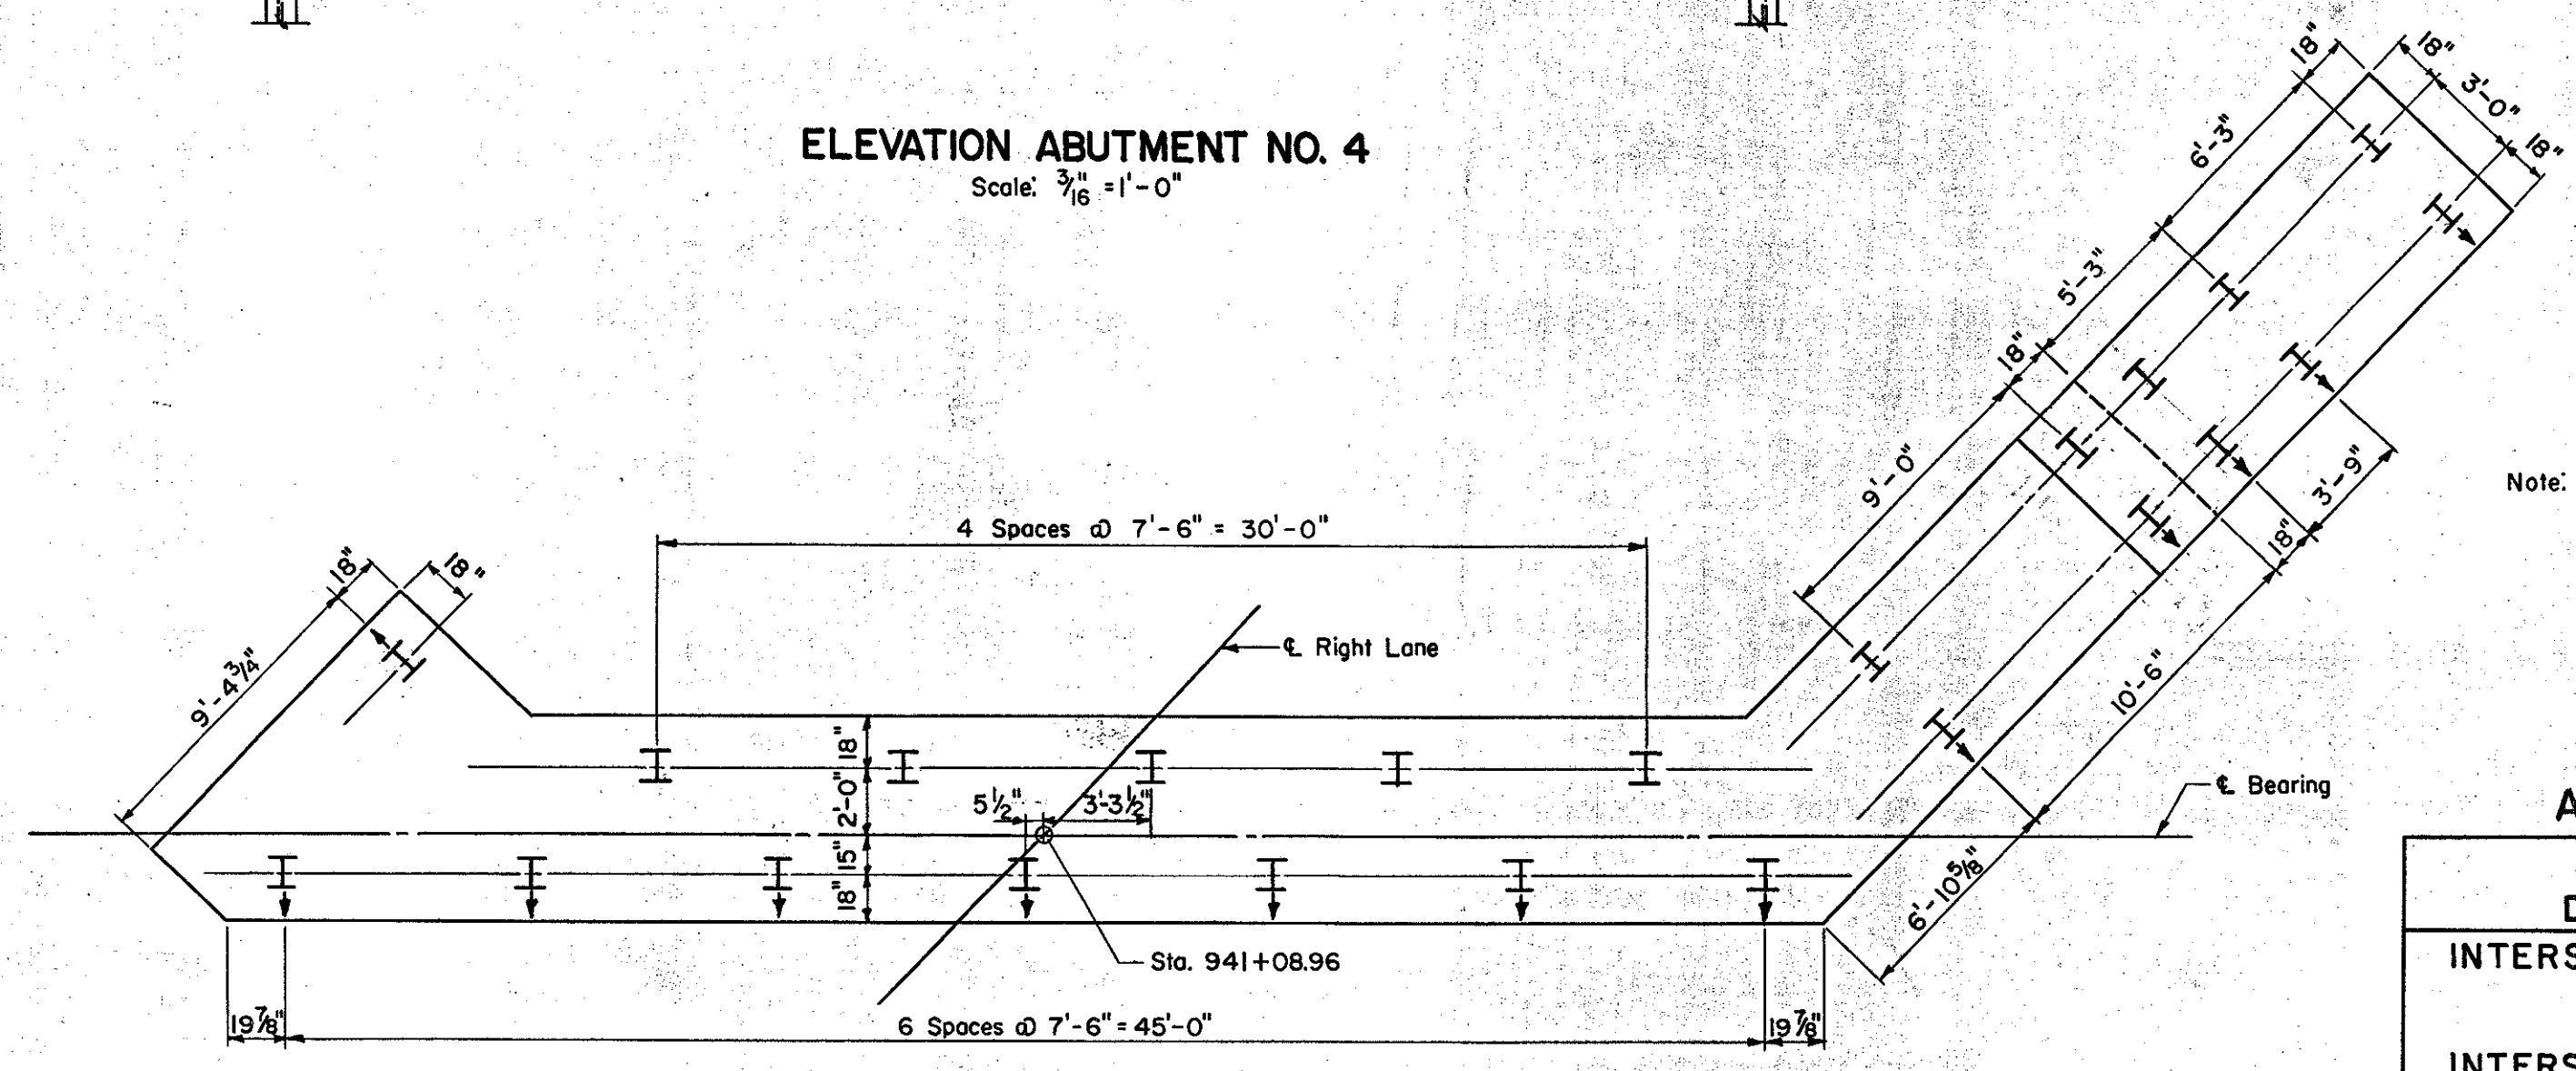


**PILE PLAN ABUTMENT NO. 4**  
Scale: 3/16" = 1'-0"

Note: See Sheet 113 for General Notes.


IM 089-2(26)  
This sheet for information only  
**BR 50 N & S**  
CONTRACT NO. 2

**ABUTMENTS NO. 3 AND NO. 4**  
STATE OF VERMONT  
DEPARTMENT OF HIGHWAYS  
INTERSTATE PROJECT in the town of  
**WATERBURY**  
INTERSTATE OVER STA. 939+50  
U.S. ROUTE 2 (RELOC.) STA. 20+00  
THE CLARKSON ENGINEERING CO., INC.  
CONSULTING ENGINEERS MASSACHUSETTS  
BOSTON  
SURVEYED BY: S.A.L. CHECKED BY: J.B.D.S. SCALE: AS NOTED  
DRAWN BY: S.A.L. IN CHARGE: J.V.B. DATE: 6-19-58  
PROJECT NO. I-89-2(7) SHEET 249 OF 307


R.P.R. DIV. NO.	STATE	PROJECT NO.	SHEET NO.	TOTAL SHEETS
1	VT.	I-89-2 (7)	250	307

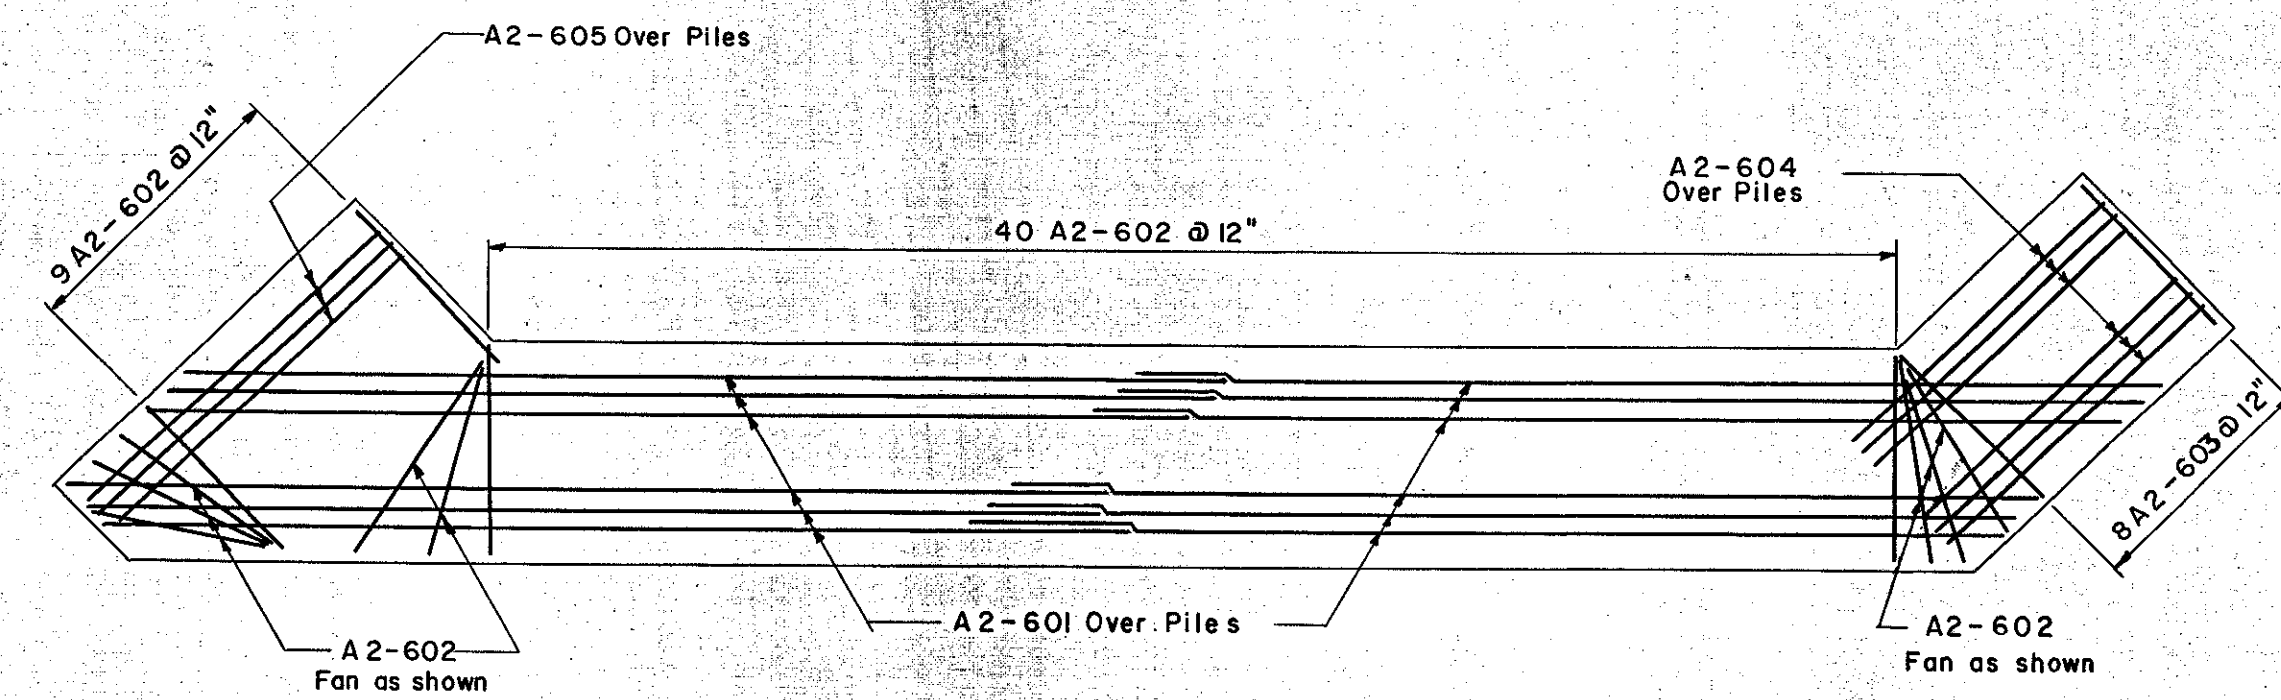


FOOTING REINFORCING PLAN ABUTMENT NO. 2  
Scale: 3/16" = 1'-0"

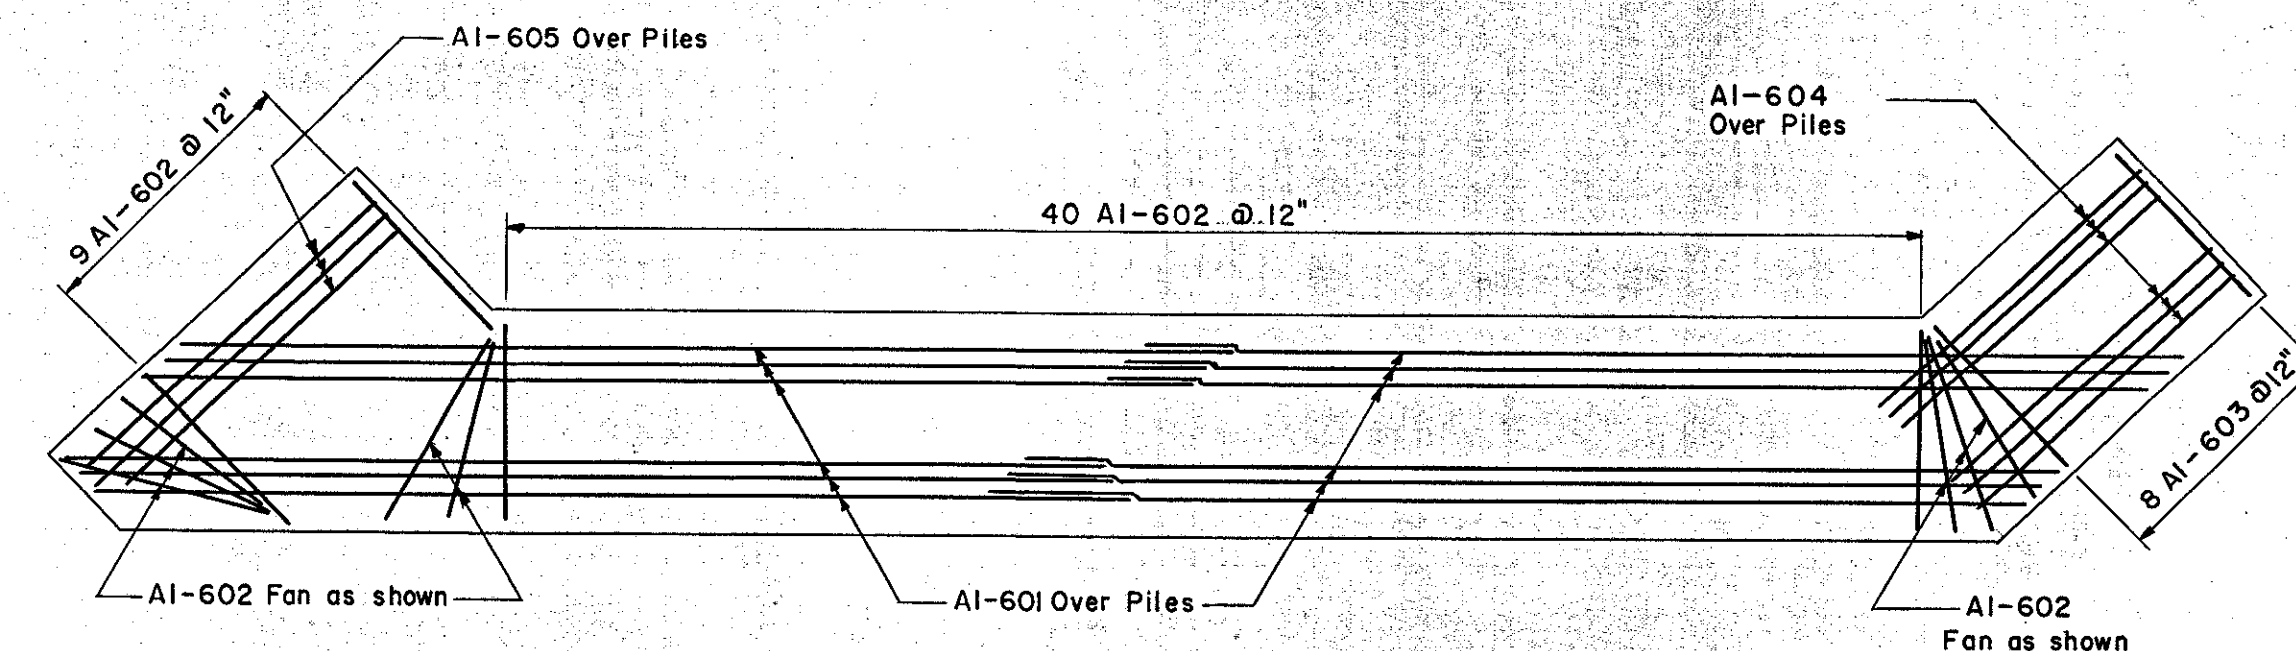

FOOTING REINFORCING PLAN ABUTMENT NO. 1  
Scale: 3/16" = 1'-0"

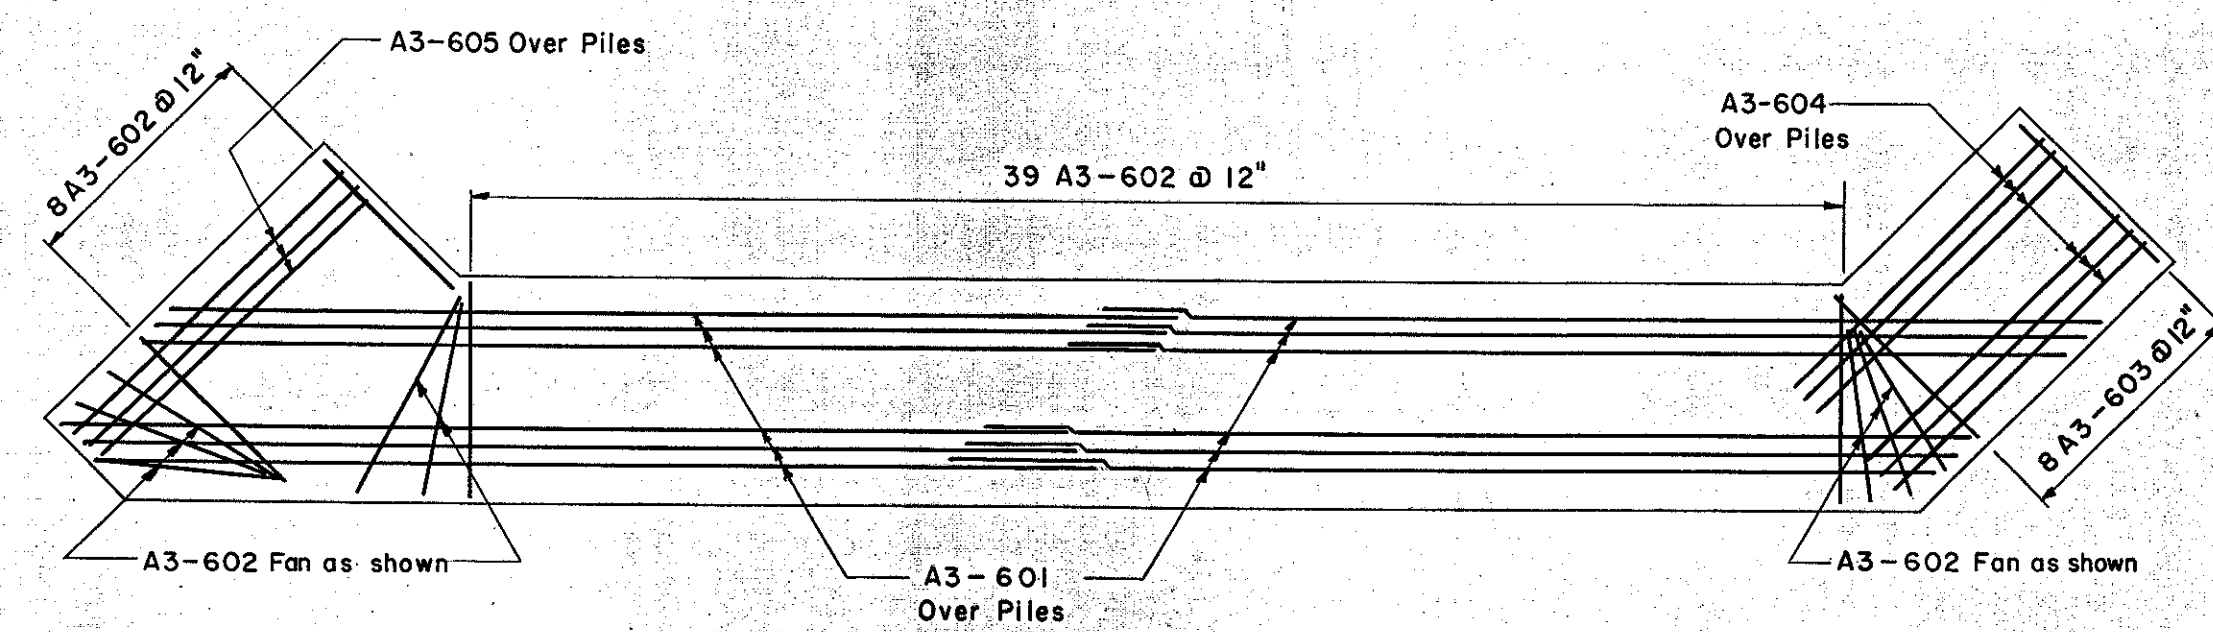

FOOTING REINFORCING PLAN ABUTMENT NO. 3  
Scale: 3/16" = 1'-0"

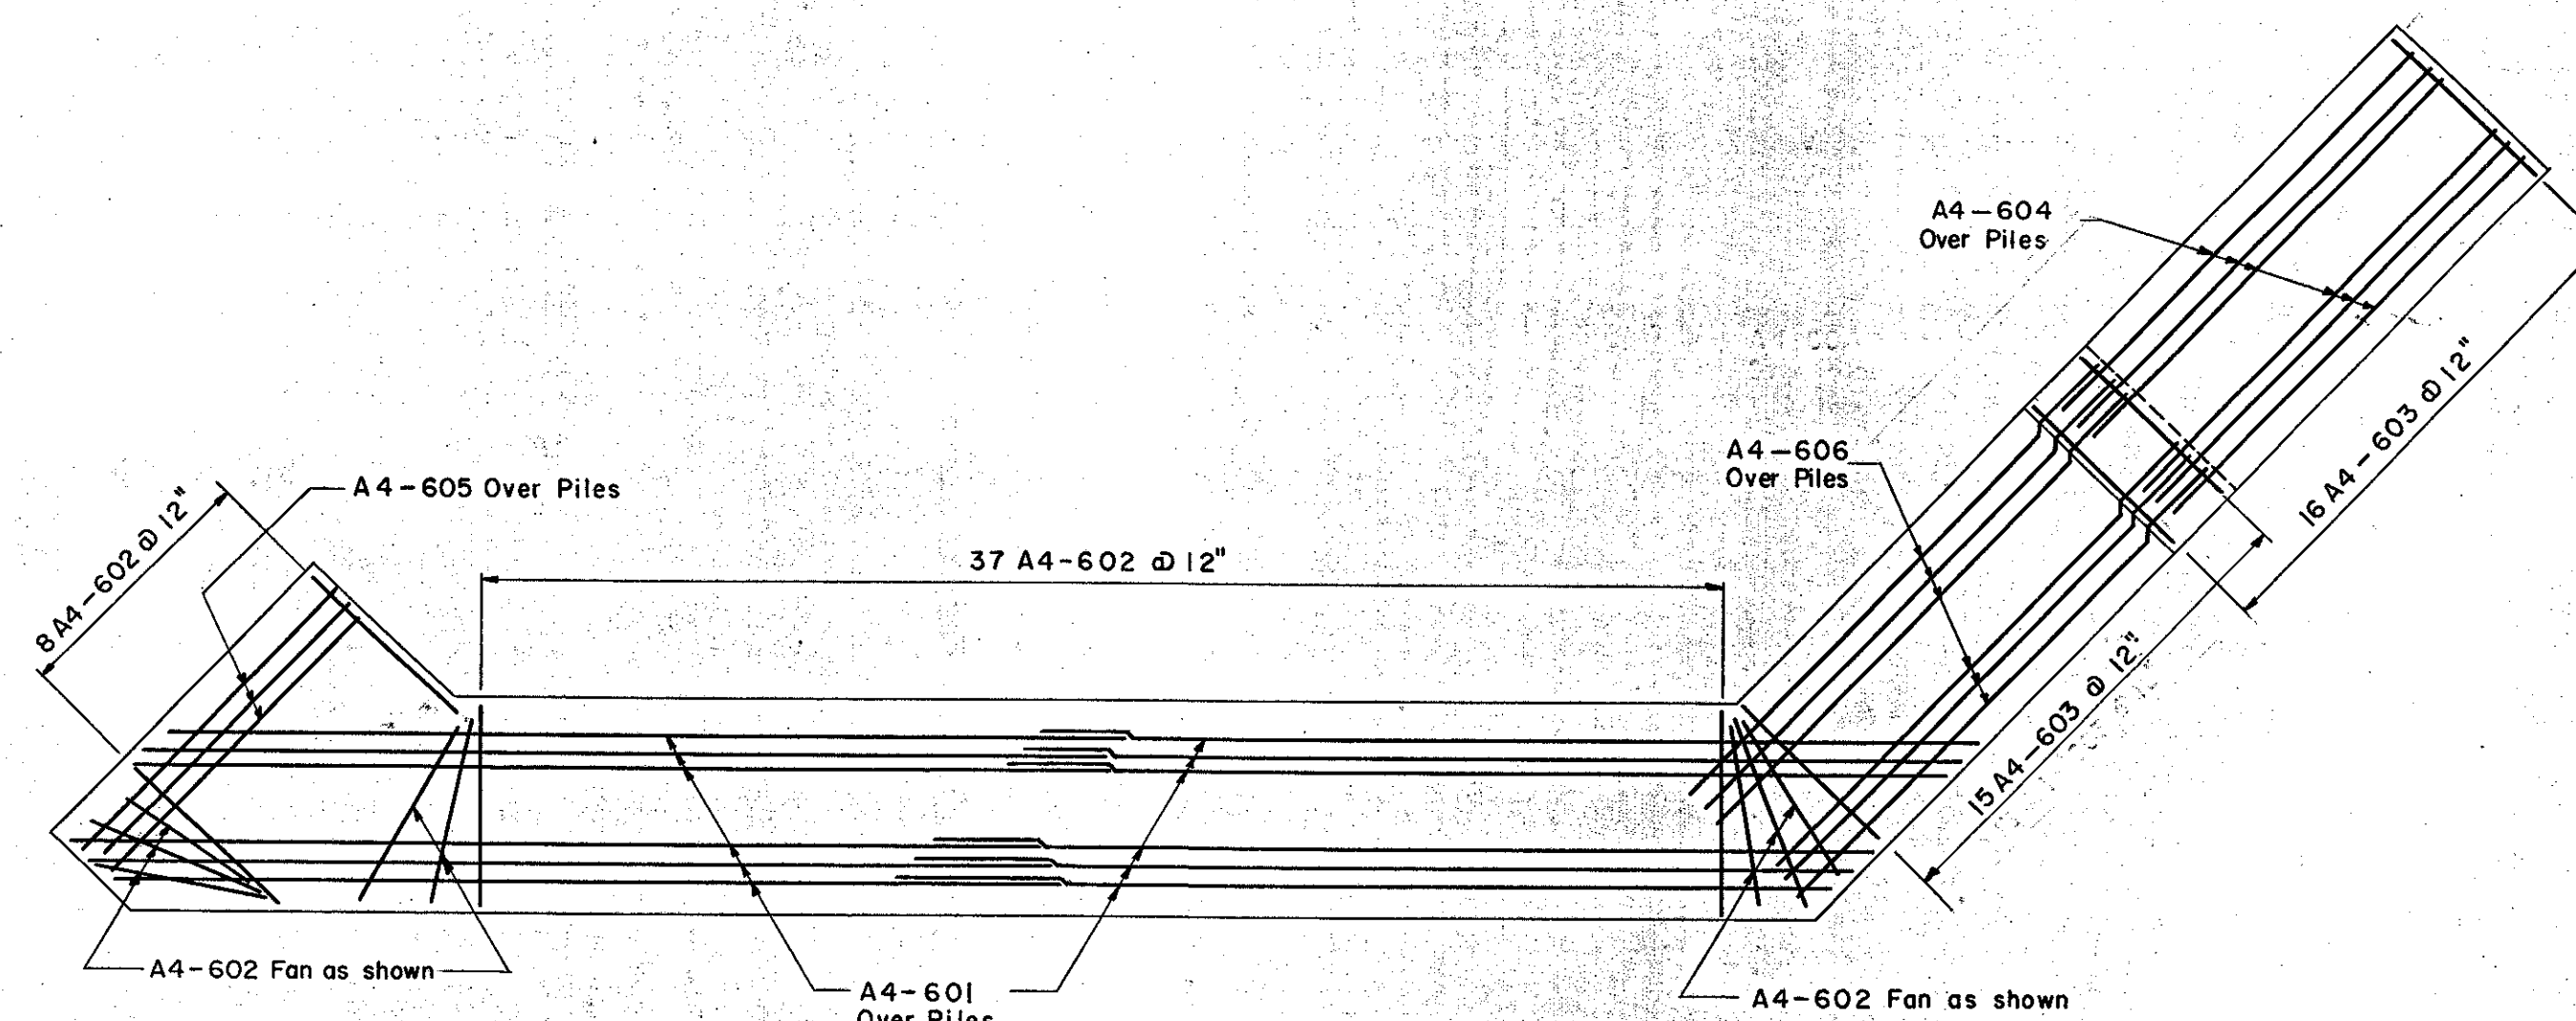

FOOTING REINFORCING PLAN ABUTMENT NO. 4  
Scale: 3/16" = 1'-0"

Note:  
1. For section of Abutment footings see Sheet No. 115  
2. For details of Abutments and Pile Plans see Sheets No. 112 & 113


IM 089-2(26)  
This sheet for information only  
**BR 50 N & S**

CONTRACT NO. 2


ABUTMENT FOOTING REINFORCING PLANS			
STATE OF VERMONT			
DEPARTMENT OF HIGHWAYS			
INTERSTATE PROJECT in the town of			
WATERBURY			
INTERSTATE	STA. 939+50		
OVER			
U.S. ROUTE 2 (RELOC)	STA. 20+00		
THE CLARKESON ENGINEERING CO., INC.			
CONSULTING ENGINEERS			
BOSTON	MASSACHUSETTS		
SURVEYED BY	CHECKED BY	SCALE	AS NOTED
DRAWN BY	IN CHARGE	DATE	8-19-86
PROJECT NO. I-89-2 (7)	SHEET	250	OF 307




B.R.R. DIV. NO.	STATE	PROJECT NO.	SHEET NO.	TOTAL SHEETS
I	VT.	I-89-2 (7)	116	296

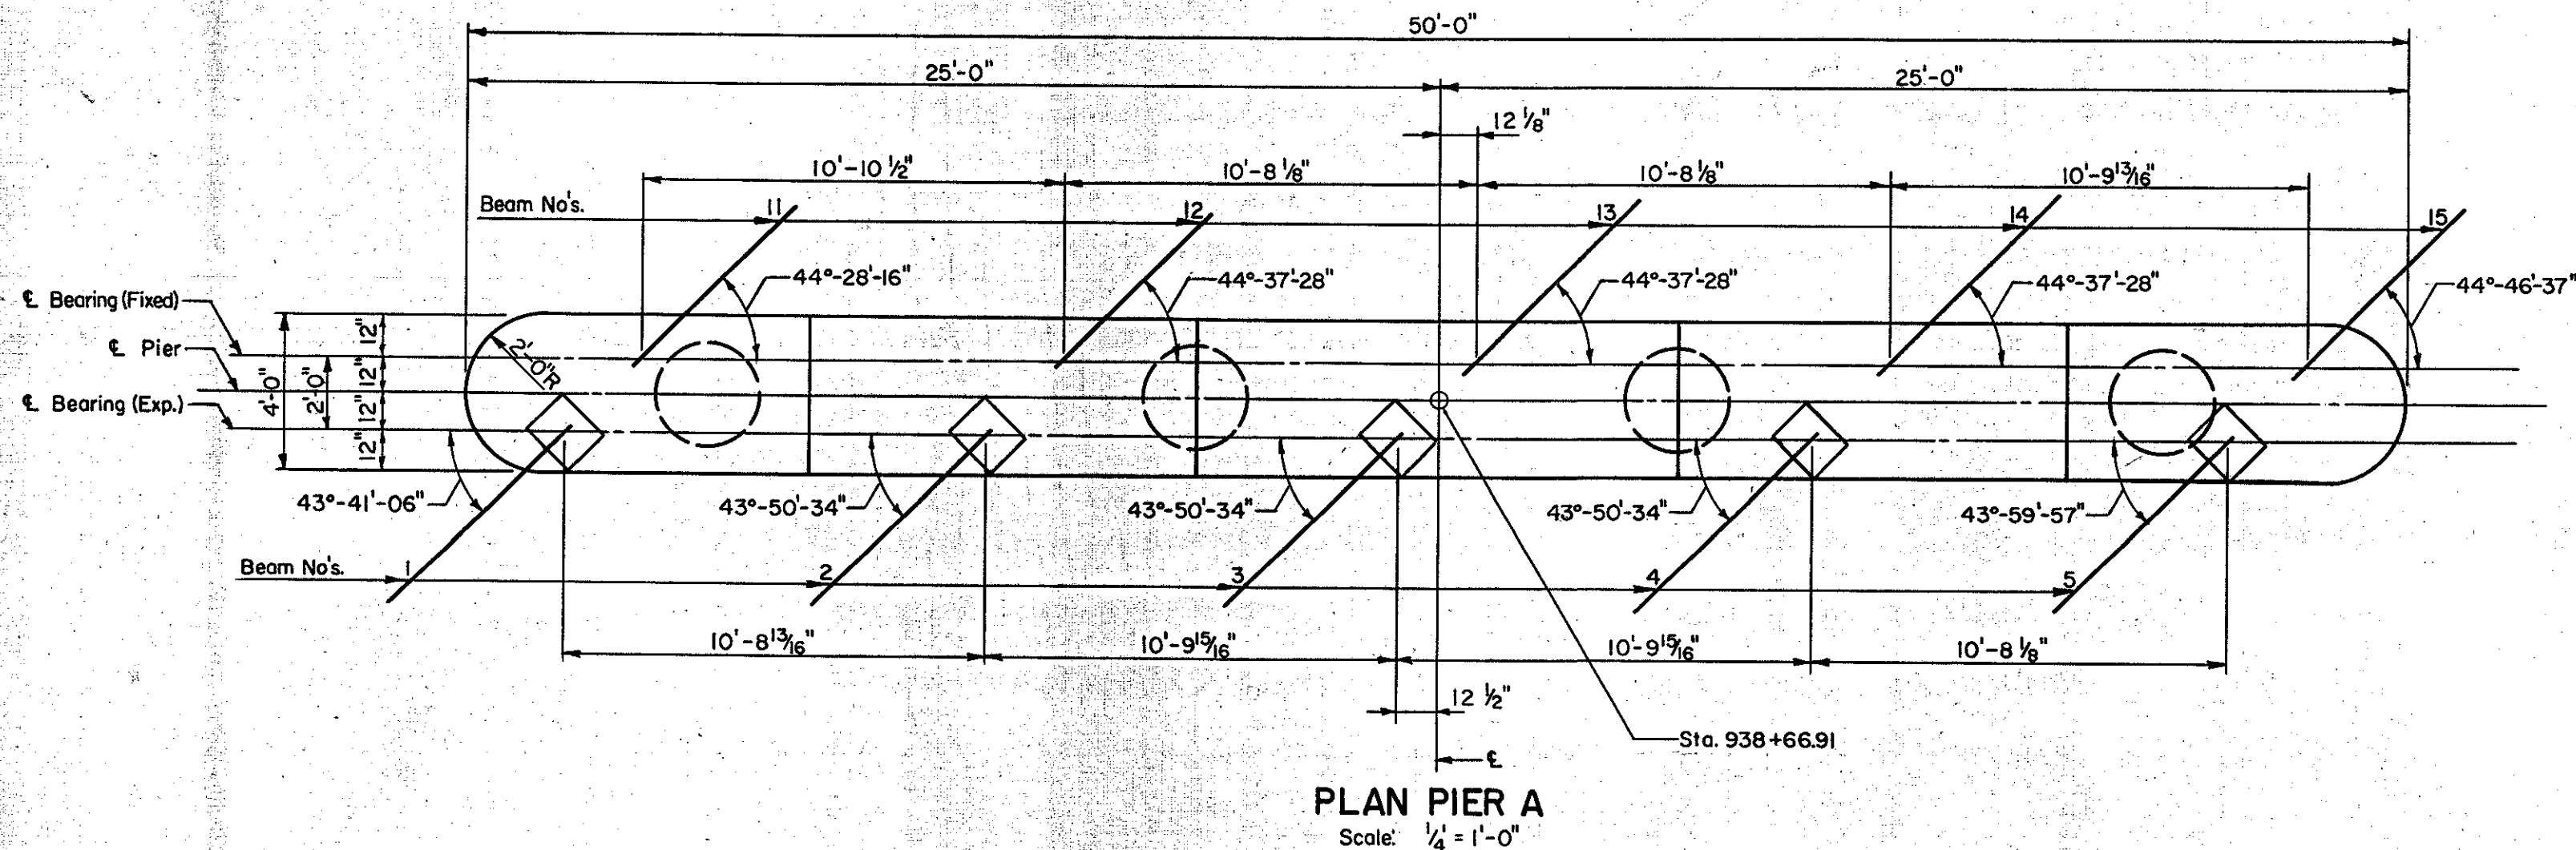


PLAN PIER A  
Scale: 1/4" = 1'-0"

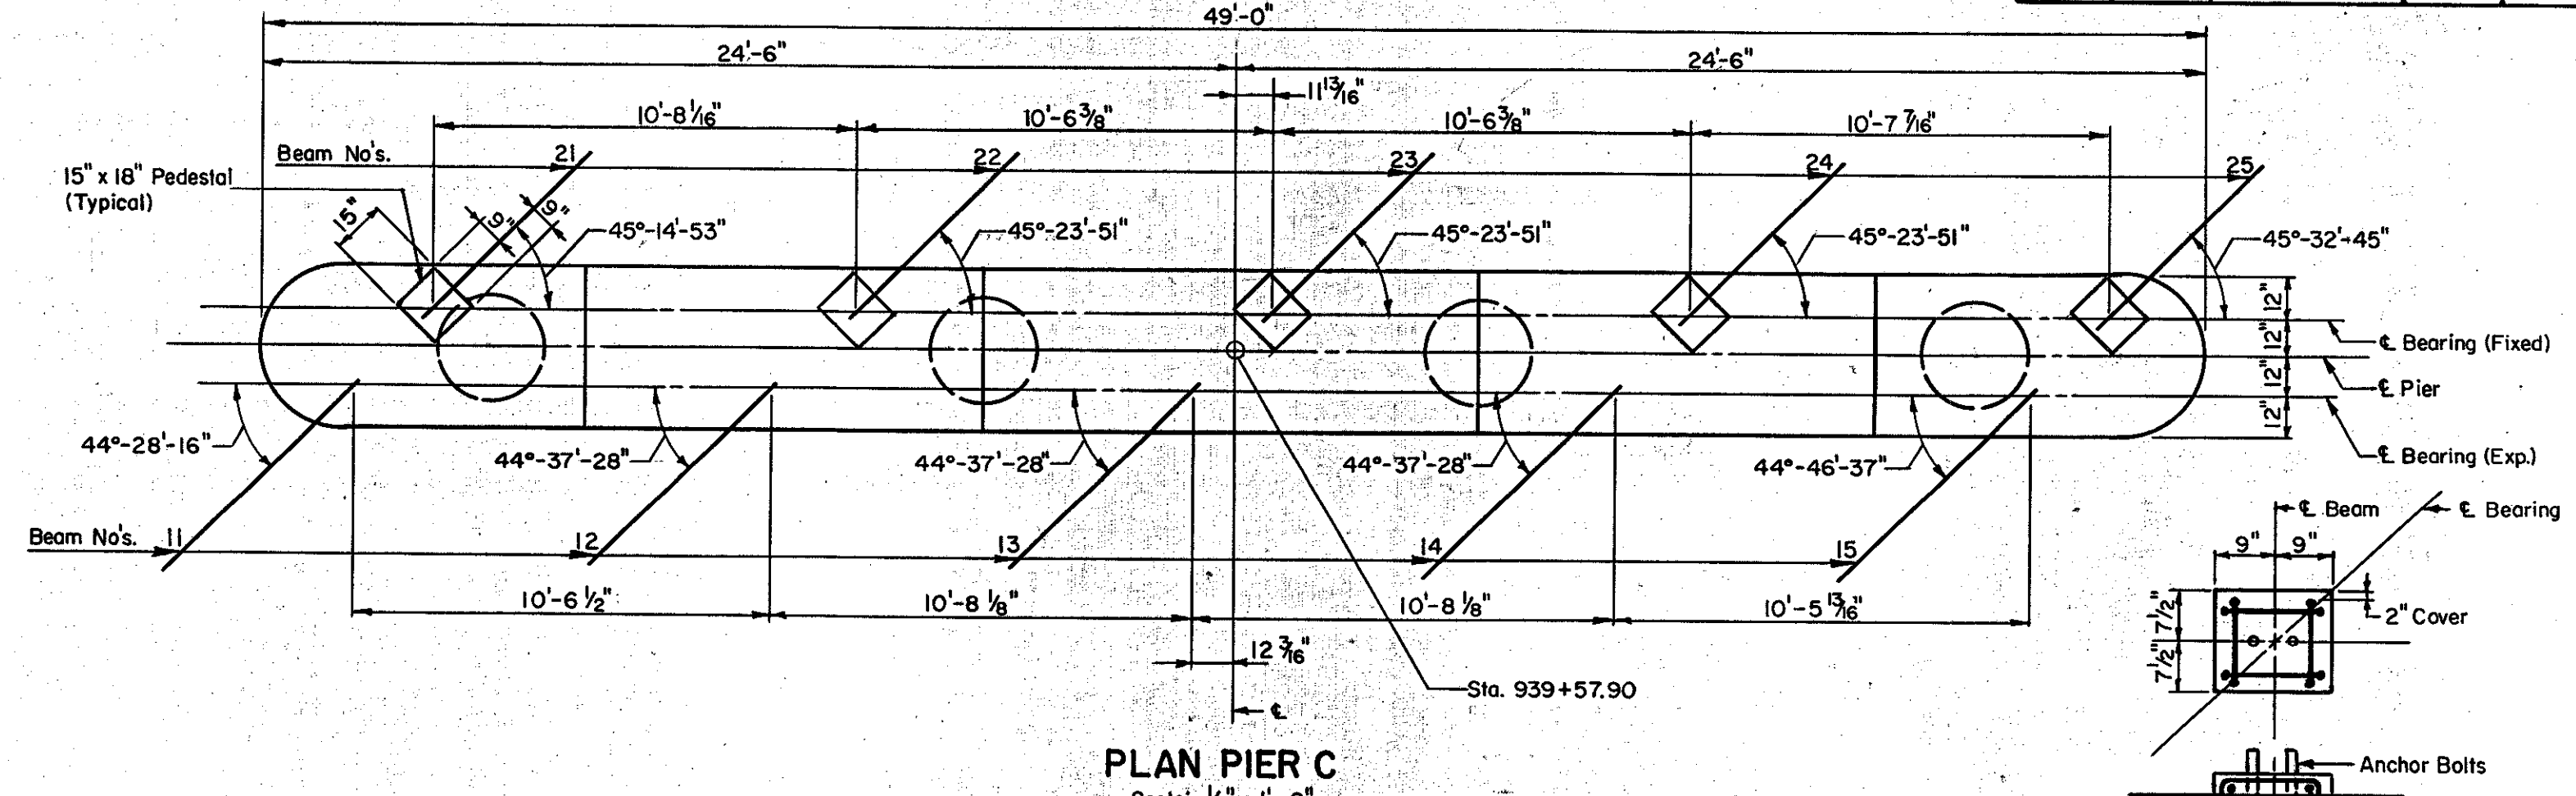


PLAN PIER C  
Scale: 1/4" = 1'-0"

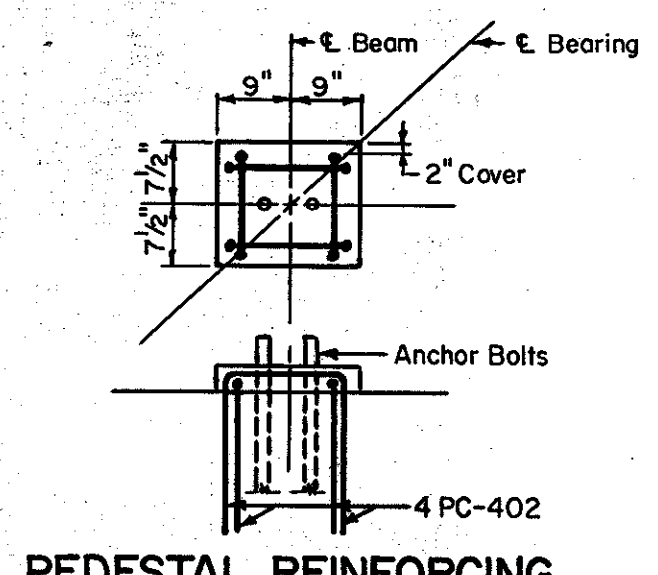

PEDESTAL REINFORCING  
Scale: 1/2" = 1'-0"  
Note: Omit Reinforcing in Pedestals less than 3'

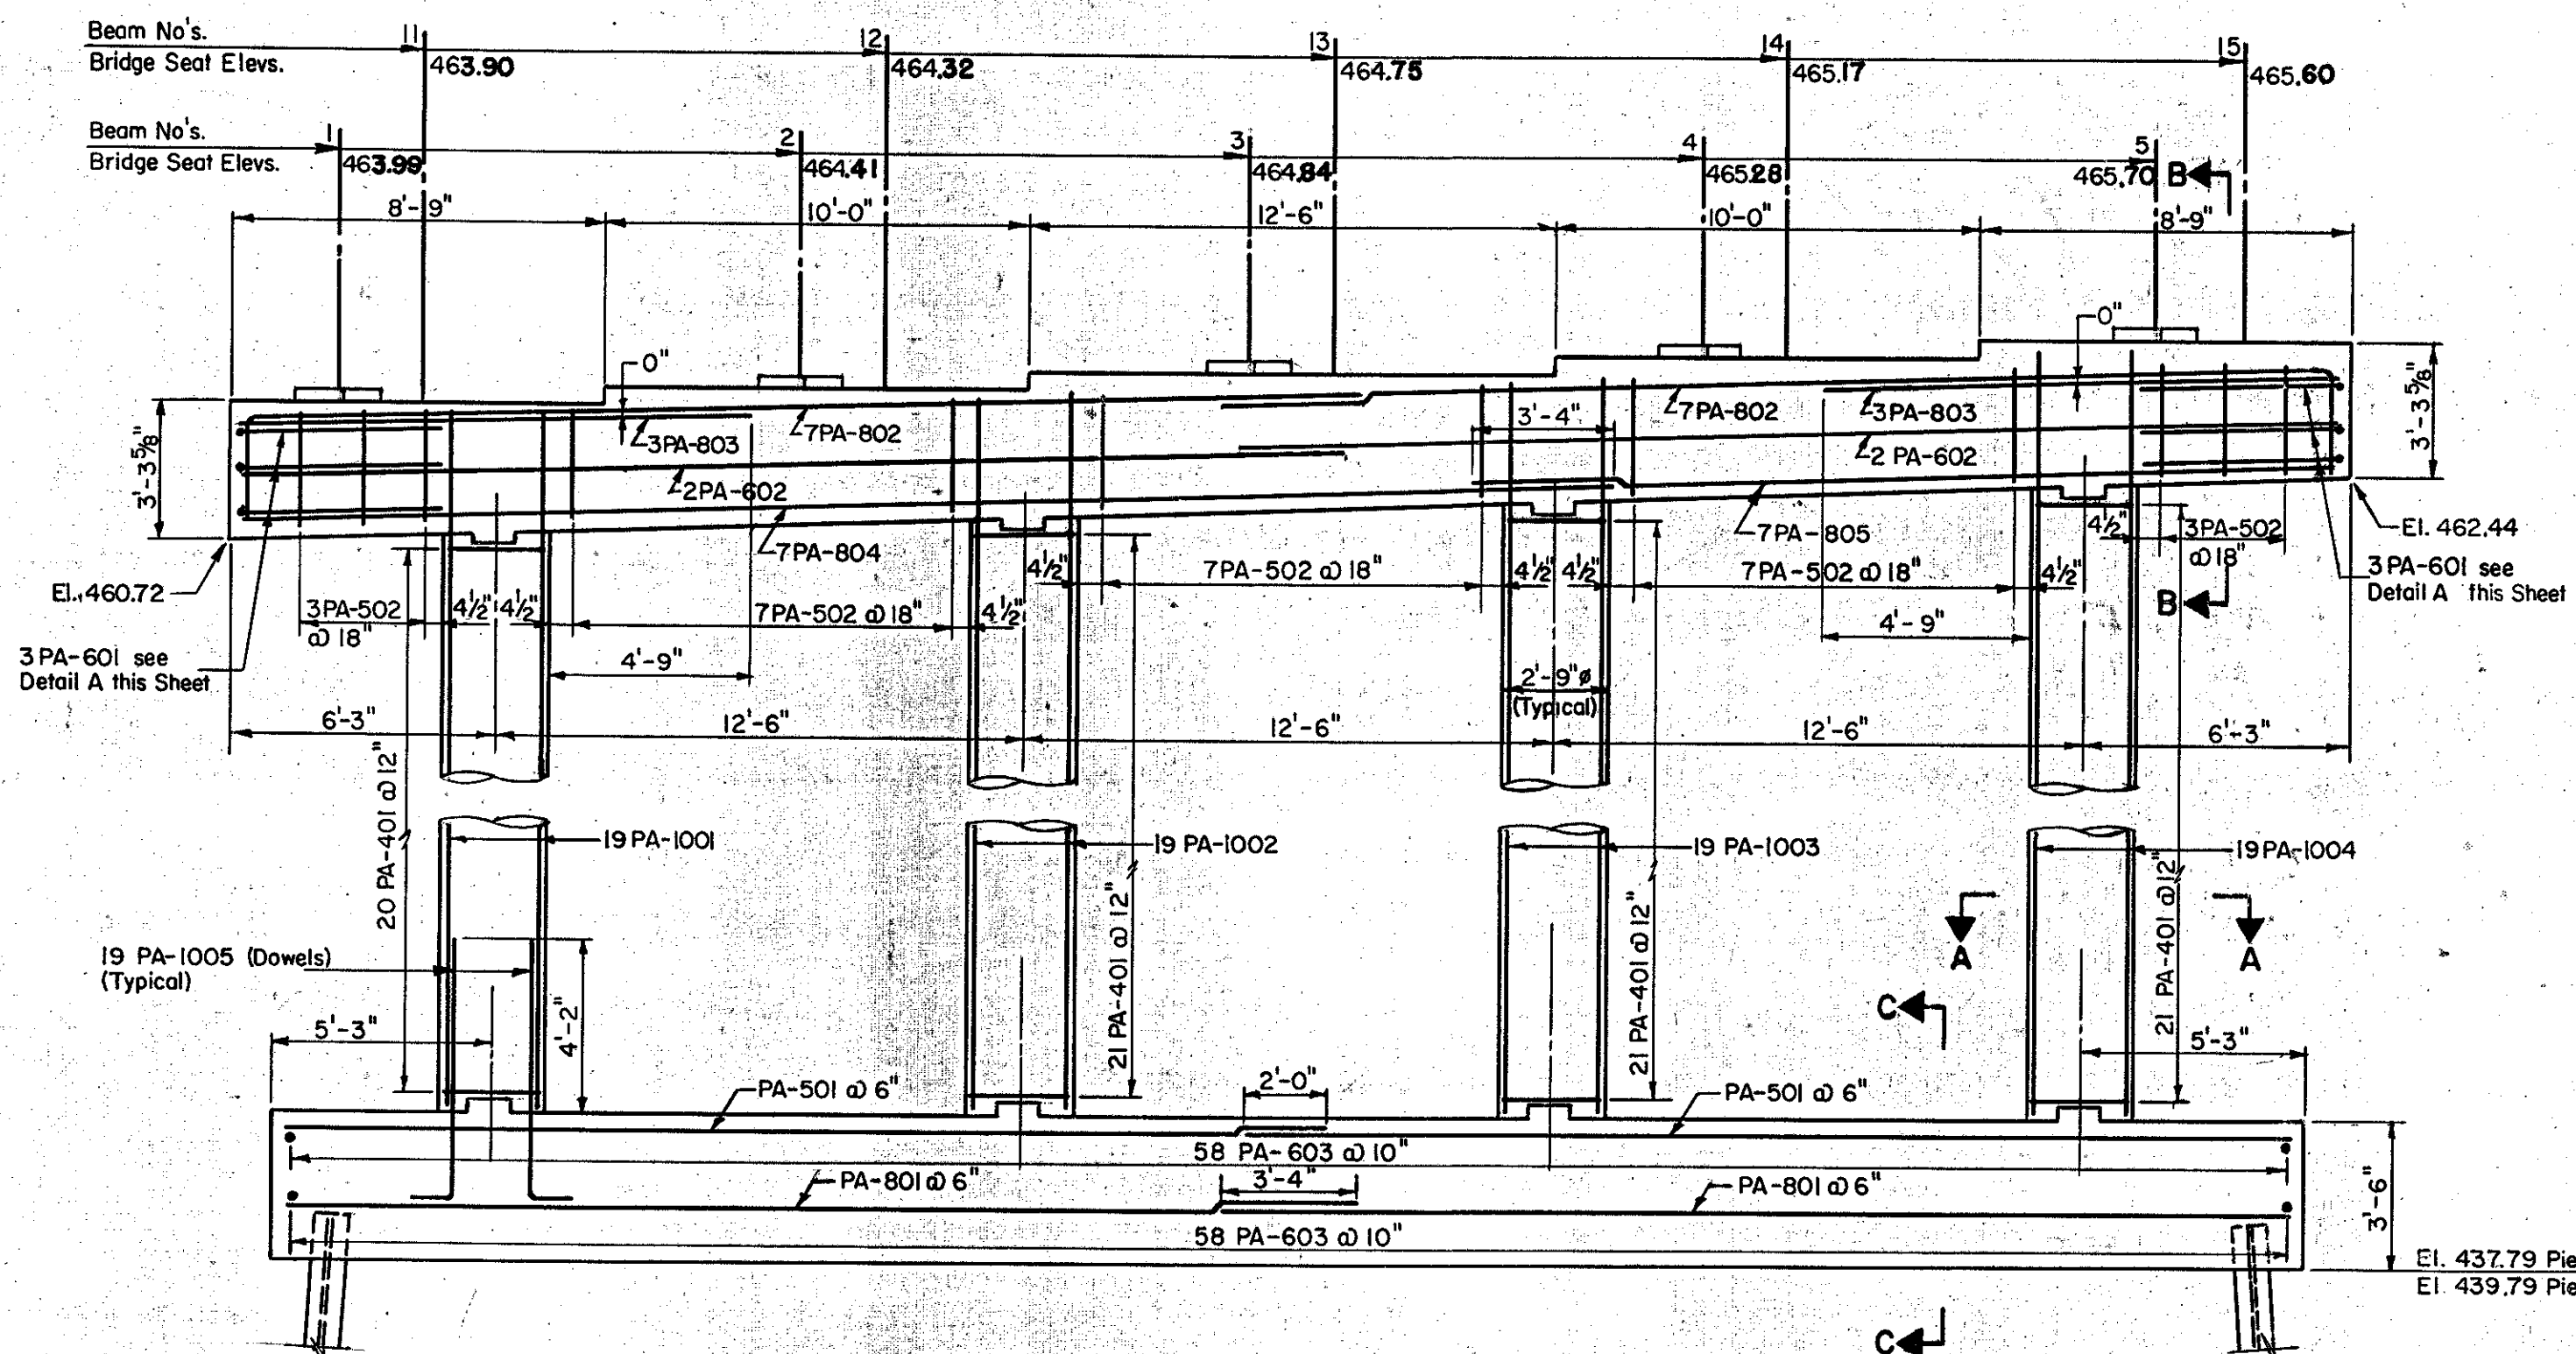


ELEVATION PIER A  
Scale: 1/4" = 1'-0"

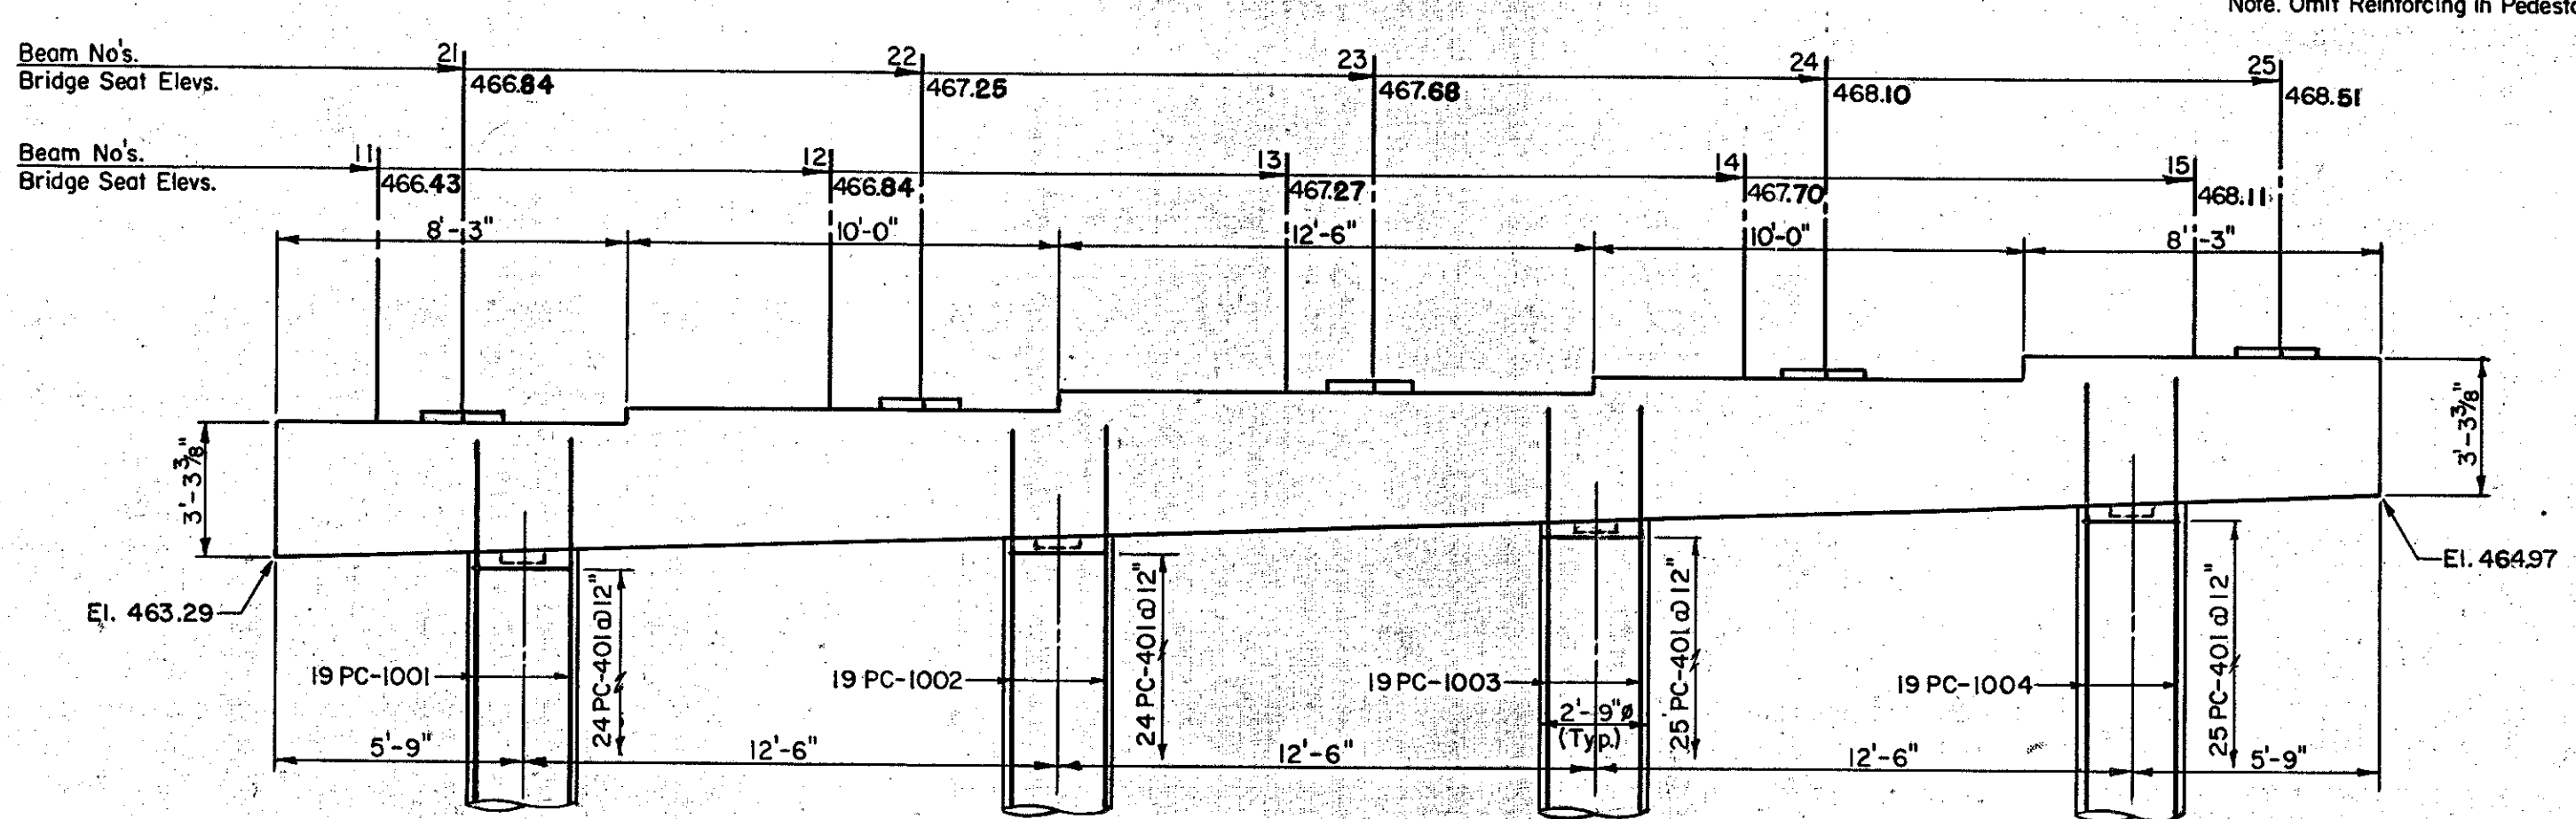


ELEVATION PIER C  
Scale: 1/4" = 1'-0"

Note: Reinforcing for Beam and Footing of Pier C similar to Pier A except bars to be prefixed PC.

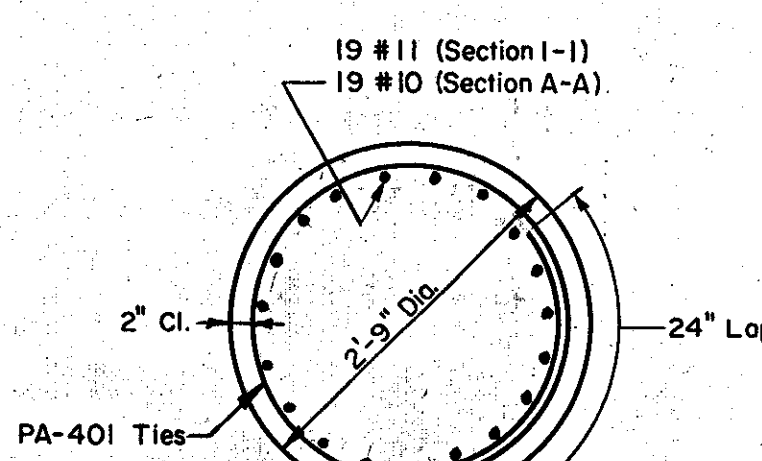


SECTION A-A  
SECTION I-I SIMILAR EXCEPT AS NOTED  
Scale: 3/4" = 1'-0"

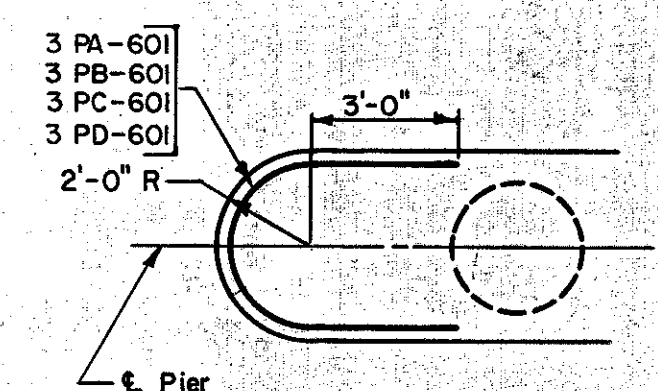


DETAIL A  
Scale: 1/4" = 1'-0"


- Notes:
- All piles IO BP 42, 35 ton design load, indicated thus: I Vertical, † Battered.
  - For estimating purposes, Pier piles are assumed to be 34' (Average) long Pier A, and 26' (Average) long Pier C.
  - Prior to driving the piles, rock free fill shall be placed under the Pier area to approximately the level of the pile cut off elevation and with a surface area of at least two (2) feet just outside the pier footings. After the piles have been driven, the fill is to be excavated to the elevations of the footings.
  - All exposed corners to have 1" Chamfer.
  - For location of Section I-I, see Sheet No. 117
  - Area between bridge seats to be sloped 1/4" per foot from † Pier. Bridge Seats to be covered with 1/2" Asphaltic-Asbestos coating after superstructure is in place.

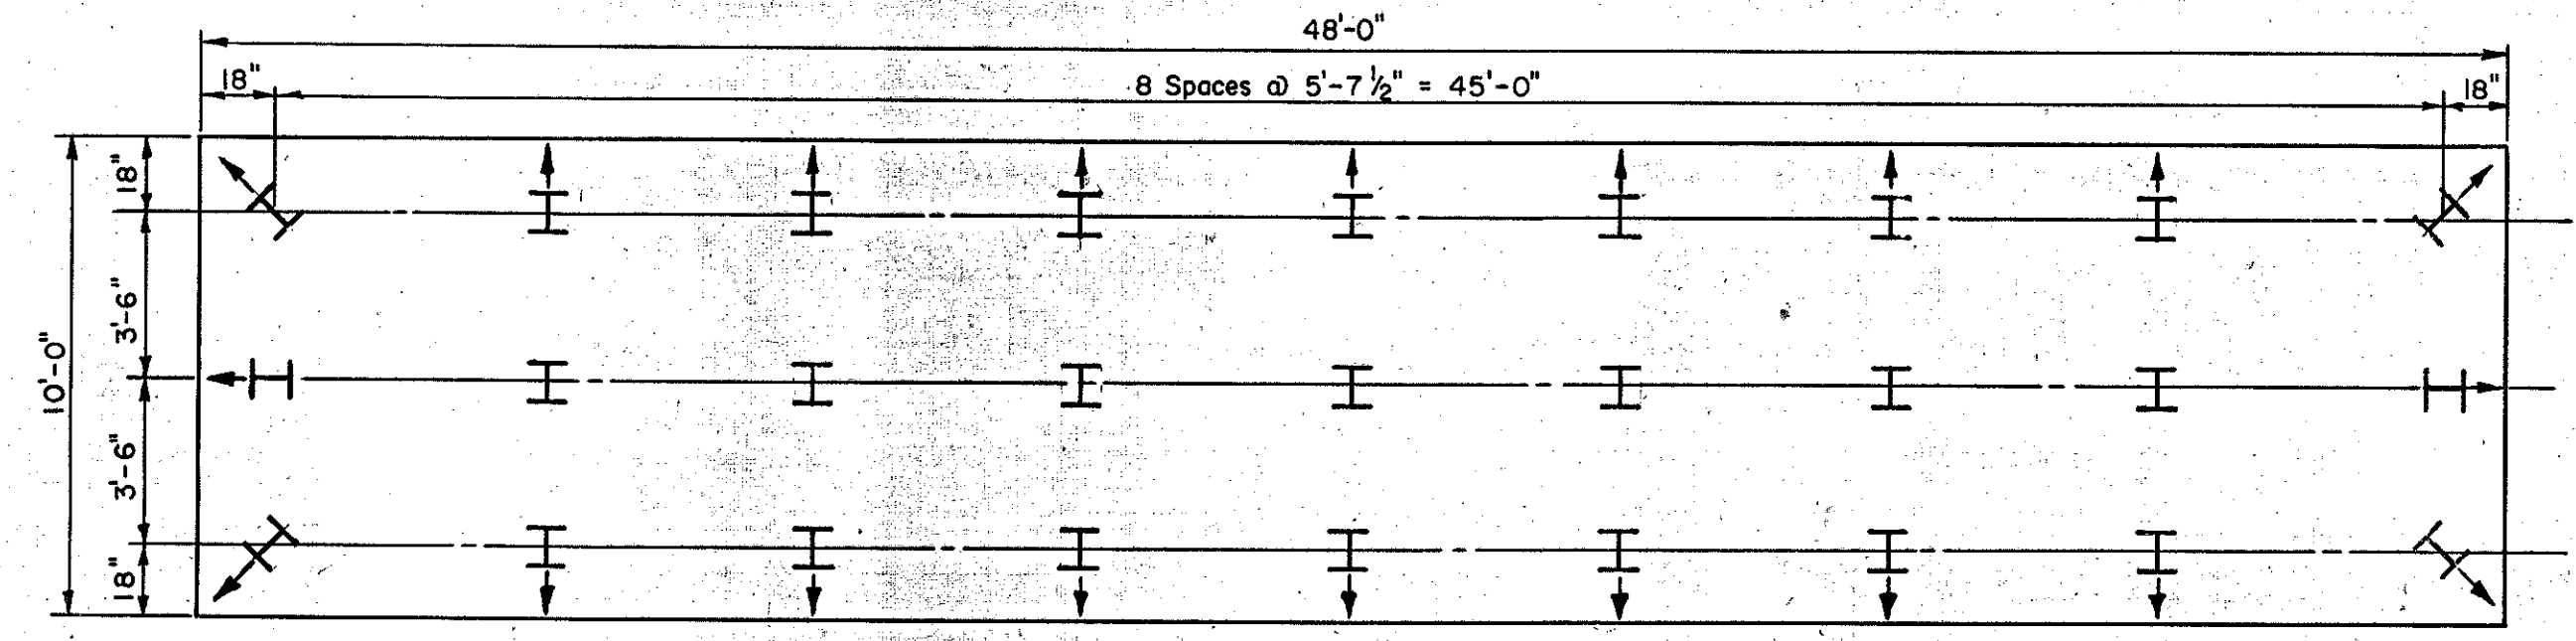

PILE PLAN  
Scale: 1/4" = 1'-0"

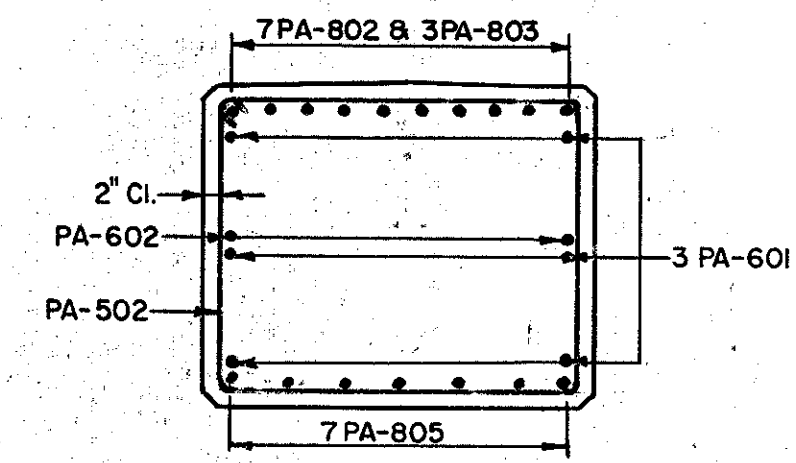

SECTION B-B  
Scale: 1/2" = 1'-0"

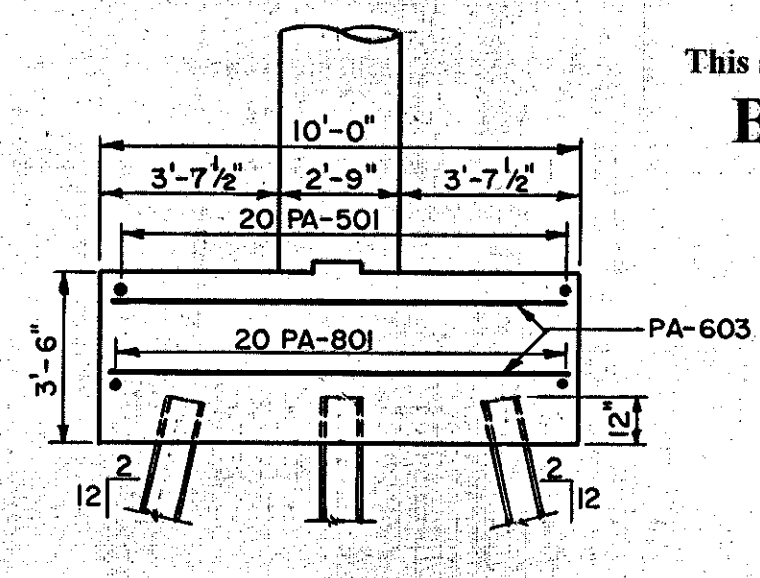


SECTION C-C  
Scale: 1/4" = 1'-0"


IM 089-2(26)  
This sheet for information only  
**BR 50 N & S**

CONTRACT NO. 2


<b>PIERS A AND C</b>	
STATE OF VERMONT DEPARTMENT OF HIGHWAYS	
INTERSTATE PROJECT in the town of <b>WATERBURY</b>	
INTERSTATE	STA. 939+50
OVER	STA. 20+00
U.S. ROUTE 2 (RELOC.)	
THE CLARKESON ENGINEERING CO., INC. CONSULTING ENGINEERS	
BOSTON	MASSACHUSETTS
SURVEYED BY: S.A.L.	CHECKED BY: D.S. & J.B.
DRAWN BY: S.A.L.	IN CHARGE: J.V.B.
SCALE: AS NOTED DATE: 6-19-58	
PROJECT NO. I-89-2(7)	SHEET 252 OF 307

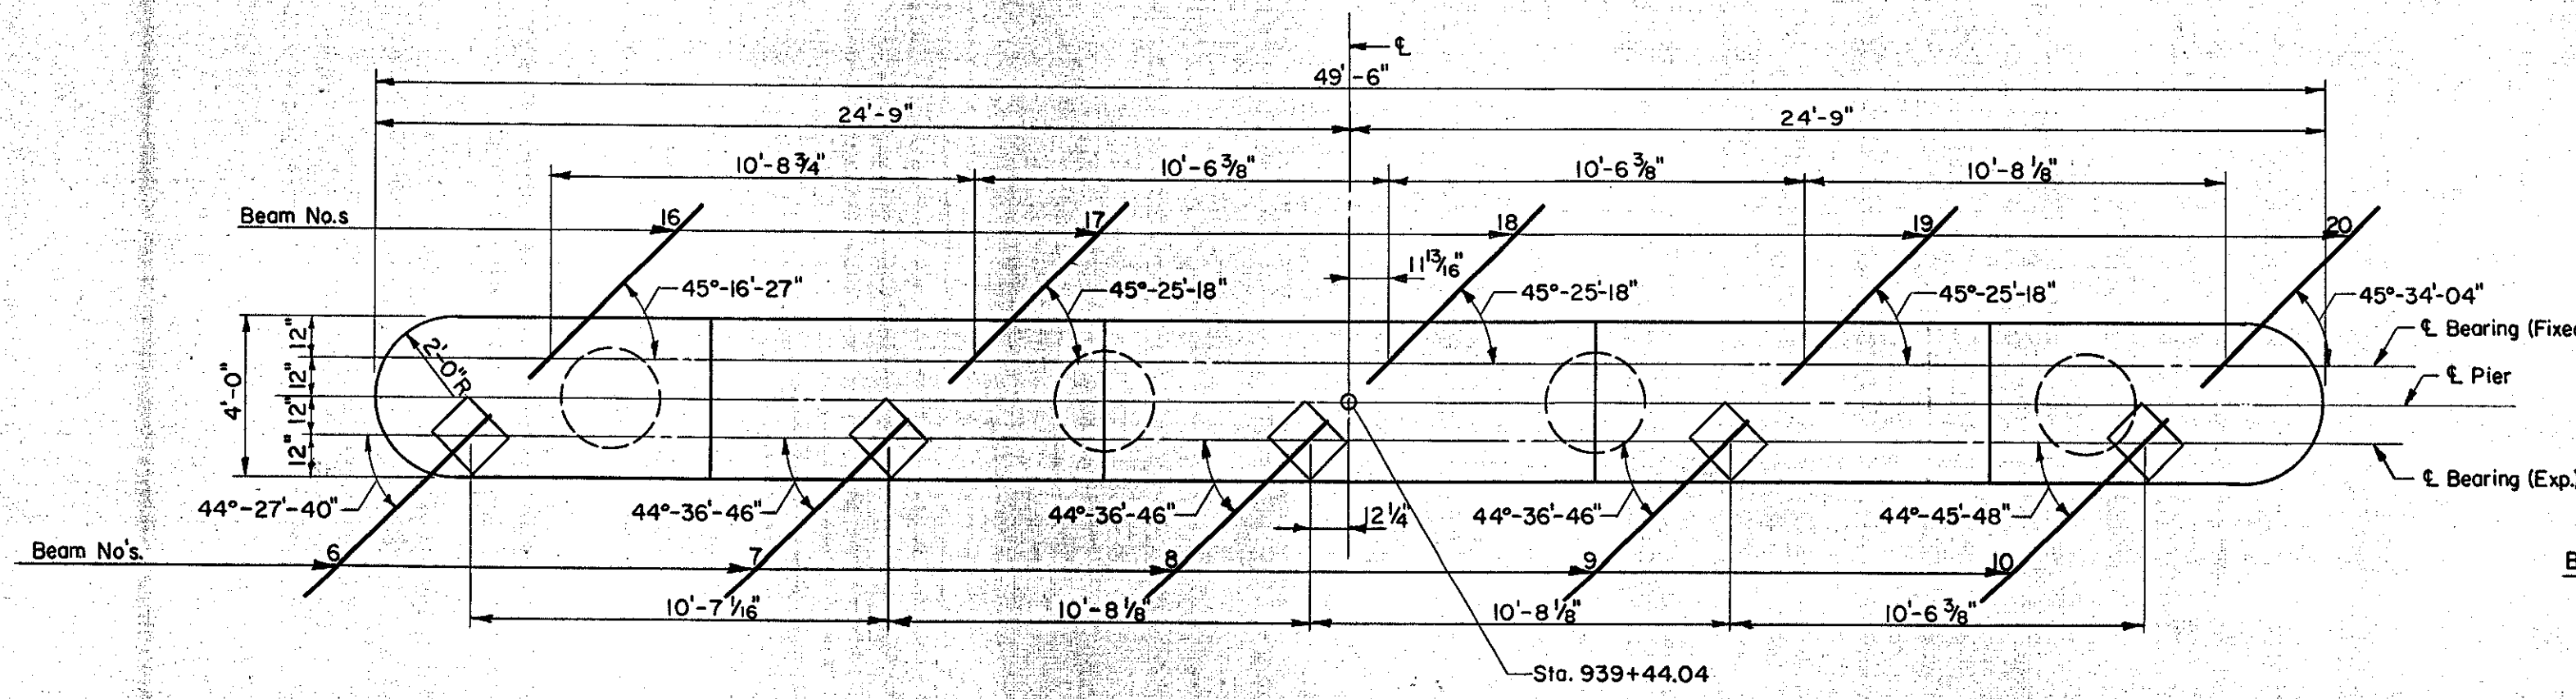


**PLAN PIER B**  
Scale: 1/4" = 1'-0"

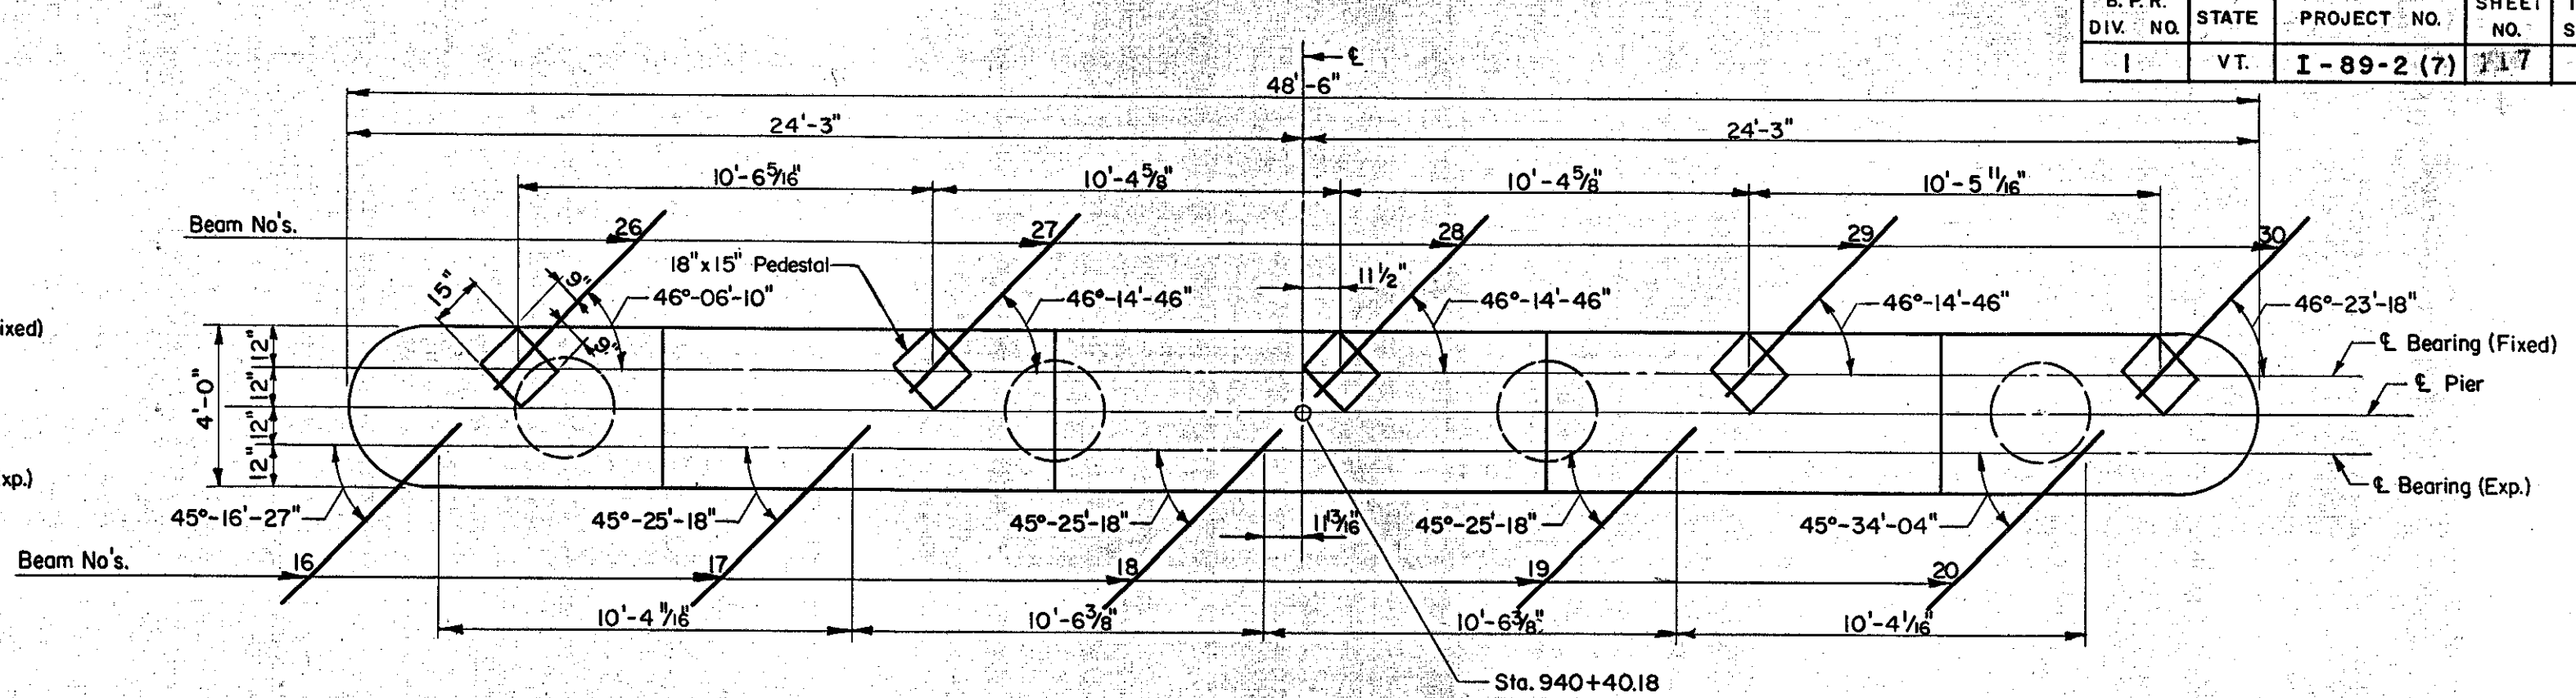


**PLAN PIER D**  
Scale: 1/4" = 1'-0"

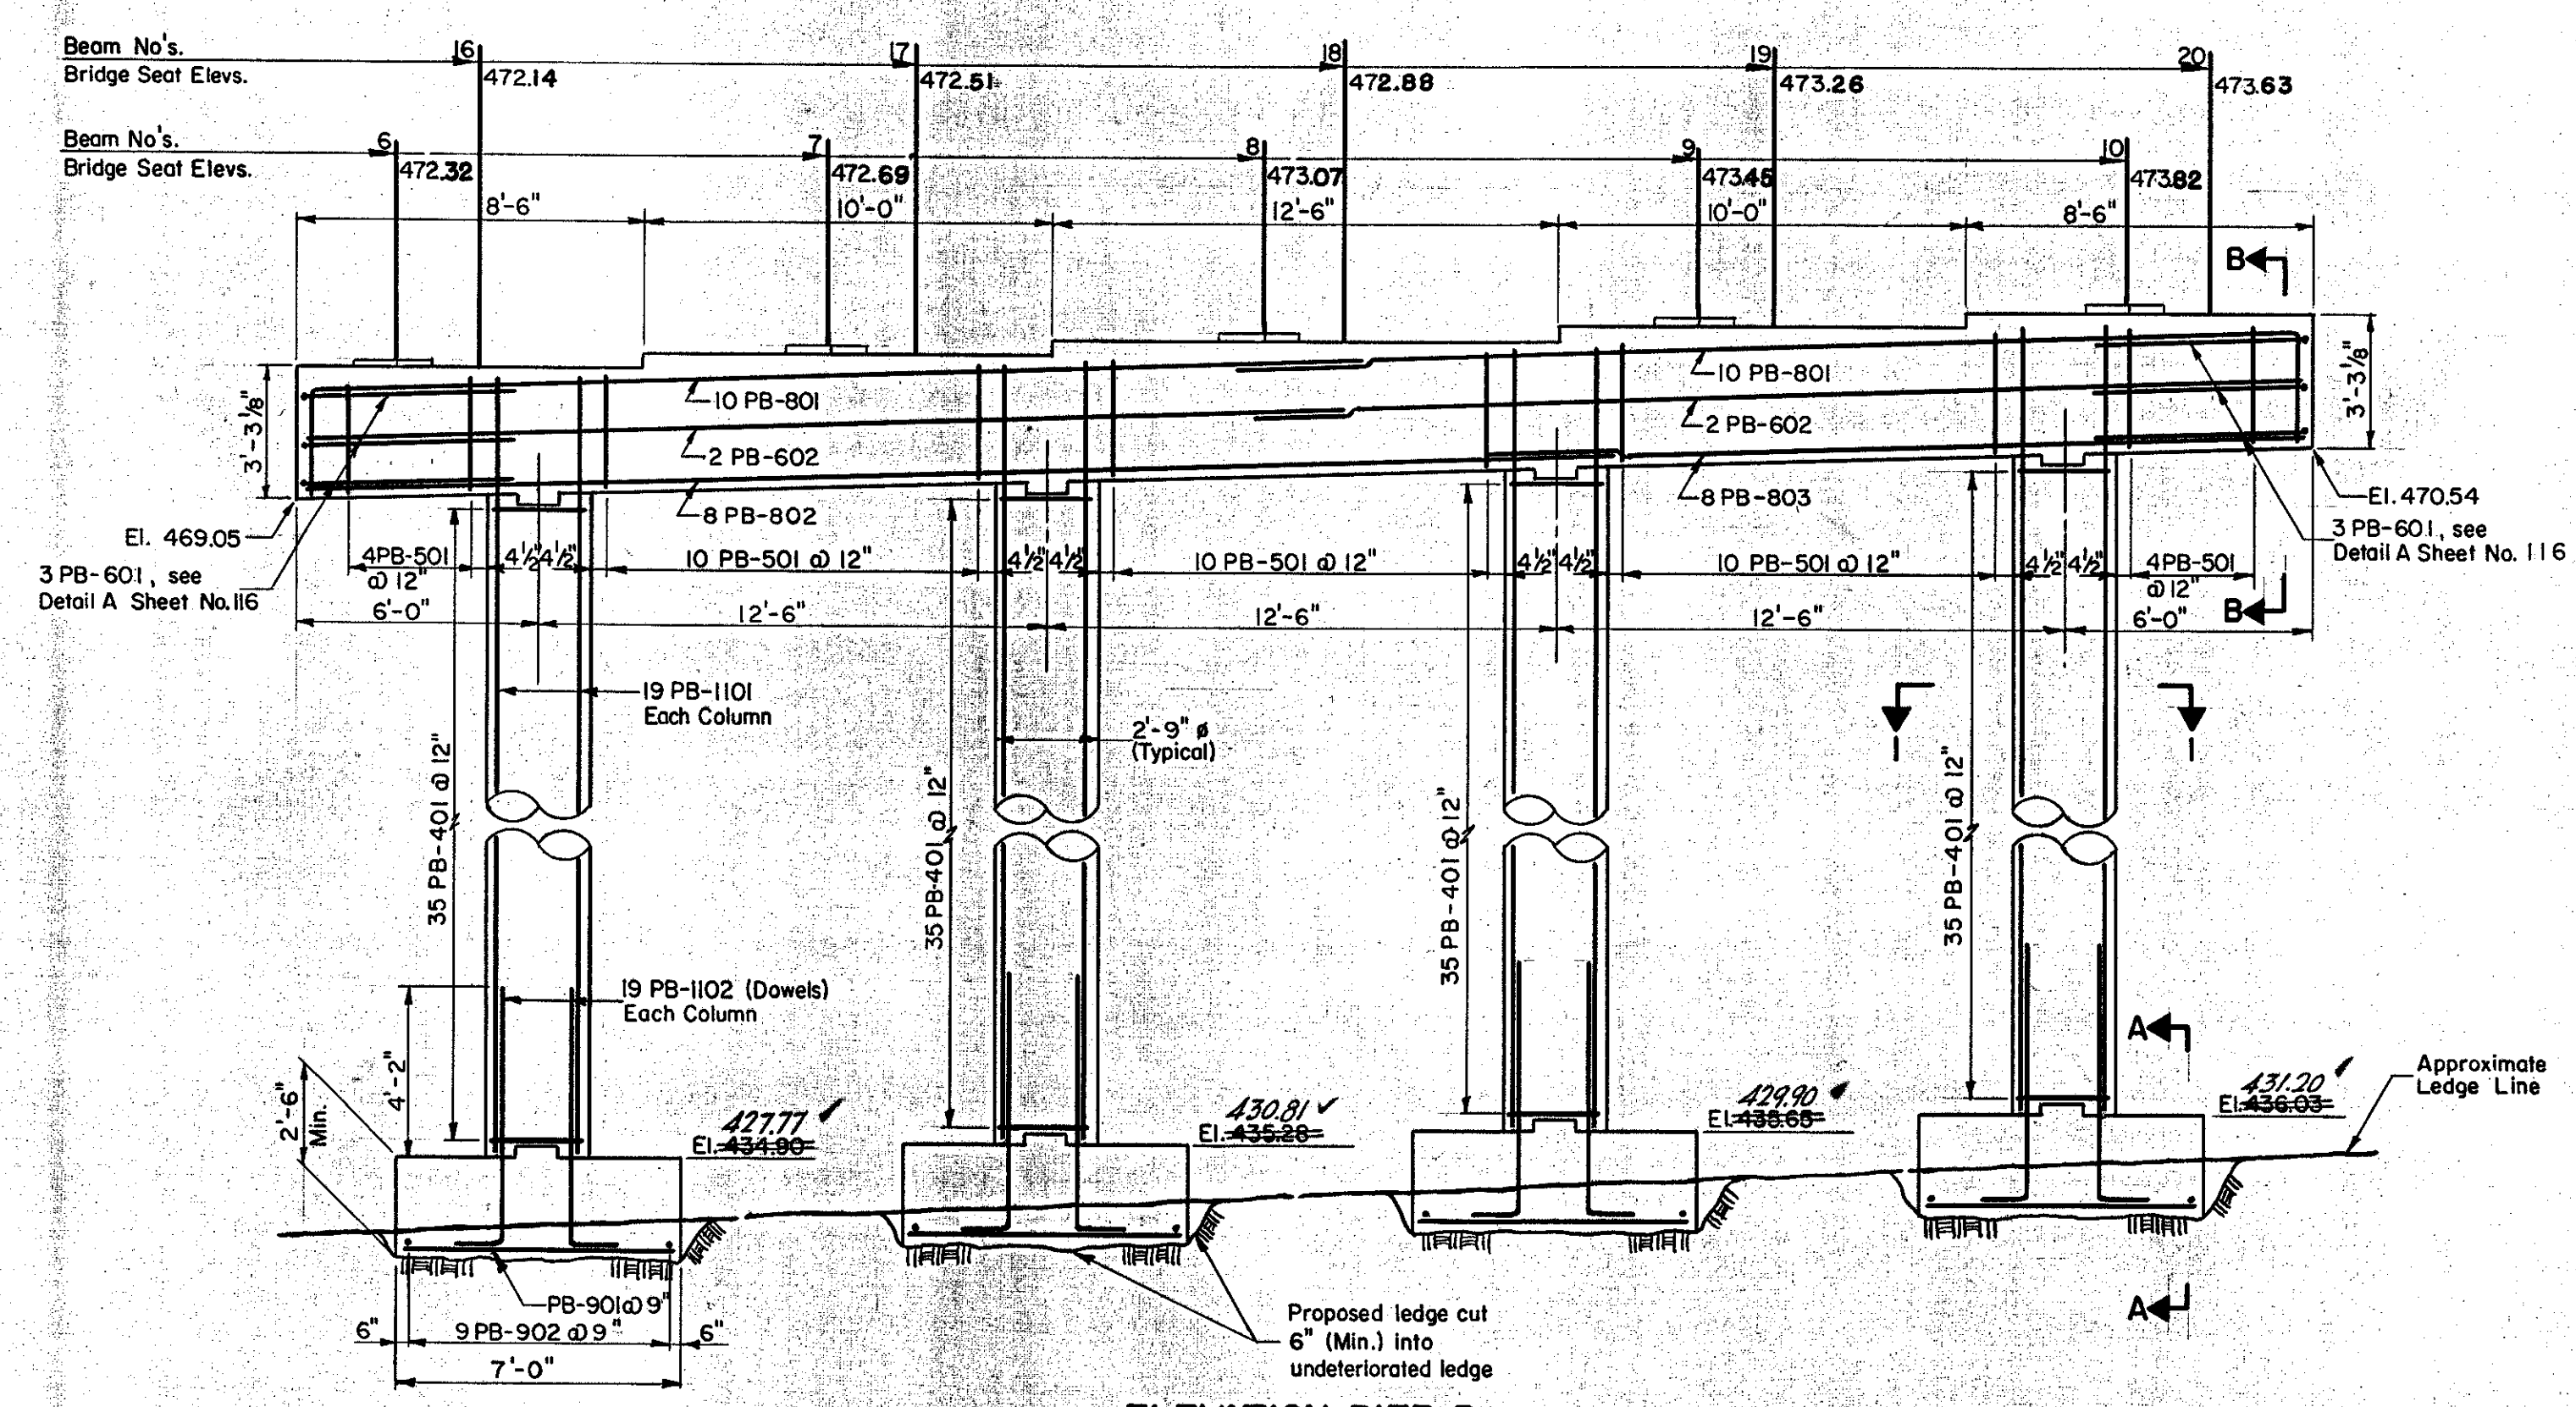


**ELEVATION PIER B**  
Scale: 1/4" = 1'-0"

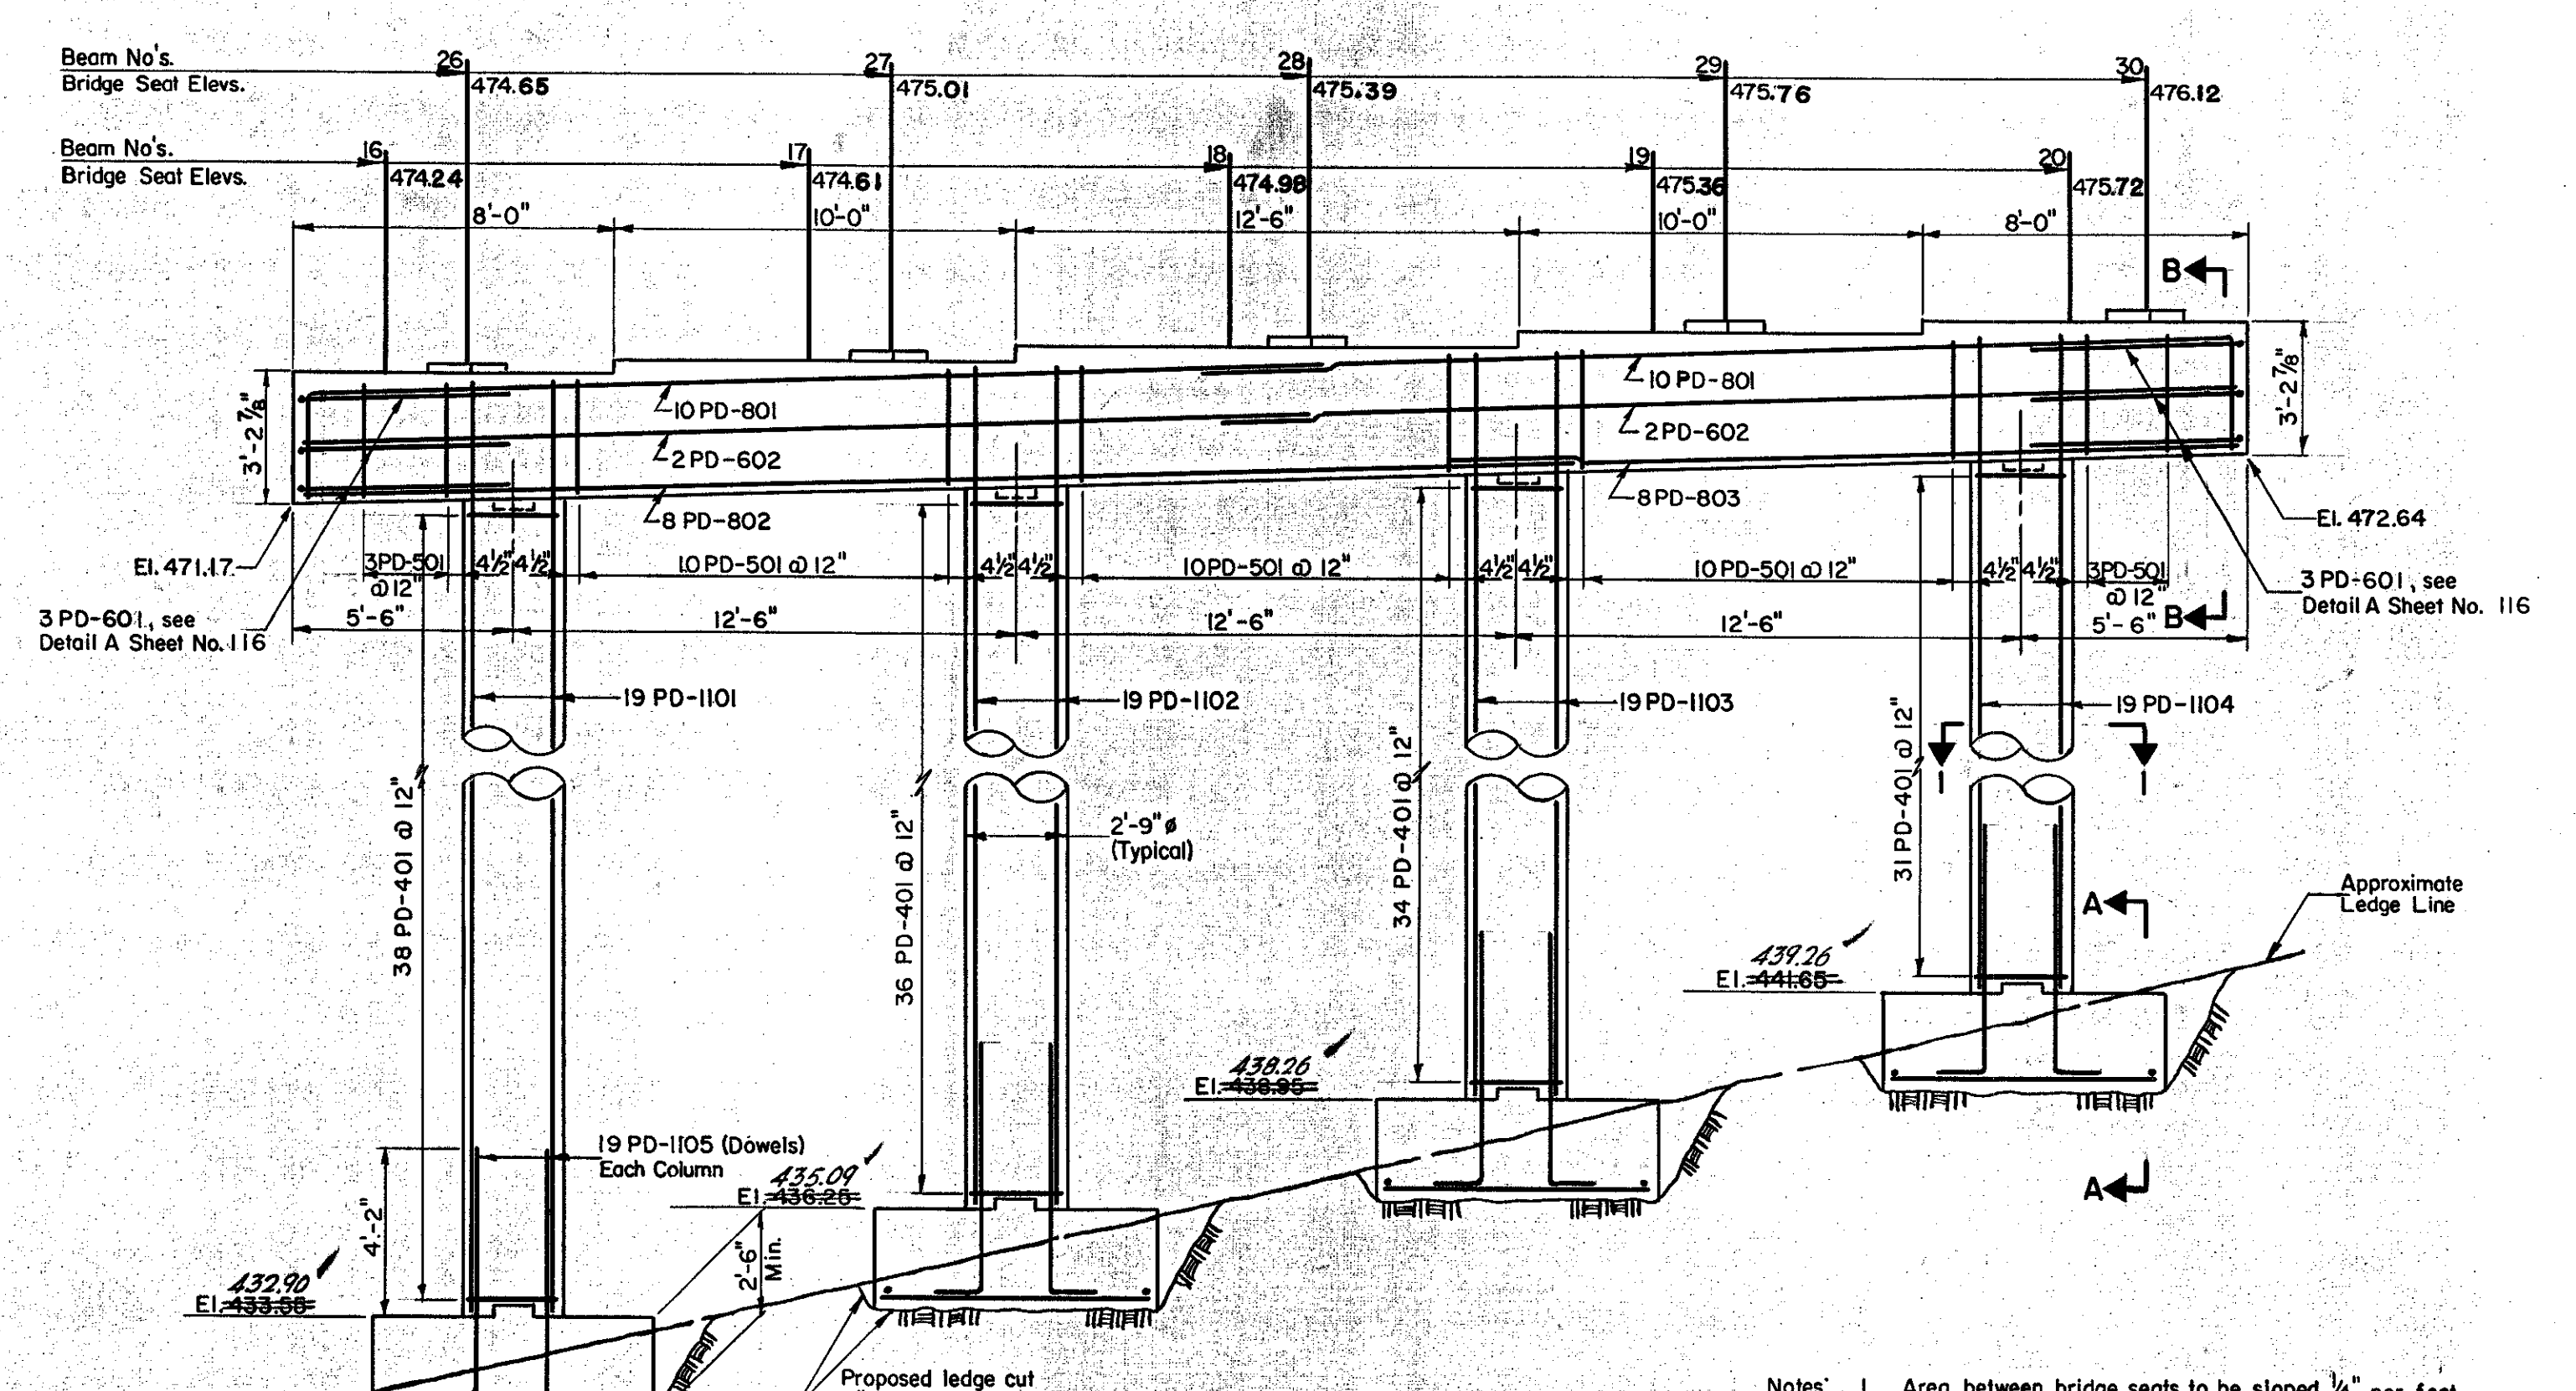

**ELEVATION PIER D**  
Scale: 1/4" = 1'-0"

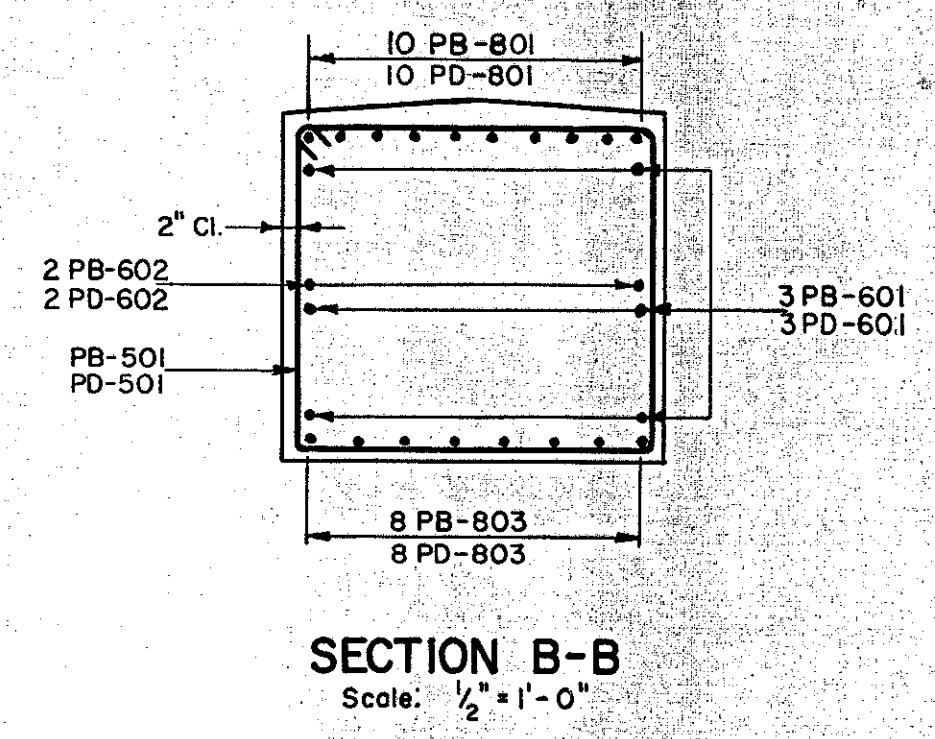

**SECTION B-B**  
Scale: 1/2" = 1'-0"

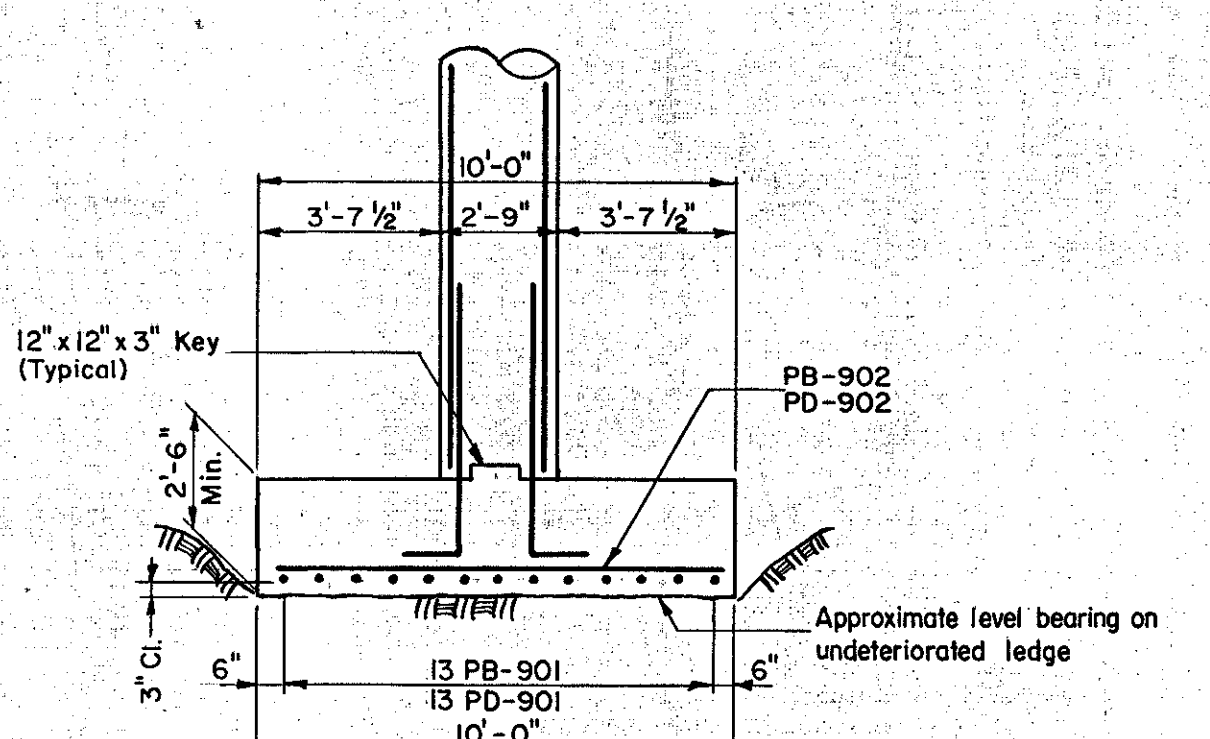

**SECTION A-A**  
Scale: 1/4" = 1'-0"

MAX. BEARING PRESSURE 9,400 LBS. PER SQ. FT.

- Notes:
- Area between bridge seats to be sloped 1/4" per foot from  $\bar{\epsilon}$  Pier. Bridge Seats to be covered with 1/2" Asphaltic Asbestos coating after superstructure is in place.
  - All exposed corners to have 1" chamfer.
  - For Section I-I, see Sheet No. 116.

**ESTIMATED QUANTITIES**

ITEM NO.	DESCRIPTION	UNIT	PIER A				PIER C				
			NET	OVER-RUN	TOTAL	FINAL	NET	OVER-RUN	TOTAL	FINAL	
107	Structure Excavation	C. Y.	23	✓	23	23	✓	23	23	✓	23
401-B	Concrete Class B (Mod.)	C. Y.	104	✓	104	104	✓	104	104	✓	104
402	Reinforcing Steel	LBS.	See Reinforcing Steel Schedule Sheet No. 122								
407	Asphaltic-Asbestos Coating	S. Y.	23	✓	23	23	✓	22	22	✓	22
504	Steel Piling	L. F.	918	✓	918	959	✓	702	702	✓	771

ITEM NO.	DESCRIPTION	UNIT	PIER B				PIER D				
			NET	OVER-RUN	TOTAL	FINAL	NET	OVER-RUN	TOTAL	FINAL	
107	Structure Excavation	C. Y.	89	✓	89	326	✓	110	110	✓	146
401-B	Concrete Class B (Mod.)	C. Y.	80	✓	80	102	✓	79	79	✓	86
402	Reinforcing Steel	LBS.	See Reinforcing Steel Schedule Sheet No. 122								
407	Asphaltic-Asbestos Coating	S. Y.	22	✓	22	22	✓	22	22	✓	22


IM 089-2(26)  
This sheet for information only  
**BR 50 N & S**

CONTRACT NO. 1

**PIERS B AND D**


**STATE OF VERMONT**  
**DEPARTMENT OF HIGHWAYS**  
INTERSTATE PROJECT in the town of  
**WATERBURY**  
INTERSTATE OVER STA. 939+50  
**U.S. ROUTE 2 (RELOC.)** OVER STA. 20+00  
THE CLARKESON ENGINEERING CO., INC.  
CONSULTING ENGINEERS  
BOSTON MASSACHUSETTS  
SURVEYED BY: S.A.L. CHECKED BY: D.S. & J.B. SCALE: AS NOTED  
DRAWN BY: S.A.L. IN CHARGE: J.V.B. DATE: 6-19-88  
PROJECT NO. I-89-2(7) SHEET 253 OF 307

B. P. R. DIV. NO.	STATE	PROJECT NO.	SHEET NO.	TOTAL SHEETS
1	VT.	I-89-2(7)	116	296

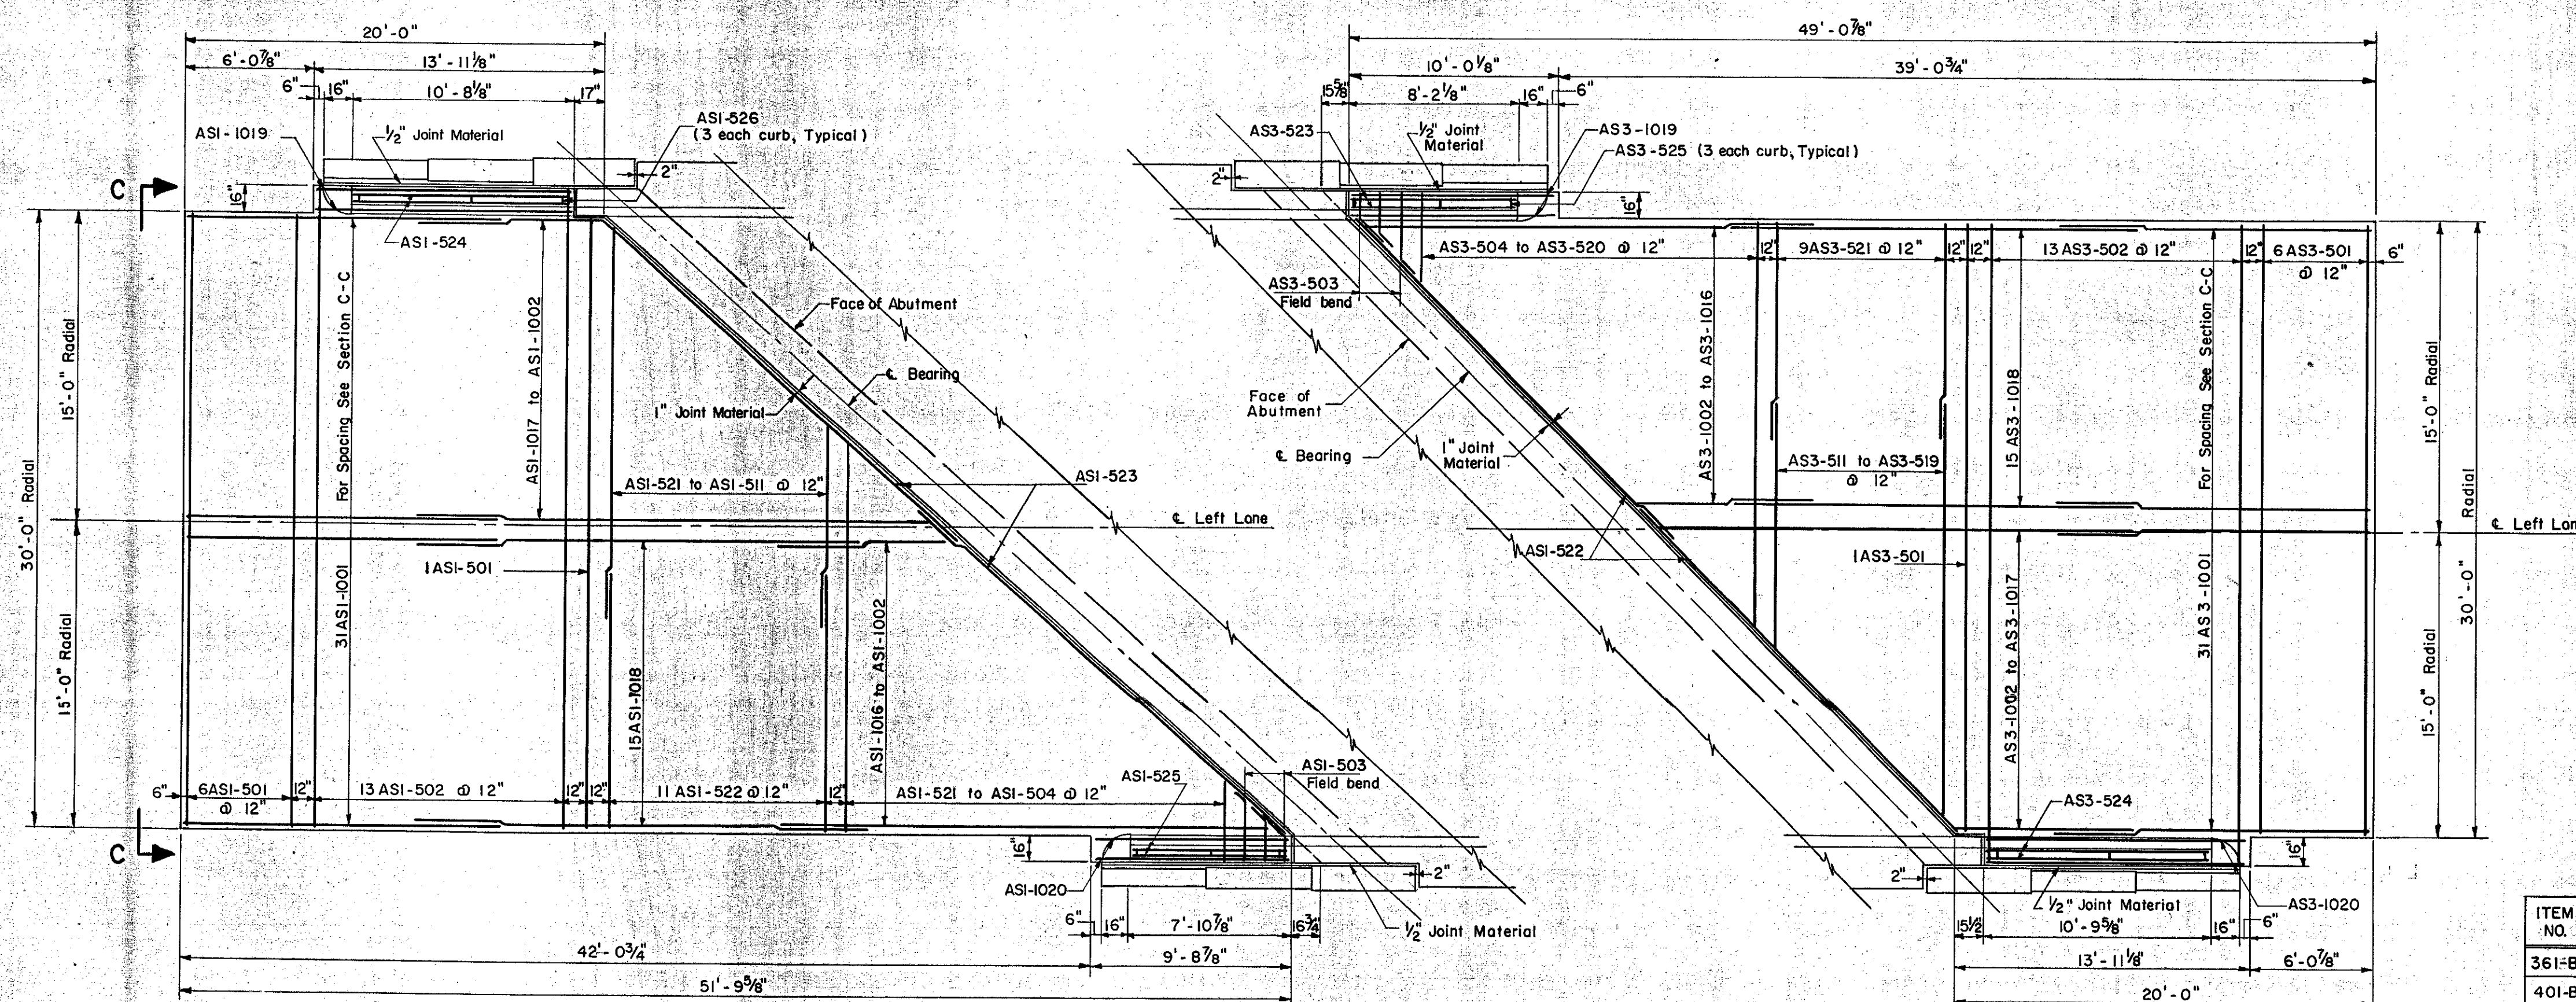

**APPROACH SLAB ABUTMENT NO. 1**  
Scale: 3/16" = 1'-0"

**APPROACH SLAB ABUTMENT NO. 3**  
Scale: 3/16" = 1'-0"

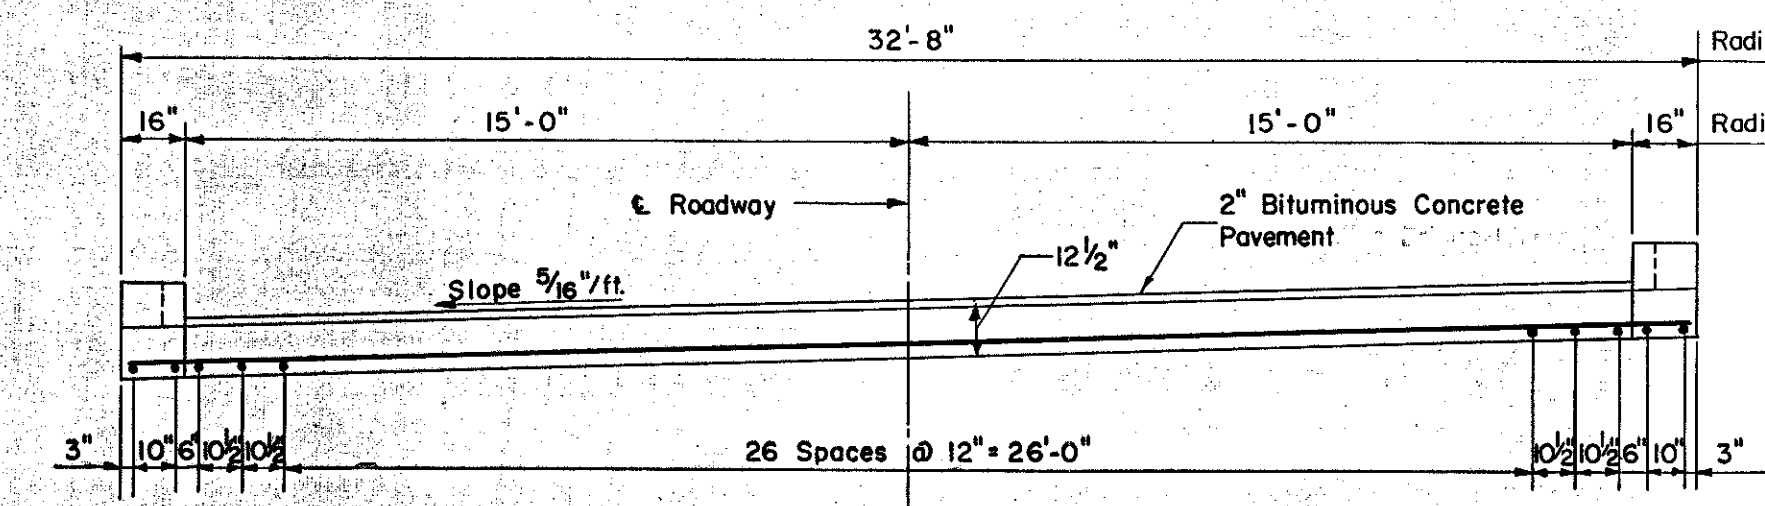


**SECTION C-C**  
Scale: 1/4" = 1'-0"  
Note: For Sections A-A and B-B See Standard Sheet SB-AS 45° Skew 57

**ESTIMATED QUANTITIES**

ITEM NO.	DESCRIPTION	UNIT	APPROACH SLAB NO. 1				APPROACH SLAB NO. 2					
			NET	OVER-RUN	TOTAL	FINAL	NET	OVER-RUN	TOTAL	FINAL		
361-B	Bituminous Concrete Pavement	TONS	14	✓	±	14	✓	±	14	✓	±	14
401-B	Concrete Class B (Mod.)	C. Y.	43	✓	±	43	✓	±	43	✓	±	43
402	Reinforcing Steel	LBS.	See Reinforcing Steel Schedule Sheet No. 123									
556-C	Granite Bridge Curb (Type I)	L.F.	See Sheet No. 3									

ITEM NO.	DESCRIPTION	UNIT	APPROACH SLAB NO. 3				APPROACH SLAB NO. 4					
			NET	OVER-RUN	TOTAL	FINAL	NET	OVER-RUN	TOTAL	FINAL		
361-B	Bituminous Concrete Pavement	TONS	13	✓	±	13	✓	±	13	✓	±	13
401-B	Concrete Class B (Mod.)	C. Y.	41	✓	±	41	✓	±	41	✓	±	41
402	Reinforcing Steel	LBS.	See Reinforcing Steel Schedule Sheet No. 123									
556-C	Granite Bridge Curb (Type I)	L.F.	See Sheet No. 3									

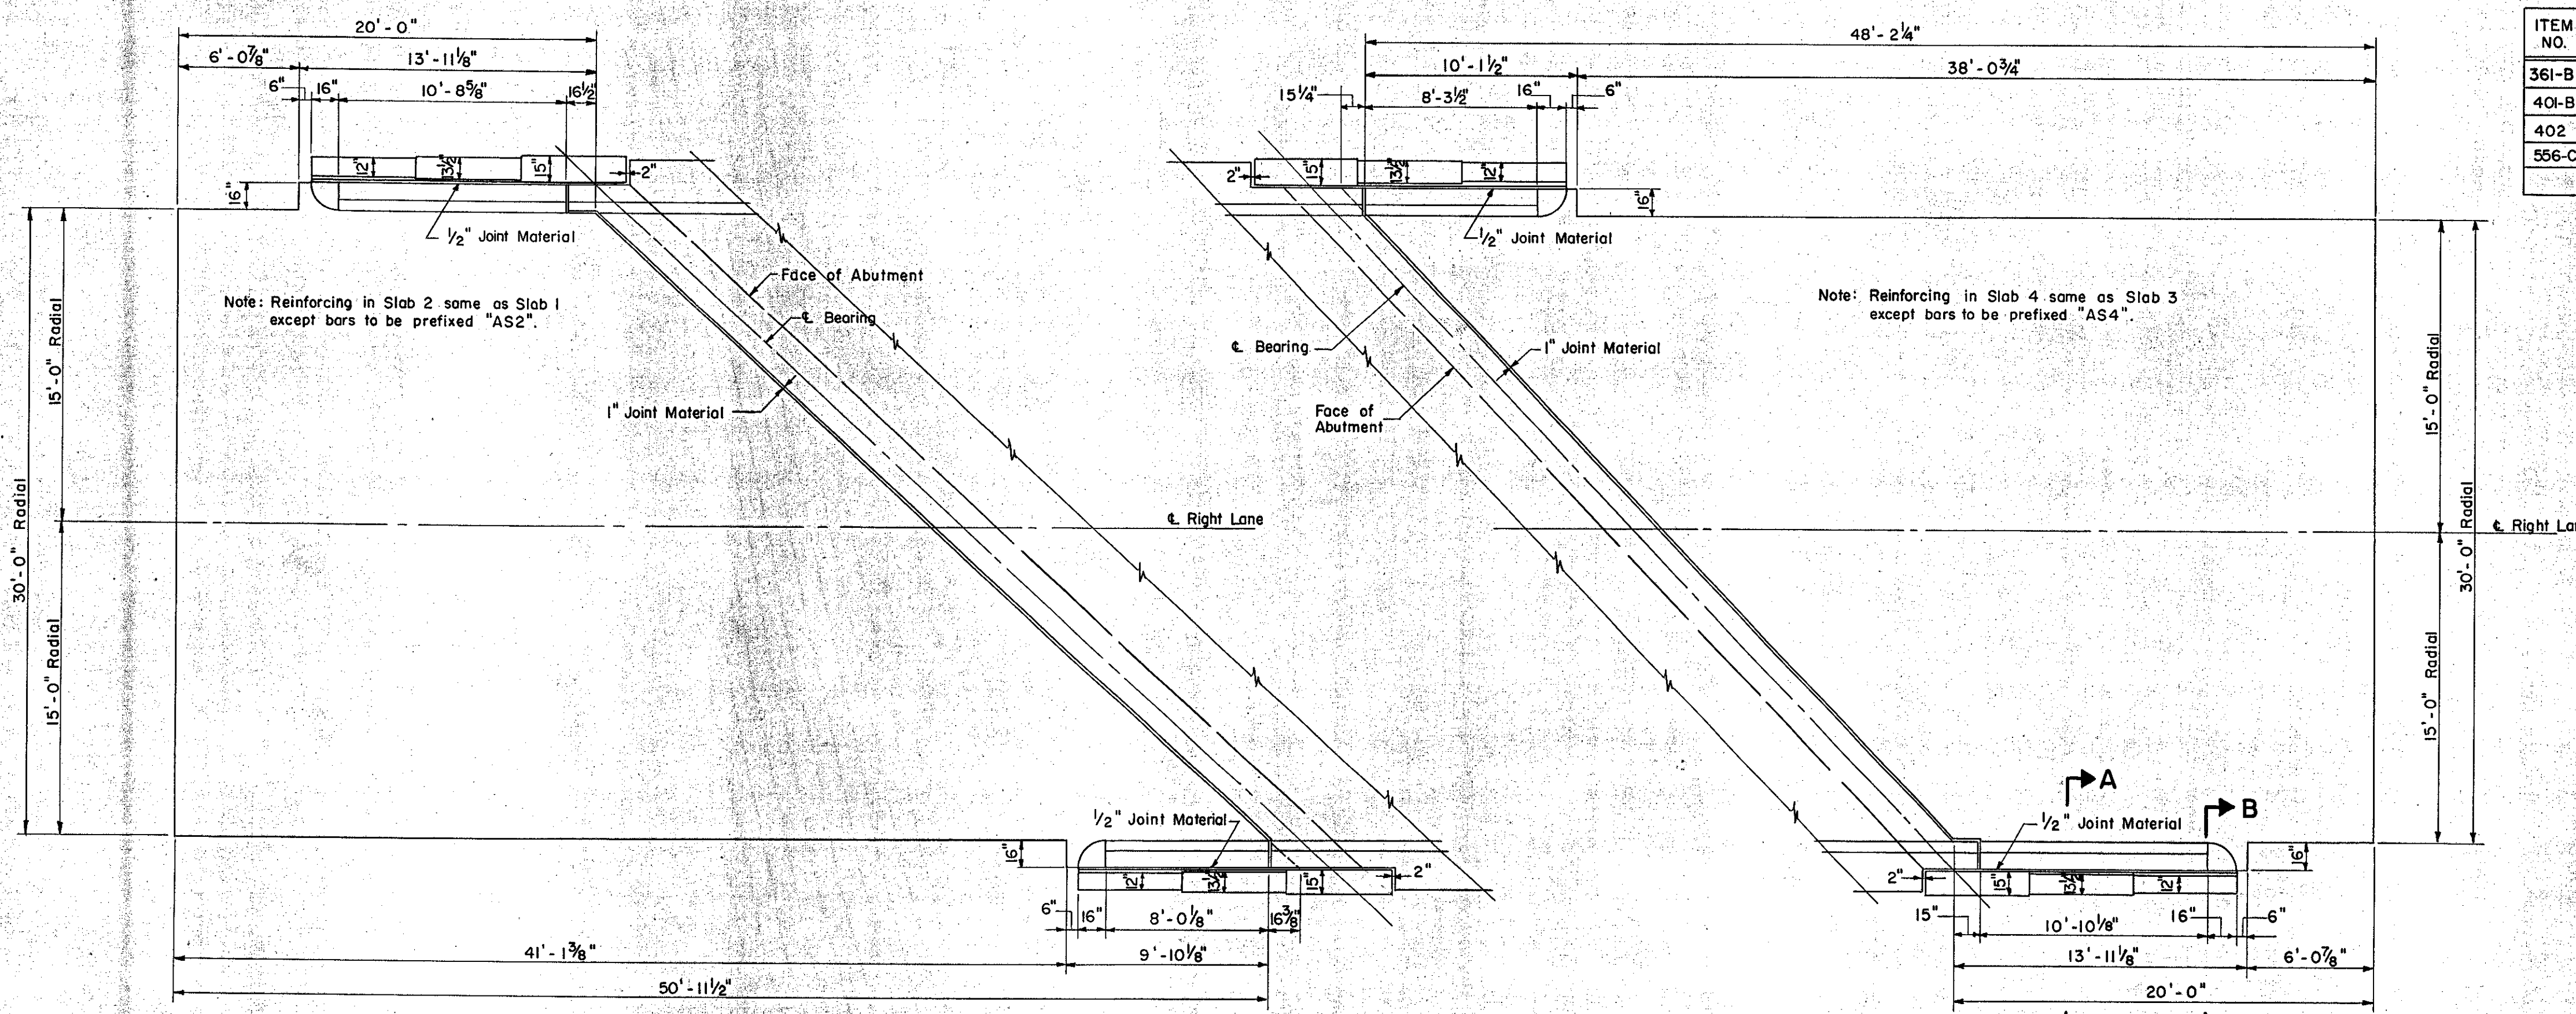

**APPROACH SLAB ABUTMENT NO. 2**  
Scale: 3/16" = 1'-0"


**APPROACH SLAB ABUTMENT NO. 4**  
Scale: 3/16" = 1'-0"

IM 089-2(26)  
This sheet for information only  
**BR 50 N & S**

CONTRACT NO. 2

**APPROACH SLABS**  
STATE OF VERMONT  
DEPARTMENT OF HIGHWAYS  
INTERSTATE PROJECT in the town of  
**WATERBURY**  
INTERSTATE OVER STA. 939+50  
U.S. ROUTE 2 (RELOC.) STA. 20+00  
THE CLARKESON ENGINEERING CO., INC.  
CONSULTING ENGINEERS  
BOSTON MASSACHUSETTS  
SURVEYED BY: S.A.L. CHECKED BY: J.B. & D.S. IN CHARGE: J.V.B. SCALE: AS NOTED DATE: 6-19-58  
PROJECT NO. I-89-2(7) SHEET 254 OF 307

B.P.R. DIV. NO.	STATE	PROJECT NO.	SHEET NO.	TOTAL SHEETS
1	VT.	I-89-2(7)	119	296

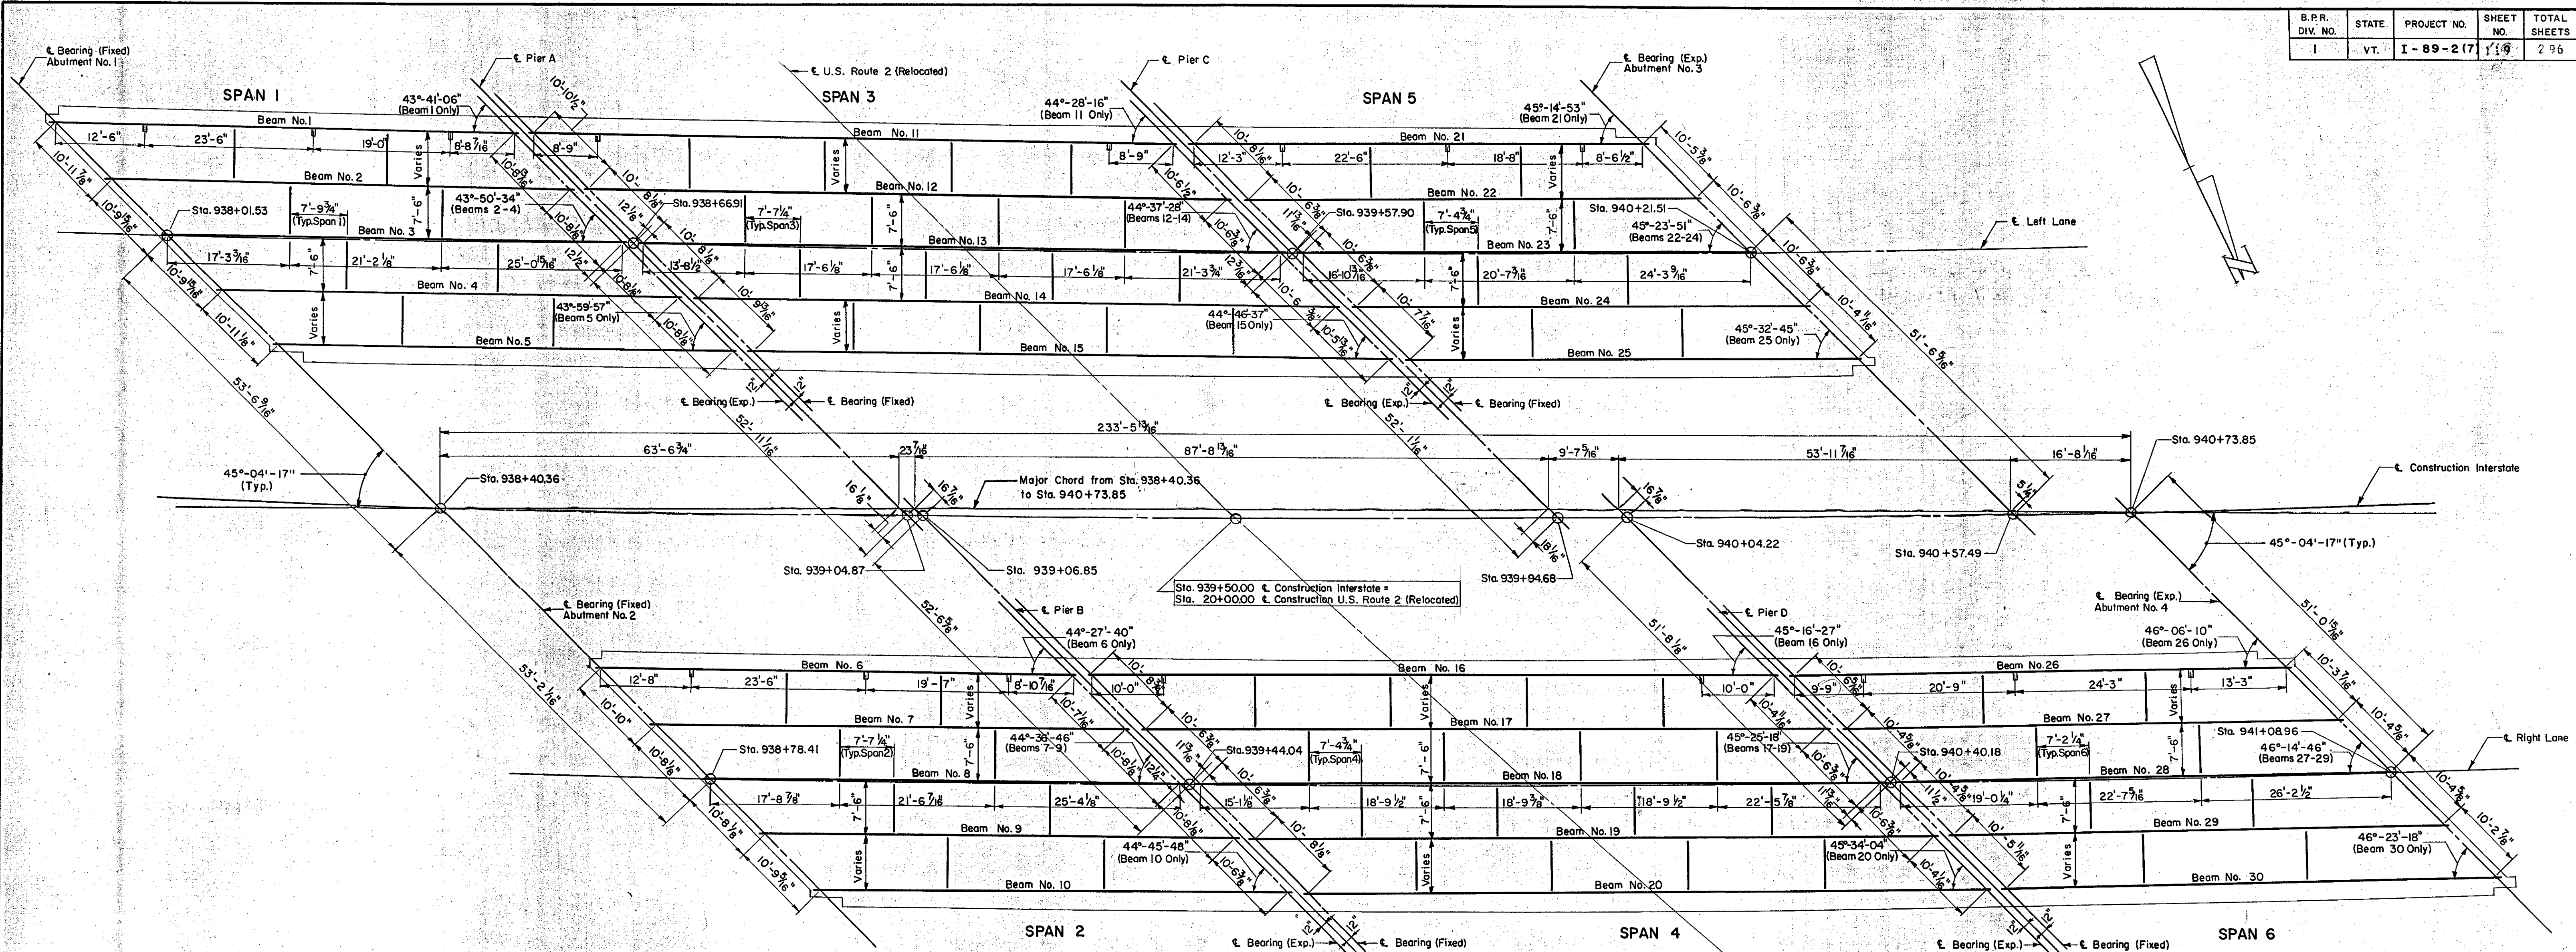

BEAMS AND COVER PLATES

Beam No.	c. to c. Bearings	Size of Beam	Cover Pl. (Bottom)
1	63'-8 7/16"	36 WF 150	10' x 7/8" x 39'-6"
2,3,4	63'-6 1/4"	do	do
5	63'-4 1/8"	do	do
6	64'-9 9/16"	do	do
7,8,9	64'-7 7/16"	do	do
10	64'-5 3/8"	do	do
11	87'-9 7/16"	36 WF 300	14' x 1" x 52'-8"
12,13,14	87'-6 5/8"	do	do
15	87'-3 3/4"	do	do
16	94'-2 1/4"	do	18' x 1" x 59'-8"
17,18,19	93'-11 3/8"	do	do
20	93'-8 9/16"	do	do
21	61'-11 1/2"	36 WF 150	10' x 7/8" x 39'-6"
22,23,24	61'-9 9/16"	do	do
25	61'-7 1/16"	do	do
26	68'-0"	36 WF 160	13' x 7/8" x 46'-3"
27,28,29	67'-10 1/16"	do	do
30	67'-8 1/8"	do	do

PLAN  
Scale 1/32" = 1'-0"


- Note:
- All dimensions are horizontal dimensions.
  - All beams shall be rolled to true circular camber with the middle ordinate as shown on Sheet No. 120.
  - For Steel Details, see Sheet No. 120.
  - Cut flanges at L Bearing as per Standard Sheet No. SB-22-58.
  - All diaphragms shall be 18C 42.7. For details, see Standard Sheet No. SB-20-56.
  - The steel for all beams and cover plates shall conform to A.S.T.M. Designation A 373. All other structural steel shall conform to either A 7 or A 373.

IM 089-2(26)  
This sheet for information only  
**BR 50 N & S**

CONTRACT NO. 2


**STRUCTURAL STEEL PLAN**  
STATE OF VERMONT  
DEPARTMENT OF HIGHWAYS  
INTERSTATE PROJECT in the town of  
**WATERBURY**  
INTERSTATE OVER STA. 939+50  
U.S. ROUTE 2 (RELOC) STA. 20+00  
THE CLARKESON ENGINEERING CO., INC.  
CONSULTING ENGINEERS  
BOSTON MASSACHUSETTS  
SURVEYED BY: S.A.L. CHECKED BY: J.B. & D.S. SCALE: AS NOTED  
DRAWN BY: S.A.L. IN CHARGE: J.V.B. DATE: 5-19-58  
PROJECT NO. I-89-2(7) SHEET 255 OF 307

B.P.R. DIV. NO.	STATE	PROJECT NO.	SHEET NO.	TOTAL SHEETS
1	VT.	I-89-2(7)	120	296

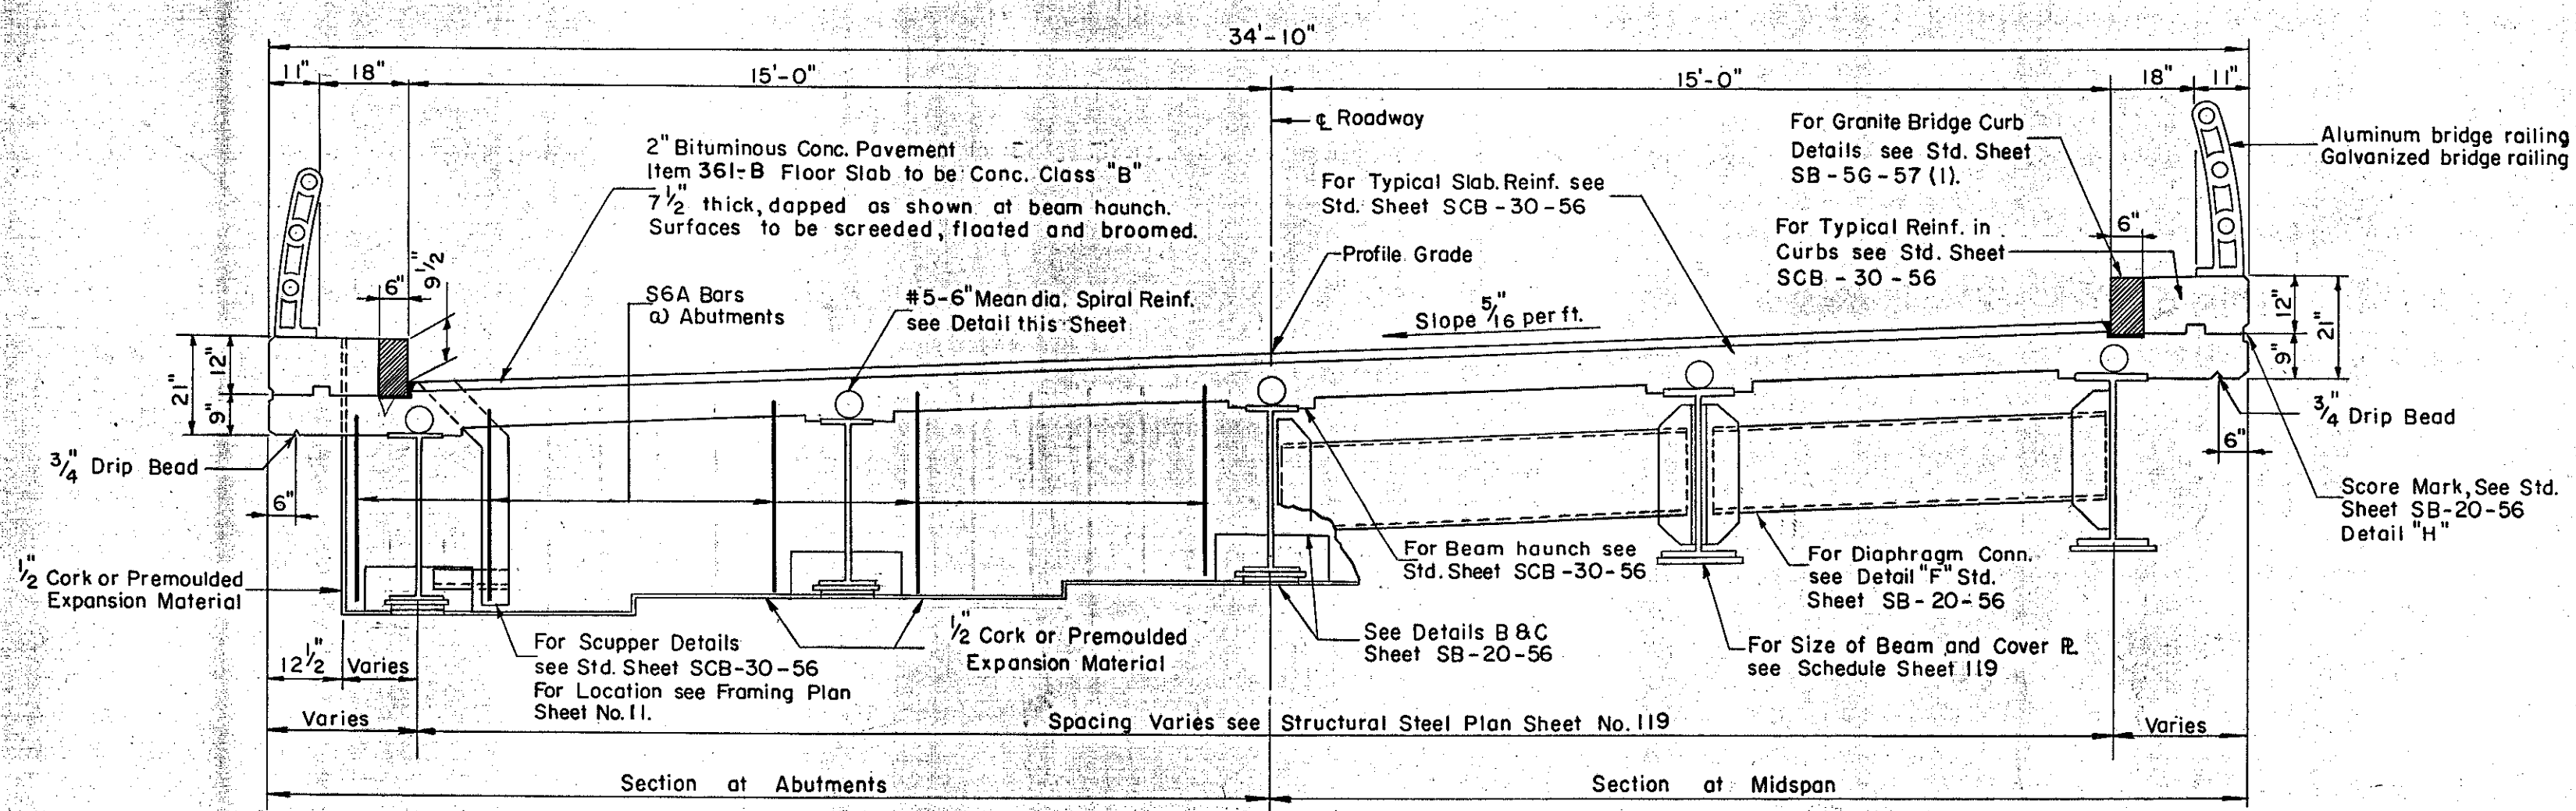


**TYPICAL CROSS SECTION**  
Scale: 3/8" = 1'-0"


BEAM SCHEDULE				SPIRAL SCHEDULE					
BEAM NO.	A	B	C	D	LENGTH OF SPAN	64'	69'	94'	99'
1	9"	14 3/8"	63' - 8 7/16"	65' - 7 13/16"	SPIRAL PITCH: 0'-10' FROM BRNG.	DOUBLE @ 5"	DOUBLE @ 5"	DOUBLE @ 6 1/2"	DOUBLE @ 5 1/2"
2,3,4	do	9"	63' - 6 1/4"	65' - 0 1/4"	" " 10'-20' OR 6' SPAN	DOUBLE @ 6 1/2"	DOUBLE @ 6 1/2"	DOUBLE @ 6 1/2"	DOUBLE @ 6 1/2"
5	do	14 1/4"	63' - 4 1/8"	65' - 3 3/8"	" " 20'-30' OR 6' SPAN	5"	4 1/2"	4 1/2"	4 1/2"
6	do	14 1/8"	64' - 9 7/16"	66' - 8 1/16"	" " 30'-40' OR 6' SPAN	7 1/2"	7"	5 1/2"	5 1/2"
7,8,9	do	9"	64' - 7 1/16"	66' - 1 7/16"	" " 40'-6' SPAN			7"	7"
10	do	14"	64' - 5 3/8"	66' - 4 3/8"					
11	14 1/8"	14 1/8"	87' - 9 7/16"	90' - 1 7/16"					
12,13,14	9"	9"	87' - 6 3/8"	89' - 0 5/8"					
15	14"	14"	87' - 3 3/4"	89' - 7 3/4"					
16	13 7/8"	13 7/8"	94' - 2 1/4"	96' - 6"					
17,18,19	9"	9"	93' - 11 3/8"	95' - 5 3/8"					
20	13 3/16"	13 3/16"	93' - 8 9/16"	96' - 0 3/16"					
21	13 7/8"	9"	61' - 11 1/2"	63' - 10 3/8"					
22,23,24	9"	do	61' - 9 9/16"	63' - 3 3/16"					
25	13 3/16"	do	61' - 7 1/16"	63' - 6 1/2"					
26	13 5/8"	do	68' - 0"	69' - 10 5/8"					
27,28,29	9"	do	67' - 10 1/16"	69' - 4 1/16"					
30	13 9/16"	do	67' - 8 1/16"	69' - 6 1/16"					

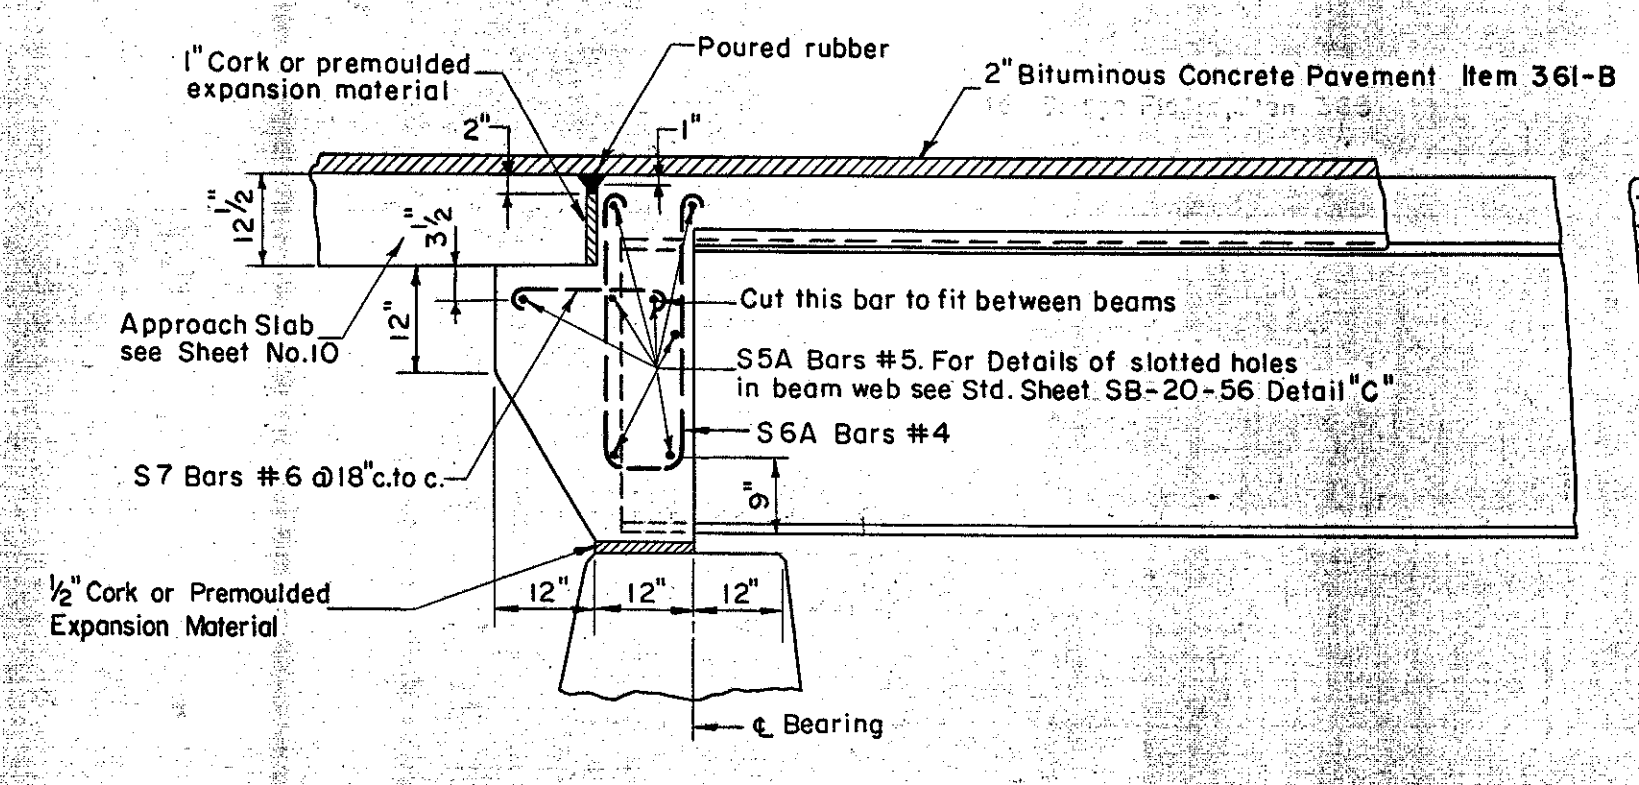


**ELEVATION AT ABUTMENTS**

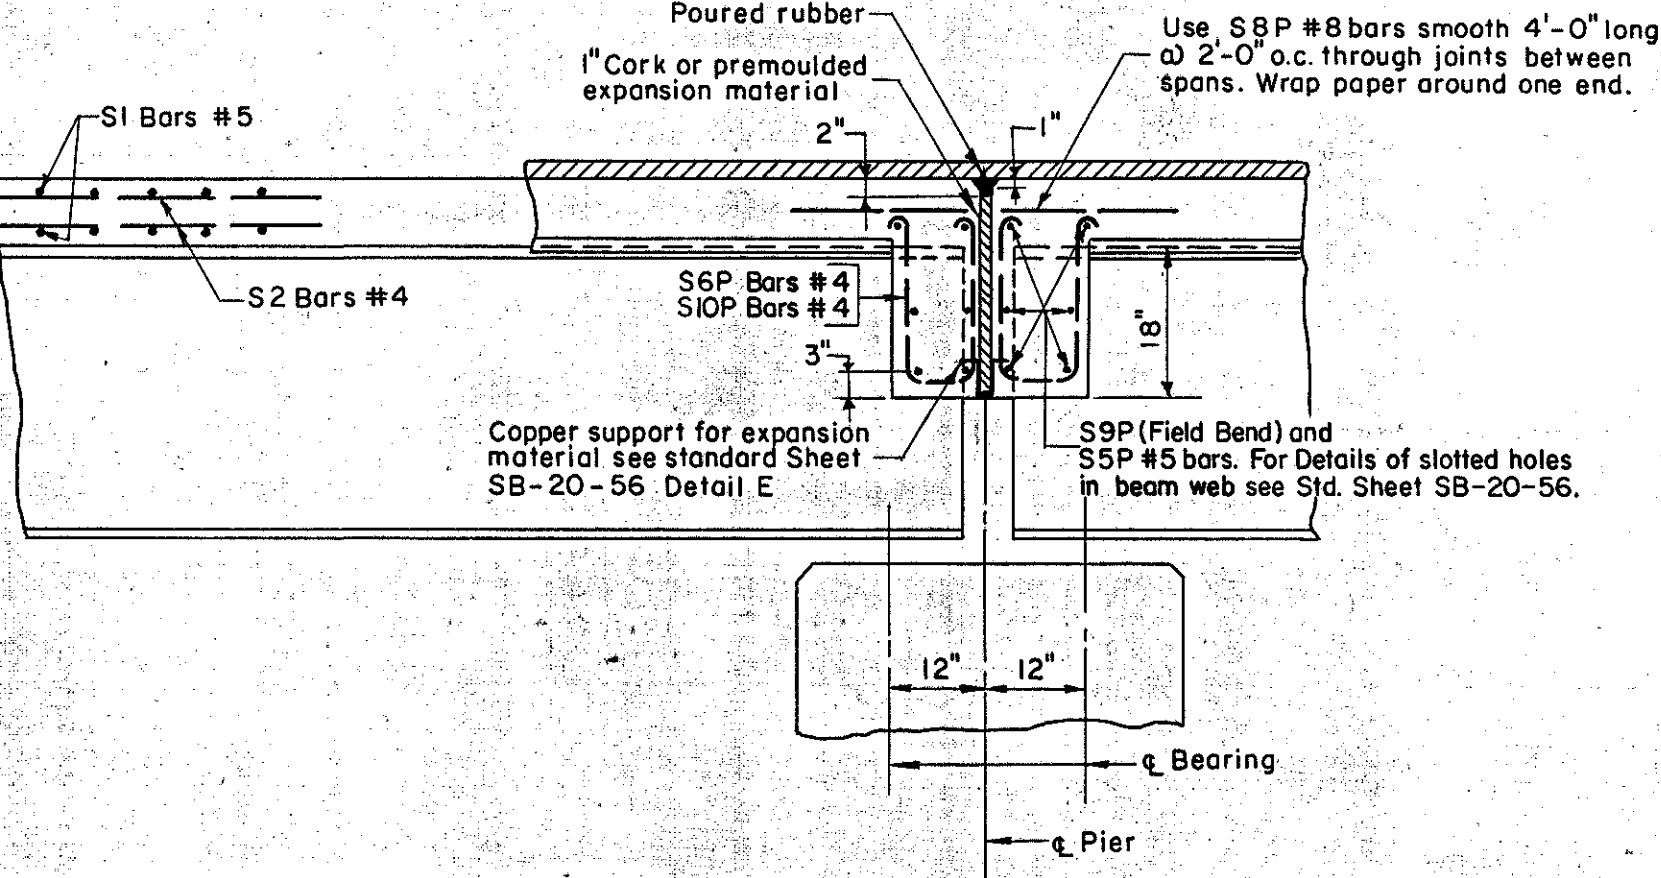

**TYPICAL ELEVATION OF BEAM (SQUARE)**

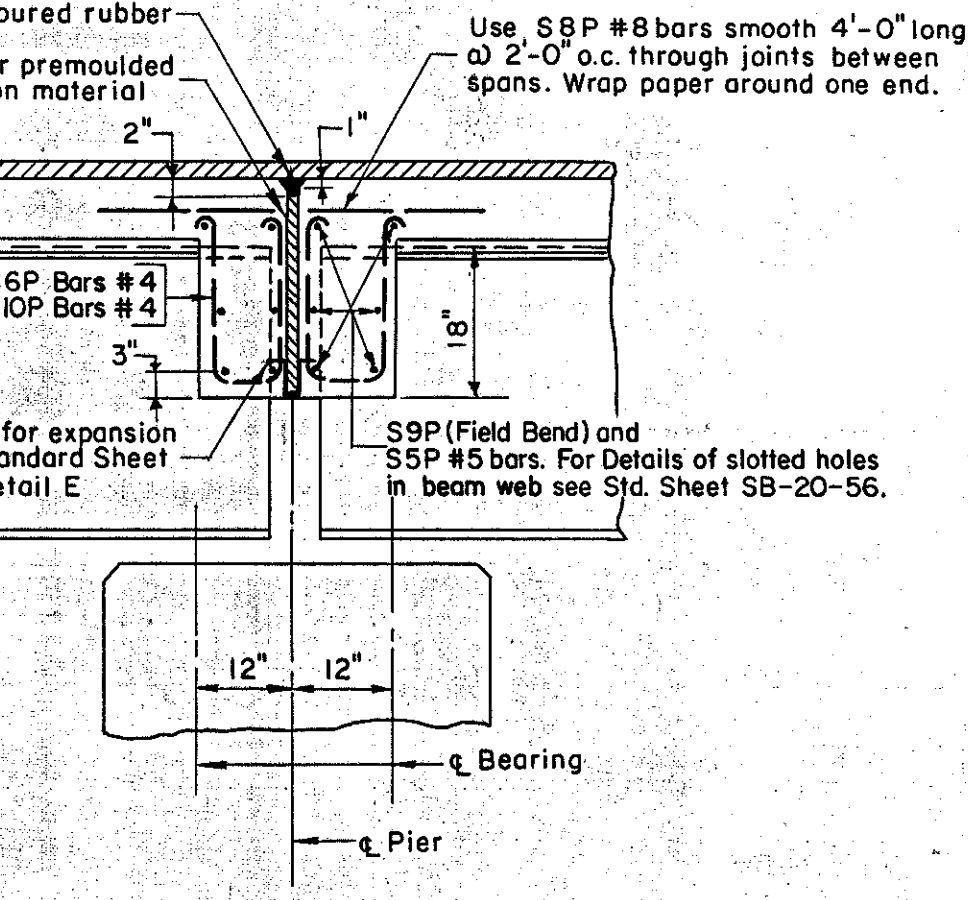


**ELEVATION AT PIERS**

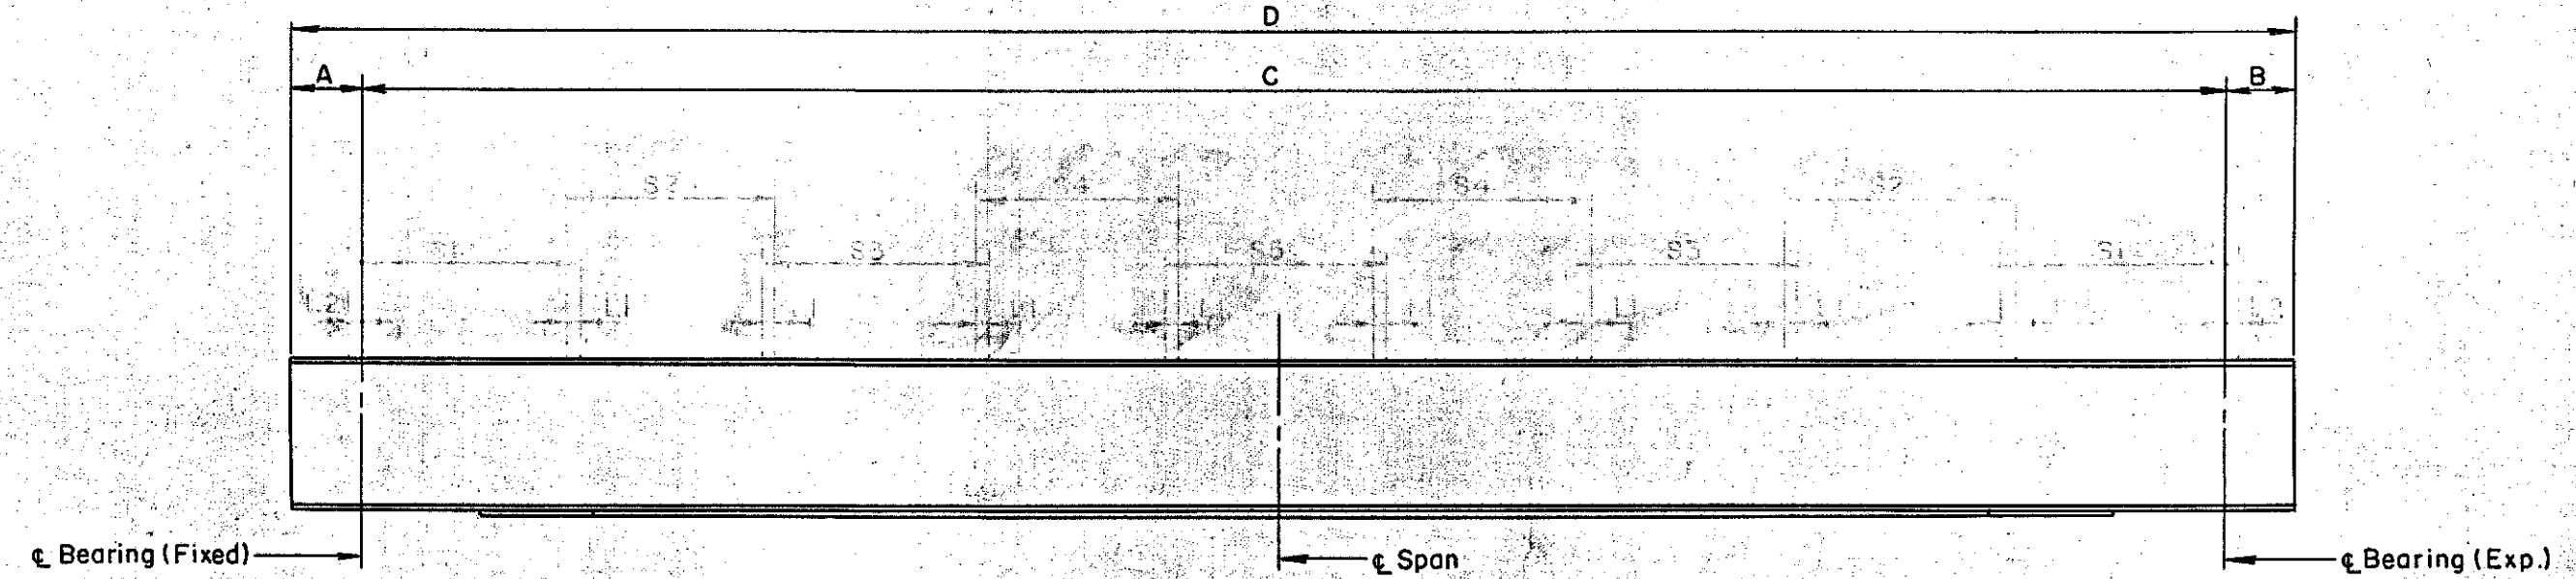


**ELEVATION OF BEAMS**  
No Scale

Notes: 1. For Beam Size and Cover R. Size see Framing Plan Sheet No.119  
2. For Cover R. Details see Std. Sheet SCB-30-56 (I).  
3. Cut Flanges @ & Bearings as per Std. Sheet SB-22-58.

NOTE: WHERE A DOUBLE SPIRAL IS CALLED FOR IN THE SCHEDULE  
(4) FOUR 6 1/2" LONG STUDS ARE REQUIRED PER PITCH.

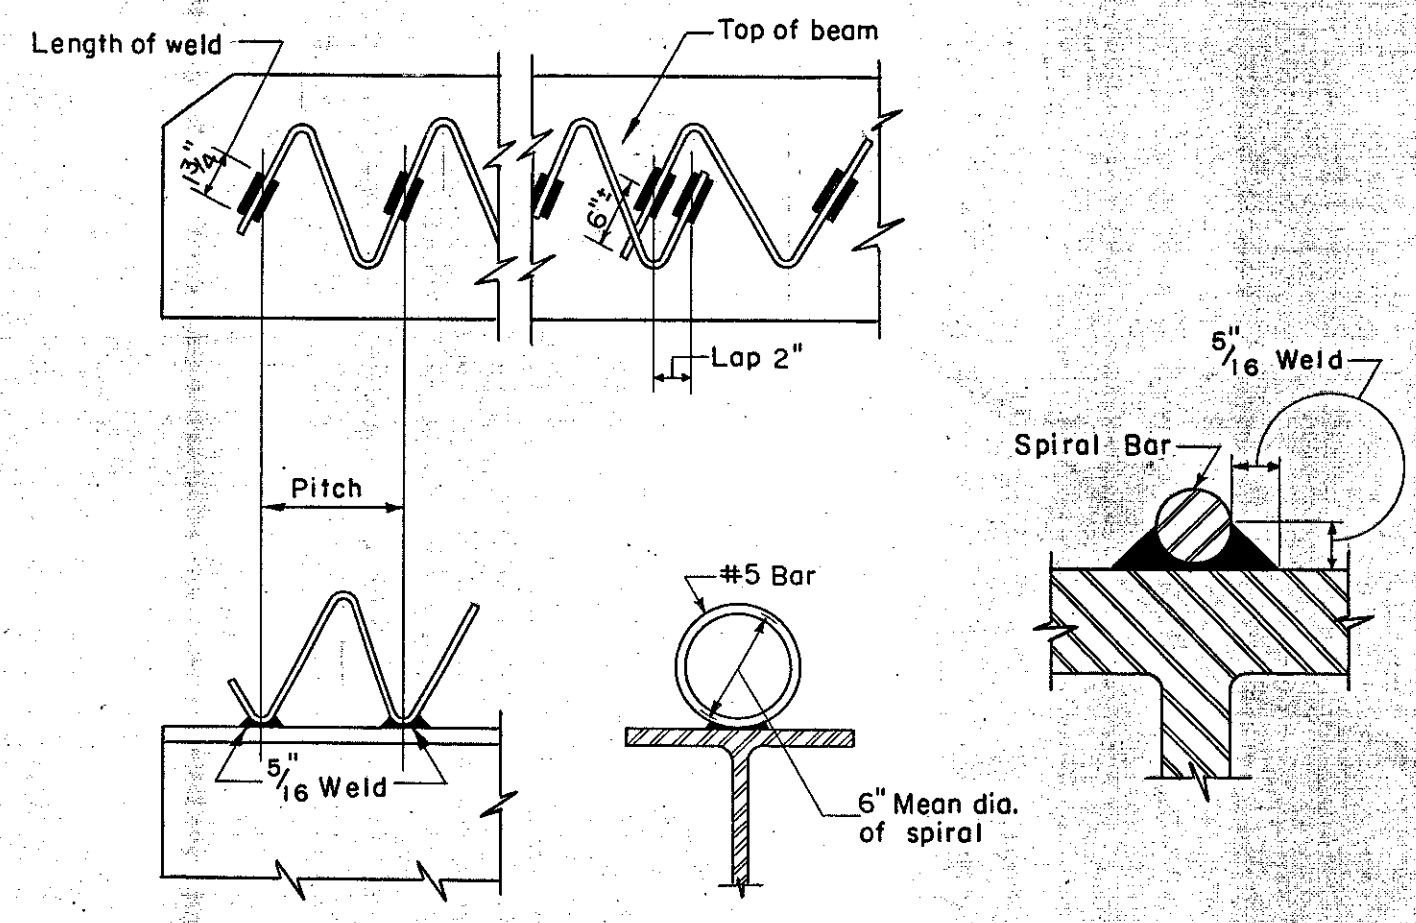


**SPIRAL WELDING DETAILS**  
No Scale

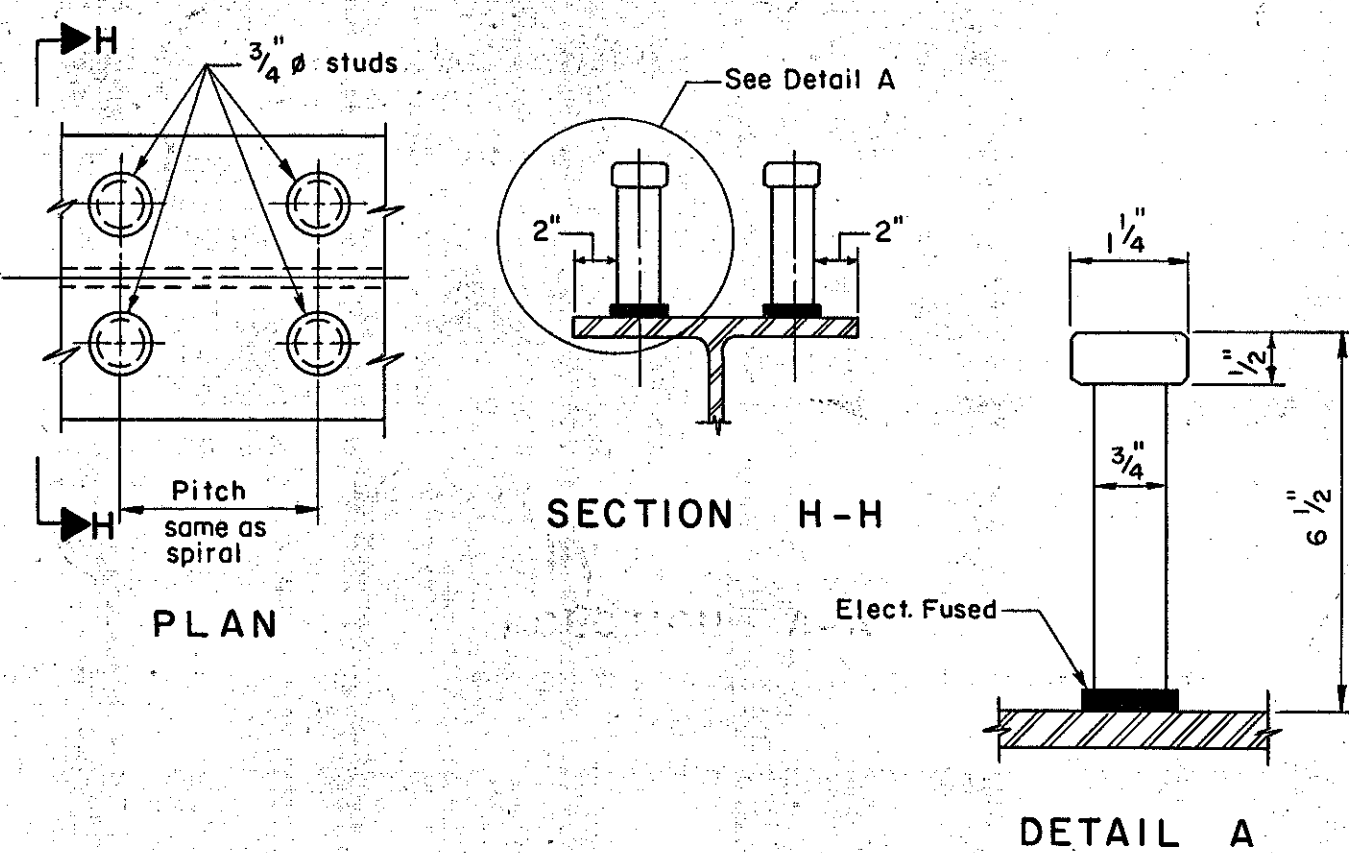

**ALTERNATE SHEAR CONNECTOR**  
No Scale

Beam	L	d
1-10	64'-0" ±	2 1/4"
11-15	87'-6" ±	4"
16-20	94'-0" ±	4 3/8"
21-25	61'-9" ±	2"
26-30	67'-10" ±	2 1/2"

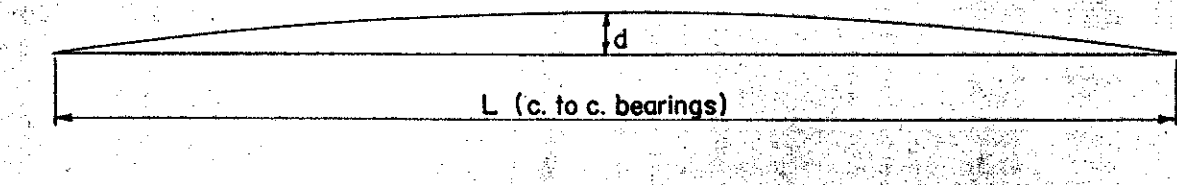

**CAMBER DIAGRAM**  
No Scale

ITEM NO.	DESCRIPTION	UNIT	SUPERSTRUCTURE		
			NET	OVER-RUN	TOTAL
361-B	Bit. Conc. Pavement	TONS	175	-86	200
401-B	Concrete Class B (Mod.)	C.Y.	460	-25	511
402	Reinforcing Steel	Lbs.	See Reinforcing Schedule Sht. 121		
403-d	Spiral Reinforcement (15,300 LB.)	L.S.	1	-	1
404-A	Structural Steel	Lbs.	571,844	44,436	563,280
					575,518

**ESTIMATED QUANTITIES**

IM 089-2(26)  
This sheet for information only  
**BR 50 N & S**  
CONTRACT NO. 2

**STRUCTURAL DETAILS**  
**STATE OF VERMONT**  
**DEPARTMENT OF HIGHWAYS**

INTERSTATE PROJECT in the town of  
**WATERBURY**

INTERSTATE OVER STA. 939 + 50  
U.S. ROUTE 2 (RELOC.) OVER STA. 20 + 00

THE CLARKESON ENGINEERING CO., INC.  
CONSULTING ENGINEERS

BOSTON MASSACHUSETTS  
SURVEYED BY V.C.S. CHECKED BY J.B.D.S. SCALE AS NOTED  
DRAWN BY J.V.B. IN CHARGE J.V.B. DATE 6-19-56

PROJECT NO. I-89-2(1) SHEET 256 OF 307





