


JOB NO.		DRAWING NO.		REV.				
JOB NO.		108						
ABM INFO	SHIP	BILL OF MATERIAL						
PAGE LINE	MARK	QTY	MARK	MATERIAL				
LENGTH	REMARKS	WT	PROCUREMENT NOTES					
FT	INCHES							
	S3B	1		STRINGER		8882		
101	A	1	wa	W 33x201	43 3/16	(M270-50HT2) (H2-3)		
102	M	2	x11ah	PL 1/2x5	2 7/8			
102	L	2	x11lp	PL 7/8x7 3/4	2 7/8			
102	M	1	x11ak	PL 1/2x5	2 7/8			

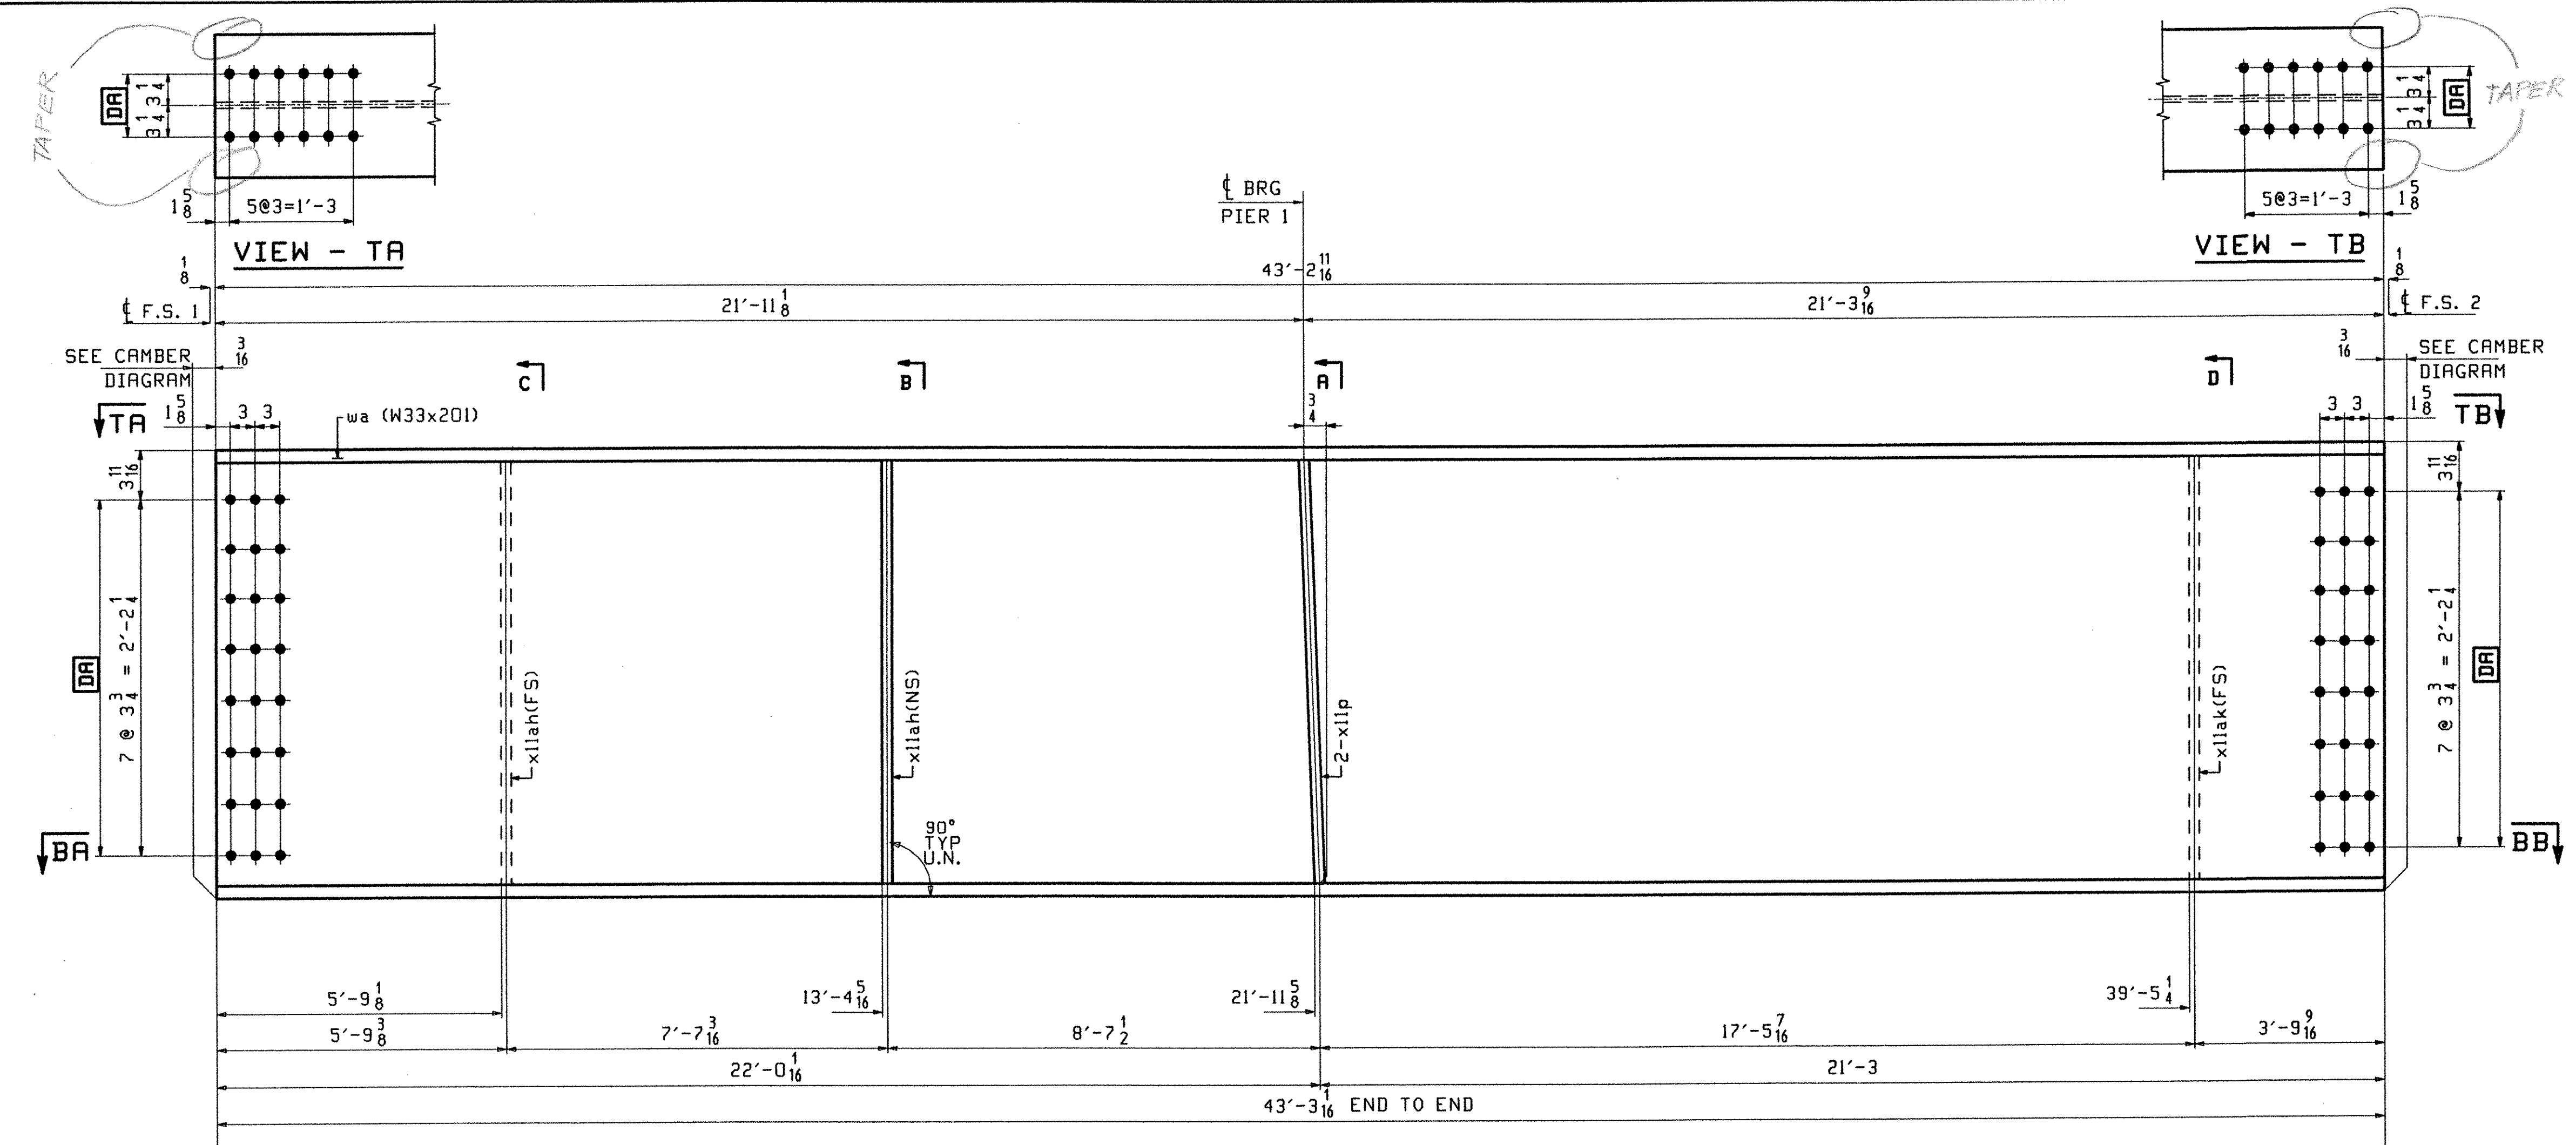

ONE - STRINGER - S3B

1. FOR STRINGER STANDARD DETAILS SEE DRAWING XII.
2. FOR CAMBER AND FLANGE DIAGRAMS SEE DRAWING C101.
3. FOR GENERAL NOTES SEE DRAWING GNI.

TVGA
Engineering, Surveying, P.C.

NO EXCEPTIONS TAKEN REJECTED
 FURNISH AS CORRECTED
 REVISE AND RESUBMIT

ENGINEER has reviewed Shop Drawings and Samples and other data which contractor is required to submit, give for conformance with the information given in the Contract Documents and compliance with the design intent of the completed Project as a functioning whole as indicated in the Contract Documents. Such review does not extend to means, methods, techniques, sequences or procedures of construction or to safety precautions and programs involving them. Contractor is responsible for dimensions to be confirmed and compliance of the job site for installation and placement of the fabrication processes or to technology of construction and for coordination of the work of all trades.

BY: R. W. S-T
DATE: 3/20/01

SEE TAPER DETAIL DRG. NO. 106

OUT FOR APPROVAL	2.2.01								
ISSUED TO SHOP									
FIELD & OFFICE									

REV.	REMARKS	DATE	DWN	CHK	APP	O.A.	NO.	DIA.	LGT	TYPE	WASHER
	MATERIAL: M270 GR 50W										
	ELECTRODES:										
	HOLES:										
	SHOP BOLTS:										

SURFACE PREP. & PAINT:
 -STEEL WITHIN 10'-0" OF ABUT 1 SHALL BE PAINTED (SEE GNI)
 -ALL OTHER STEEL SHALL BE BLAST CLEANED AND LEFT UNPAINTED.

DESCRIPTION:	STRINGER - S3B	DRAWN BY	PHG	DATE	01/23
JOB:	BRIDGE NO. 435	CHKD BY	TRM	DATE	01/27
	I-89 SB OVER U.S. ROUTE 2	APPROV BY	H. J. GATTI		
	I-89 IMPROVEMENTS	SUPERVISOR			
	TOWN OF MIDDLESEX-BOLTON, VERMONT				
PROJ NO.	1M-089-2(26)				

CUSTOMER:	VERMONT AGENCY OF TRANSPORTATION	JOB NO.	116-435	DRG. NO.	108
	CASCO BAY STEEL STRUCTURES, INC.				
	75 SPRING HILL ROAD	SACO, MAINE 04072			
	PHONE (207) 282-7360	FAX (207) 282-1179			