


FRAMING PLAN

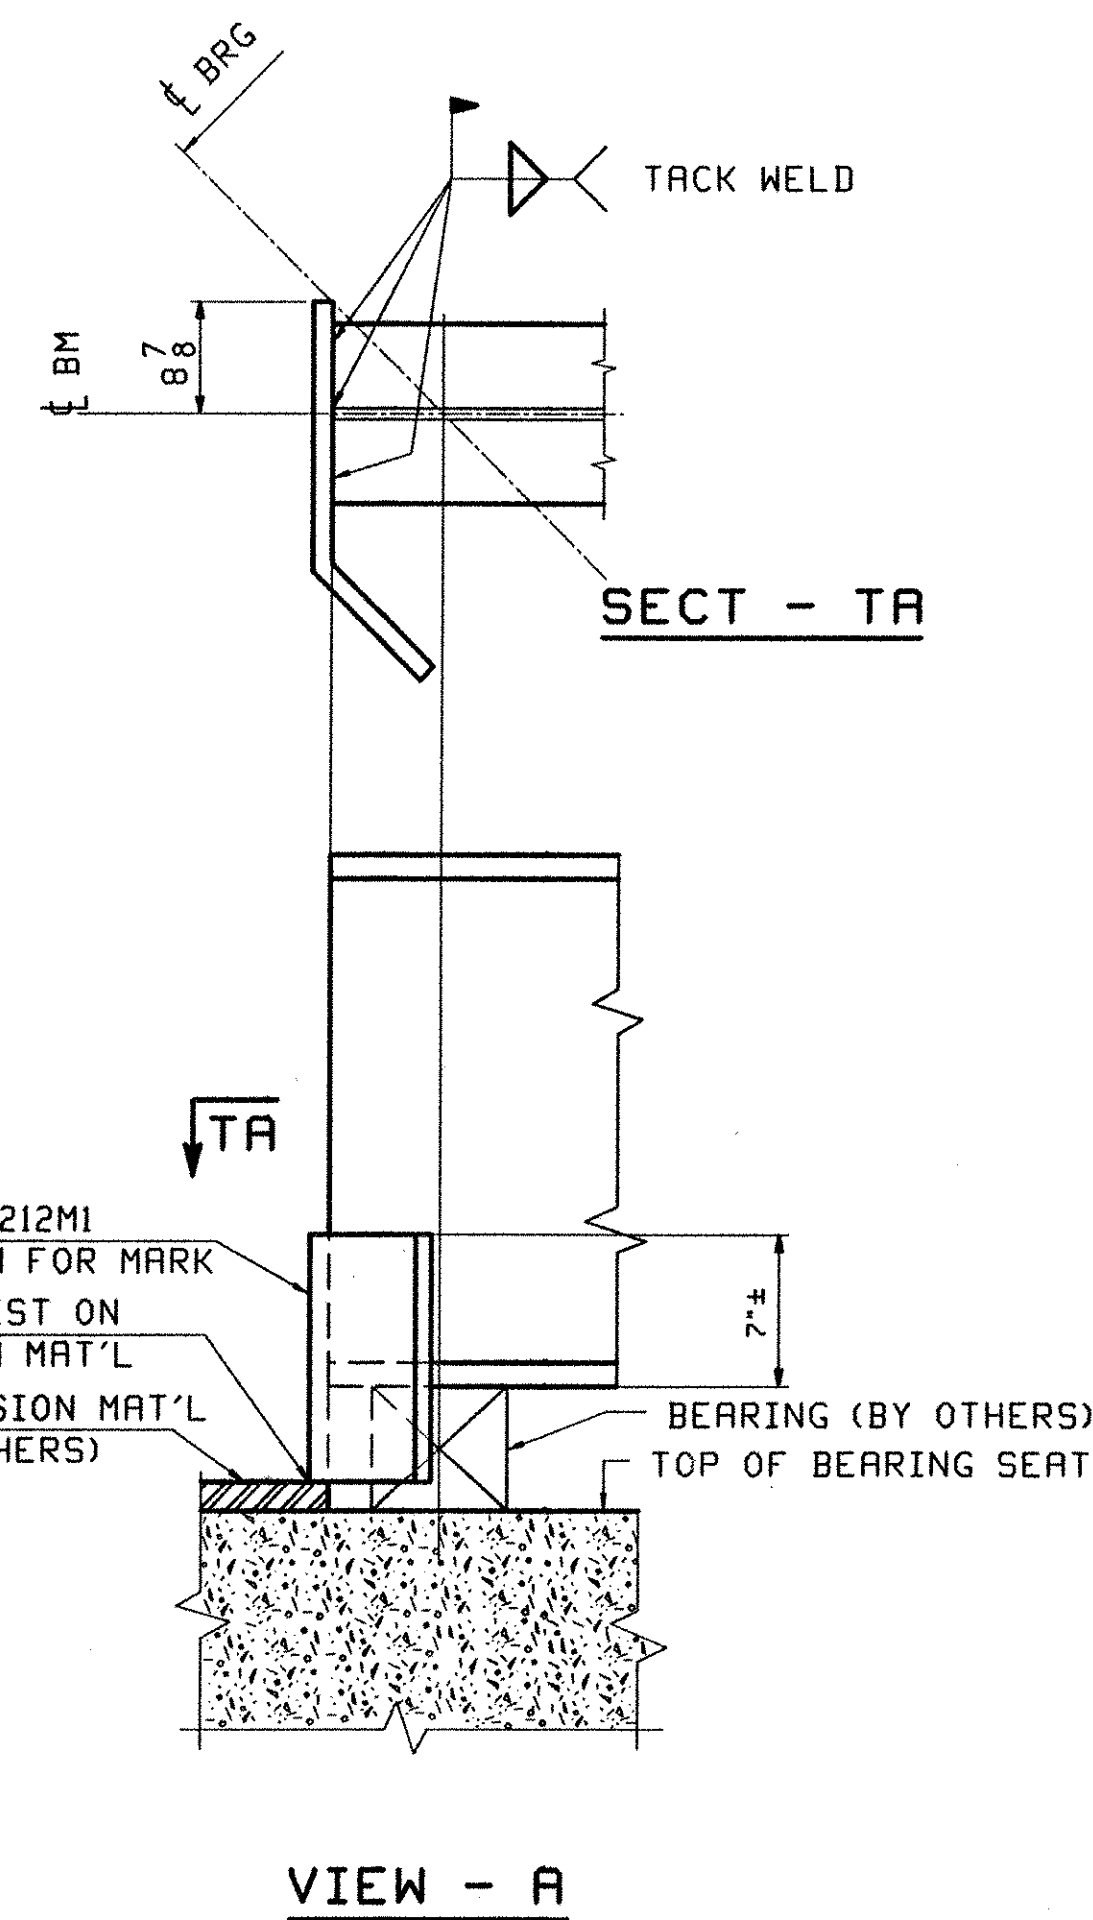

TVGA
Engineering, Surveying, P.C.

NO EXCEPTIONS TAKEN REJECTED
 FURNISH AS CORRECTED REVISE AND RESUBMIT

ENGINEER has reviewed Shop Drawings and Samples and other data which Contractor is required to submit, solely for conformance with the information given in the Contract Documents and compliance with the design concept of the Contract Documents. With review of shop drawings to means, methods, techniques, sequences or procedures of construction or to safety precautions and programs to be followed, Contractor is responsible for providing to the Engineer, and for obtaining the necessary approvals for construction, and for certification of the work of all trades.

BY: LLA
DATE: 11-06-2001

OUT FOR APPROVAL	3-5-01																		
OUT FOR APPROVAL																			
ISSUED TO SHOP																			
FIELD & OFFICE																			
REV.	REMARKS	DATE	DWN	CHK	APP	Q.A.	NO.	DIA.	LGT	TYPE	WASHER								
MATERIAL:	M270 GR 50W	ELECTRODES:		HOLES:	15/16 Ø (UN)	SHOP BOLTS:	7/8 Ø (UN)												
SURFACE PREP. & PAINT: -STEEL WITHIN 10'-0 OF ABUT 2 SHALL BE PAINTED (SEE GND) -ALL OTHER STEEL SHALL BE BLAST CLEANED AND LEFT UNPAINTED.																			
DESCRIPTION: FRAMING PLAN												DRAWN BY	DATE						
JOB: BRIDGE NO. 43N												PHG	02/16						
I-89 SB OVER U.S. ROUTE 2												CHKD BY							
I-89 IMPROVEMENTS												TRM	02/21						
TOWN OF MIDDLESEX-BOLTON, VERMONT												APPROV BY							
TENSON 2105-N												SUPERVISOR	W. J. GATTI						
PROJ NO. IM-089-2(26)												Q.A.							
CUSTOMER: VERMONT AGENCY OF TRANSPORTATION																			
CASCO BAY STEEL STRUCTURES, INC.												JOB NO.	DRG. NO.						
75 SPRING HILL ROAD												117-43N	E201						
PHONE (207) 282-7360												FAX.	(207) 282-1179						
												REV.	△						

PHG Tue Feb 27 09:45:07 EST 2001 c:\msd\jms\2105-N\CED1 - Rev0