




D.O.R.
10 ~ x21a

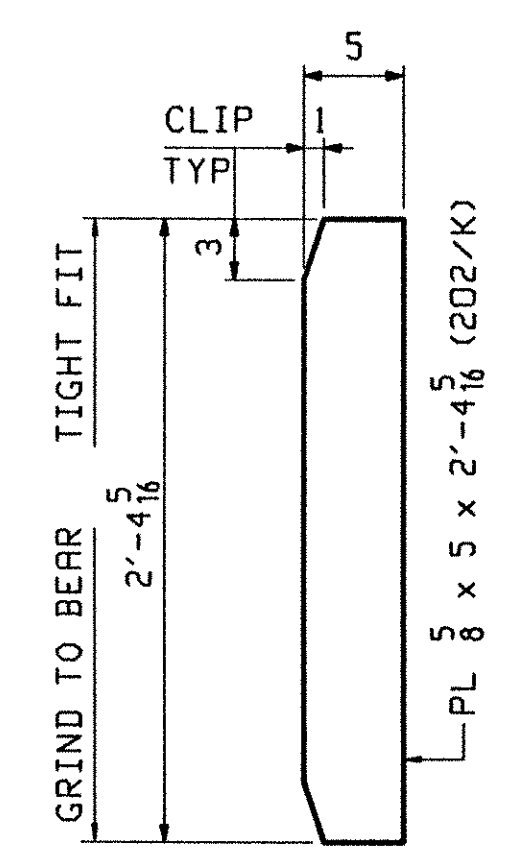


10 ~ x21g
BRG STIFF

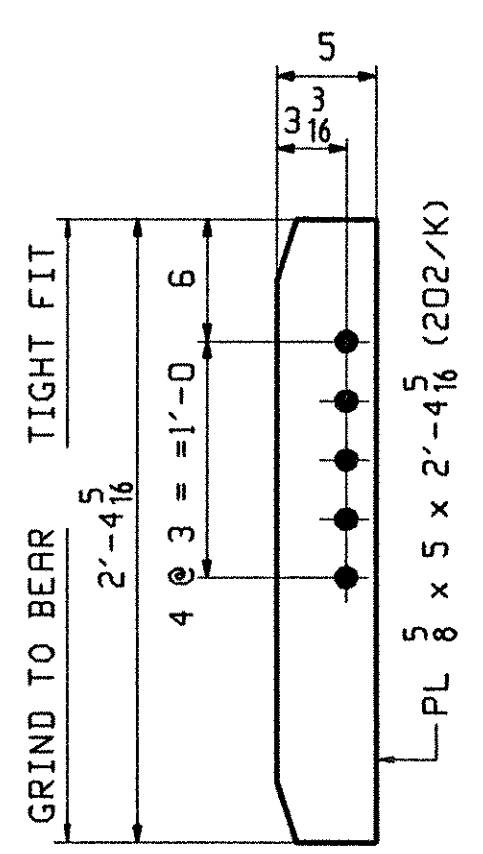


4 ~ x21h
BRG STIFF @ ABUT

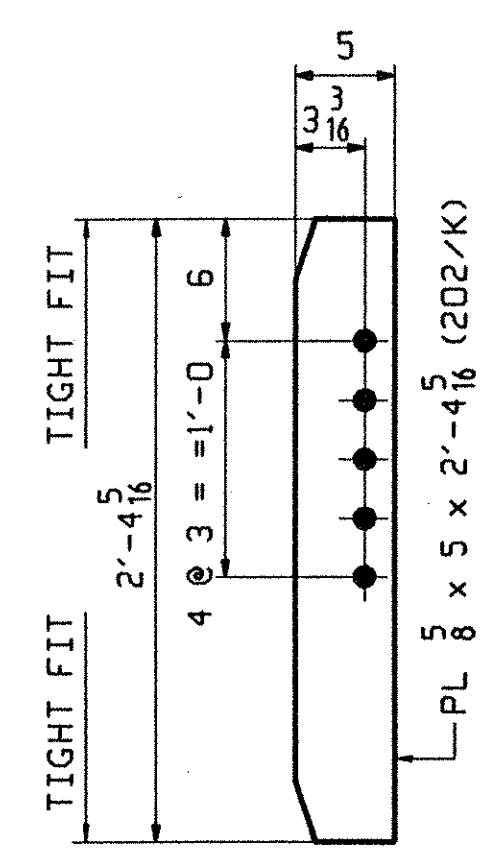

4 ~ x21k
ABUT CONN STIFF

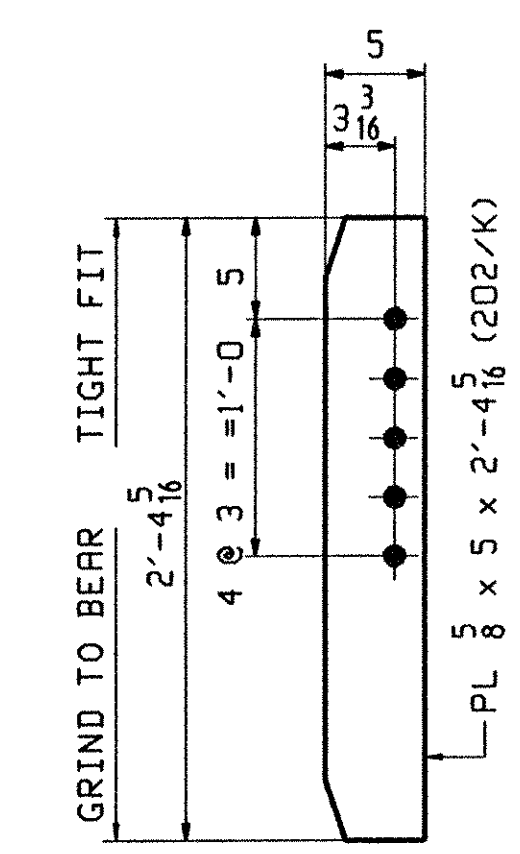


16 ~ x21m
BRG STIFF @ PIER 1&2

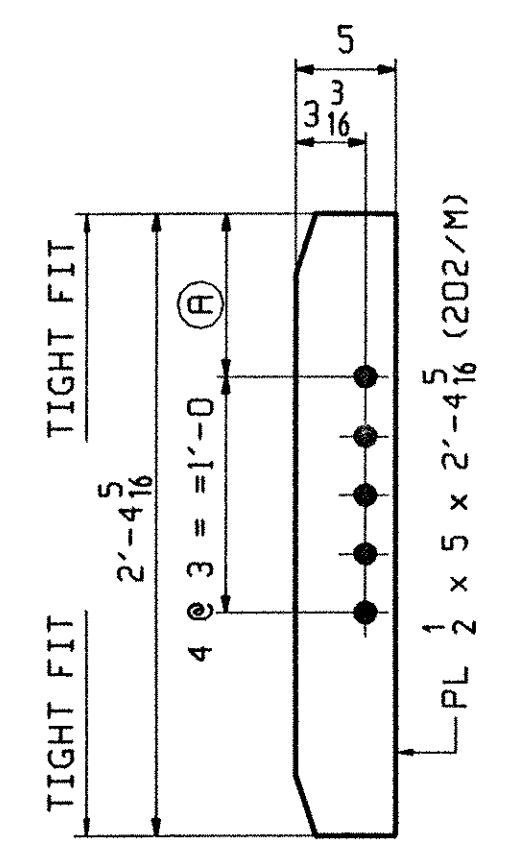


INT CONN STIFF


MARK	REQ'D	(A)
x21n	32	7
x21p	4	8 3/8
x21s	14	8 3/4
x21t	10	9 1/16
x21v	4	9 3/8

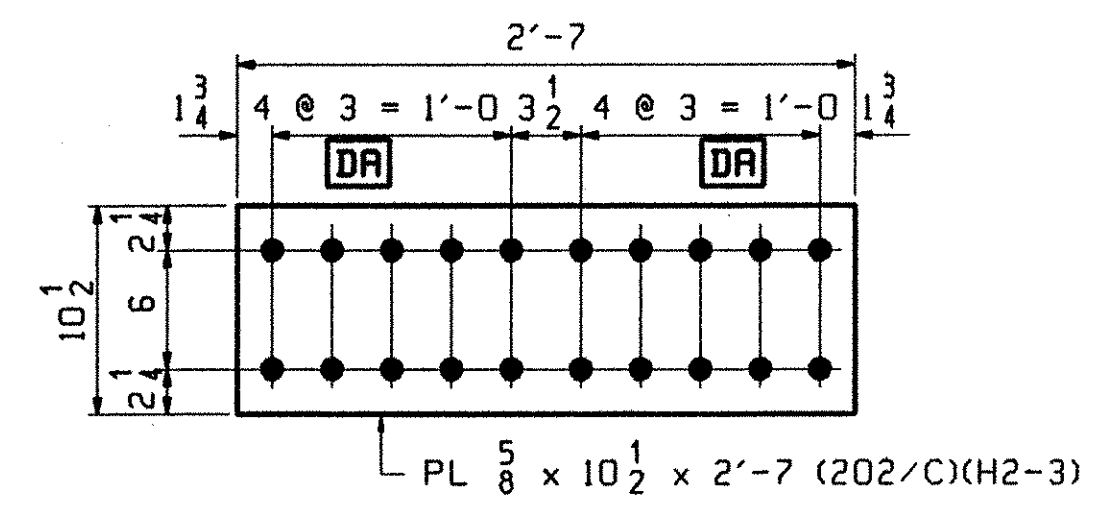


D.O.R.
10 ~ x21b

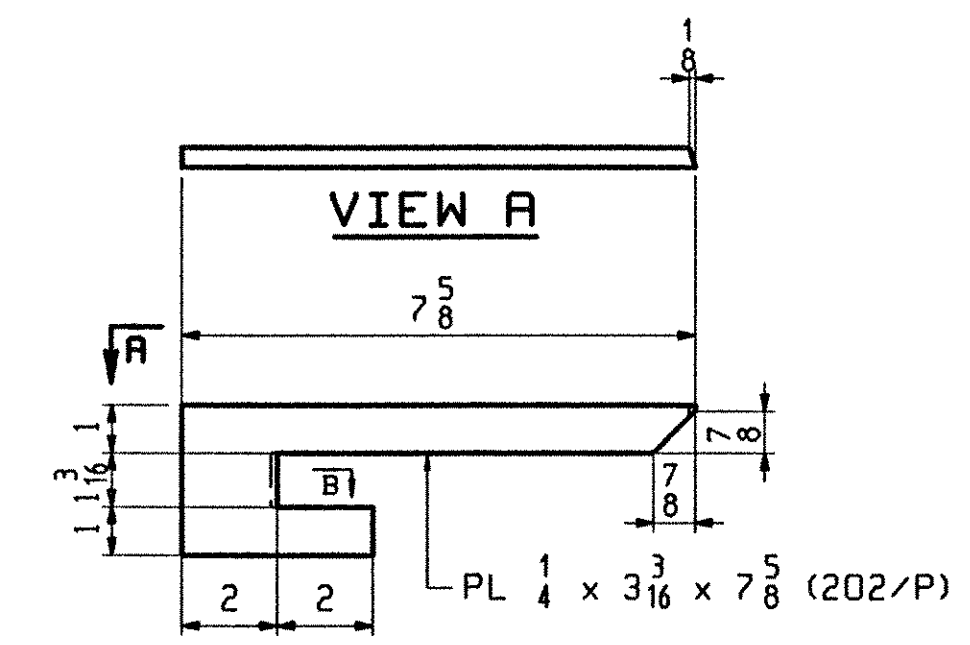

1 ~ x21w
DRIP PL

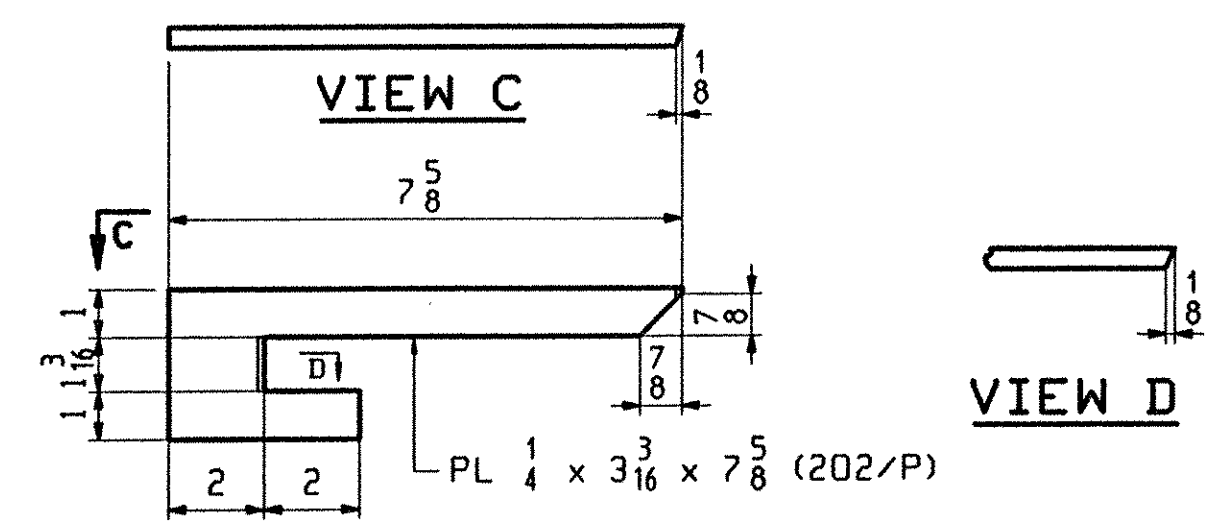


1 ~ x21y
DRIP PL

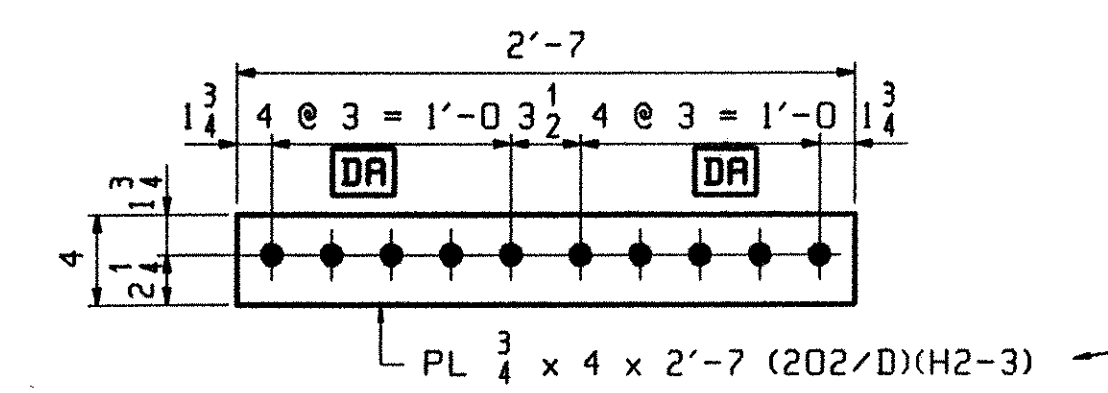


D.O.R.
20 ~ x21c


ENGR VERIFY WIDTH OF PL REDUCED TO CLEAR "K" OF W30 THICKNESS INCREASED TO 4" TO MAINTAIN NET SECTION

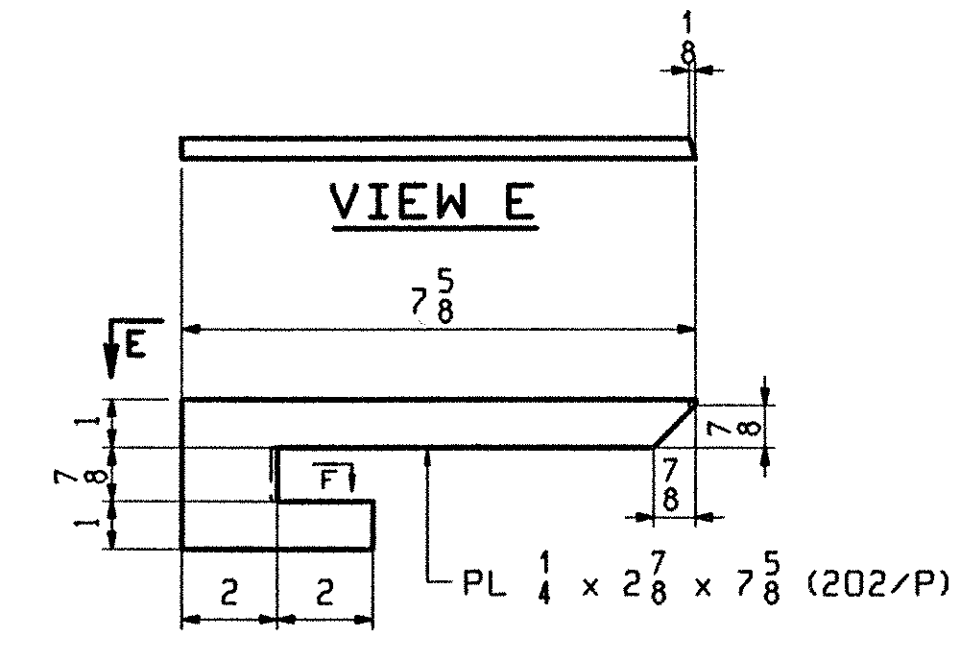

2 ~ x21aa
DRIP PL

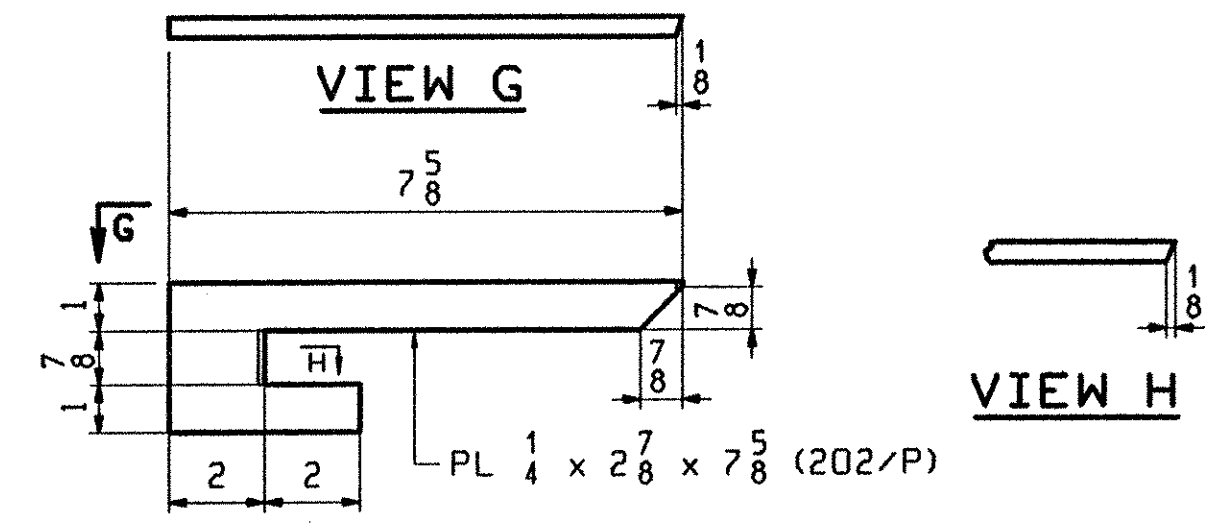

2 ~ x21ab
DRIP PL

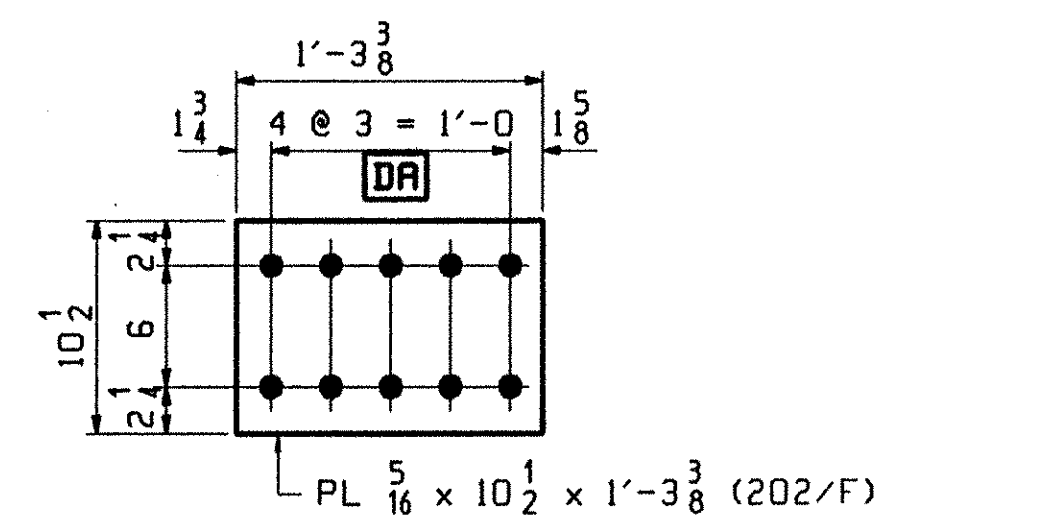

10 ~ x21d

TVGA
Engineering, Surveying, P.C.
 NO EXCEPTIONS TAKEN REJECTED
 FURNISH AS CORRECTED
 REVISE AND RESUBMIT
ENGINEER has reviewed Shop Drawings and Samples and for conformance with the information given in the Contract Documents and compatibility with the design concept of the completed Project as a foretelling whole as indicated in the Contract Documents. Such reviews do not extend to means, methods, techniques, sequences or procedures of construction or to safety precautions and programs incident thereto. Contractor is responsible for information that pertains solely to the fabrication processes or to techniques of construction; and for coordination of the work of all trades.

BY: LLG
DATE: 11-06-2001

NOTES:
FOR GENERAL NOTES SEE GNI
H2-3 DENOTES MATERIAL SUBJECT TO CHARPY V-NOTCH TESTING.
D.O.R. DENOTES DIRECTION OF MILL ROLLING

OUT FOR APPROVAL	5501																		
OUT FOR APPROVAL																			
ISSUED TO SHOP																			
FIELD & OFFICE																			

REV.	REMARKS	DATE	DWN	CHK	APP	Q.A.	NO.	DIA.	LGT	TYPE	WASHER
MATERIAL:	M270 GR 50W	ELECTRODES:									
		HOLES:									
		SHOP BOLTS:									

SURFACE PREP. & PAINT:
-STEEL WITHIN 10'-0 OF ABUT 2 SHALL BE PAINTED (SEE GNI)
-ALL OTHER STEEL SHALL BE BLAST CLEANED AND LEFT UNPAINTED.

DESCRIPTION: STRINGER STANDARDS		DRAWN BY	DATE
JOB:	BRIDGE NO. 43N	PHG	02/09
	1-89 SB OVER U.S. ROUTE 2	CHKD BY	
	1-89 IMPROVEMENTS	TRM	02/21
	TOWN OF MIDDLESEX-BOLTON, VERMONT	APPROV BY	
		SUPERVISOR	H. J. GATTI
PROJ NO.	1M-089-2(26)	Q.A.	
CUSTOMER: VERMONT AGENCY OF TRANSPORTATION			
CASCO BAY STEEL STRUCTURES, INC.		JOB NO.	DRG. NO.
75 SPRING HILL ROAD		117-43N	X21
PHONE (207) 282-7360		FAX. (207) 282-1179	
		REV.	△