
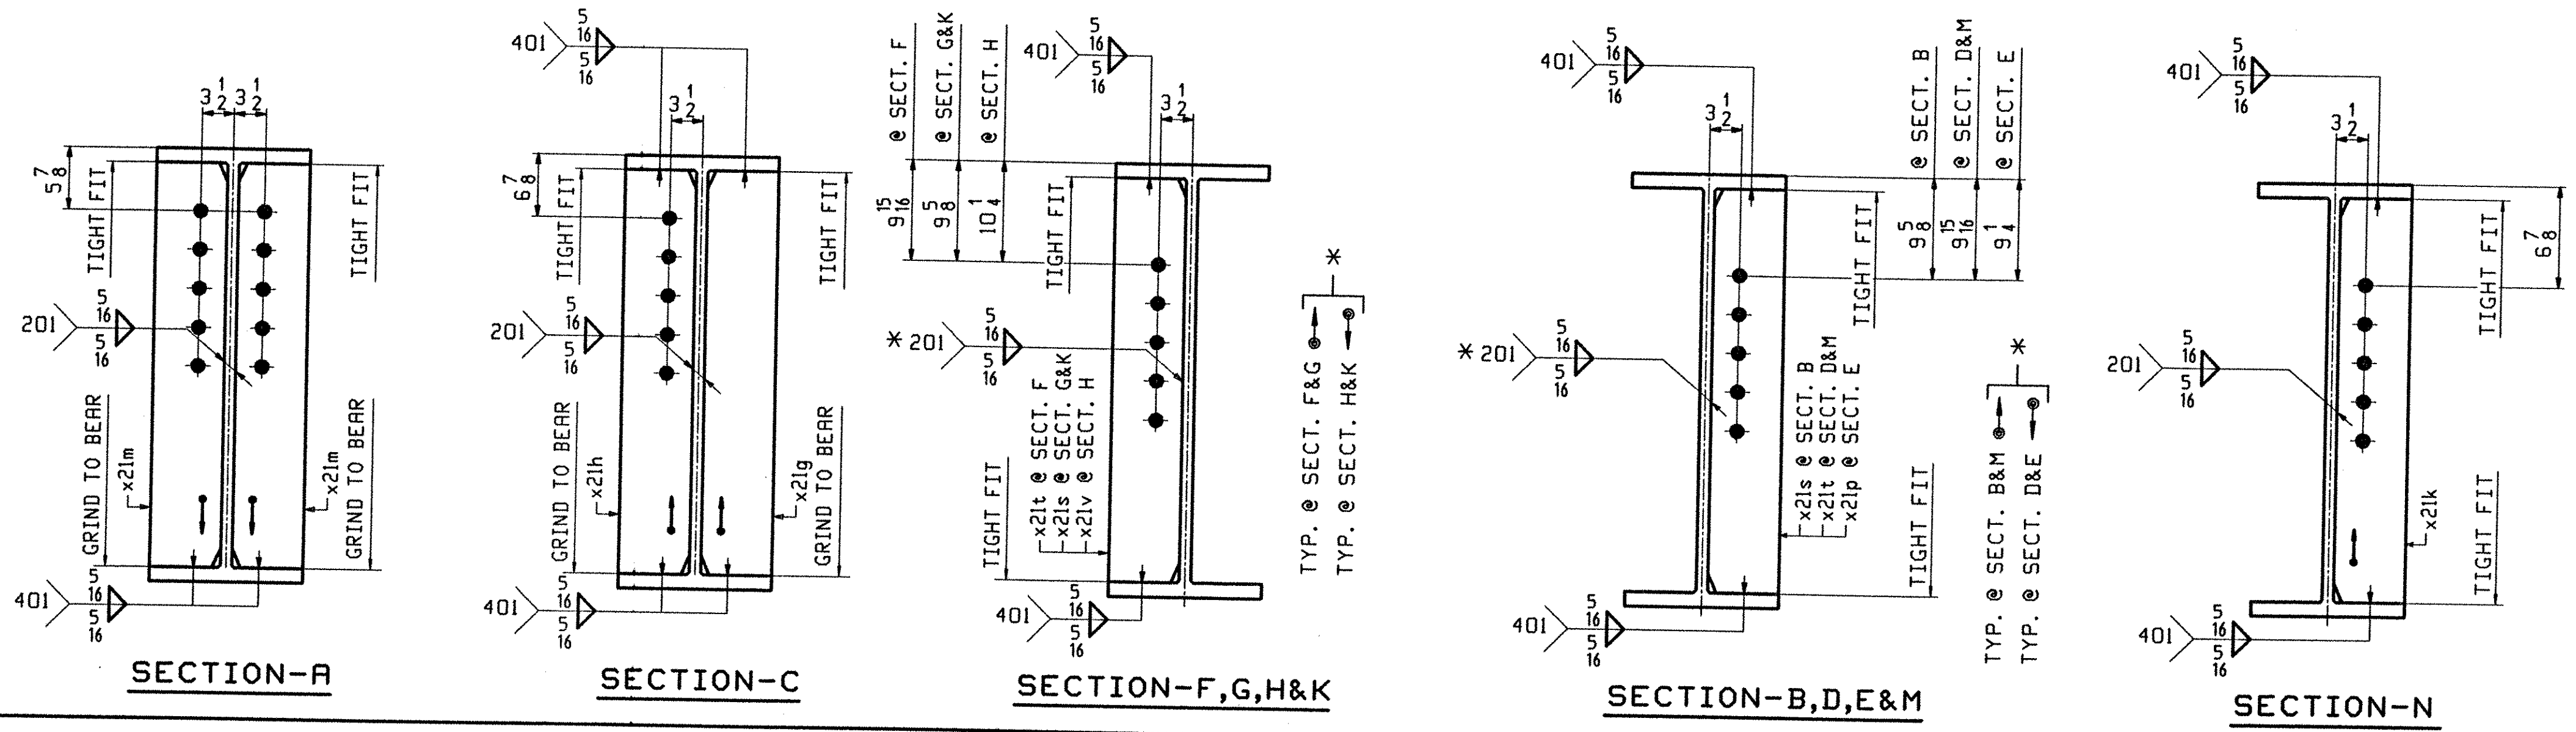


**ONE - STRINGER - S3B**

- FOR STRINGER STANDARD DETAILS SEE DRAWING X21.
- FOR CAMBER AND FLANGE DIAGRAMS SEE DRAWING C202.
- FOR GENERAL NOTES SEE DRAWING GNI.

JOB NO.		DRAWING NO.		REV.					
208		208		208					
PAGE	LINE	MARK	QTY	MARK	MATERIAL	LENGTH	REMARKS	WT	PROCUREMENT
						FT			NOTES
		S3B	1		STRINGER				12968
201	C		1	wa	W 30x116	105	9 3/8		(M270-50HT2) (H2-3)
202	B		2	x21a	PL 1/2 x 26 1/4	1	7		(M270-50HT2) (H2-3)
202	C		2	x21b	PL 5/8 x 10 1/2	2	7		(M270-50HT2) (H2-3)
202	D		4	x21c	PL 3/4 x 4	2	7		(M270-50HT2) (H2-3)
202	F		2	x21d	PL 5/16 x 10 1/2	1	3 3/8		FILL
202	M		3	x21t	PL 1/2 x 5	2	5 1/16		
202	M		4	x21s	PL 1/2 x 5	2	4 5/16		
202	K		2	x21m	PL 5/8 x 5	2	4 1/16		
202	M		1	x21p	PL 1/2 x 5	2	4 1/16		
202	M		1	x21v	PL 1/2 x 5	2	4 1/16		
202	K		1	x21h	PL 5/8 x 5	2	4 1/16		
202	K		1	x21g	PL 5/8 x 5	2	4 1/16		
202	K		1	x21k	PL 5/8 x 5	2	4 1/16		

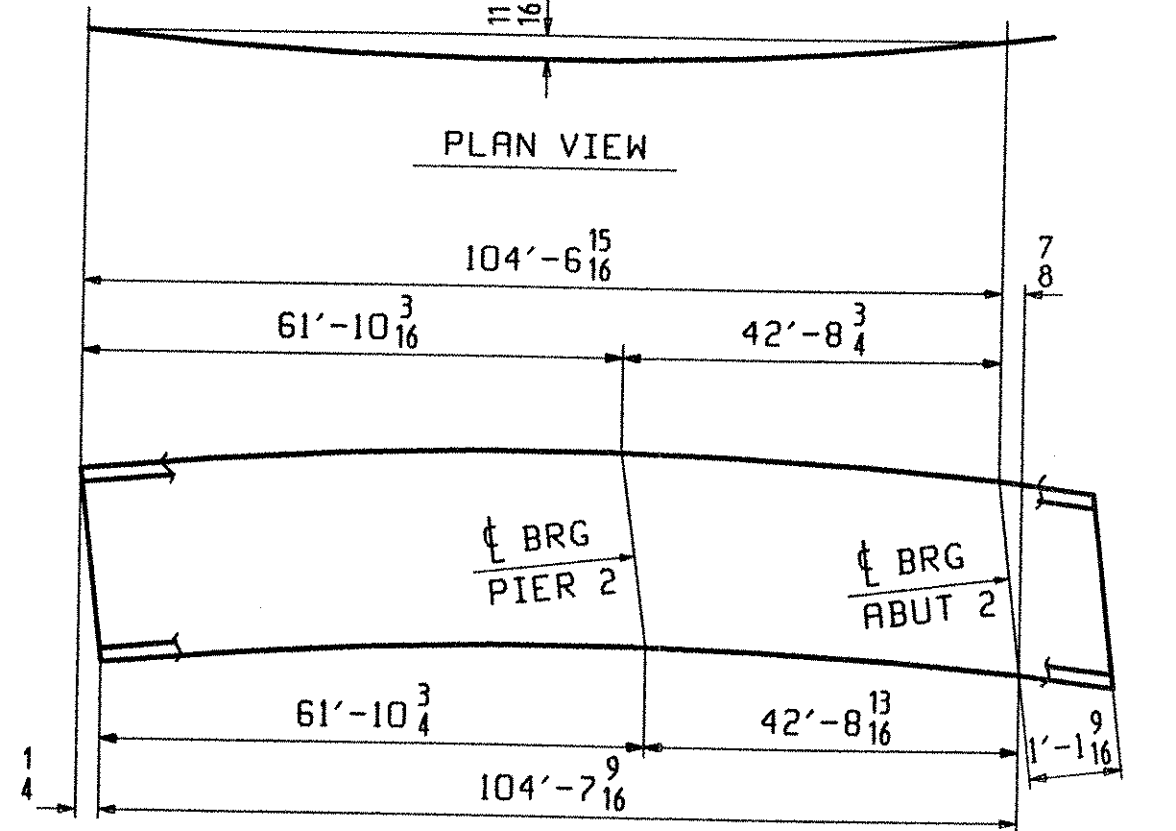

**TVGA**  
Engineering, Surveying, P.C.

NO EXCEPTIONS TAKEN  REJECTED

FURNISH AS CORRECTED

REVISE AND RESUBMIT

ENGINEER has reviewed Shop Drawings and Samples and other data which Contractor is required to provide, and for compliance with the information given in the Contract Documents and compliance with the design criteria of the completed Project as a fabricator who is responsible in the Contract Documents. Each revision shall be accompanied by a memo, methods, techniques, sequence or procedure of construction or its safety precautions and program of work thereon. Contractor is responsible for determining the quality and quantity of the work and for coordination of the work of all trades.

BY: W.A.

DATE: 11-01-2001

OUT FOR APPROVAL	3-5-01											
OUT FOR APPROVAL												
ISSUED TO SHOP												
FIELD & OFFICE												
REV.	REMARKS	DATE	DWN	CHK	APP	O.A.	NO.	DIA.	LGT	TYPE	WASHER	
	MATERIAL:	ELECTRODES:		HOLES:		SHOP BOLTS:						
	M270 GR 50W			15/16 Ø (UN)		7/8 Ø (UN)						
SURFACE PREP. & PAINT: -STEEL WITHIN 10'-0" OF ABUT 2 SHALL BE PAINTED (SEE GNI) -ALL OTHER STEEL SHALL BE BLAST CLEANED AND LEFT UNPAINTED.												
DESCRIPTION: STRINGER - S3B										DRAWN BY		DATE
JOB: BRIDGE NO. 43N										PHG		02/14
I-89 SB OVER U.S. ROUTE 2										CHKD BY		
I-89 IMPROVEMENTS										TRM		02/21
TOWN OF MIDDLESEX-BOLTON, VERMONT										APPROV BY		
PROJ NO. IM-089-2(26)										SUPERVISOR		H. J. GATTI
CUSTOMER: VERMONT AGENCY OF TRANSPORTATION										Q.A.		
<b>CASCO BAY STEEL STRUCTURES, INC.</b>										JOB NO.		DRG. NO.
75 SPRING HILL ROAD										117-43N		208
PHONE (207) 282-7360										SACO, MAINE 04072		
										FAX. (207) 282-1179		
										REV.		△