


JOB NO.		DRAWING NO.		REV.				
325		325						
ABM INFO	SHIP	BILL OF MATERIAL				REMARKS	WT	PROCUREMENT NOTES
PAGE	LINE	MARK	QTY	MARK	MATERIAL	LENGTH FT INCHES		
		G5E	1		GIRDER			16129
301	N		1	wa	PL 1/2 x 36 7/16	77 8 11/16		(M270-50HT2) (H2-3)
301	G		1	ta	PL 5/8 x 16	77 8 11/16		(M270-50HT2) (H2-3)
301	A		1	ba	PL 5/8 x 16	77 7 7/8		(M270-50HT2) (H2-3)
302	B		2	x31a	PL 1/2 x 29 3/4	1 7		(M270-50HT2) (H2-3)
302	C		2	x31b	PL 5/8 x 16	2 7		(M270-50HT2) (H2-3)
302	D		4	x31c	PL 5/8 x 7	2 7		(M270-50HT2) (H2-3)
302	F		1	x31d	PL 1/2 x 16	1 3 3/8		FILL
302	M		1	x31aa	PL 1/2 x 5	2 8 3/4		
302	H		1	x31y	PL 1/2 x 5	2 8 3/4		
302	M		1	x31v	PL 1/2 x 5	2 8 3/4		
302	K		2	x31g	PL 7/8 x 7 1/4	2 8 3/4		

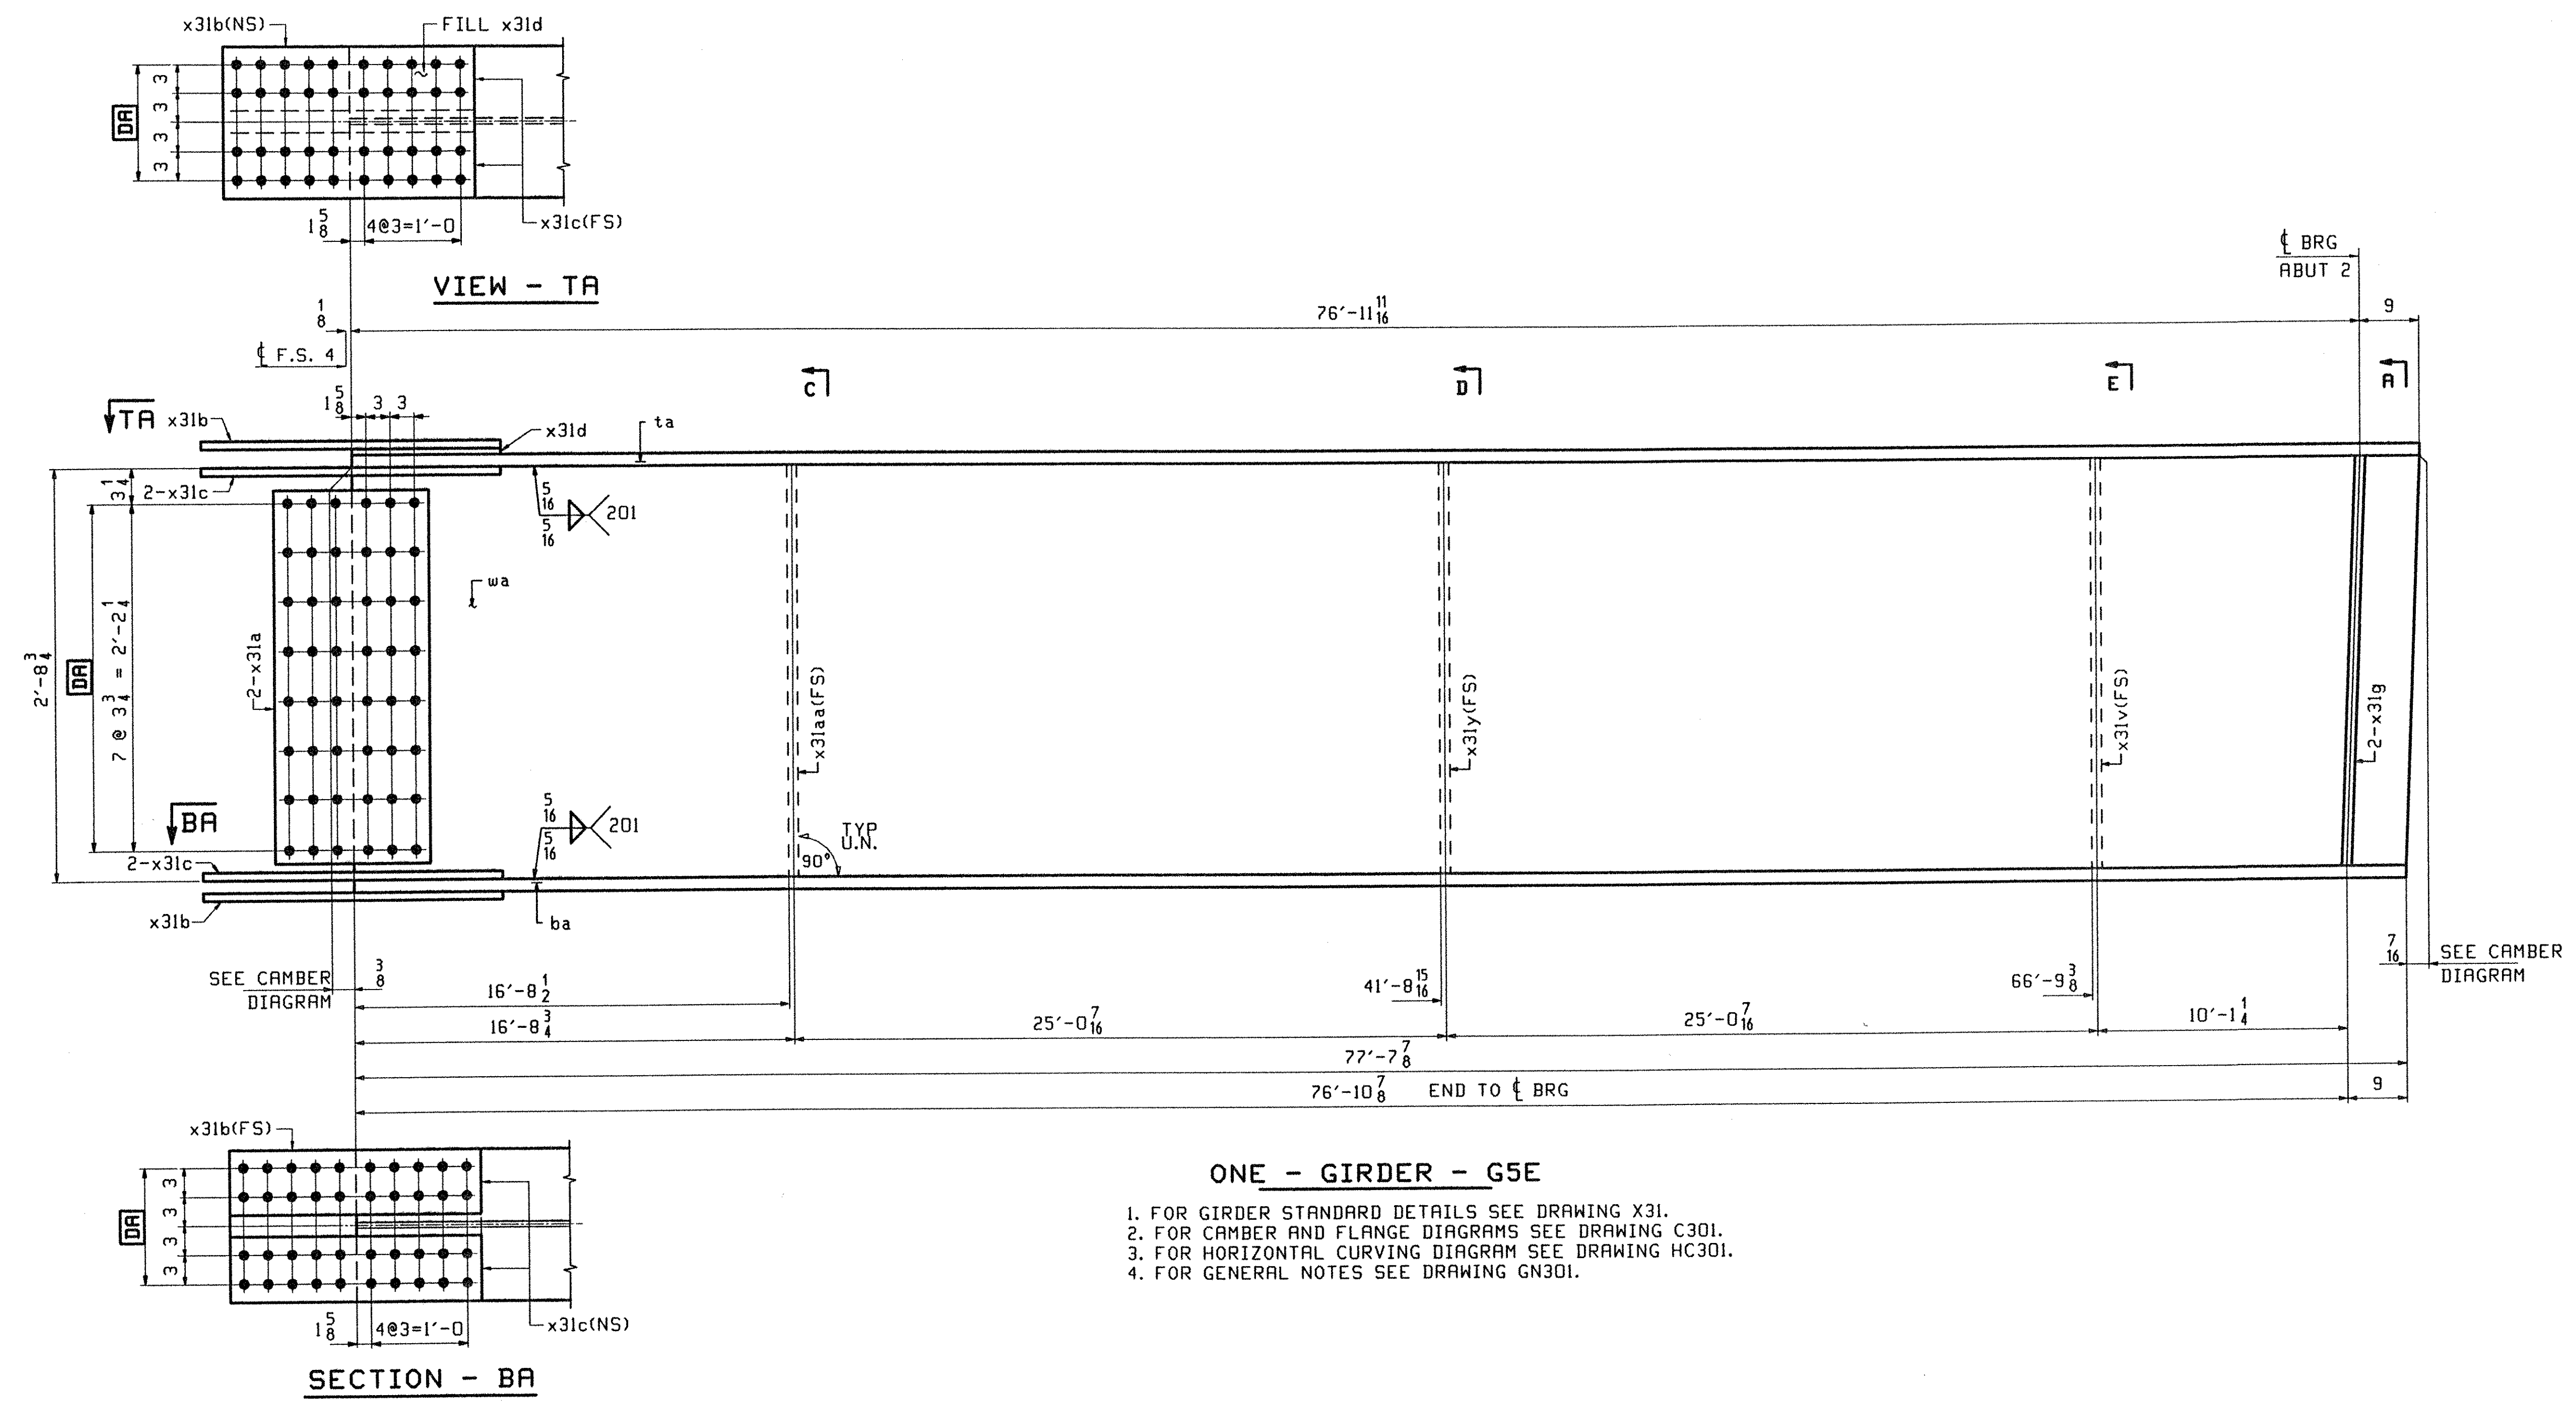

**ONE - GIRDER - G5E**

1. FOR GIRDER STANDARD DETAILS SEE DRAWING X31.
2. FOR CAMBER AND FLANGE DIAGRAMS SEE DRAWING C301.
3. FOR HORIZONTAL CURVING DIAGRAM SEE DRAWING HC301.
4. FOR GENERAL NOTES SEE DRAWING GN301.

TVGA  
Engineering, Surveying, P.C.

NO EXCEPTIONS TAKEN  
IF FURNISH AS CORRECTED  
IF REVISE AND RESUBMIT

ENGINEER HAS REVIEWED SHOP Drawings and Samples and other data which Contractor is required to submit, only for conformance with the information given in the Contract Documents and compliance with the design concept of the Contract Documents. Such review shall not extend to methods, techniques, sequences or procedures of construction or to safety practices and programs incident thereto. Contractor is responsible for determining to be performed safely by the fabrication process or to techniques of construction, and for coordination of the work of all trades.

BY: *W. S. E.*  
DATE: 4/9/01

OUT FOR APPROVAL	3/13/01										
OUT FOR APPROVAL											
ISSUED TO SHOP											
FIELD & OFFICE											
REV.	REMARKS	DATE	DWN	CHK	APP	O.A.	NO.	DIA.	LG T	TYPE	WASHER
	MATERIAL: M270 GR 50W										
	ELECTRODES:										
	HOLES:										
	SHOP BOLTS:										
	SURFACE PREP. & PAINT: -STEEL WITHIN 10'-0" OF ABUT 1 SHALL BE PAINTED (SEE GN301) -ALL OTHER STEEL SHALL BE BLAST CLEANED AND LEFT UNPAINTED.										
	DESCRIPTION: GIRDER - G5E										
	JOB: BRIDGE NO. 485										
	1-89 SB OVER LITTLE RIVER										
	1-89 IMPROVEMENTS										
	TOWN OF MIDDLESEX-BOLTON, VERMONT										
	PROJ NO. IM-089-2(26)										
	CUSTOMER: VERMONT AGENCY OF TRANSPORTATION										
	<b>CASCO BAY STEEL STRUCTURES, INC.</b>										
	75 SPRING HILL ROAD SACO, MAINE 04072										
	PHONE (207) 282-7360 FAX. (207) 282-1179										
	JOB NO. 118-485										
	DRG. NO. 325										
	REV. $\Delta$										

