

ABM INFO		SHIP		BILL OF MATERIAL				JOB NO.	DRAWING NO.	REV.
PAGE	LINE	MARK	QTY	MARK	MATERIAL	LENGTH	REMARKS	WT	PROCUREMENT NOTES	
						FT				
						INCHES				
		G3B	1		GIRDER			12562		
401	N		1	wa	PL 1/2 x 3/4	52 5/8	(H270-50WT2) (H2-3)			
401	C		1	ta	PL 1/2 x 1/2	52 5/8	(H270-50WT2) (H2-3)			
401	C		1	ba	PL 1/2 x 1/2	52 5/8	(H270-50WT2) (H2-3)			
402	M		2	x41t	PL 1/2 x 5	2 3/4				
402	M		1	x41w	PL 1/2 x 5	2 3/4				
402	K		1	x41p	PL 3/4 x 7/4	2 3/4				
402	K		1	x41n	PL 3/4 x 7/4	2 3/4				
402	M		1	x41aa	PL 1/2 x 5	2 3/4				

TVGA
Engineering, Surveying, P.C.

NO EXCEPTIONS TAKEN REJECTED
FURNISH AS CORRECTED
REVISE AND RESUBMIT
ENGINEER has reviewed Shop Drawings and Samples and other data which Contractor is required to submit, only for conformance with the information given in the Contract Documents and compatibility with the design concept of the completed Project as a following whole as indicated in the Contract Documents. Each revision shall extend to masses, methods, techniques, sequences or procedures of construction or to safety procedures and programs incident thereto. Contractor is responsible for dimensions to be confirmed and correlated at the job site; for information that pertains solely to the fabrication processes or to techniques of construction; and for coordination of the work of all trades.

BY: *[Signature]*
DATE: 01-11-2007


OUT FOR APPROVAL	11-13-07								
OUT FOR APPROVAL									
ISSUED TO SHOP									
FIELD & OFFICE									

REV.	REMARKS	DATE	DWN	CHK	APP	Q.R.	NO.	DIA.	LGT	TYPE	WASHER
	MATERIAL: M270 GR. 50W (UN)										
	ELECTRODES:										
	HOLES:										
	SHOP BOLTS:										

SURFACE PREP. & PAINT:
- STEEL WITHIN 10'-0" OF ABUT. 2 SHALL BE PAINTED (SEE GN301)
- ALL OTHER STEEL SHALL BE BLAST CLEANED AND LEFT UNPAINTED.

DESCRIPTION:	GIRDER - G3B	DRAWN BY	DATE
JOB:	I-89 NB OVER LITTLE RIVER	BW	08/02
	I-89 IMPROVEMENTS	CHKD BY	
	BETWEEN TOWNS OF MIDDLESEX & BOLTON	ELC	9/12/01
	COUNTY OF WASHINGTON VERMONT	APPROV BY	
		SUPERVISOR	W. J. GATTI
PROJ NO.	IM-089-2(26)	Q.R.	
CUSTOMER:	VERMONT AGENCY OF TRANSPORTATION		

CASCO BAY STEEL STRUCTURES, INC.	JOB NO.	DRG. NO.
75 SPRING HILL ROAD	SACO, MAINE 04072	119-48N 408
PHONE (207) 282-7360	FAX. (207) 282-1179	REV. Δ

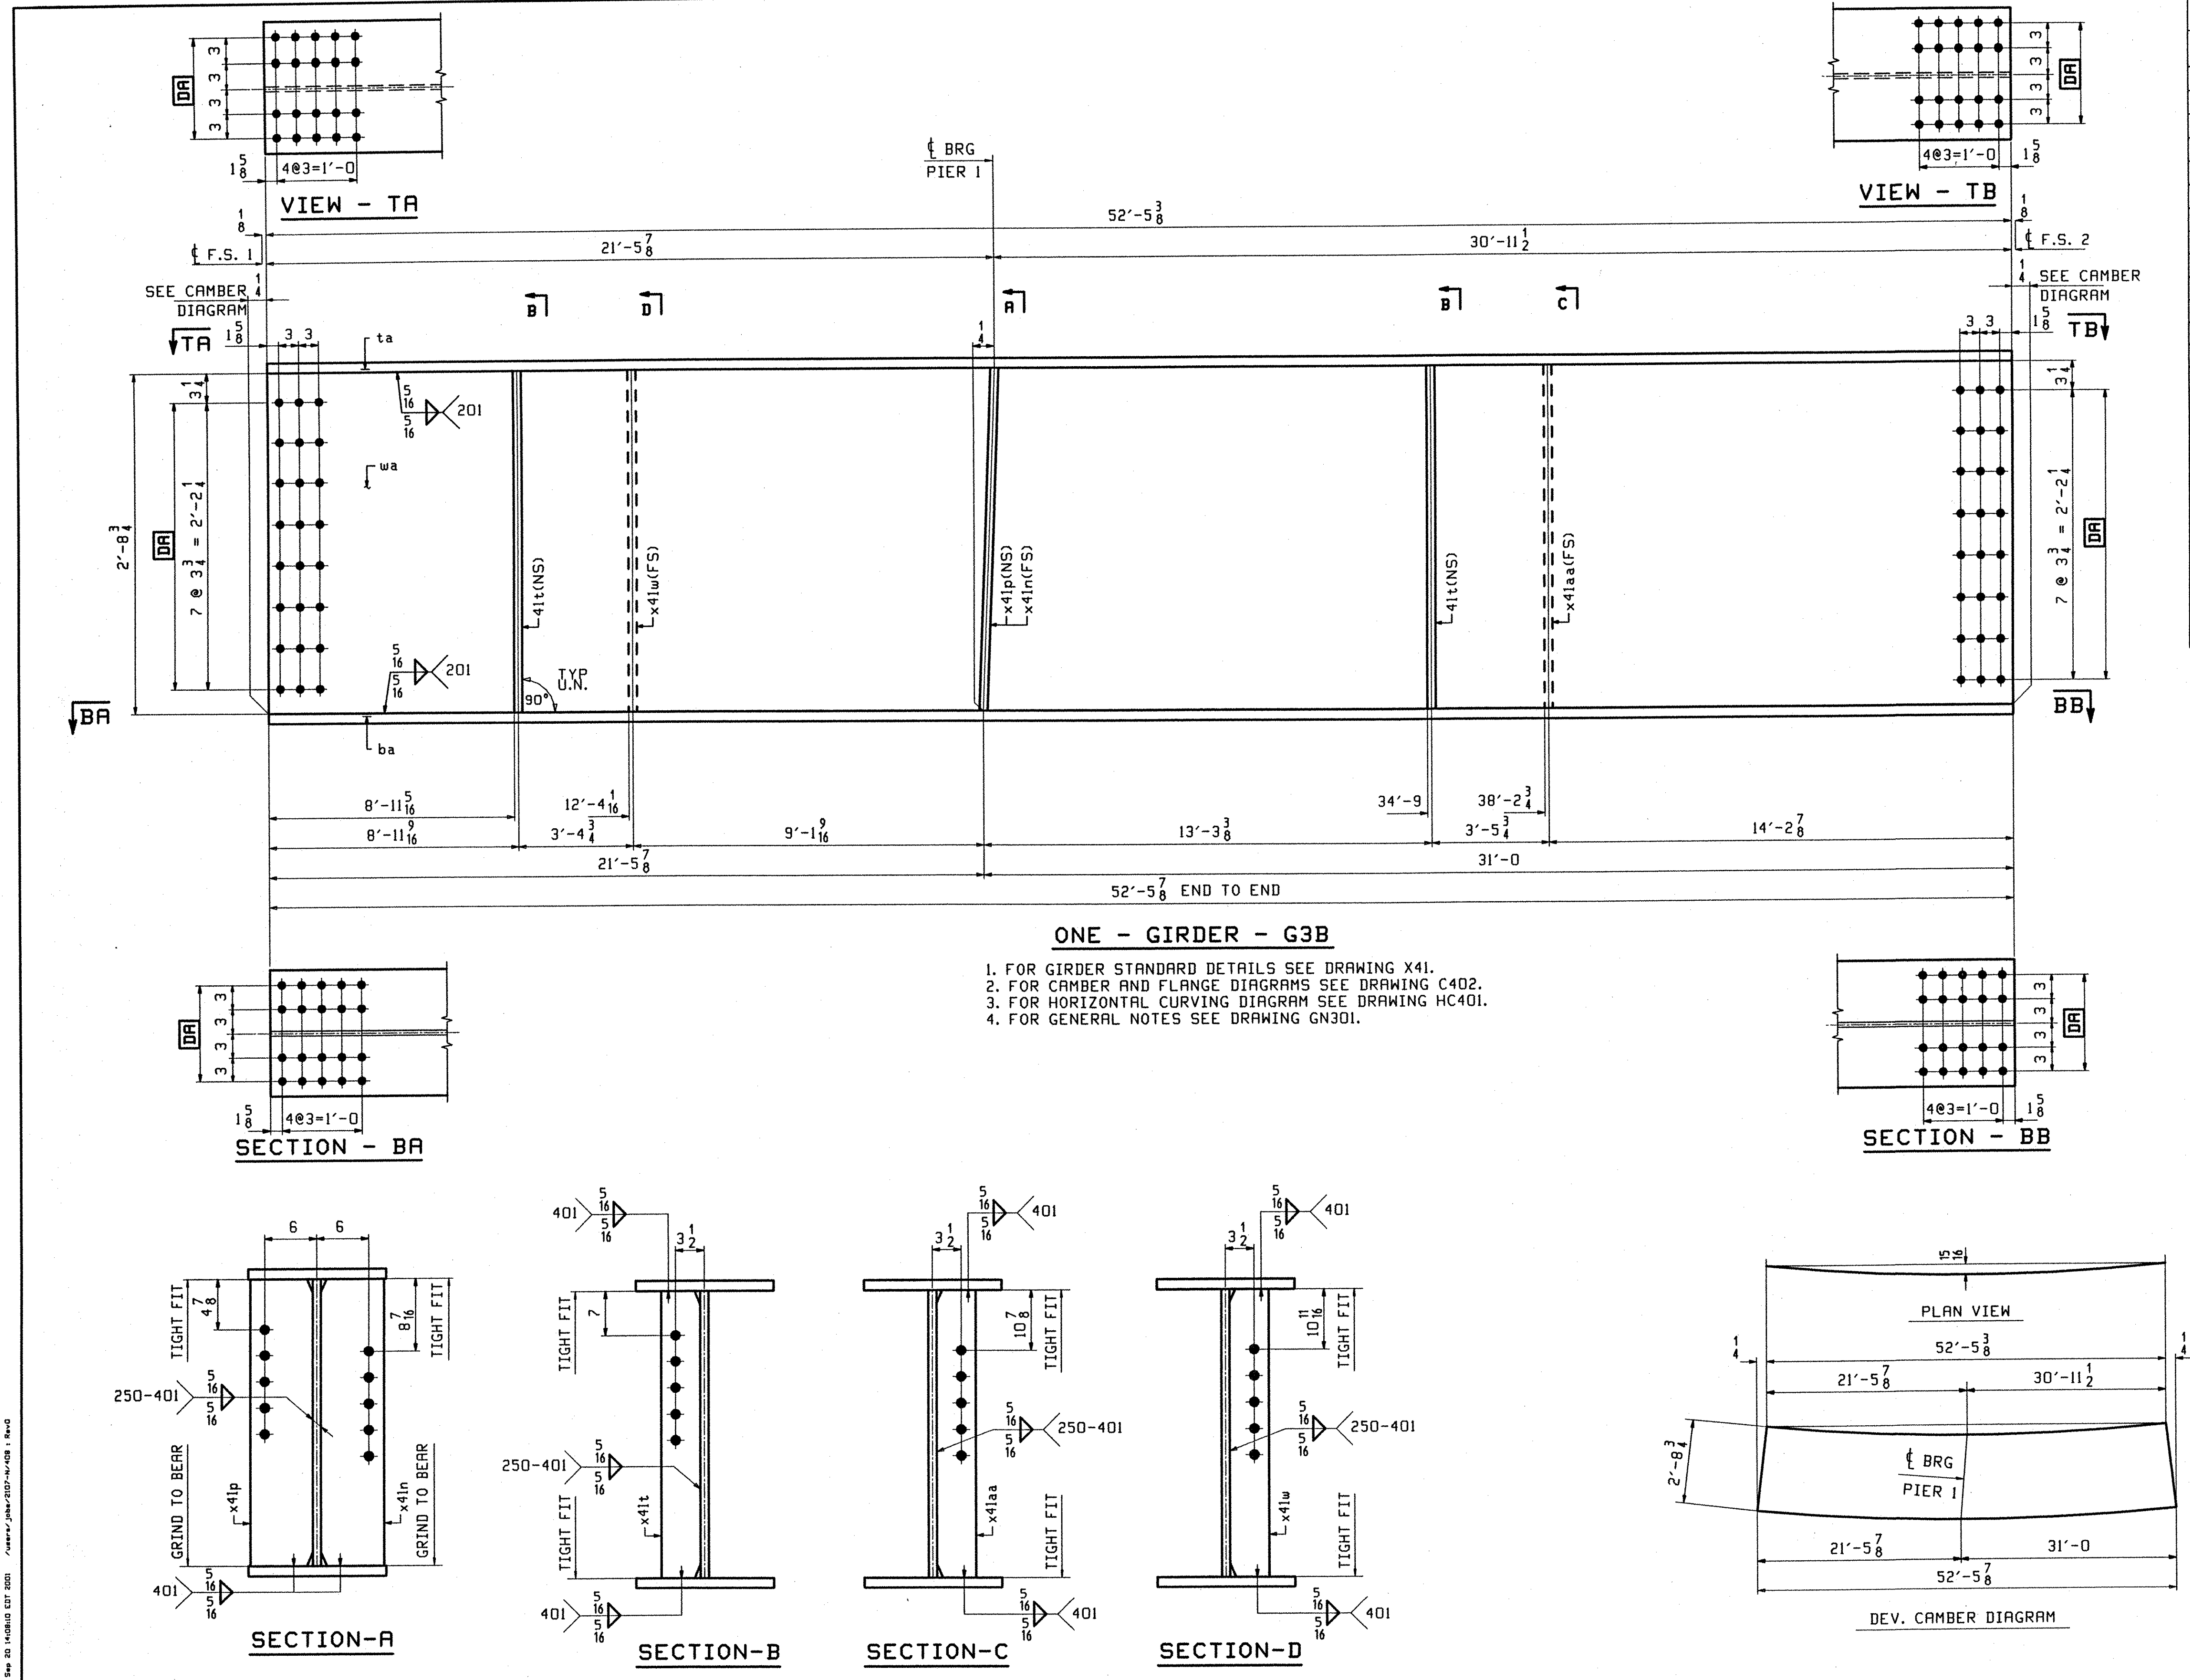

- ONE - GIRDER - G3B**
1. FOR GIRDER STANDARD DETAILS SEE DRAWING X41.
 2. FOR CAMBER AND FLANGE DIAGRAMS SEE DRAWING C402.
 3. FOR HORIZONTAL CURVING DIAGRAM SEE DRAWING HC401.
 4. FOR GENERAL NOTES SEE DRAWING GN301.

The Size 20 font is 1/8" high. Rev 01 01/01/07