


VIEW "A" (TYP)
SEE DWG E602

MEASURED HORIZONTAL
ALONG CONST. 50N

66'-3¹⁵/₁₆ C/C BRG.


96'-6 C/C BRG.

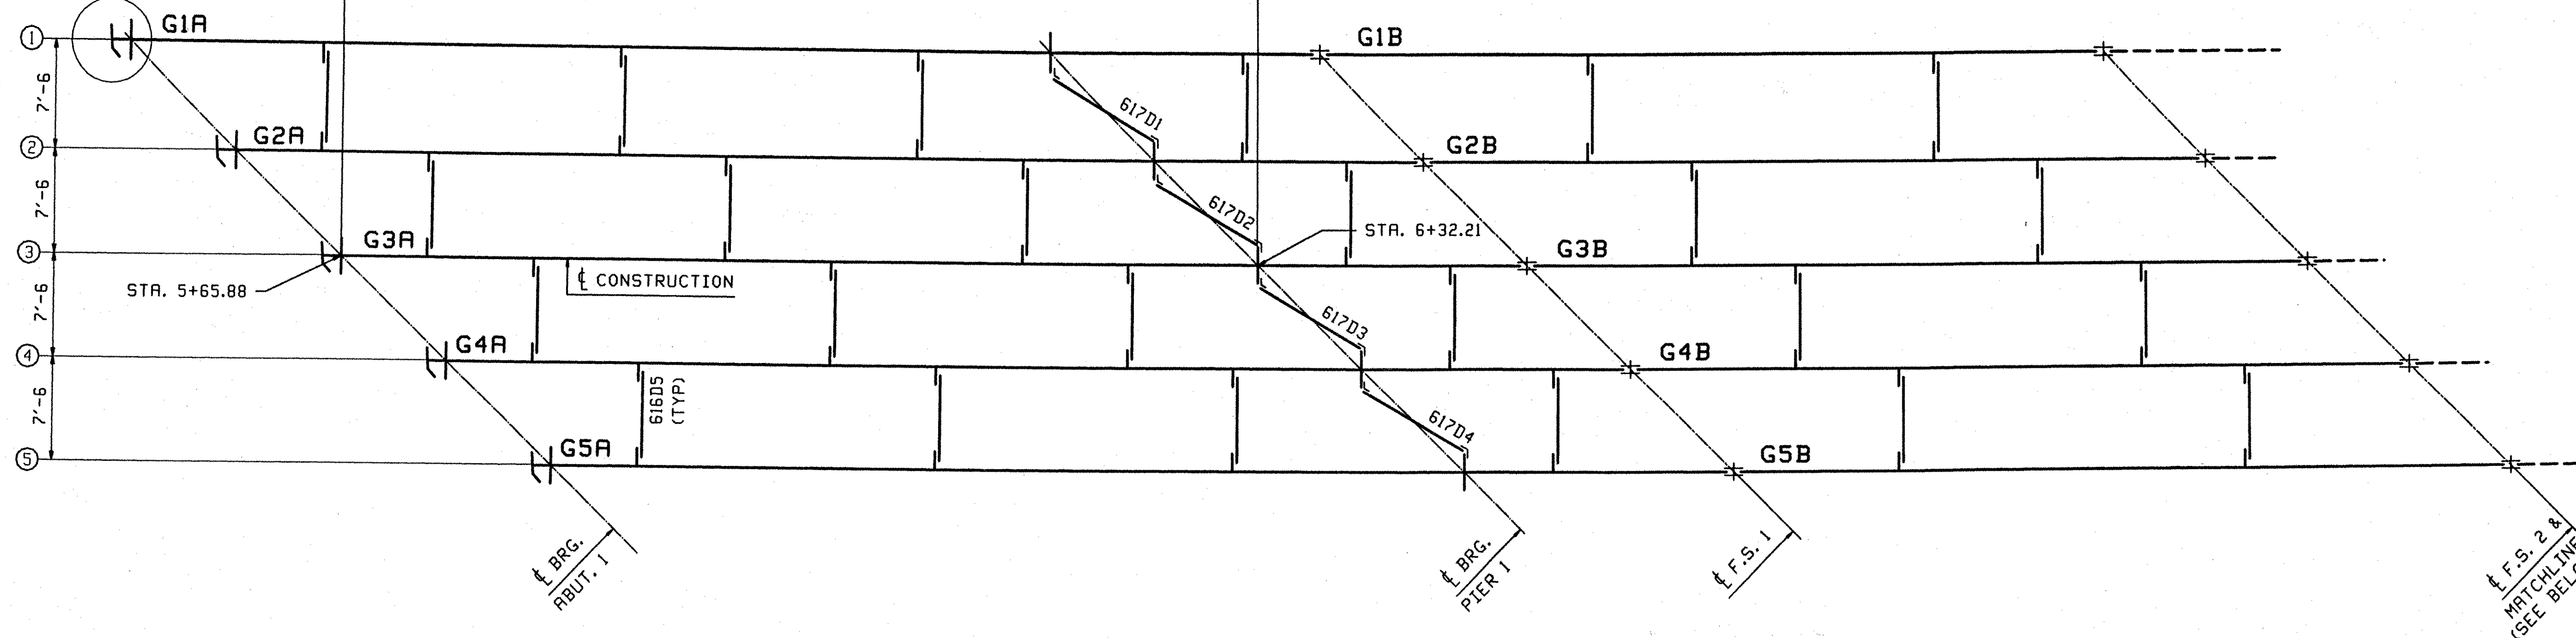

96'-6 C/C BRG.

69'-9⁵/₈ C/C BRG.

MEASURED HORIZONTAL
ALONG CONST. 50N

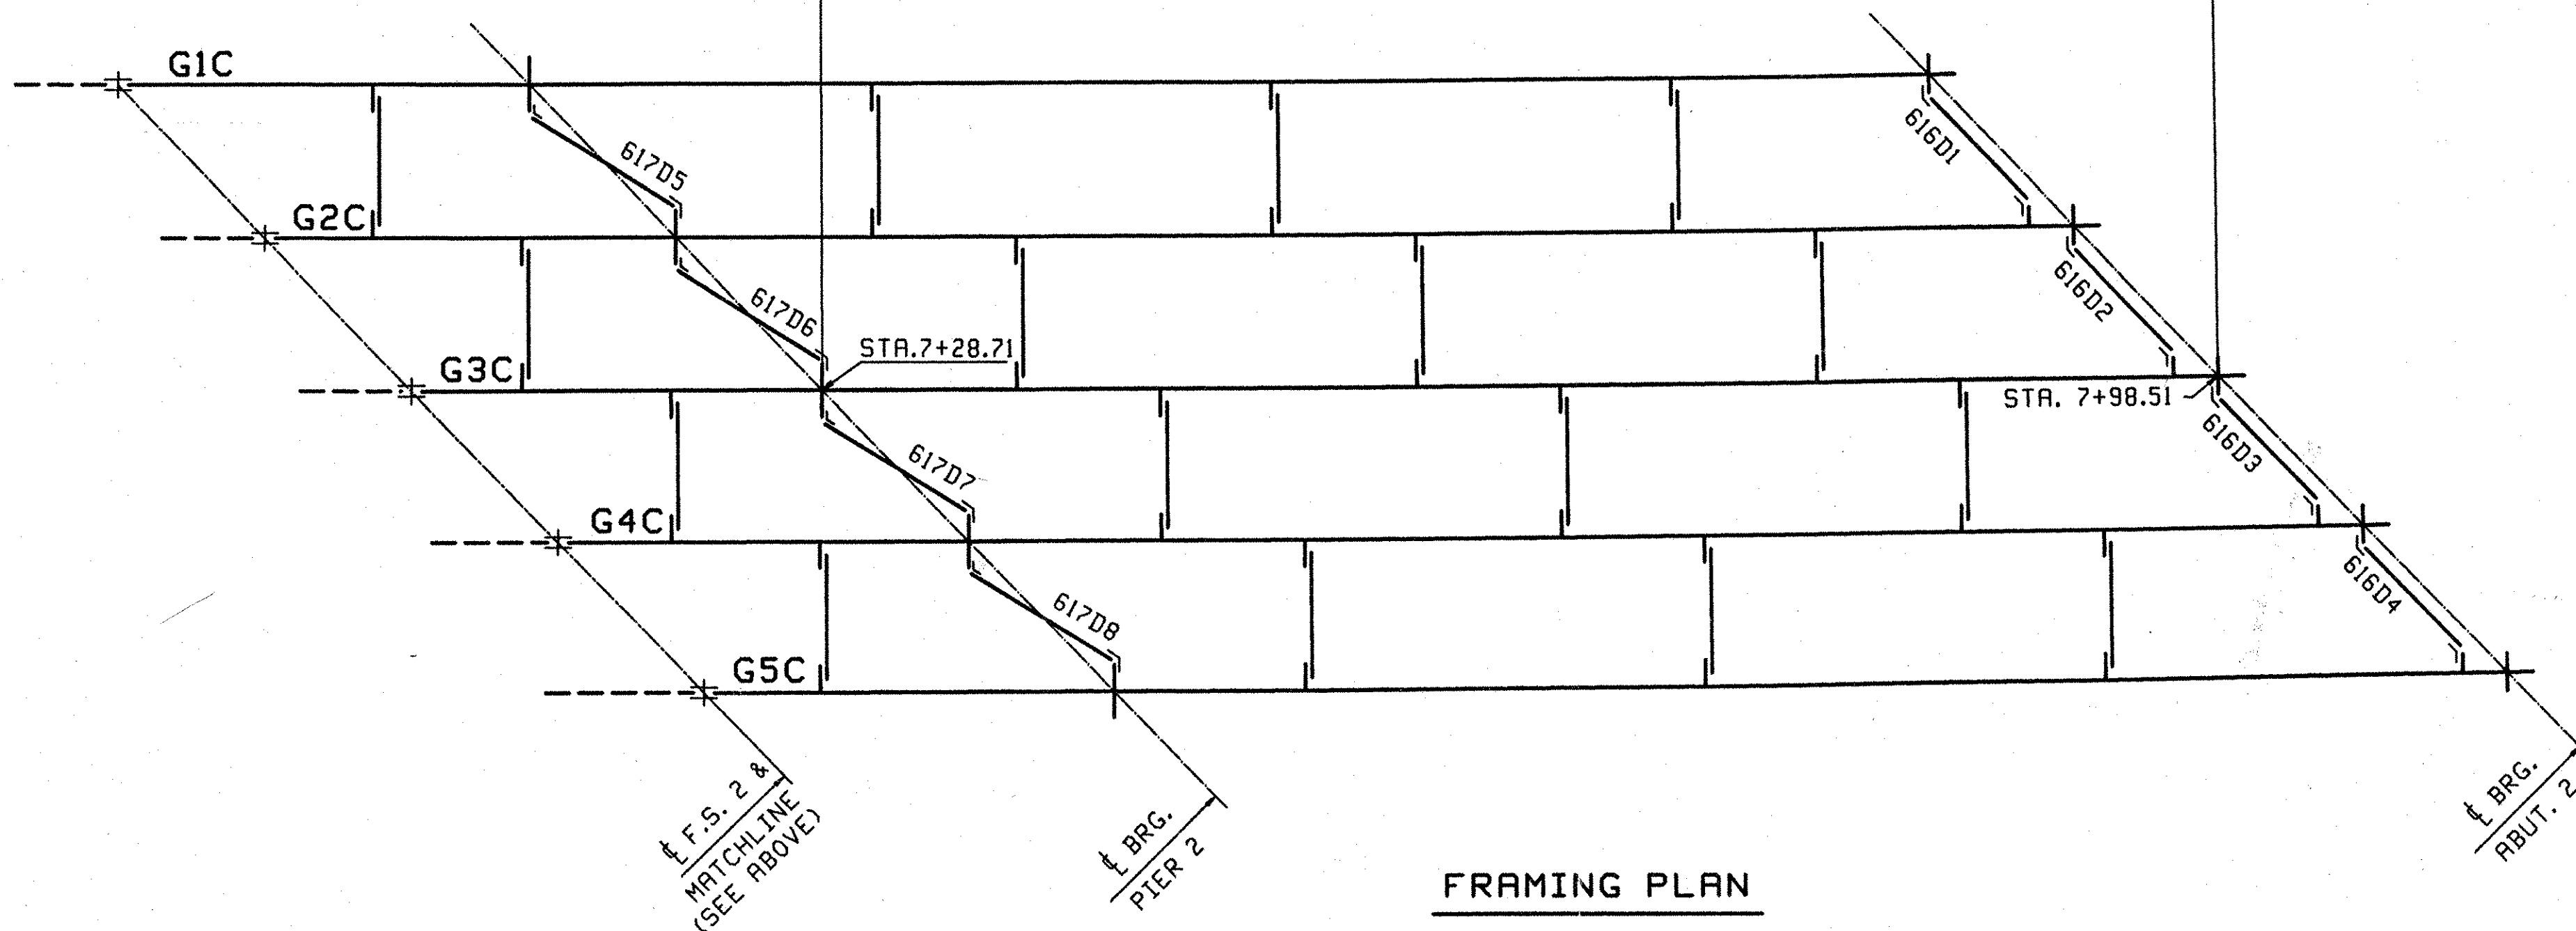

FRAMING PLAN



WORK THIS DWG WITH DWG E602

OUT FOR APPROVAL	09/21								
OUT FOR APPROVAL									
ISSUED TO SHOP									
FIELD & OFFICE									

REV.	REMARKS	DATE	DWN	CHK	APP	Q.A.	NO.	DIA.	LGT	TYPE	WASHER
MATERIAL:	M270 GR 50W	ELECTRODES:									
		HOLES:						15/16 φ (UN)			7/8 φ (UN)

SURFACE PREP. & PAINT:
 -STEEL WITHIN 10'-0 OF ABUT 2 SHALL BE PAINTED (SEE GN501)
 -ALL OTHER STEEL SHALL BE BLAST CLEANED AND LEFT UNPAINTED.

DESCRIPTION:	FRAMING PLAN	DRAWN BY:	BW	DATE:	09/25
JOB:	BRIDGE NO. 50N I-89 NB OVER U.S. ROUTE 2 I-89 IMPROVEMENTS TOWN OF MIDDLESEX-BOLTON, VERMONT	CHKD BY:	DO	DATE:	10/1
PROJ NO.	IM-089-2(26)	APPROV BY:	M. J. GATTI	SUPERVISOR:	M. J. GATTI
CUSTOMER:	VERMONT AGENCY OF TRANSPORTATION	JOB NO.	123-50N	DRG. NO.	E601
	CASCO BAY STEEL STRUCTURES, INC. 75 SPRING HILL ROAD PHONE (207) 282-7360		SACO, MAINE 04072 FAX. (207) 282-1179	REV.	▲

TVGA
 Engineering, Surveying, P.C.

NO EXCEPTIONS TAKEN REJECTED
 FURNISH AS CORRECTED
 REVISE AND RESUBMIT

ENGINEER HAS REVIEWED SHOP DRAWINGS AND SAMPLES AND OTHER DATA WHICH CONTRACTOR IS REQUIRED TO SUBMIT, ONLY FOR CONFORMANCE WITH THE INFORMATION GIVEN IN THE CONTRACT DOCUMENTS AND ASSUMING THE DESIGN ACCEPTED AT THE CONTRACTOR'S RISK AS A CONDITIONAL APPROVAL. SUCH REVIEW DOES NOT EXTEND TO MATERIALS, METHODS, TECHNIQUES, PROCESSES OR PROCEDURES OF CONSTRUCTION OR TO THE CONTRACTOR'S RESPONSIBILITY TO PERFORM AS TO THE QUALITY OF THE WORK OR TO THE CONTRACTOR'S OBLIGATION TO COORDINATE THE WORK WITH OTHER CONTRACTORS.

BY: MMB
 DATE: 09-16-2002

DW The Date: 4/20/03 EST 2001 / www.casco.com / E601 Rev 3