

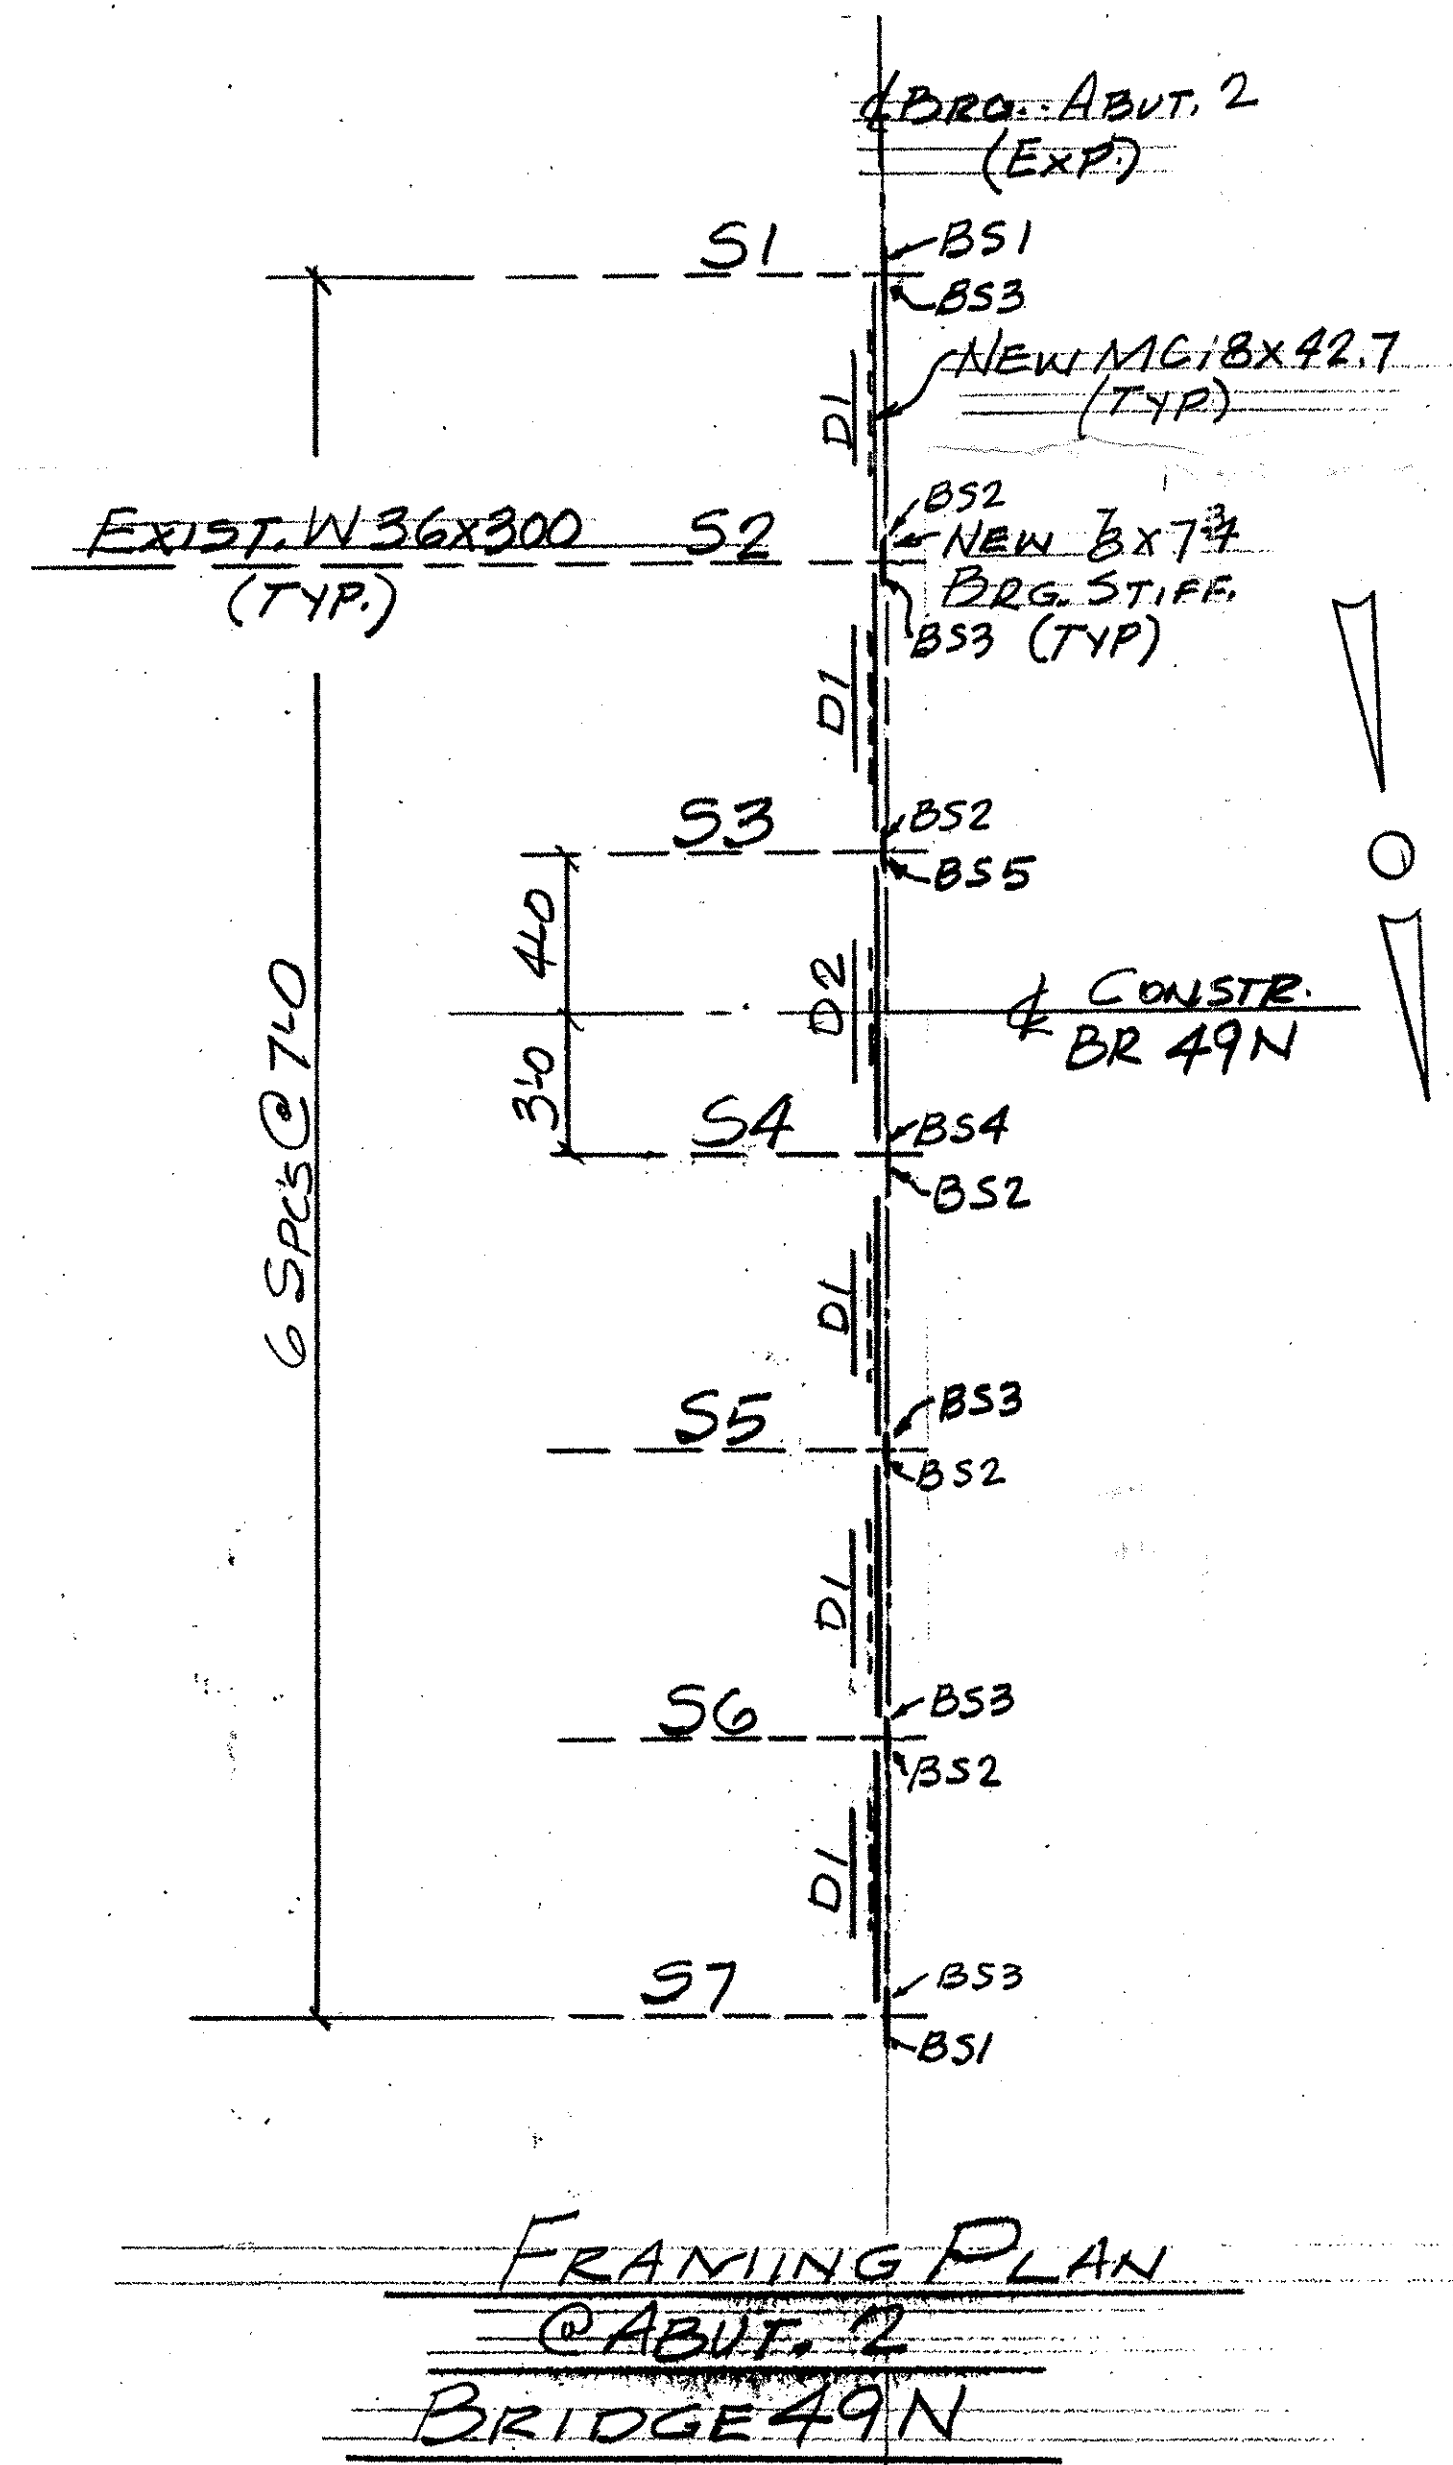
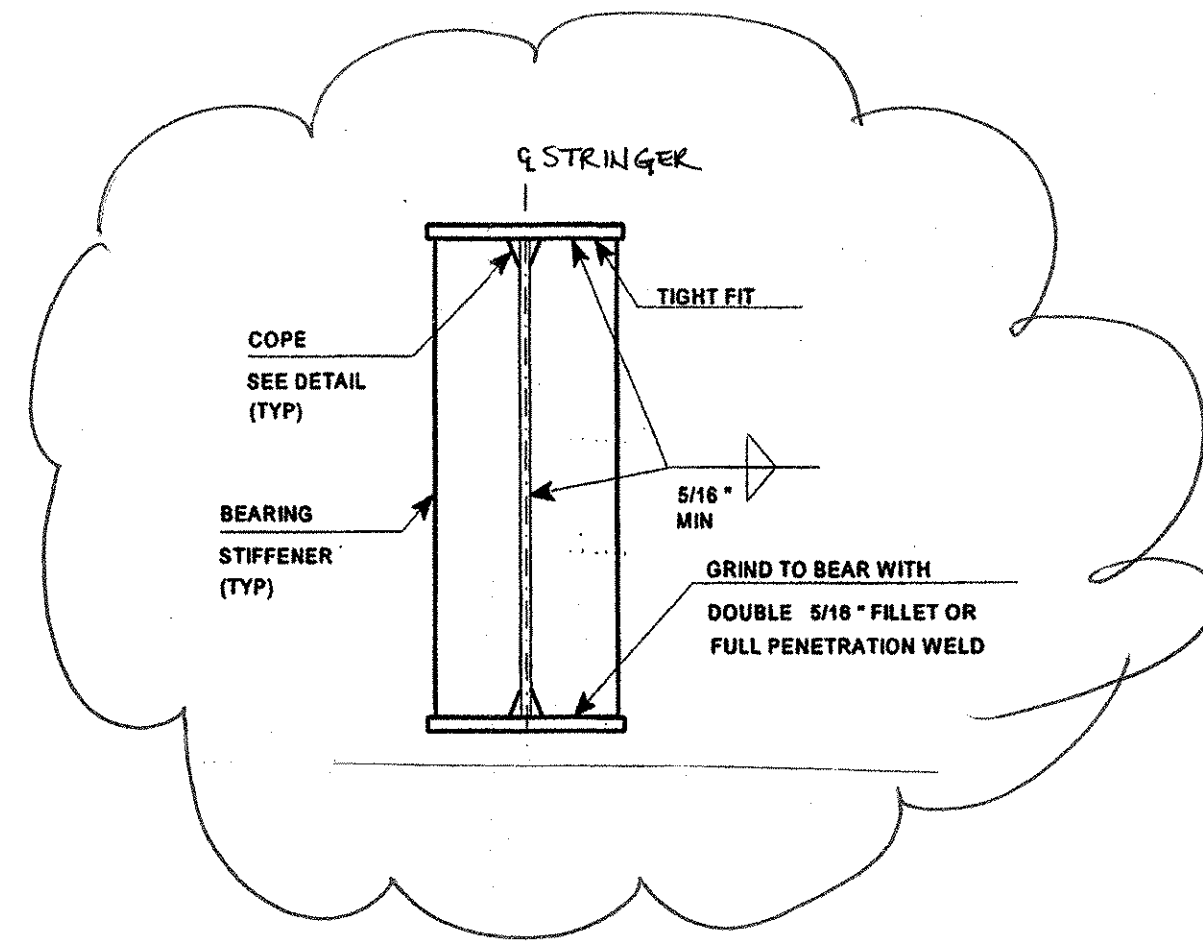
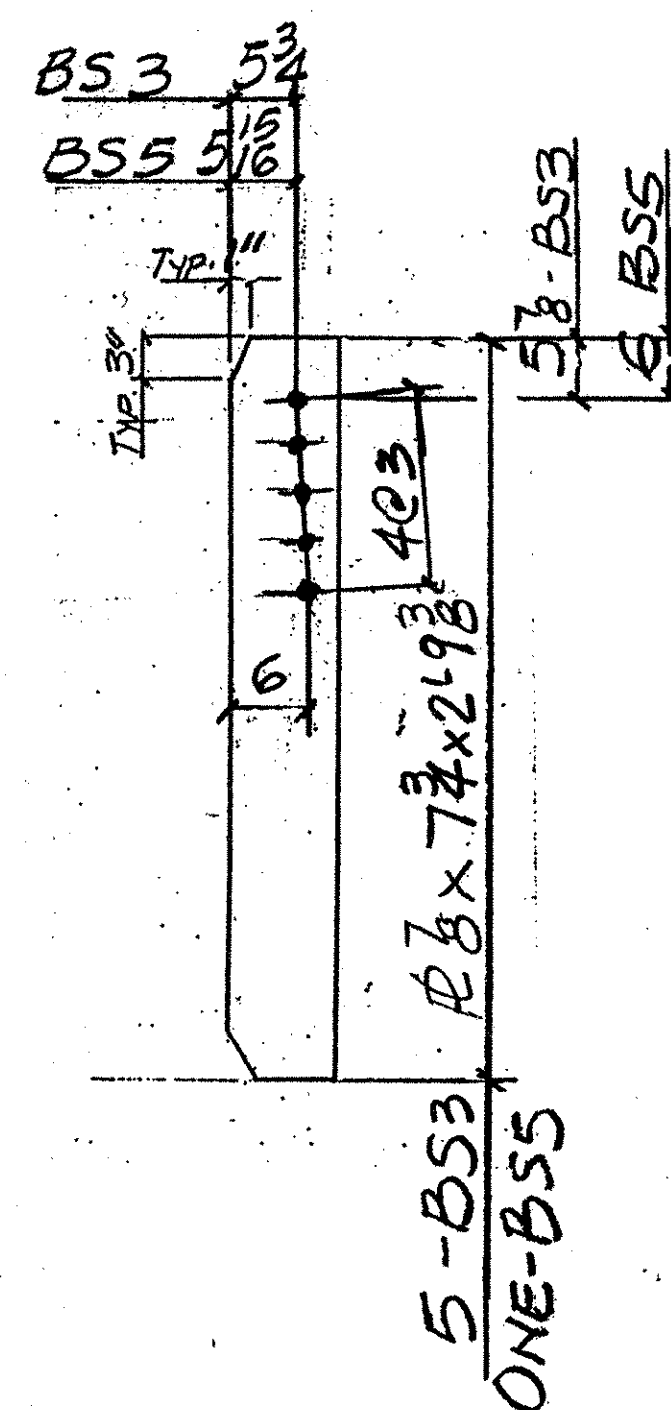
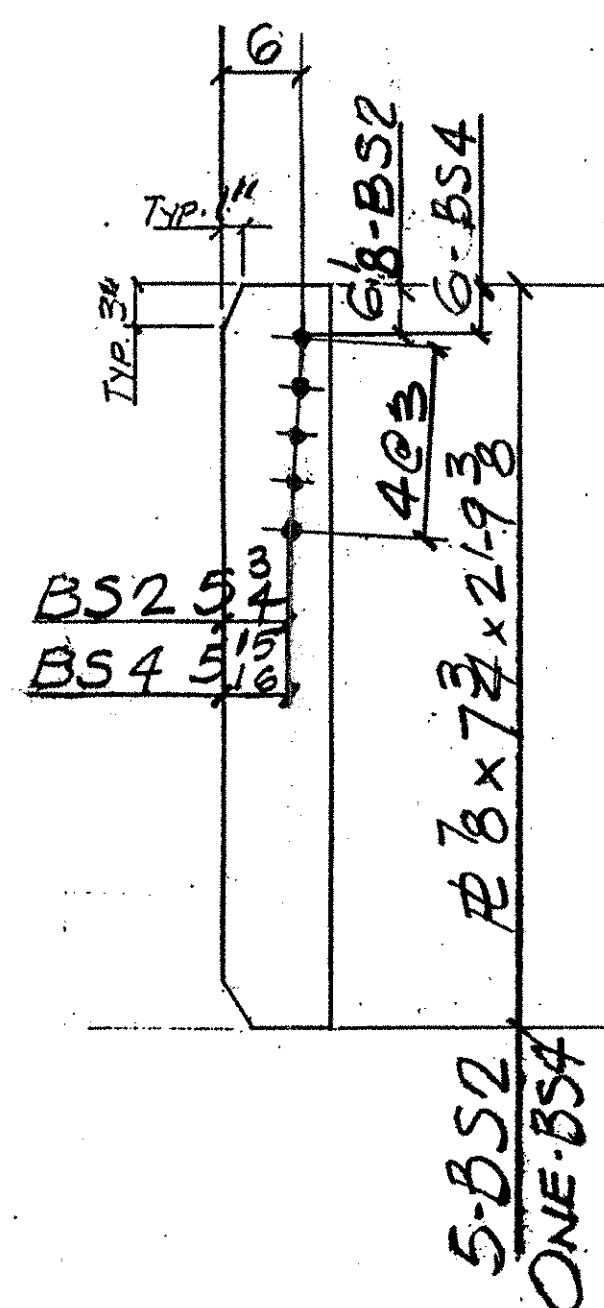


TYPICAL WELD TERMINATION AND COPING DETAIL

N.T.S.
 * NO WELD PLACED FOR 1/4" MIN. V. MAX. EXCEPT MUST MAINTAIN 1" MINIMUM FROM EDGE OF FLANGED

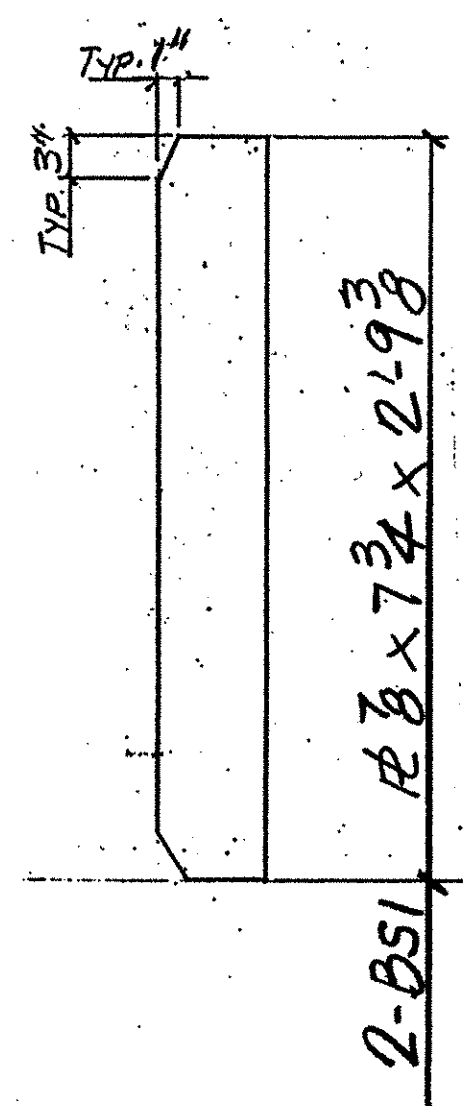

FRAMING PLAN
 @ ABUT. 2
 BRIDGE 49N

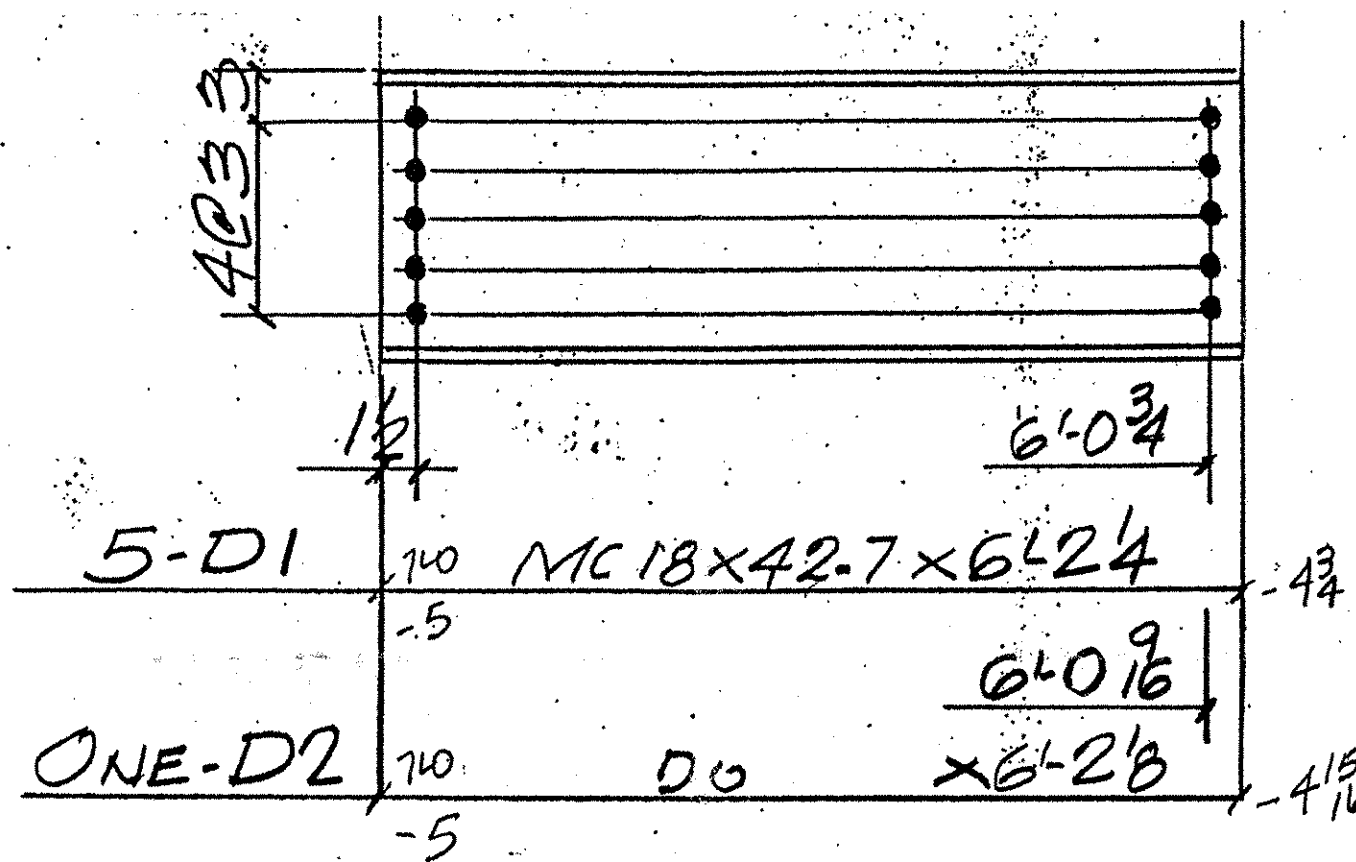

TVGA
 Engineering, Surveying, P.C.
 NO EXCEPTIONS TAKEN REJECTED
 FURNISH AS CORRECTED
 REVISE AND RESUBMIT
 ENGINEER has reviewed Shop Drawings and Samples and other data which Contractor is required to submit, only for conformance with the information given in the Contract Documents and compatibility with the design concept of the completed Project as a forerunning whole as indicated in the Contract Documents. Such review does not extend to means, methods, techniques, sequences or procedures of construction or to safety precautions and programs incident thereto. Contractor is responsible for dimensions to be confirmed and controlled at the job site for information that pertains solely to the fabrication processes or to techniques of construction, and for coordination of the work of all trades.
 BY: J.W.S.
 DATE: 2/22/01

ABM INFO		SHOP BILL				JOB NO.	DRG. NO.		
PAGE	LINE	NO.	DESCRIPTION	FT	IN	ASSEMBLY MARK	SHIPPING MARK	REMARKS	WEIGHT
	5		MC18x42.7	6	24			D1	
	1		DO	6	28			D2	
	2		RB x 7 3/4	2	9 3/8			B51	
	5		DO	2	9 3/8			B52	
	5		DO	2	9 3/8			B53	
	1		DO	2	9 3/8			B54	
	1		DO	2	9 3/8			B55	
	60		5/8\"/>						

PAY ITEM 506.60

OUT FOR APPROVAL	12-01										
OUT FOR APPROVAL	2-201										
ISSUED TO SHOP											
FIELD & OFFICE											
REV.	REMARKS	DATE	DWN	CHK	APP	Q.A.	NO.	DIA.	LGT	TYPE	WASHER
	PROJECT NO. IM-089-2(26) STATE BRIDGE NO. 49N										
	MATERIAL: 1/2\"/>										
	SURFACE PREP. & PAINT:										
	No PAINT										
DESCRIPTION:	BRG. STIFFS. & DIAPHRAGMS	DRAWN BY:	JPE	DATE:	12-00						
JOB:	BRIDGE 49N	CHKD BY:	EJ.								
	I 89-NB-OVER TH 7	APPROV BY:									
	MIDDLESEX-BOLTON, VT.										
CUSTOMER:	WINTERSET INC.										
CASCO BAY STEEL STRUCTURES, INC.		JOB NO.:	121-49N	DRG. NO.:	51-N						
75 SPRING HILL ROAD	SACO, MAINE 04072	PHONE (207) 282-7360	FAX (207) 282-1179	514 B34	REV.:						