





ADM INFO		SHOP BILL				JOB NO.	DRG. NO.		
PAGE	LINE	NO.	DESCRIPTION	FT	IN	ASSEM. MARK	SHIPPING MARK	REMARKS	WEIGHT
	1		DOWNSPOUT	5	10±		D50S		
		1	1 I 8 x 8 x 3/8	6	3±	+1		ASSEMBLY	
		2	1 R 3 x 7/4	1	13	HP1		BEND	
		1	1 R 3 x 1 1/4	1	1	HP2			
		1	1 R 3 x 3	1	11/4	HP3			
		1	1 L 6 x 4 x 1/2	3	1				
	2		BAR 3 x 1/2	2	6±		SA1	BAND	
	2		DO	1	4		SB1		
	4		5/8" THREADED ROD	9			TS1	PER WINTER SET 7/14/08	
		8	3/4" HEX NUTS						
		8	3/4" WASHERS						
	4		EPOXY GROUT				FIELD	HUTTING HIGH-150 SYSTEM	

TVGA
Engineering, Surveying, P.C.

NO EXCEPTIONS TAKEN REJECTED
 FURNISH AS CORRECTED

REVISE AND REQUANTIFY
ENGINEER'S RESPONSIBILITY FOR DIMENSIONS AND SAMPLES AND OTHER DATA UNDER CONTRACTOR'S CONTROL IS LIMITED TO THAT WHICH IS SHOWN ON THE CONTRACT DOCUMENTS AND COMPATIBLE WITH THE DESIGN CONCEPT OF THE CONTRACT DOCUMENTS. SUCH REVISES SHALL BE DONE TO MAINTAIN, UNLESS OTHERWISE SPECIFIED, THE SAFETY, DURABILITY AND PERFORMANCE OF THE WORK. CONTRACTOR IS RESPONSIBLE FOR OBTAINING ALL NECESSARY PERMITS AND FOR COORDINATION OF THE WORK OF ALL TRADES.

BY: PE H. S. C.
DATE: 1/17/08

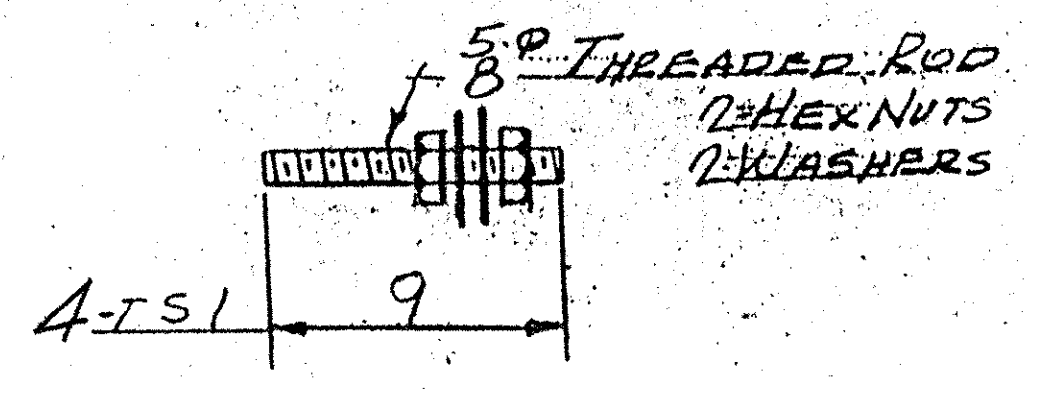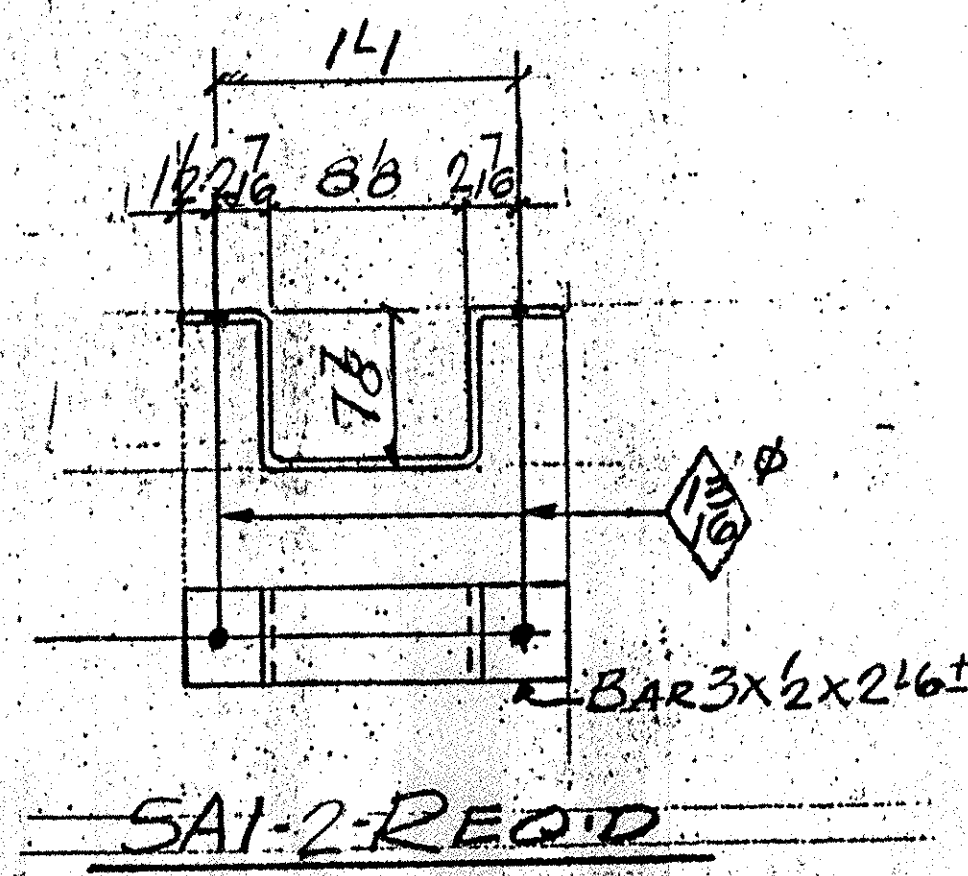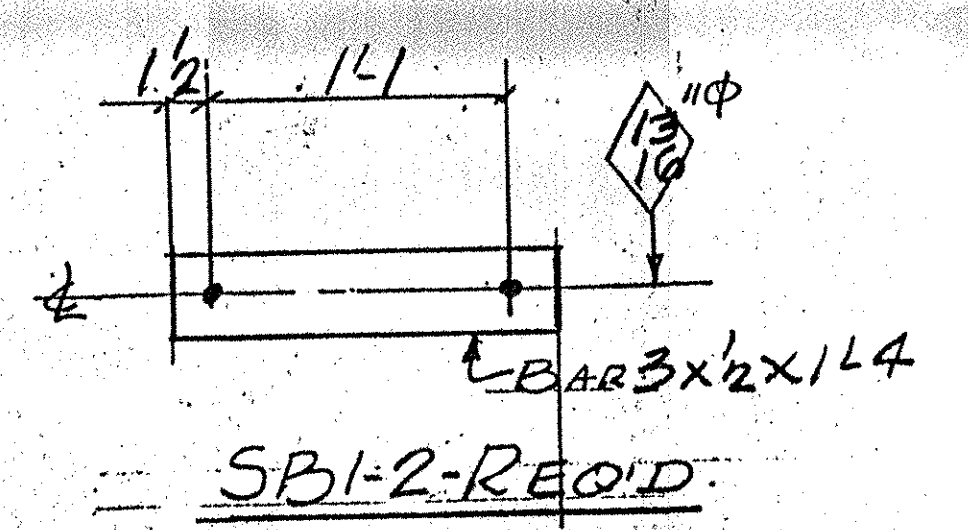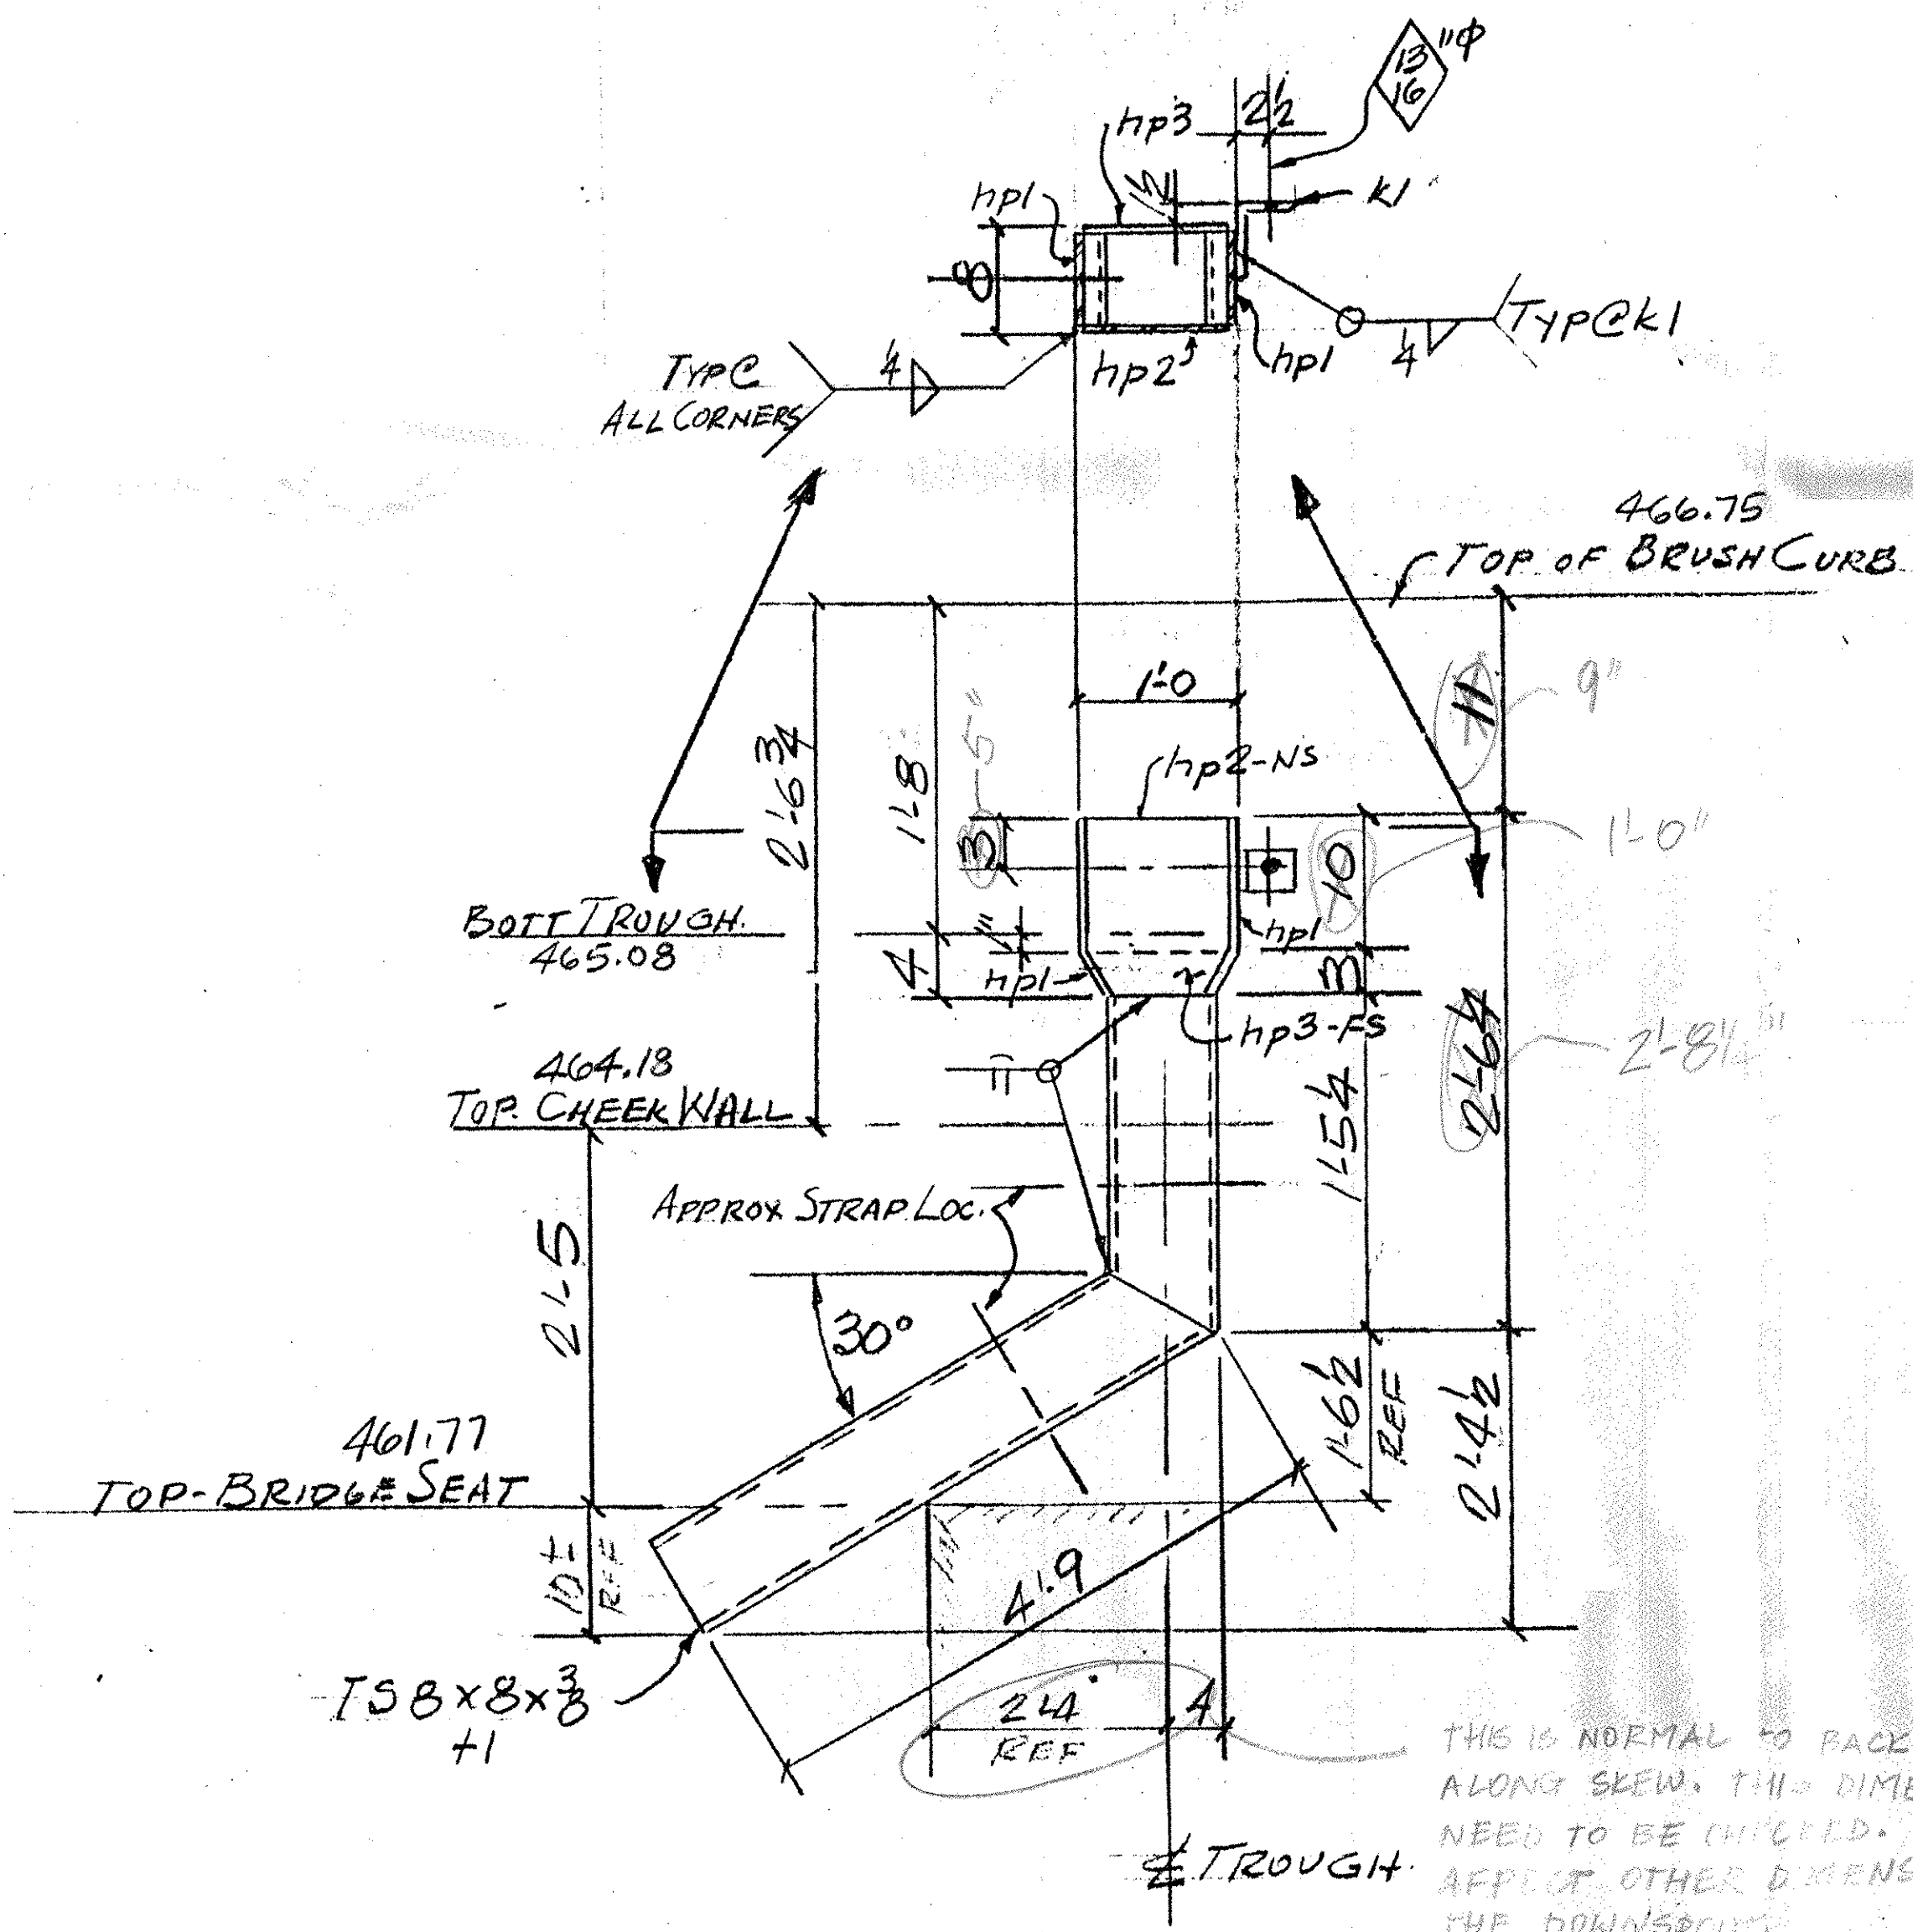

D50S-ONE REQ'D.

PAY ITEM 506.60

OUT FOR APPROVAL	22-01								
ISSUED TO SHOP									
FIELD & OFFICE									

REV.	REMARKS	DATE	DWN	CHK	APP.	Q.A.	NO.	DIA.	LGT	TYPE	WASHER
	PROJECT NO: TM-089-2(26) STATE BRIDGE NO. 50S										
	MATERIAL: A572-10 PER 1270-GA30 ELECTRODES: PER 1270-GA30 HOLES: AS NOTED SHOP BOLTS:										
	SURFACE PREP. & PAINT:										

GALVANIZED AFTER FAB.

DESCRIPTION: DOWNSPOUT ABUT. 1	DRAWN BY	DATE
JOB: BRIDGE 50S	JPF	1-01
I 89 OVER U.S. ROUTE 2	CHKD BY	EJ.
MIDDLESEX-BOLTON VT	APPROV BY	
	Q.A.	

CUSTOMER: WINTER SET, INC.

CASCO BAY STEEL STRUCTURES, INC.
75 SPRING HILL ROAD SACO, MAINE 04072
PHONE (207) 282-7360 FAX (207) 282-1179

JOB NO. 127-50S
DRG. NO. DS1