


I-91 NORTHBOUND  
MM 126.75 RT & LT

NOT TO SCALE

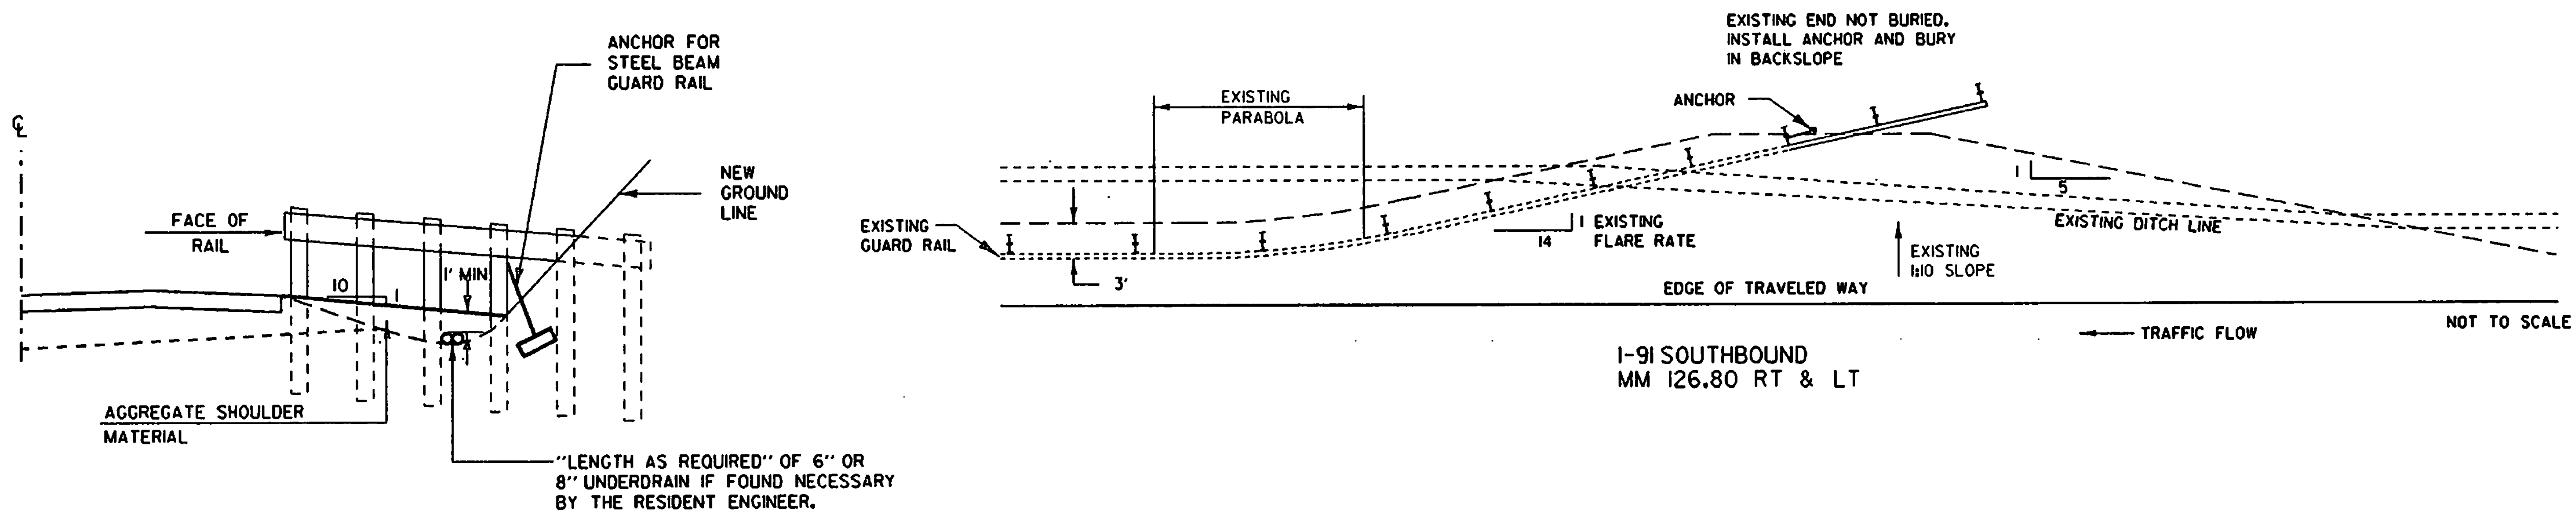

I-91 SOUTHBOUND  
MM 126.80 RT & LT

NOT TO SCALE

**BURIED GUARD RAIL  
END DETAIL**

NOT TO SCALE

PROJECT: <b>STATEWIDE GUARDRAIL</b>	PROJECT NO.: <b>IMG GDRL(1)</b>
DESIGN FILE NAME: sqdb/95a376/d0376.dgn	PLOT DATE: 17-SEP-1996
IPARM FILE NAME: da376gr3.l	SURVEY DATE: n/a
SURVEYED BY: n/a	DRAWN BY: sqdb/rev. jfg
SQUAD LEADER: bt nyqulet	SHEET: 17 OF 28