




VT 104 TYPICAL

FOR TRAVELWAY AND SHOULDERS:
 3 1/2'' BITUMINOUS CONCRETE PAVEMENT
 (1 1/2'' TYPE III S OVER 2'' TYPE II S) (PG 64-34)
 4 1/2'' BITUMINOUS CONCRETE PAVEMENT (TYPE I S) (PG 64-34)
 24'' SUBBASE OF ~~DENSE GRADED CRUSHED STONE~~ GRAVEL

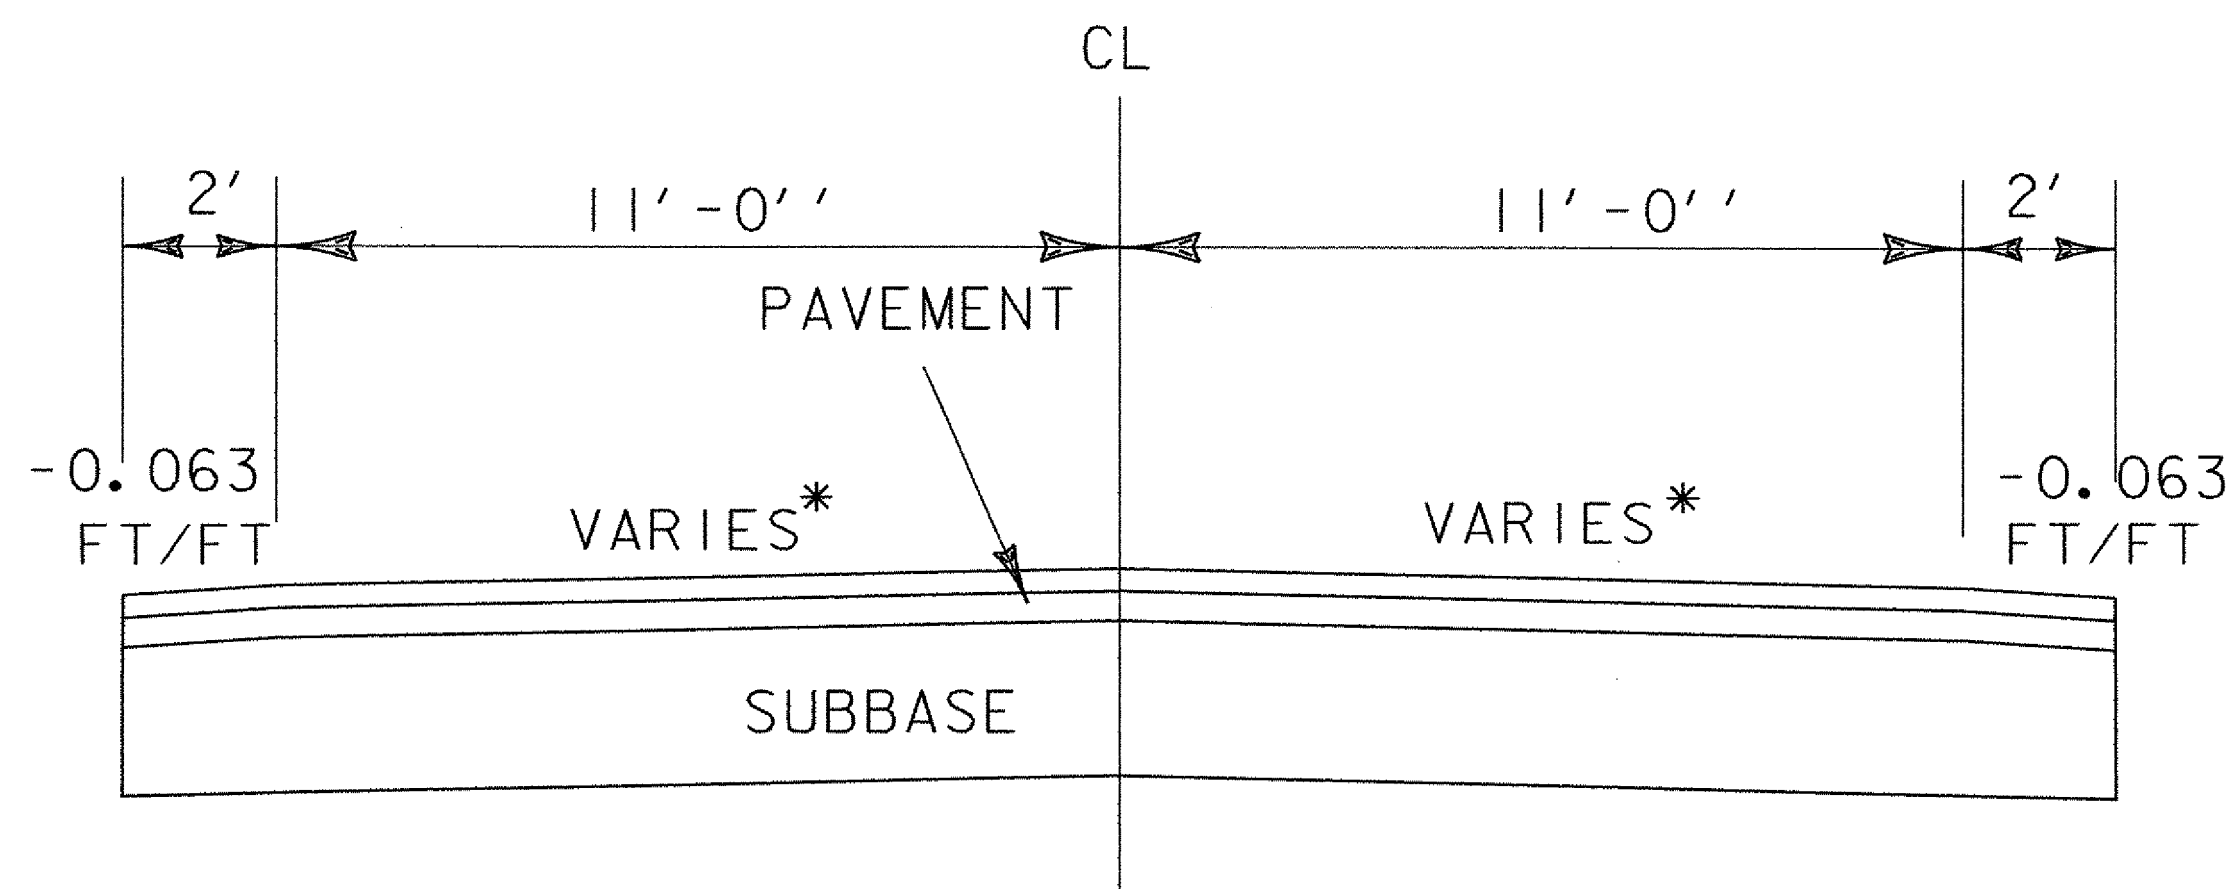

* REFER TO THE CROSS SECTIONS

VT 104 POT 106+00 =
 VT 105 POT 205+00

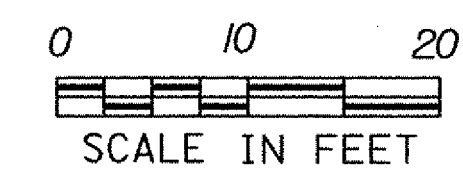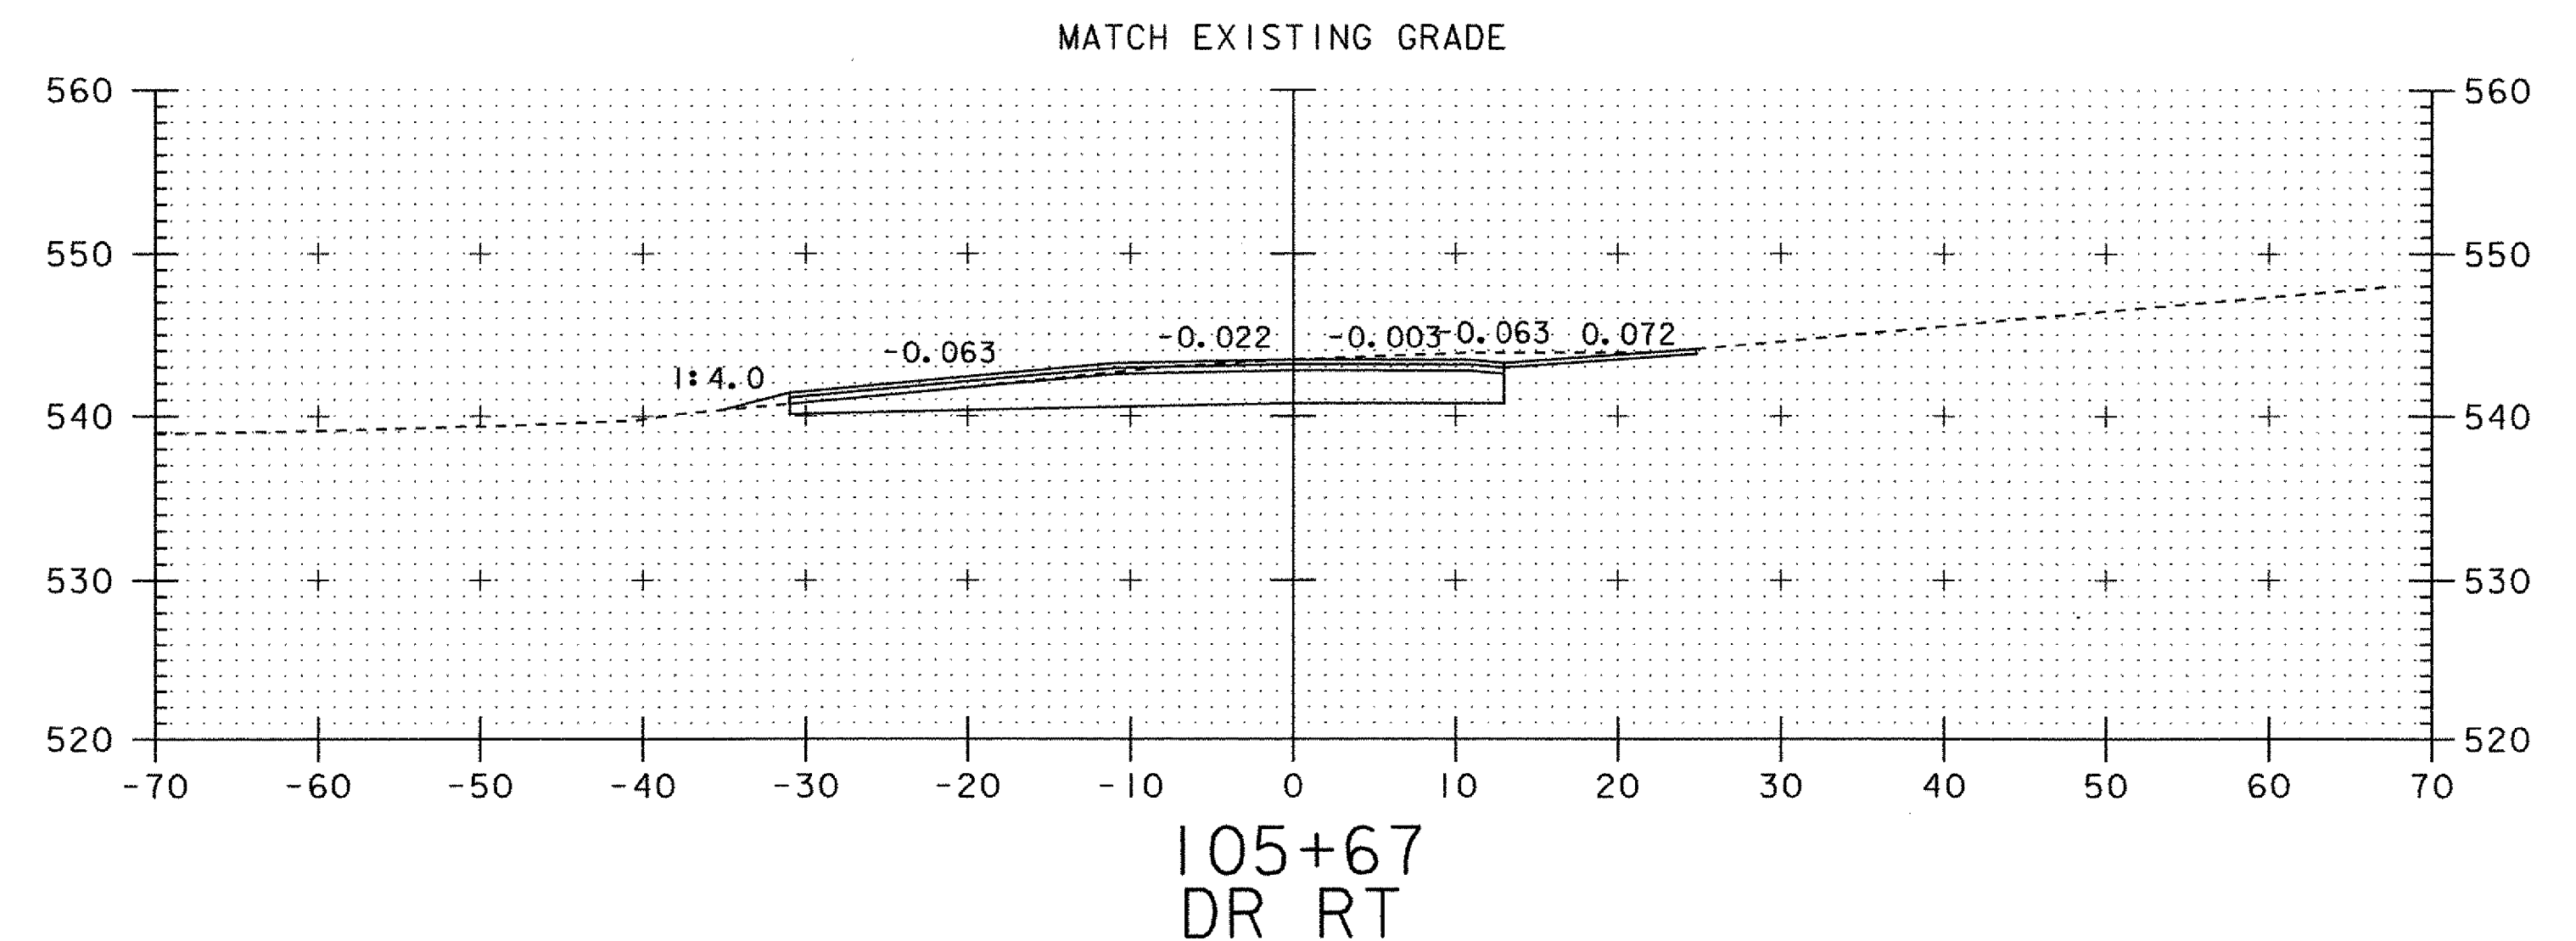

PROJECT: FAIRFAX-FAIRFIELD-ST. ALBANS	PROJECT NO.: IM 089-3(27)
DESIGN FILE NAME: /87A007B/DESIGN/DA007XS2.DGN	PLOT DATE: 22-SEP-2000
IPARM FILE NAME: DA007TXLJ	SURVEY DATE: 9/90
SURVEYED BY: R. MOREAU	DRAWN BY: SQUAD B
SQUAD LEADER: DELLA SANTA	SHEET: 40A OF 370