



CONSTRUCTION ITEMS
COMMON EXCAVATION
GRANULAR BORROW
BITUMINOUS CONCRETE PAVEMENT

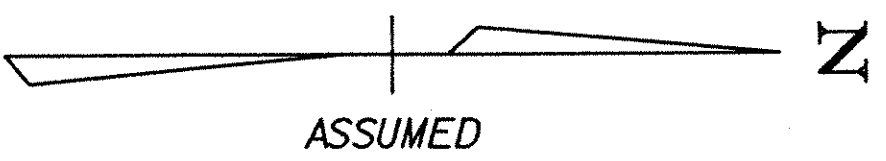

US 7 SOUTH
TO
ST. ALBANS CITY

US 7 NORTH
TO
SWANTON

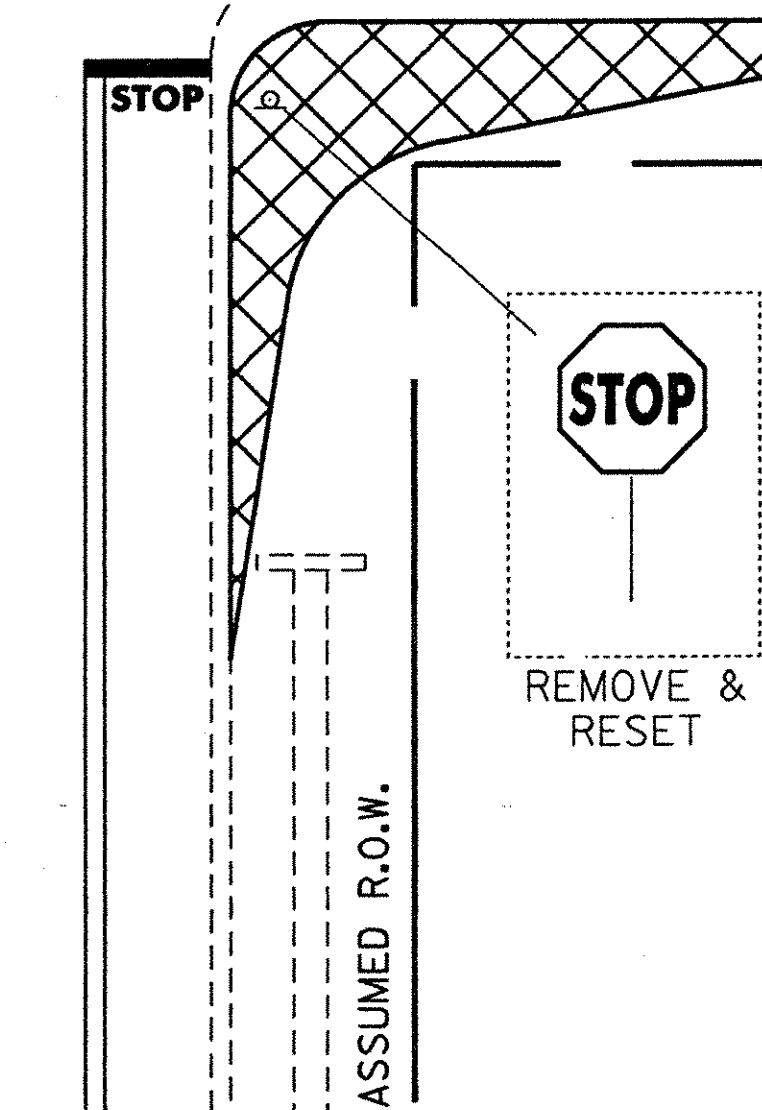


PHASE A

EXCAVATE CROSS-HATCHED AREA AS SHOWN STAYING WITHIN RIGHT-OF-WAY.
CONSTRUCT APRON USING 2' OF GRANULAR BORROW
AND 6" OF BITUMINOUS CONCRETE PAVEMENT.

REMOVE AND RESET STOP SIGN, MOVE STOP BAR
AND LETTERS AS SHOWN IN PHASE B

AT THE TERMINATION OF THE TEMPORARY DETOUR,
THE CONSTRUCTED AREA SHALL BE RETURNED TO ITS ORIGINAL
CONDITION. THE STOP SIGN SHALL BE REMOVED AND RESET,
AND THE STOP BAR AND SYMBOLS MOVED. THE AREA SHALL
BE TOPSOILED AND SEEDED.

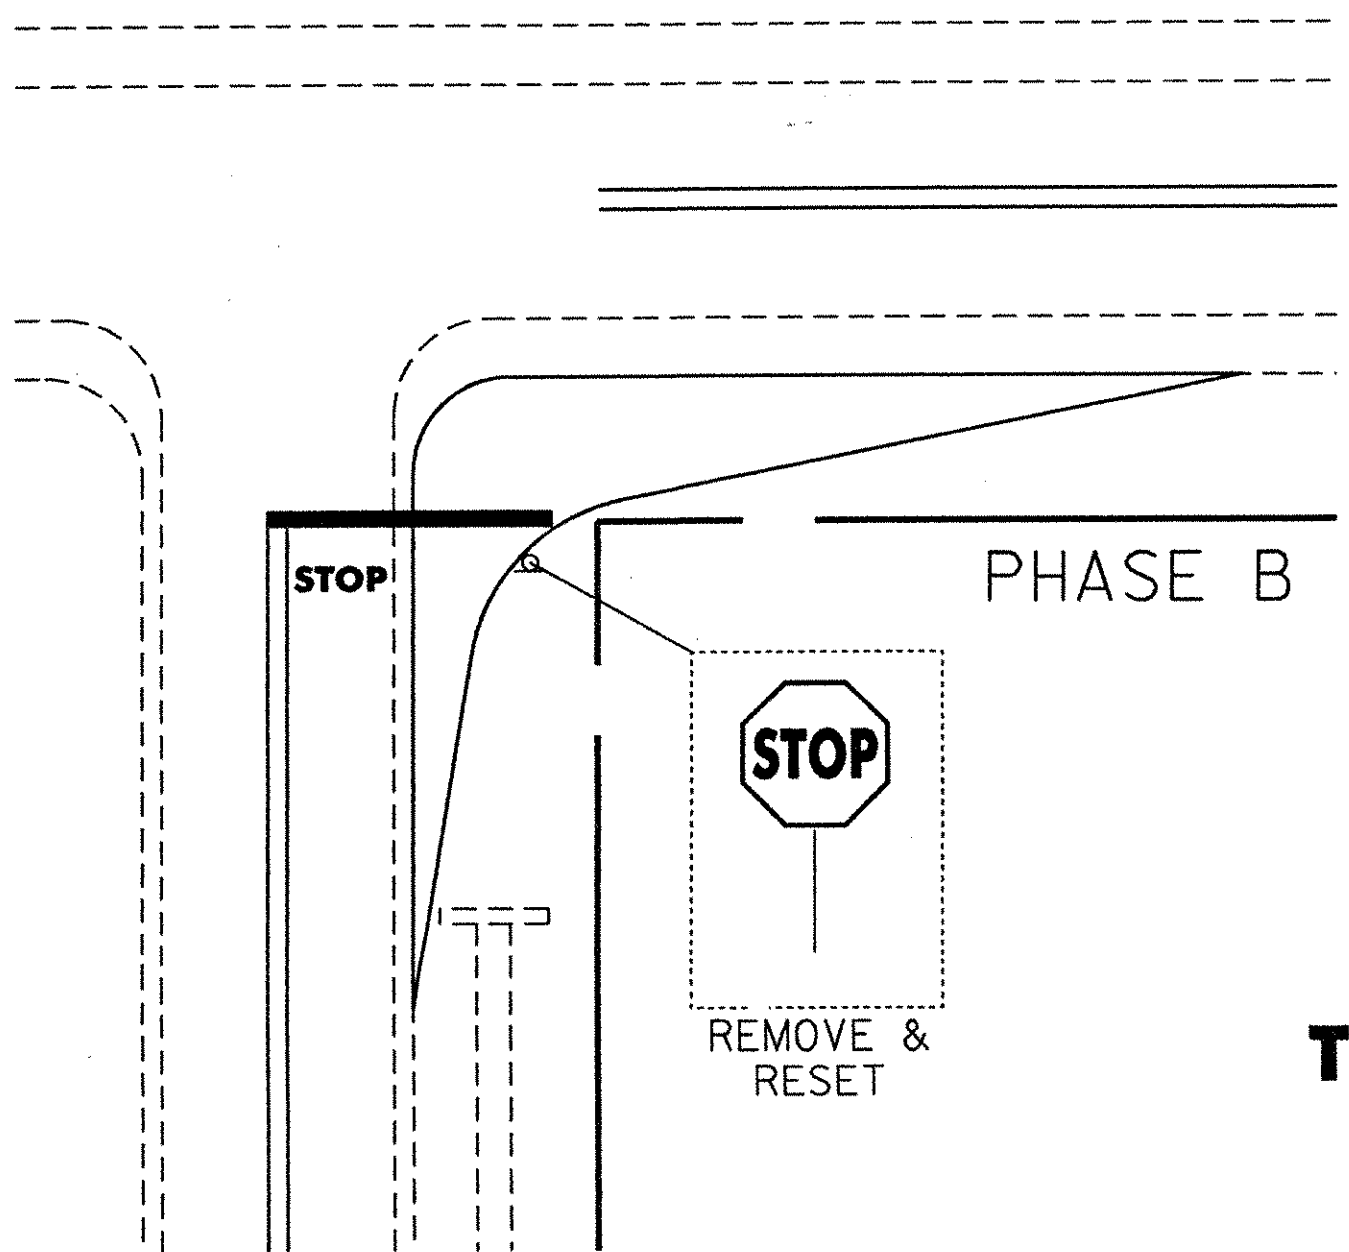

TEMPORARY SHOULDER CONSTRUCTION
FOR DETOUR AT VT 105 AND US 7

0 20 40
SCALE IN FEET

PROJECT NAME:	FAIRFAX-FAIRFIELD-ST.ALBA	PLOT DATE:	13-MAR-2000
PROJECT NUMBER:	IM 089-3(27)	DRAWN BY:	J gruchacz
FILE NAME:	J:/sqda/2dl057.dgn	CHECKED BY:	
PROJECT LEADER:	blondin	SHEET	41 OF 370
DESIGNED BY:	J gruchacz		
te076shlj			