


SOUTHBOUND GRADE PROFILE ALONG MEDIAN SIDE (REFER TO TYPICAL SHEET)
STA. 3317+00 - 3333+00

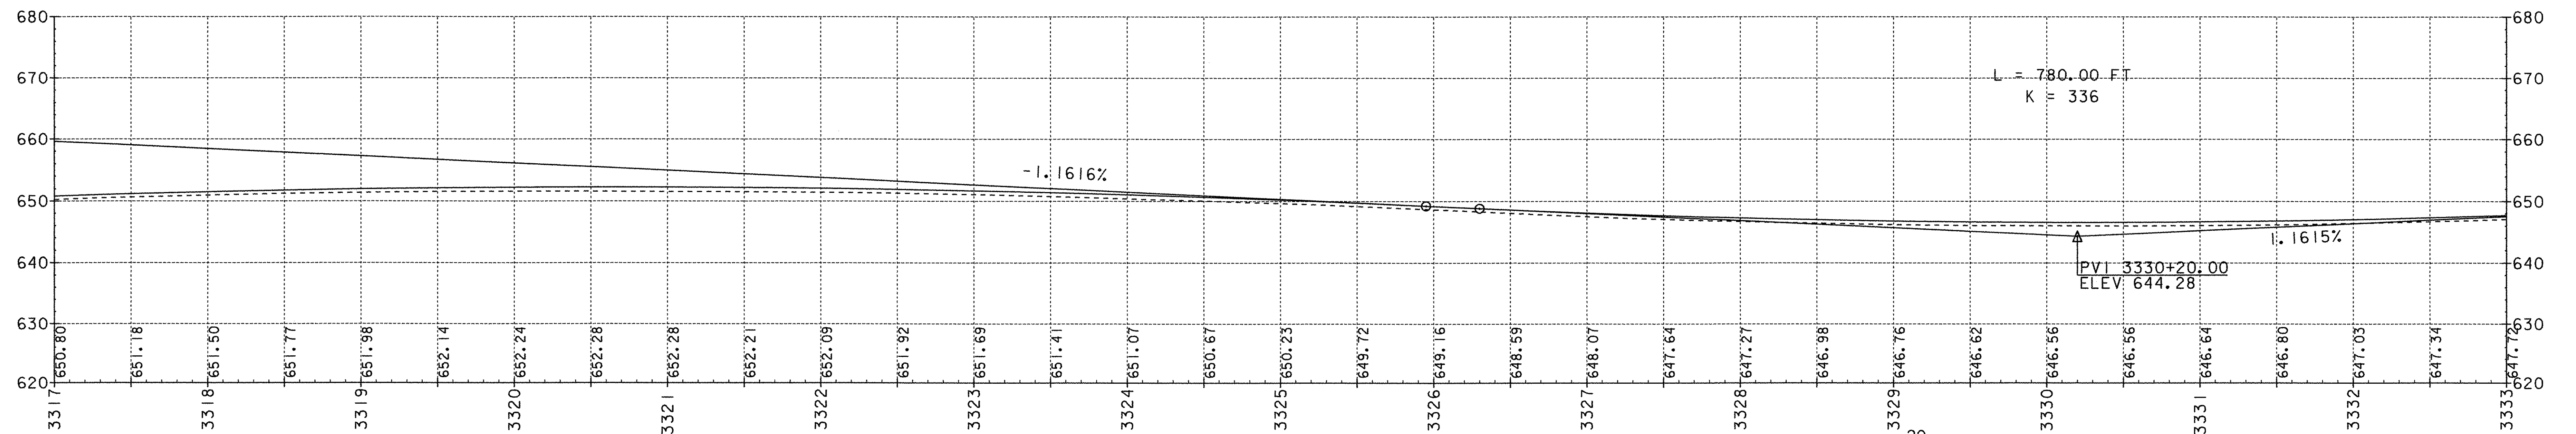

NORTHBOUND GRADE PROFILE ALONG MEDIAN SIDE (REFER TO TYPICAL SHEET)
STA. 3317+00 - 3333+00

DATUM
 VERTICAL NAVD88
 HORIZONTAL NAD83(92)

SCALES IN FEET



PROJECT: FAIRFAX - FAIRFIELD - ST. ALBANS		PROJECT NO.: IM 089-3(27)
DESIGN FILE NAME:	/87A007B/DESIGN/DA007XSL.DGN	PLOT DATE: 04-OCT-2000
IPARM FILE NAME:	DA007P04	SURVEY DATE: 6/98
SURVEYED BY:	ORVIS	DRAWN BY: SQUAD B
SQUAD LEADER:	DELLA SANTA	SHEET: 56 OF 370