



**SOUTHBOUND GRADE PROFILE ALONG MEDIAN SIDE (REFER TO TYPICAL SHEET)**  
**STA. 3381+00 - 3397+00**

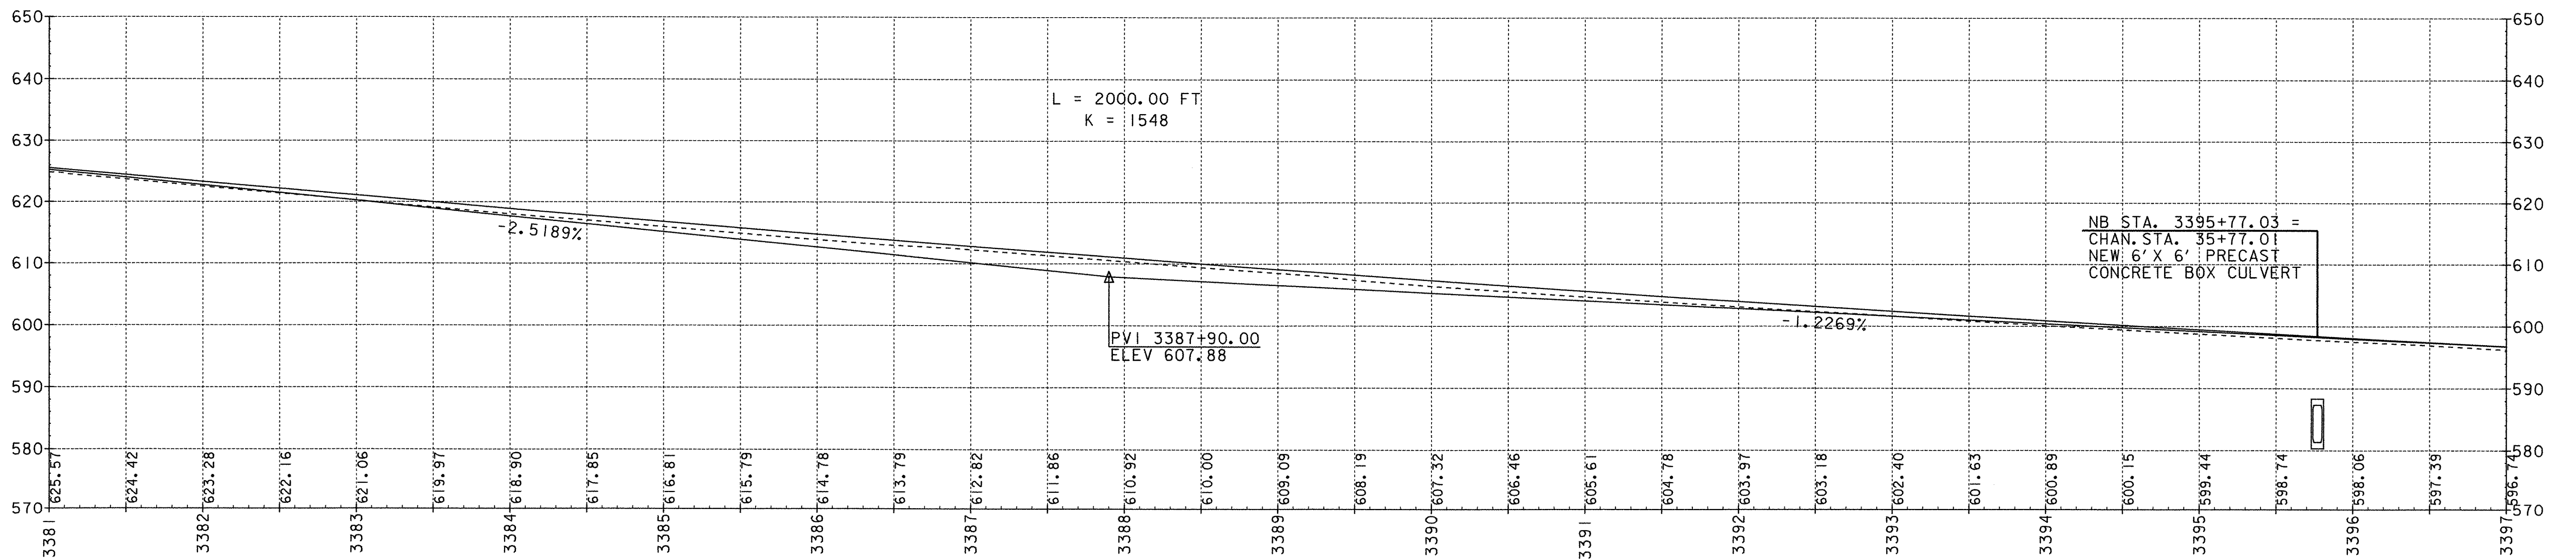

**NORTHBOUND GRADE PROFILE ALONG MEDIAN SIDE (REFER TO TYPICAL SHEET)**  
**STA. 3381+00 - 3397+00**

**DATUM**  
 VERTICAL NAVD88  
 HORIZONTAL NAD83(92)

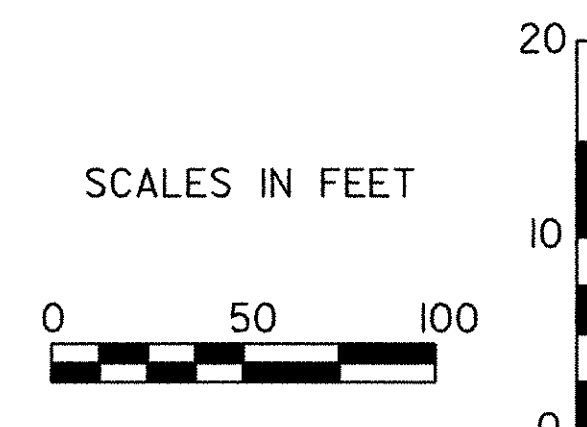

PROJECT:	FAIRFAX - FAIRFIELD - ST. ALBANS	PROJECT NO.:	IM 089-3(27)
DESIGN FILE NAME:	/87A007B/DESIGN/DA007XSLDGN	PLOT DATE:	04-OCT-2000
IPARM FILE NAME:	DA007P08	SURVEY DATE:	6/98
SURVEYED BY:	ORVIS	DRAWN BY:	SQUAD B
SQUAD LEADER:	DELLA SANTA	SHEET:	64 OF 370