

DATUM

| | |
|------------|-----------|
| VERTICAL | NAVD88 |
| HORIZONTAL | NAD83(92) |

NB CURVE #3 DATA

Δ = 162°36'58.24" RT.
 D = 1'
 R = 5729.58'
 T = 836.68'
 L = 1661.62'
 E = 60.77'
 BANK = 0.026 FT / FT

STEEL BEAM GUARD RAIL (NORTHBOUND)


3420+42.4 LT - 3422+42.4 LT
 3425+02.5 LT - 3425+77.5 LT
 3420+22.8 RT (FROM RAMP A) - 3422+47.8 RT
 3424+93.3 RT - 3429+00 RT

GUARD RAIL APPROACH SECTION, NETC 2 RAIL (NORTHBOUND)

3422+42.4 LT - 3422+71.8 LT
 3422+47.8 RT - 3422+77.3 RT
 3424+73.1 LT - 3425+02.5 LT
 3424+63.9 RT - 3424+93.3 RT

BRIDGE RAILING - NETC 2 RAIL (NORTHBOUND)

3422+71.8 LT - 3424+73.1 LT
 3422+77.3 RT - 3424+63.9 RT

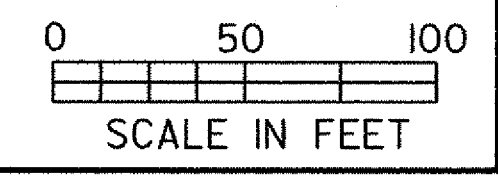

| | | | |
|--|-------------------------------|----------------------------------|--|
| PROJECT: FAIRFAX - FAIRFIELD - ST. ALBANS | | PROJECT NO.: IM 089-3(27) | |
| DESIGN FILE NAME: /8TA007B/DESIGN/DA007NULDGN | PLOT DATE: 23-AUG-2000 | | |
| IPARM FILE NAME: DA007LIO | SURVEY DATE: 6/98 | | |
| SURVEYED BY: ORVIS | DRAWN BY: SQUAD B | | |
| SQUAD LEADER: DELLA SANTA | SHEET: 67 OF 370 | | |