



**SOUTHBOUND GRADE PROFILE ALONG MEDIAN SIDE (REFER TO TYPICAL SHEET)**  
**STA. 3429+00 - 3445+00**

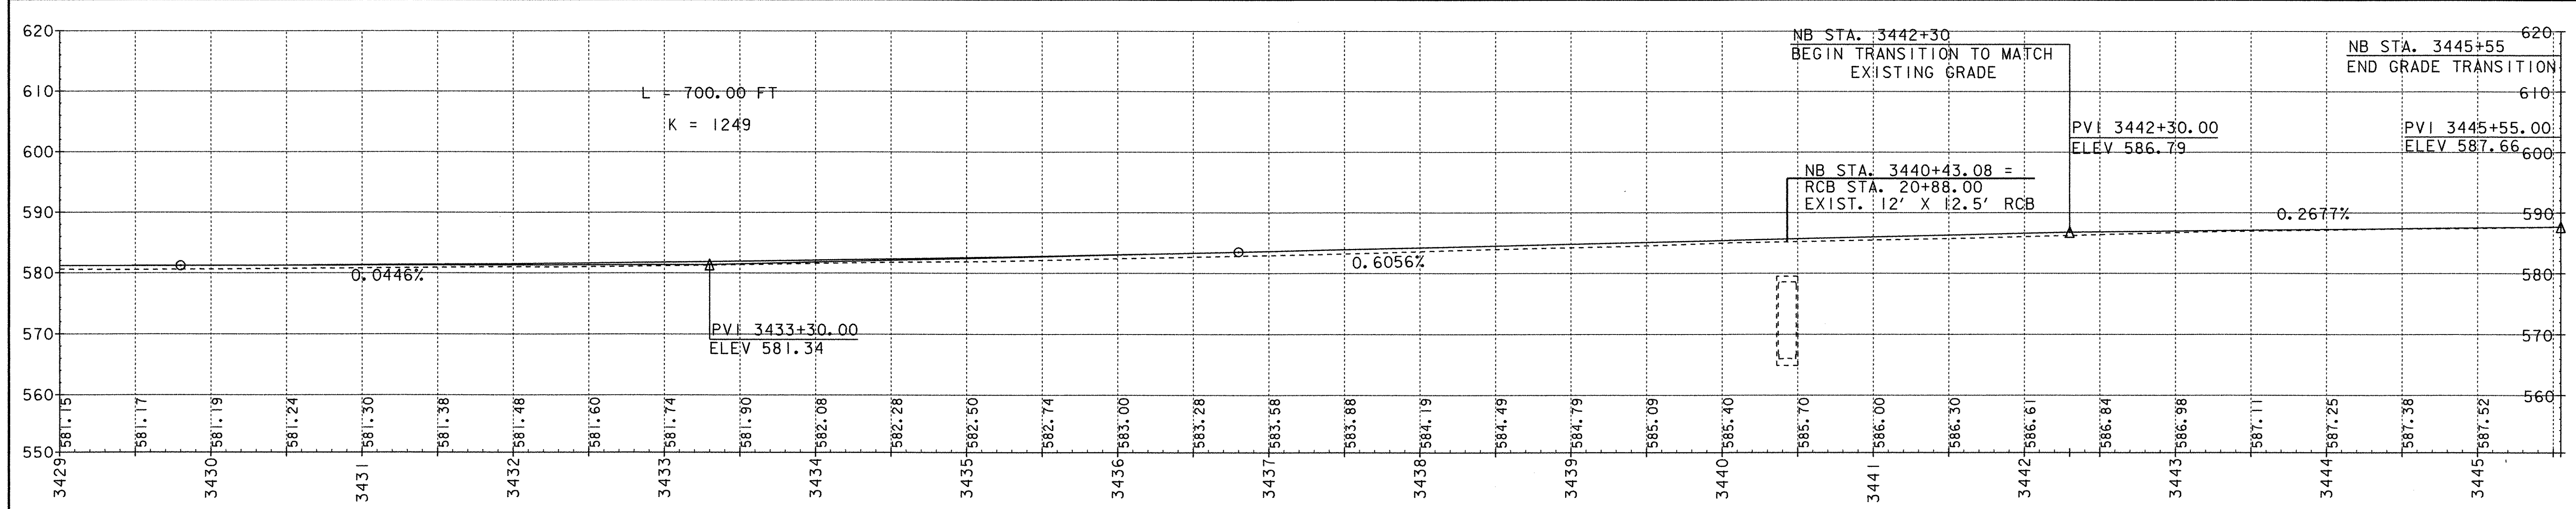

**NORTHBOUND GRADE PROFILE ALONG MEDIAN SIDE (REFER TO TYPICAL SHEET)**  
**STA. 3429+00 - 3445+55**

DATUM  
 VERTICAL NAVD88  
 HORIZONTAL NAD83(92)

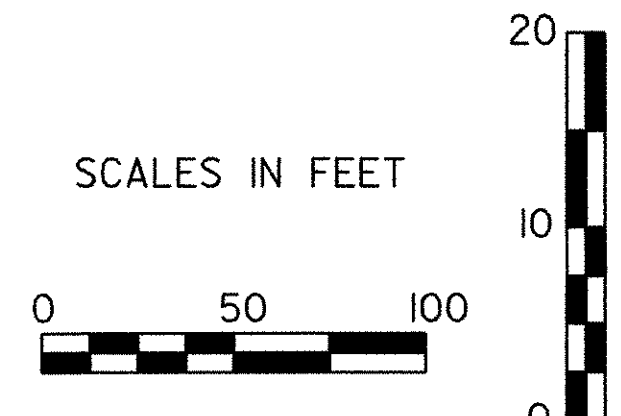

PROJECT:	FAIRFAX - FAIRFIELD - ST. ALBANS	PROJECT NO.:	IM 089-3(27)
DESIGN FILE NAME:	/87A007B/DESIGN/DA007XSLDGN	PLOT DATE:	04-OCT-2000
IPARM FILE NAME:	DA007PII	SURVEY DATE:	6/98
SURVEYED BY:	ORVIS	DRAWN BY:	SQUAD B
SQUAD LEADER:	DELLA SANTA	SHEET:	70 OF 370