


$$\begin{aligned}\Delta &= 71^{\circ}52'-28.05'' \text{ RT.} \\ D &= 10^{\circ} \\ R &= 572.96' \\ T &= 415.32' \\ L &= 718.74' \\ E &= 134.69'\end{aligned}$$

RAMP C 11+75
BEGIN RAMP C CONSTRUCTION

RAMP C PC 10+00.64


STONE FILL, TYPE II
(FOR SLOPE PROTECTION)
RAMP C 14+25 RT-14+75 RT

CHAIN LINK FENCE, 6 FEET
RAMP C 8+28 RT-16+00 RT

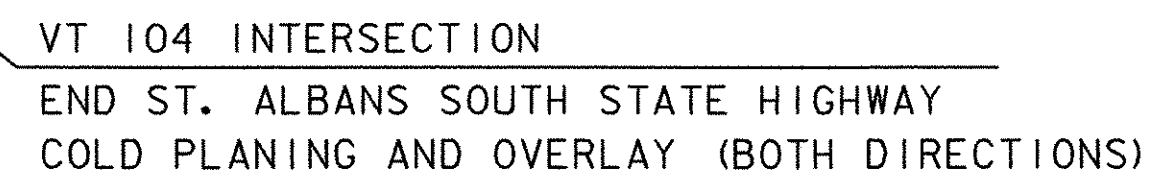

RAMP D MM 0.327
END RAMP D COLD PLANING AND OVERLAY

DATUM	
VERTICAL	NAVD88
HORIZONTAL	NAD83(92)

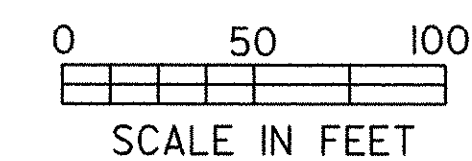

RAMP C 8+28 - 16+00

PROJECT:	FAIRFAX - FAIRFIELD - ST. ALBANS	PROJECT NO.:	IM 089-3(27)
DESIGN FILE NAME:	/78A007B/DESIGN/DA007NUI.DGN	PLOT DATE:	18-AUG-2000
IPARM FILE NAME:	DA007I3	SURVEY DATE:	6/98
SURVEYED BY:	ORVIS	DRAWN BY:	SQUAD B
SQUAD LEADER:	DELLA SANTA	SHEET:	72 OF 370