



BRIDGE 87S DECK REINFORCING PLAN

SCALE: 1/4" = 1'-0"

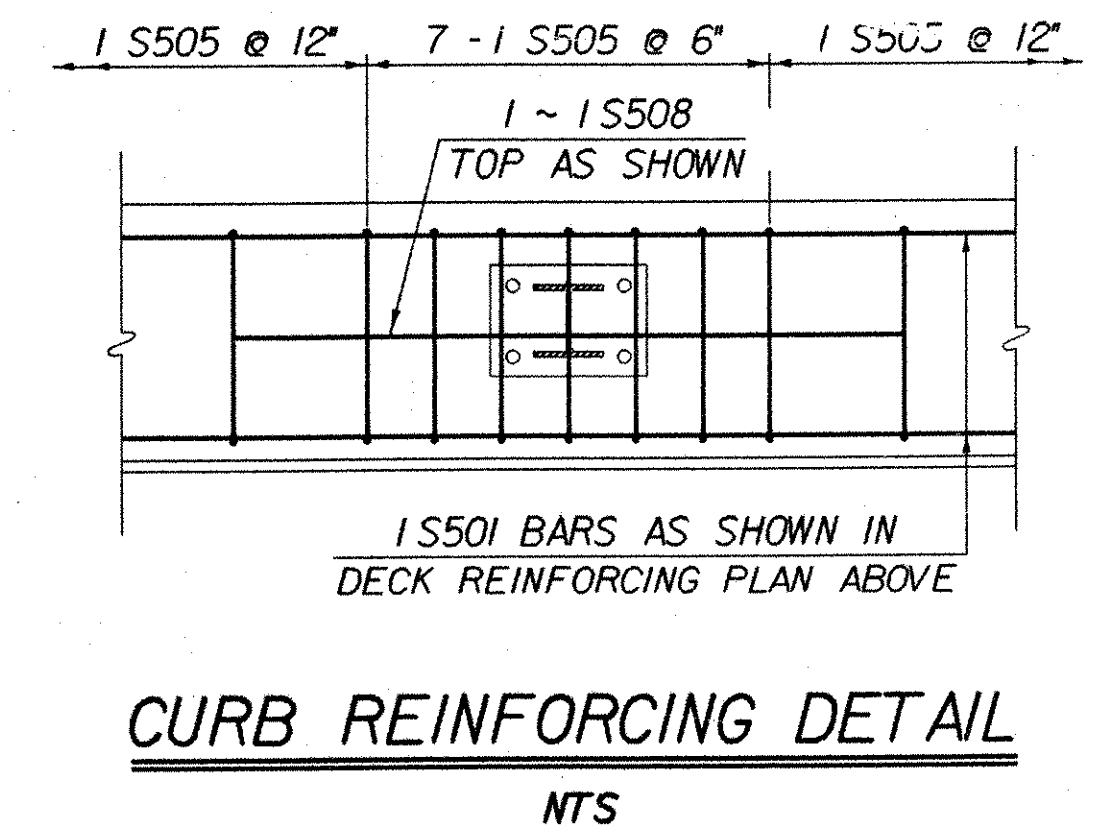

CURB REINFORCING DETAIL
NTS

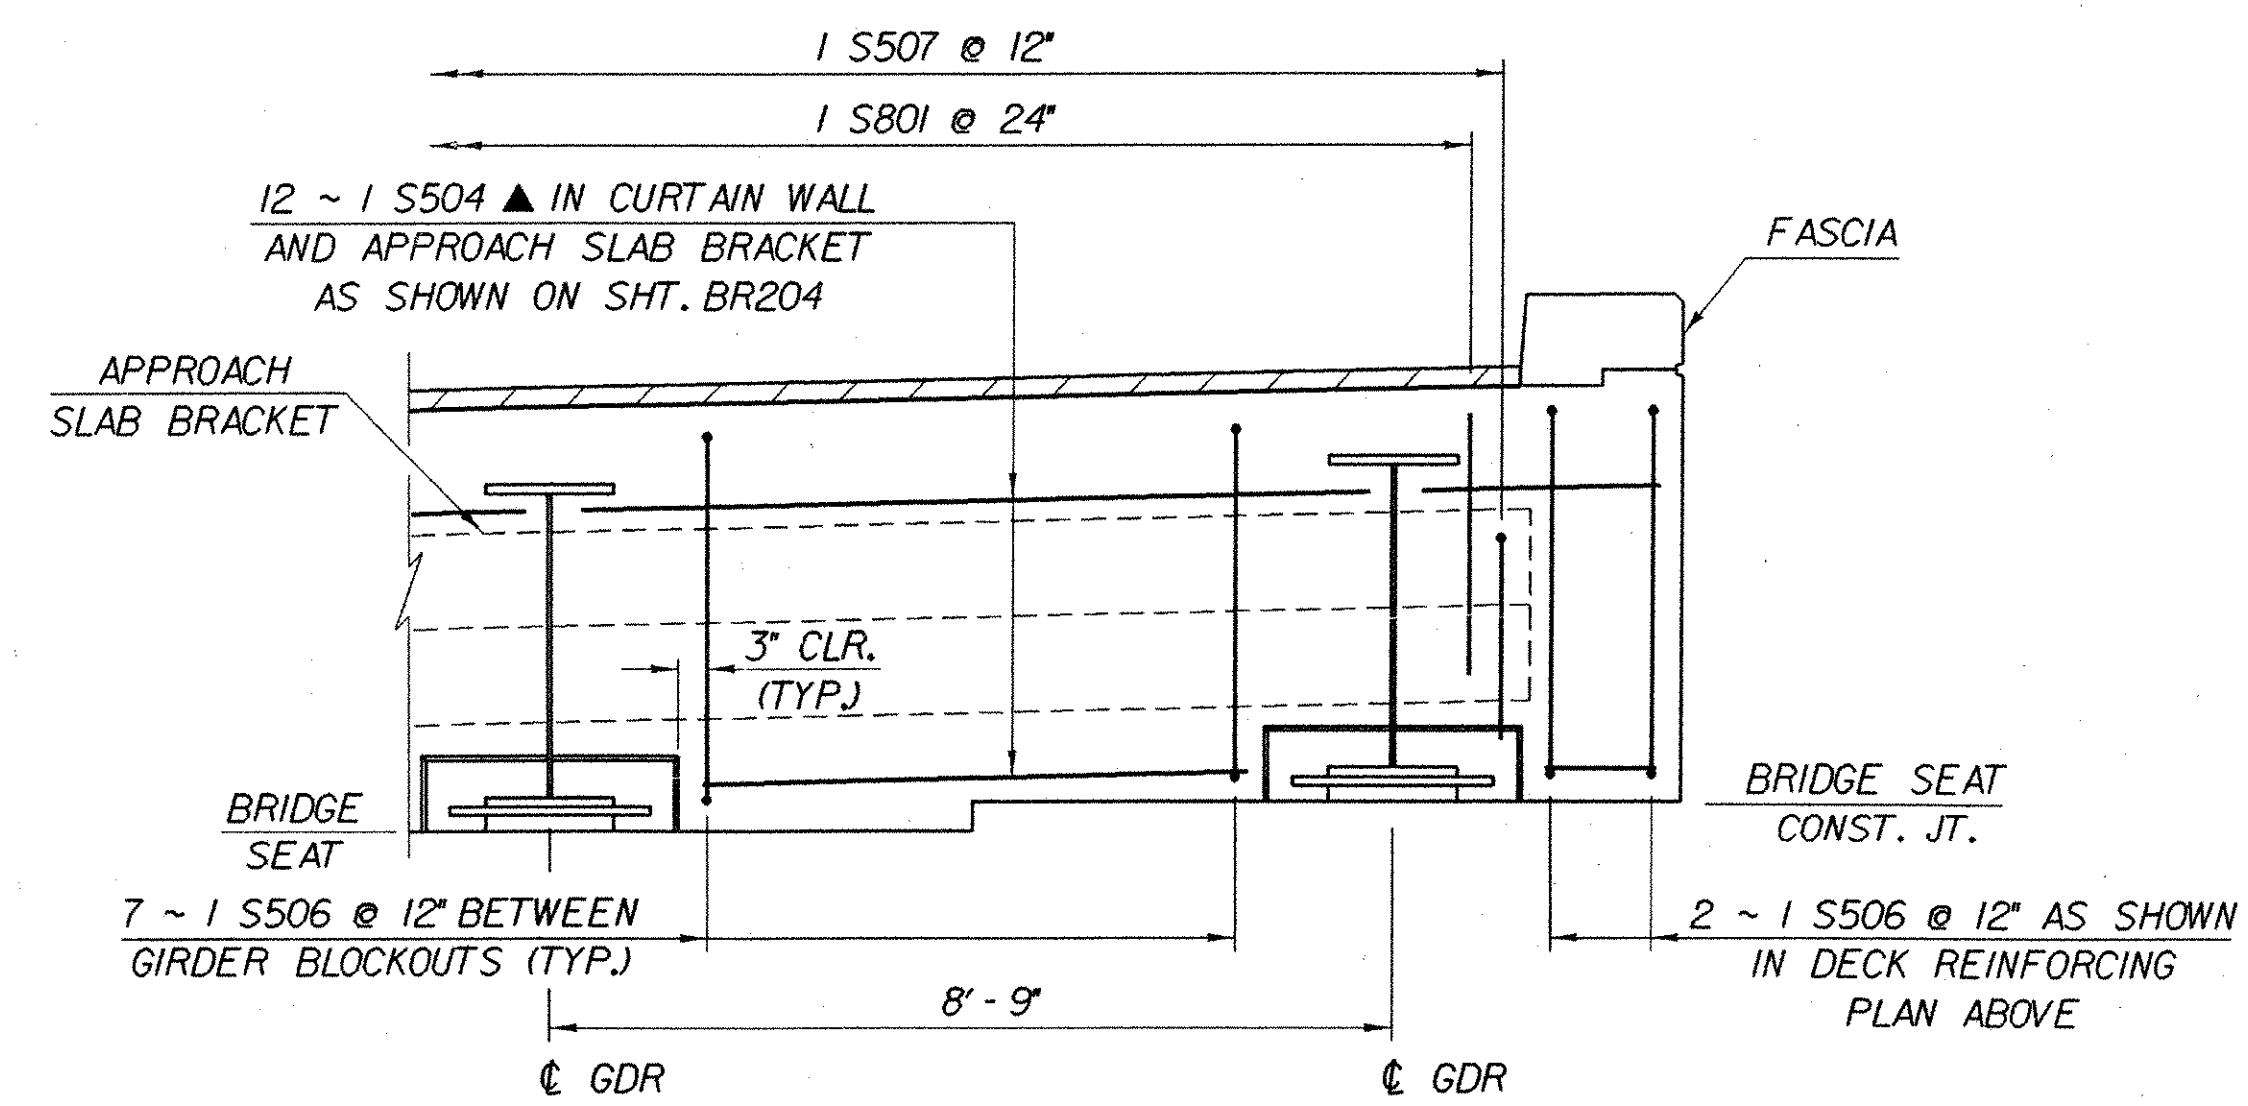

SECTION A - A
SCALE: 1/2" = 1'-0"

IMPORTANT NOTE: BRIDGE FINISHED GRADES ARE CENTERLINE GRADES.

STATE OF VERMONT AGENCY OF TRANSPORTATION	
Town Of FAIRFAX- FAIRFIELD-ST. ALBANS	Bridge No. 87 S
Highway No. 1 - 89	Log Sta. Surv. Sta.
1 - 89 OVER VT 104	
87S DECK REINFORCING PLAN	
Designed By M.LOZIER	Drawn By K.CHISHOLM
Checked By G.ROY	Bridge Design Supervisor R.R.WHITCOMB Date 11/99
PROJECT FAIRFAX- FAIRFIELD-ST. ALBANS	PROJECT NO. 1 M 089 - 3 (27)
I.G.C. Info. 96a056Structures\sa056sp2.dgn	sa056sp5j
Bridge Sheet No. BR205	Sheet 83 of 370