



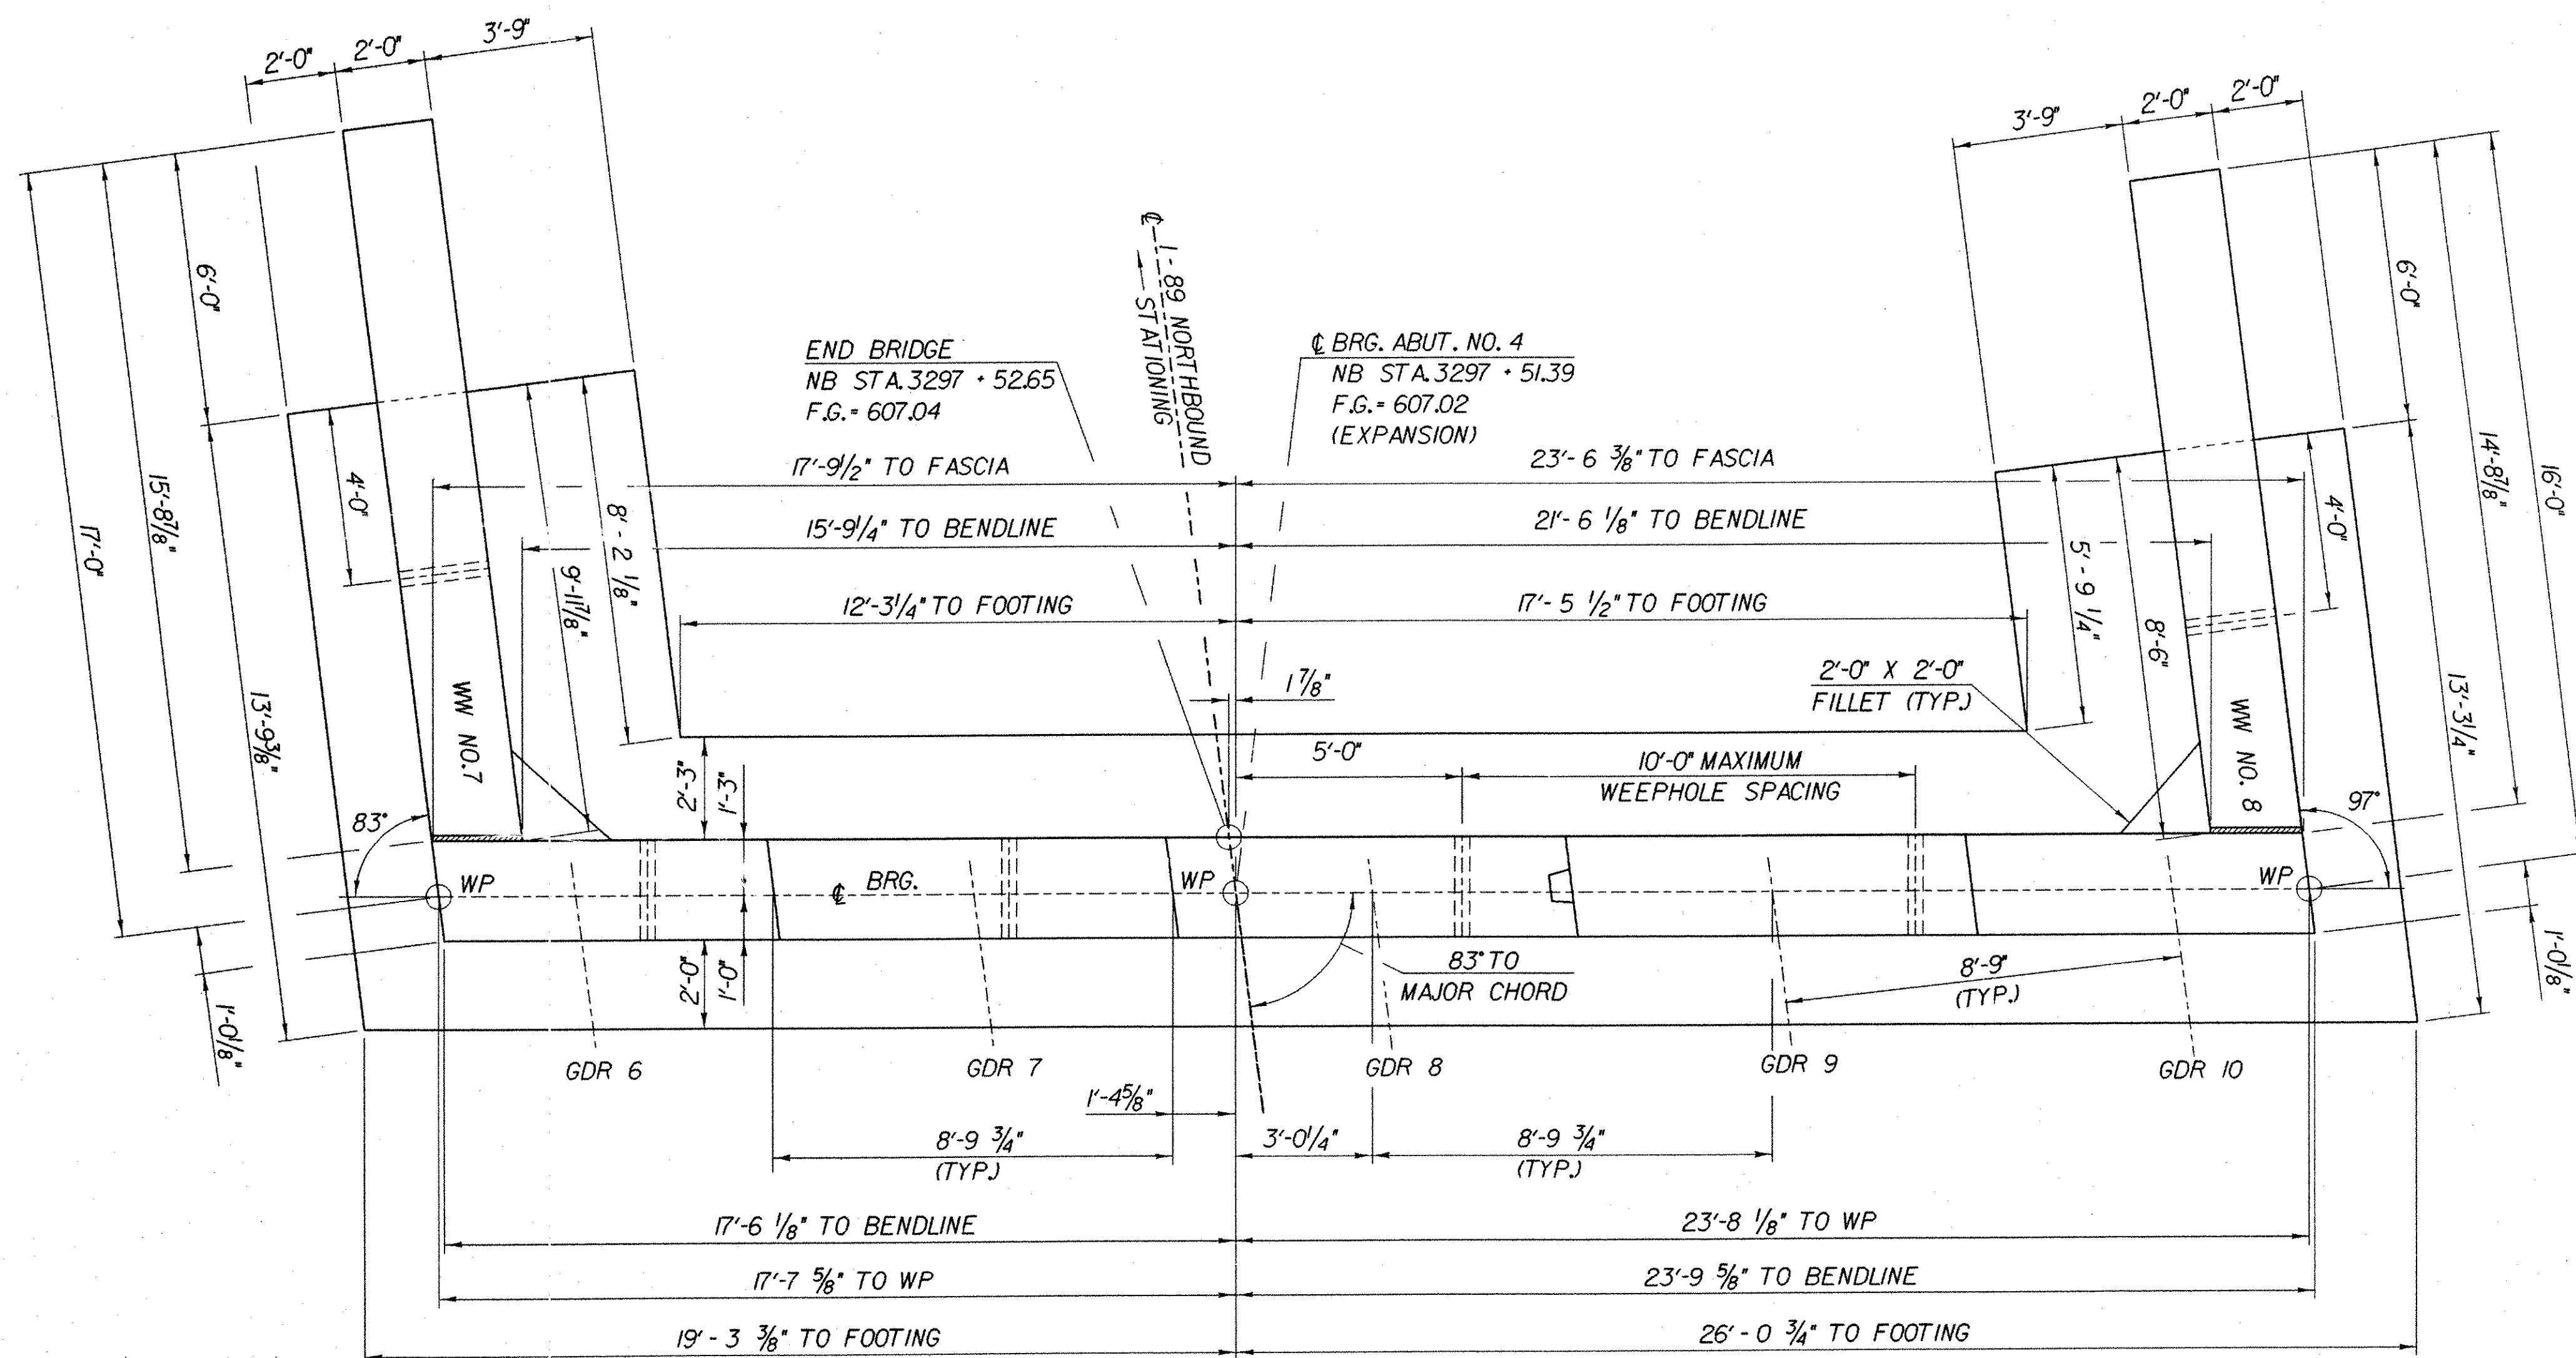

ABUTMENT NO. 4 PLAN

SCALE: $\frac{3}{8}$ " = 1'-0"

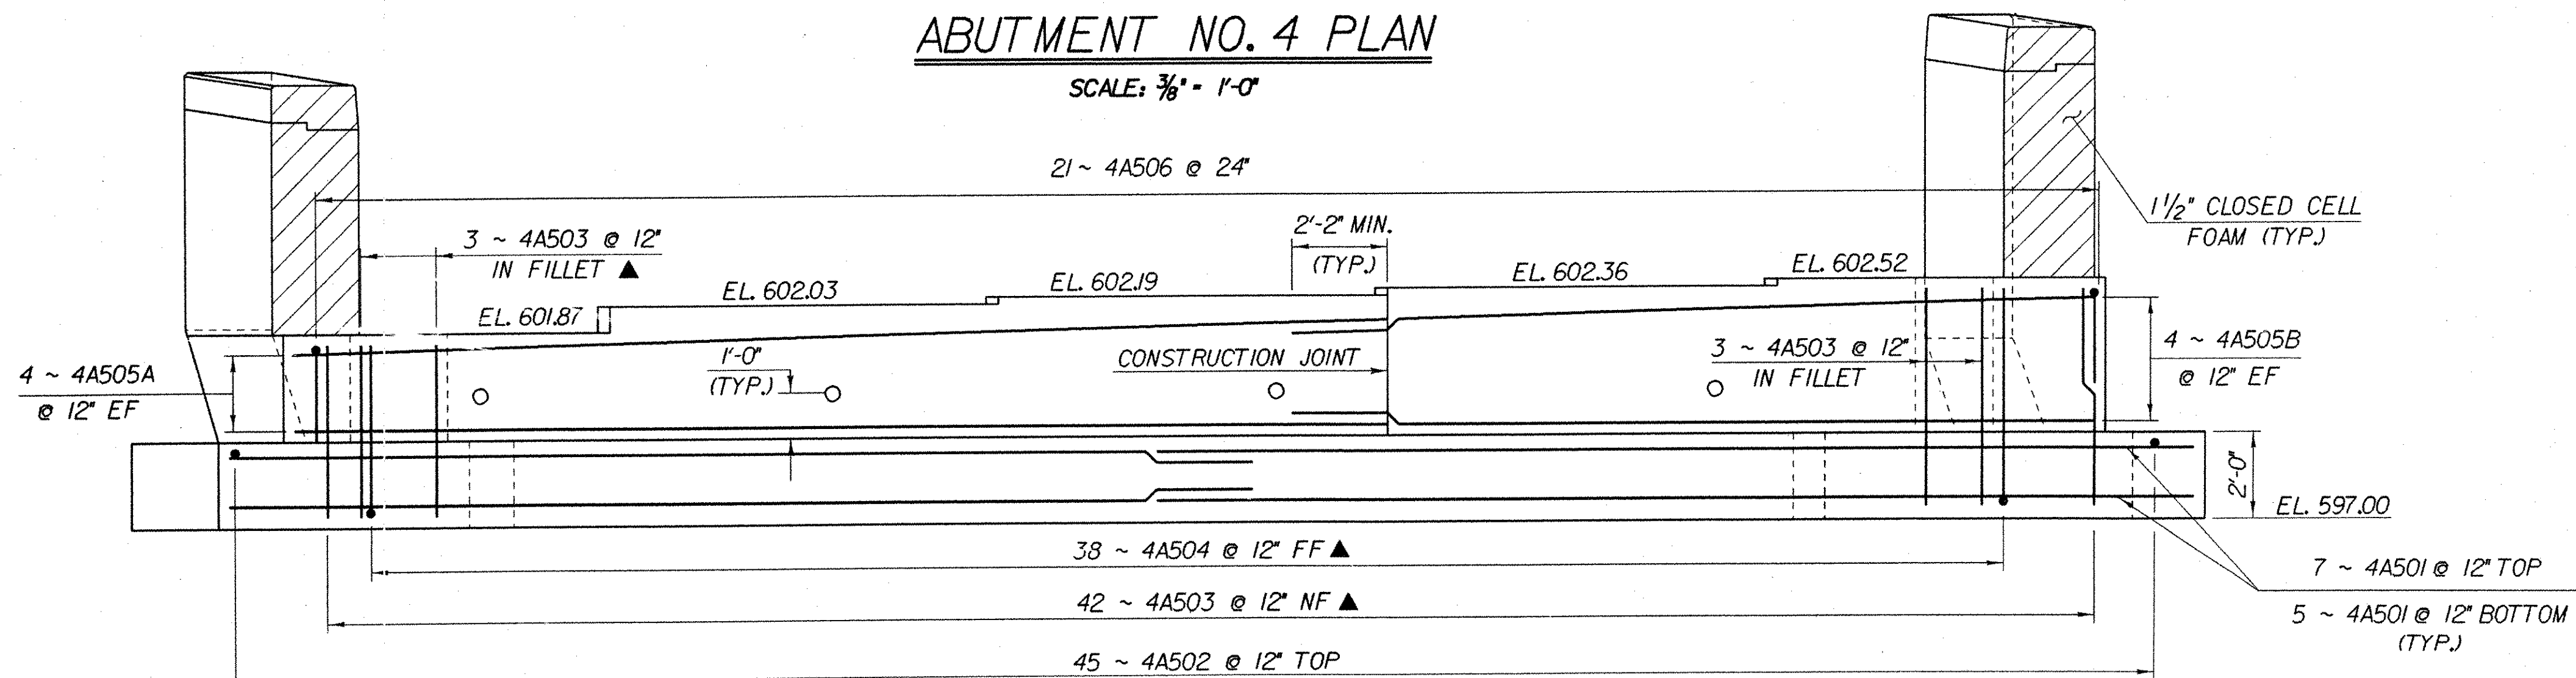

ABUTMENT NO. 4 ELEVATION

SCALE: $\frac{3}{8}$ " = 1'-0"

NOTE:

NF = NEAR FACE
FF = FAR FACE
EF = EACH FACE
▲ = CUT TO FIT IN FIELD
3" CLR. UNLESS OTHERWISE
SPECIFIED ON THE PLANS.

**STATE OF VERMONT
AGENCY OF TRANSPORTATION**

Town Of **FAIRFAX-FAIRFIELD-ST. ALBANS** Bridge No. **87N**
Highway No. **I-89** Log Sta. **1M 089 - 3 (27)**
Surv. Sta. **sa056ab4j**

I-89 OVER VT 104

ABUTMENT NO. 4 DETAILS

Designed By **M. LOZIER** Drawn By **K. CHISHOLM**
Checked By **G. ROY** Date **10/99** Bridge Design Supervisor **R. R. WHITCOMB** Date **11/99**
PROJECT **FAIRFAX-FAIRFIELD-ST. ALBANS** PROJECT NO. **1M 089 - 3 (27)**
I.G.C. Info. **94/106 Structures/j106ab.dgn** **sa056ab4j**
Bridge Sheet No. **BR225** Sheet **103** of **370**

**IMPORTANT NOTE: BRIDGE FINISHED GRADES
ARE CENTERLINE GRADES.**