
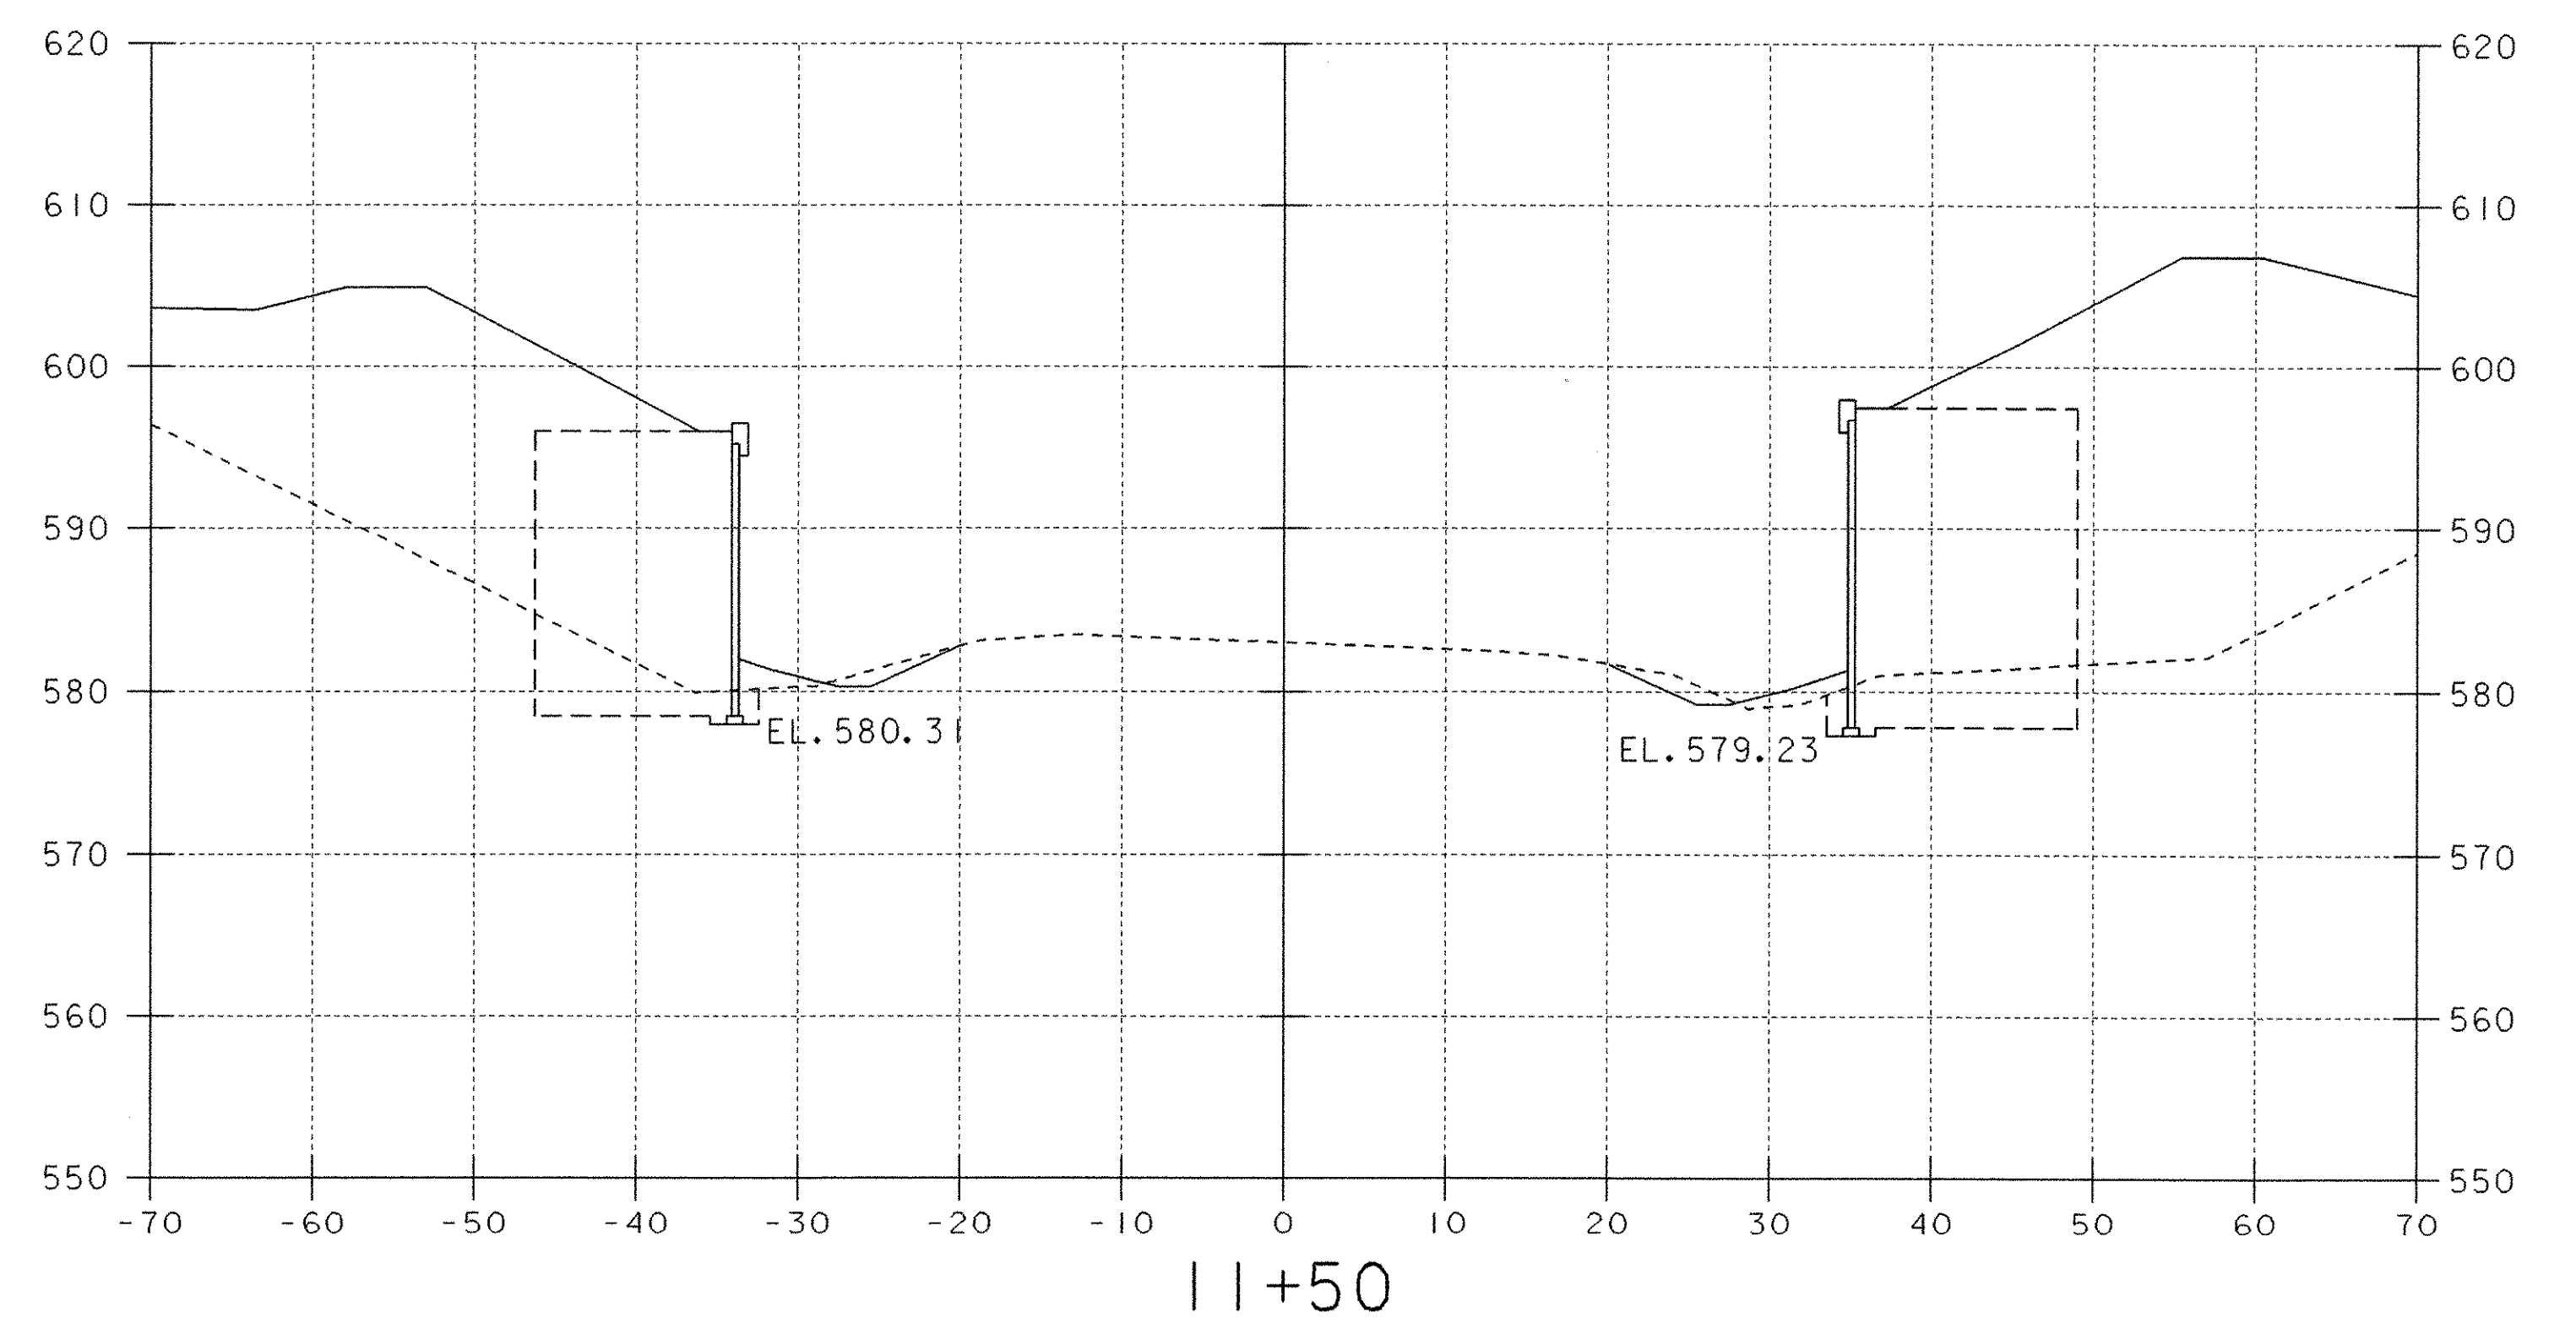
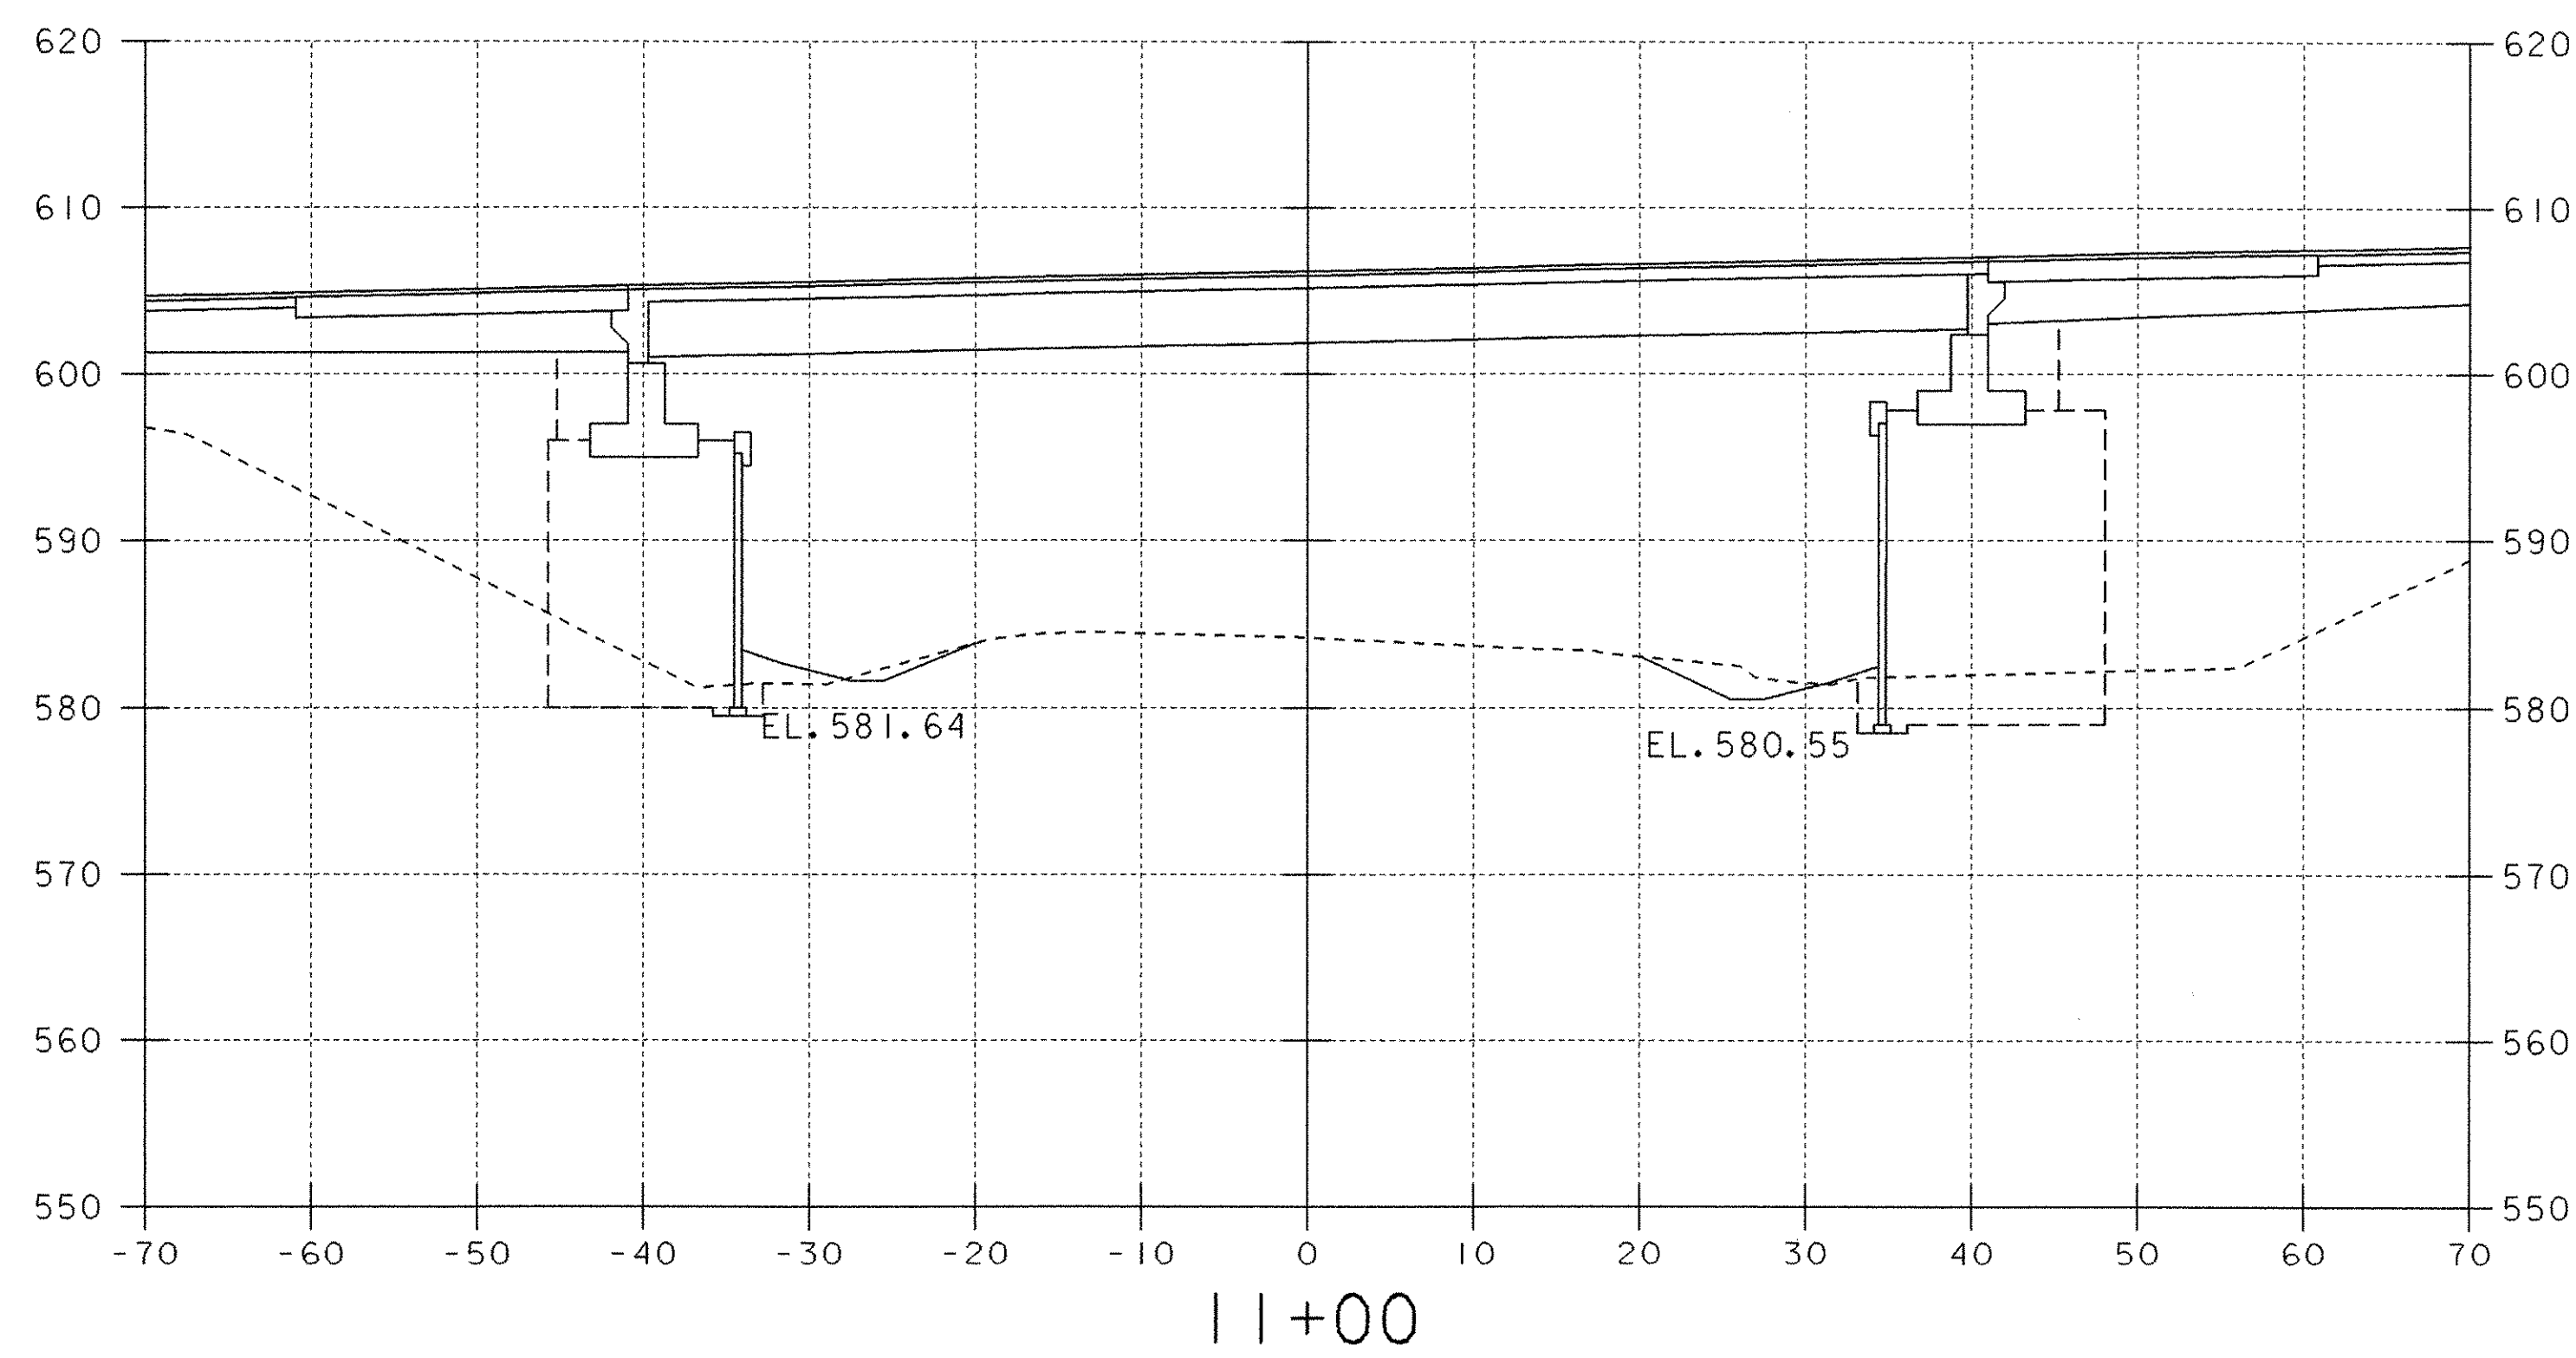
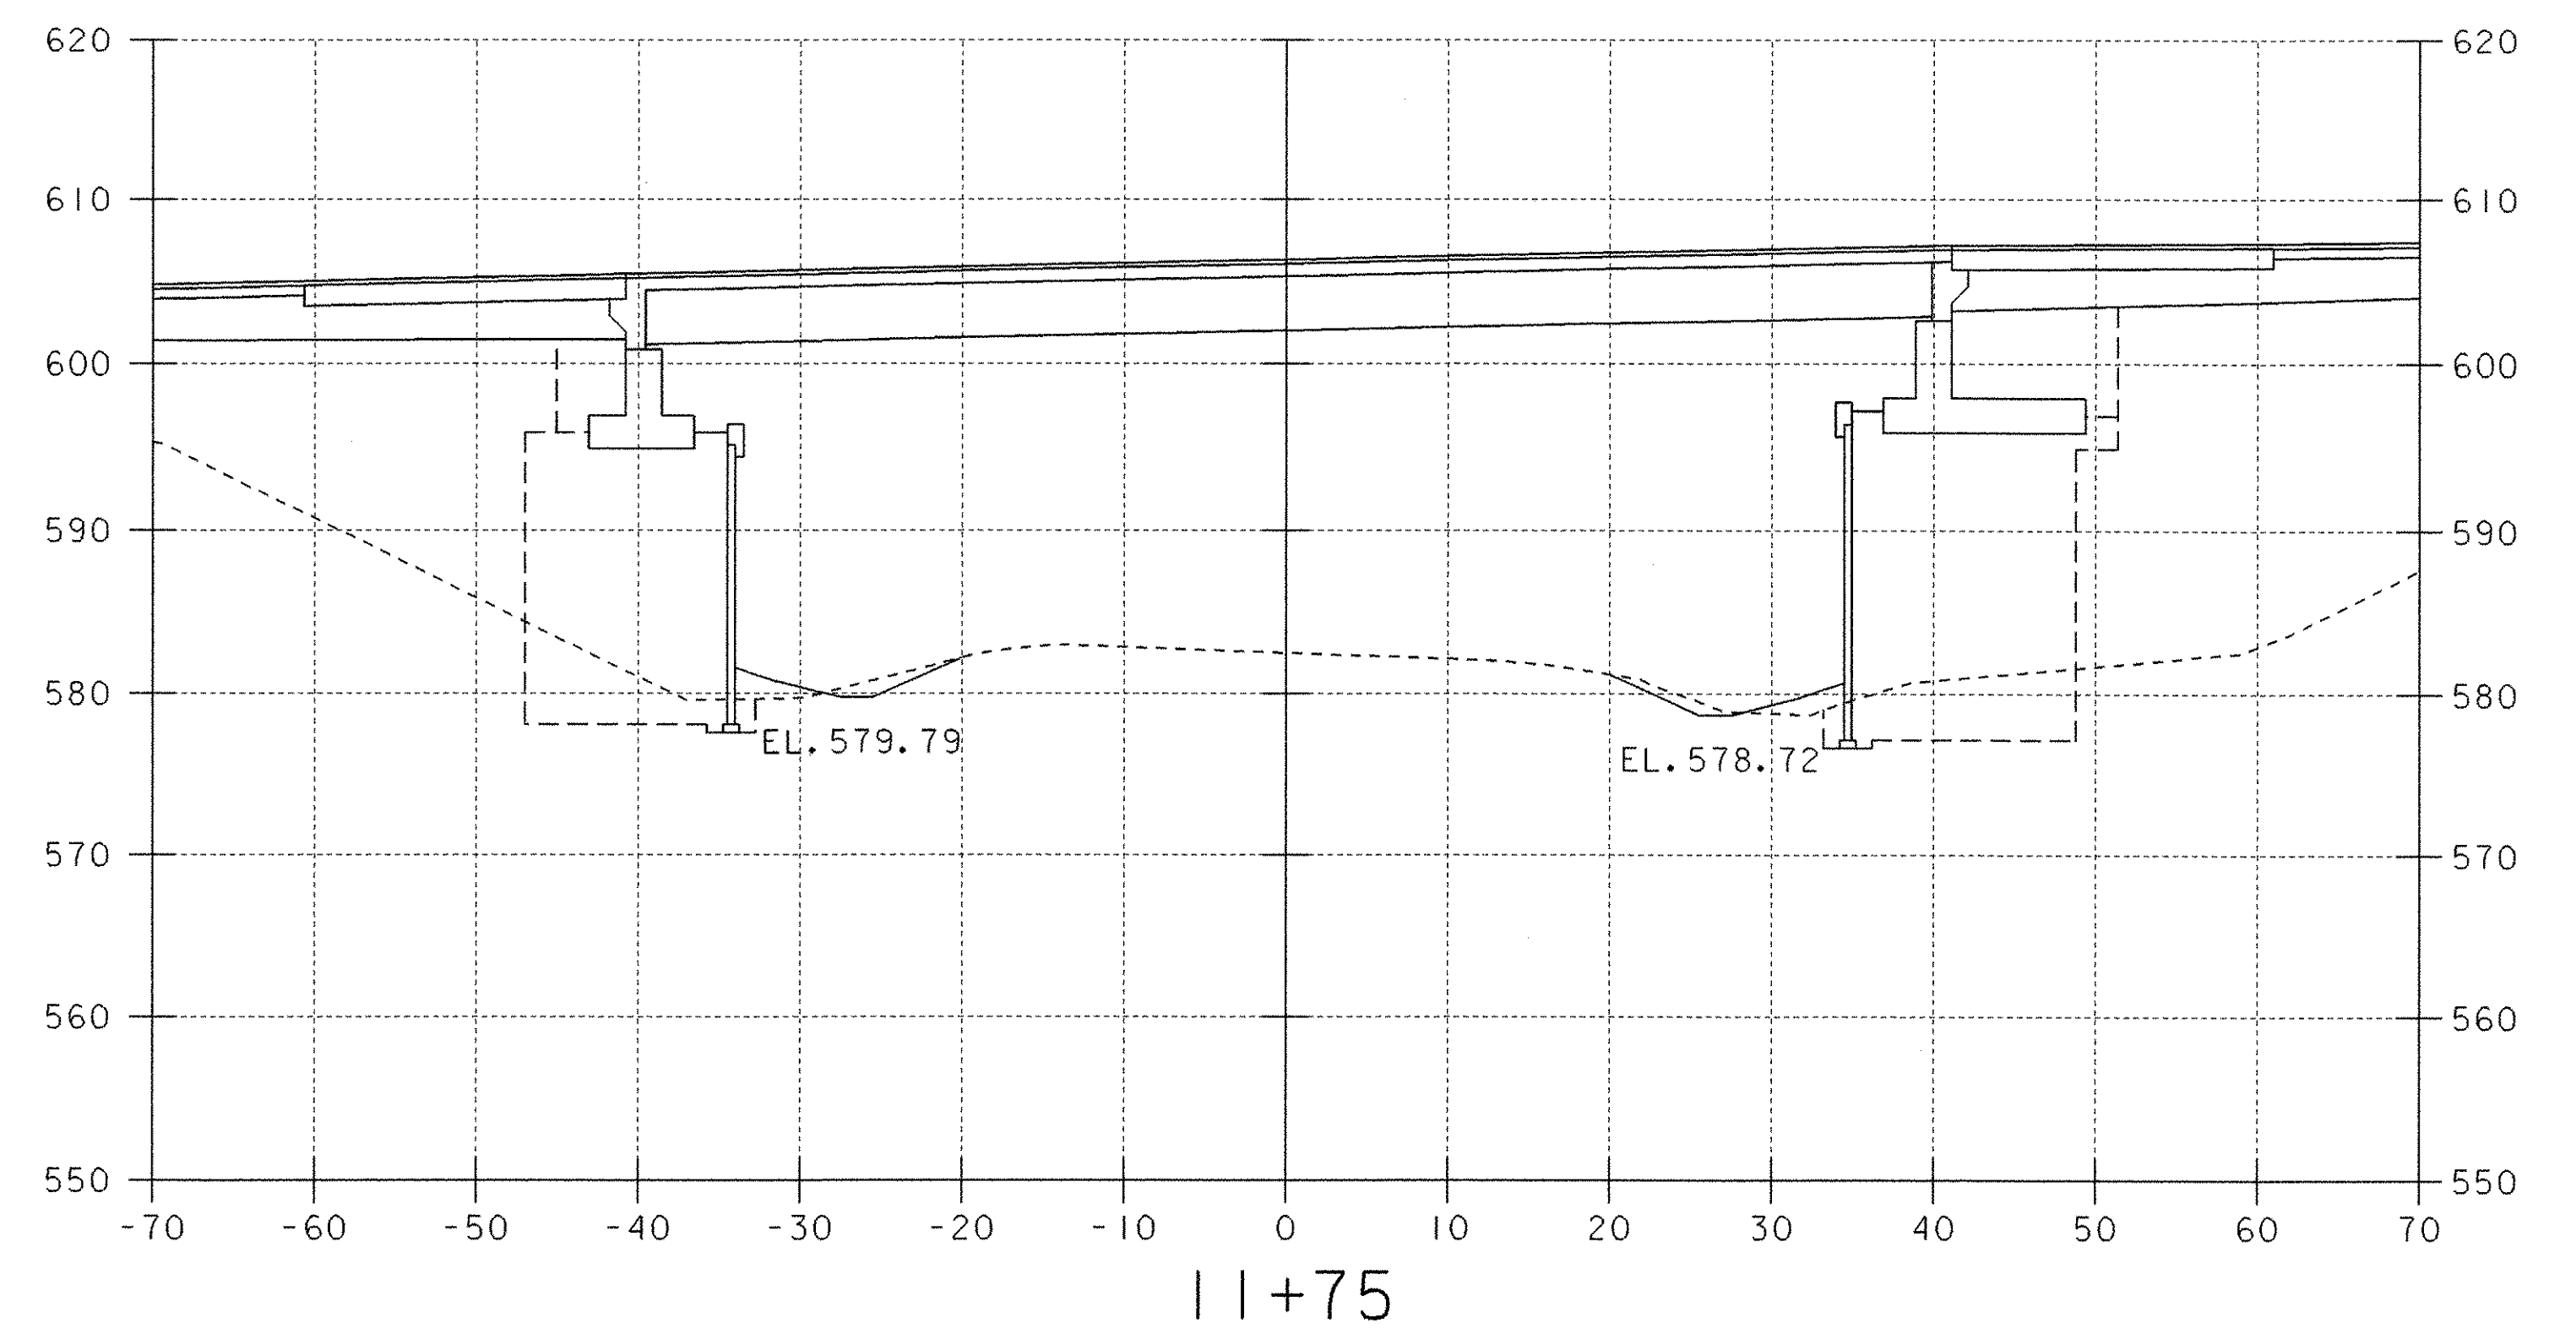


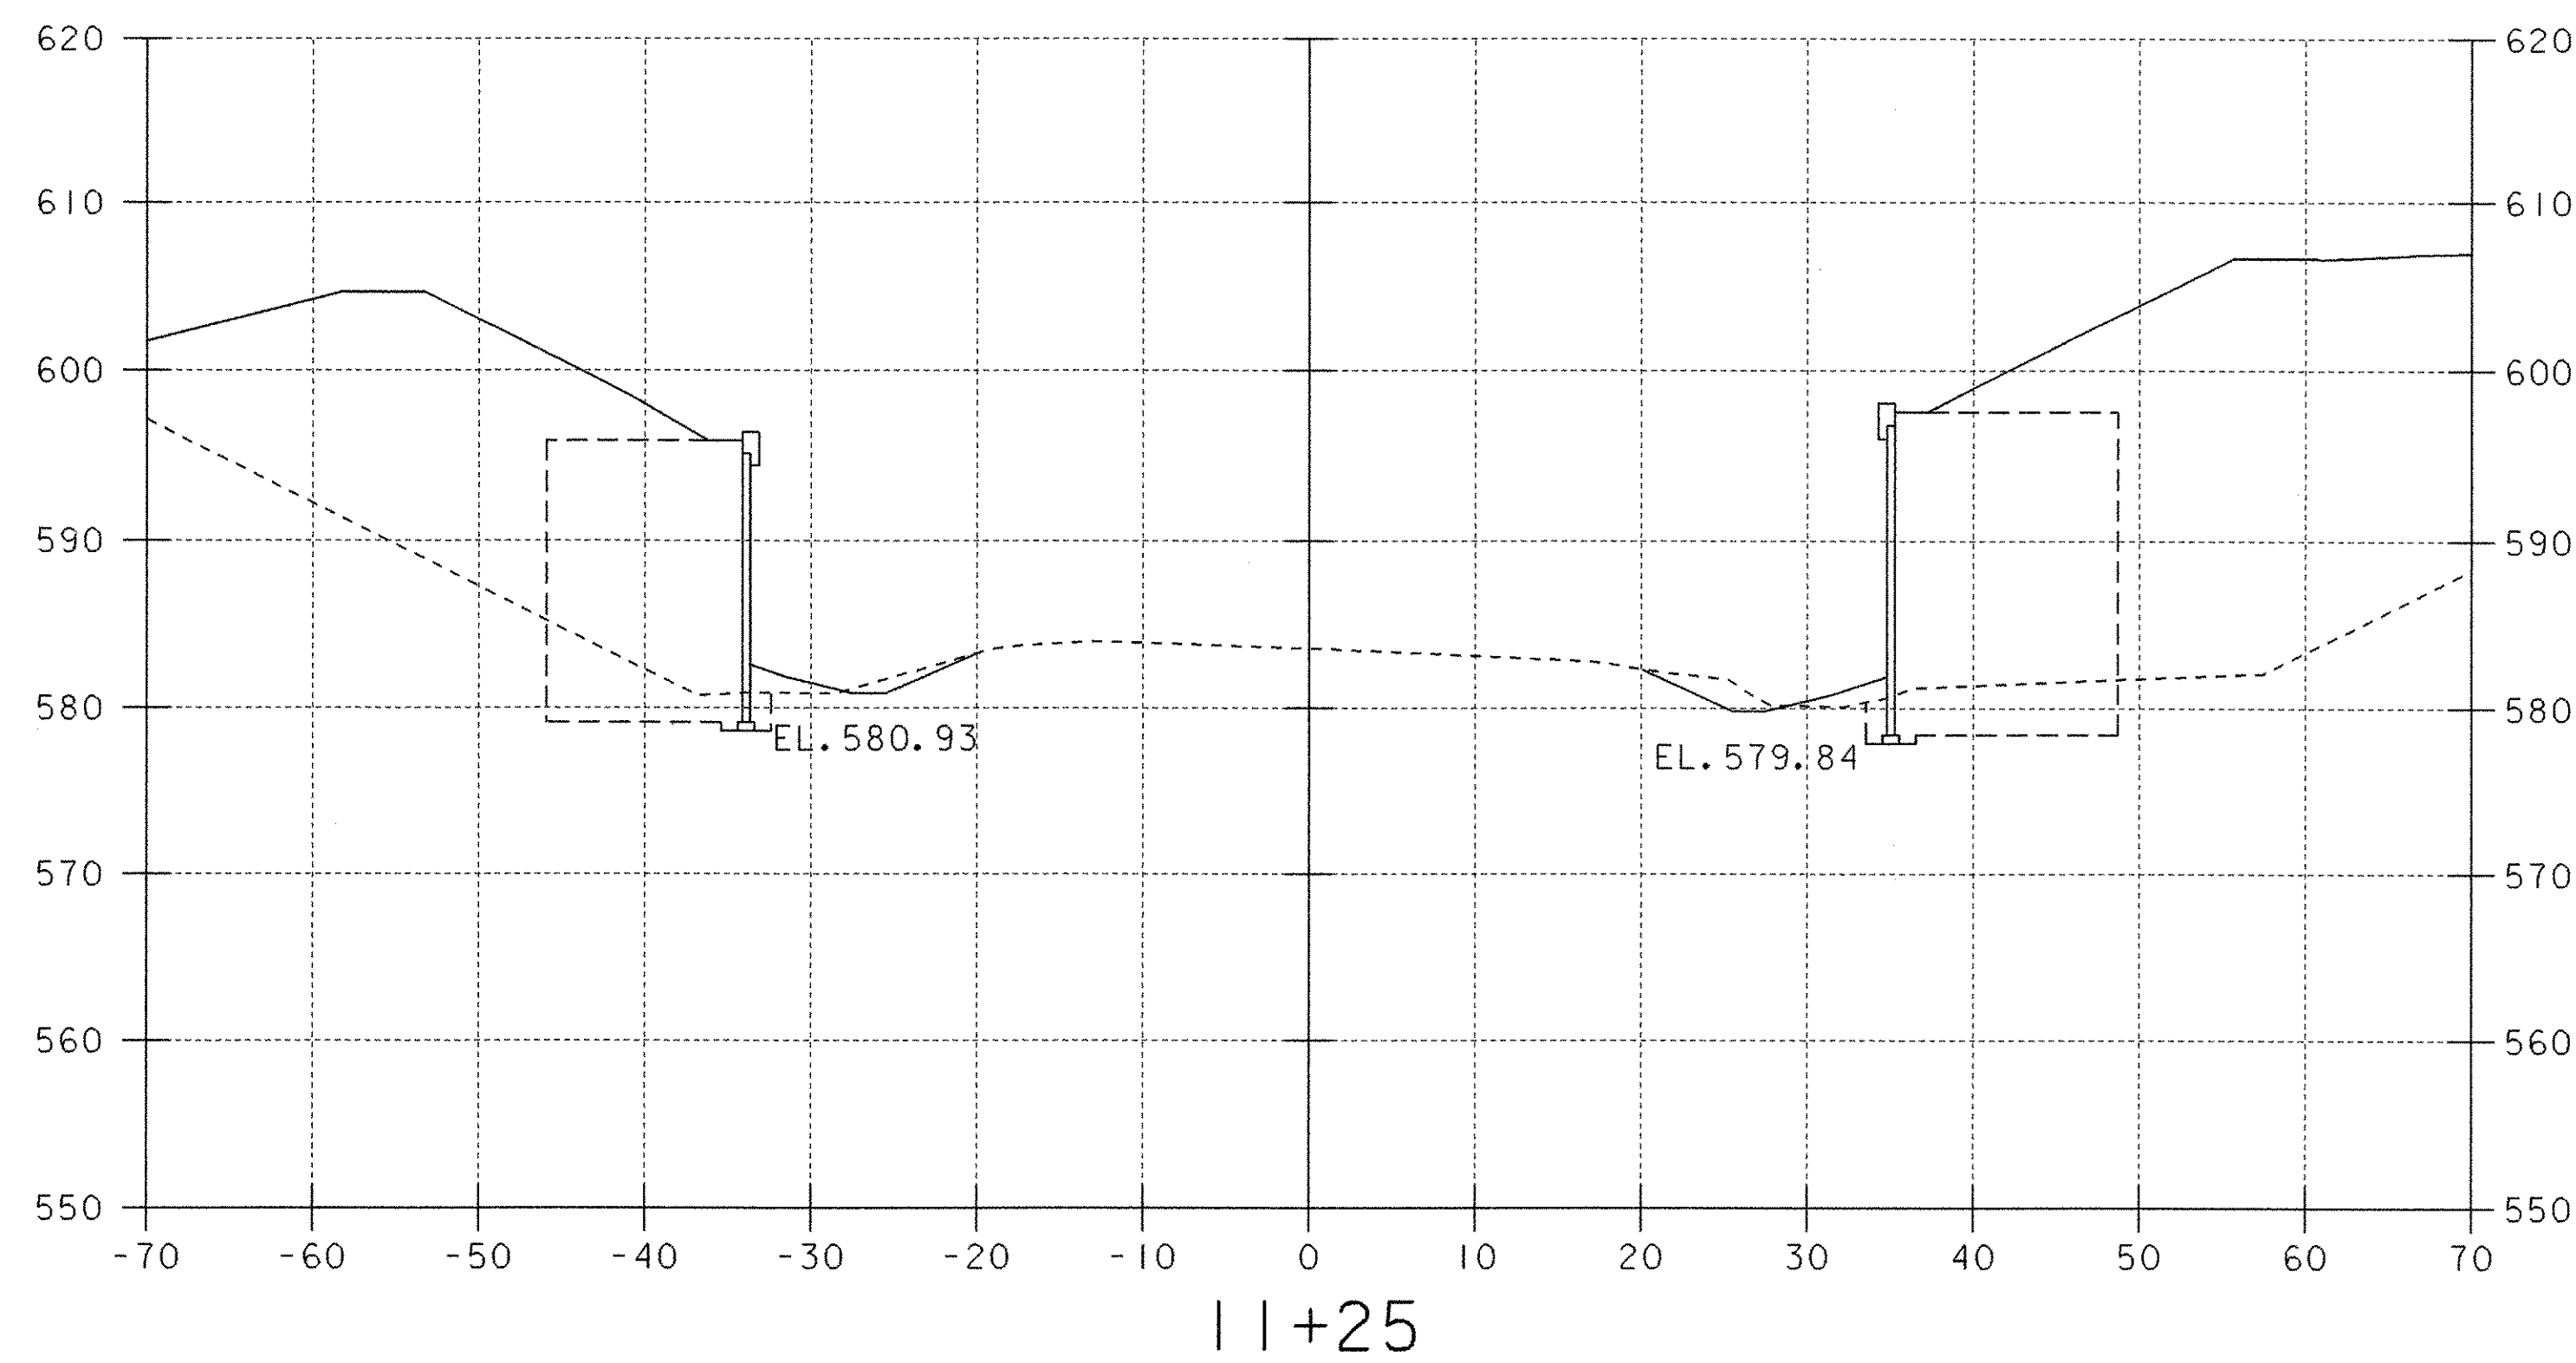

DATUM
 VERTICAL _____
 HORIZONTAL _____

SCALE 1" = 10'-0"
 10 0 10

PROJECT: FAIRFAX-FAIRFIELD-ST. ALBANS	PROJECT NO.: IM 089-3 (27)
DESIGN FILE NAME: \\96a056\Structures\sa056xsl.dgn	PLOT DATE: 21-SEP-2000
IPARM FILE NAME: sa056c02.i	VT 104 CROSS SECTIONS
BRIDGE SHEET BR237	SHEET: 115 OF 370