


CHANNEL STA. 33+29
 END UNCLASSIFIED CHANNEL EXCAVATION
 GEOTEXTILE UNDER STONE FILL
 STONE FILL, TYPE IV

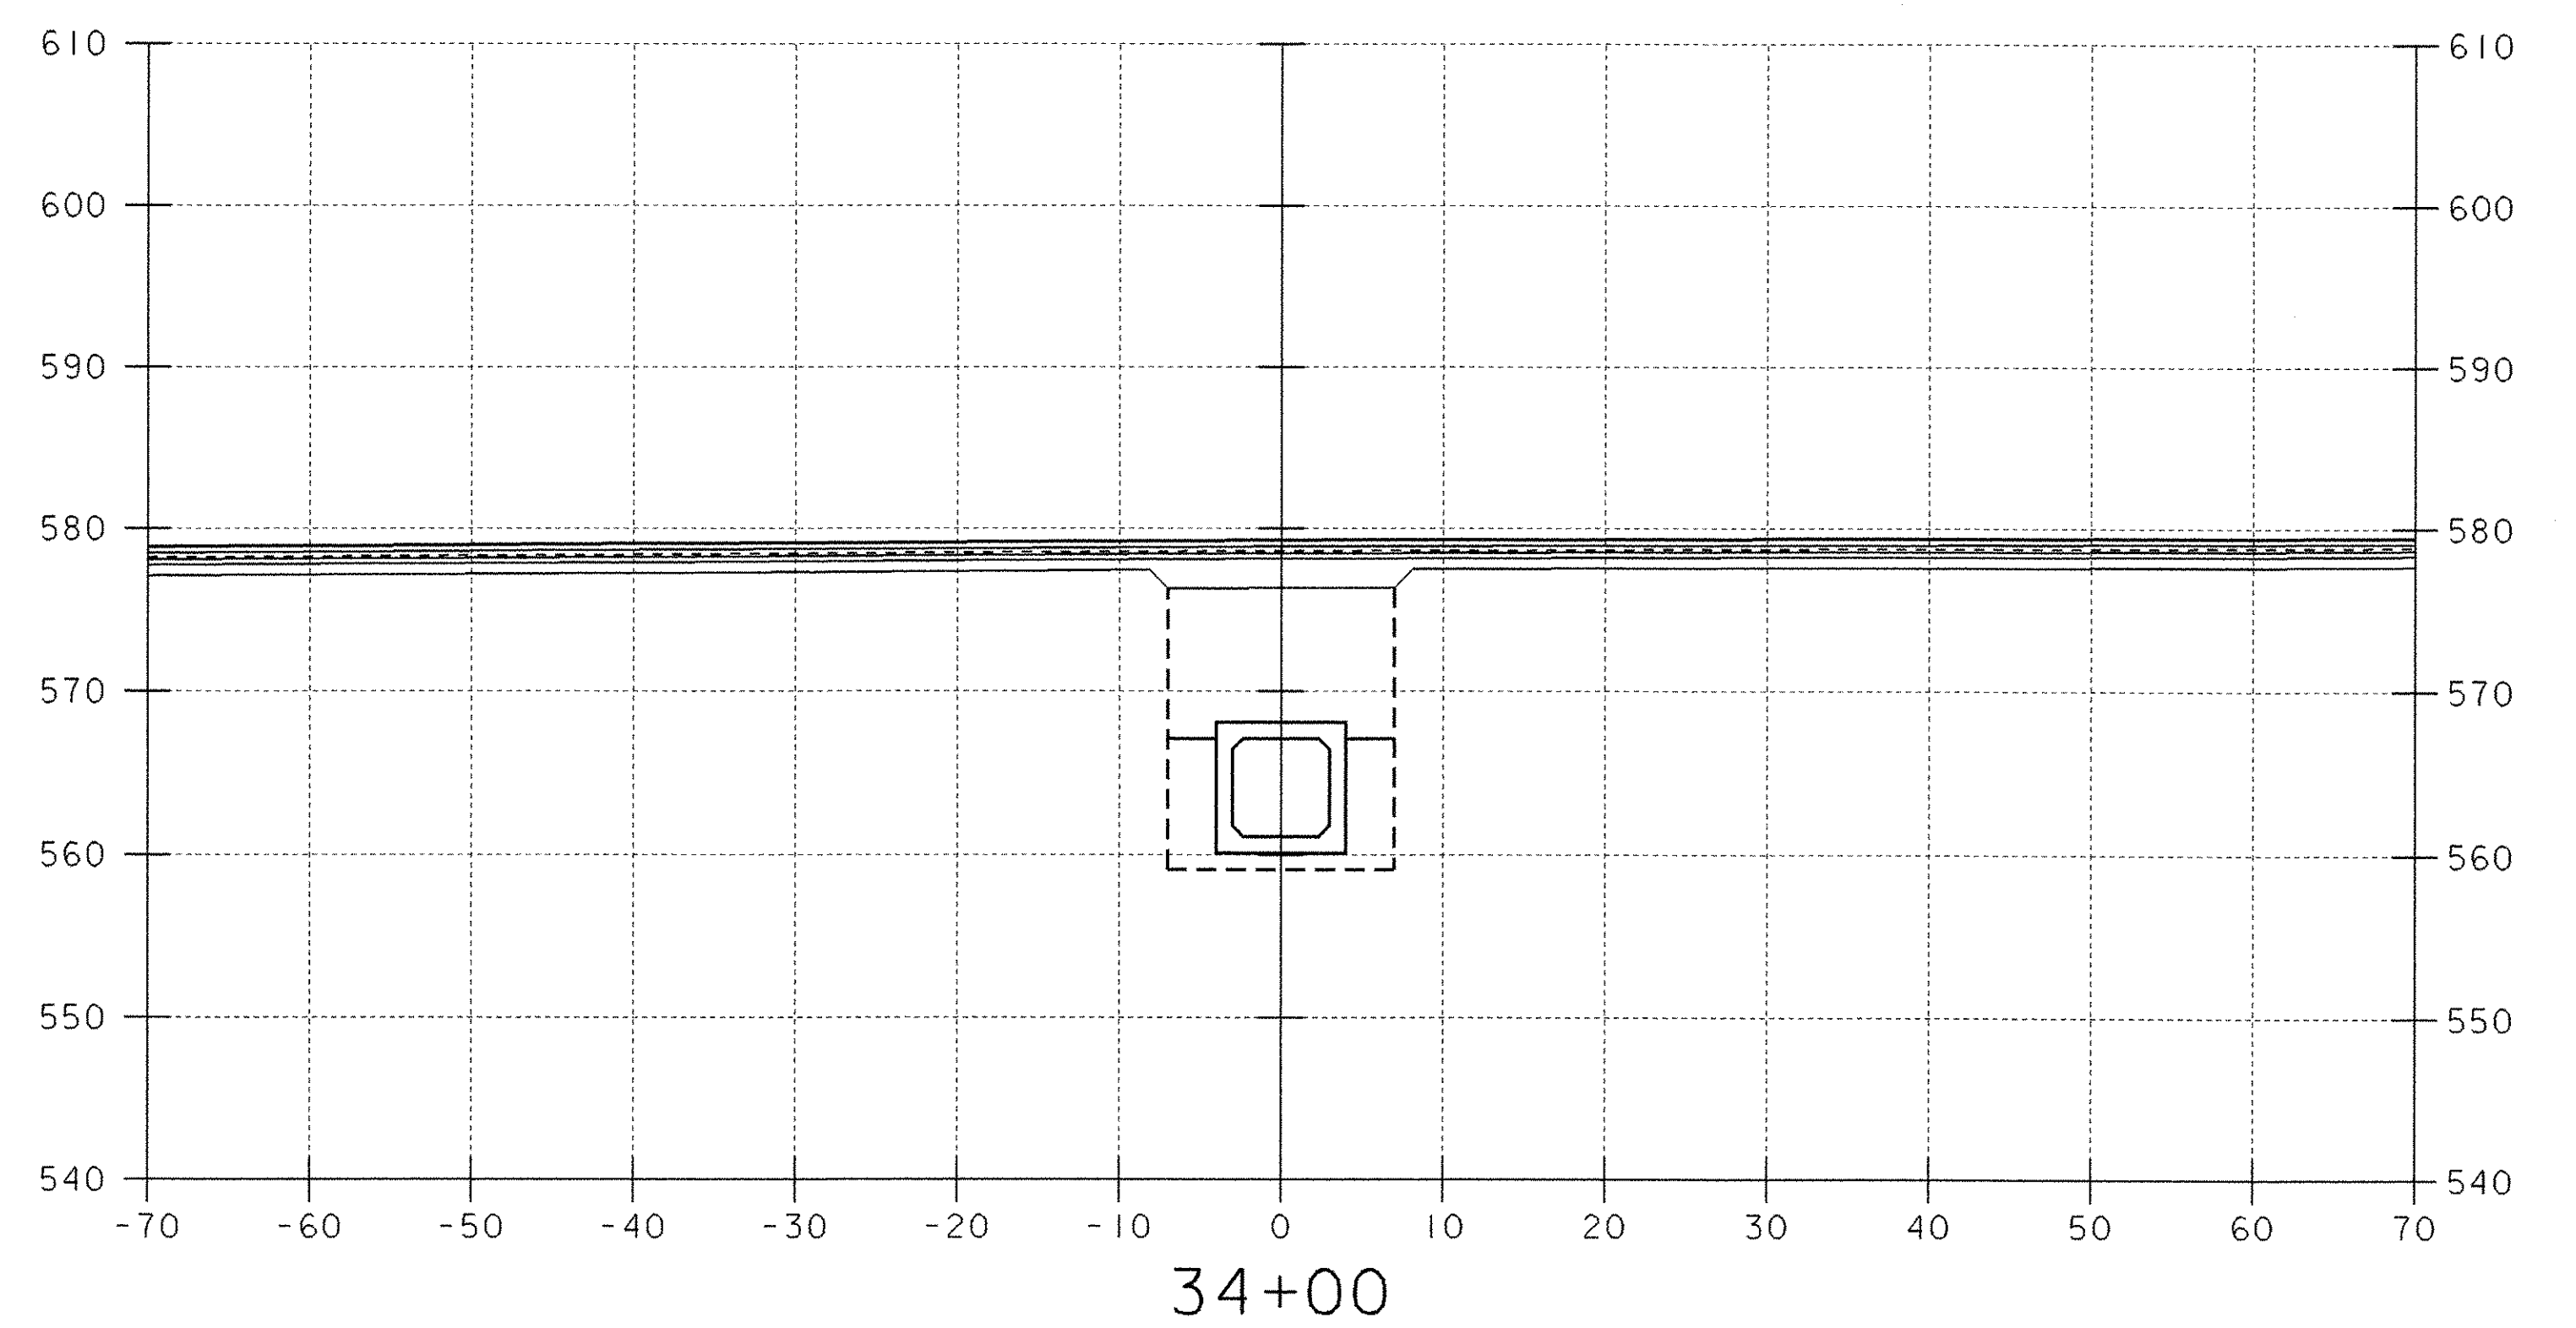

SCALE 1" = 10'-0"
 10 0 10

DATUM
 VERTICAL _____
 HORIZONTAL _____

PROJECT: FAIRFAX-FAIRFIELD-ST. ALBANS	PROJECT NO.: IM 089-3 (27)
DESIGN FILE NAME: \96a056\Structures\sa056xs4.dgn	PLOT DATE: 21-SEP-2000
IPARM FILE NAME: sa056c05.i	BRIDGE SHEET BR320
CHANNEL CROSS SECTIONS (4)	SHEET: 146 OF 370
STA. 33+50 TO STA. 34+25	