

NOTES


1. **SCOPE OF WORK:** FOR BOTH BRIDGES 88N AND 88S: REMOVE EXISTING CONCRETE DECK AND STEEL BEAM SUPERSTRUCTURE. PERFORM SUBSTRUCTURE CONCRETE REMOVAL AND REPAIR WORK, INCLUDING BRIDGE SEATS AND WINGWALLS, AS SHOWN IN THE DRAWINGS AND AS DIRECTED BY THE RESIDENT ENGINEER. PLACE NEW BEARINGS AT EACH SUBSTRUCTURE UNIT. SPLICE EXISTING STEEL BEAMS TO MAKE CONTINUOUS AT THE PIERS. CONSTRUCT NEW CONCRETE DECK.
2. ALL MATERIALS AND CONSTRUCTION SHALL CONFORM TO VERMONT AGENCY OF TRANSPORTATION STANDARD SPECIFICATIONS FOR CONSTRUCTION, DATED 1990, AND ITS LATEST REVISIONS AND THE AASHTO STANDARD SPECIFICATIONS FOR HIGHWAY BRIDGES, DATED 1996, AND ITS LATEST REVISIONS.

88 N & S INDEX OF SHEETS

BR400	88 N & S PRELIMINARY INFORMATION SHEET
BR401	88 N & S BRIDGE QUANTITY SHEET
BR402	88 N & S PLAN AND ELEVATION SHEET
BR403	88 N & S PROJECT NOTES
BR404	88 S BRIDGE DECK DETAILS
BR405-407	88 S DECK REINFORCING PLAN
BR408	88 S FRAMING PLAN DETAILS
BR409	88 S STRUCTURAL STEEL CONNECTION DETAILS
BR410	88 S STRUCTURAL STEEL SPLICE DETAILS
BR411	88 N BRIDGE DECK DETAILS
BR412-414	88 N DECK REINFORCING PLAN
BR415	88 N FRAMING PLAN DETAILS
BR416	88 N STRUCTURAL STEEL CONNECTION DETAILS
BR417	88 N STRUCTURAL STEEL SPLICE DETAILS
BR418-420	88 S BEARING DETAILS
BR421-423	88 N BEARING DETAILS
BR424	88 N & S EXPANSION JOINT DETAILS
BR425	88 S EXPANSION JOINT PLAN
BR426	88 N EXPANSION JOINT PLAN
BR427	88 N & S CURB PLATE DETAILS
BR428	88 N & S DOWNSPOUT DETAILS
BR429	88 S APPROACH SLAB DETAILS
BR430	88 N APPROACH SLAB DETAILS

INDEX OF SHEETS (CONT.)


BR431	88 N & S CURB AND RAIL DETAILS
BR432-435	NETC RAIL DETAILS
BR436	88 S ABUTMENT REMOVAL DETAILS
BR437	88 S WINGWALL REMOVAL DETAILS
BR438	88 S PIER REMOVAL DETAILS
BR439	ABUTMENT NO. 5 DETAILS
BR440	ABUTMENT NO. 6 DETAILS
BR441	WINGWALL NOS. 9 - 12 ELEVATIONS
BR442	PIER NO. 1 DETAILS
BR443	PIER NO. 2 DETAILS
BR444	88 N ABUTMENT REMOVAL DETAILS
BR445	88 N WINGWALL REMOVAL DETAILS
BR446	88 N PIER REMOVAL DETAILS
BR447	ABUTMENT NO. 7 DETAILS
BR448	ABUTMENT NO. 8 DETAILS
BR449	WINGWALL NOS. 13 - 16 ELEVATIONS
BR450	PIER NO. 3 DETAILS
BR451	PIER NO. 4 DETAILS
BR452	PIER NOS. 3 & 4 CAP REINFORCING DETAILS
BR453-454	88 N & S REINFORCING STEEL SCHEDULE
BR455-491	88 N & S REFERENCE SHEETS 1-37

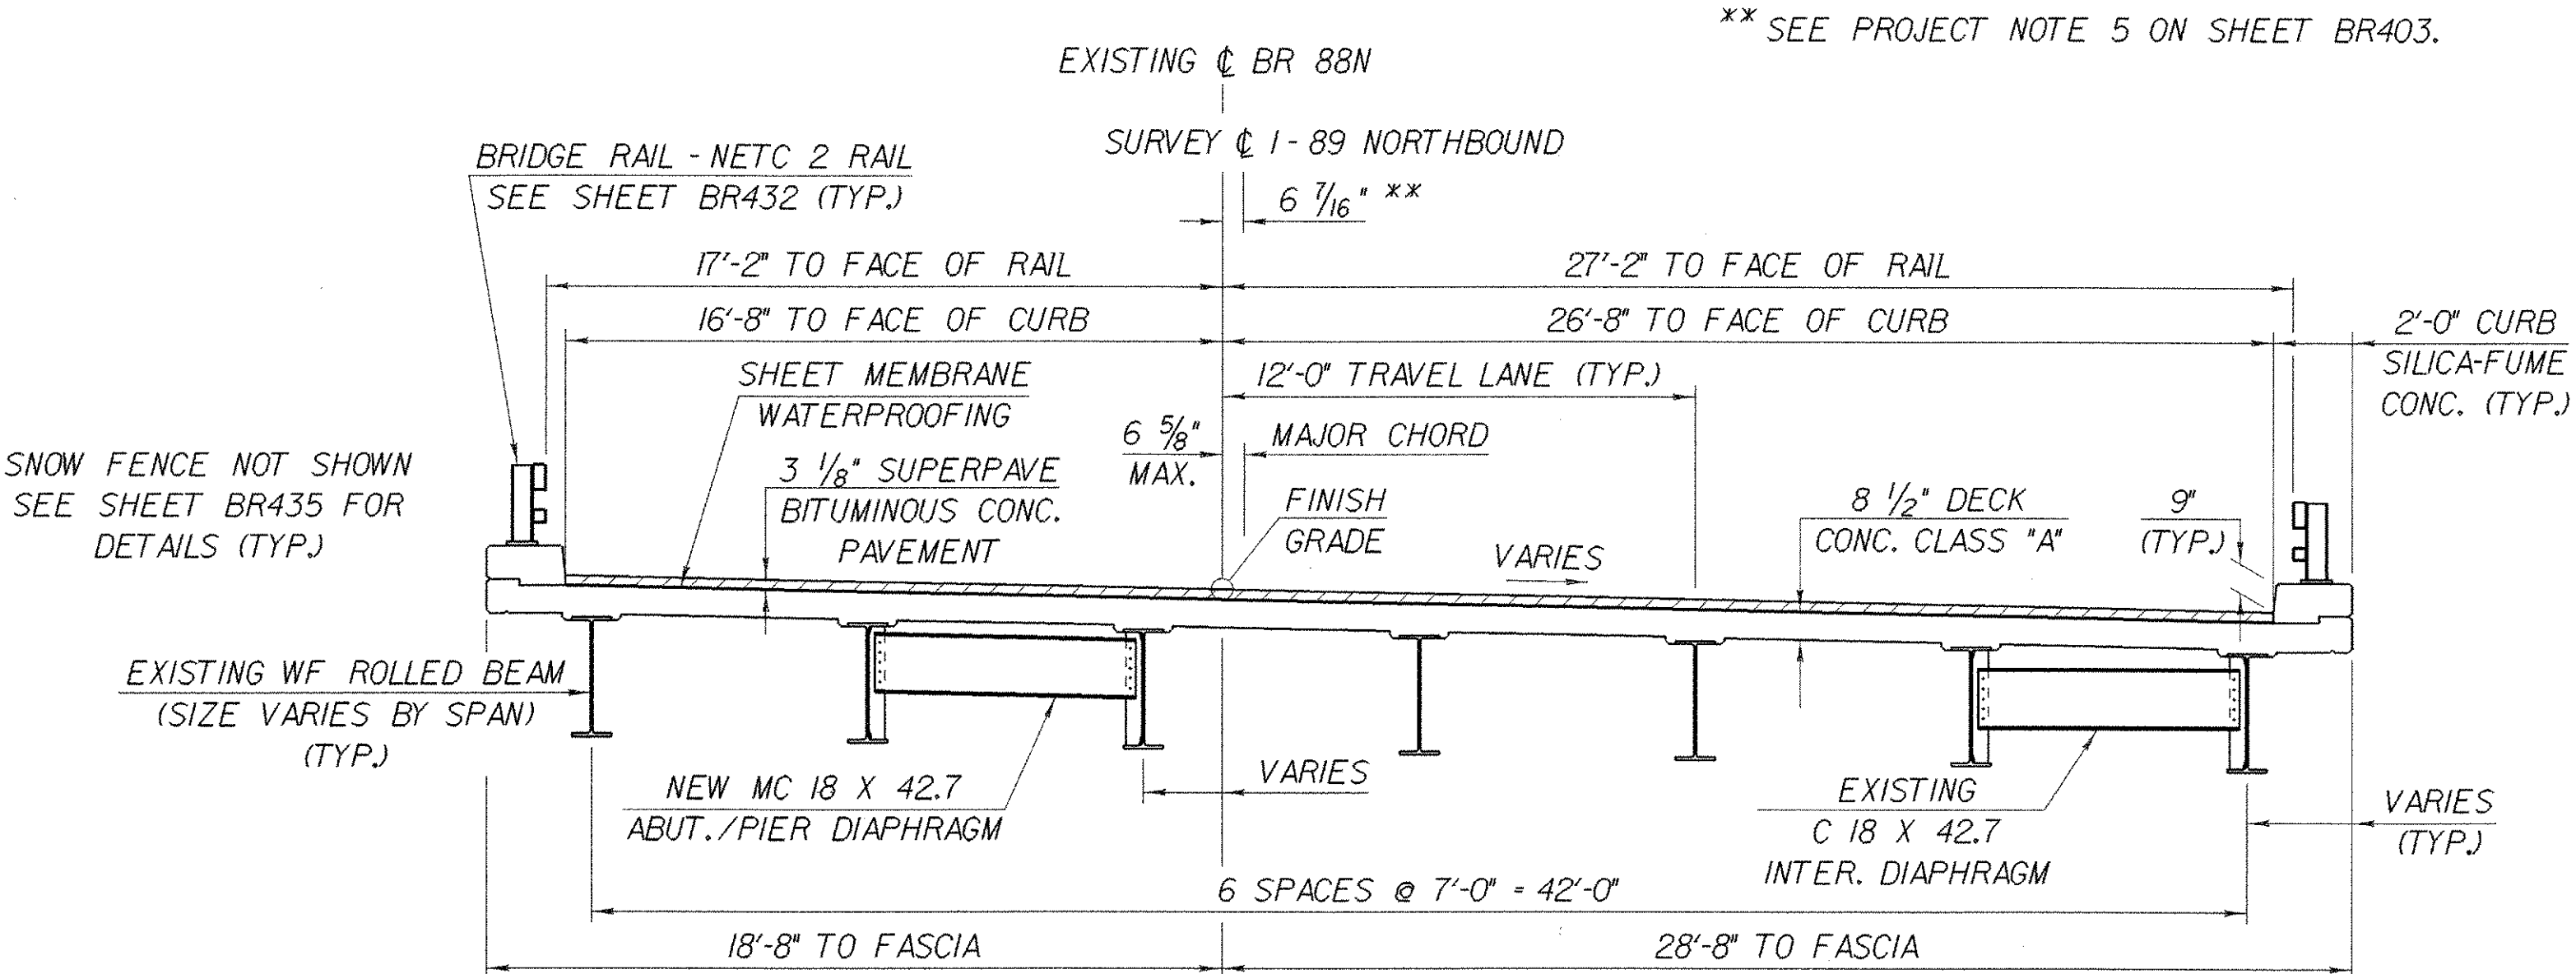

BRIDGE 88N TYPICAL SECTION

SCALE 1/4" = 1'-0"

** SEE PROJECT NOTE 5 ON SHEET BR403.

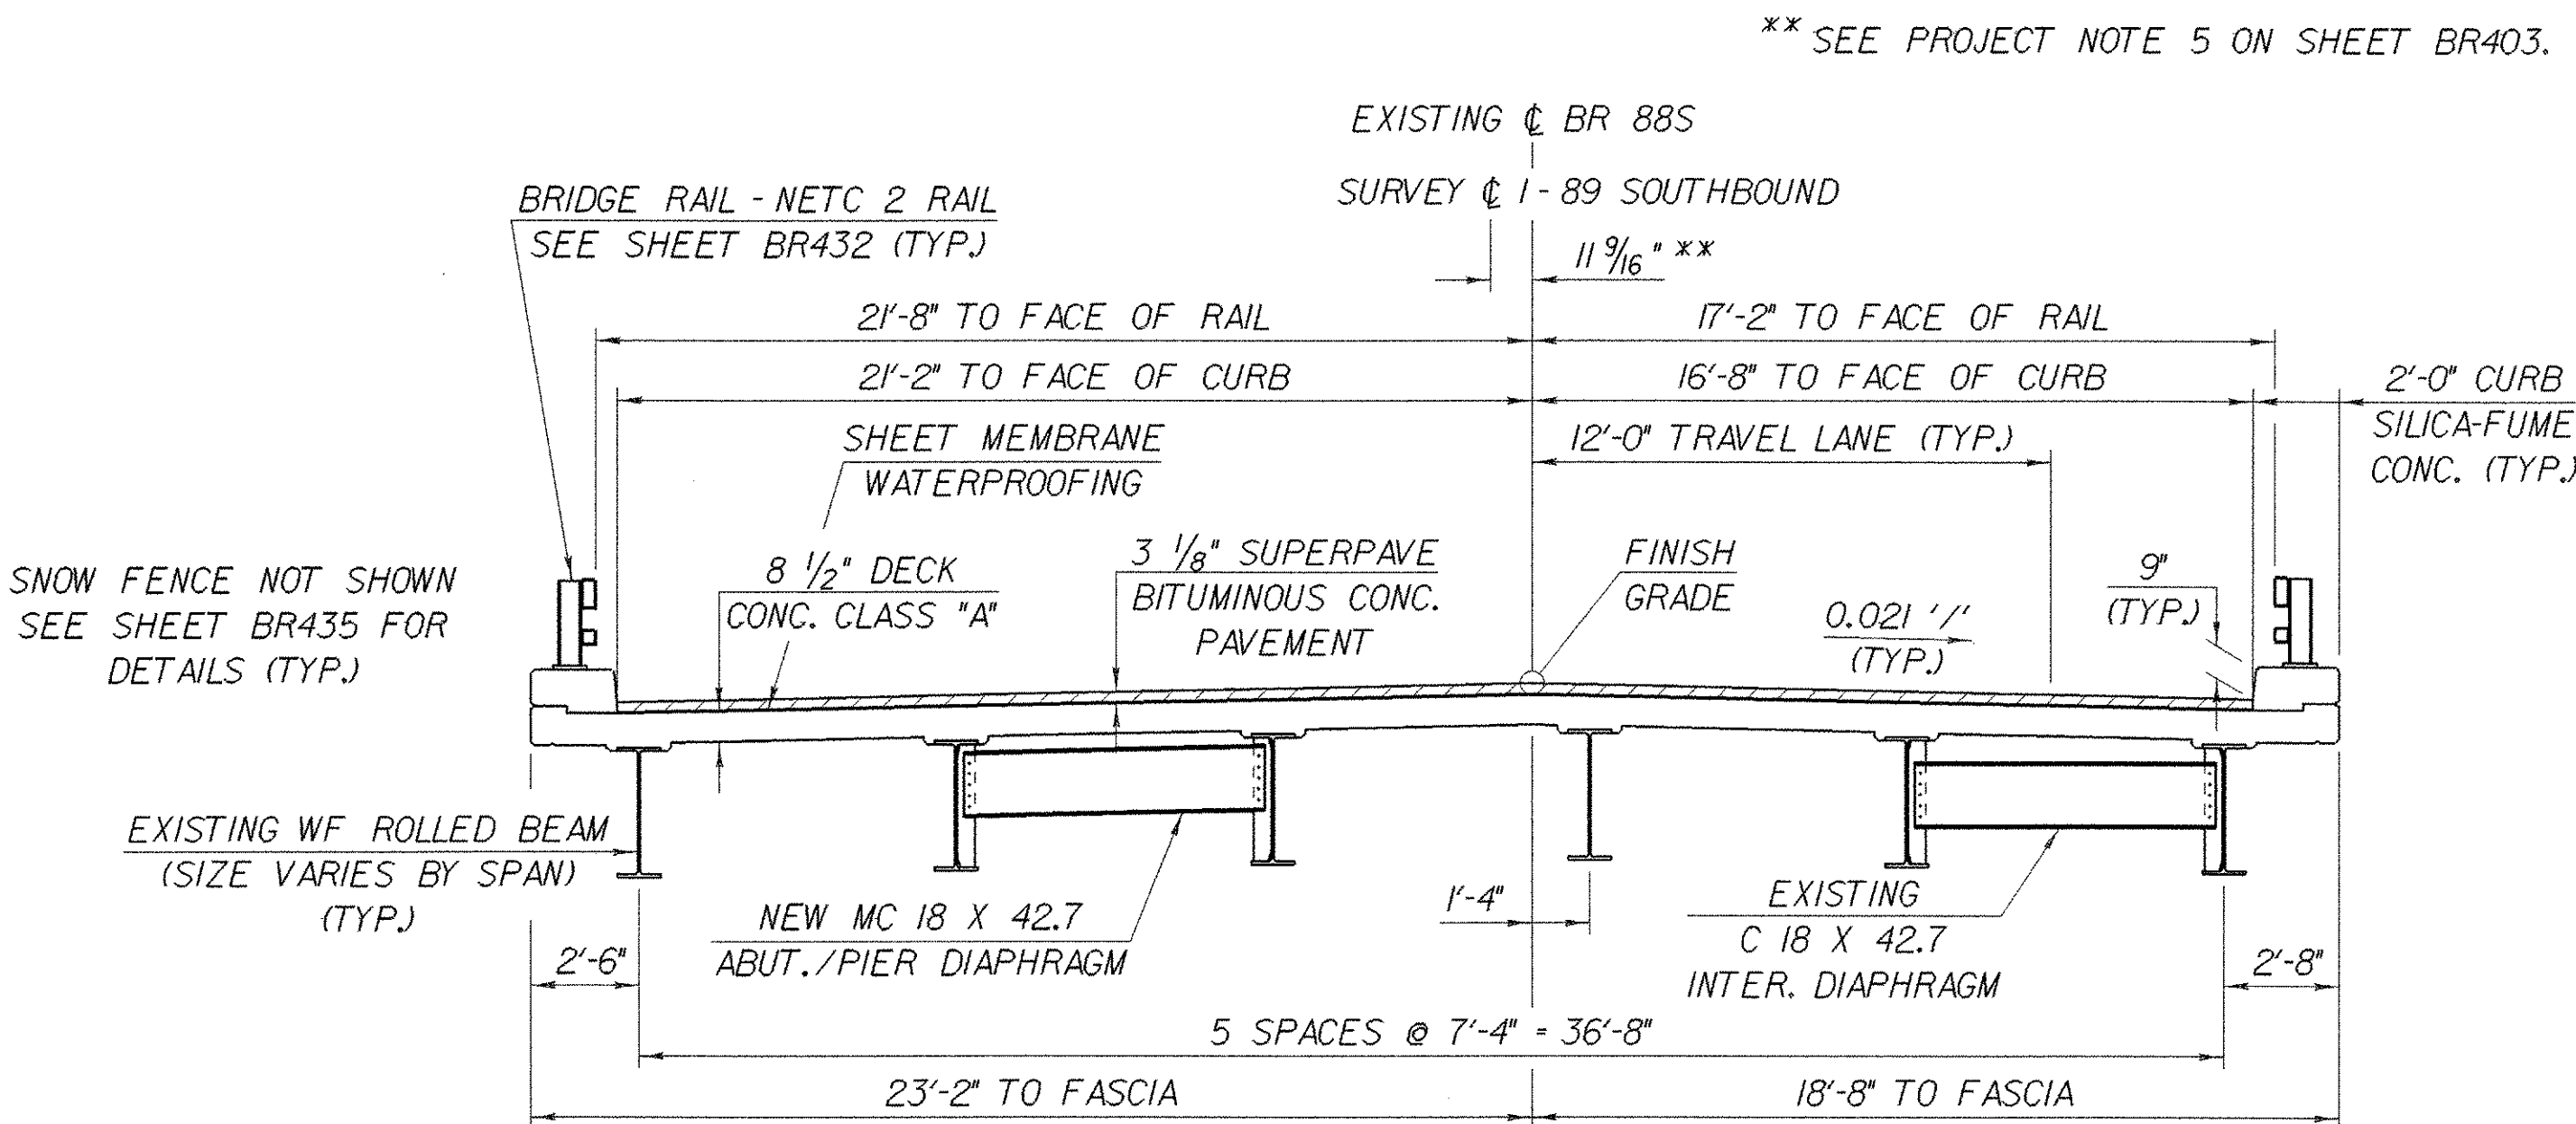

BRIDGE 88S TYPICAL SECTION

SCALE 1/4" = 1'-0"

** SEE PROJECT NOTE 5 ON SHEET BR403.

* SEE TRAFFIC CONTROL SHEETS

DESIGN CRITERIA:	
1. DESIGN LIVE LOAD AASHTO	HS25-44
2. DESIGN SPAN	NB 48 - 69 - 48 SB 53 - 74 - 53
3. ALLOWABLE LOAD FOR SPREAD FOOTINGS ON SOIL	N/A ON LEDGE N/A
4. ALLOWABLE LOAD FOR PILING	N/A TYPE N/A ESTIMATED LENGTH N/A
5. STRUCTURAL STEEL AASHTO GRADE	SEE PROJECT NOTES
6. REINFORCING STEEL GRADE	60
7. CONCRETE CLASS A	f _c : 4000 PSI
CONCRETE CLASS B	f _c : 3500 PSI
SILICA-FUME CONCRETE	f _c : 5000 PSI

* TRAFFIC MAINTENANCE:	
1. IS TRAFFIC TO BE MAINTAINED?	IF YES, ON EXISTING STRUCTURE OR ON TEMPORARY BRIDGE
2. TEMPORARY BRIDGE REQUIREMENTS: ONE OR TWO WAY	TRAFFIC CONTROL SIGNALS REQUIRED
MINIMUM	
ARE SIDEWALKS REQUIRED?	IF SO, ON WHAT SIDE?

BR 88S LOAD FACTOR LOAD RATING (TONS)						
LOADING LEVELS (LOAD FACTOR)	H	HS	3S2	6 AXLE	3A. STR.	4A. STR.
INVENTORY A=2.17 B=1.00	22	40				
POSTED A=1.55 B=1.40	31	56	75		68	69
OPERATING A=1.30 B=1.67		67	89	85	82	82
BR 88N LOAD FACTOR LOAD RATING (TONS)						
LOADING LEVELS (LOAD FACTOR)	H	HS	3S2	6 AXLE	3A. STR.	4A. STR.
INVENTORY A=2.17 B=1.00	29	53				
POSTED A=1.55 B=1.40	41	74	93		92	92
OPERATING A=1.30 B=1.67		89	111	107	110	110
STRENGTH RF = $\frac{0.95 F_y S_{LL+1} - M_{DL} S_{LL+1} - M_{SD} S_{SD+1}}{A \times M_{LL+1}}$ SERVICEABILITY RF = B						
NOTE: SERVICEABILITY AT PIERS GOVERNS						

STATE OF VERMONT
AGENCY OF TRANSPORTATION

Town of FAIRFAX-FAIRFIELD-ST. ALBANS
Highway No. 1-89

1-89 OVER ST. ALBANS SOUTH STATE HIGHWAY (EXIT 19)

88 N & S PRELIMINARY INFORMATION SHEET

Designed By M. LOZIER
Checked By M. LOZIER Date 2/00
Drawn By G. ROY
Bridge Design Supervisor R.R. WHITCOMB Date 2/00

PROJECT FAIRFAX-FAIRFIELD-ST. ALBANS
I.G.C. Info. 960056Structures\sa056pl3.dgn

Bridge Sheet No. BR400

Sheet 152 of 370