


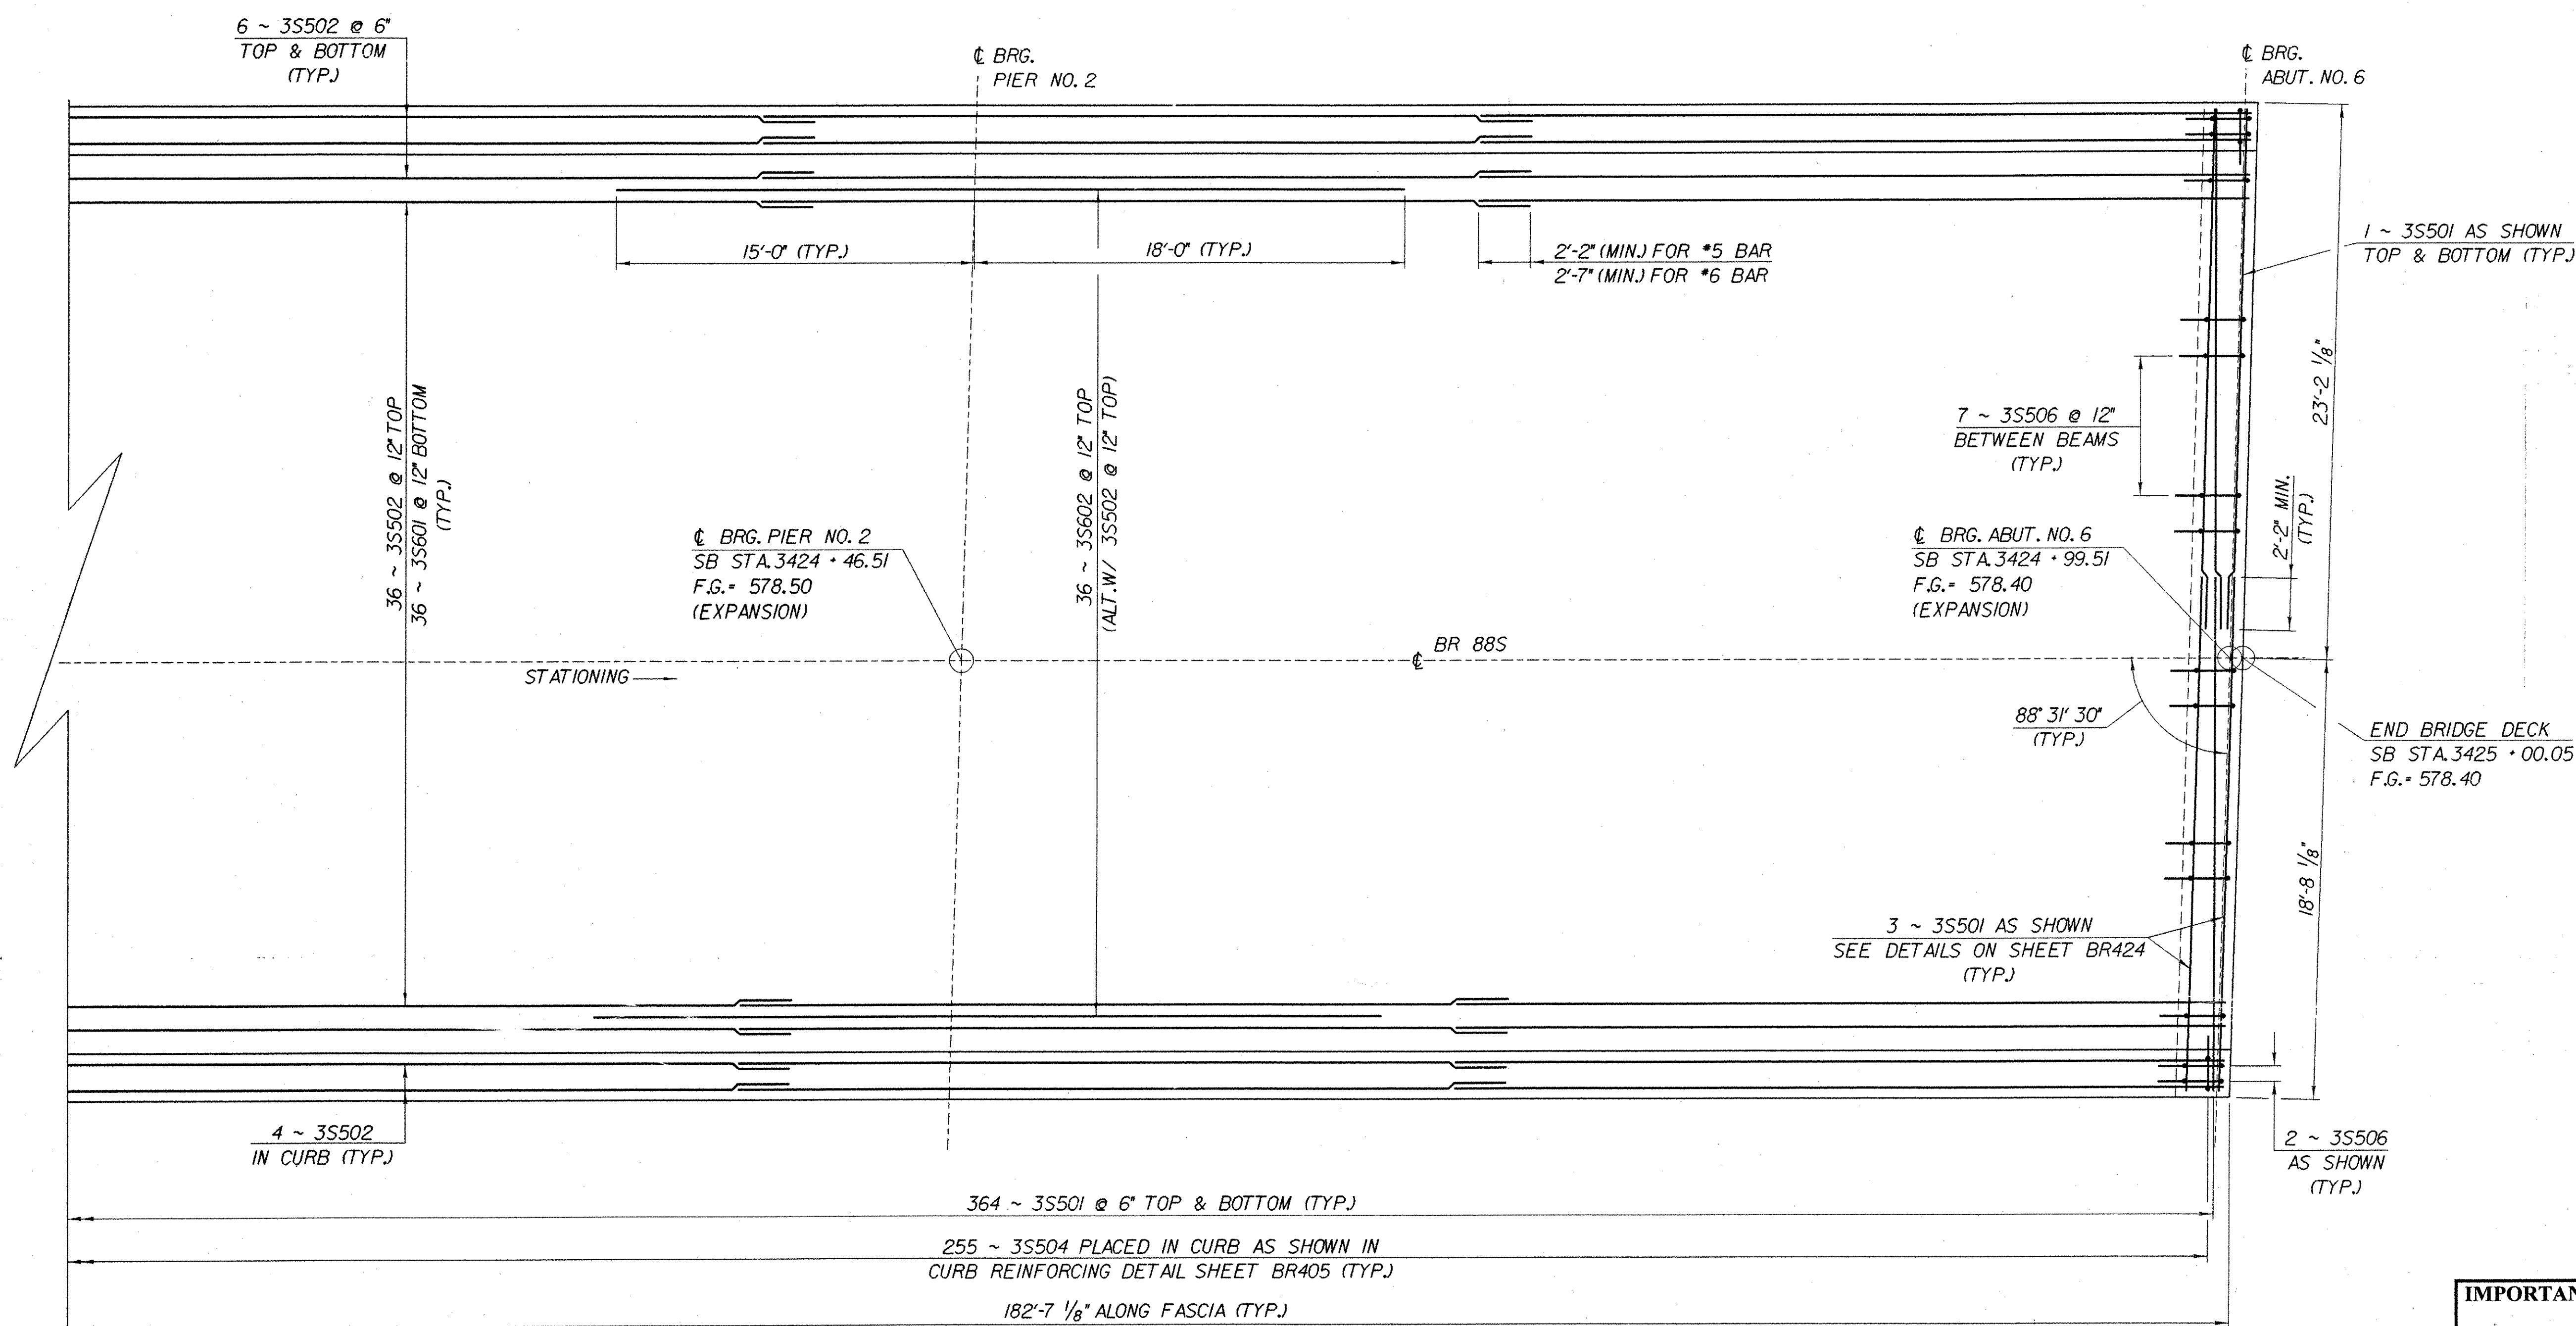

IMPORTANT NOTE: BRIDGE FINISHED GRADES ARE CENTERLINE GRADES.

BRIDGE 88S DECK REINFORCING PLAN SPAN THREE

SCALE: 1/4" = 1'-0"

STATE OF VERMONT AGENCY OF TRANSPORTATION

Town Of FAIRFAX-FAIRFIELD- ST. ALBANS	Bridge No. 88S
Highway No. 1-89	Log Sta. Surv. Sta.
1-89 OVER ST. ALBANS SOUTH STATE HIGHWAY (EXIT 19)	
88S DECK REINFORCING PLAN SPAN NO. 3	
Designed By M. LOZIER	Drawn By K. CHISHOLM
Checked By M. LOZIER	Bridge Design Supervisor R. R. WHITCOMB
Date 2/00	Date 2/00
PROJECT FAIRFAX-FAIRFIELD-ST. ALBANS	PROJECT NO. 1M 089 - 3 (27)
I.G.C. Info. 96a056Structures\sd056sp3.dgn	sd056sp3j
Bridge Sheet No. BR407	Sheet 159 of 370

PLOTTED 21-SEP-2000