

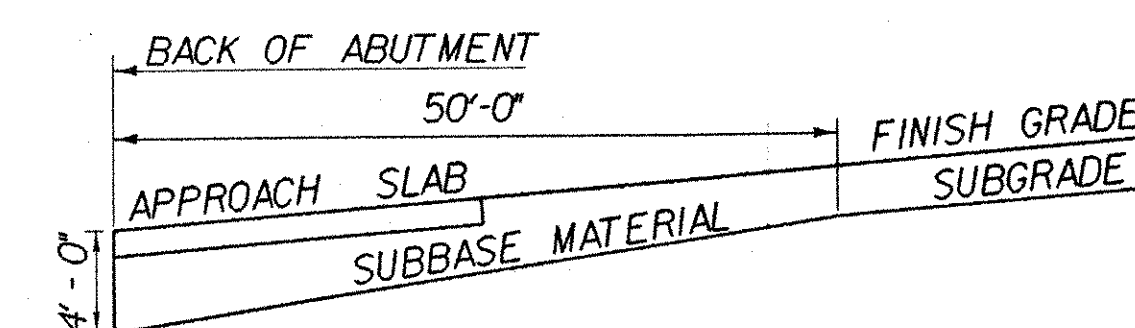
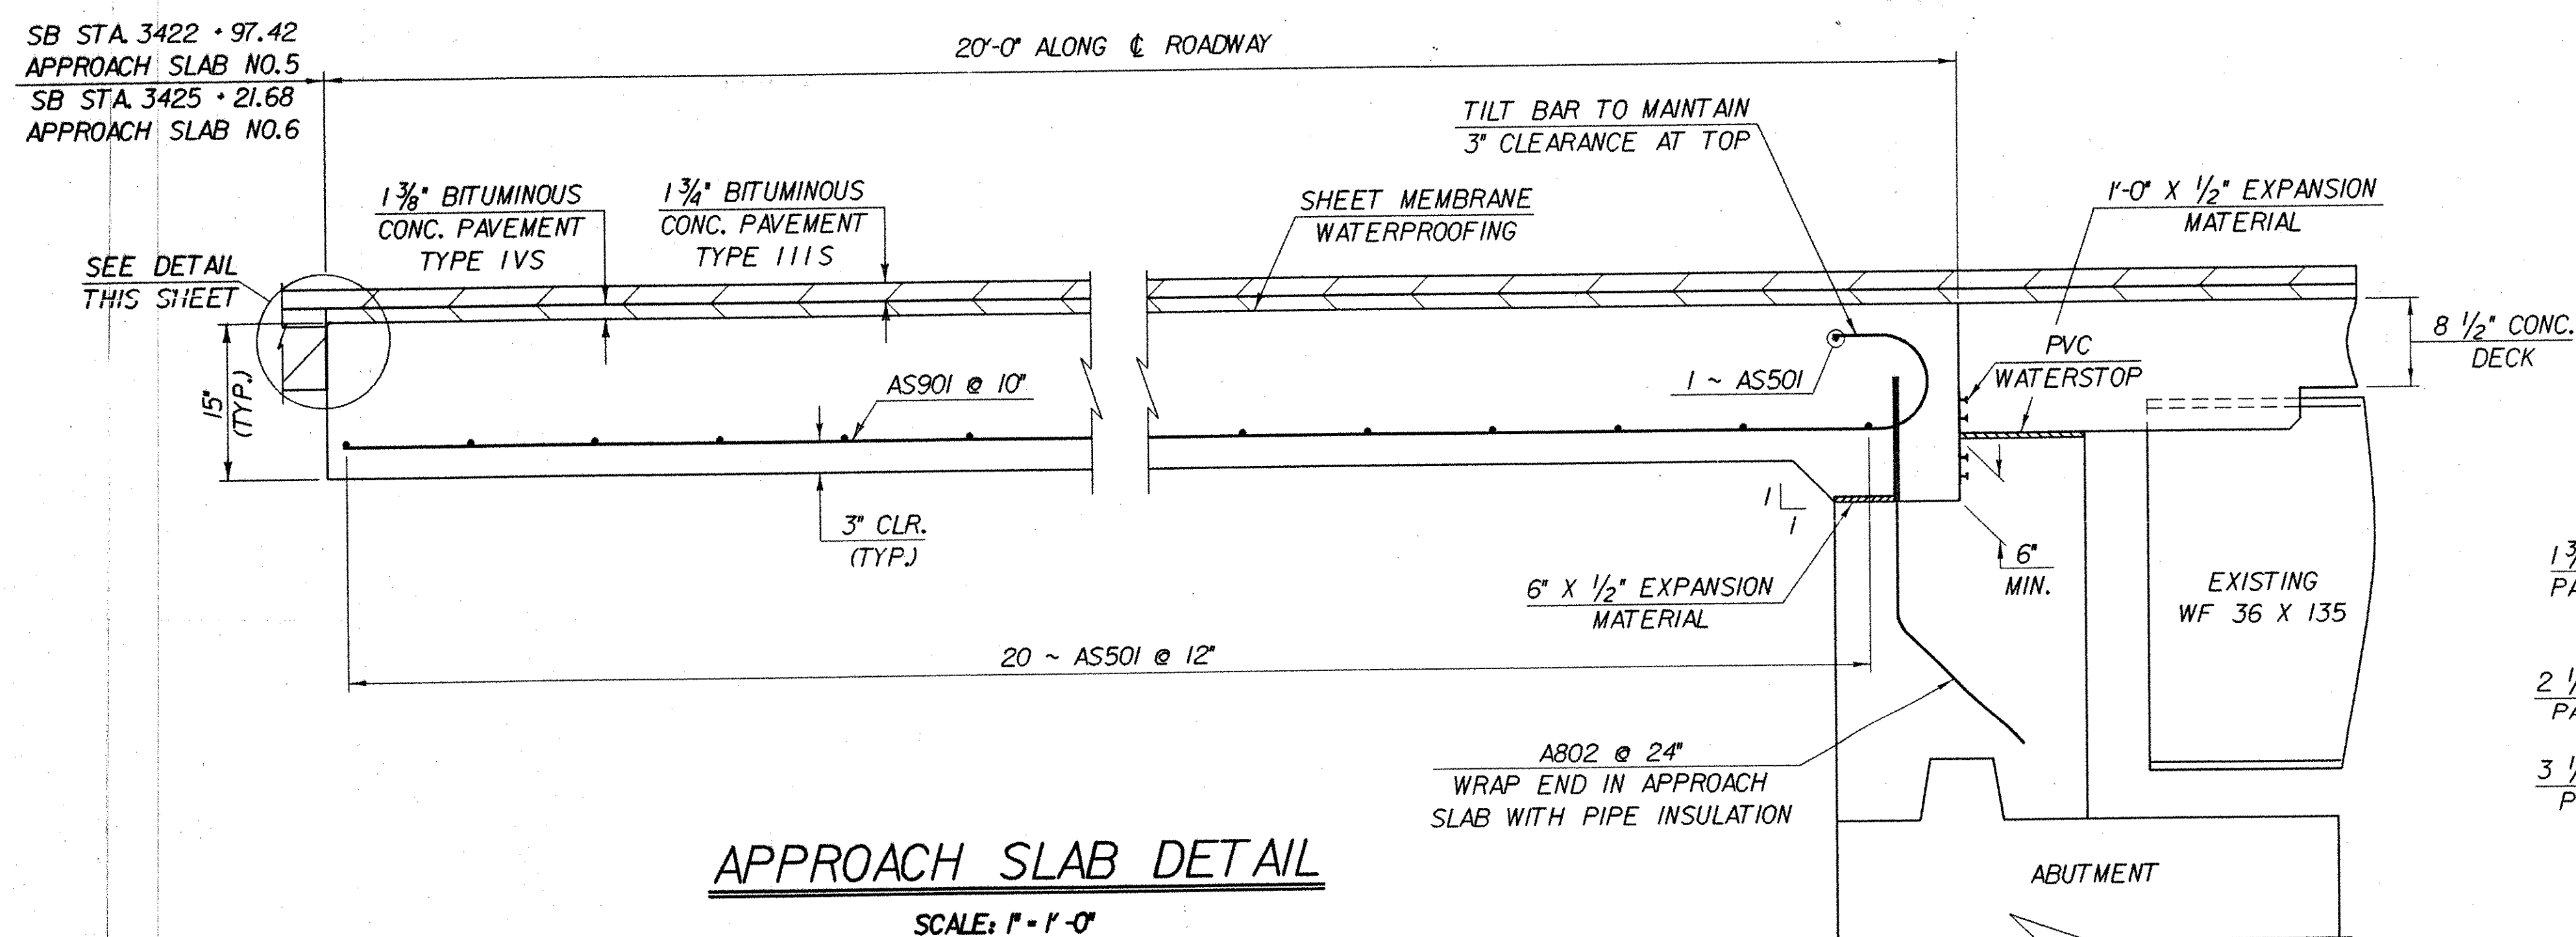
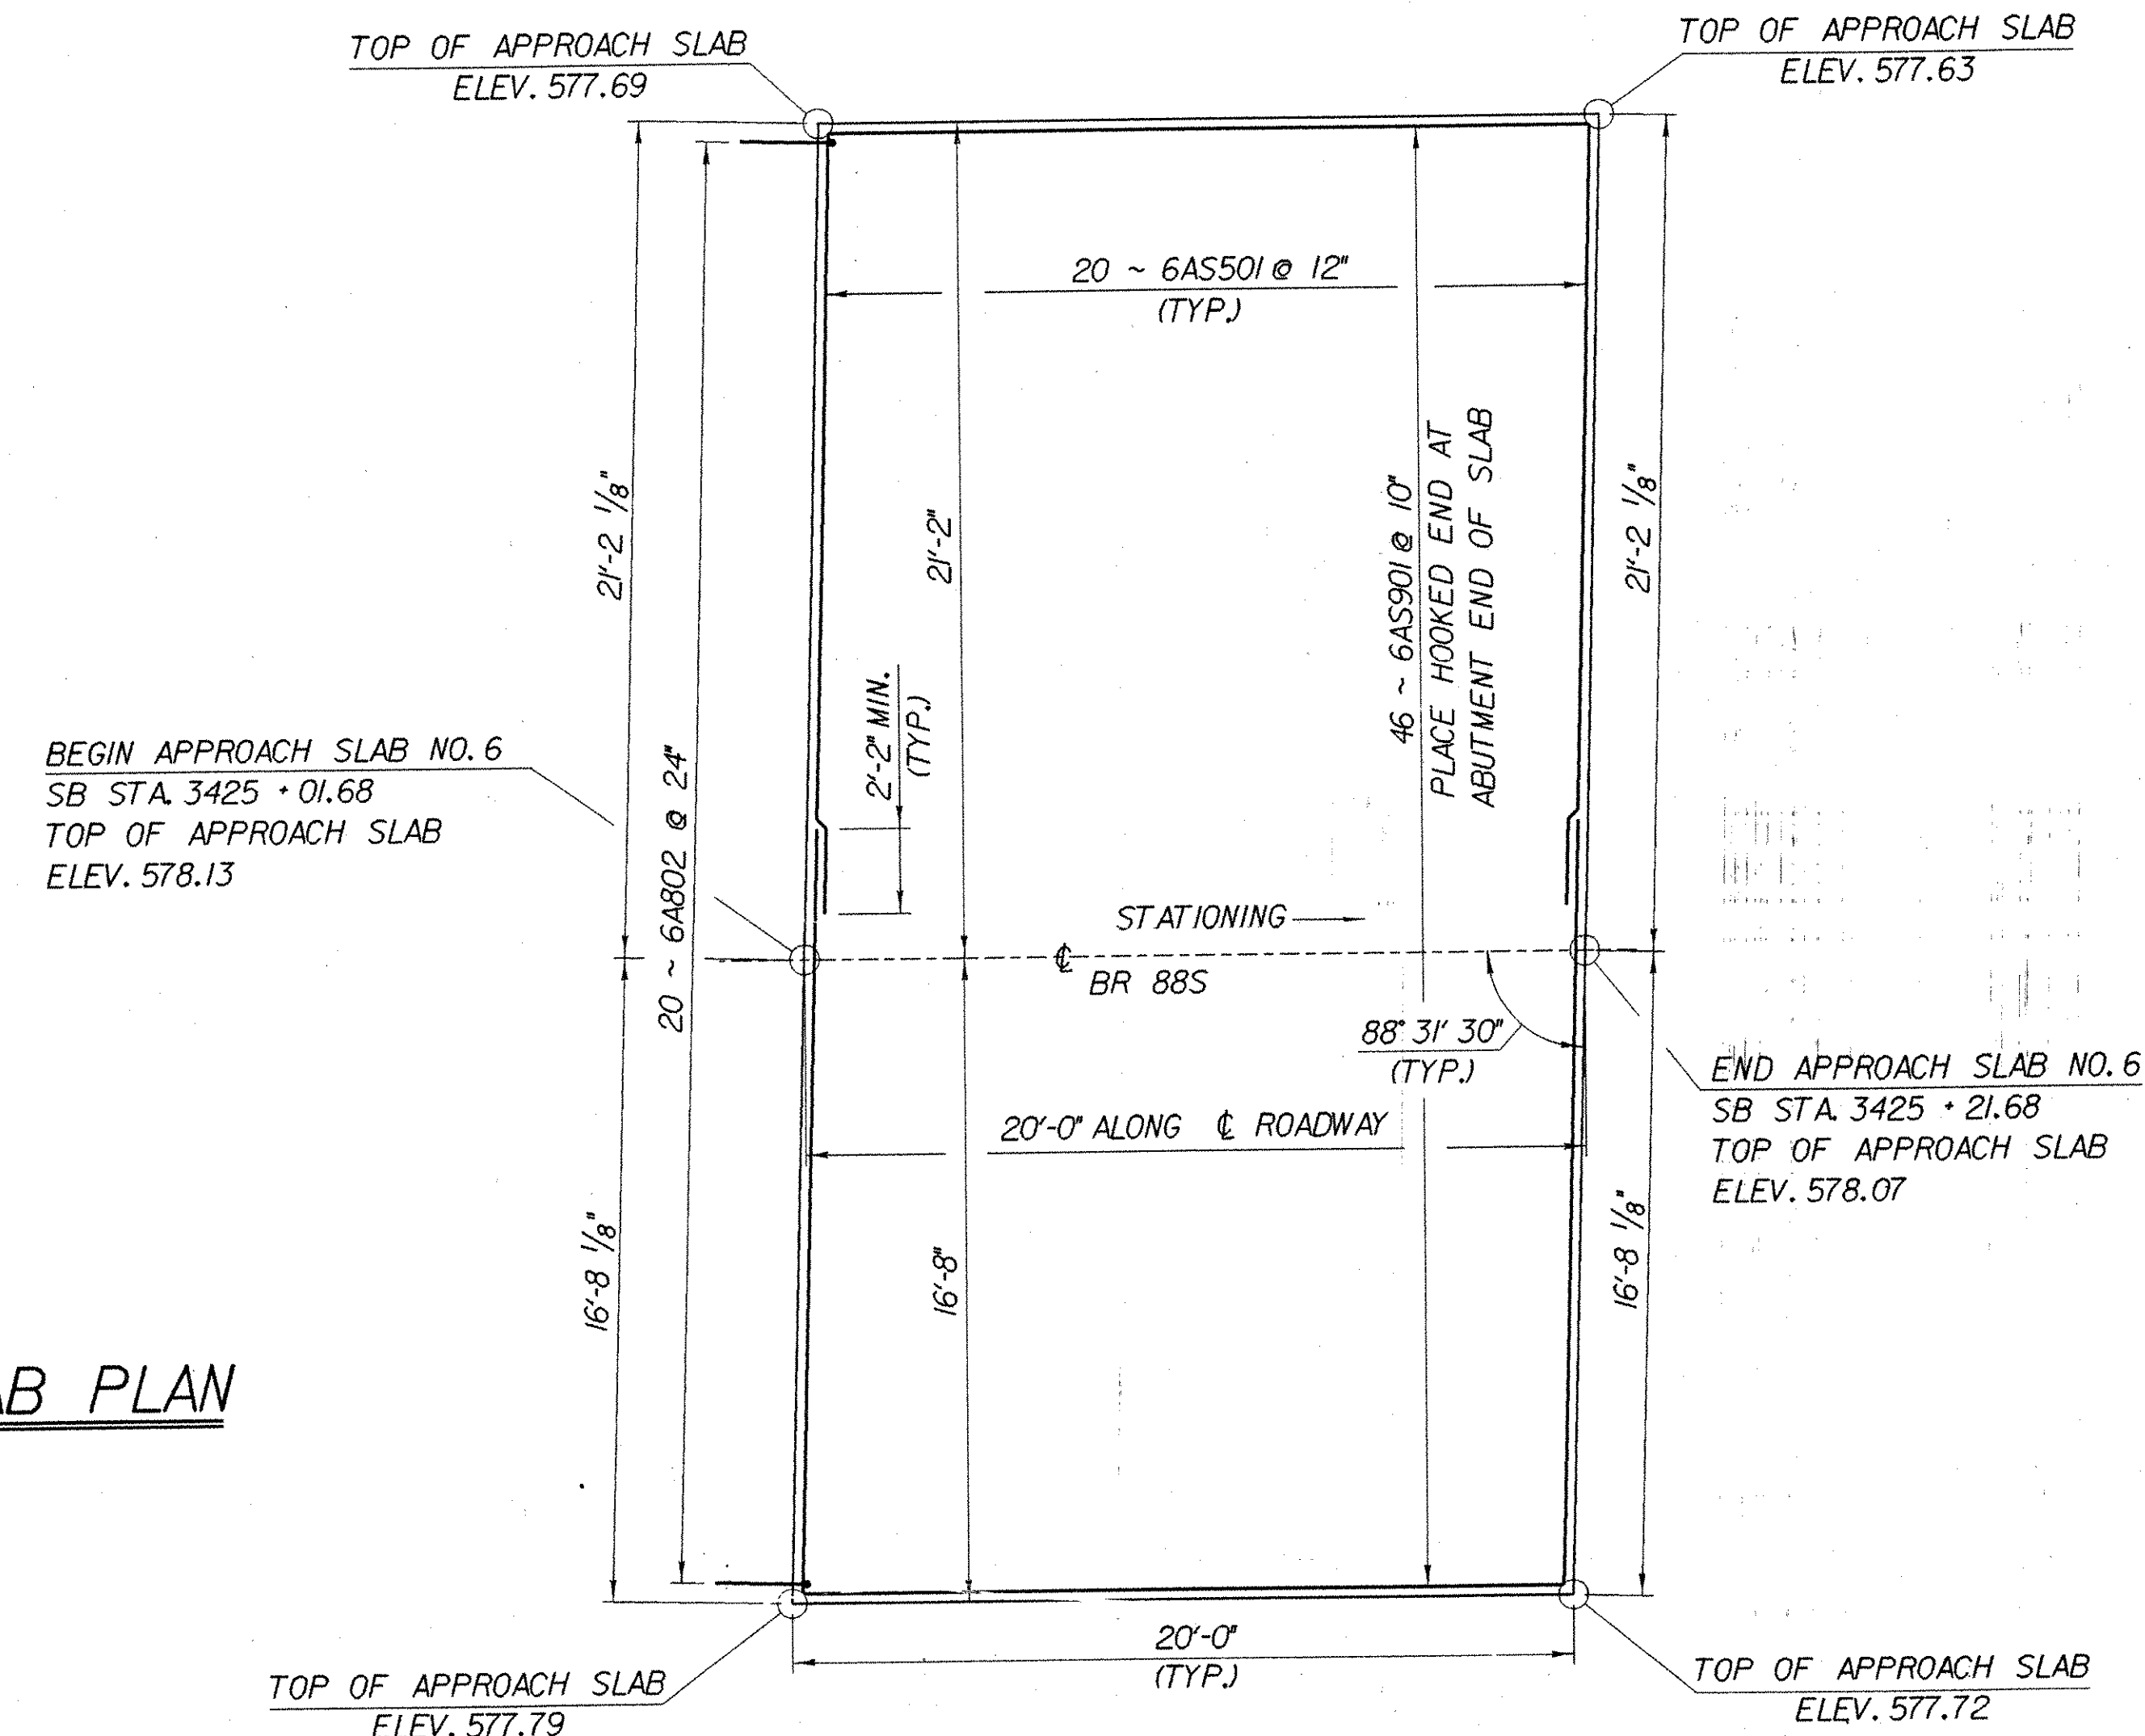


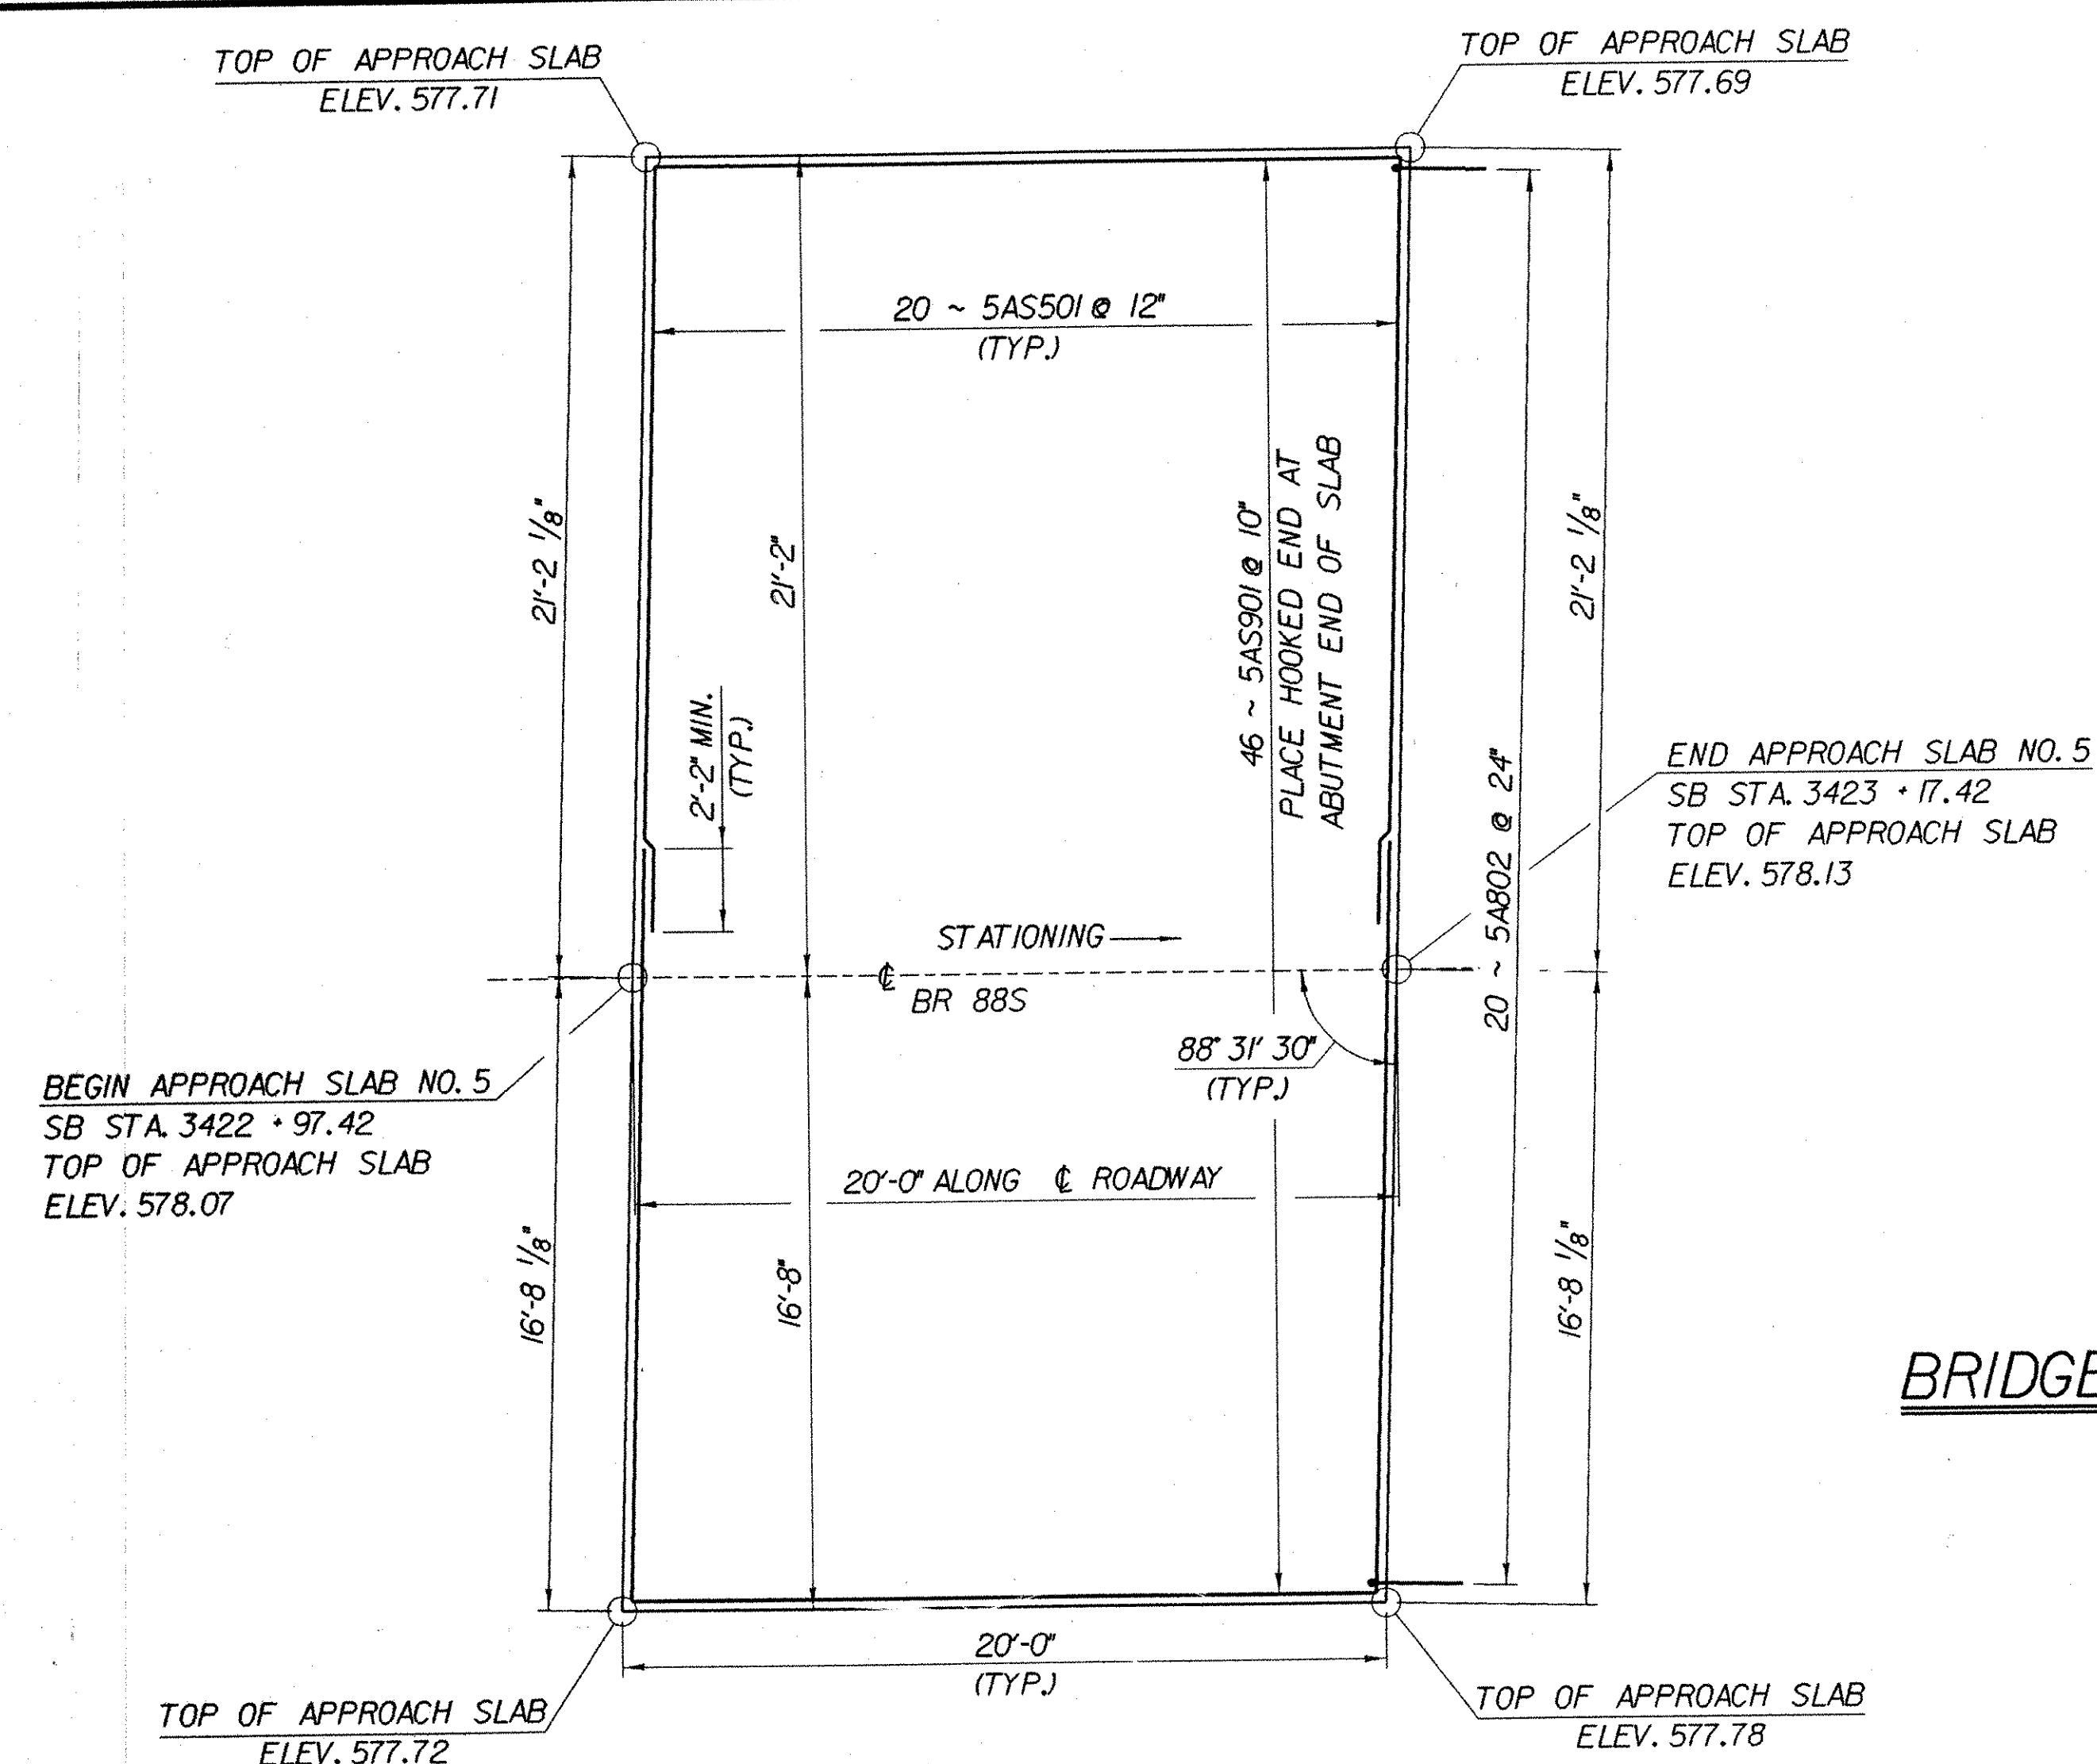

SUBBASE DETAIL AT ABUTMENTS
(ELEVATION IN CUT AND FILL)
NOT TO SCALE

**IMPORTANT NOTE: BRIDGE FINISHED GRADES
ARE CENTERLINE GRADES.**

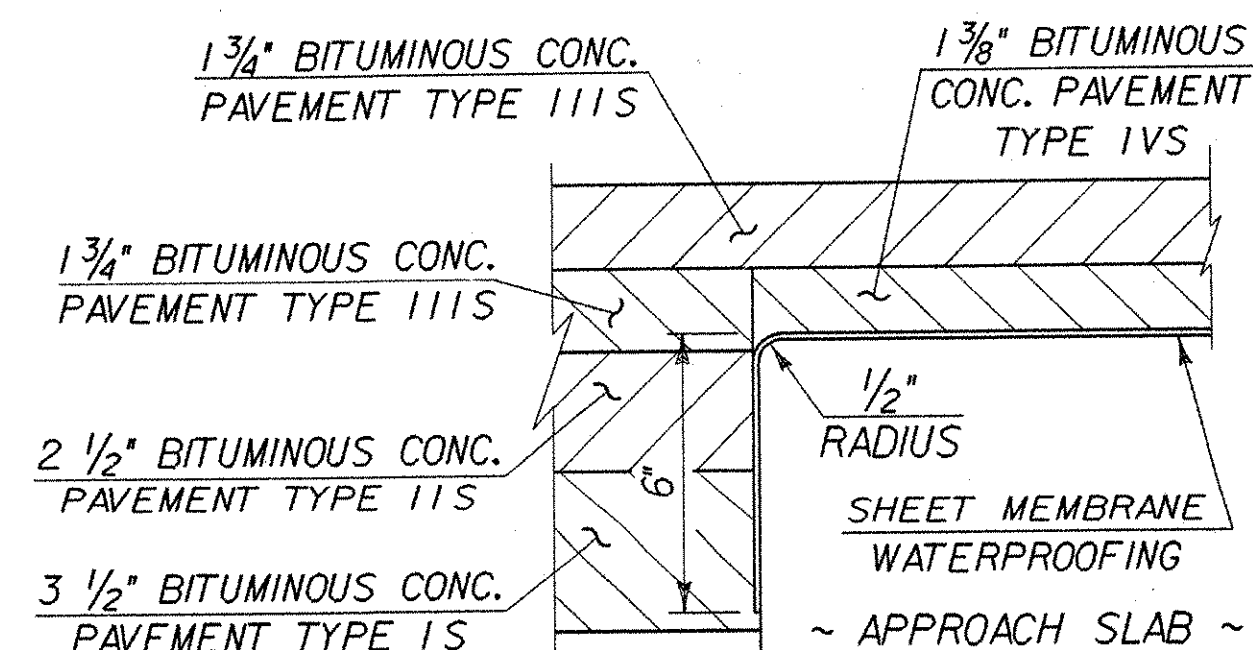

DETAIL FOR SHEET MEMBRANE
AT APPROACH SLAB END
SCALE: 3" = 1'-0"

STATE OF VERMONT
AGENCY OF TRANSPORTATION

Town Of FAIRFAX-FAIRFIELD- ST. ALBANS		Bridge No. 885
Highway No. 1-89		Log Sta.
		Surv. Sta.
1-89 OVER ST. ALBANS SOUTH STATE HIGHWAY (EXIT 19)		
88S APPROACH SLAB DETAILS		
Designed By M. LOZIER		Drawn By K. CHISHOLM
Checked By M. LOZIER	Date 2/00	Bridge Design Supervisor R. R. WHITCOMB Date 2/00
PROJECT FAIRFAX-FAIRFIELD- ST. ALBANS		PROJECT NO. 1M 089 - 3 (27)
I.G.C. Info. 96a056\Structures\sds056sp3.dgn		sds056sp3
Bridge Sheet No. BR429		Sheet 181 of 370

PLOTTED 21-SEP-2000