



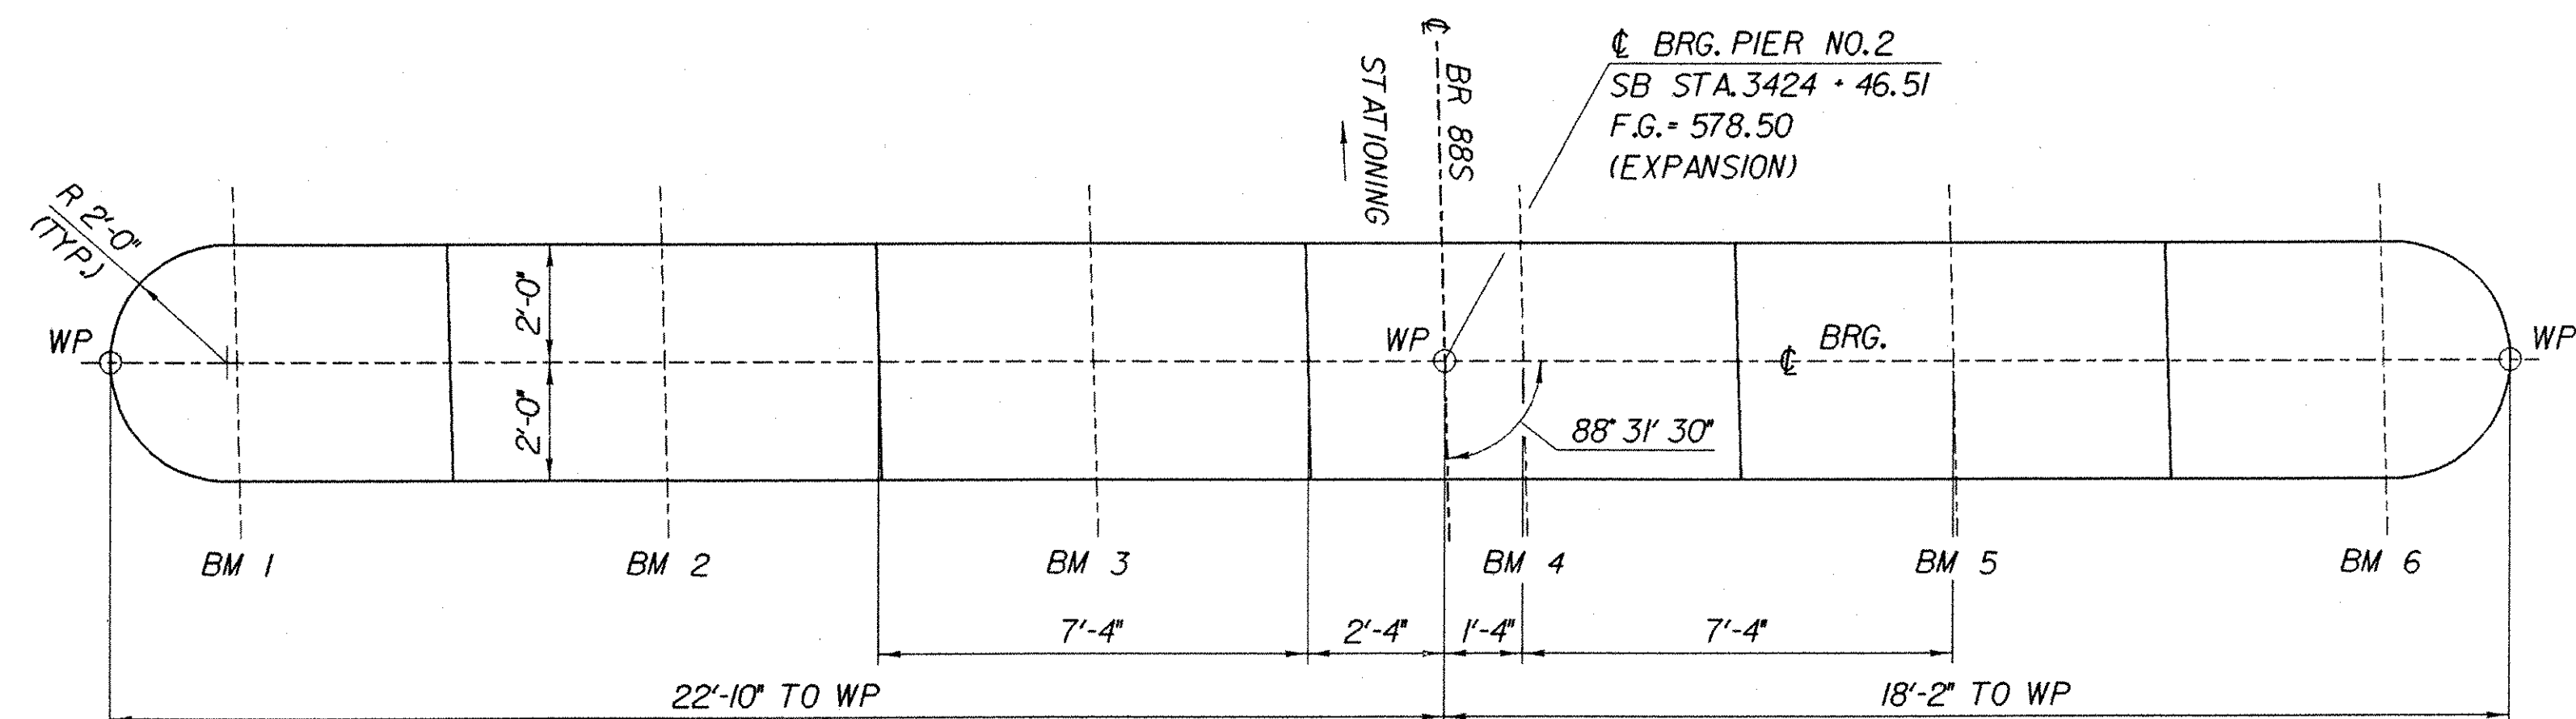

PIER NO. 2 PLAN
SCALE: $\frac{3}{8}$ " = 1'-0"

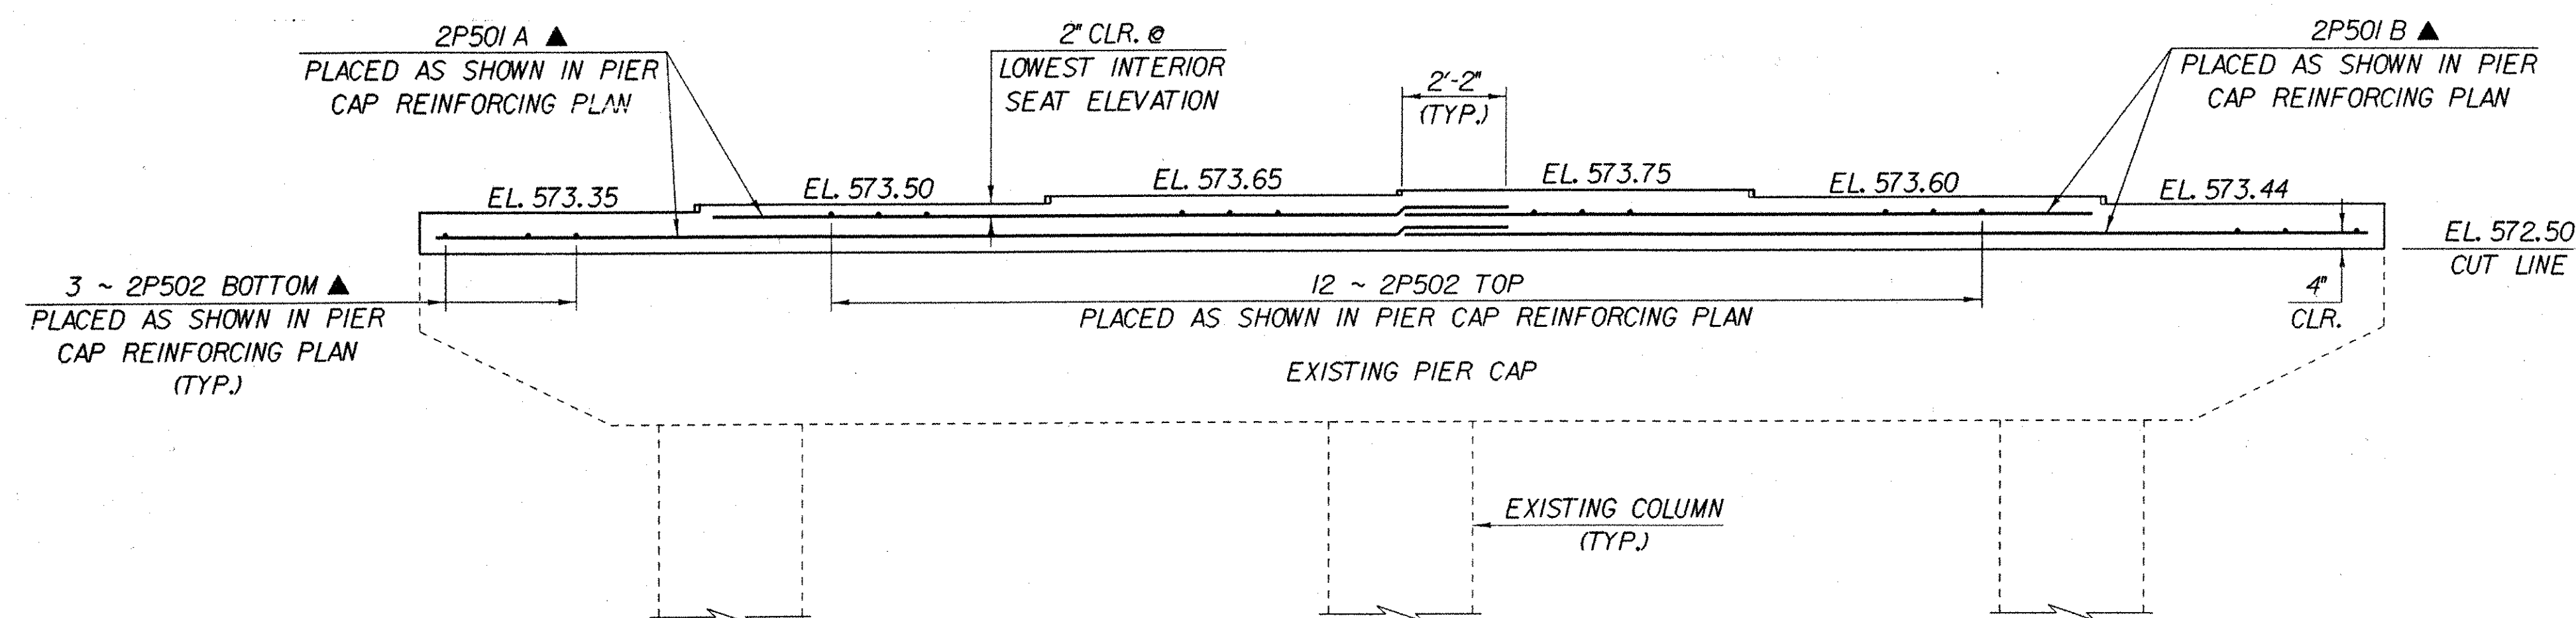

PIER NO. 2 PARTIAL ELEVATION
(LOOKING UPSTATION)
SCALE: $\frac{3}{8}$ " = 1'-0"

**IMPORTANT NOTE: BRIDGE FINISHED GRADES
ARE CENTERLINE GRADES.**

NOTE:

NF - NEAR FACE
FF - FAR FACE
EF - EACH FACE
▲ - CUT TO FIT IN FIELD
3" CLR. UNLESS OTHERWISE
SPECIFIED ON THE PLANS.

**STATE OF VERMONT
AGENCY OF TRANSPORTATION**

Town Of	FAIRFAX-FAIRFIELD-ST. ALBANS	Bridge No.	88S
Highway No.	1-89	Log Sta.	
		Surv. Sta.	
1-89 OVER ST. ALBANS SOUTH STATE HIGHWAY (EXIT 19)			
PIER NO. 2 DETAILS			
Designed By	M. LOZIER	Drawn By	K. CHISHOLM
Checked By	M. LOZIER	Bridge Design Supervisor	R. R. WHITCOMB
	Date 2/00	Date	2/00
PROJECT	FAIRFAX-FAIRFIELD-ST. ALBANS	PROJECT NO.	1M 089 - 3 (27)
I.G.C. Info.	96a056Structures\sa056ab2.dgn		sa056pr2.j
Bridge Sheet No.	BR443	Sheet	195 of 370