



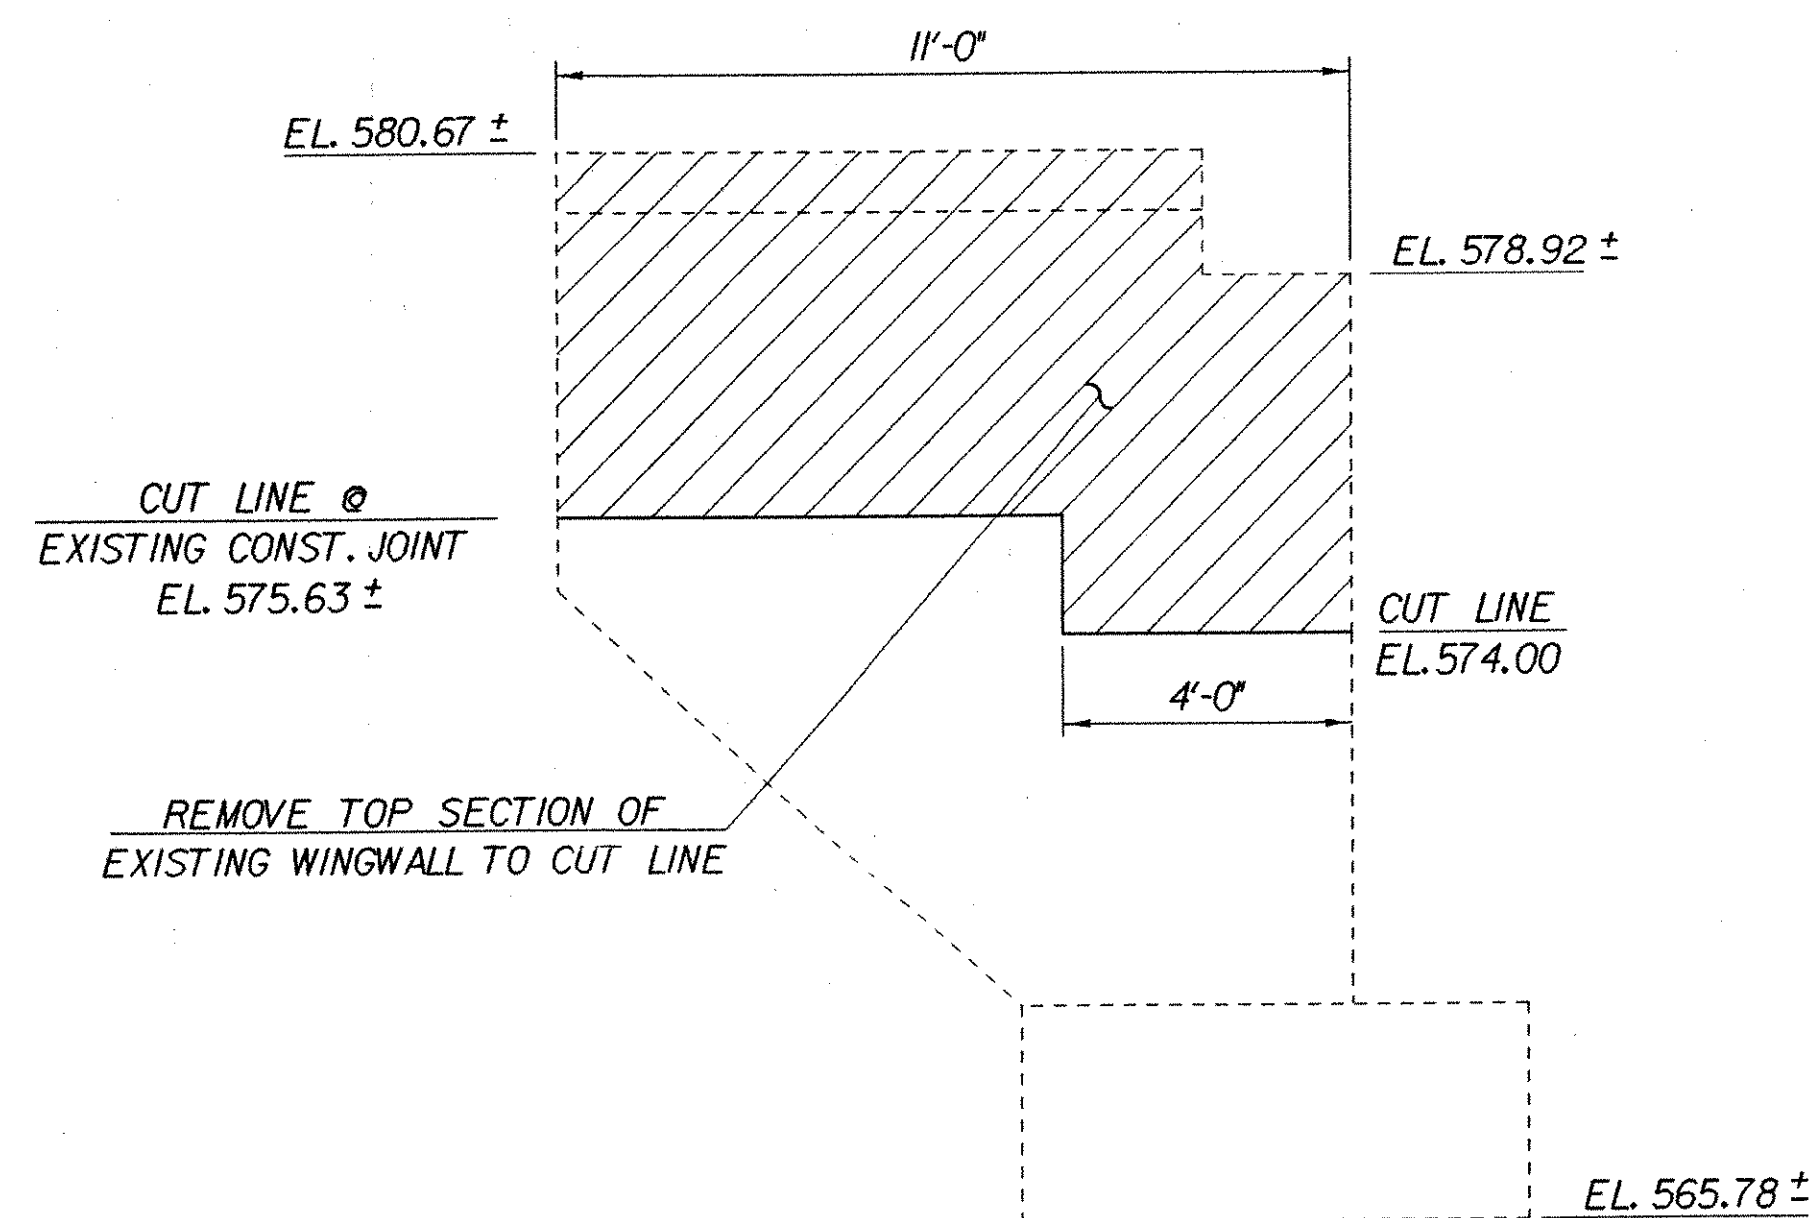


**PARTIAL REMOVAL OF
EXISTING WINGWALL NO. 14**

SCALE: $\frac{3}{8}$ " = 1'-0"

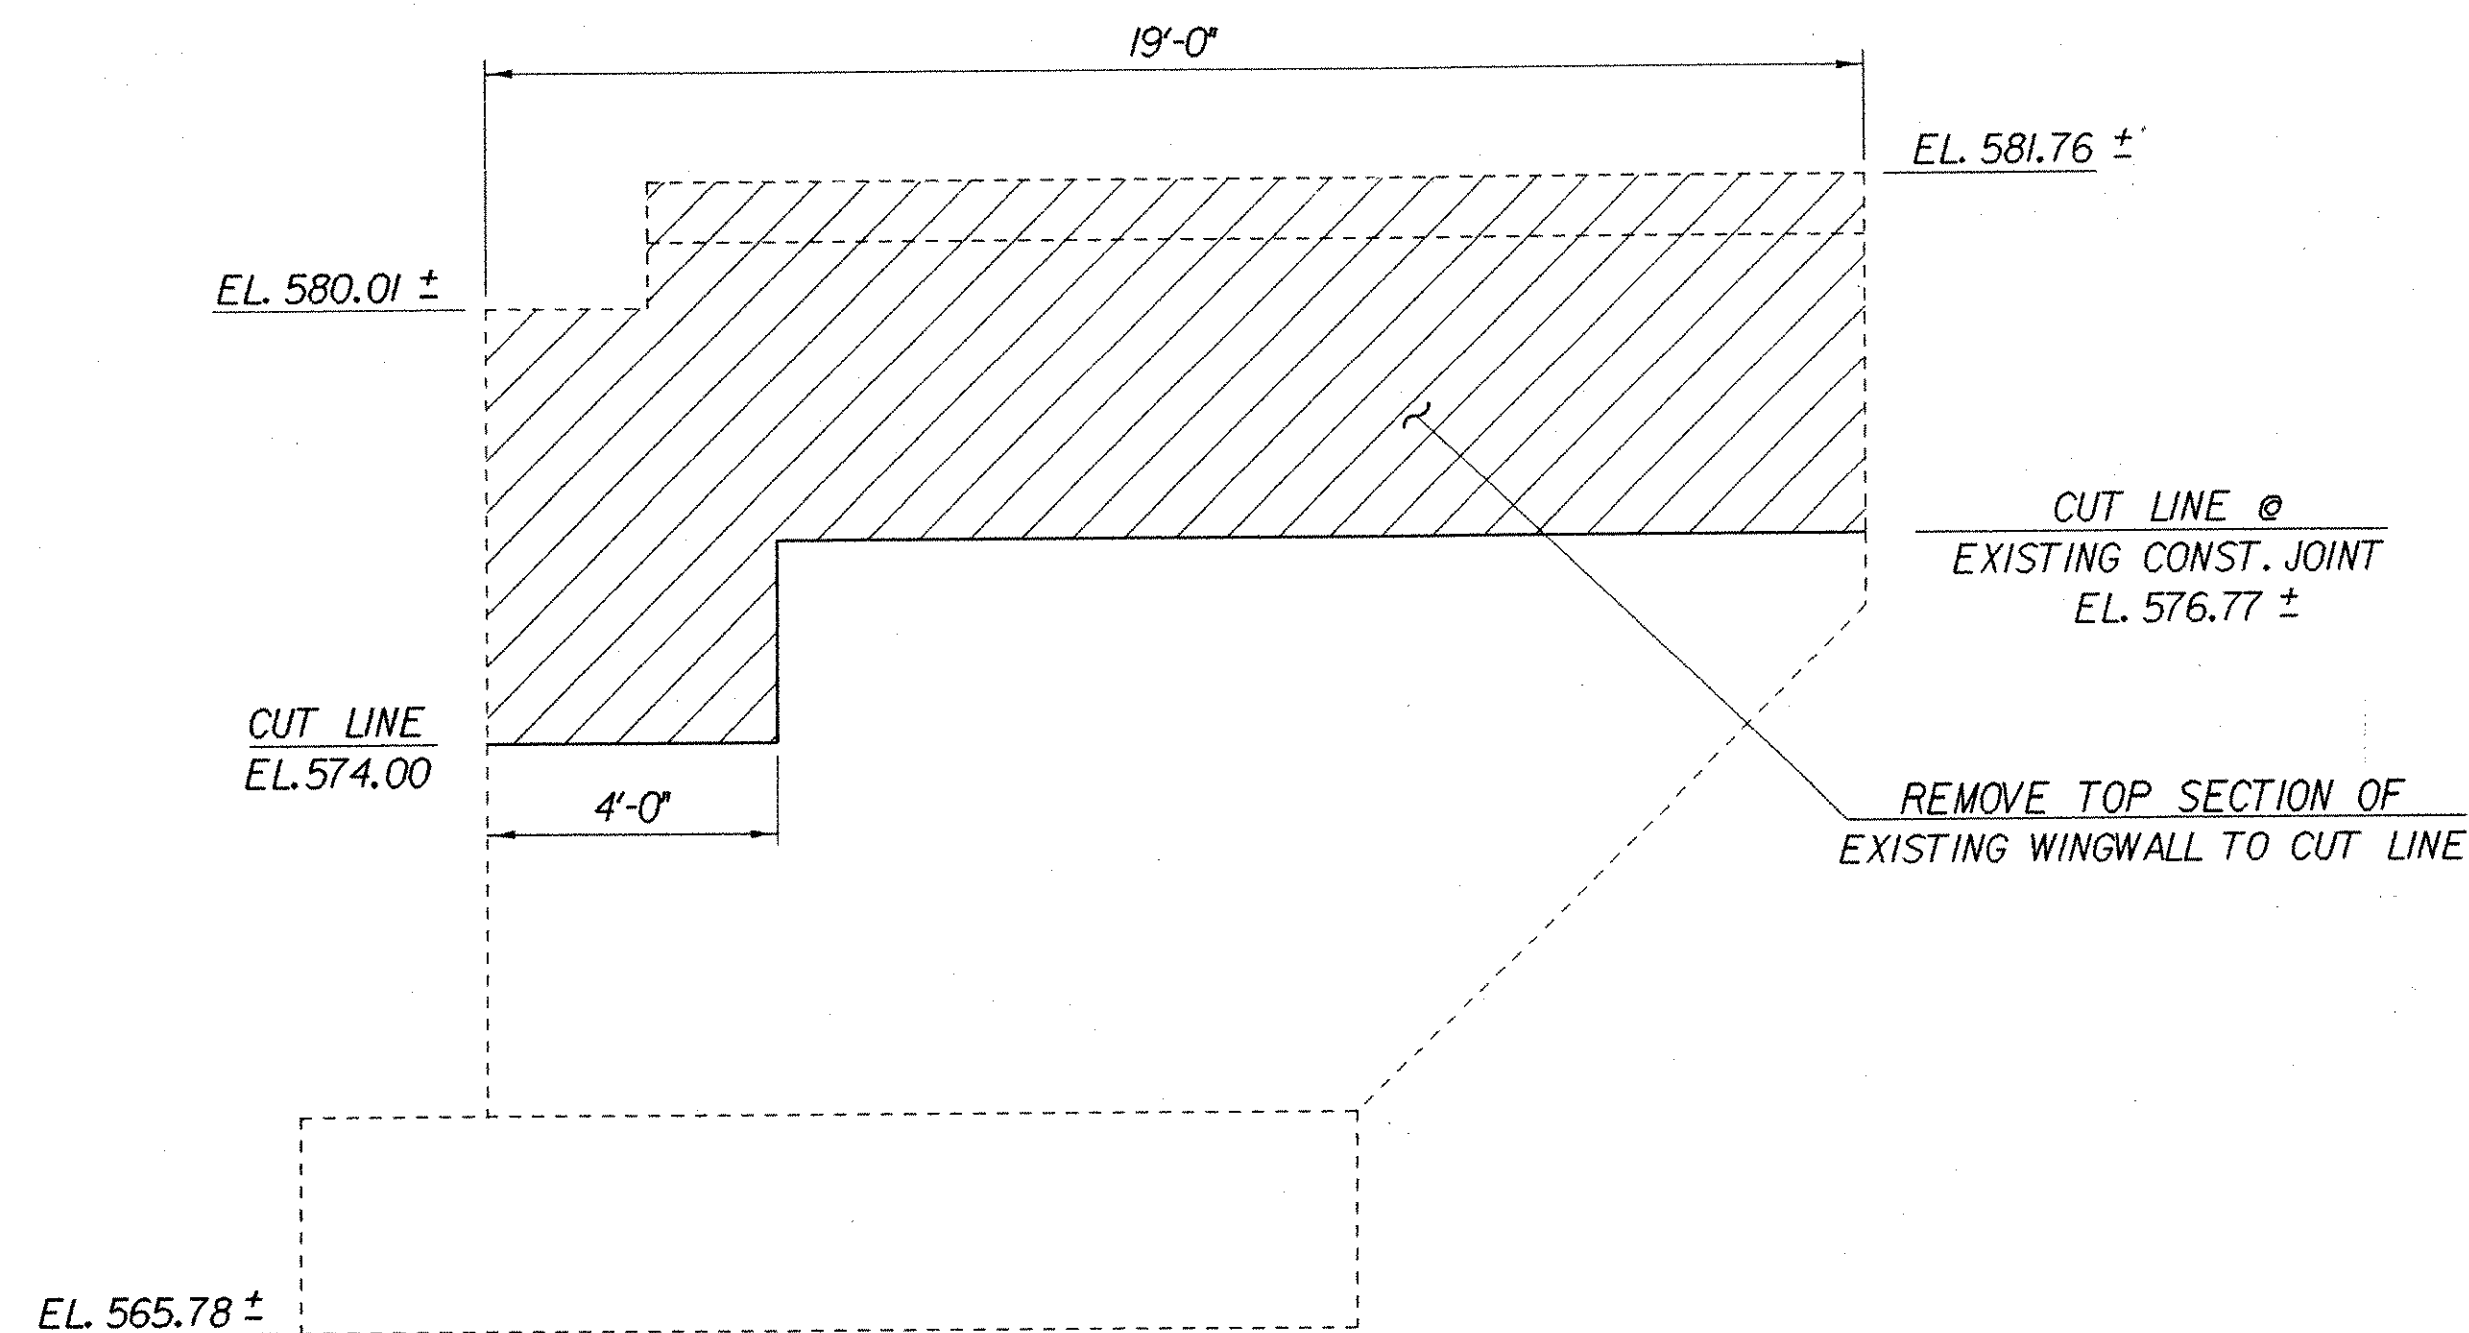


**PARTIAL REMOVAL OF
EXISTING WINGWALL NO. 13**

SCALE: $\frac{3}{8}$ " = 1'-0"

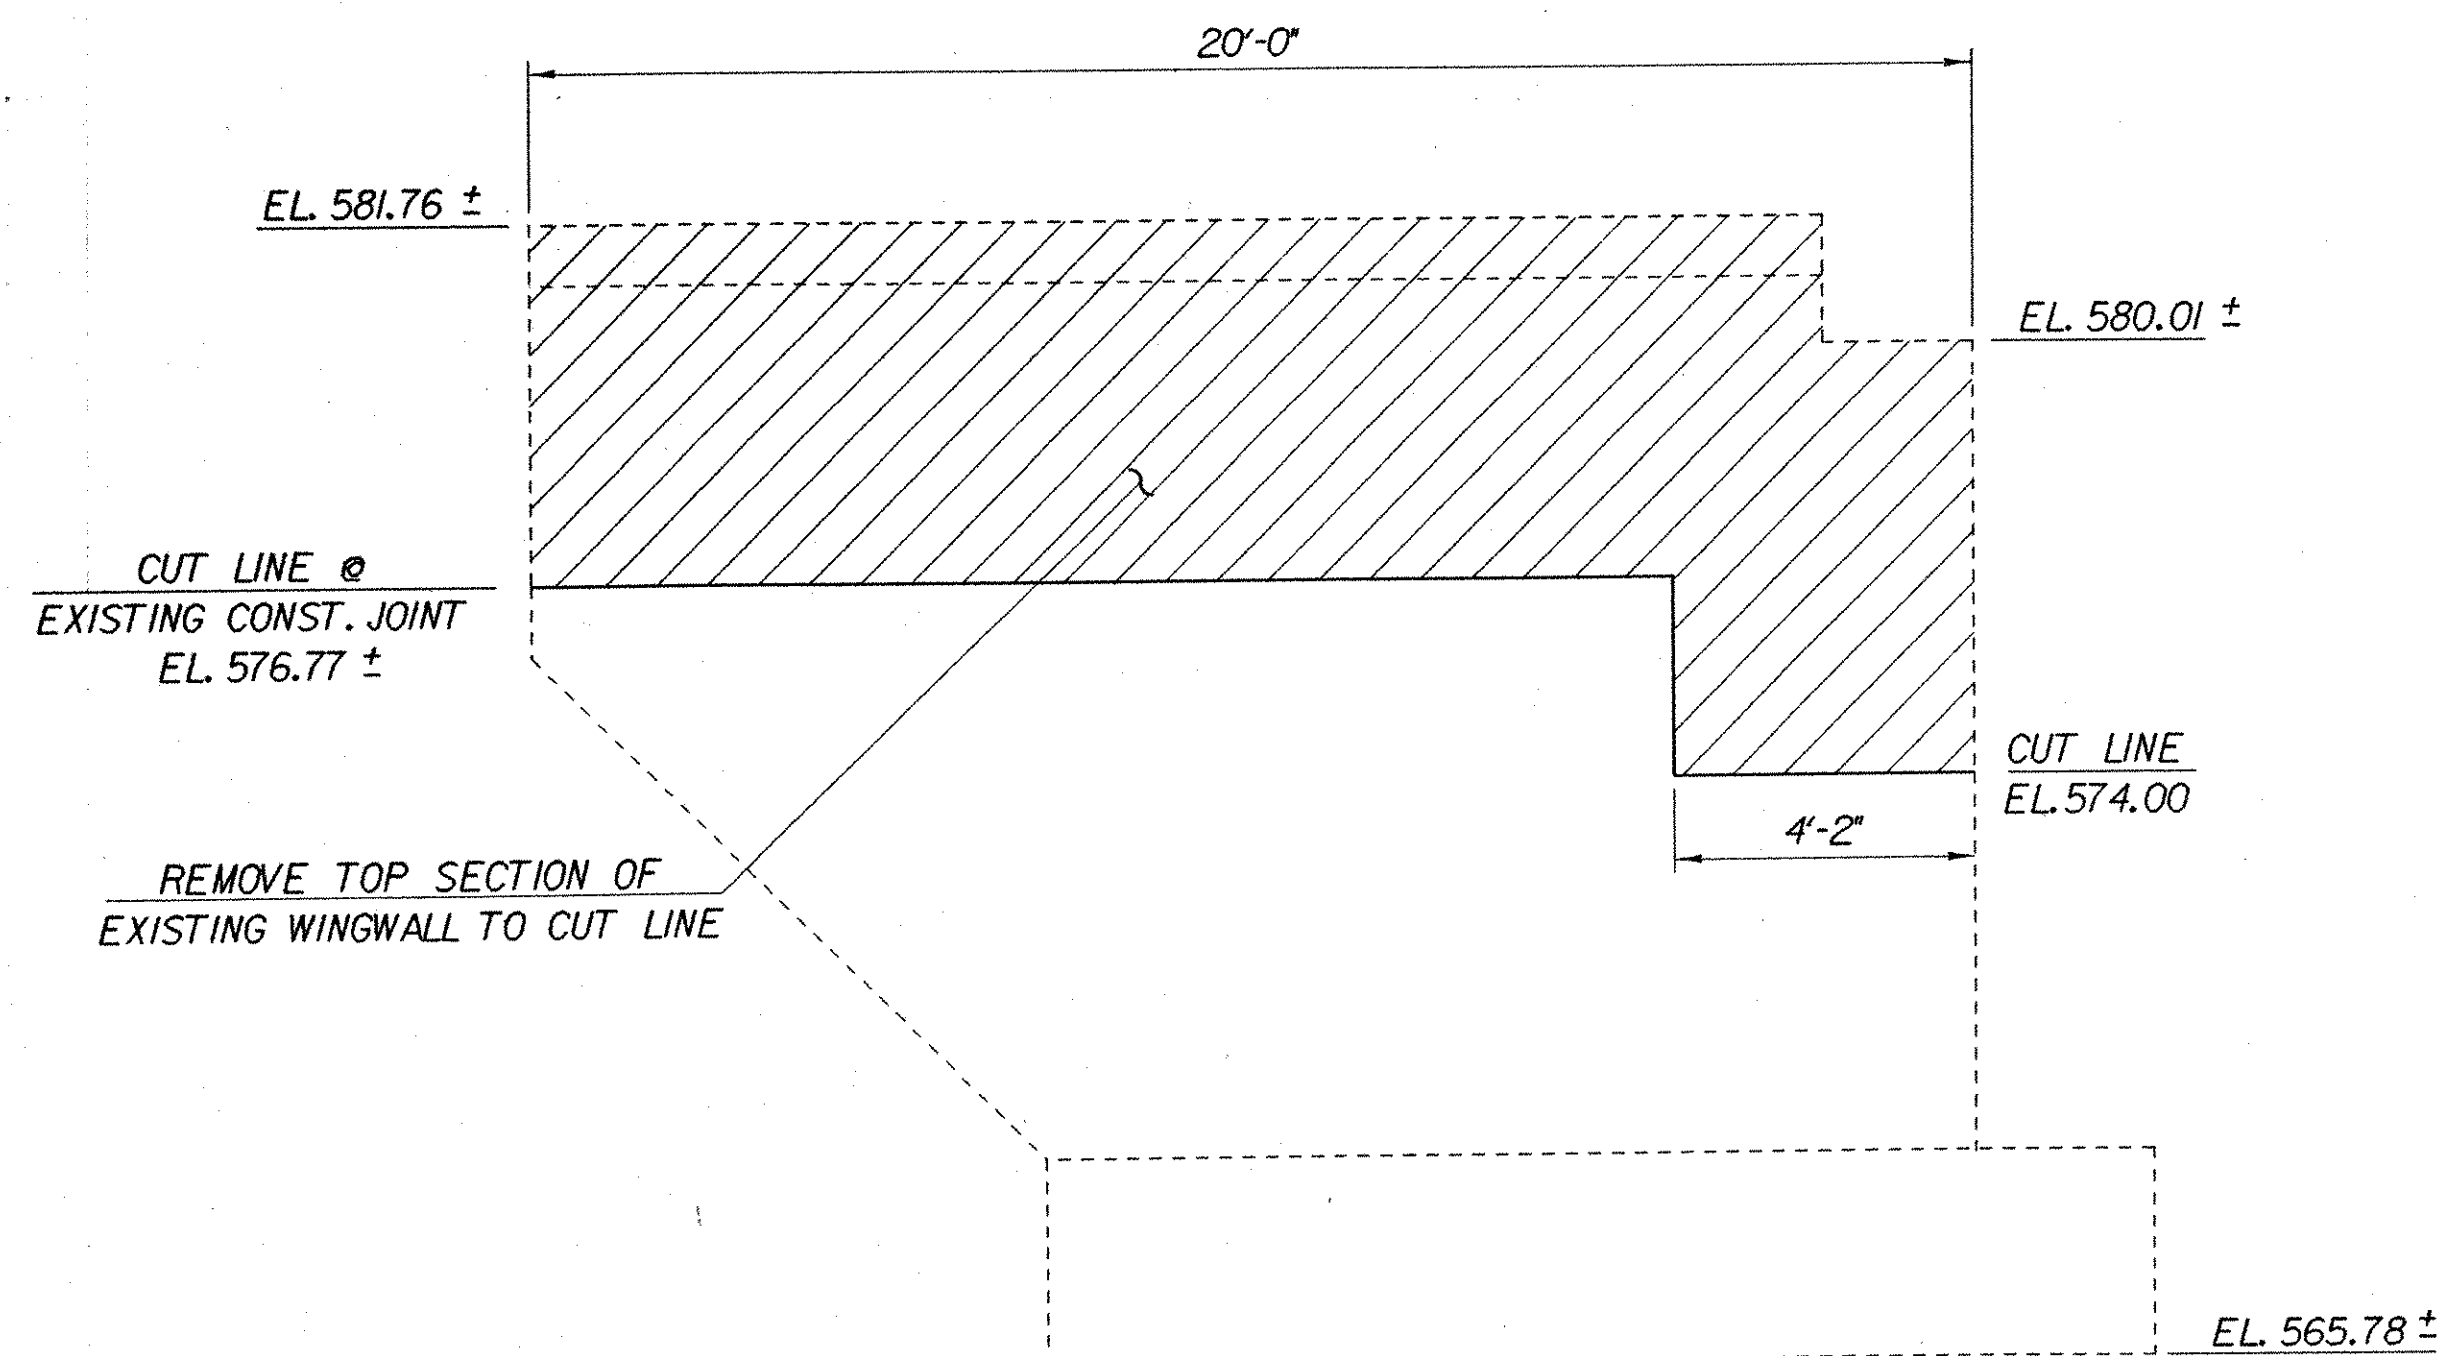

**PARTIAL REMOVAL OF
EXISTING WINGWALL NO. 15**

SCALE: $\frac{3}{8}$ " = 1'-0"

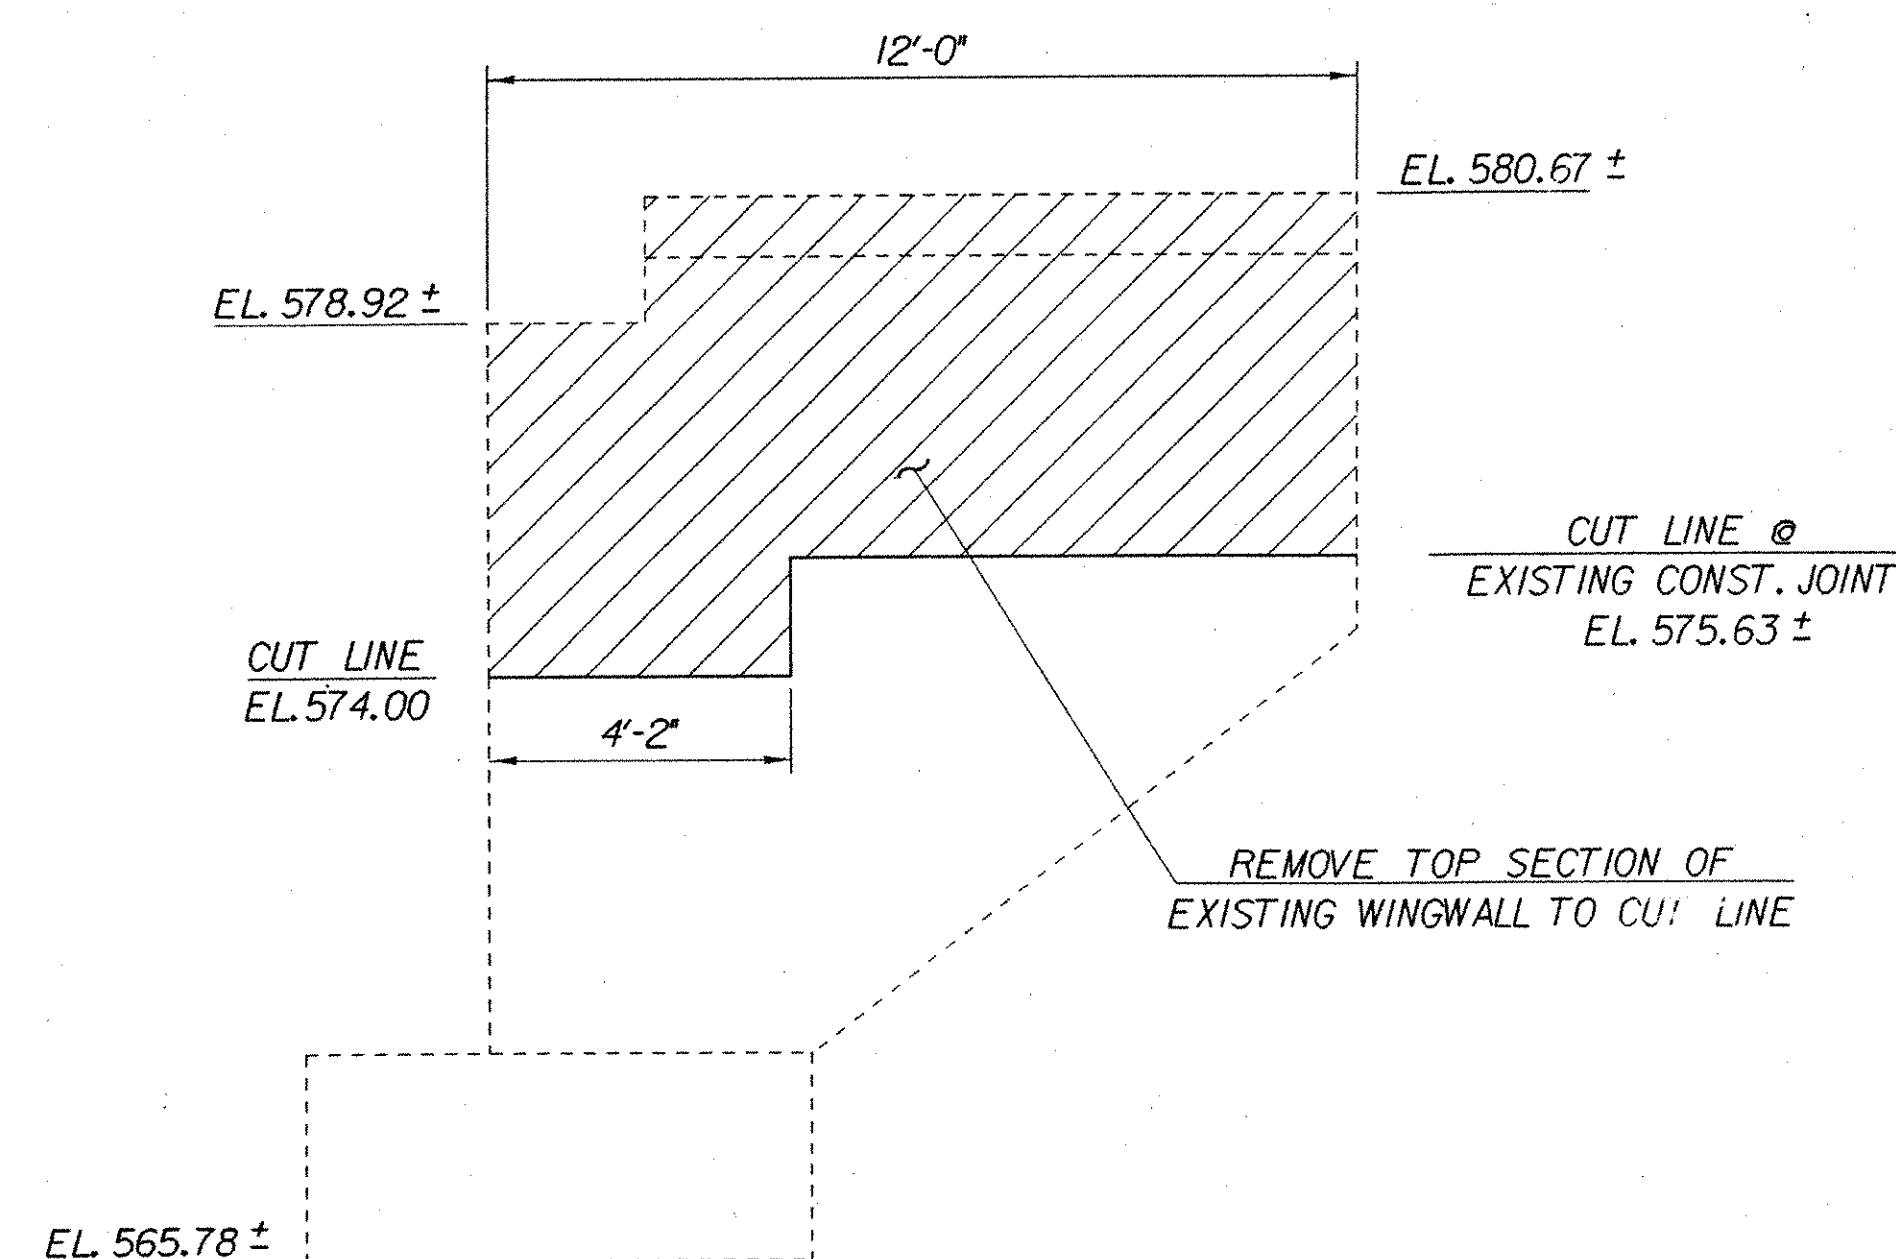

**PARTIAL REMOVAL OF
EXISTING WINGWALL NO. 16**

SCALE: $\frac{3}{8}$ " = 1'-0"

**IMPORTANT NOTE: BRIDGE FINISHED GRADES
ARE CENTERLINE GRADES.**

**STATE OF VERMONT
AGENCY OF TRANSPORTATION**

Town Of FAIRFAX-FAIRFIELD-ST. ALBANS	Bridge No. 88N
Highway No. 1-89	Log Sta.
	Surv. Sta.
1-89 OVER ST. ALBANS SOUTH STATE HIGHWAY (EXIT 19)	
88N WINGWALL REMOVAL DETAILS	
Designed By P. PERRY	Drawn By K. CHISHOLM
Checked By M. LOZIER	Bridge Design Supervisor R. R. WHITCOMB
Date 2/00	Date 2/00
PROJECT FAIRFAX-FAIRFIELD-ST. ALBANS	PROJECT NO. 1M 089 - 3 (27)
I.G.C. Info. 96a056Structures\sd056ab3.dgn	sd056rm5J
Bridge Sheet No. BR445	Sheet 197 of 370

PLOTTED 21-SEP-2000